





PREPARED BY:
MARK ALLEN BREUER
PE-2005007268
06.09.2023

SCHLAGEL & ASSOCIATES, P.A.

**PERGOLA PARK 5TH PLAT
STREET, STORMWATER, MASTER DRAINAGE
PLAN & EROSION AND SEDIMENT CONTROL**

- LEE'S SUMMIT, MISSOURI

Record Drawing

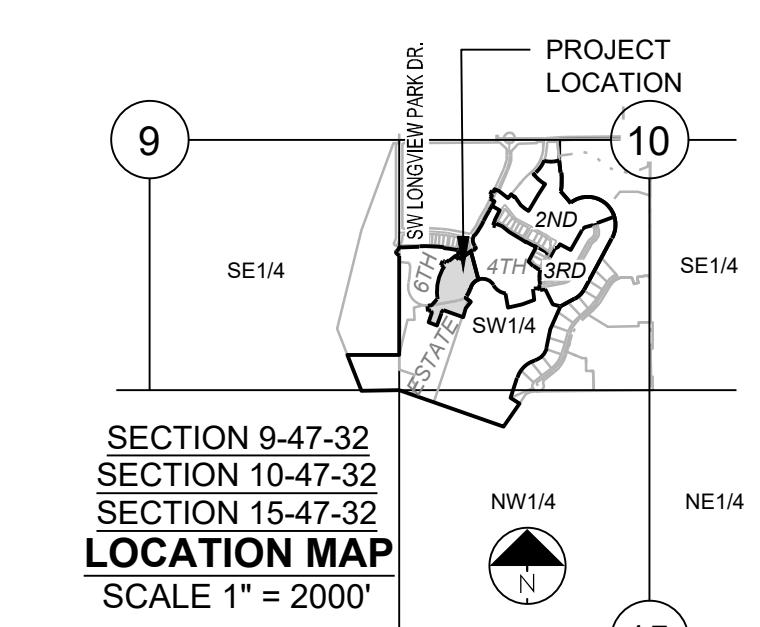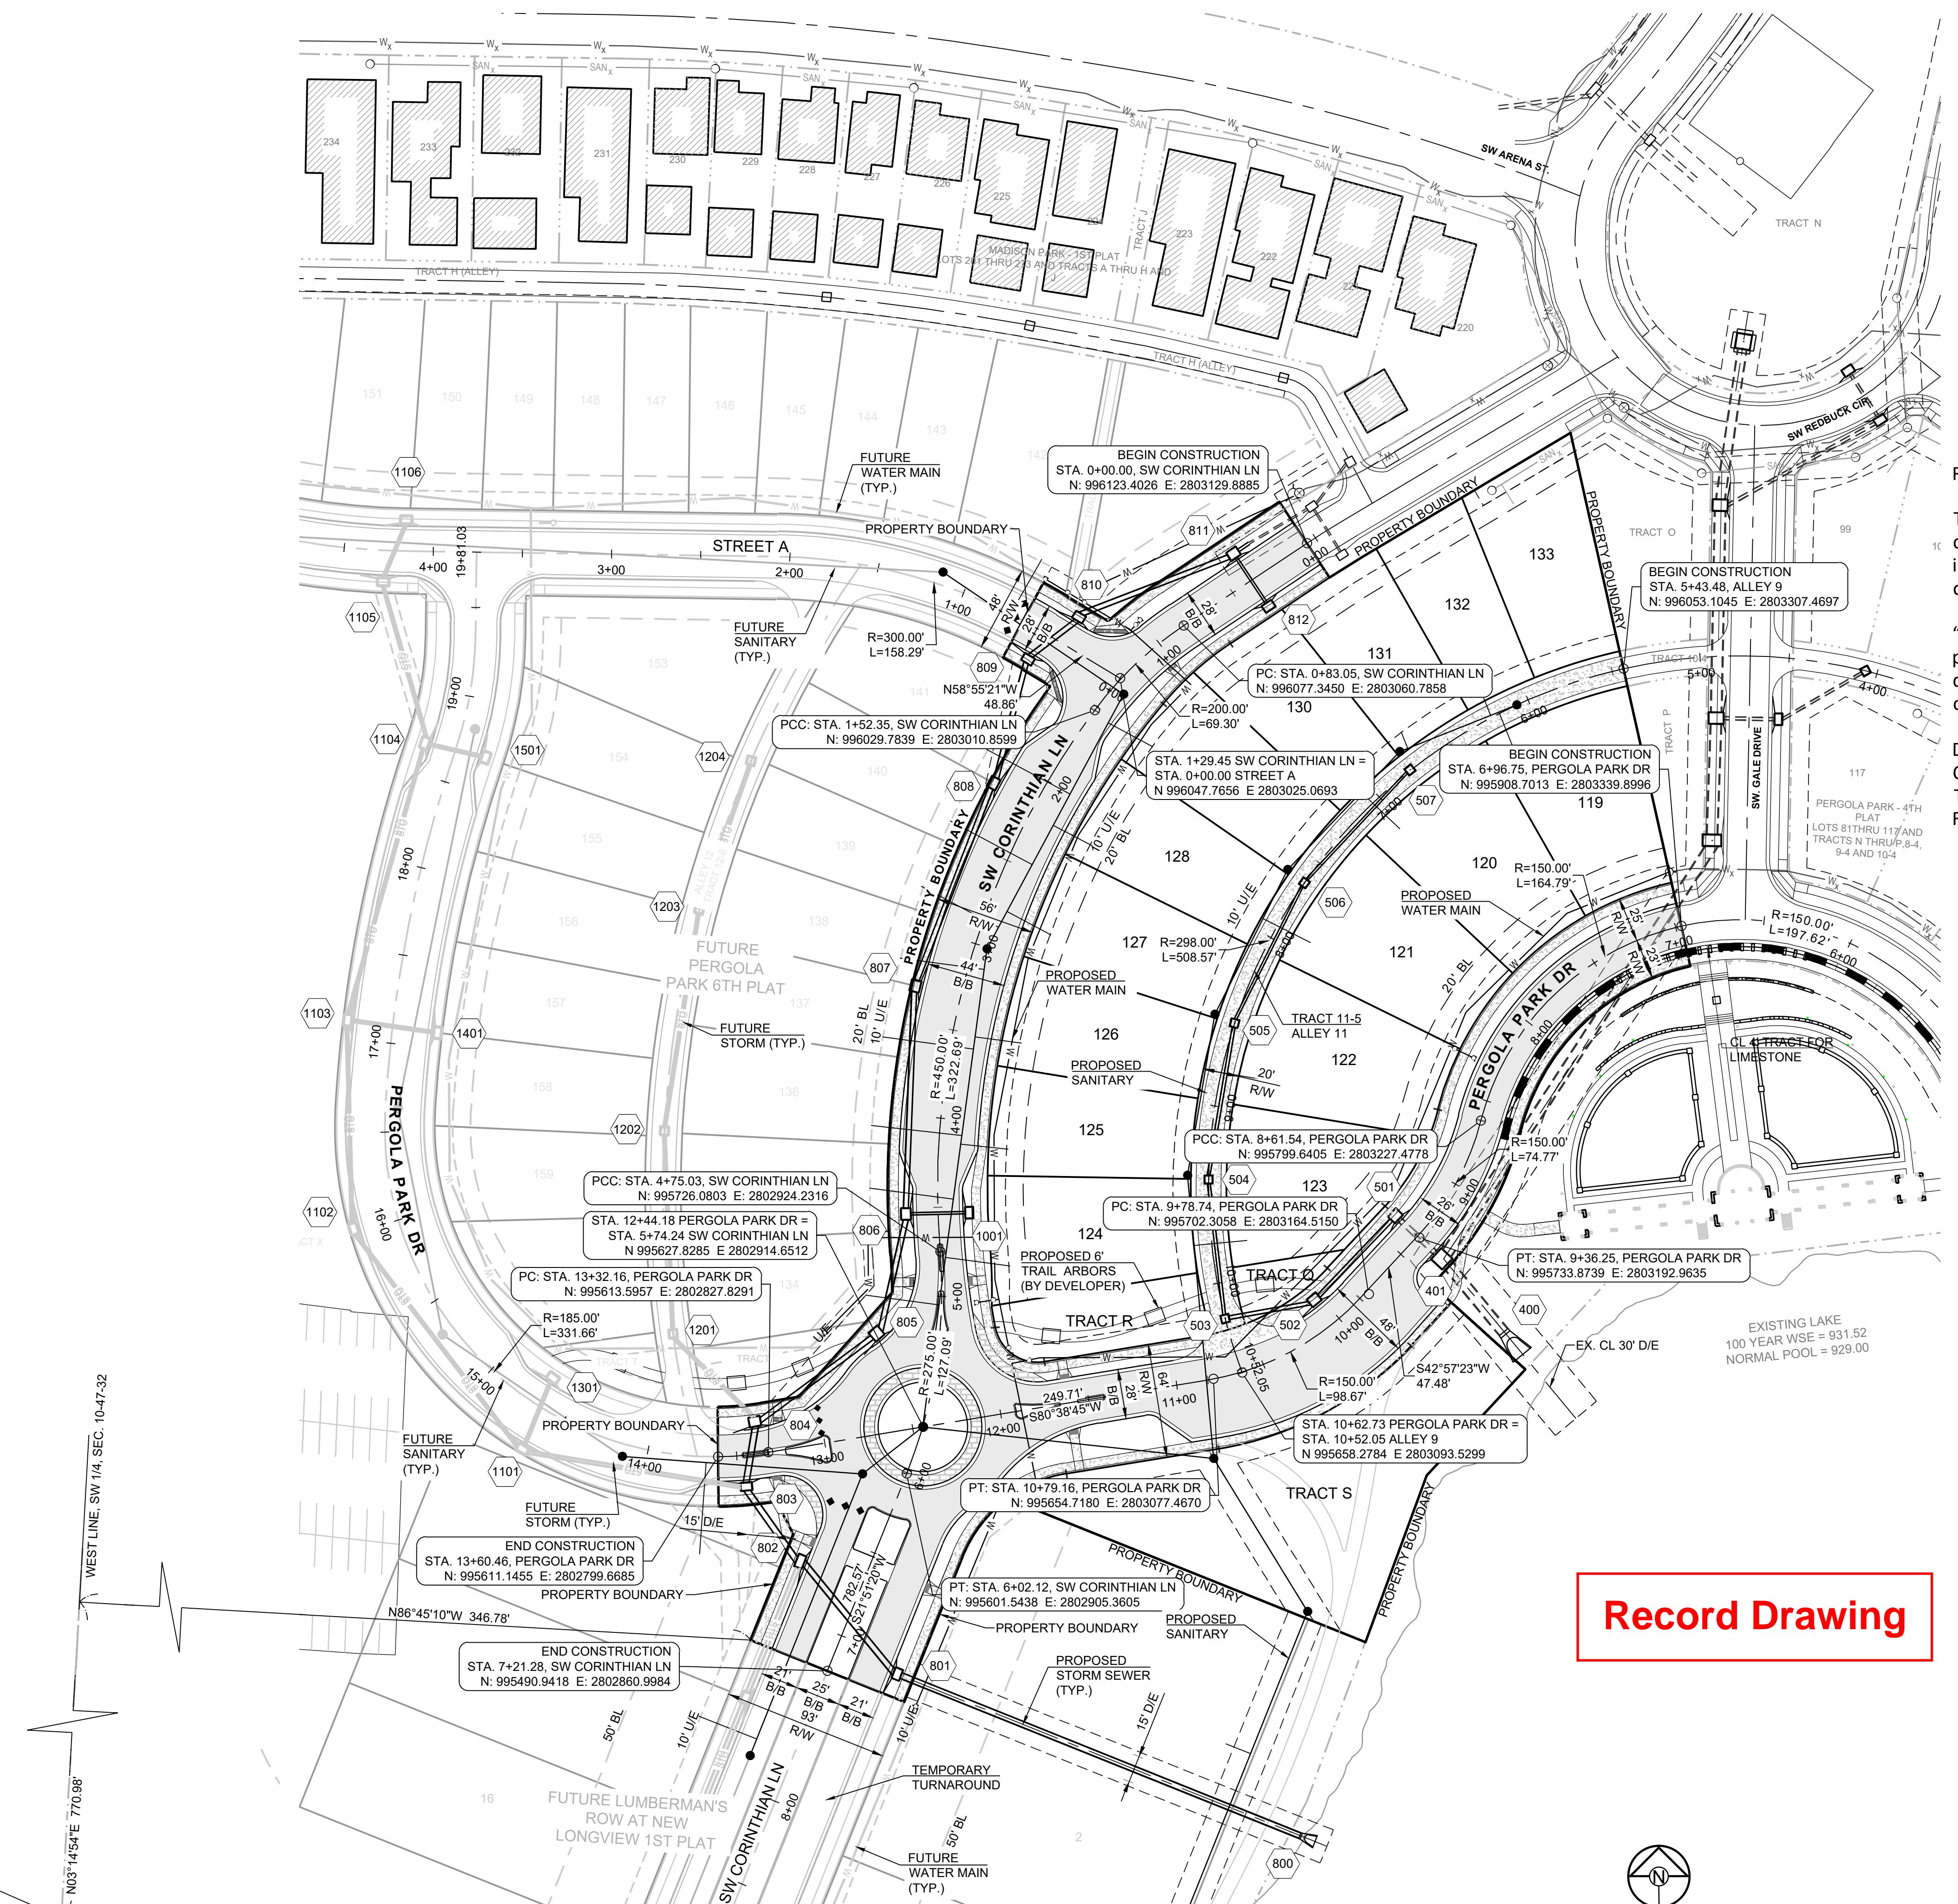

**MISSOURI GEOGRAPHIC REFERENCE SYSTEM
BENCH MARK:**

BM JA-148, IS A STAMPED KC METRO DISK SET IN CONCRETE LOCATED 2 MILES WEST OF THE INTERSECTION OF HIGHWAY 50 AND 3RD ST. IT IS 44 FT NORTH OF THE CENTER OF 3RD ST. AND 102.5 FT WEST OF THE CENTER OF THE EXIT FROM THE ADJACENT PARKING LOT.

ELEV. 935.18


PROJECT BENCHMARK:

CHISELED "SQUARE" ON STORM CURB INLET AT NORTHWEST
INTERSECTION OF SW. TOWER PARK DRIVE AND SW. LONGVIEW
BOULEVARD.

NORTHING: 998893.4148
EASTING: 2803318.5413
ELEV. 1004.09

SURVEY NOTES

The bases of bearing and coordinates are base on the Missouri Coordinate System of 1983, West Zone (2003 Adjustment) with a Grid Factor of 0.999902.

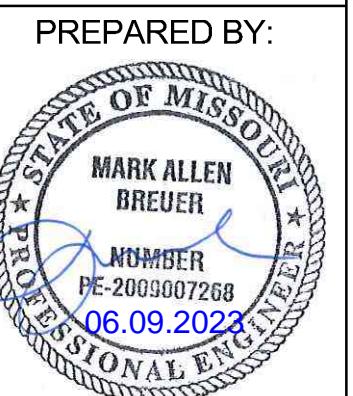


SCHLAGEL & ASSOCIATES, P.A.

PREPARED BY:
MARK ALLEN BREWER
JANNE BREWER
PE-2035007268
06.09.2023

PERGOLA PARK 5TH PLAT

STREET, STORMWATER, MASTER DRAINAGE
PLAN & EROSION AND SEDIMENT CONTROL
- LEE'S SUMMIT, MISSOURI

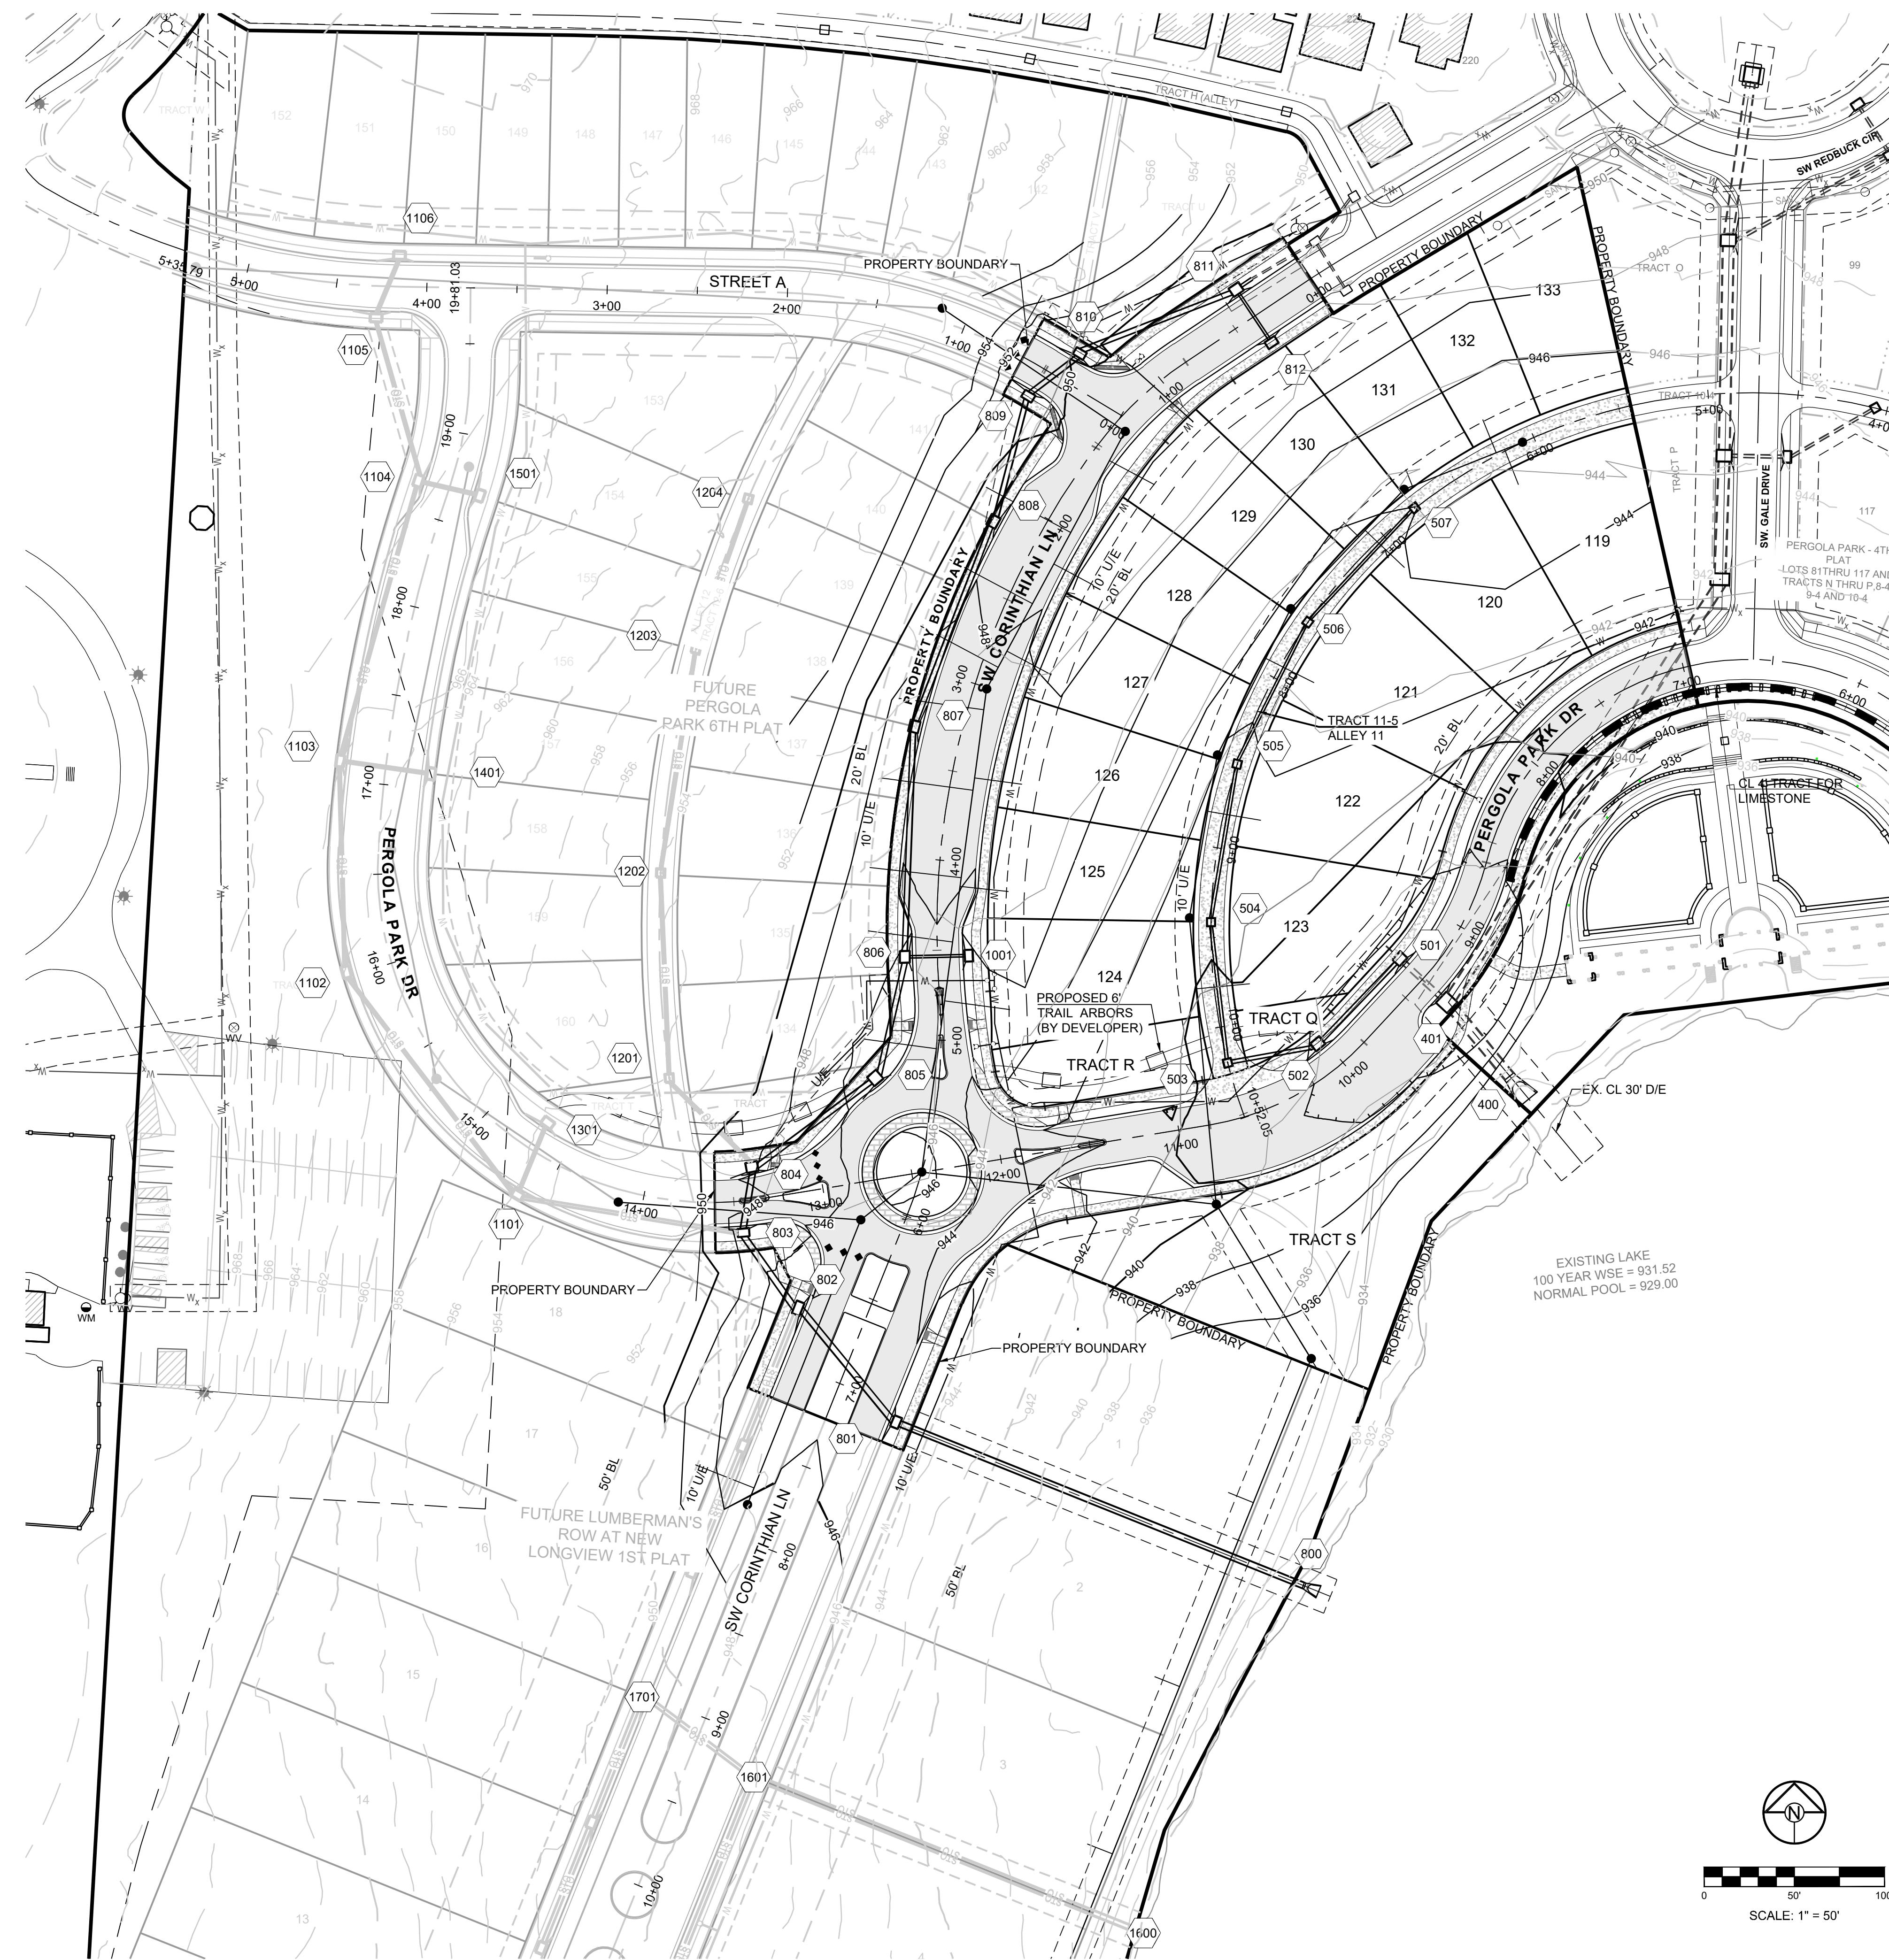

RECORD DRAWING

The information provided on this drawing conforms to construction records; it is not intended for construction, implementation or recording purposes; and it is solely based on information obtained by Schlagel and Associates.

"100.00 100.10", "1.00% 1.15% slope", or "8-inch HDPE PVC pipe" are all typical examples of revisions that indicate that design data has been replaced with "as-built" information. All other data is as designed and has not been field verified.

Date: 5/22/2023
Certified by: BAL
Title: Design Engineer
Firm: Schlagel and Associates, P.A.

NOTE:

THE CONTRACTOR IS RESPONSIBLE FOR VERIFYING ALL EXISTING UTILITY LOCATIONS PRIOR TO EXCAVATIONS.

- DENOTES PROPOSED MAJOR CONTOUR
- DENOTES PROPOSED MINOR CONTOUR
- DENOTES EXISTING MAJOR CONTOUR
- DENOTES EXISTING MINOR CONTOUR
- DENOTES AS-BUILT MAJOR CONTOUR
- DENOTES AS-BUILT MINOR CONTOUR

MISSOURI GEOGRAPHIC REFERENCE SYSTEM
BENCH MARK:

BM JA-148, IS A STAMPED KC METRO DISK SET IN CONCRETE LOCATED 2 MILES WEST OF THE INTERSECTION OF HIGHWAY 50 AND 3RD ST. IT IS 44 FT NORTH OF THE CENTER OF 3RD ST. AND 102.5 FT WEST OF THE CENTER OF THE EXIT FROM THE ADJACENT PARKING LOT.

ELEV. 935.18


PROJECT BENCHMARK:

CHISELED "SQUARE" ON STORM CURB INLET AT NORTHWEST INTERSECTION OF SW. PARK DRIVE AND SW. LONGVIEW BOULEVARD.

NORTHING: 998893.4148
EASTING: 280318.5413
ELEV. 1004.09


SCALE: 1" = 50'
0 50' 100'

Record Drawing

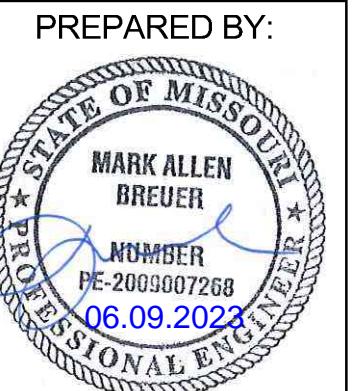


PREPARED BY:
MARK ALLEN BREUER
PE-2035007268
06.09.2023

SCHLAGEL & ASSOCIATES, P.A.

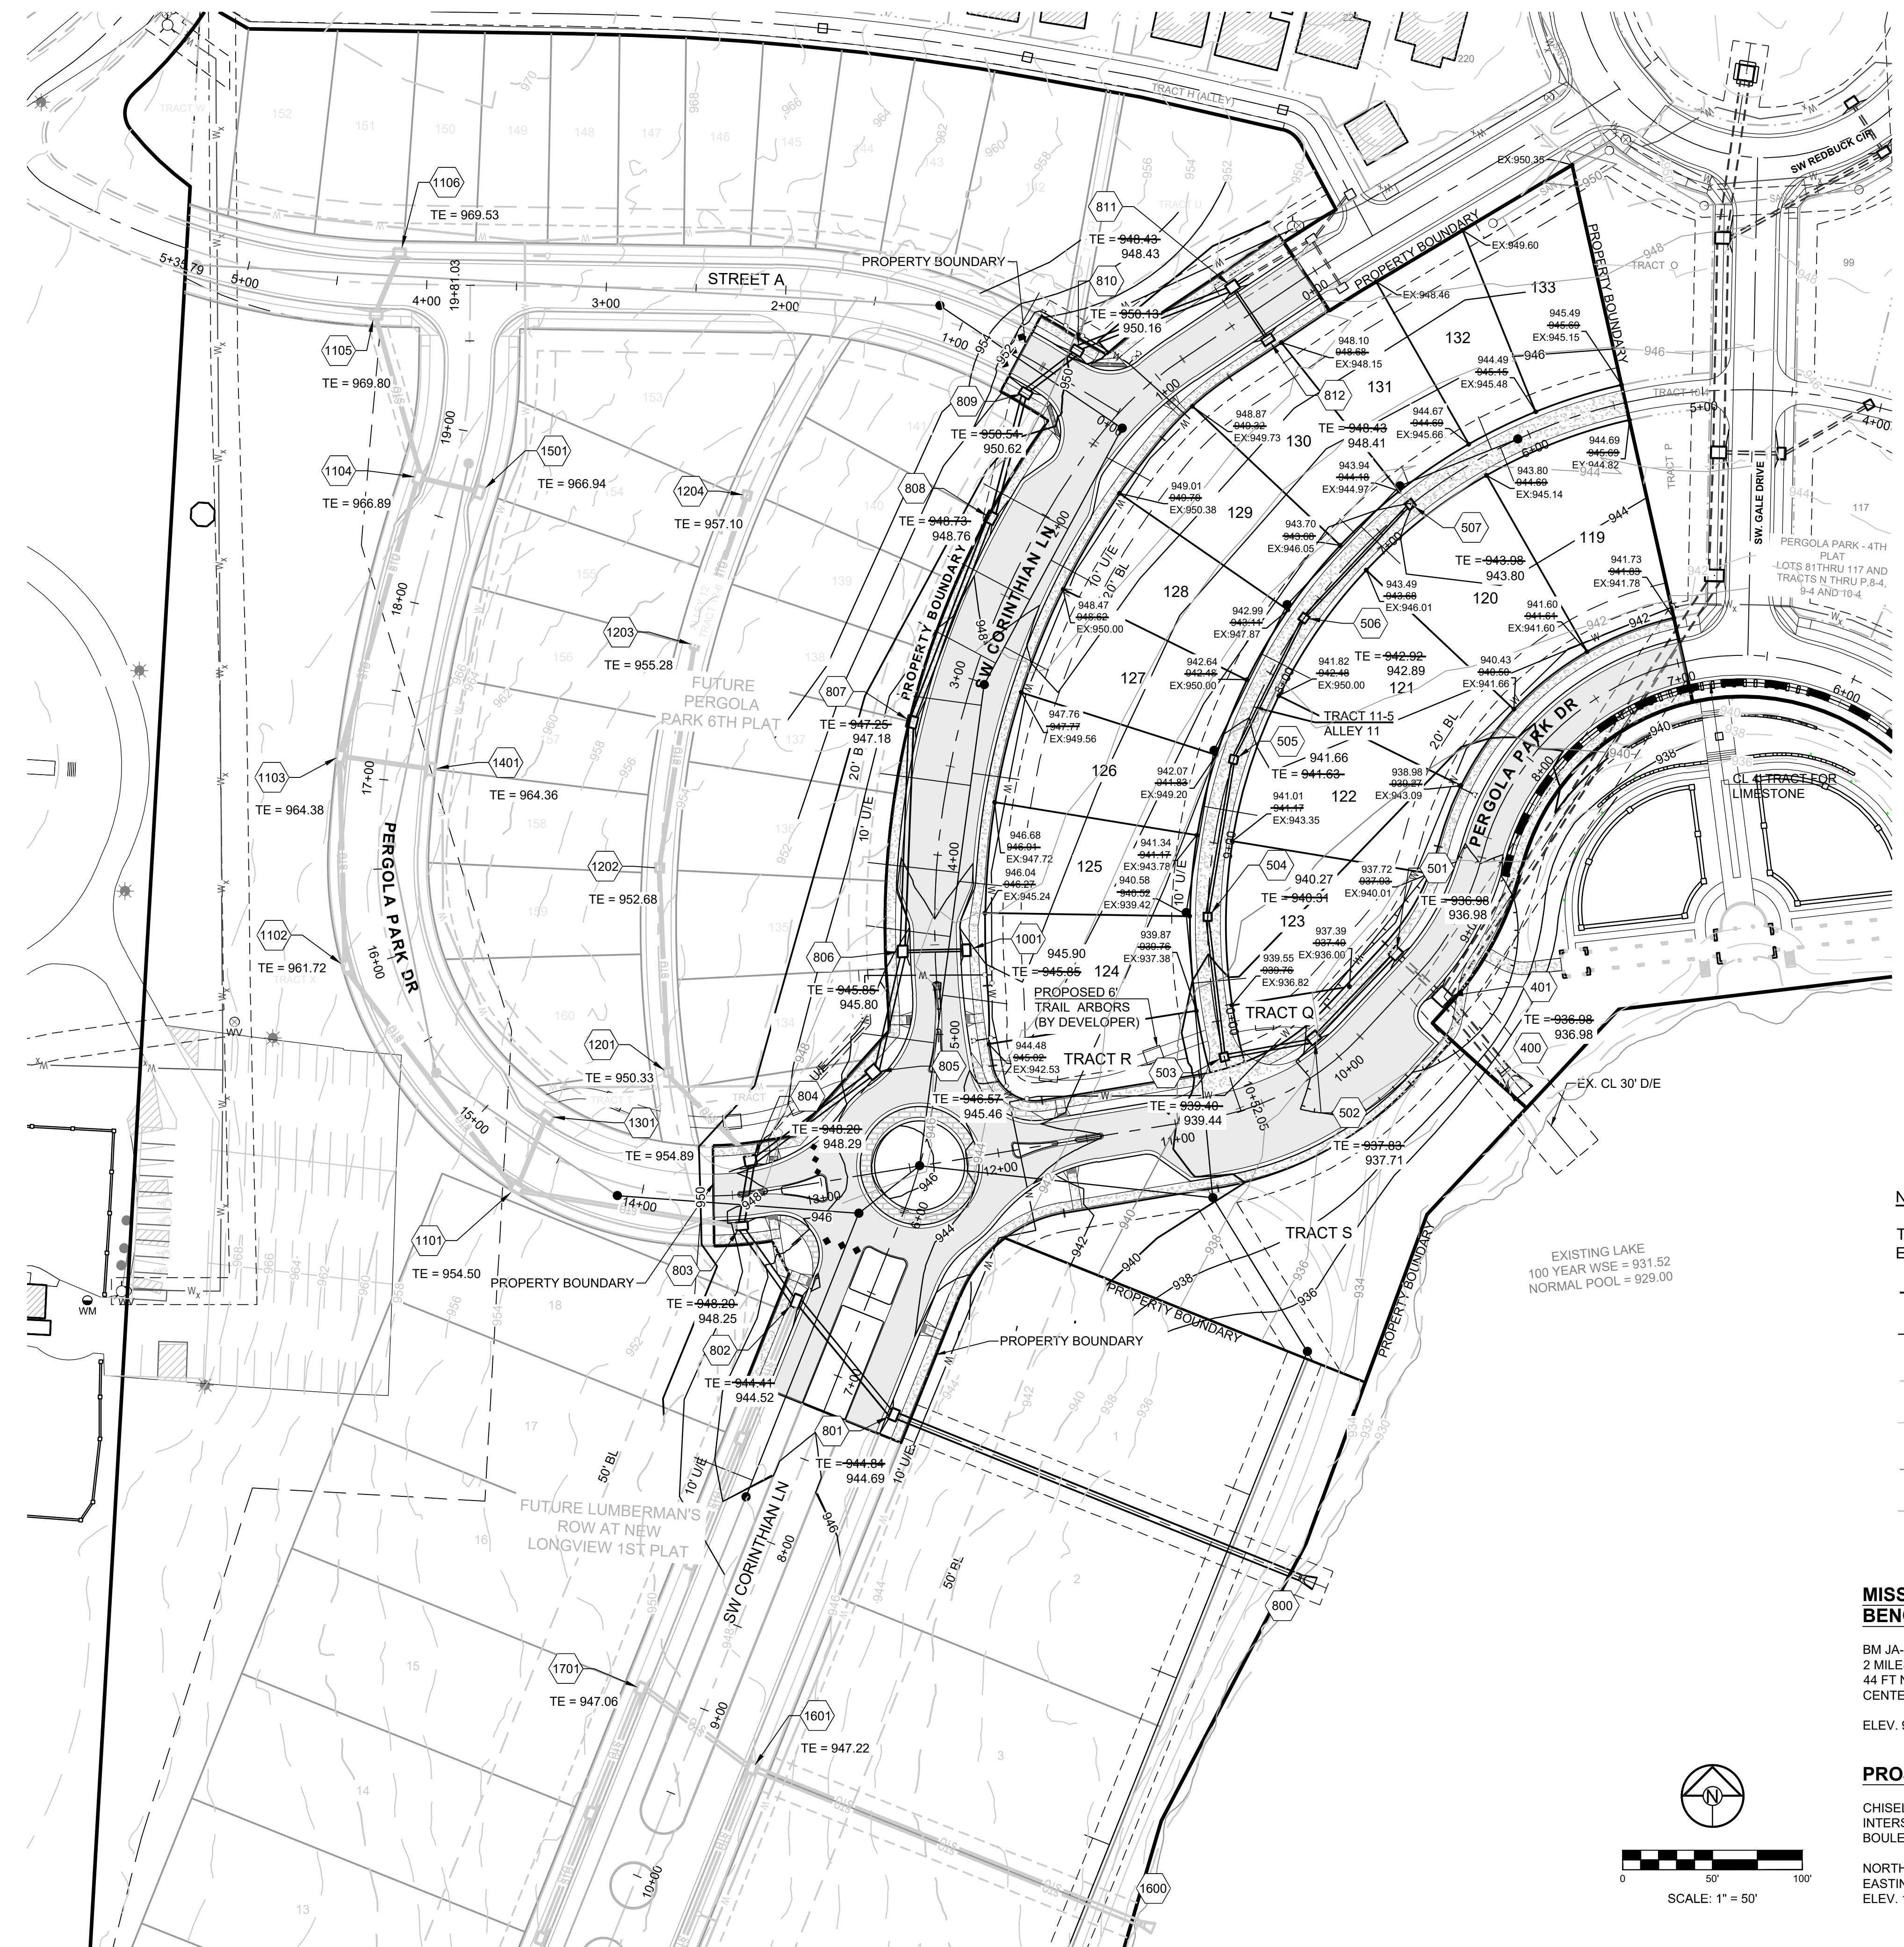

**PERGOLA PARK 5TH PLAT
STREET, STORMWATER, MASTER DRAINAGE
PLAN & EROSION AND SEDIMENT CONTROL
- LEE'S SUMMIT, MISSOURI**

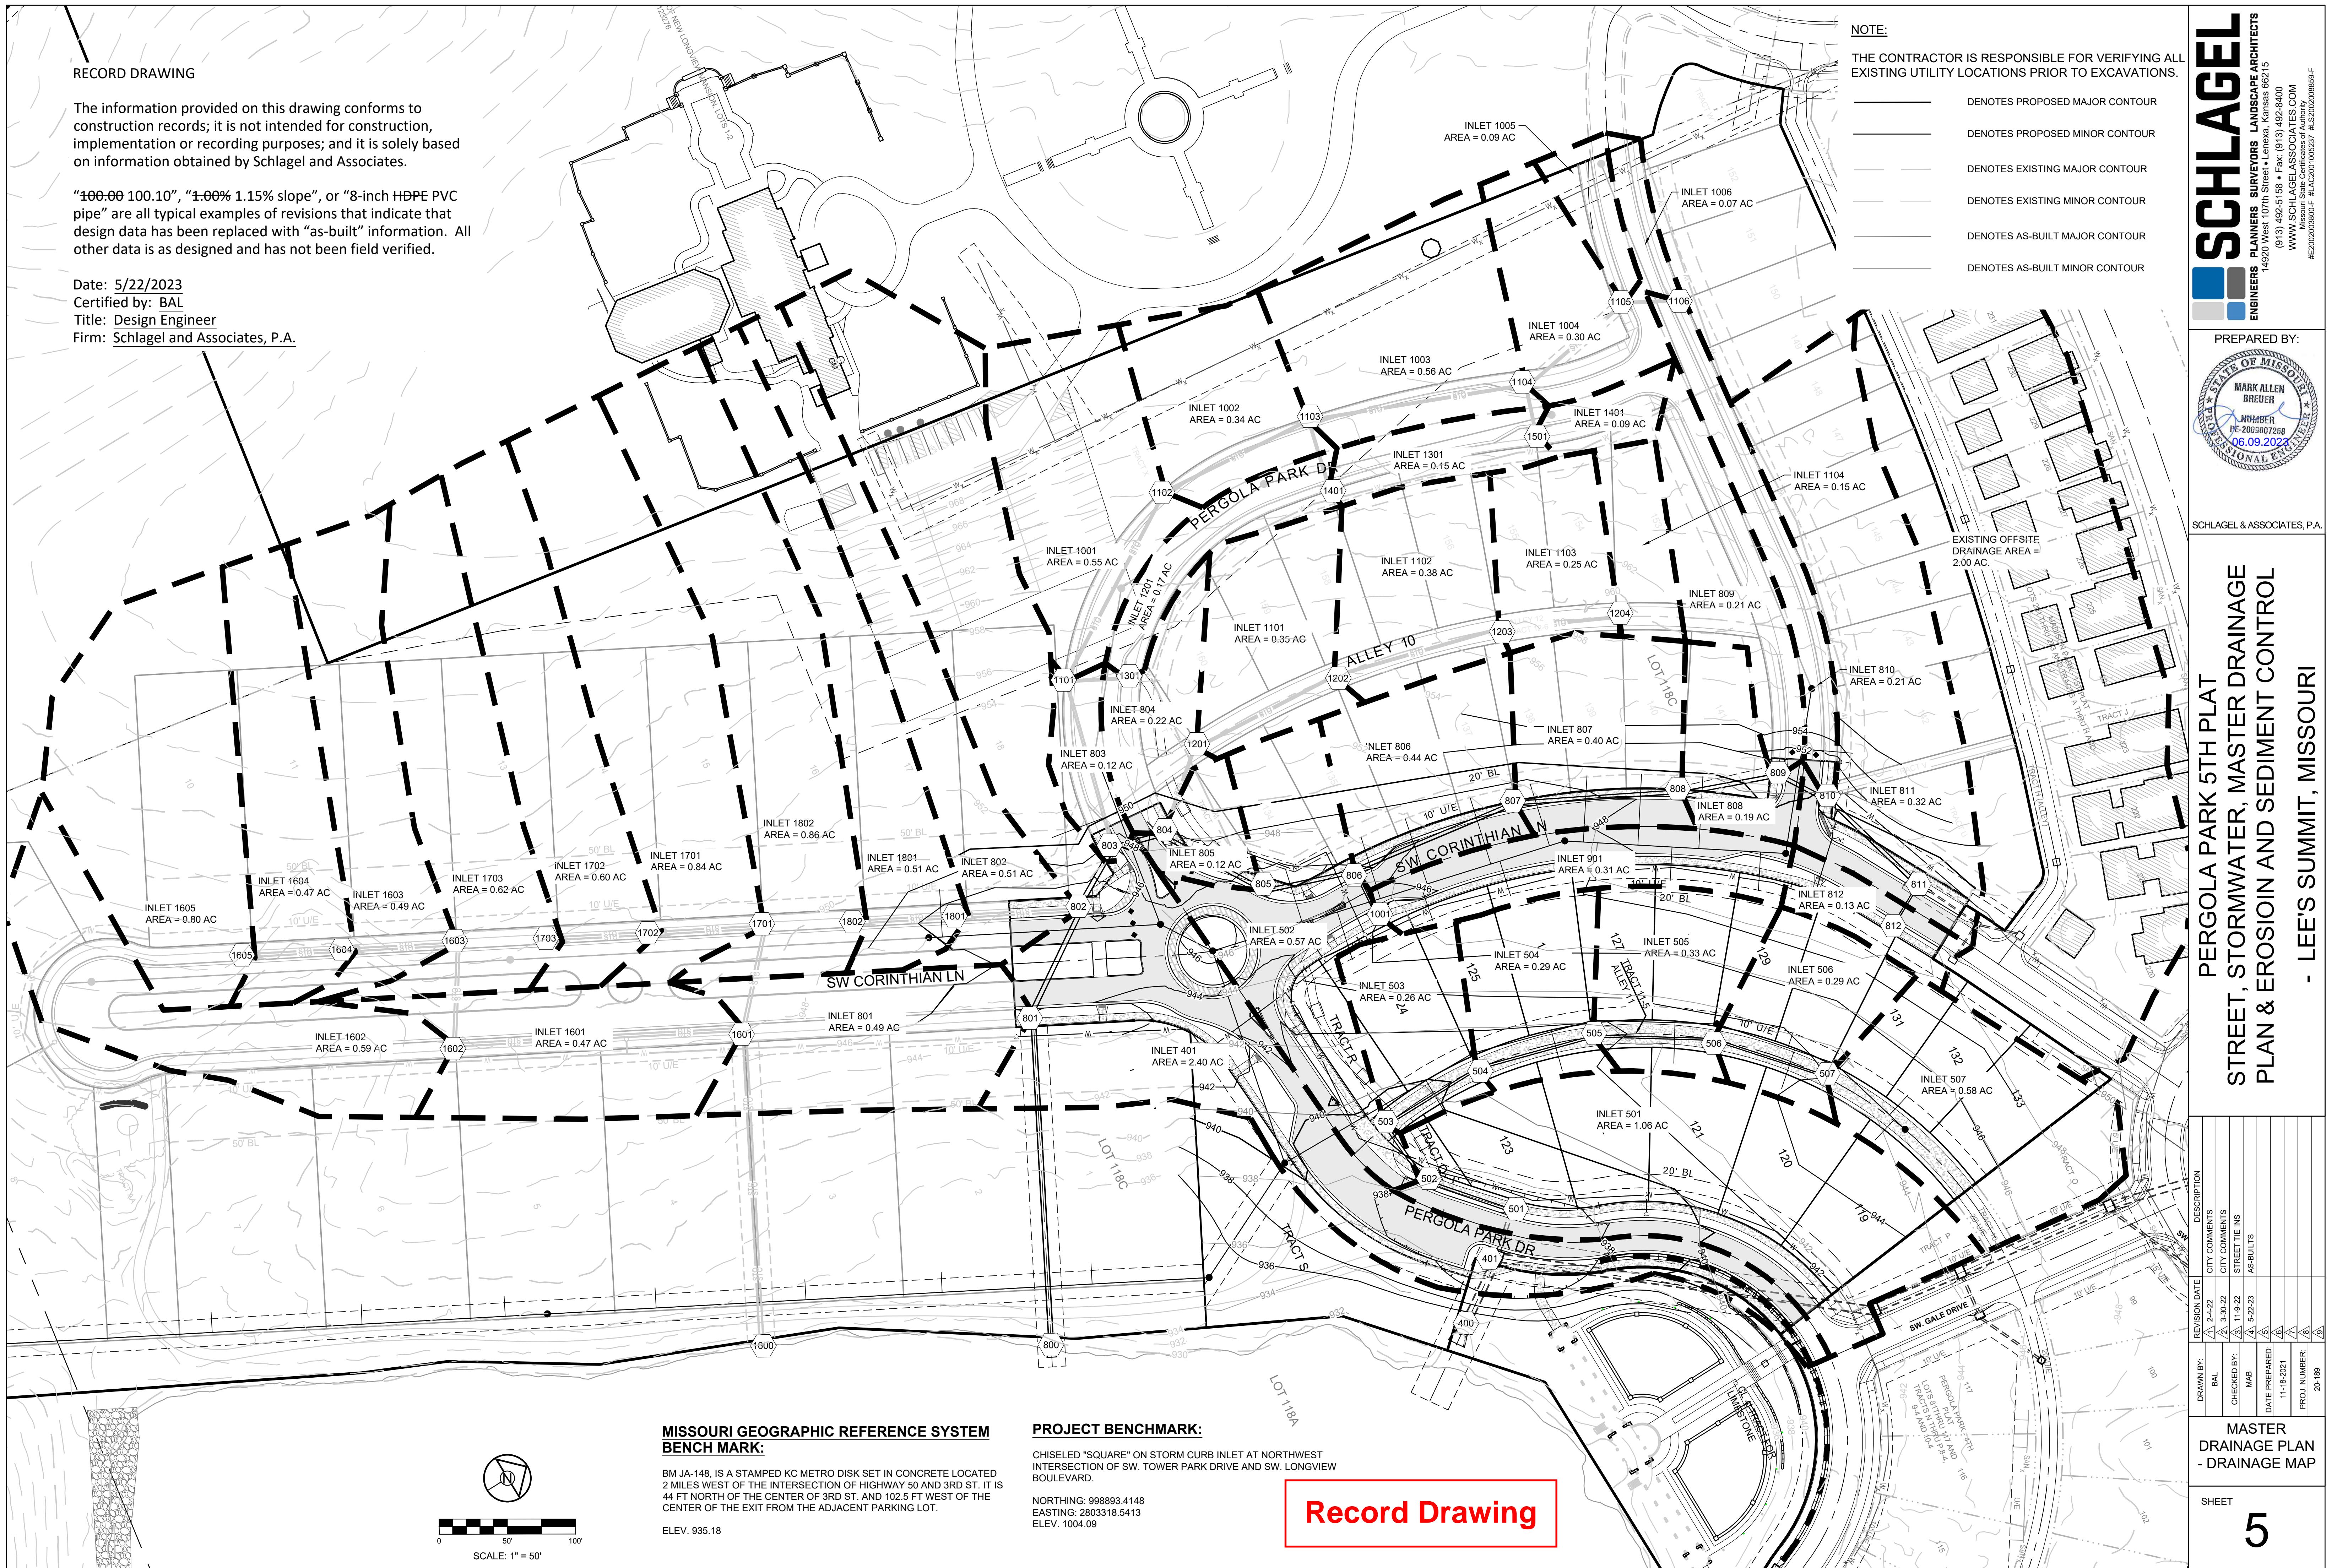


PREPARED BY:

 MARK ALLEN BREUER
 PE-205007268
 06.09.2023

SCHLAGEL & ASSOCIATES, P.A.

**PERGOLA PARK 5TH PLAT
STREET, STORMWATER, MASTER DRAINAGE
PLAN & EROSION AND SEDIMENT CONTROL**

- LEE'S SUMMIT, MISSOURI

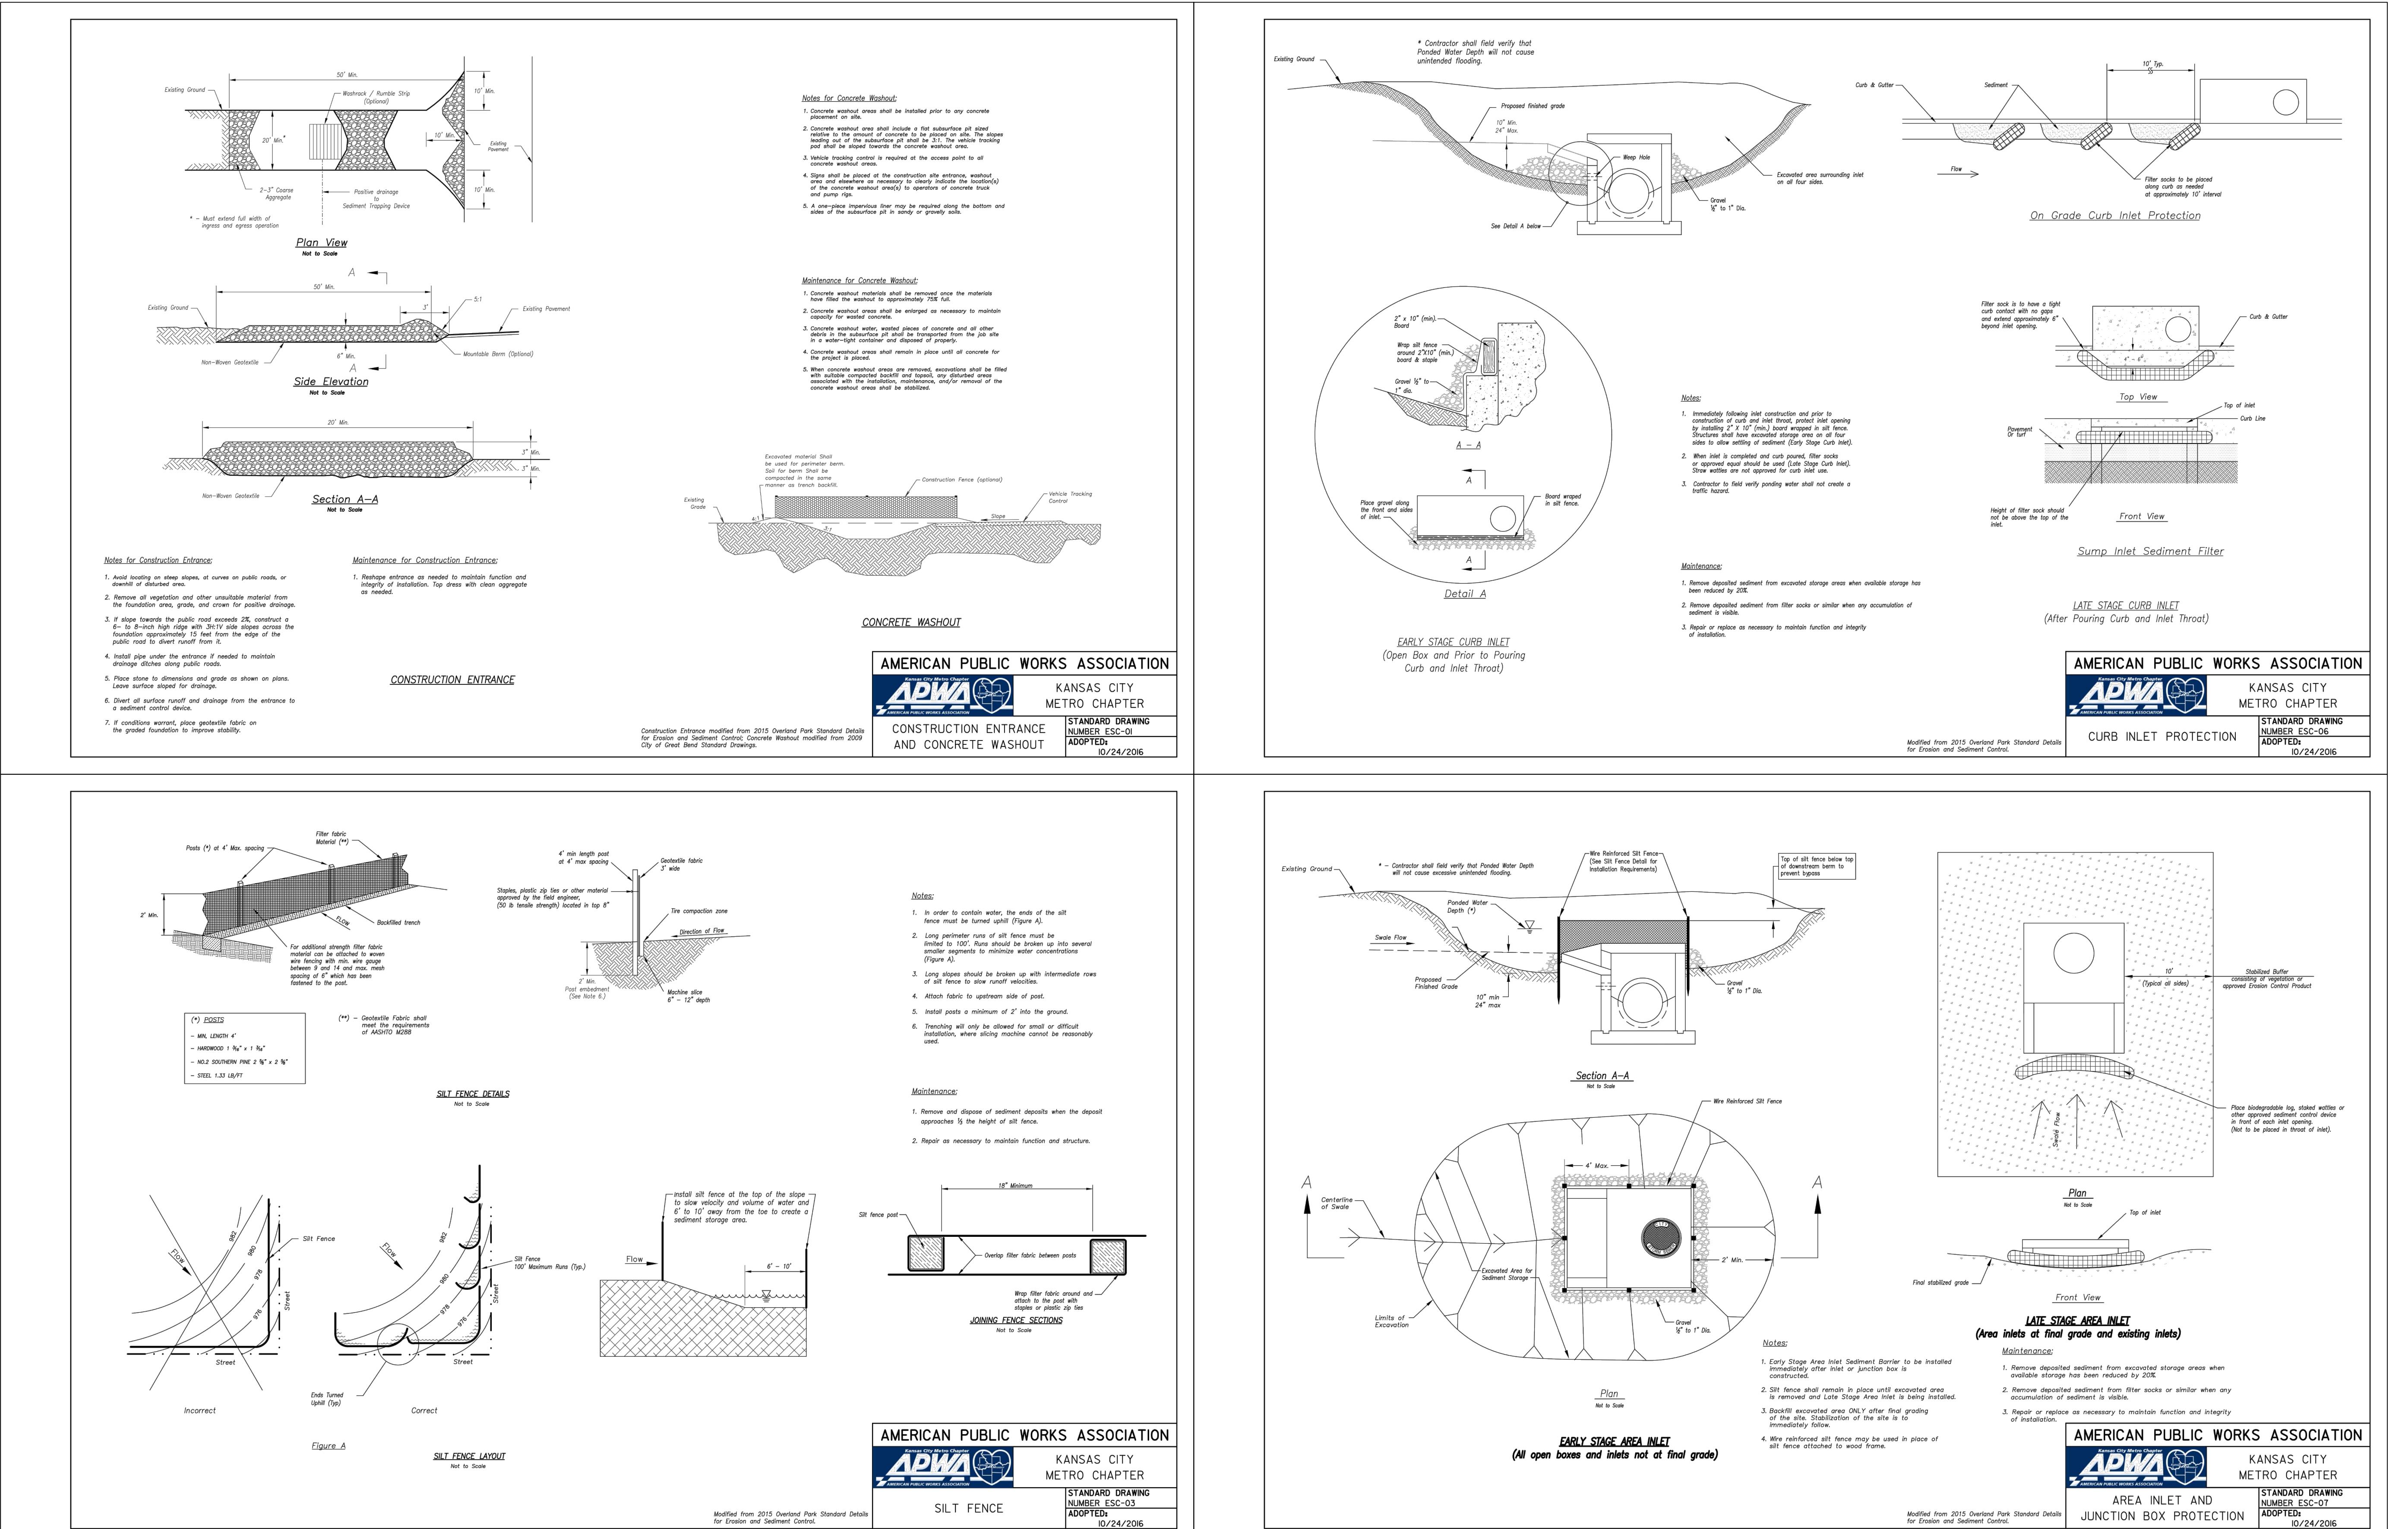


RECORD DRAWING

The information provided on this drawing conforms to construction records; it is not intended for construction, implementation or recording purposes; and it is solely based on information obtained by Schlagel and Associates.

"100.00 100.10", "1.00% 1.15% slope", or "8-inch HDPE PVC pipe" are all typical examples of revisions that indicate that design data has been replaced with "as-built" information. All other data is as designed and has not been field verified.

Date: 5/22/2023
 Certified by: BAL
 Title: Design Engineer
 Firm: Schlagel and Associates, P.A.


Record Drawing

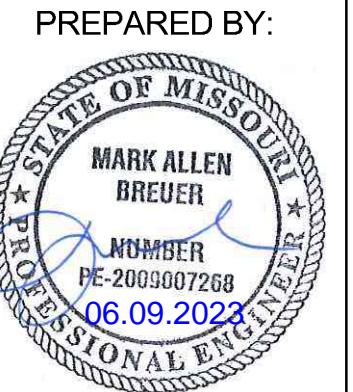


SCHLAGEL & ASSOCIATES, P.A.

**PERGOLA PARK 5TH PLAT
STREET, STORMWATER, MASTER DRAINAGE
PLAN & EROSION AND SEDIMENT CONTROL**

- LEE'S SUMMIT, MISSOURI


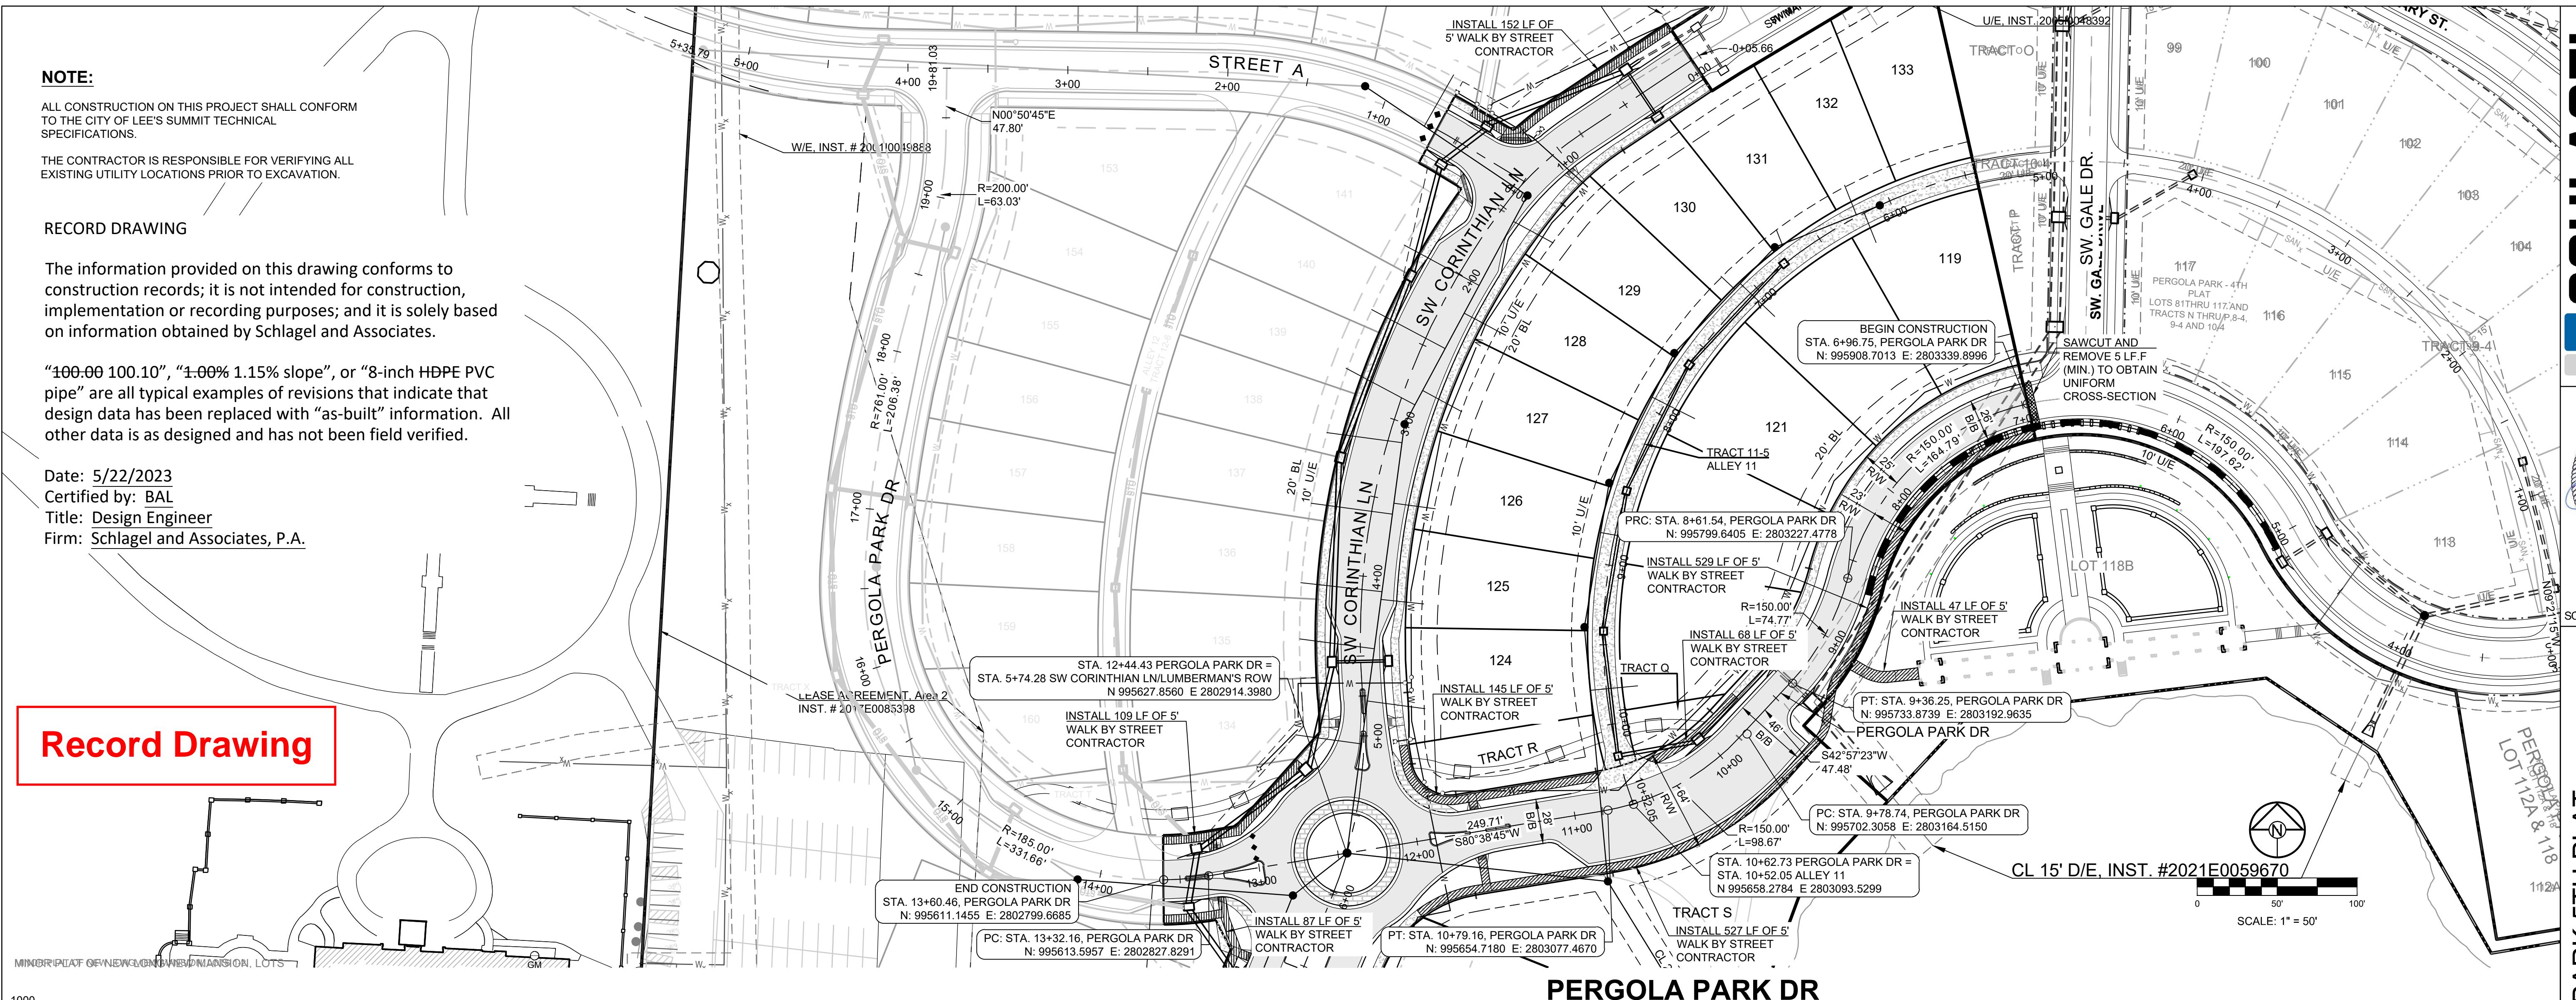


PERGOLA PARK DR

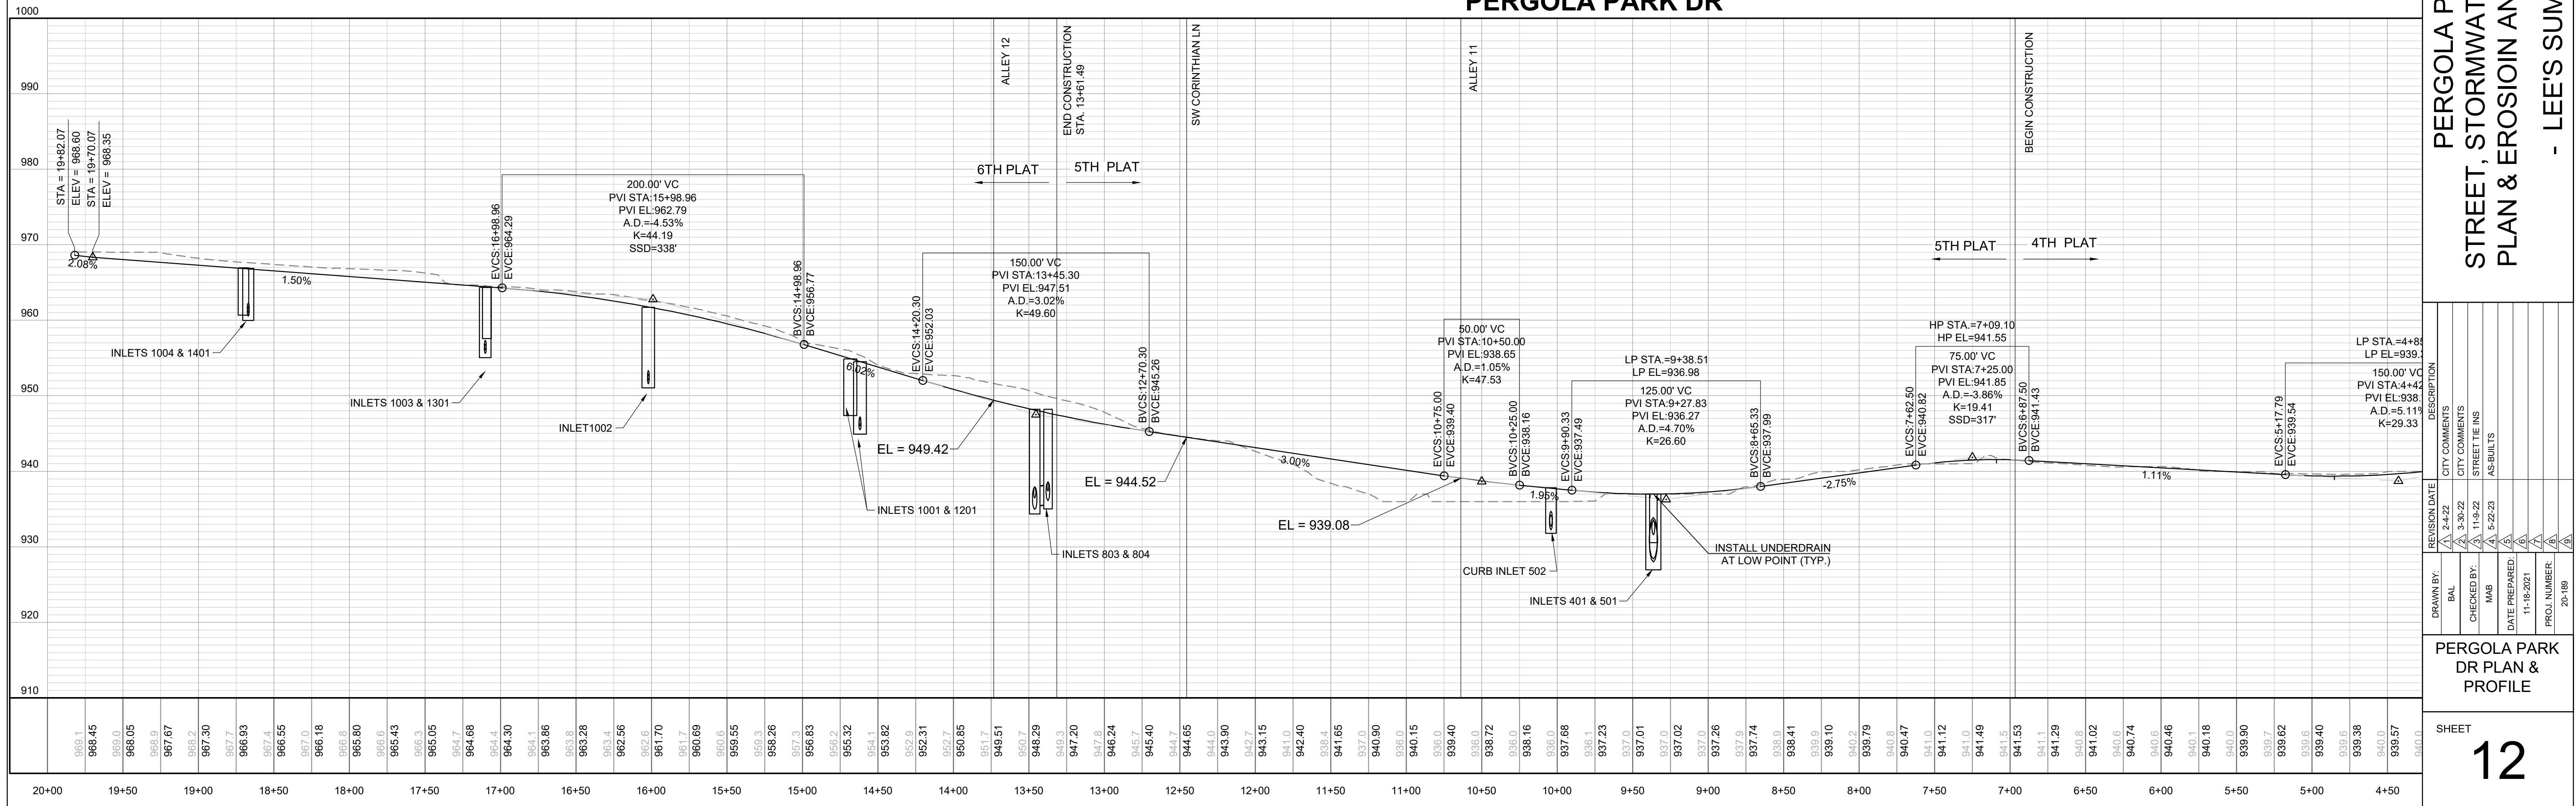


PREPARED BY:
MARK ALLEN BREUER
JANNE BREUER
PE-205007268
06.09.2023

SCHLAGEL & ASSOCIATES, P.A.

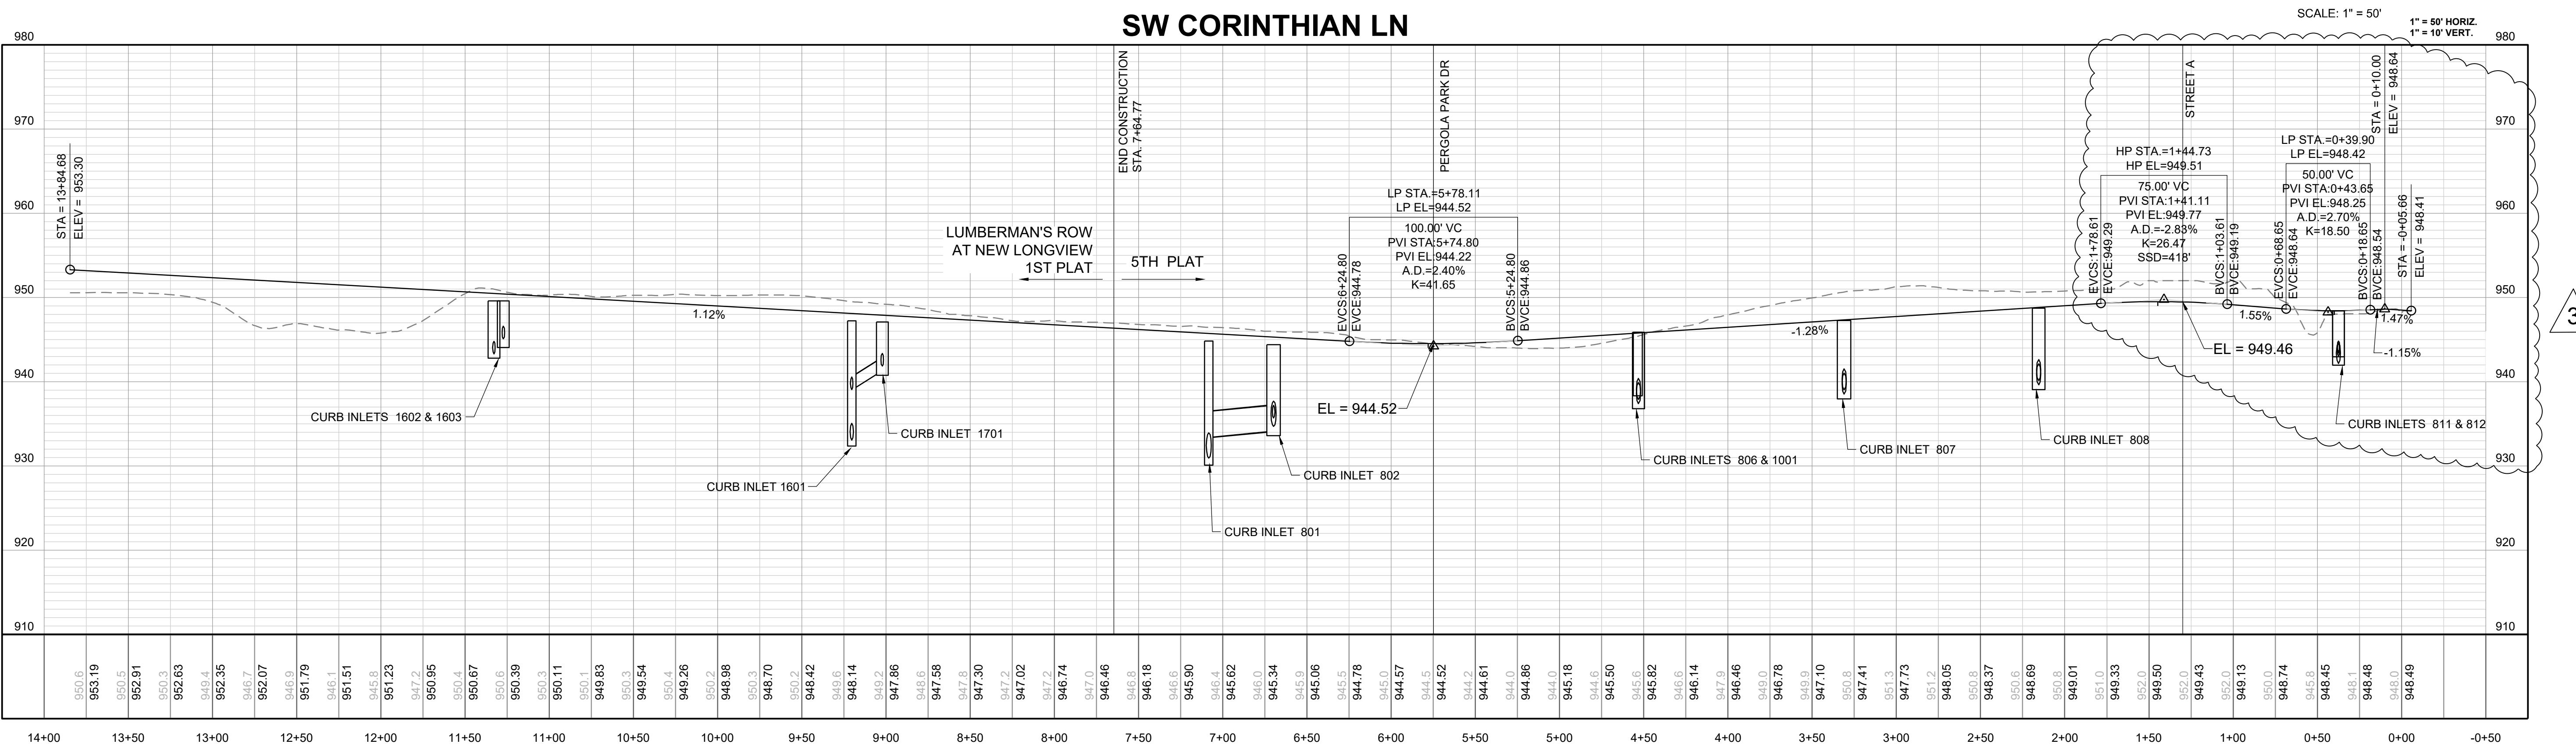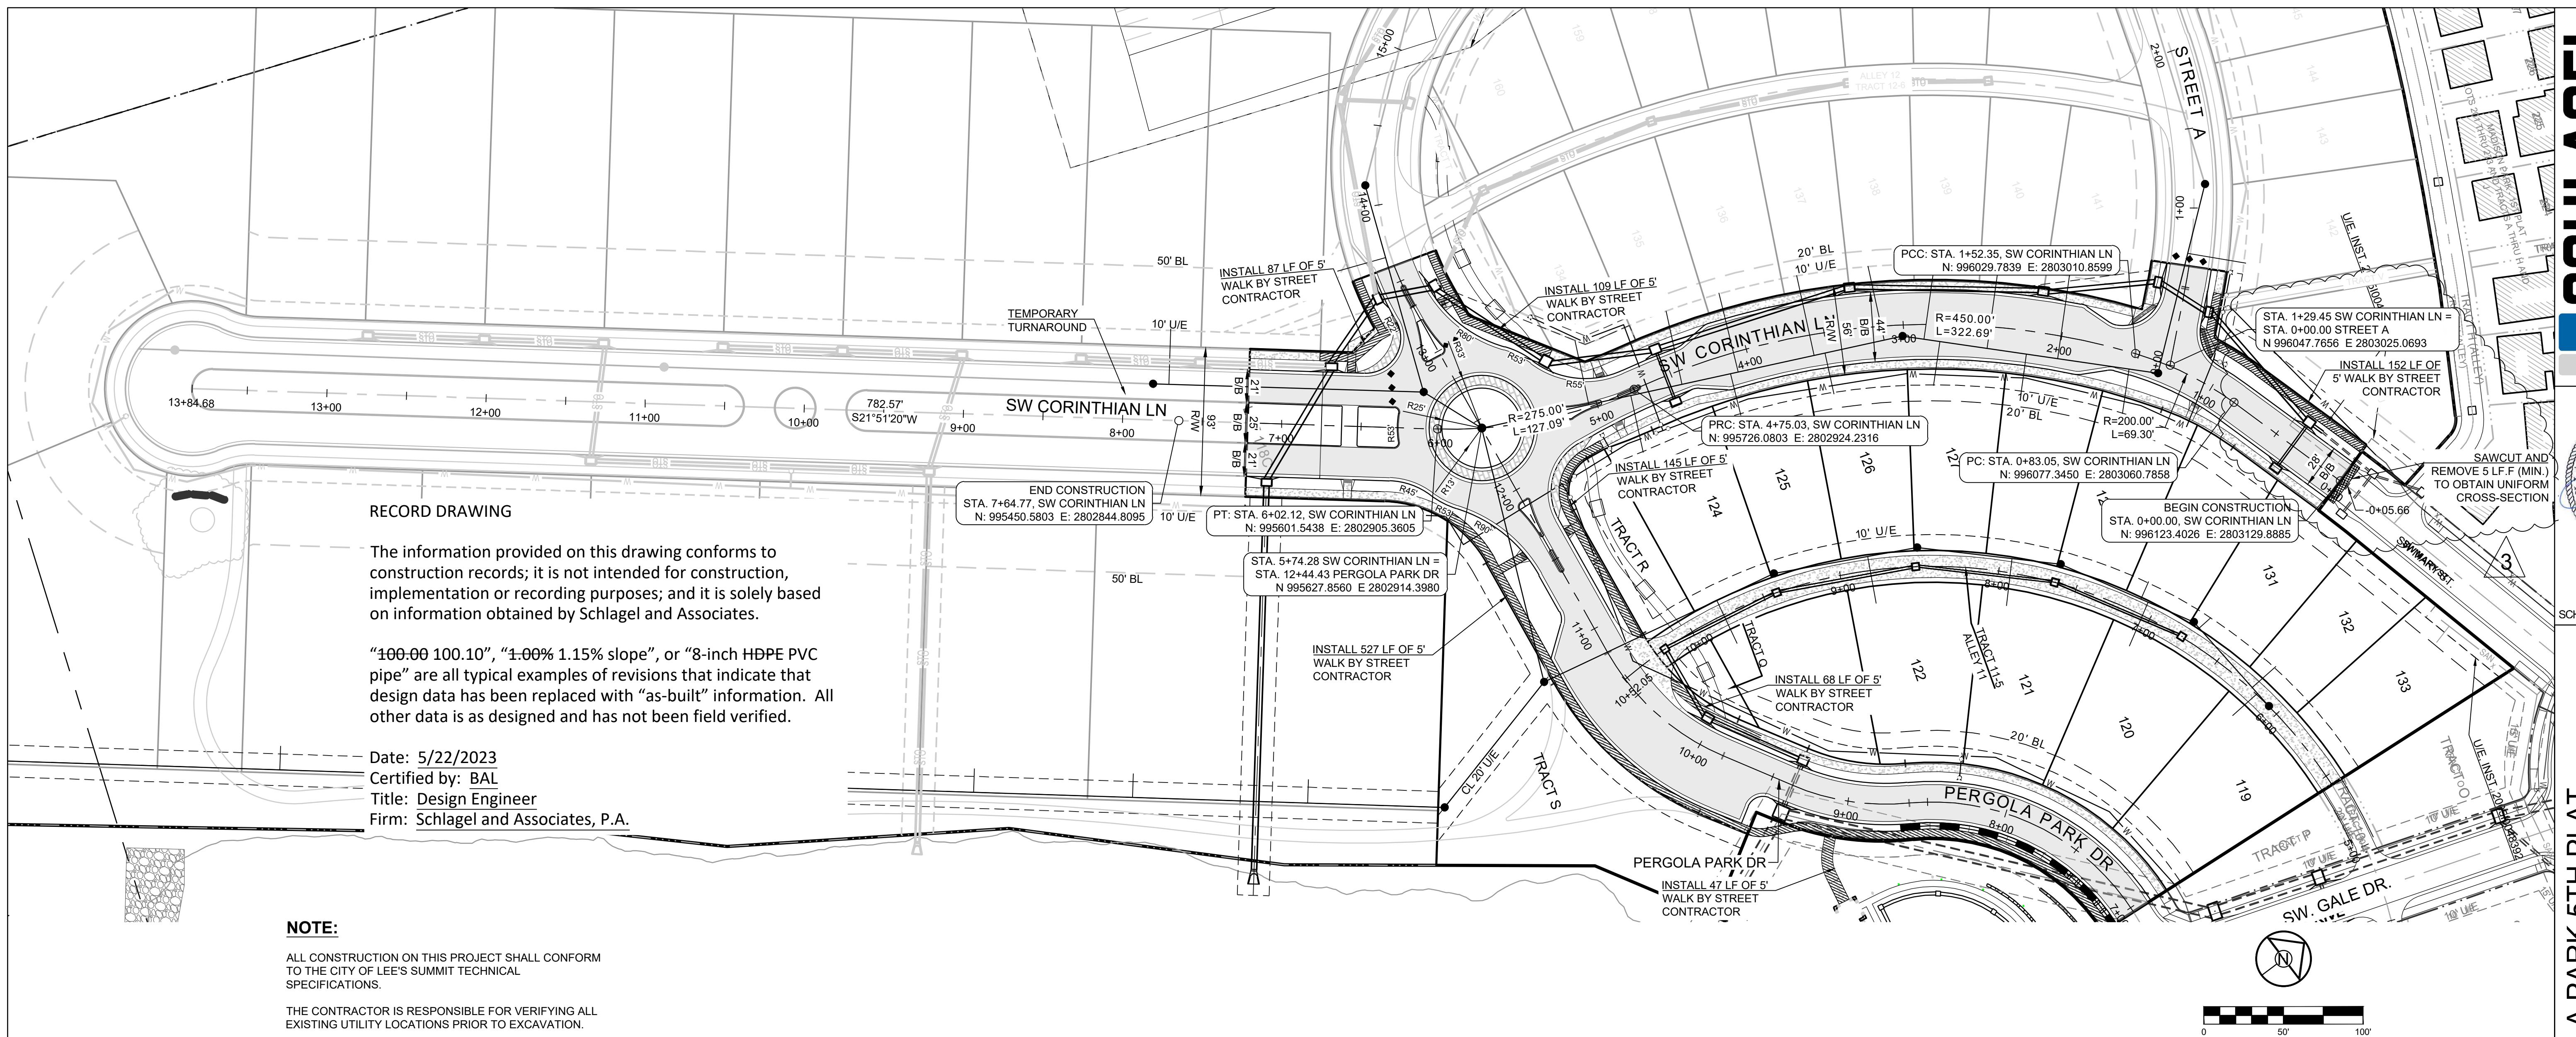

PERGOLA PARK 5TH PLAT
STREET, STORMWATER, MASTER DRAINAGE
PLAN & EROSION AND SEDIMENT CONTROL


- LEE'S SUMMIT, MISSOURI

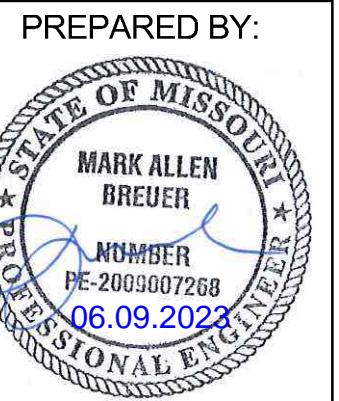


PREPARED BY:
MARK ALLEN BREUER
PE-2035007268
06.09.2023

SCHLAGEL & ASSOCIATES, P.A.

**PERGOLA PARK 5TH PLAT
STREET, STORMWATER, MASTER DRAINAGE
PLAN & EROSION AND SEDIMENT CONTROL**
- LEE'S SUMMIT, MISSOURI

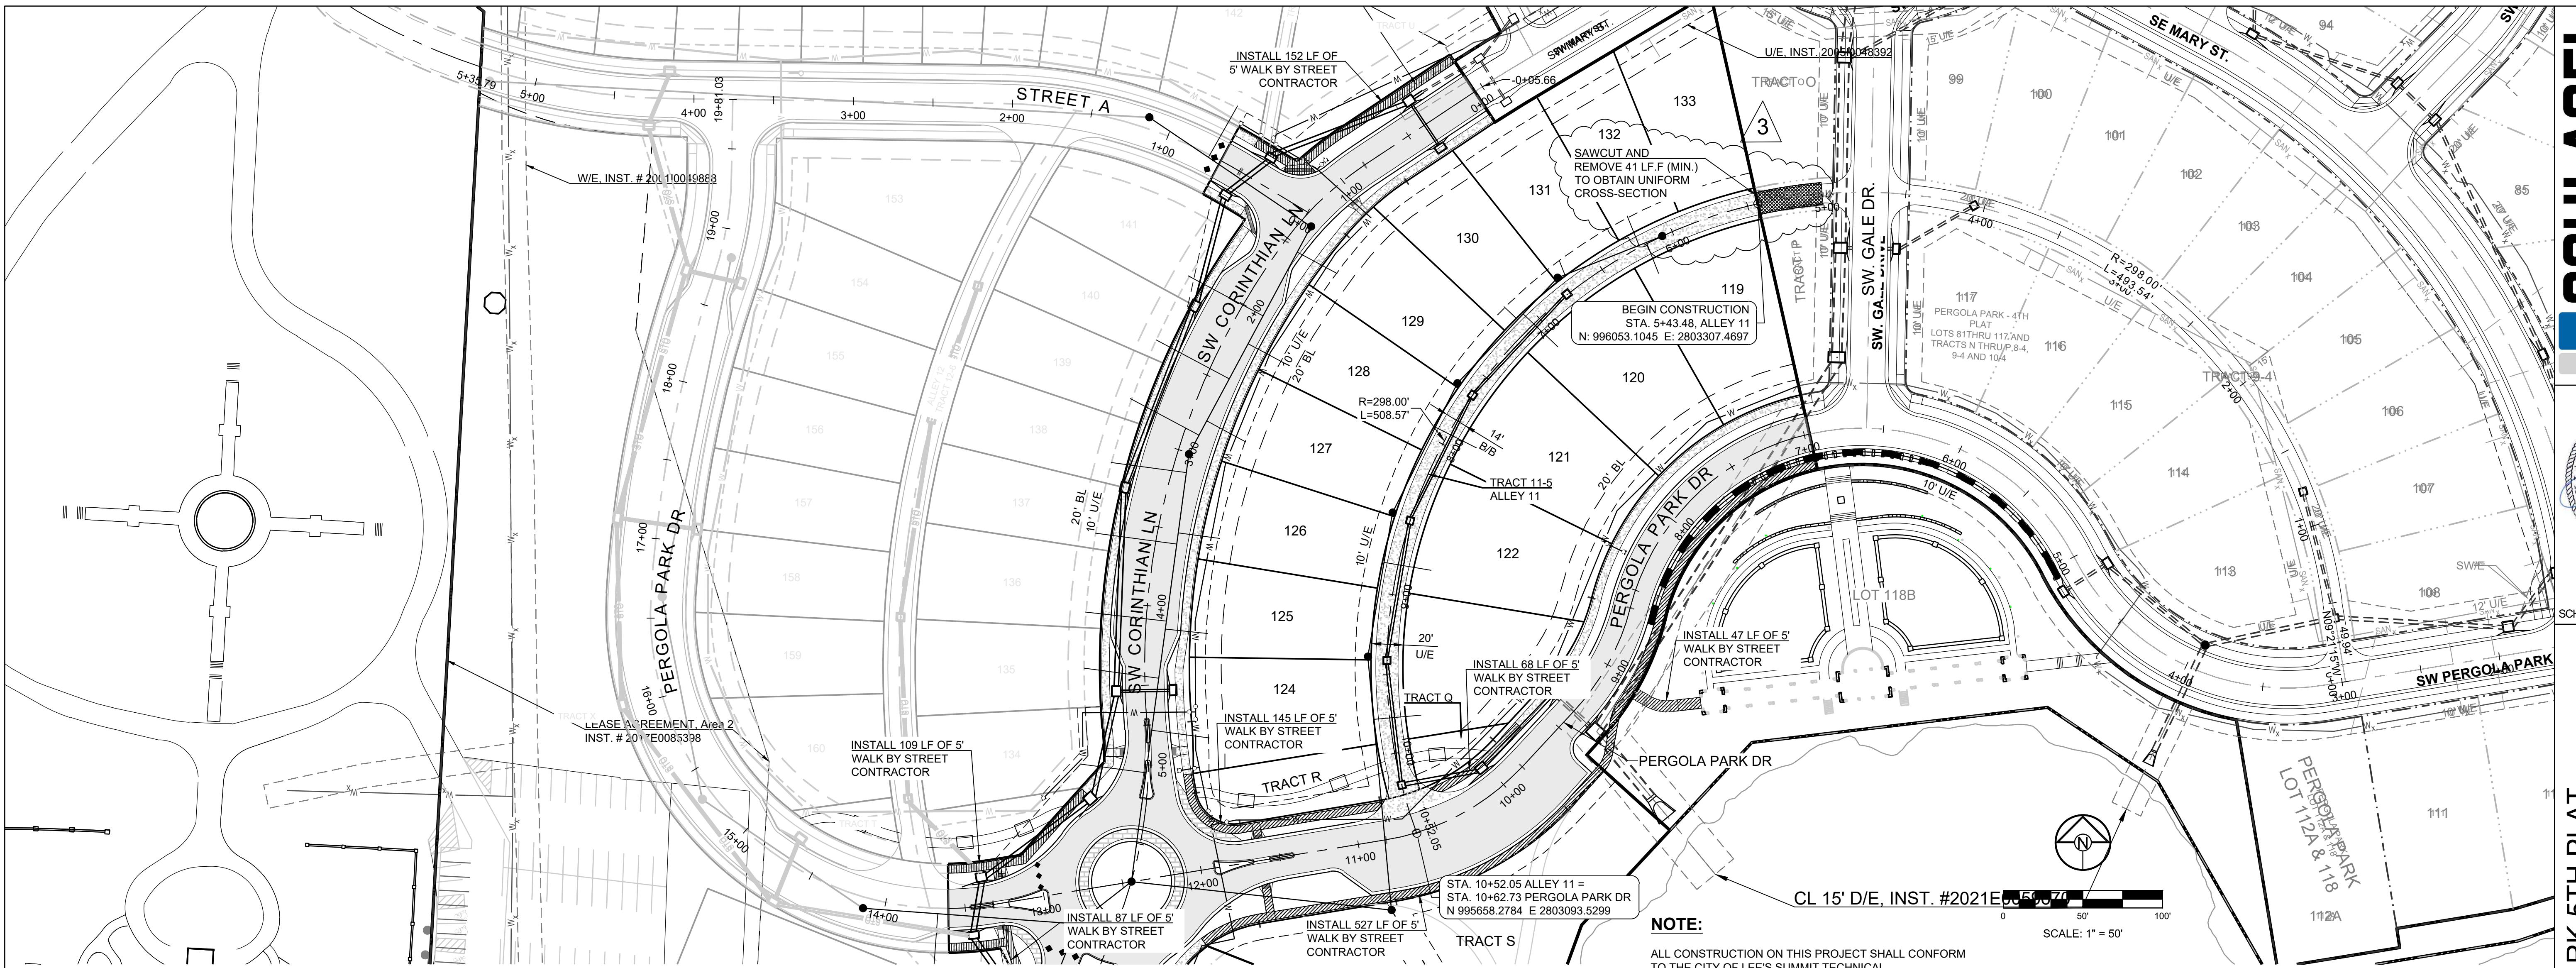

ALLEY 11

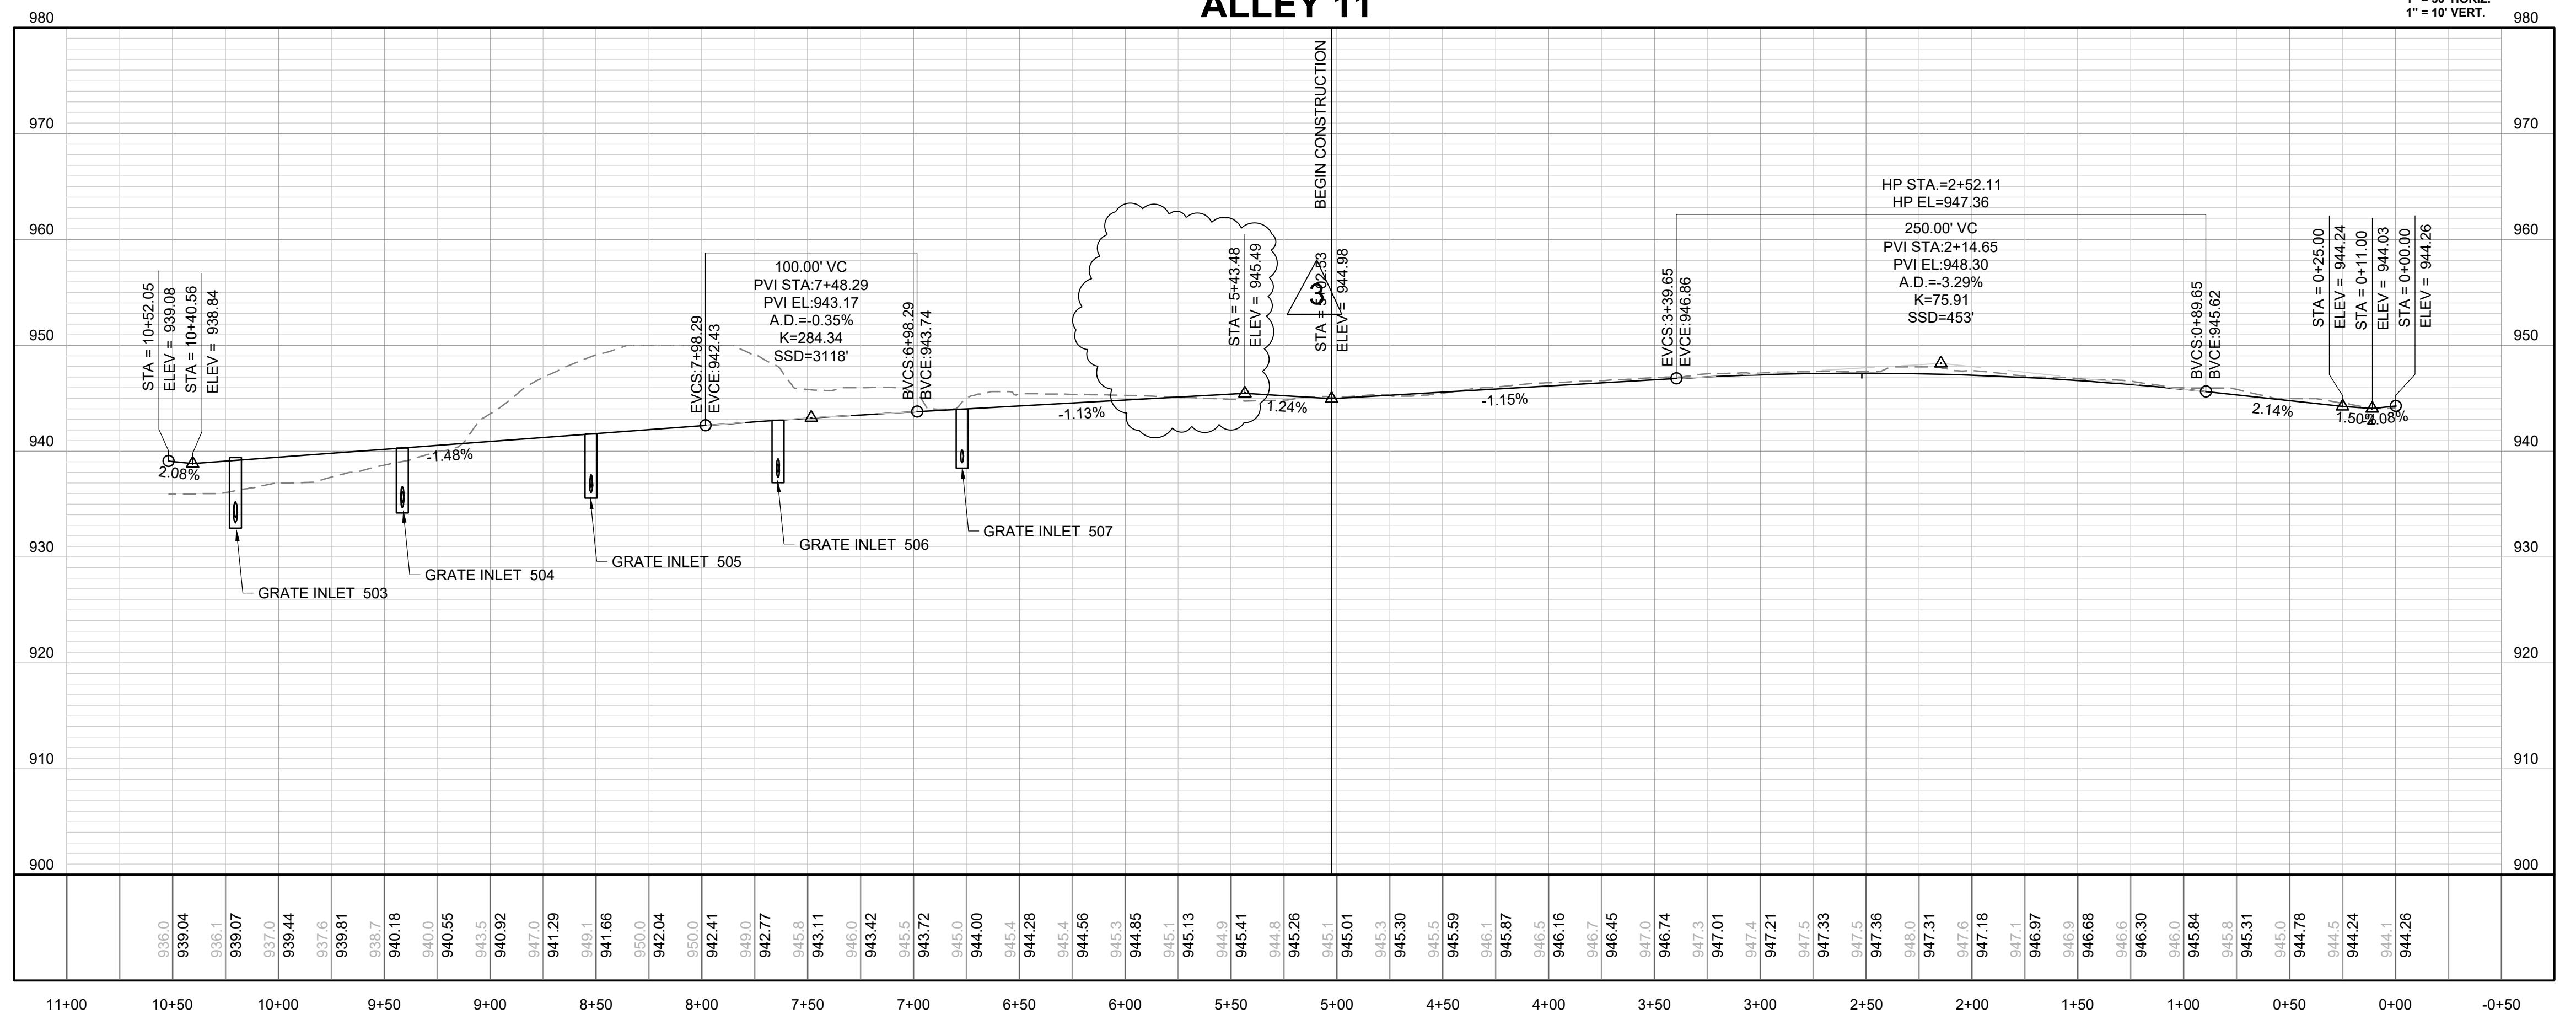


RECORD DRAWING

The information provided on this drawing conforms to construction records; it is not intended for construction, implementation or recording purposes; and it is solely based on information obtained by Schlagel and Associates.

"100.00 100.10", "1.00% 1.15% slope", or "8-inch HDPE PVC pipe" are all typical examples of revisions that indicate that design data has been replaced with "as-built" information. All other data is as designed and has not been field verified.

Date: 5/22/2023
Certified by: BAL
Title: Design Engineer
Firm: Schlagel and Associates, P.A.

Record Drawing

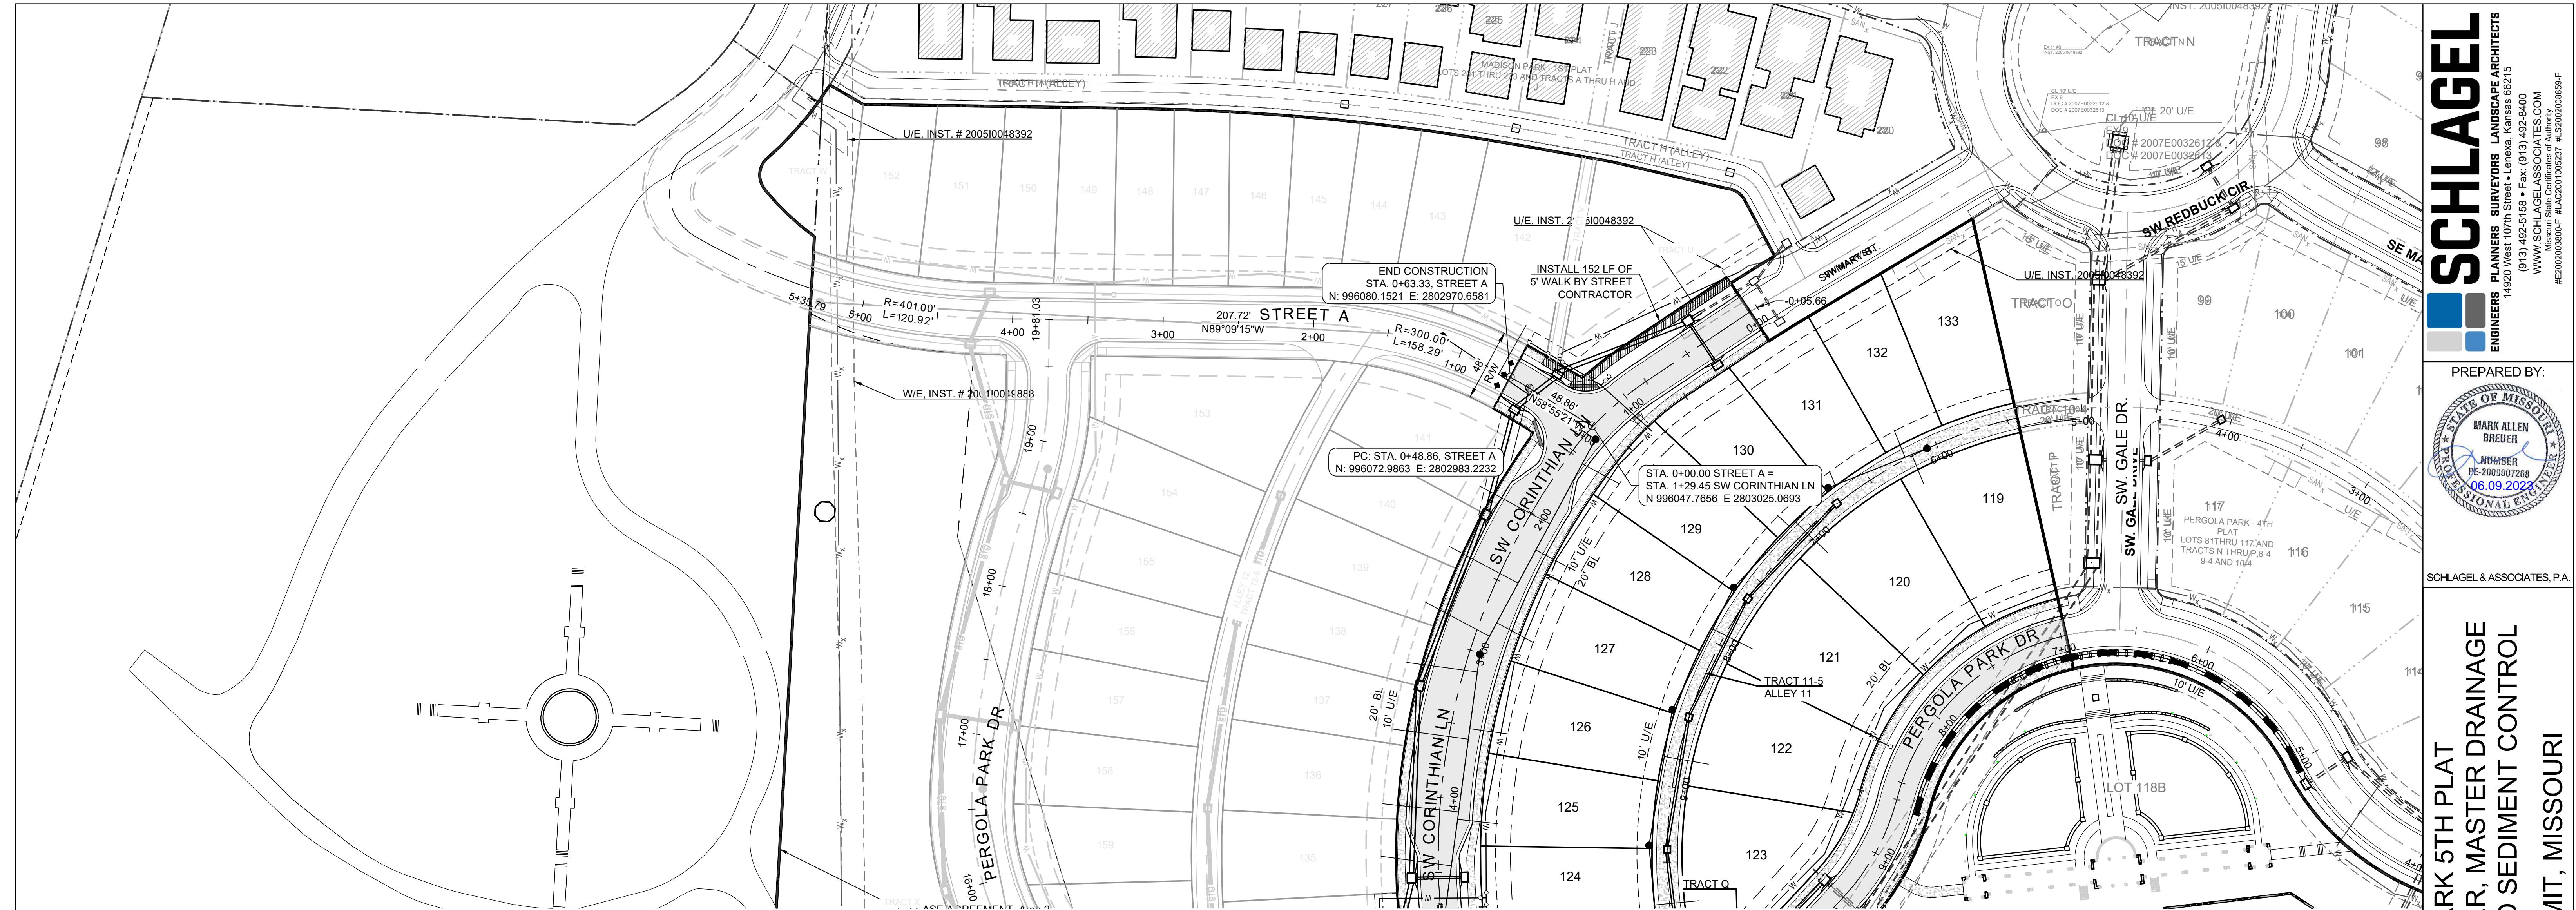


RECORD DRAWING

The information provided on this drawing conforms to construction records; it is not intended for construction, implementation or recording purposes; and it is solely based on information obtained by Schlagel and Associates.

"100:00 100.10", "1:00% 1.15% slope", or "8-inch HDPE PVC pipe" are all typical examples of revisions that indicate that design data has been replaced with "as-built" information. All other data is as designed and has not been field verified.

Date: 5/22/2023
Certified by: BAL
Title: Design Engineer
Firm: Schlagel and Associates, P.A.

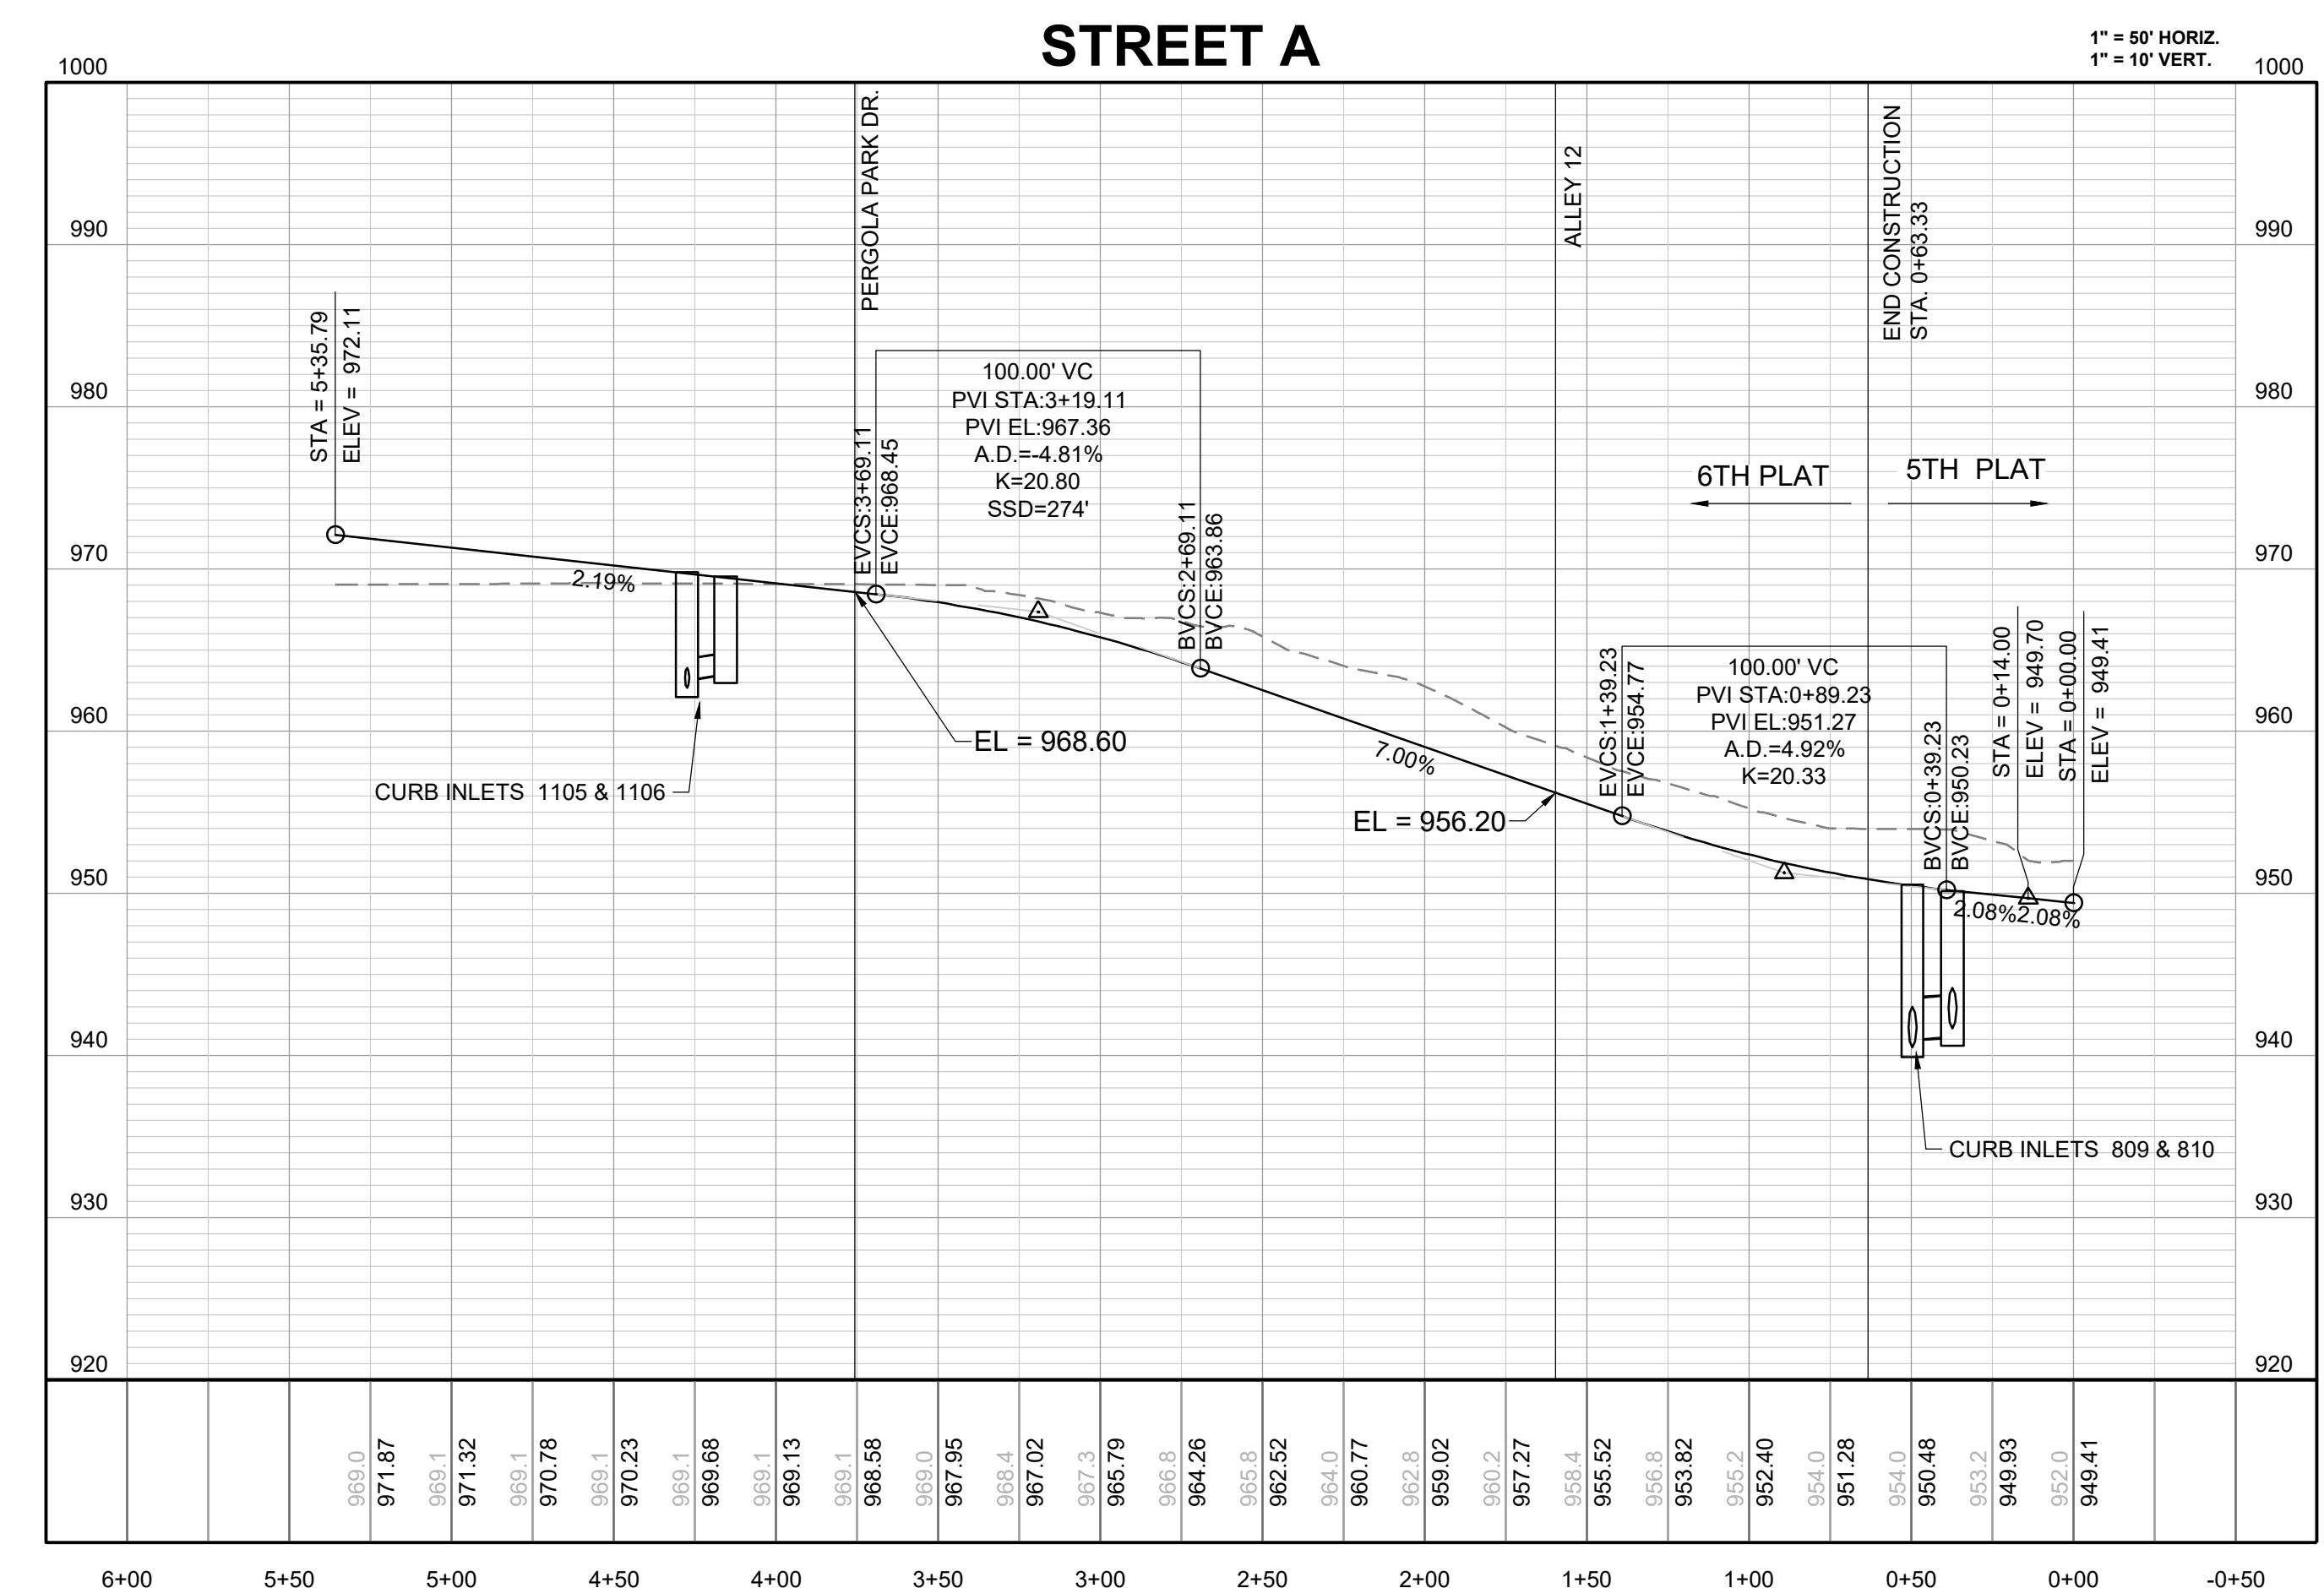

Record Drawing


PERGOLA PARK 5TH PLAT STREET, STORMWATER, MASTER DRAINAGE PLAN & EROSION AND SEDIMENT CONTROL - LEE'S SUMMIT, MISSOURI

SCHLAGEL
ENGINEERS PLANNERS SURVEYORS LANDSCAPE ARCHITECTS
1490 West 107th Street • Lenexa Kansas 66215
(913) 492-5158 • Fax (913) 492-2400
www.schlagelassociates.com
Master Certified Civil Engineers of Missouri
#E202003800 F #LAC201000237 #S202009859-F

PREPARED BY:
MARK ALLEN BREWER
JANNE BREWER
PE-2005007268
06.09.2023

SCHLAGEL & ASSOCIATES, P.A.


STREET A PLAN & PROFILE
SHEET 15
DRAWN BY: BAL
REVISION DATE: 2-4-22
CITY COMMENTS: □ 3-30-22
CHECKED BY: □ 1-19-22
STREET TIE INS: □
MAB: □ 5-22-23
AS-BUILTS: □
DATE PREPARED: 11-1-2021
PROJ. NUMBER: 20-189
VER.: 9

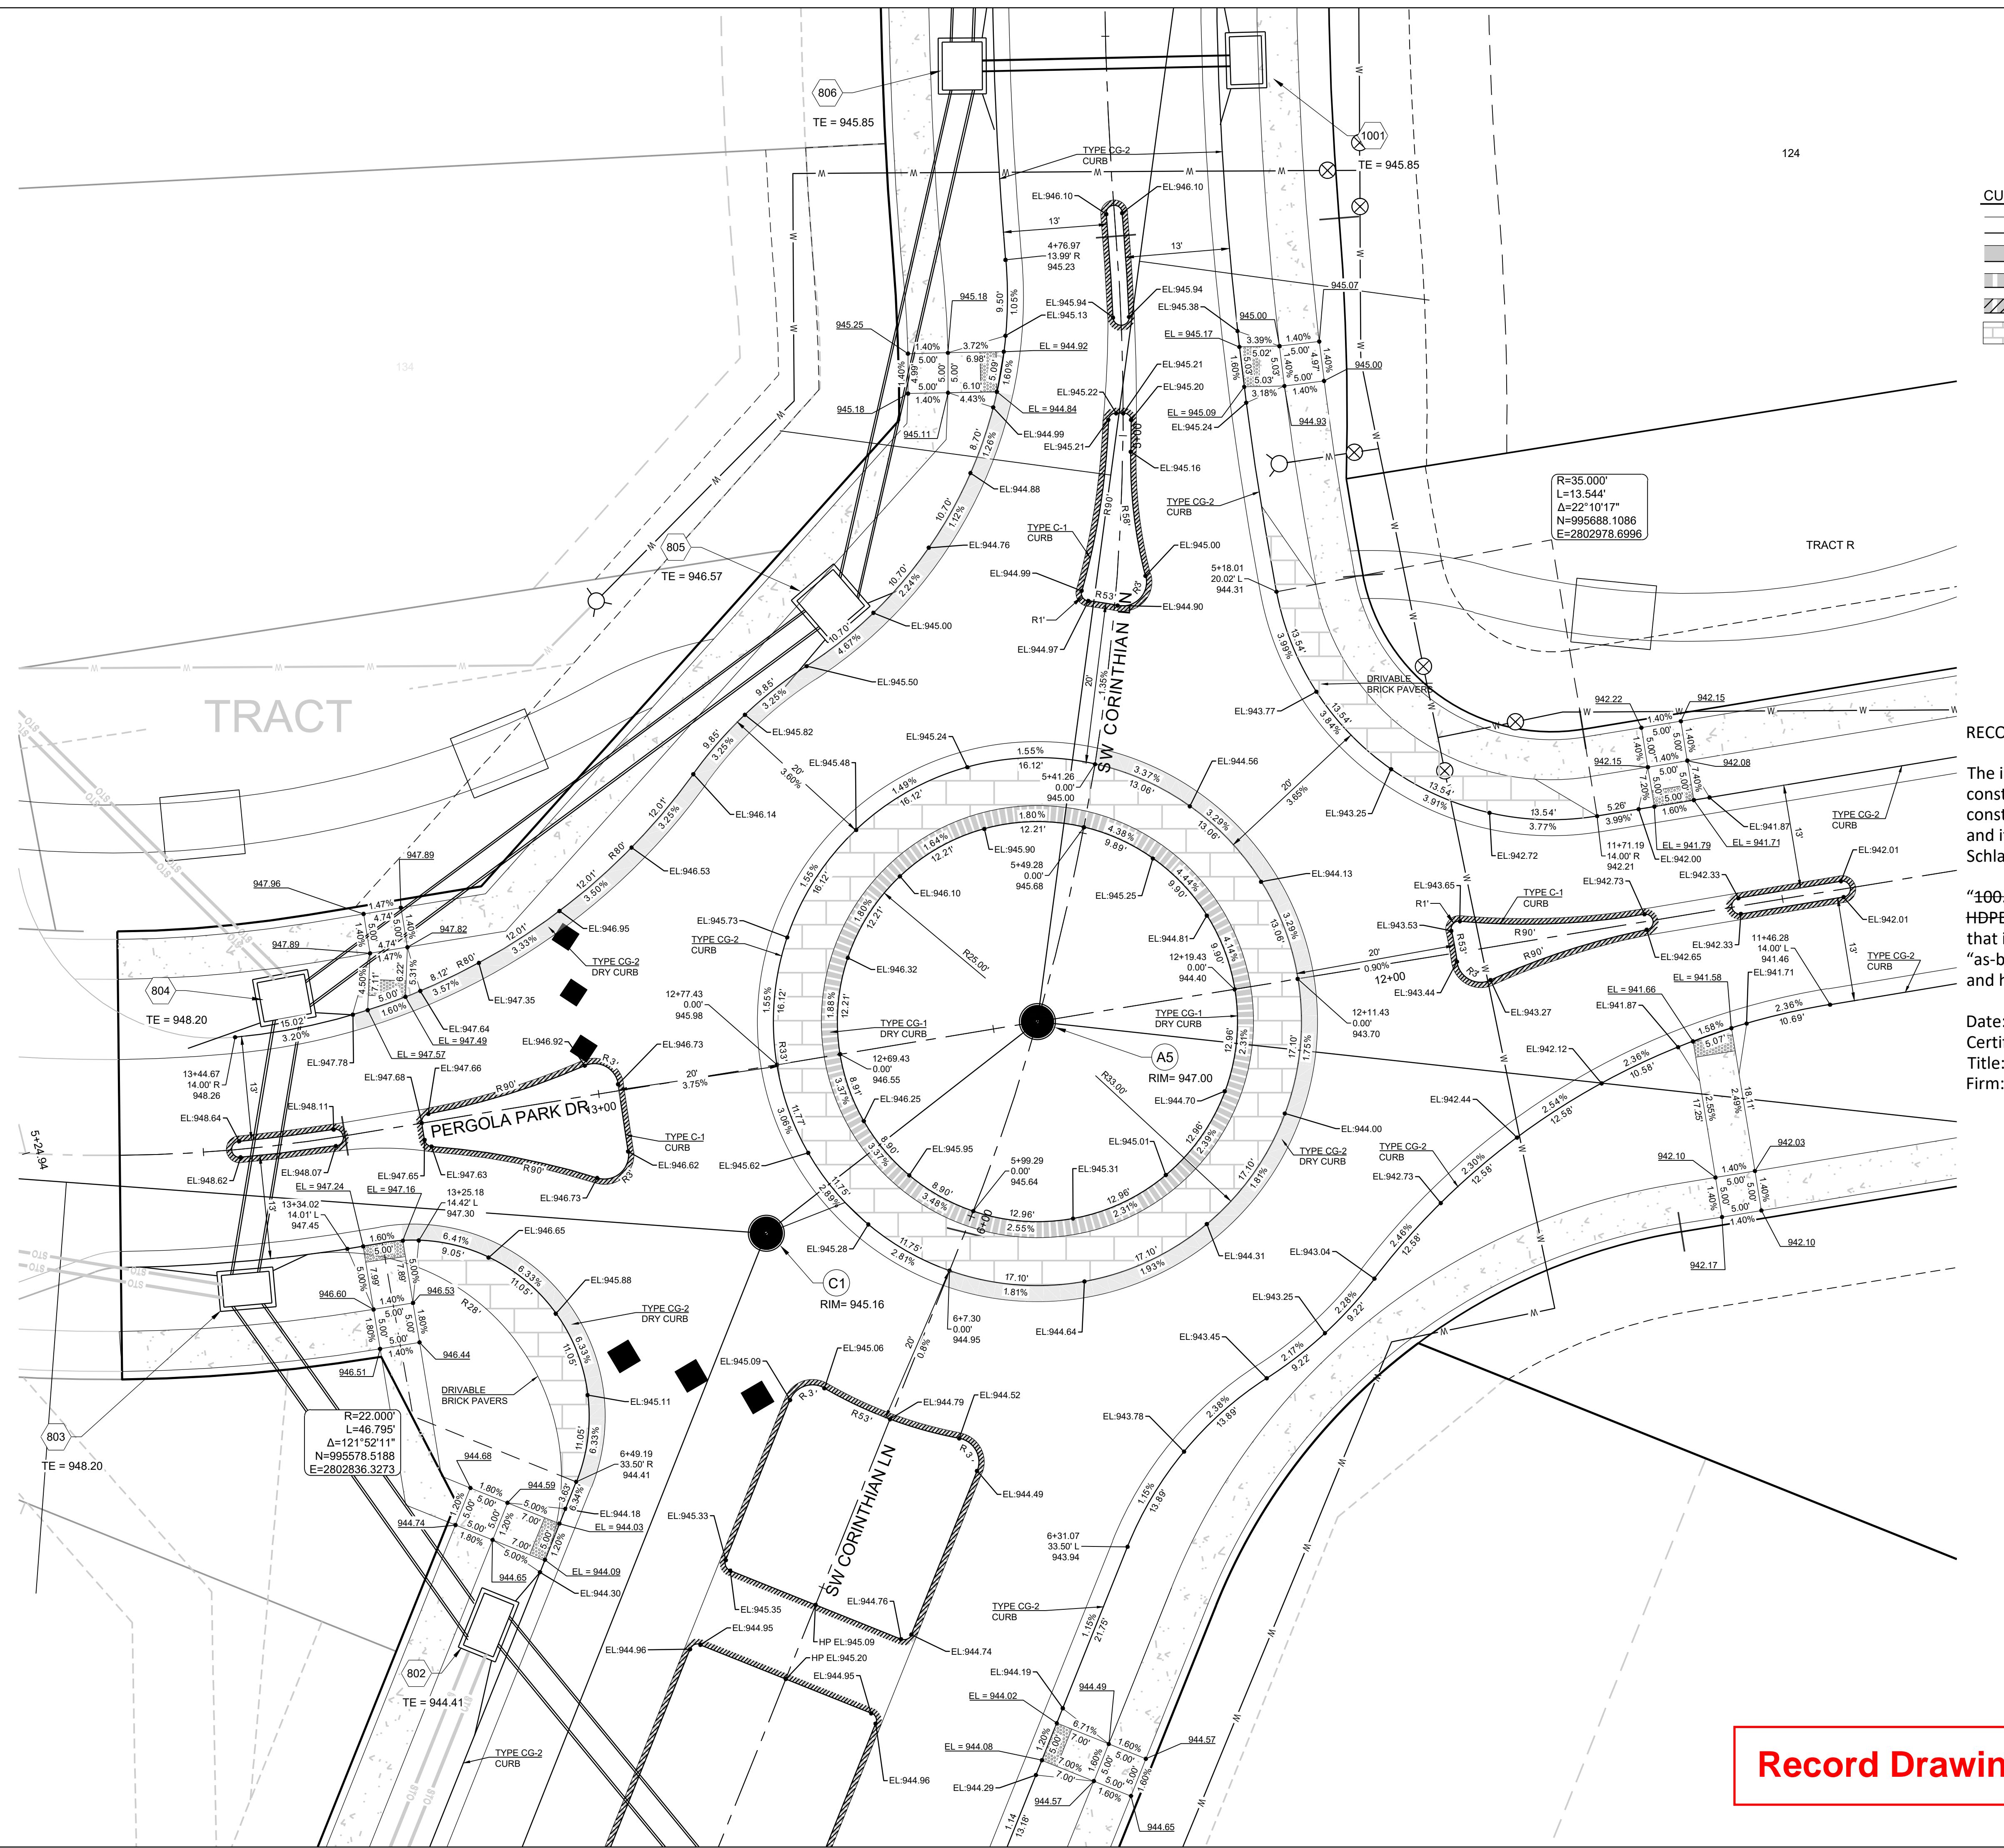

PERGOLA PARK 5TH PLAT STREET, STORMWATER, MASTER DRAINAGE PLAN & EROSION AND SEDIMENT CONTROL

- LEE'S SUMMIT, MISSOURI


SCHLAGEL
ENGINEERS PLANNERS SURVEYORS LANDSCAPE ARCHITECTS
14920 West 107th Street • Lenexa Kansas 66215
(913) 492-5158 • Fax: (913) 492-2400
WWW.SCHLAGELASSOCIATES.COM
Master Certified Civil Engineer of the Year
#E202003800 F BLCC201000237 MSL202003859-F

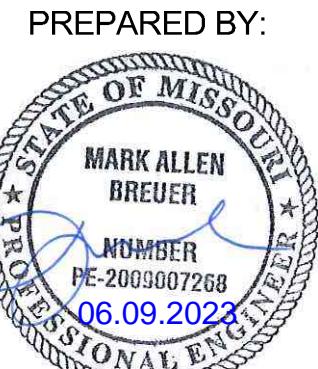


SCHLAGEL & ASSOCIATES, P.A.

PREPARED BY:
MARK ALLEN BREUER
PE-2005007268
06.09.2023

ROUNDABOUT INTERSECTION DETAIL	
DRAWN BY:	REVISION DATE
BAL	2-4-22
CHECKED BY:	3-30-22
MAB	3-19-22
DATE PREPARED	5/22/23
PROJ. NUMBER:	202-189
SHEET	
16	

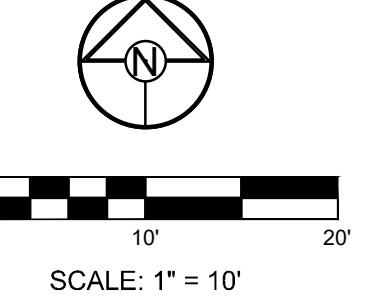


SCALE: 1" = 10'

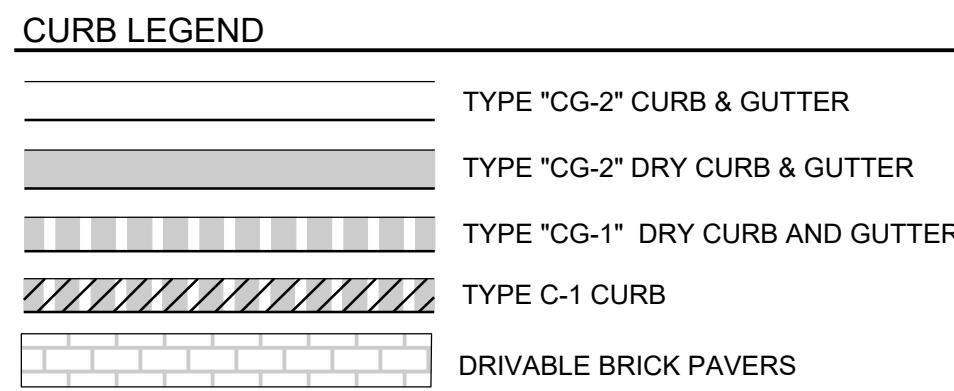**RECORD DRAWING**


The information provided on this drawing conforms to construction records; it is not intended for construction, implementation or recording purposes; and it is solely based on information obtained by Schlagel and Associates.

"100.00 100.10", "1.00% 1.15% slope", or "8-inch HDPE PVC pipe" are all typical examples of revisions that indicate that design data has been replaced with "as-built" information. All other data is as designed and has not been field verified.

Date: 5/22/2023
Certified by: BAL
Title: Design Engineer
Firm: Schlagel and Associates, P.A.

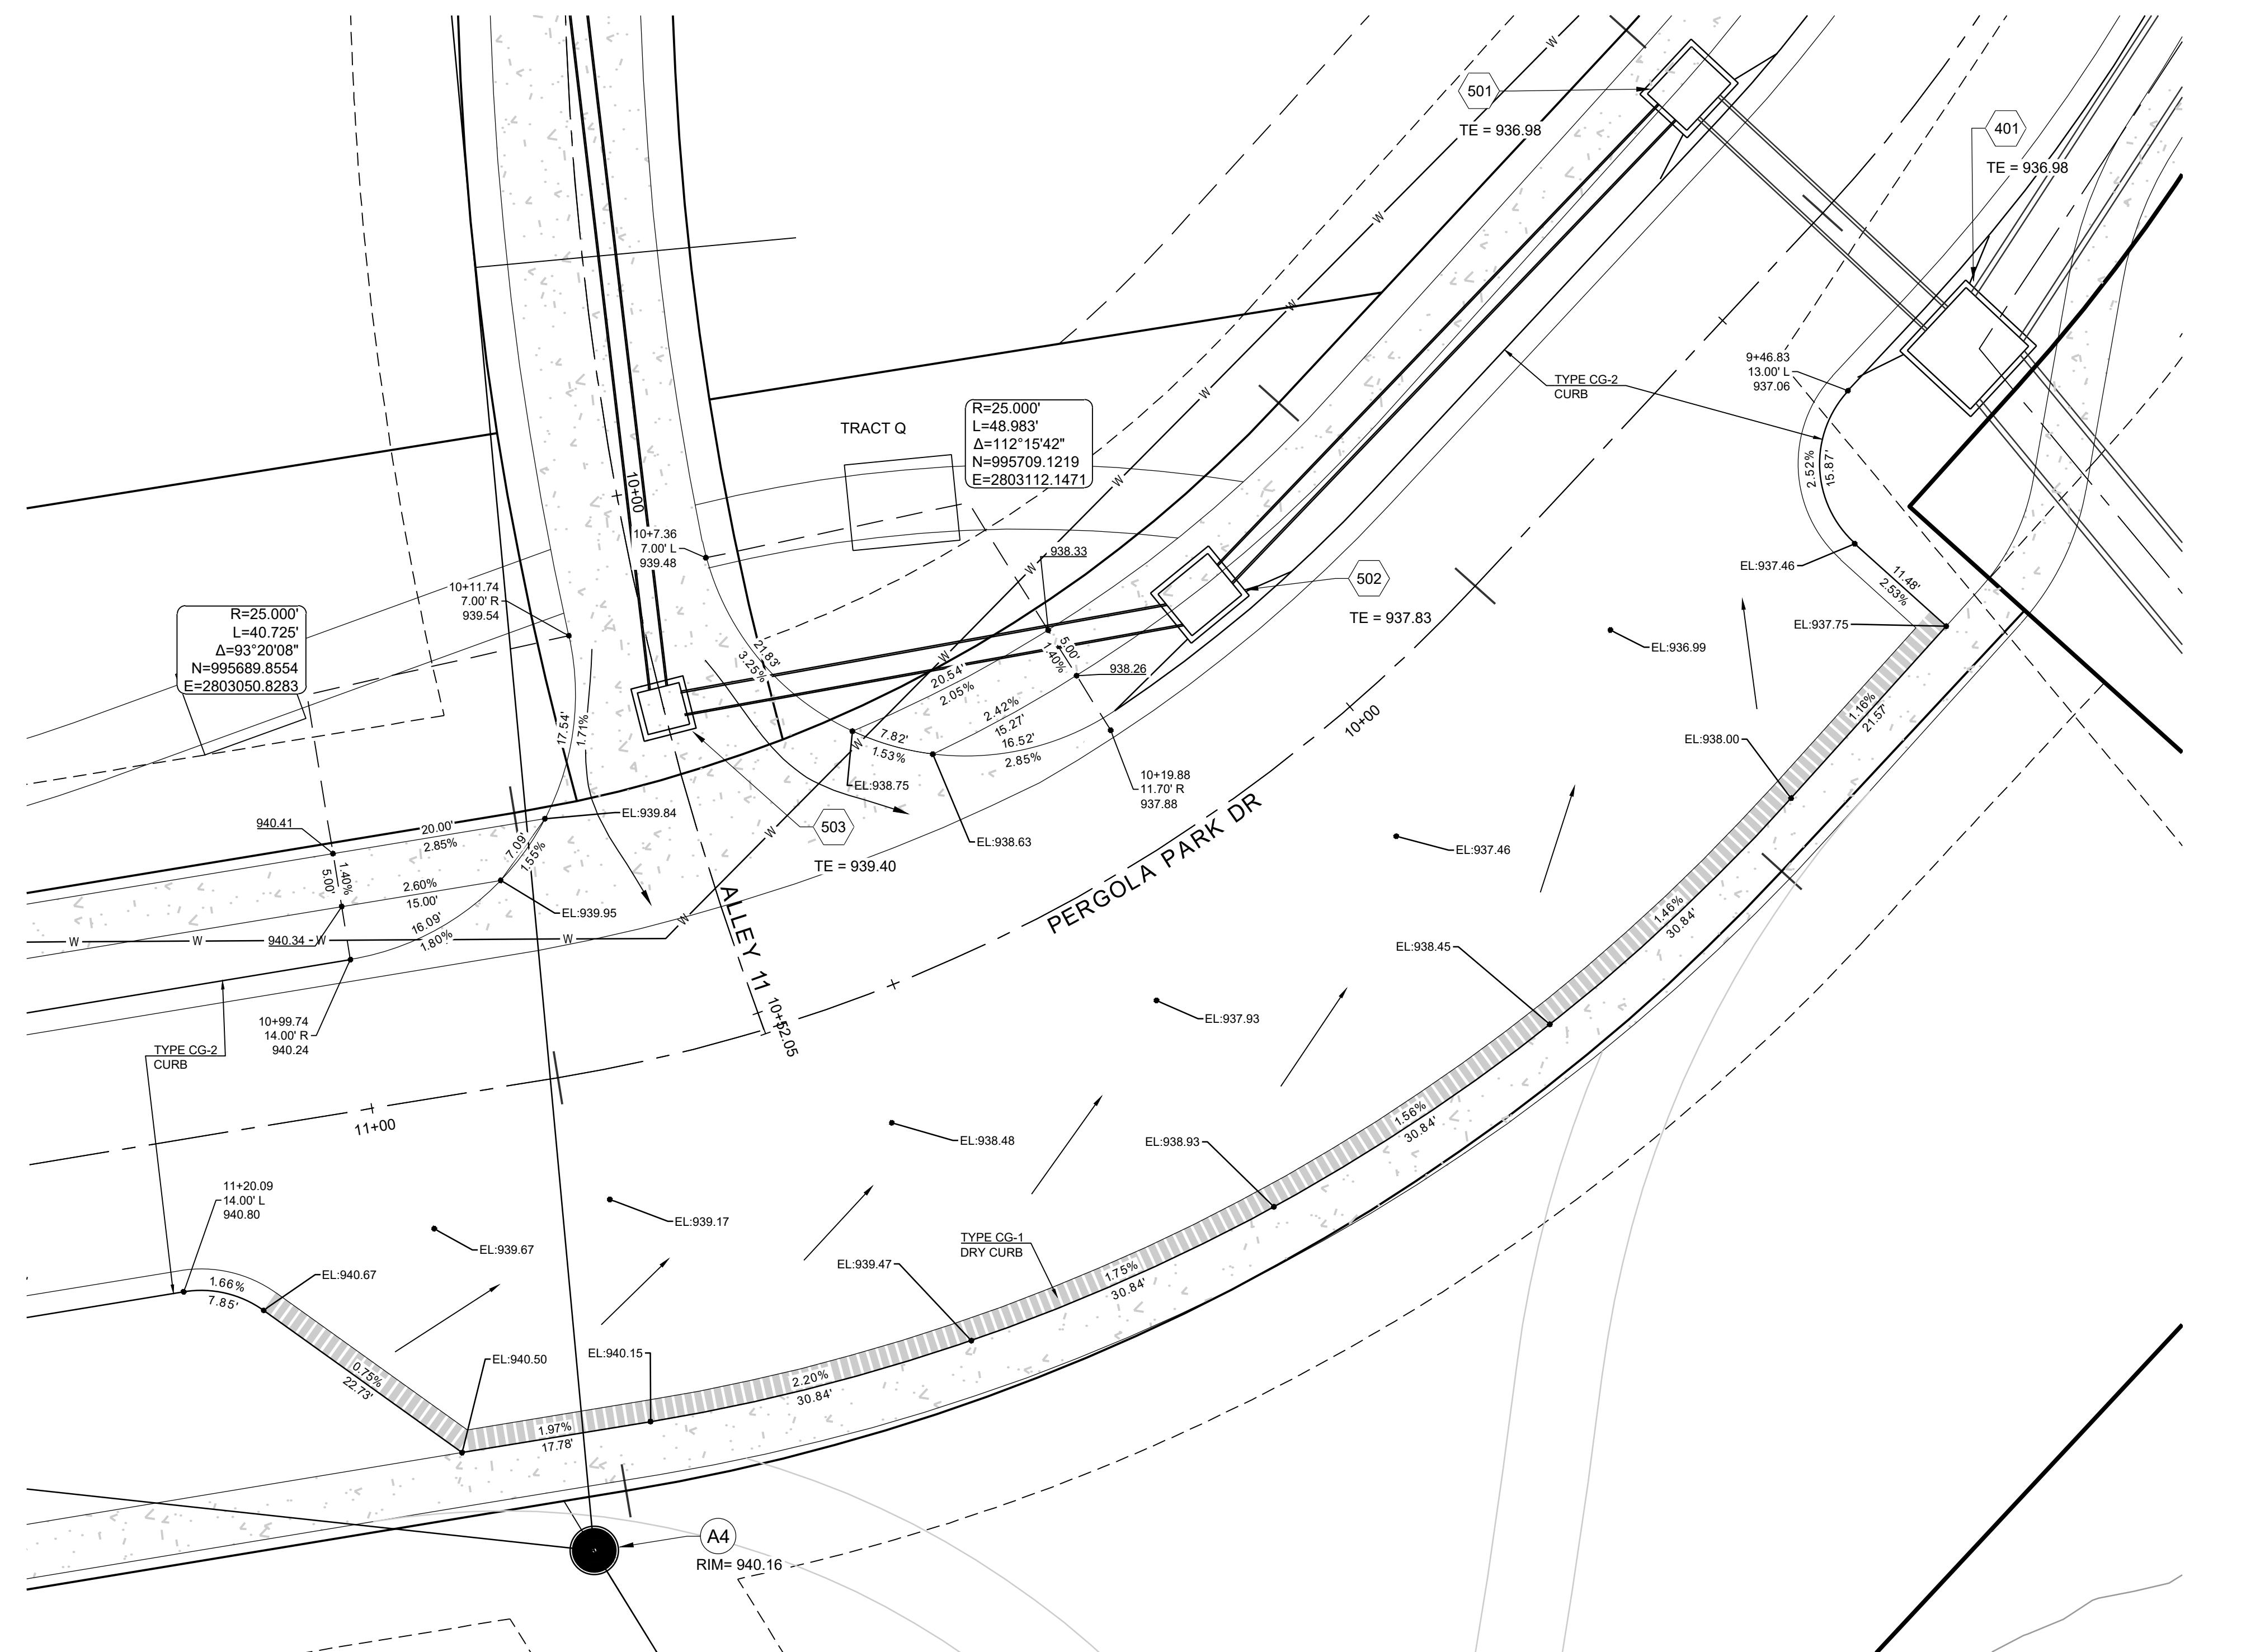

Record Drawing

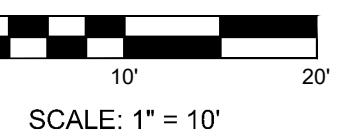


SCALE: 1" = 10'

17

PERGOLA PARK 5TH PLAT
STREET, STORMWATER, MASTER DRAINAGE
PLAN & EROSION AND SEDIMENT CONTROL

- LEE'S SUMMIT, MISSOURI

SCHLAGEL
ENGINEERS PLANNERS SURVEYORS LANDSCAPE ARCHITECTS
14920 West 107th Street • Lenexa Kansas 66215
(913) 492-5158 • Fax: (913) 492-2400
WWW.SCHLAGELASSOCIATES.COM
Master Certified Civil Engineers of Missouri
#E202003800 F BLCC201000237 MS2020038859-F

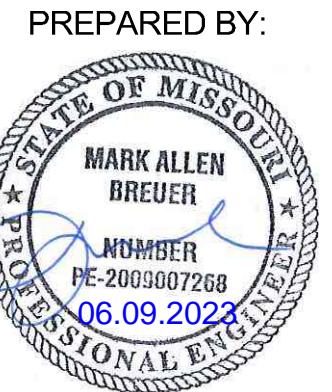


SCHLAGEL & ASSOCIATES, P.A.

DESCRIPTION		DRAWN BY:	REVISION DATE
CITY COMMENTS	STREET TIE INS		
BAL	2-4-22	CHECKED BY:	3-30-22
		MAB	3-14-22
		DATE PREPARED:	5/22/2023
		PROJ. NUMBER:	11-1-2021
			20-189




SHEET

17

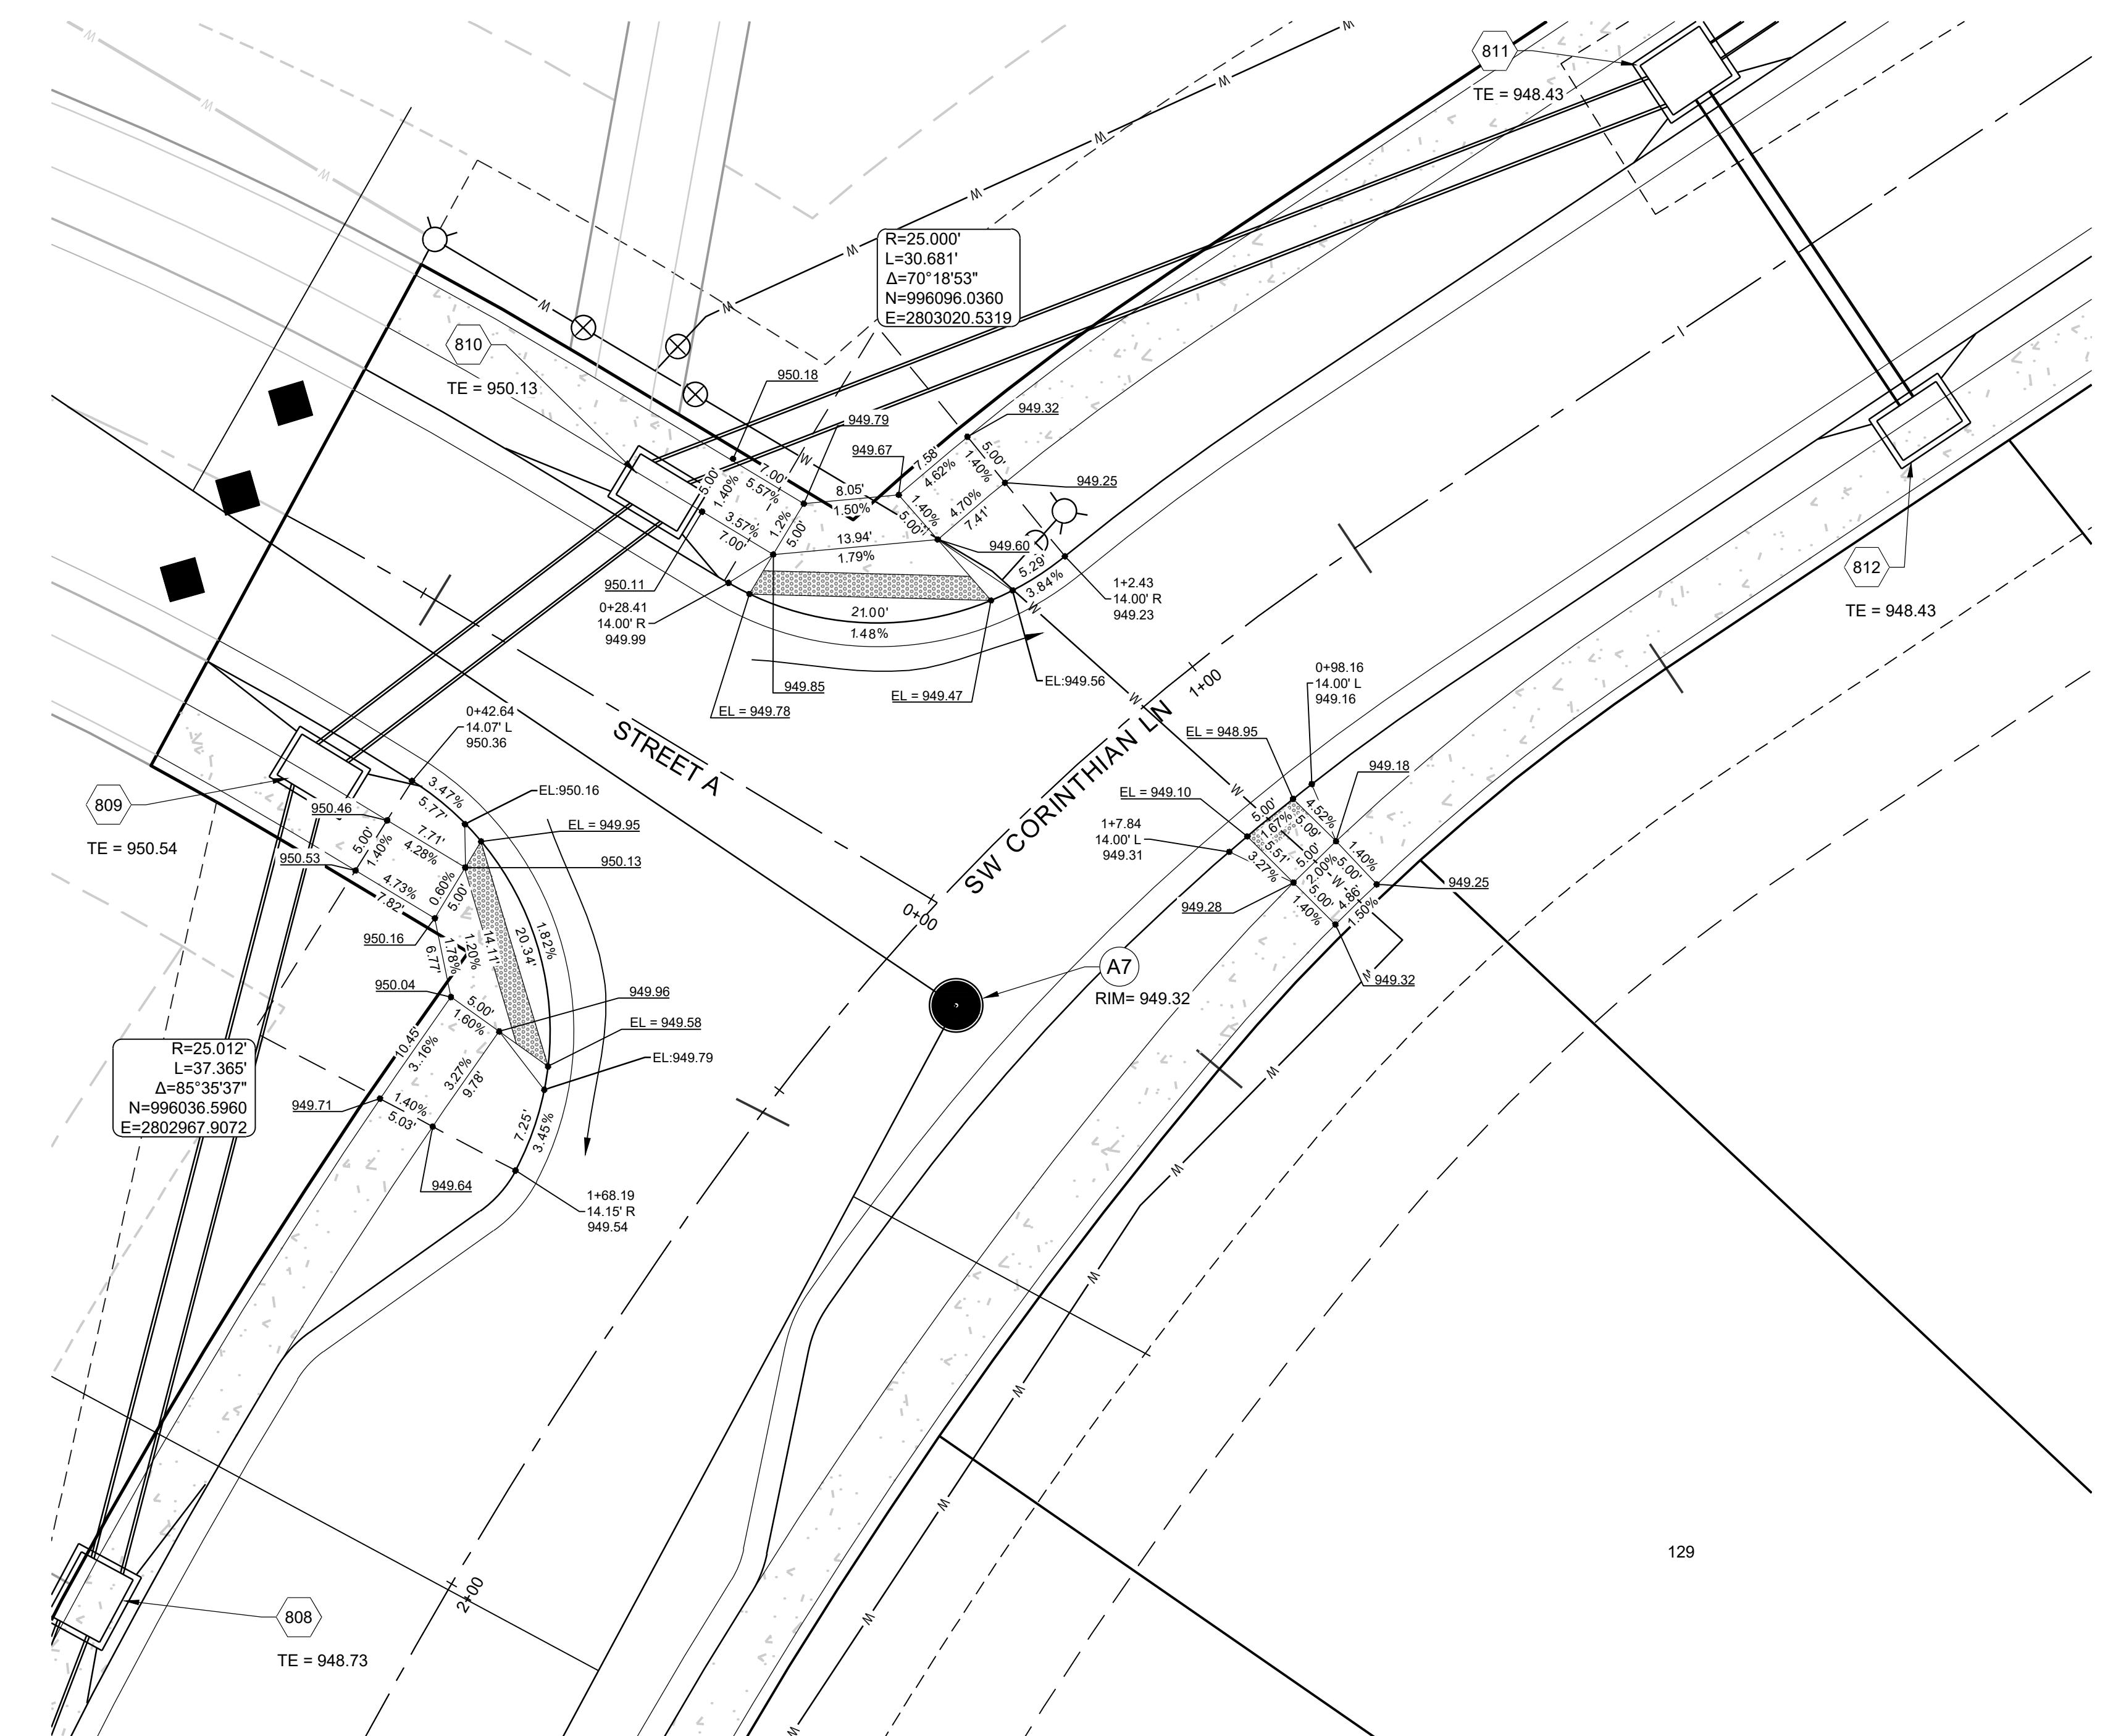

Record Drawing

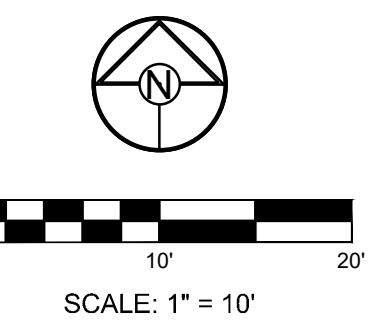

18

**PERGOLA PARK 5TH PLAT
STREET, STORMWATER, MASTER DRAINAGE
PLAN & EROSION AND SEDIMENT CONTROL**
- LEE'S SUMMIT, MISSOURI

PREPARED BY:

MARK ALLEN BREUER
PE-2005007268
06.09.2023

SCHLAGEL & ASSOCIATES, P.A.

CURB LEGEND

	TYPE "CG-2" CURB & GUTTER
	TYPE "CG-1" DRY CURB AND GUTTER
	TYPE C-1 CURB
	DRIVABLE BRICK PAVERS


RECORD DRAWING

The information provided on this drawing conforms to construction records; it is not intended for construction, implementation or recording purposes; and it is solely based on information obtained by Schlagel and Associates.

"100.00 100.10", "1.00% 1.15% slope", or "8-inch HDPE PVC pipe" are all typical examples of revisions that indicate that design data has been replaced with "as-built" information. All other data is as designed and has not been field verified.

Date: 5/22/2023
Certified by: BAL
Title: Design Engineer
Firm: Schlagel and Associates, P.A.

SCHLAGEL
ENGINEERS PLANNERS SURVEYORS LANDSCAPE ARCHITECTS
14920 West 107th Street • Lenexa Kansas 66215
(913) 492-5158 • Fax: (913) 492-2400
WWW.SCHLAGELASSOCIATES.COM
Master Certified Civil Engineer of the Year
#E202003800-F BLCC201000237 MS202008859-F

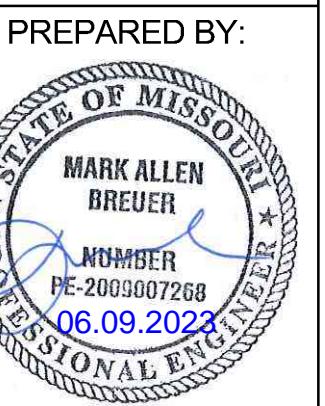


PREPARED BY:

MARK ALLEN BREUER
 PE-203007268
 06.09.2023

SCHLAGEL & ASSOCIATES, P.A.

PERGOLA PARK 5TH PLAT STREET, STORMWATER, MASTER DRAINAGE PLAN & EROSION AND SEDIMENT CONTROL

- LEE'S SUMMIT, MISSOURI




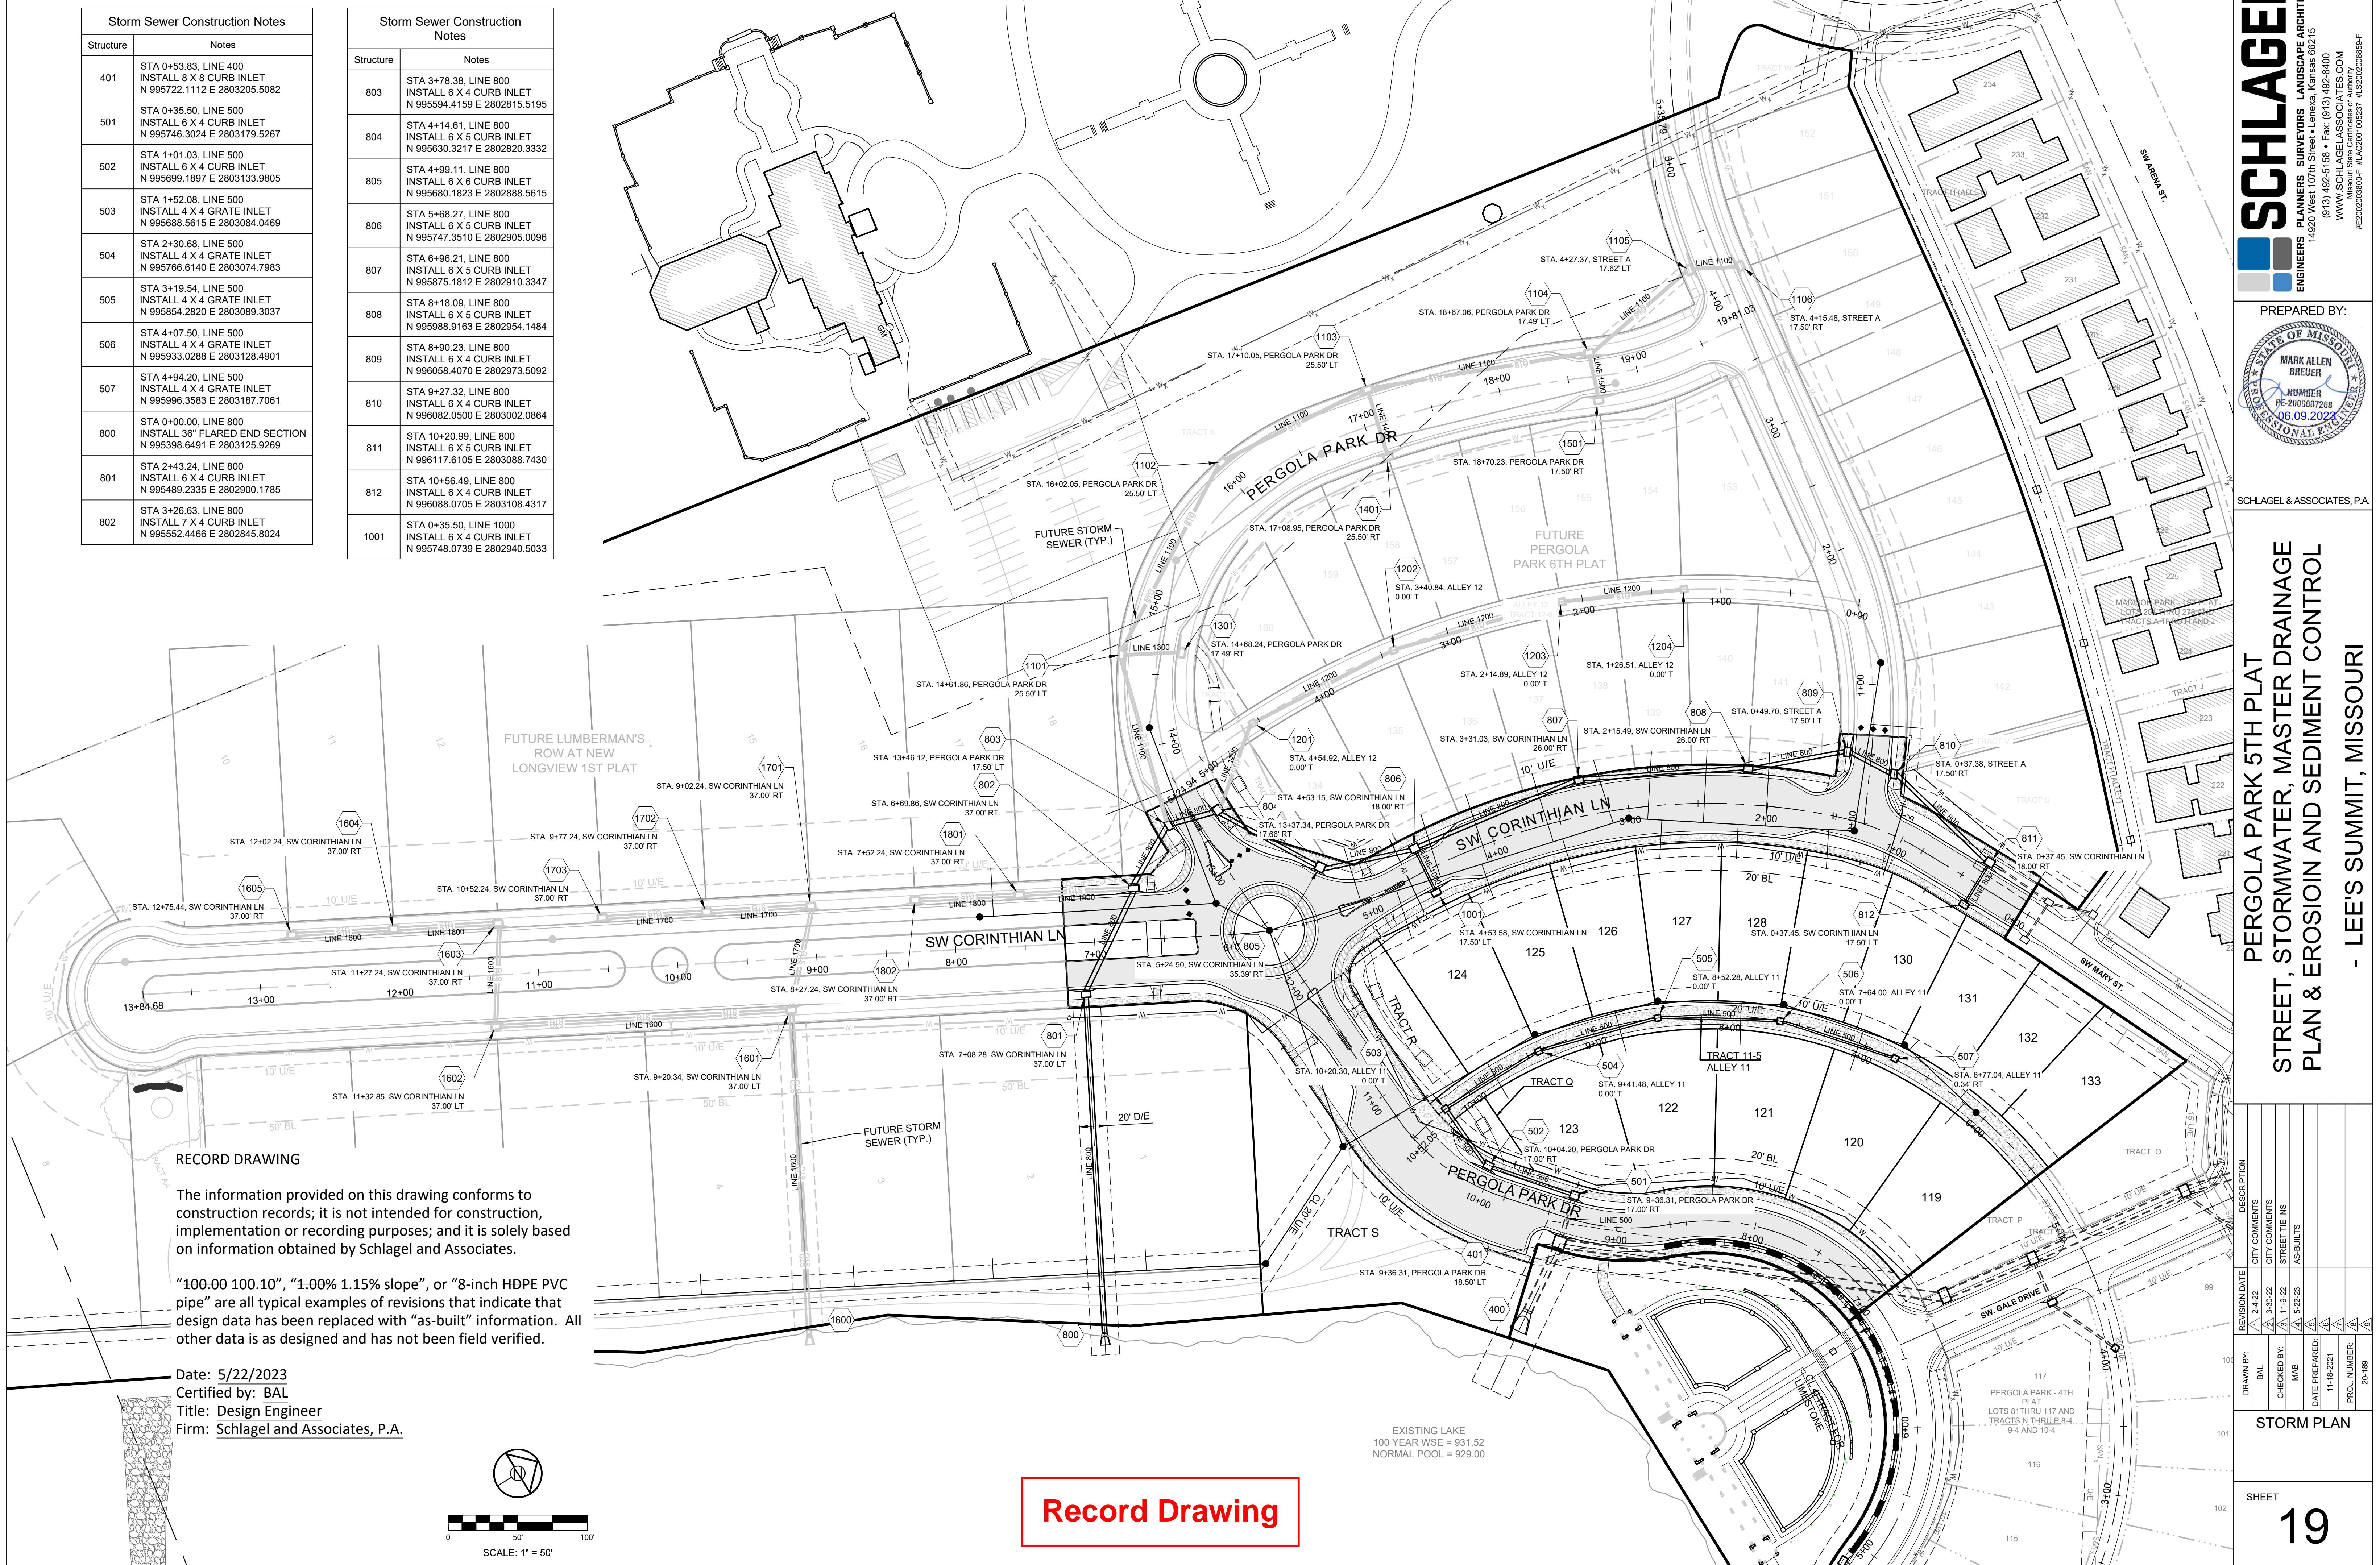


RECORD DRAWING

The information provided on this drawing conforms to construction records; it is not intended for construction, implementation or recording purposes; and it is solely based on information obtained by Schlagel and Associates.

"100-00 100.10", "1-00% 1.15% slope", or "8-inch HDPE PVC pipe" are all typical examples of revisions that indicate that design data has been replaced with "as-built" information. All other data is as designed and has not been field verified.

Date: 5/22/2023
Certified by: BAL
Title: Design Engineer
Firm: Schlagel and Associates, P.A.

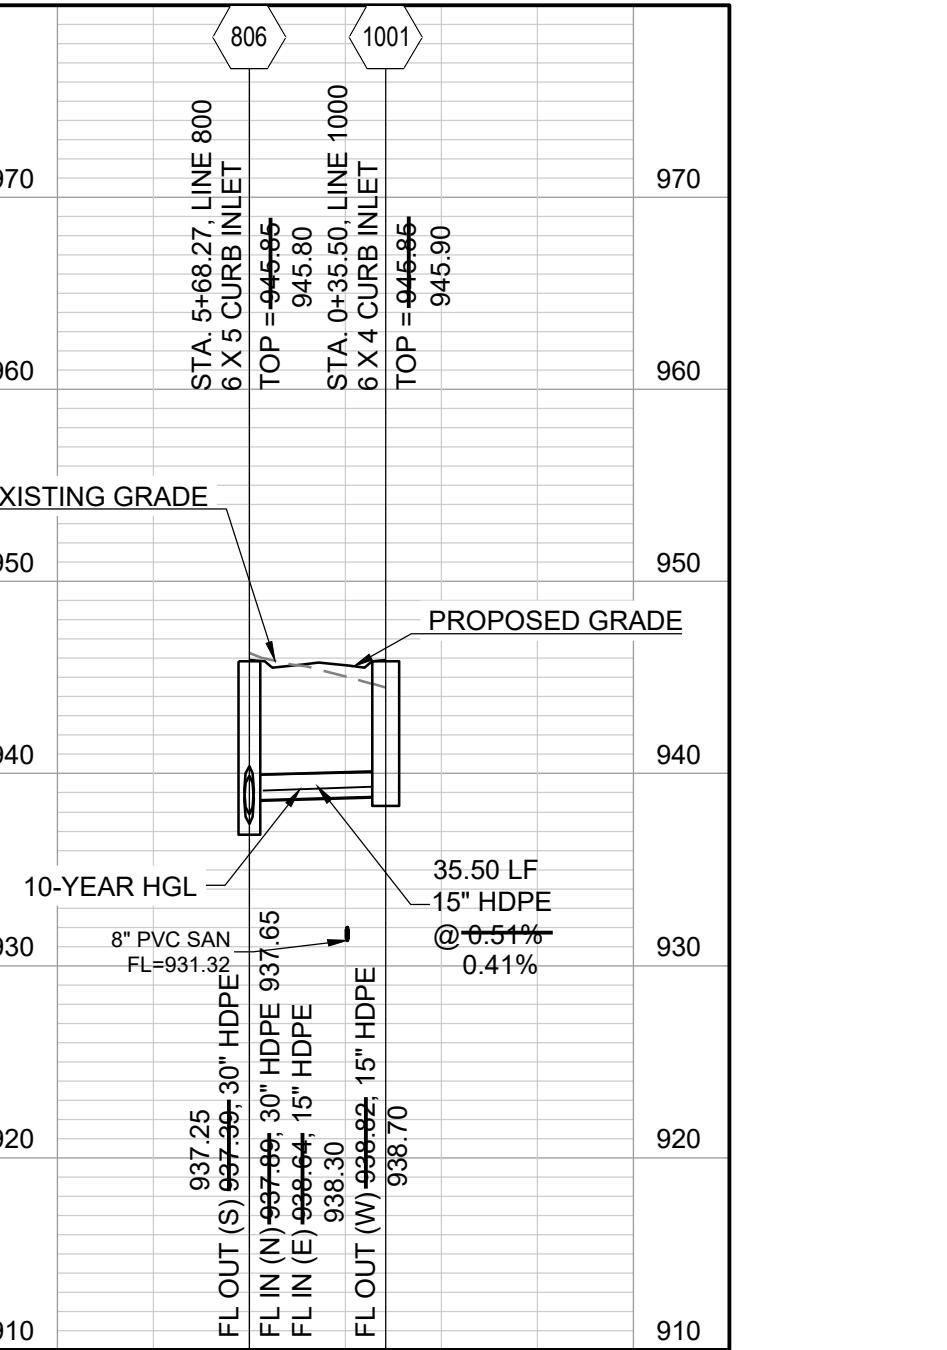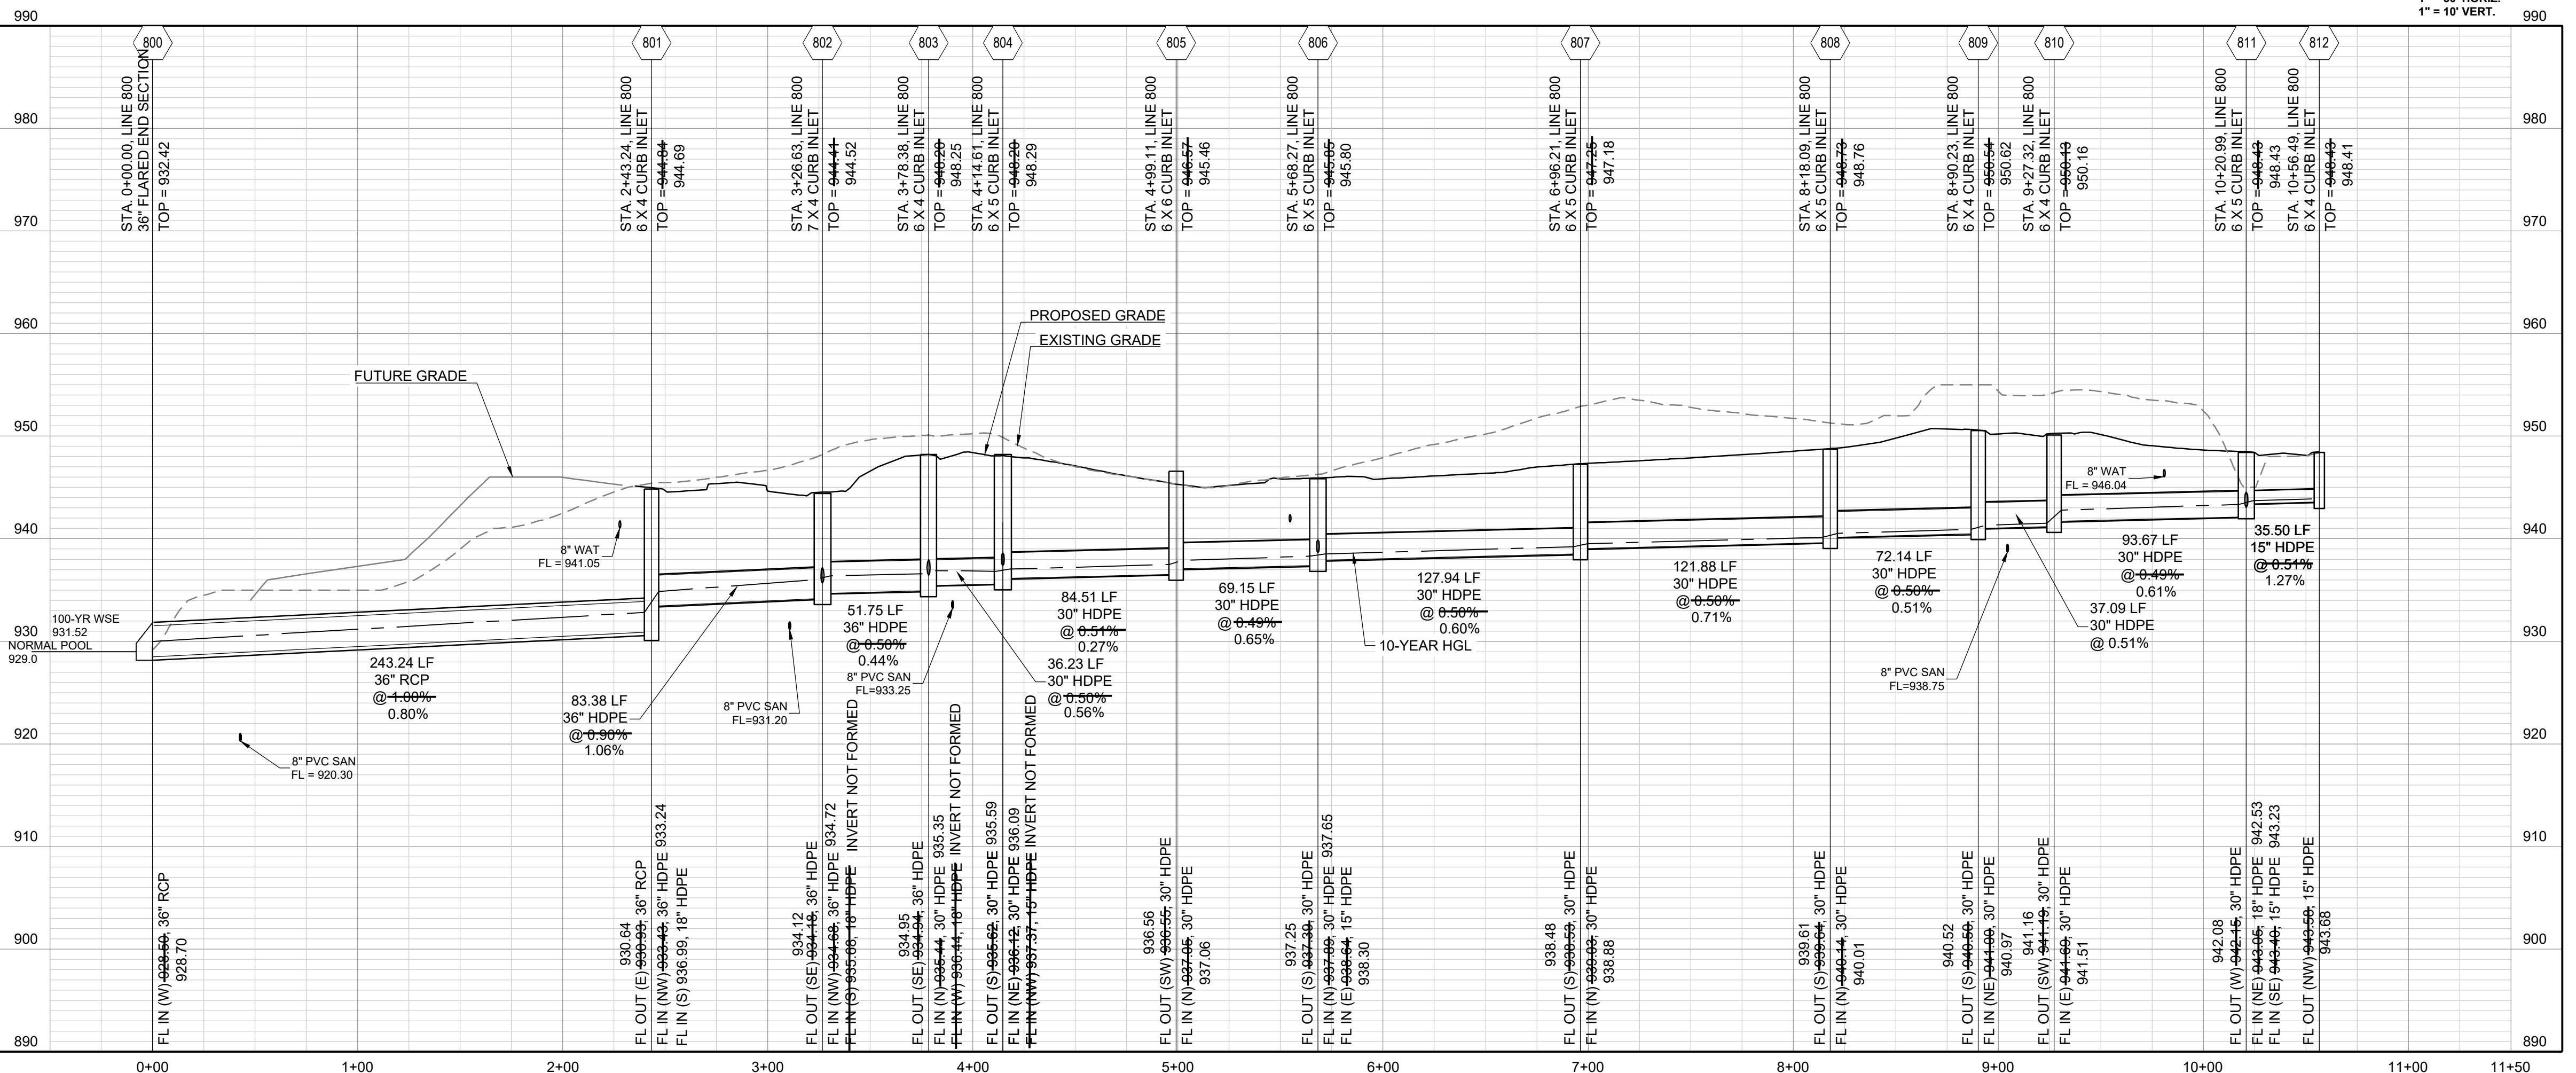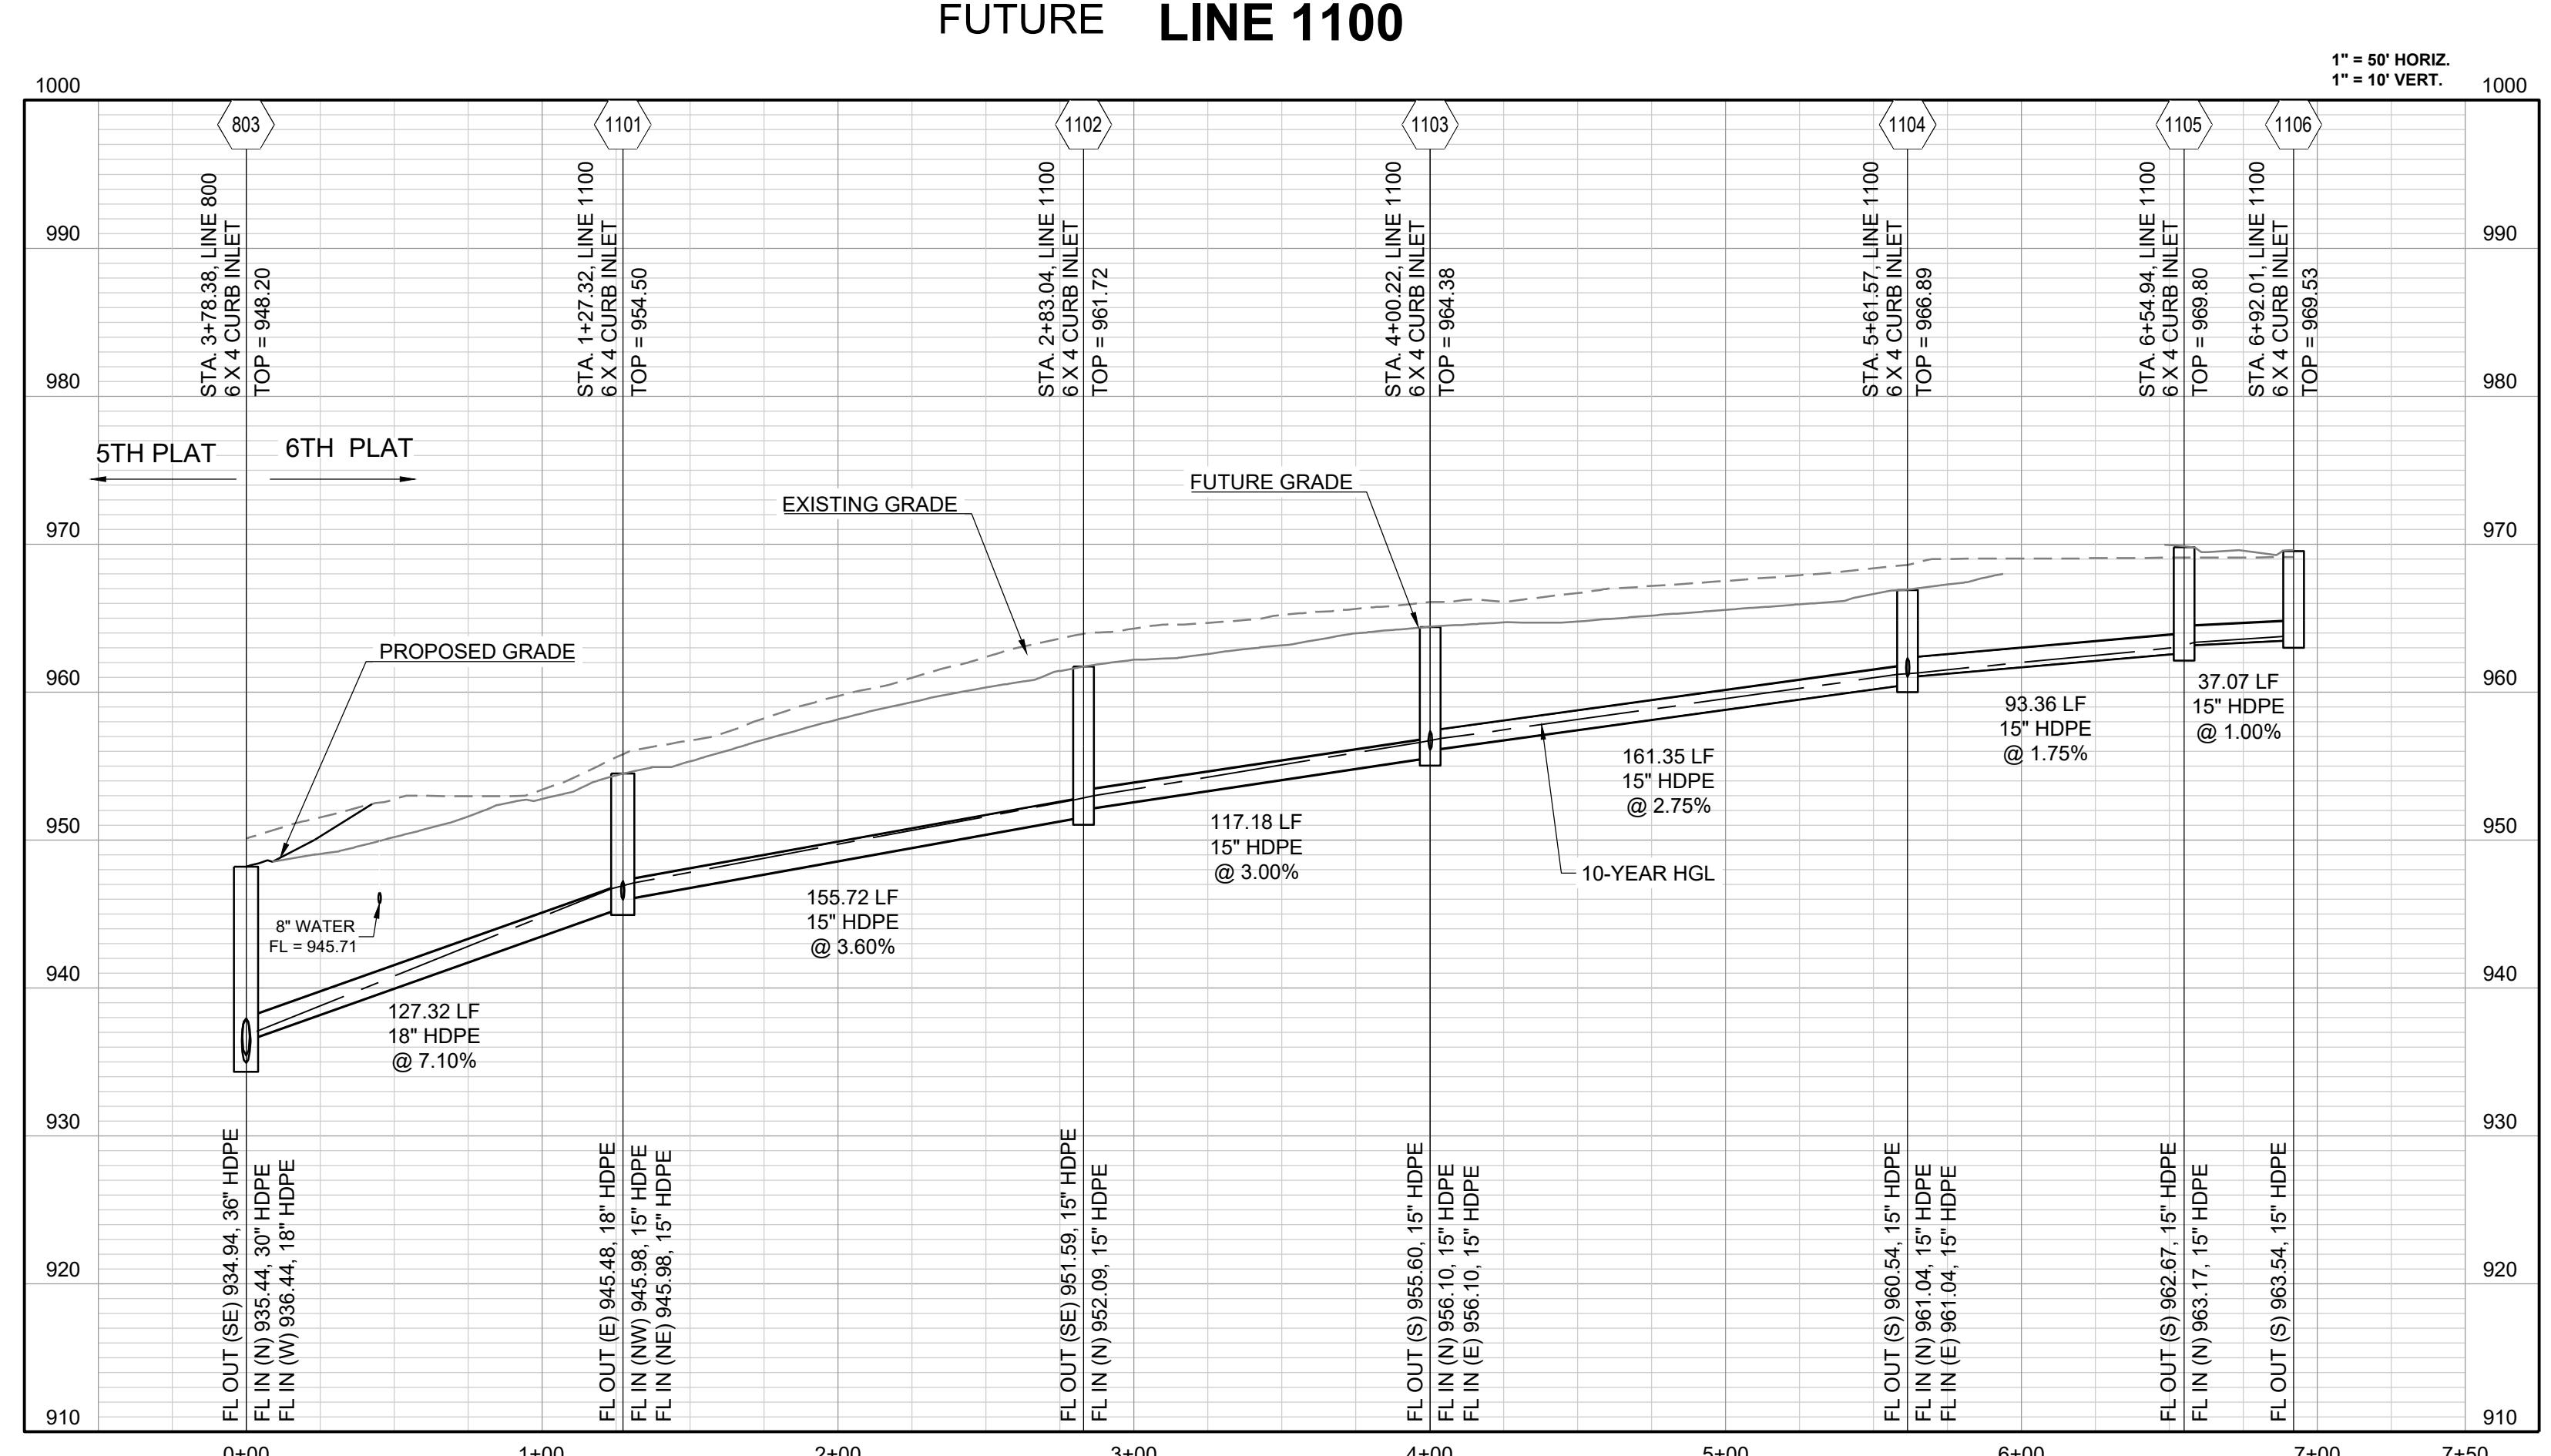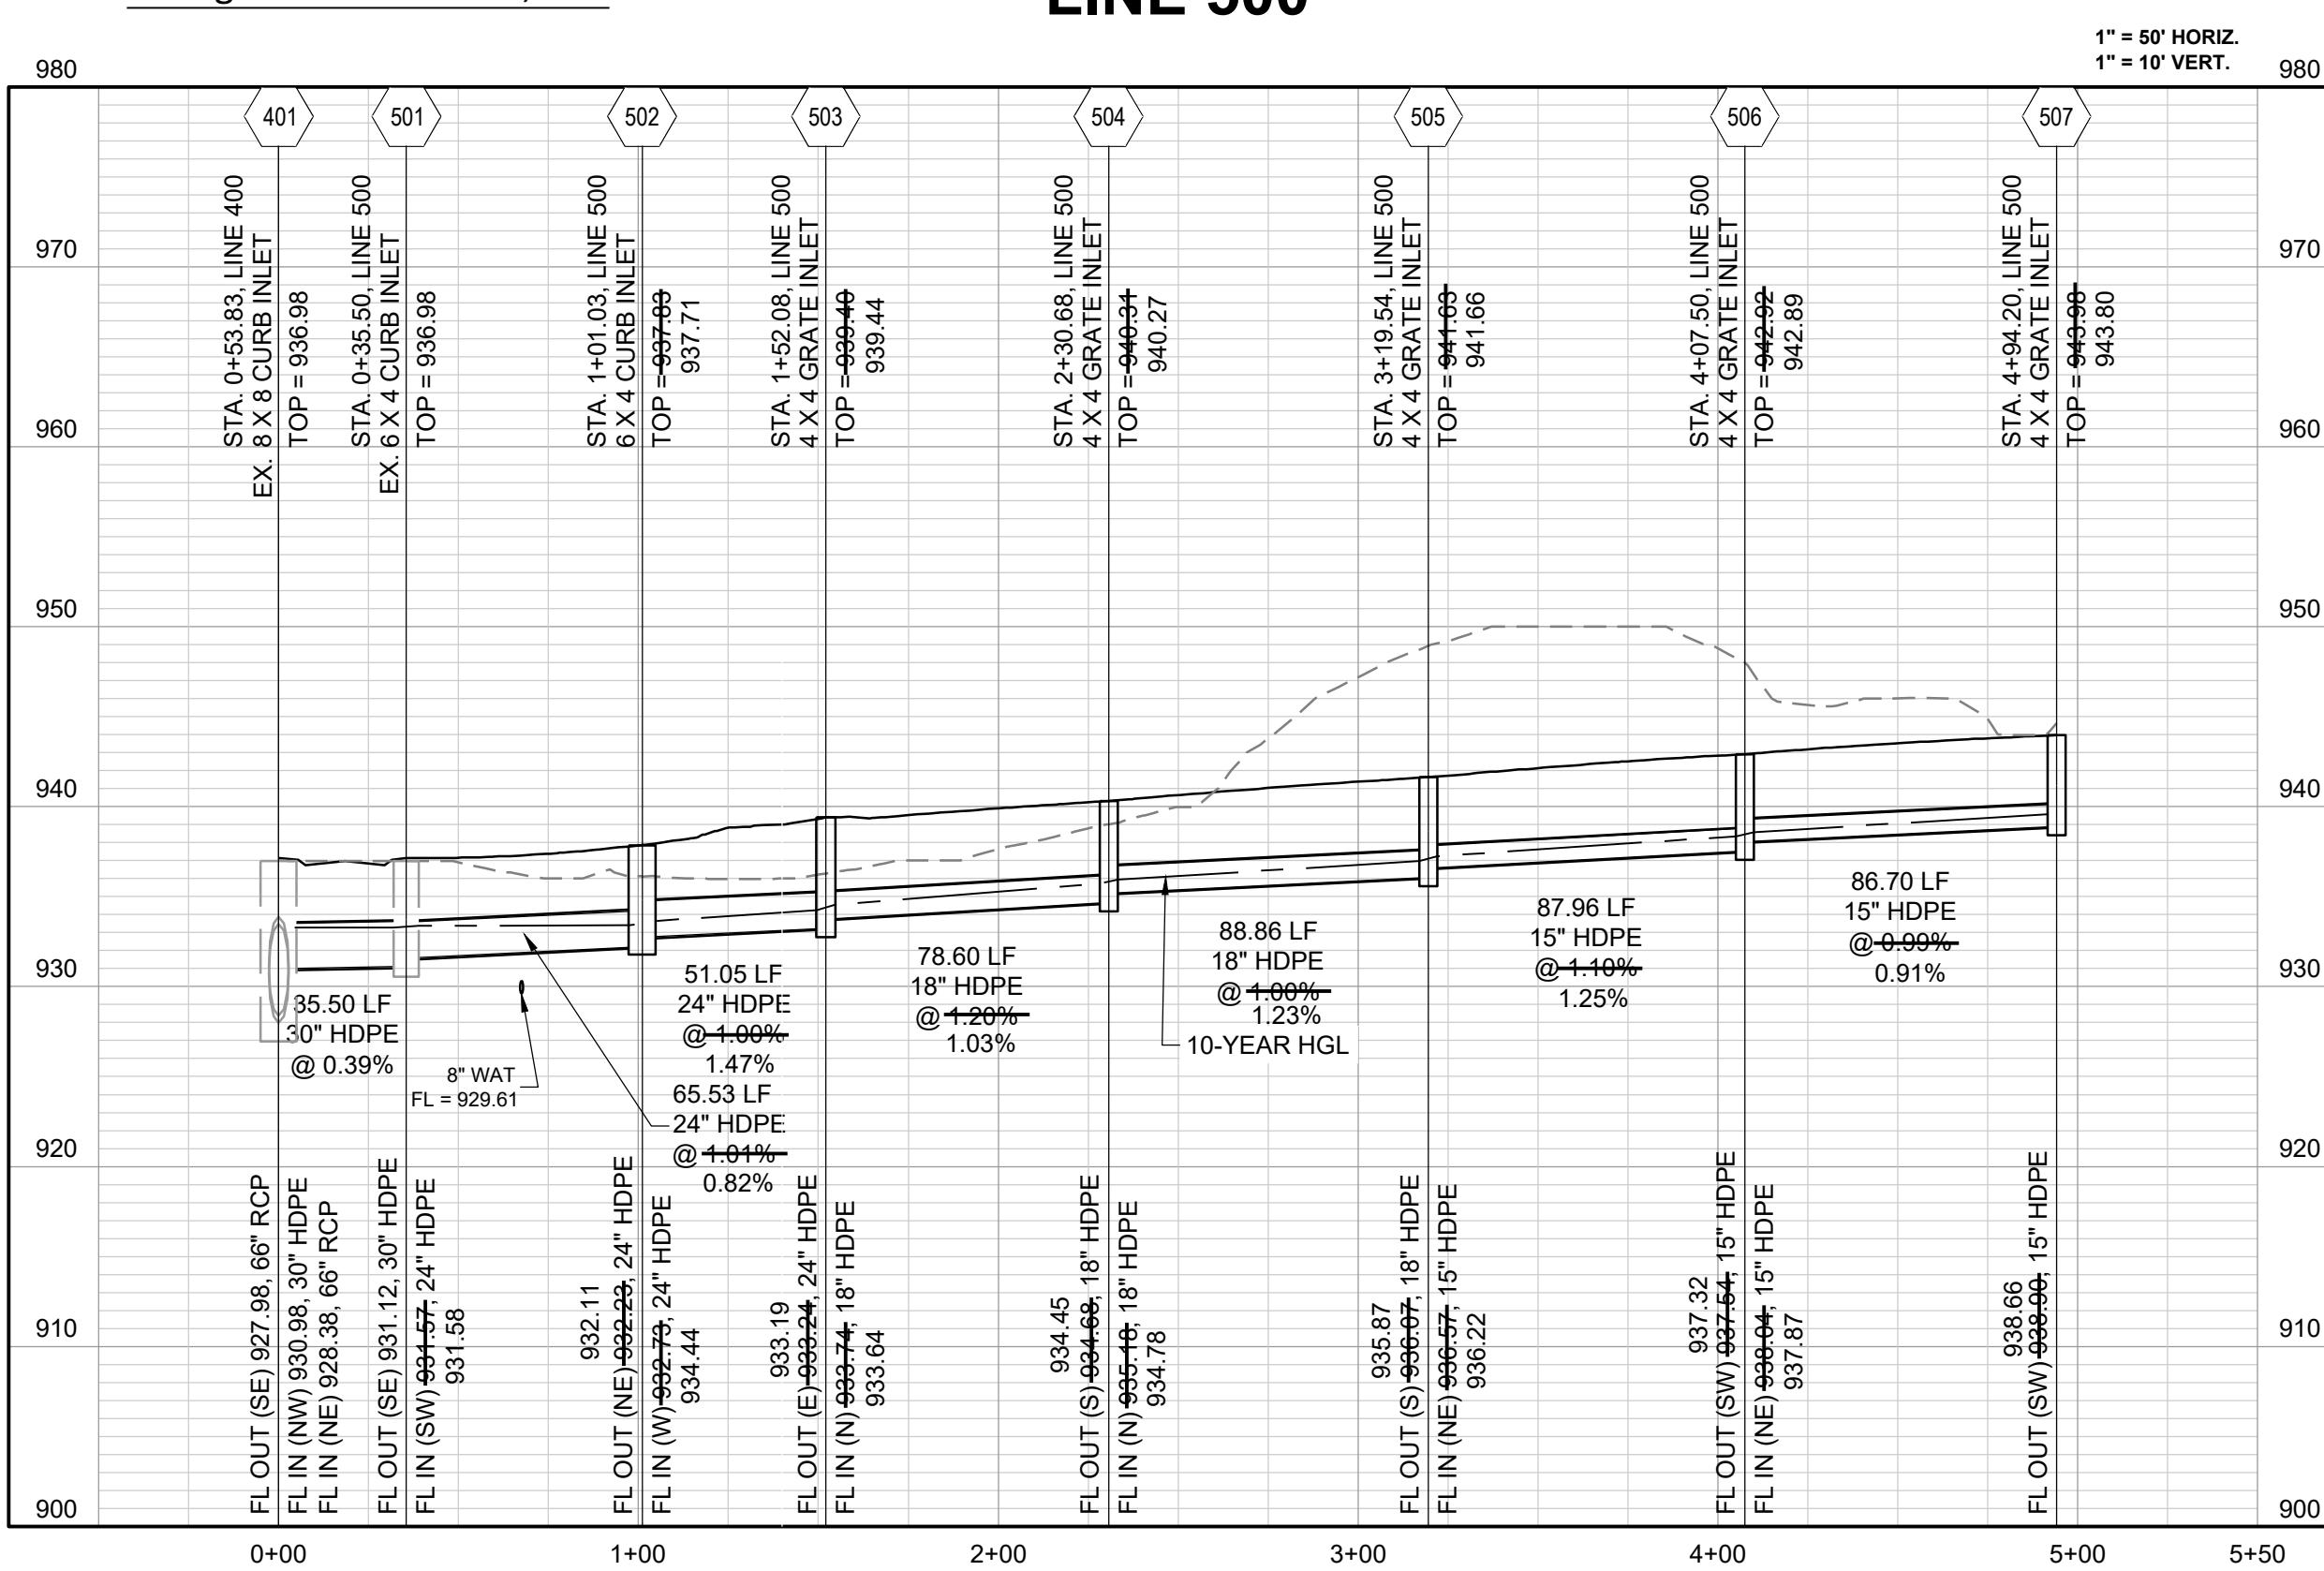

PERGOLA PARK 5TH PLAT
STREET, STORMWATER, MASTER DRAINAGE
PLAN & EROSION AND SEDIMENT CONTROL

- LEE'S SUMMIT, MISSOURI

Record Drawing



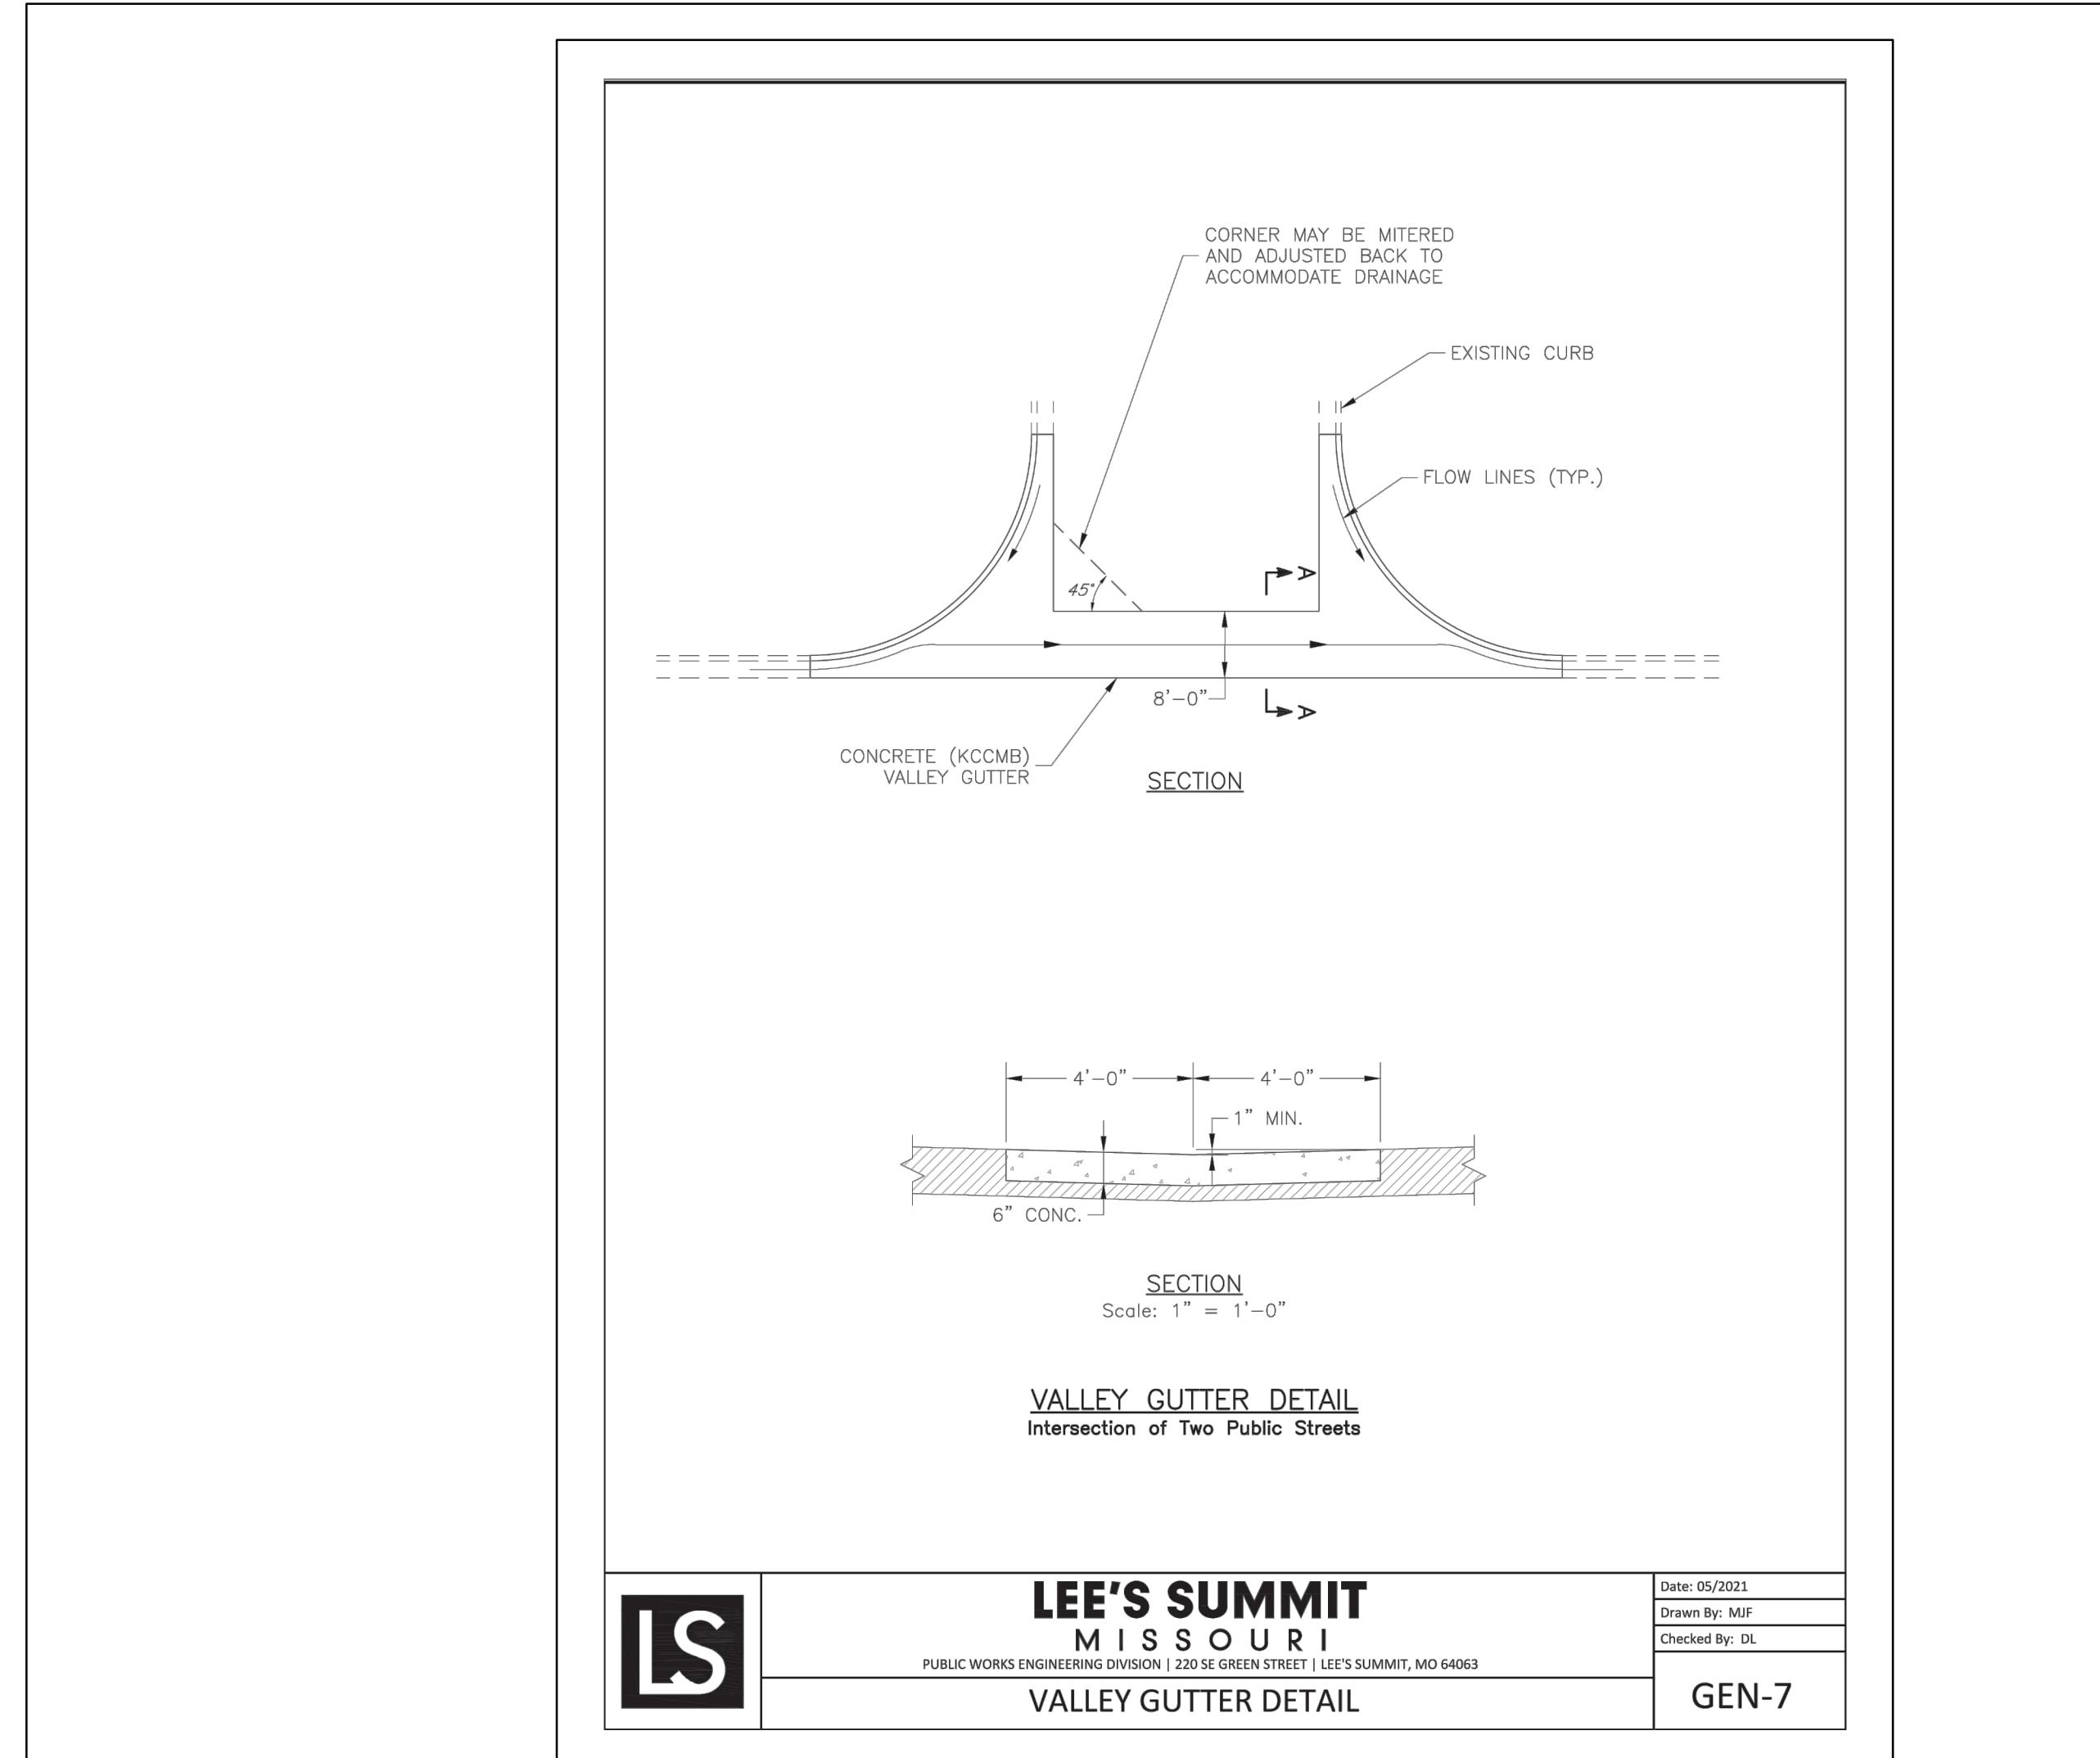


TABLE LS-2: MINIMUM ASPHALT PAVEMENT THICKNESSES


Street Classification	Pavement Option	AC Surface (in.)	AC Base (in.)	MoDOT Type 5 Base (in.)	Geogrid(1)	Chemical Subgrade Stabilization(2) (in.)
Residential Local/Access	A	2	4	6	--	6
	B	2	4	10	Geogrid	--
Residential Collector	A	2	5.5	6	--	9
	B	2	5.5	12	Geogrid	--
Commercial Industrial Local/Collector	A	2	7.5	6	--	9
	B	2	7.5	12	Geogrid	--

TABLE LS-3: MINIMUM PCC PAVEMENT THICKNESSES

Street Classification	PCC (in.)	Aggregate Base (in.)	Subgrade Stabilization ⁽¹⁾ (in.)
Residential Local/Access	6	4	--
Residential Collector	6	4	6
Commercial Industrial Local/Collector	8	4	9

(1) Subgrade Stabilization and 4" aggregate base may be replaced by approved geogrid and 6" of aggregate base

LSS200 16 October 2016

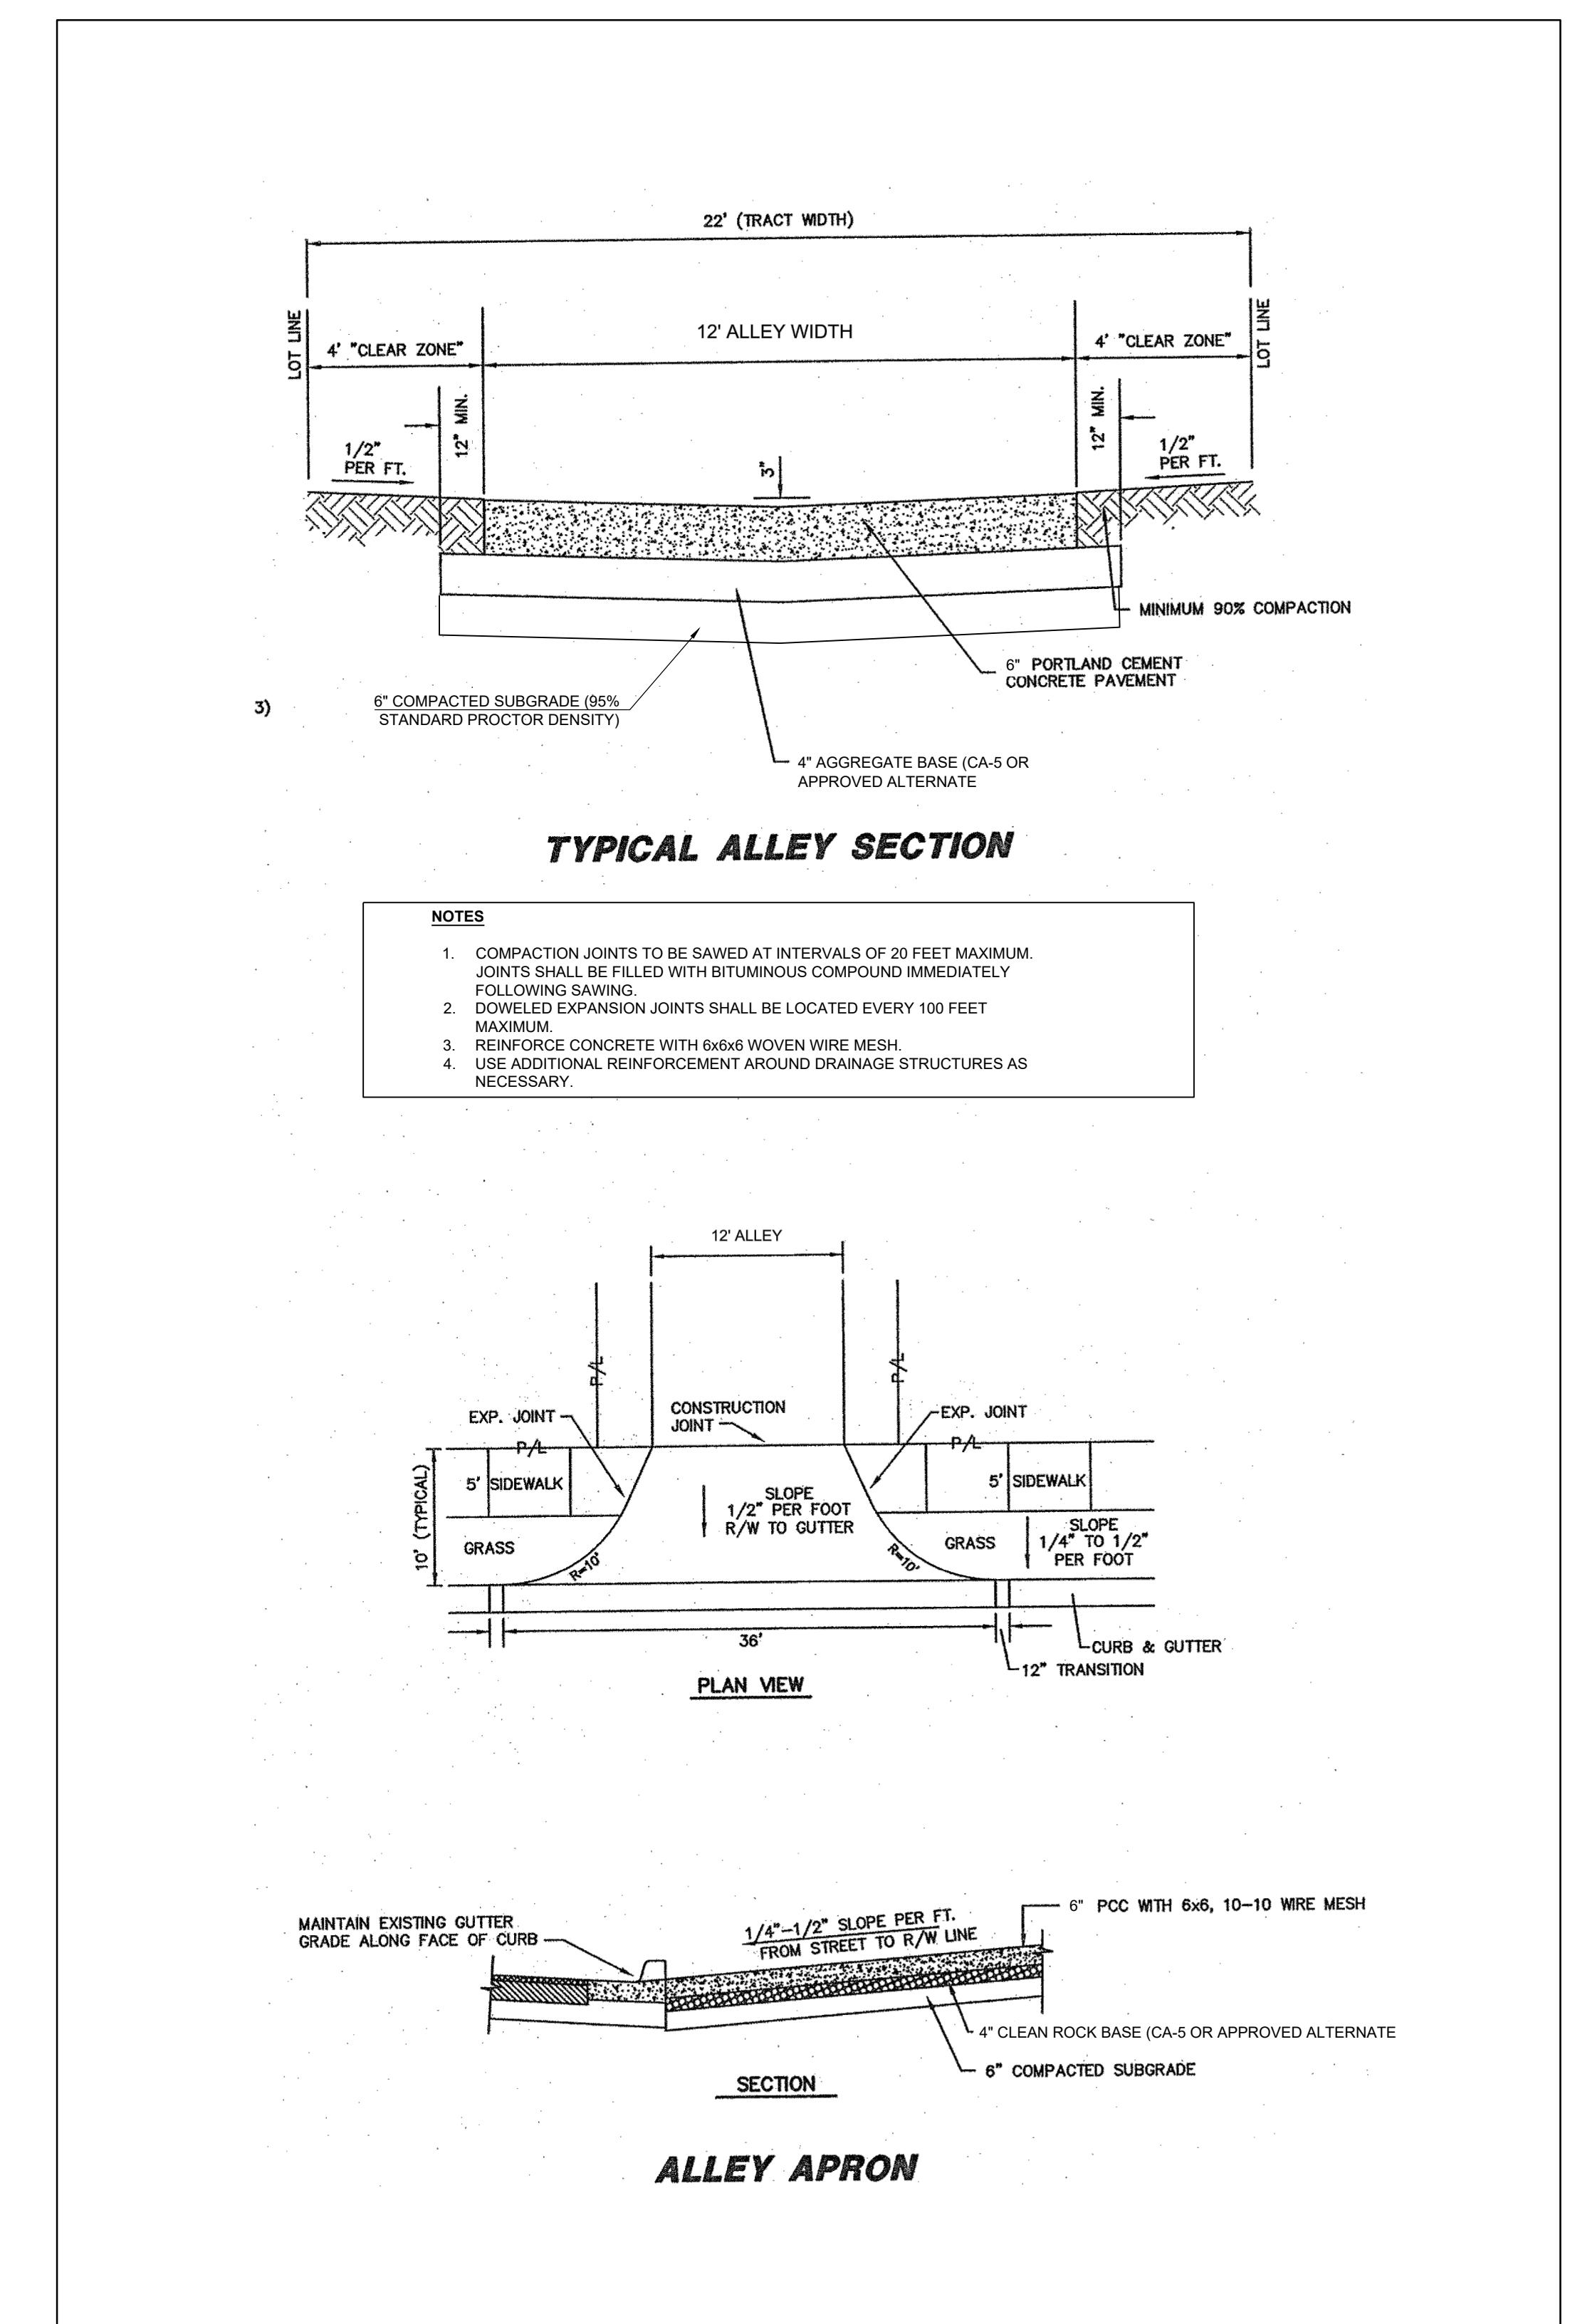

RECORD DRAWING

The information provided on this drawing conforms to construction records; it is not intended for construction, implementation or recording purposes; and it is solely based on information obtained by Schlagel and Associates.

"100.00 100.10", "1.00% 1.15% slope", or "8-inch HDPE PVC pipe" are all typical examples of revisions that indicate that design data has been replaced with "as-built" information. All other data is as designed and has not been field verified.

Date: 5/22/2023
Certified by: BAL
Title: Design Engineer
Firm: Schlagel and Associates, P.A.


Record Drawing

23

SCHLAGEL
ENGINEERS PLANNERS SURVEYORS LANDSCAPE ARCHITECTS
14920 West 107th Street • Lenexa Kansas 66215
(913) 492-5158 • Fax: (913) 492-2400
WWW.SCHLAGELASSOCIATES.COM
Master Certified Construction Professional of the Year
#E202003800-F BLACC201000237 MS202003859-F

PREPARED BY:
MARK ALLEN BREUER
JANNEKE PE-2035007208
06.09.2023
SCHLAGEL & ASSOCIATES, P.A.

**PERGOLA PARK 5TH PLAT
STREET, STORMWATER, MASTER DRAINAGE
PLAN & EROSION AND SEDIMENT CONTROL**
- LEE'S SUMMIT, MISSOURI

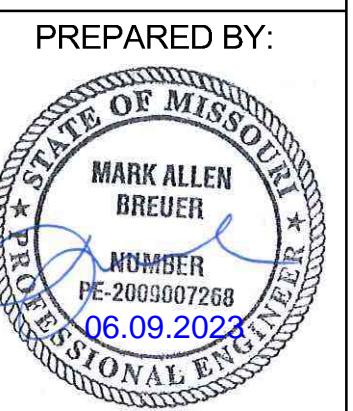





SCHLAGEL & ASSOCIATES, P.A.


PERGOLA PARK 5TH PLAT
STREET, STORMWATER, MASTER DRAINAGE
PLAN & EROSION AND SEDIMENT CONTROL

- LEE'S SUMMIT, MISSOURI

25

Record Drawing

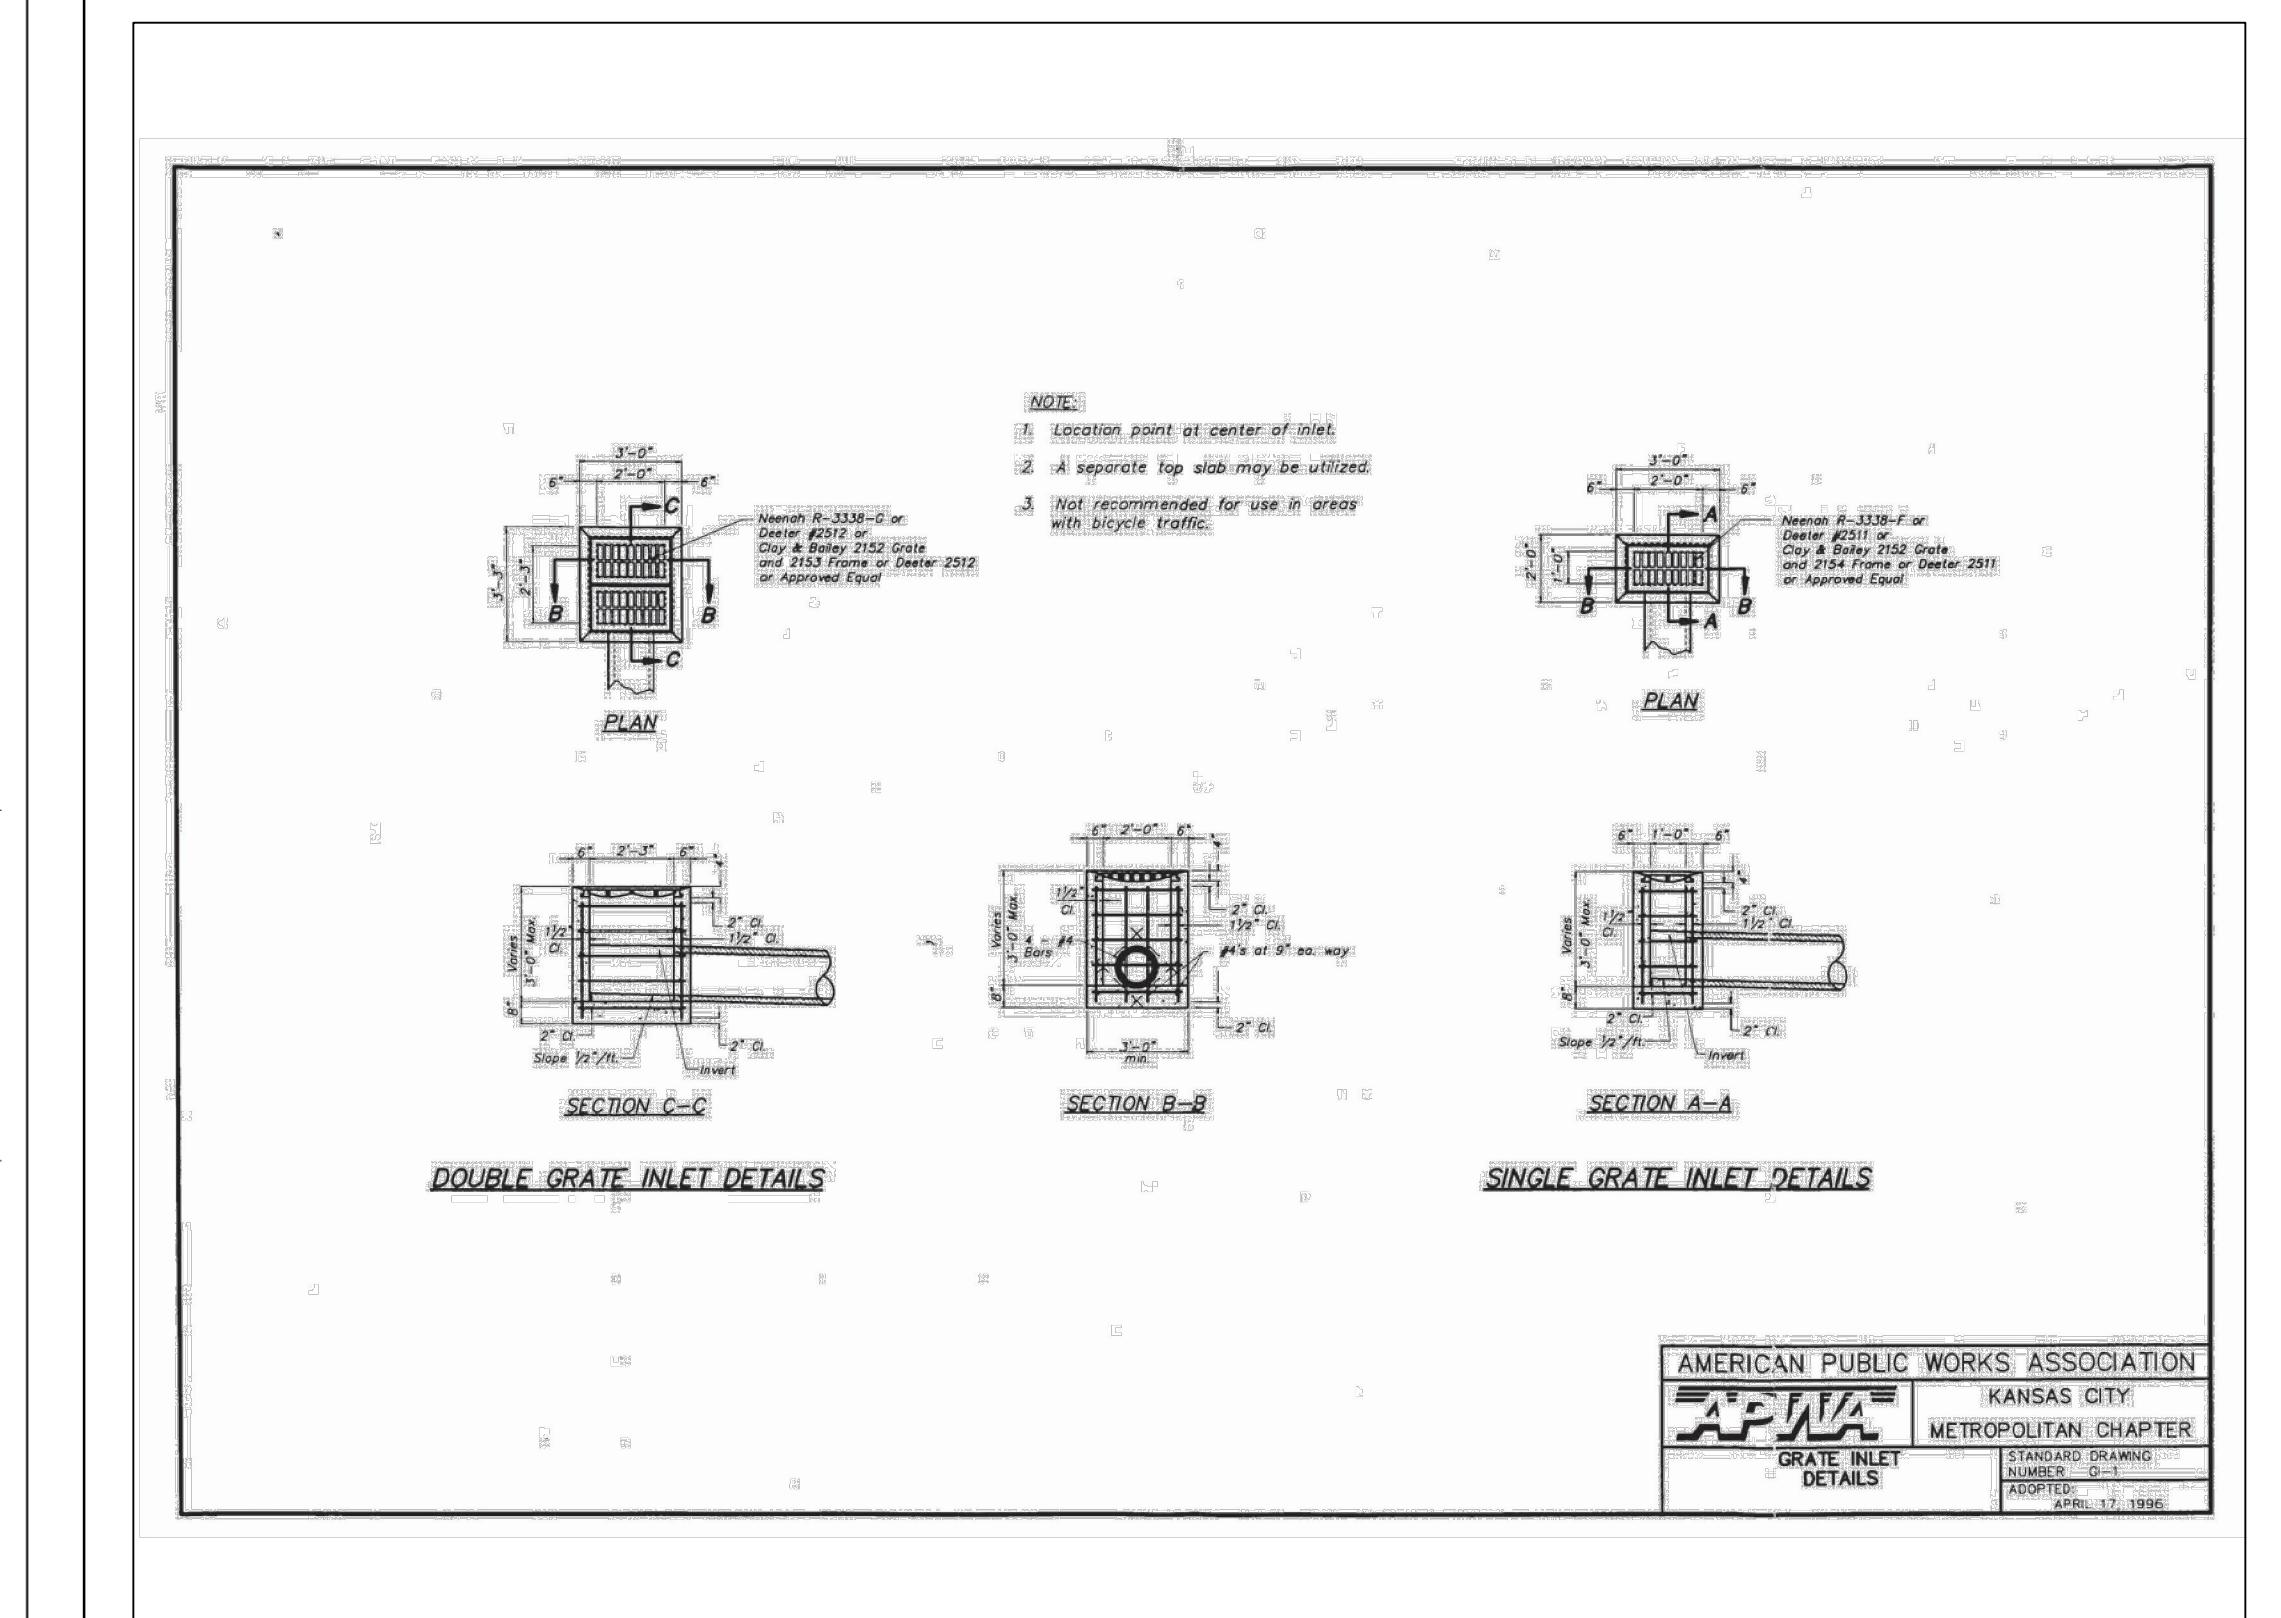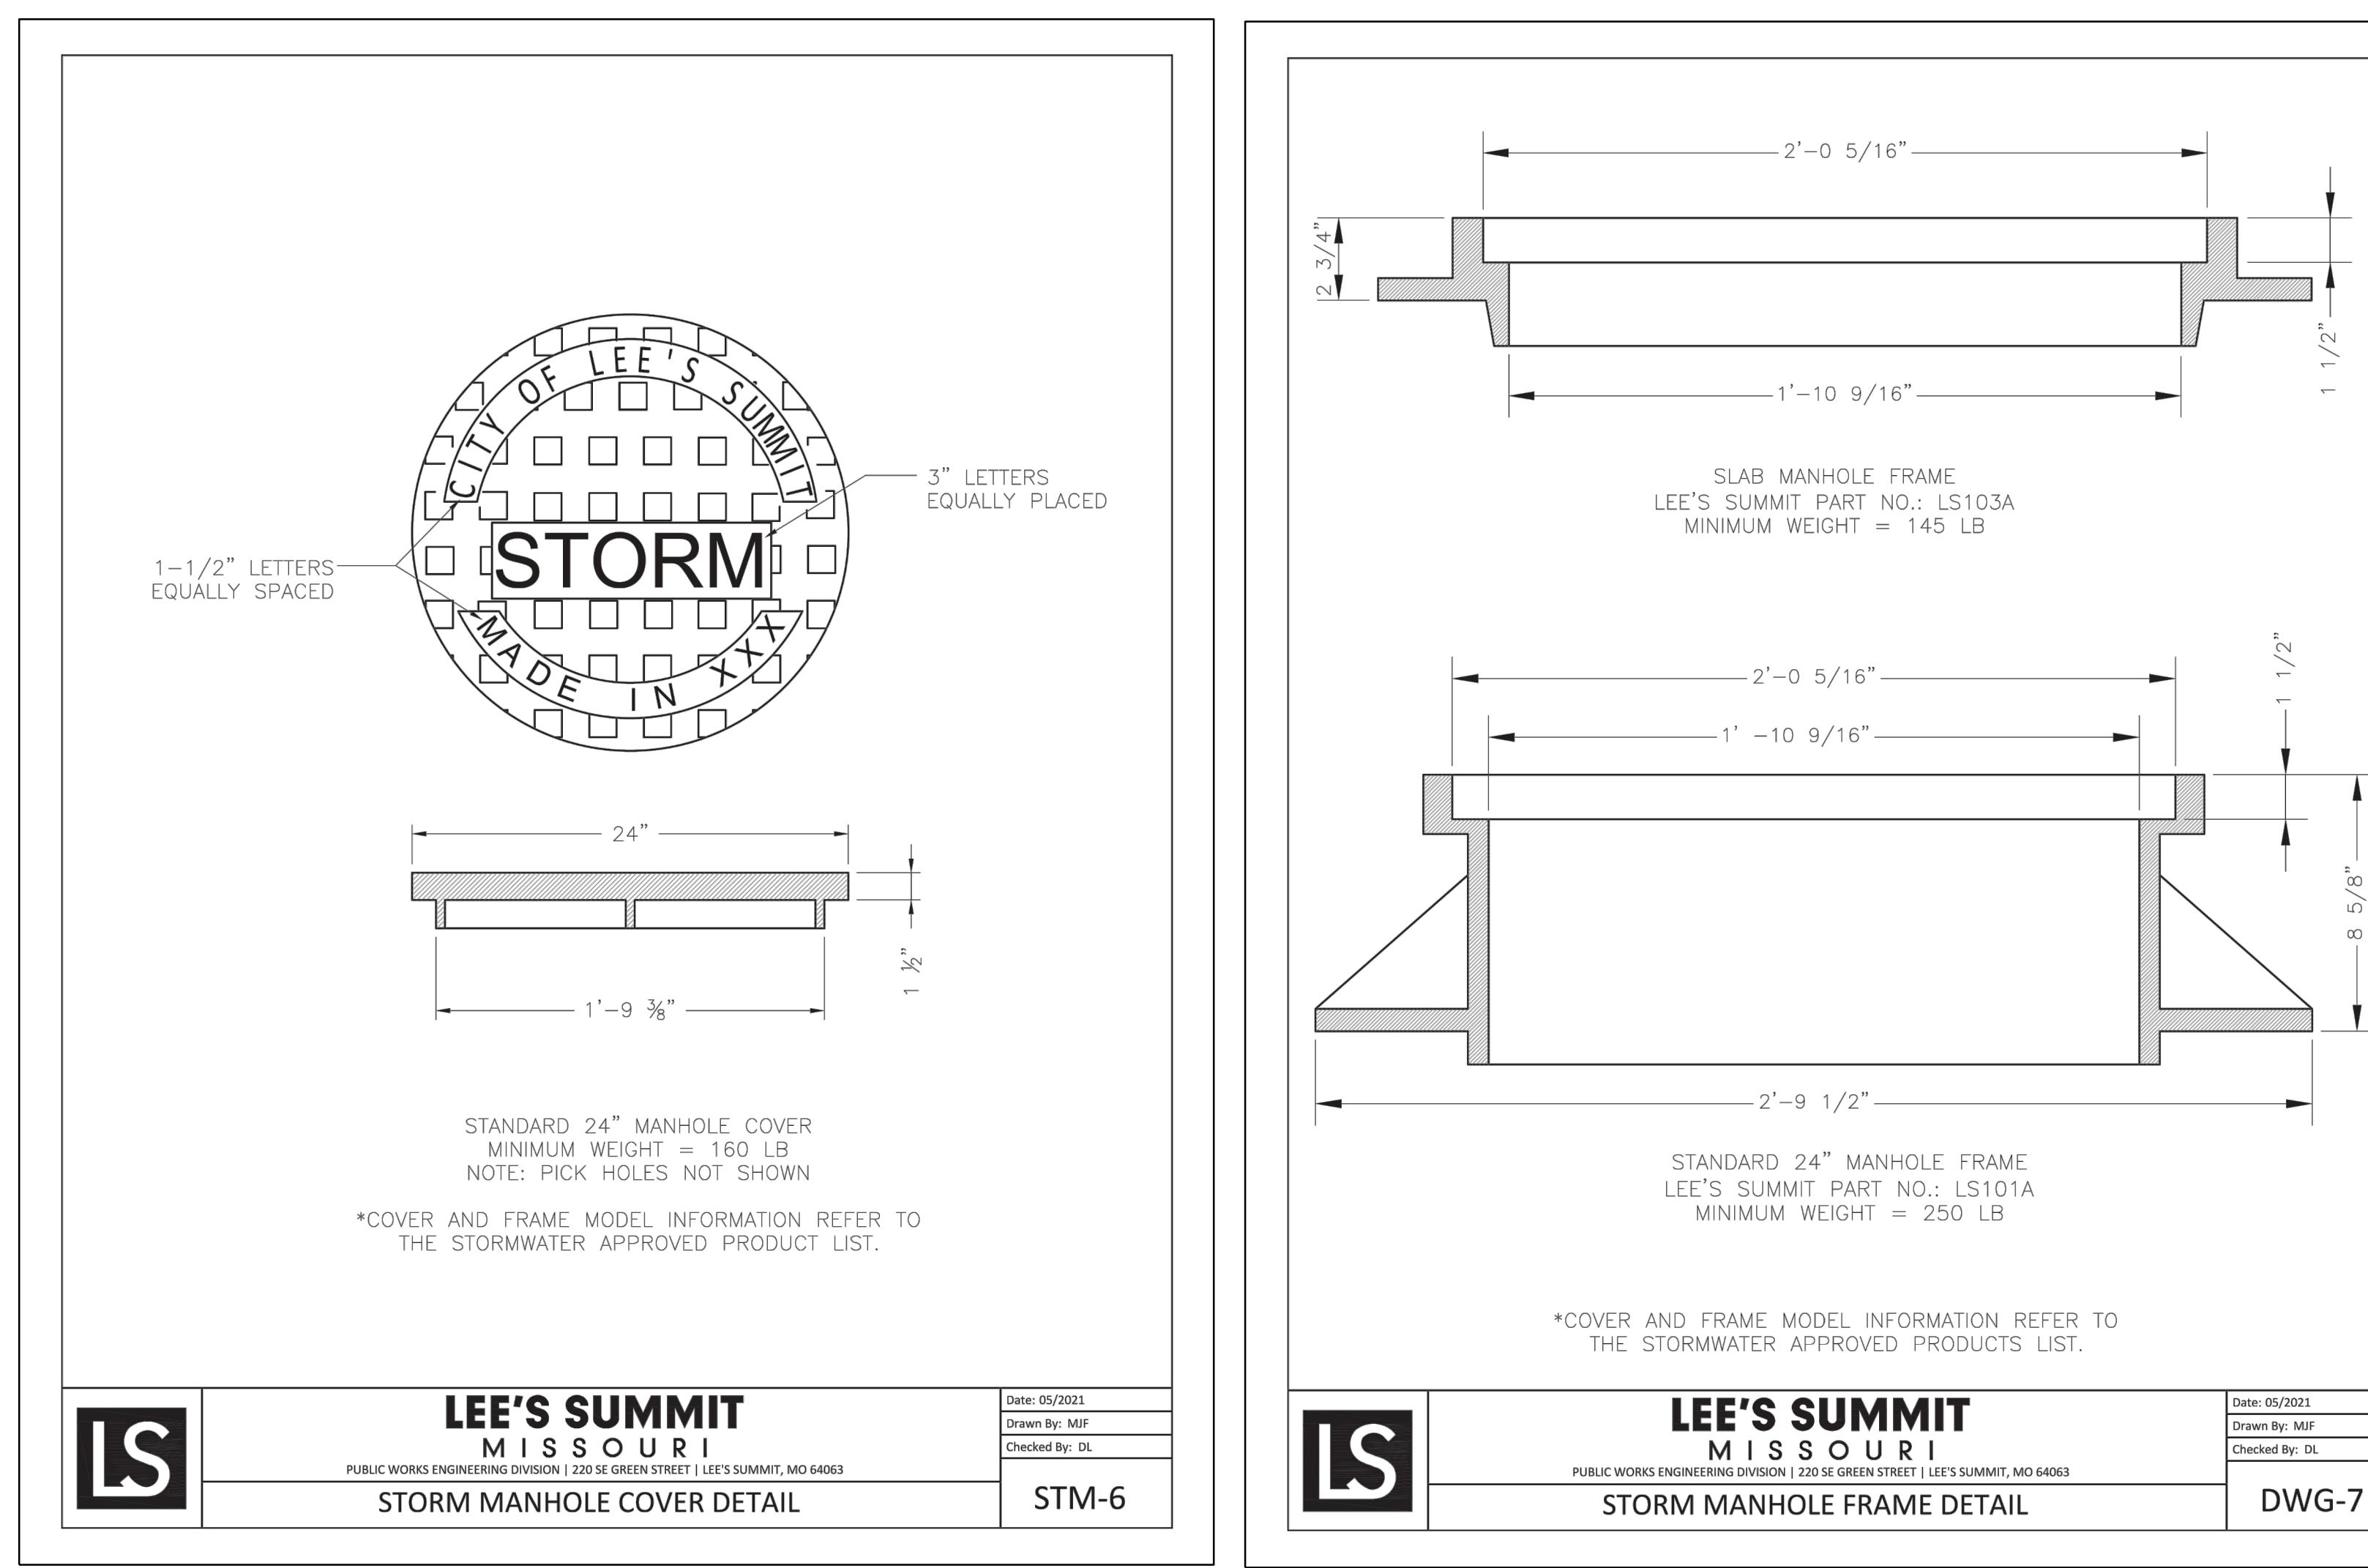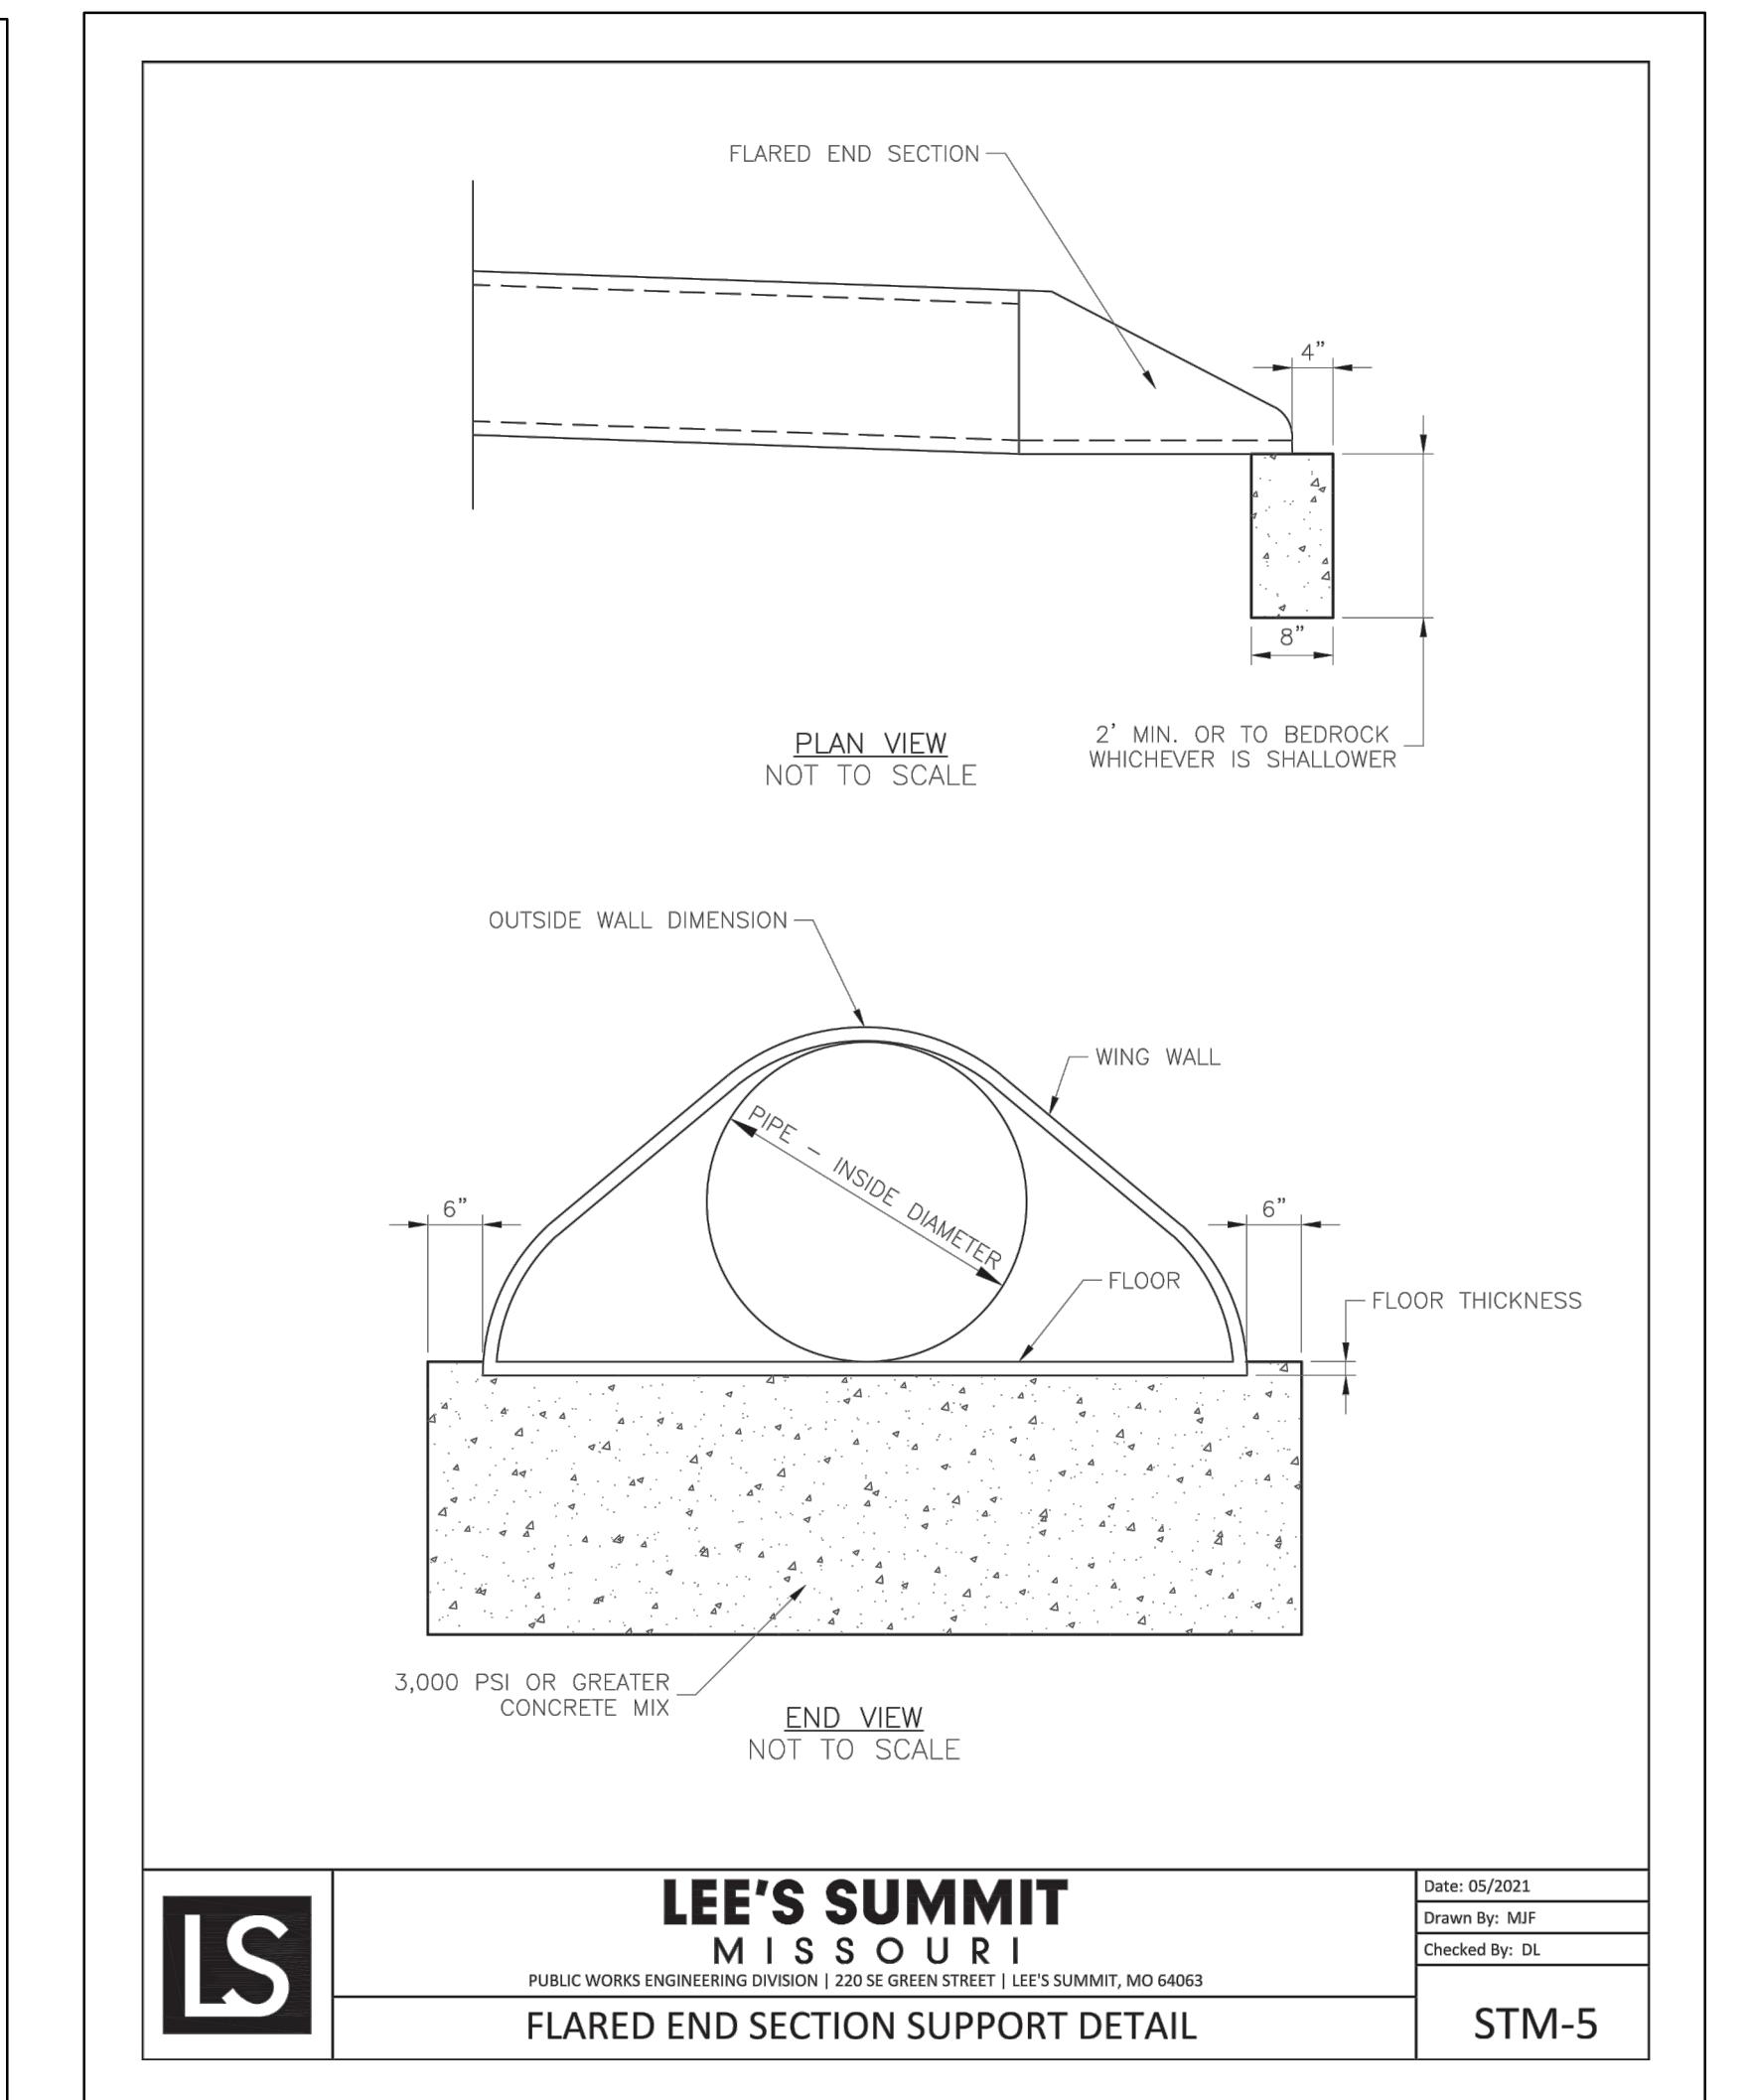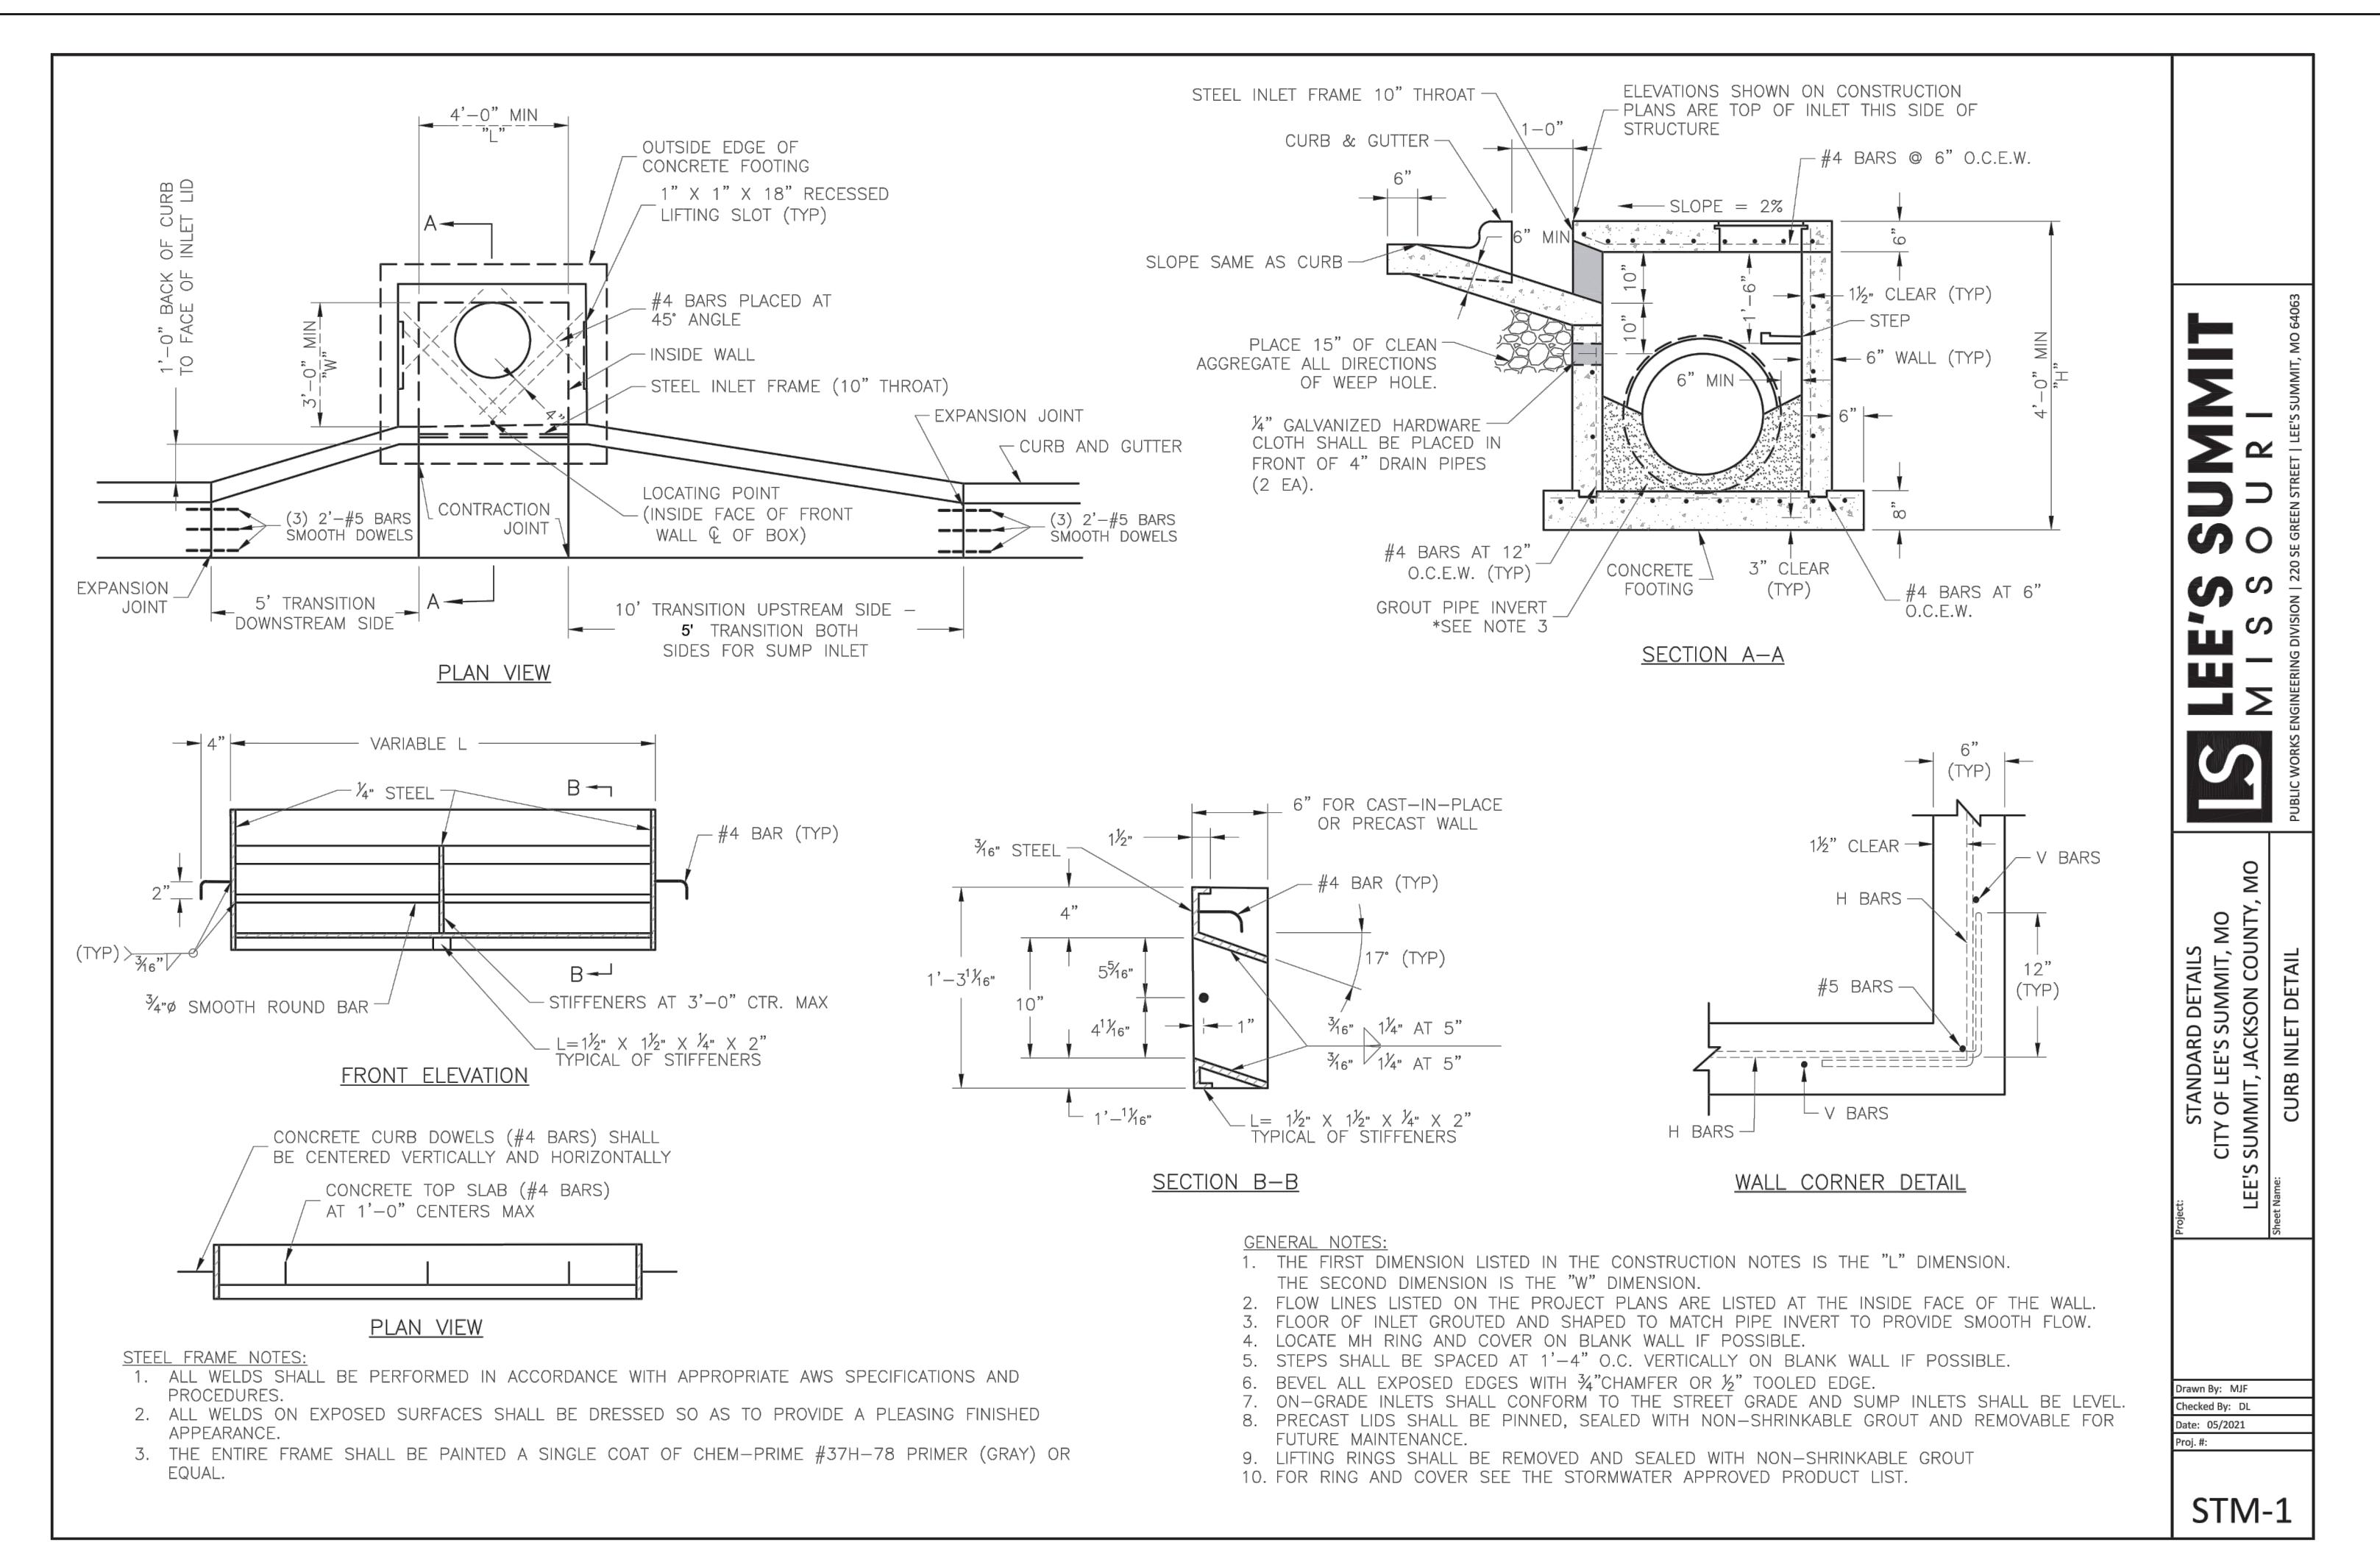

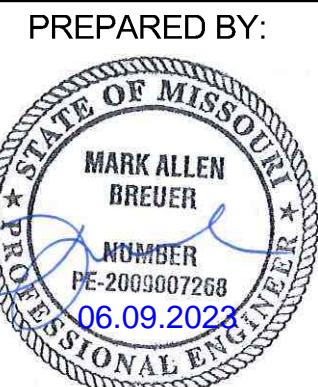

PREPARED BY:
MARK ALLEN BREUER
JANNEKA BREUER
PE-2035007268
06.09.2023

SCHLAGEL & ASSOCIATES, P.A.

**PERGOLA PARK 5TH PLAT
STREET, STORMWATER, MASTER DRAINAGE
PLAN & EROSION AND SEDIMENT CONTROL**
- LEE'S SUMMIT, MISSOURI


Record Drawing


RECORD DRAWING

The information provided on this drawing conforms to construction records; it is not intended for construction, implementation or recording purposes; and it is solely based on information obtained by Schlagel and Associates.

"100.00 100.10", "1.00% 1.15% slope", or "8-inch HDPE PVC pipe" are all typical examples of revisions that indicate that design data has been replaced with "as-built" information. All other data is as designed and has not been field verified.

Date: 5/22/2023
Certified by: BAL
Title: Design Engineer
Firm: Schlagel and Associates, P.A.

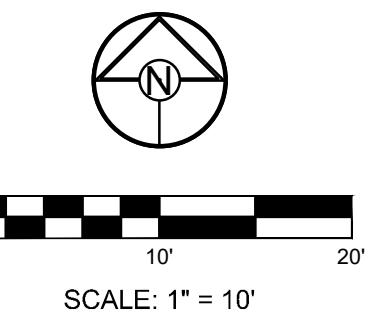

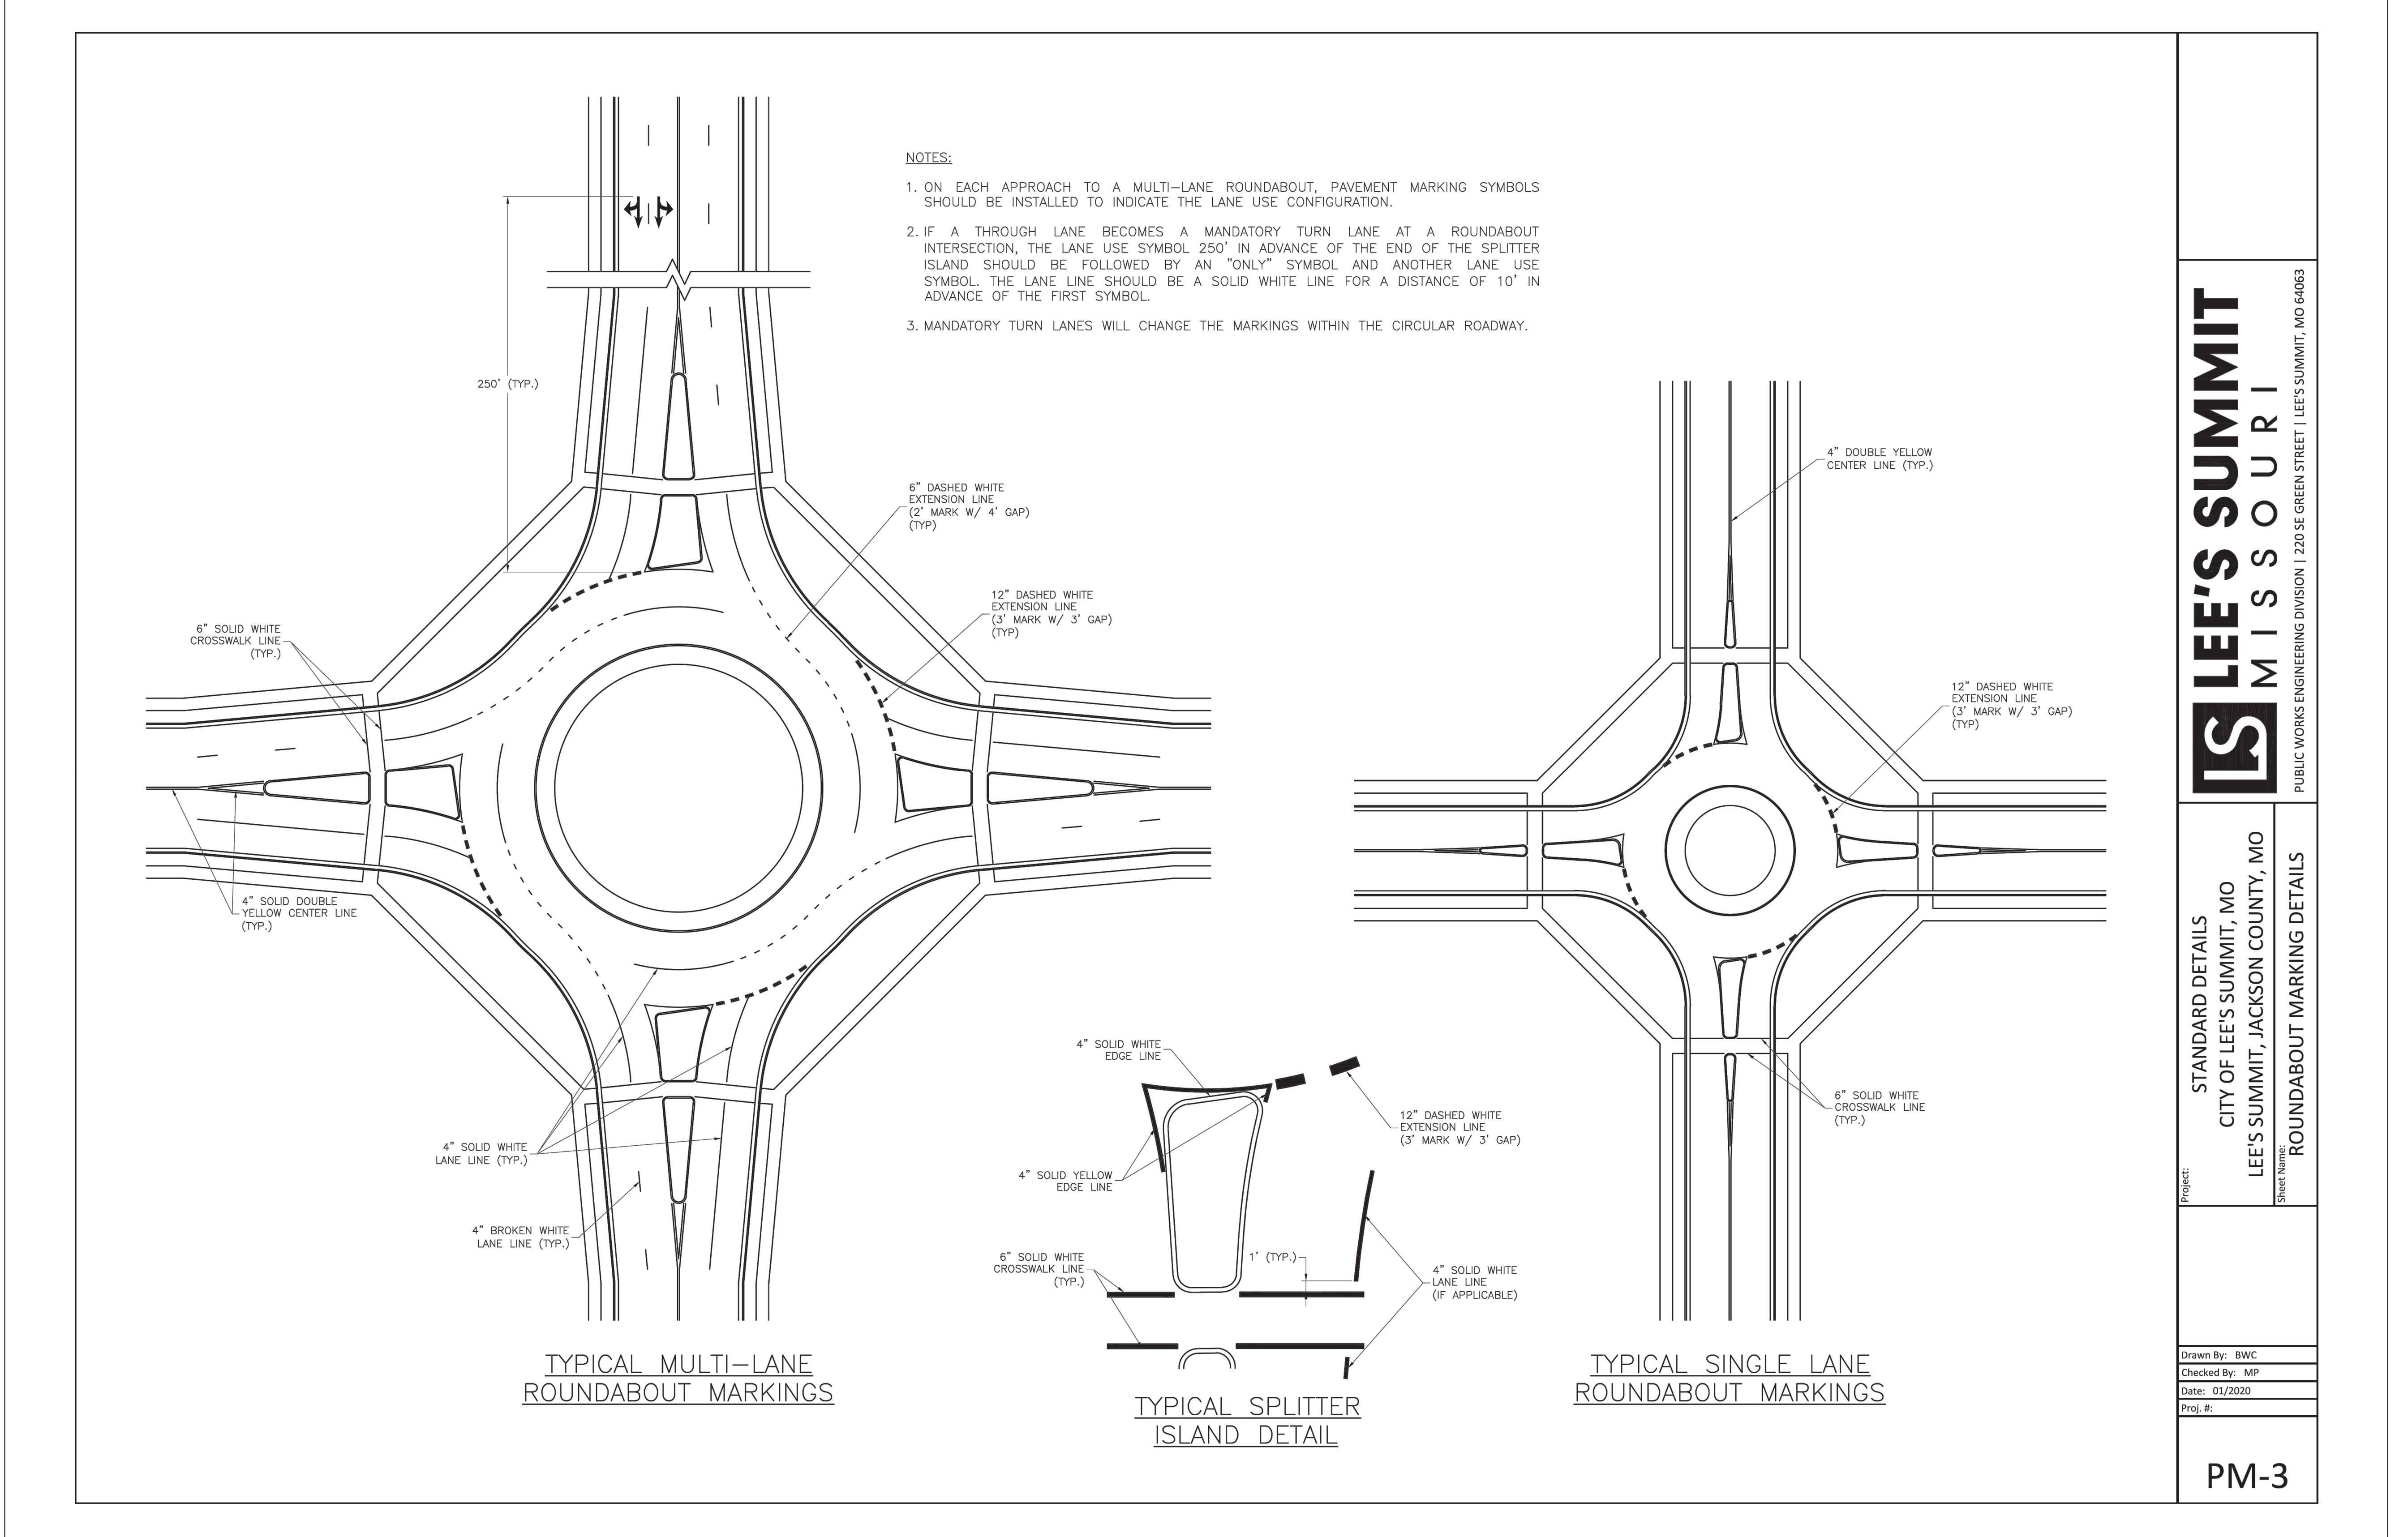

LEE'S SUMMIT MISSOURI	
PUBLIC WORKS ENGINEERING DIVISION 220 SE GREEN STREET LEE'S SUMMIT, MO 64063	
Project:	STANDARD DETAILS CITY OF LEE'S SUMMIT, MO LEE'S SUMMIT, JACKSON COUNTY, MO
Street Name:	ROUNDABOUT MARKING DETAILS
Drawn By:	BWC
Checked By:	MP
Date:	01/2020
Proj. #:	
PM-3	


RECORD DRAWING

The information provided on this drawing conforms to construction records; it is not intended for construction, implementation or recording purposes; and it is solely based on information obtained by Schlagel and Associates.

"100.00 100.10", "1.00% 1.15% slope", or "8-inch HDPE PVC pipe" are all typical examples of revisions that indicate that design data has been replaced with "as-built" information. All other data is as designed and has not been field verified.

Date: 5/22/2023
Certified by: BAL
Title: Design Engineer
Firm: Schlagel and Associates, P.A.

Record Drawing

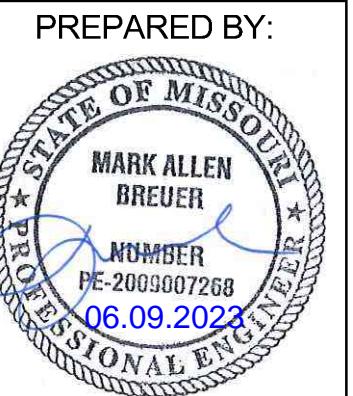

PREPARED BY:
 MARK ALLEN BREUER
 PE-2005007268
 06.09.2023

SCHLAGEL & ASSOCIATES, P.A.



**PERGOLA PARK 5TH PLAT
 STREET, STORMWATER, MASTER DRAINAGE
 PLAN & EROSION AND SEDIMENT CONTROL
 - LEE'S SUMMIT, MISSOURI**

RECORD DRAWING

The information provided on this drawing conforms to construction records; it is not intended for construction, implementation or recording purposes; and it is solely based on information obtained by Schlagel and Associates.

"100.00 100.10", "1.00% 1.15% slope", or "8-inch HDPE PVC pipe" are all typical examples of revisions that indicate that design data has been replaced with "as-built" information. All other data is as designed and has not been field verified.

Date: 5/22/2023
 Certified by: BAL
 Title: Design Engineer
 Firm: Schlagel and Associates, P.A.



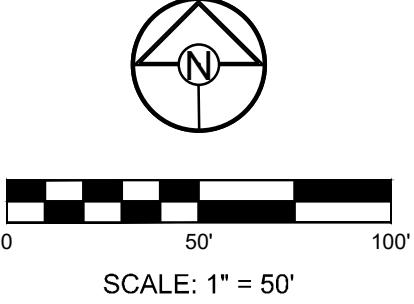
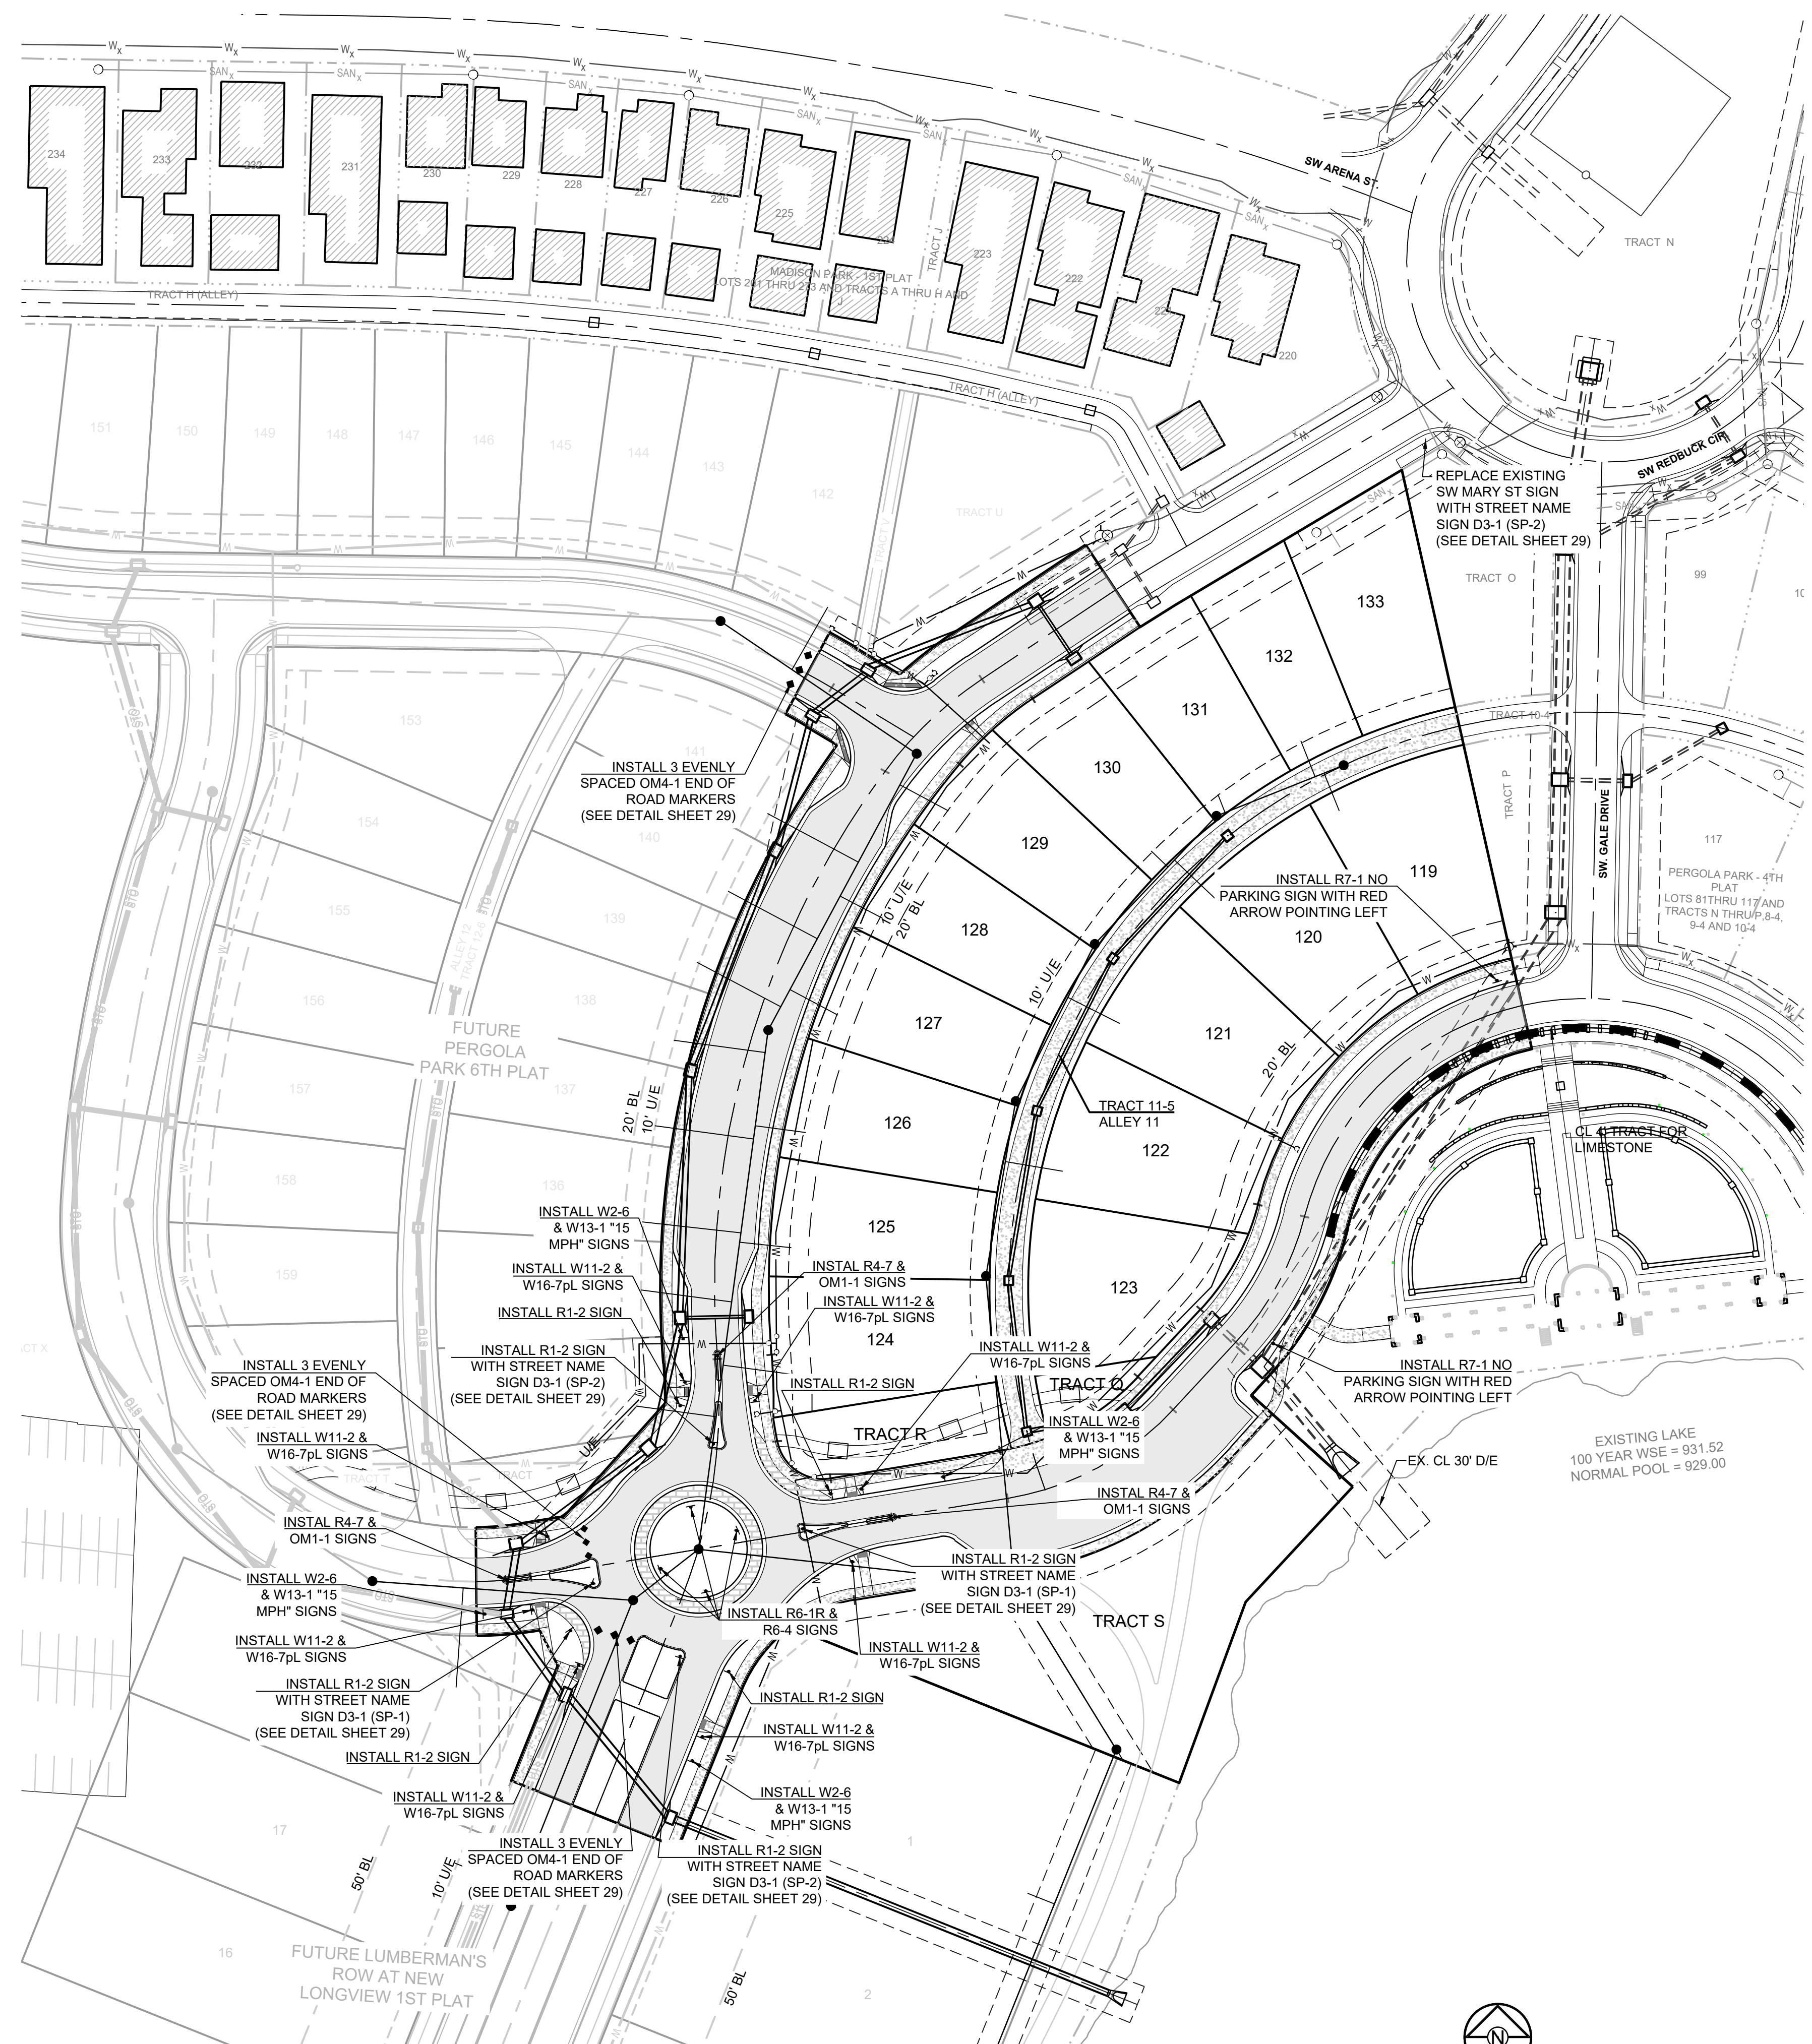


Record Drawing

PREPARED BY:
MARK ALLEN BREUER
JANUARY 06.09.2023
PE-20G007208

SCHLAGEL & ASSOCIATES, P.A.

PERGOLA PARK 5TH PLAT STREET, STORMWATER, MASTER DRAINAGE PLAN & EROSION AND SEDIMENT CONTROL - LEE'S SUMMIT, MISSOURI

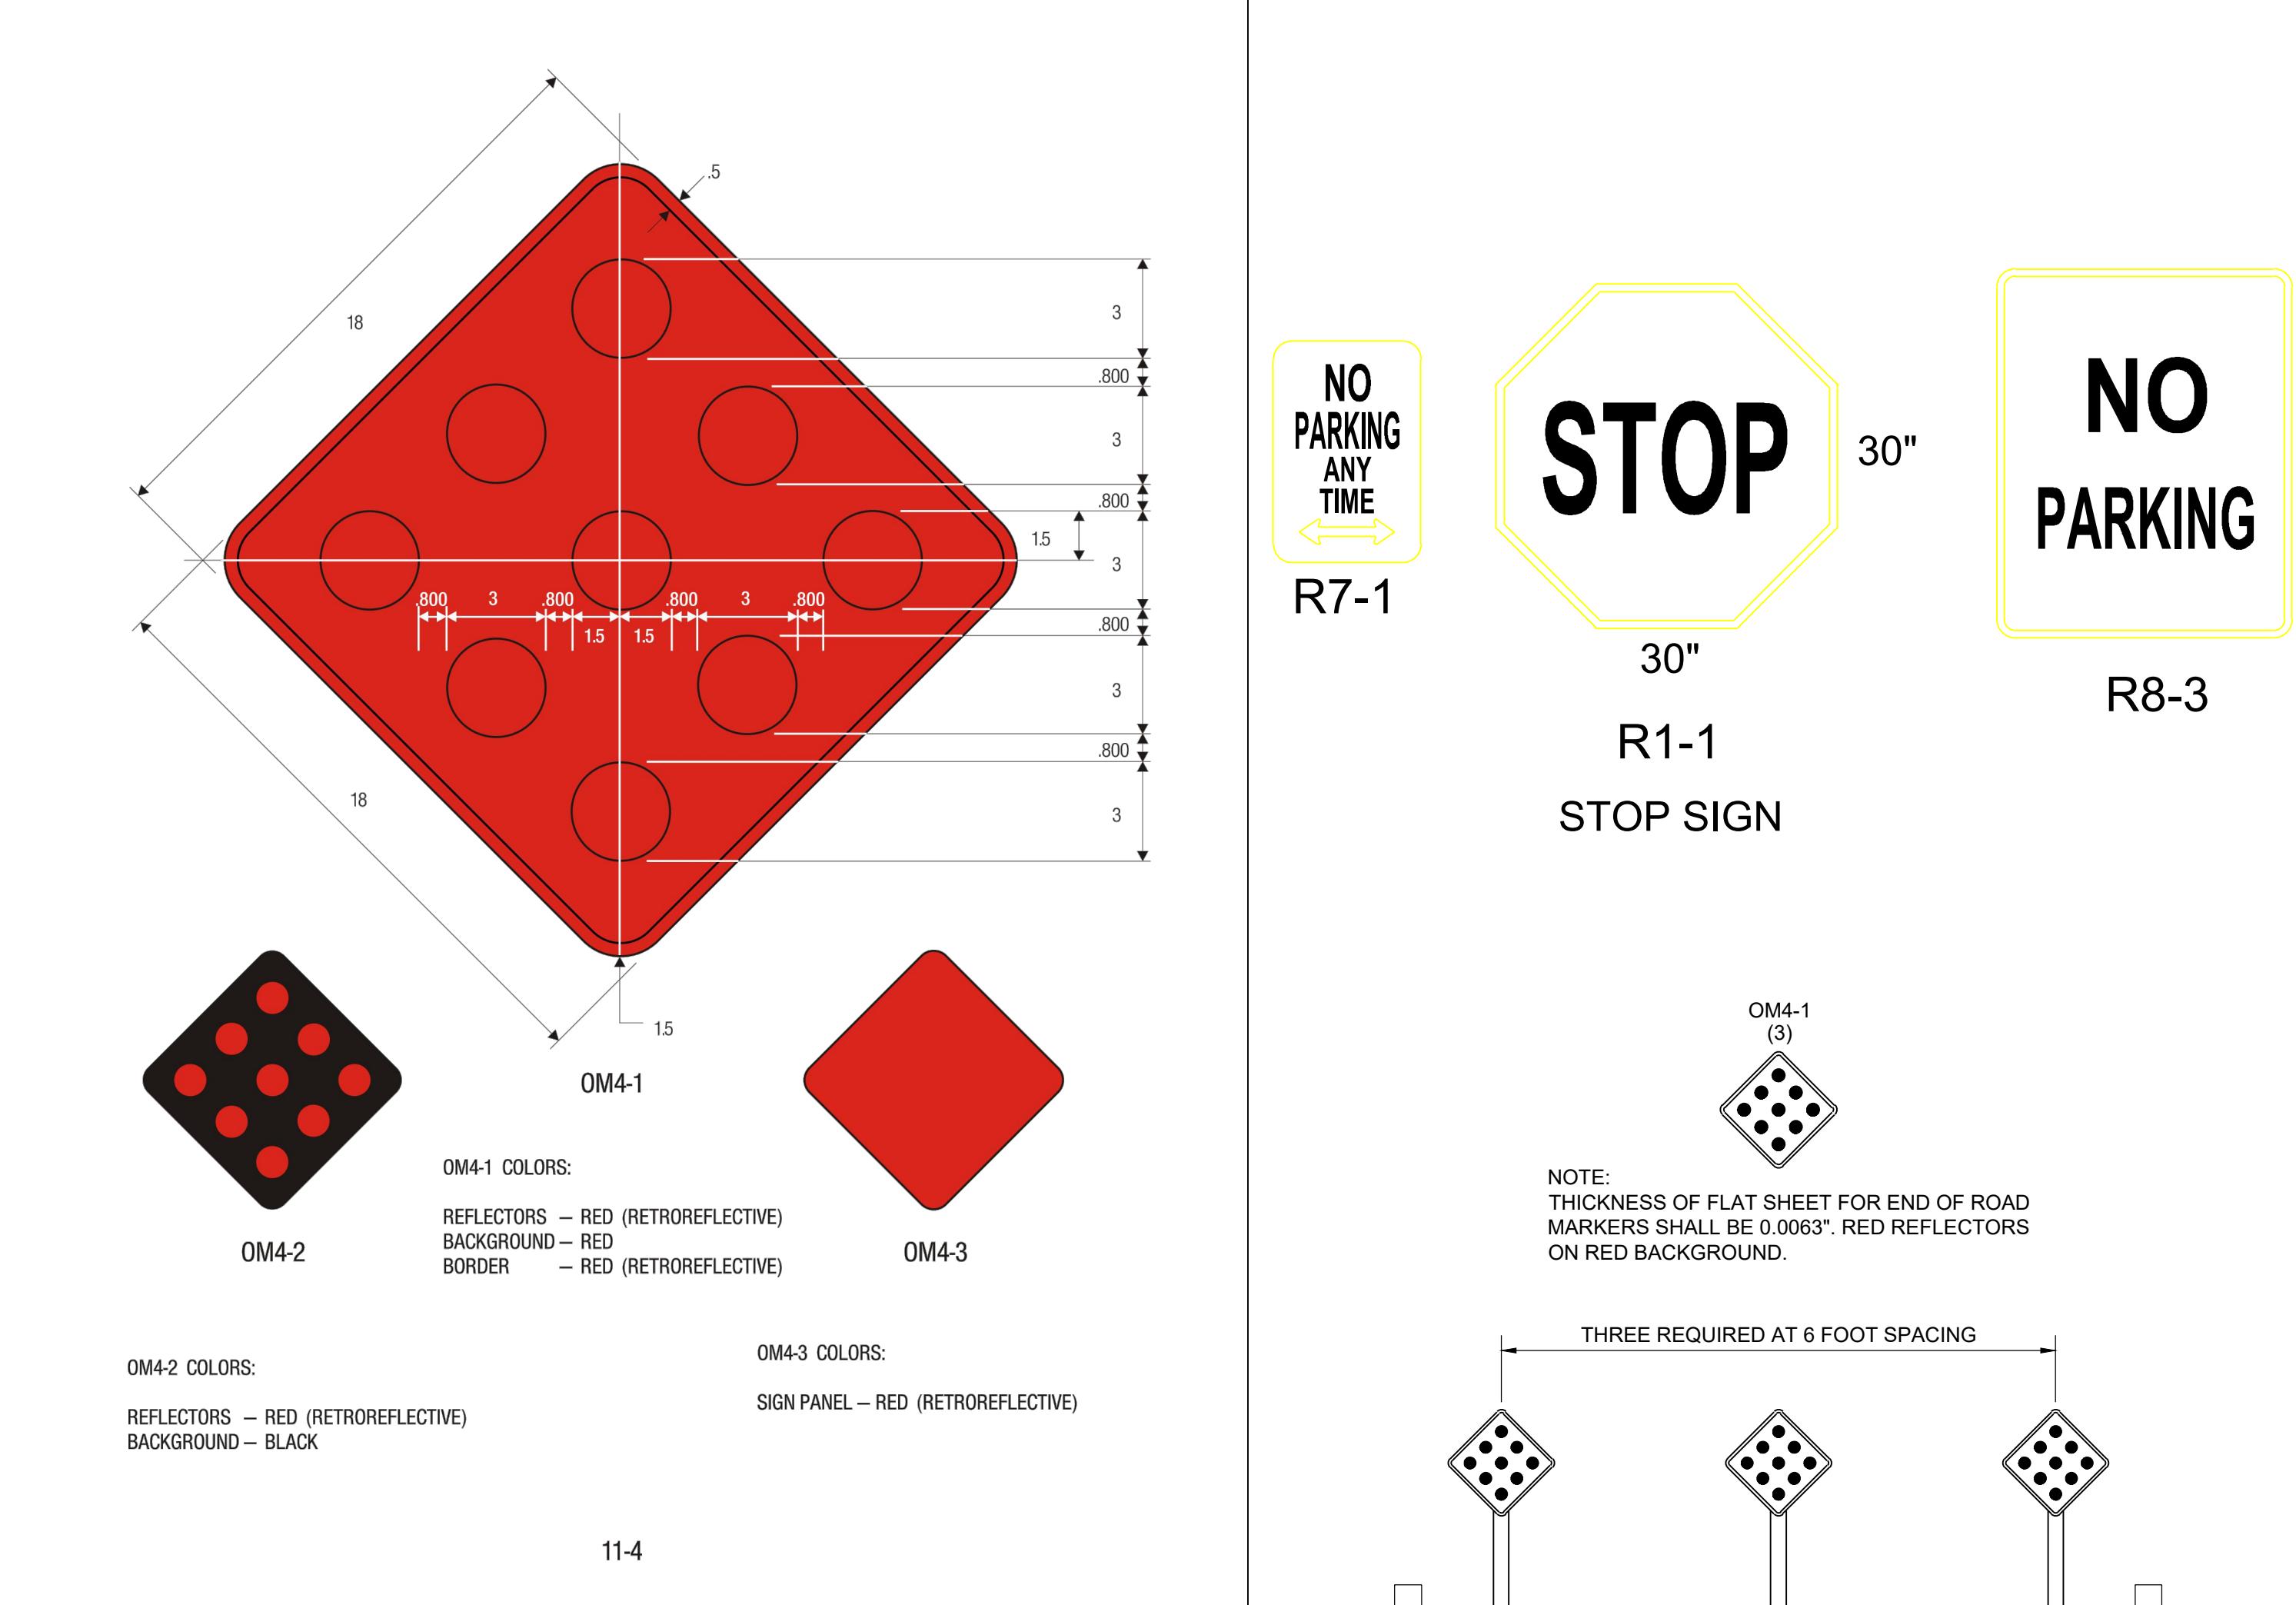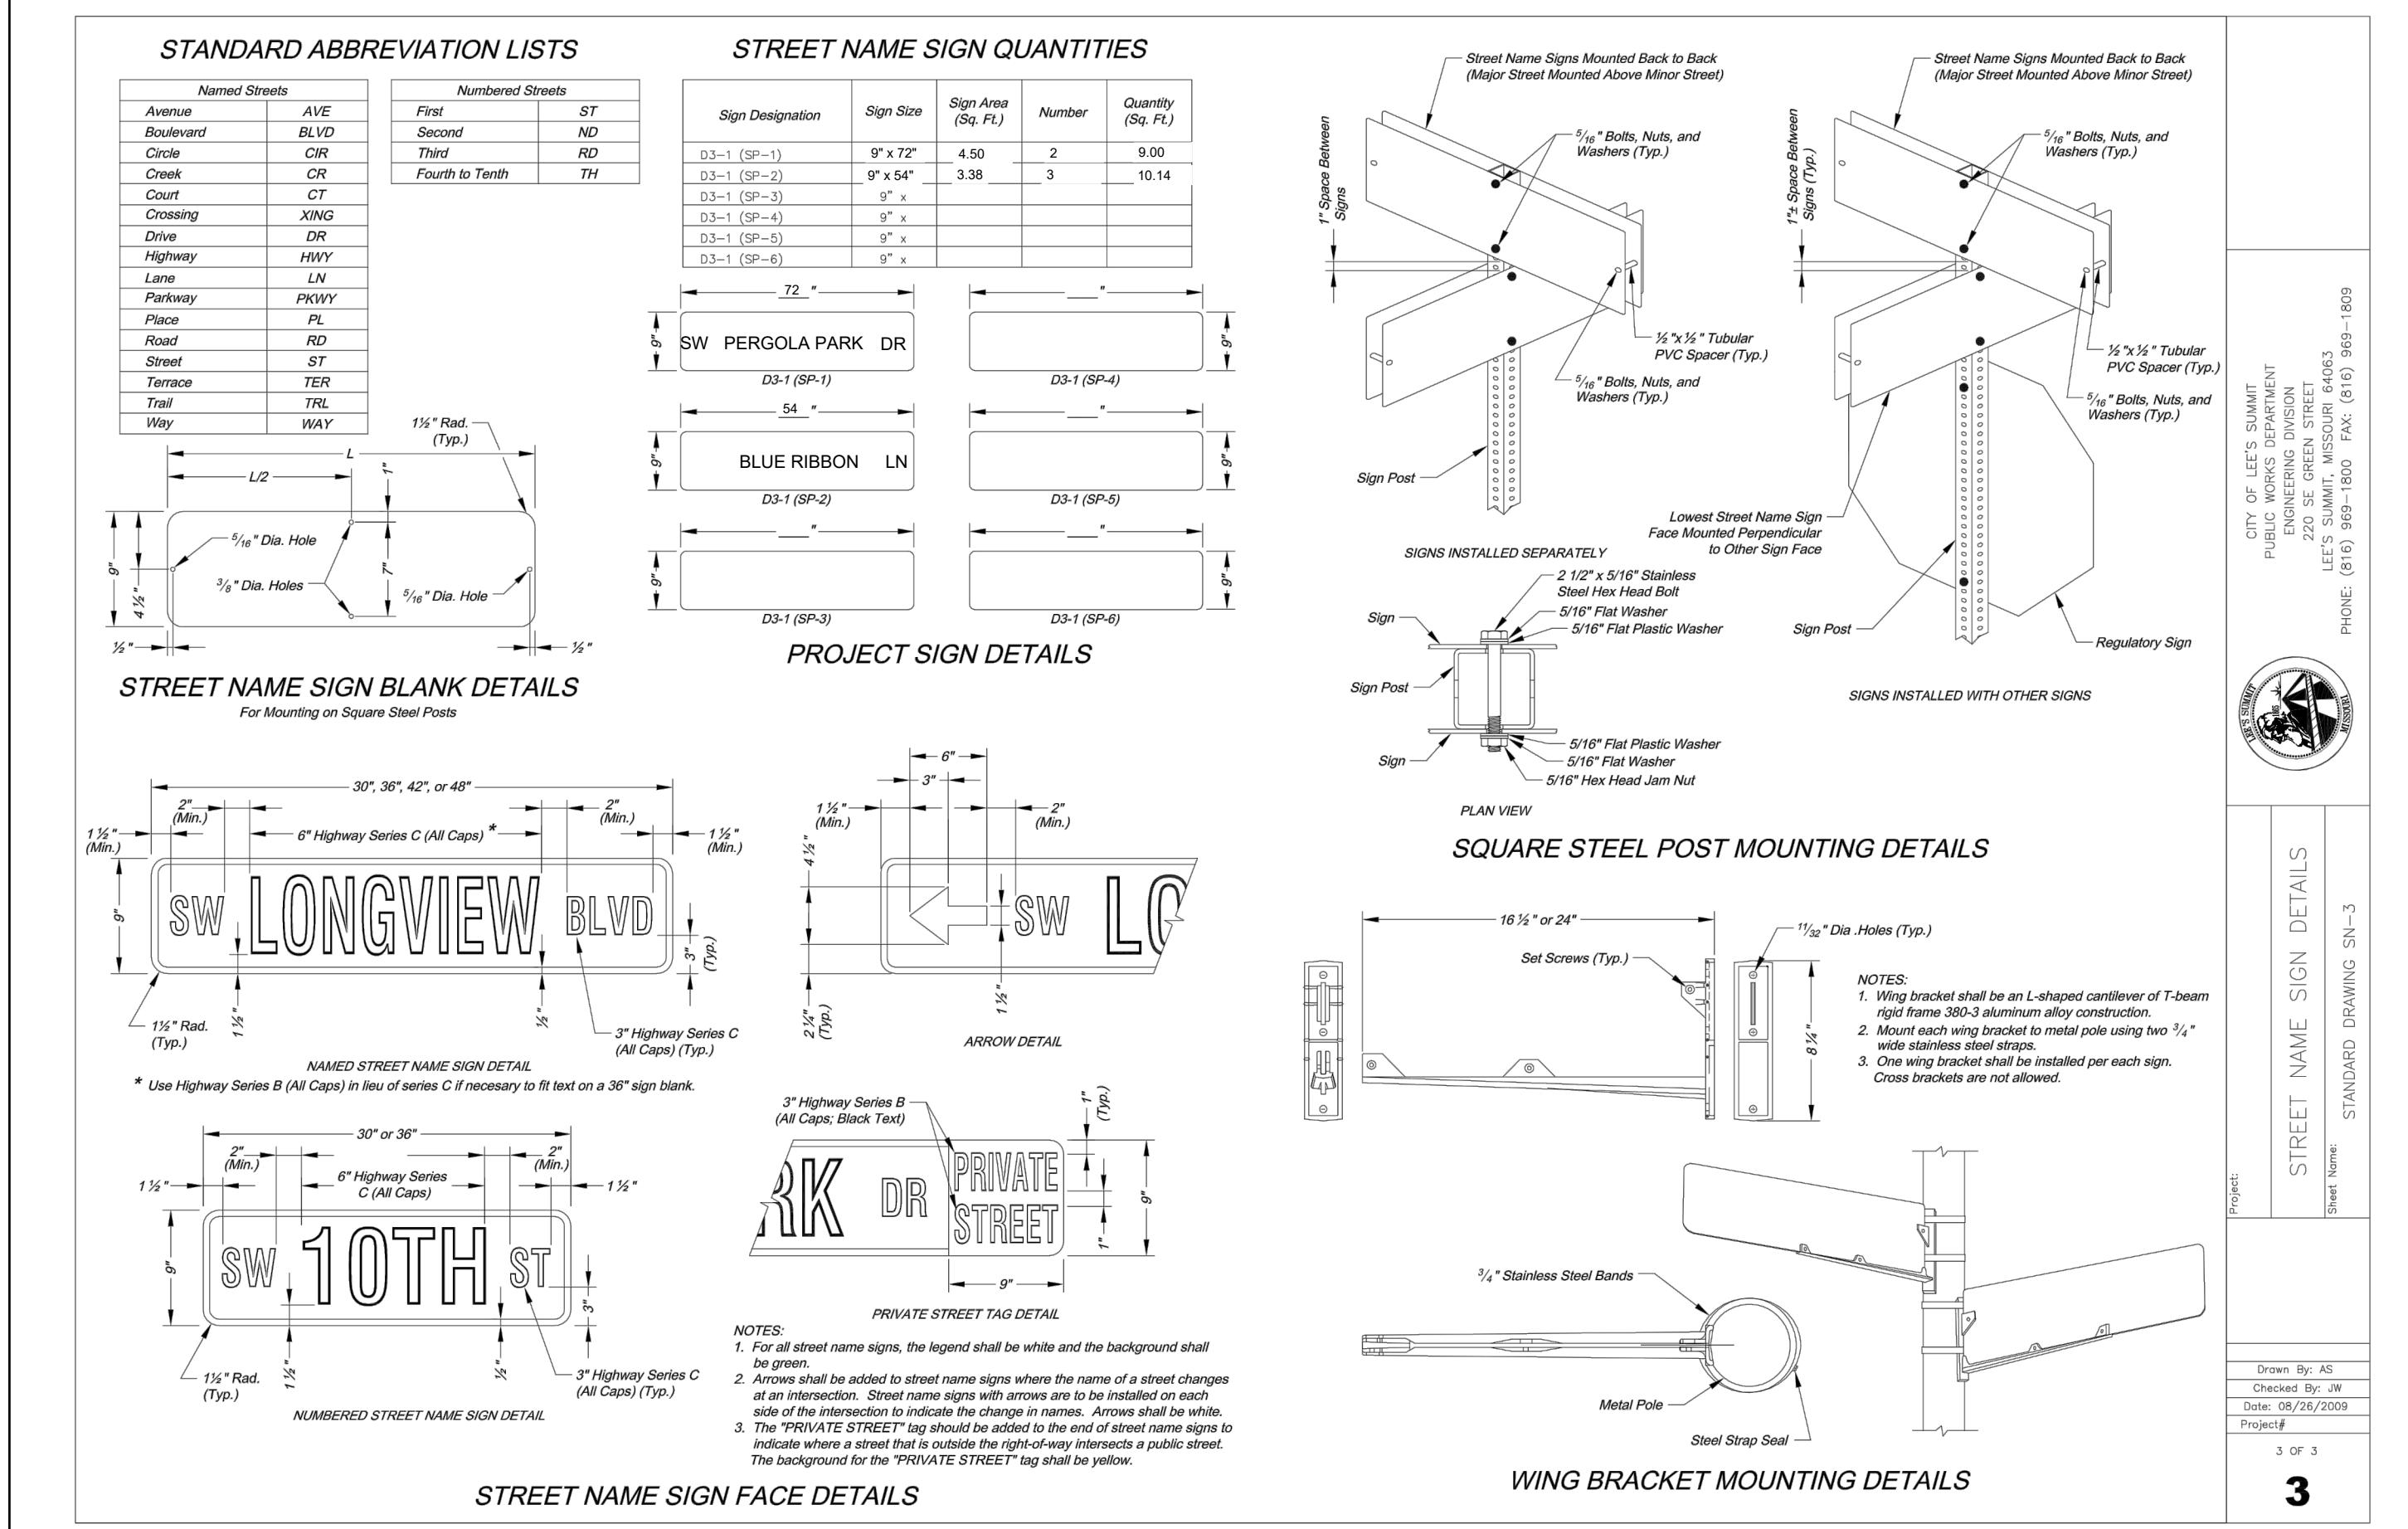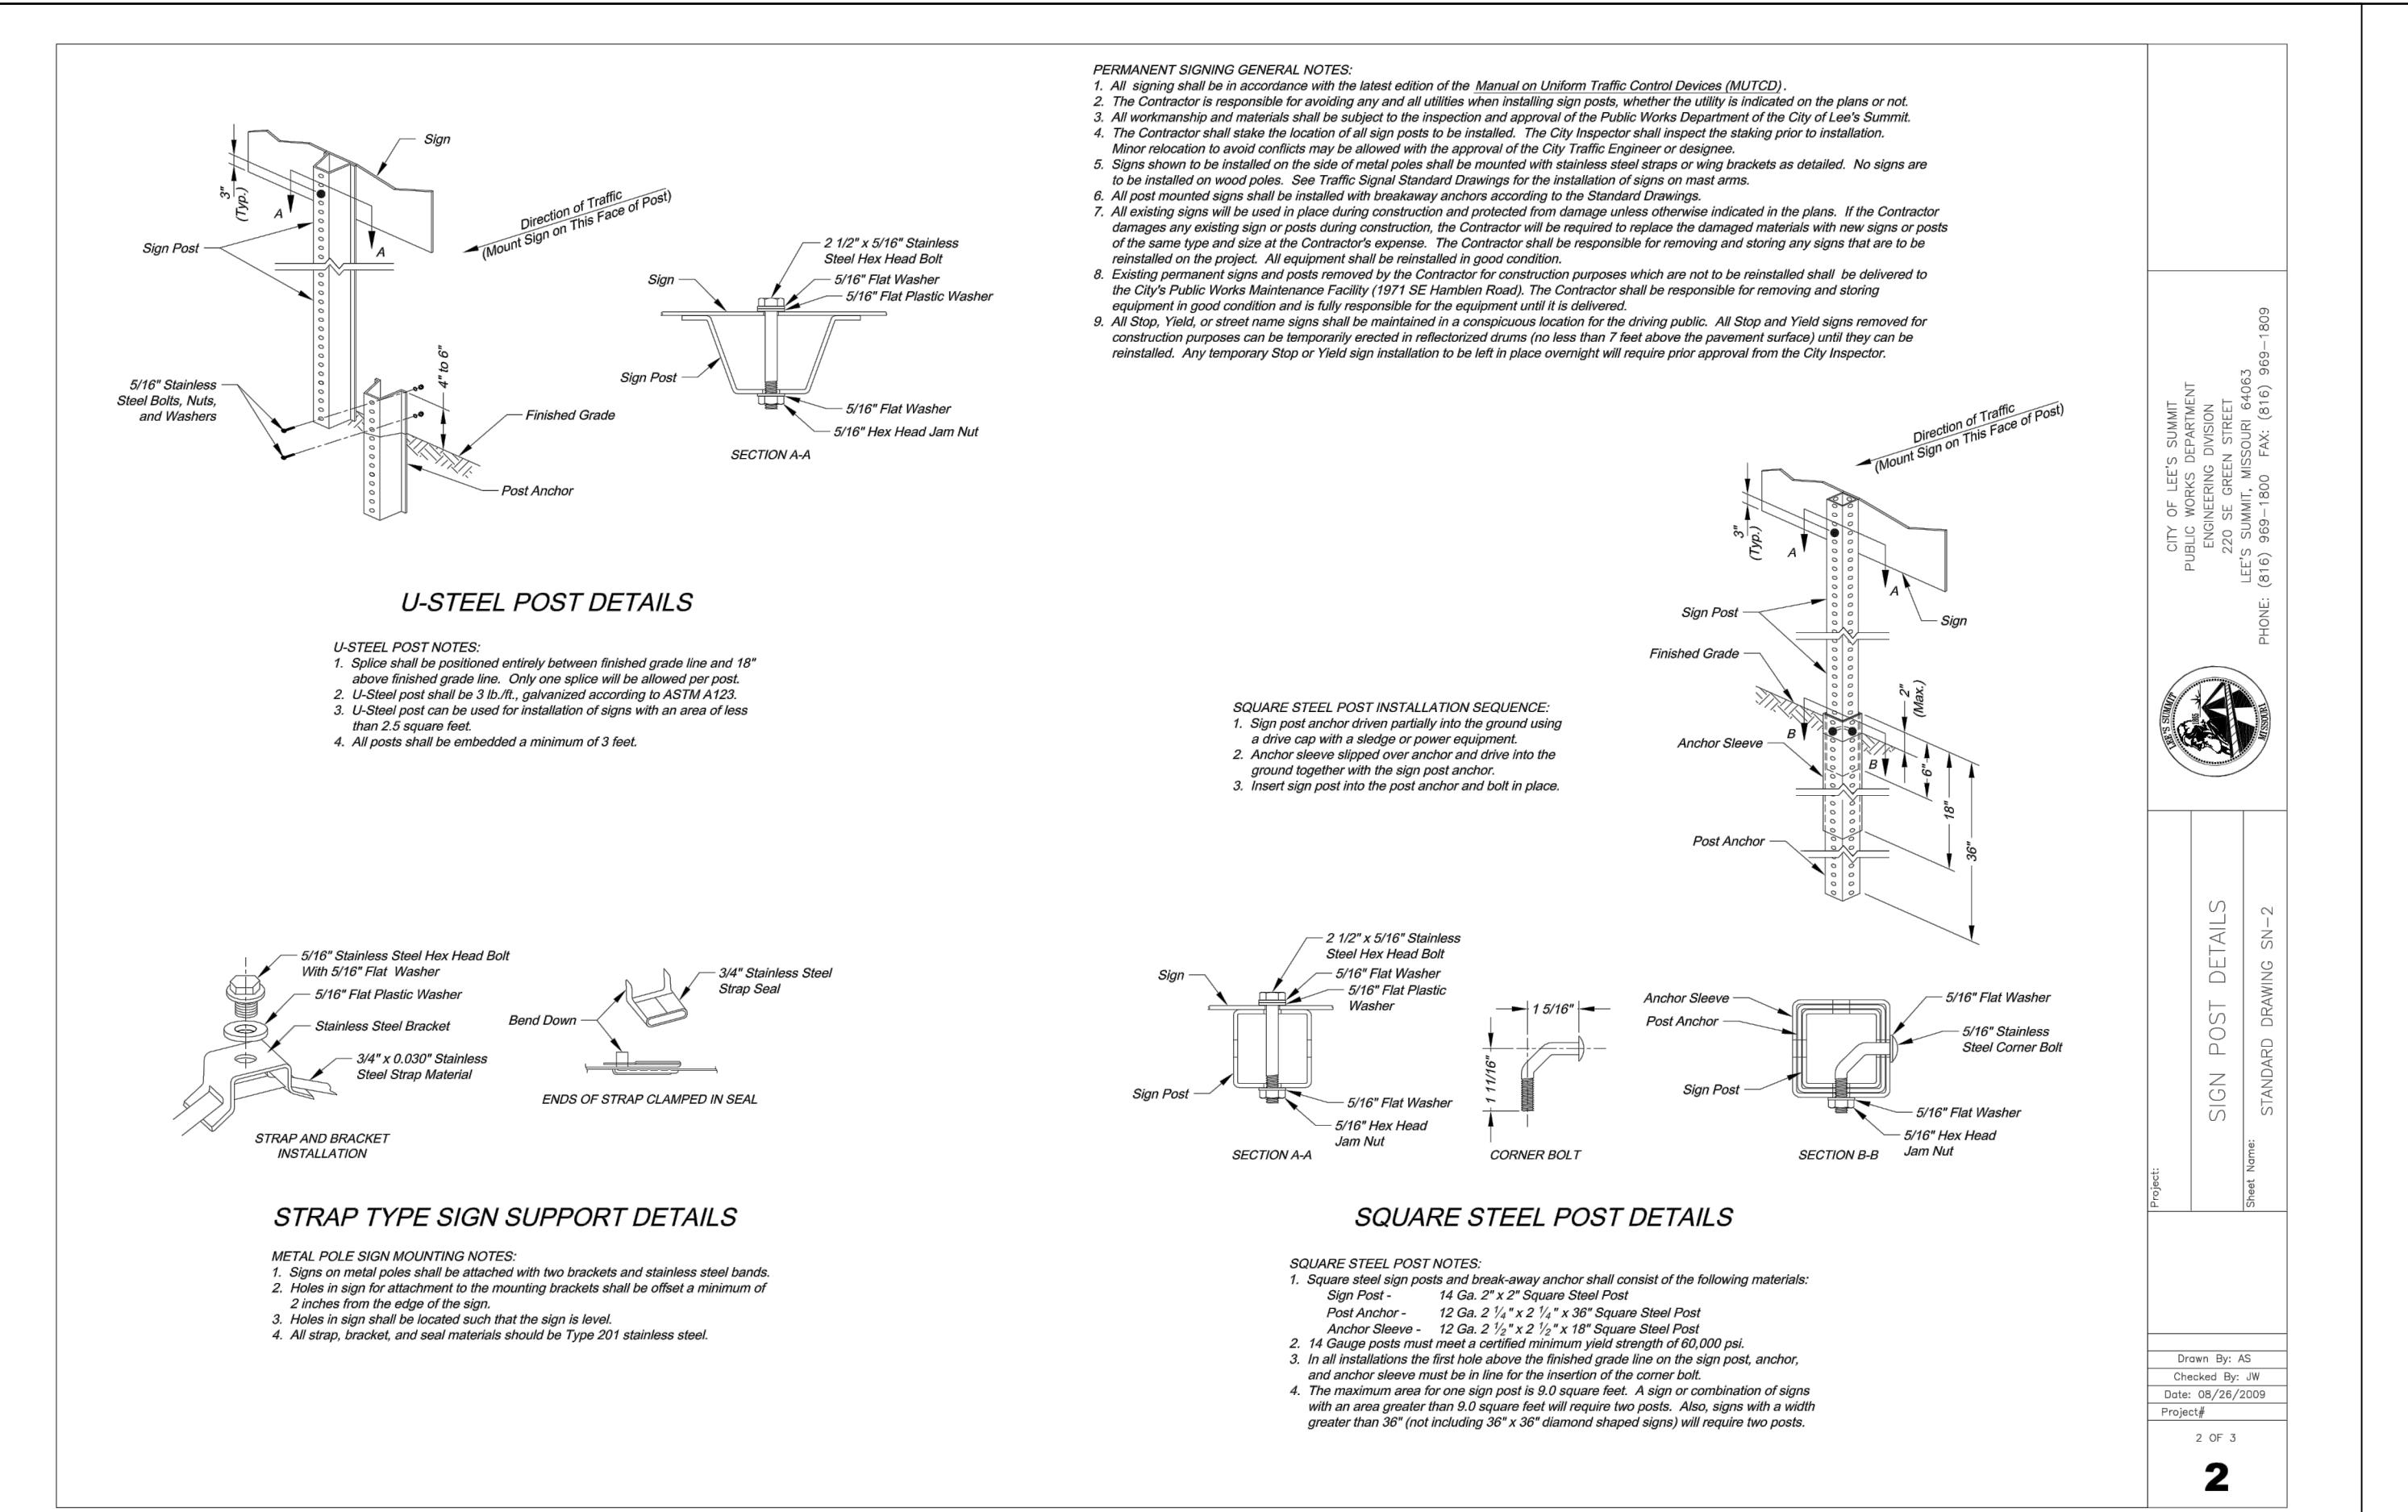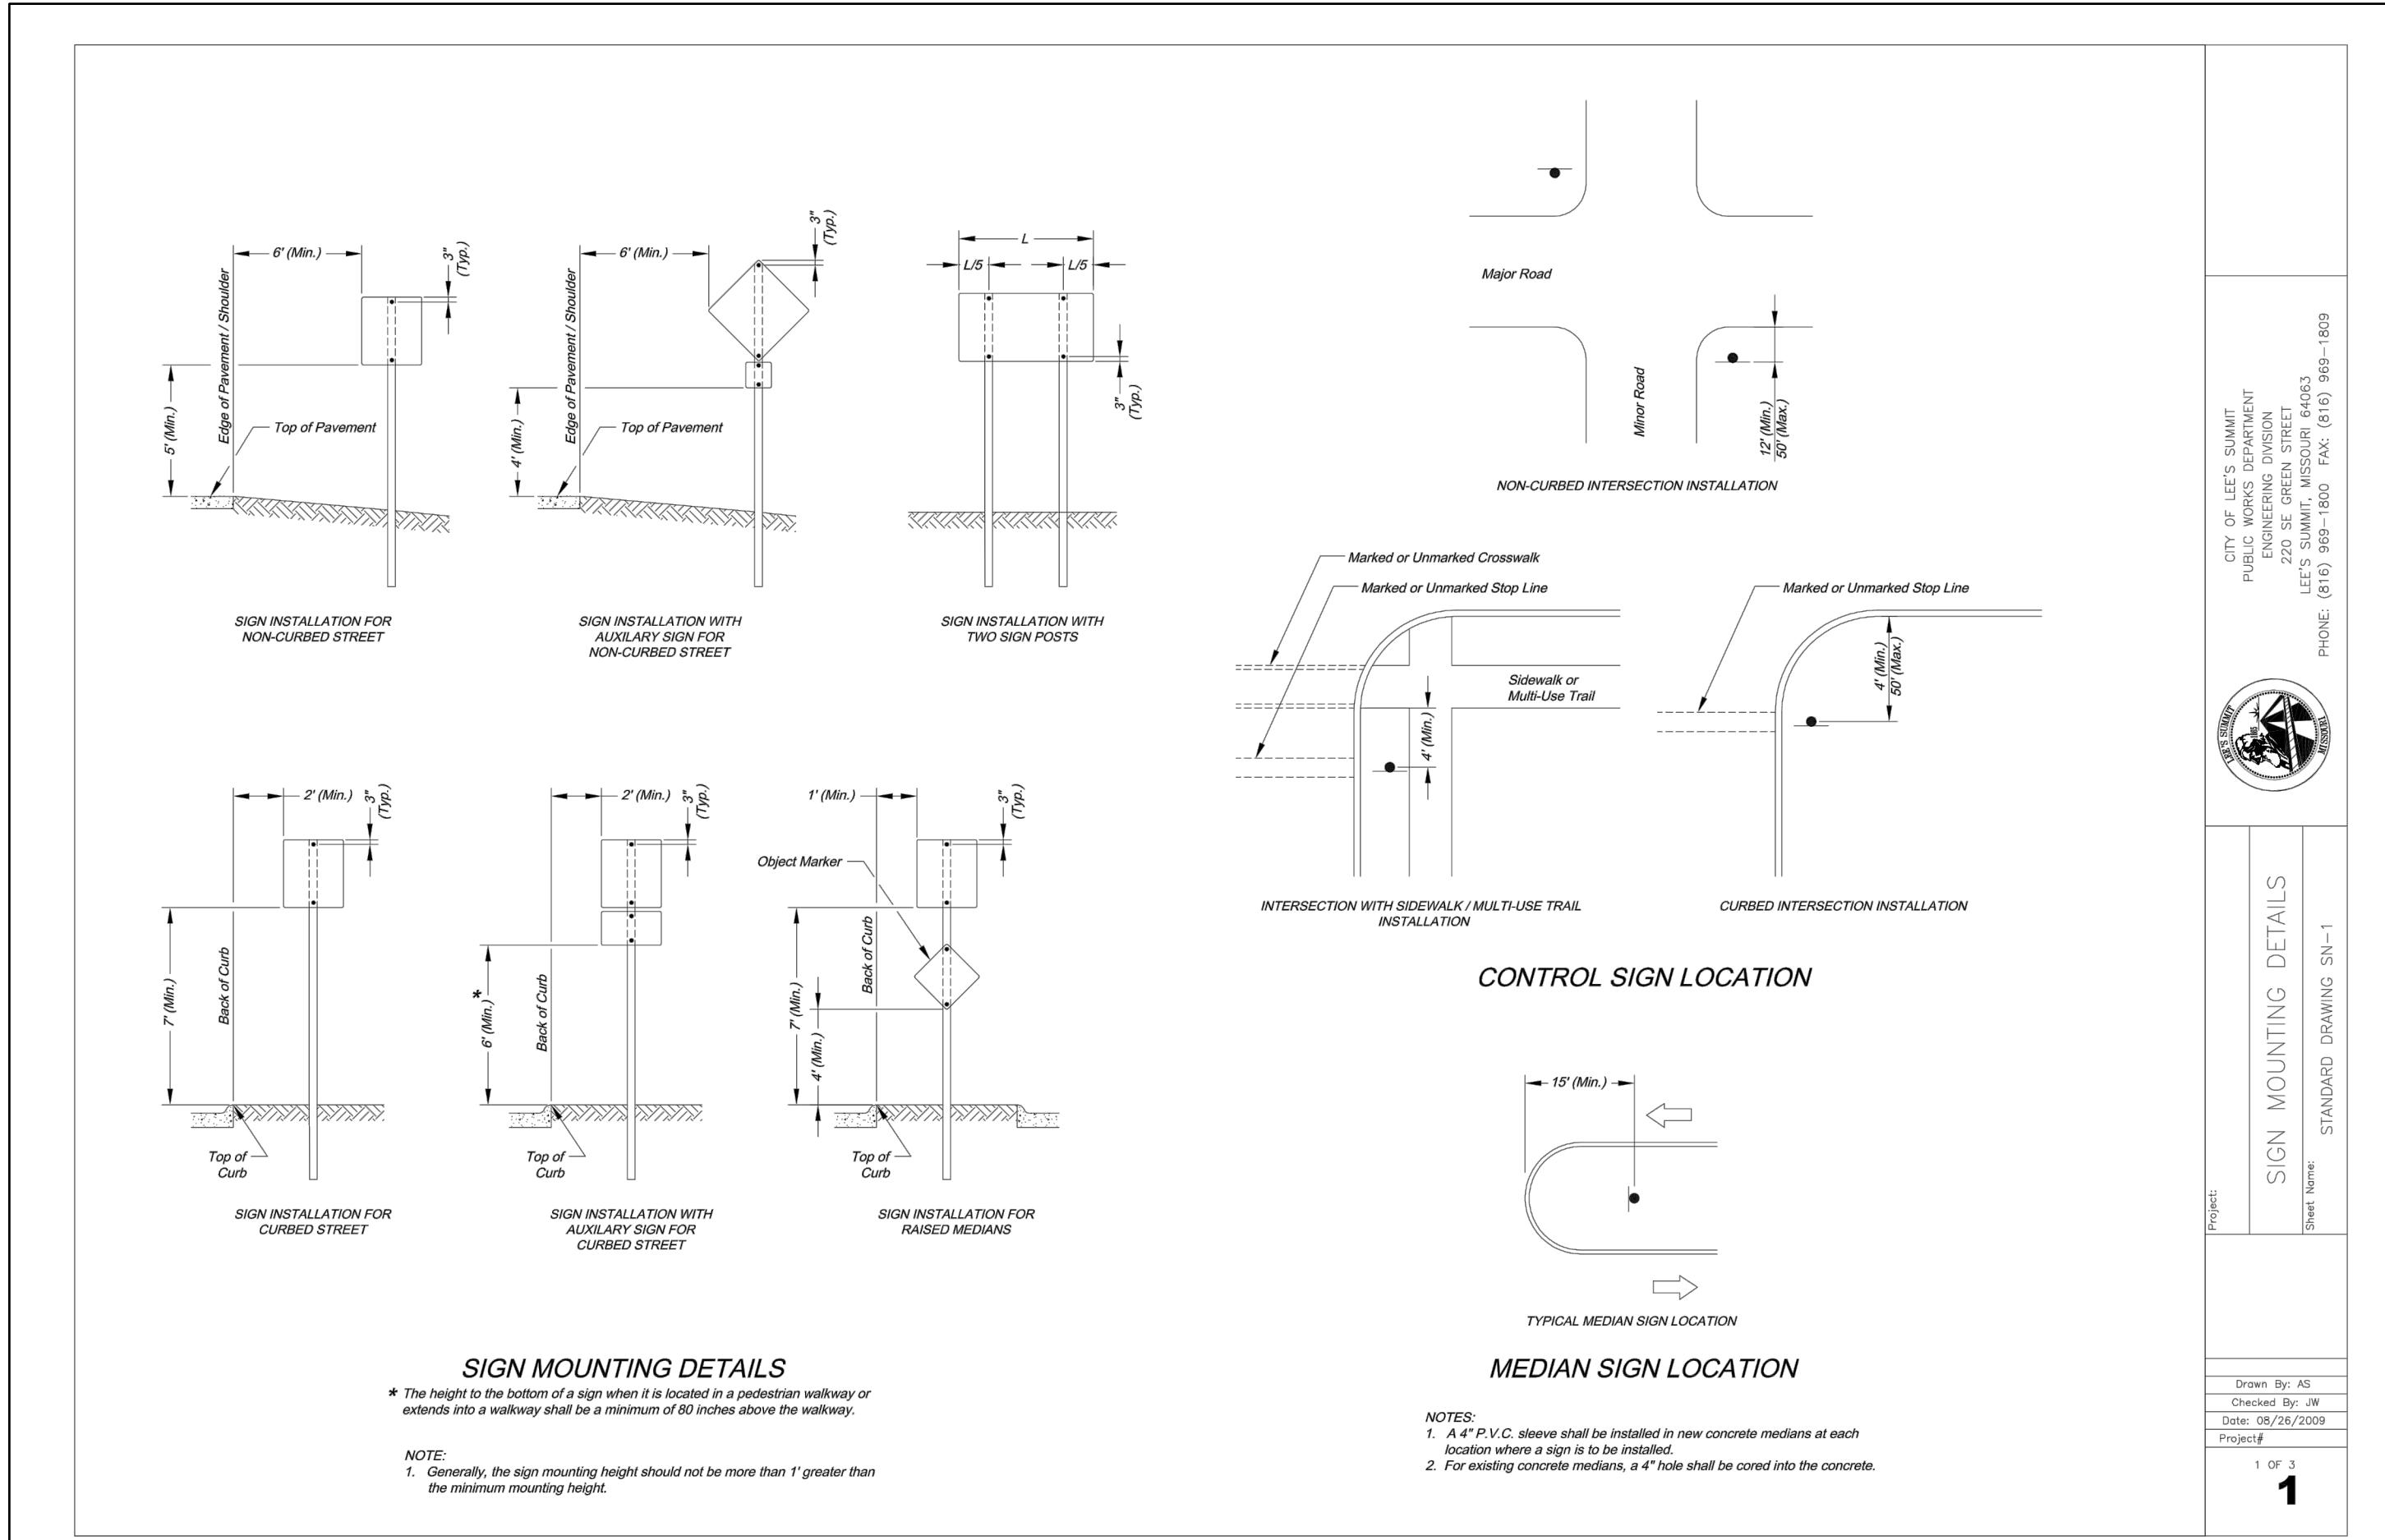

Record Drawing

