

| EARTHWORK SUMMARY |              |
|-------------------|--------------|
| CUT               | 24,183 CY    |
| FILL              | 20,290 CY    |
| NET               | 3,893 CY CUT |

**RECORD DRAWING**

The information provided on this drawing conforms to construction records; it is not intended for construction, implementation or recording purposes; and it is solely based on information obtained by Schlager and Associates.

"100.00 100.10", "1.00% 1.15% slope", or "8-inch HDPE PVC pipe" are all typical examples of revisions that indicate that design data has been replaced with "as-built" information. All other data is as designed and has not been field verified.

Date: 8/8/2023  
 Certified by: BAL  
 Title: Design Engineer  
 Firm: Schlager and Associates, P.A.

**NOTE:**

THE CONTRACTOR IS RESPONSIBLE FOR VERIFYING ALL EXISTING UTILITY LOCATIONS PRIOR TO EXCAVATIONS.

- 950 — DENOTES PROPOSED MAJOR CONTOUR
- 950 — DENOTES PROPOSED MINOR CONTOUR
- 950 — DENOTES EXISTING MAJOR CONTOUR
- 950 — DENOTES EXISTING MINOR CONTOUR
- 950 — DENOTES AS-BUILT MAJOR CONTOUR
- 950 — DENOTES AS-BUILT MINOR CONTOUR

**MISSOURI GEOGRAPHIC REFERENCE SYSTEM BENCH MARK:**

BM JA-148, IS A STAMPED KC METRO DISK SET IN CONCRETE LOCATED 2 MILES WEST OF THE INTERSECTION OF HIGHWAY 50 AND 3RD ST. IT IS 44 FT NORTH OF THE CENTER OF 3RD ST. AND 102.5 FT WEST OF THE CENTER OF THE EXIT FROM THE ADJACENT PARKING LOT.

ELEV. 935.18


**PROJECT BENCHMARK:**

CHISELED "SQUARE" ON STORM CURB INLET AT NORTHWEST INTERSECTION OF SW. TOWER PARK DRIVE AND SW. LONGVIEW BOULEVARD.

NORTHING: 998893.4148  
 EASTING: 2803318.5413  
 ELEV. 1004.09

**SURVEY NOTES**

The bases of bearing and coordinates are base on the Missouri Coordinate System of 1983, West Zone (2003 Adjustment) with a Grid Factor of 0.9999020.

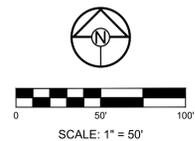

PREPARED BY:




SCHLAGEL & ASSOCIATES, P.A.

**LUMBERMAN'S ROW STREET, STORMWATER, MASTER DRAINAGE PLAN & EROSION AND SEDIMENT CONTROL - LEE'S SUMMIT, MISSOURI**

| REVISION DATE | DESCRIPTION       |
|---------------|-------------------|
| 8-12-22       | CITY COMMENTS     |
| 8-8-23        | AS-BUILTS         |
| 8-31-23       | AS-BUILT COMMENTS |
| 8-22          | DATE PREPARED     |
| 22-534        | PROJ. NUMBER      |

**MASTER DRAINAGE PLAN - GRADING PLAN**

SHEET  
**3**

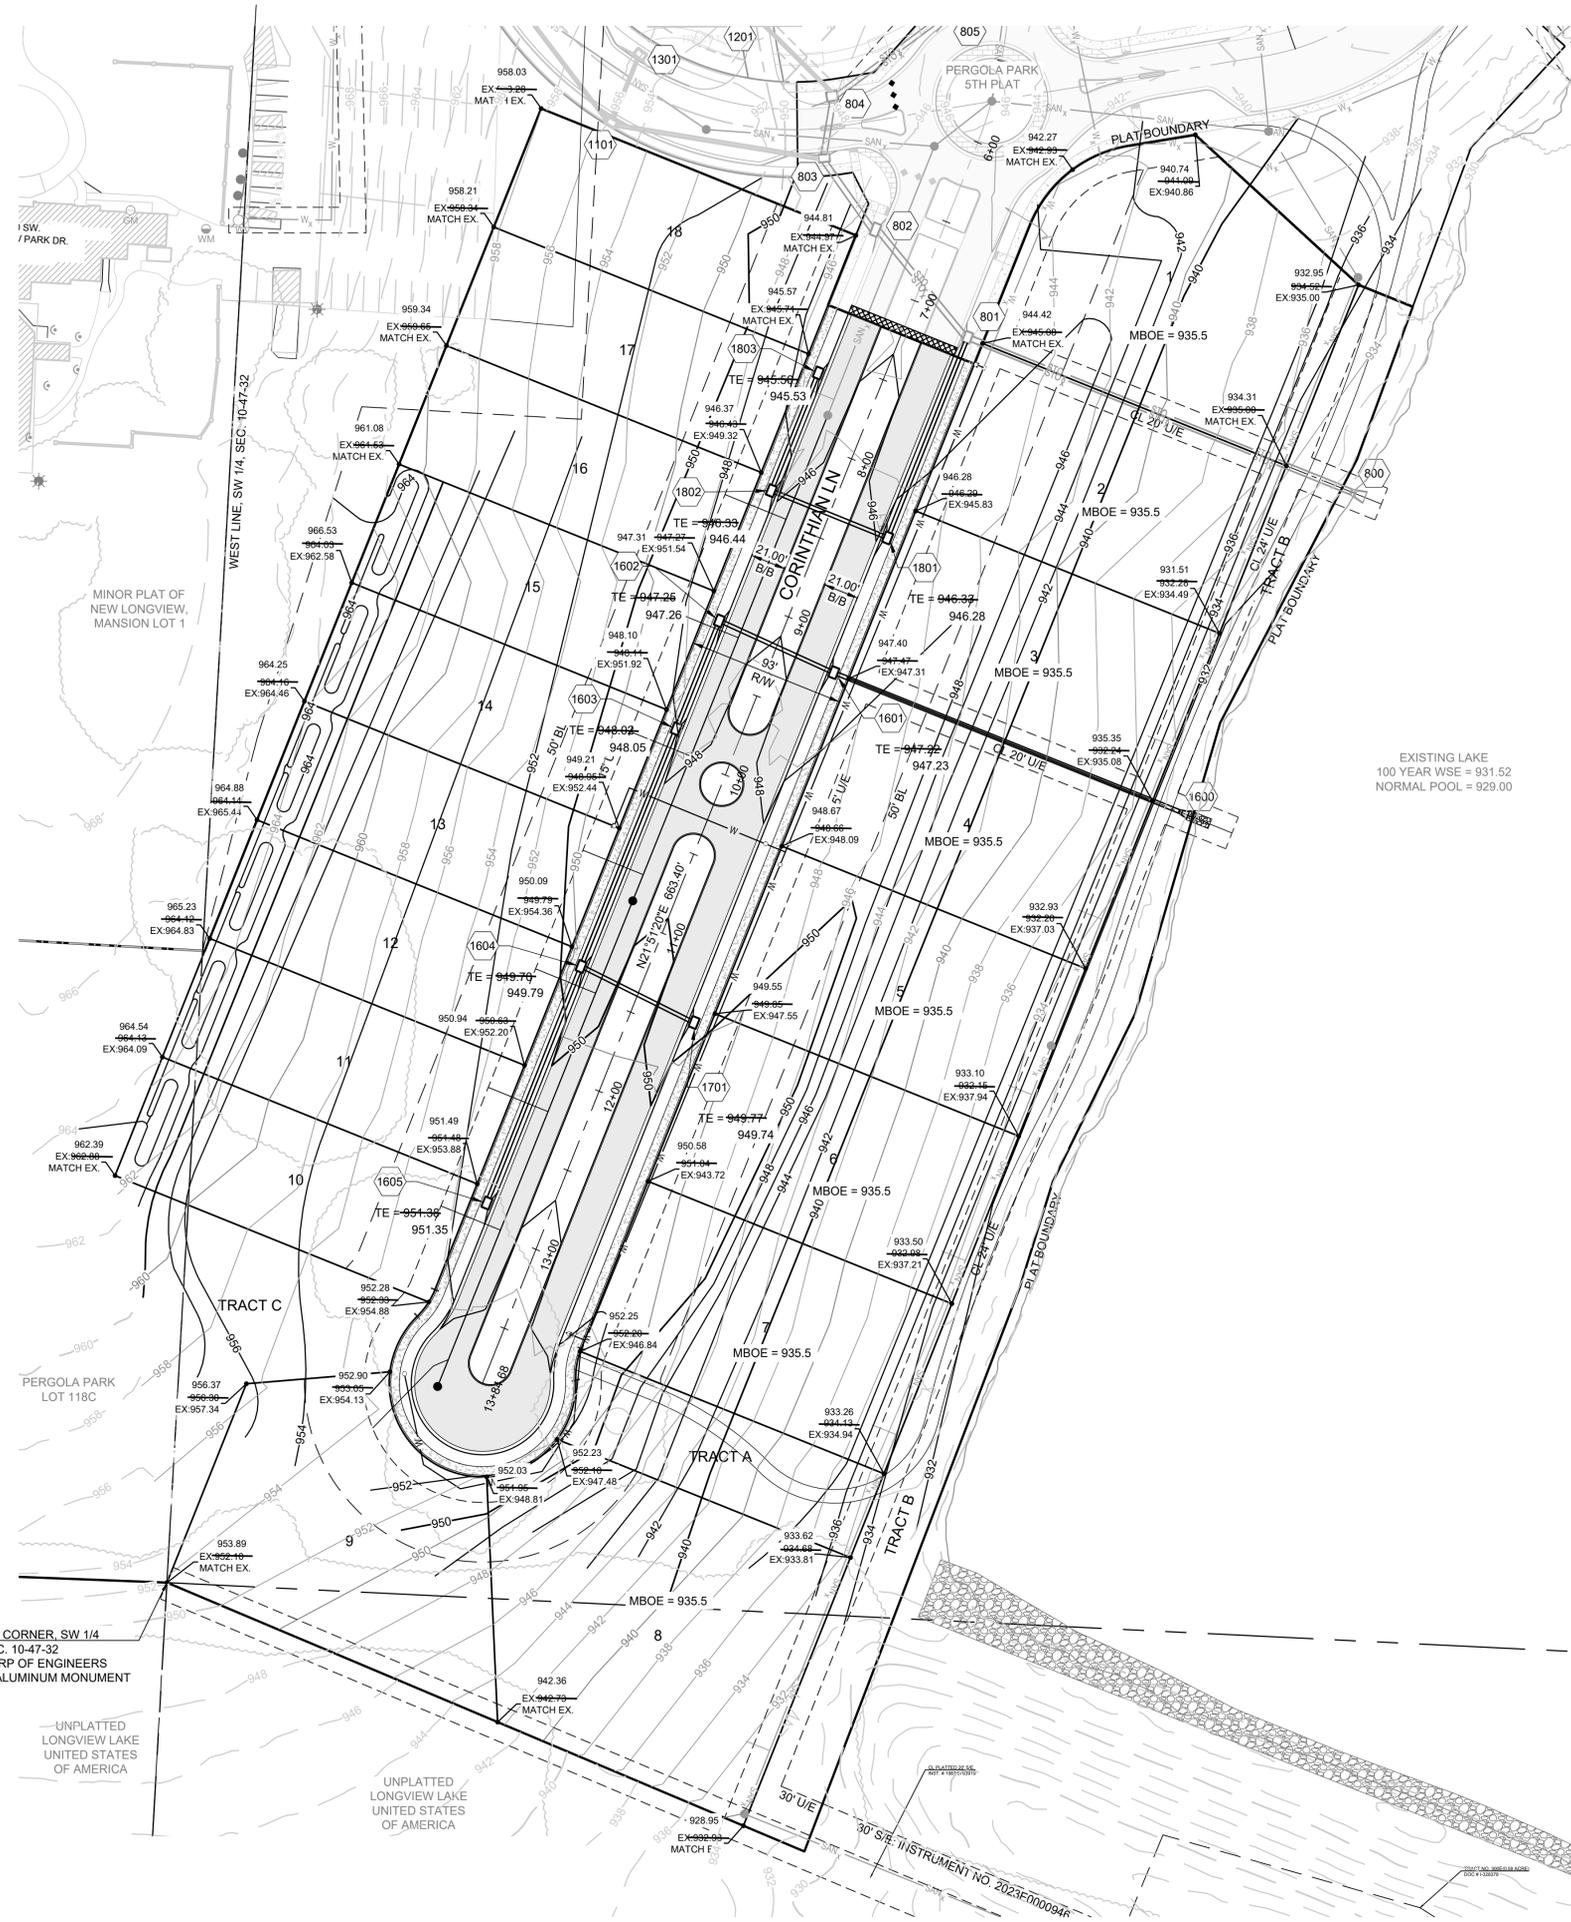

LOT TYPE TABLE

| LOT # | BASEMENT TYPE | FRONT MBOE | REAR MBOE | AS-BUILT FRONT MBOE | AS-BUILT REAR MBOE |
|-------|---------------|------------|-----------|---------------------|--------------------|
| 1     | WALKOUT       | 945.60     | 935.50    | 944.90              | 935.50             |
| 2     | WALKOUT       | 946.40     | 935.50    | 946.80              | 935.50             |
| 3     | WALKOUT       | 948.00     | 935.50    | 947.90              | 935.50             |
| 4     | WALKOUT       | 948.60     | 935.50    | 949.20              | 935.50             |
| 5     | WALKOUT       | 950.40     | 935.50    | 950.05              | 935.50             |
| 6     | WALKOUT       | 951.60     | 935.50    | 951.10              | 935.50             |
| 7     | WALKOUT       | 947.40     | 935.50    | 952.75              | 935.50             |
| 8     | WALKOUT       | 952.00     | 935.50    | 952.75              | 935.50             |
| 9     | STANDARD      | 953.60     | 952.60    | 953.40              | 954.40             |
| 10    | STANDARD      | 952.90     | 952.90    | 952.80              | 952.80             |
| 11    | STANDARD      | 952.00     | 952.00    | 952.00              | 952.00             |
| 12    | STANDARD      | 951.20     | 951.20    | 951.50              | 951.50             |
| 13    | STANDARD      | 950.30     | 950.30    | 950.60              | 950.60             |
| 14    | STANDARD      | 949.50     | 949.50    | 949.70              | 949.70             |
| 15    | STANDARD      | 948.70     | 948.70    | 948.60              | 948.60             |
| 16    | STANDARD      | 947.80     | 947.80    | 947.80              | 947.80             |
| 17    | STANDARD      | 947.00     | 947.00    | 946.90              | 946.90             |
| 18    | STANDARD      | 946.30     | 946.30    | 946.10              | 946.10             |

ALL LOTS TO REQUIRE AS-GRADED PLOT PLANS


**NOTE:**  
THE CONTRACTOR IS RESPONSIBLE FOR VERIFYING ALL EXISTING UTILITY LOCATIONS PRIOR TO EXCAVATIONS.



**MISSOURI GEOGRAPHIC REFERENCE SYSTEM BENCH MARK:**  
BM JA-148, IS A STAMPED KC METRO DISK SET IN CONCRETE LOCATED 2 MILES WEST OF THE INTERSECTION OF HIGHWAY 50 AND 3RD ST. IT IS 44 FT NORTH OF THE CENTER OF 3RD ST. AND 102.5 FT WEST OF THE CENTER OF THE EXIT FROM THE ADJACENT PARKING LOT.  
ELEV. 935.18

**PROJECT BENCHMARK:**  
CHISELED "SQUARE" ON STORM CURB INLET AT NORTHWEST INTERSECTION OF SW. TOWER PARK DRIVE AND SW. LONGVIEW BOULEVARD.  
NORTHING: 998893.4148  
EASTING: 2803318.5413  
ELEV. 1004.09

**SURVEY NOTES**  
The bases of bearing and coordinates are base on the Missouri Coordinate System of 1983, West Zone (2003 Adjustment) with a Grid Factor of 0.9999020.

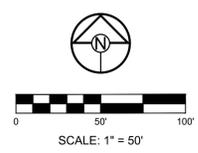

**RECORD DRAWING**

The information provided on this drawing conforms to construction records; it is not intended for construction, implementation or recording purposes; and it is solely based on information obtained by Schlagel and Associates.

"100.00 100.10", "1.00% 1.15% slope", or "8-inch HDPE PVC pipe" are all typical examples of revisions that indicate that design data has been replaced with "as-built" information. All other data is as designed and has not been field verified.

Date: 8/8/2023  
Certified by: BAL  
Title: Design Engineer  
Firm: Schlagel and Associates, P.A.

**LUMBERMAN'S ROW  
STREET, STORMWATER, MASTER DRAINAGE  
PLAN & EROSION AND SEDIMENT CONTROL  
- LEE'S SUMMIT, MISSOURI**

| REVISION DATE | DESCRIPTION       |
|---------------|-------------------|
| 8-12-22       | CITY COMMENTS     |
| 8-23          | AS-BUILTS         |
| 8-31-23       | AS-BUILT COMMENTS |

DRAWN BY: BAL  
CHECKED BY: MAB  
DATE PREPARED: 8-22  
PROJ. NUMBER: 22-034

**MASTER DRAINAGE PLAN - LOT INFO**

I:\PROJECTS\2022\22-034\3.0 Design\3.0 DWG Plans\3.0 SS\22-034-SS-GRAD.dwg, 4 MASTER DRAINAGE PLAN - LOT INFO, 9/7/2023 3:16:54 PM, 11



**LUMBERMAN'S ROW  
 STREET, STORMWATER, MASTER DRAINAGE  
 PLAN & EROSION AND SEDIMENT CONTROL**  
 - LEE'S SUMMIT, MISSOURI

**RECORD DRAWING**

The information provided on this drawing conforms to construction records; it is not intended for construction, implementation or recording purposes; and it is solely based on information obtained by Schlager and Associates.

"100.00 100.10", "1.00% 1.15% slope", or "8-inch HDPE PVC pipe" are all typical examples of revisions that indicate that design data has been replaced with "as-built" information. All other data is as designed and has not been field verified.

Date: 8/8/2023  
 Certified by: BAL  
 Title: Design Engineer  
 Firm: Schlager and Associates, P.A.

- PROPOSED DRAINAGE
- EXISTING DRAINAGE
- FUTURE DRAINAGE

**MISSOURI GEOGRAPHIC REFERENCE SYSTEM  
 BENCH MARK:**

BM JA-148. IS A STAMPED KC METRO DISK SET IN CONCRETE LOCATED 2 MILES WEST OF THE INTERSECTION OF HIGHWAY 50 AND 3RD ST. IT IS 44 FT NORTH OF THE CENTER OF 3RD ST. AND 102.5 FT WEST OF THE CENTER OF THE EXIT FROM THE ADJACENT PARKING LOT.

ELEV. 935.18

**PROJECT BENCHMARK:**

CHISELED "SQUARE" ON STORM CURB INLET AT NORTHWEST INTERSECTION OF SW. TOWER PARK DRIVE AND SW. LONGVIEW BOULEVARD.

NORTHING: 998893.4148  
 EASTING: 2803318.5413  
 ELEV. 1004.09



| REVISION DATE | DESCRIPTION       |
|---------------|-------------------|
| 8-12-22       | CITY COMMENTS     |
| 8-8-23        | AS-BUILTS         |
| 8-31-23       | AS-BUILT COMMENTS |
| 8-22          | DATE PREPARED     |
| 22-034        | PROJ. NUMBER      |

MASTER DRAINAGE PLAN - DRAINAGE MAP

**LUMBERMAN'S ROW STREET, STORMWATER, MASTER DRAINAGE PLAN & EROSION AND SEDIMENT CONTROL - LEE'S SUMMIT, MISSOURI**

| REVISION DATE | DESCRIPTION       |
|---------------|-------------------|
| 8-12-22       | CITY COMMENTS     |
| 8-14-23       | AS-BUILTS         |
| 8-31-23       | AS-BUILT COMMENTS |
| 9-6-23        | DATE PREPARED     |
| 9-6-22        | PROJ. NUMBER      |
| 22-034        |                   |

**RECORD DRAWING**

The information provided on this drawing conforms to construction records; it is not intended for construction, implementation or recording purposes; and it is solely based on information obtained by Schlager and Associates.

"400-00 100.10", "1-00% 1.15% slope", or "8-inch HDPE PVC pipe" are all typical examples of revisions that indicate that design data has been replaced with "as-built" information. All other data is as designed and has not been field verified.

Date: 8/8/2023  
 Certified by: BAL  
 Title: Design Engineer  
 Firm: Schlager and Associates, P.A.

**100-YEAR RUNOFF CALCULATIONS**

| Runoff Calculations |              |           |                     |            |     |           |                 |               |           |           |                  |                  |                 |        | Pipe Properties |            |           |           |           |        |         |               |       |         |           |           |  |  |  |  |  |
|---------------------|--------------|-----------|---------------------|------------|-----|-----------|-----------------|---------------|-----------|-----------|------------------|------------------|-----------------|--------|-----------------|------------|-----------|-----------|-----------|--------|---------|---------------|-------|---------|-----------|-----------|--|--|--|--|--|
| Inlet #             | Area (acres) | "C" Value | Cumul. Area (acres) | Cumul. CxA | Tc  | Intensity | Runoff To Inlet | Cumul. Runoff | Pipe Cap. | Pipe Vel. | Up Piped Inlet 1 | Up Piped Inlet 2 | Up Area (acres) | Up CxA | Up Inlet        | Down Inlet | Pipe Type | "n" Value | Pipe Size | Length | Slope % | Drop In Inlet | FL Up | FL Down | Inlet Top | HGL Elev. |  |  |  |  |  |
| EXISTING LINE 400   |              |           | 401                 | 2.40         | 0.66      | 46.76               | 30.86      | 5.7 | 7.13      | 11.29           | 220.00        | 220.20    | 9.27      | 501              |                  |                 | 402                 | 0.04         | 0.66      | 40.98               | 27.05      | 5.4 | 7.24      | 0.19            | 195.88        | 286.92    | 12.08     |                  |                  | 403                 | 0.07         | 0.66      | 40.94               | 27.02      | 5.3 | 7.27      | 0.34            | 196.43        | 300.36    | 12.64     | 601              |                  |                 | 404                 | 0.06         | 0.66      | 39.97               | 26.38      | 5.1 | 7.32      | 0.29            | 193.18        | 270.74    | 11.40     |                  |                  | 405                 | 38.50        | 0.66      | 38.50               | 25.41      | 5.0 | 7.35      | 186.84          | 186.84        | 251.06    | 15.79     |                  |                  | EXISTING LINE 600   |              |           | 601                 | 0.36         | 0.66      | 0.90                | 0.59       | 5.1 | 7.35      | 1.74            | 4.35          | 19.45     | 11.00     |                  |                  | 602                 | 0.54         | 0.66      | 0.54                | 0.36       | 5.0 | 7.35      | 2.62            | 2.62          | 13.70     | 11.00     |                  |                  | EXISTING LINE 700   |              |           | 701                 | 1.14         | 0.66      | 1.41                | 0.93       | 5.1 | 7.32      | 5.51            | 6.82          | 9.26      | 7.54      |                  |                  | 702                 | 0.27         | 0.66      | 0.27                | 0.18       | 5.0 | 7.35      | 1.31            | 1.31          | 7.10      | 5.79      |                  |                  | EXISTING LINE 800   |              |           | 801                 | 0.29         | 0.51      | 8.77                | 5.30       | 6.6 | 6.89      | 1.02            | 36.54         | 66.70     | 9.44      | 1801             |                  |                 | 802                 | 1.38         | 0.51      | 6.91                | 4.35       | 6.5 | 6.93      | 4.88            | 30.17         | 68.55     | 9.70      |                  |                  | 803                 | 0.12         | 0.66      | 5.53                | 3.65       | 6.3 | 6.96      | 0.55            | 25.41         | 51.09     | 7.23      | 1101             |                  |                 | 804                 | 0.22         | 0.66      | 3.09                | 2.04       | 6.2 | 6.99      | 1.01            | 14.25         | 31.42     | 6.40      | 1201             |                  |                 | 805                 | 0.12         | 0.66      | 1.74                | 1.15       | 6.0 | 7.05      | 0.56            | 8.10          | 31.42     | 6.40      |                  |                  | 806                 | 0.40         | 0.66      | 1.62                | 1.07       | 5.8 | 7.10      | 1.88            | 7.59          | 31.42     | 6.40      | 1001             |                  |                 | 807                 | 0.40         | 0.66      | 0.91                | 0.60       | 5.2 | 7.20      | 1.90            | 4.32          | 31.42     | 6.40      |                  |                  | 808                 | 0.19         | 0.66      | 0.51                | 0.34       | 5.2 | 7.30      | 0.91            | 2.46          | 31.42     | 6.40      |                  |                  | 809                 | 0.32         | 0.66      | 0.32                | 0.21       | 5.0 | 7.35      | 1.55            | 1.55          | 31.42     | 6.40      |                  |                  | 810                 | 0.21         | 0.66      | 0.21                | 0.14       | 5.0 | 7.35      | 1.02            | 1.02          | 31.42     | 6.40      |                  |                  | 811                 | 2.32         | 0.66      | 2.63                | 1.74       | 5.1 | 7.31      | 11.19           | 12.69         | 31.42     | 6.40      |                  |                  | 812                 | 0.13         | 0.66      | 0.13                | 0.09       | 5.0 | 7.35      | 0.63            | 0.63          | 4.95      | 4.03      |                  |                  | EXISTING LINE 1000  |              |           | 1001                | 0.31         | 0.66      | 0.31                | 0.20       | 5.0 | 7.35      | 1.50            | 1.50          | 4.95      | 4.03      |                  |                  | FUTURE LINE 1100    |              |           | 1101                | 0.55         | 0.66      | 2.32                | 1.53       | 6.0 | 7.05      | 2.56            | 10.79         | 30.32     | 17.16     | 1301             |                  |                 | 1102                | 0.34         | 0.66      | 1.60                | 1.06       | 5.8 | 7.11      | 1.60            | 7.51          | 13.28     | 10.82     |                  |                  | 1103                | 0.56         | 0.66      | 1.29                | 0.83       | 5.6 | 7.13      | 2.65            | 5.96          | 13.28     | 10.82     | 1401             |                  |                 | 1104                | 0.30         | 0.66      | 0.55                | 0.36       | 5.3 | 7.26      | 1.44            | 2.63          | 11.51     | 9.46      | 1501             |                  |                 | 1105                | 0.09         | 0.66      | 0.16                | 0.11       | 5.1 | 7.32      | 0.43            | 0.77          | 9.26      | 7.54      |                  |                  | 1106                | 0.07         | 0.66      | 0.07                | 0.05       | 5.0 | 7.35      | 0.34            | 0.34          | 7.00      | 5.70      |                  |                  | FUTURE LINE 1200    |              |           | 1201                | 0.35         | 0.66      | 1.13                | 0.75       | 5.6 | 7.19      | 1.66            | 5.35          | 18.52     | 15.09     |                  |                  | 1202                | 0.38         | 0.66      | 0.78                | 0.51       | 5.4 | 7.23      | 1.81            | 3.72          | 13.09     | 10.67     |                  |                  | 1203                | 0.25         | 0.66      | 0.40                | 0.26       | 5.2 | 7.30      | 1.20            | 1.93          | 11.06     | 9.02      |                  |                  | 1204                | 0.15         | 0.66      | 0.15                | 0.10       | 5.0 | 7.35      | 0.73            | 0.73          | 11.06     | 9.02      |                  |                  | FUTURE LINE 1300    |              |           | 1301                | 0.17         | 0.66      | 0.17                | 0.11       | 5.0 | 7.35      | 0.83            | 0.83          | 15.65     | 12.75     |                  |                  | FUTURE LINE 1400    |              |           | 1401                | 0.15         | 0.66      | 0.15                | 0.10       | 5.0 | 7.35      | 0.73            | 0.73          | 14.00     | 11.41     |                  |                  | FUTURE LINE 1500    |              |           | 1501                | 0.09         | 0.66      | 0.09                | 0.06       | 5.0 | 7.35      | 0.44            | 0.44          | 4.95      | 4.03      |                  |                  | LINE 1600           |              |           | 1601                | 0.47         | 0.51      | 4.29                | 2.19       | 6.1 | 7.04      | 1.69            | 15.40         | 31.99     | 10.18     |                  |                  | 1602                | 0.84         | 0.51      | 3.82                | 1.95       | 5.9 | 7.08      | 3.03            | 13.80         | 25.70     | 8.18      |                  |                  | 1603                | 1.22         | 0.51      | 2.98                | 1.52       | 5.8 | 7.13      | 4.43            | 10.83         | 24.51     | 7.80      |                  |                  | 1604                | 0.96         | 0.51      | 1.76                | 0.90       | 5.4 | 7.24      | 3.54            | 6.49          | 11.94     | 6.75      |                  |                  | 1605                | 0.80         | 0.51      | 0.80                | 0.41       | 5.0 | 7.35      | 3.00            | 3.00          | 11.38     | 6.44      |                  |                  | LINE 1700           |              |           | 1701                | 0.59         | 0.51      | 0.59                | 0.30       | 5.0 | 7.35      | 2.21            | 2.21          | 7.00      | 5.70      |                  |                  | LINE 1800           |              |           | 1801                | 0.20         | 0.51      | 1.57                | 0.80       | 5.4 | 7.23      | 0.74            | 5.79          | 11.38     | 6.44      |                  |                  | 1802                | 0.86         | 0.51      | 1.37                | 0.70       | 5.2 | 7.29      | 3.20            | 5.09          | 11.38     | 6.44      |                  |                  | 1803                | 0.51         | 0.51      | 0.51                | 0.26       | 5.0 | 7.35      | 1.91            | 1.91          | 7.00      | 5.70      |                  |                  
**10-YEAR RUNOFF CALCULATIONS**

| Runoff Calculations |              |           |                     |            |     |           |                 |               |           |           |                  |                  |                 |        | Pipe Properties |            |           |           |           |        |         |               |       |         |           |           |  |  |  |  |
|---------------------|--------------|-----------|---------------------|------------|-----|-----------|-----------------|---------------|-----------|-----------|------------------|------------------|-----------------|--------|-----------------|------------|-----------|-----------|-----------|--------|---------|---------------|-------|---------|-----------|-----------|--|--|--|--|
| Inlet #             | Area (acres) | "C" Value | Cumul. Area (acres) | Cumul. CxA | Tc  | Intensity | Runoff To Inlet | Cumul. Runoff | Pipe Cap. | Pipe Vel. | Up Piped Inlet 1 | Up Piped Inlet 2 | Up Area (acres) | Up CxA | Up Inlet        | Down Inlet | Pipe Type | "n" Value | Pipe Size | Length | Slope % | Drop In Inlet | FL Up | FL Down | Inlet Top | HGL Elev. |  |  |  |  |
| EXISTING LINE 400   |              |           | 401                 | 2.40         | 0.66      | 46.76               | 30.86      | 5.7 | 7.13      | 11.29           | 220.00        | 220.20    | 9.27      | 501              |                  |                 |        |                 |            |           |           |           |        |         |               |       |         |           |           |  |  |  |  |
| 402                 | 0.04         | 0.66      | 40.98               | 27.05      | 5.4 | 7.24      | 0.19            | 195.88        | 286.92    | 12.08     |                  |                  | 403                 | 0.07         | 0.66      | 40.94               | 27.02      | 5.3 | 7.27      | 0.34            |               |           
**LUMBERMAN'S ROW  
 STREET, STORMWATER, MASTER DRAINAGE  
 PLAN & EROSION AND SEDIMENT CONTROL  
 - LEE'S SUMMIT, MISSOURI**

**GUTTER SPREAD AND INLET CAPACITY CALCULATIONS - LUMBERMAN'S ROW**

DESIGN STORM 10 CURB TYPE "A" = LAZY BACK  
 "K" FACTOR 1.00 CURB TYPE "B" = HIGH BACK

| RUNOFF CALCULATIONS       |               |      |          |           |        |                |                |                |                |                            | INLET DESIGN |              |                    |           |              |                  |                    |                            |              |                    | GUTTER DESIGN |                |  |  |
|---------------------------|---------------|------|----------|-----------|--------|----------------|----------------|----------------|----------------|----------------------------|--------------|--------------|--------------------|-----------|--------------|------------------|--------------------|----------------------------|--------------|--------------------|---------------|----------------|--|--|
| INLET #                   | COMPOSITE "C" | AREA | INLET Tc | INTENSITY | RUNOFF | UPSTREAM INLET | UPSTREAM INLET | UPSTREAM INLET | UPSTREAM INLET | BYPASS FROM UPSTREAM INLET | TOTAL RUNOFF | STREET GRADE | STREET CROSS SLOPE | CURB TYPE | INLET LENGTH | EFFECTIVE LENGTH | INLET INTERCEPTION | BYPASS TO DOWNSTREAM INLET | STREET GRADE | STREET CROSS SLOPE | DEPTH AT CURB | SPREAD OF FLOW |  |  |
| <b>EXISTING LINE 400</b>  |               |      | 401                       | 0.66          | 2.40 | 5        | 7.35      | 11.64  | 801            | 802            | 803            |                | 0.79                       | 12.43        | SUMP         | 2.08               | A         | 8            | 6.4              | 17.92              | 0.00                       | SUMP         | 2.08               | < 0.21        | < 10.50        |  |  |
| 402                       | 0.66          | 0.04 | 5        | 7.35      | 0.19   | 403            |                |                |                | 0.02                       | 0.21         | 3.24         | 2.08               | A         | 6            | 4.8              | 0.20               | 0.00                       | 3.24         | 2.08               | 0.06          | 3.48           |  |  |
| 403                       | 0.66          | 0.07 | 5        | 7.35      | 0.34   | 404            |                |                |                | 0.01                       | 0.35         | 3.24         | 2.08               | A         | 6            | 4.8              | 0.33               | 0.02                       | 3.24         | 2.08               | 0.08          | 4.12           |  |  |
| 404                       | 0.66          | 0.06 | 5        | 7.35      | 0.29   |                |                |                |                | 0.00                       | 0.29         | 3.24         | 2.08               | A         | 6            | 4.8              | 0.28               | 0.01                       | 3.24         | 2.08               | 0.07          | 3.88           |  |  |
| <b>EXISTING LINE 500</b>  |               |      | 501                       | 0.66          | 1.06 | 5        | 7.35      | 5.14   | 402            | 502            |                |                | 1.09                       | 6.24         | SUMP         | 2.08               | A         | 6            | 4.8              | 13.44              | 0.00                       | SUMP         | 2.08               | < 0.21        | < 10.50        |  |  |
| 502                       | 0.66          | 0.57 | 5        | 7.35      | 2.77   | 804            | 503            | 806            | 901            | 0.84                       | 3.61         | 1.95         | 2.08               | A         | 6            | 4.8              | 2.52               | 1.09                       | 1.95         | 2.08               | 0.20          | 10.05          |  |  |
| 503                       | 0.66          | 0.26 | 5        | 7.35      | 1.26   | 504            |                |                |                | 0.33                       | 1.59         | 1.49         | 2.08               | A         | 4            | 3.2              | 1.33               | 0.26                       | 1.49         | 2.08               | 0.15          | 7.89           |  |  |
| 504                       | 0.66          | 0.29 | 5        | 7.35      | 1.41   | 505            |                |                |                | 0.40                       | 1.81         | 1.49         | 2.08               | A         | 4            | 3.2              | 1.48               | 0.33                       | 1.49         | 2.08               | 0.16          | 8.25           |  |  |
| 505                       | 0.66          | 0.33 | 5        | 7.35      | 1.60   | 506            |                |                |                | 0.41                       | 2.01         | 1.49         | 2.08               | A         | 4            | 3.2              | 1.61               | 0.40                       | 1.49         | 2.08               | 0.17          | 8.57           |  |  |
| 506                       | 0.66          | 0.29 | 5        | 7.35      | 1.41   | 507            |                |                |                | 0.63                       | 2.03         | 1.49         | 2.08               | A         | 4            | 3.2              | 1.63               | 0.41                       | 1.49         | 2.08               | 0.17          | 8.60           |  |  |
| 507                       | 0.66          | 0.58 | 5        | 7.35      | 2.81   |                |                |                |                | 0.00                       | 2.81         | 1.13         | 2.08               | A         | 4            | 3.2              | 2.19               | 0.63                       | 1.13         | 2.08               | 0.20          | 10.14          |  |  |
| <b>EXISTING LINE 800</b>  |               |      | 801                       | 0.51          | 0.29 | 5        | 7.35      | 1.09   | 1601           | 1801           |                |                | 0.25                       | 1.34         | 1.12         | 2.08               | A         | 6            | 4.8              | 1.25               | 0.08                       | 1.12         | 2.08               | 0.15          | 7.80           |  |  |
| 802                       | 0.51          | 0.51 | 5        | 7.35      | 1.91   | 1701           |                |                |                | 0.12                       | 2.04         | 1.12         | 2.08               | A         | 6            | 4.8              | 1.82               | 0.21                       | 1.12         | 2.08               | 0.18          | 9.05           |  |  |
| 803                       | 0.66          | 0.12 | 5        | 7.35      | 0.58   | 1101           |                |                |                | 1.61                       | 2.19         | 3.00         | 2.08               | A         | 6            | 4.8              | 1.70               | 0.49                       | 3.00         | 2.08               | 0.15          | 7.81           |  |  |
| 804                       | 0.66          | 0.22 | 5        | 7.35      | 1.07   | 1301           | 1201           |                |                | 0.67                       | 1.74         | 3.00         | 2.08               | A         | 6            | 4.8              | 1.43               | 0.31                       | 3.00         | 2.08               | 0.14          | 7.20           |  |  |
| 805                       | 0.66          | 0.12 | 5        | 7.35      | 0.58   |                |                |                |                | 0.00                       | 0.58         | 3.00         | 2.08               | A         | 6            | 4.8              | 0.55               | 0.03                       | 3.00         | 2.08               | 0.09          | 4.94           |  |  |
| 806                       | 0.66          | 0.40 | 5        | 7.35      | 1.94   | 807            |                |                |                | 0.23                       | 2.17         | 1.28         | 2.08               | A         | 6            | 4.8              | 1.90               | 0.27                       | 1.28         | 2.08               | 0.18          | 9.04           |  |  |
| 807                       | 0.66          | 0.40 | 5        | 7.35      | 1.94   | 808            |                |                |                | 0.07                       | 2.01         | 1.28         | 2.08               | A         | 6            | 4.8              | 1.78               | 0.23                       | 1.28         | 2.08               | 0.17          | 8.80           |  |  |
| 808                       | 0.66          | 0.19 | 5        | 7.35      | 0.92   | 809            |                |                |                | 0.24                       | 1.16         | 1.28         | 2.08               | A         | 6            | 4.8              | 1.09               | 0.07                       | 1.28         | 2.08               | 0.14          | 7.25           |  |  |
| 809                       | 0.66          | 0.32 | 5        | 7.35      | 1.55   |                |                |                |                | 0.00                       | 1.55         | 2.75         | 2.08               | A         | 6            | 4.8              | 1.32               | 0.24                       | 2.75         | 2.08               | 0.14          | 7.03           |  |  |
| 810                       | 0.66          | 0.21 | 5        | 7.35      | 1.02   | 1106           |                |                |                | 0.00                       | 1.02         | 2.75         | 2.08               | A         | 6            | 4.8              | 0.92               | 0.10                       | 2.75         | 2.08               | 0.12          | 6.08           |  |  |
| 811                       | 0.66          | 2.32 | 5        | 7.35      | 11.25  | 810            |                |                |                | 0.10                       | 11.35        | SUMP         | 2.08               | A         | 6            | 4.8              | 16.80              | 0.00                       | SUMP         | 2.08               | < 0.21        | < 10.50        |  |  |
| 812                       | 0.66          | 0.13 | 5        | 7.35      | 0.63   |                |                |                |                | 0.00                       | 0.63         | SUMP         | 2.08               | A         | 6            | 4.8              | 16.80              | 0.00                       | SUMP         | 2.08               | < 0.21        | < 10.50        |  |  |
| <b>EXISTING LINE 1000</b> |               |      | 1001                      | 0.66          | 0.31 | 5        | 7.35      | 1.50   |                |                |                |                | 0.00                       | 1.50         | 1.28         | 2.08               | A         | 6            | 4.8              | 1.38               | 0.12                       | 1.28         | 2.08               | 0.15          | 7.94           |  |  |
| <b>FUTURE LINE 1100</b>   |               |      | 1101                      | 0.66          | 0.55 | 5        | 7.35      | 2.67   | 1102           |                |                |                | 0.77                       | 3.44         | 6.02         | 2.08               | A         | 6            | 4.8              | 1.83               | 1.61                       | 6.02         | 2.08               | 0.16          | 8.09           |  |  |
| 1102                      | 0.66          | 0.34 | 5        | 7.35      | 1.65   | 1103           |                |                |                | 0.59                       | 2.24         | 6.02         | 2.08               | A         | 6            | 4.8              | 1.47               | 0.77                       | 6.02         | 2.08               | 0.13          | 6.97           |  |  |
| 1103                      | 0.66          | 0.56 | 5        | 7.35      | 2.72   | 1104           |                |                |                | 0.15                       | 2.87         | 1.80         | 2.08               | A         | 6            | 4.8              | 2.28               | 0.59                       | 1.80         | 2.08               | 0.19          | 9.40           |  |  |
| 1104                      | 0.66          | 0.30 | 5        | 7.35      | 1.46   | 1105           |                |                |                | 0.01                       | 1.46         | 1.80         | 2.08               | A         | 6            | 4.8              | 1.31               | 0.15                       | 1.80         | 2.08               | 0.14          | 7.41           |  |  |
| 1105                      | 0.66          | 0.09 | 5        | 7.35      | 0.44   |                |                |                |                | 0.00                       | 0.44         | 1.50         | 2.08               | A         | 6            | 4.8              | 0.43               | 0.01                       | 1.50         | 2.08               | 0.09          | 5.04           |  |  |
| 1106                      | 0.66          | 0.07 | 5        | 7.35      | 0.34   |                |                |                |                | 0.00                       | 0.34         | 1.50         | 2.08               | A         | 6            | 4.8              | 0.34               | 0.00                       | 1.50         | 2.08               | 0.09          | 4.64           |  |  |
| <b>FUTURE LINE 1200</b>   |               |      | 1201                      | 0.66          | 0.35 | 5        | 7.35      | 1.70   | 1202           |                |                |                | 0.49                       | 2.19         | 2.45         | 2.08               | A         | 4            | 3.2              | 1.64               | 0.55                       | 2.45         | 2.08               | 0.16          | 8.08           |  |  |
| 1202                      | 0.66          | 0.38 | 5        | 7.35      | 1.84   | 1203           |                |                |                | 0.20                       | 2.05         | 2.45         | 2.08               | A         | 4            | 3.2              | 1.56               | 0.49                       | 2.45         | 2.08               | 0.15          | 7.90           |  |  |
| 1203                      | 0.66          | 0.25 | 5        | 7.35      | 1.21   | 1204           |                |                |                | 0.07                       | 1.28         | 2.45         | 2.08               | A         | 4            | 3.2              | 1.08               | 0.20                       | 2.45         | 2.08               | 0.13          | 6.71           |  |  |
| 1204                      | 0.66          | 0.15 | 5        | 7.35      | 0.73   |                |                |                |                | 0.00                       | 0.73         | 2.45         | 2.08               | A         | 4            | 3.2              | 0.66               | 0.07                       | 2.45         | 2.08               | 0.10          | 5.52           |  |  |
| <b>FUTURE LINE 1300</b>   |               |      | 1301                      | 0.66          | 0.17 | 5        | 7.35      | 0.82   | 1401           |                |                |                | 0.03                       | 0.86         | 6.02         | 2.08               | A         | 6            | 4.8              | 0.73               | 0.12                       | 6.02         | 2.08               | 0.09          | 5.01           |  |  |
| <b>FUTURE LINE 1400</b>   |               |      | 1401                      | 0.66          | 0.15 | 5        | 7.35      | 0.73   | 1501           |                |                |                | 0.01                       | 0.74         | 1.80         | 2.08               | A         | 6            | 4.8              | 0.70               | 0.03                       | 1.80         | 2.08               | 0.11          | 5.84           |  |  |
| <b>FUTURE LINE 1500</b>   |               |      | 1501                      | 0.66          | 0.09 | 5        | 7.35      | 0.44   |                |                |                |                | 0.00                       | 0.44         | 1.80         | 2.08               | A         | 6            | 4.8              | 0.43               | 0.01                       | 1.80         | 2.08               | 0.09          | 4.89           |  |  |
| <b>LINE 1600</b>          |               |      | 1601                      | 0.51          | 0.47 | 5        | 7.35      | 1.76   | 1701           |                |                |                | 0.25                       | 2.01         | 1.12         | 2.08               | A         | 6            | 6                | 1.81               | 0.21                       | 1.12         | 2.08               | 0.18          | 9.01           |  |  |
| 1602                      | 0.51          | 0.84 | 5        | 7.35      | 3.15   | 1603           |                |                |                | 1.47                       | 4.62         | 1.12         | 2.08               | A         | 6            | 6                | 3.53               | 1.09                       | 1.12         | 2.08               | 0.24          | 12.13          |  |  |
| 1603                      | 0.51          | 1.22 | 5        | 7.35      | 4.57   | 1604           |                |                |                | 0.85                       | 5.43         | 1.12         | 2.08               | A         | 6            | 6                | 3.95               | 1.47                       | 1.12         | 2.08               | 0.26          | 12.85          |  |  |
| 1604                      | 0.51          | 0.96 | 5        | 7.35      | 3.60   | 1605           |                |                |                | 0.47                       | 4.07         | 1.12         | 2.08               | A         | 6            | 6                | 3.21               | 0.85                       | 1.12         | 2.08               | 0.23          | 11.58          |  |  |
| 1605                      | 0.51          | 0.80 | 5        | 7.35      | 3.00   |                |                |                |                | 0.00                       | 3.00         | 1.12         | 2.08               | A         | 6            | 6                | 2.53               | 0.47                       | 1.12         | 2.08               | 0.21          | 10.39          |  |  |
| <b>LINE 1700</b>          |               |      | 1701                      | 0.51          | 0.59 | 5        | 7.35      | 2.21   |                |                |                |                | 0.00                       | 2.21         | 1.12         | 2.08               | A         | 6            | 6                | 1.96               | 0.25                       | 1.12         | 2.08               | 0.18          | 9.32           |  |  |
| <b>LINE 1800</b>          |               |      | 1801                      | 0.51          | 0.20 | 5        | 7.35      | 0.75   | 1601           |                |                |                | 0.21                       | 0.96         | 1.12         | 2.08               | A         | 6            | 6                | 0.92               | 0.04                       | 1.12         | 2.08               | 0.13          | 6.94           |  |  |
| 1802                      | 0.51          | 0.86 | 5        | 7.35      | 3.22   | 1602           |                |                |                | 1.09                       | 4.31         | 1.12         | 2.08               | A         | 6            | 6                | 3.36               | 0.96                       | 1.12         | 2.08               | 0.24          | 11.83          |  |  |
| 1803                      | 0.51          | 0.51 | 5        | 7.35      | 1.91   | 1802           |                |                |                | 0.96                       | 2.87         | 1.12         | 2.08               | A         | 6            | 6                | 2.44               | 0.43                       | 1.12         | 2.08               | 0.20          | 10.22          |  |  |

NOTES:  
 1. CAPACITY OF INLETS ON GRADE DETERMINED USING ROUTINE OUTLINED ON PGS 56-95 TO 56-97, SECTION 5600 APWA  
 2. CAPACITY OF SUMP INLETS CALCULATED USING FIGURE 5604-21, SECTION 5600 APWA  
 3. MANNINGS "n" VALUE FOR COMBINED ASPHALT PAVEMENT AND CONCRETE CURB - 0.014

EXISTING 5TH PLAT  
 FUTURE 6TH PLAT

RECORD DRAWING

The information provided on this drawing conforms to construction records; it is not intended for construction, implementation or recording purposes; and it is solely based on information obtained by Schlagel and Associates.

"100:00 100.10", "1:00% 1.15% slope", or "8-inch HDPE PVC pipe" are all typical examples of revisions that indicate that design data has been replaced with "as-built" information. All other data is as designed and has not been field verified.

Date: 8/8/2023  
 Certified by: BAL  
 Title: Design Engineer  
 Firm: Schlagel and Associates, P.A.

| REVISION DATE | DESCRIPTION       |
|---------------|-------------------|
| 8-12-22       | CITY COMMENTS     |
| 8-12-23       | AS-BUILT          |
| 8-31-23       | AS-BUILT COMMENTS |
| 9-6-23        | DATE PREPARED     |
| 9-6-22        | PROJ. NUMBER      |
| 22-034        |                   |

DRAWN BY: BAL  
 CHECKED BY: MAB  
 DATE PREPARED: 9-6-22  
 PROJ. NUMBER: 22-034

MASTER DRAINAGE PLAN - DRAINAGE CALCS CONT SHEET

7