



DWG: C:\Temp\AcPublish_15120\XASB-LOT1PONDS_02104157.dwg
DATE: Oct 31, 2023 10:48am
USER: ttraynor

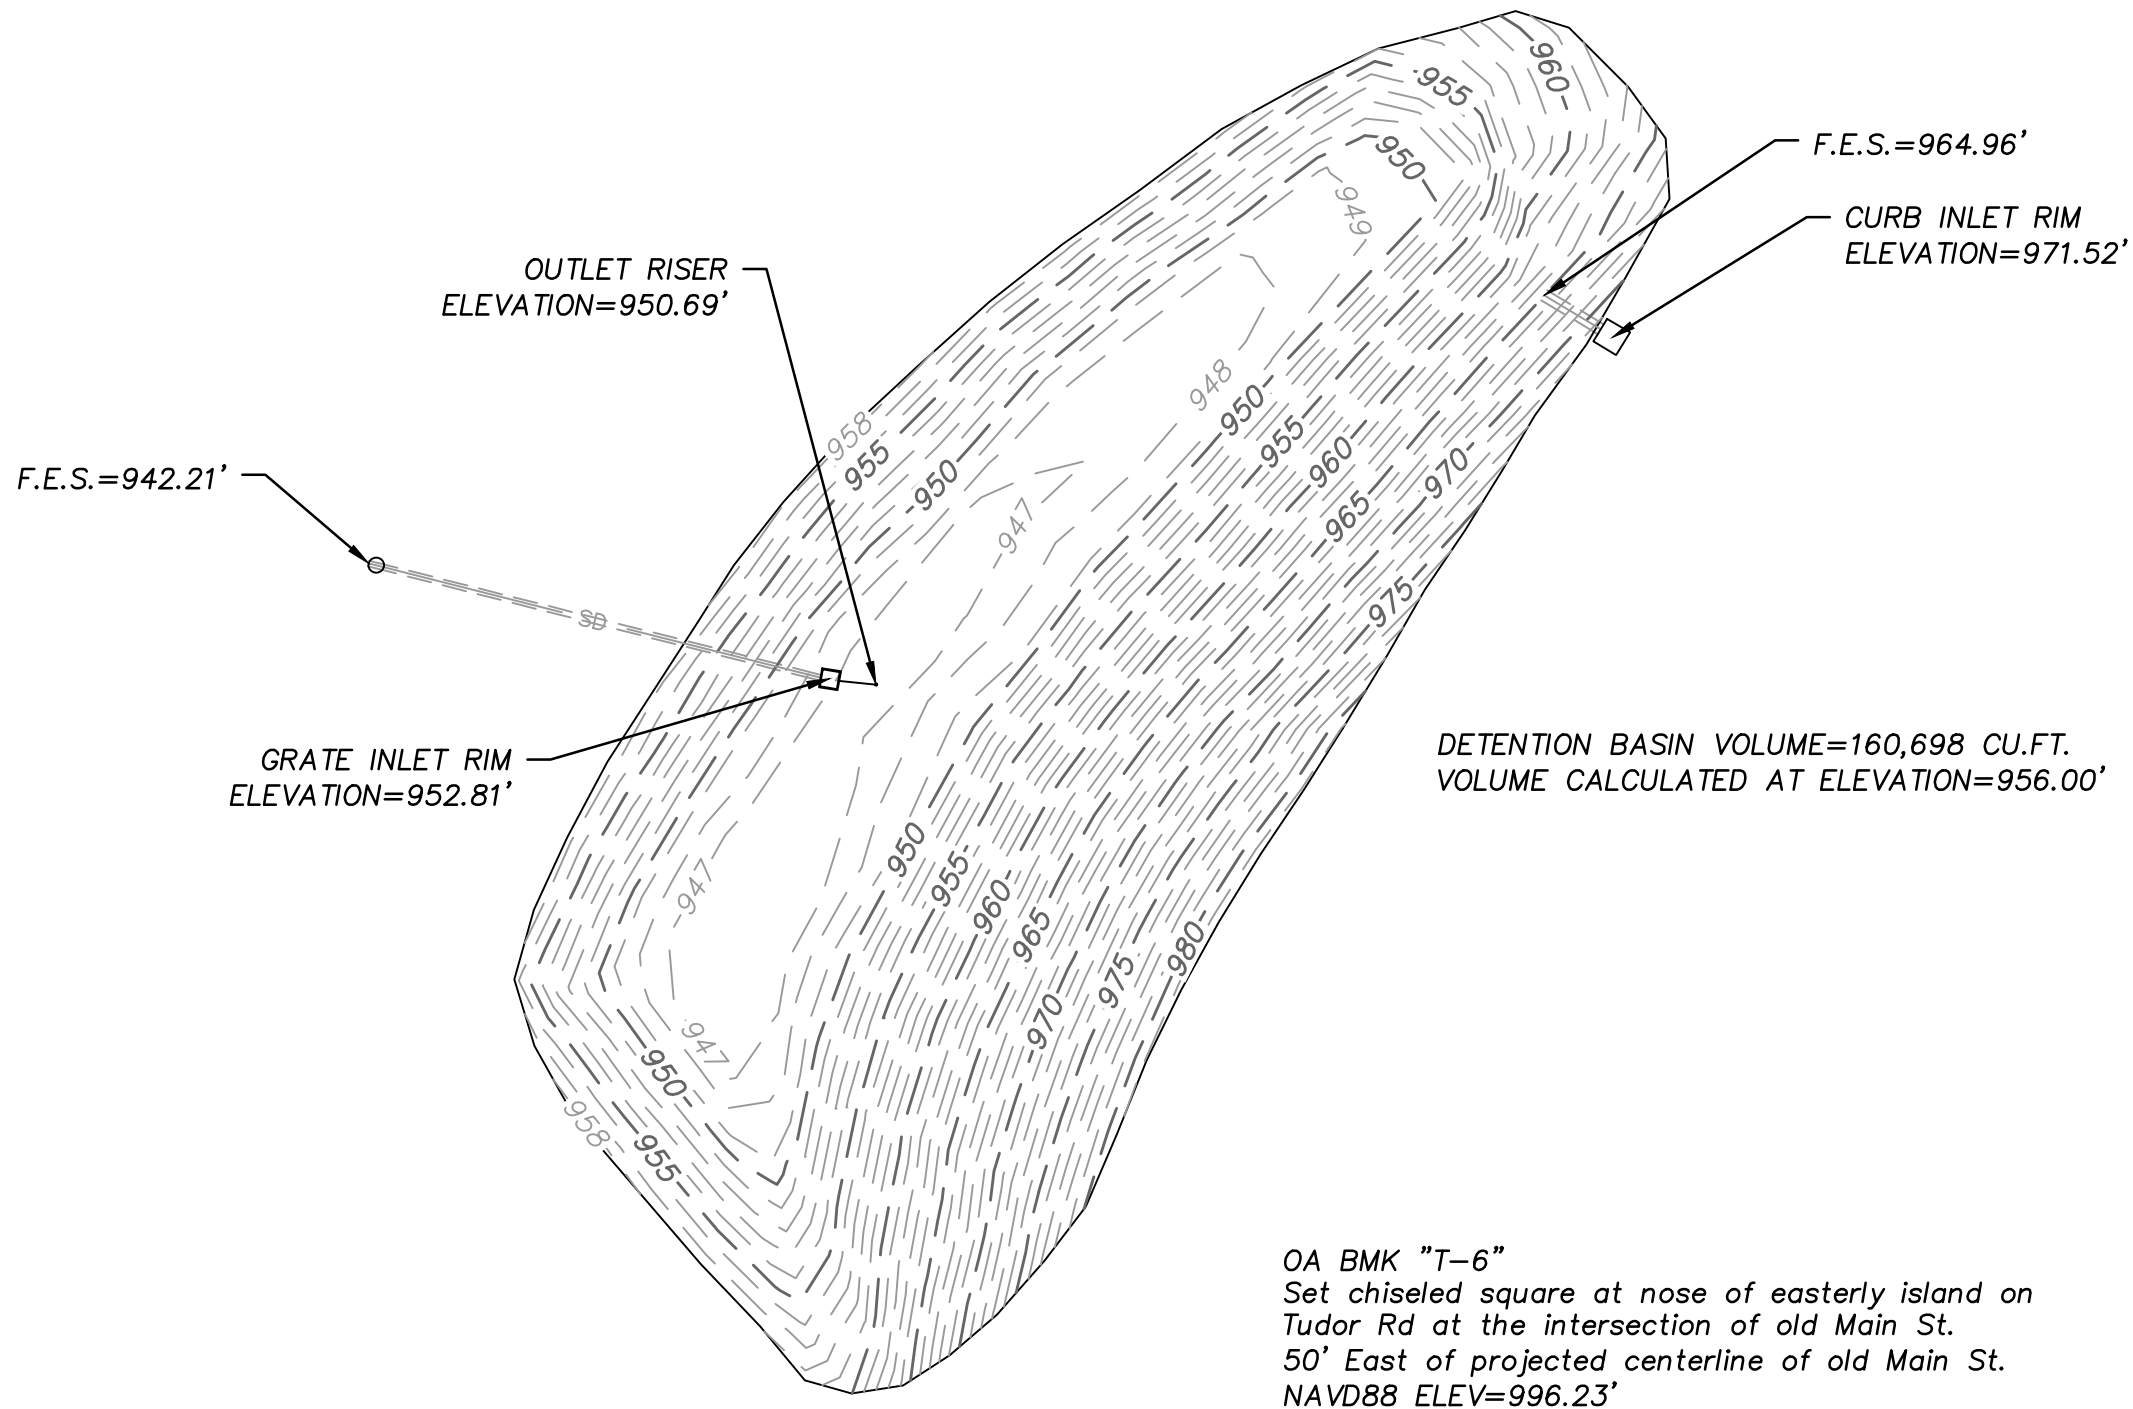

OA BMK "T-6"
Set chiseled square at nose of easterly island on
Tudor Rd at the intersection of old Main St.
50' East of projected centerline of old Main St.
NAVD88 ELEV=996.23'

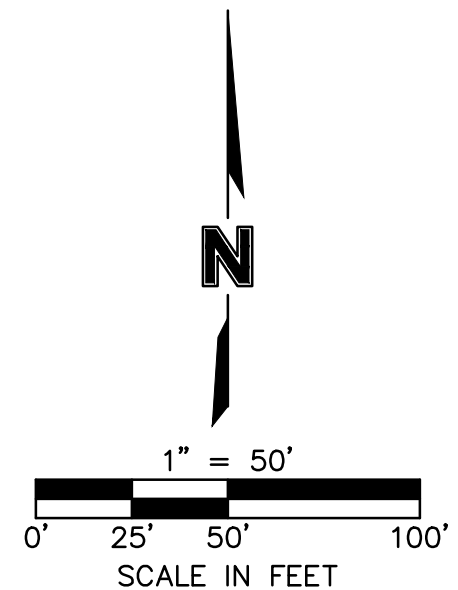

PROJECT NO: 21-04157

DRAWN BY: TWT

DATE: 10-13-2023


Lee's Summit Logistics Lot 1 - Northwest Detention Pond Volume As-built

olsson

7301 West 133rd Street
Suite 200
Overland Park, KS 66213-4750
TEL 913.381.1170

EXHIBIT

1

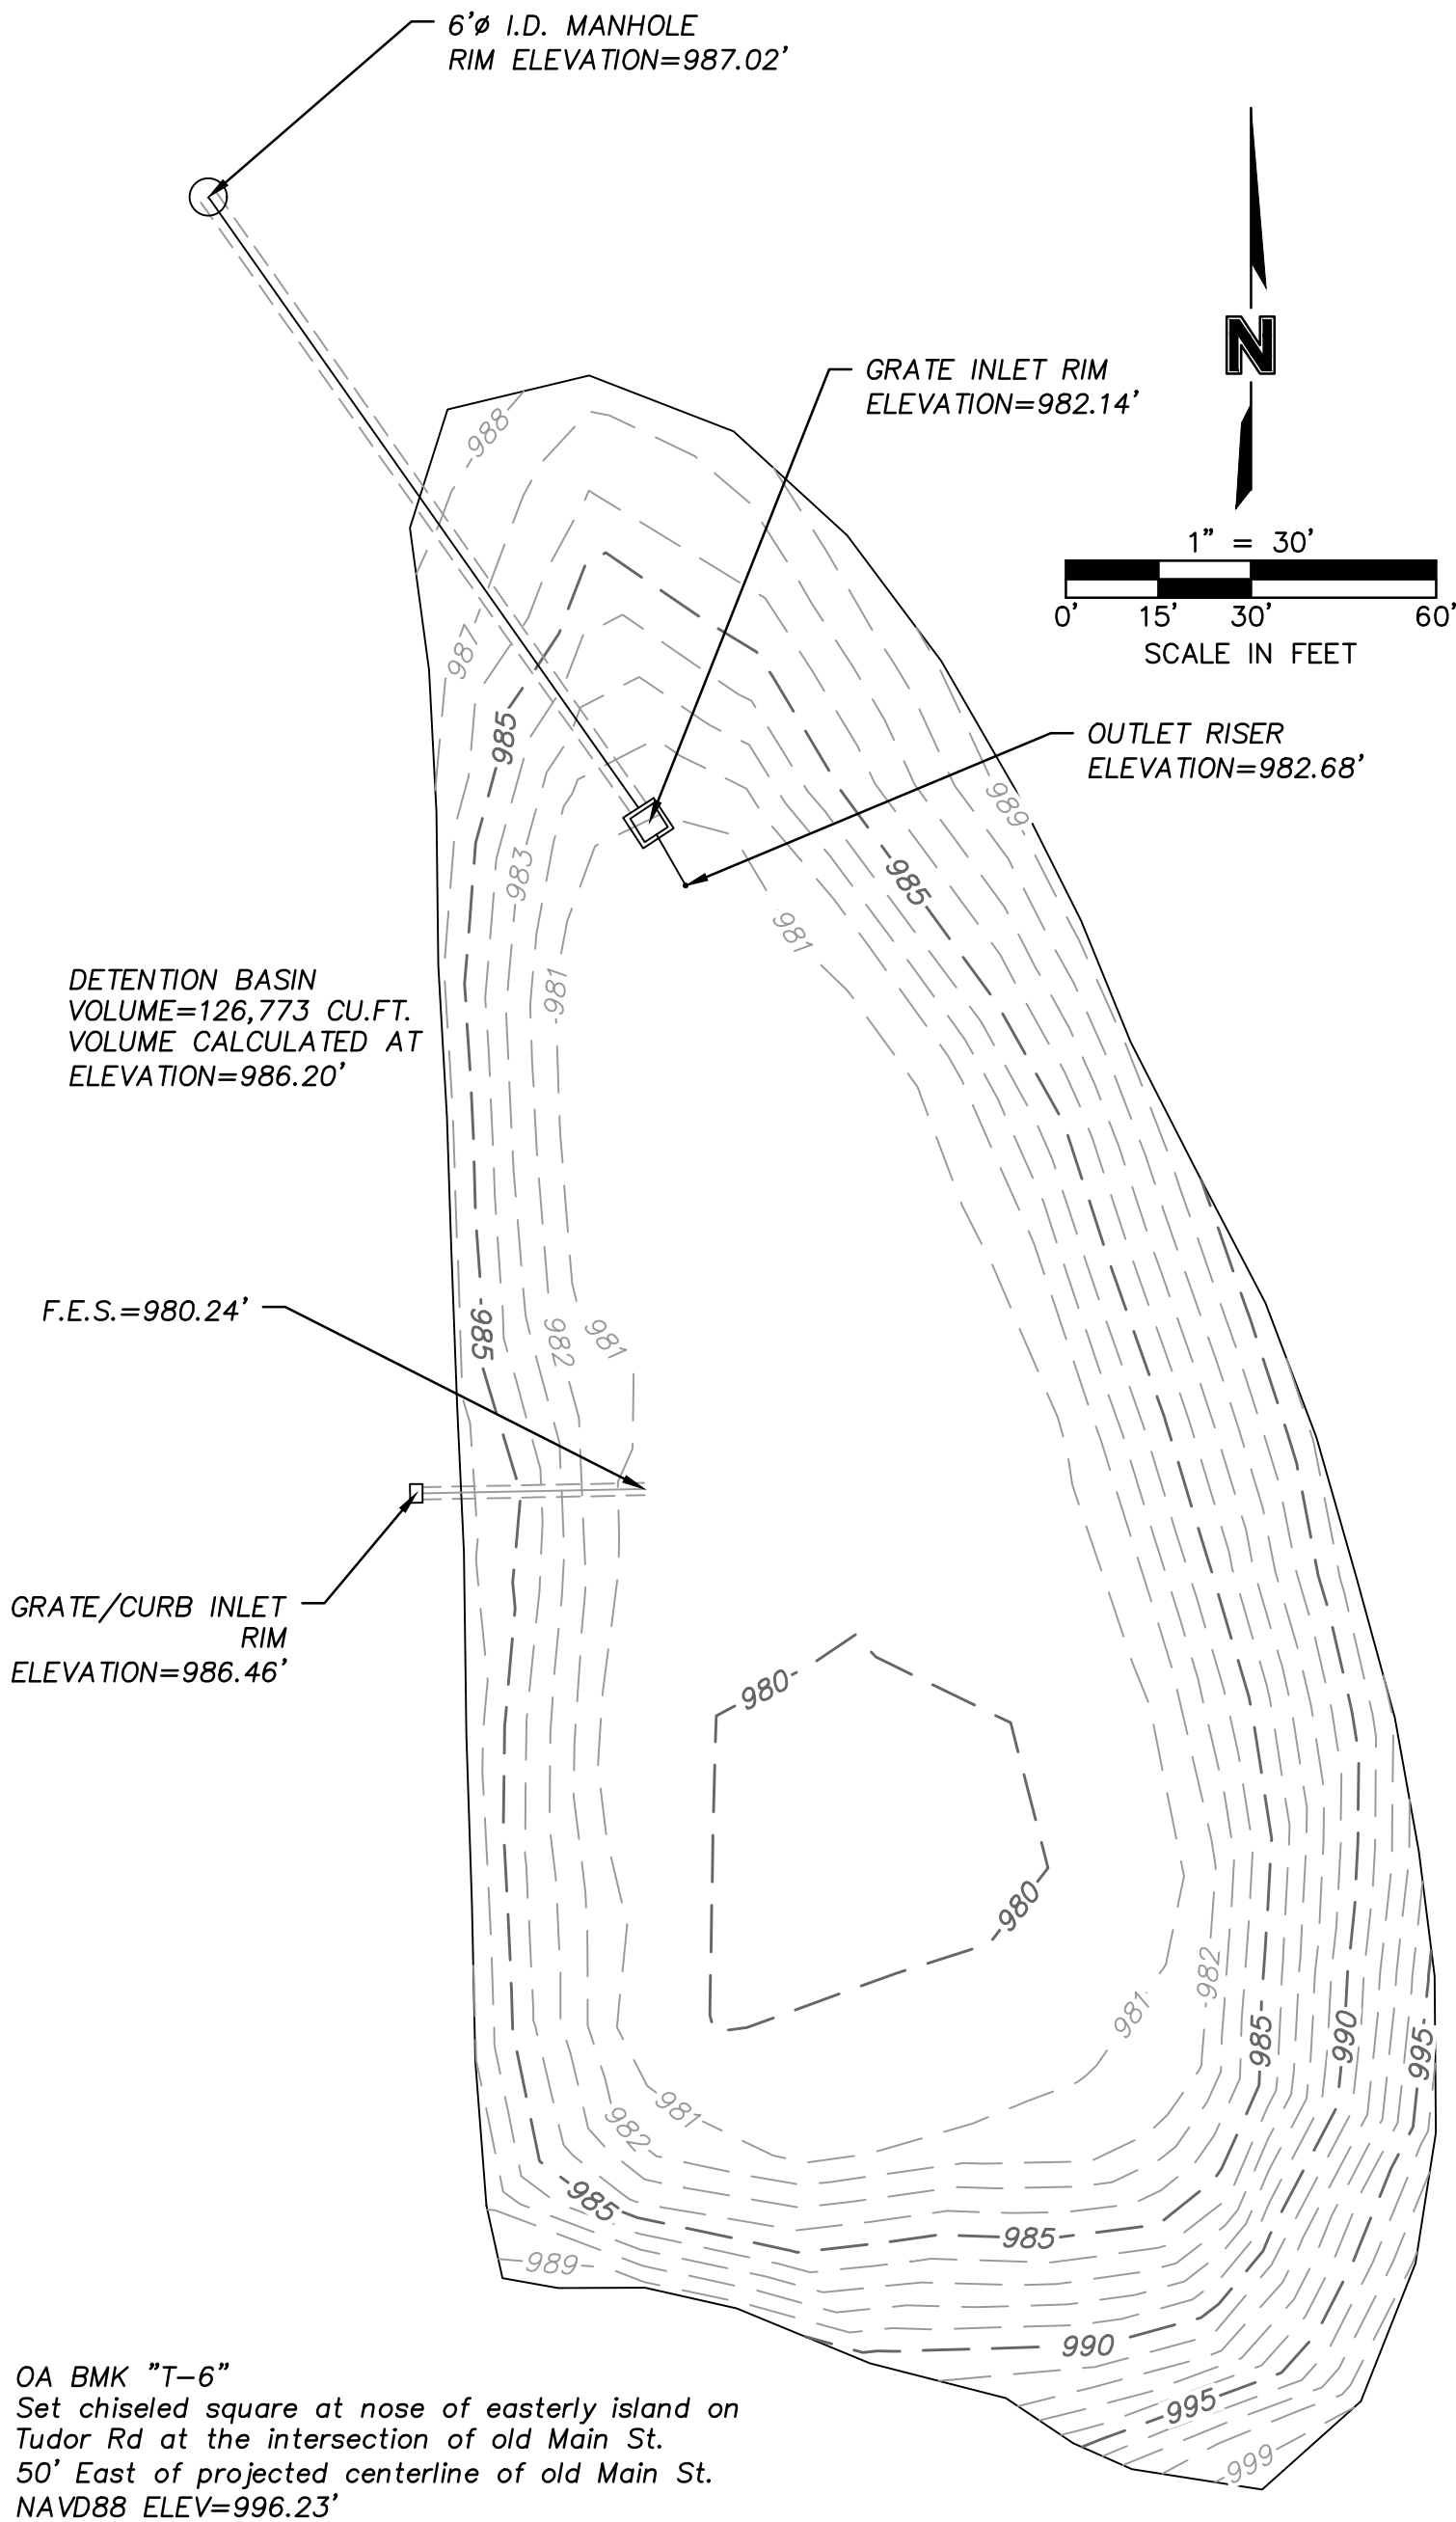

DWG: C:\Temp\AcPublish_15120\V_XASB-LOTIPONDS_02104157.dwg
DATE: Oct 31, 2023 10:48am
USER: ttraynor
XREFS:


PROJECT NO:	21-04157
DRAWN BY:	TWT
DATE:	10-13-2023

Lee's Summit Logistics Lot 1 -
Northwest Detention Pond Volume As-built

7301 West 133rd Street
Suite 200
Overland Park, KS 66213-4750
TEL 913.381.1170

EXHIBIT
1

DWG: C:\Temp\AcPublish_15120\XASB-LOT1PONDS_02104157.dwg
DATE: Oct 31, 2023 10:48am
USER: ttraynor
XREFS:

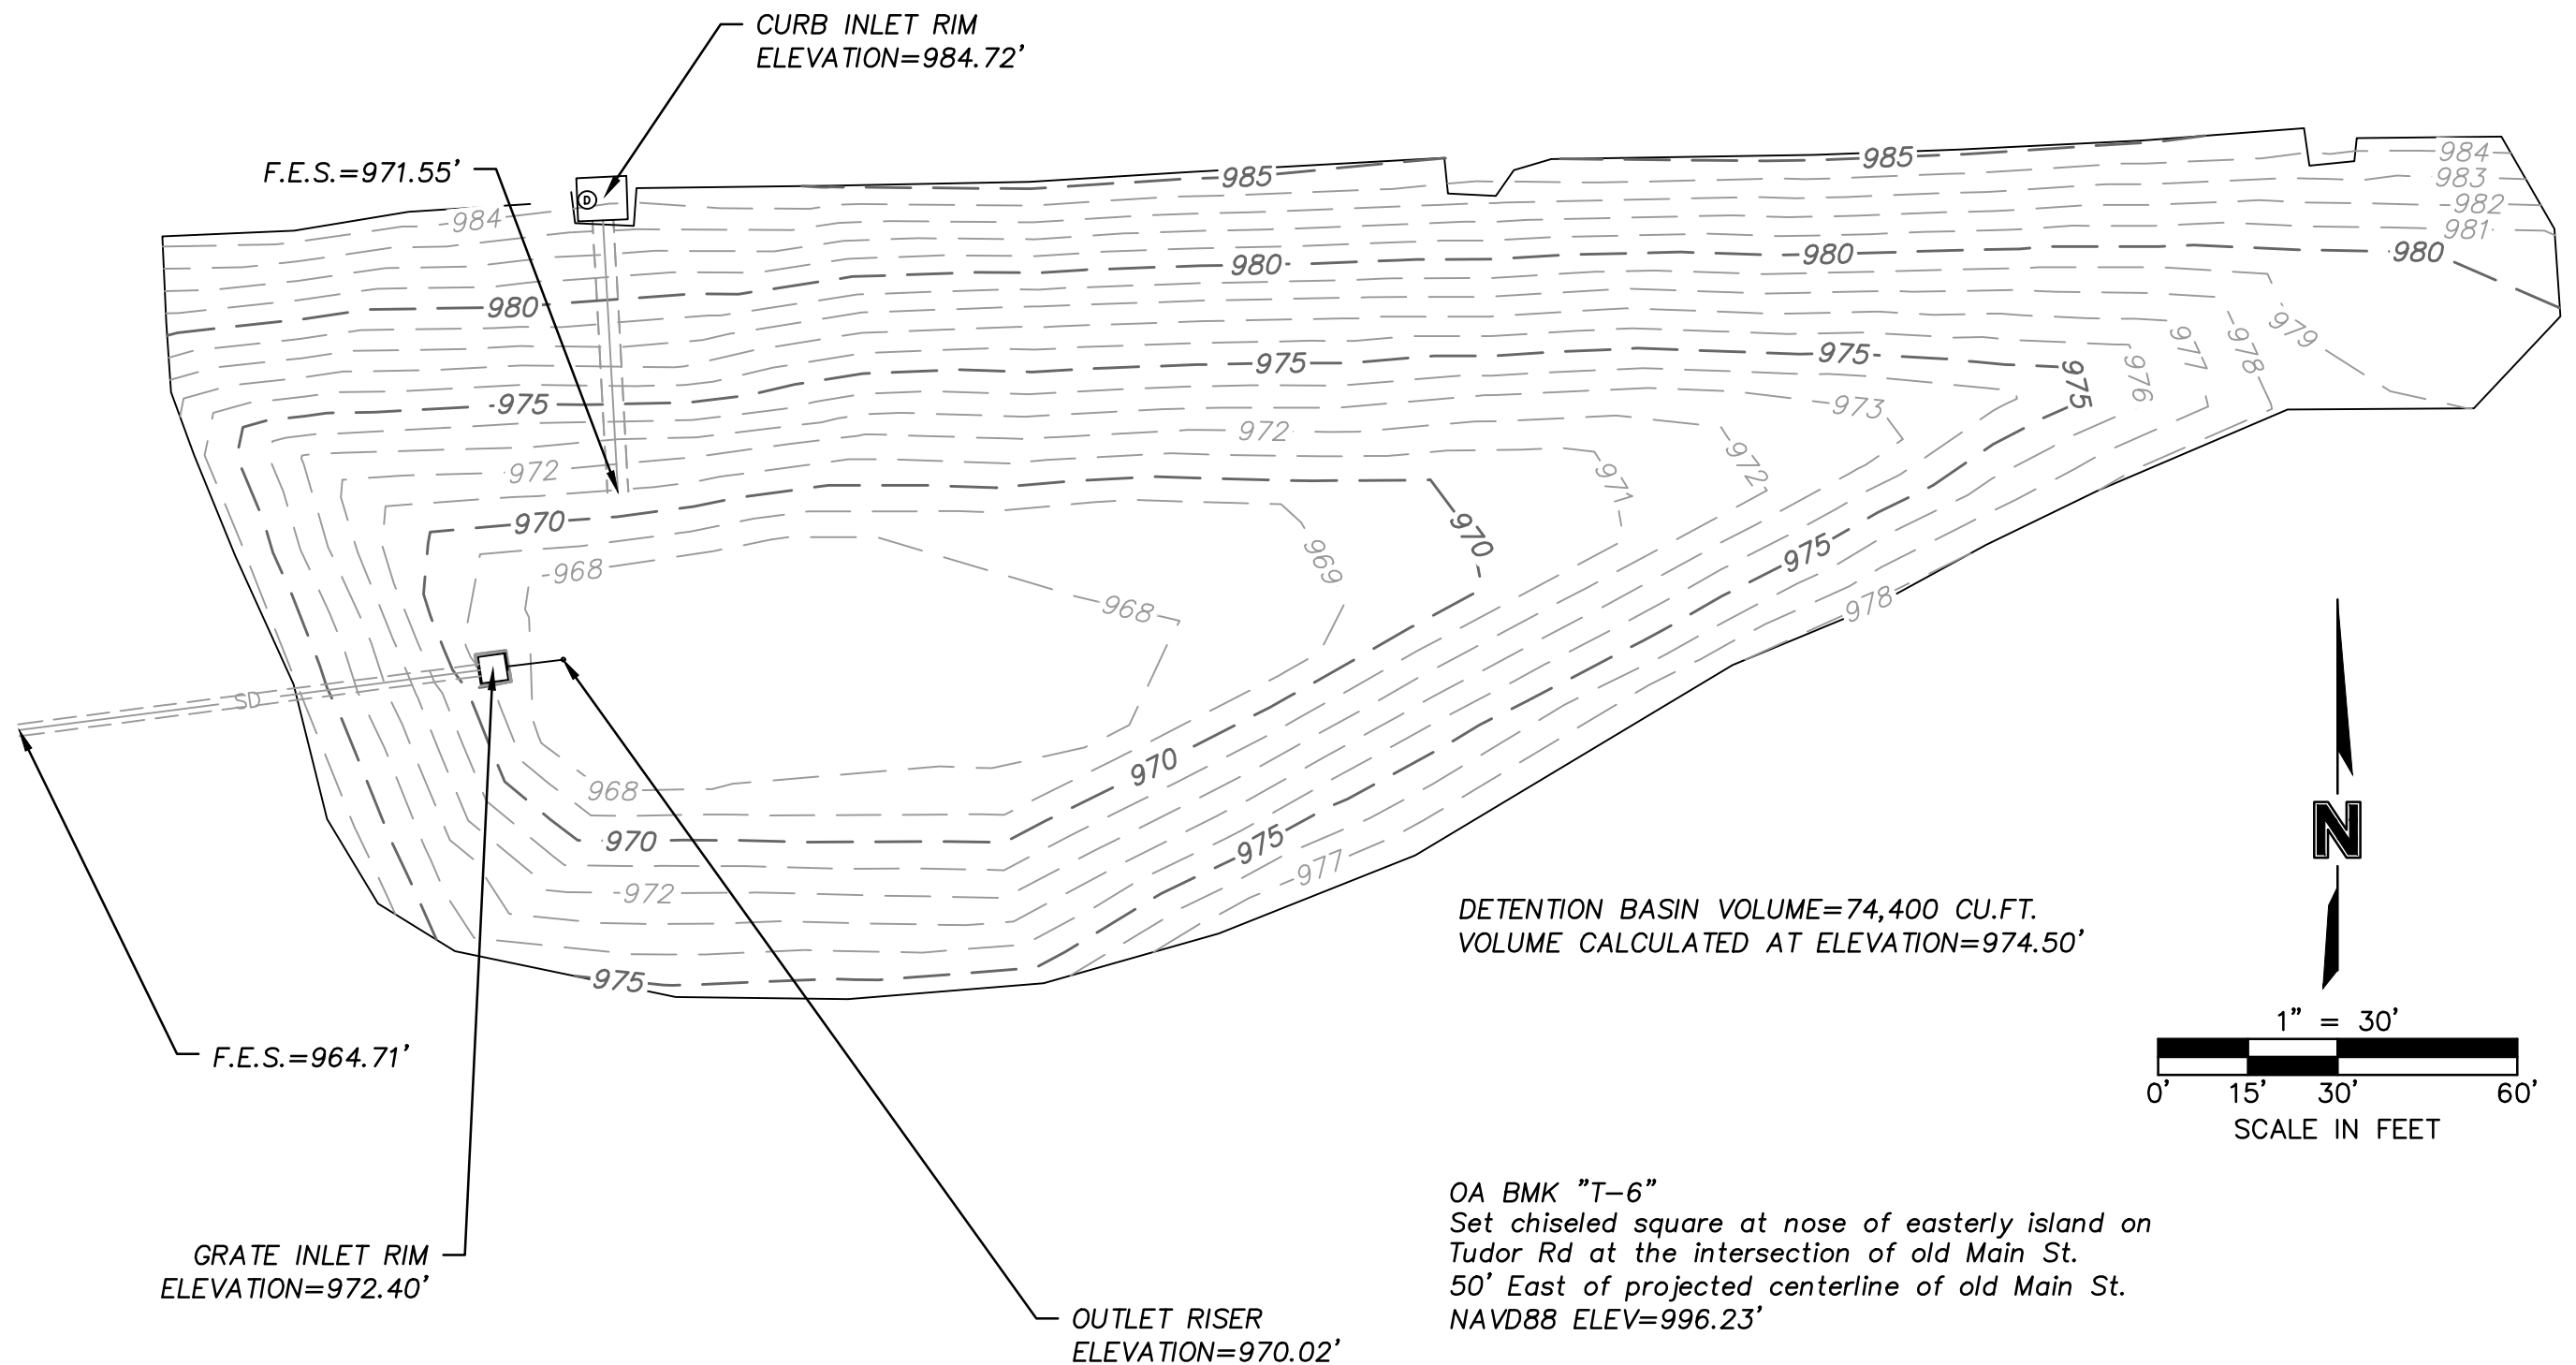

PROJECT NO: 21-04157

DRAWN BY: TWT

DATE: 10-13-2023

Lee's Summit Logistics Lot 1 - South Detention Pond Volume As-built

olsson

7301 West 133rd Street
Suite 200
Overland Park, KS 66213-4750
TEL 913.381.1170

EXHIBIT

1