



Architect: _____

MIDWEST ARCHITECTS
1120 NW Eagle Ridge Blvd.
Grain Valley, Missouri 64029
t: (816) 229-8115

Client:

Ward Development
1120 NW Eagle Ridge Blvd.
Grain Valley, Missouri 64029
t: (816) 229-8115

Consultants: _____

Civil Engineering:
Engineering Solutions
50 SE 30th Street
Lee's Summit, Missouri 64082
t: (816) 623-9888

Structural Engineering:
Structura Logica
18901 E. 299th Street
Harrisonville, MO 64701
t: (816) 872-4883

MEP Engineering:
JSC Engineers
1925 Central Street, Suite 201
Kansas City, MO 64108
t: (816) 272-5289

Revisions to technical submissions which are not made or approved by the licensee are prohibited.



Michael Moores, MO Architect #2009032812

Project Number: 2307

Project Type: NEW CONSTRUCTION

Project Name and Address:

**LAKEWOOD BUSINESS CENTER,
LOT 1
NE Maguire Blvd
Lee's Summit, Missouri 64064**


Issue:	Date:
Permit Set	08.31.23

Sheet Title:

AREA PLAN - WEST

ENLARGED PLAN

A-110

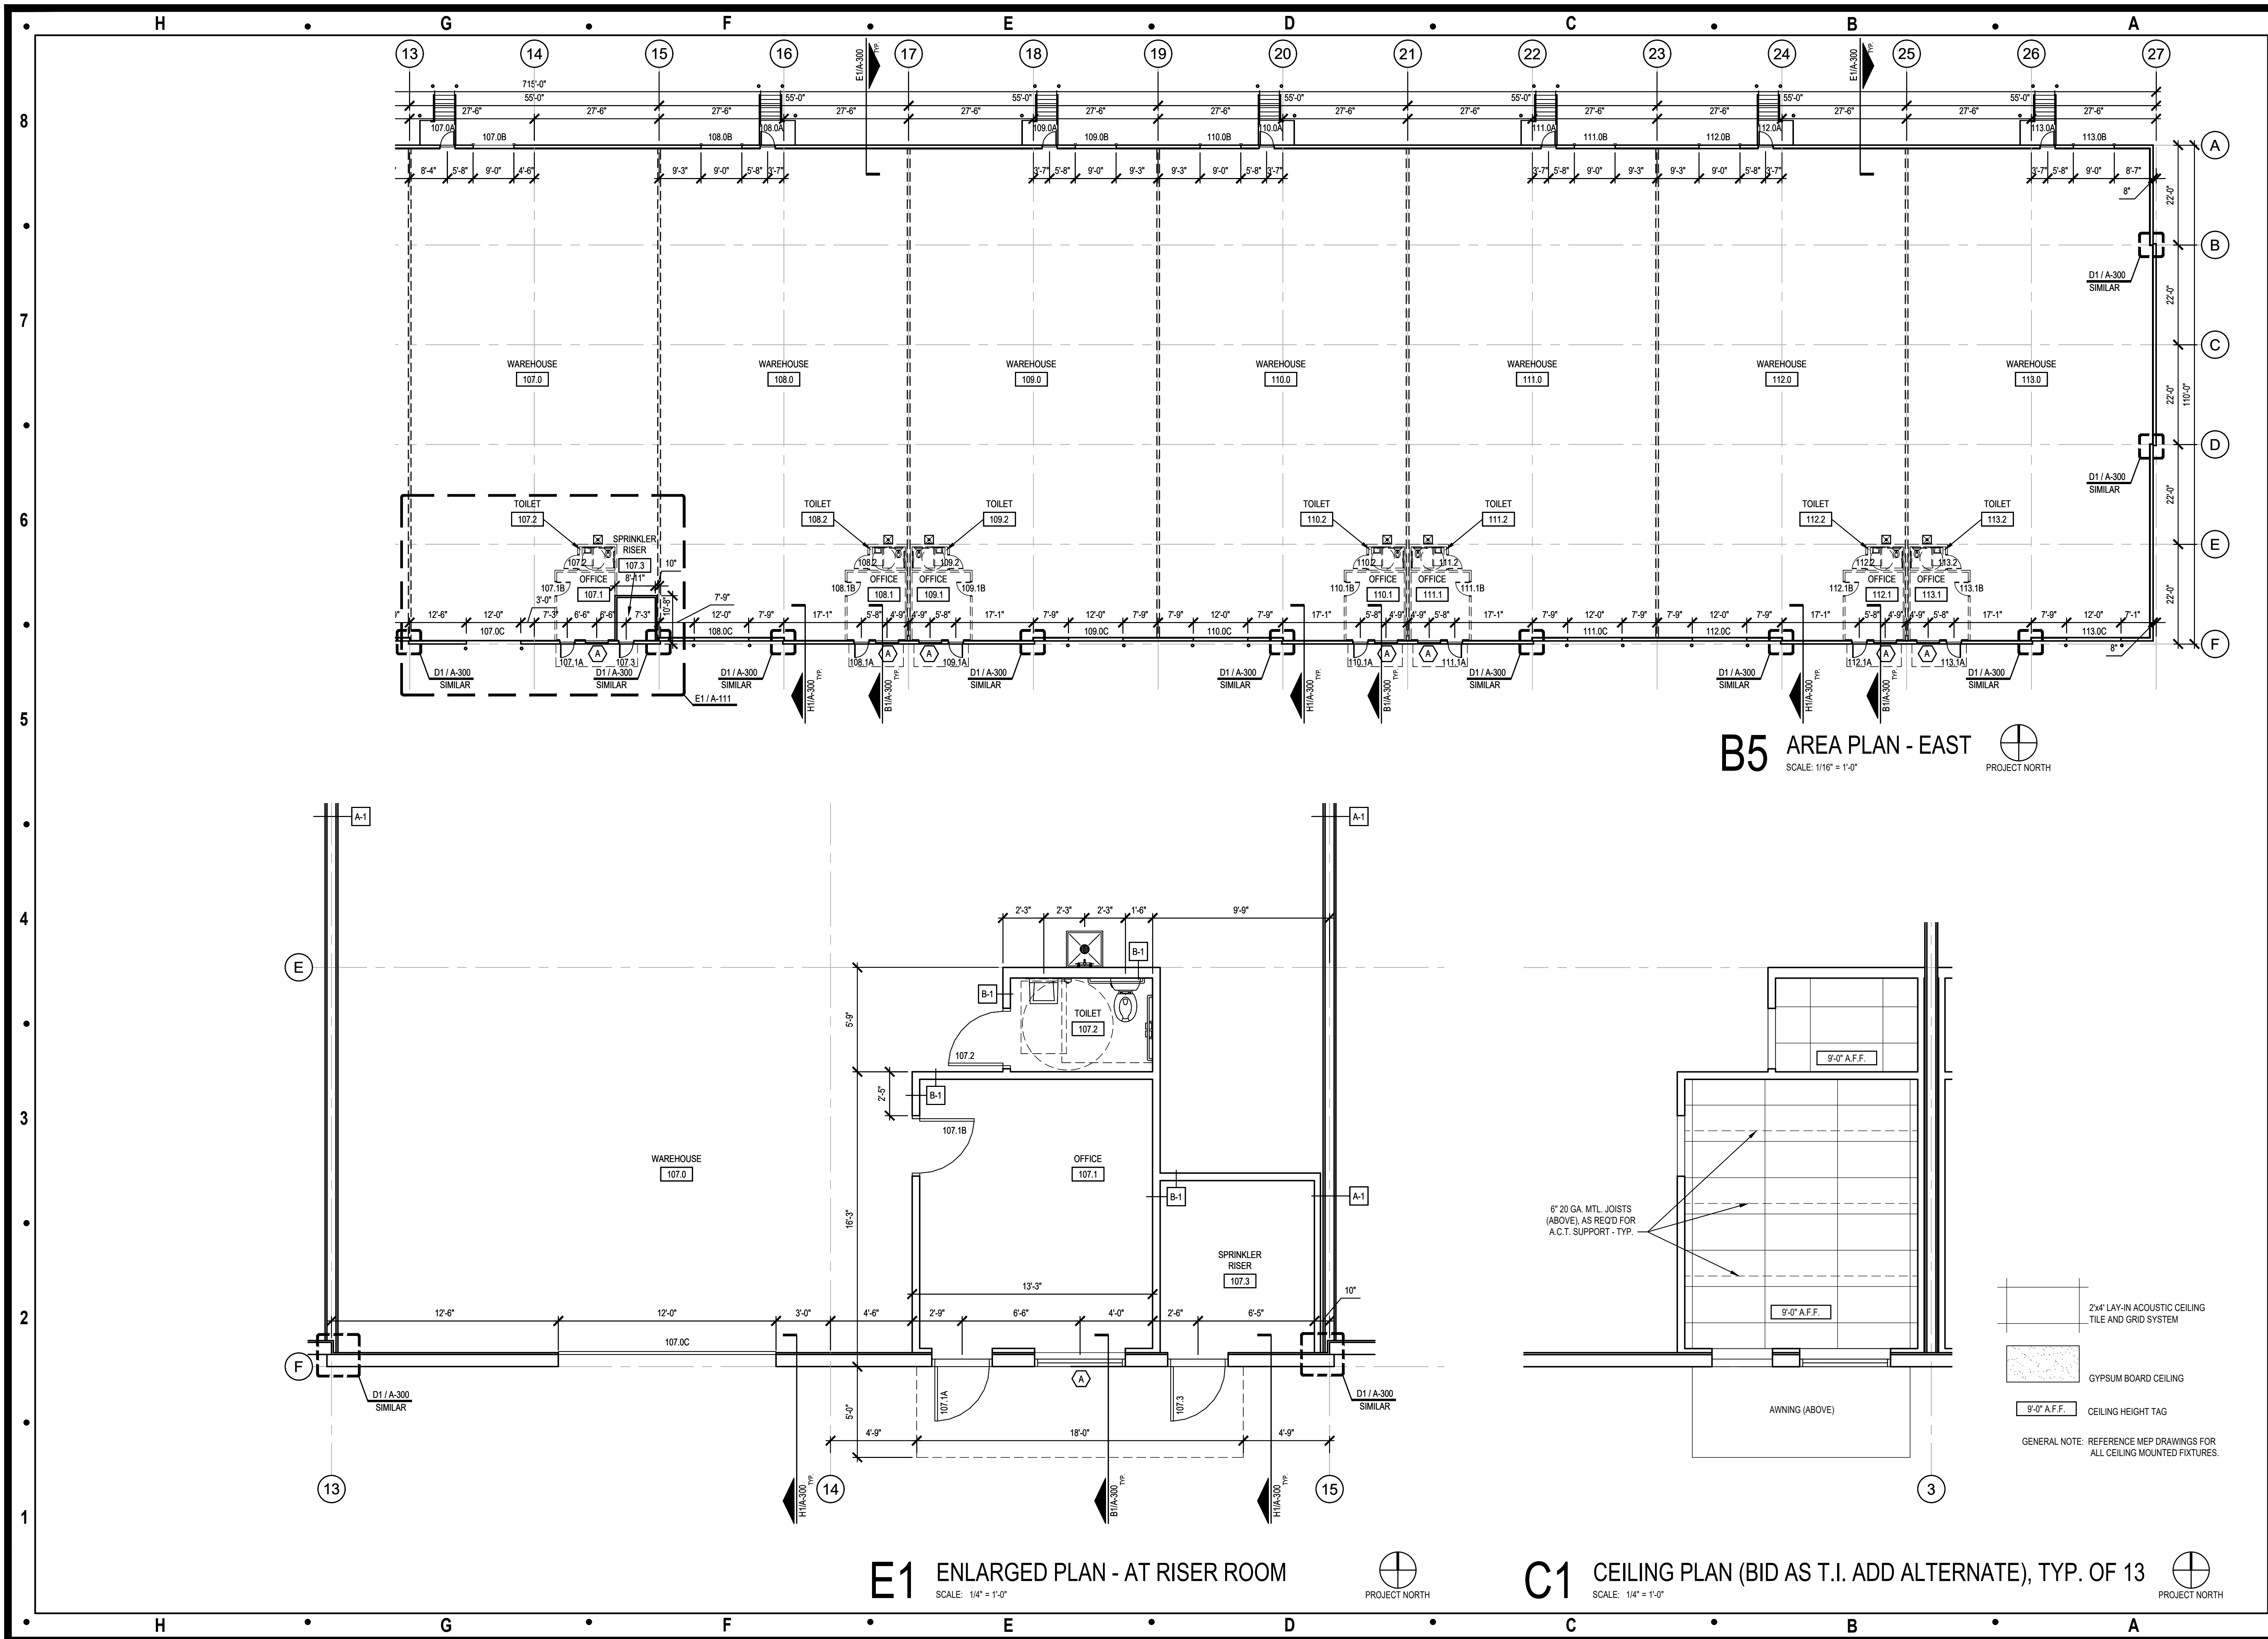

Architect:

MIDWEST ARCHITECTS
1120 NW Eagle Ridge Blvd.
Grain Valley, Missouri 64029
t: (816) 229-8115

Client:

Ward Development
1120 NW Eagle Ridge Blvd.
Grain Valley, Missouri 64029
t: (816) 229-8115

Consultants:

Civil Engineering:
Engineering Solutions
50 SE 30th Street
Lee's Summit, Missouri 64082
t: (816) 623-9888

Structural Engineering:
Structura Logica
18901 E. 299th Street
Harrisonville, MO 64701
t: (816) 872-4883

MEP Engineering:
JSC Engineers
1925 Central Street, Suite 201
Kansas City, MO 64108
t: (816) 272-5289

Revisions to technical submissions which are not made or approved by the licensee are prohibited.

Seal:

MICHAEL MOORES
NUMBER A-2009032812
ARCHITECT
08.31.23

Michael Moores, MO Architect #2009032812


Project Number: 2307
Project Type: NEW CONSTRUCTION
Project Name and Address:

LAKWOOD BUSINESS CENTER,
LOT 1
NE Maguire Blvd
Lee's Summit, Missouri 64064

Issue: Date:
Permit Set 08.31.23

Sheet Title:

AREA PLAN - EAST
ENLARGED PLAN
CEILING PLAN
A-111

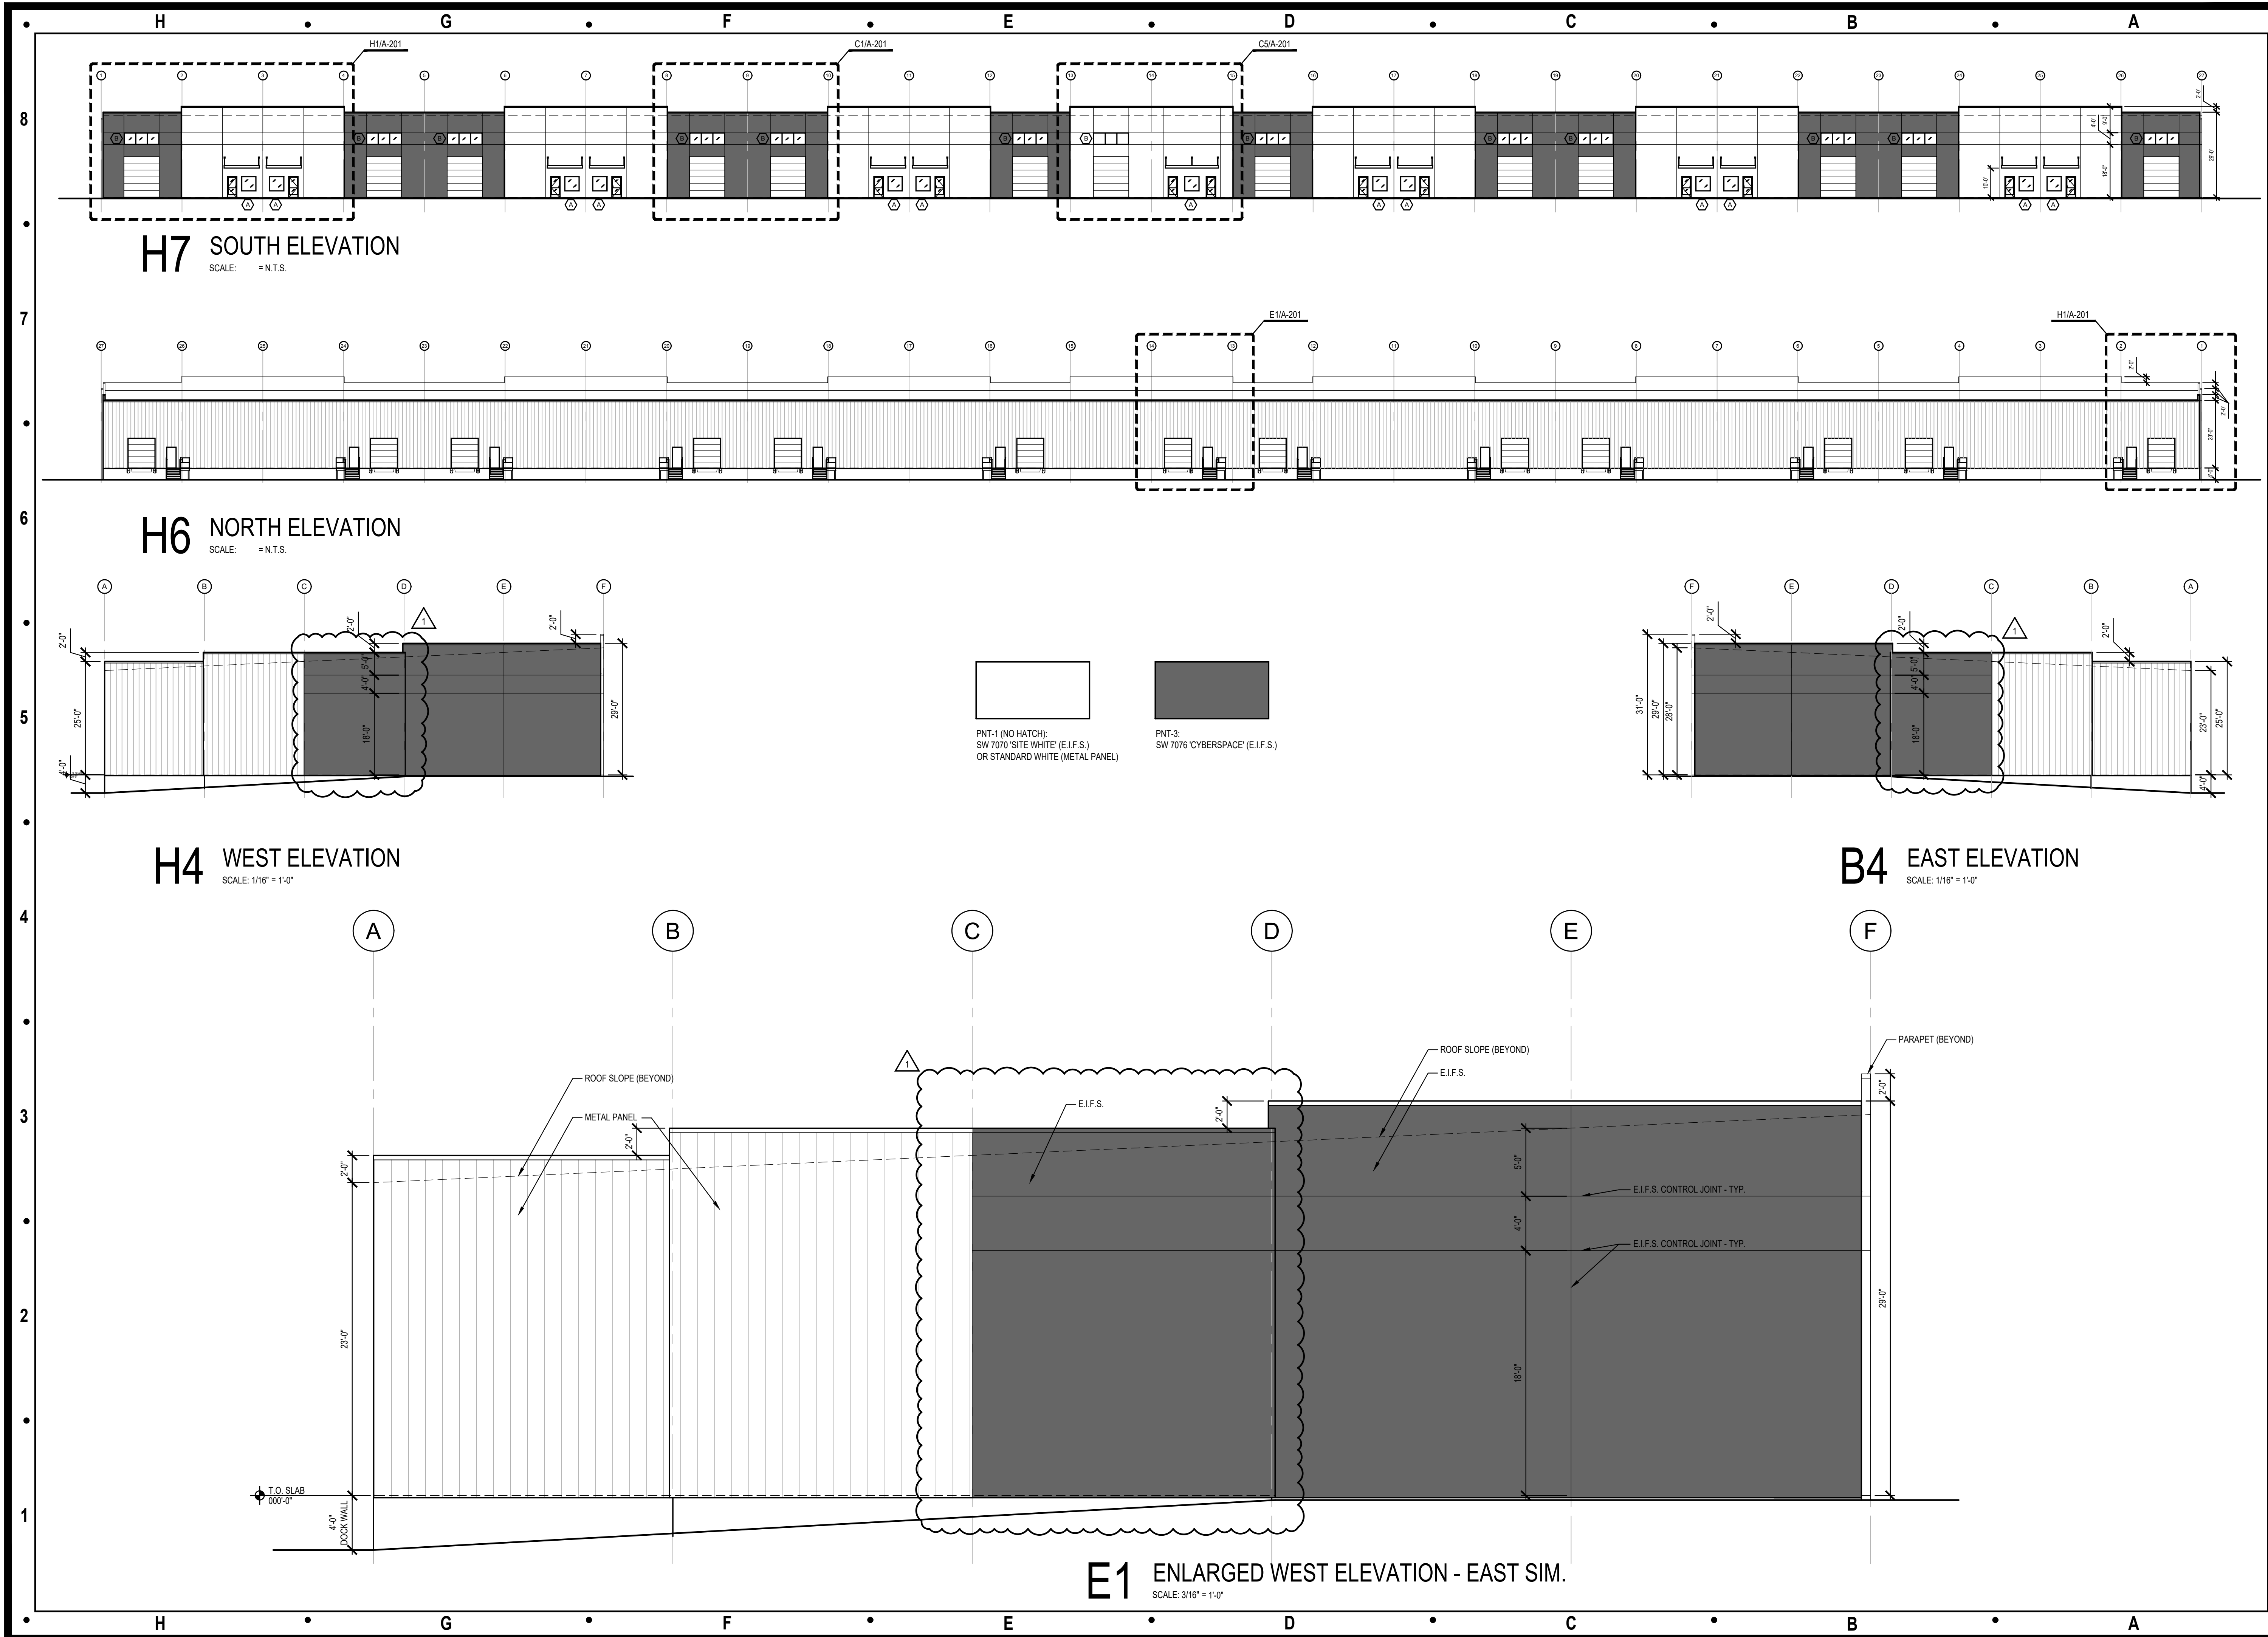

Architect:

MIDWEST ARCHITECTS
1120 NW Eagle Ridge Blvd.
Grain Valley, Missouri 64029
t: (816) 229-8115


Client:
Ward Development
1120 NW Eagle Ridge Blvd.
Grain Valley, Missouri 64029
t: (816) 229-8115

Consultants:
Civil Engineering:
Engineering Solutions
50 SE 30th Street
Lee's Summit, Missouri 64082
t: (816) 623-9888

Structural Engineering:
Structura Logica
18901 E. 299th Street
Harrisonville, MO 64701
t: (816) 872-4883

MEP Engineering:
JSC Engineers
1925 Central Street, Suite 201
Kansas City, MO 64108
t: (816) 272-5289

Revisions to technical submissions which are not made or approved by the licensee are prohibited.

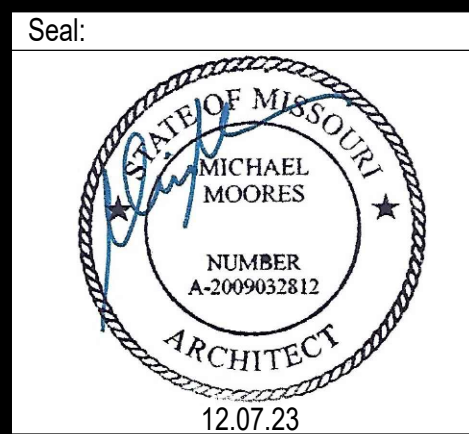

Michael Moore, MO Architect #2009932812
Project Number: 2307
Project Type: NEW CONSTRUCTION
Project Name and Address:

LAKWOOD BUSINESS CENTER,
LOT 1
NE Maguire Blvd
Lee's Summit, Missouri 64064

Issue: Date:
Permit Set 08.31.23
Plan Review Comments 12.07.23

Sheet Title:
EXTERIOR
ELEVATIONS

A-200



A-201