




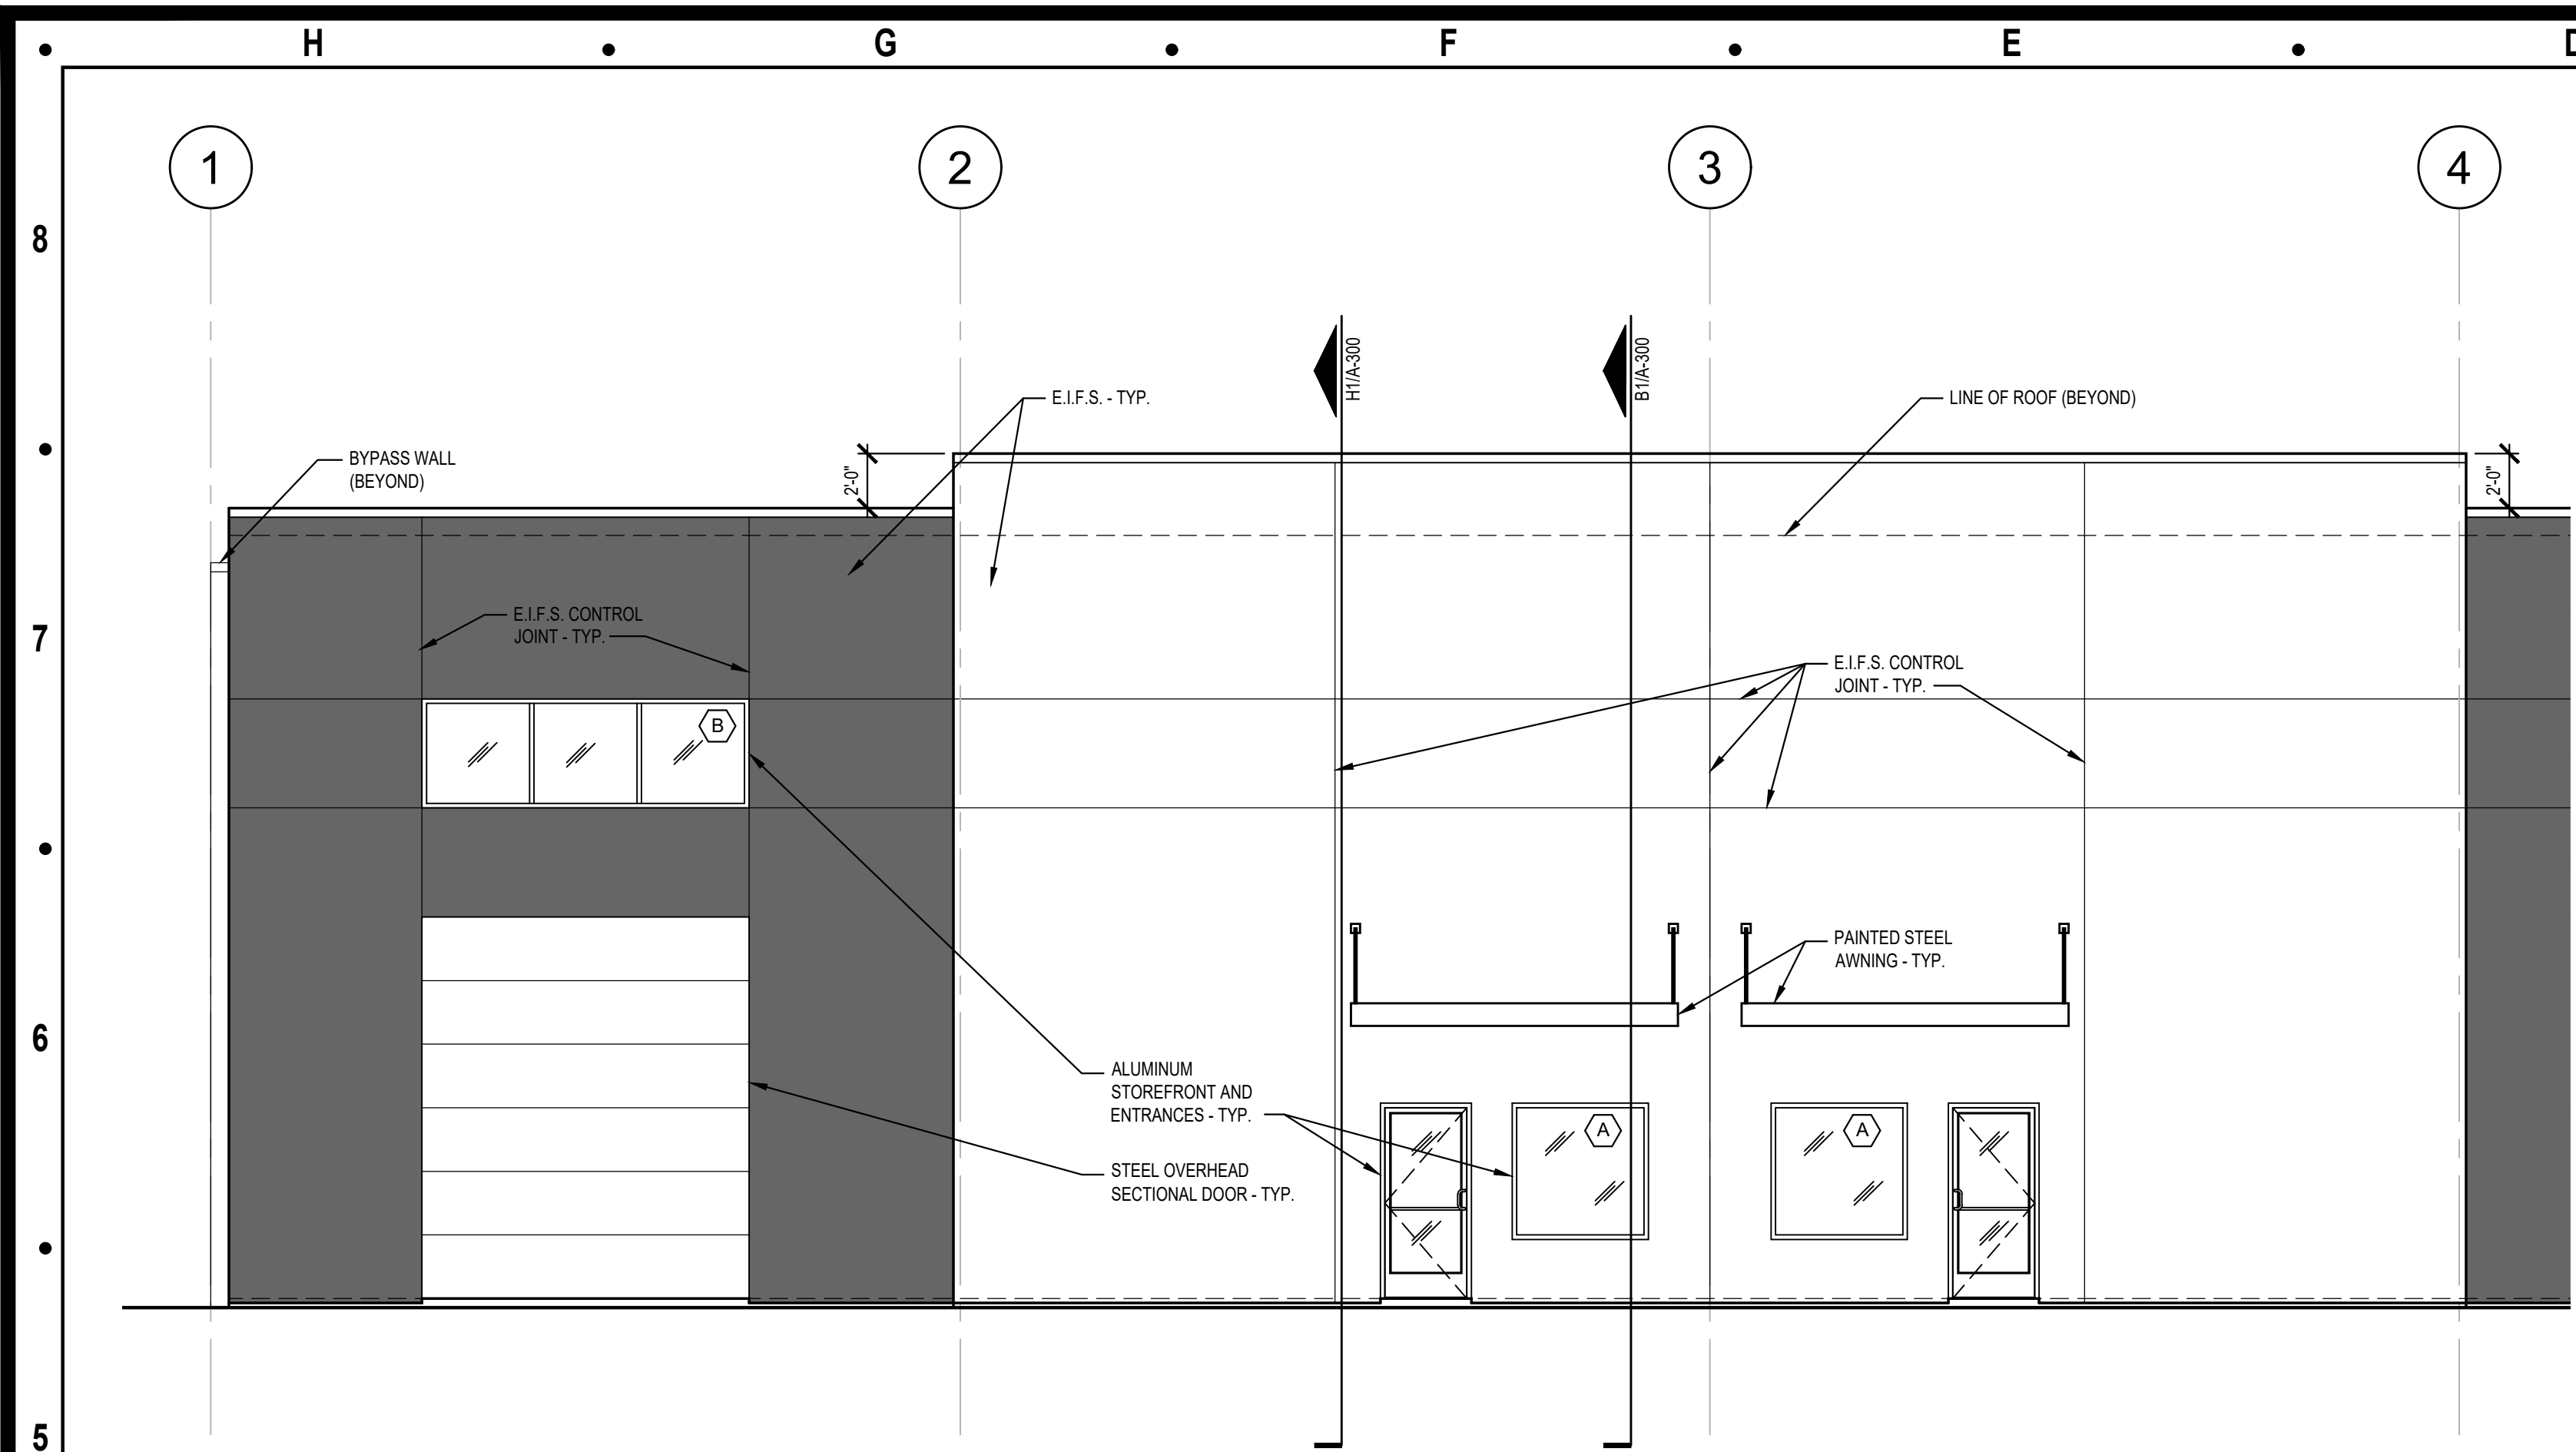


H5 ENLARGED SOUTH ELEVATION
SCALE: 3/16" = 1'-0"

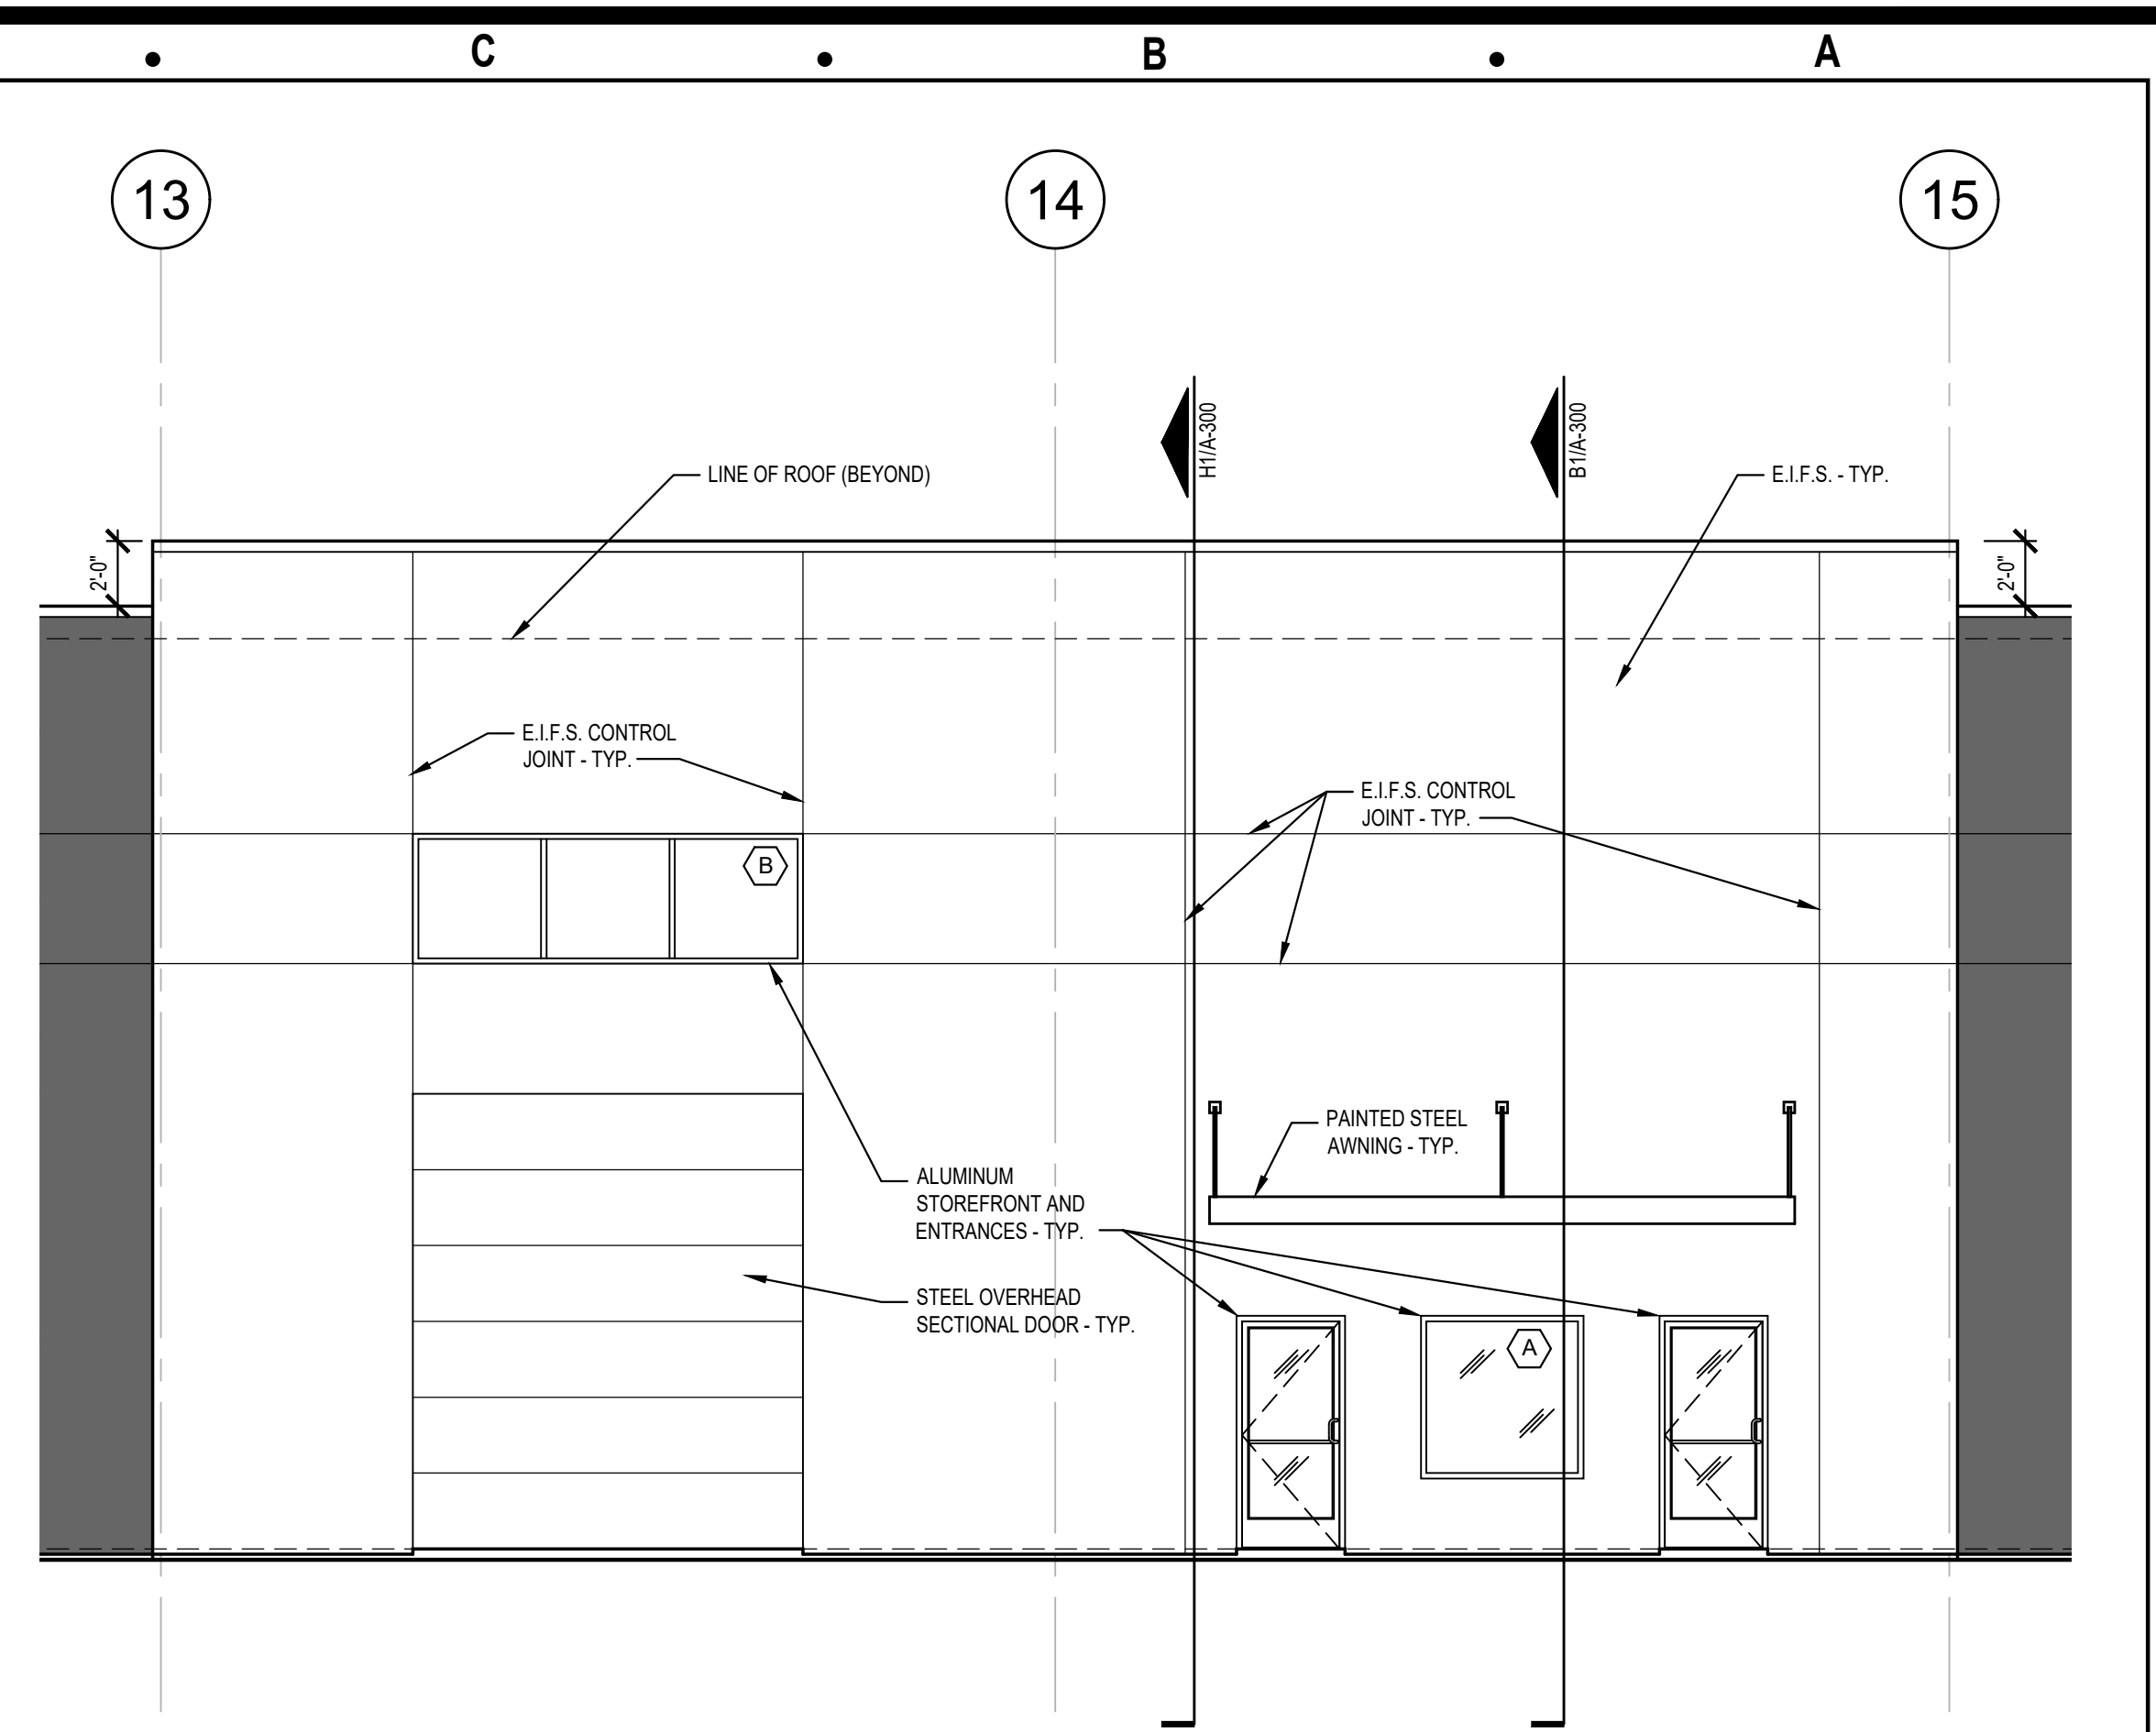


C5 ENLARGED SOUTH ELEVATION
SCALE: 3/16" = 1'-0"

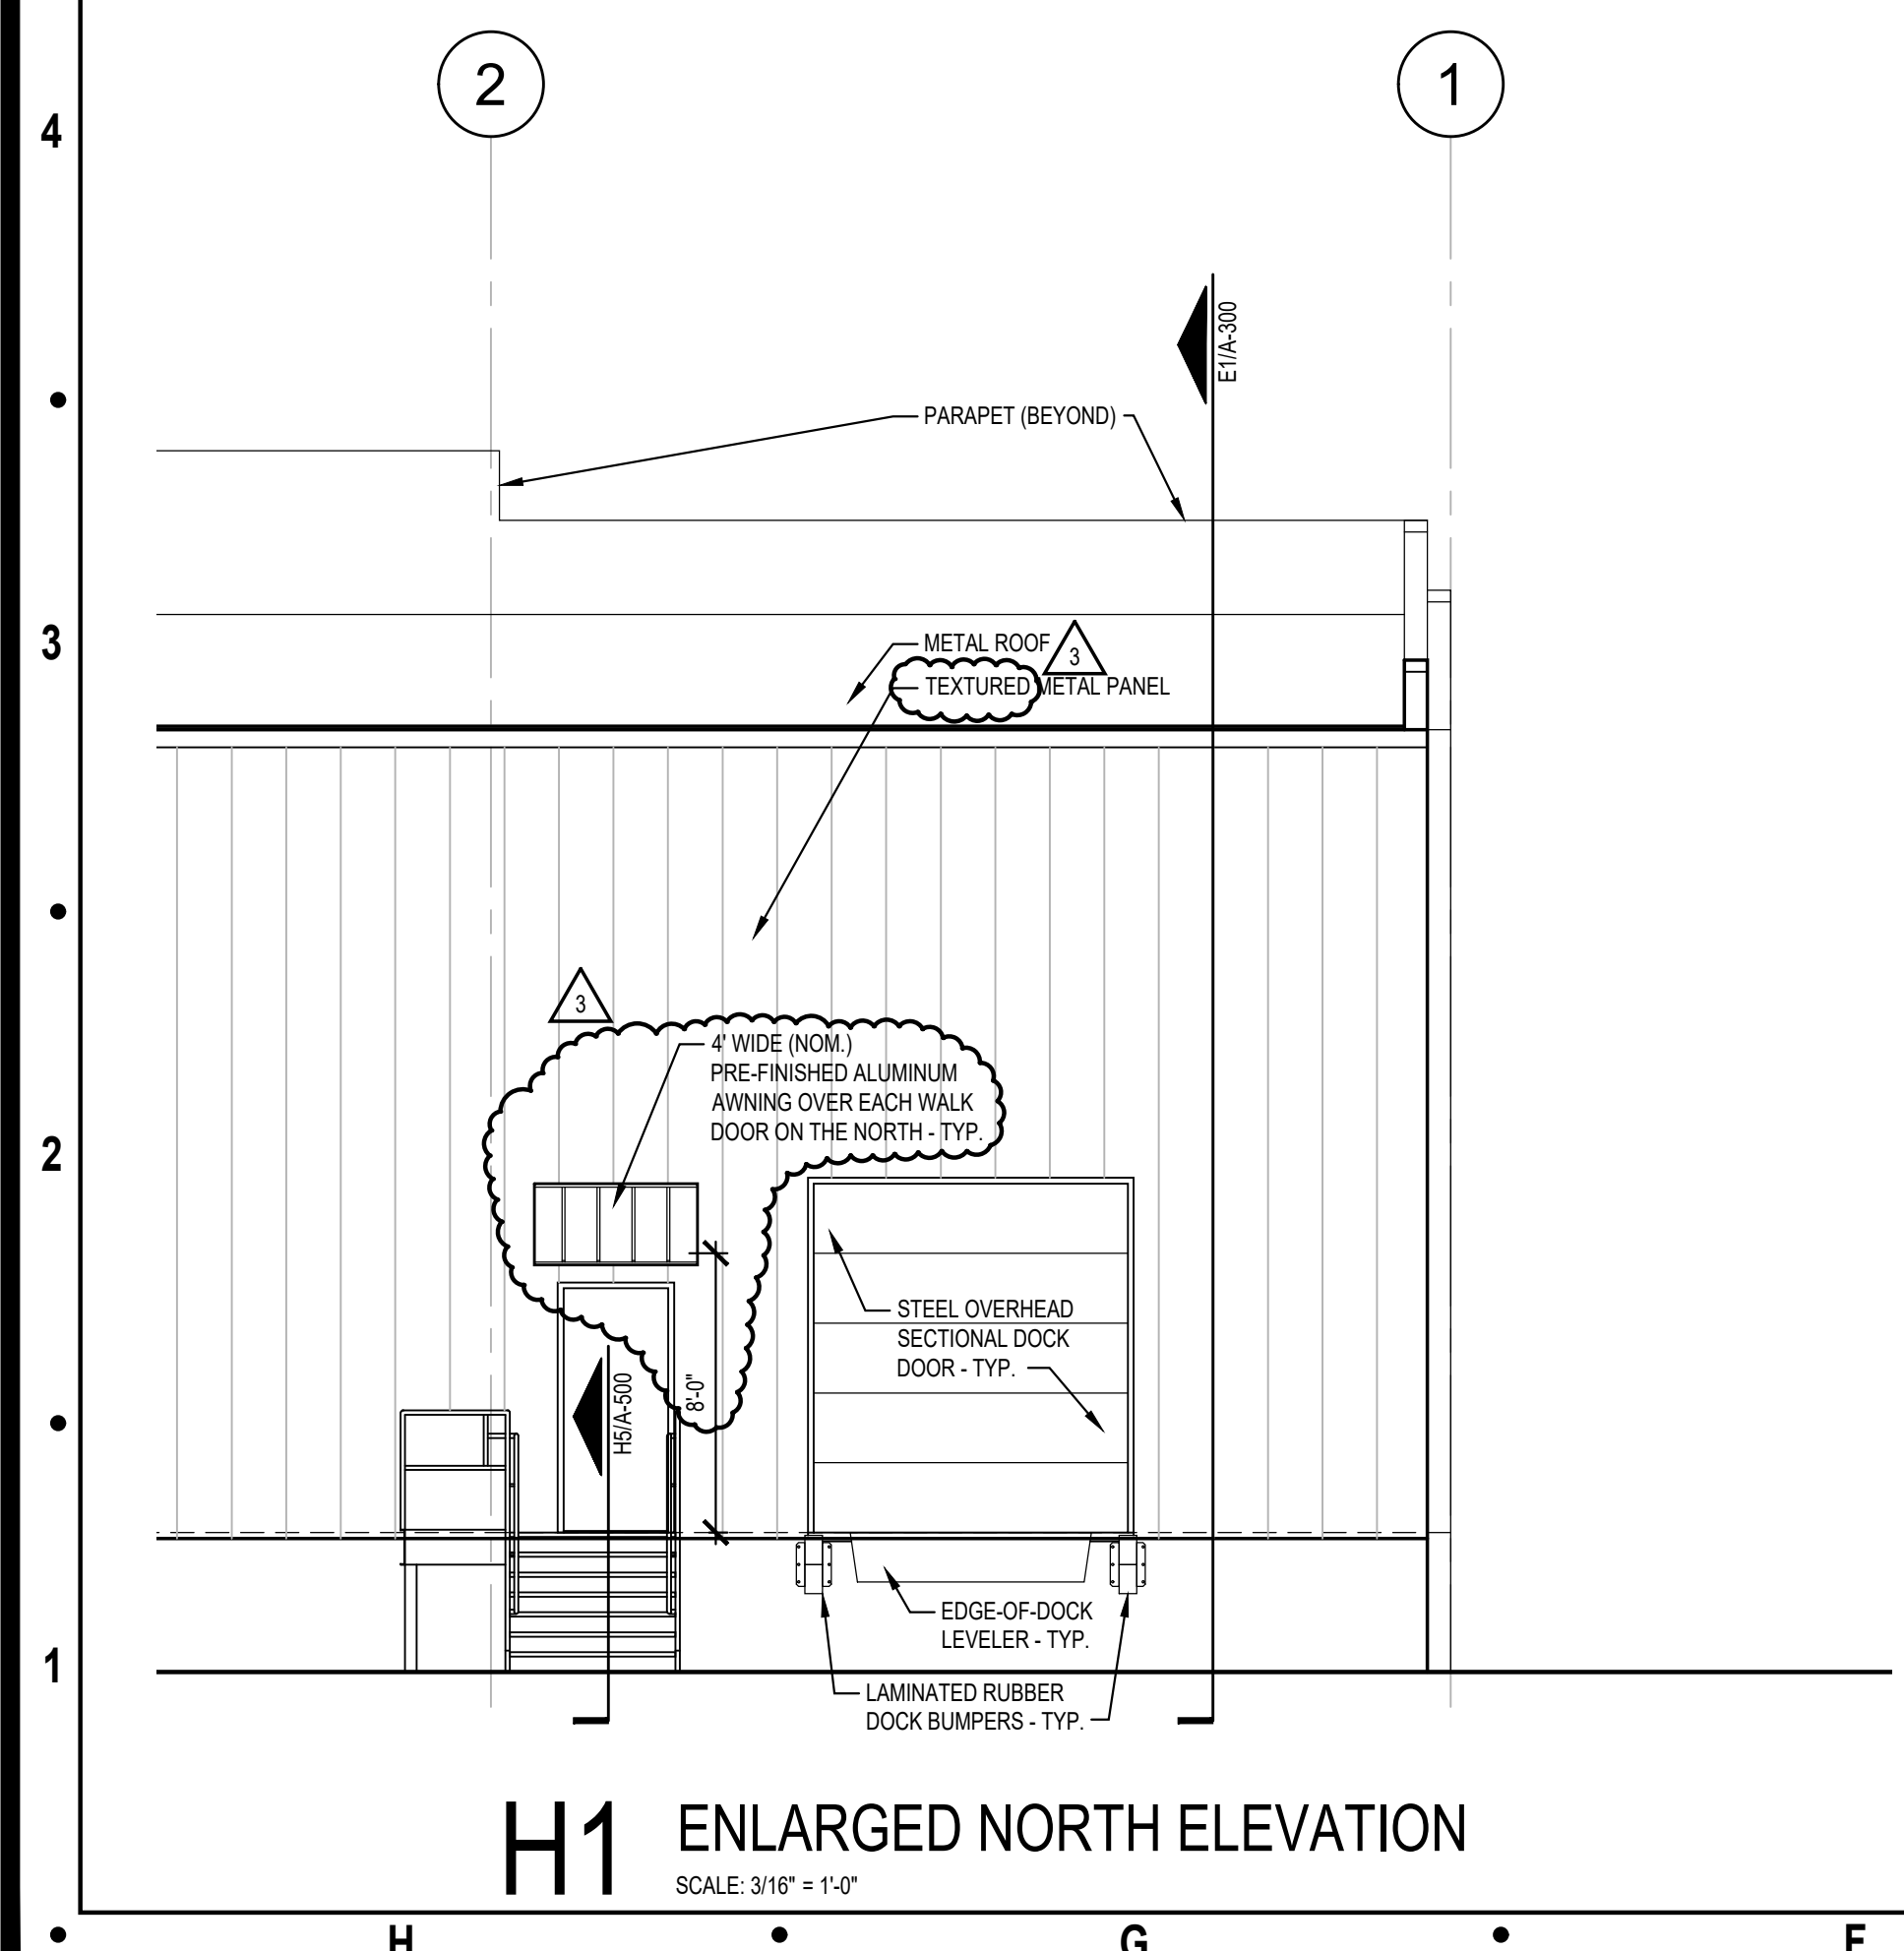

H1 ENLARGED NORTH ELEVATION
SCALE: 3/16" = 1'-0"

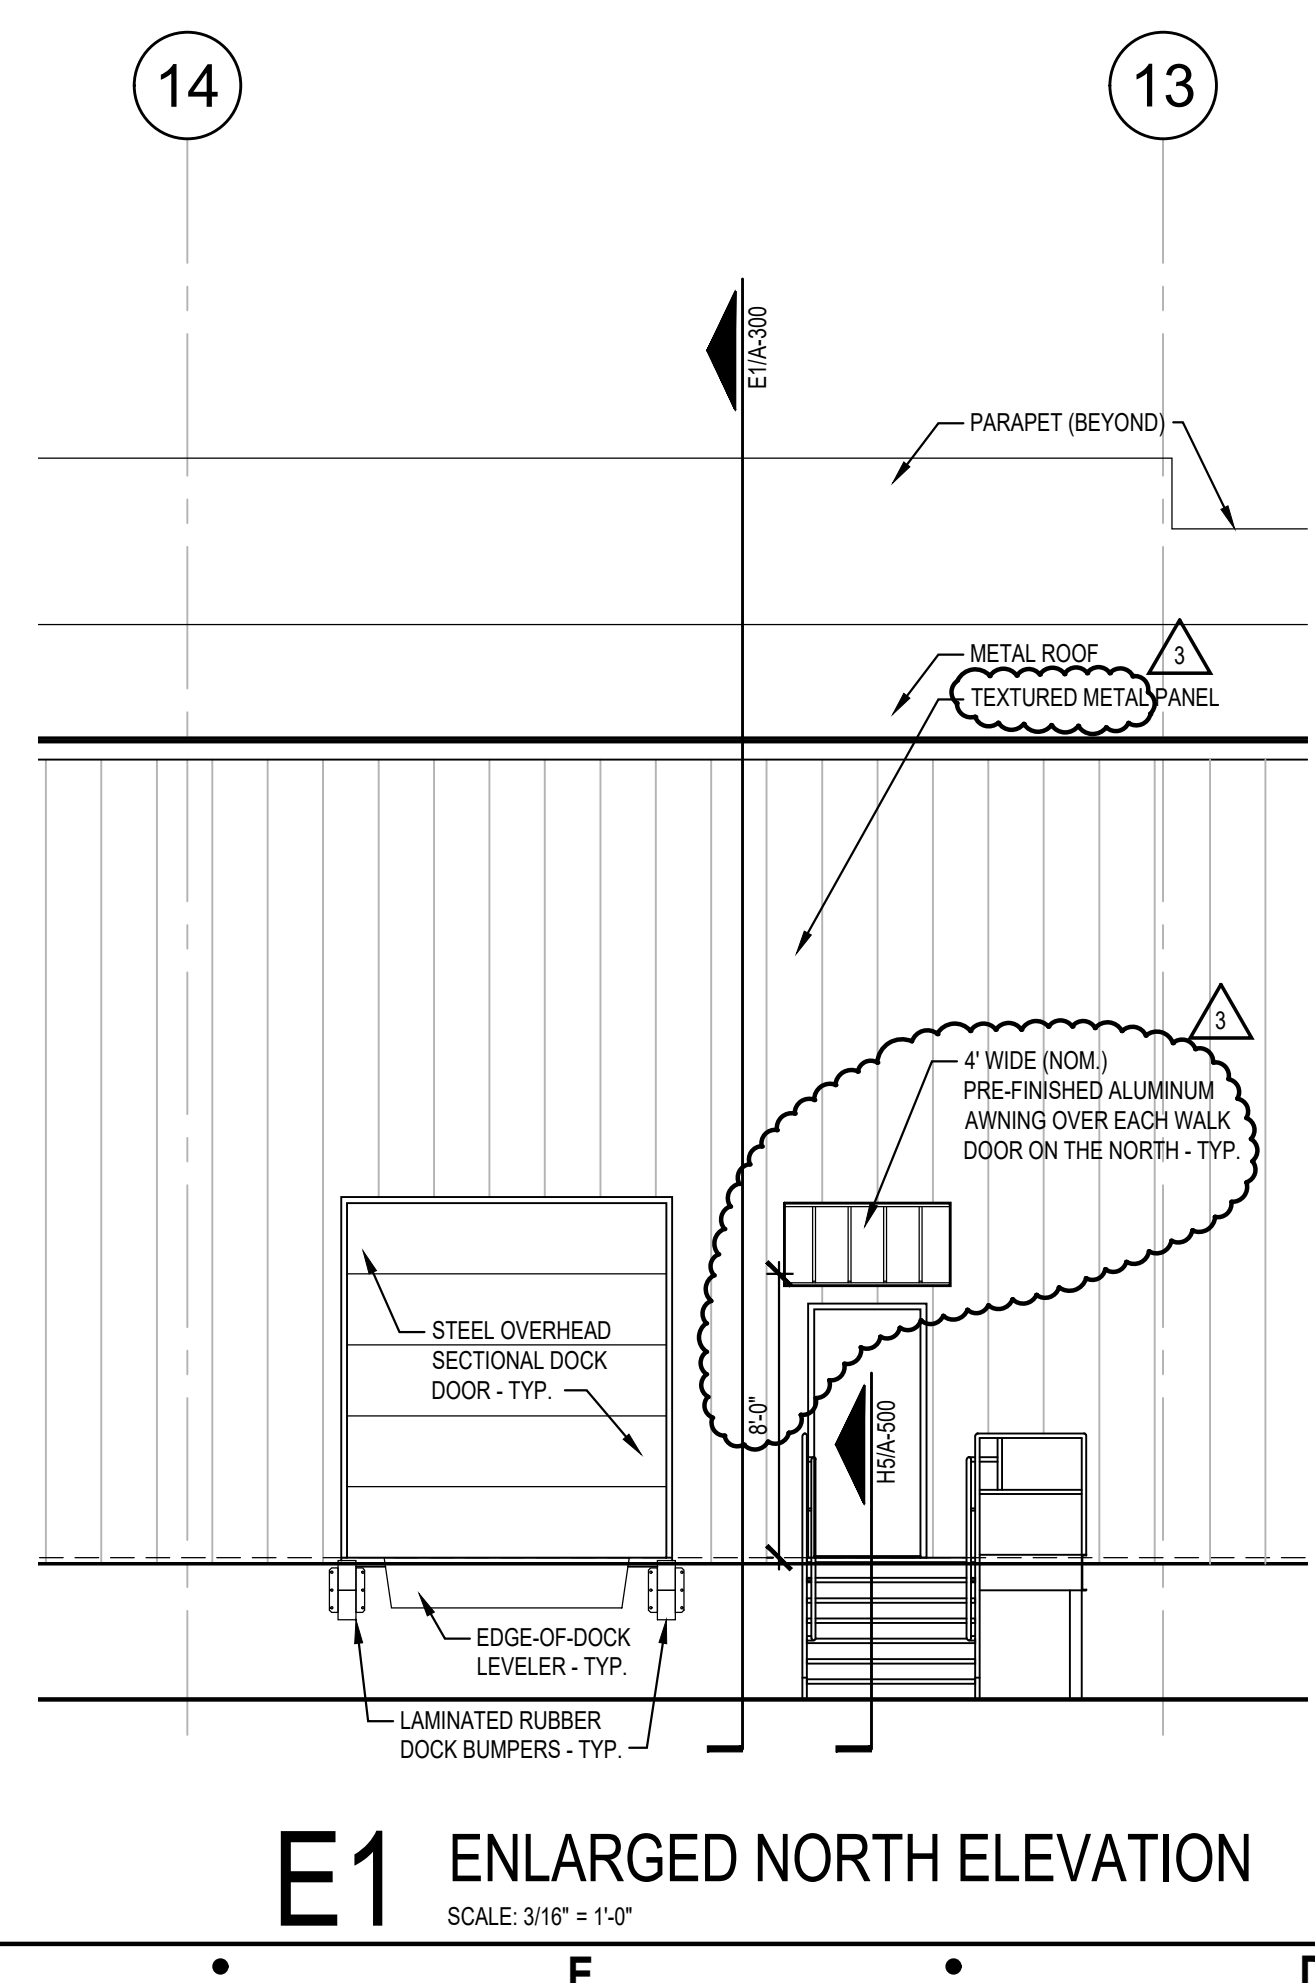

E1 ENLARGED NORTH ELEVATION
SCALE: 3/16" = 1'-0"

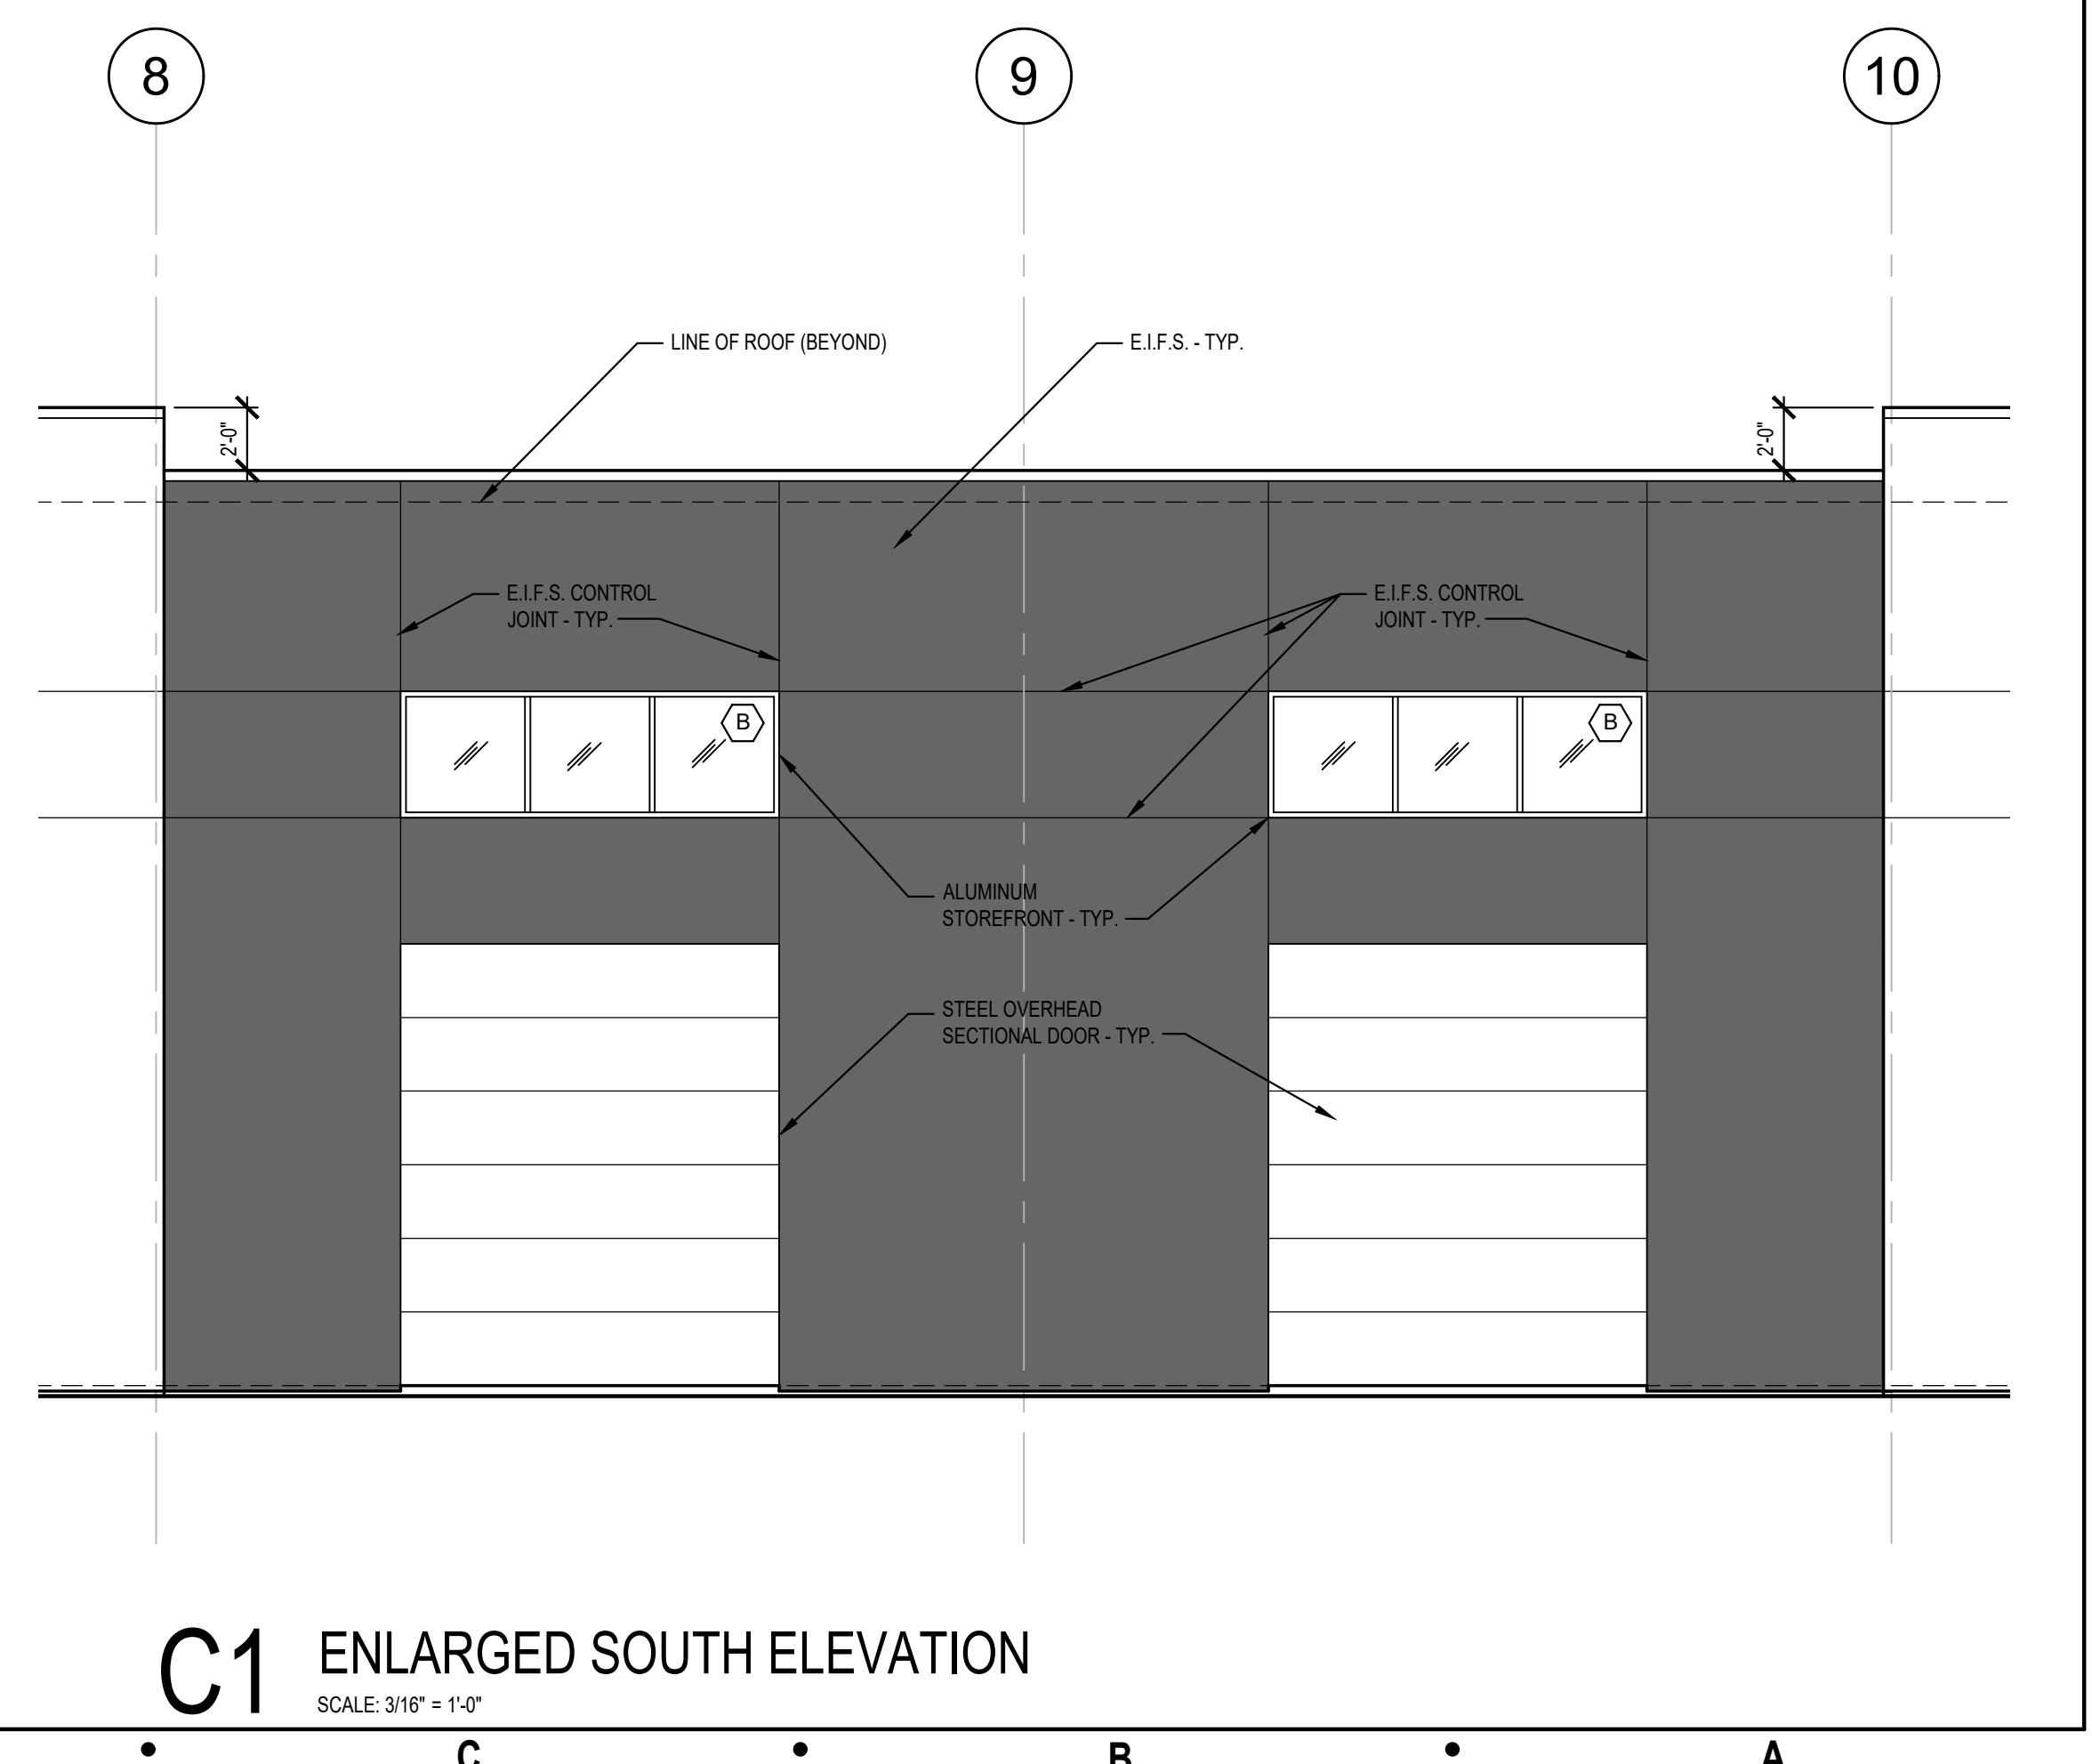

C1 ENLARGED SOUTH ELEVATION
SCALE: 3/16" = 1'-0"

Architect:

MIDWEST ARCHITECTS
1120 NW Eagle Ridge Blvd.
Grain Valley, Missouri 64029
t: (816) 229-8115

Client:

Ward Development
1120 NW Eagle Ridge Blvd.
Grain Valley, Missouri 64029
t: (816) 229-8115

Consultants:

Civil Engineering:
Engineering Solutions
50 SE 30th Street
Lee's Summit, Missouri 64082
t: (816) 623-9888

Structural Engineering:
Structura Logica
18901 E. 299th Street
Harrisonville, MO 64701
t: (816) 872-4883

MEP Engineering:
JSC Engineers
1925 Central Street, Suite 201
Kansas City, MO 64108
t: (816) 272-5289

Revisions to technical submissions which are not made or approved by the licensee are prohibited.

Seal:



Michael Moors, MO Architect #2009032812

Project Number: 2307

Project Type: NEW CONSTRUCTION

Project Name and Address:

LAKWOOD BUSINESS CENTER, LOT 1
NE Maguire Blvd
Lee's Summit, Missouri 64064

Issue: 08.31.23
Permit Set 12.07.23
Plan Review Comments 12.21.23
Planning Comments 01.31.24

Sheet Title:

ENLARGED EXTERIOR ELEVATIONS
A-201