

WOODLAND OAKS

Lots 1 thru 42

STREET AND STORM SEWER CONSTRUCTION PLANS

Section 27, Township 48 North, Range 31 West LEE'S SUMMIT, JACKSON COUNTY, MISSOURI

OIL - GAS WELLS

ACCORDING TO EDWARD ALTON MAY JR'S ENVIRONMENTAL IMPACT STUDY OF ABANDONED OIL AND GAS WELLS IN LEE'S SUMMIT, MISSOURI IN 1995, THERE ARE NOT OIL AND GAS WELLS WITHIN 185 FEET OF THE PROPERTY AS SURVEYED HEREON.

FLOOD INFORMATION:

THE SUBJECT PROPERTY SURVEYED LIES WITHIN A FLOOD ZONE DESIGNATED ZONE (X), AREAS LOCATED OUTSIDE THE 100 YEAR FLOOD PLAIN, PER F.E.M.A. MAP, COMMUNITY PANEL NO. 29095C0416G EFFECTIVE DATE: JANUARY 20, 2017.

CONSTRUCTION AND DESIGN NOTES:

STREET & STORM SEWERS:

1 ~ STREET PAVEMENT SHALL CONSIST OF TYPE CG-2 CURBS WITH PAVEMENT PER TABLE LS-2 OF THE LEE'S SUMMIT DESIGN AND CONSTRUCTION MANUAL

RESIDENTIAL LOCAL STREET SEE BELOW FOR TYPICAL SECTION.

- OPTION 1) 4" TYPE 5 ASPHALT BASE AND 2" TYPE 5 OR 6 ASPHALT SURFACE OVER A 6" MODOT TYPE 5 BASE AND A SUBGRADE MIXTURE OF 6" FLY ASH STABILIZED SUBGRADE IN ACCORDANCE WITH THE CITY OF LEE'S SUMMIT DESIGN AND CONSTRUCTION MANUAL.
- OPTION 2) 4" TYPE 5 ASPHALT BASE AND 2" TYPE 5 OR 6 ASPHALT SURFACE OVER 10" MODOT TYPE 5 BASE OVERTOP A BIAXIAL GEOGRID PER THE CITY'S APPROVED PRODUCT LIST.

2 ~ STORM SEWER PIPE SHALL BE HIGH DENSITY POLYETHYLENE (HDPE) AS APPROVED BY CITY OF LEE'S SUMMIT DESIGN AND CONSTRUCTION MANUAL.

3 ~ JUNCTION BOXES SHALL BE PER CITY OF LEE'S SUMMIT STANDARD DRAWING NO. STM-3. FIELD INLETS SHALL BE PER CITY OF LEE'S SUMMIT STANDARD DRAWING STM-2. TOEWALLS SHALL BE PER CITY OF LEE'S SUMMIT DRAWING NO. STM-5. JUNCTION BOXES SHALL BE PER CITY OF LEE'S SUMMIT STM-3. ROCK LINING AND RIP RAP SHALL BE PER CITY OF LEE'S SUMMIT.

GENERAL NOTES:

1 ~ ALL CONSTRUCTION SHALL CONFORM TO THE CITY OF LEE'S SUMMIT DESIGN AND CONSTRUCTION MANUAL AS ADOPTED BY ORDINANCE 5813.

2 ~ ALL REQUIRED EASEMENTS WITHIN THE BOUNDARY OF THIS PROJECT SHALL BE PROVIDED FOR ON THE FINAL PLAT.

3 ~ ANY REQUIRED EASEMENT LOCATED OUTSIDE OF THE BOUNDARY OF THIS PROJECT SHALL BE PROVIDED FOR BY SEPARATE INSTRUMENT PRIOR TO ISSUANCE OF CONSTRUCTION PERMITS.

4 ~ THE CONTRACTOR SHALL CONTACT THE CITY'S DEVELOPMENT SERVICES ENGINEERING INSPECTION TO SCHEDULE A PRE-CONSTRUCTION MEETING WITH A FIELD ENGINEERING INSPECTOR PRIOR TO ANY LAND DISTURBANCE WORK AT (816) 969-1200.

5 ~ THE CONTRACTOR SHALL NOTIFY ENGINEERING SOLUTIONS AT 816.623.9888 OF ANY CONFLICT WITH THE IMPROVEMENTS PROPOSED BY THESE PLANS AND SITE CONDITIONS.

6 ~ THE CONTRACTOR SHALL NOTIFY THE CITY ENGINEER AND OBTAIN THE APPROPRIATE BLASTING PERMITS FOR A REQUIRED BLASTING. IF BLASTING IS ALLOWED, ALL BLASTING SHALL CONFORM TO STATE REGULATIONS AND LOCAL ORDINANCES.


UTILITY COMPANIES:

THE FOLLOWING LIST OF UTILITY COMPANIES IS PROVIDED FOR INFORMATION ONLY. WE DO NOT OFFER ANY GUARANTEE OR WARRANTY THAT THIS LIST IS COMPLETE OR ACCURATE. THE CONTRACTOR SHALL BE RESPONSIBLE FOR CONTACTING ALL UTILITY COMPANIES THAT MAY BE AFFECTED BY THE PROPOSED CONSTRUCTION AND VERIFYING THE ACTUAL LOCATION OF EACH UTILITY LINE. THE CONTRACTOR SHALL NOTIFY ENGINEERING SOLUTIONS AT 816.623.9888 OF ANY CONFLICT WITH PROPOSED IMPROVEMENTS.

EVERGY ~ 298-1196
MISSOURI GAS ENERGY ~ 756-5261
SOUTHWESTERN BELL TELEPHONE ~ 761-5011
COMCAST CABLE ~ 795-1100
WILLIAMS PIPELINE ~ 422-6300
CITY OF LEE'S SUMMIT PUBLIC WORKS ~ 969-1800
CITY OF LEE'S SUMMIT PUBLIC WORKS INSPECTIONS ~ 969-1800
CITY OF LEE'S SUMMIT WATER UTILITIES ~ 969-1900
MISSOURI ONE CALL (DIG RITE) ~ 1-800-344-7483



SITE LOCATION MAP

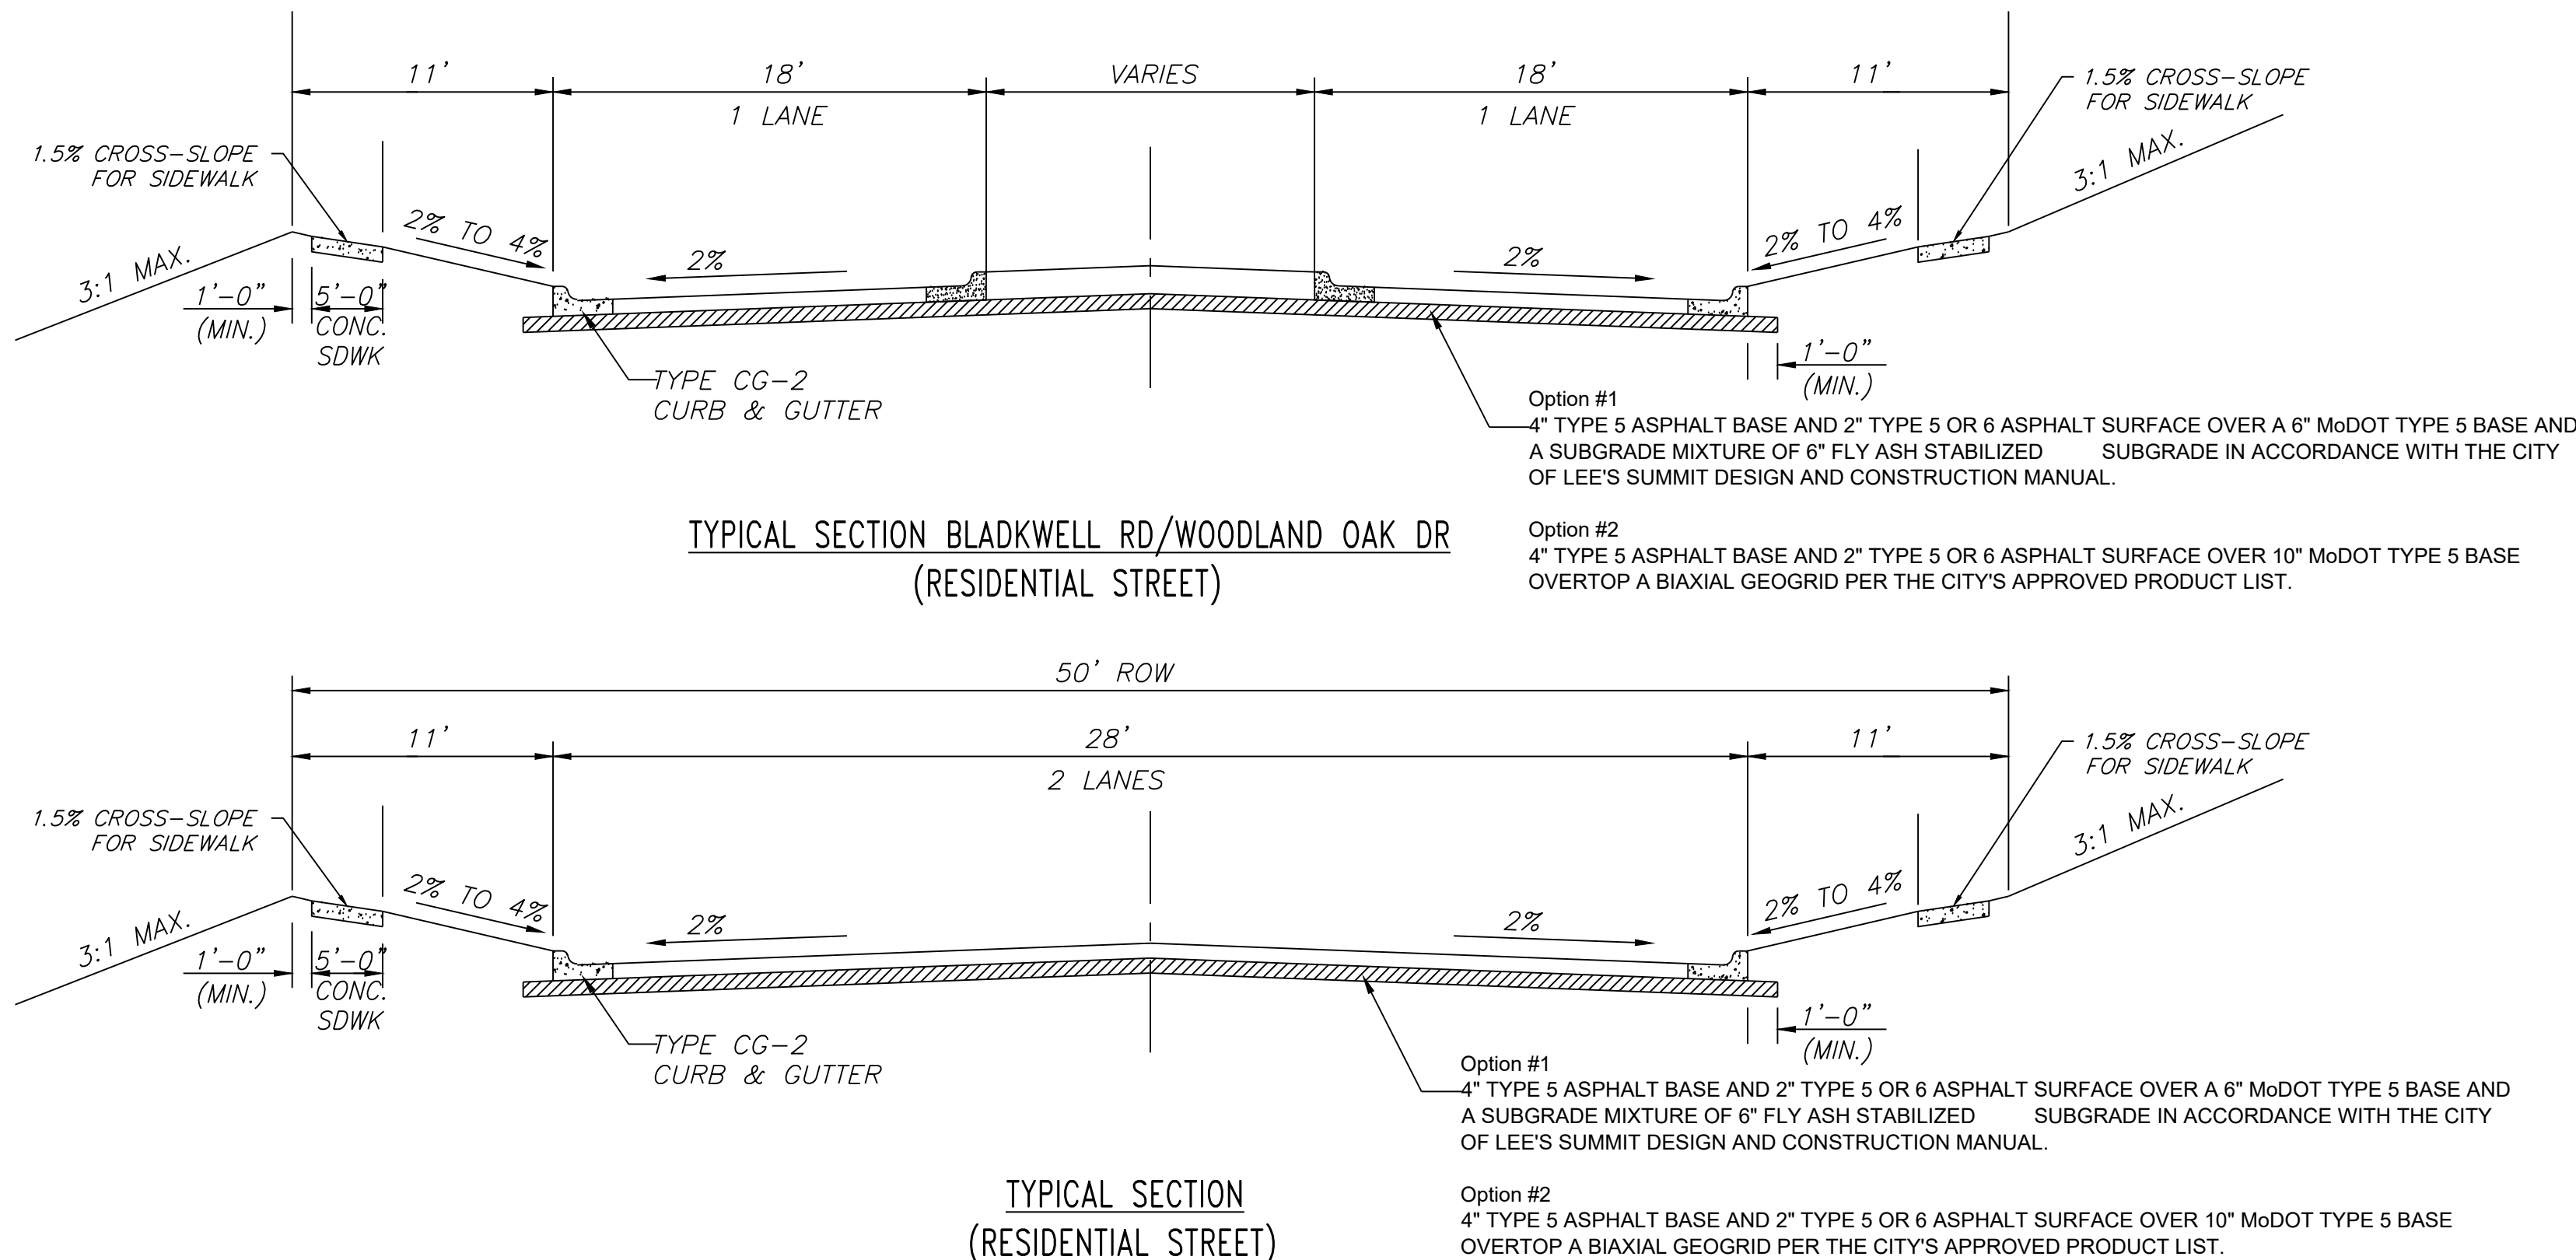

Summary of Quantities:

ITEM AND DESCRIPTION	UNIT	ESTIMATED QUANTITY
ASPHALT PAVING	S.Y.	7,187.12
CURBING	FT	4643.65
MoDOT Type 5 Base	S.Y.	7,689.66
GEOGRID	S.Y.	7,689.66
CLEARING, GRADING & GRUBBING	LS	1.00
SILT FENCE	FT	12,550.00
INLET PROTECTION	UNIT	81.00
SEEDING / MULCHING/ FERTILIZING	AC	19.51
CONST. ENTRANCE	UNIT	1.00
RIP RAP W/ FABRIC	S.Y.	142.05
SEDIMENT TRAP ROCK	C.Y.	19.00
FAIRCLOTH SKIMMER ASSEMBLY	UNIT	1.00
5' SIDEWALK	S.F.	9,524
STREET SIGNAGE	UNIT	4
ADA SIDEWALK RAMP	UNIT	11
STORM		
15" HDPE	FT	1598.78
18" HDPE	FT	829.84
24" HDPE	FT	307.87
30" HDPE	FT	51.00
15" HDPE END SECTION / TOE WALL	LS	3.00
18" HDPE END SECTION / TOE WALL	LS	1.00
24" HDPE END SECTION / TOE WALL	LS	4.00
30" HDPE END SECTION / TOE WALL	LS	1.00
4' x 4' STORM FIELD INLET	EA	10.00
5' x 5' JUNCTION BOX	EA	2.00
5' x 4' STORM CURB INLET	EA	14.00
5' x 5' CONTROL STRUCTURE	EA	1.00
5' x 4' CONTROL STRUCTURE	EA	1.00


INDEX OF SHEETS:

- C.001 ~ STREET & STORM COVER SHEET
C.050 ~ ESC PHASE 1 - PRE CLEARING PLAN
C.051 ~ ESC PHASE 2 - INITIAL AREA STABILIZATION PLAN
C.052 ~ ESC PHASE 3 - FINAL RESTORATION PLAN
C.053 ~ ESC - STANDARD DETAILS
C.054 ~ ESC - STANDARD DETAILS
C.100 ~ SITE PLAN
C.200 ~ MASTER DRAINAGE PLAN SHEET 1 OF 3 GRADING PLAN - SWPPP
C.201 ~ MASTER DRAINAGE PLAN SHEET 2 OF 3 SPOT ELEVATIONS
C.202 ~ MASTER DRAINAGE PLAN SHEET 3 OF 3 DRAINAGE AREA MAP
C.203 ~ STREET PLAN & PROFILE
C.204 ~ STREET PLAN & PROFILE
C.205 ~ SIDEWALK AND INTERSECTION PLAN
C.206 ~ DETENTION BASIN PLAN
C.207 ~ BYPASS CHANNEL PLAN
C.208 ~ STREET SIGNAGE PLAN
C.300 ~ STORM SEWER GENERAL LAYOUT
C.301 ~ STORM SEWER PLAN & PROFILE
C.302 ~ STORM SEWER PLAN & PROFILE
C.303 ~ STORM SEWER PLAN & PROFILE
C.304 ~ STORM SEWER PLAN & PROFILE
C.305 ~ STORM SEWER TABLES - 10 YEAR
C.306 ~ STORM SEWER TABLES - 100 YEAR
C.600 ~ CONSTRUCTION DETAILS
C.601 ~ CONSTRUCTION DETAILS

UTILITY COMPANIES:

THE FOLLOWING LIST OF UTILITY COMPANIES IS PROVIDED FOR INFORMATION ONLY. WE DO NOT OFFER ANY GUARANTEE OR WARRANTY THAT THIS LIST IS COMPLETE OR ACCURATE. THE CONTRACTOR SHALL BE RESPONSIBLE FOR CONTACTING ALL UTILITY COMPANIES THAT MAY BE AFFECTED BY THE PROPOSED CONSTRUCTION AND VERIFYING THE ACTUAL LOCATION OF EACH UTILITY LINE. THE CONTRACTOR SHALL NOTIFY ENGINEERING SOLUTIONS AT 816.623.9888 OF ANY CONFLICT WITH PROPOSED IMPROVEMENTS.

EVERGY ~ 298-1196
MISSOURI GAS ENERGY ~ 756-5261
SOUTHWESTERN BELL TELEPHONE ~ 761-5011
COMCAST CABLE ~ 795-1100
WILLIAMS PIPELINE ~ 422-6300
CITY OF LEE'S SUMMIT PUBLIC WORKS ~ 969-1800
CITY OF LEE'S SUMMIT DEVELOPMENT ENGINEERING INSPECTION AT 816.969.1200
CITY OF LEE'S SUMMIT WATER UTILITIES ~ 969-1900
MISSOURI ONE CALL (DIG RITE) ~ 1-800-344-7483

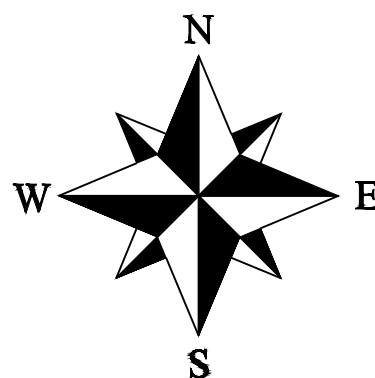

LEGEND:

- B/L ~ BUILDING SET-BACK
C/A ~ COMMON AREA
D/E ~ DRAINAGE EASEMENT
FND. ~ FOUND
L/E ~ LANDSCAPE EASEMENT
L.N.A. ~ LIMITS OF NO ACCESS
R/W ~ RIGHT OF WAY
SAN ~ SANITARY SEWER LINE
S/W ~ SIDEWALK
U/E ~ UTILITY EASEMENT
W ~ WATER LINE
ST ~ STORM SEWER LINE

ENGINEER'S CERTIFICATION:


I HEREBY CERTIFY THAT THIS PROJECT HAS BEEN DESIGNED AND THESE PLANS PREPARED IN ACCORDANCE WITH THE CURRENT DESIGN CRITERIA OF THE CITY OF LEE'S SUMMIT, MISSOURI AND THE STATE OF MISSOURI. I FURTHER CERTIFY THAT THESE PLANS WERE DESIGNED IN ACCORDANCE TO AASHTO STANDARDS.

Street, Stormwater, Master Drainage Plan, and Erosion and Sediment Control

RECORD DRAWING
The information provided on this drawing conforms to construction records; it is not intended for construction, implementation or recording purposes; and it is solely based on information obtained by my firm.

*100-00 100.10", "4-00% 1.15% slope", or "8-inch HDPE-PVC pipe" are all typical examples of revisions that indicate that design data has been replaced with "as-built" information. All other data is as designed and has not been field verified.

Date: 1/18/2024
Certified by: Matthew J. Schlicht
Title: Engineer
Firm: Engineering Solutions

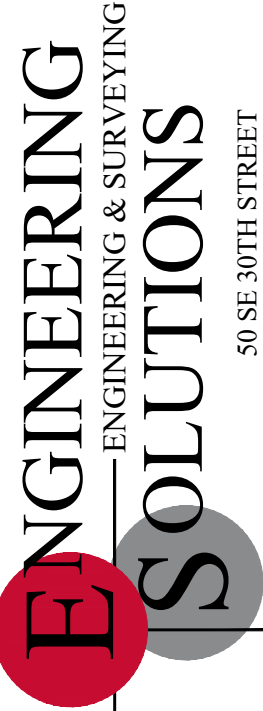


Professional Registration
Missouri
Engineering 2005002186-D
Surveying 2005008319-D
Kansas
Engineering E-1685
Surveying LS-218
Oklahoma
Engineering 6254
Nebraska
Engineering CA2821

Part of the Southeast 1
Section 27, Township 48 North, Range 31 West
Lee's Summit, Jackson County, Missouri

Project:
WOODLAND OAKS
LSMO
Issue Date:
January 18, 2024

Street & Storm Cover Sheet
Construction Plans for:
WOODLAND OAKS
Lots 1 thru 42
Lee's Summit, Jackson County, Missouri

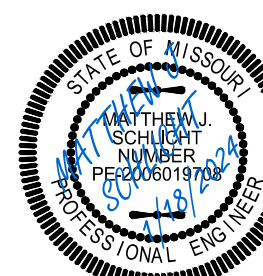

Matthew J. Schlicht
MO PE 2006019708
KS PE 19071
OK PE 25226
NE PE E-14335

REVISIONS
1/18/2024 As-Built



ENGINEERING SOLUTIONS

ENGINEERING & SURVEYING

50 SE 30TH STREET
LEE'S SUMMIT, MO 64082
P: (816) 623-9888 F: (816) 623-9849

Professional Registration

Missouri
Engineering 2005002186-D
Surveying 2005008319-D

Kansas
Engineering E-1685
Surveying LS-218

Oklahoma
Engineering 6254

Nebraska
Engineering CA2821

Project:

WOODLAND OAKS
LSMO

Issue Date:

January 18, 2024

ESC PHASE 1 - Pre Clearing Plan

Construction Plans for:
WOODLAND OAKS
Lots 1 thru 42

Lee's Summit, Jackson County, Missouri

STATE OF MISSOURI


Matthew J. Schlicht
Professional Engineer
No. 0000000000


Matthew J. Schlicht
MO PE 2006019708
KS PE 19071
OK PE 25226
NE PE E-14335

REVISIONS

1/18/2024 As-Built

C. 050

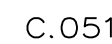

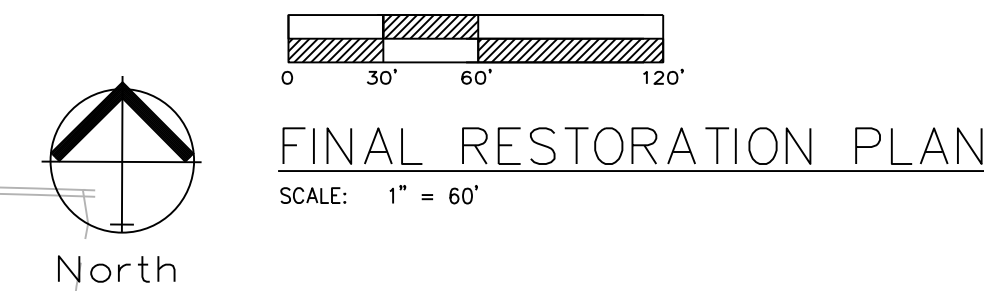

- LEGEND**
- PHASE 1 SILT FENCE — SF-1 — SF-1 —
- PHASE 2 SILT FENCE — SF-2 — SF-2 —
- INLET PROTECTION
GUTTER BUDDY OR EQUIVALENT —

DURING ALL PHASES OF CONSTRUCTION, INACTIVE AREA STABILIZATION METHODS AS DESCRIBED IN APWA SECTION 5111.3 SHALL BE USED TO CONTROL EROSION AND SILTATION.

NOTES: The Land Disturbance Plans indicates the Final placement of erosion control devices. The contractor(s) may proceed with construction prior to the final placement of these devices by providing additional devices to control erosion on their items of work. These devices shall be maintained until the final devices are in place.

SEED AND MULCH NOTES:

All areas disturbed by construction activities shall be seeded and mulched. Seeding shall be done before the proposed seedbed becomes eroded, crusted over, or dried out and shall not be done when the ground is frozen, or covered with snow. The seed shall comply with the requirements of the Missouri Seed Law and the Federal Seed Act. Also, it shall contain no seed of any plant on the Federal Noxious Weed List. Other weed seeds shall not exceed one percent by weight of mix.

Seed and Fertilizer Rate:

Mix I - Rye Grass / Blue Grass 100 lbs. per Acre
Mix II - Tall Fescue / Blue Grass 195 lbs. per Acre
Lime 2000 lbs per Acre (50 lbs. per 1000 sq. ft.)
Fertilizer 800 to 1200 lbs per Acre (25 lbs per 1000 sq. ft.)

During the dates December 15th through May 31 ALL lime fertilizer, seed and mulch shall be applied to finished slopes of disturbed areas. During the months of June, July, October and November 1st through December 15th, lime fertilizer, seed and mulch shall be applied at the following rates:
Lime - 100% of specified quantity
Fertilizer - 75% of the specified quantity
Seed - 50% of the specified quantity
Mulch - 100% of the specified quantity

Mulch shall be Vegetative type, cereal straw from stalks of oats, rye, or barley, or approved equal. The straw shall be free of prohibited weed seed and relatively free of all other noxious and undesirable seed. Mulch shall be applied at the rate of 2 tons per acre, (70 to 90 lbs per 1000 sq. ft.). Mulch shall be embedded by a mulch anchoring tool or disk type roller having flat serrated disks spaced not more than 10 inches apart and cleaning scrapers shall be provided

ONCE SITE IS 90% VEGETATED ALL ESC DEVICES SHALL BE REMOVED AND ANY DISTURBED AREAS SHALL BE RESTORED

RECORD DRAWING

The information provided on this drawing conforms to construction records; it is not intended for construction, implementation or recording purposes; and it is solely based on information obtained by my firm.

"100-00 100.10", "4-00% 1.15% slope", or "8-inch HDPE-PVC pipe" are all typical examples of revisions that indicate that design data has been replaced with "as-built" information. All other data is as designed and has not been field verified.

Date: 1/18/2024
Certified by: Matthew J. Schlicht
Title: Engineer
Firm: Engineering Solutions

ESC PHASE 3 - Final Restoration Plan

Construction Plans for:
WOODLAND OAKS
Lots 1 thru 42


Lee's Summit, Jackson County, Missouri

Project:
WOODLAND OAKS
LSMO

Issue Date:
January 18, 2024

Part of the Southeast 1
Section 27, Township 48 North, Range 31 West
Lee's Summit, Jackson County, Missouri





Professional Registration
Missouri
Engineering 2005002186-D
Surveying 2005008319-D
Kansas
Engineering E-1695
Surveying LS-218
Oklahoma
Engineering 6254
Nebraska
Engineering CA2821

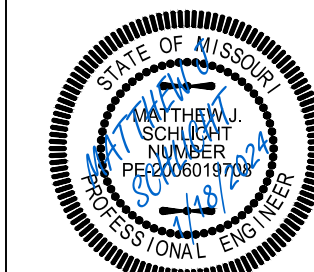


Matthew J. Schlicht
MO PE 2006019708
KS PE 19071
OK PE 25226
NE PE E-14335

REVISIONS

1/18/2024 As-Built

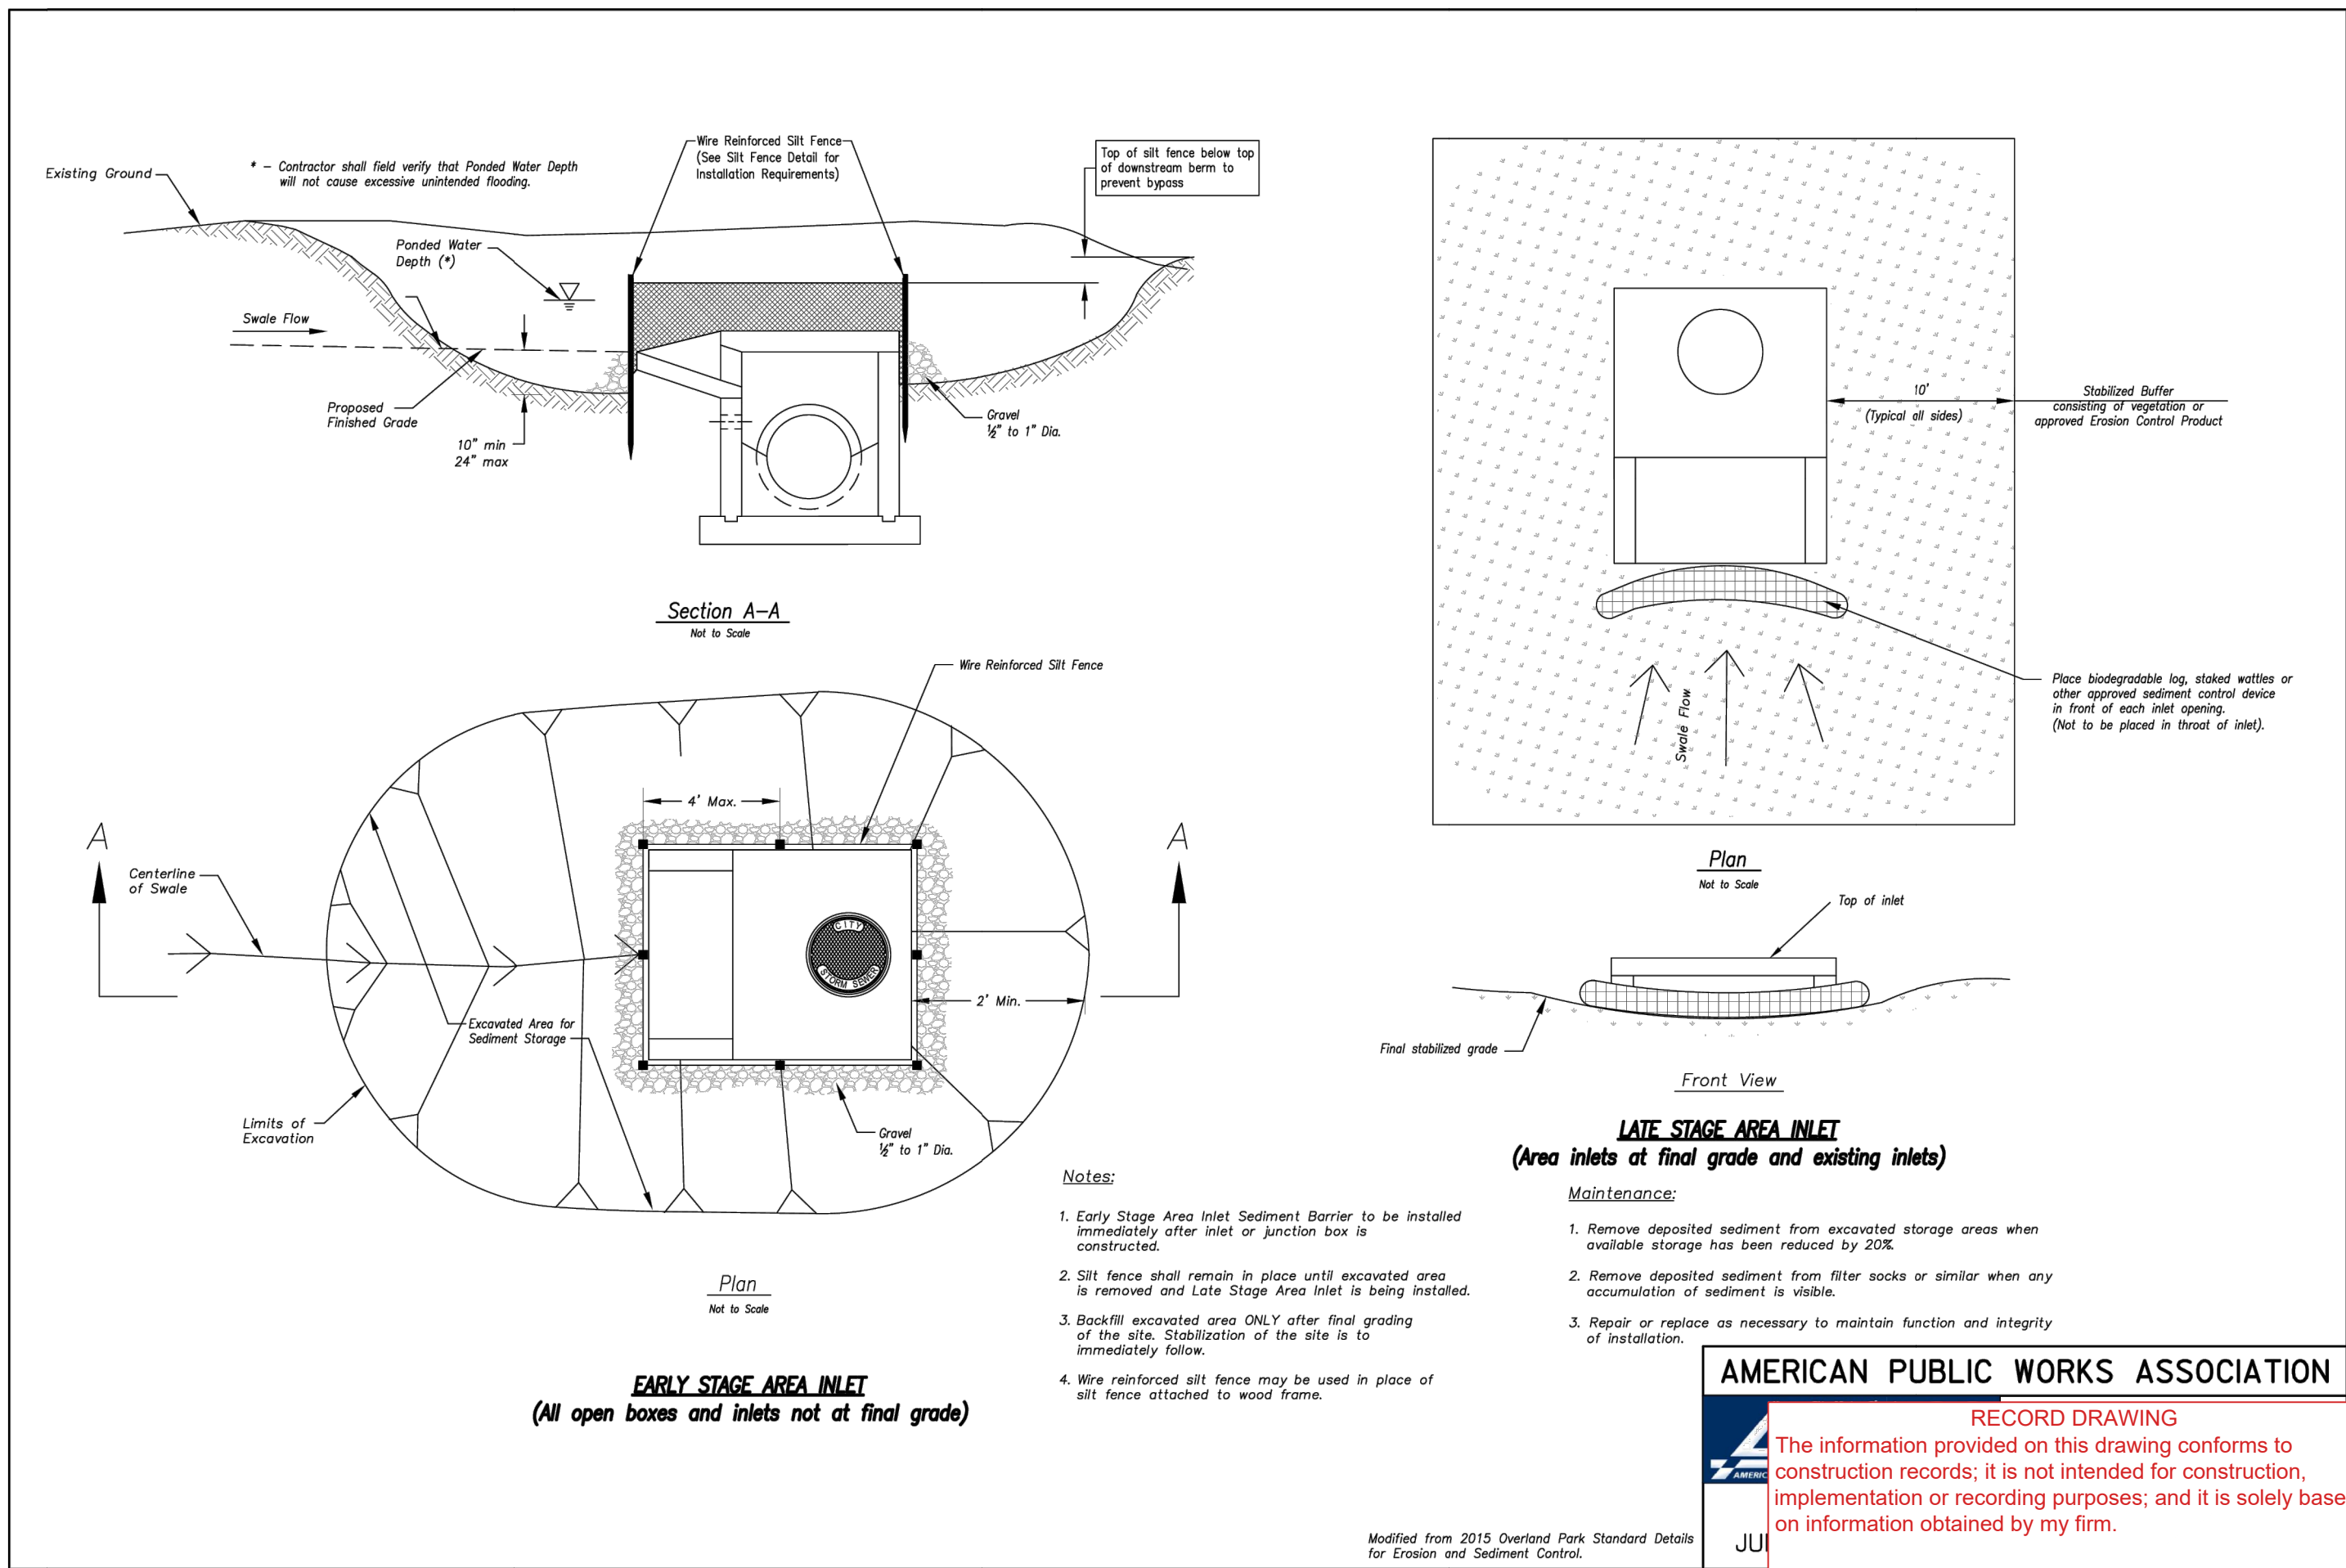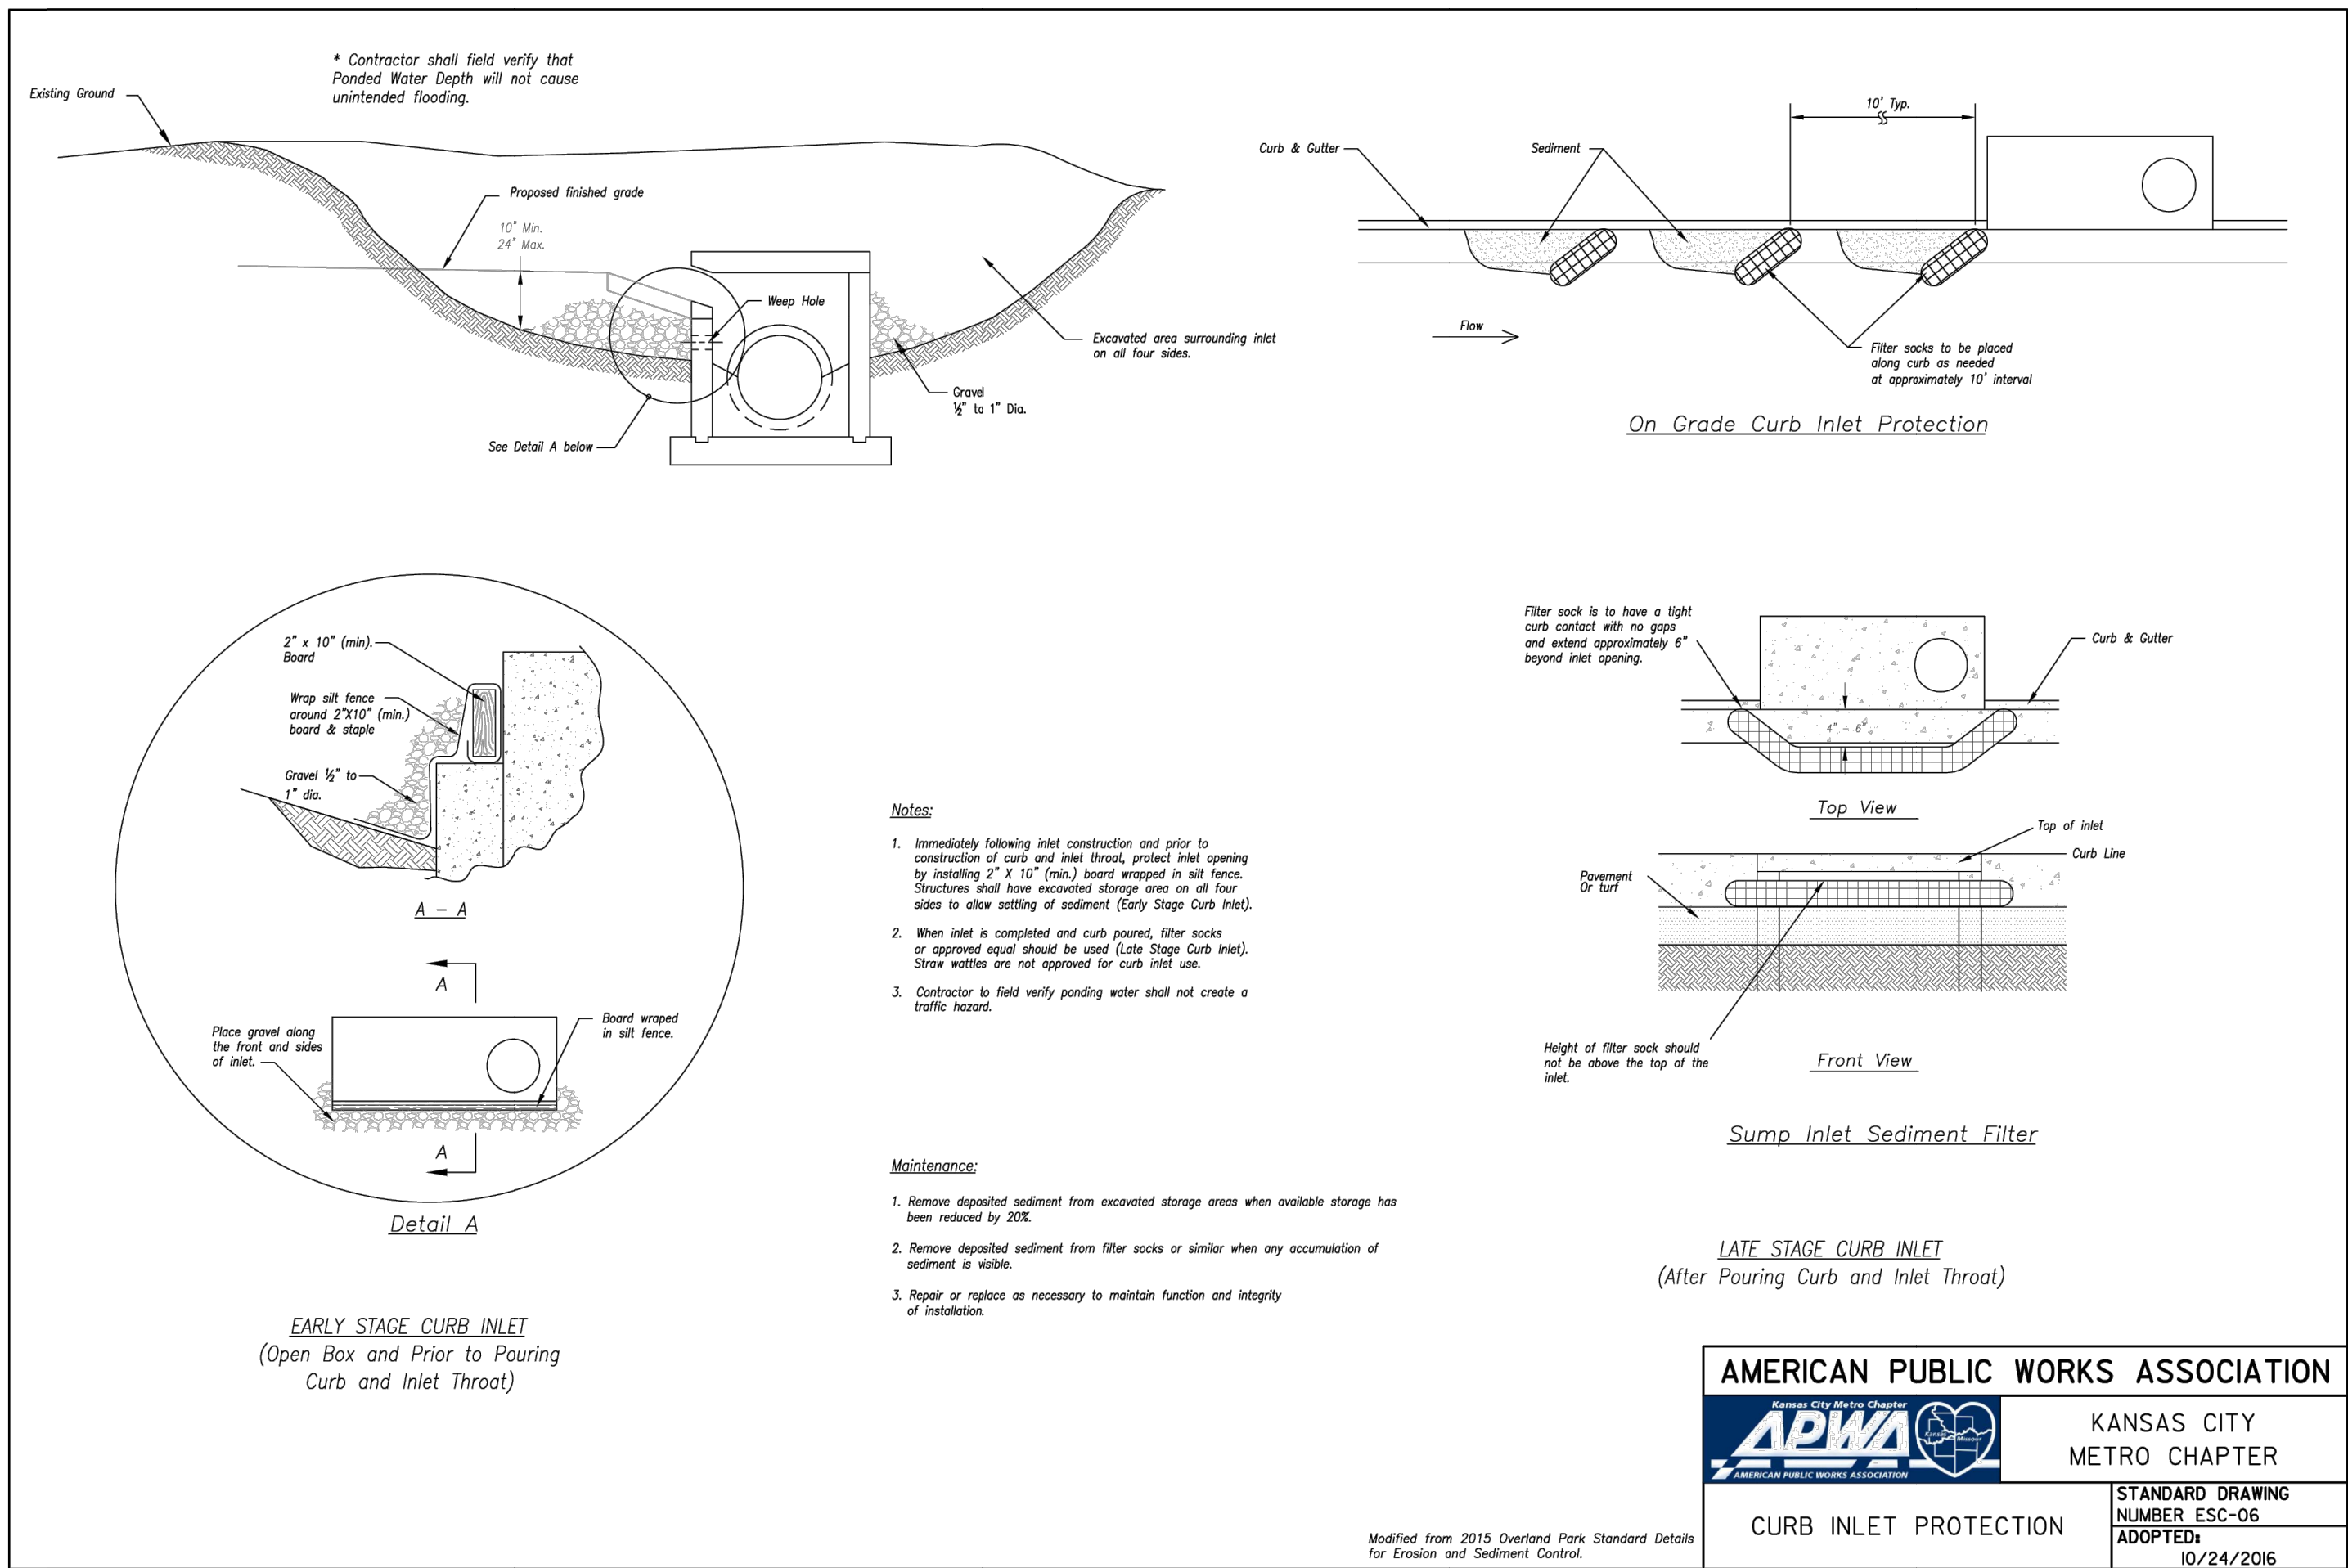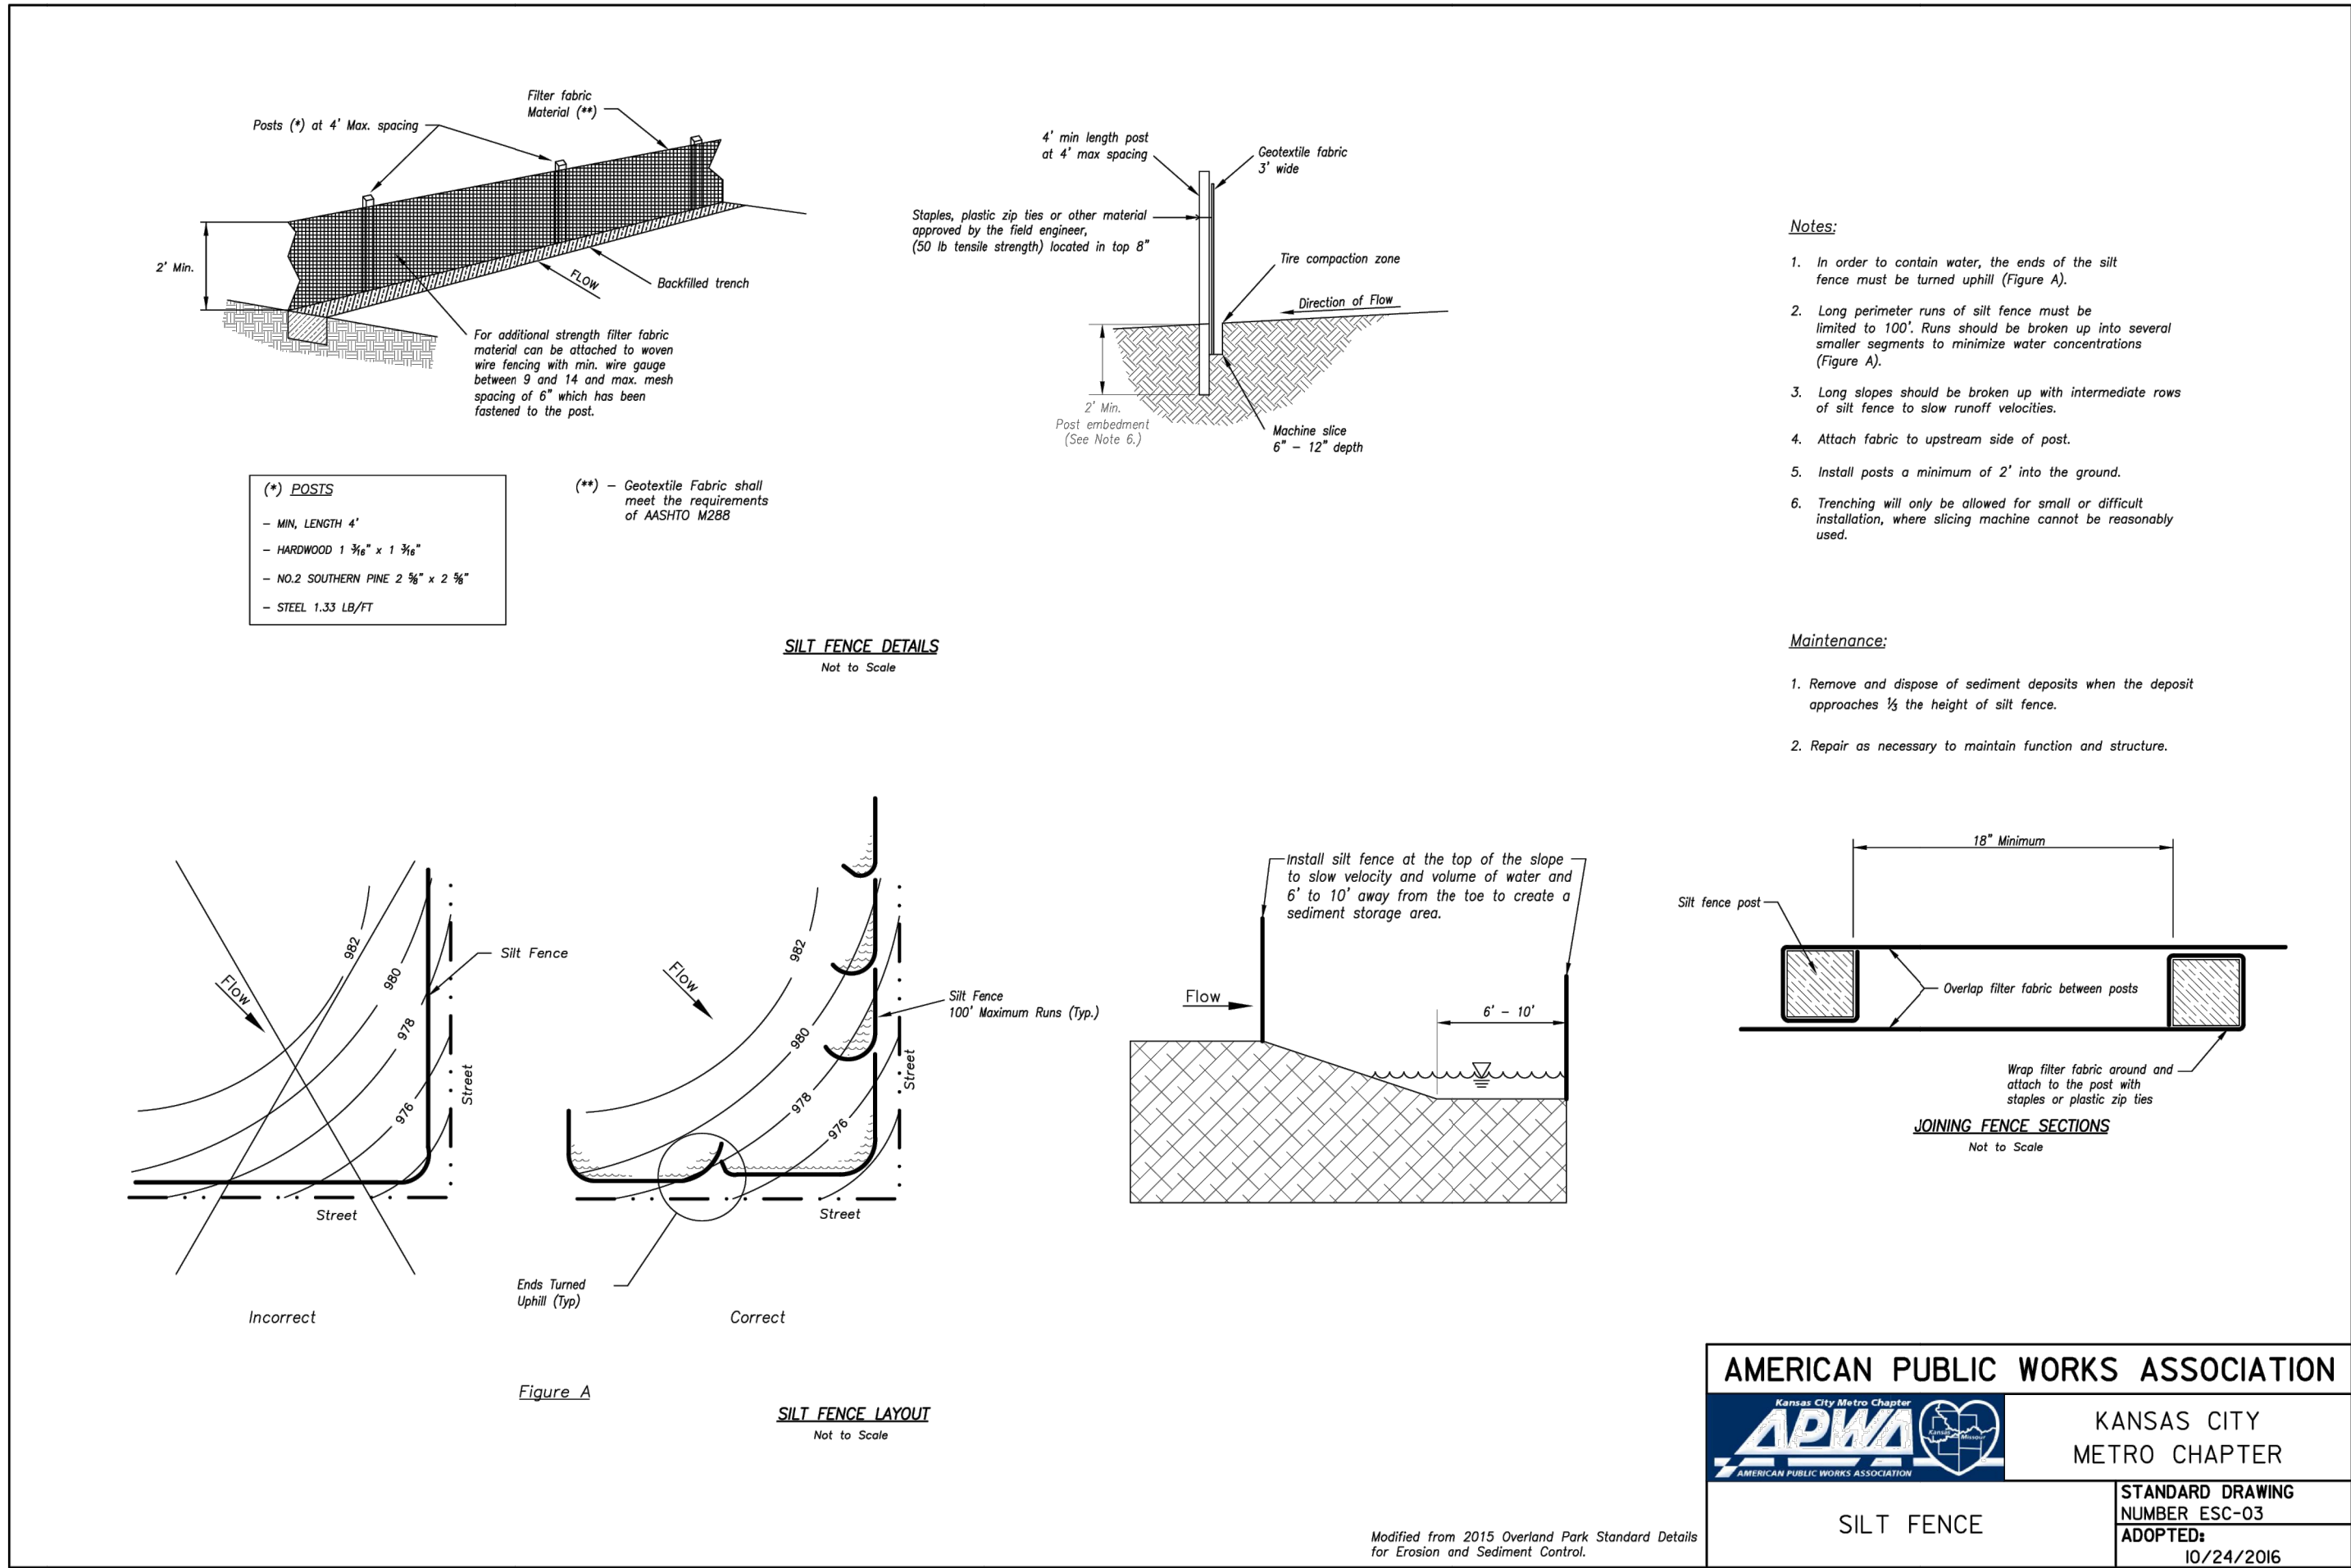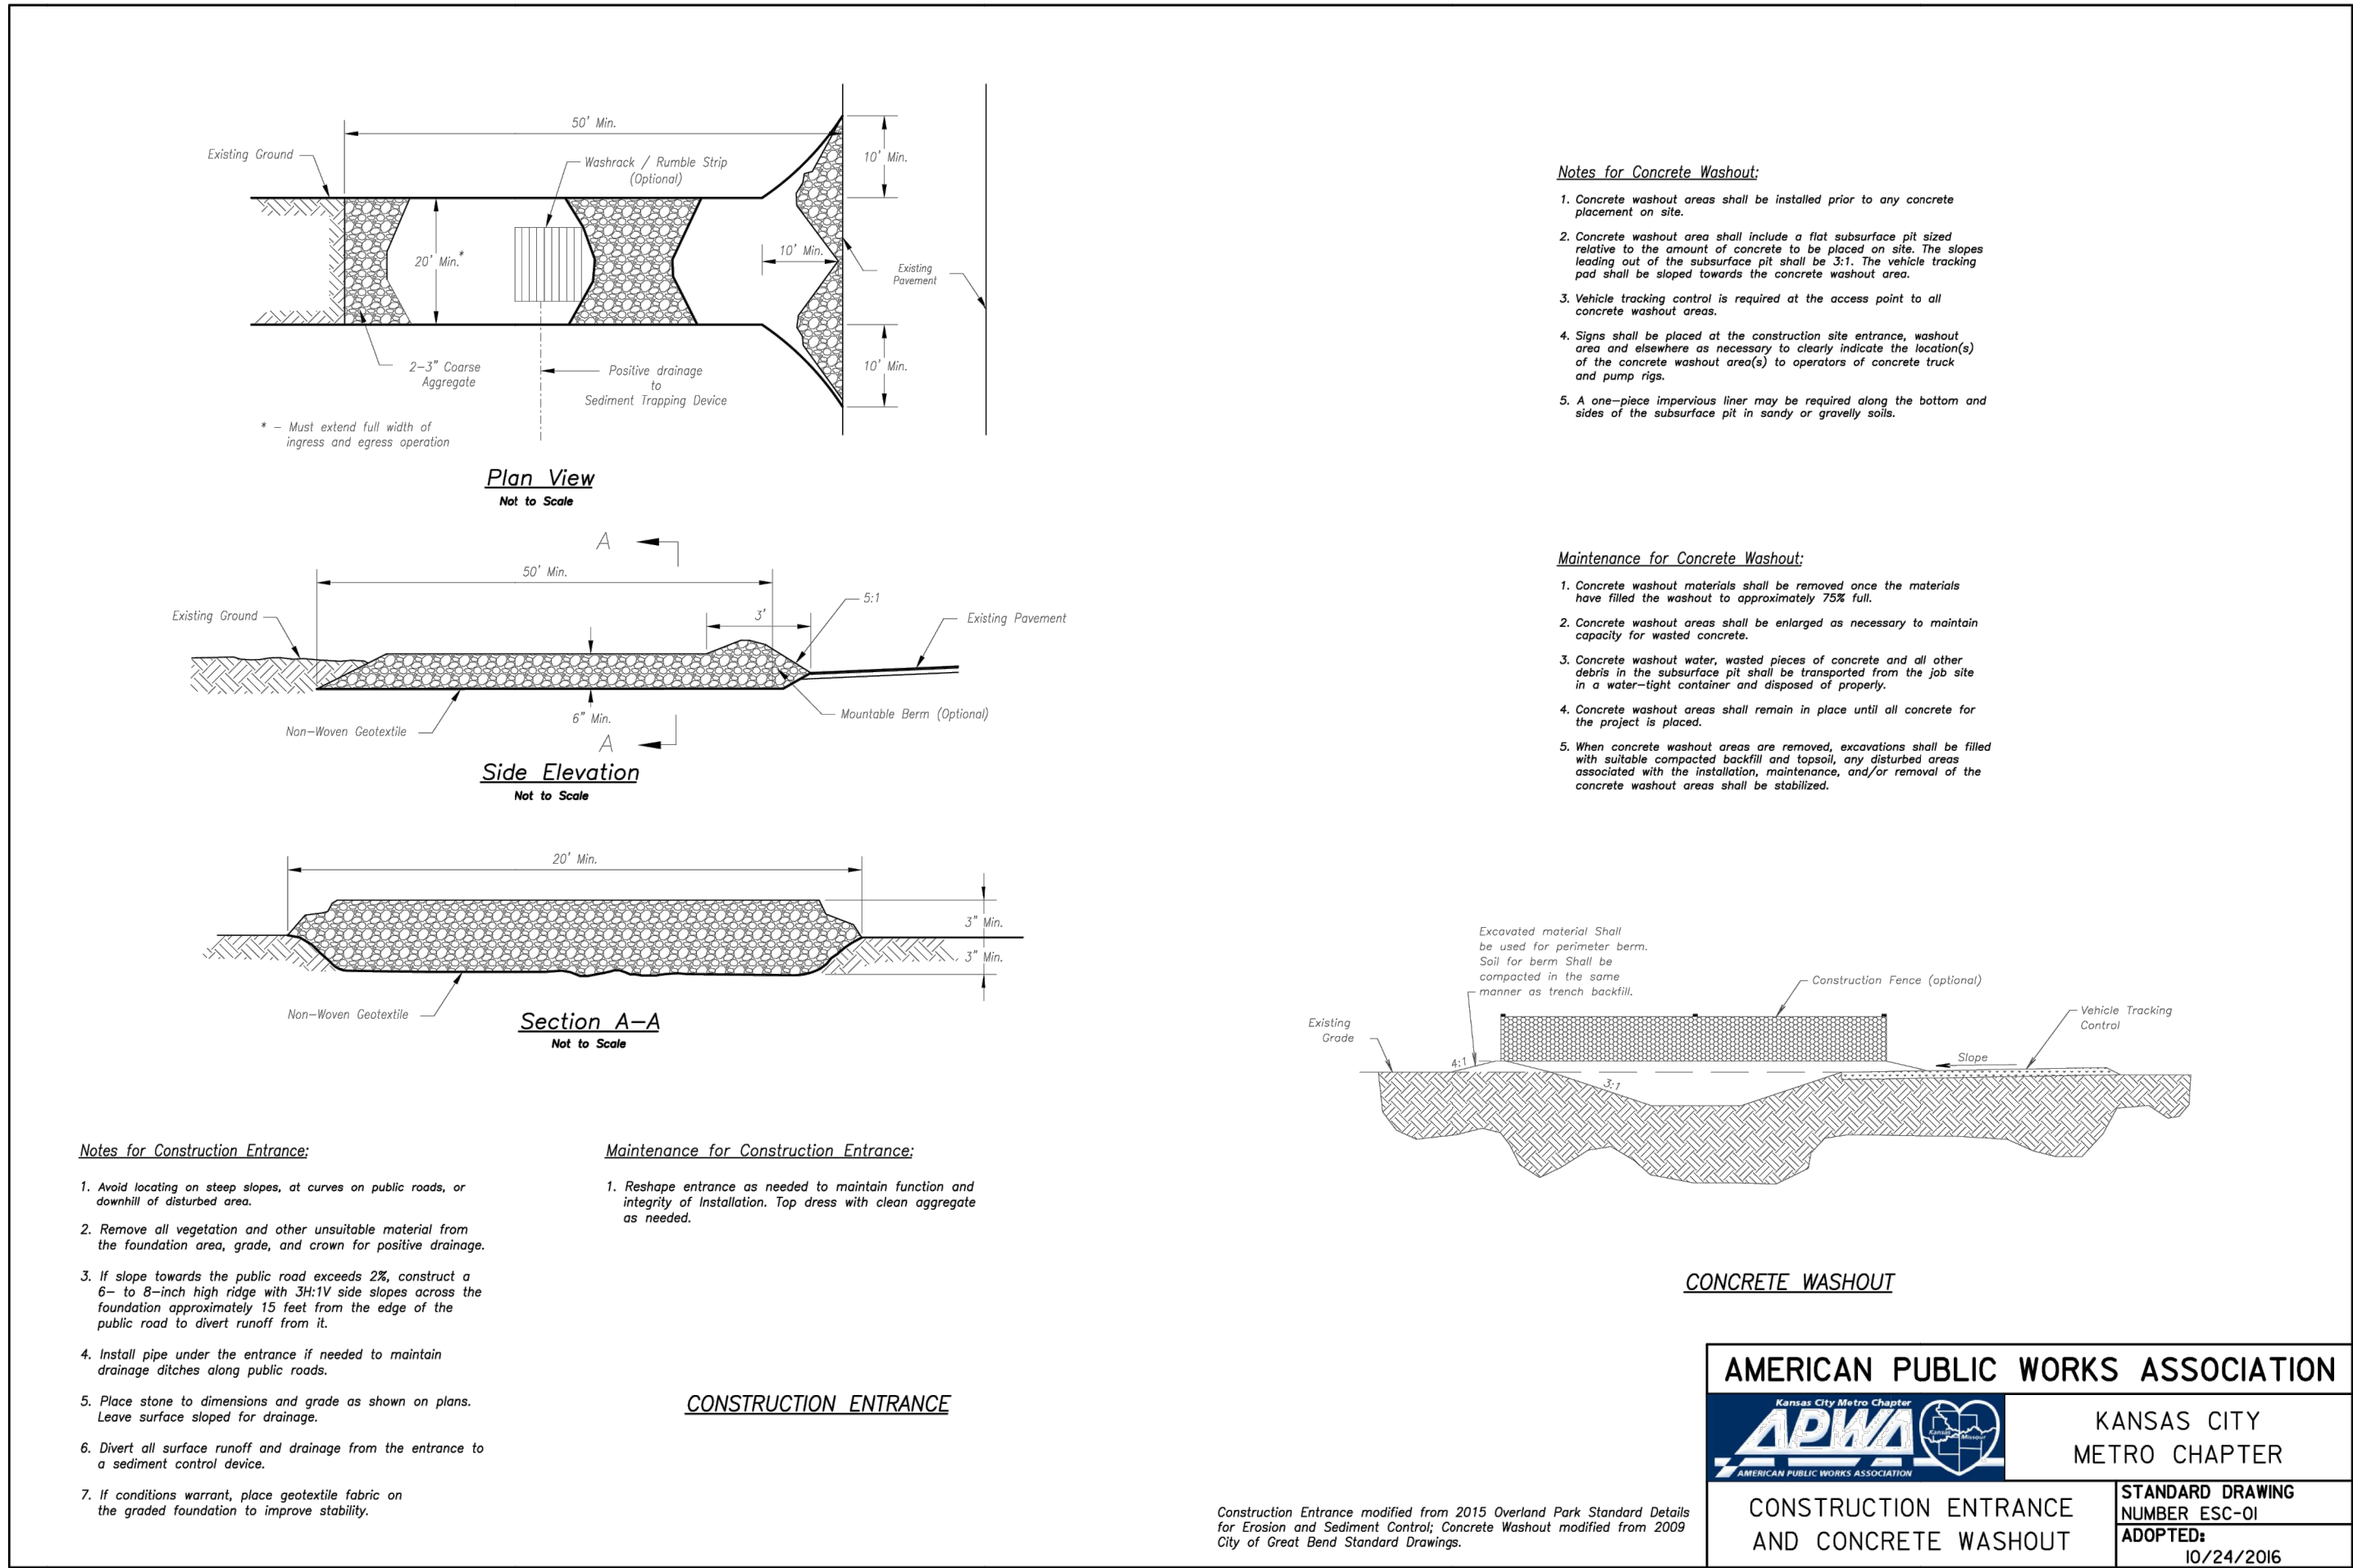


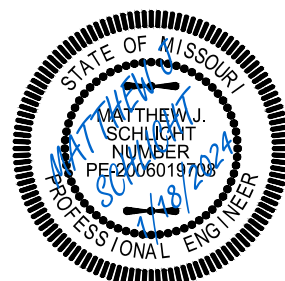

Matthew J. Schlicht
MO PE 2006019708
KS PE 19071
OK PE 25226
NE PE E-14335

REVISIONS


1/18/2024 As-Built

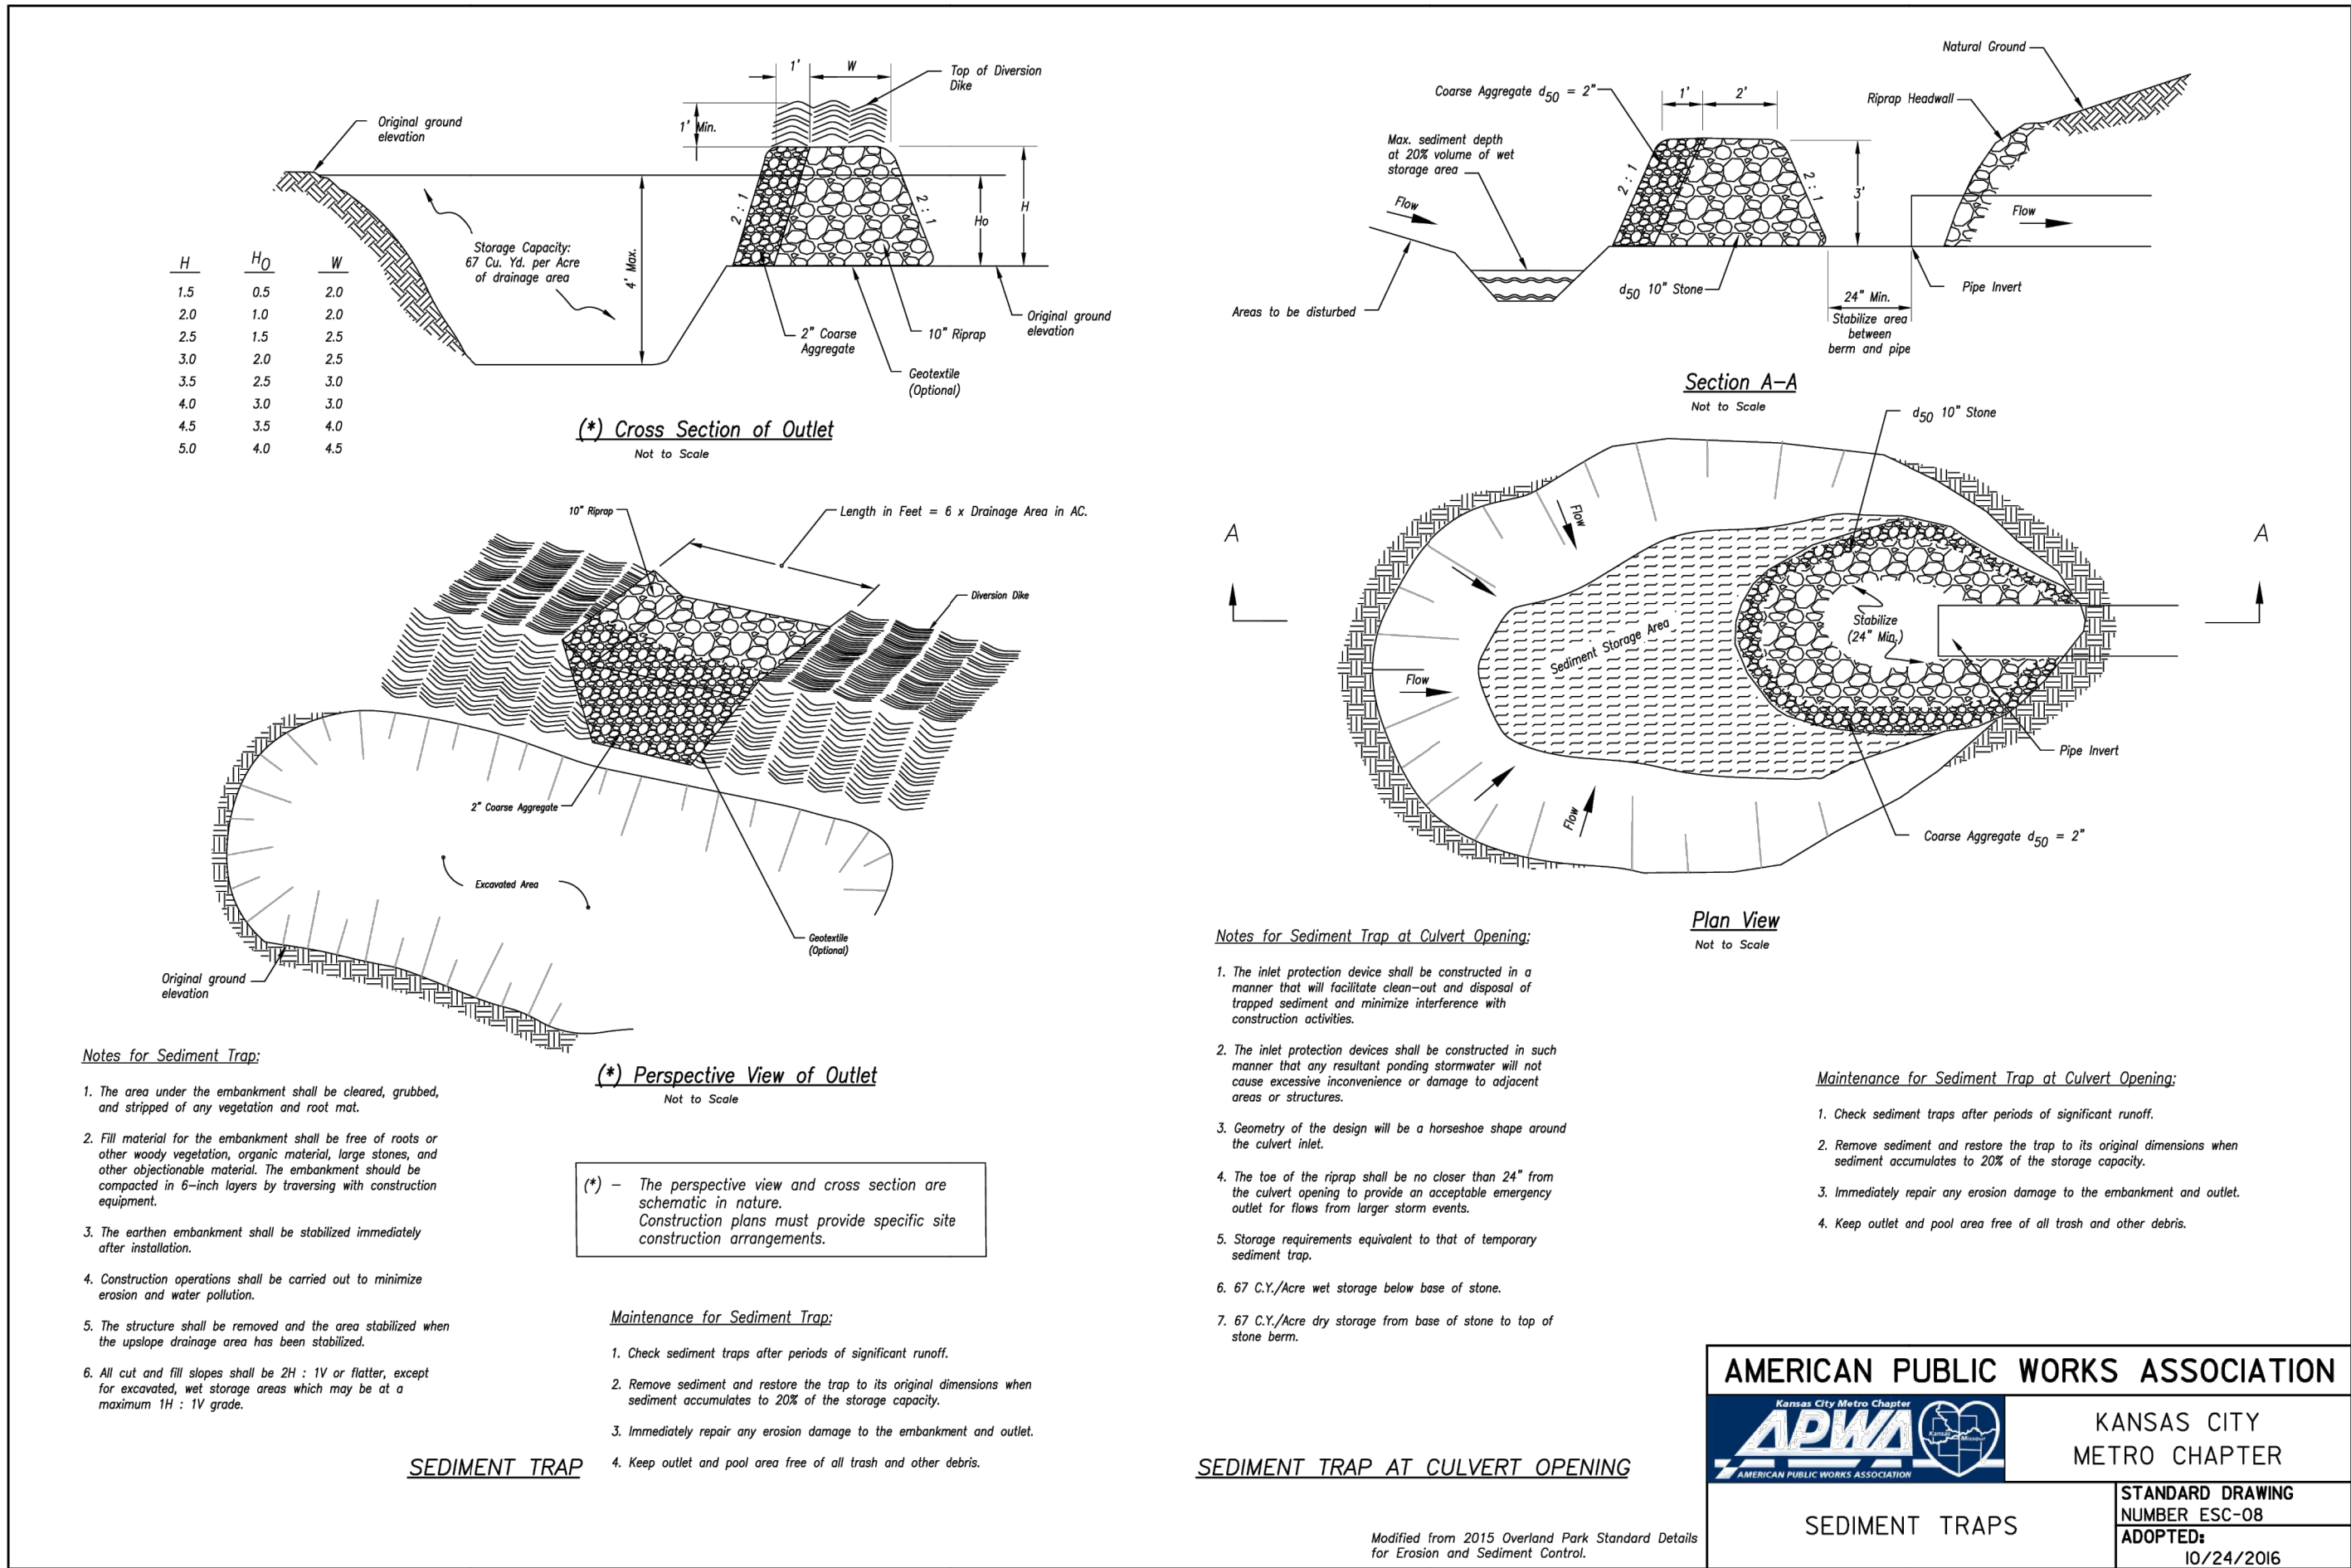

RECORD DRAWING
The information provided on this drawing conforms to construction records; it is not intended for construction, implementation or recording purposes; and it is solely based on information obtained by my firm.

"100-00 100.10", "4-00% 1.15% slope", or "8-inch HDPE-PVC pipe" are all typical examples of revisions that indicate that design data has been replaced with "as-built" information. All other data is as designed and has not been field verified.


Date: 1/18/2024
Certified by: Matthew J. Schlicht
Title: Engineer
Firm: Engineering Solutions

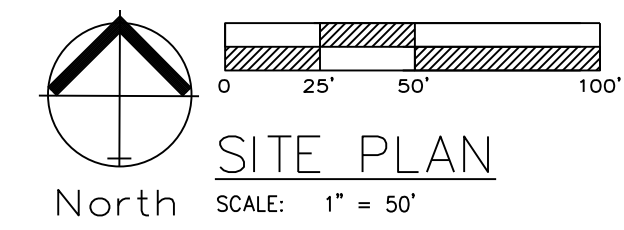

RECORD DRAWING
The information provided on this drawing conforms to construction records; it is not intended for construction, implementation or recording purposes; and it is solely based on information obtained by my firm.

*100-00 100.10", "4-00% 1.15% slope", or "8-inch HDPE-PVC pipe" are all typical examples of revisions that indicate that design data has been replaced with "as-built" information. All other data is as designed and has not been field verified.

Date: 1/18/2024
Certified by: Matthew J. Schlicht
Title: Engineer
Firm: Engineering Solutions

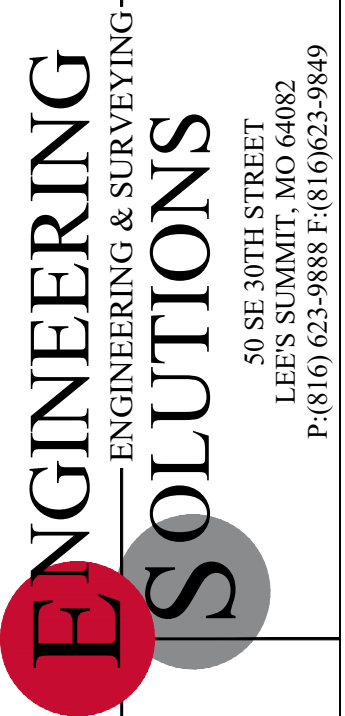

Professional Registration
Missouri
Engineering 2005002186-D
Surveying 2005008319-D
Kansas
Engineering E-1685
Surveying LS-218
Oklahoma
Engineering 6284
Nebraska
Engineering CA2821

Part of the Southeast 1/4
Section 27, Township 48 North, Range 31 West
Lee's Summit, Jackson County, Missouri


Project: WOODLAND OAKS
LSMO
Issue Date: January 18, 2024

Construction Plans for:
WOODLAND OAKS
Lots 1 thru 42
Lee's Summit, Jackson County, Missouri



Matthew J. Schlicht
MO PE 2006019708
KS PE 19071
OK PE 25226
NE PE E-14335


REVISIONS
1/18/2024 As-Built

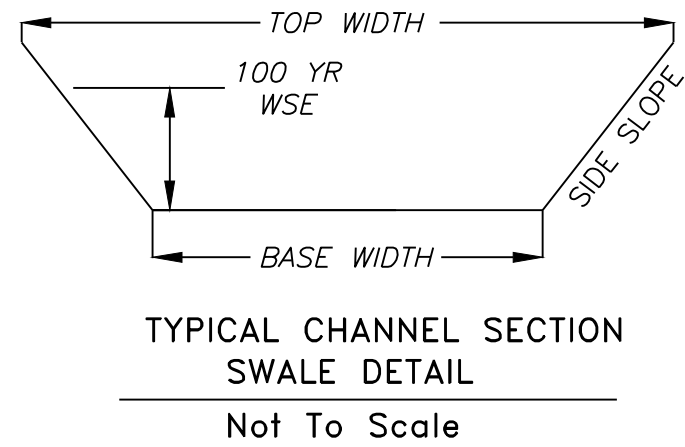


NOTE: Swale sections extend the entire length between upstream and downstream structures with the exception of a transition at each structure.

100 YEAR OVERFLOW SWALE SECTIONS										
Section	100 Yr. Runoff (c.f.s.)	Bed Slope (%)	Base Width (ft)	Side Slope (1:V)	100 Yr WSE (ft)	Sectional Area	Velocity 100Yr. (f.p.s.)	Hydraulic Radius (ft)	Shear Stress (p.s.f.)	
1-1	1.42	2.32	5	6	0.14	0.82	1.73	0.12	0.18	
2-2	1.42	2.19	5	6	0.14	0.82	1.73	0.12	0.17	
3-3	0.96	2.00	5	6	0.12	0.69	1.39	0.11	0.13	
4-4	2.87	2.00	5	6	0.22	1.39	2.06	0.18	0.23	
5-5	1.25	2.00	5	6	0.14	0.82	1.52	0.12	0.15	

NOTE: Swale should be lined with "Straw with Net" turf reinforcement (Curlex Blanket or Eqv.). Per Table 5607-1 in APWA Manual

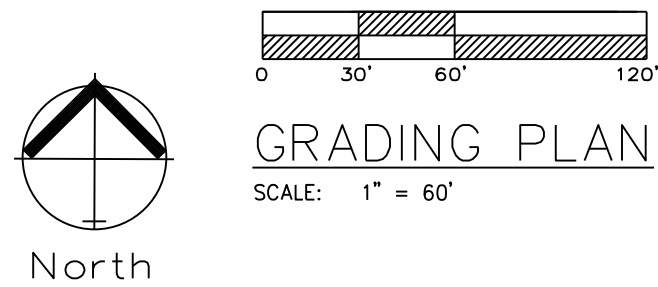

GRADING PLAN
SCALE: 1" = 60'

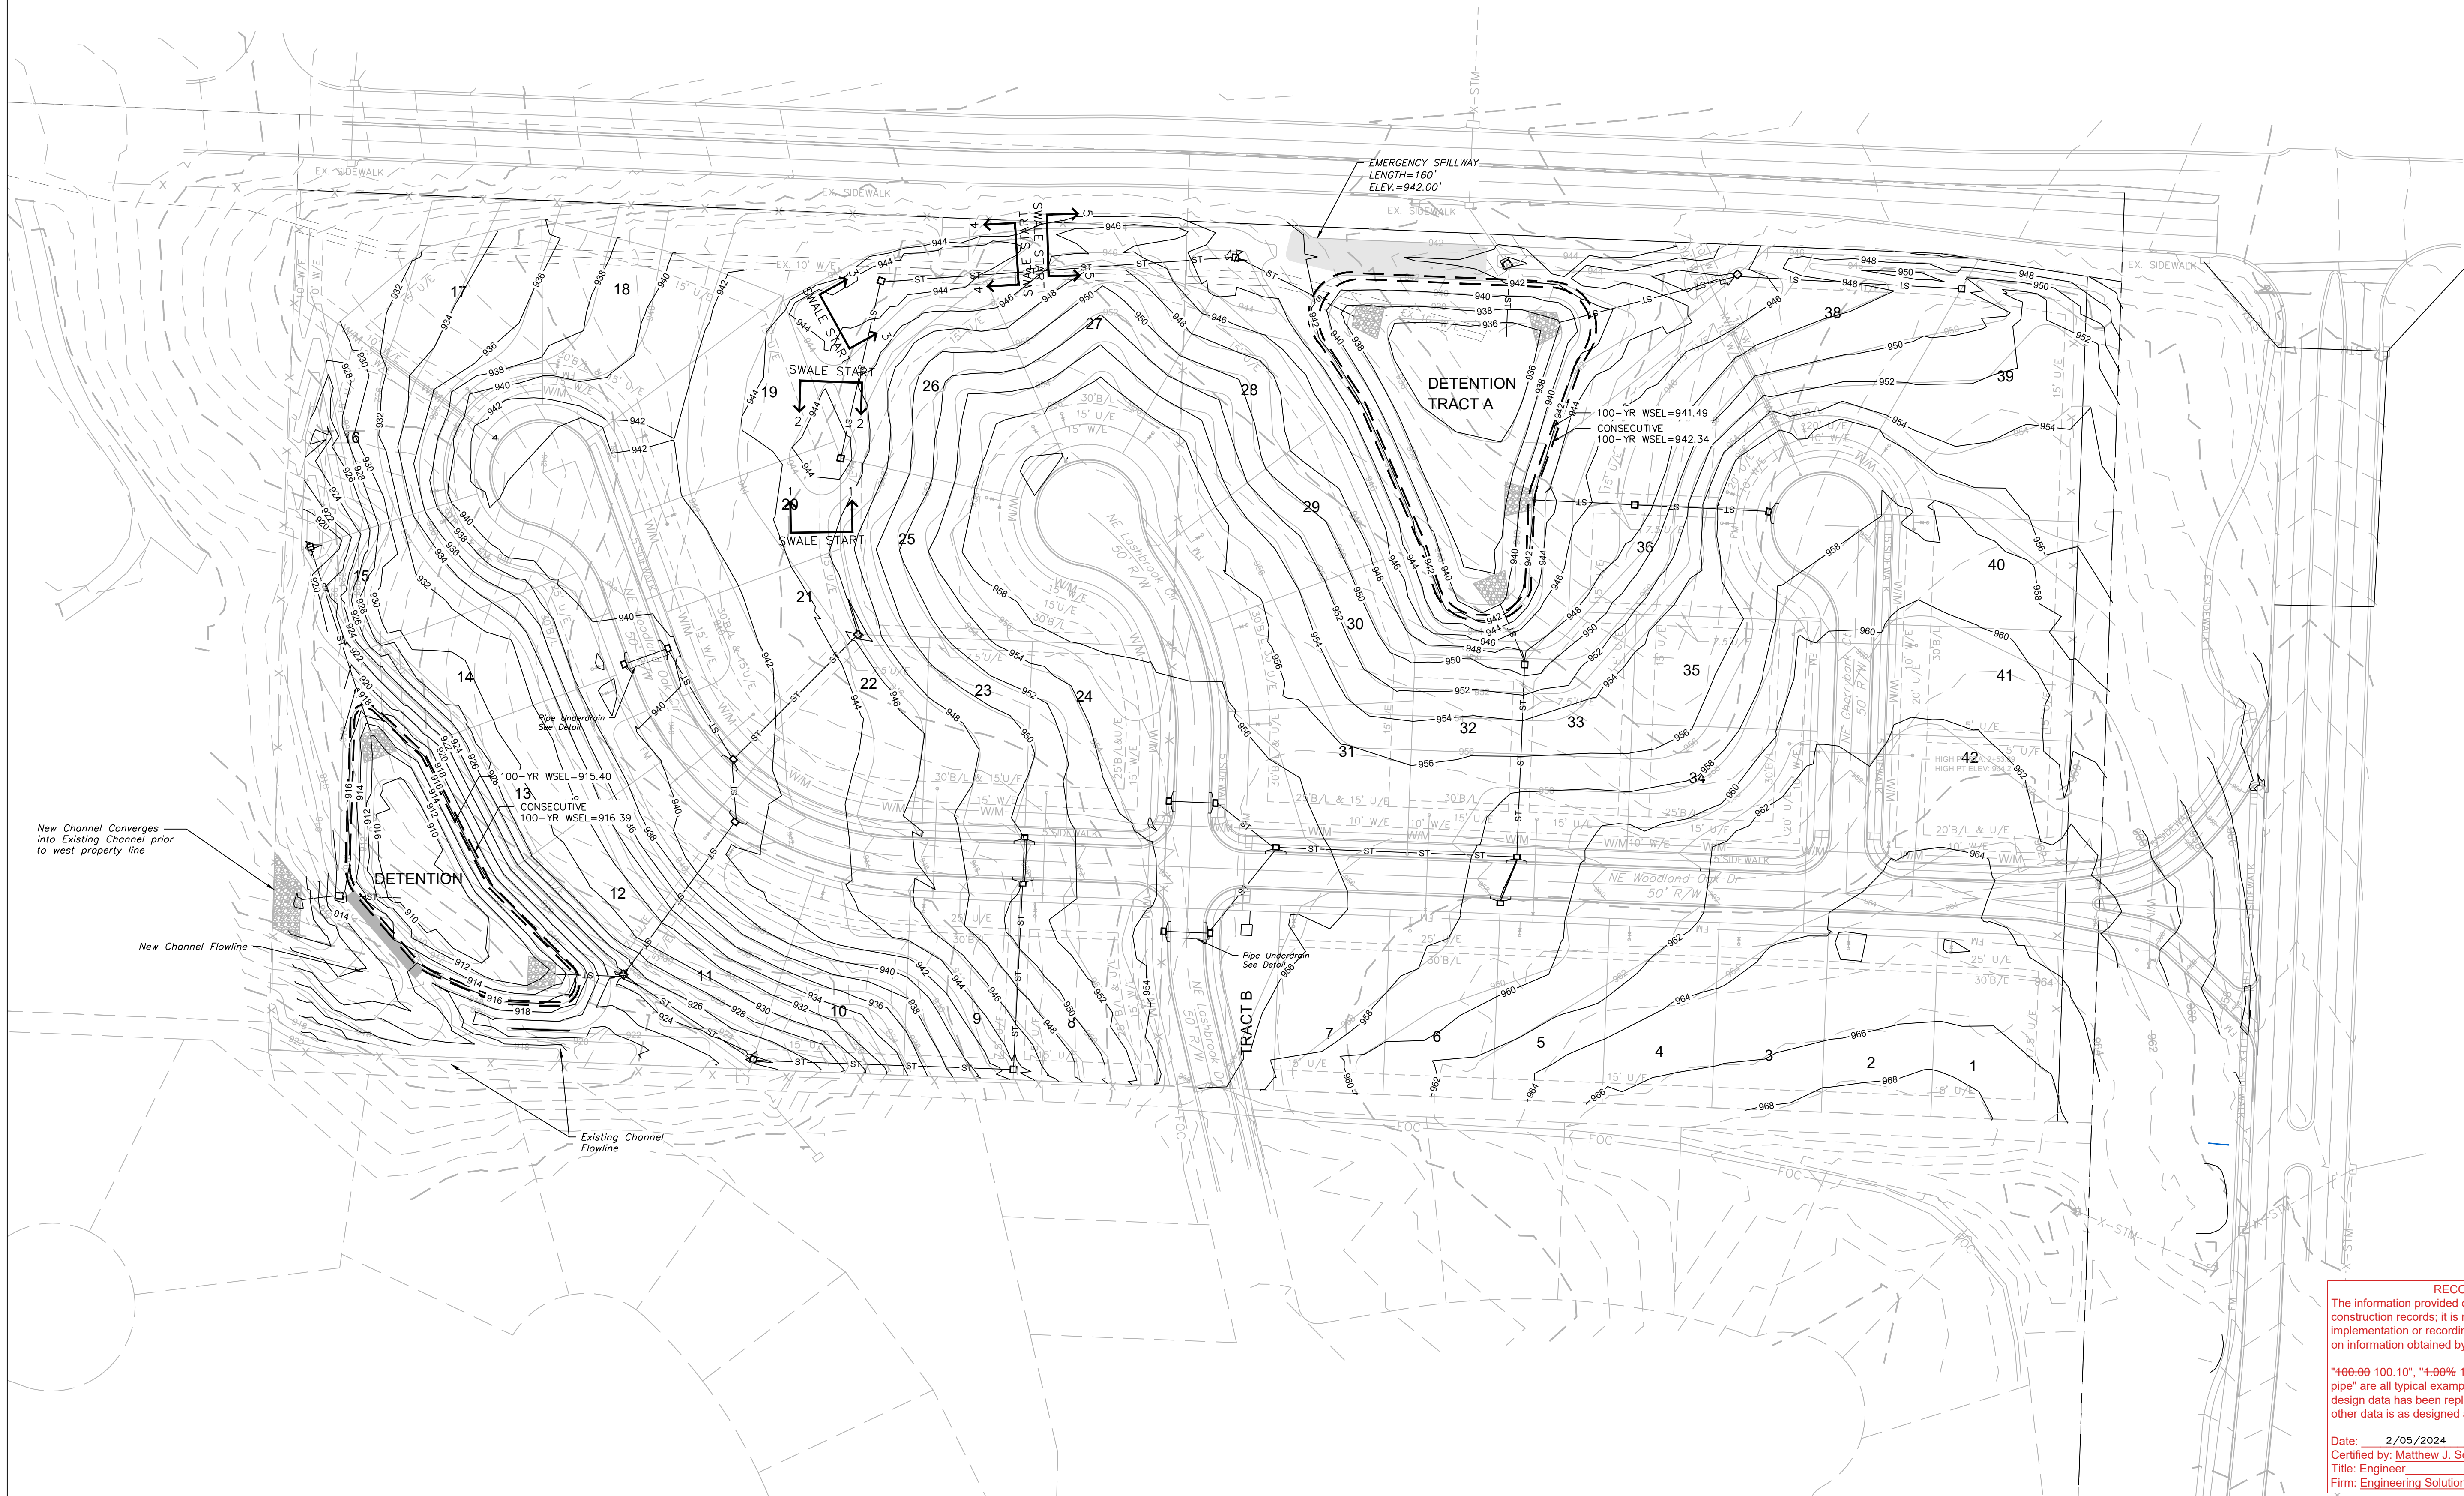

MASTER DRAINAGE PLAN SHEET 1 OF 3

GRADING PLAN - SWPPP

Construction Plans for:

WOODLAND OAKS

Lots 1 thru 42

Lee's Summit, Jackson County, Missouri

Project:

WOODLAND OAKS

LSMO

Issue Date:

January 18, 2024

Part of the Southeast 1/4

Section 27, Township 48 North, Range 31 West

Lee's Summit, Jackson County, Missouri

Professional Registration

Missouri

Engineering 2005002186-D

Surveying 2005008319-D

Kansas

Engineering E-1695


Surveying LS-218

Oklahoma

Engineering 6254

Nebraska

Engineering CA2821

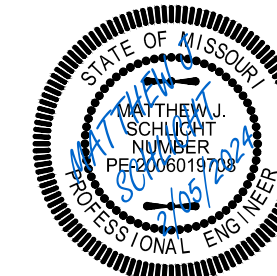

Matthew J. Schlicht
MO PE 2006019708
KS PE 19071
OK PE 25226
NE PE E-14335

REVISIONS

1/18/2024 As-Built



2/05/2024 As-Built

RECORD DRAWING
The information provided on this drawing conforms to construction records; it is not intended for construction, implementation or recording purposes; and it is solely based on information obtained by my firm.

"100-60 100.10", "4-00% 1.15% slope", or "8-inch HDPE-PVC pipe" are all typical examples of revisions that indicate that design data has been replaced with "as-built" information. All other data is as designed and has not been field verified.

Date: 2/05/2024
Certified by: Matthew J. Schlicht
Title: Engineer
Firm: Engineering Solutions

C. 200

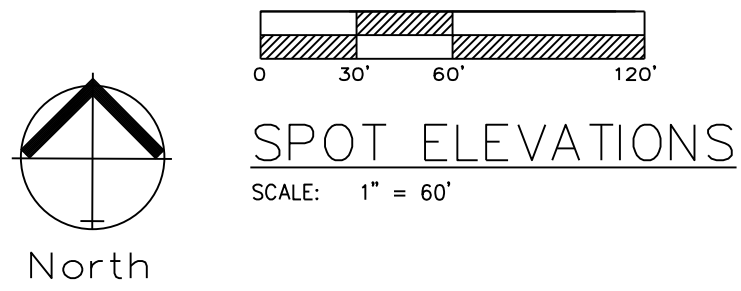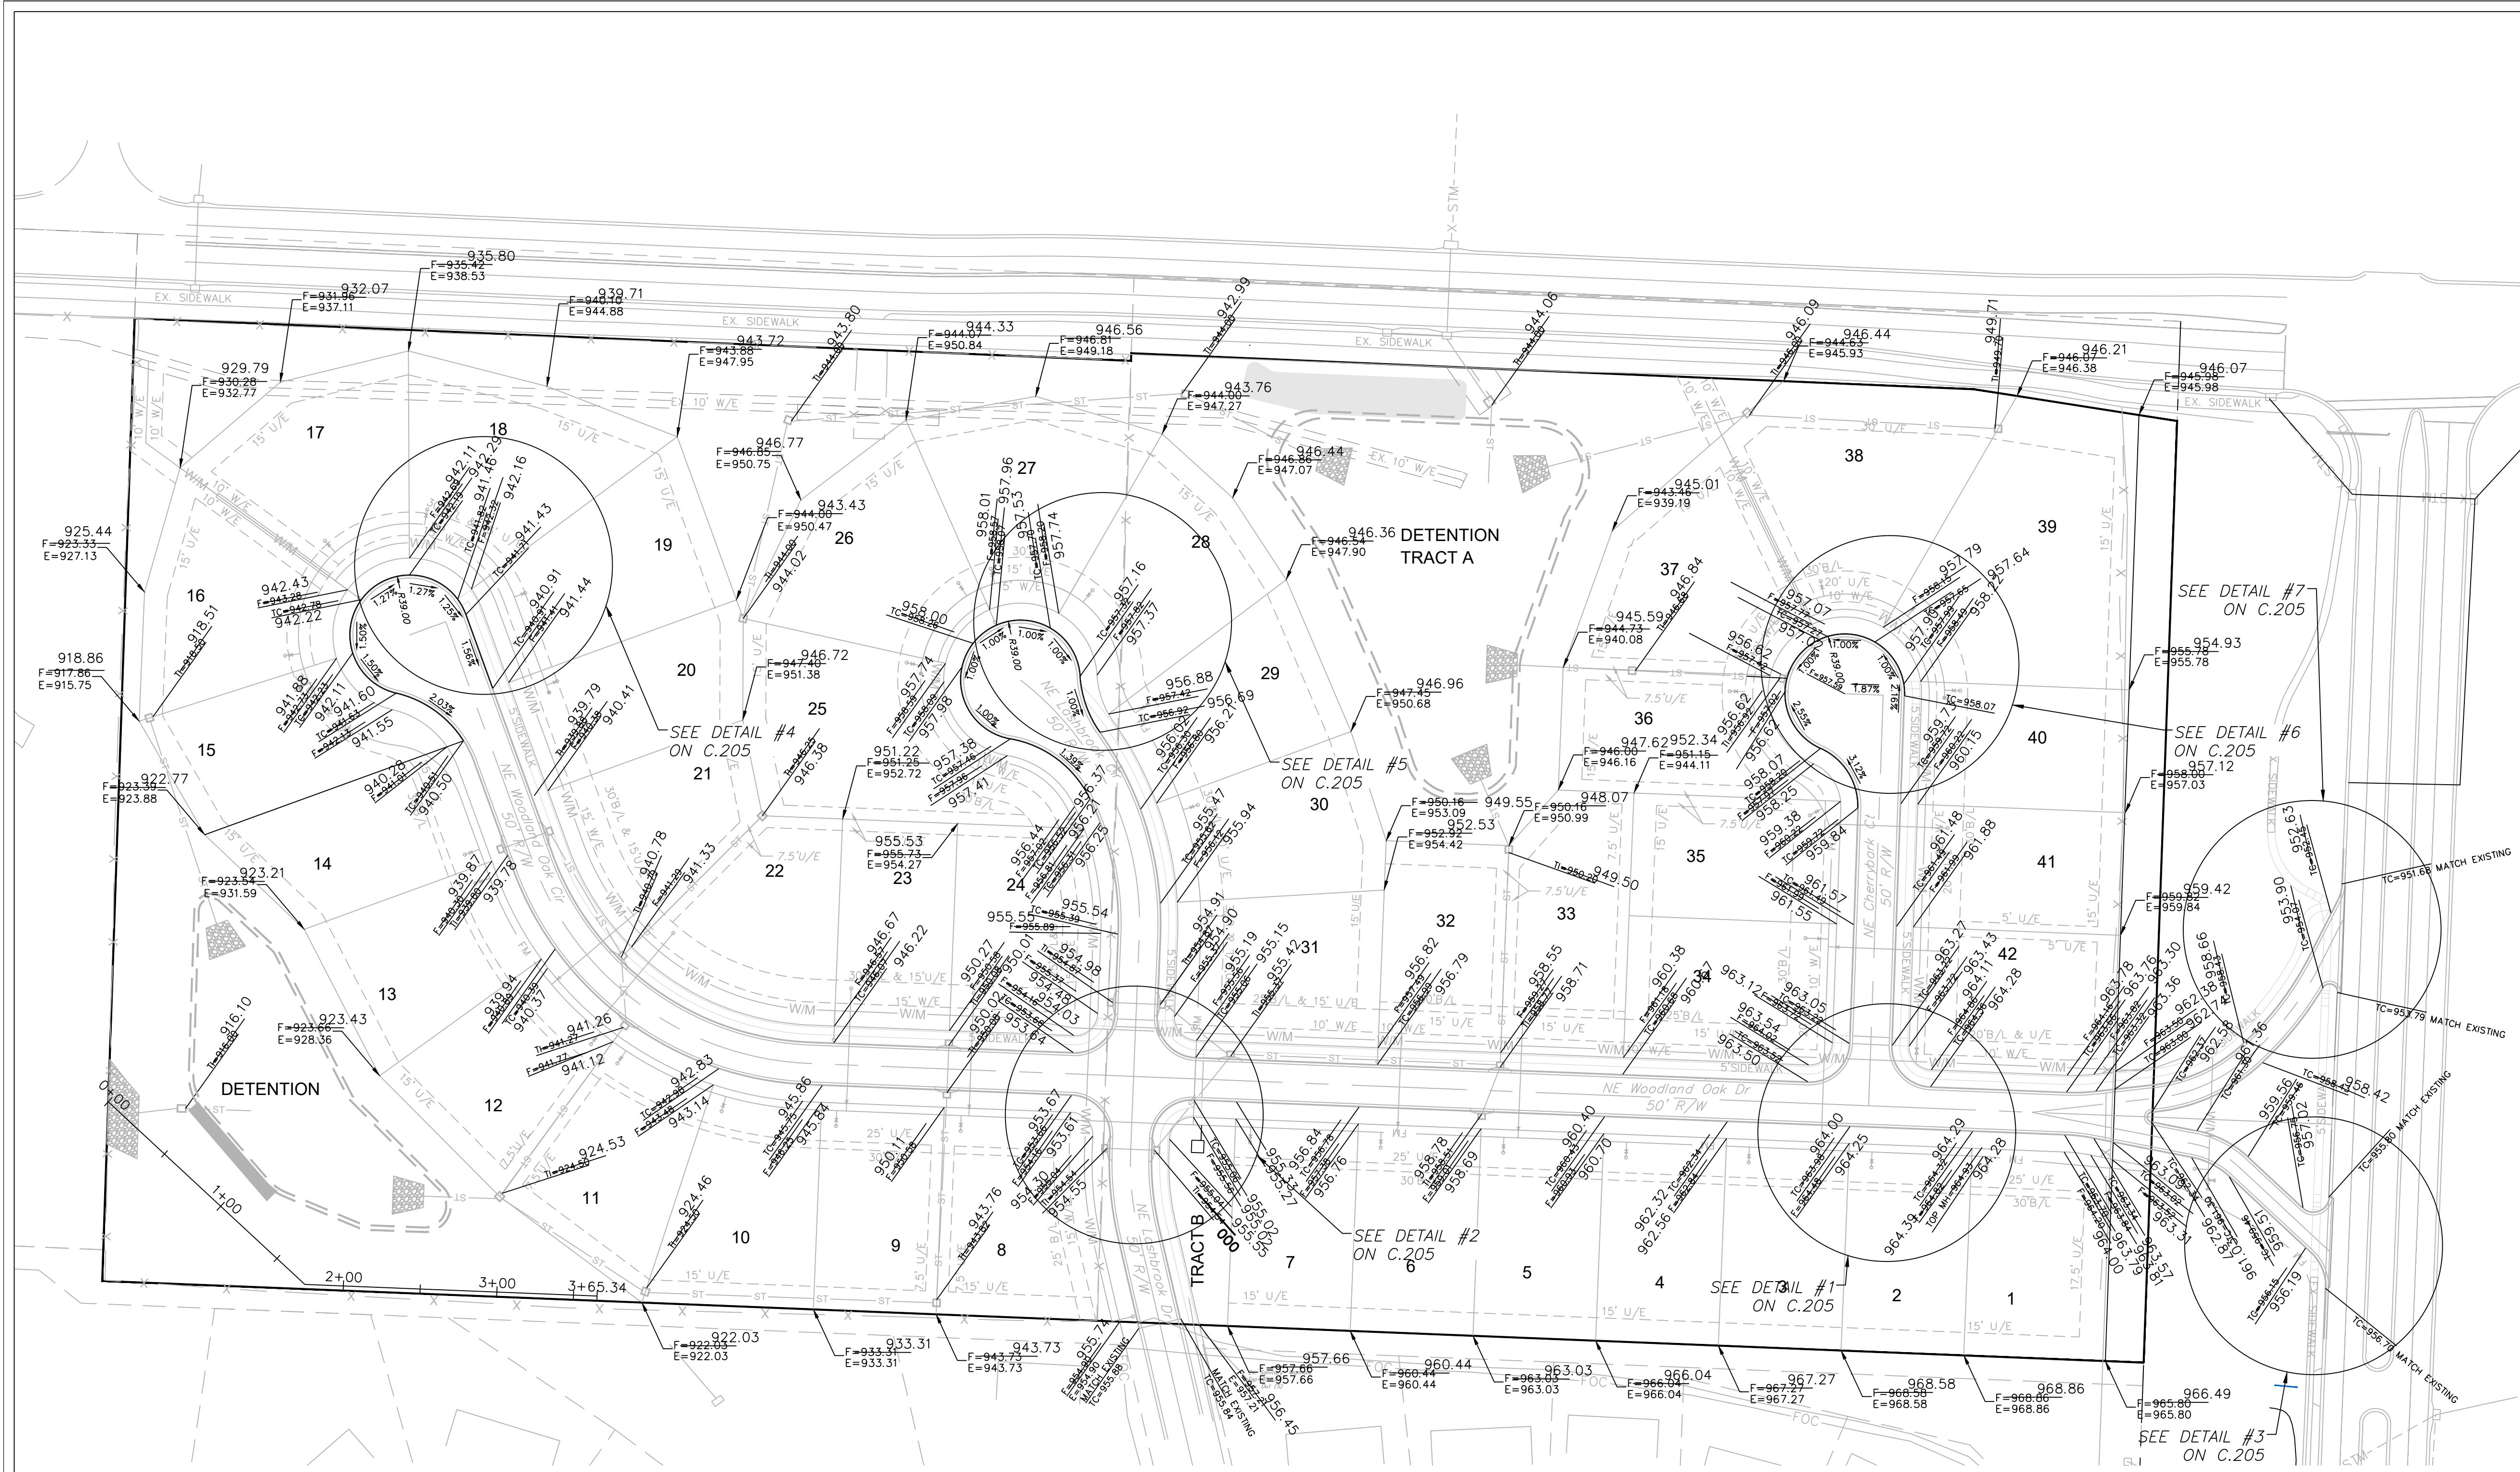

Lot Number	Basement Type	MBOE
1	Standard	
2	Standard	
3	Standard	
4	Standard	
5	Standard	
6	Standard	
7	Standard	
8	Walkout	945.58
9	Walkout	945.58
10	Walkout	925.86
11	Walkout	925.65
12	Walkout	925.65
13	Walkout	917.4
14	Walkout	917.4
15	Walkout	919.77
16	Daylight	919.77
17	Standard	
18	Standard	
19	Standard	945.15
20	Standard	945.14
21	Standard	947.42
22	Standard	947.42
23	Standard	
24	Standard	
25	Walkout	945.14
26	Walkout	945.15
27	Walkout	945.12
28	Walkout	943.49
29	Walkout	943.49
30	Daylight	943.49
31	Standard	
32	Walkout	943.49
33	Walkout	943.49
34	Daylight	
35	Daylight	
36	Walkout	943.49
37	Walkout	943.49
38	Daylight	947.17
39	Daylight	950.93
40	Daylight	
41	Daylight	
42	Standard	

RECORD DRAWING
The information provided on this drawing conforms to construction records; it is not intended for construction, implementation or recording purposes; and it is solely based on information obtained by my firm.

*100-00 100.10", "4-00% 1.15% slope", or "8-inch HDPE-PVC pipe" are all typical examples of revisions that indicate that design data has been replaced with "as-built" information. All other data is as designed and has not been field verified.

Date: 1/18/2024
Certified by: Matthew J. Schlicht
Title: Engineer
Firm: Engineering Solutions



MASTER DRAINAGE PLAN SHEET 2 OF 3

SPOT ELEVATIONS
Construction Plans for:
WOODLAND OAKS
Lots 1 thru 42
Lee's Summit, Jackson County, Missouri

Project:
WOODLAND OAKS
LSMO
Issue Date:
January 18, 2024


Part of the Southeast 1
Section 27, Township 48 North, Range 31 West
Lee's Summit, Jackson County, Missouri

Professional Registration
Missouri
Engineering 2005002186-D
Surveying 2005008319-D
Kansas
Engineering E-1695
Surveying LS-218
Oklahoma
Engineering S254
Nebraska
Engineering CA2821

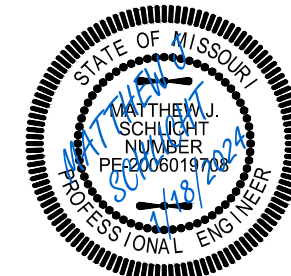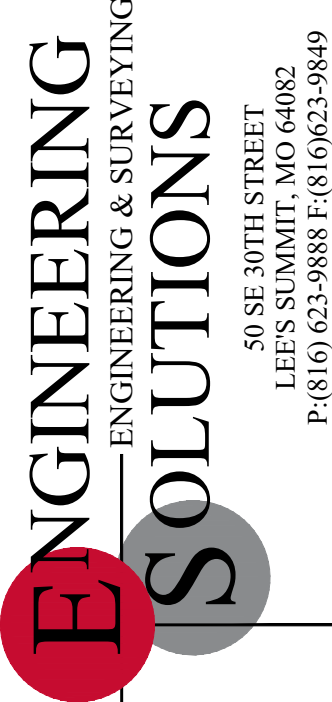




Matthew J. Schlicht
MO PE 2006019708
KS PE 19071
OK PE 25226
NE PE E-14335

REVISIONS
1/18/2024 As-Built



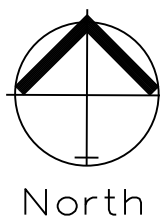


Date: 1/18/2024
 Certified by: Matthew J. Schlicht
 Title: Engineer
 Firm: Engineering Solutions

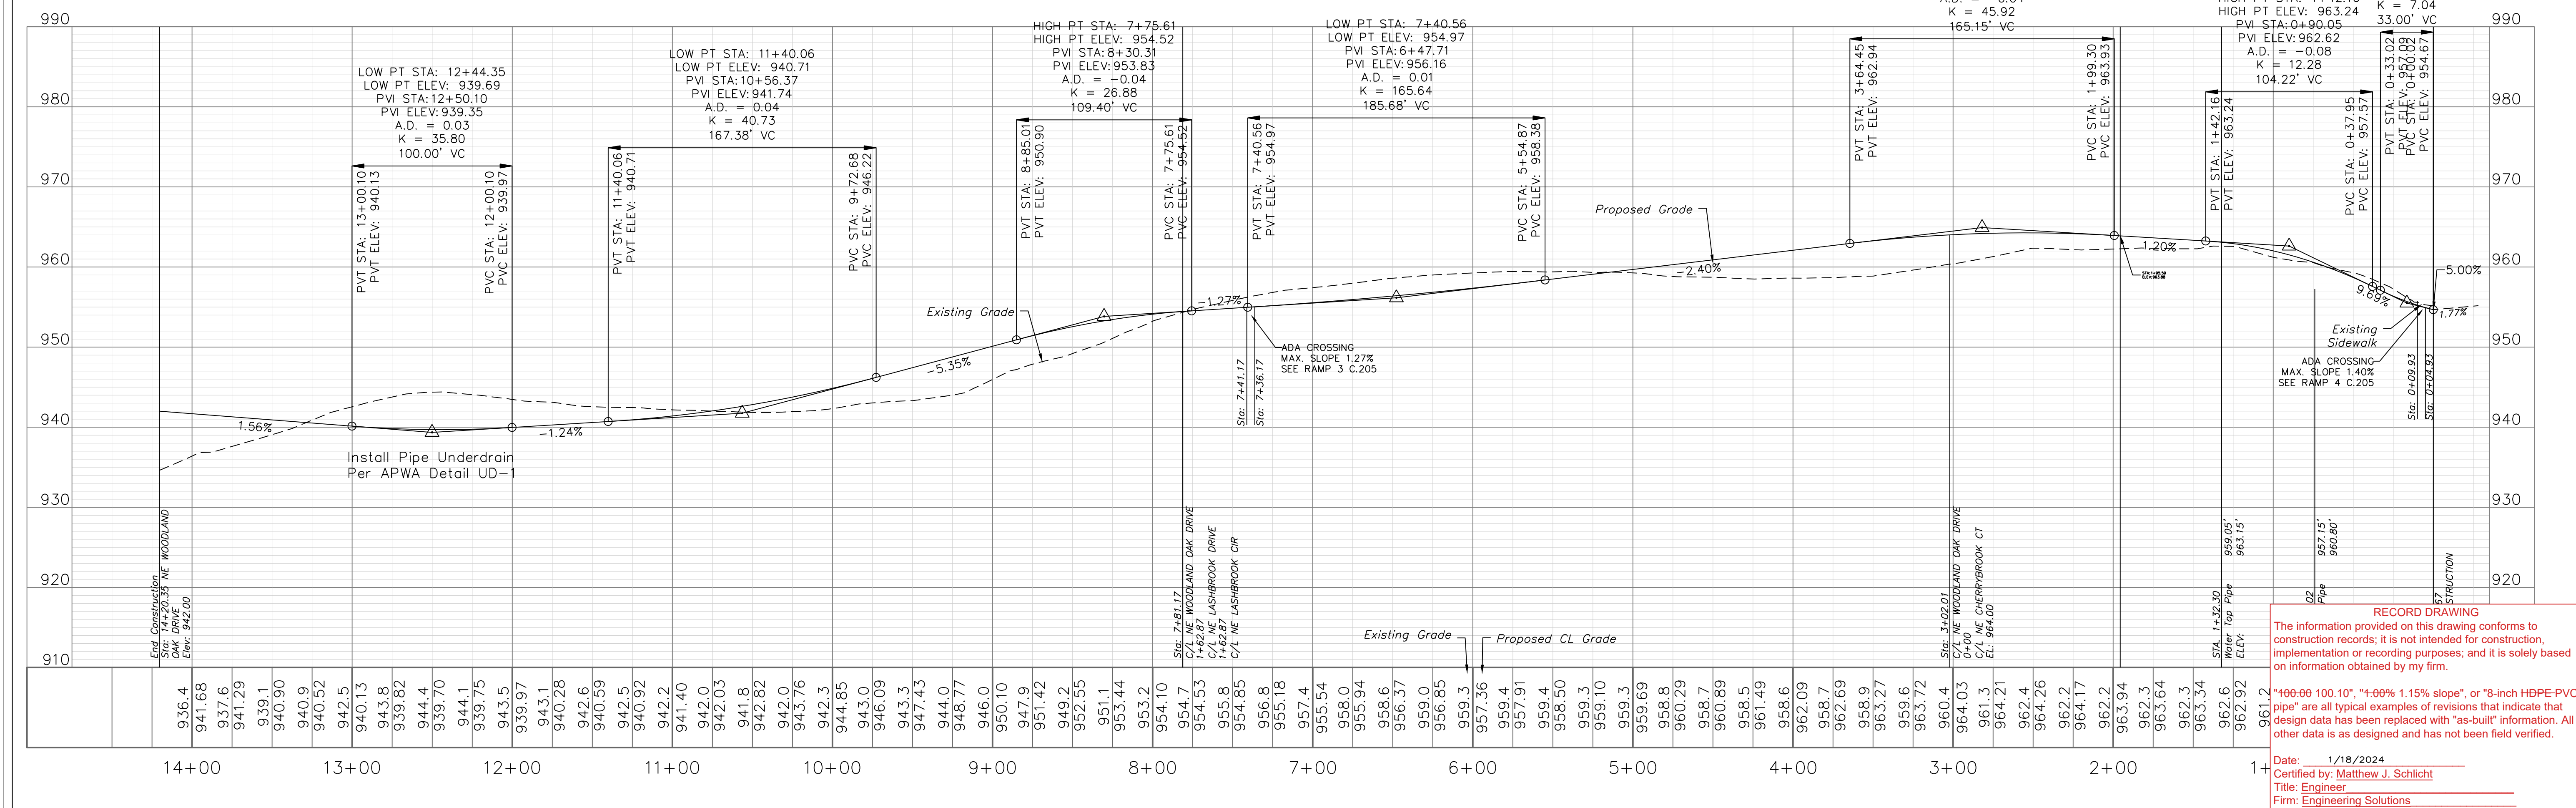


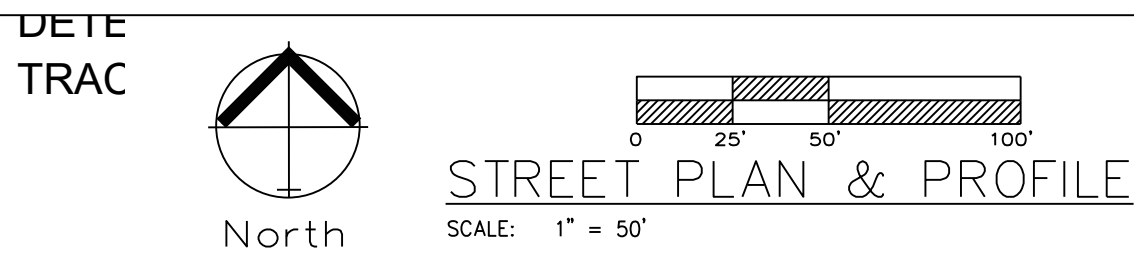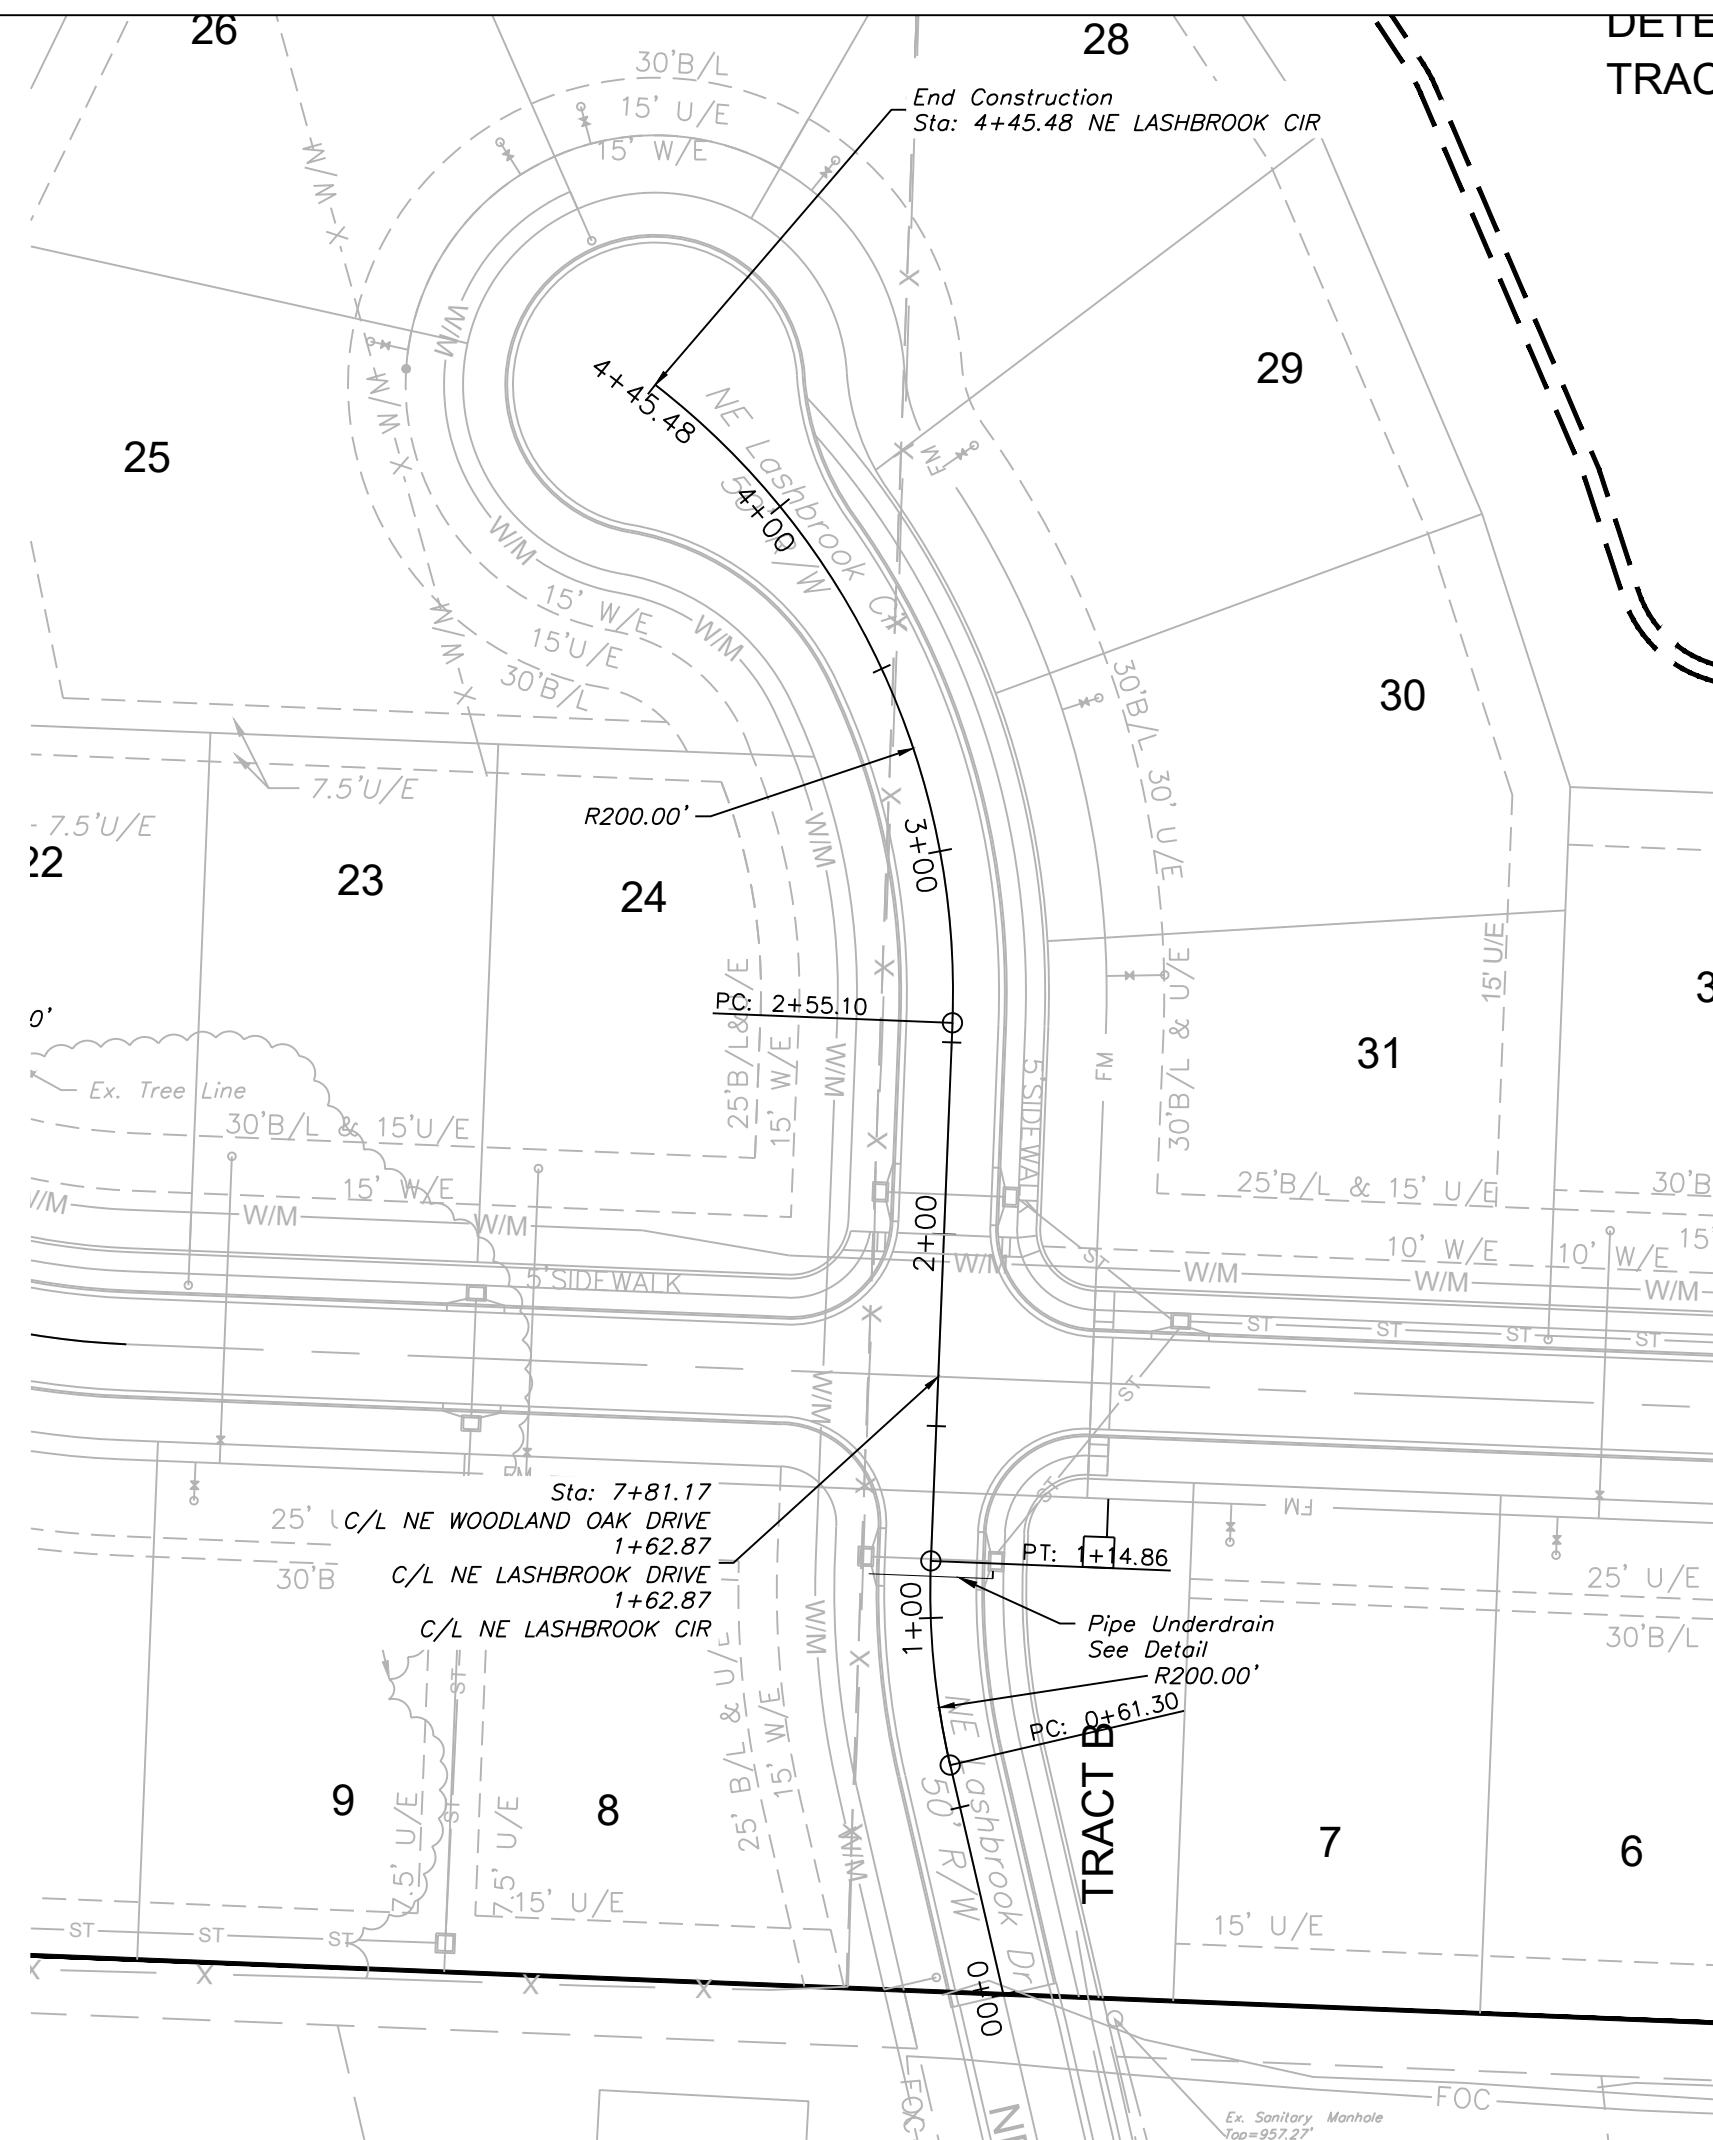

NE LASHBROOK DR

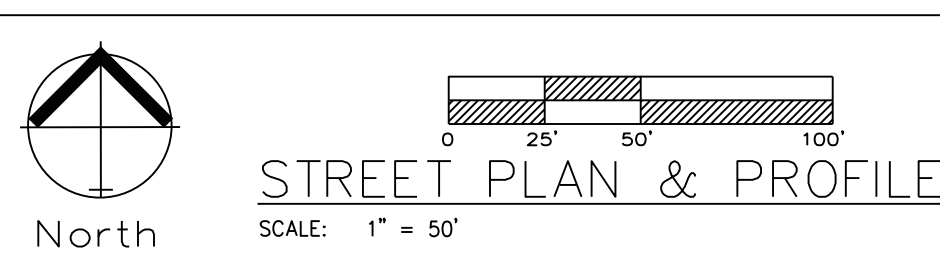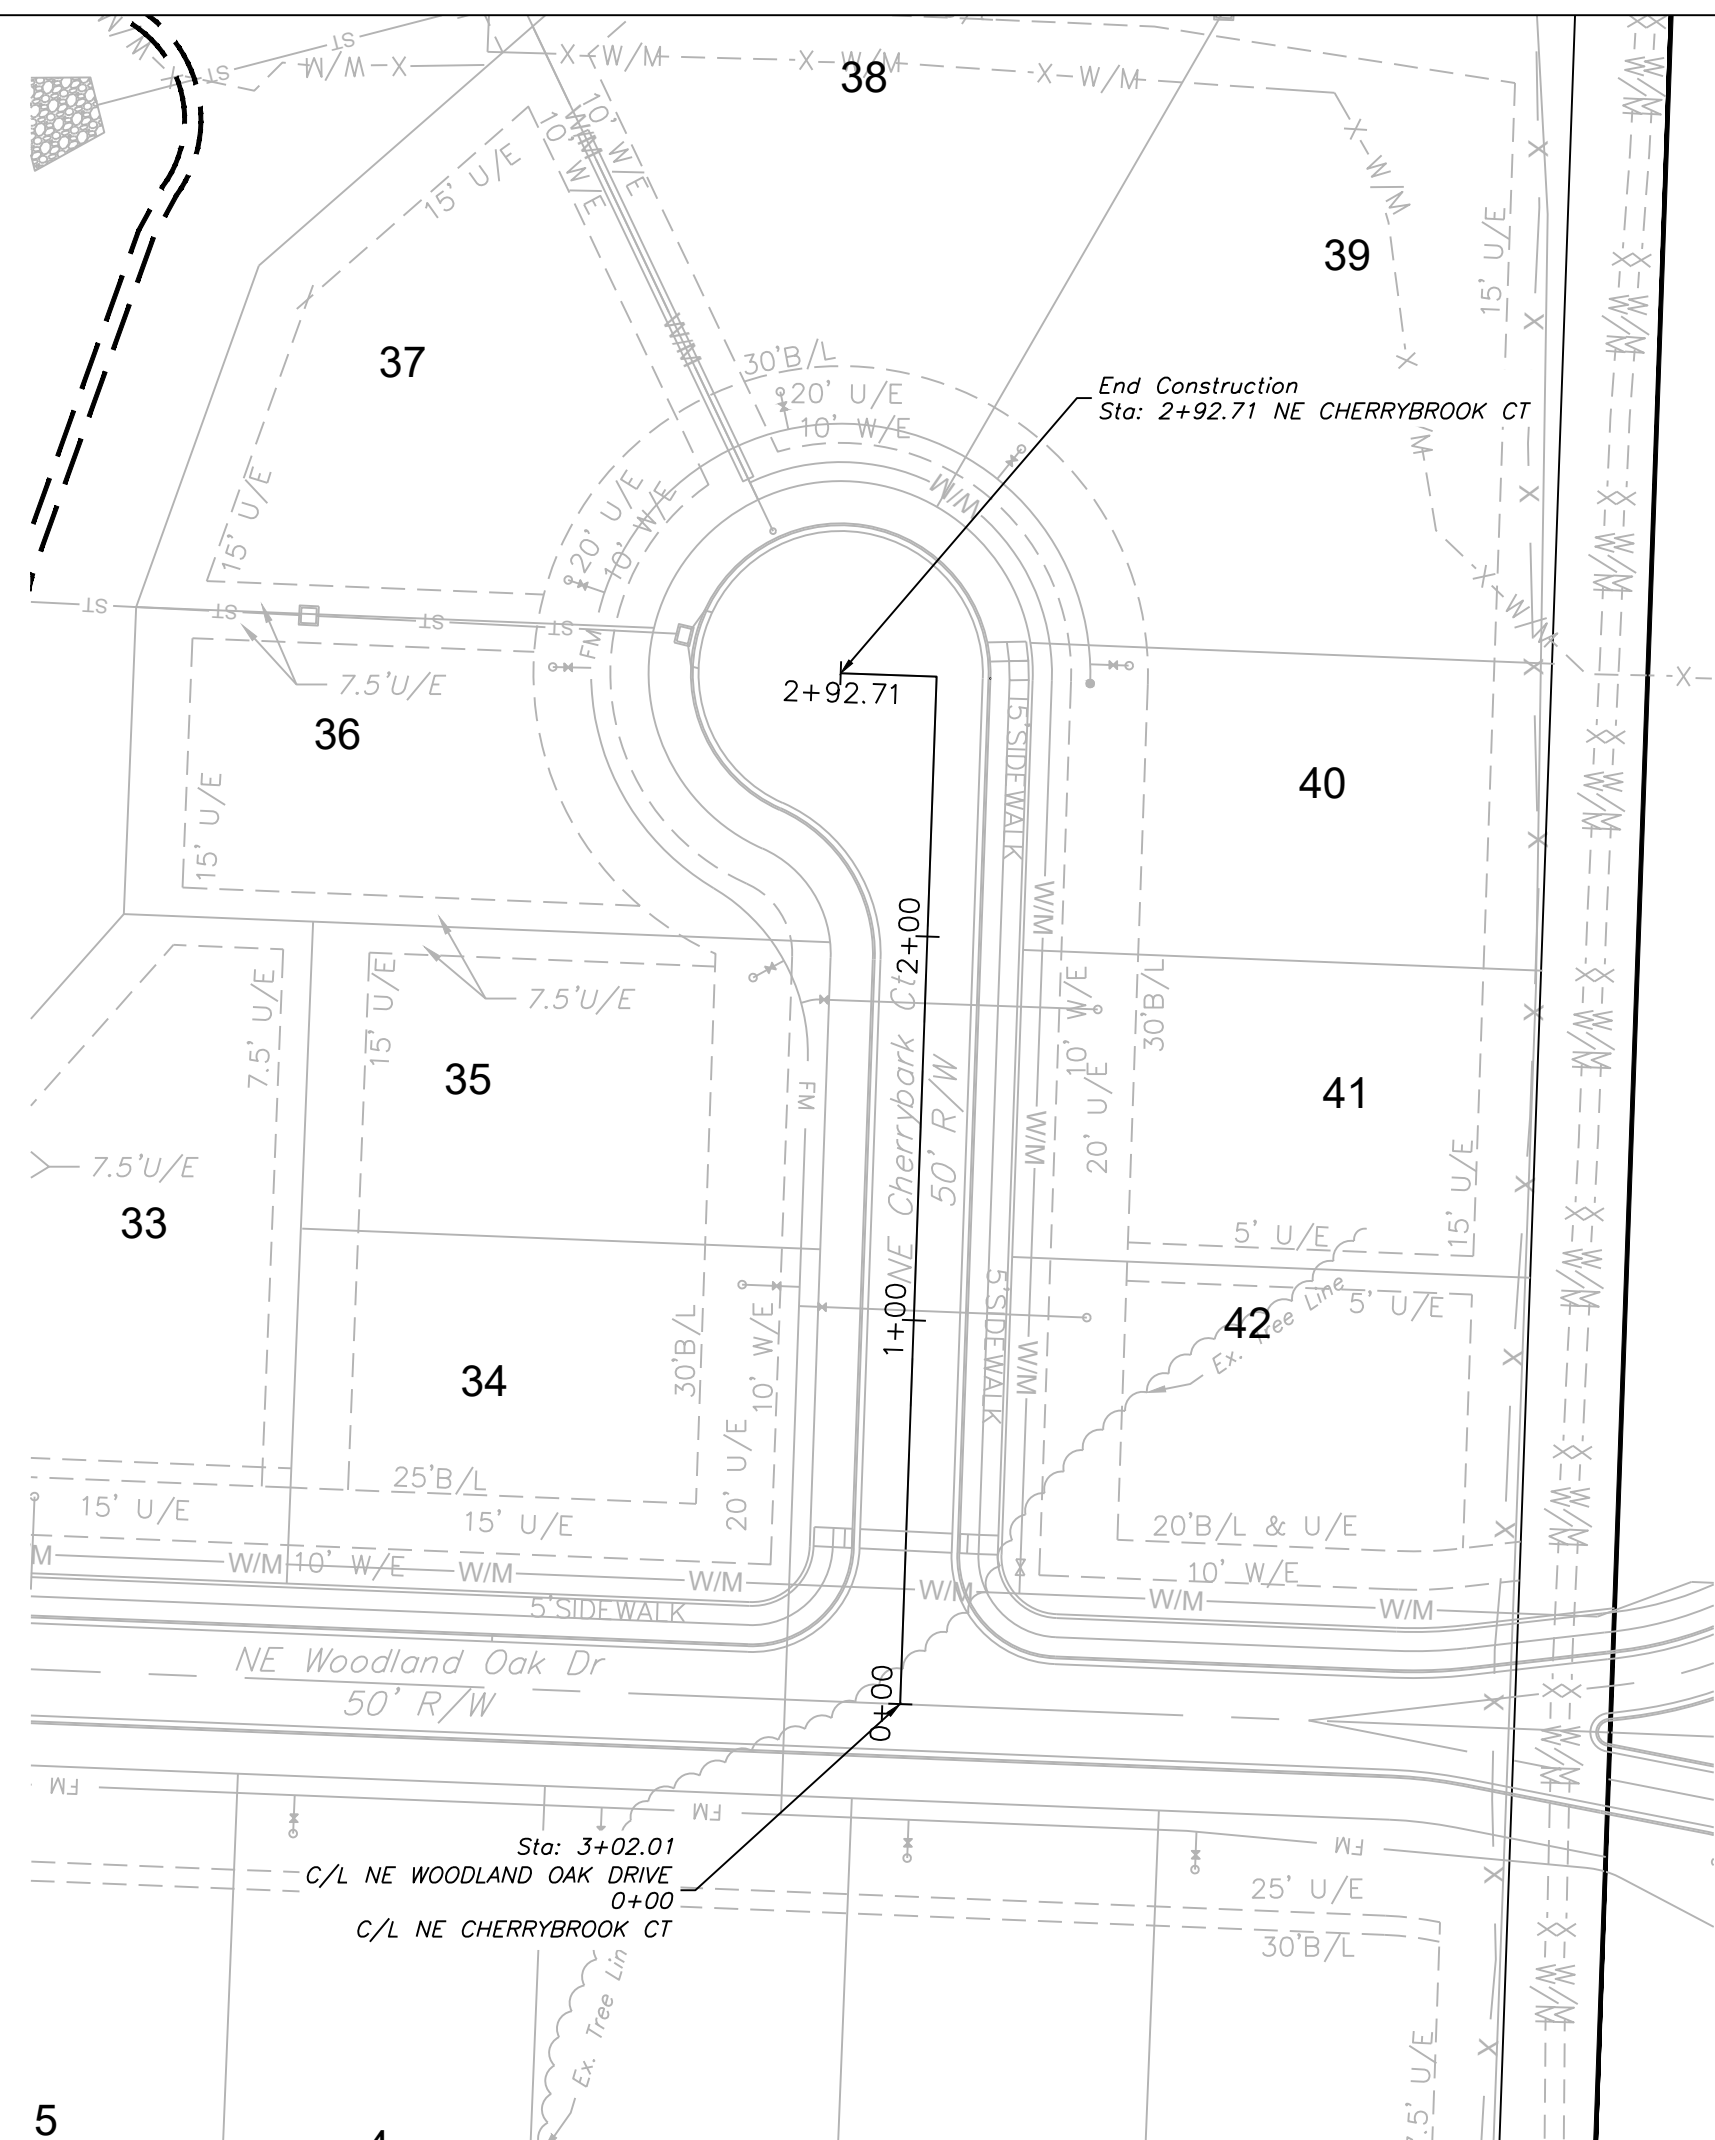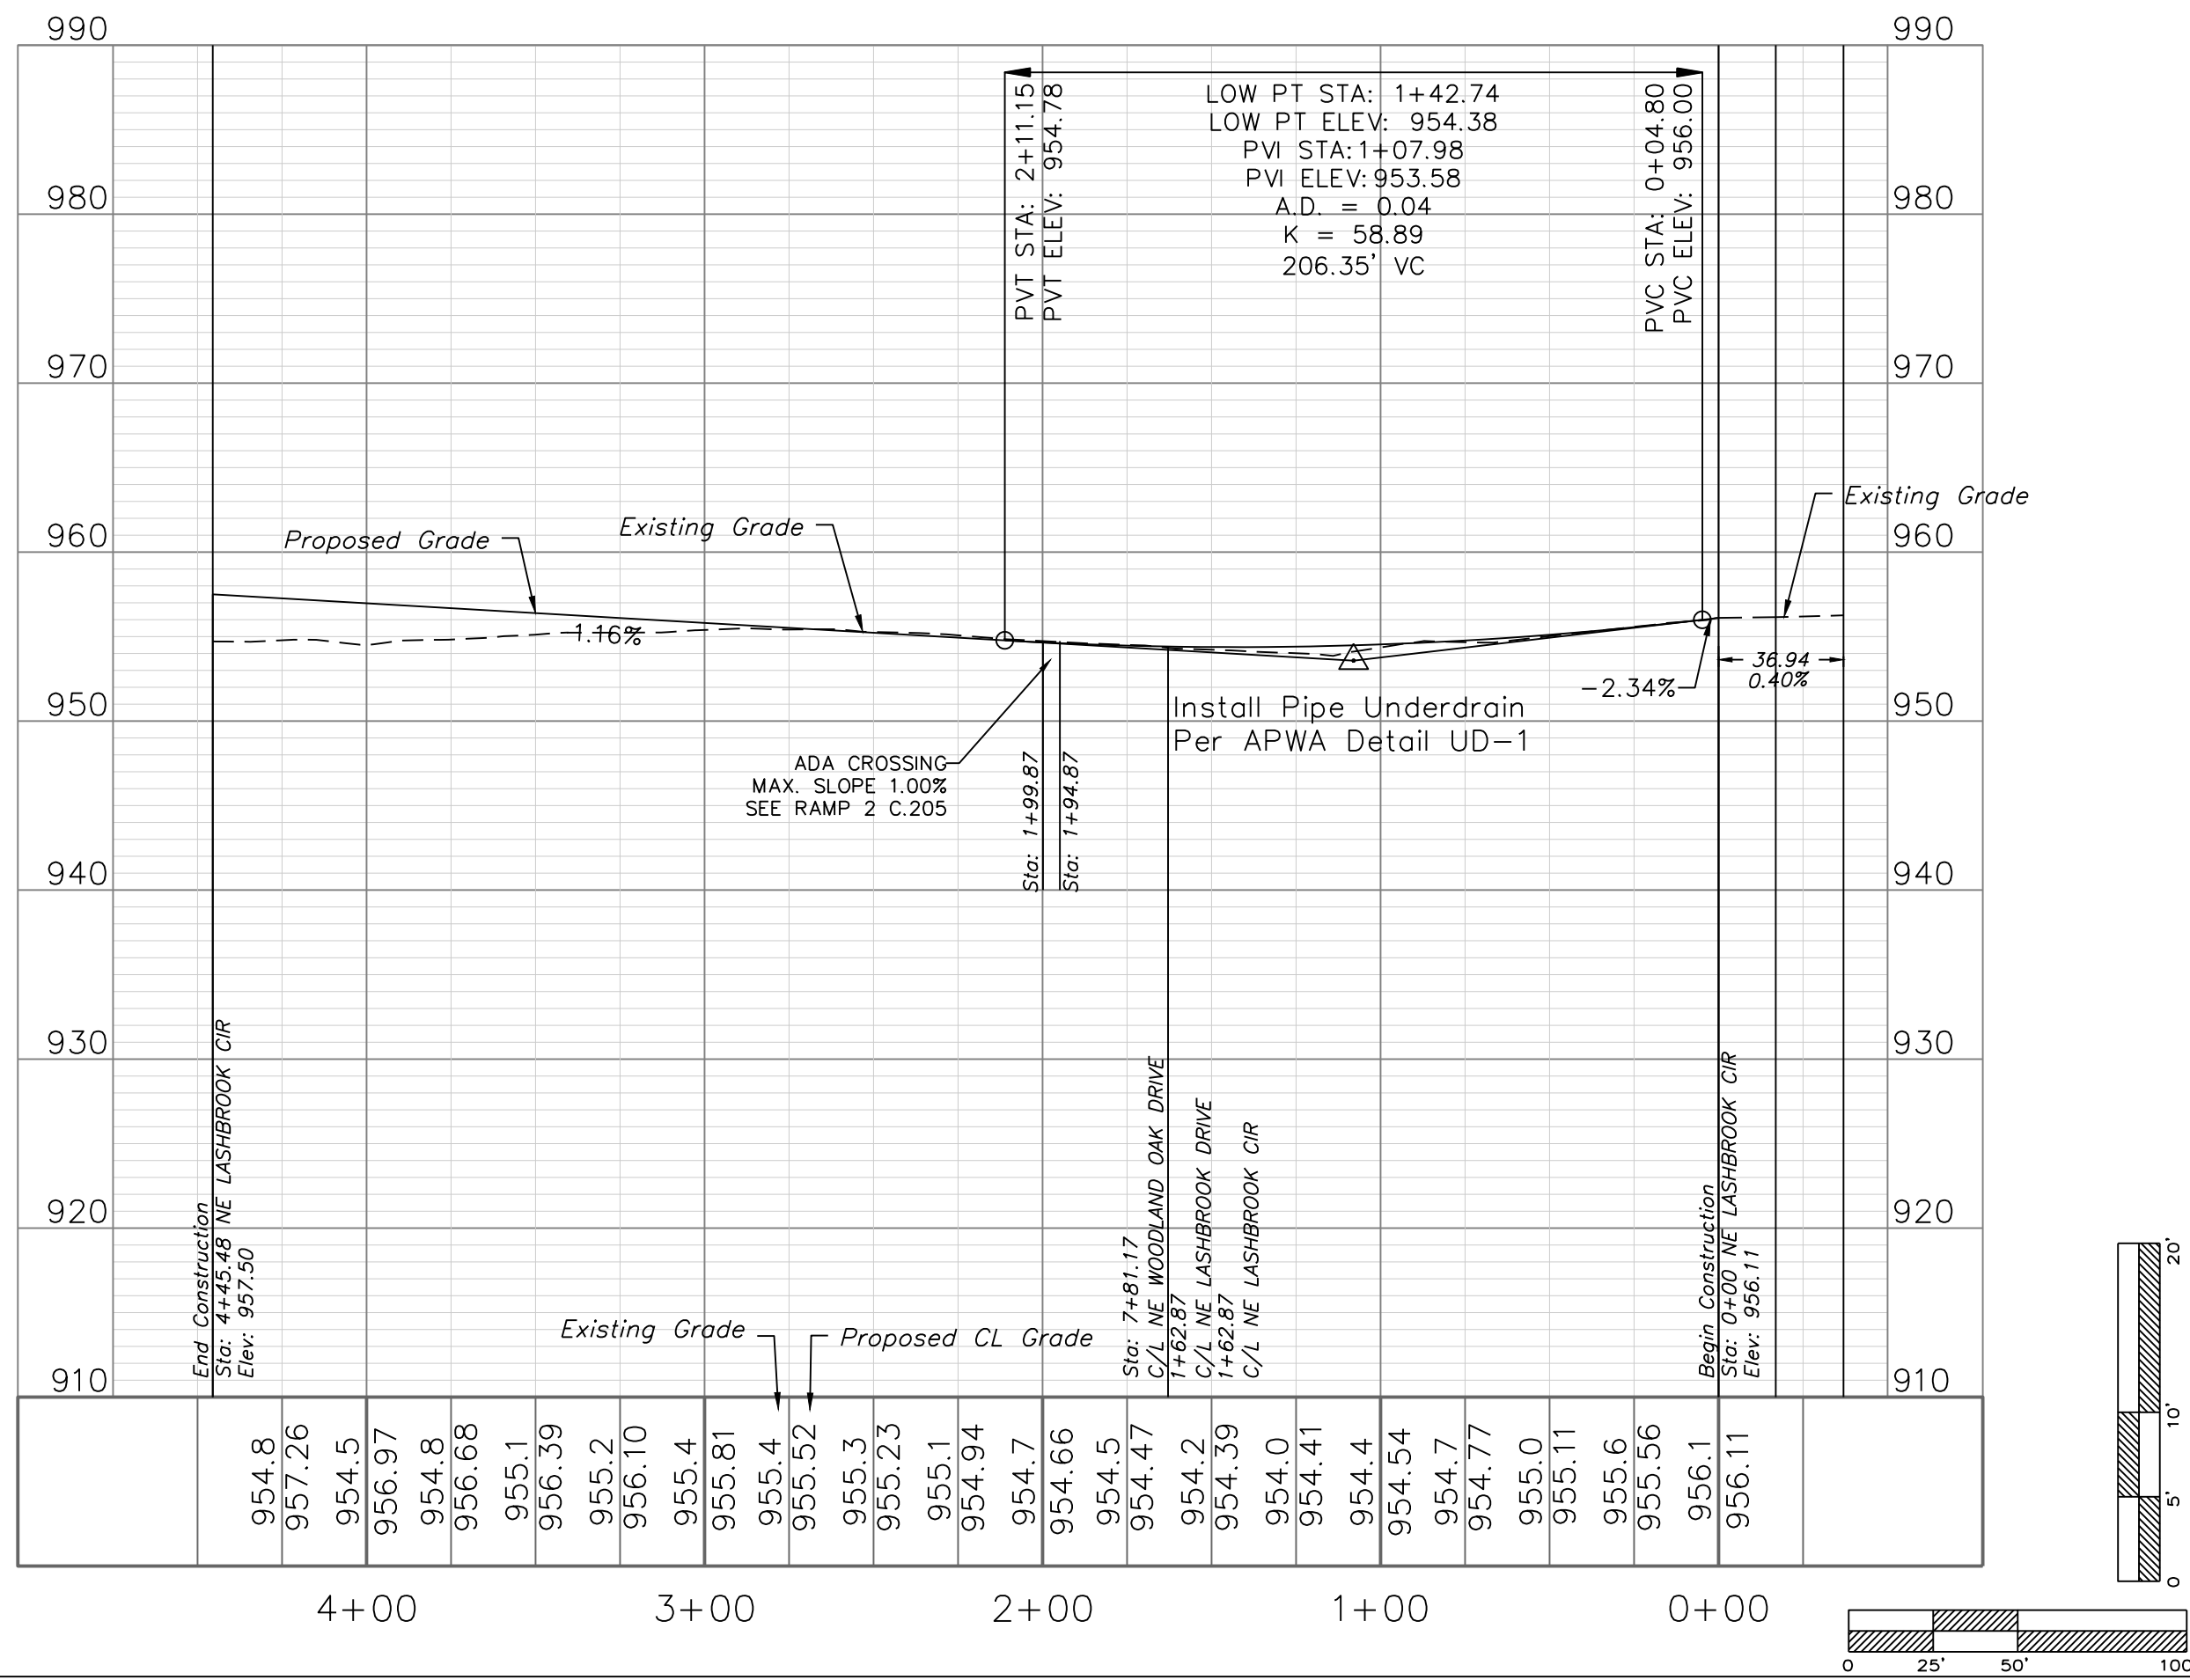

NE CHERRYBARK CT

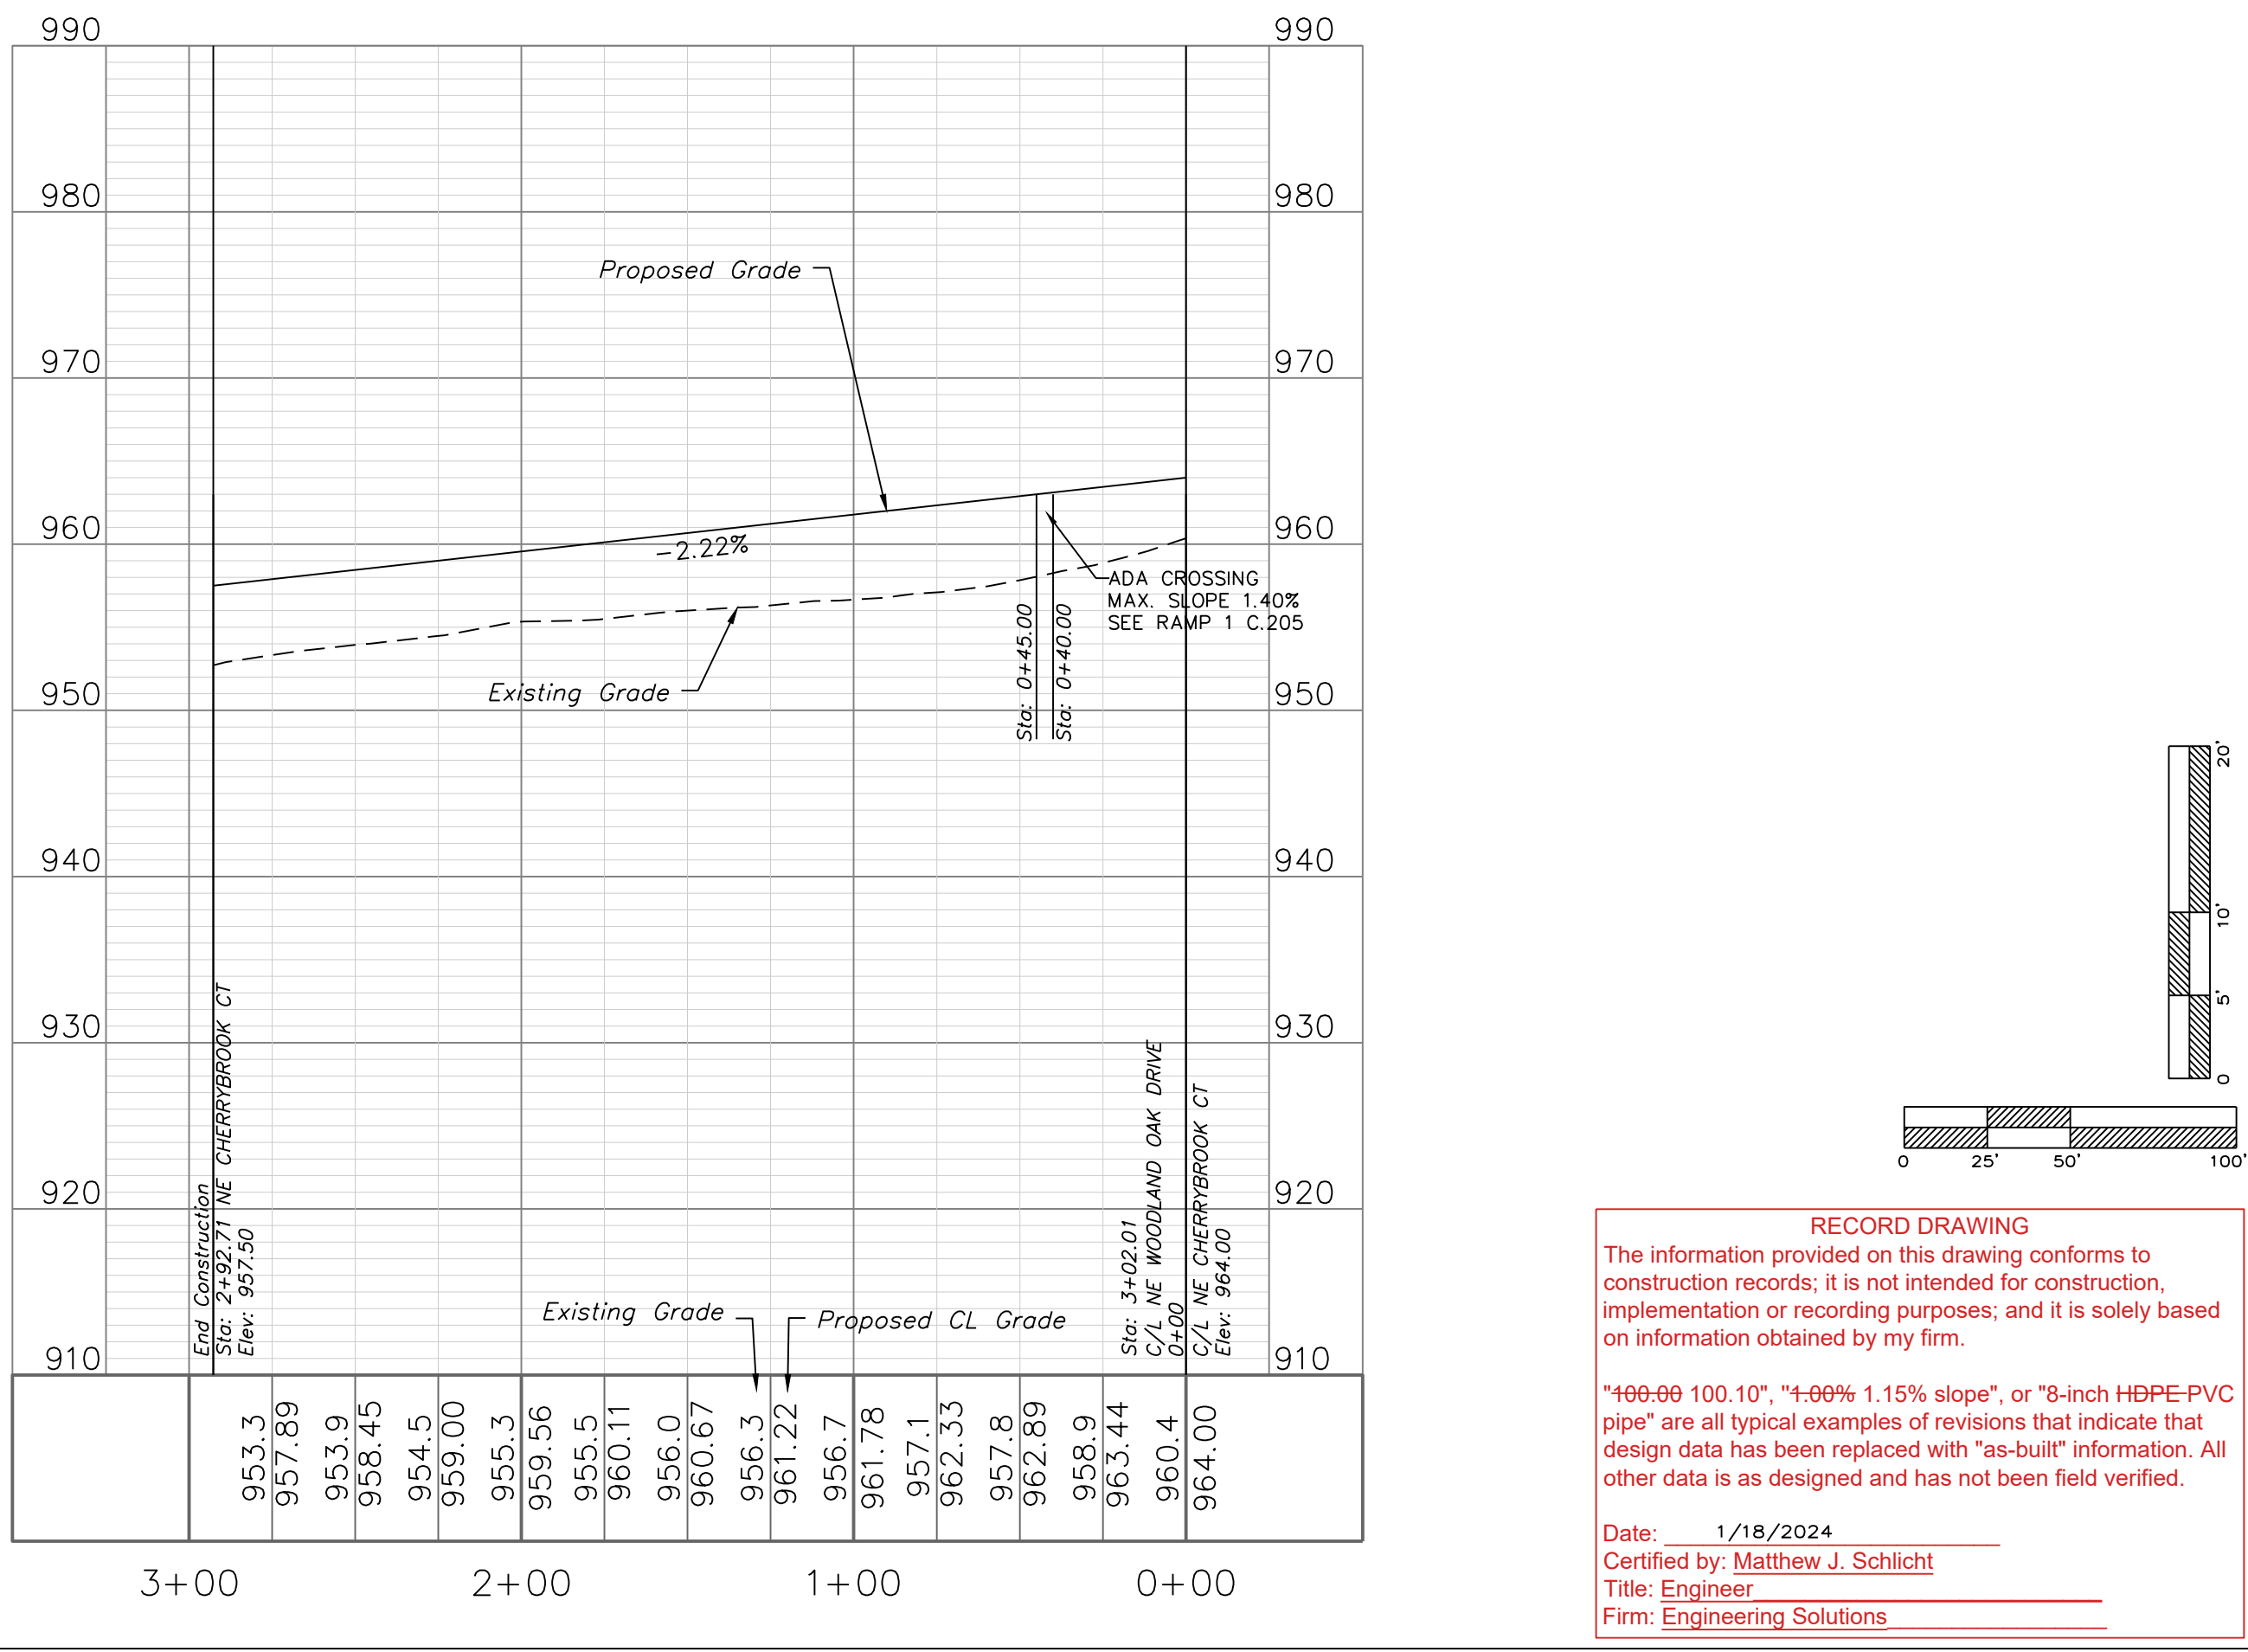


ENGINEERING SOLUTIONS
ENGINEERING & SURVEYING
50 SE 30TH STREET
LEE'S SUMMIT, MO 64082
P: (816) 623-9888 F: (816) 623-9849

Professional Registration
Missouri
Engineering 2005002186-D
Surveying 2005008319-D
Kansas
Engineering E-1685
Surveying LS-218
Oklahoma
Engineering 6284
Nebraska
Engineering CA2821

Part of the Southeast 1/4
Section 27, Township 48 North, Range 31 West
Lee's Summit, Jackson County, Missouri

Project:
WOODLAND OAKS
LSMO
Issue Date:
January 18, 2024

Street Plan and Profile
Construction Plans for:
WOODLAND OAKS
Lots 1 thru 42
Lee's Summit, Jackson County, Missouri

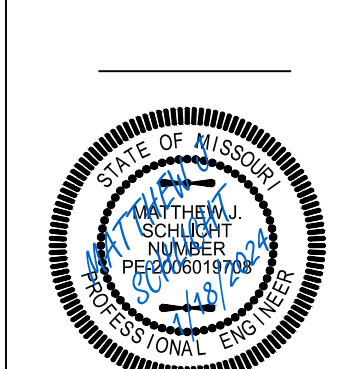


Matthew J. Schlicht
MO PE 2006019708
KS PE 19071
OK PE 25226
NE PE E-14335

REVISIONS
1/18/2024 As-Built


C.204

RECORD DRAWING
The information provided on this drawing conforms to construction records; it is not intended for construction, implementation or recording purposes; and it is solely based on information obtained by my firm.


Date: 1/18/2024
Certified by: Matthew J. Schlicht
Title: Engineer
Firm: Engineering Solutions

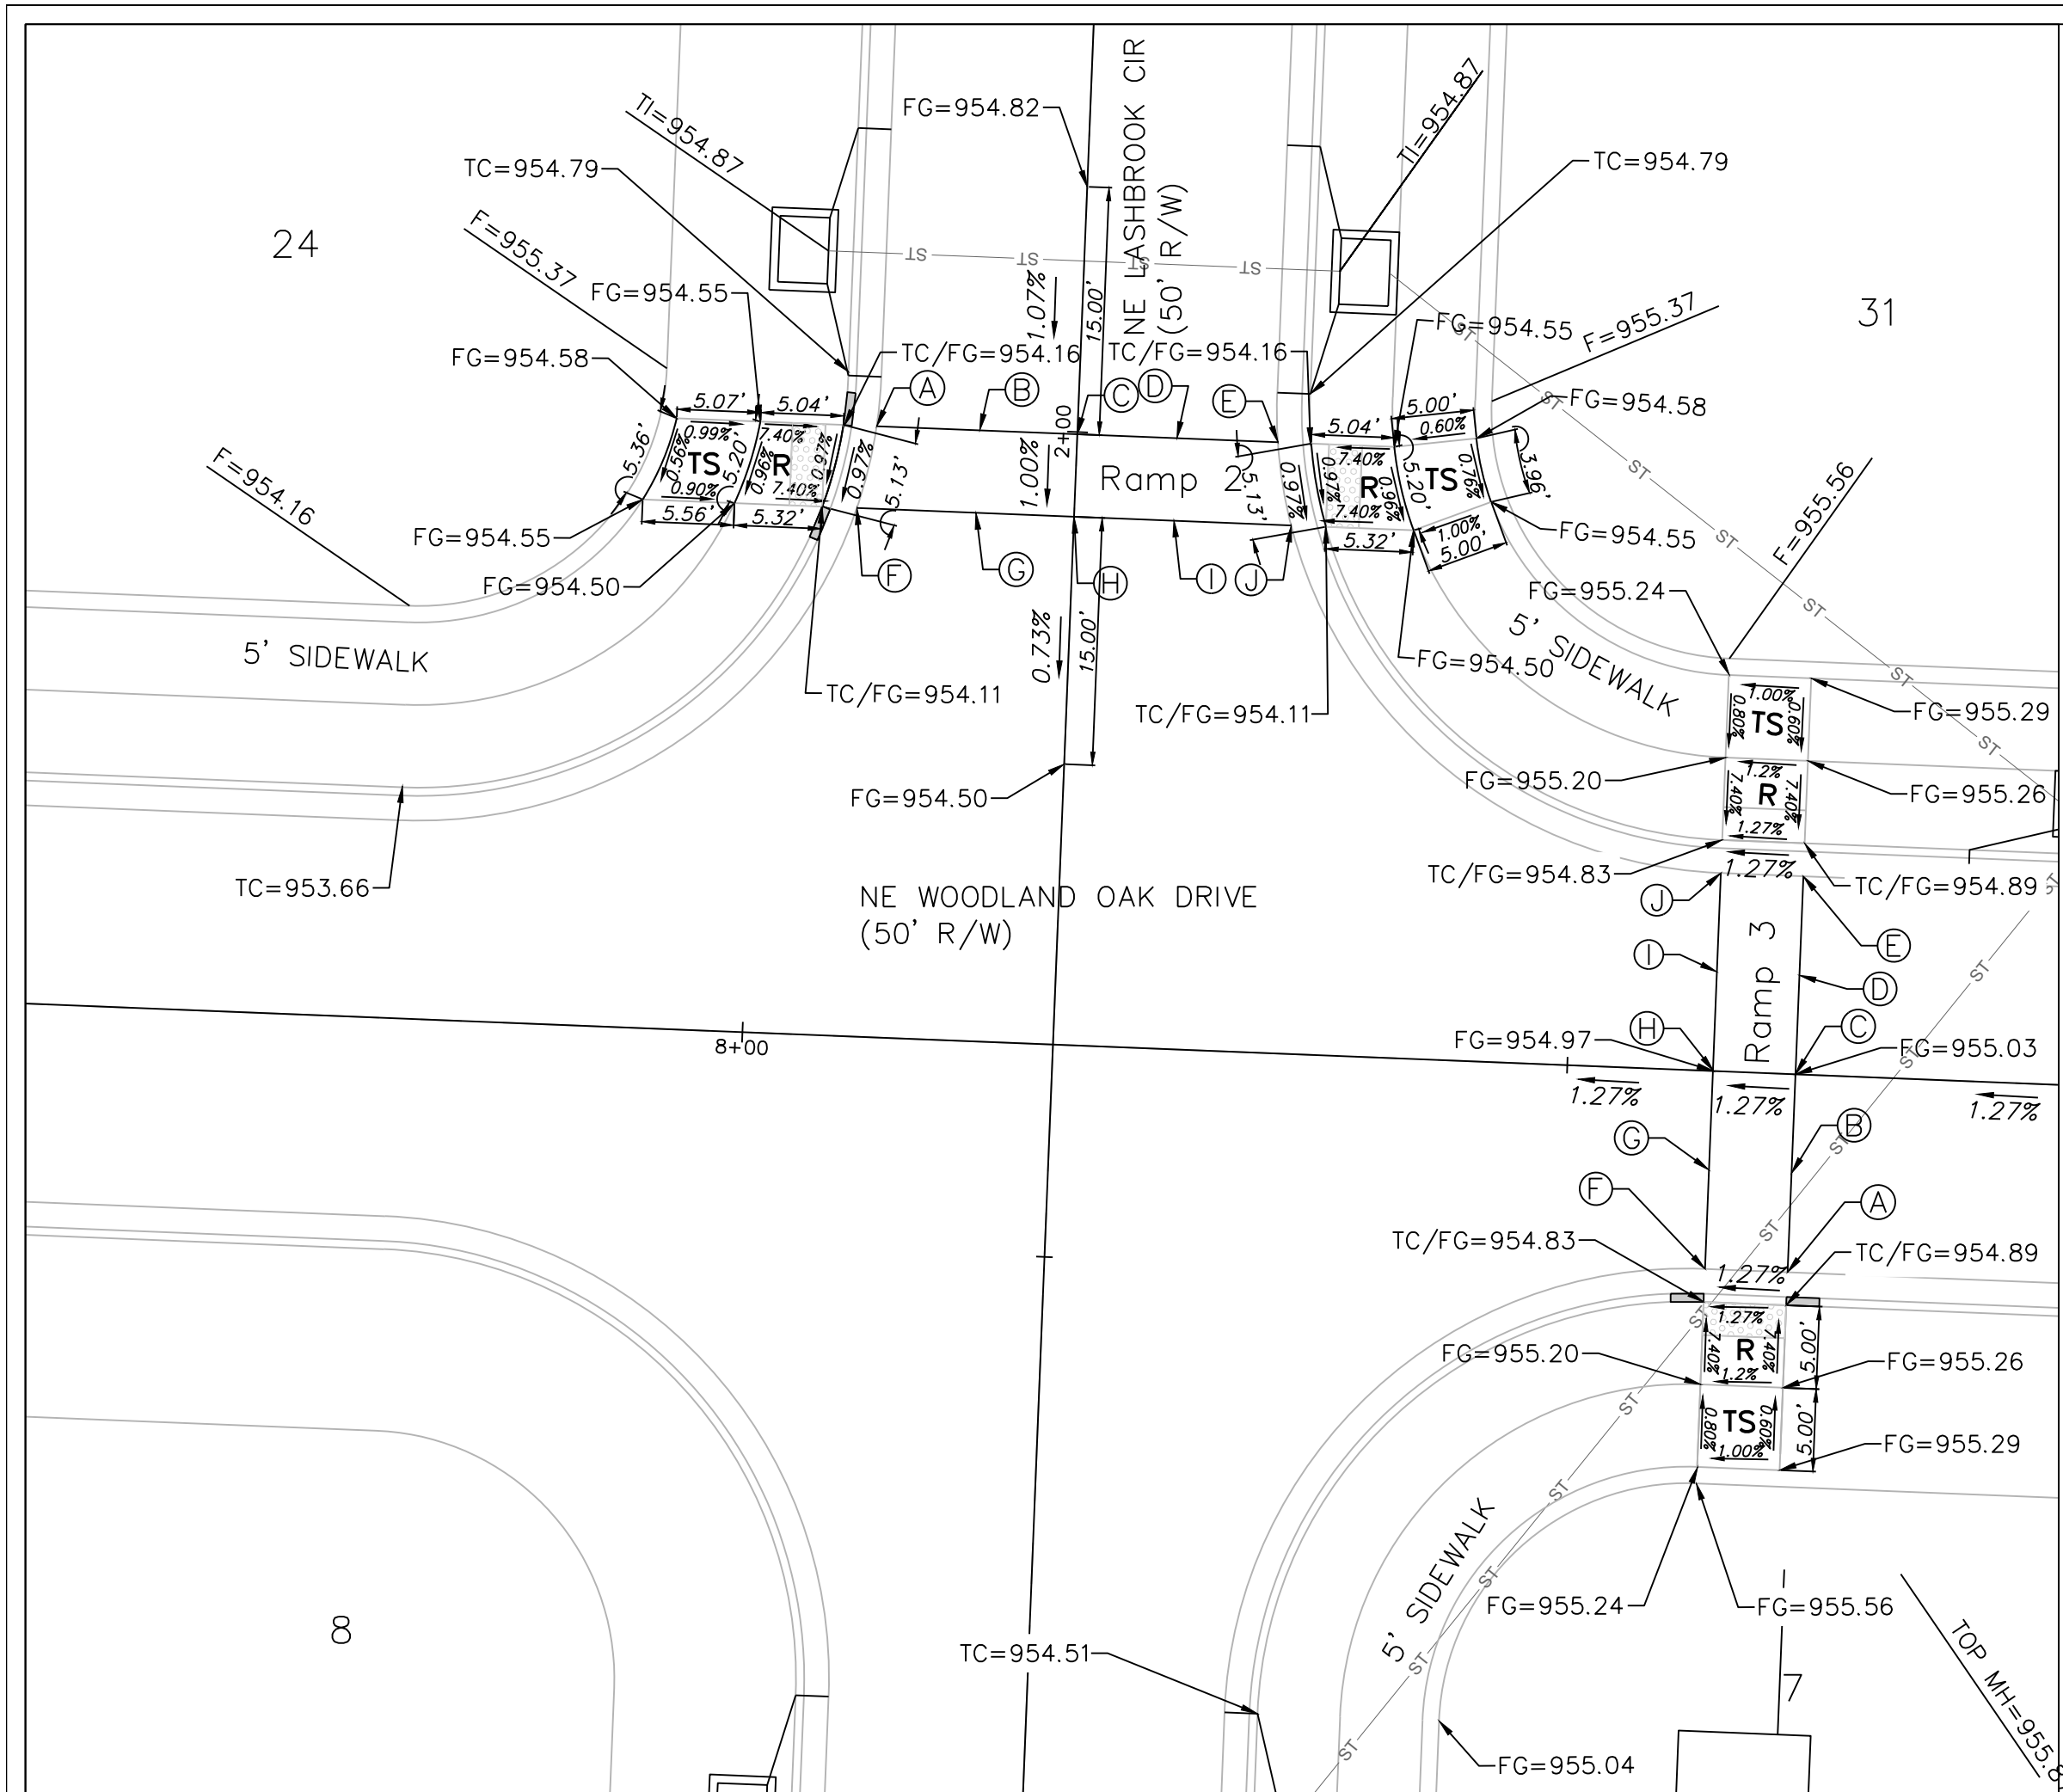


DETAIL 2

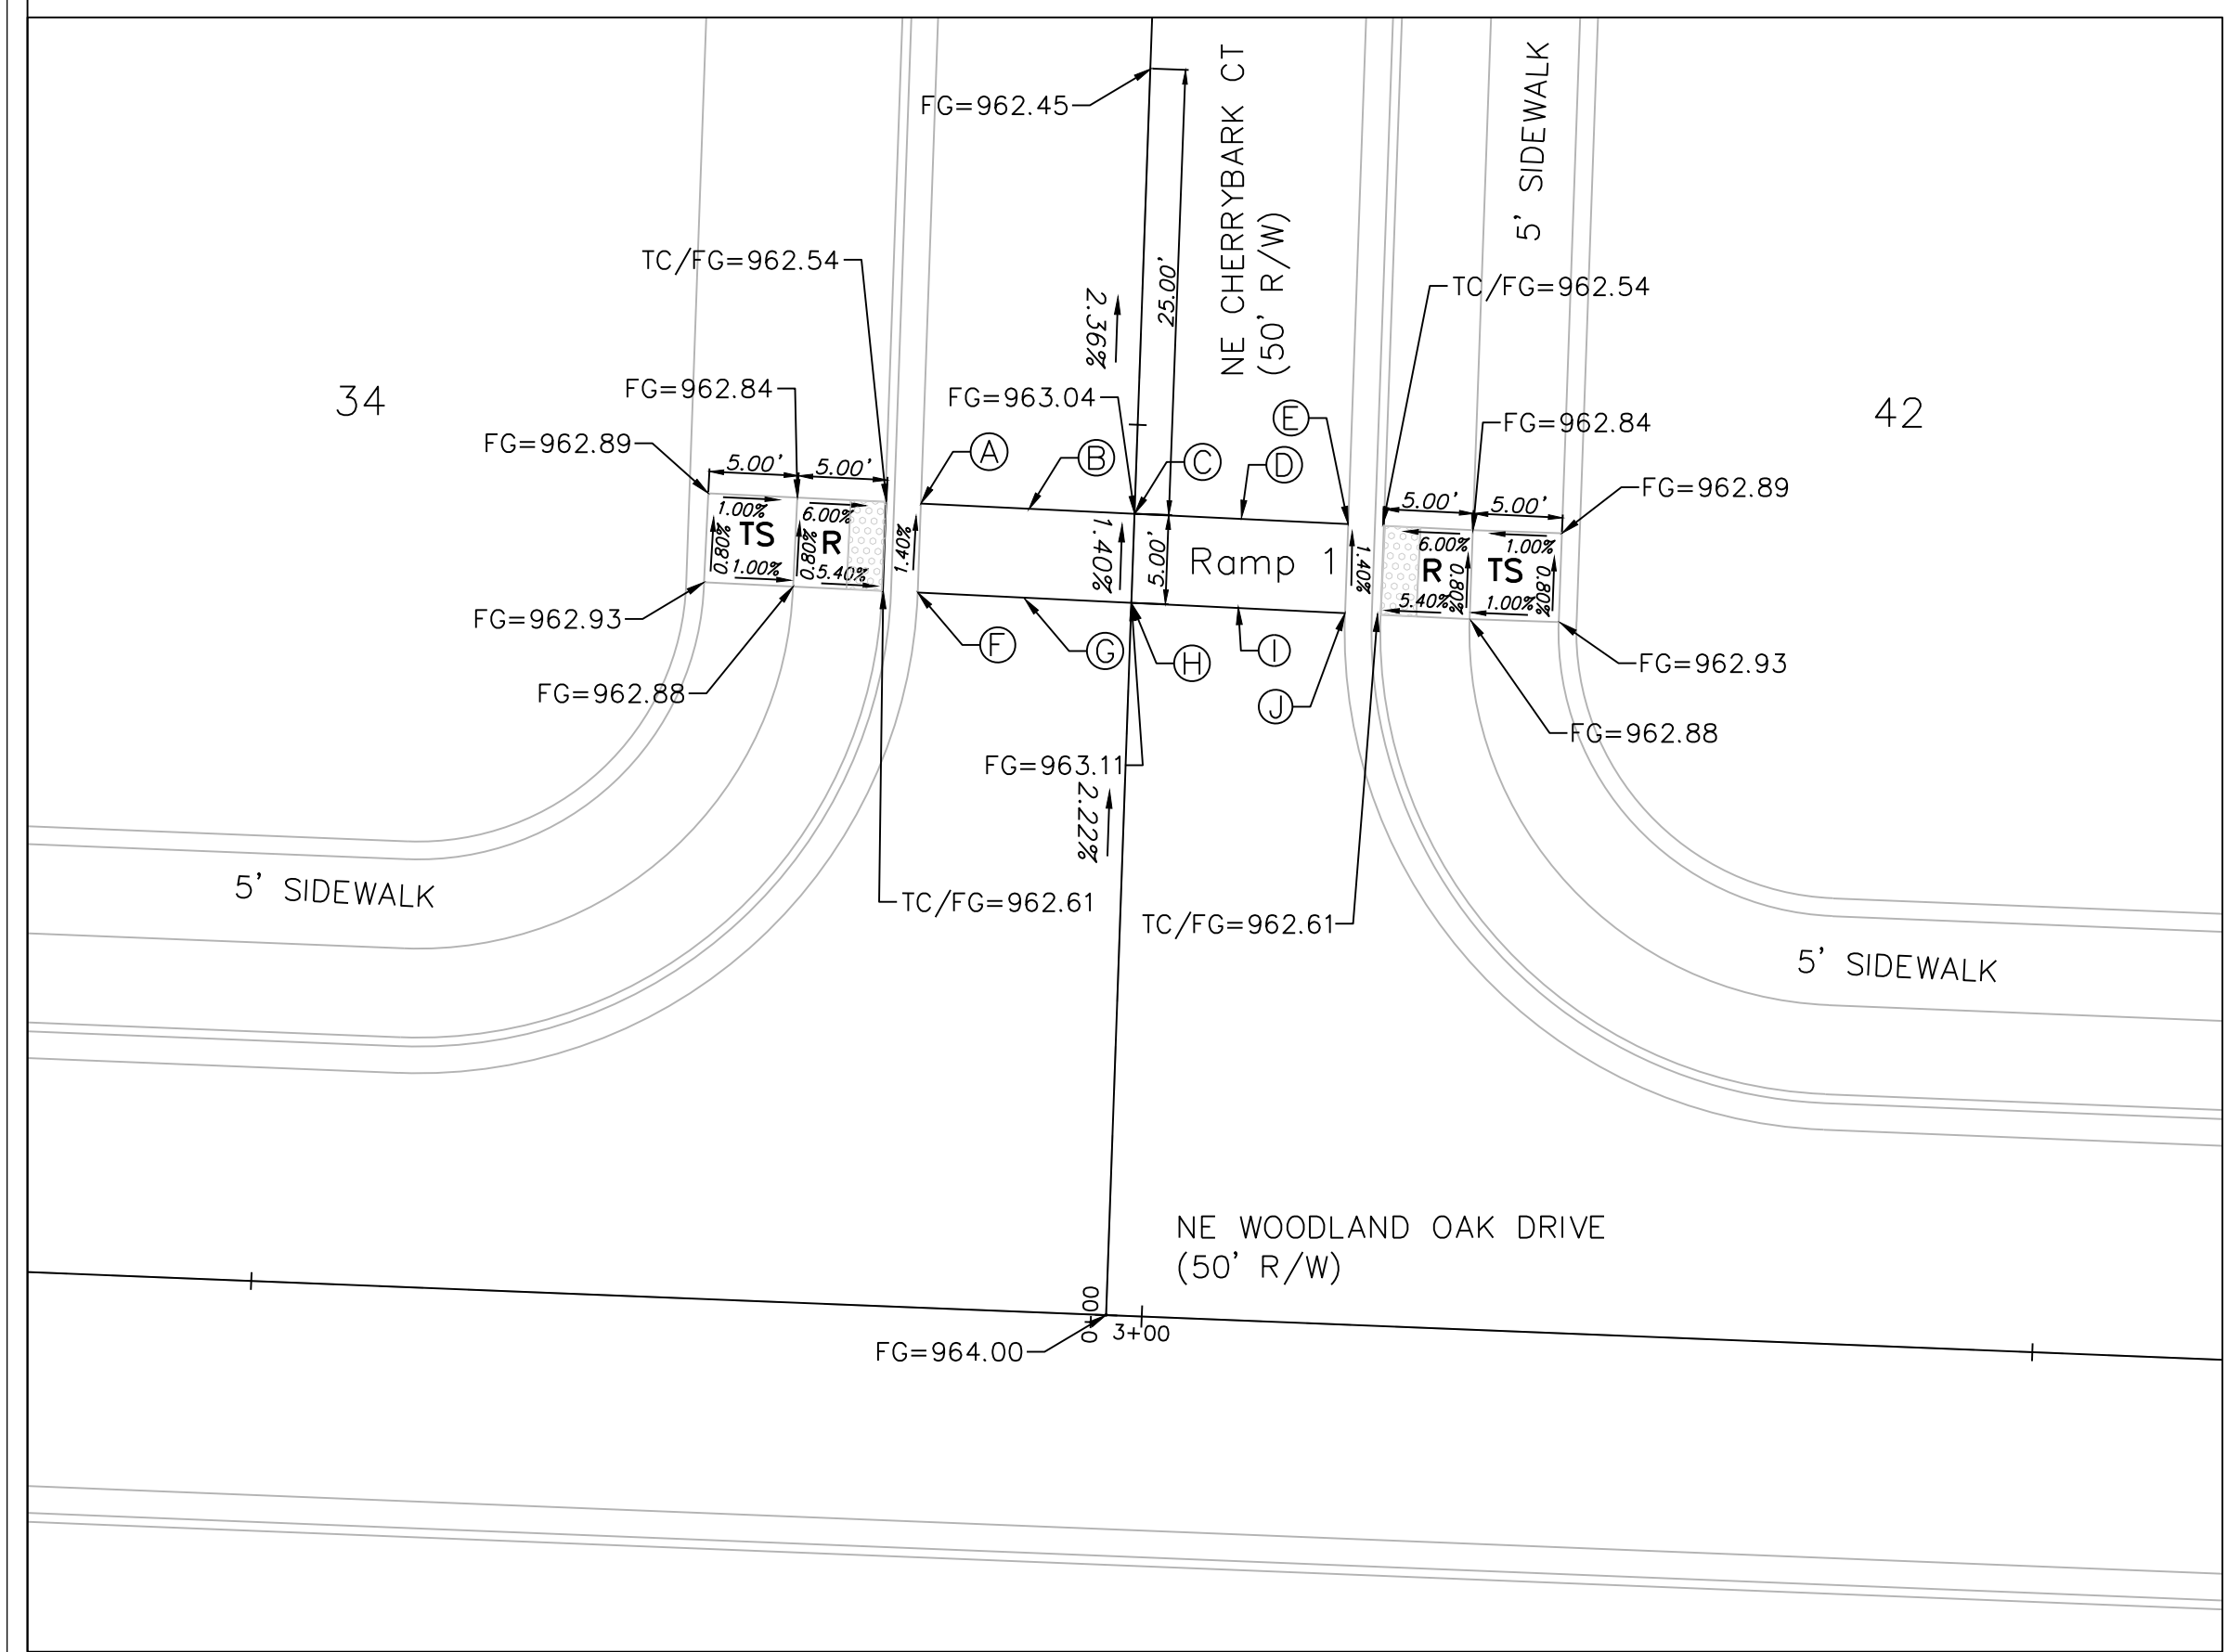


DETAIL 1

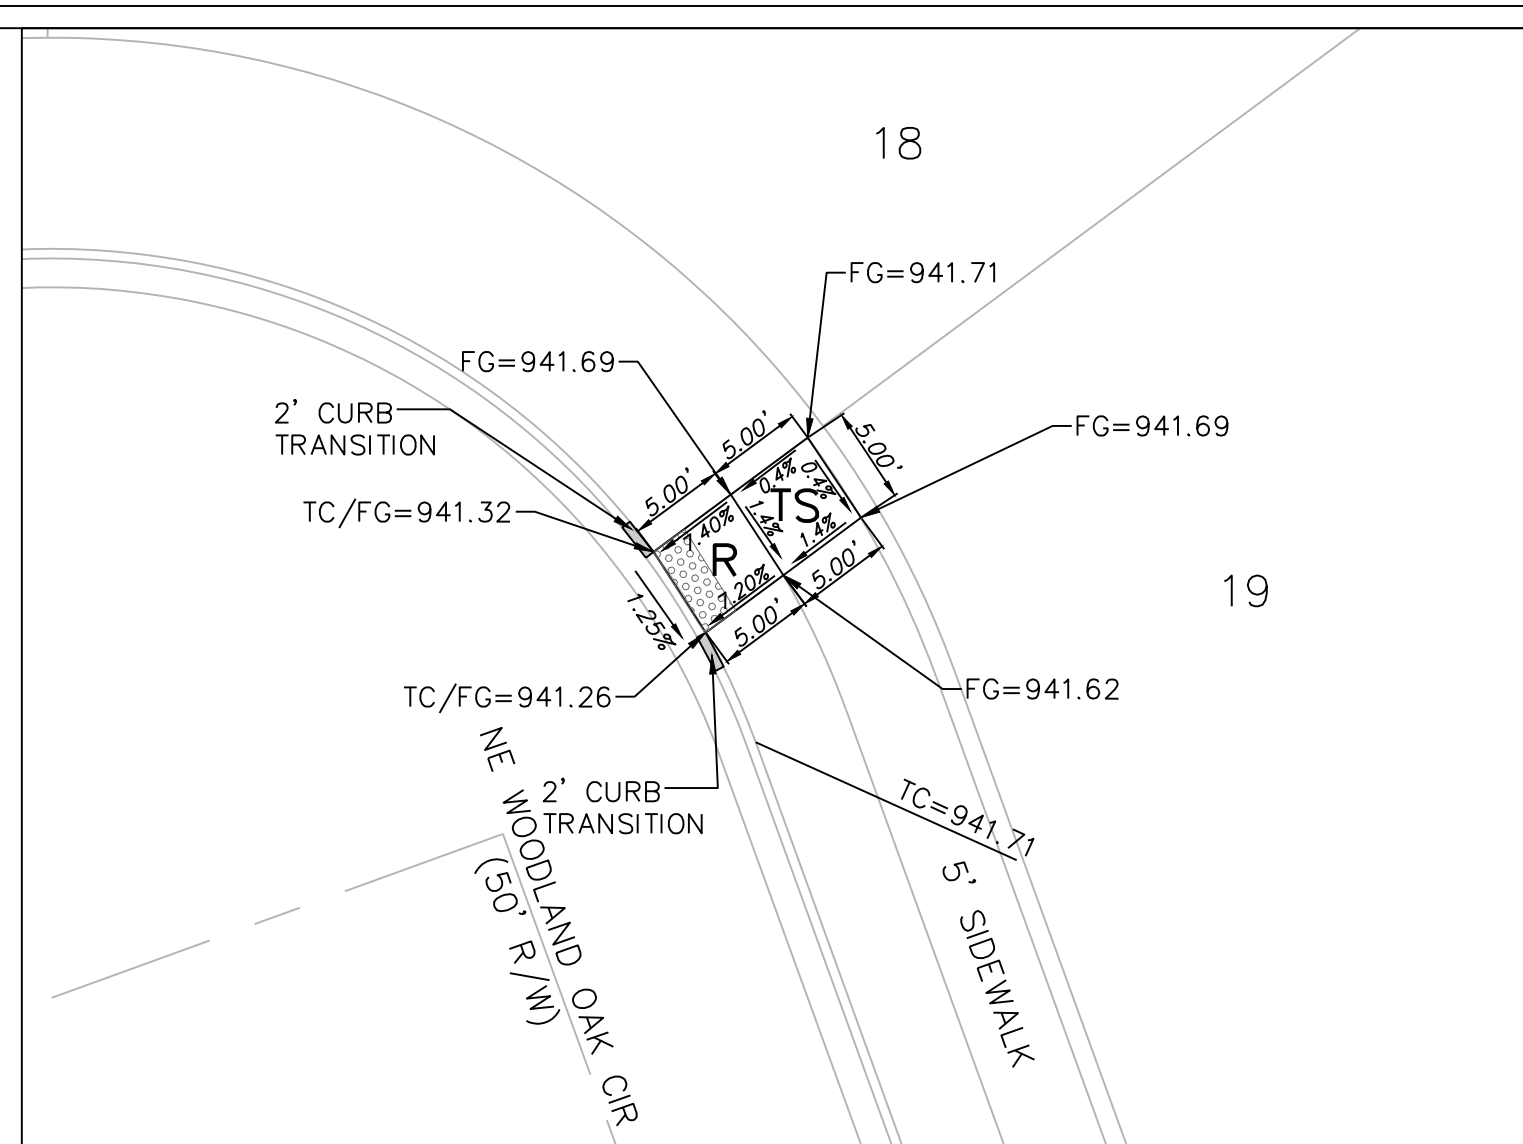

DETAIL 4

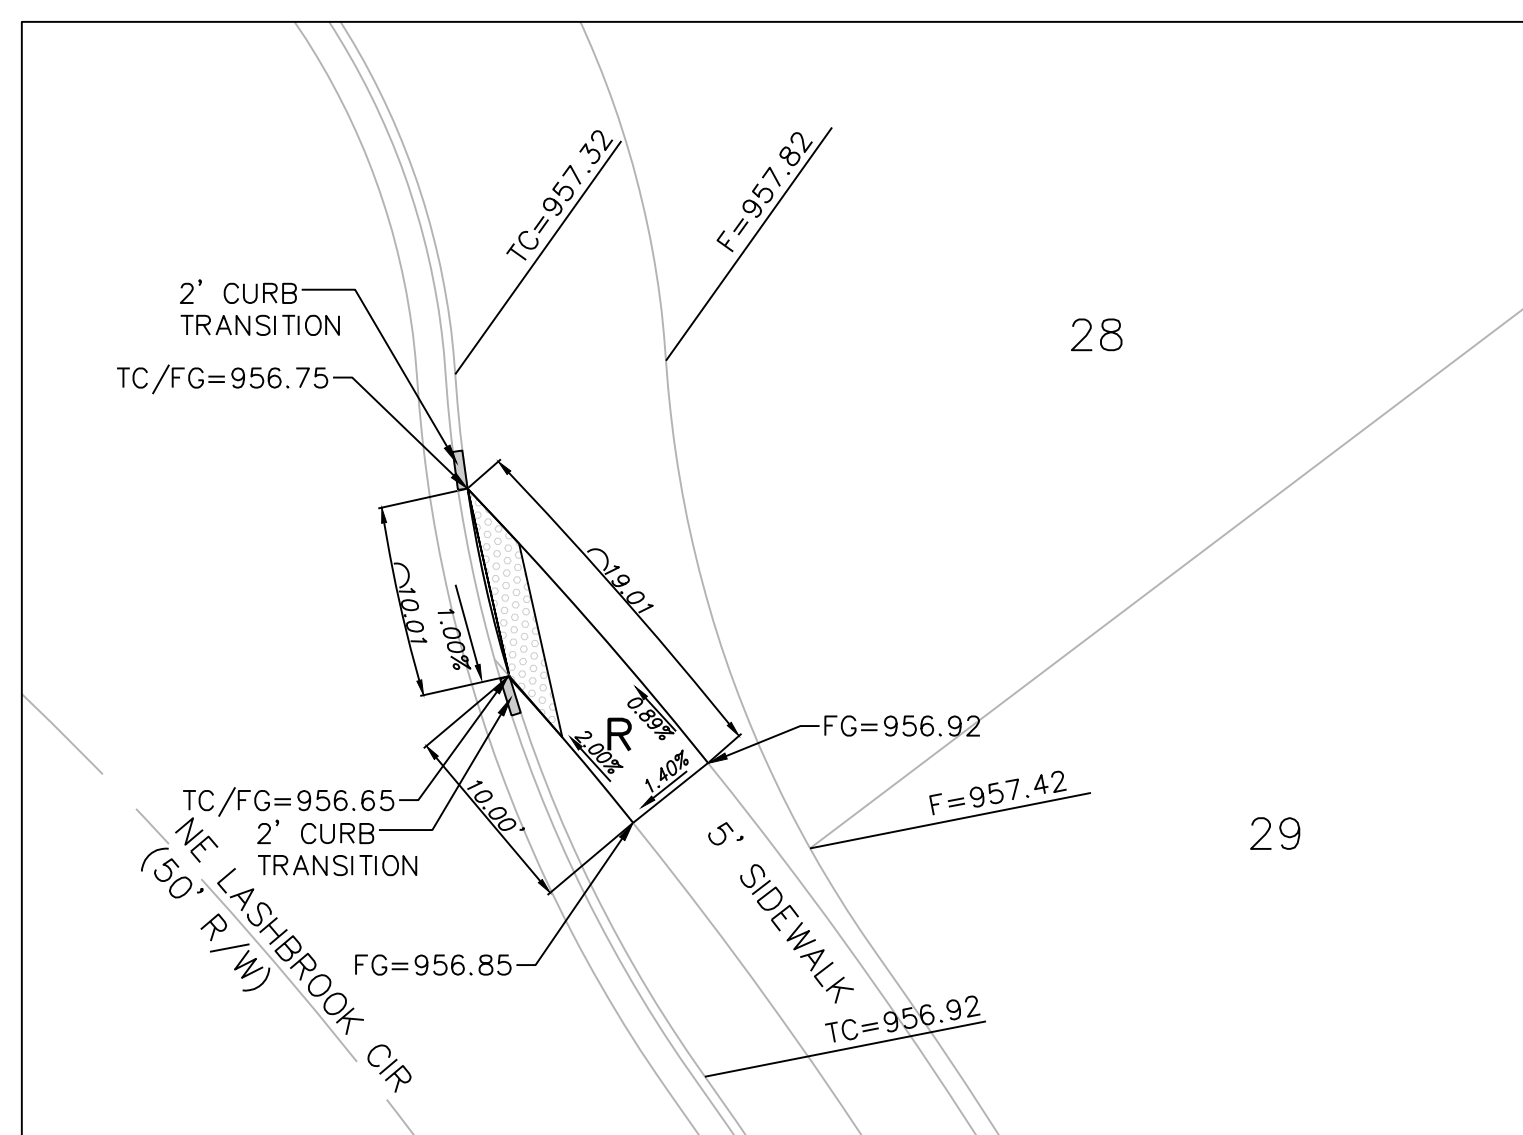


DETAIL 5

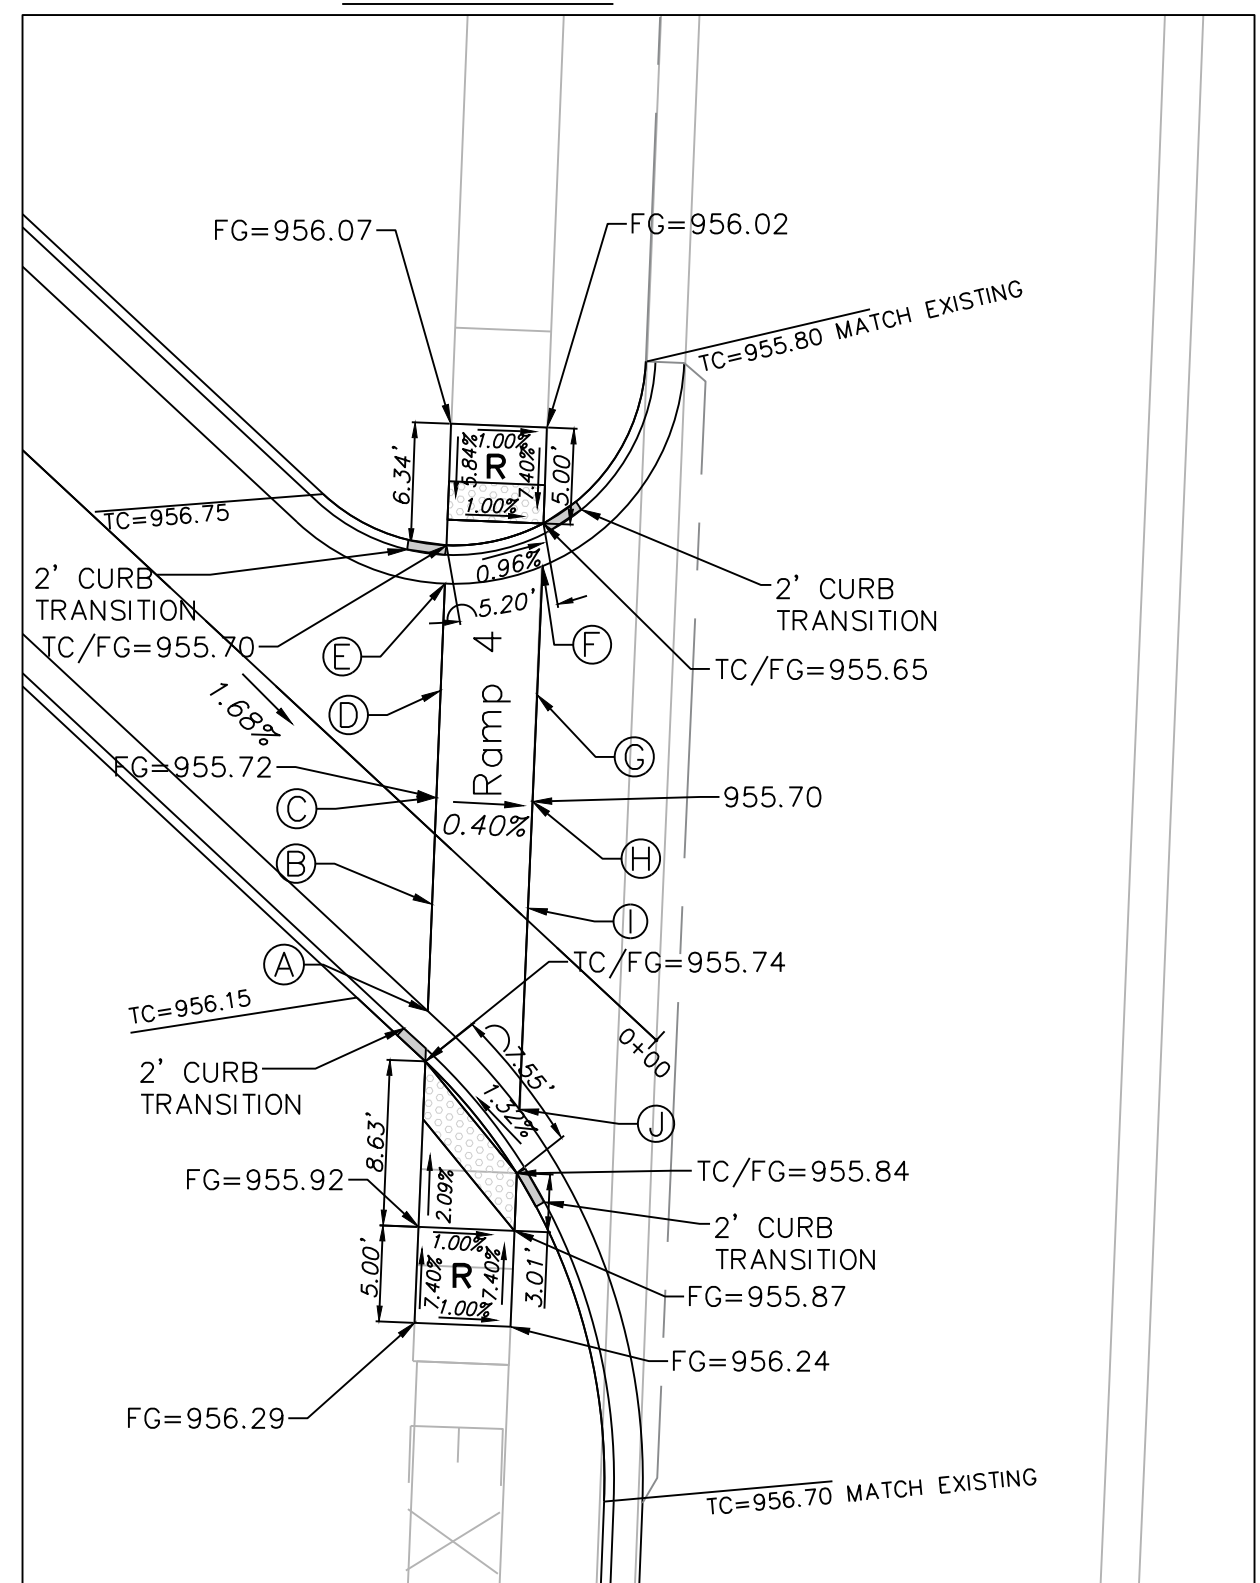


DETAIL 3

Legend:
 EX TC = Existing Top of Curb
 EX FG = Existing Finished Grade
 FG = Finished Grade
 TC = Top of Curb
 TC/FG = Top of Curb/Finished Grade
 Detectable Warning

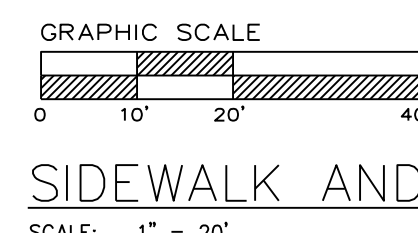


SIDEWALK AND INTERSECTION PLAN

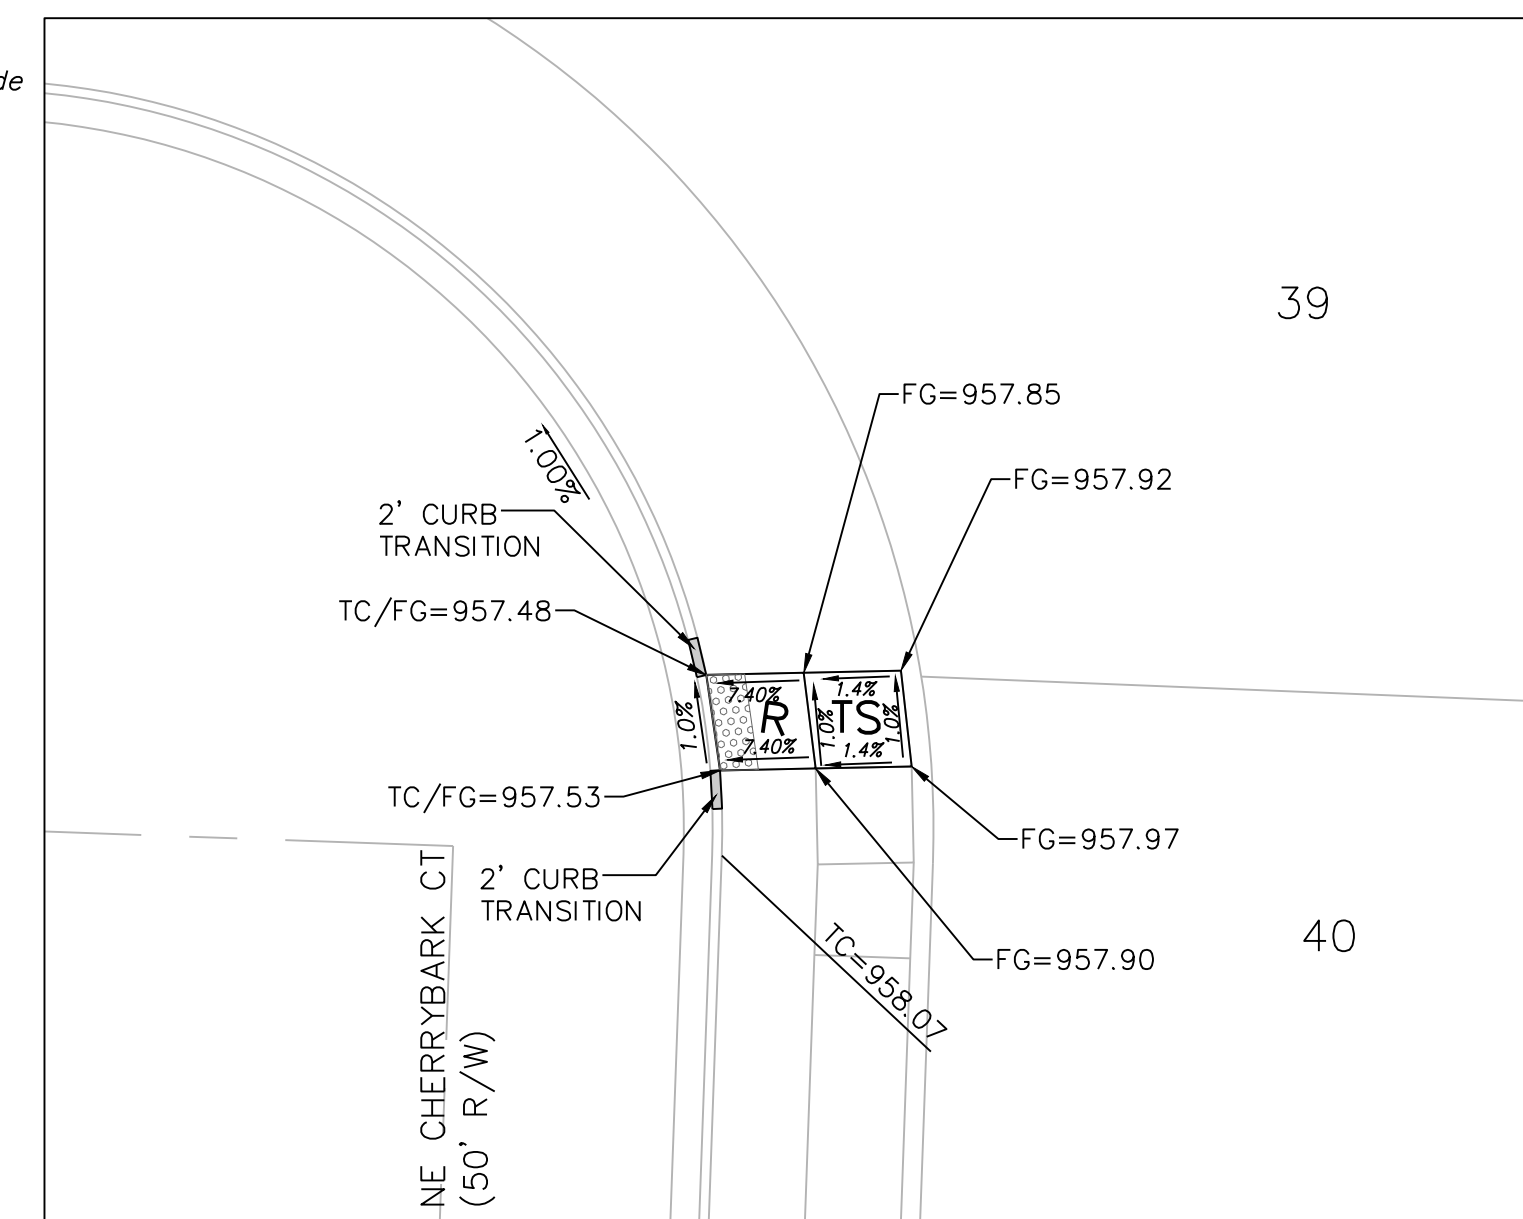

DETAIL 6

SPOT ELEVATION TABLE					
Spot	Ramp 1	Ramp 2	Ramp 3	Ramp 4	Ramp 5
A	962.54	954.16	954.89	955.74	953.65
B	962.92	954.54	954.91	955.73	953.44
C	963.04	954.66	955.03	955.72	953.23
D	962.92	954.54	954.91	955.71	953.11
E	962.54	954.16	954.89	955.70	952.67
F	962.61	954.11	954.83	955.65	952.59
G	962.99	954.49	954.85	955.68	953.05
H	963.11	954.61	954.97	955.70	953.17
I	962.99	954.49	954.85	955.75	953.38
J	962.61	954.11	954.83	955.84	953.58

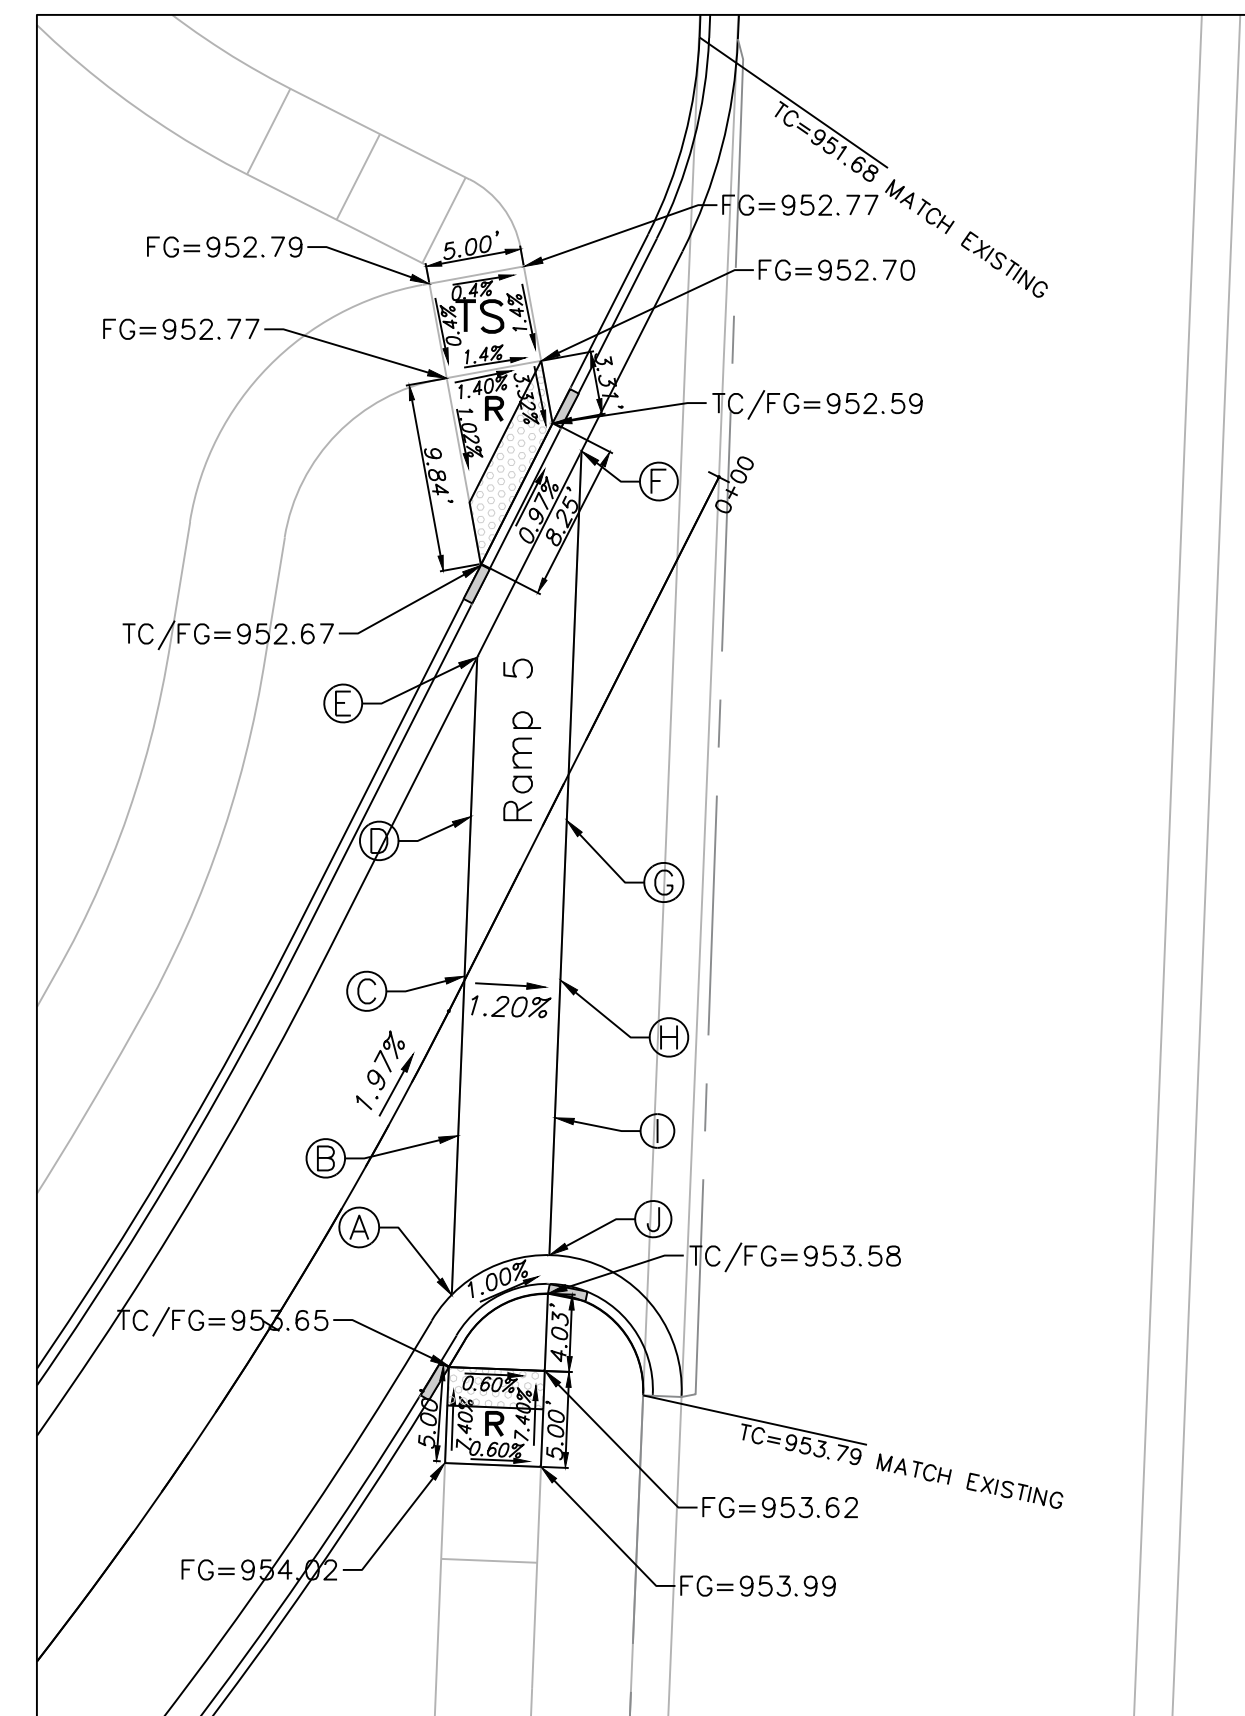

DETAIL 7

RECORD DRAWING
 The information provided on this drawing conforms to construction records; it is not intended for construction, implementation or recording purposes; and it is solely based on information obtained by my firm.
 "400-60 100.10", "4-00% 1.15% slope", or "8-inch HDPE-PVC pipe" are all typical examples of revisions that indicate that design data has been replaced with "as-built" information. All other data is as designed and has not been field verified.
 Date: 1/18/2024
 Certified by: Matthew J. Schlicht
 Title: Engineer
 Firm: Engineering Solutions




Professional Registration
 Missouri
 Engineering 2005002186-D
 Surveying 2005008319-D
 Kansas
 Engineering E-1685
 Surveying LS-218
 Oklahoma
 Engineering 6254
 Nebraska
 Engineering CA2821

Part of the Southeast 1
 Section 27, Township 48 North, Range 31 West
 Lee's Summit, Jackson County, Missouri




Project:
 WOODLAND OAKS
 LS MO
 Issue Date:
 January 18, 2024

Sidewalk and
 Intersection Plans for
 Construction Plans for:
 WOODLAND OAKS
 Lots 1 thru 42
 Lee's Summit, Jackson County, Missouri

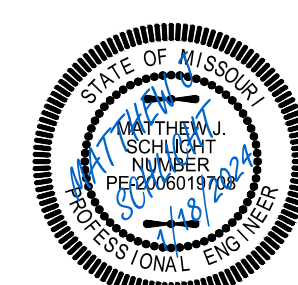

Matthew J. Schlicht
 MO PE 2006019708
 KS PE 19071
 OK PE 25226
 NE PE E-14335

REVISIONS
 1/18/2024 As-Built

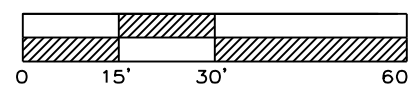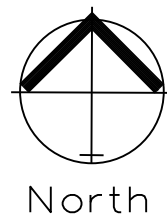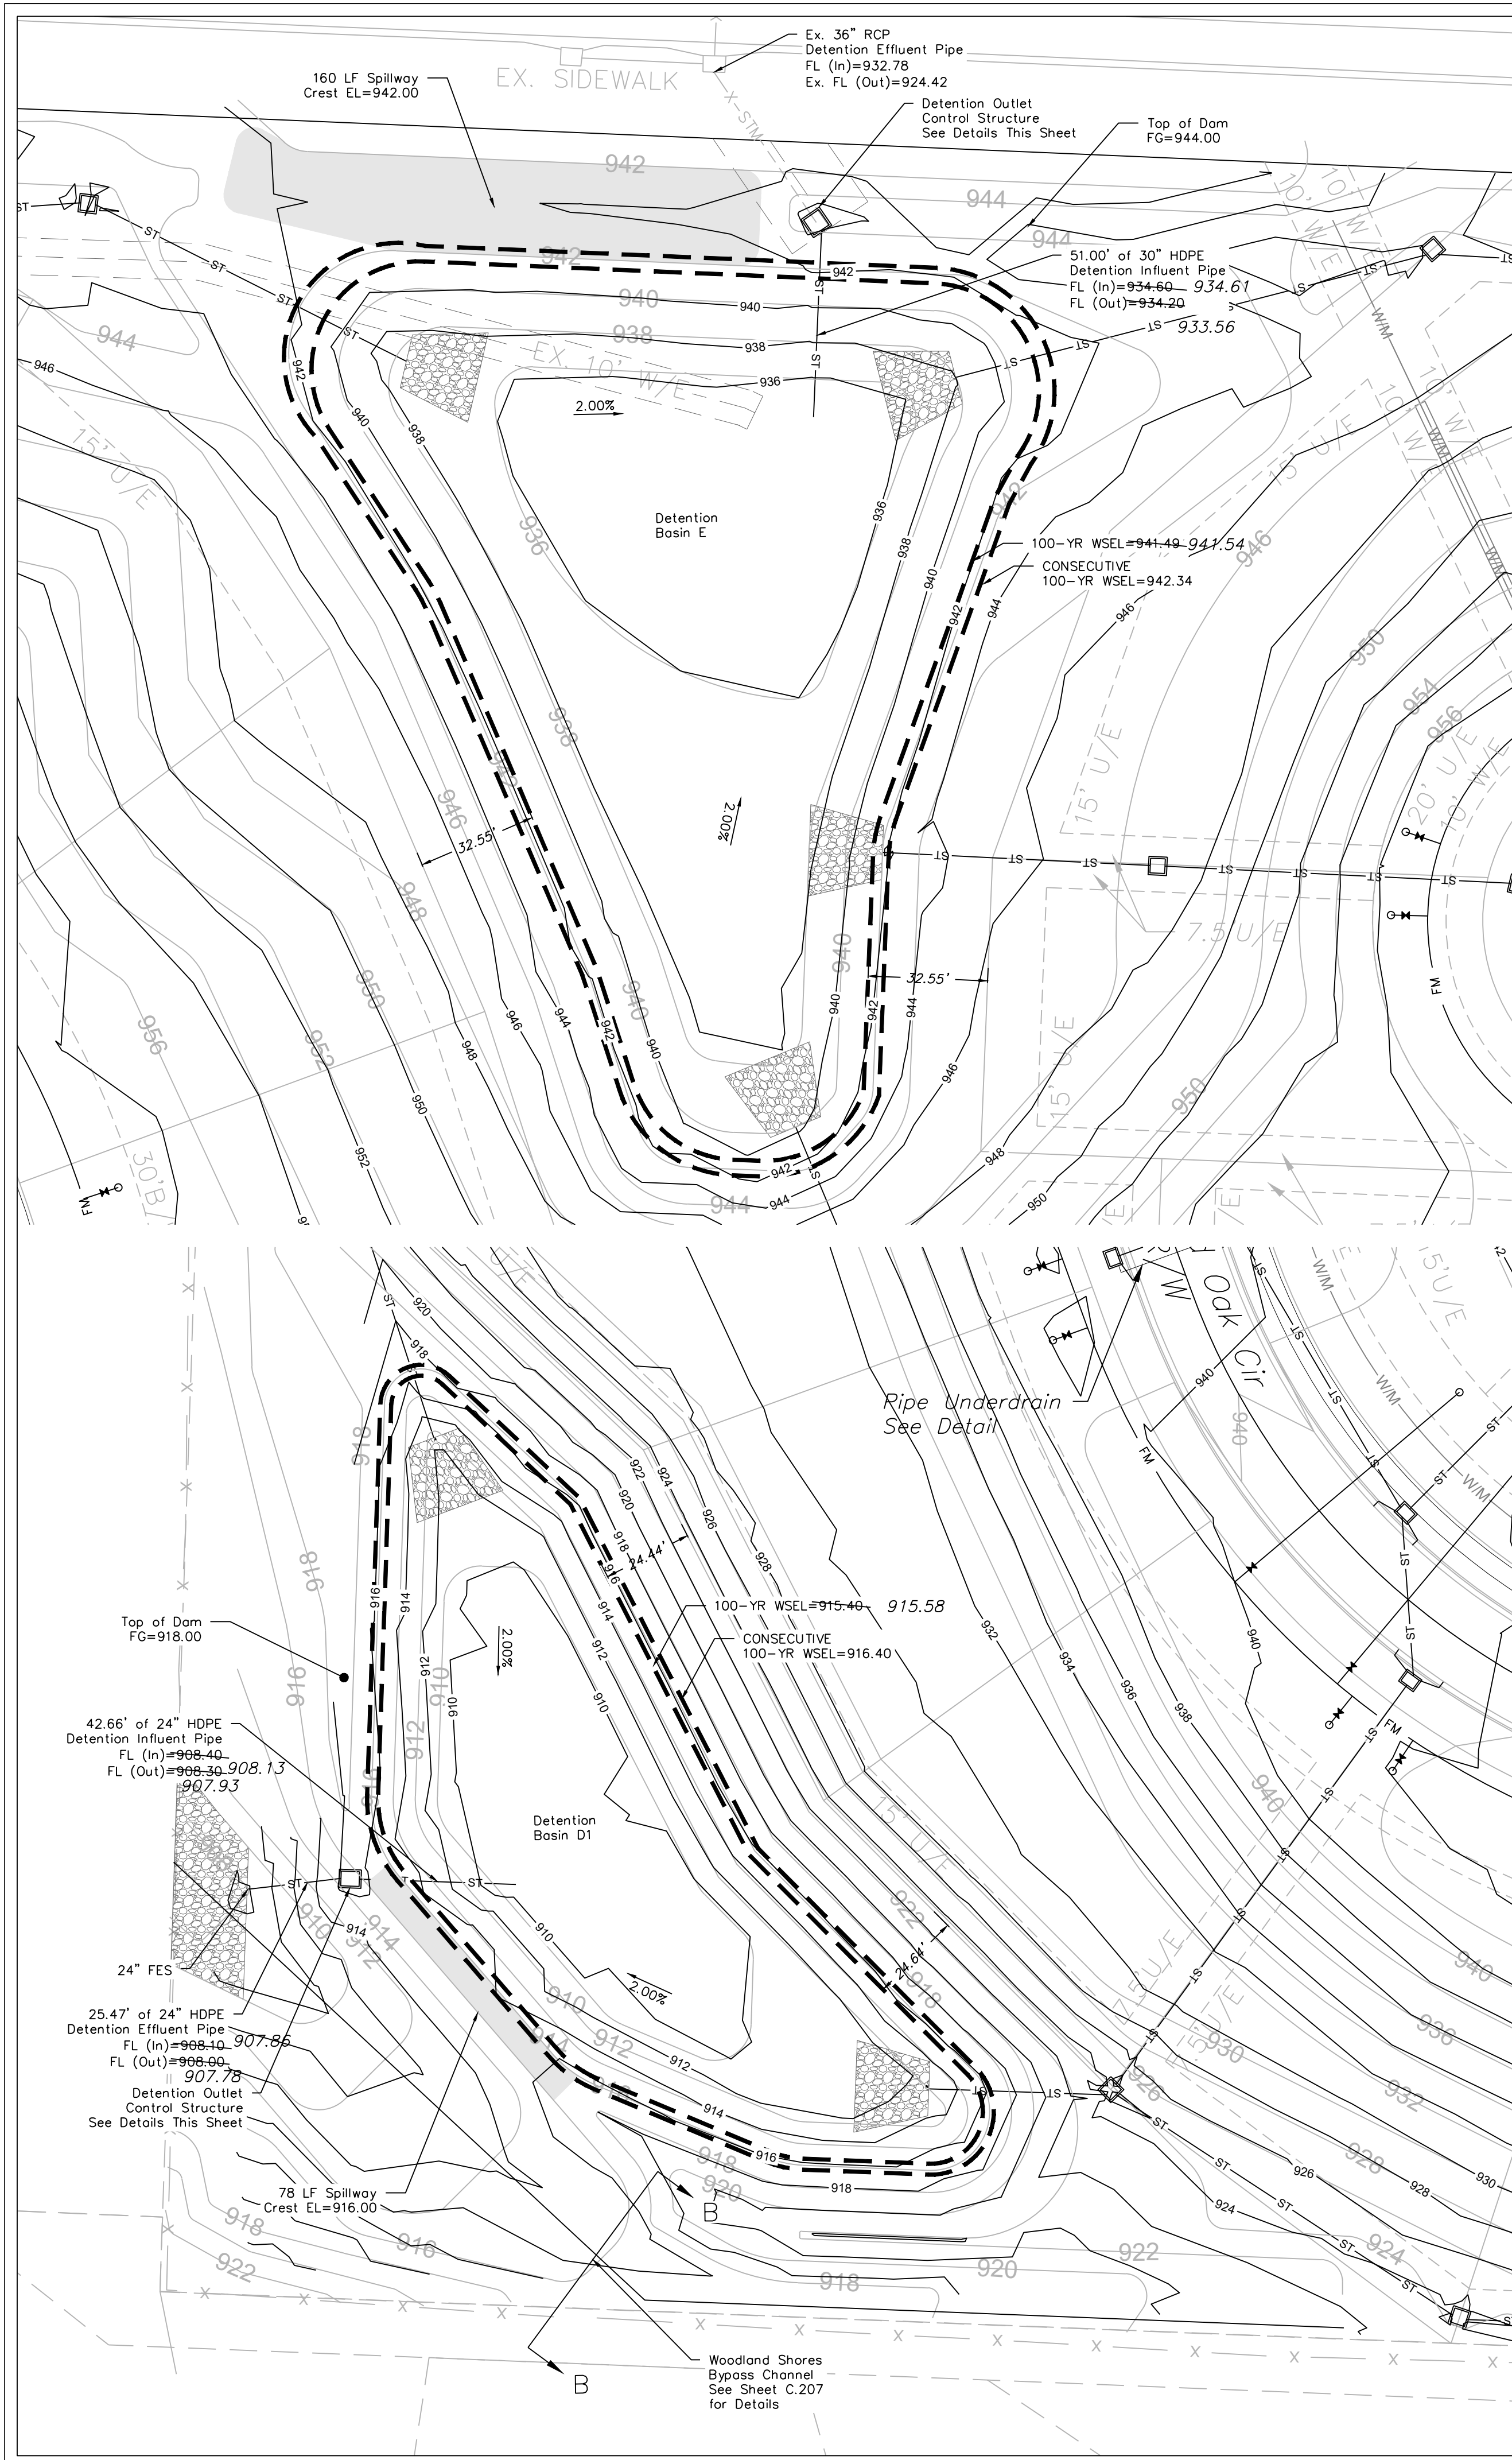

DETENTION BASIN PLAN

SCALE: 1" = 30'

NOTES:

- BOTH BASINS SHALL BE CONSTRUCTED WITH THE EROSION AND SEDIMENT CONTROL MEASURES.
- AN AS-BUILT DETENTION BASIN PLAN SHALL BE SUBMITTED AND ACCEPTED PRIOR TO ISSUANCE OF A CERTIFICATE OF SUBSTANTIAL COMPLETION, WITH AS-BUILT VERSUS PROPOSED STORAGE.



Structure
Top ~~944.00~~ 944.06

Top Pond EL 944.00'
Maximum Storage ~~206,503~~ c.f.
198,341

100 Year WSE
~~941.49~~ 941.54

SECTION VIEW - BASIN E

N.T.S.

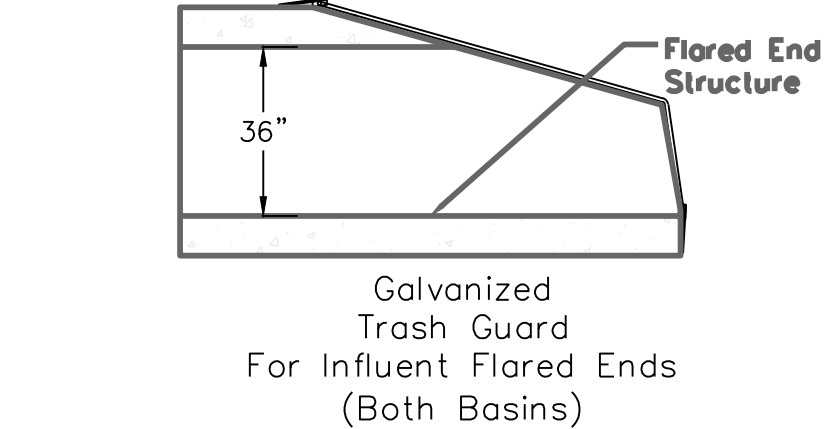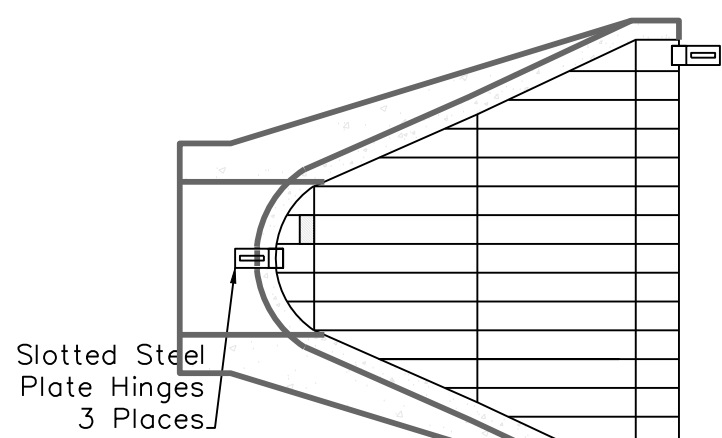





Structure
Top ~~916.00~~ 916.10

Top Pond EL 918.00'
Maximum Storage ~~118,309~~ c.f.
110,033

100 Year WSE
~~915.40~~ 915.58





SECTION VIEW - BASIN D1

N.T.S.

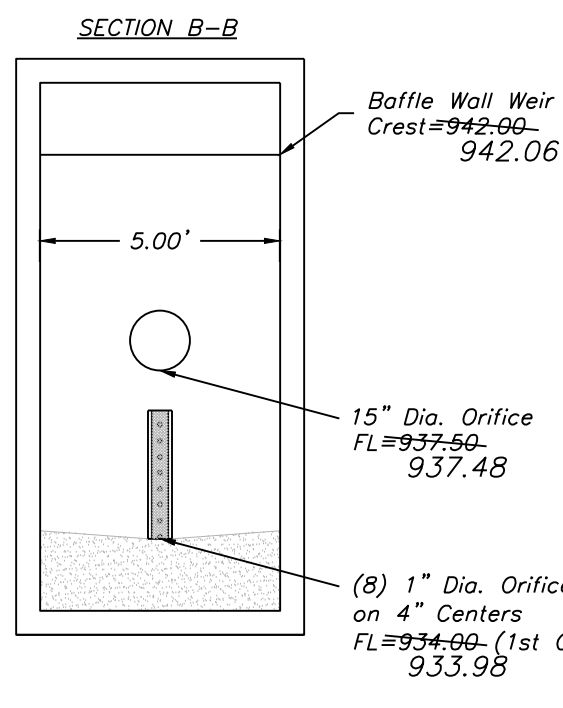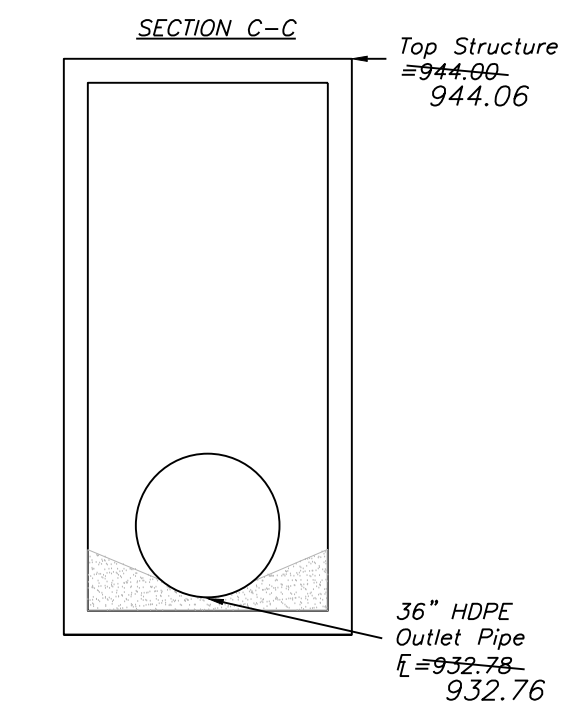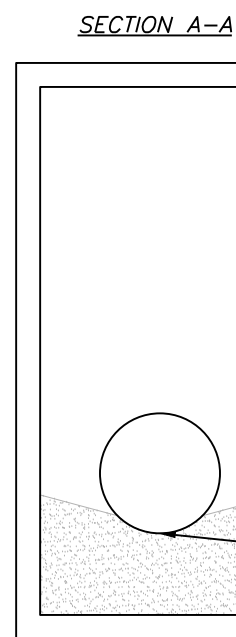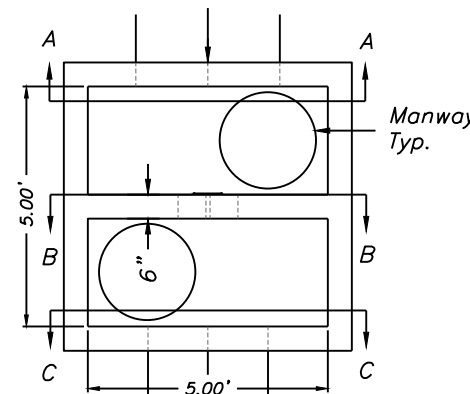

CONTROL STRUCTURE - BASIN E

1/4" = 1'-0"

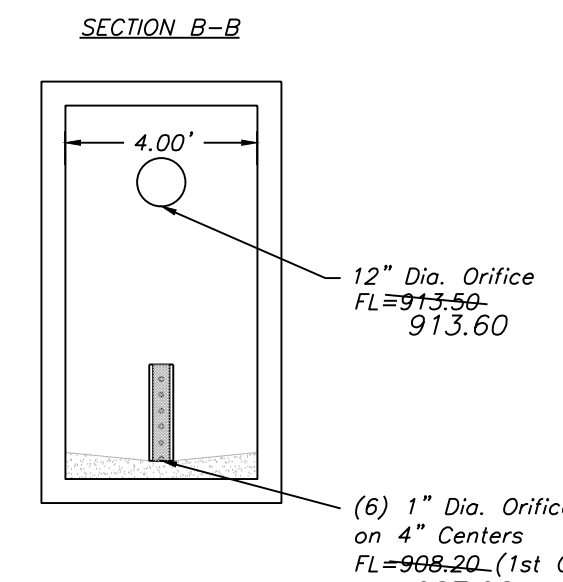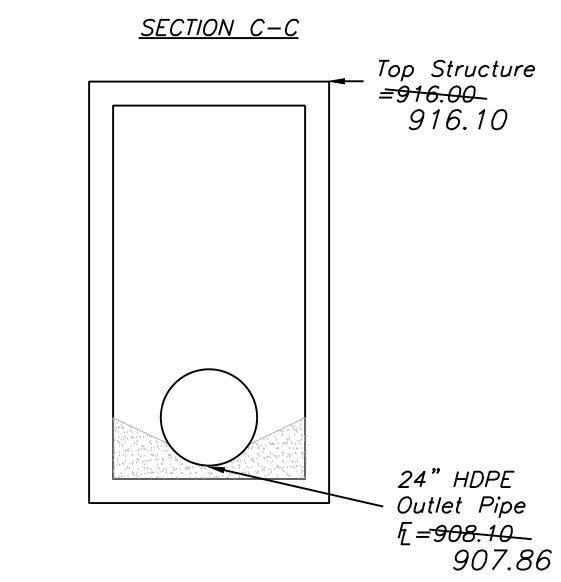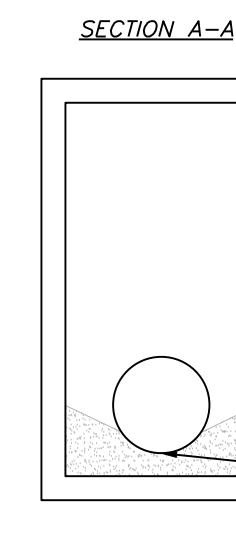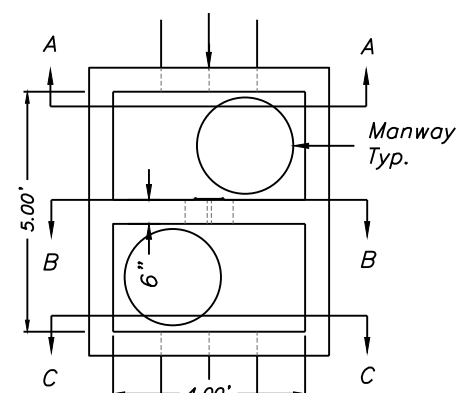

CONTROL STRUCTURE - BASIN D1

1/4" = 1'-0"

RECORD DRAWING
The information provided on this drawing conforms to construction records; it is not intended for construction, implementation or recording purposes; and it is solely based on information obtained by my firm.

"100-00 100.10", "4-00% 1.15% slope", or "8-inch HDPE-PVC pipe" are all typical examples of revisions that indicate that design data has been replaced with "as-built" information. All other data is as designed and has not been field verified.

Date: 2/05/2024
Certified by: Matthew J. Schlicht
Title: Engineer
Firm: Engineering Solutions

Detention Basin Plan

Construction Plans for:

WOODLAND OAKS

Lots 1 thru 42

Lee's Summit, Jackson County, Missouri

Project:

WOODLAND OAKS

LSMO

Issue Date:

January 18, 2024

ENGINEERING SOLUTIONS

ENGINEERING & SURVEYING


50 SE 30TH STREET

LEE'S SUMMIT, MO 64082

P: (816) 623-9888 F: (816) 623-9849

Professional Registration
Missouri
Engineering 2005002186-D
Surveying 2005008319-D
Kansas
Engineering E-1685
Surveying LS-218
Oklahoma
Engineering 6254
Nebraska
Engineering CA2821


Part of the Southeast 1/4
Section 27, Township 48 North, Range 31 West
Lee's Summit, Jackson County, Missouri

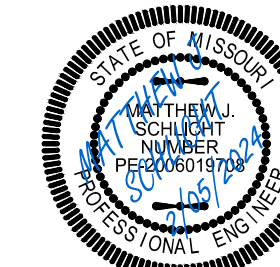

Matthew J. Schlicht
MO PE 2006019708
KS PE 19071
OK PE 25226
NE PE E-14335

REVISIONS

1/18/2024 As-Built
2/05/2024 As-Built

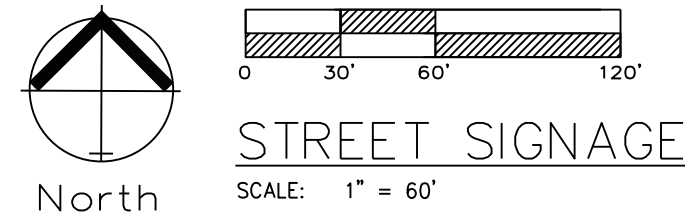


Professional Registration
Missouri
Engineering 2005002186-D
Surveying 2005008319-D
Kansas
Engineering E-1695
Surveying LS-218
Oklahoma
Engineering 6254
Nebraska
Engineering CA2821

Part of the Southeast 1/4
Section 27, Township 48 North, Range 31 West
Lee's Summit, Jackson County, Missouri

Project:
WOODLAND OAKS
LSMO
Issue Date:
January 18, 2024

Street Signage Plan
Construction Plans for:
WOODLAND OAKS
Lots 1 thru 42
Lee's Summit, Jackson County, Missouri




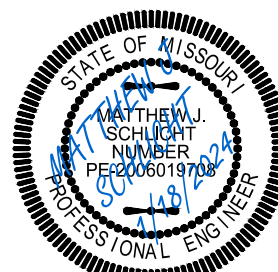


Matthew J. Schlicht
MO PE 2006019708
KS PE 19071
OK PE 25226
NE PE E-14335

REVISIONS

1/18/2024 As-Built

C.208

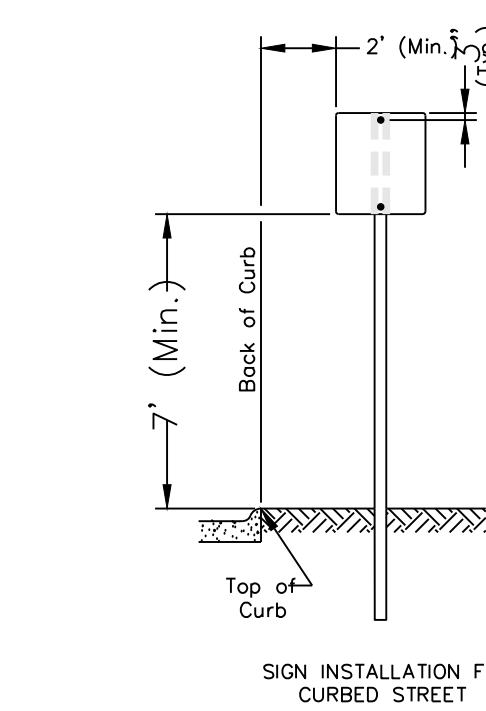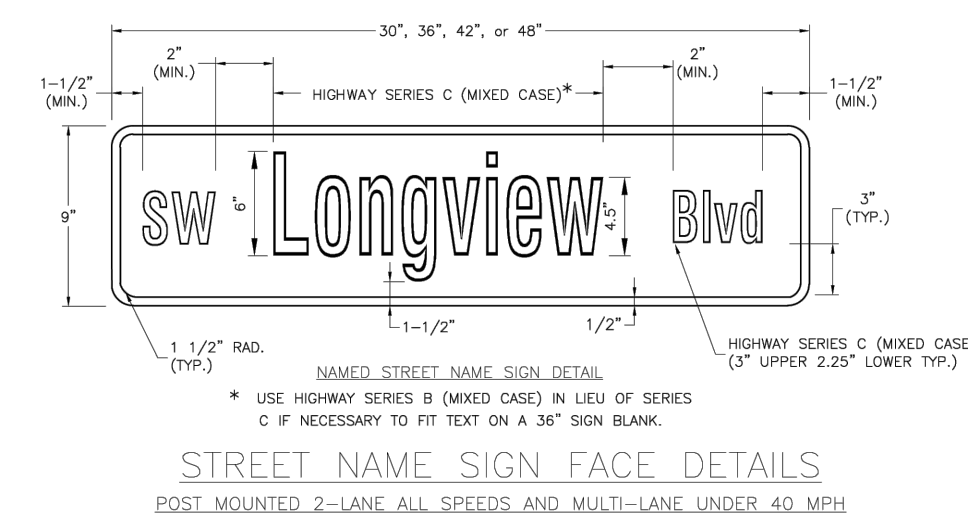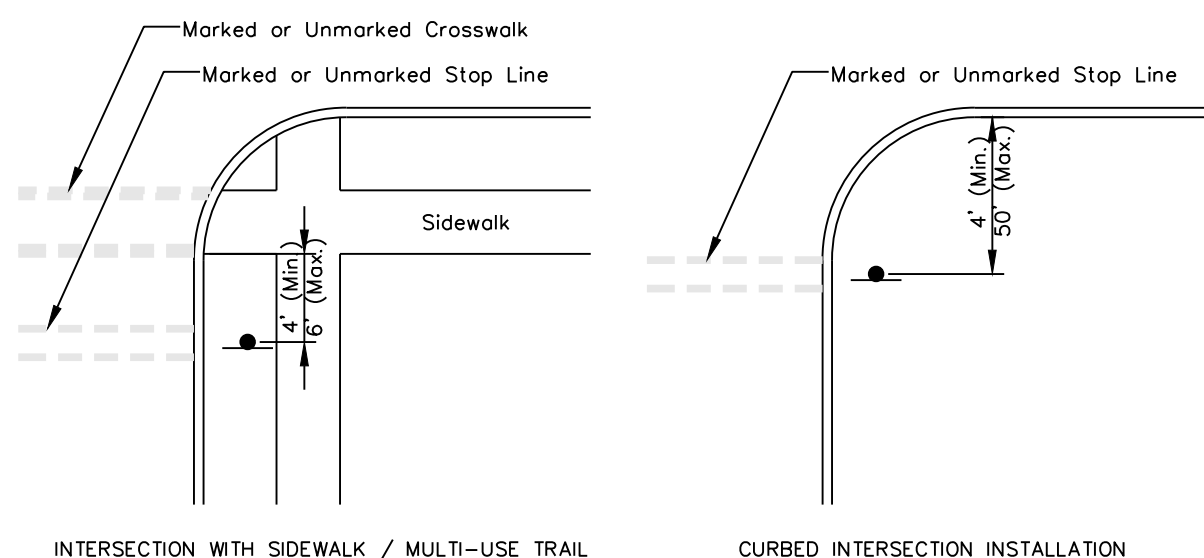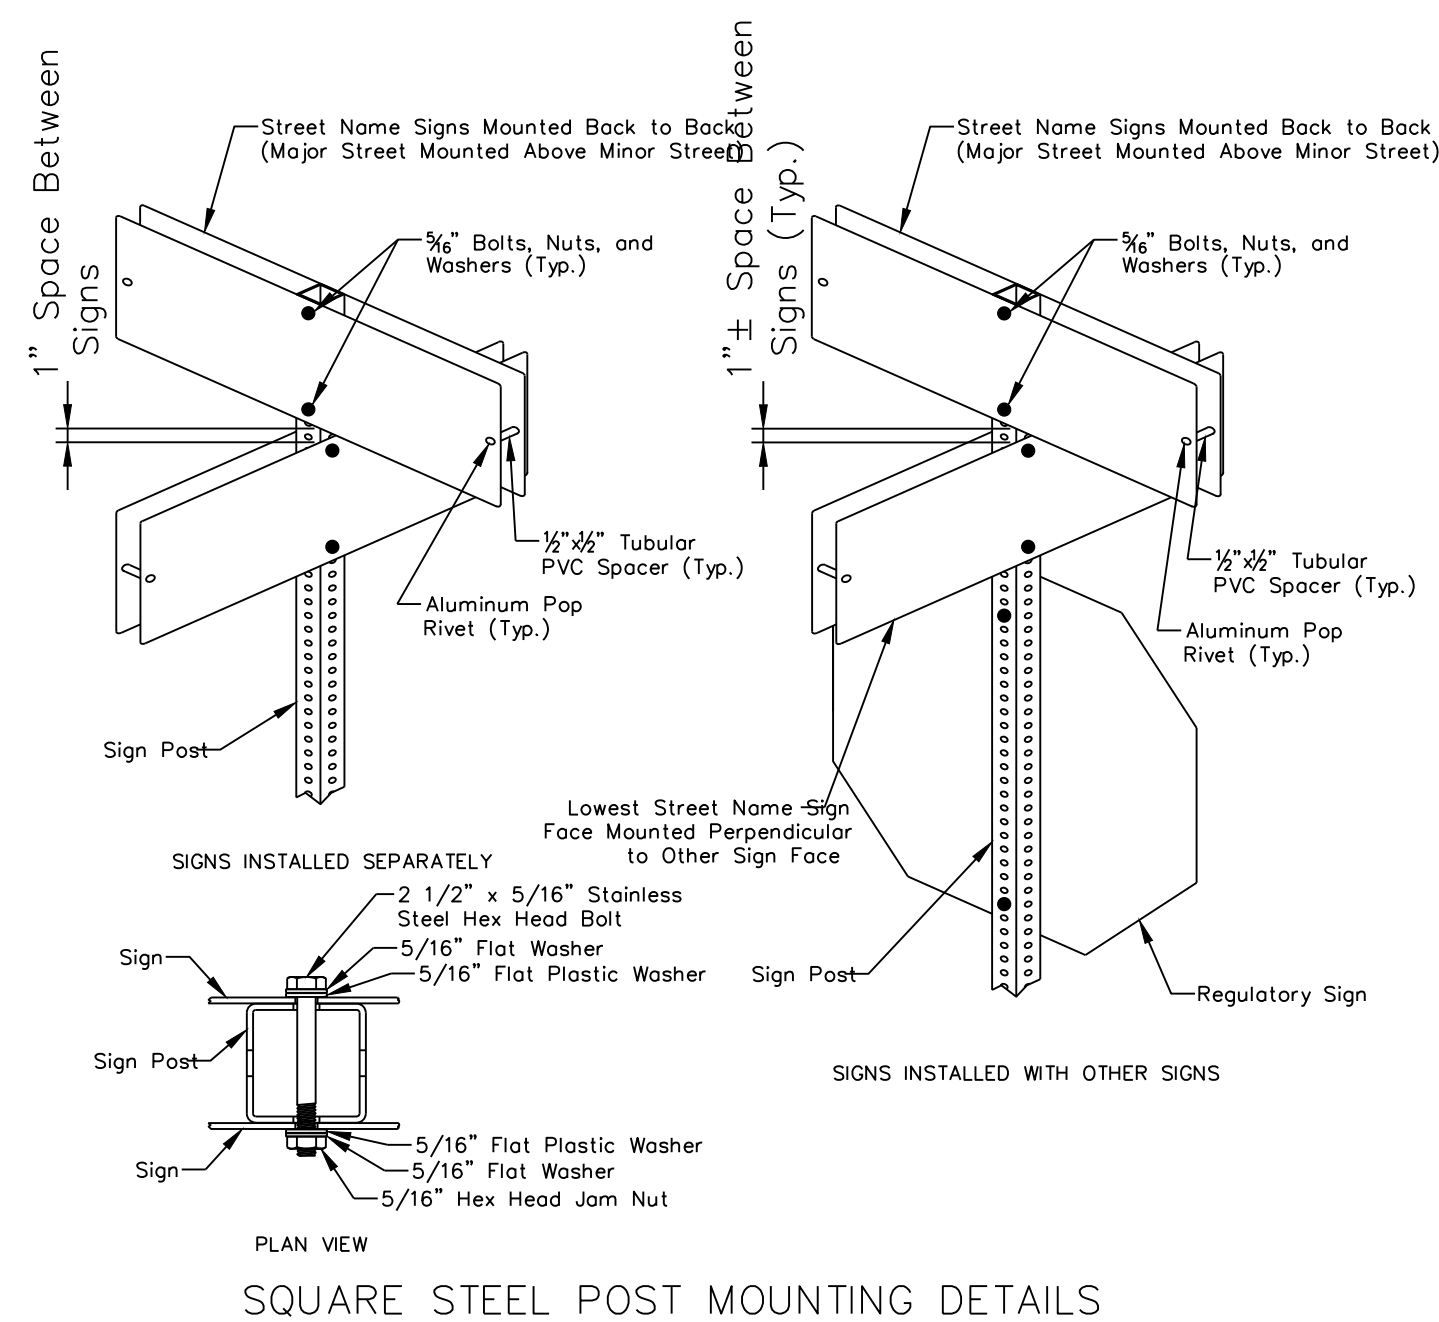


RECORD DRAWING
The information provided on this drawing conforms to construction records; it is not intended for construction, implementation or recording purposes; and it is solely based on information obtained by my firm.
"100-00 100.10", "4.00% 1.15% slope", or "8-inch HDPE-PVC pipe" are all typical examples of revisions that indicate that design data has been replaced with "as-built" information. All other data is as designed and has not been field verified.
Date: 1/18/2024
Certified by: Matthew J. Schlicht
Title: Engineer
Firm: Engineering Solutions



STORM SEWER GENERAL LAYOUT

SCALE: 1" = 50'

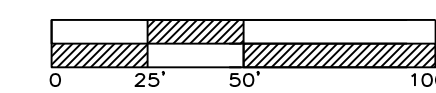


Professional Registration
Missouri
Engineering 2005002186-D
Surveying 2005008319-D
Kansas
Engineering E-1695
Surveying LS-218
Oklahoma
Engineering 6254
Nebraska
Engineering CA2821

Part of the Southeast 1
Section 27, Township 48 North, Range 31 West
Lee's Summit, Jackson County, Missouri

Project: WOODLAND OAKS
LSMO
Issue Date: January 18, 2024

Storm Sewer General Layout
Construction Plans for:
WOODLAND OAKS
Lots 1 thru 42
Lee's Summit, Jackson County, Missouri

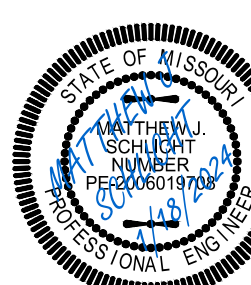

Matthew J. Schlicht
MO PE 2006019708
KS PE 19071
OK PE 25226
NE PE E-14335

REVISIONS




1/18/2024 As-Built

RECORD DRAWING

The information provided on this drawing conforms to construction records; it is not intended for construction, implementation or recording purposes; and it is solely based on information obtained by my firm.

"100-00 100.10", "4-00% 1.15% slope", or "8-inch HDPE-PVC pipe" are all typical examples of revisions that indicate that design data has been replaced with "as-built" information. All other data is as designed and has not been field verified.

Date: 1/18/2024
Certified by: Matthew J. Schlicht
Title: Engineer
Firm: Engineering Solutions

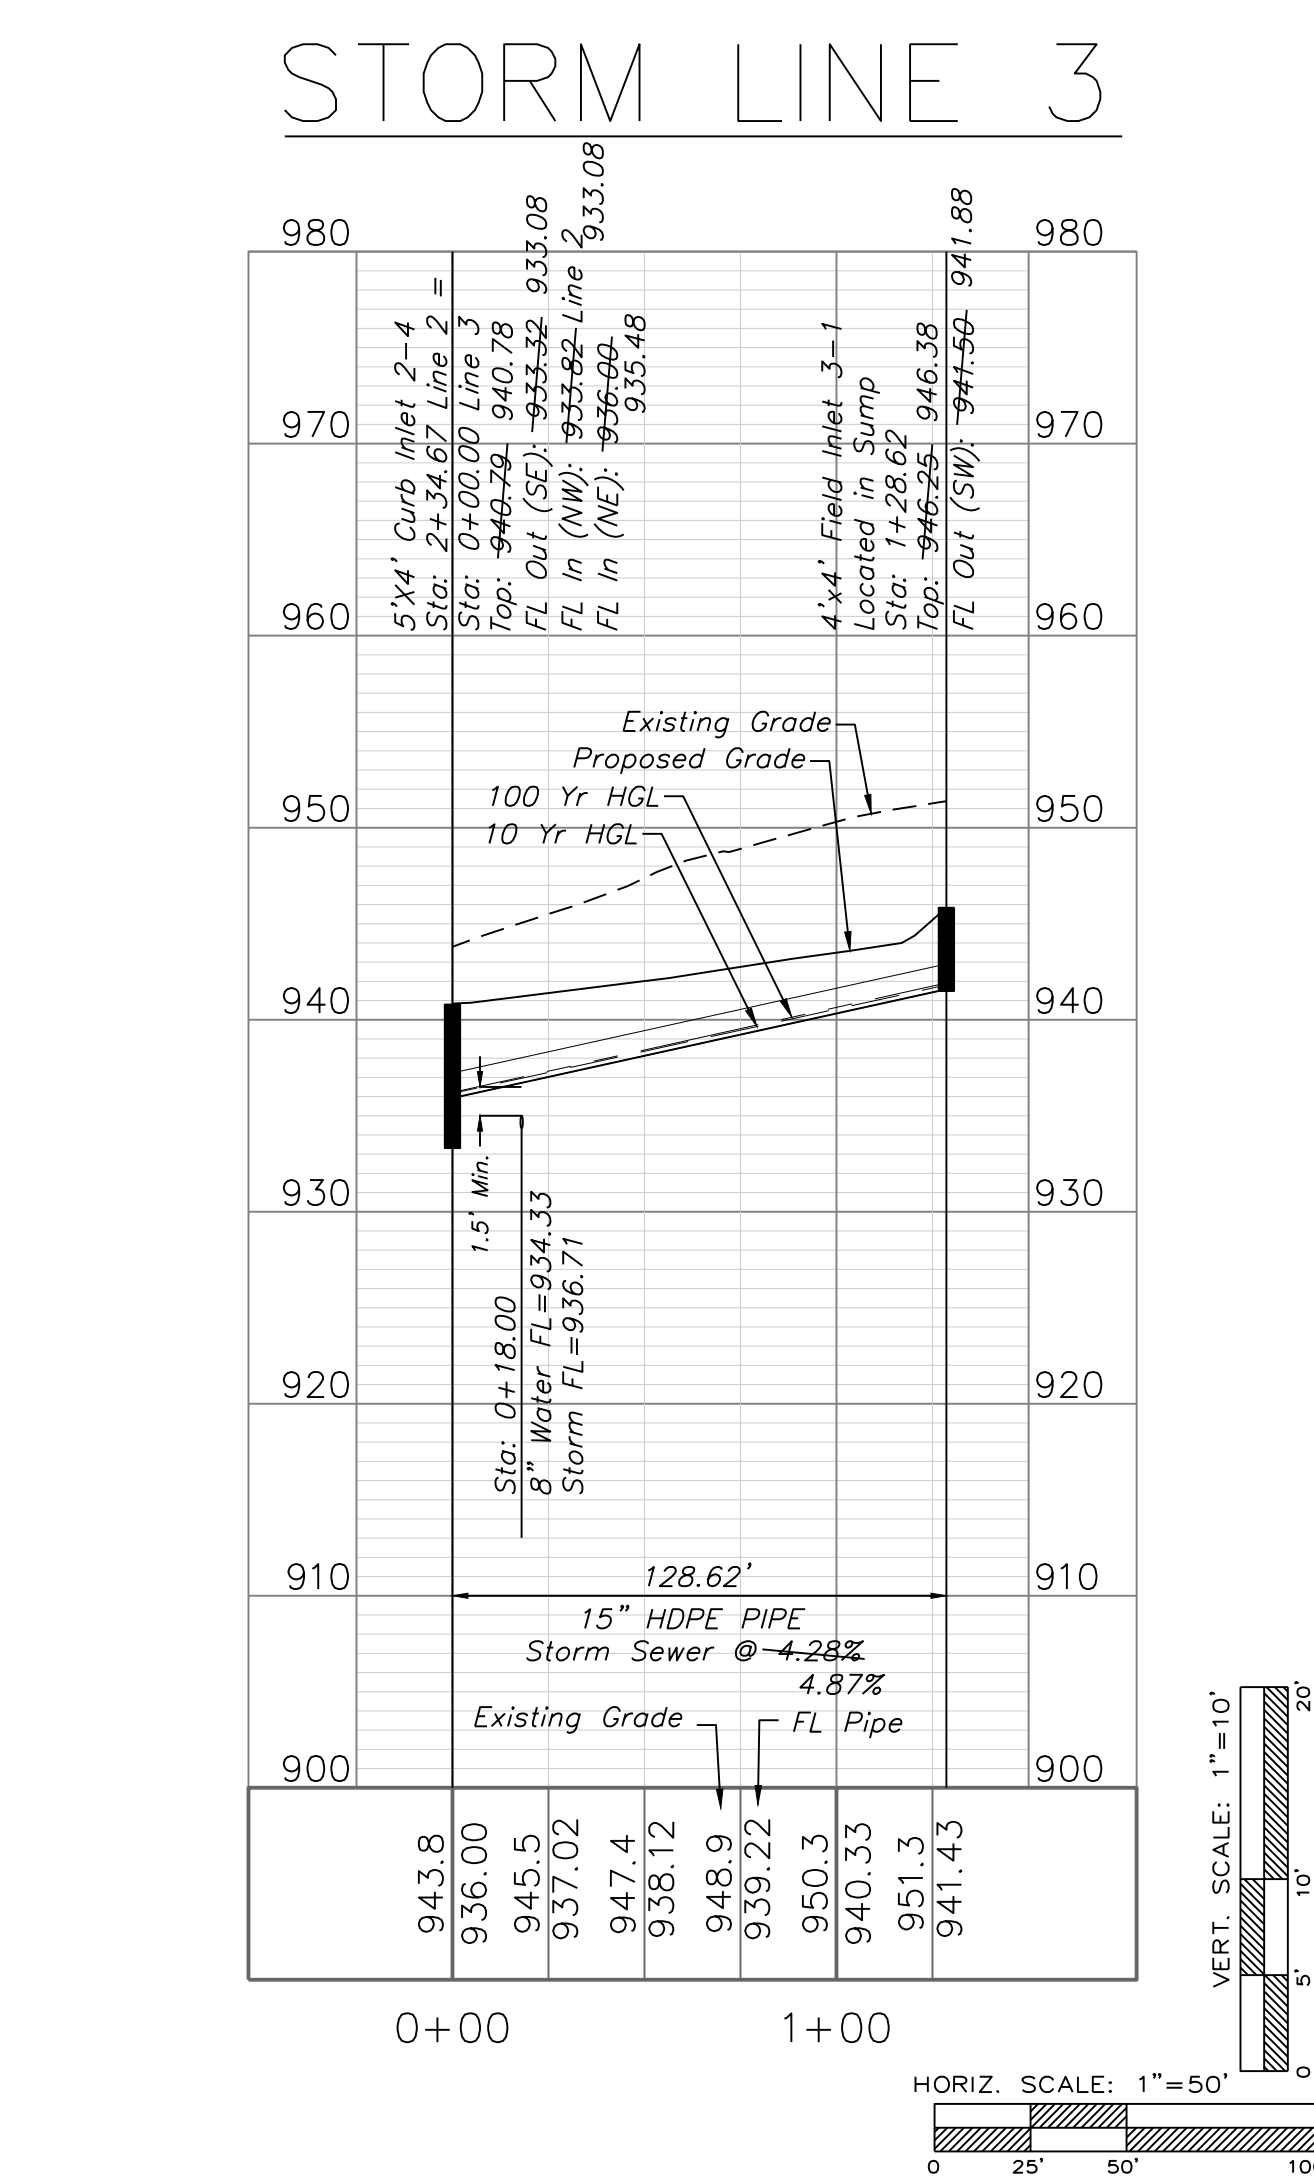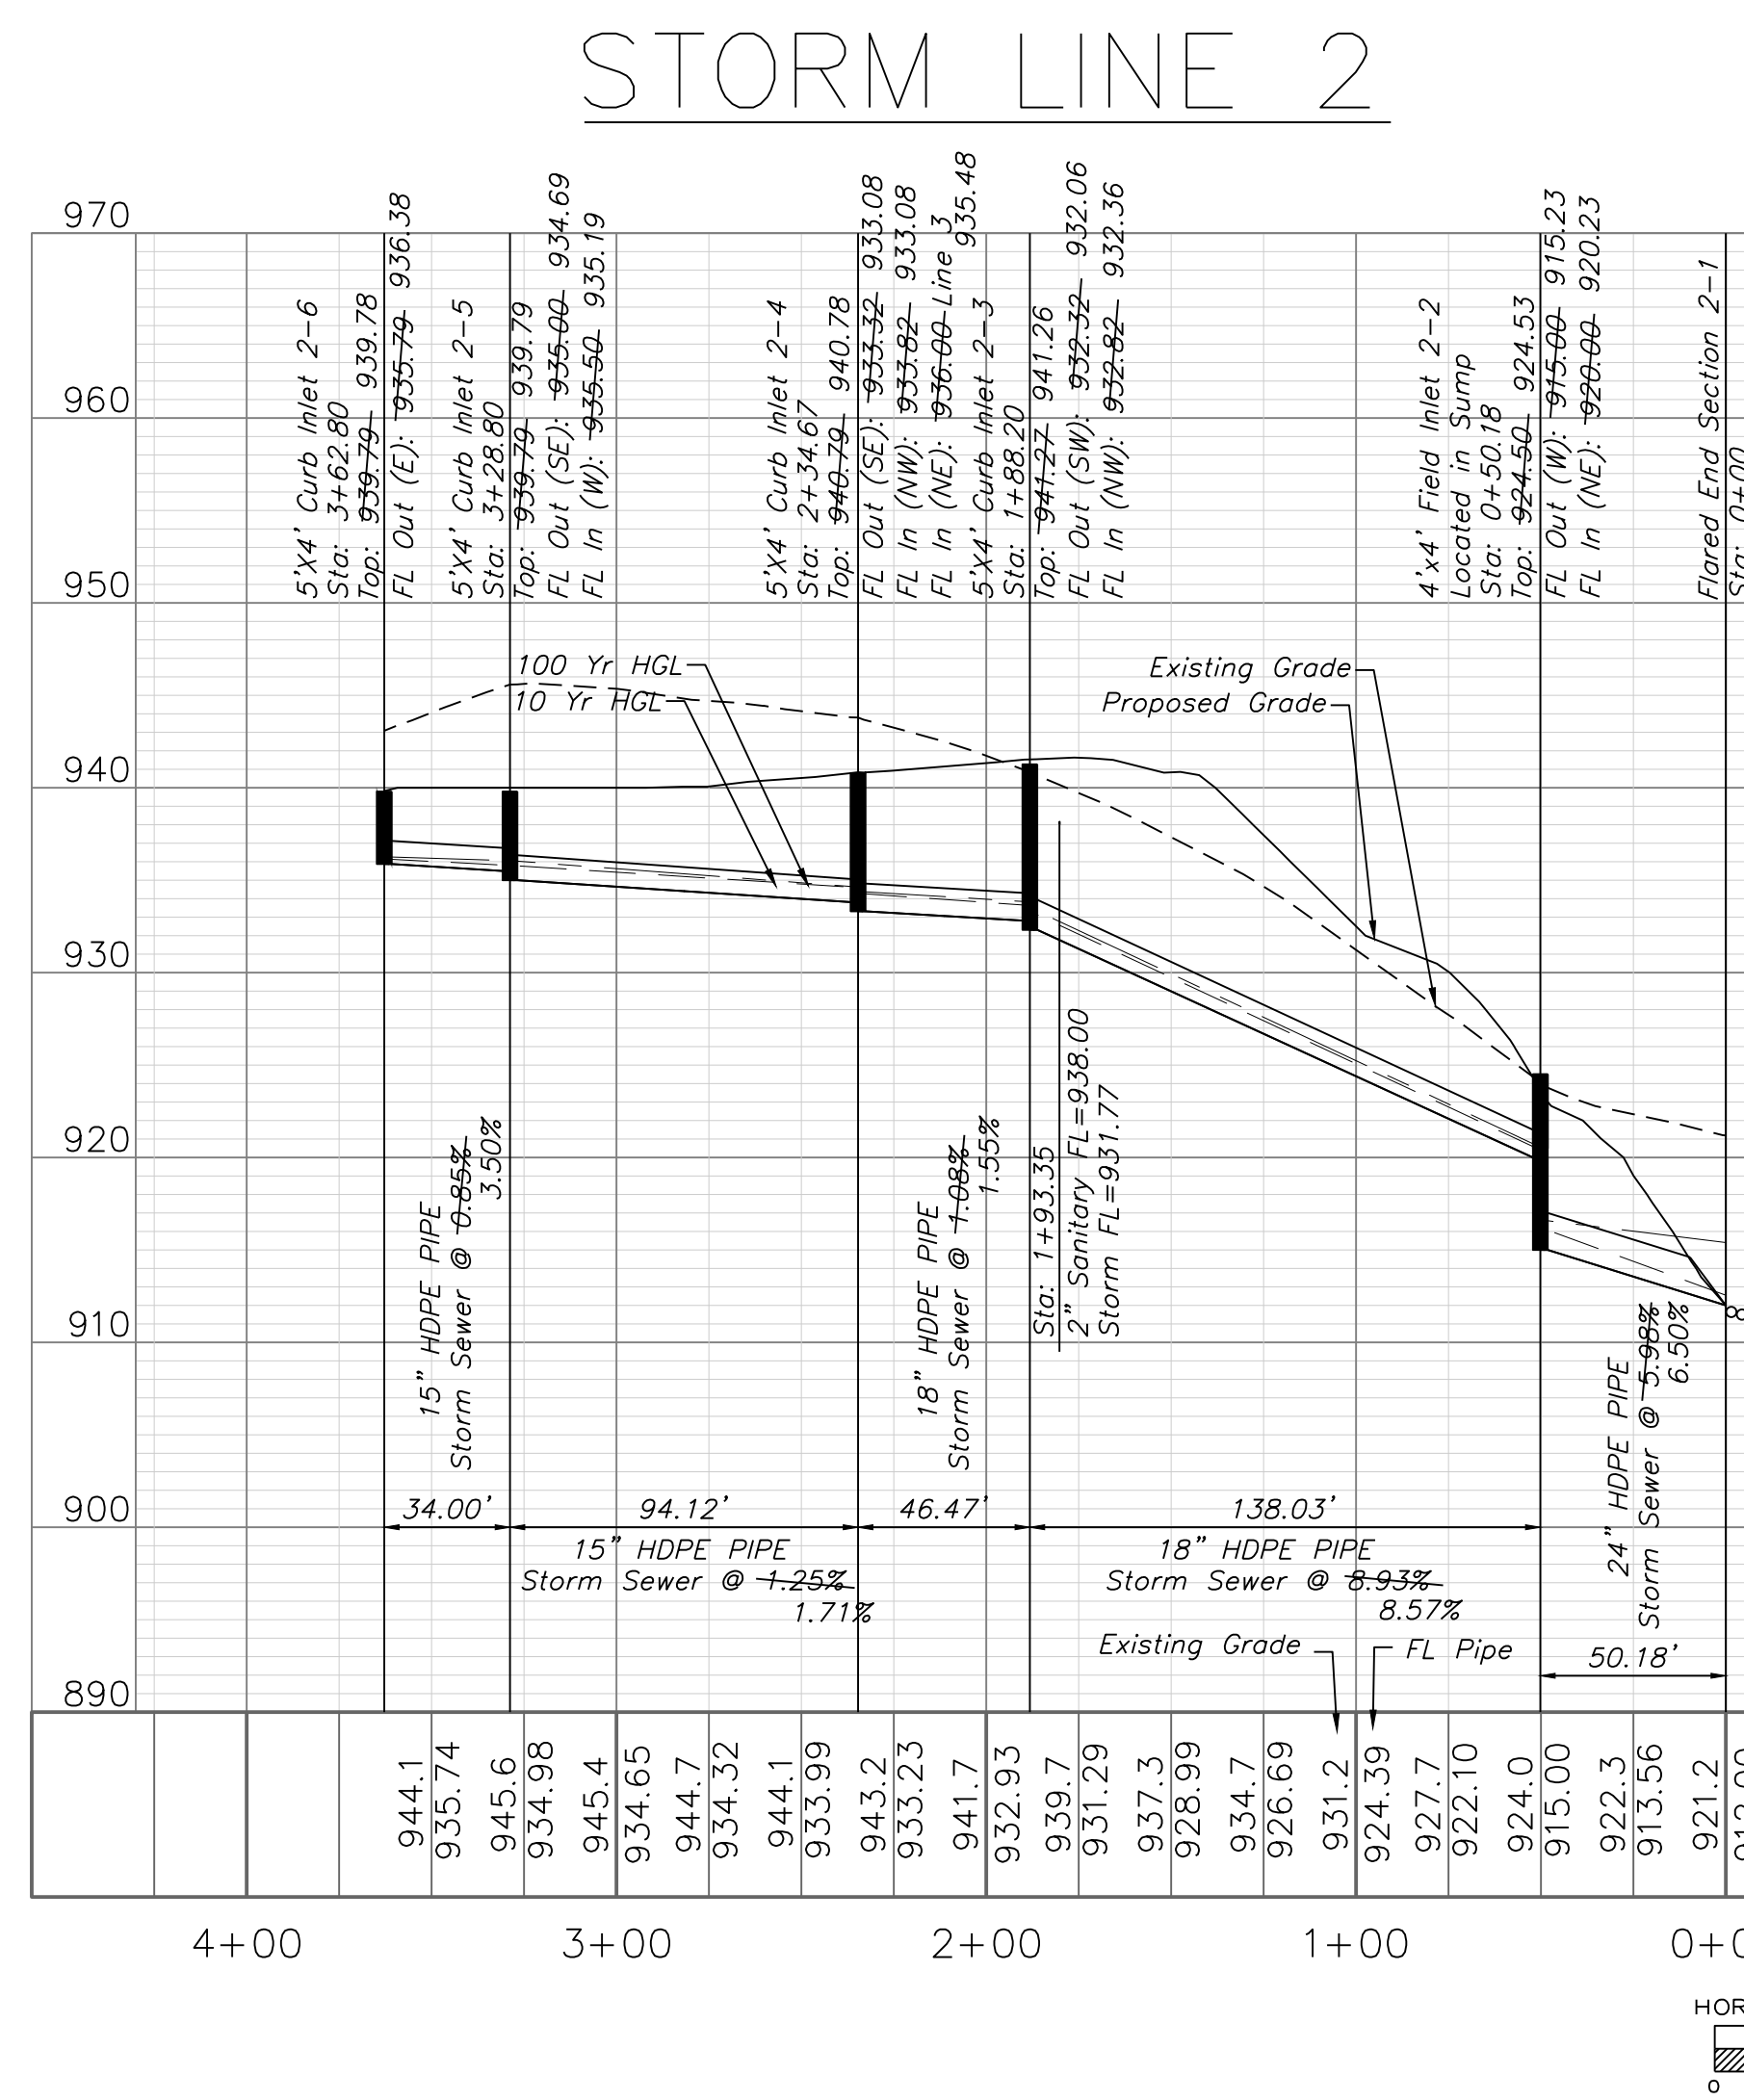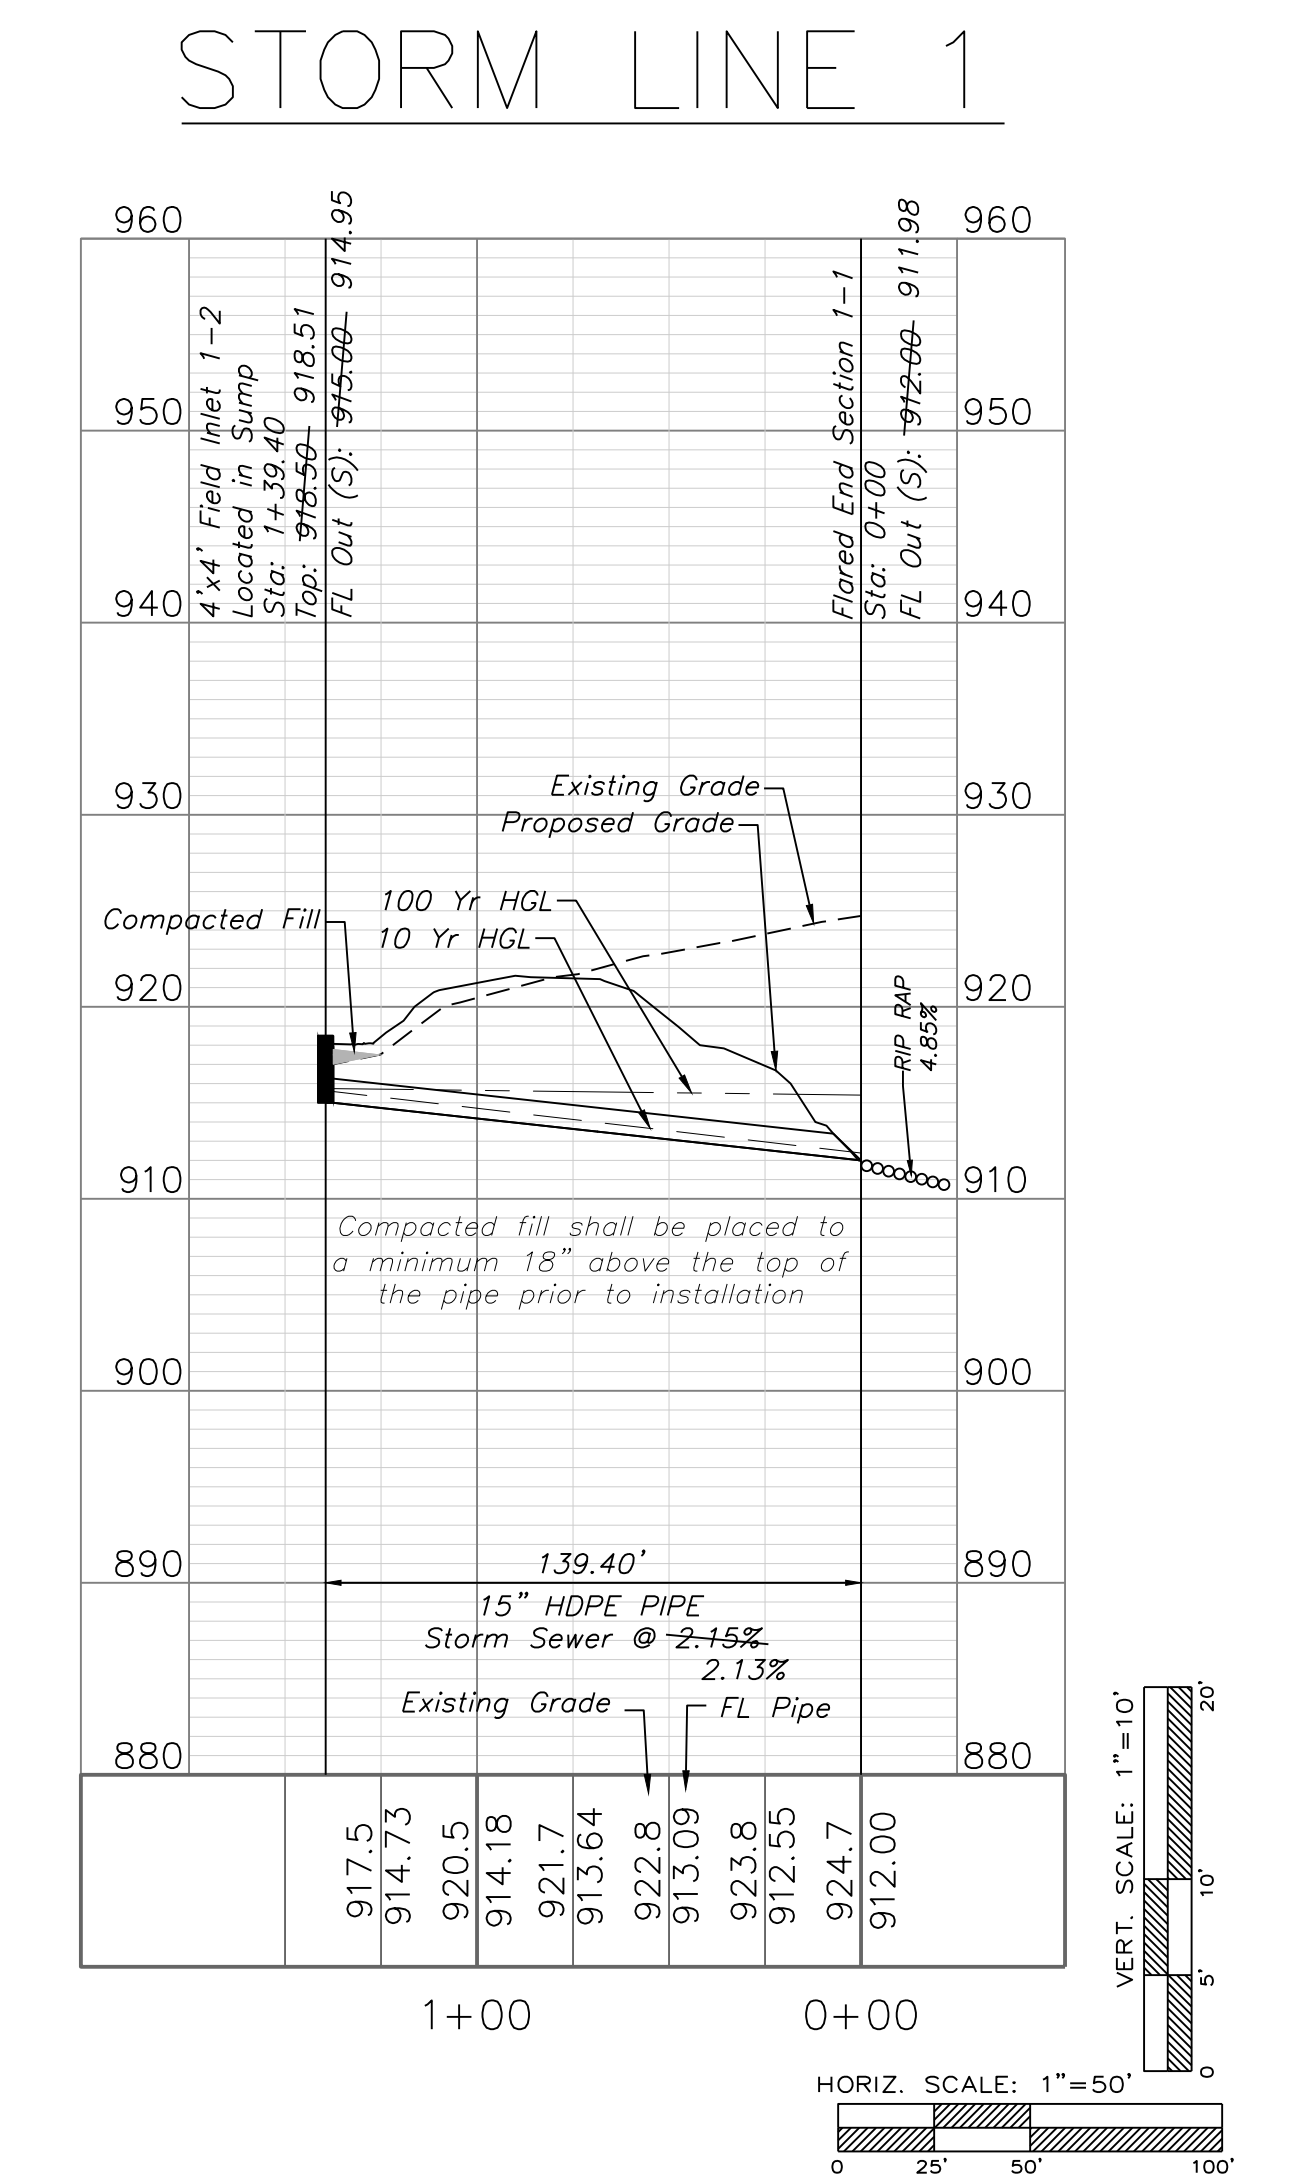



ENGINEERING SOLUTIONS

—ENGINEERING & SURVEYING—

50 SE 30TH STREET
LEE'S SUMMIT, MO 64082
P: (816) 623-9888 F: (816) 623-9849

Professional Registration

Missouri

Engineering 2005002186-D
Surveying 2005000319-D

Kansas

Engineering E-1685
Surveying LS-218

Oklahoma

Engineering 1354

Nebraska

Engineering CA2821

Part of the Southeast 1
Section 27, Township 48 North, Range 31 West
Lee's Summit, Jackson County, Missouri

Storm Sewer Plan & Profile

Construction Plans for:


WOODLAND OAKS

Lois 1 thru 42

Lee's Summit, Jackson County, Missouri

Project: WOODLAND OAKS
LSMO







Issue Date: January 18, 2024








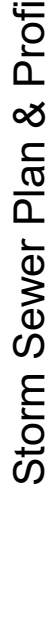


Matthew J. Schlicht
MO PE 2006091708
KS PE 19071
OK PE 25226
NE PE E-14335

REVISIONS

1/18/2024 As-Built

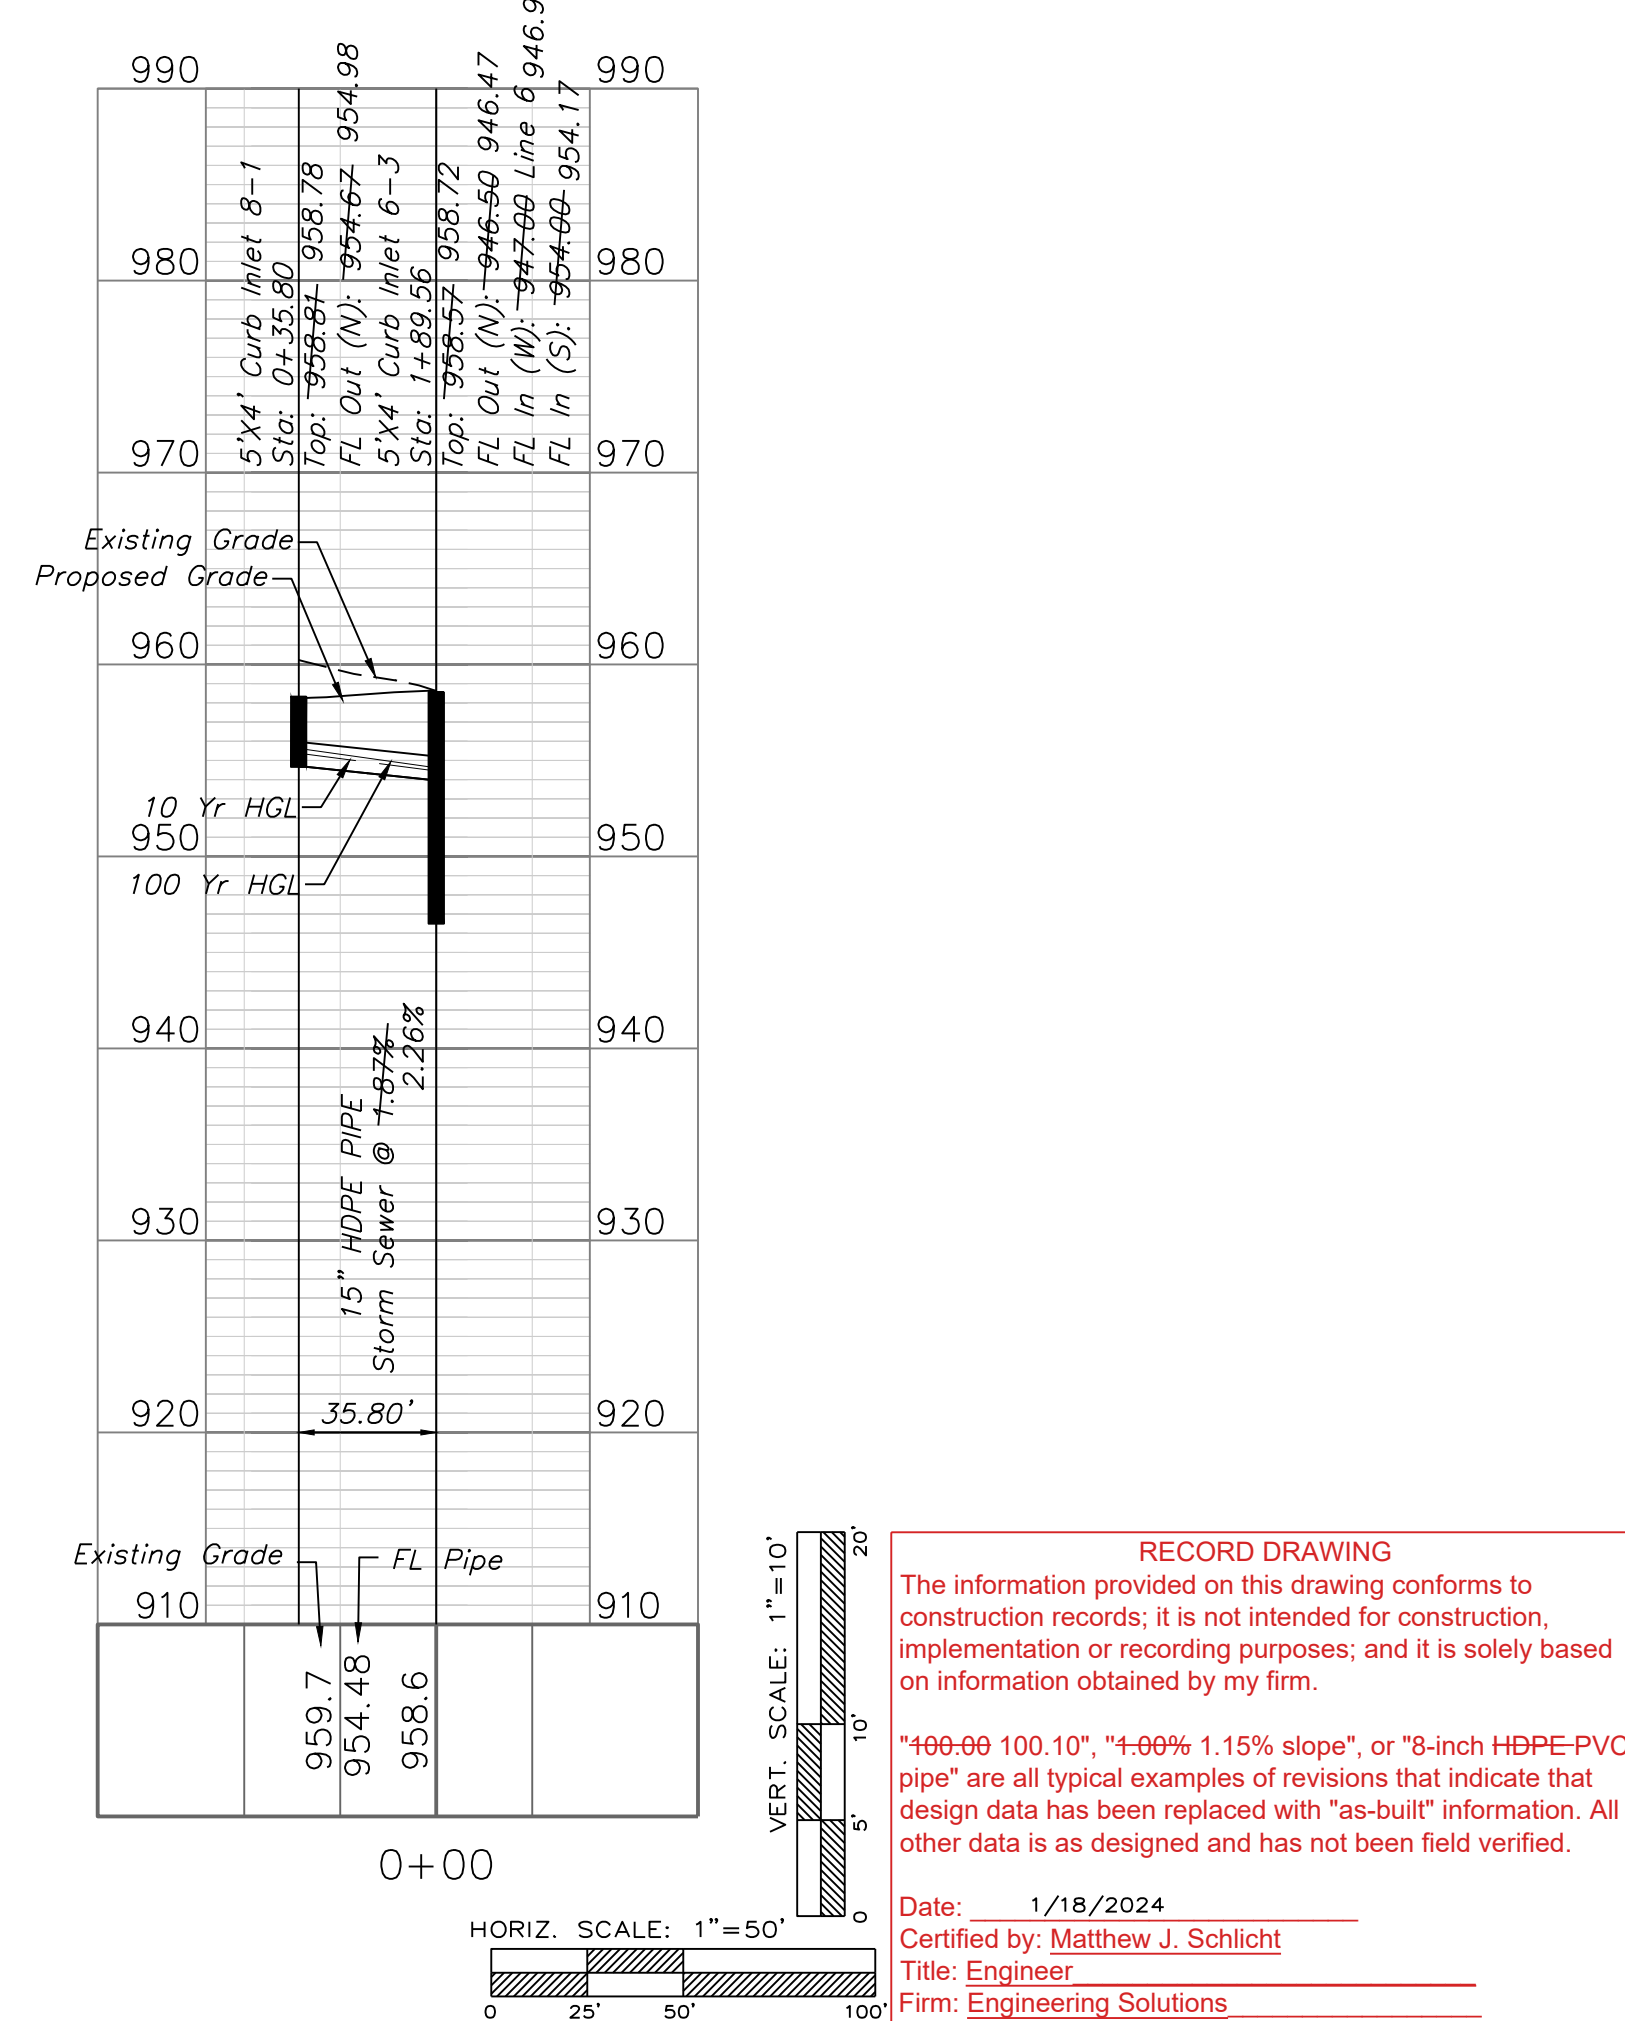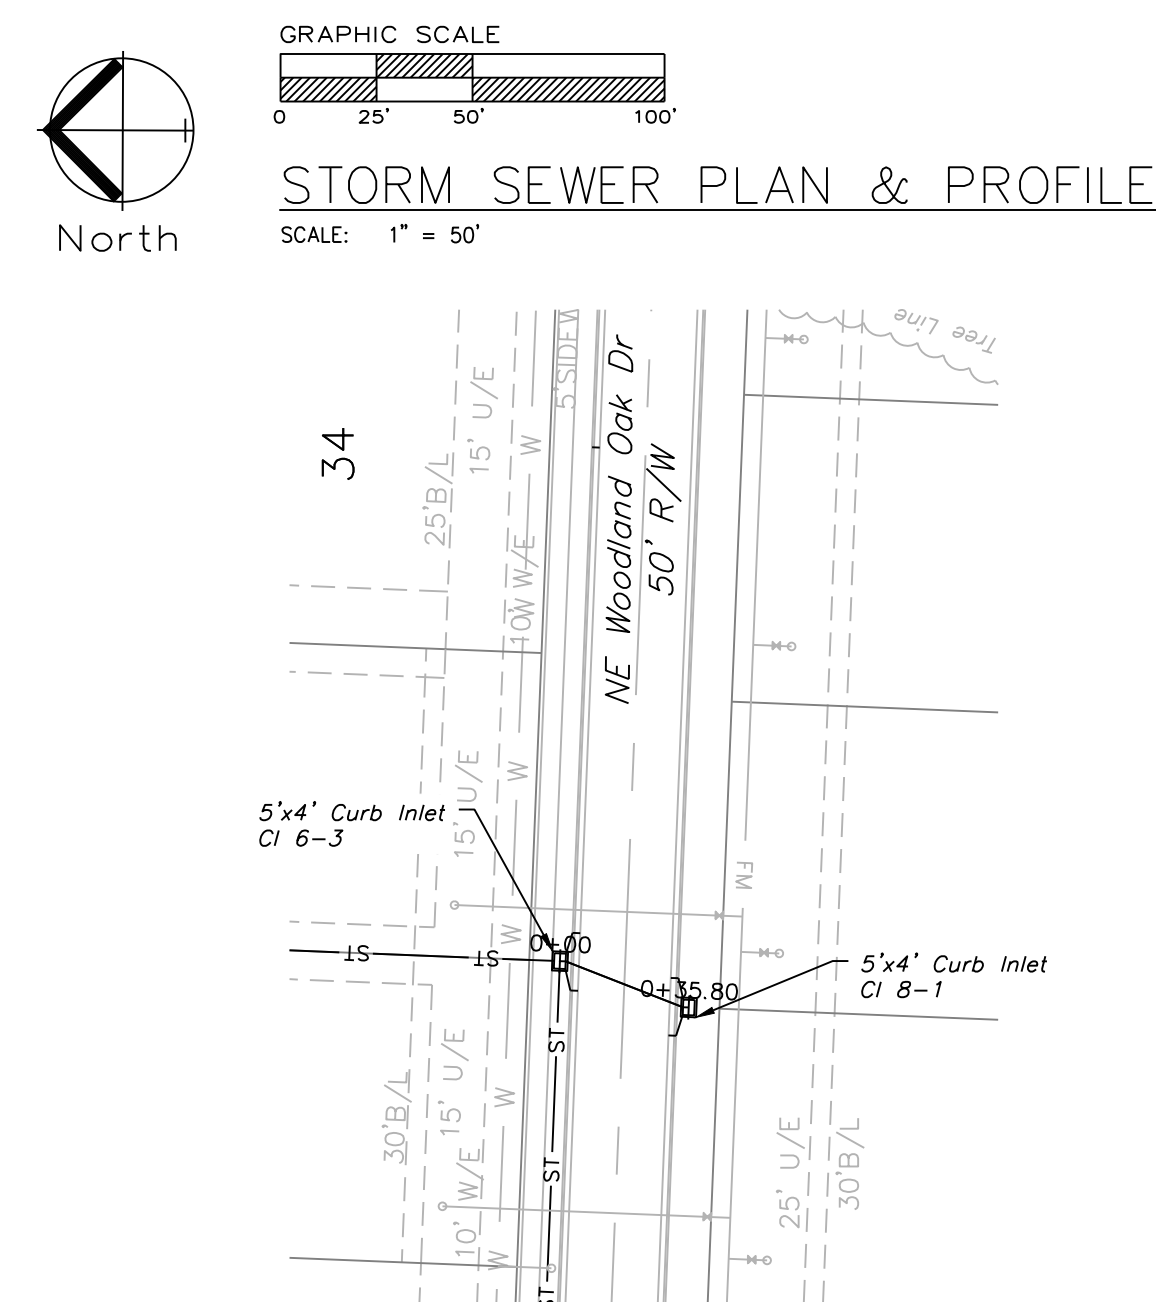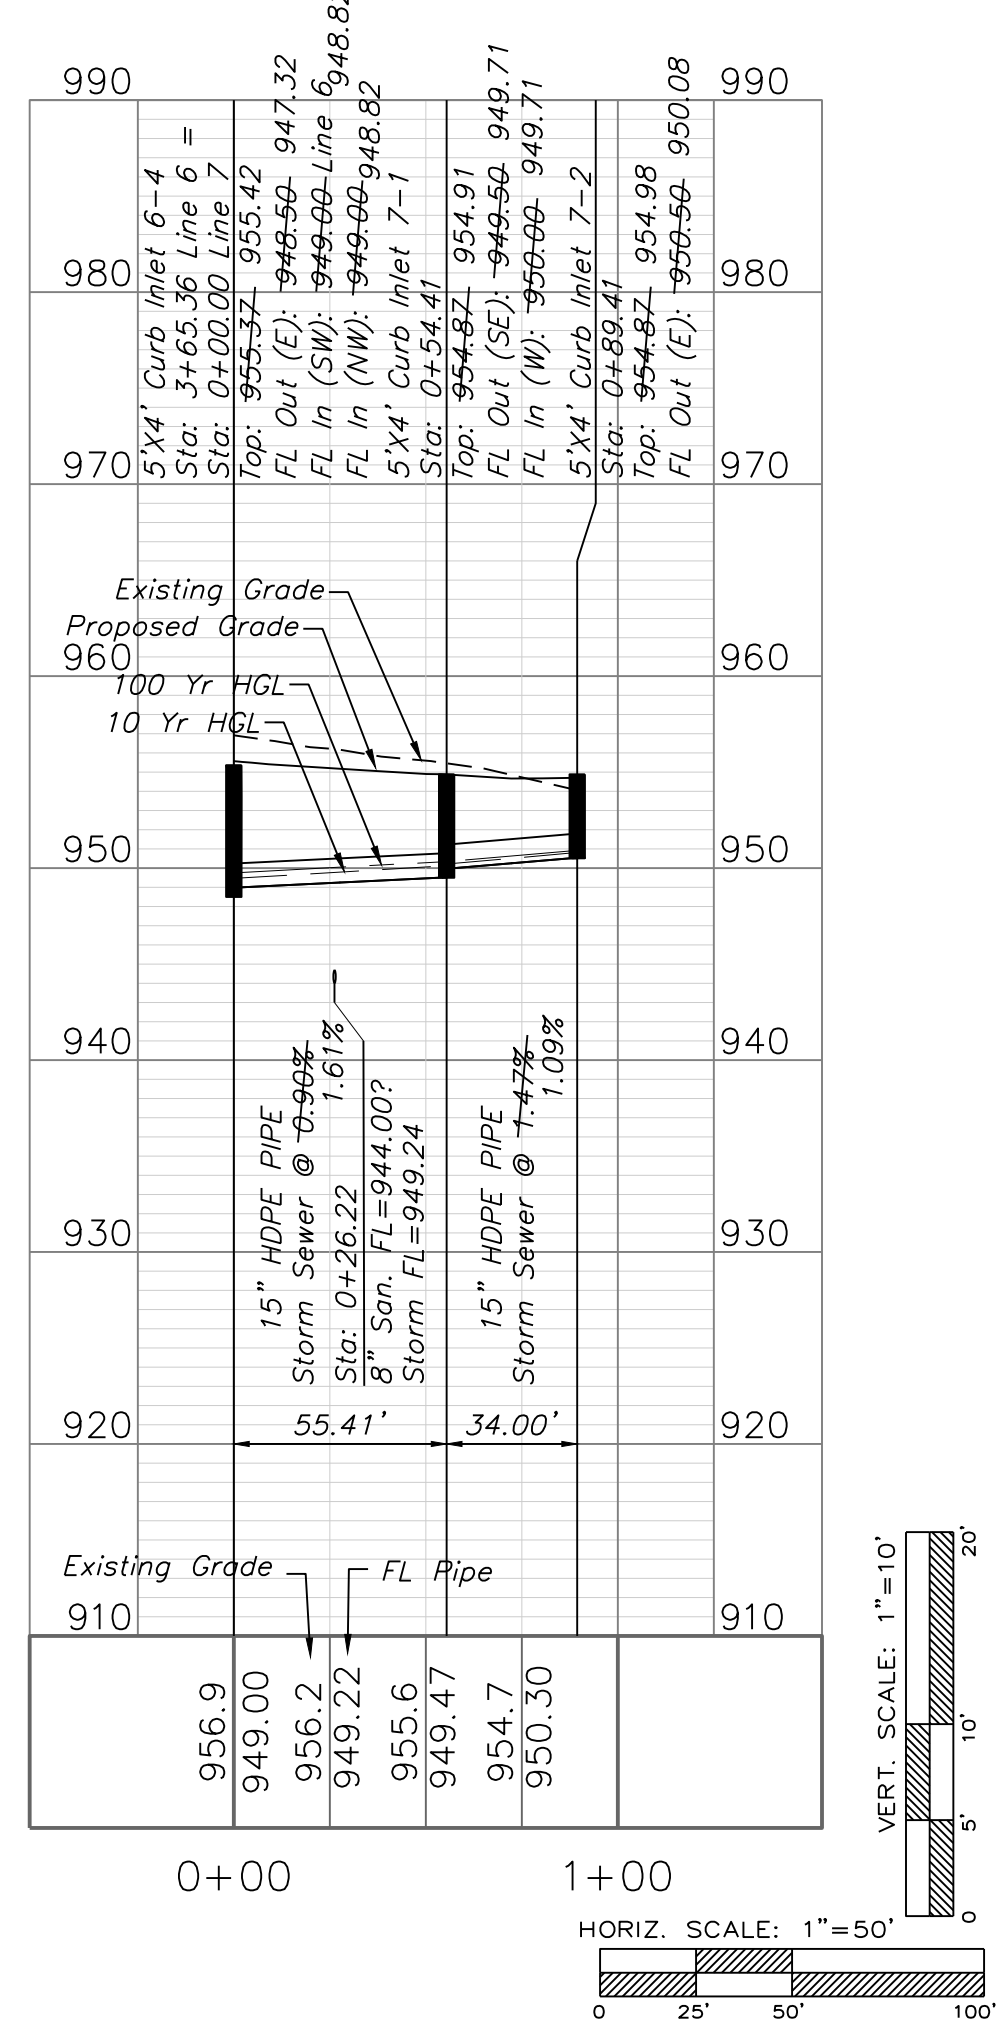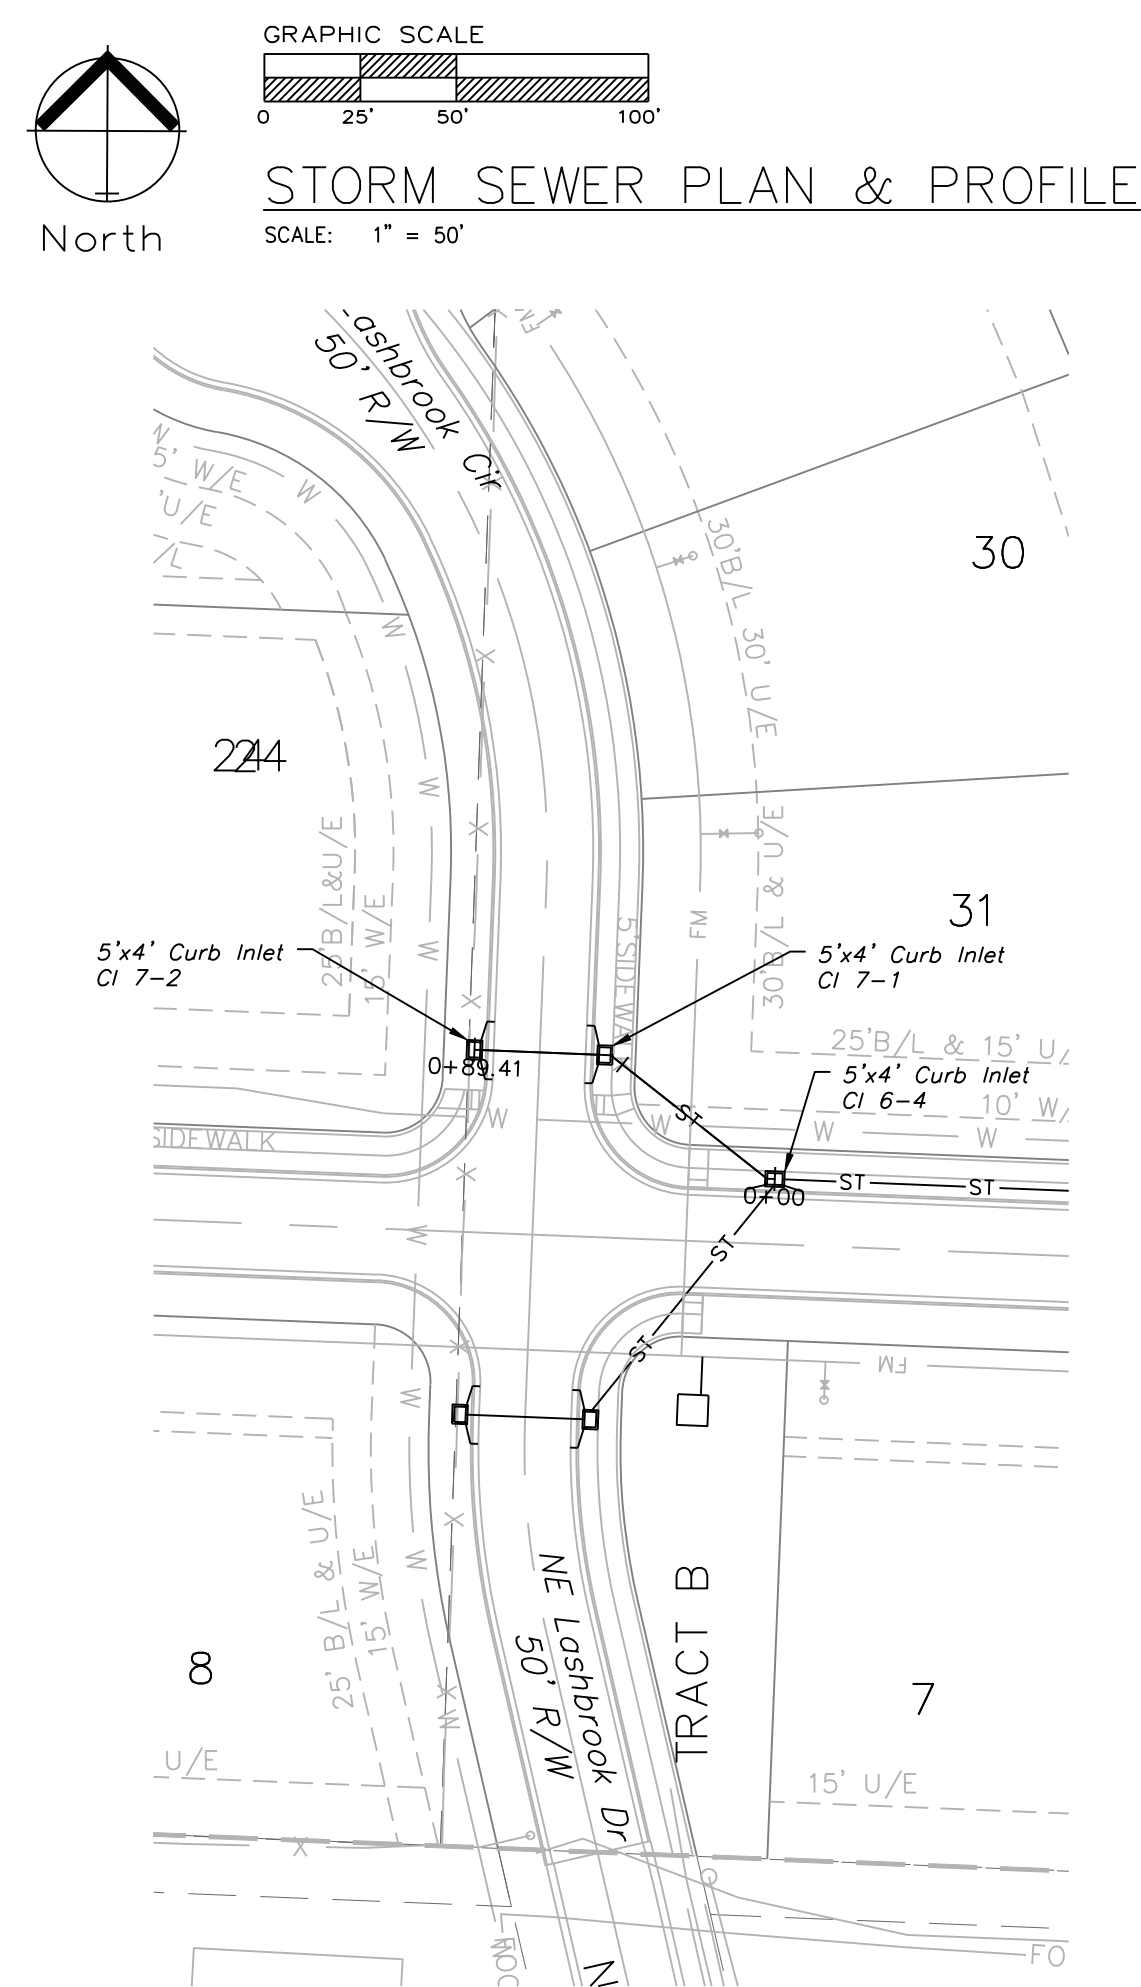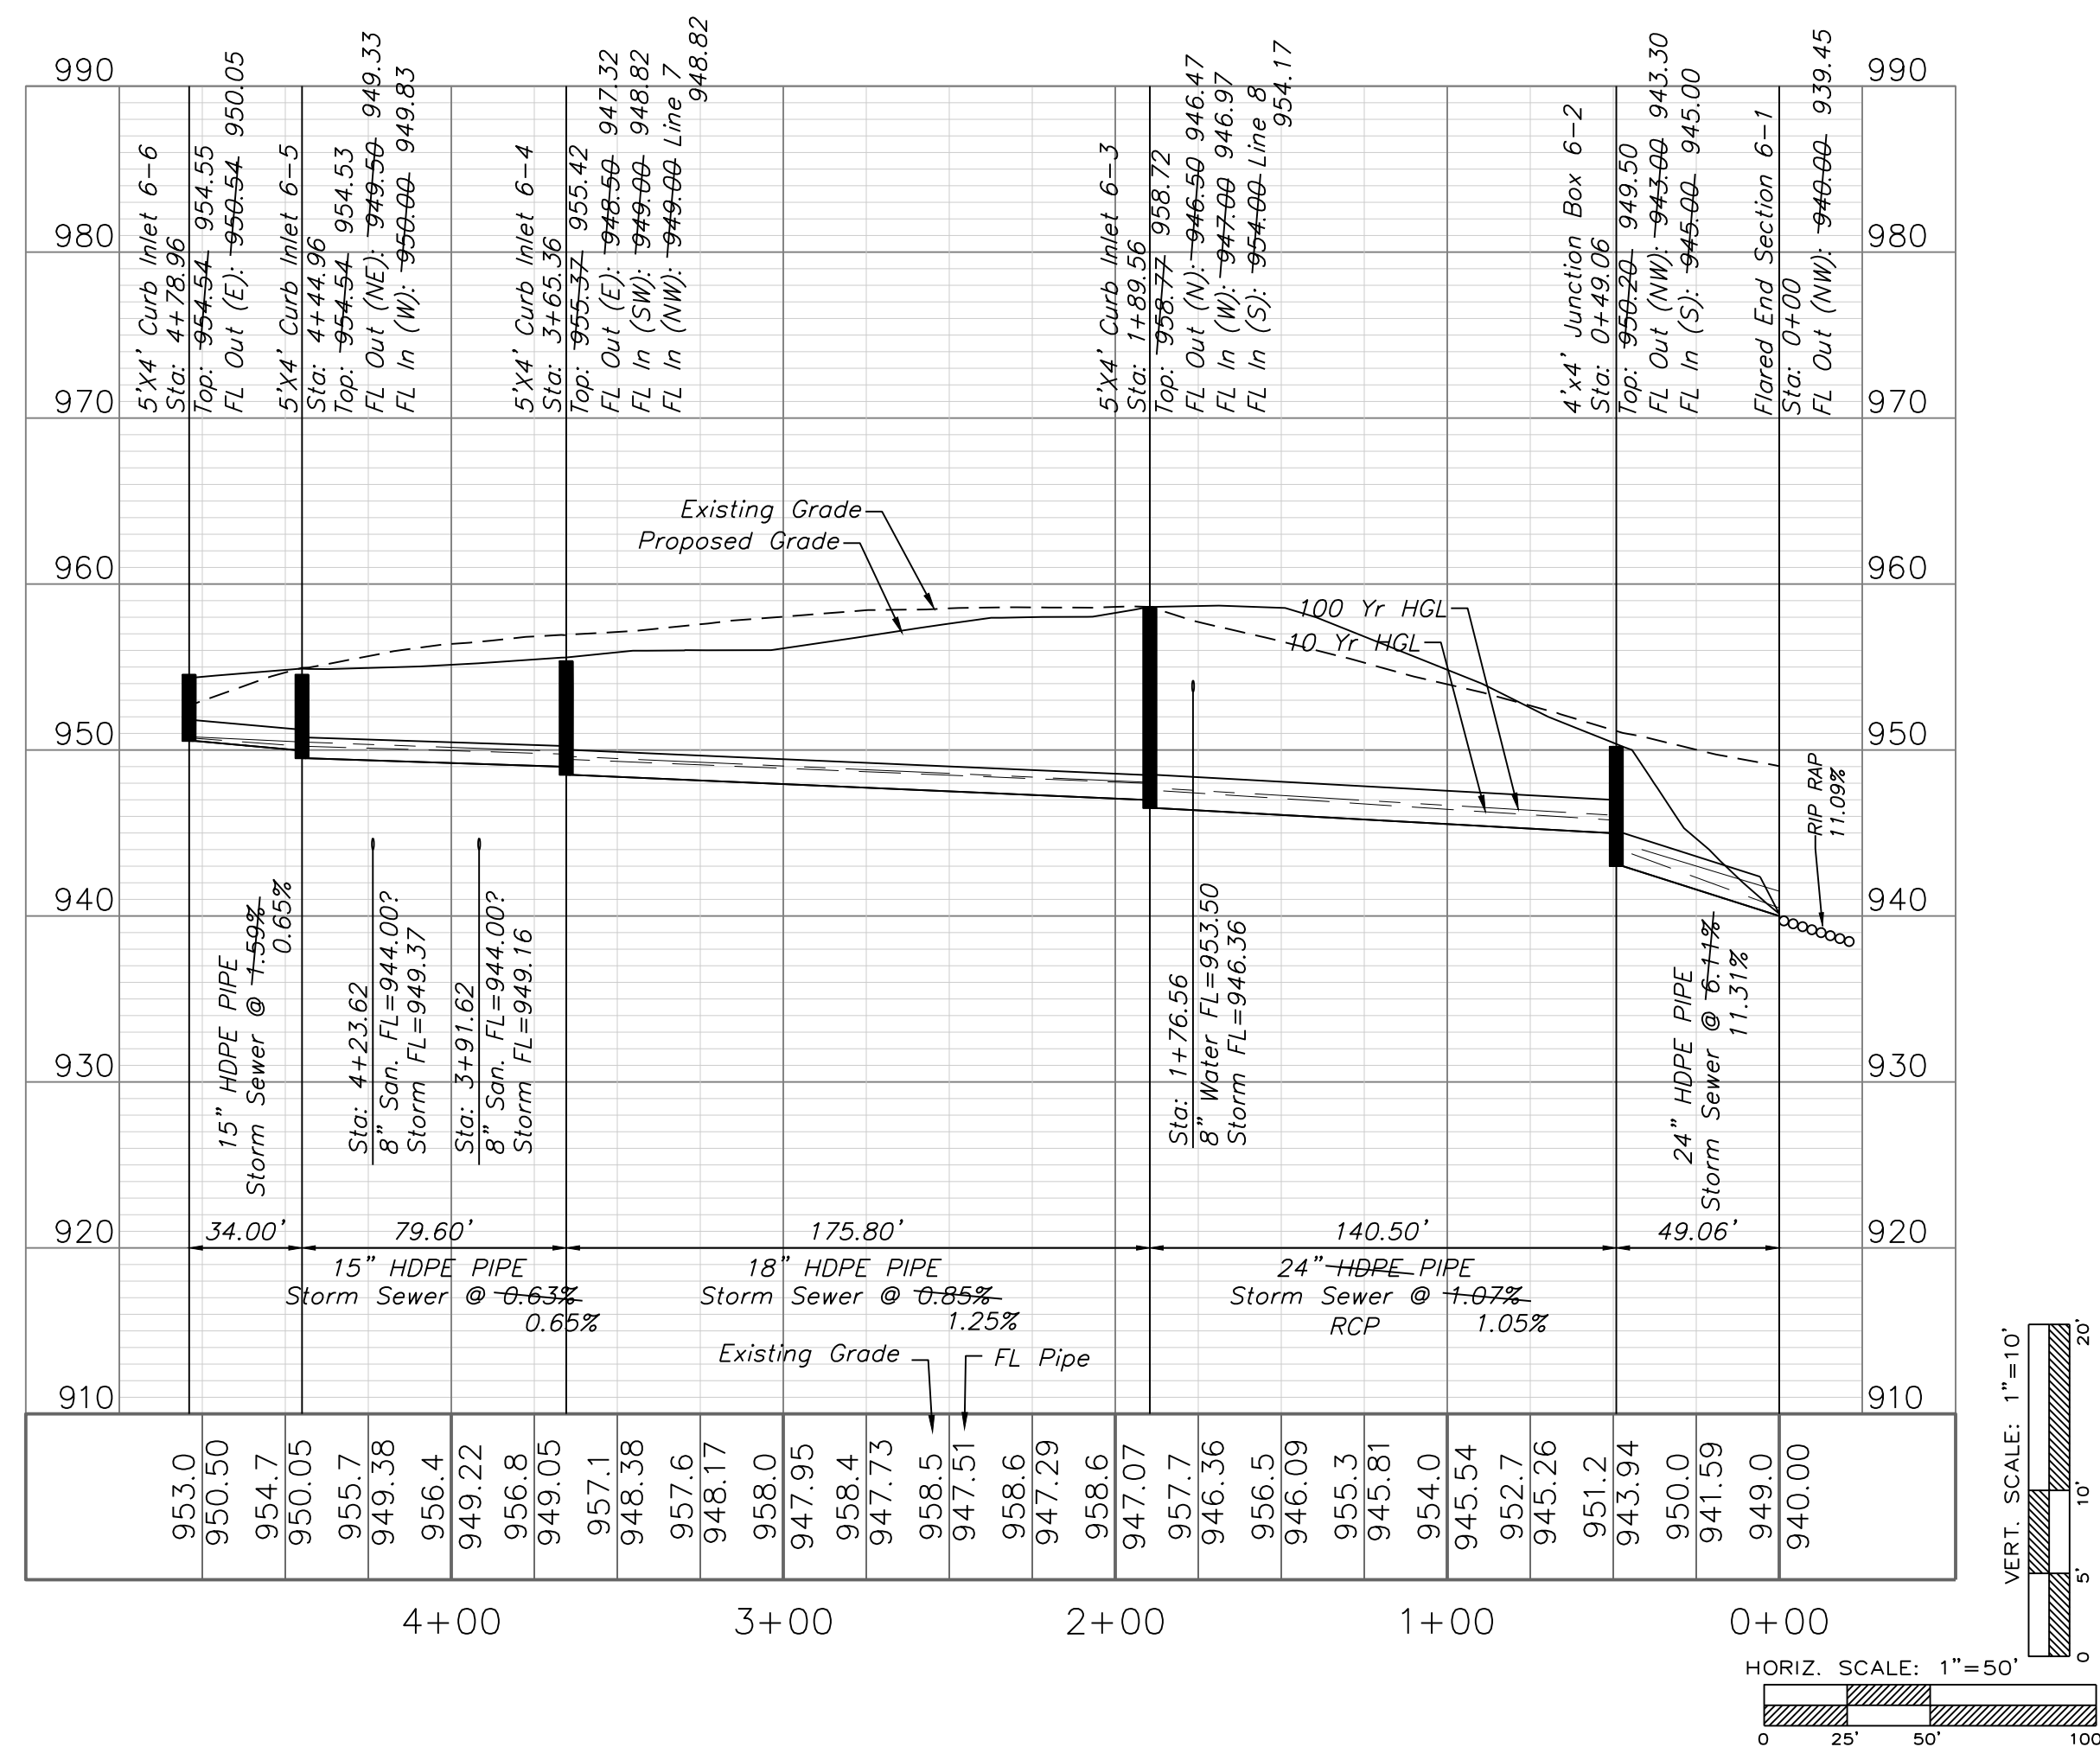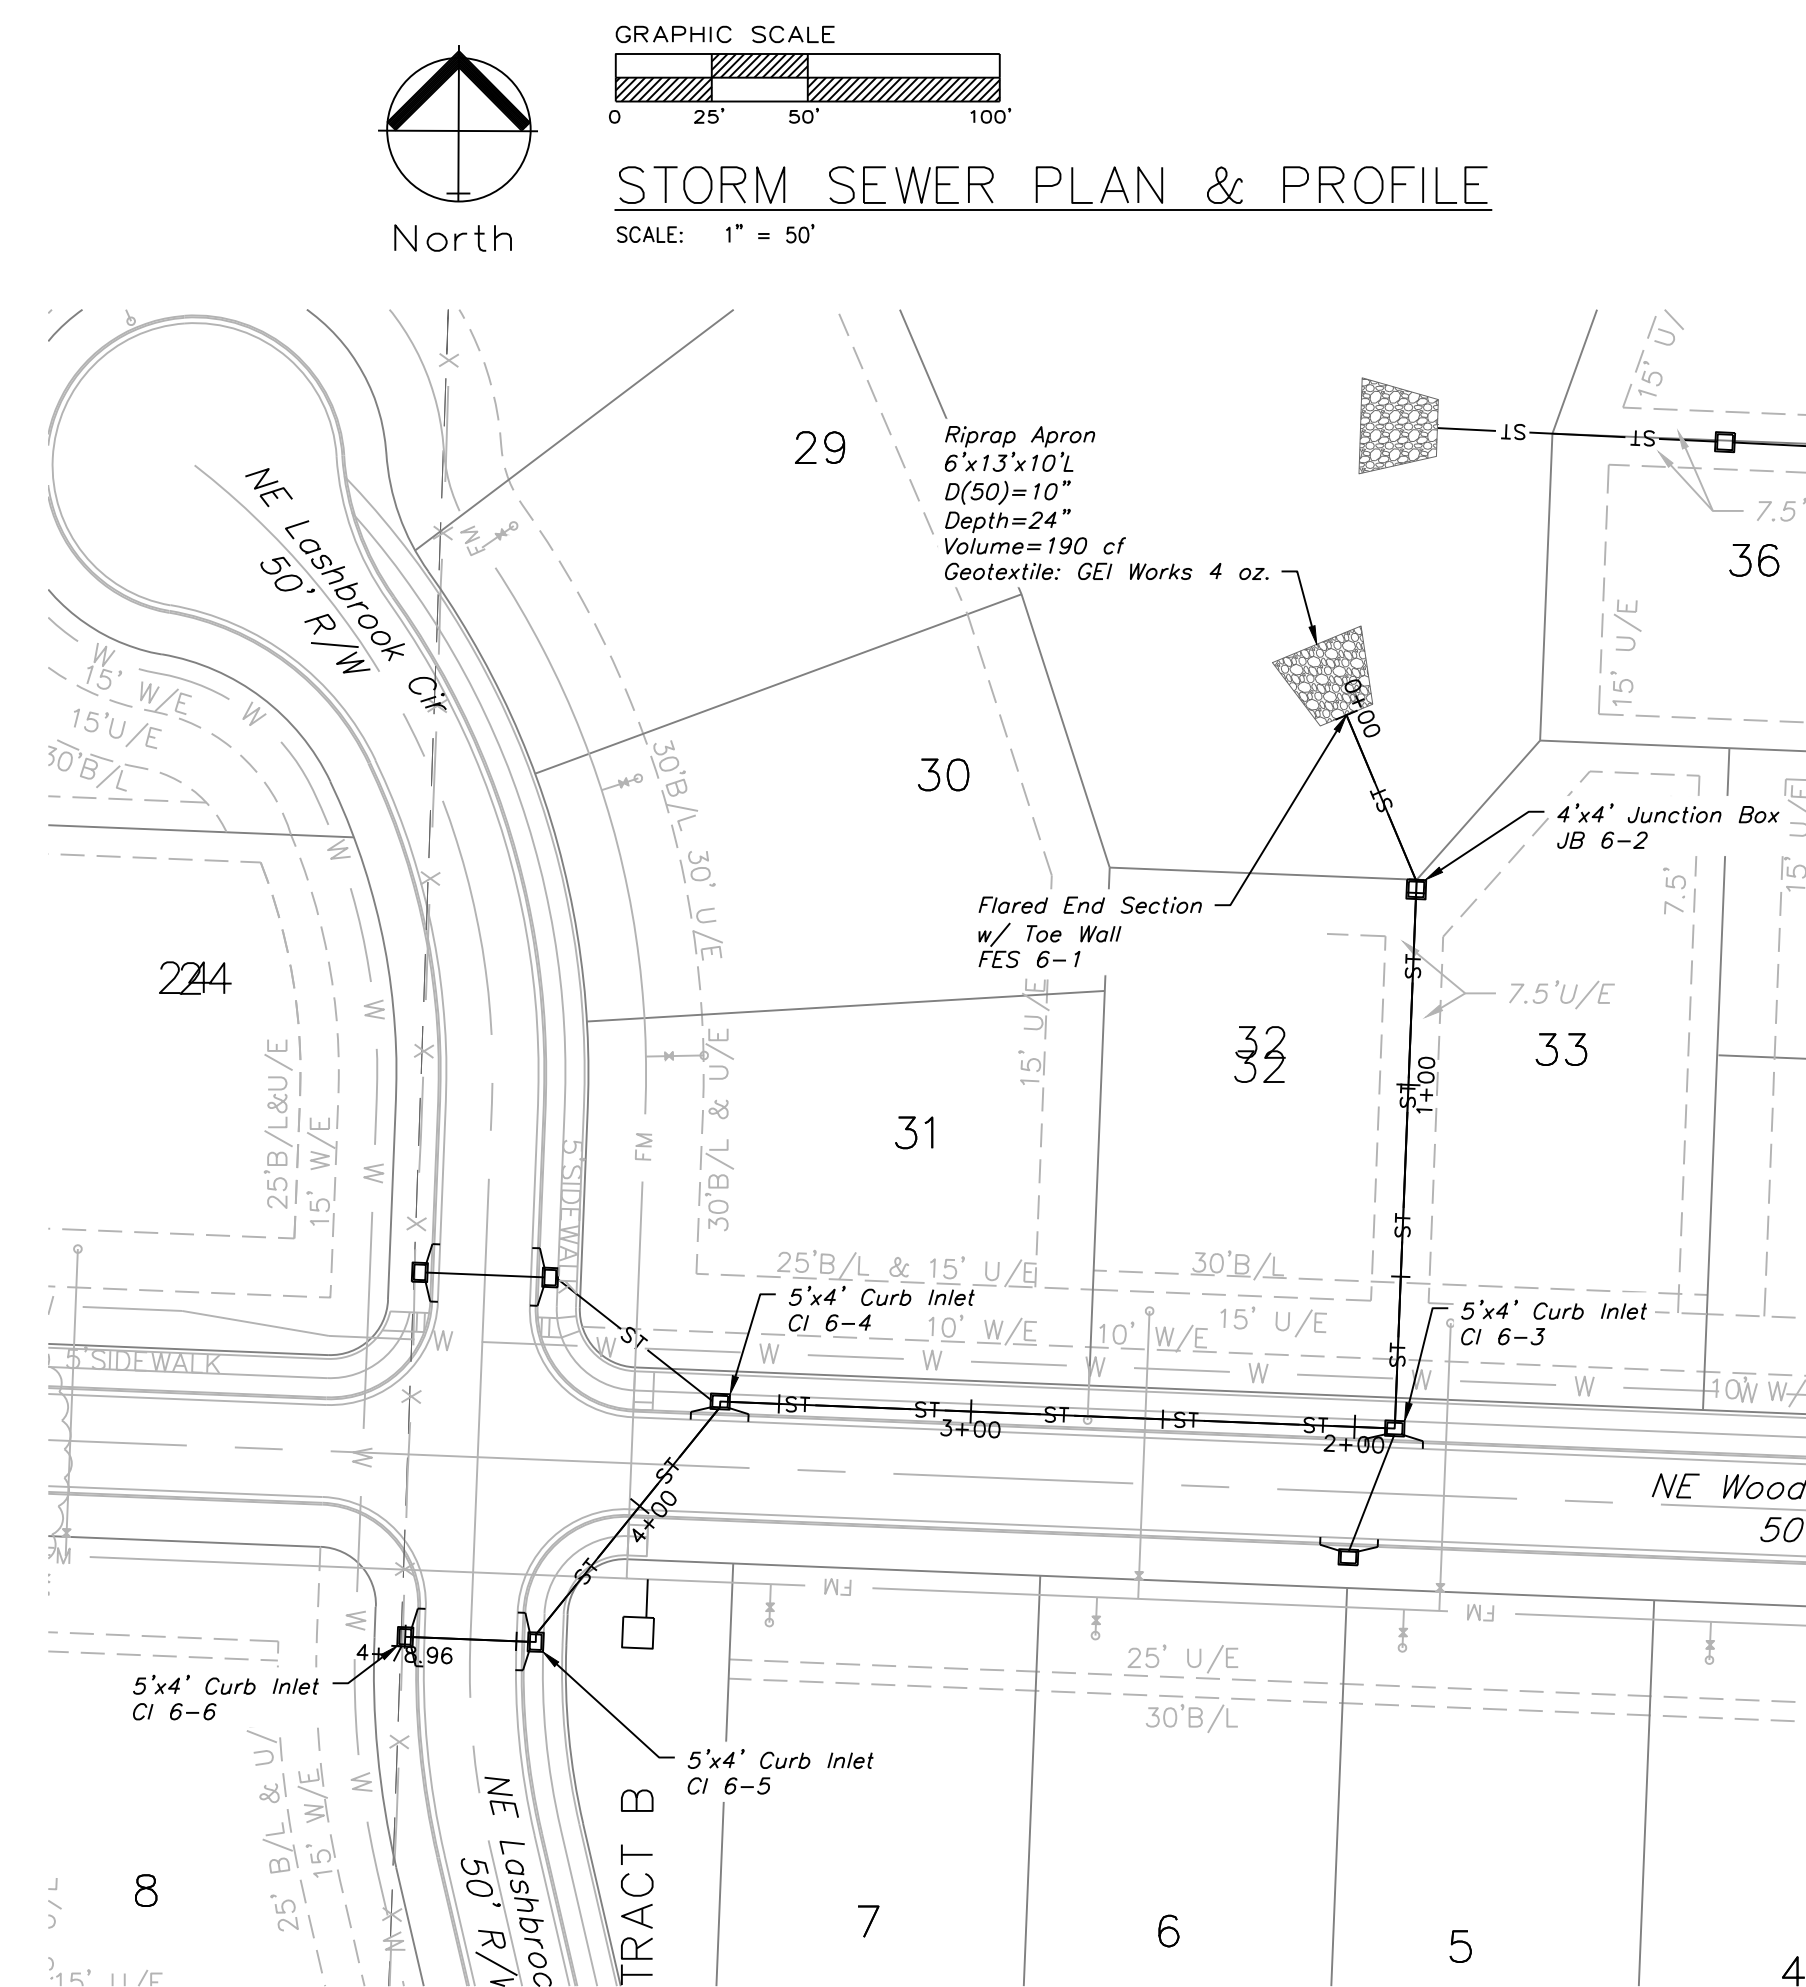

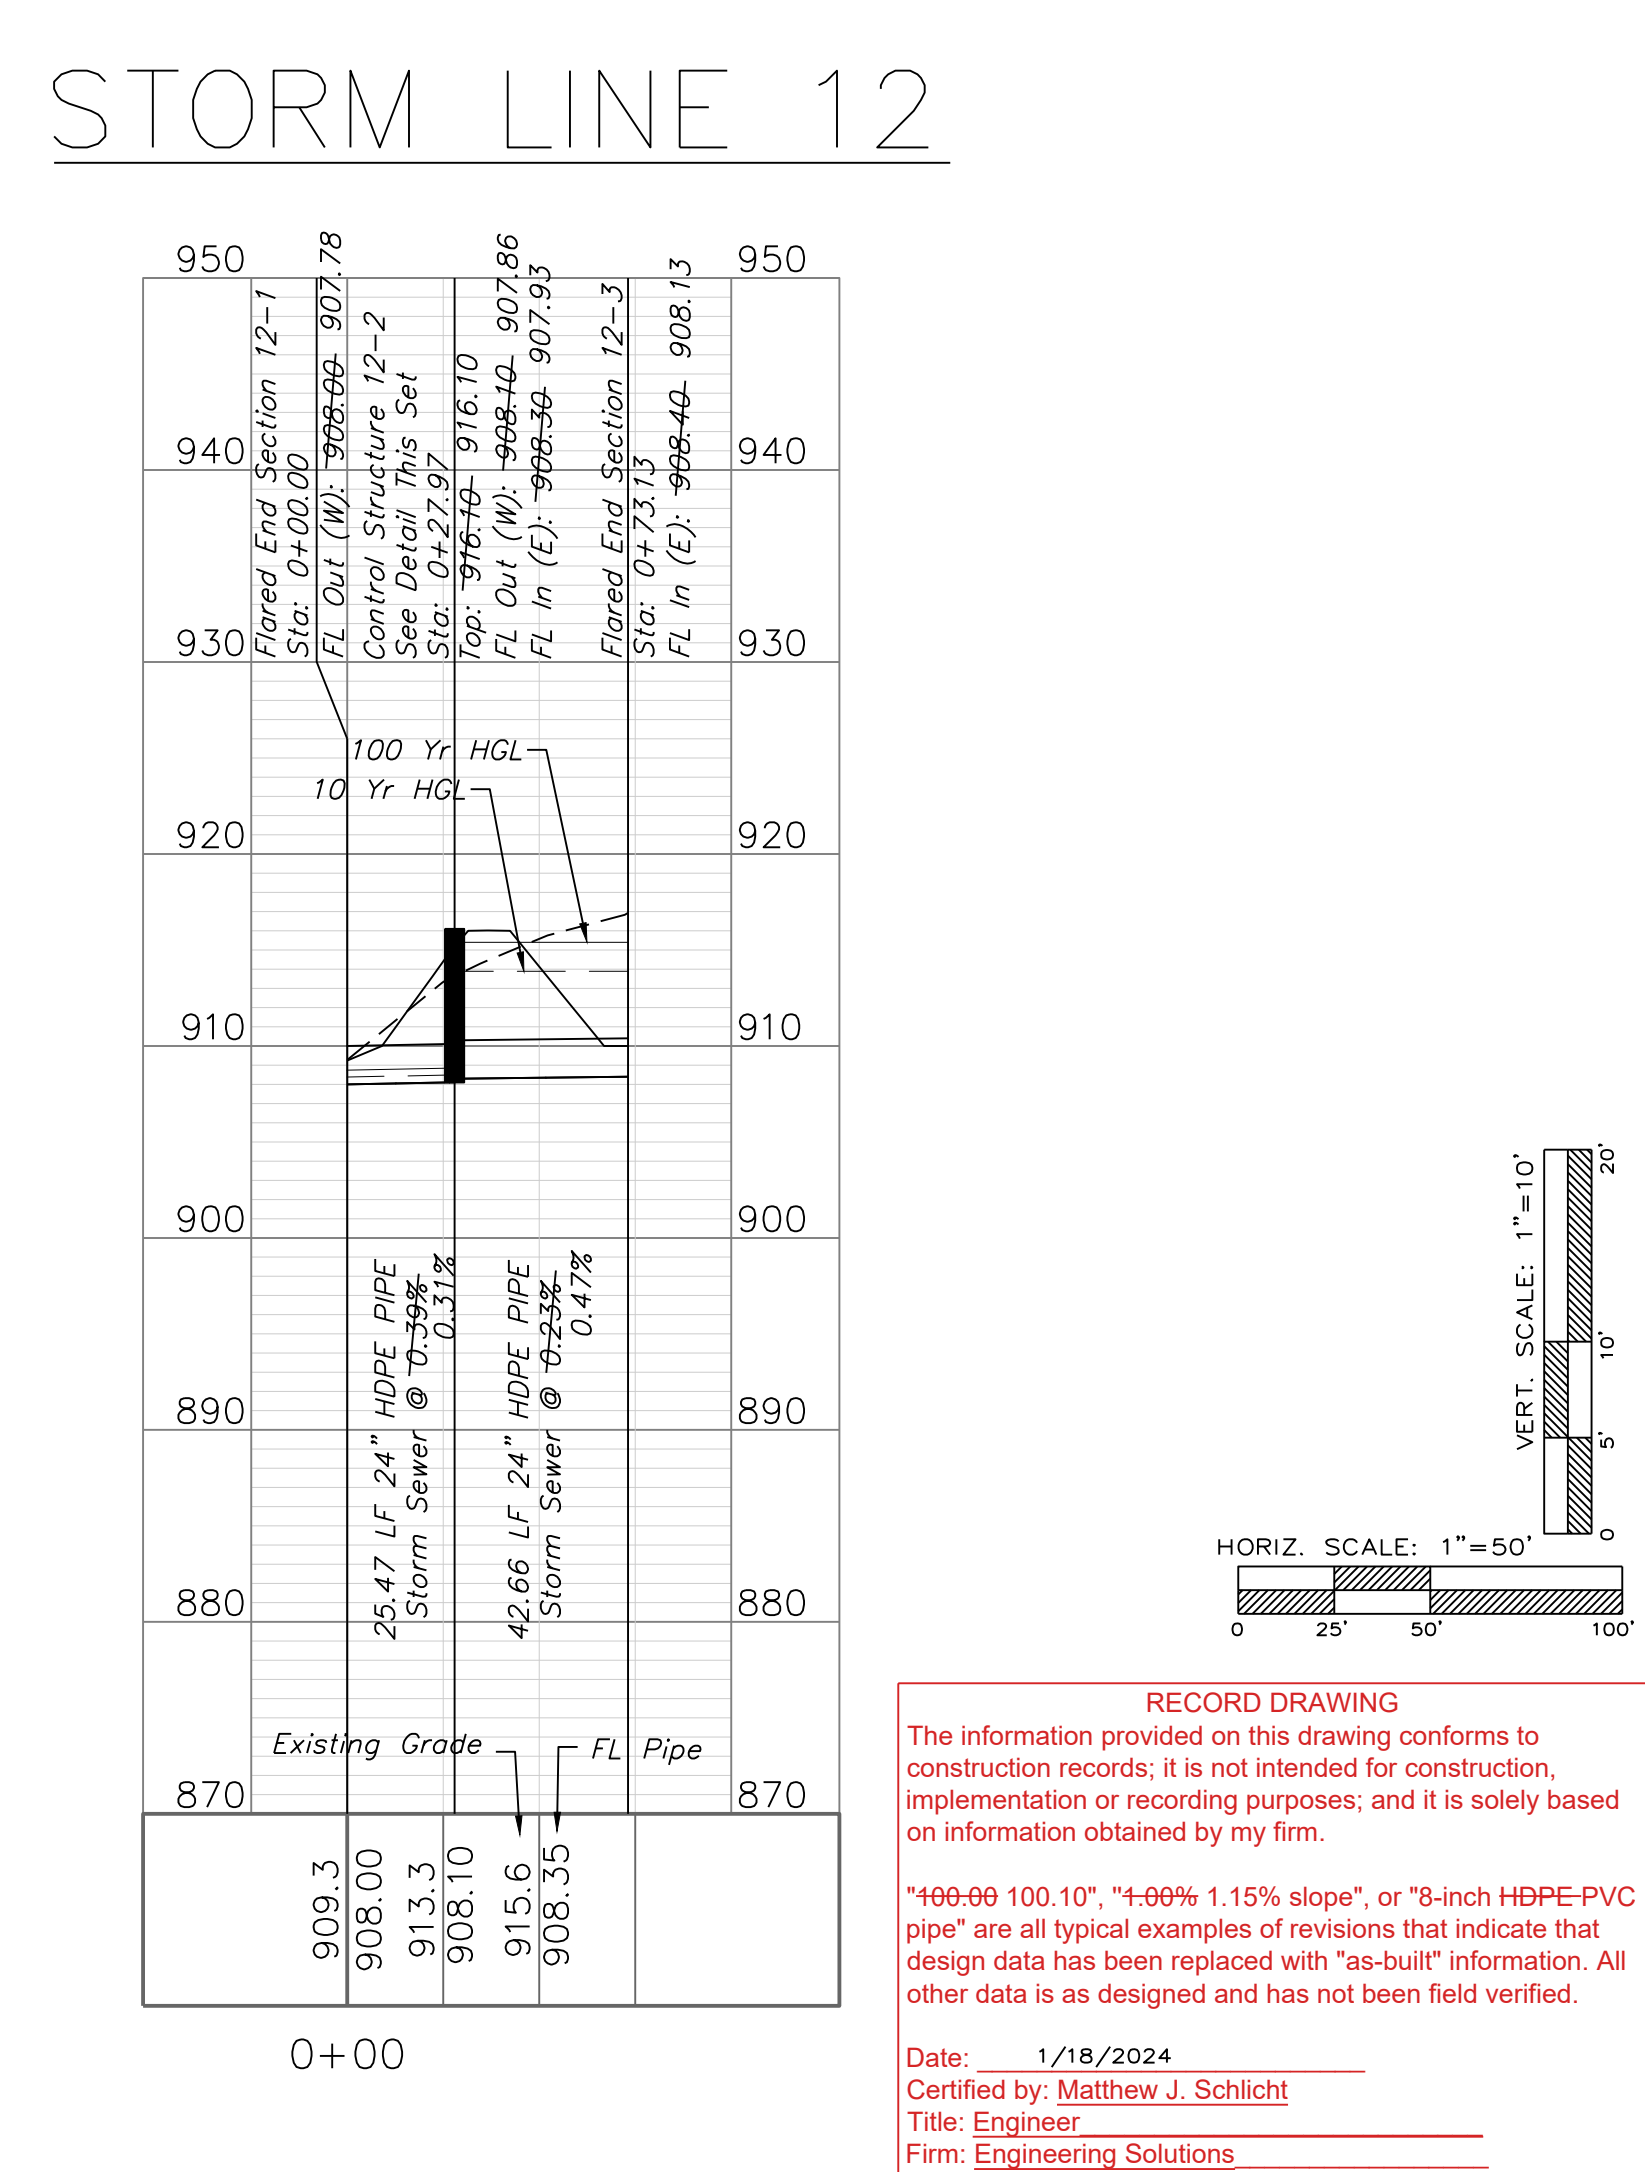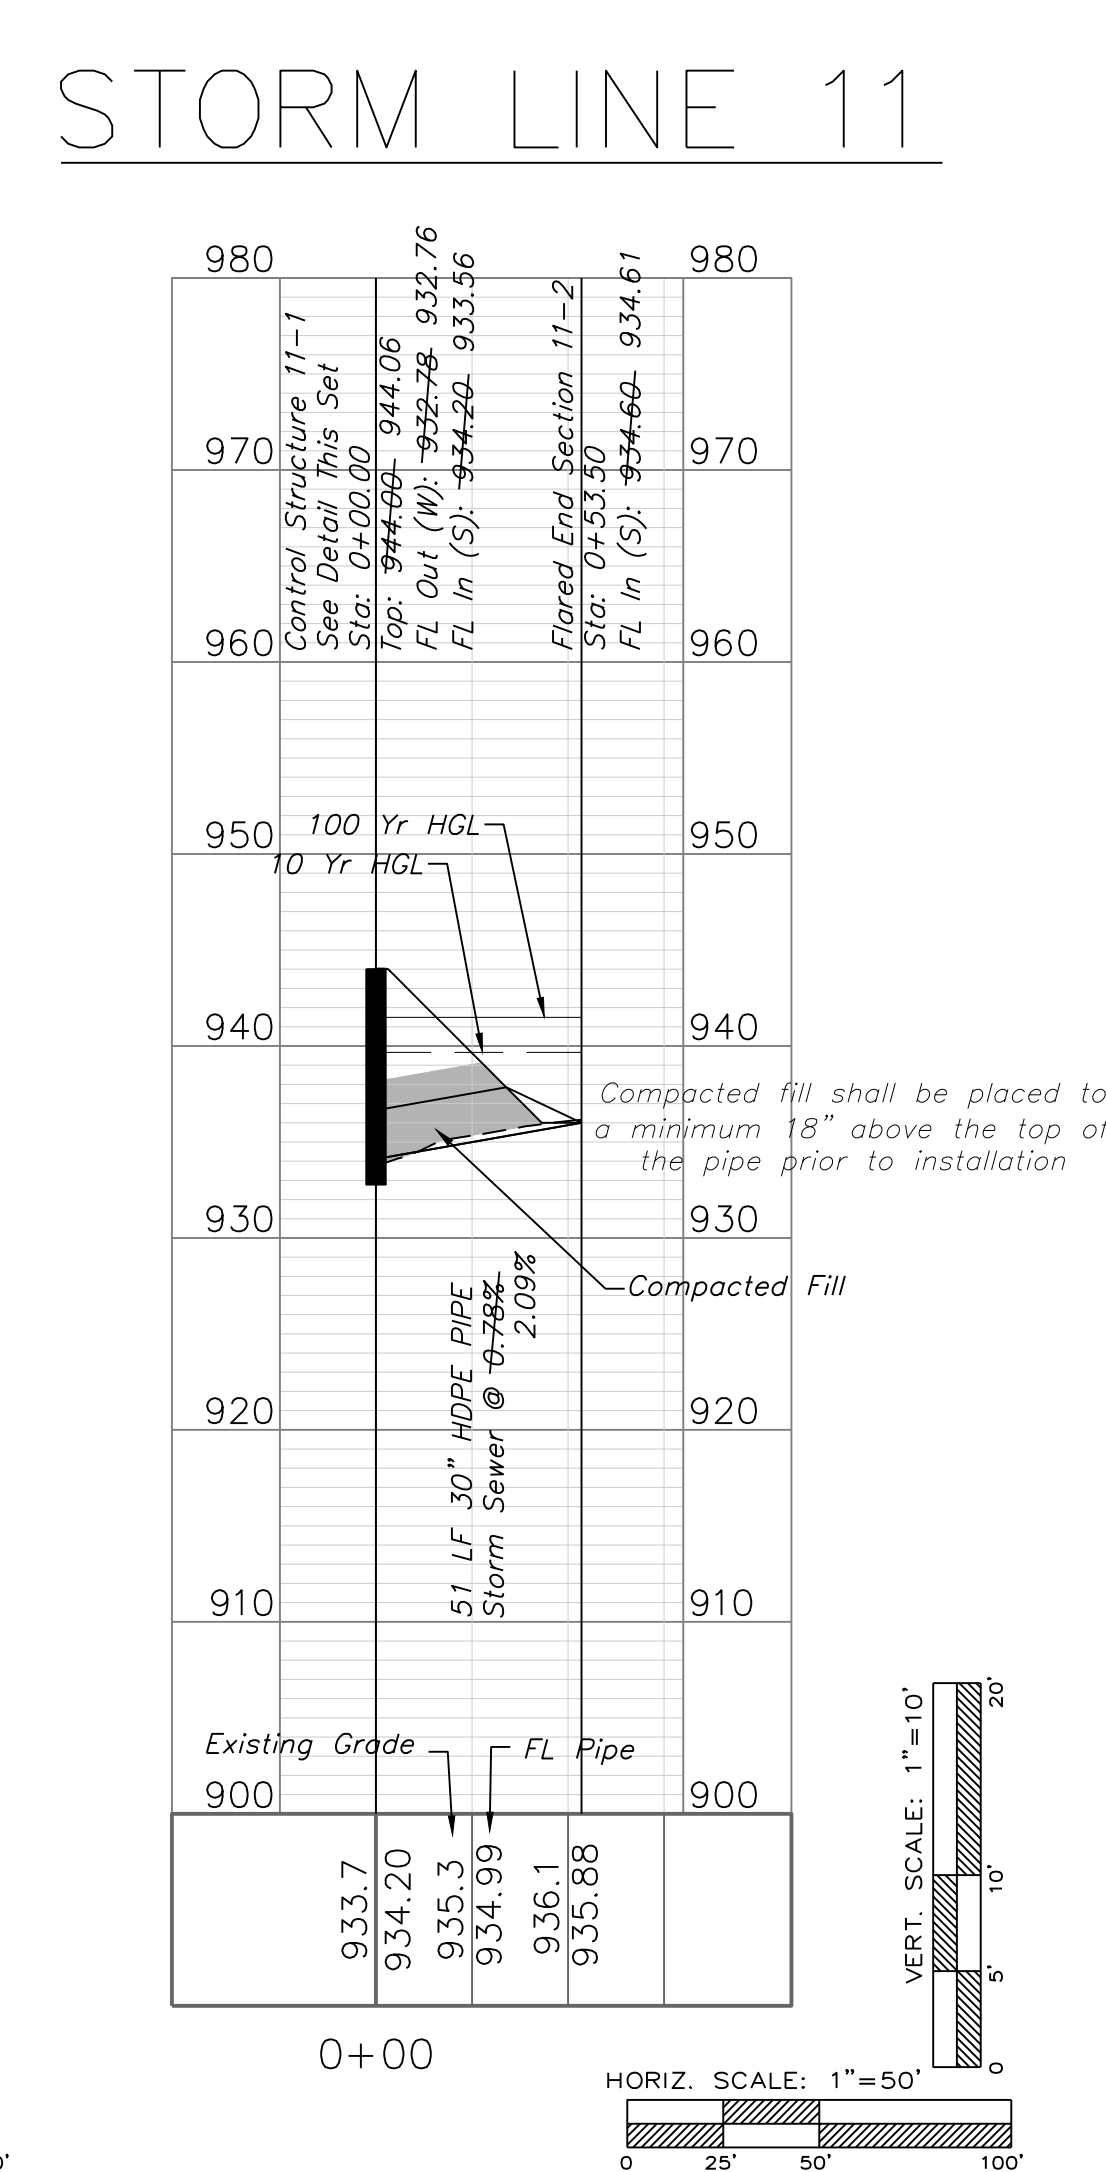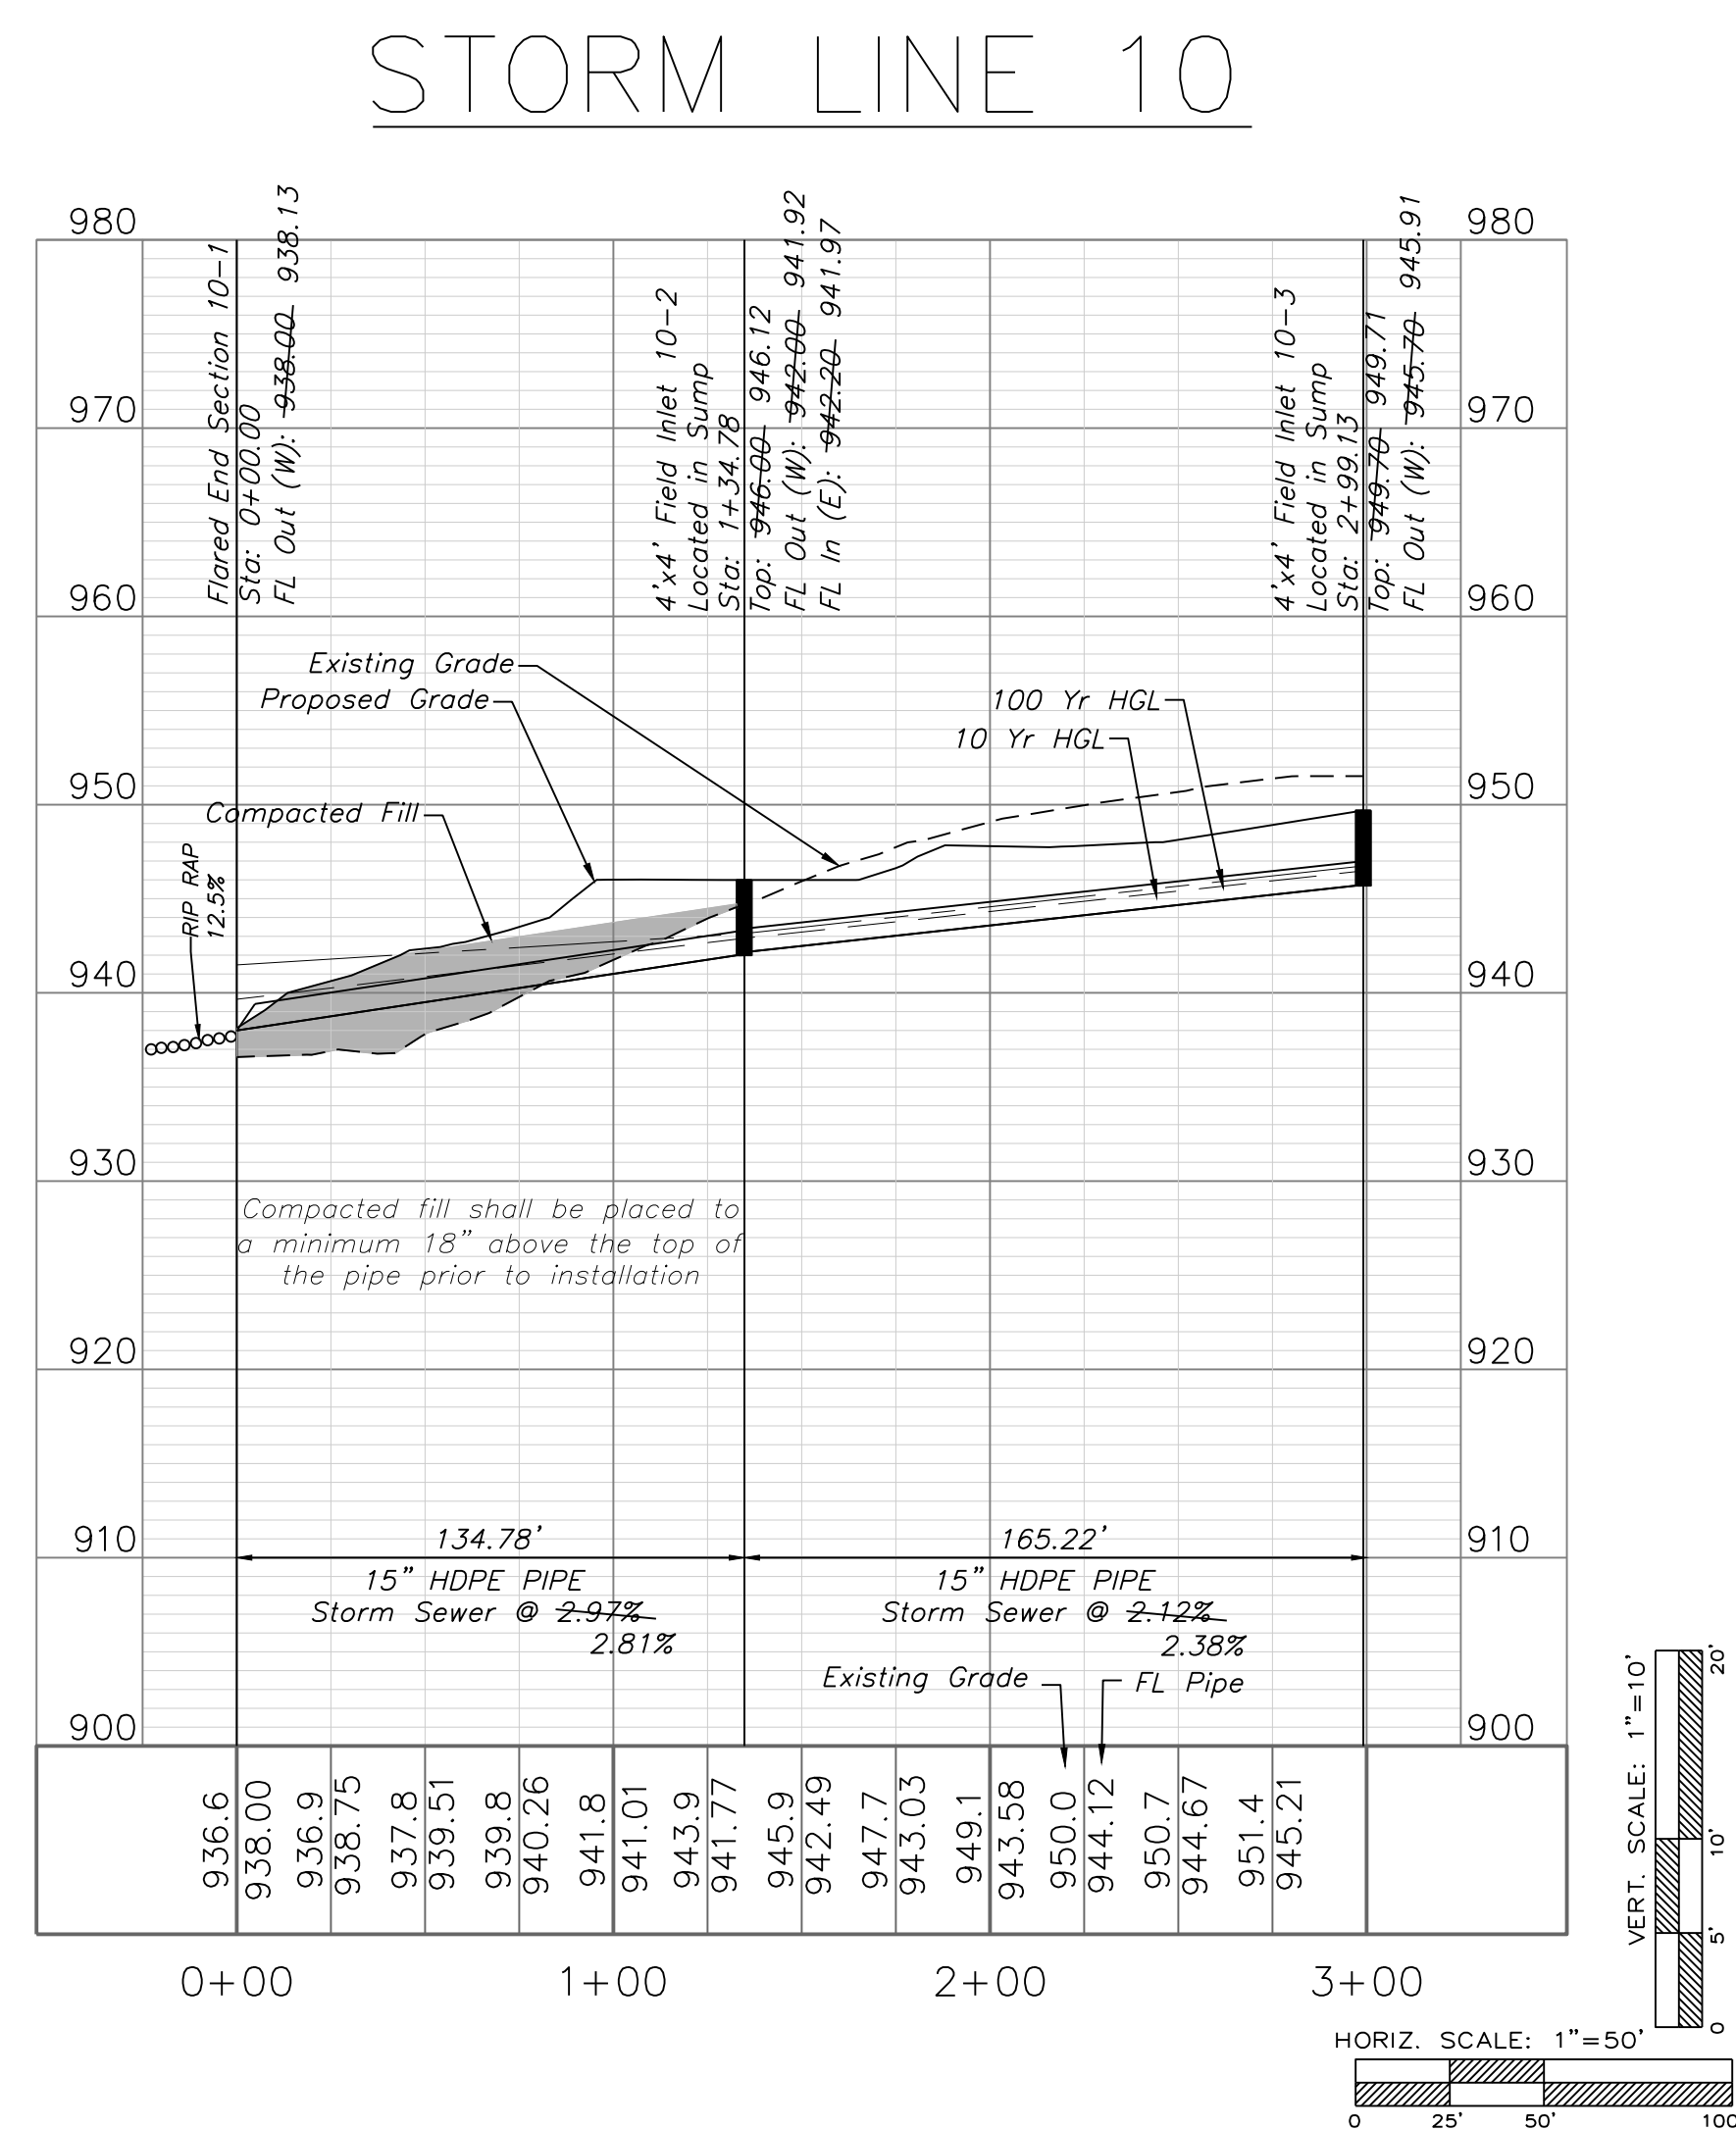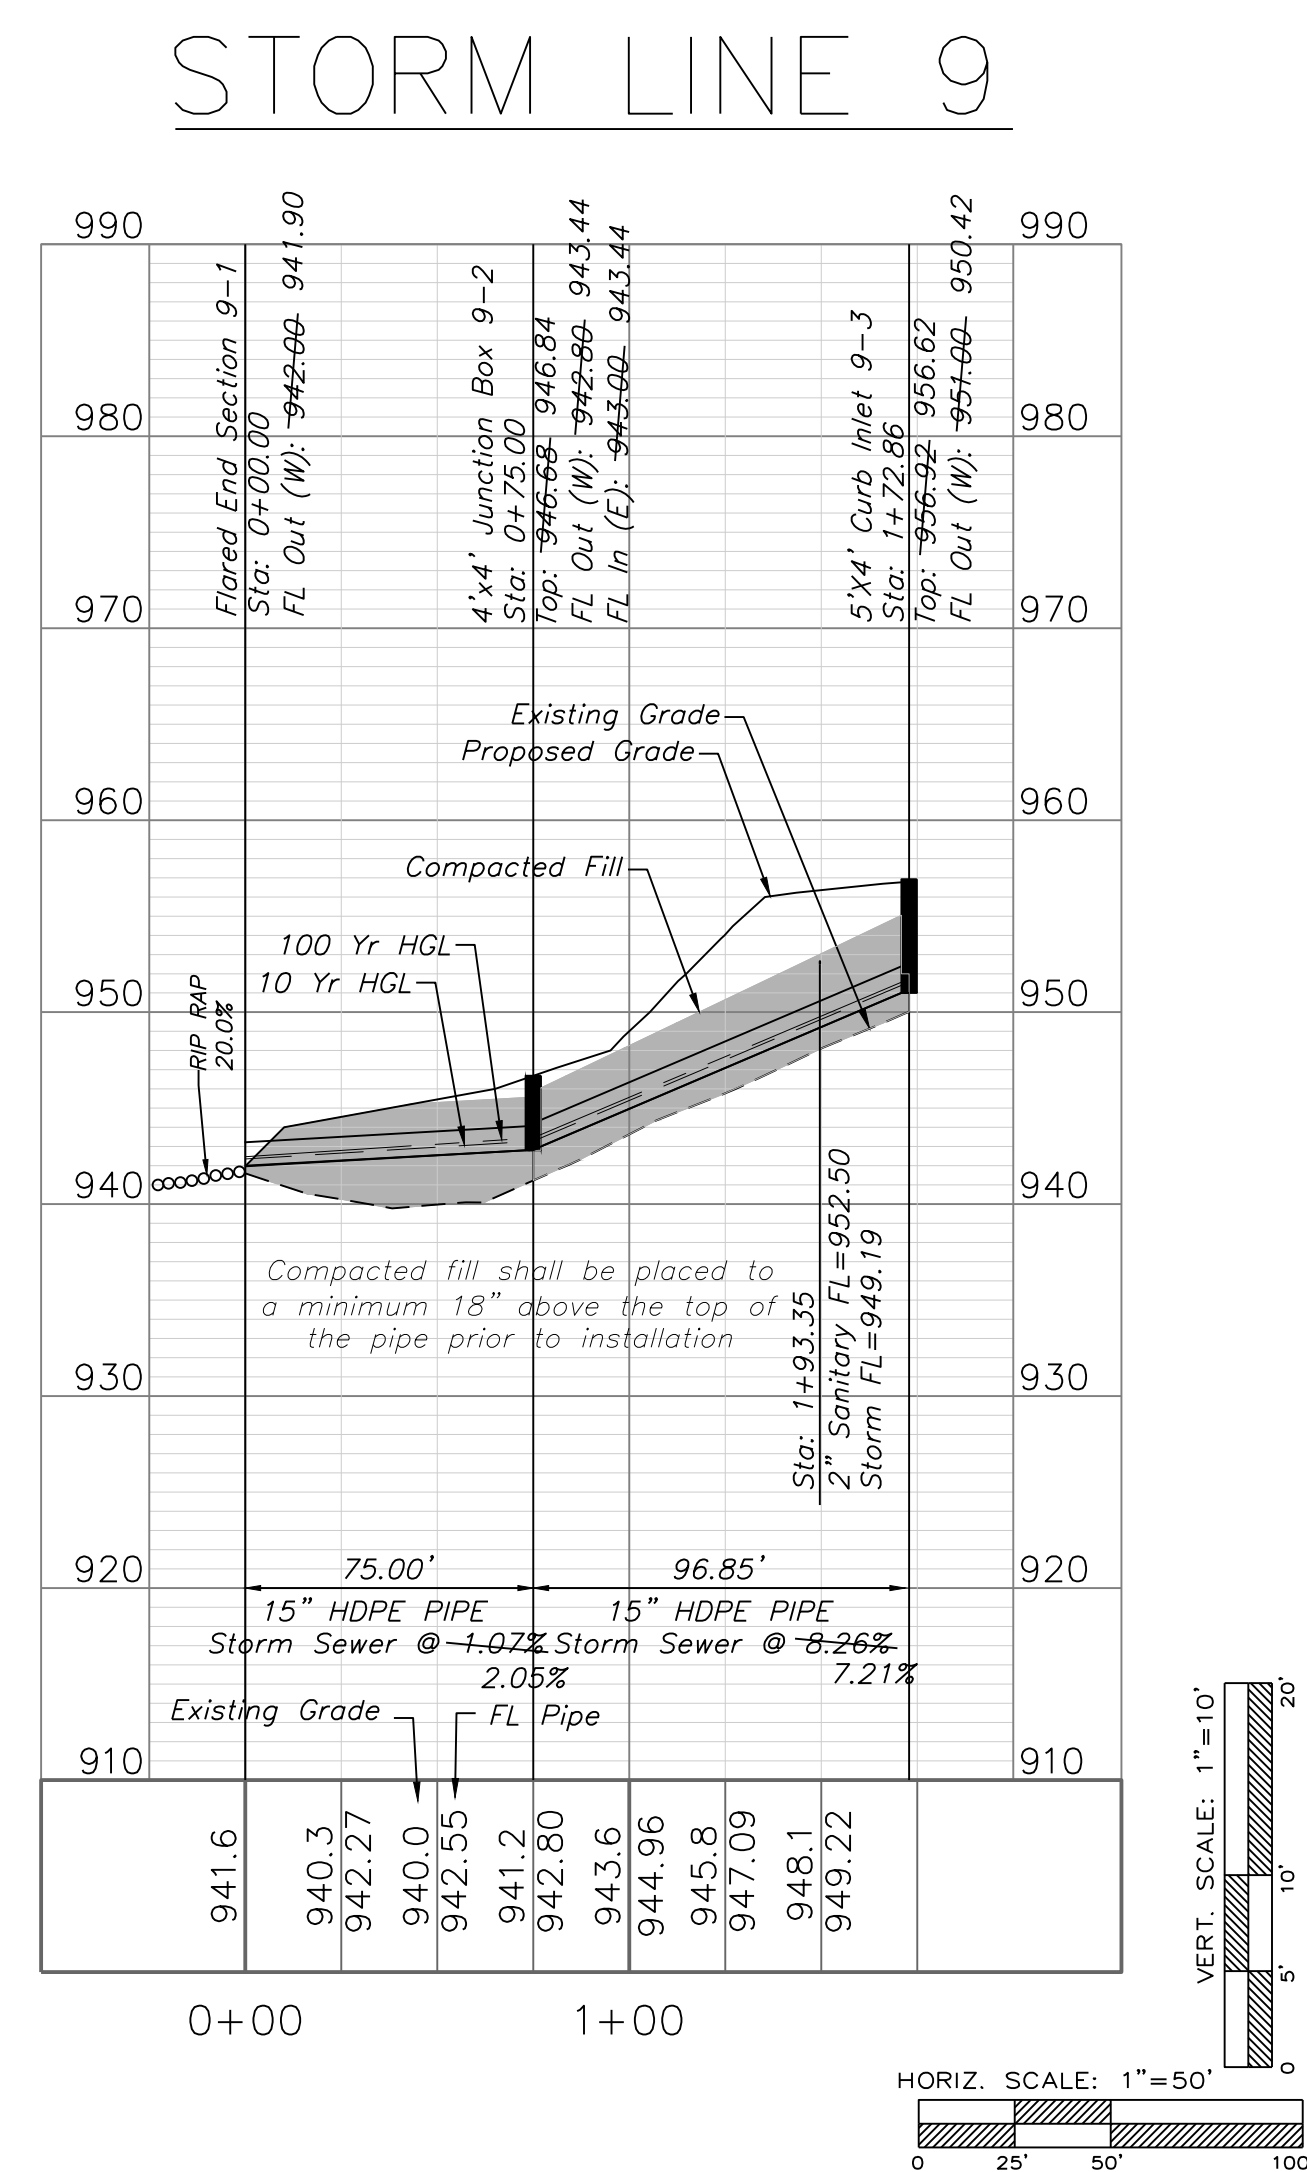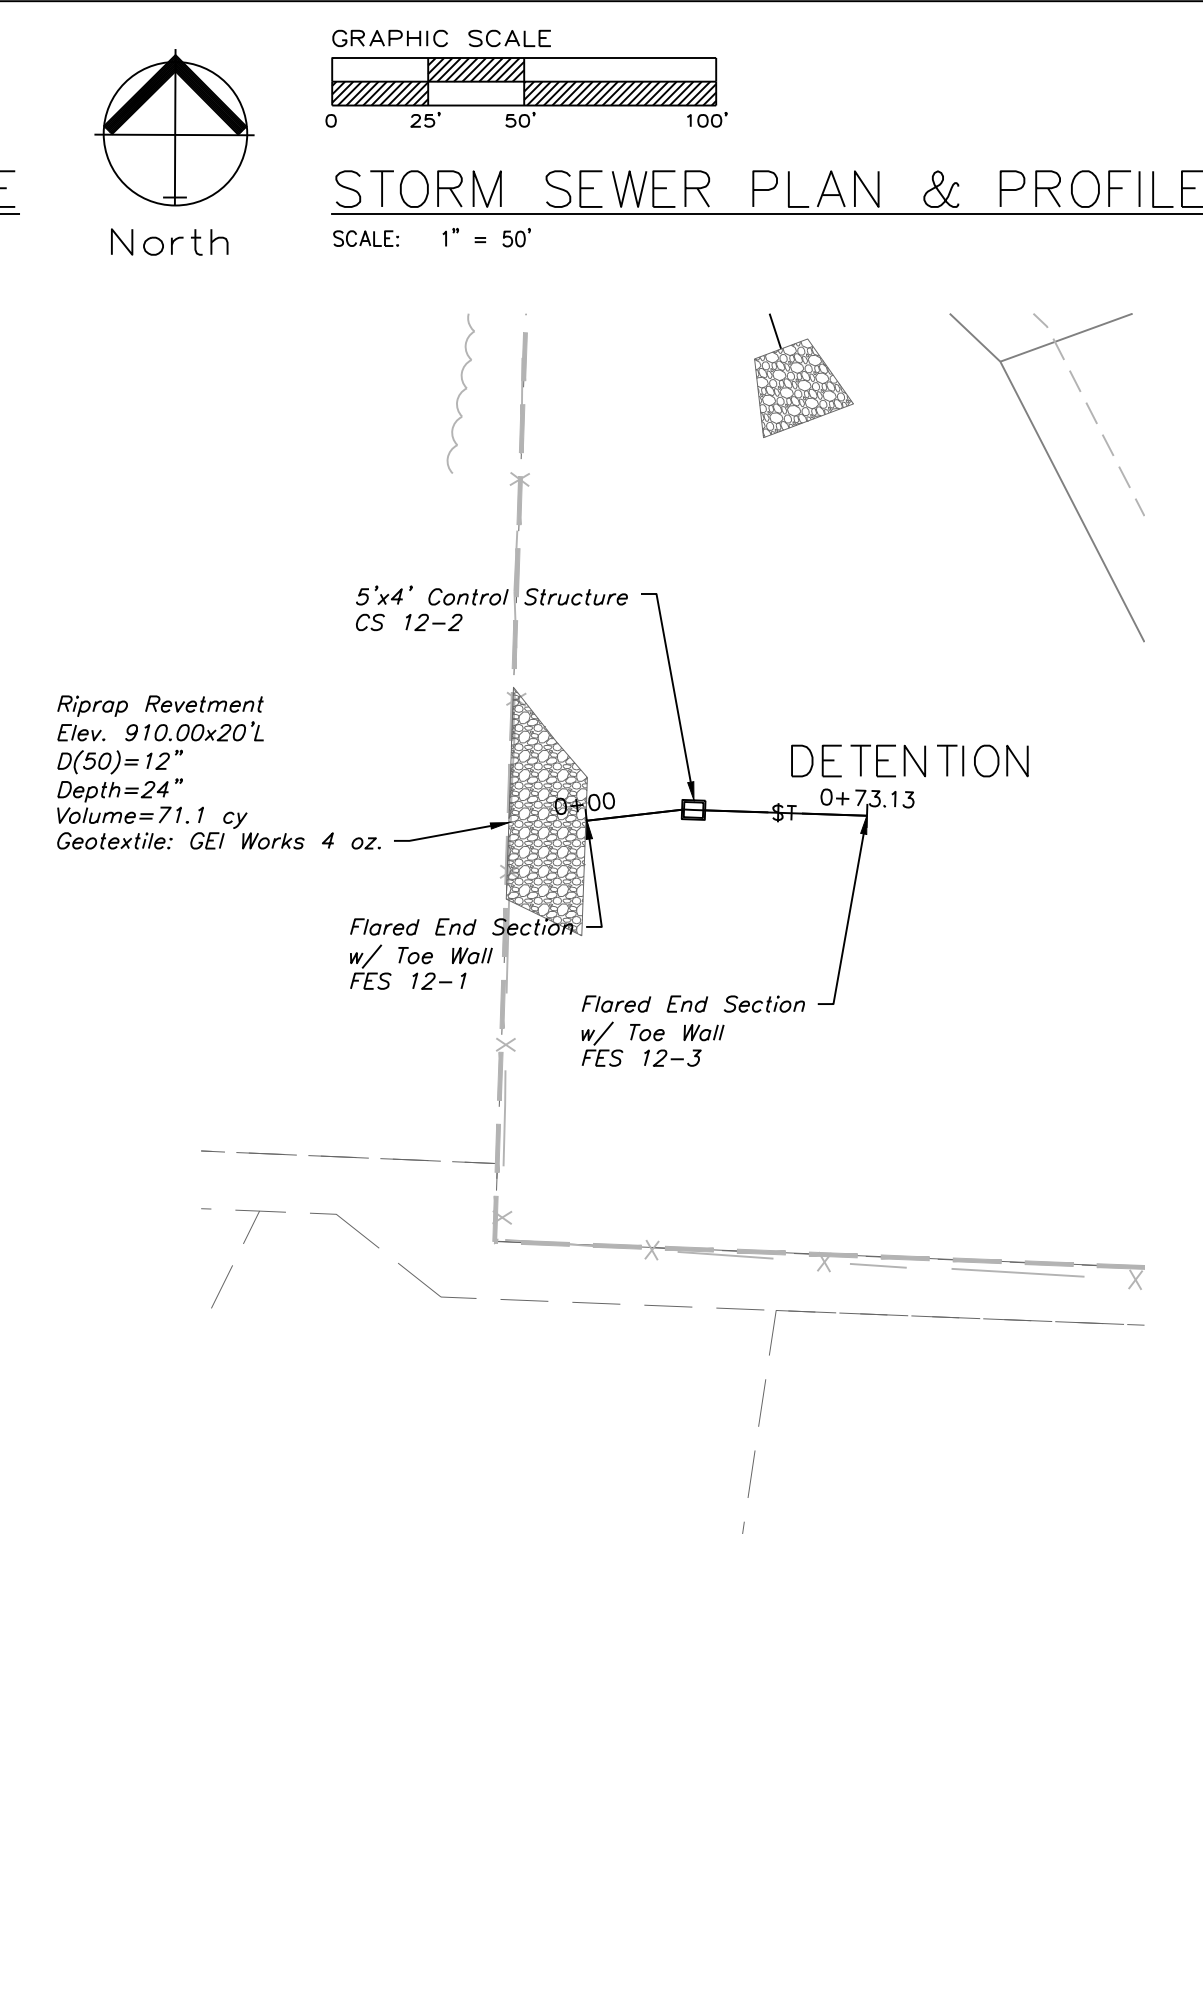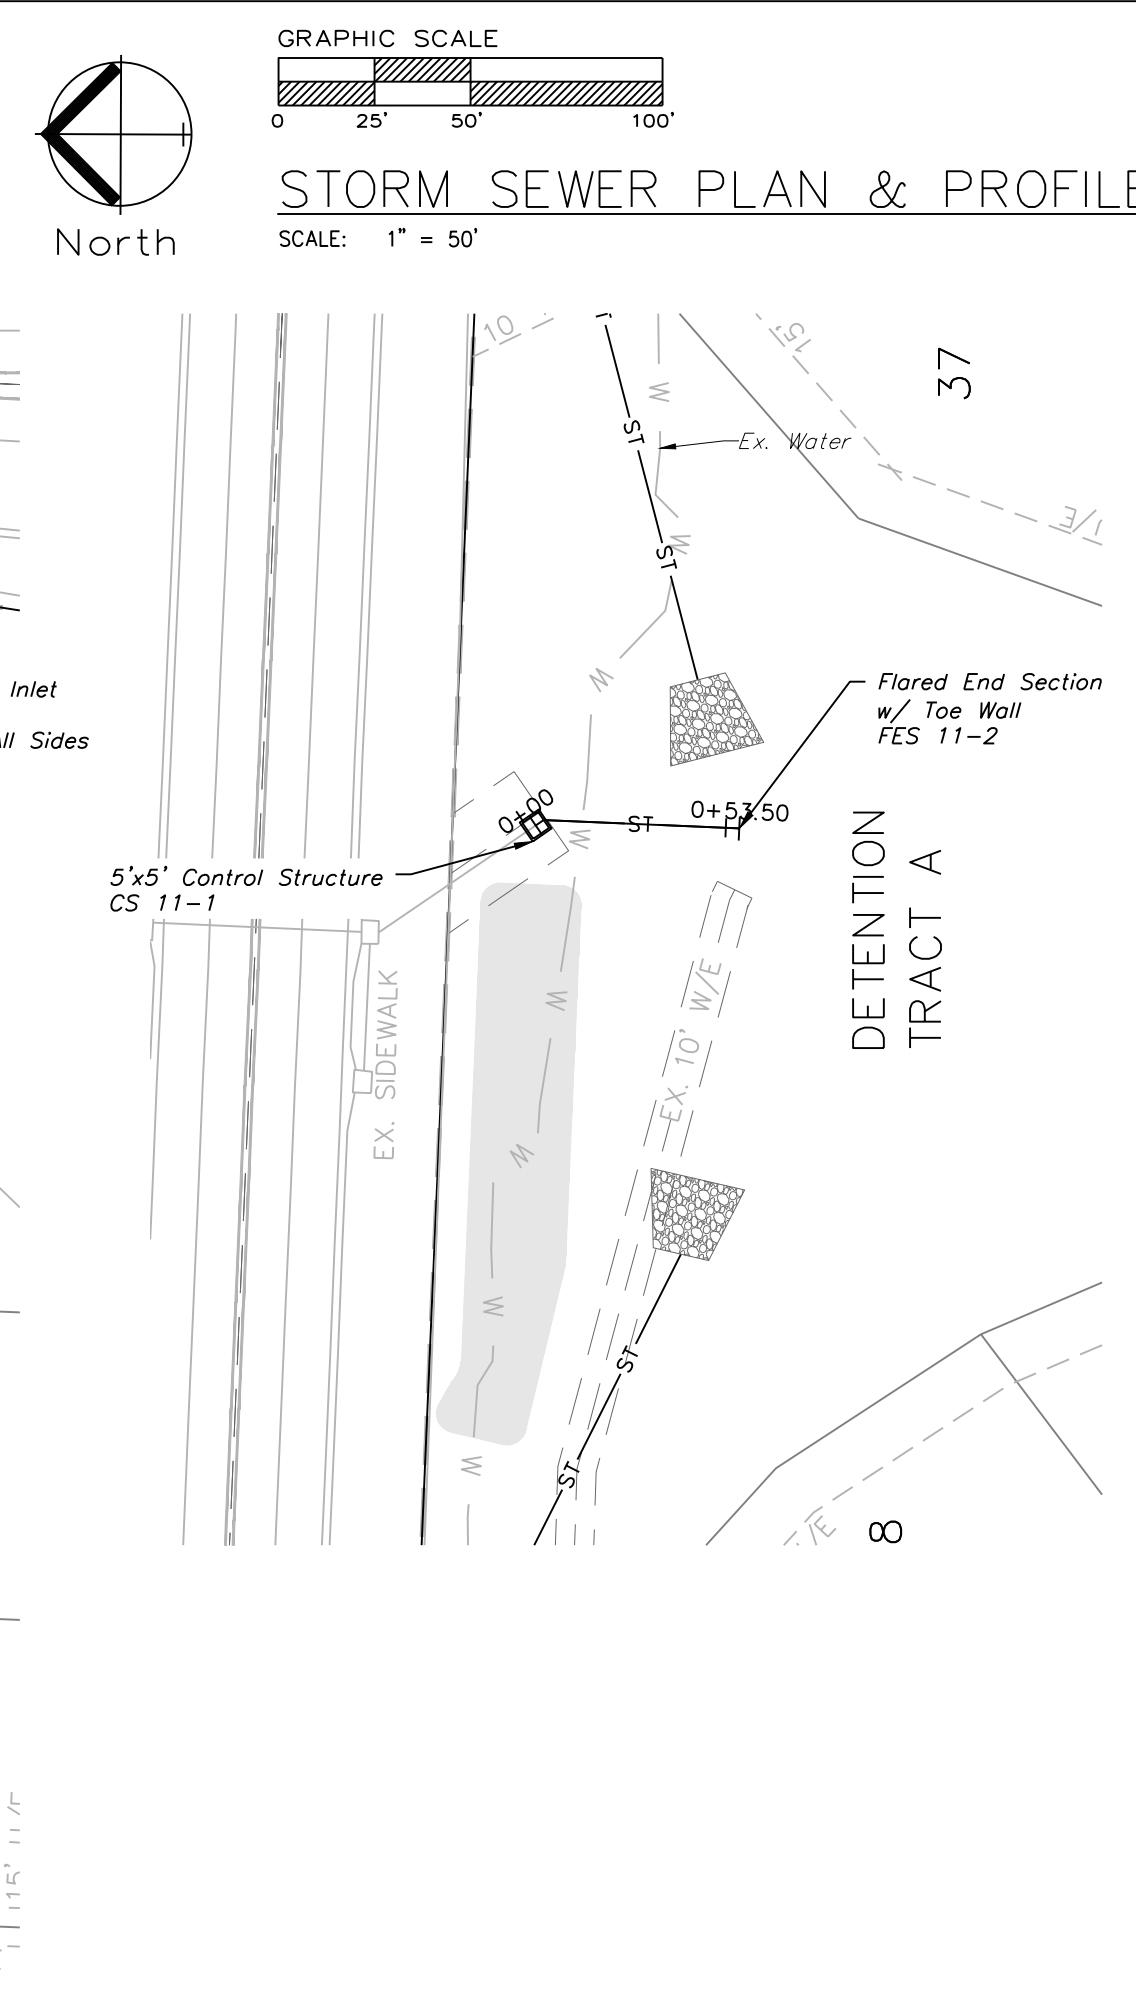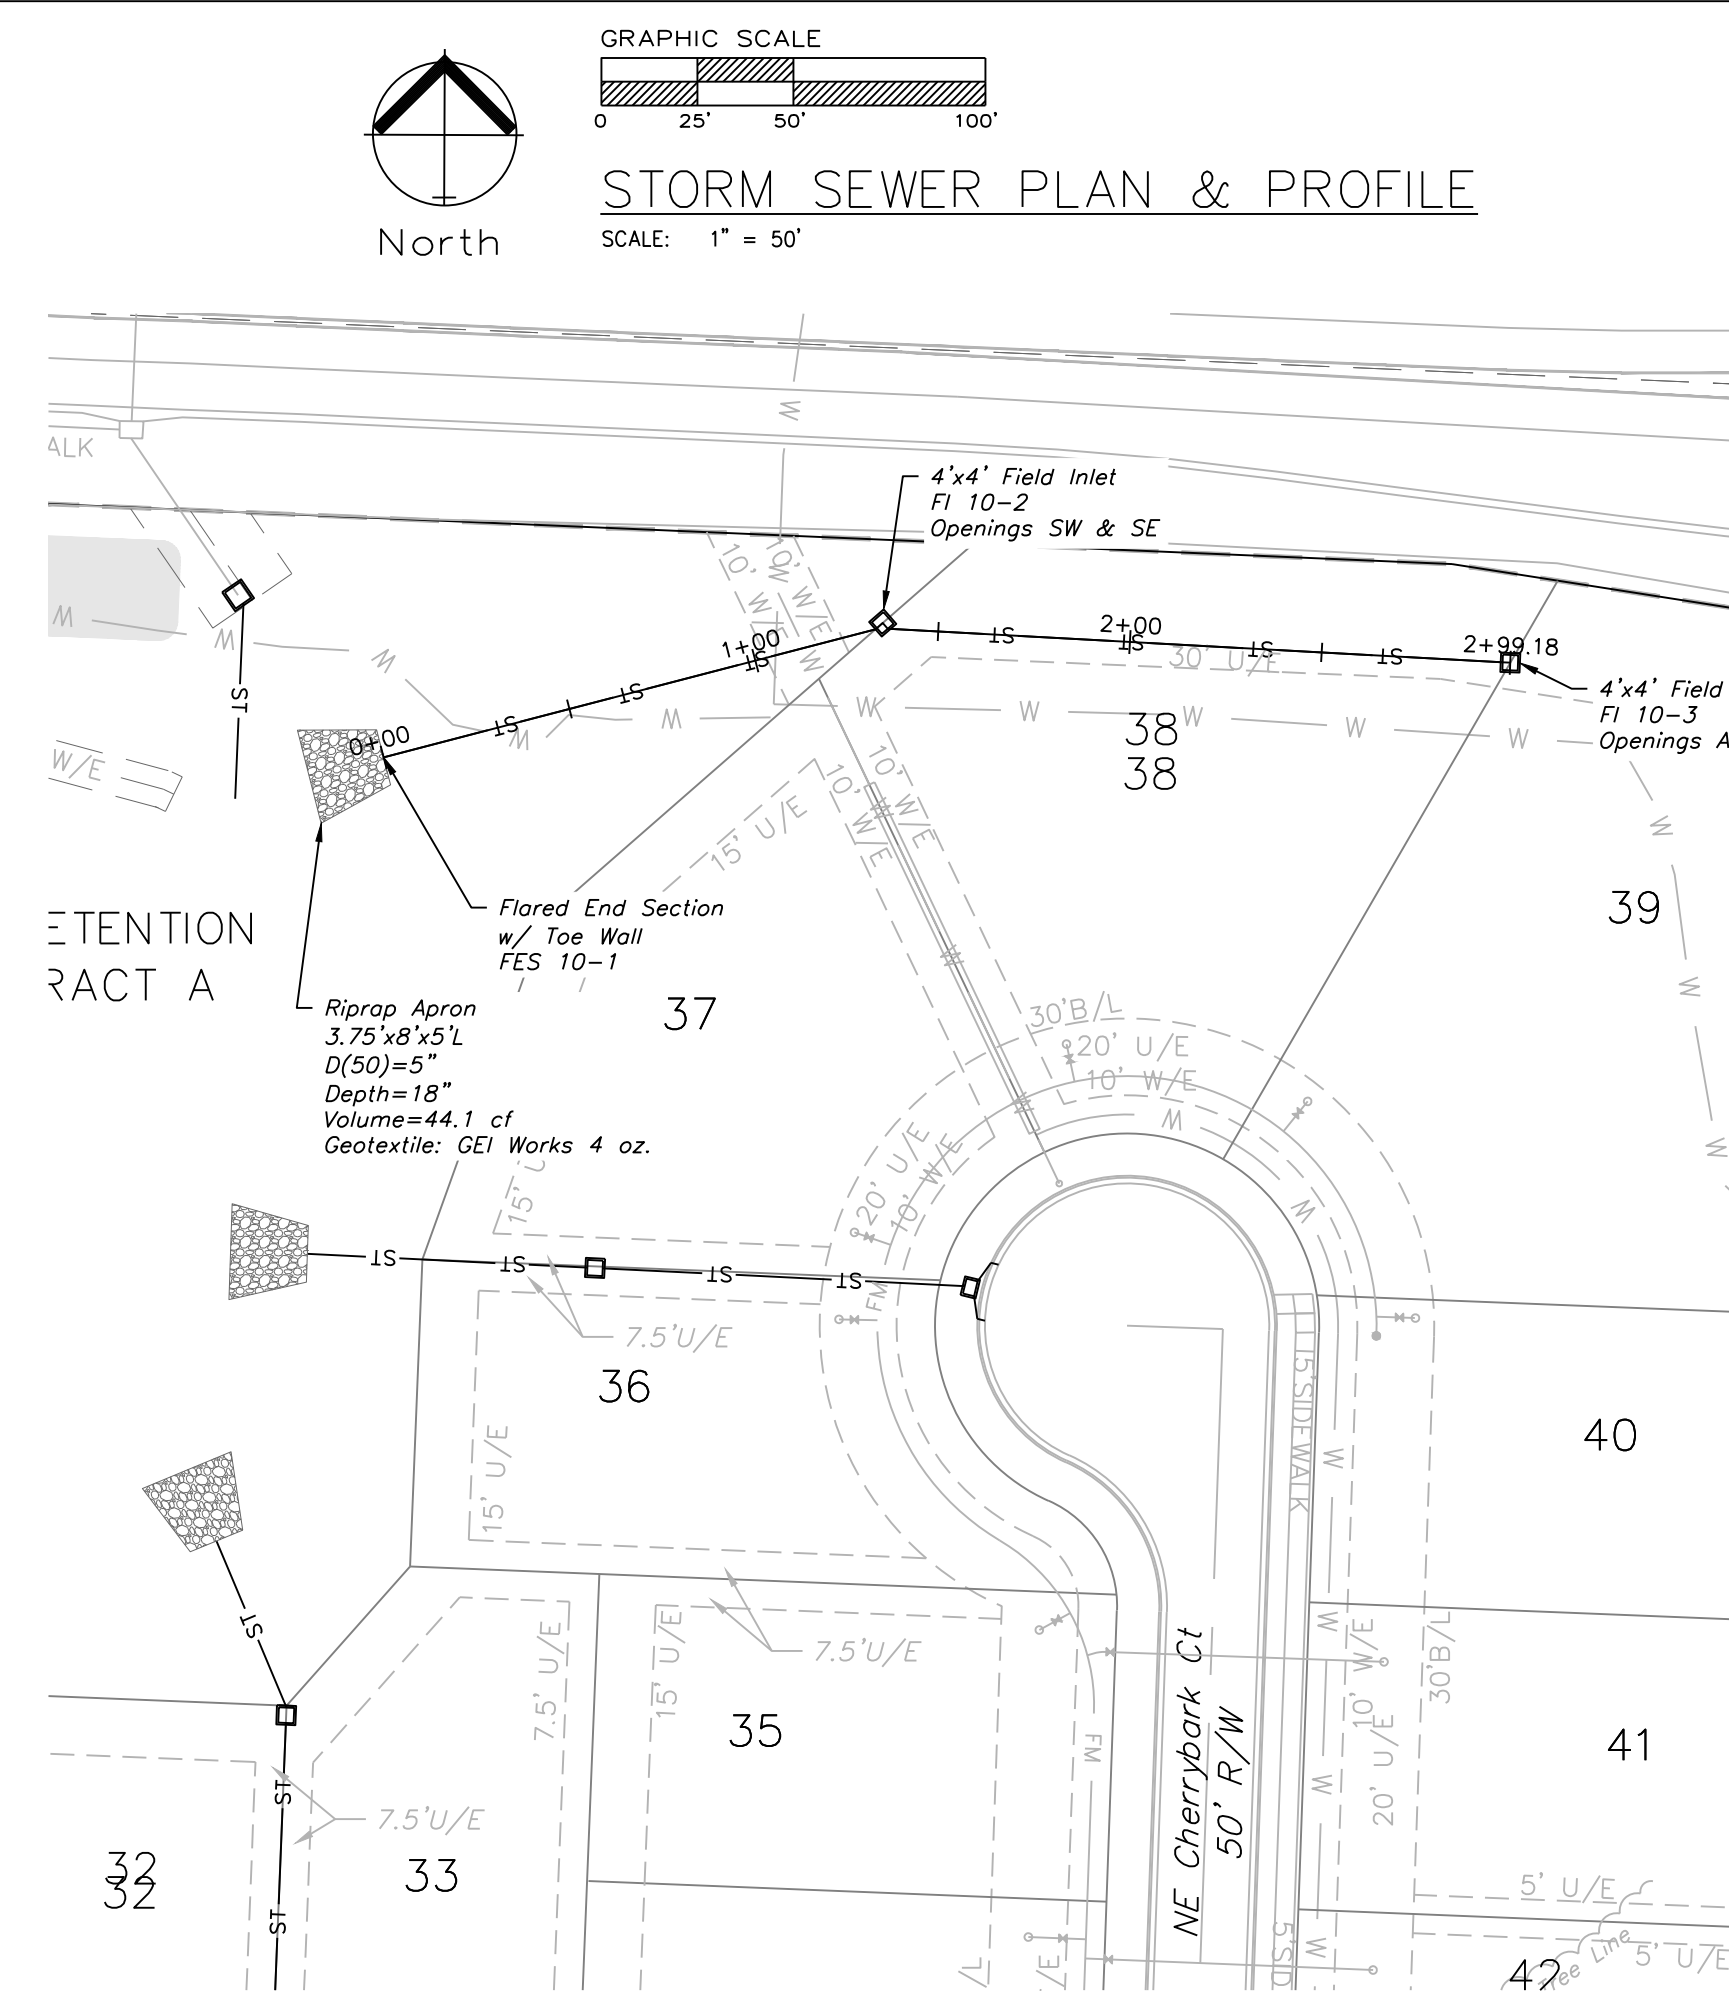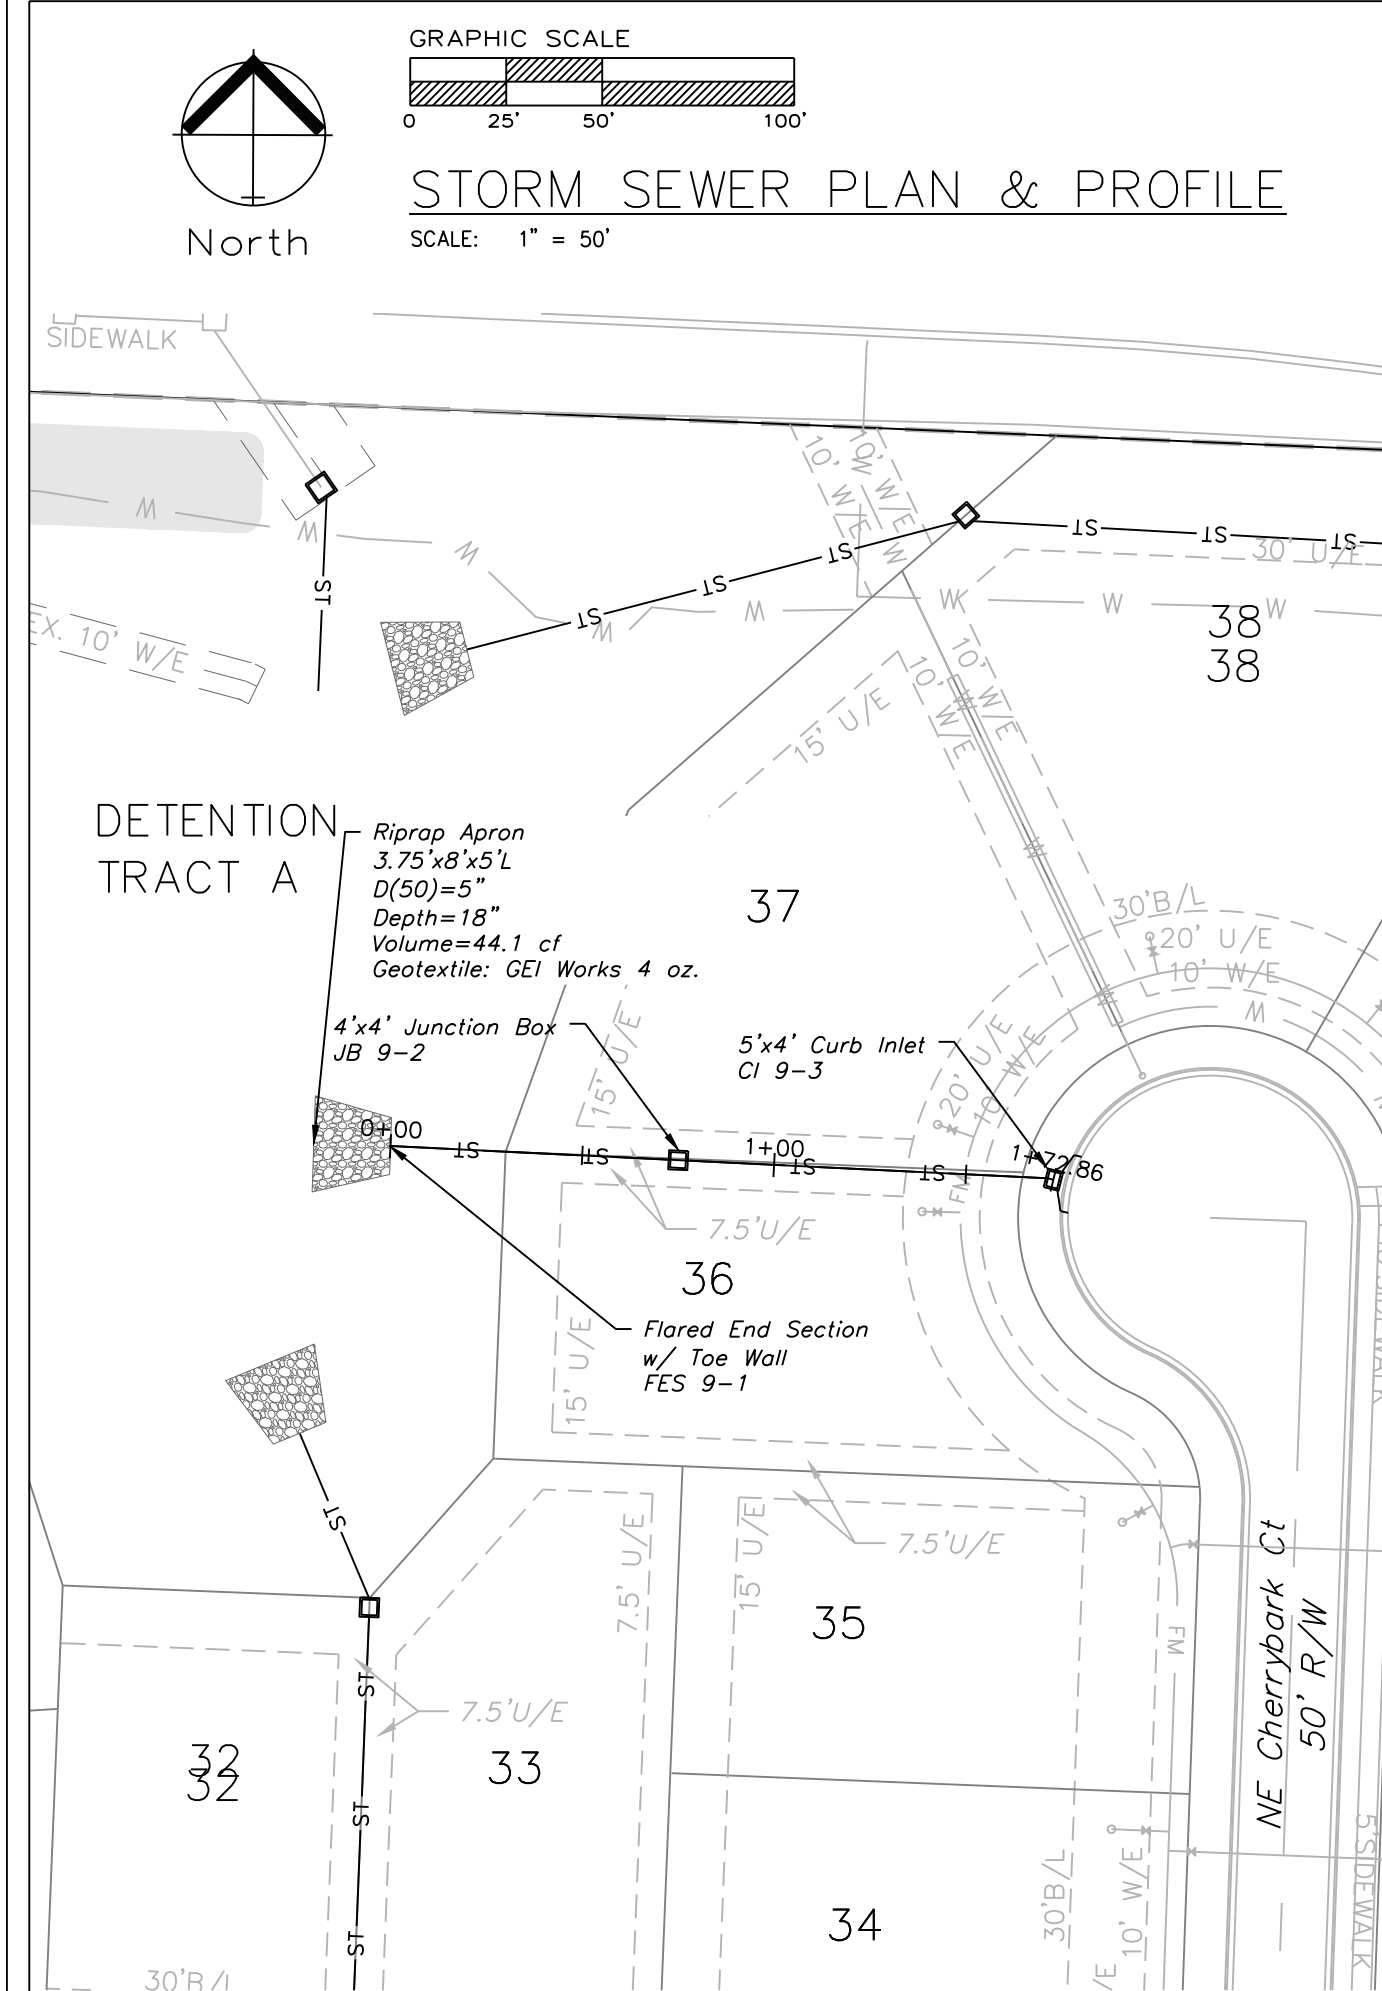

10-YEAR INLET																						
D.S. Str.	Str. No.	Area (ac)	InletTime (min)	Int. (in/hr)	RunoffCoeff. (C)	Q=CIA (cfs)	Q Carry-over (cfs)	QCaptured (cfs)	QBypassed (cfs)	JunctType	CurbHeight (in)	CurbLength (ft)	GutterSlope (ft/ft)	GutterWidth (ft)	CrossSlope, Sw (ft/ft)	CrossSlope, Sx (ft/ft)	InletDepth (ft)	BypassDepth (ft)	BypassSpread (ft)	GutterDepth (ft)	GutterSpread (ft)	Bypass Str.
1-1	1-2	0.77	8.8	6.37	0.51	2.5	0	2.5	0	Dp-Curb	6	8	Sag		0.02	0.02	0.22	n/a	n/a	0.22	11.06	Sag
2-1	2-2	0.28	5.3	7.26	0.51	1.04	0	1.04	0	Dp-Curb	6	8	Sag		0.02	0.02	0.12	n/a	n/a	0.12	6.15	Sag
2-2	2-3	0.12	5.9	7.08	0.51	0.43	0.12	0.3	0.26	Curb	10	5	0.038	2	0.05	0.02	0.12	0.09	1.77	0.12	2.87	2-6
2-3	2-4	0.6	6.2	7	0.51	2.14	1.91	0.89	3.16	Curb	10	5	0.038	2	0.05	0.02	0.22	0.21	7.35	0.22	8.19	2-5
2-4	2-5R	0.4	6.4	6.95	0.51	1.42	3.16	4.58	0	Curb	10	5	Sag	2	0.05	0.02	0.44	n/a	n/a	0.44	18.84	Sag
2-4	2-5L	0.55	8.1	6.53	0.51	1.83	0	1.83	0	Curb	10	5	Sag	2	0.05	0.02	0.26	n/a	n/a	0.26	10.22	Sag
2-5	2-6R	0.16	6.5	6.92	0.51	0.56	0.26	0.82	0	Curb	10	5	Sag	2	0.05	0.02	0.18	n/a	n/a	0.18	6.01	Sag
2-5	2-6L	0.08	6.2	7	0.51	0.29	0	0.29	0	Curb	10	5	Sag	2	0.05	0.02	0.12	n/a	n/a	0.12	2.96	Sag
2-4	3-1	0.19	8.8	6.37	0.51	0.62	0	0.62	0	Dp-Curb	6	4	Sag		0.02	0.02	0.14	n/a	n/a	0.14	6.91	Sag
2-2	4-1	0.54	6.8	6.84	0.51	1.88	0	1.88	0	Dp-Curb	6	4	Sag		0.02	0.02	0.29	n/a	n/a	0.29	14.55	Sag
4-1	4-2	0.32	7.6	6.65	0.51	1.08	0	1.08	0	Dp-Curb	6	4	Sag		0.02	0.02	0.2	n/a	n/a	0.2	10.06	Sag
4-2	4-3	0.08	5.6	7.17	0.51	0.29	0.03	0.19	0.12	Curb	10	5	0.05	2	0.05	0.02	0.09	0.06	1.27	0.09	1.81	2-3
4-3	4-4	0.37	7	6.79	0.51	1.28	1.28	0.66	1.91	Curb	10	5	0.05	2	0.05	0.02	0.19	0.17	5.45	0.19	6.28	2-4
5-1	5-2	0.4	6.1	7.03	0.51	1.43	0	1.43	0	Dp-Curb	6	16	Sag		0.02	0.02	0.1	n/a	n/a	0.1	4.81	Sag
5-2	5-3	0.61	6.3	6.98	0.51	2.17	0	2.17	0	Dp-Curb	6	16	Sag		0.02	0.02	0.13	n/a	n/a	0.13	6.34	Sag
5-3	5-4	0.5	6.3	6.98	0.51	1.78	0	1.78	0	Dp-Curb	6	16	Sag		0.02	0.02	0.11	n/a	n/a	0.11	5.55	Sag
6-1	6-2	0	0	0	0.51	0				MH												Sag
6-2	6-3	0.13	6.4	6.95	0.51	0.46	0	0.3	0.16	Curb	10	5	0.02	2	0.05	0.02	0.12	0.08	1.65	0.12	3.14	6-4
6-3	6-4	0.1	6.1	7.03	0.51	0.36	0.16	0.33	0.19	Curb	10	5	0.02	2	0.05	0.02	0.13	0.09	1.76	0.13	3.38	4-4
6-4	6-5R	0.7	7.6	6.65	0.51	2.37	2.26	4.63	0	Curb	10	5	Sag	2	0.05	0.02	0.44	n/a	n/a	0.44	18.99	Sag
6-4	6-5L	0.21	7	6.79	0.51	0.73	0	0.73	0	Curb	10	5	Sag	2	0.05	0.02	0.17	n/a	n/a	0.17	5.52	Sag
6-5	6-6	0.07	5.8	7.11	0.51	0.25	0	0.23	0.03	Curb	10	5	0.01	2	0.05	0.02	0.11	0.05	0.95	0.11	2.62	4-3
6-4	7-1R	0.17	8.2	6.5	0.51	0.56	0	0.37	0.19	Curb	10	5	0.014	2	0.05	0.02	0.14	0.09	1.9	0.14	3.99	4-4
6-4	7-1L	0.37	7.3	6.72	0.51	1.27	0	0.6	0.66	Curb	10	5	0.014	2	0.05	0.02	0.18	0.15	4.38	0.18	6.08	4-4
7-1	7-2	0.19	7.3	6.72	0.51	0.65	0	0.41	0.24	Curb	10	5	0.014	2	0.05	0.02	0.15	0.1	2.19	0.15	4.33	4-4
6-3	8-1	0.97	8.6	6.41	0.51	3.17	0	0.91	2.26	Curb	10	5	0.02	2	0.05	0.02	0.23	0.21	7.3	0.23	8.46	6-5
9-1	9-2	0	0	0	0.51	0				MH												Sag
9-2	9-3R	0.25	7.5	6.67	0.51	0.85	0	0.85	0	Curb	10	5	Sag	2	0.05	0.02	0.18	n/a	n/a	0.18	6.13	Sag
9-2	9-3L	0.19	6.7	6.87	0.51	0.67	0	0.67	0	Curb	10	5	Sag	2	0.05	0.02	0.16	n/a	n/a	0.16	5.21	Sag
10-1	10-2	0.35	6.3	6.98	0.51	1.25	0	1.25	0	Dp-Curb	6	8	Sag		0.02	0.02	0.14	n/a	n/a	0.14	6.95	Sag
10-2	10-3	1.26	9.7	6.18	0.51	3.97	0	3.97	0	Dp-Curb	6	16	Sag		0.02	0.02	0.19	n/a	n/a	0.19	9.48	Sag

10-YEAR PIPE																						
D.S. Str.	U.S. Str.	LineLength (ft)	Incr.Area (ac)	TotalArea (ac)	RunoffCoeff. (C)	IncrC x A	TotalC x A	InletTime (min)	TimeConc (min)	RnfallInt (in/hr)	TotalRunoff (cfs)	TotalFlow (cfs)	CapacFull (cfs)	Veloc (ft/s)	PipeSize (in)	PipeSlope (%)	Inv ElevDn (ft)	Inv ElevUp (ft)	HGLDn (ft)	HGLUp (ft)	Grnd/RimDn (ft)	Grnd/RimUp (ft)
1-1	1-2	139.4	0.77	0.77	0.51	0.39	0.39	8.8	8.8	6.4	2.5	2.5	12.32	5.94	15	2.15	912	915	912.38	915.63	0	918.5
2-1	2-2	50.18	0.28	3.69	0.51	0.14	1.88	5.3	9.6	6.2	11.67	11.67	71.89	11.31	24	5.98	912	915	912.55	916.23	0	924.5
2-2	2-3	138.03	0.12	2.1	0.51	0.06	1.07	5.9	9.4	6.2	6.69	6.69	40.78	11.18	18	8.93	920	932.32	920.41	933.32	924.5	941.27
2-3	2-4	46.47	0.6	1.98	0.51	0.31	1.01	6.2	9.3	6.3	6.33	6.33	14.16	6.51	18	1.08	932.82	933.32	932.51	934.29	941.27	940.79
2-4	2-5R	94.12	0.4	1.19	0.51	0.2	0.61	6.4	8.1	6.5	3.96	3.96	9.4	6.04	15	1.25	933.82	935	934.39	935.8	940.79	939.79
2-4	2-5L	1	0.55	0.55	0.51	0.28	0.28	8.1	8.1	6.5	1.83	1.83	26.54	2.91	15	10	935	935.1	935.8	935.64	939.79	939.79
2-5	2-6R	34	0.16	0.24	0.51	0.08	0.12	6.5	6.5	6.9	0.85	0.85	7.75	3.28	15	0.85	935.5	935.79	935.8	936.15	939.79	939.79
2-5	2-6L	1	0.08	0.08	0.51	0.04	0.04	6.2	6.2	7	0.29	0.29	26.55	1.56	15	10	935.79	935.89	936.15	936.1	939.79	939.79
2-4	3-1	128.62	0.19	0.19	0.51	0.1	0.1	8.8	8.8	6.4	0.62	0.62	17.36	4.65	15	4.28	936	941.5	936.16	941.81	940.79	946.25
2-2	4-1	113.49	0.54	1.31	0.51	0.28	0.67	6.8	8.3	6.5	4.33	4.33	14.33	5.82	18	1.1	916.5	917.75	917.07	918.55	924.5	924.5
4-1	4-2	189.85	0.32	0.77	0.51	0.16	0.39	7.6	7.6	6.6	2.61	2.61	25.85	4.56	15	9.48	918	936	918.55	936.65	924.5	944.33
4-2	4-3	135.55	0.08	0.45	0.51	0.04	0.23	5.6	7.1	6.8	1.55	1.55	16.12	5.87	15	3.69	940	945	940.26	945.49	944.33	950.08
4-3	4-4	34	0.37	0.37	0.51	0.19	0.19	7	7	6.8	1.28	1.28	12.47	4.55	15	2.21	945.2	945.95	945.49	946.4	950.08	950.08
5-1	5-2	96.83	0.4	1.51	0.51	0.2	0.77	6.1	7.8	6.6	5.09	5.09	9.61	5.16	18	0.5	937	937.48	937.78	938.35	0	944
5-2	5-3	259.22	0.61	1.11	0.51	0.31	0.57	6.3	6.9	6.8	3.87	3.87	9.67	4.76	18	0.5	937.98	939.28	938.64	940.03	944	944
5-3	5-4	132.58	0.5	0.5	0.51	0.26	0.26	6.3	6.3	7	1.78	1.78	5.92	3.91	15	0.5	939.78	940.44	940.25	940.97	944	944
6-1	6-2	49.06	0	2.91	0.51	0	1.48	0	9.2	6.3	9.33	9.33	72.71	10.62	24	6.11	940	943	940.48	944.09	0	950.2
6-2	6-3	140.5	0.13	2.91	0.51	0.07	1.48	6.4	8.9	6.4	9.44	9.44	30.38	6.94	24	1.07	945	946.5	945.77	947.6	950.2	958.57
6-3	6-4	175.8	0.1	1.81	0.51	0.05	0.92	6.1	8.4	6.5	5.97	5.97	12.61	6.07	18	0.85	947	948.5	947.73	949.44	958.57	955.36
6-4	6-5R	79.6	0.7	0.98	0.51	0.36	0.5	7.6	7.6	6.6	3.32	3.32	6.65	4.93	15	0.63	949	949.5	949.62	950.23	955.36	954.54
6-4	6-5L	1	0.21	0.21	0.51	0.11	0.11	7	7	6.8	0.73	0.73	26.54	1.87	15	10	949.5	949.6	950.23	949.93	954.54	954.54
6-5	6-6	34	0.07	0.07	0.51	0.04	0.04	5.8	5.8	7.1	0.25	0.25	10.58	1.84	15	1.59	950	950.54	950.23	950.73	954.54	954.54
6-4	7-1R	50	0.17	0.73	0.51	0.09	0.37	8.2	8.2	6.5	2.42	2.42	8.39	4.94	15	1	949	949.5	949.46	950.12	955.36	954.87
6-4	7-1L	1	0.37	0.56	0.51	0.19	0.29	7.3	7.5	6.7	1.91	1.91	26.54	3.4	15	10	949.5	949.6	950.12	950.15	954.87	954.87
7-1	7-2	34	0.19	0.19	0.51	0.1	0.1	7.3	7.3	6.7	0.65	0.65	10.18	3.67	15	1.47	950	950.5	950.21	950.81	954.87	954.87
6-3	8-1	35.8	0.97	0.97	0.51	0.49	0.49	8.6	8.6	6.4	3.17	3.17	11.48	6.18	15	1.87	954	954.67	954.45	955.39	958.57	958.33
9-1	9-2	75	0	0.44	0.51	0	0.22	0	7.8	6.6	1.48	1.48	8.67	4.34	15	1.07	942	942.8	942.35	943.28	0	950.86
9-2	9-3R	96.85	0.25	0.44	0.51	0.13	0.22	7.5	7.5	6.7	1.5	1.5	24.13	5.33	15	8.26	943	951	943.28	951.48	950.86	956.92
9-2	9-3L	1	0.19	0.19	0.51	0.1	0.1	6.7	6.7	6.9	0.67	0.67	26.54	5.93	15	10	952	952.1	952.14	952.42	956.92	956.92
10-1	10-2	134.78	0.35	1.61	0.51	0.18	0.82	6.3	10.2	6.1	4.98	4.98	14.46	7.97	15	2.97	938	942	938.51	942.9	0	946
10-2	10-3	165.22	1.26	1.26	0.51	0.64	0.64	9.7	9.7	6.2	3.97	3.97	12.22	5.16	15	2.12	942.2	942.8	942.9	946.51	946	949.7

100-YEAR INLET																						
D.S. Str.	Str. No.	Area (ac)	InletTime (min)	Int. (in/hr)	RunoffCoeff. (C)	Q=CIA (cfs)	Q Carry-over (cfs)	QCaptured (cfs)	QBypassed (cfs)	JunctType	CurbHeight (in)	CurbLength (ft)	GutterSlope (ft/ft)	GutterWidth (ft)	CrossSlope, Sw (ft/ft)	CrossSlope, Sx (ft/ft)	InletDepth (ft)	BypassDepth (ft)	BypassSpread (ft)	GutterDepth (ft)	GutterSpread (ft)	Bypass Str.
1-1	1-2	0.77	8.8	11.31	0.51	4.44	0	4.44	0	Dp-Curb	6	8	Sag		0.02	0.02	0.32	n/a	n/a	0.32	16.22	Sag
2-1	2-2	0.28	5.3	12.75	0.51	1.82	0	1.82	0	Dp-Curb	6	8	Sag		0.02	0.02	0.18	n/a	n/a	0.18	8.95	Sag
2-2	2-3	0.12	5.9	12.48	0.51	0.76	0.32	0.44	0.64	Curb	10	5	0.038	2	0.05	0.02	0.15	0.12	3.17	0.15	4.36	7
2-3	2-4	0.6	6.2	12.34	0.51	3.78	4.31	1.27	6.82	Curb	10	5	0.038	2	0.05	0.02	0.28	0.26	10.19	0.28	10.92	5
2-4	2-5R	0.4	6.4	12.26	0.51	2.5	6.82	9.32	0	Curb	10	5	Sag	2	0.05	0.02	0.67	n/a	n/a	0.67	30.26	Sag
2-4	2-5L	0.55	8.1	11.57	0.51	3.24	0	3.24	0	Curb	10	5	Sag	2	0.05	0.02	0.36	n/a	n/a	0.36	14.97	Sag
2-5	2-6R	0.16	6.5	12.21	0.51	1	0.64	1.64	0	Curb	10	5	Sag	2	0.05	0.02	0.25	n/a	n/a	0.25	9.5	Sag
2-5	2-6L	0.08	6.2	12.34	0.51	0.5	0	0.5	0	Curb	10	5	Sag	2	0.05	0.02	0.15	n/a	n/a	0.15	4.32	Sag
2-4	3-1	0.19	8.8	11.31	0.51	1.1	0	1.1	0	Dp-Curb	6	4	Sag		0.02	0.02	0.2	n/a	n/a	0.2	10.13	Sag
2-2	4-1	0.54	6.8	12.08	0.51	3.33	0	3.33	0	Dp-Curb	6	4	Sag		0.02	0.02	0.43	n/a	n/a	0.43	21.26	Sag
4-1	4-2	0.32	7.6	11.76	0.51	1.92	0	1.92	0	Dp-Curb	6	4	Sag		0.02	0.02	0.29	n/a	n/a	0.29	14.72	Sag
4-2	4-3	0.08	5.6	12.61	0.51	0.51	0.1	0.3	0.32	Curb	10	5	0.05	2	0.05	0.02	0.12	0.09	1.82	0.12	2.8	3
4-3	4-4	0.37	7	12	0.51	2.26	2.99	0.95	4.31	Curb	10	5	0.05	2	0.05	0.02	0.23	0.22	7.92	0.23	8.63	4
5-1	5-2	0.4	6.1	12.39	0.51	2.53	0	2.53	0	Dp-Curb	6	16	Sag		0.02	0.02	0.14	n/a	n/a	0.14	7.02	Sag
5-2	5-3	0.61	6.3	12.3	0.51	3.83	0	3.83	0	Dp-Curb	6	16	Sag		0.02	0.02	0.19	n/a	n/a	0.19	9.25	Sag
5-3	5-4	0.5	6.3	12.3	0.51	3.14	0	3.14	0	Dp-Curb	6	16	Sag		0.02	0.02	0.16	n/a	n/a	0.16	8.1	Sag
6-1	6-2	0	0	0	0.51	0				MH												
6-2	6-3	0.13	6.4	12.26	0.51	0.81	0	0.43	0.38	Curb	10	5	0.02	2	0.05	0.02	0.15	0.11	2.74	0.15	4.44	19
6-3	6-4	0.1	6.1	12.39	0.51	0.63	0.38	0.49	0.52	Curb	10	5	0.02	2	0.05	0.02	0.16	0.13	3.41	0.16	4.98	13
6-4	6-5R	0.7	7.6	11.76	0.51	4.2	4.4	8.6	0	Curb	10	5	Sag	2	0.05	0.02	0.63	n/a	n/a	0.63	28.69	Sag
6-4	6-5L	0.21	7	12	0.51	1.29	0	1.29	0	Curb	10	5	Sag	2	0.05	0.02	0.22	n/a	n/a	0.22	8.07	Sag
6-5	6-6	0.07	5.8	12.52	0.51	0.45	0	0.34	0.1	Curb	10	5	0.01	2	0.05	0.02	0.14	0.08	1.61	0.14	3.84	12
6-4	7-1R	0.17	8.2	11.53	0.51	1	0	0.53	0.47	Curb	10	5	0.014	2	0.05	0.02	0.17	0.13	3.59	0.17	5.42	13
6-4	7-1L	0.37	7.3	11.88	0.51	2.24	0	0.82	1.42	Curb	10	5	0.014	2	0.05	0.02	0.22	0.19	6.41	0.22	7.87	13
7-1	7-2	0.19	7.3	11.88	0.51	1.15	0	0.57	0.58	Curb	10	5	0.014	2	0.05	0.02	0.18	0.14	4.06	0.18	5.81	13
6-3	8-1	0.97	8.6	11.38	0.51	5.63	0	1.23	4.4	Curb	10	5	0.02	2	0.05	0.02	0.27	0.25	9.71	0.27	10.74	20
9-1	9-2	0	0	0	0.51	0				MH												
9-2	9-3R	0.25	7.5	11.8	0.51	1.5	0	1.5	0	Curb	10	5	Sag	2	0.05	0.02	0.24	n/a	n/a	0.24	8.97	Sag
9-2	9-3L	0.19	6.7	12.13	0.51	1.18	0	1.18	0	Curb	10	5	Sag	2	0.05	0.02	0.21	n/a	n/a	0.21	7.61	Sag
10-1	10-2	0.35	6.3	12.3	0.51	2.2	0	2.2	0	Dp-Curb	6	8	Sag		0.02	0.02	0.2	n/a	n/a	0.2	10.14	Sag
10-2	10-3	1.26	9.7	10.99	0.51	7.06	0	7.06	0	Dp-Curb	6	16	Sag		0.02	0.02	0.28	n/a	n/a	0.28	13.93	Sag

100-YEAR PIPE																						
D.S. Str.	U.S. Str.	LineLength (ft)	Incr.Area (ac)	TotalArea (ac)	RunoffCoeff. (C)	IncrC x A	TotalC x A	InletTime (min)	TimeConc (min)	RnfalInt (in/hr)	TotalRunoff (cfs)	TotalFlow (cfs)	CapacFull (cfs)	Veloc (ft/s)	PipeSize (in)	PipeSlope (%)	Inv ElevDn (ft)	Inv ElevUp (ft)	HGLDn (ft)	HGLUp (ft)	Grnd/RimDn (ft)	Grnd/RimUp (ft)
1-1	1-2	139.4	0.77	0.77	0.51	0.39	0.39	8.8	8.8	11.3	4.44	4.44	12.32	4.3	15	2.15	912	915	915.4	915.85	0	918.5
2-1	2-2	50.18	0.28	3.69	0.51	0.14	1.88	5.3	9.5	11.1	20.84	20.84	71.89	7.11	24	5.98	912	915	915.4	916.63	0	924.5
2-2	2-3	138.03	0.12	2.1	0.51	0.06	1.07	5.9	9.3	11.1	11.92	11.92	40.78	13.65	18	8.93	920	932.32	920.56	933.63	924.5	941.27
2-3	2-4	46.47	0.6	1.98	0.51	0.31	1.01	6.2	9.2	11.2	11.28	11.28	14.16	7.95	18	1.08	932.82	933.32	933.83	934.6	941.27	940.79
2-4	2-5R	94.12	0.4	1.19	0.51	0.2	0.61	6.4	8.1	11.6	7.02	7.02	9.4	7.36	15	1.25	933.82	935	934.63	936.06	940.79	939.79
2-4	2-5L	1	0.55	0.55	0.51	0.28	0.28	8.1	8.1	11.6	3.24	3.24	26.54	3.66	15	10	935	935.1	936.06	935.83	939.79	939.79
2-5	2-6R	34	0.16	0.24	0.51	0.08	0.12	6.5	6.5	12.2	1.49	1.49	7.75	3.11	15	0.85	935.5	935.79	936.06	936.27	939.79	939.79
2-5	2-6L	1	0.08	0.08	0.51	0.04	0.04	6.2	6.2	12.3	0.5	0.5	26.55	1.83	15	10	935.79	935.89	936.27	936.17	939.79	939.79
2-4	3-1	128.62	0.19	0.19	0.51	0.1	0.1	8.8	8.8	11.3	1.1	1.1	17.36	5.5	15	4.28	936	941.5	936.21	941.91	940.79	946.25
2-2	4-1	113.49	0.54	1.31	0.51	0.28	0.67	6.8	8.2	11.5	7.7	7.7	14.33	6.97	18	1.1	916.5	917.75	917.28	918.82	924.5	924.5
4-1	4-2	189.85	0.32	0.77	0.51	0.16	0.39	7.6	7.6	11.8	4.62	4.62	25.85	5.22	15	9.48	918	936	918.82	936.87	924.5	944.33
4-2	4-3	135.55	0.08	0.45	0.51	0.04	0.23	5.6	7.1	12	2.74	2.74	16.12	6.96	15	3.69	940	945	940.35	945.66	944.33	950.08
4-3	4-4	34	0.37	0.37	0.51	0.19	0.19	7	7	12	2.26	2.26	12.47	4.67	15	2.21	945.2	945.95	945.66	946.55	950.08	950.08
5-1	5-2	96.83	0.4	1.51	0.51	0.2	0.77	6.1	8.3	11.5	8.85	8.85	9.61	5.01	18	0.5	937	937.48	941.49	941.9	0	944
5-2	5-3	259.22	0.61	1.11	0.51	0.31	0.57	6.3	7.2	11.9	6.76	6.76	9.67	3.82	18	0.5	937.98	939.28	942.23	942.87	944	944
5-3	5-4	132.58	0.5	0.5	0.51	0.26	0.26	6.3	6.3	12.3	3.14	3.14	5.92	2.56	15	0.5	939.78	940.44	943.21	943.39	944	944
6-1	6-2	49.06	0	2.91	0.51	0	1.48	0	9	11.2	16.65	16.65	72.71	6.68	24	6.11	940	943	941.49	944.47	0	950.2
6-2	6-3	140.5	0.13	2.91	0.51	0.07	1.48	6.4	8.8	11.3	16.8	16.8	30.38	8.34	24	1.07	945	946.5	946.06	947.98	950.2	958.57
6-3	6-4	175.8	0.1	1.81	0.51	0.05	0.92	6.1	8.4	11.5	10.59	10.59	12.61	7.36	18	0.85	947	948.5	948.05	949.75	958.57	955.36
6-4	6-5R	79.6	0.7	0.98	0.51	0.36	0.5	7.6	7.6	11.8	5.88	5.88	6.65	5.91	15	0.63	949	949.5	949.91	950.48	955.36	954.54
6-4	6-5L	1	0.21	0.21	0.51	0.11	0.11	7	7	12	1.29	1.29	26.54	2.25	15	10	949.5	949.6	950.48	950.05	954.54	954.54
6-5	6-6	34	0.07	0.07	0.51	0.04	0.04	5.8	5.8	12.5	0.45	0.45	10.58	1.73	15	1.59	950	950.54	950.48	950.8	954.54	954.54
6-4	7-1R	50	0.17	0.73	0.51	0.09	0.37	8.2	8.2	11.5	4.29	4.29	8.39	5.25	15	1	949	949.5	949.75	950.34	955.36	954.87
6-4	7-1L	1	0.37	0.56	0.51	0.19	0.29	7.3	7.5	11.8	3.38	3.38	26.54	4.16	15	10	949.5	949.6	950.34	950.34	954.87	954.87
7-1	7-2	34	0.19	0.19	0.51	0.1	0.1	7.3	7.3	11.9	1.15	1.15	10.18	3.71	15	1.47	950	950.5	950.34	950.92	954.87	954.87
6-3	8-1	35.8	0.97	0.97	0.51	0.49	0.49	8.6	8.6	11.4	5.63	5.63	11.48	7.44	15	1.87	954	954.67	954.62	955.63	958.57	958.33
9-1	9-2	75	0	0.44	0.51	0	0.22	0	7.8	11.7	2.62	2.62	8.67	5.13	15	1.07	942	942.8	942.47	943.45	0	950.86
9-2	9-3R	96.85	0.25	0.44	0.51	0.13	0.22	7.5	7.5	11.8	2.65	2.65	24.13	5.39	15	8.26	943	951	943.45	951.65	950.86	956.92
9-2	9-3L	1	0.19	0.19	0.51	0.1	0.1	6.7	6.7	12.1	1.18	1.18	26.54	7.02	15	10	952	952.1	952.18	952.53	956.92	956.92
10-1	10-2	134.78	0.35	1.61	0.51	0.18	0.82	6.3	10.1	10.9	8.91	8.91	14.46	7.4	15	2.97	938	942	941.49	943.15	0	946
10-2	10-3	165.22	1.26	1.26	0.51	0.64	0.64	9.7	9.7	11	7.06	7.06	12.22	6.7	15	2.12	942.2	945.7	943.15	946.76	946	949.7

