



Record Drawing

Emery Sapp & Sons, inc. Redlines

① Relocate Existing Gas Marker
Coordinate with Utility

Ward Road Baseline Curve:
PC Sta: 10+59.04
Length: 392.366'
Radius: 762.007'
Delta: 29.5023°
PT Sta: 14+51.40

All Long Line Pavement Markings Shall Be High Build
Paint and All Symbols, Stop Line, Crosswalk Lines
and Diagonals Shall Be Preformed Thermoplastic
Material in Accordance With City Specifications.

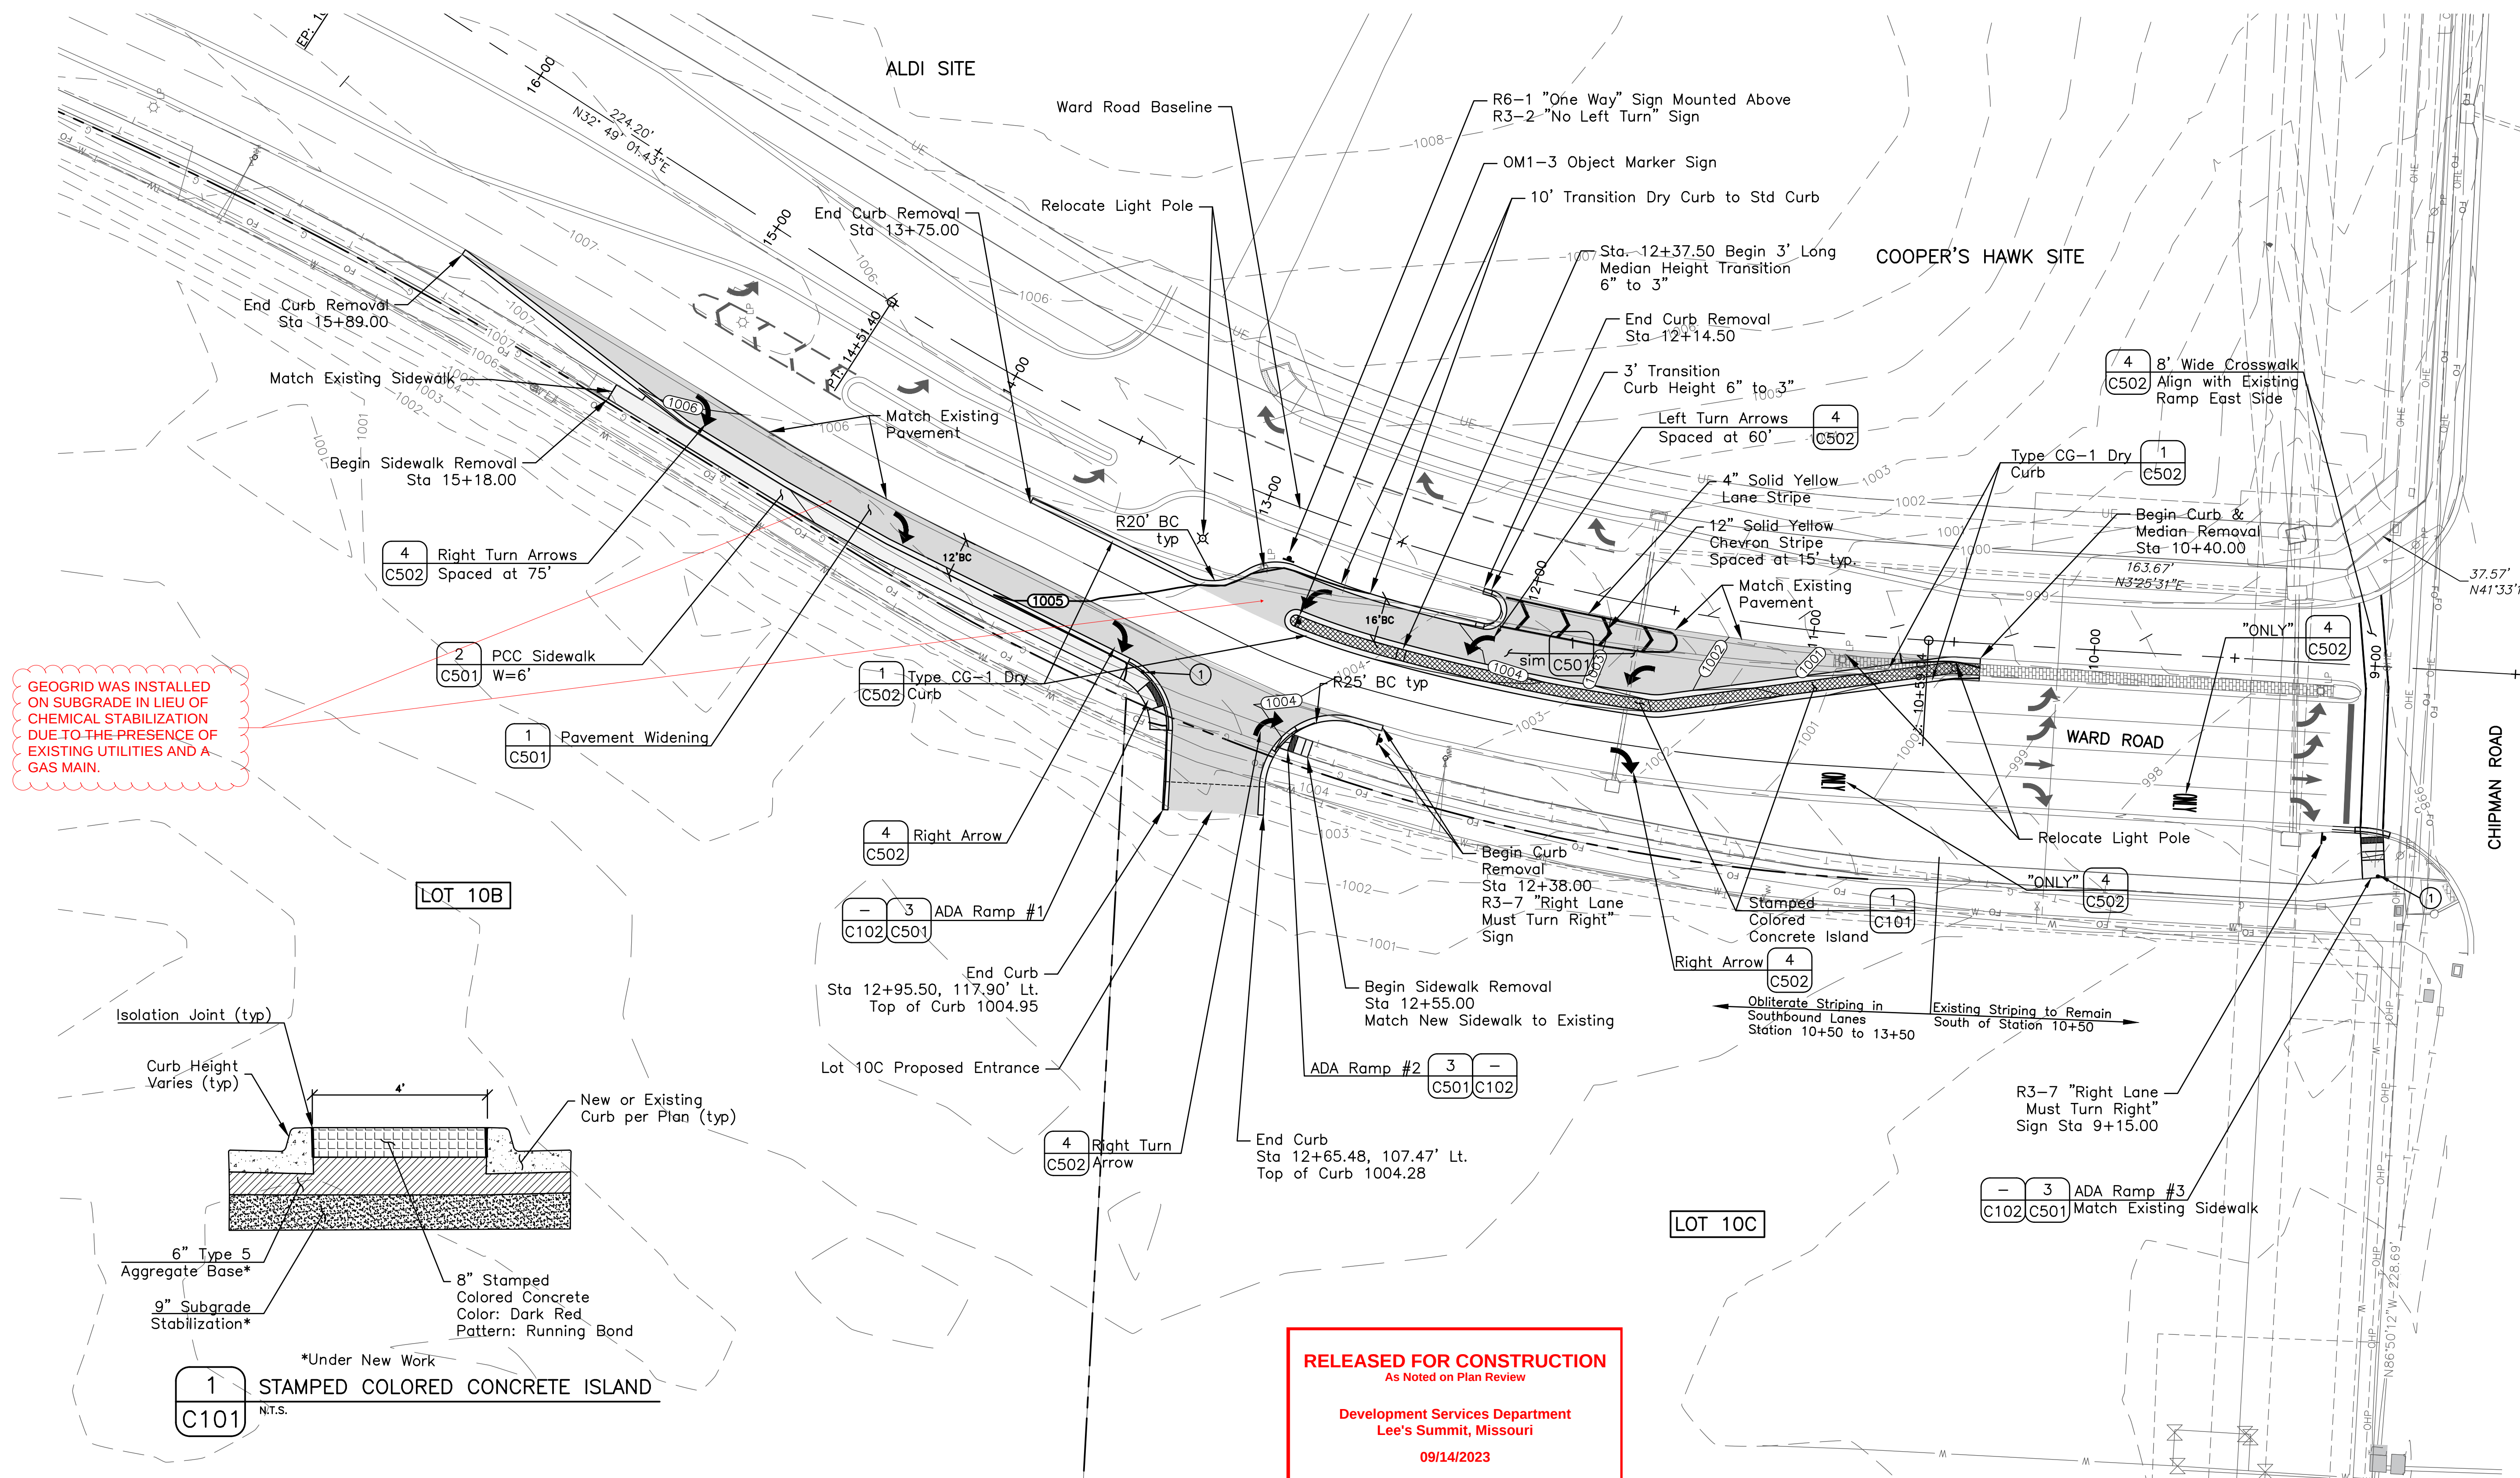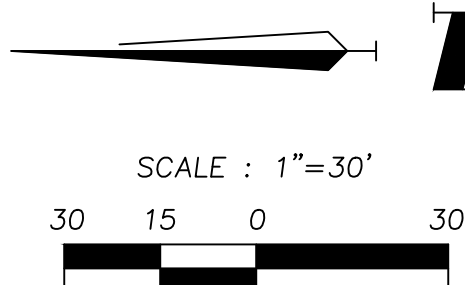

RELEASED FOR CONSTRUCTION
As Noted on Plan Review

Development Services Department
Lee's Summit, Missouri
09/14/2023

AE


**ANDERSON
ENGINEERING
EMPLOYEE OWNED**

ENGINEERS • SURVEYORS • LABORATORIES • DRILLING
4240 PHILLIPS FARM RD. STE. 101 • COLUMBIA, MO 65201 • PHONE (573) 397-5476
A LICENSED MISSOURI ENGINEERING & SURVEYING CORPORATION
MISSOURI CERTIFICATE OF AUTHORITY #0000682 EXPIRES 12/31/2023

REVISIONS			DRAWING INFO.	
NO.	DESCRIPTION	BY	DATE	
				DRAWN BY:
				LICENSE NO.
				CHECKED BY:
				LICENSE NO.
				DATE:
				09/01/2023
				JOB NUMBER:
				23CO10001

© COPYRIGHT ANDERSON ENGINEERING, INC. 2023

LOT 10C
WARD ROAD IMPROVEMENTS
WIDENING/TURN LANE PLAN
LEE'S SUMMIT, JACKSON COUNTY, MO

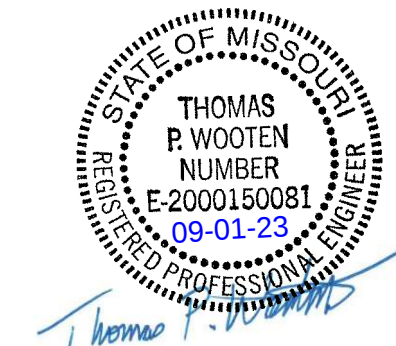

SHEET NUMBER
C101
4 OF 11



8 OF 11