

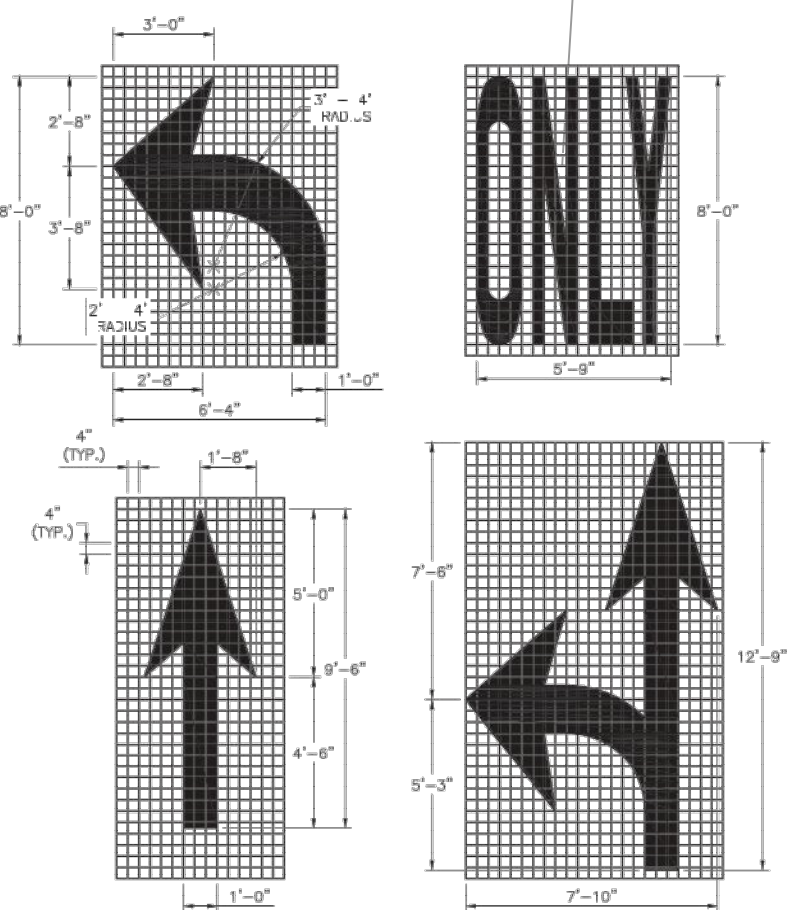


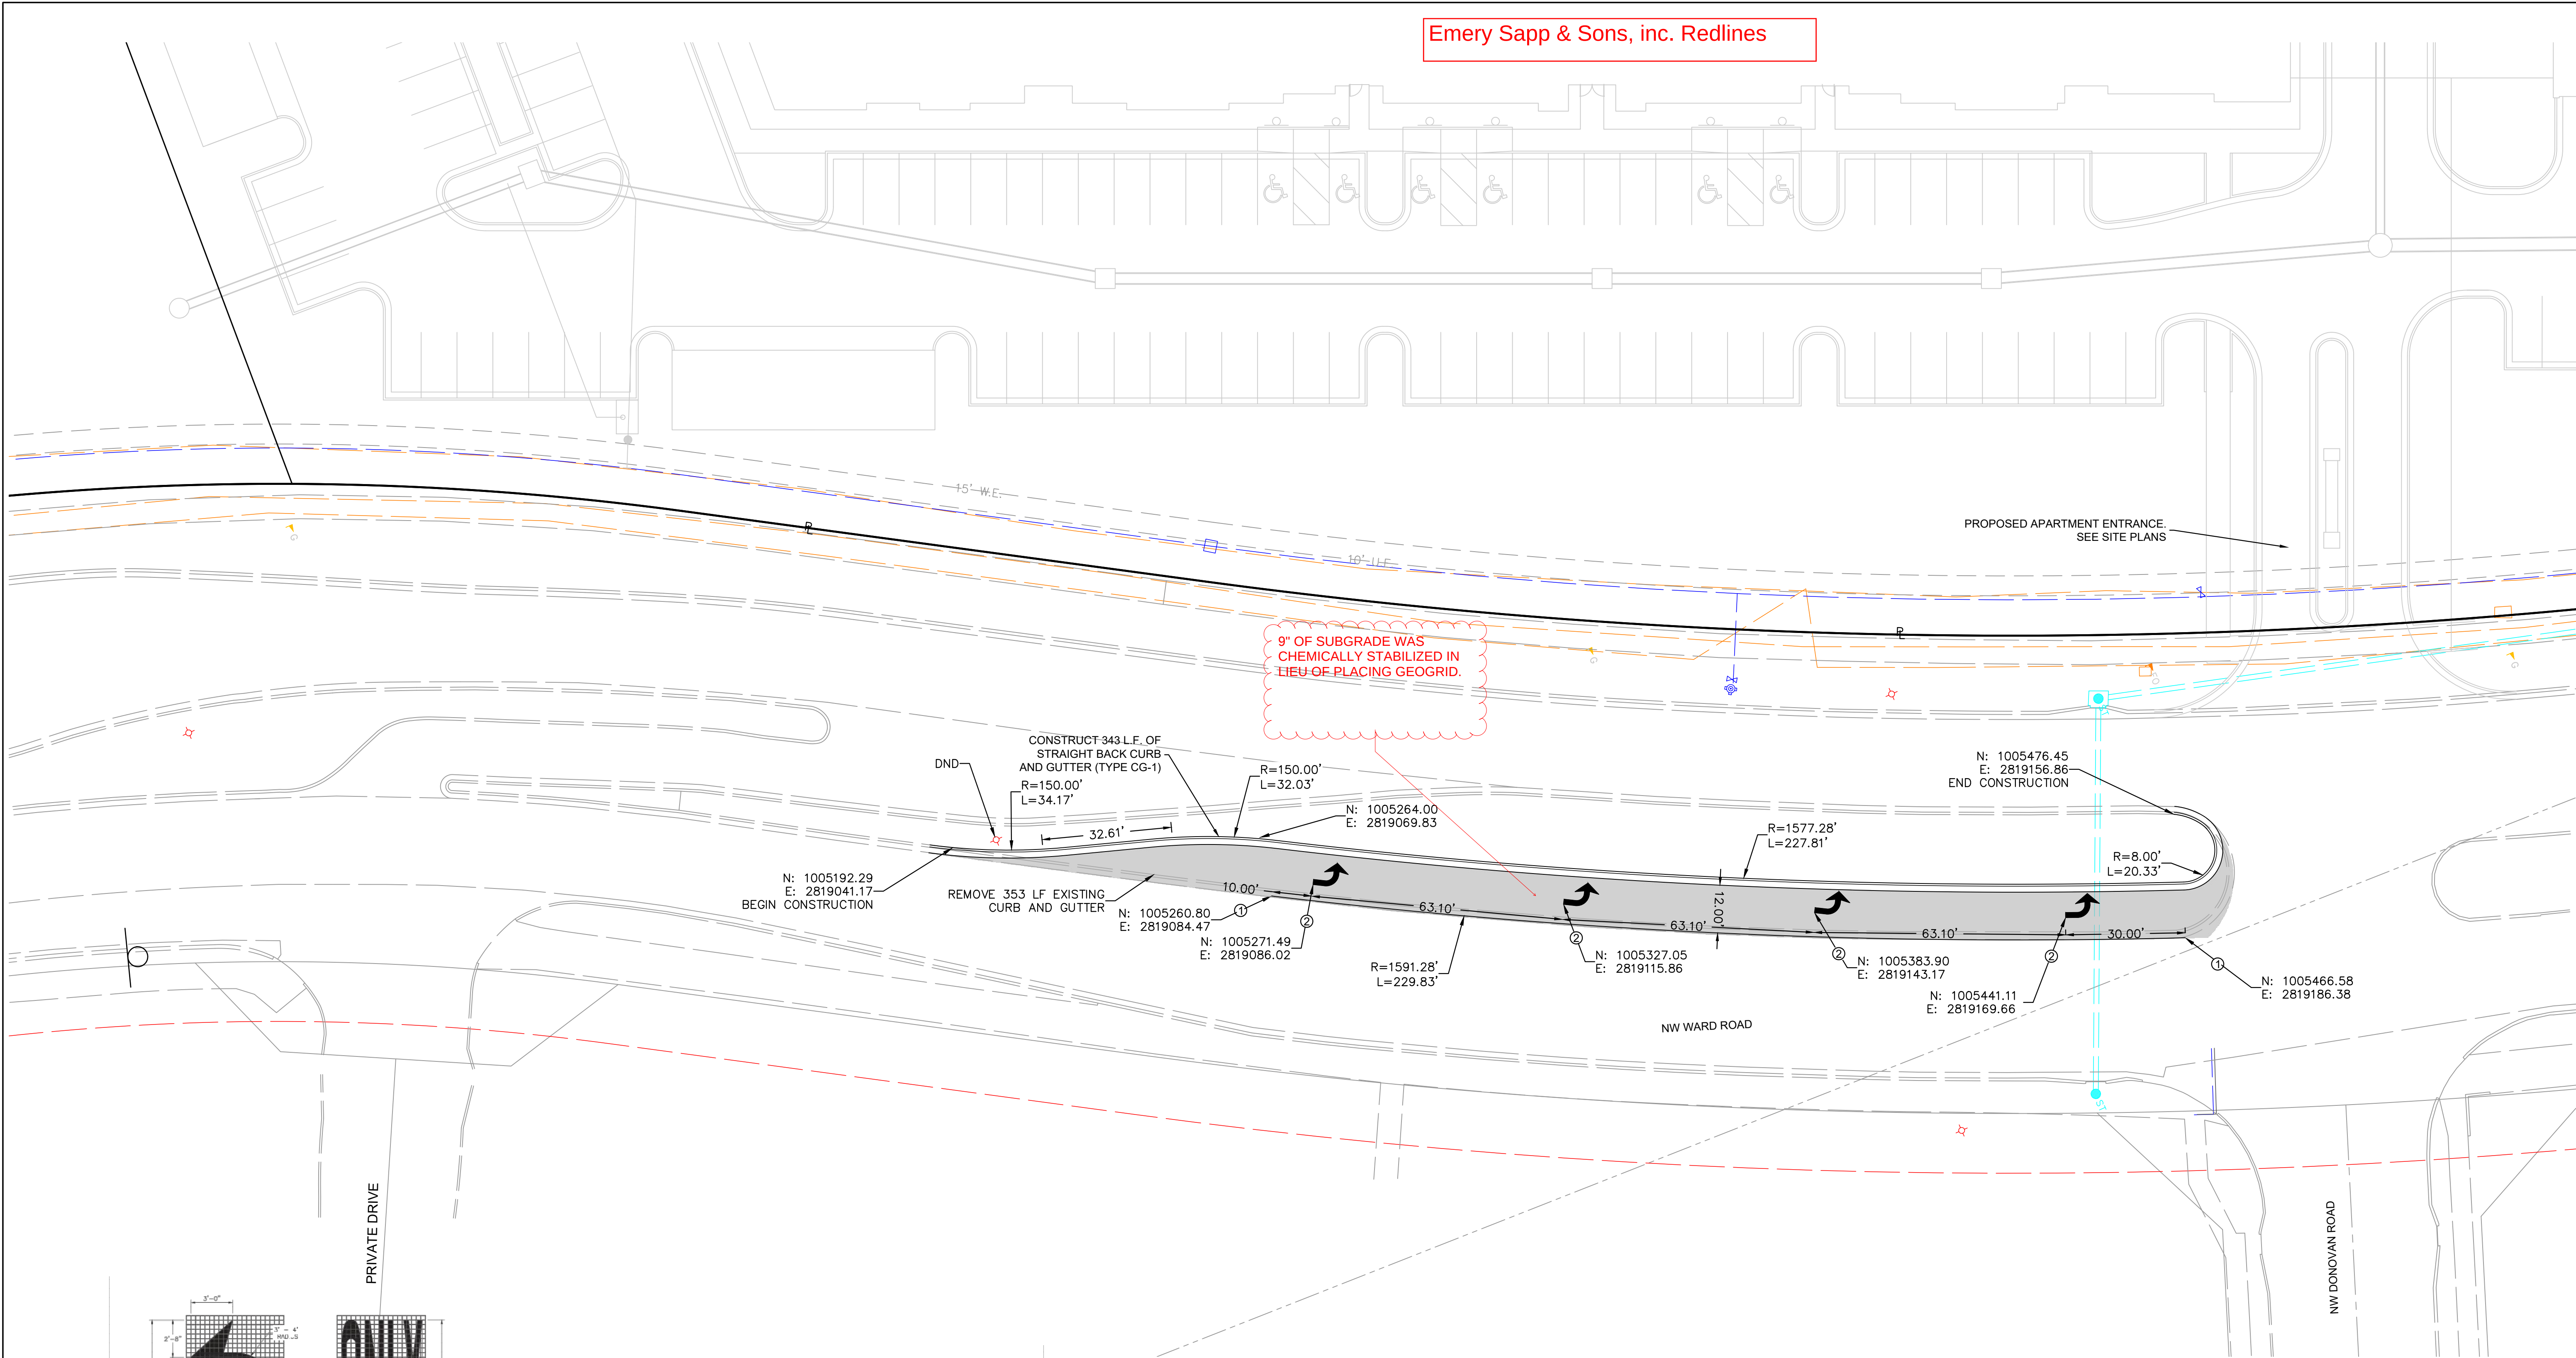


ARROW AND SYMBOL DETAILS

NOTES:

1. ALL ARROW AND SYMBOL MARKINGS SHALL BE WHITE, AND SHALL BE CENTERED IN THEIR RESPECTIVE TRAFFIC LANES.
2. RIGHT-TURN AND COMBINATION RIGHT-TURN/STRAIGHT ARROWS ARE REVERSE OF ARROWS SHOWN.

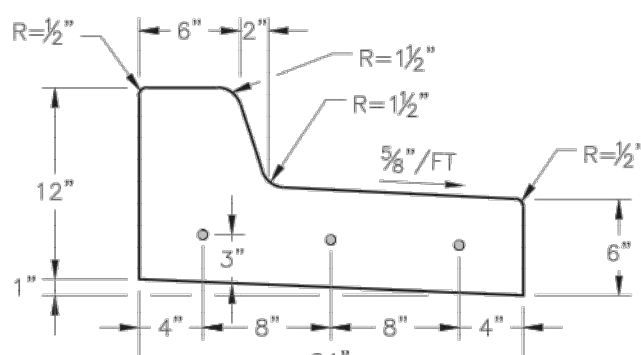

STRAIGHT BACK DRY CURB & GUTTER
(TYPE CG-1 DRY)

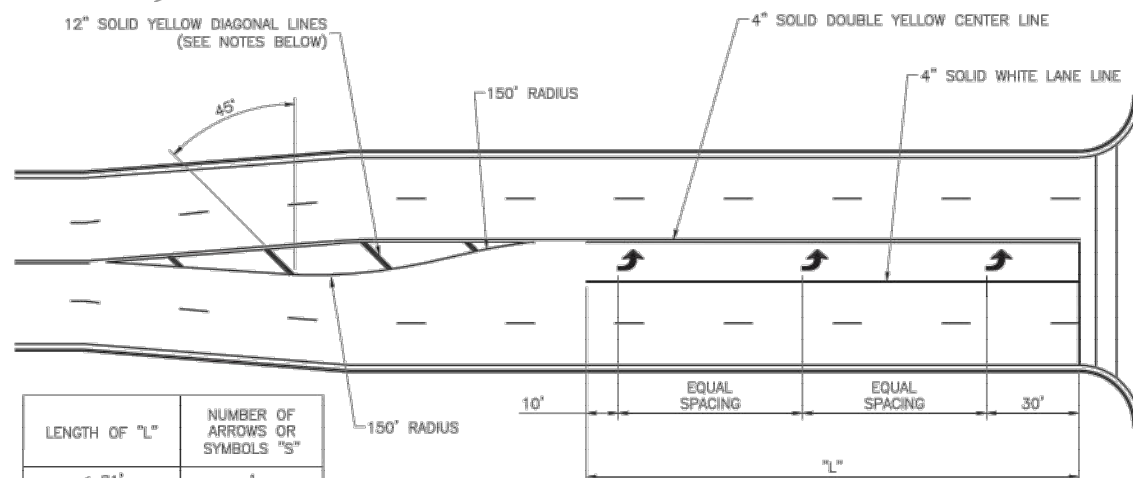

TYPICAL TURN LANE MARKINGS

NOTES:

1. DIAGONAL LINES ARE REQUIRED BETWEEN CENTERLINES IF THE WIDTH OF THE AREA BETWEEN THE CENTER LINES IS GREATER THAN 12' AND/OR THE LENGTH OF THE AREA BETWEEN CENTER LINES IS GREATER THAN 250'.
2. DIAGONAL LINES SHOULD BE SPACED AT 5' INCREMENTS, EQUAL TO THE POSTED SPEED LIMIT.
3. EQUAL SPACING IS CALCULATED AS $(L - 40) / (S - 1)$.
4. WHEN A THROUGH LANE OF TRAFFIC TERMINATES AS A MANDATORY TURN LANE, ARROW AND "ONLY" SYMBOLS SHOULD BE MARKED IN THE TURN LANE. IN ALTERNATING ORDER, THE FIRST AND LAST SYMBOLS SHOULD BE ARROWS.

LEGEND	
	ASPHALT PAVEMENT
	2" ASPHALT SURFACE
	7.5" ASPHALT BASE
	6" AGGREGATE BASE
	9" CHEMICAL SUBGRADE STABILIZATION
	CG-1 CURB & GUTTER (See Detail)


RELEASED FOR CONSTRUCTION
As Noted on Plan Review

Development Services Department
Lee's Summit, Missouri

03/27/2023

LEGEND

- ① 4" SOLID WHITE THERMOPLASTIC
- ② SOLID WHITE ARROW THERMOPLASTIC

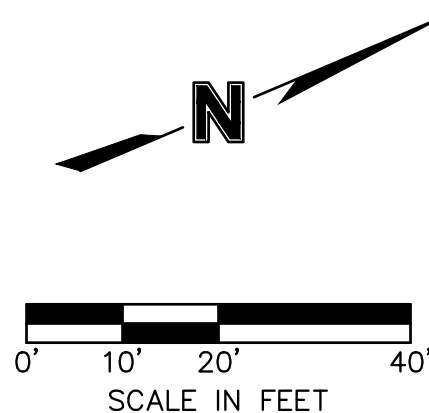

REVISIONS/APPROVALS:	
NO.	DATE
1	2023.02.16
INITIAL CITY SUBMITAL	
REVIEWED BY:	N.W.H.
DESIGNED BY:	N.W.H.
DRAFTED BY:	D.A.H.
SP PROJECT #:	4024
NEIL W. HAAS, P.E.	202034072

GENERAL LAYOUT
TRILOGY APARTMENTS
LEFT TURN LANE ADDITION
NW WARD ROAD
LEE'S SUMMIT, JACKSON COUNTY, MO




Certificate of Authority #MO 2020018354

SHEET #:


C-0200

S:\01 PROJECTS\MULTI-FAMILY\024 SUMMIT SQUARE 3YDP AND PUBLIC IMPROVEMENTS\PLANS\02-STREET & STORM SEWER PLANS\C-0400 GRADING PLAN.DWG

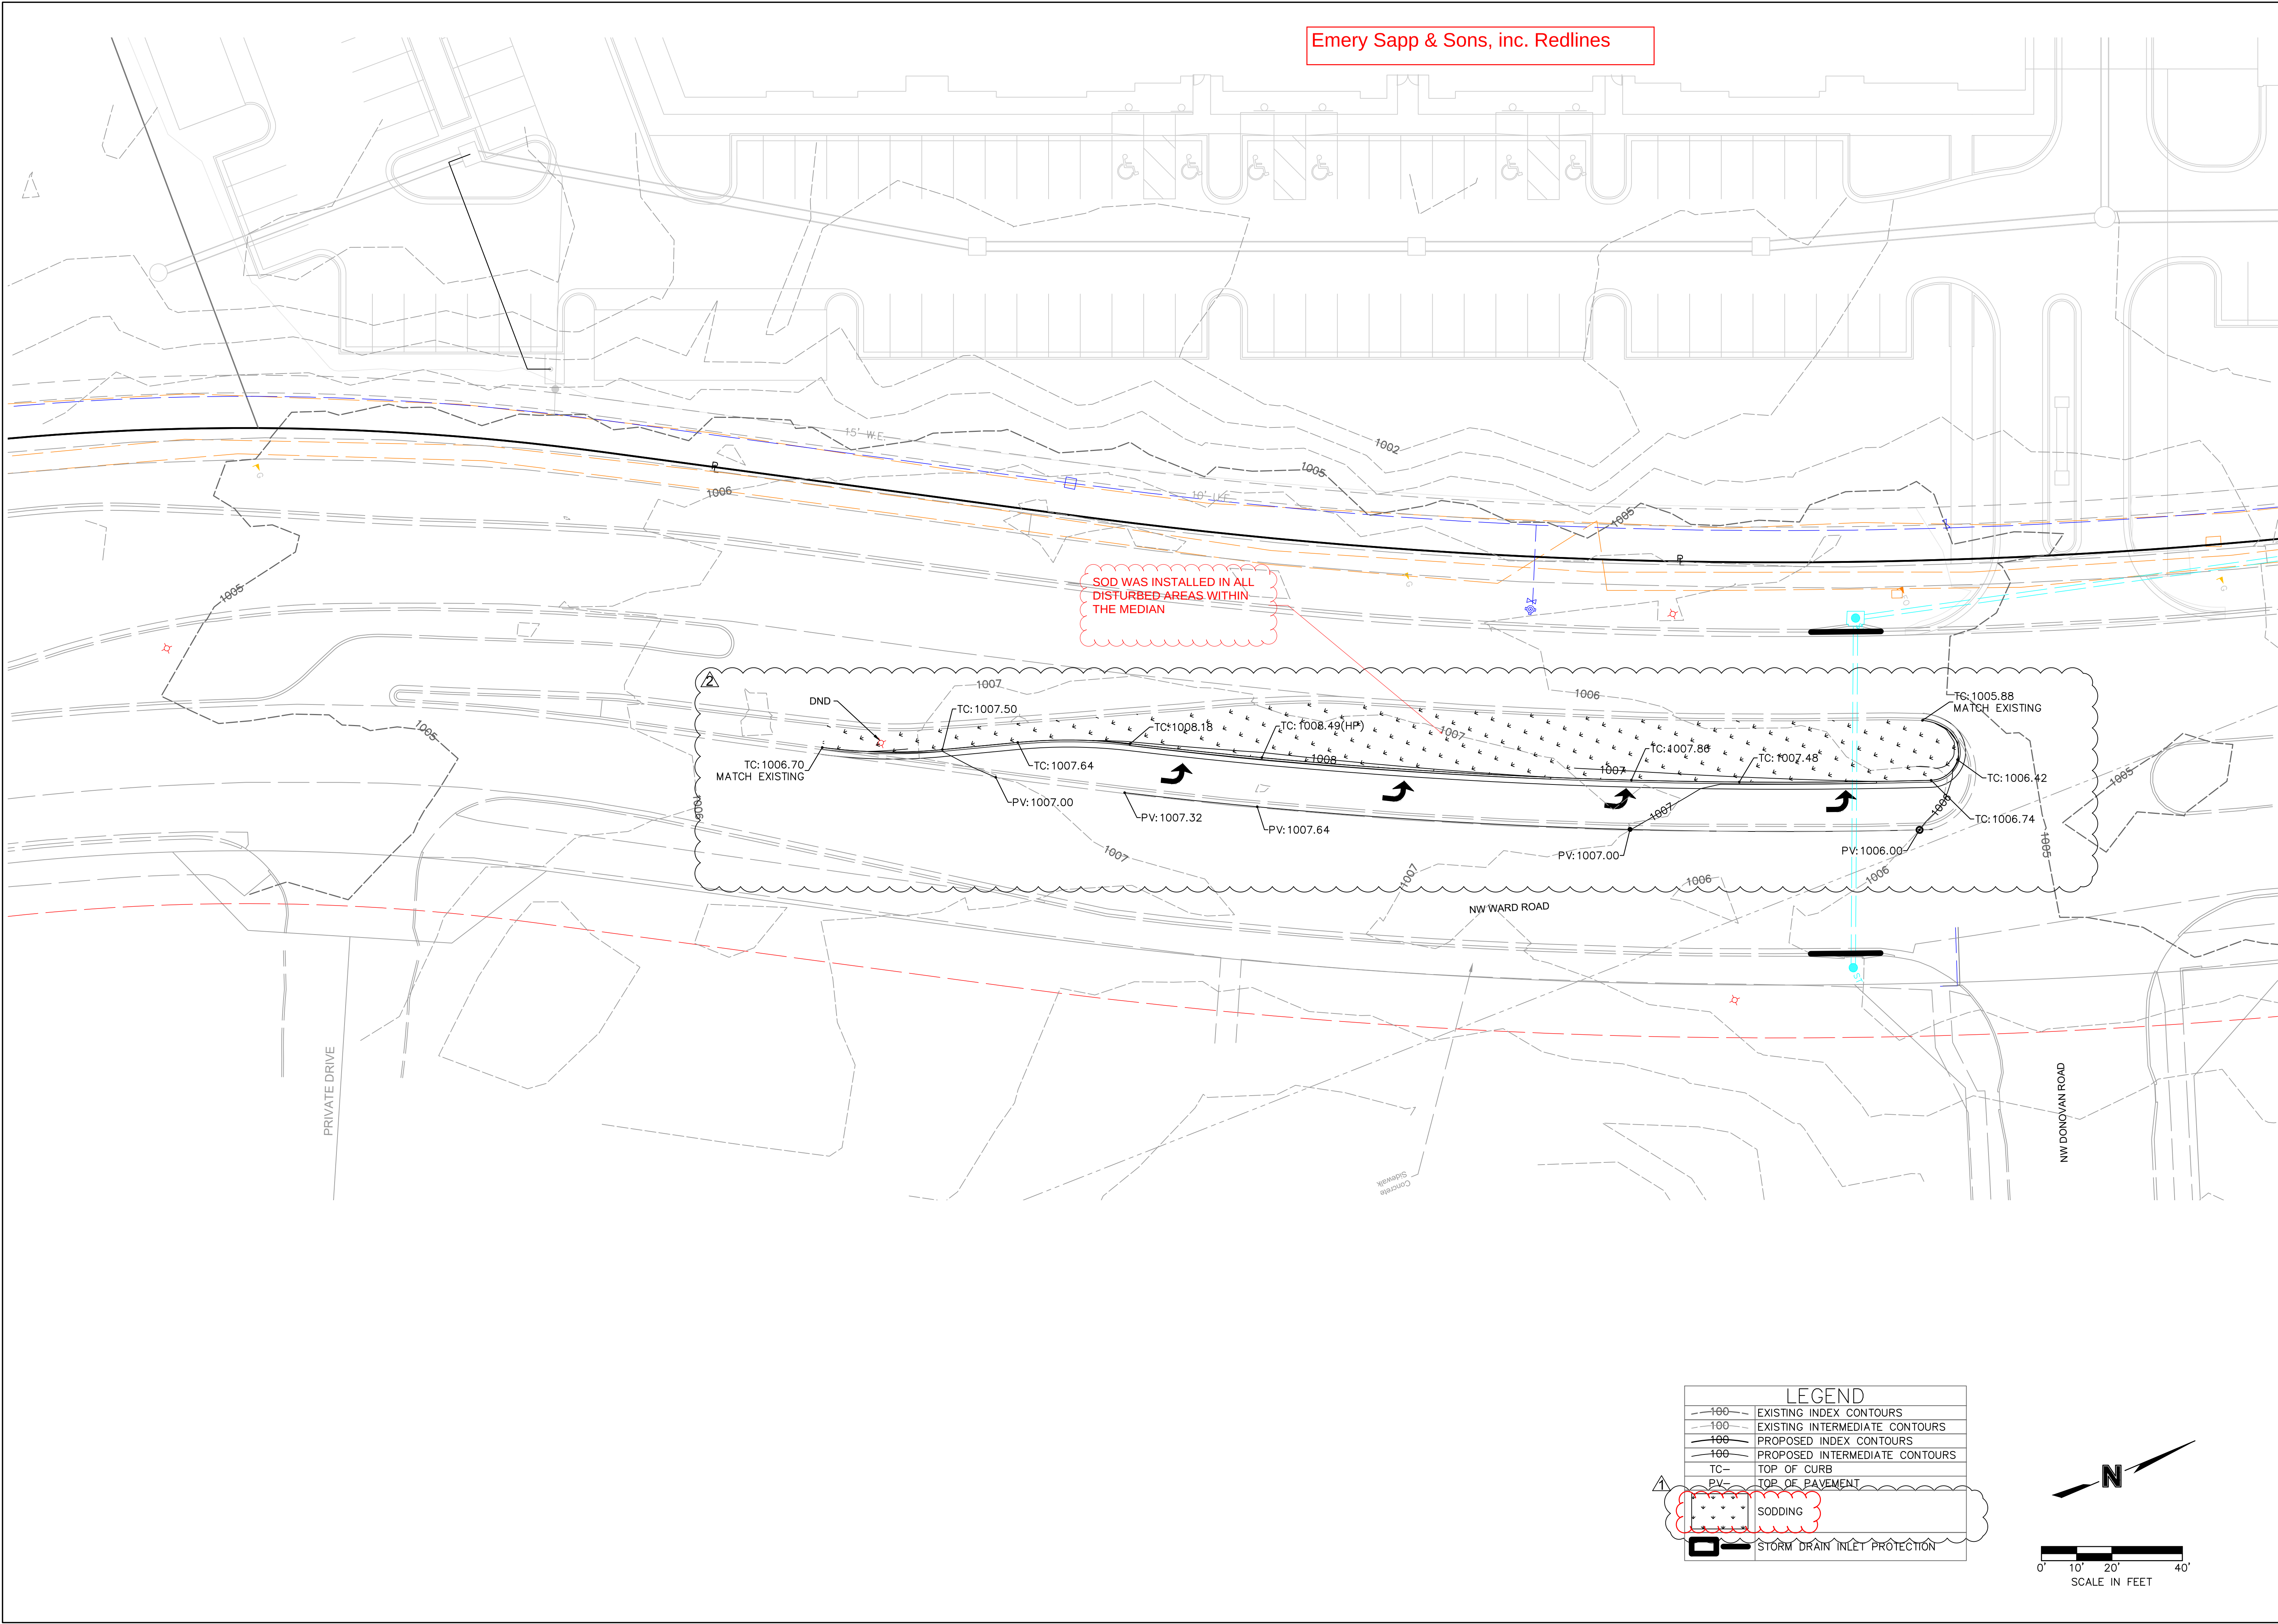

Emery Sapp & Sons, inc. Redlines

LEGEND	
	EXISTING INDEX CONTOURS
	EXISTING INTERMEDIATE CONTOURS
	PROPOSED INDEX CONTOURS
	PROPOSED INTERMEDIATE CONTOURS
	TOP OF CURB
	TOP OF PAVEMENT
	SODDING
	STORM DRAIN INLET PROTECTION

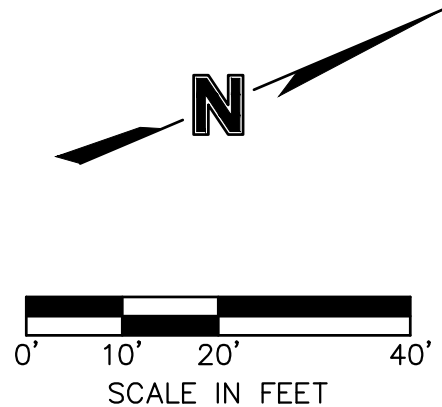

A Division of NorthPoint Development

3315 N Oak Trafficway
Kansas City, MO 64116

816.888.7380
sitepoint@northpointkc.com

REVISIONS/APPROVALS:	
NO.	DATE
1	2023 02 16
2	2023 03 16
3	2023 06 21
4	
5	
6	
7	
8	
9	
10	

REVISIONS/APPROVALS:	
NO.	DATE
1	2023 02 16
2	2023 03 16
3	2023 06 21
4	
5	
6	
7	
8	
9	
10	

REVISIONS/APPROVALS:	
NO.	DATE
1	2023 02 16
2	2023 03 16
3	2023 06 21
4	
5	
6	
7	
8	
9	
10	

REVISIONS/APPROVALS:	
NO.	DATE
1	2023 02 16
2	2023 03 16
3	2023 06 21
4	
5	
6	
7	
8	
9	
10	

REVISIONS/APPROVALS:	
NO.	DATE
1	2023 02 16
2	2023 03 16
3	2023 06 21
4	
5	
6	
7	
8	
9	
10	