

SITE PLAN
1" = 40'-0"

SP1.00

DRAWING RELEASE LOG


O9.16.24 PERMIT SET

10.28.24 CITY COMMENTS

 \triangle REVISIONS

DRAWN BY SLW / KRM

1 09.13.24 FDP COMMENTS 1 2 10.28.24 PERMIT COMMENTS 2

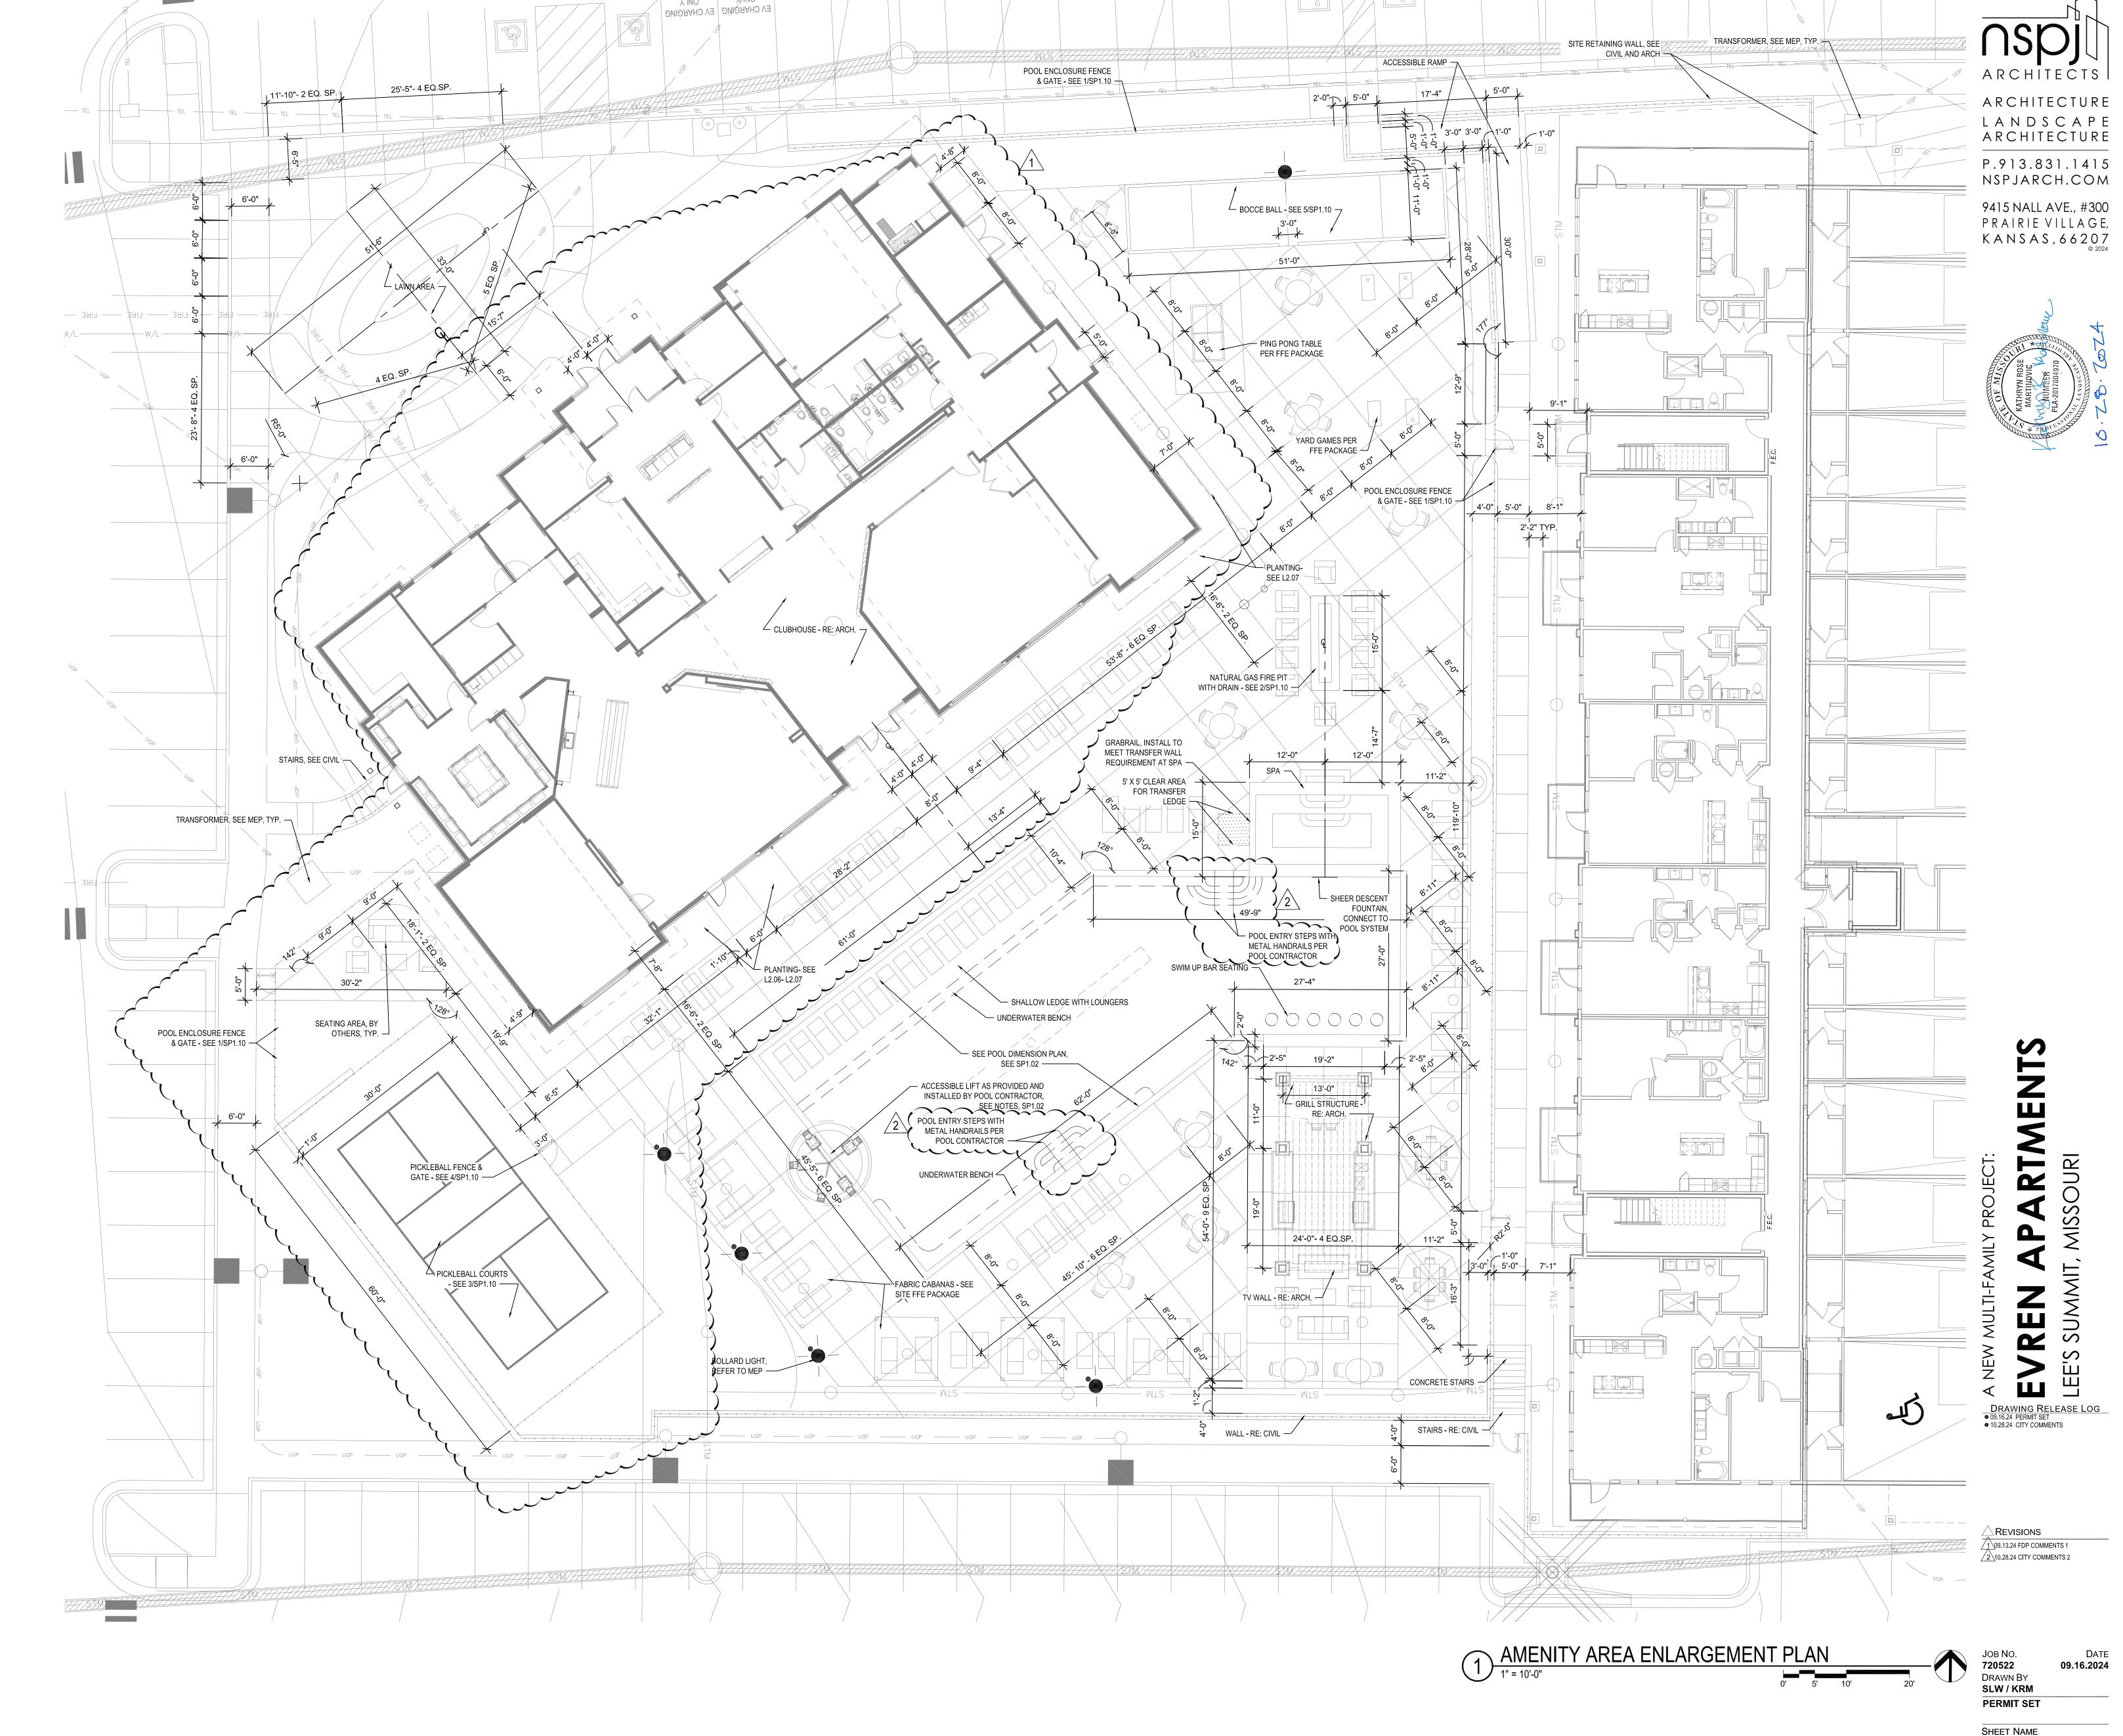

10/3/2022 2:48:43 F

SHEET NAME

AMENITY AREA

ENLARGEMENT PLAN

SHEET NO.

POOL DIMENSION PLAN

1/8" = 1'-0"

O' 5' 10' 20'

POOL NOTES

1. ALL POOL DRAWINGS AS PART OF THIS PACKAGE ARE TO CONVEY DESIGN INTENT. POOL IS TO BE DESIGN-BUILD AND ALL EQUIPMENT, PLUMBING, STRUCTURAL DETAILS, SAFETY EQUIPMENT, & SIGNAGE ARE TO BE PROVIDED BY THE POOL CONTRACTOR. PROVIDE MATERIAL AND COLOR SAMPLES TO THE LANDSCAPE ARCHITECT/OWNER FOR APPROVAL. ALL PERMITS & APPROVALS ARE THE RESPONSIBILITY OF THE CONTRACTOR.

2. PROVIDE SALT WATER FILTRATION SYSTEM FOR POOL.

3. ALL POOL LIGHTING TO BE COLOR CHANGING LED & BE CONTROLLABLE BY WIRELESS CONTROLLER.

4. POOL COPING TO BE BULL NOSED CAST STONE OR APPROVED EQUAL. COLOR AS APPROVED BY OWNER.

5. POOL CONTRACTOR TO PROVIDE REMOVABLE SAFETY COVER COMPLYING WITH ASTMF1346 FOR THE POOL.

6. POOL CONTRACTOR TO PROVIDE NO DIVING/DEPTH TILES IN POOL DECK FOR ALL AREAS PER CODE REQUIREMENTS.

7. FINAL SLOPES WITHIN POOL SHELL TO BE DETERMINED BY POOL CONTRACTOR AND MEET ALL APPLICABLE CODES.

8. CORD. BONDING FOR ANY METAL WITHIN 10' OF POOL WITH POOL CONTRACTOR.

ALL POOL GATES ARE TO BE SELF-CLOSING & SELF-LATCHING, INCLUDE A CRASH BAR/PANIC HARDWARE ON POOL SIDE OF GATE, AND OPEN AWAY FROM THE POOL. LOCATION, SIZE, AND STYLE OF FENCE AND GATES ARE AS SPECIFIED IN THE PLANS & DETAILS.


10. SLEEVE FOR ADA LIFT SHALL BE PROVIDED BY POOL CONTRACTOR ANCHORED PER MANUF. SPECS. POOL CONTRACTOR TO PROVIDE ACCESSIBLE LIFT.

11. REPORT ANY MISSING INFORMATION AND / OR DISCREPANCIES FOUND WITH REGARD TO EXISTING CONDITIONS OR PROPOSED DESIGN IMMEDIATELY TO THE LANDSCAPE ARCHITECT. DO NOT WILLFULLY PROCEED WITH CONSTRUCTION AS DESIGNED WHERE IT IS FOUND THAT KNOWN DISCREPANCIES EXIST. THE CONTRACTOR SHALL ASSUME FULL RESPONSIBILITY FOR ALL NECESSARY REVISIONS DUE TO FAILURE TO GIVE SUCH NOTIFICATION.


12. EMERGENCY PHONE TO BE PROVIDED BY POOL CONTRACTED AND LOCATED PER MEP PLANS, AS APPROVED BY OWNER.



3 SHEER DESCENT FOUNTAIN WITH LIGHTING

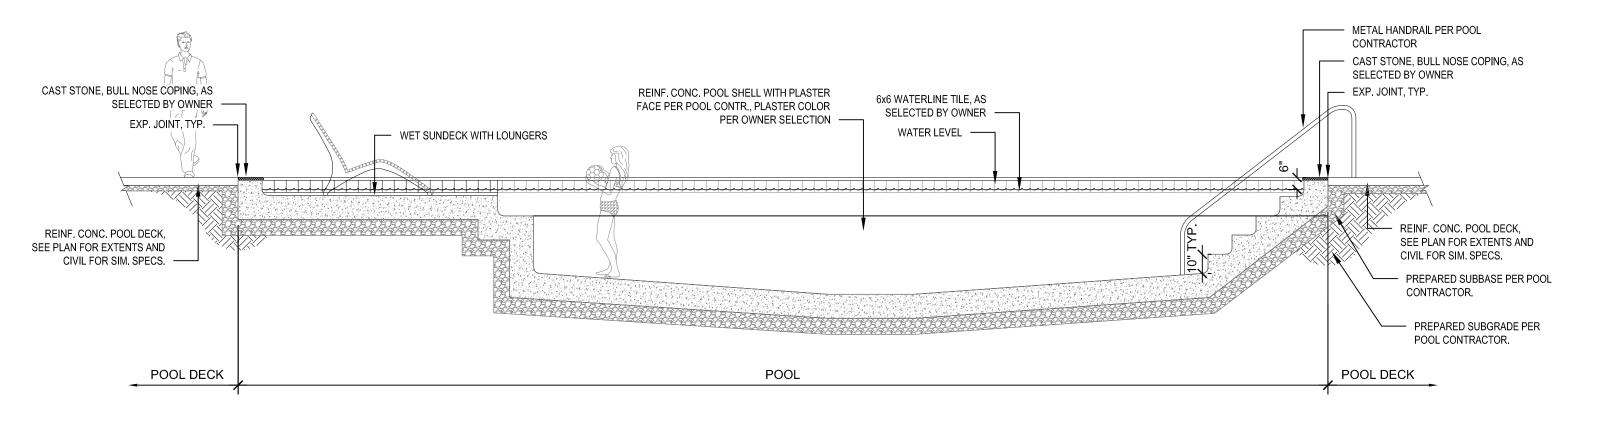

POOL SECTION

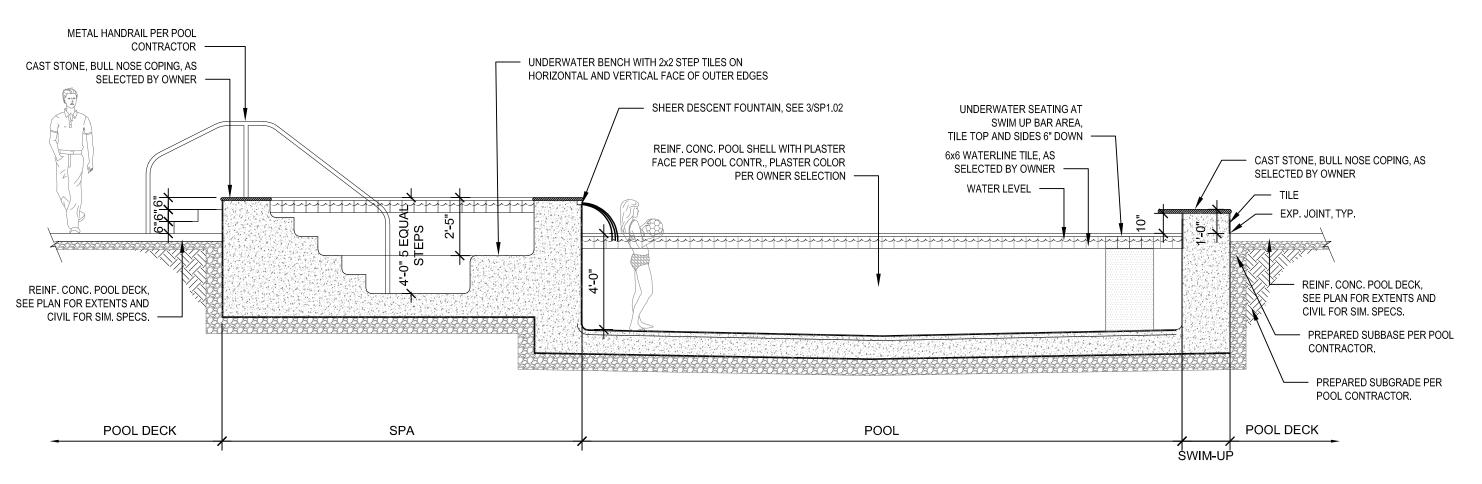

1) POOL SECTION

1/4" = 1'-0"

ARCHITECTS

ARCHITECTURE
LANDSCAPE
ARCHITECTURE
P.913.831.1415

NSPJARCH.COM

9415 NALL AVE., #300
PRAIRIE VILLAGE,
KANSAS, 66207



VEW MULII-FAMILY PROJECT:

VREN APARTMENT

SE'S SUMMIT, MISSOURI

REVISIONS


1 10.28.24 CITY COMMENTS 2

• 10.28.24 CITY COMMENTS


JOB NO. DATE
720522 09.16.2024
DRAWN BY
SLW / KRM
PERMIT SET

SHEET NAME
POOL DIMENSION
PLAN & SECTIONS
SHEET NO.


- 1. UNLESS NOTED OTHERWISE IN THE PLANS & DETAILS, NEAT EXCAVATE ALL FOOTINGS INTO 2000 PSF (MIN.) SOIL (FIELD VERIFY). 3000 PSI CONC. (+/- 4" SLUMP).
- 2. ALL EXPANSION JOINTS (EJ) TO HAVE SELF LEVELING CAULK OVER FELT TO SEAL COLOR TO MATCH ADJACENT PAVING.
- 3. VERIFY ALL STRUCTURAL INFORMATION WITH STRUCTURAL ENGINEER, INCLUDING, BUT NOT LIMITED TO, WOOD MEMBER SIZES, ALL ANCHORING CONDITIONS, AND FOOTING/FOUNDATION SIZE AND REINEODOEMENT.
- 4. VERIFY ALL NOTED ELEVATIONS AGAINST CIVIL ENGINEER GRADING PLAN.
- 5. REPORT ANY DISCREPANCIES OR MISSING INFORMATION IMMEDIATELY TO THE LANDSCAPE
- ARCHITECT. DO NOT WILLFULLY PROCEED WITH CONSTRUCTION AS DESIGNED WHERE IT IS FOUND THAT KNOWN DISCREPANCIES EXIST. THE CONTRACTOR SHALL ASSUME FULL RESPONSIBILITY FOR
- ALL NECESSARY REVISIONS DUE TO FAILURE TO GIVE SUCH NOTIFICATION.
- 6. ALL WOOD MEMBERS TO BE S4S CEDAR, STAINED PER SPECS., COLOR AS SELECTED BY OWNER

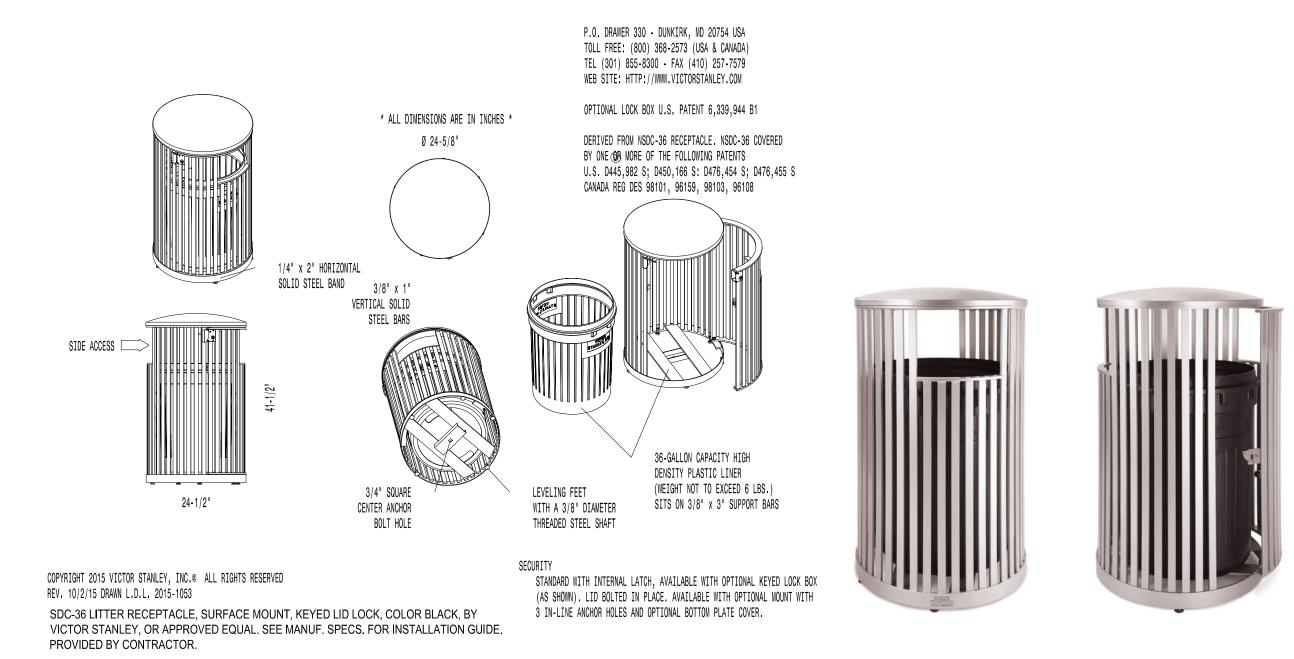

TRASH RECEPTACLE

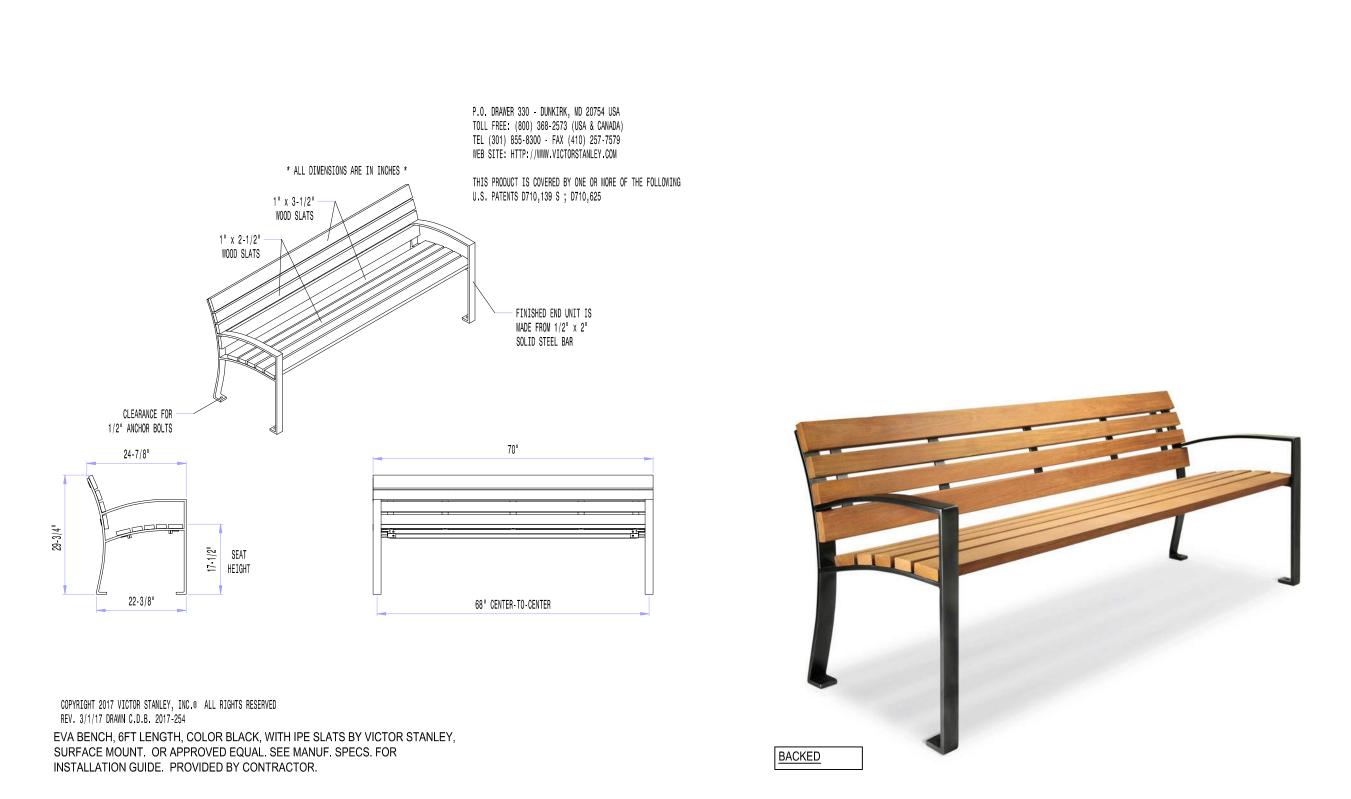


SITE BENCH

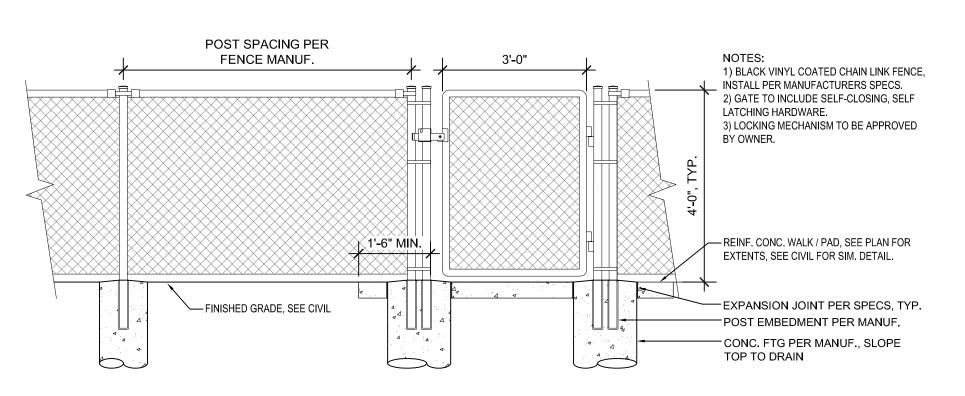

DOG PARK FENCE & GATE

1/2" = 1'-0"

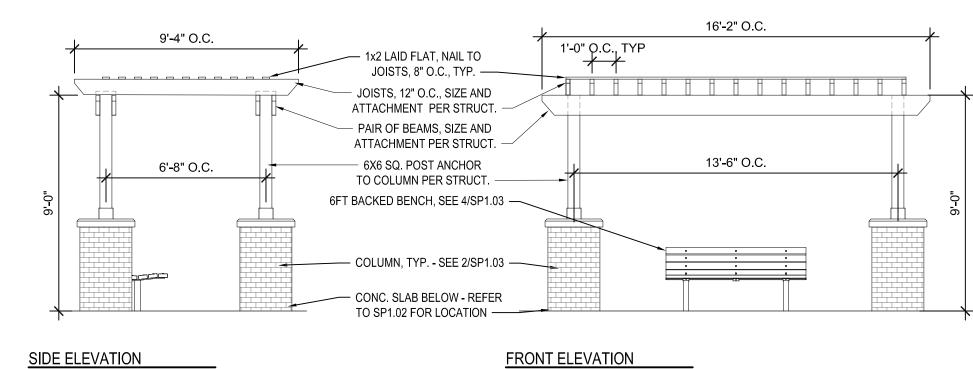

✓ 6x6 SQ. WOOD POST, ANCHOR PER STRUCT. 1X5 WOOD TRIM, 45° CHAMFER ON ALL CORNERS, SILICONE SEAL AT BASE, ALL CAST STONE CAPS TO HAVE DRIP EDGE ON UNDERSIDE, COLOR TO MATCH COLUMN CAP NEAR OUTSIDE EDGE -- 4" THICK CAST STONE CAP, 1" CHAMFER ON TOP EDGE, AS SELECTED BY OWNER, SLOPED SLIGHTLY FOR DRAINAGE, 2" OVERHANG, TYP. PIN IN PLACE, SILICONE SEAL ALL JOINTS, COLOR TO MATCH STONE TOP COURSE CMU TO CONCEAL BASE PLATE EPDM FLASHING W/ METAL DRIP EDGE, TYP. POST ANCHOR PER STRUCT. FULL WYTH BRICK TO MATCH ARCH. INSTALL PER MANUF. SPECS. INSTALL WALL TIES PER REINF. CMU COLUMN CORE, PER STRUCT. WATERPROOF OUTSIDE FACES PER MANUF. SPECS. REINF. CONC. PATIO, SEE PLAN FOR EXTENTS, SEE CIVIL FOR PAVING DETAILS. EXPANSION JOINT PER SPECS, TYP. REINF. CONC. FTG. PER STRUCT. ALL FOOTING DIMENSIONS ARE SHOWN ON THESE PLANS ARE FOR REFERENCE ONLY. VERIFY

DIMENSIONS IN STRUCTURAL DRAWINGS AND

NOTIFY LANDSCAPE ARCHITECT OF ANY

DISCREPANCIES PRIOR TO PROCEEDING.

COLUMN, TYP. - SEE
2/SP1.03

6FT BACKED BENCH,
SEE 4/SP1.03

TRELLIS ABOVEREFER TO ELEVATION

PLAN

13'-6"


11'-4"

2/SP1.03

FRONT ELEV.

3 COLUMN - SECTION
1/2" = 1'-0"

TRELLIS W/ SEATING

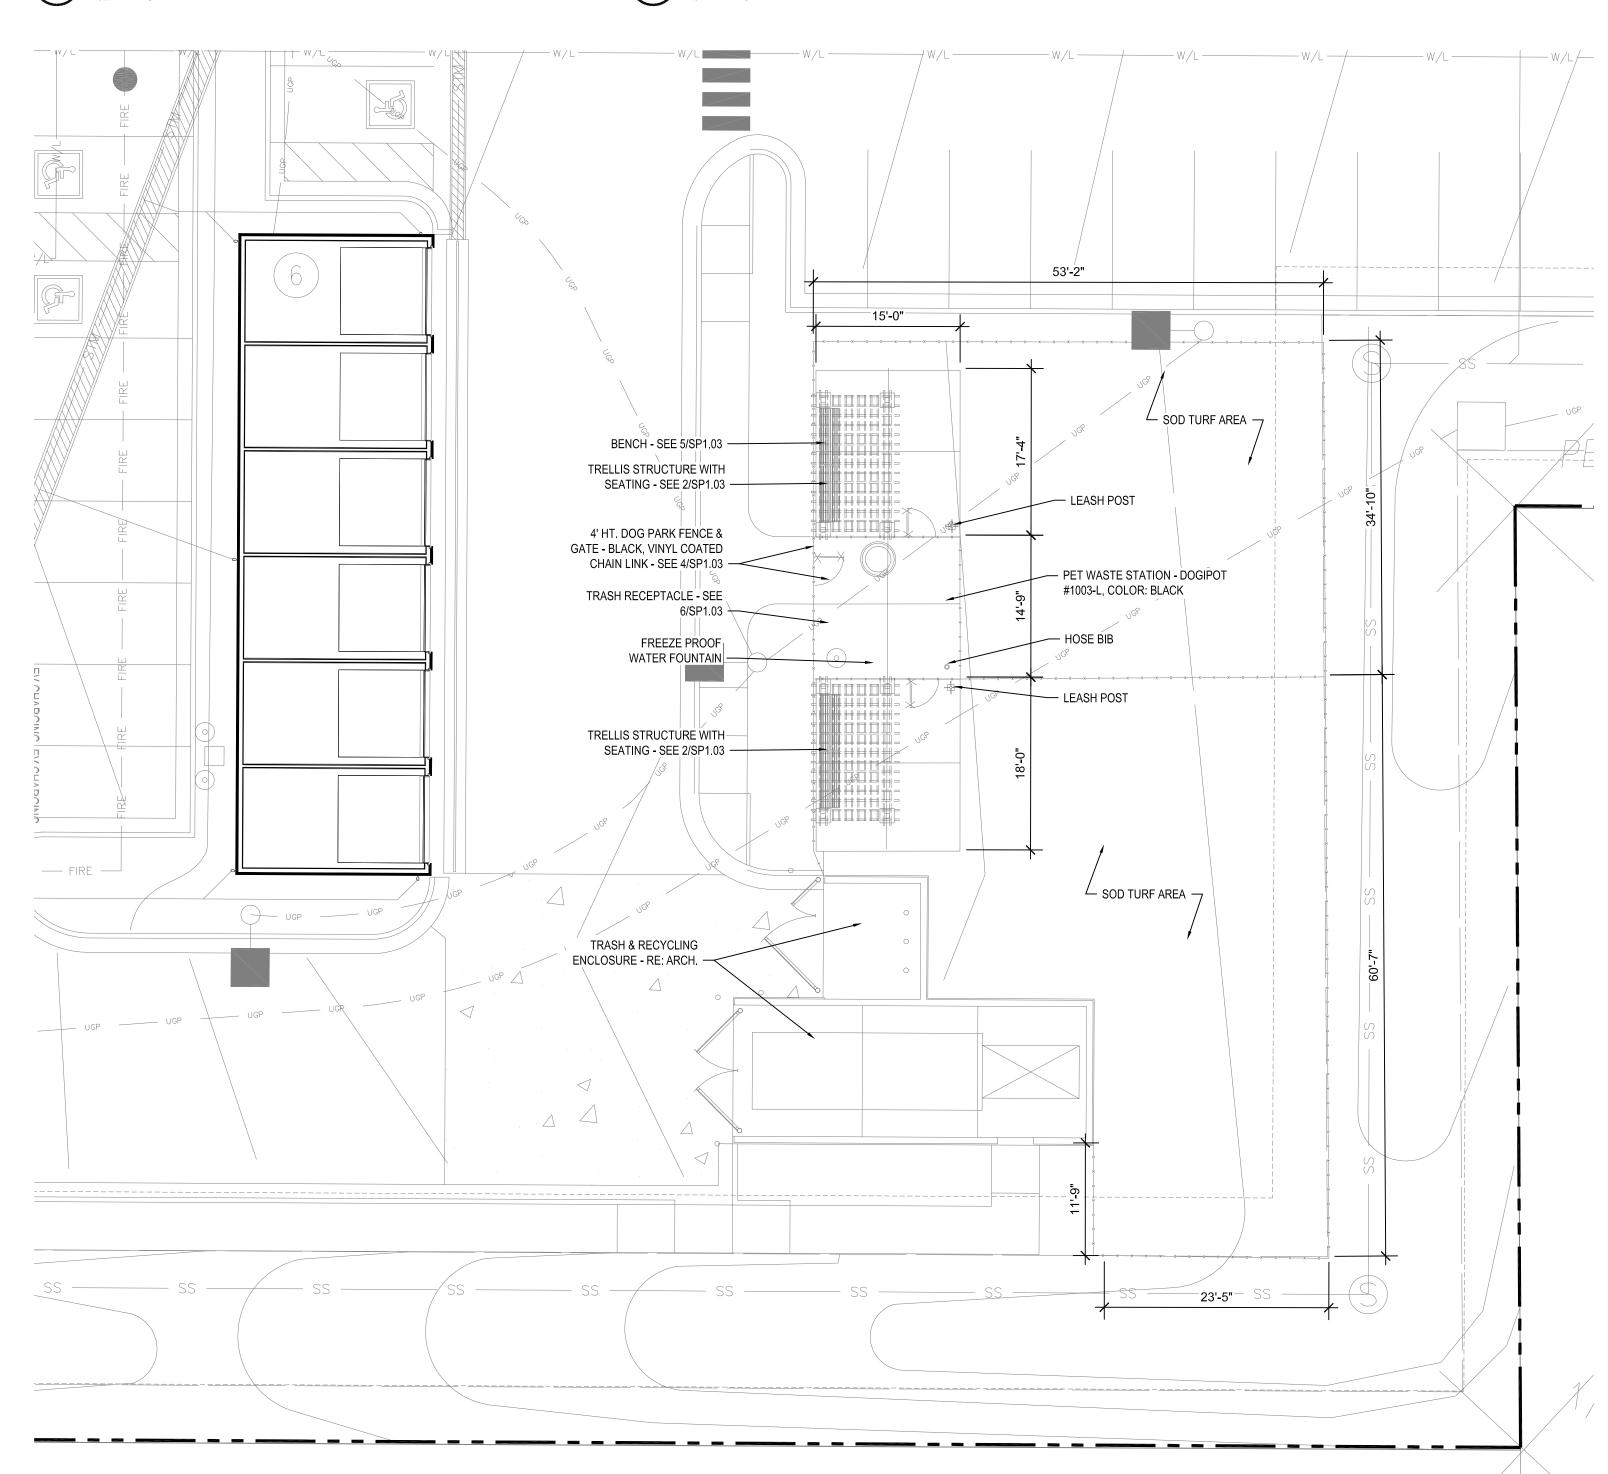

1 DOG PARK ENLARGEMENT

ARCHITECTS

ARCHITECTURE
LANDSCAPE
ARCHITECTURE

P.913.831.1415

NSPJARCH.COM

9415 NALL AVE., #300 PRAIRIE VILLAGE, KANSAS, 66207



EVREN APARTMENTS

LEE'S SUMMIT, MISSOURI

DRAWING RELEASE LOG

• 09.16.24 PERMIT SET

• 10.28.24 CITY COMMENTS

REVISIONS
10.28.24 CITY COMMENTS 2

JOB NO. DATE
720522 09.16.2024
DRAWN BY
SLW / KRM
PERMIT SET

SHEET NAME
ENLARGEMENT PLAN

SP1.03

UNLESS NOTED OTHERWISE IN THE PLANS & DETAILS, NEAT EXCAVATE ALL FOOTINGS INTO 2000 PSF (MIN.) SOIL (FIELD VERIFY). 3000 PSI CONC. (+/- 4" SLUMP).

ALL EXPANSION JOINTS (EJ) TO HAVE SELF LEVELING CAULK OVER FELT TO SEAL - COLOR TO MATCH ADJACENT PAVING. VERIFY ALL STRUCTURAL INFORMATION WITH STRUCTURAL ENGINEER, INCLUDING, BUT NOT LIMITED TO, WOOD MEMBER

SIZES, ALL ANCHORING CONDITIONS, AND FOOTING/FOUNDATION SIZE AND REINFORCEMENT.

4. VERIFY ALL NOTED ELEVATIONS AGAINST CIVIL ENGINEER GRADING PLAN.


REPORT ANY DISCREPANCIES OR MISSING INFORMATION IMMEDIATELY TO THE LANDSCAPE ARCHITECT. DO NOT WILLFULLY PROCEED WITH CONSTRUCTION AS DESIGNED WHERE IT IS FOUND THAT KNOWN DISCREPANCIES EXIST. THE CONTRACTOR SHALL ASSUME FULL RESPONSIBILITY FOR ALL NECESSARY REVISIONS DUE TO FAILURE TO GIVE SUCH NOTIFICATION.

6. ALL WOOD MEMBERS TO BE S4S CEDAR, STAINED PER SPECS., COLOR AS SELECTED BY OWNER




KANSAS,66207



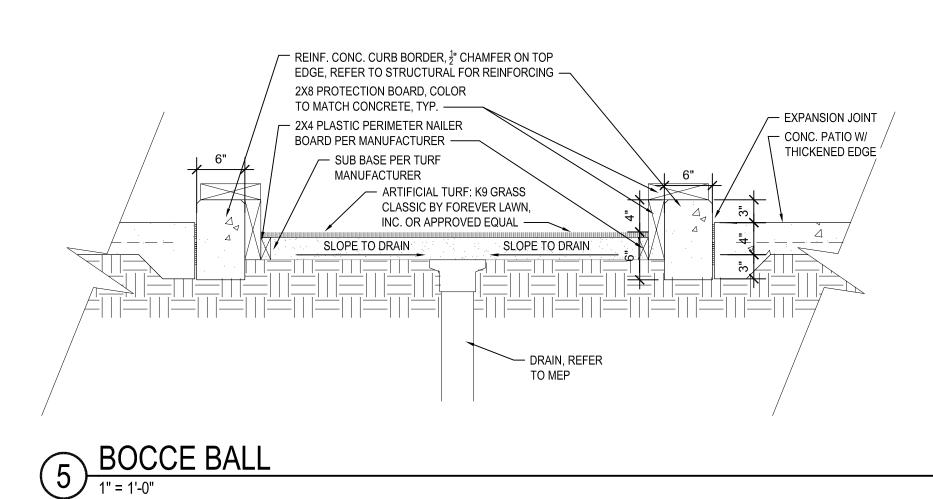

8'-0" HT. BLACK VINYL COATED CHAIN LINK FENCE W/ FABRIC SCREEN, INSTALL AIR VENTS EVERY 8-12' O.C., INSTALL PER MANUFACTURERS SPECIFICIATIONS. — EXPANSION JOINT, TYP. — SPORT COURT PAVING, NOVAPLAY PICKLEBALL SURFACE, INSTALLED PER MANUFACTURER'S SPECS. — 6" GRAVEL BED OVER COMPACTED SUB-GRADE — CONC. FTGS/CURB FOR GATE REINFORCED CONC. SUB-SLAB, REBAR POSTS PER MANUF. SPECS. SLOPE TOP SLIGHTLY FOR DRAINAGE. PER MANUF. RECOMMENDATION, PIN SLAB TO FENCE FOOTING ————

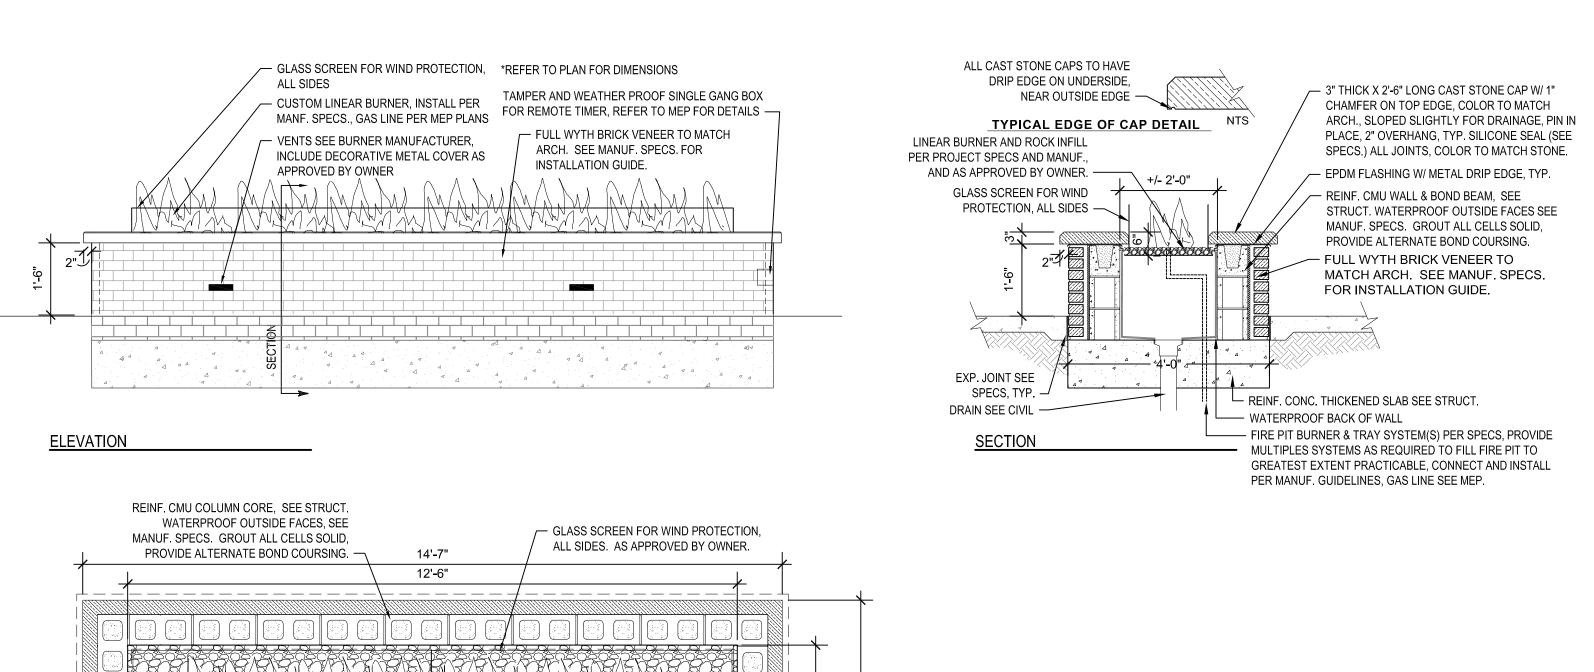

- DRAIN PER MEP

APPROVED BY OWNER.

FIRE PIT BURNER & TRAY SYSTEM(S) PER SPECS, PROVIDE

MULTIPLES SYSTEMS AS REQUIRED TO FILL FIRE PIT TO


GREATEST EXTENT PRACTICABLE, CONNECT AND INSTALL

PER MANUF. GUIDELINES, GAS LINE SEE MEP.

- ROCK INFILL PER PROJECT SPECS, AND AS

— FULL WYTH BRICK VENEER TO MATCH ARCH.

SEE MANUF. SPECS. FOR INSTALLATION GUIDE.

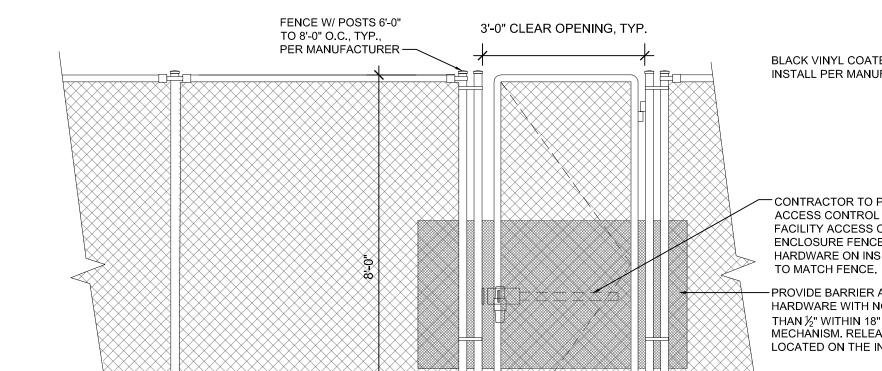

BLACK VINYL COATED CHAIN LINK FENCE, INSTALL PER MANUF. SPECS. CONTRACTOR TO PROVIDE AND INSTALL EXTERIOR ACCESS CONTROL HARDWARE IN CONJUNCTION WITH FACILITY ACCESS CONTROL SYSTEM ON OUTSIDE OF ENCLOSURE FENCE AND A CRASH BAR/PANIC HARDWARE ON INSIDE OF FENCE PERIMETER. COLOR TO MATCH FENCE. - PROVIDE BARRIER AROUND PANIC HARDWARE WITH NO OPENING GREATER THAN ½" WITHIN 18" OF RELEASE MECHANISM. RELEASE MECHANISM TO BE LOCATED ON THE INSIDE OF GATE. CONC. FTGS FOR GATE POSTS PER MANUF. SPECS. SLOPE TOP SLIGHTLY FOR DRAINAGE.

POST SPACING PER 3'-0" CLEAR CONTRACTOR TO PROVIDE AND INSTALL EXTERIOR FENCE MANUF. OPENING, TYP. ACCESS CONTROL HARDWARE IN CONJUNCTION WITH FACILITY ACCESS CONTROL SYSTEM ON OUTSIDE (NON-POOL SIDE) OF ENCLOSURE FENCE AND A POST SIZE VARIES, 1) AMERISTAR ECHELON PLUS, 3 RAIL MAJESTIC GATE & CRASH BAR/PANIC HARDWARE ON INSIDE (POOL SIDE) FENCE, OR APPROVED EQUAL. GATE IS TO BE SELF-CLOSING, SEE MANUF. SPECS OF FENCE PERIMETER. COLOR TO MATCH FENCE. SELF-LATCHING, COLOR: BLACK 2) CONTRACTOR TO PROVIDE AND INSTALL IMPACT ----PICKET -PROVIDE BARRIER AROUND PANIC REDUCING HINGE/CLOSER IN CONJUNCTION WITH ALL OTHER HARDWARE WITH NO OPENING GREATER GATE HARDWARE, THIS HINGE/CLOSER SHOULD BE THAN ½" WITHIN 18" OF RELEASE SUBMITTED TO THE LANDSCAPE ARCHITECT FOR REVIEW MECHANISM. RELEASE MECHANISM TO BE LOCATED ON THE POOL SIDE OF GATE. 3) PROVIDE WALL MOUNT BRACKETS WHERE FENCE OF APPROACH PROVIDE 12" HT. SMOOTH SURFACE KICK ATTACHES TO BUILDING COLUMNS AND/OR WALLS. WALK, TYP. PLATE ON BOTH SIDES OF GATE, LEVEL 4) WHERE POSTS ARE LOCATED ON PAVED SURFACE AND WITH BOTTOM OF GATE PICKETS, COLOR NOT EMBEDDED IN A FOOTING, PAVEMENT SHOULD BE TO MATCH GATE. ALL EXPOSED EDGES CROWNED SLIGHTLY AT EACH POST FOR DRAINAGE. / RIVER ROCK OR HARDWOOD TO BE SMOOTH / ROUNDED. SURFACE MOUNT HARDWARE TO BE PROVIDED AND MULCH PER SPECS, SEE INSTALLED PER MANUF. SPECS. CONTRACTOR ALSO TO POOL, PET, & PLAY SPRING HINGE, PLAN, EXTEND TO BOTTOM PROVIDE SAFETY CAPS FOR ALL EXPOSED BOLTS OR NUTS, QUANTITY PER FENCE MANUF. / OF PICKETS AND OVER TOP AND ALL EXPOSED SHARP EDGES SHOULD BE GROUND EXPANSION JOINT PER SPECS, TYP. OF FOOTINGS. SMOOTH REPAINTED TO MATCH. REINF. CONC. POOL DECK / SIDEWALK, SEE PLAN FOR EXTENTS, SEE CIVIL FOR SIM. DETAIL. FINISHED GRADE PER CIVIL +POST EMBEDMENT POST EMBEDMENT PER MANUF. PER MANUF. CONC. FTG PER MANUF., SLOPE L SEE NOTES \pm CONC. FTG PER MANUF. SLOPE TOP TO DRAIN PAVED SURFACE LANDSCAPE BED SEE PLAN FOR FENCE LOCATION AND TREATMENT OF SURFACE BELOW.

POOL ENCLOSURE FENCE & GATE

1/2" = 1'-0"

☐ 3" THICK CAST STONE CAP W/ 1"

CHAMFER ON TOP EDGE, COLOR TO

MATCH ARCH., SLOPED SLIGHTLY

FOR DRAINAGE, PIN IN PLACE, 2"

MATCH STONE

OVERHANG, TYP. SILICONE SEAL

(SEE SPECS.) ALL JOINTS, COLOR TO

0.064 - 0.069 gallons per sq. yd., per coat 130 - 140 sq. ft. per gallon per coat Black, Blue, Brown, Burgundy, Classic Green, Grass Green, Grey, Nova Green, Red, Sand Dune, Stadium Blue, Terra Cotta 5 gallon pail or 30 gallon drum 14 lbs per gallon Minimum Application Temperature is 50°F and rising. Application is with a neoprene rubber squeegee as described on page 7.

NOVAPLAY is not hazardous* and is free of lead, mercury, asbestos and formaldehyde.

6 PICKLEBALL COURT PAVING DETAIL

09.16.2024

DRAWING RELEASE LOG

• 10.28.24 CITY COMMENTS

REVISIONS

720522

DRAWN BY

SLW / KRM

PERMIT SET

SHEET NAME SITE DETAILS

NOVAPLAY NOVAPLAY is a high performance, heavy duty, color coating system for pavements that are subjected to more wear than tennis courts. The appearance of Novaplay is very similar to that of a tennis court surface, however, it is formulated with a tougher acrylic emulsion so as to be able to stand up to abuse from street

shoes, roller skates, skateboards, vehicular traffic and objects such as furniture legs, This textured, non-skid, heavy duty surface coating is ideally suited for use on basketball courts, playgrounds, walkways, wheelchair and handicap ramps, and all other pavements where there is a need for an attractive color surfac e that can

stand up to a lot of abuse. Novaplay is available in all the standard Novacrylic colors. We recommend two coats of undiluted Novaplay for maximum performance and best appearance.


SPREADING RATE COLOR PACKAGED QUANTITY WEIGHT


COLOR TO BE SELECTED BY OWNER

3 PICKLEBALL FENCE & GATE


1/2" = 1'-0"

- 1. UNLESS NOTED OTHERWISE IN THE PLANS & DETAILS, NEAT EXCAVATE ALL FOOTINGS INTO 2000 PSF (MIN.) SOIL (FIELD VERIFY). 3000 PSI CONC. (+/- 4" SLUMP).
- 2. ALL EXPANSION JOINTS (EJ) TO HAVE SELF LEVELING CAULK OVER FELT TO SEAL COLOR TO MATCH ADJACENT PAVING.
- 3. VERIFY ALL STRUCTURAL INFORMATION WITH STRUCTURAL ENGINEER, INCLUDING, BUT NOT LIMITED TO, WOOD MEMBER SIZES, ALL ANCHORING CONDITIONS, AND FOOTING/FOUNDATION SIZE AND REINFORCEMENT.
- 4. VERIFY ALL NOTED ELEVATIONS AGAINST CIVIL ENGINEER GRADING PLAN.
- REPORT ANY DISCREPANCIES OR MISSING INFORMATION IMMEDIATELY TO THE LANDSCAPE ARCHITECT. DO NOT WILLFULLY PROCEED WITH CONSTRUCTION AS DESIGNED WHERE IT IS FOUND THAT KNOWN DISCREPANCIES EXIST. THE CONTRACTOR SHALL ASSUME FULL RESPONSIBILITY FOR ALL NECESSARY REVISIONS DUE TO FAILURE TO GIVE SUCH NOTIFICATION.
- 6. ALL WOOD MEMBERS TO BE S4S CEDAR, STAINED PER SPECS., COLOR AS SELECTED BY OWNER

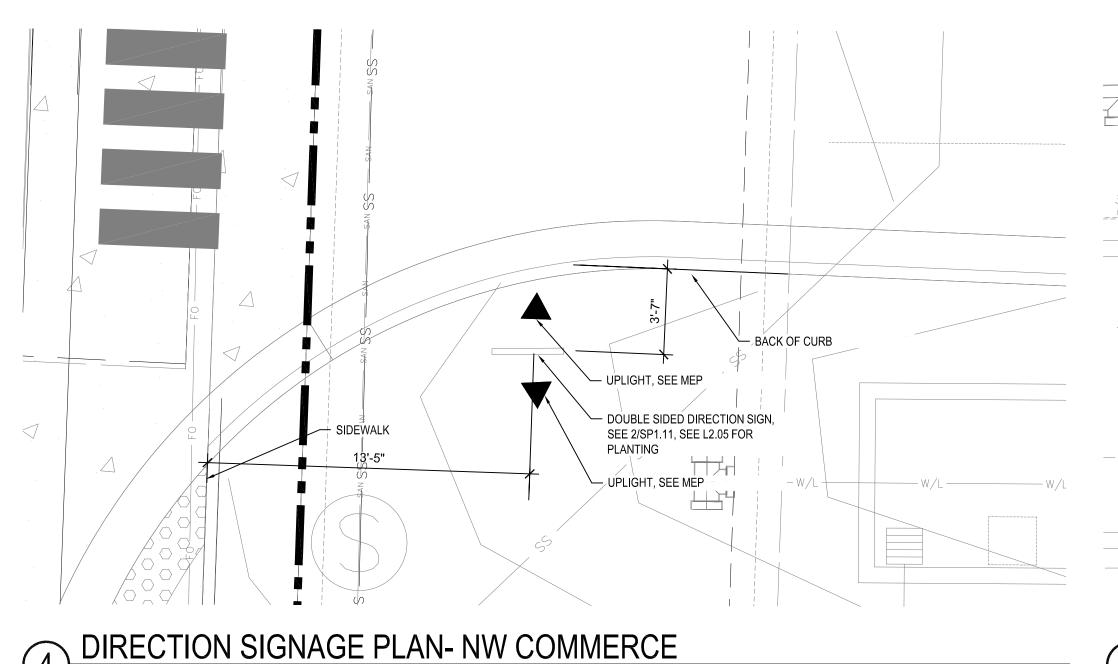

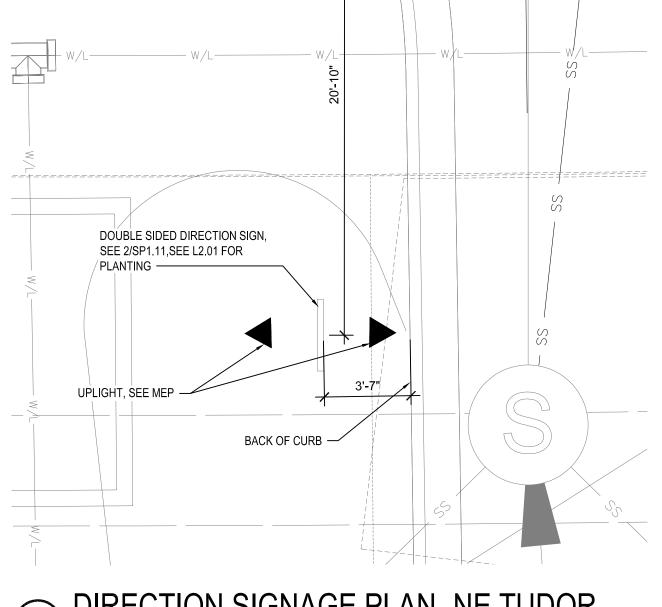

SIDEWALK -

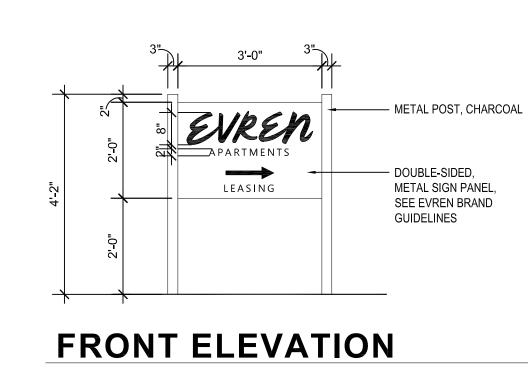

3" CAST STONE CAP, 2"



ARCHITECTS

ARCHITECTURE

L A N D S C A P E ARCHITECTURE

P.913.831.1415

NSPJARCH.COM

9415 NALL AVE., #300

PRAIRIE VILLAGE,

KANSAS,66207

DIRECTION SIGNAGE PLAN- NW COMMERCE

1/4 = 1'-0"

3 DIRECTION SIGNAGE PLAN- NE TUDOR

PLAN

BER CEMENT LAP SIDING, COLOR-

HITE, METAL STUD FRAMING WITH

DENSGLASS AND WPM -

ALUMINUM SKIN, PER

COLOR: CHARCOAL -

FIXTURE, BLACK -

STRUCTURAL,

MATERIAL -

BACKLIT LINEAR LIGHT

METAL STUD FRAME WITH

THIN BRICK VENEER, DARK

FINISH, TO MATCH ARCH.

DIRECTION SIGNAGE

1/2" = 1'-0"

– METAL STUD FRAME WITH 🖰 FIBER CEMENT LAP SIDING, COLOR- 🖰 THIN BRICK VENEER, DARK

ALUMINUM SKIN, COLOR: WHITE, METAL STUD FRAMING WITH FINISH, TO MATCH ARCH.

/ 3" CAST STONE CAP, 2"


- BLACK PIN MOUNTED, BACK


LIT LETTERS, SEE EVREN

BRAND GUIDELINES


DENSGLASS AND WPM

BACKLIT LINEAR LIGHT FIXTURE, BLACK

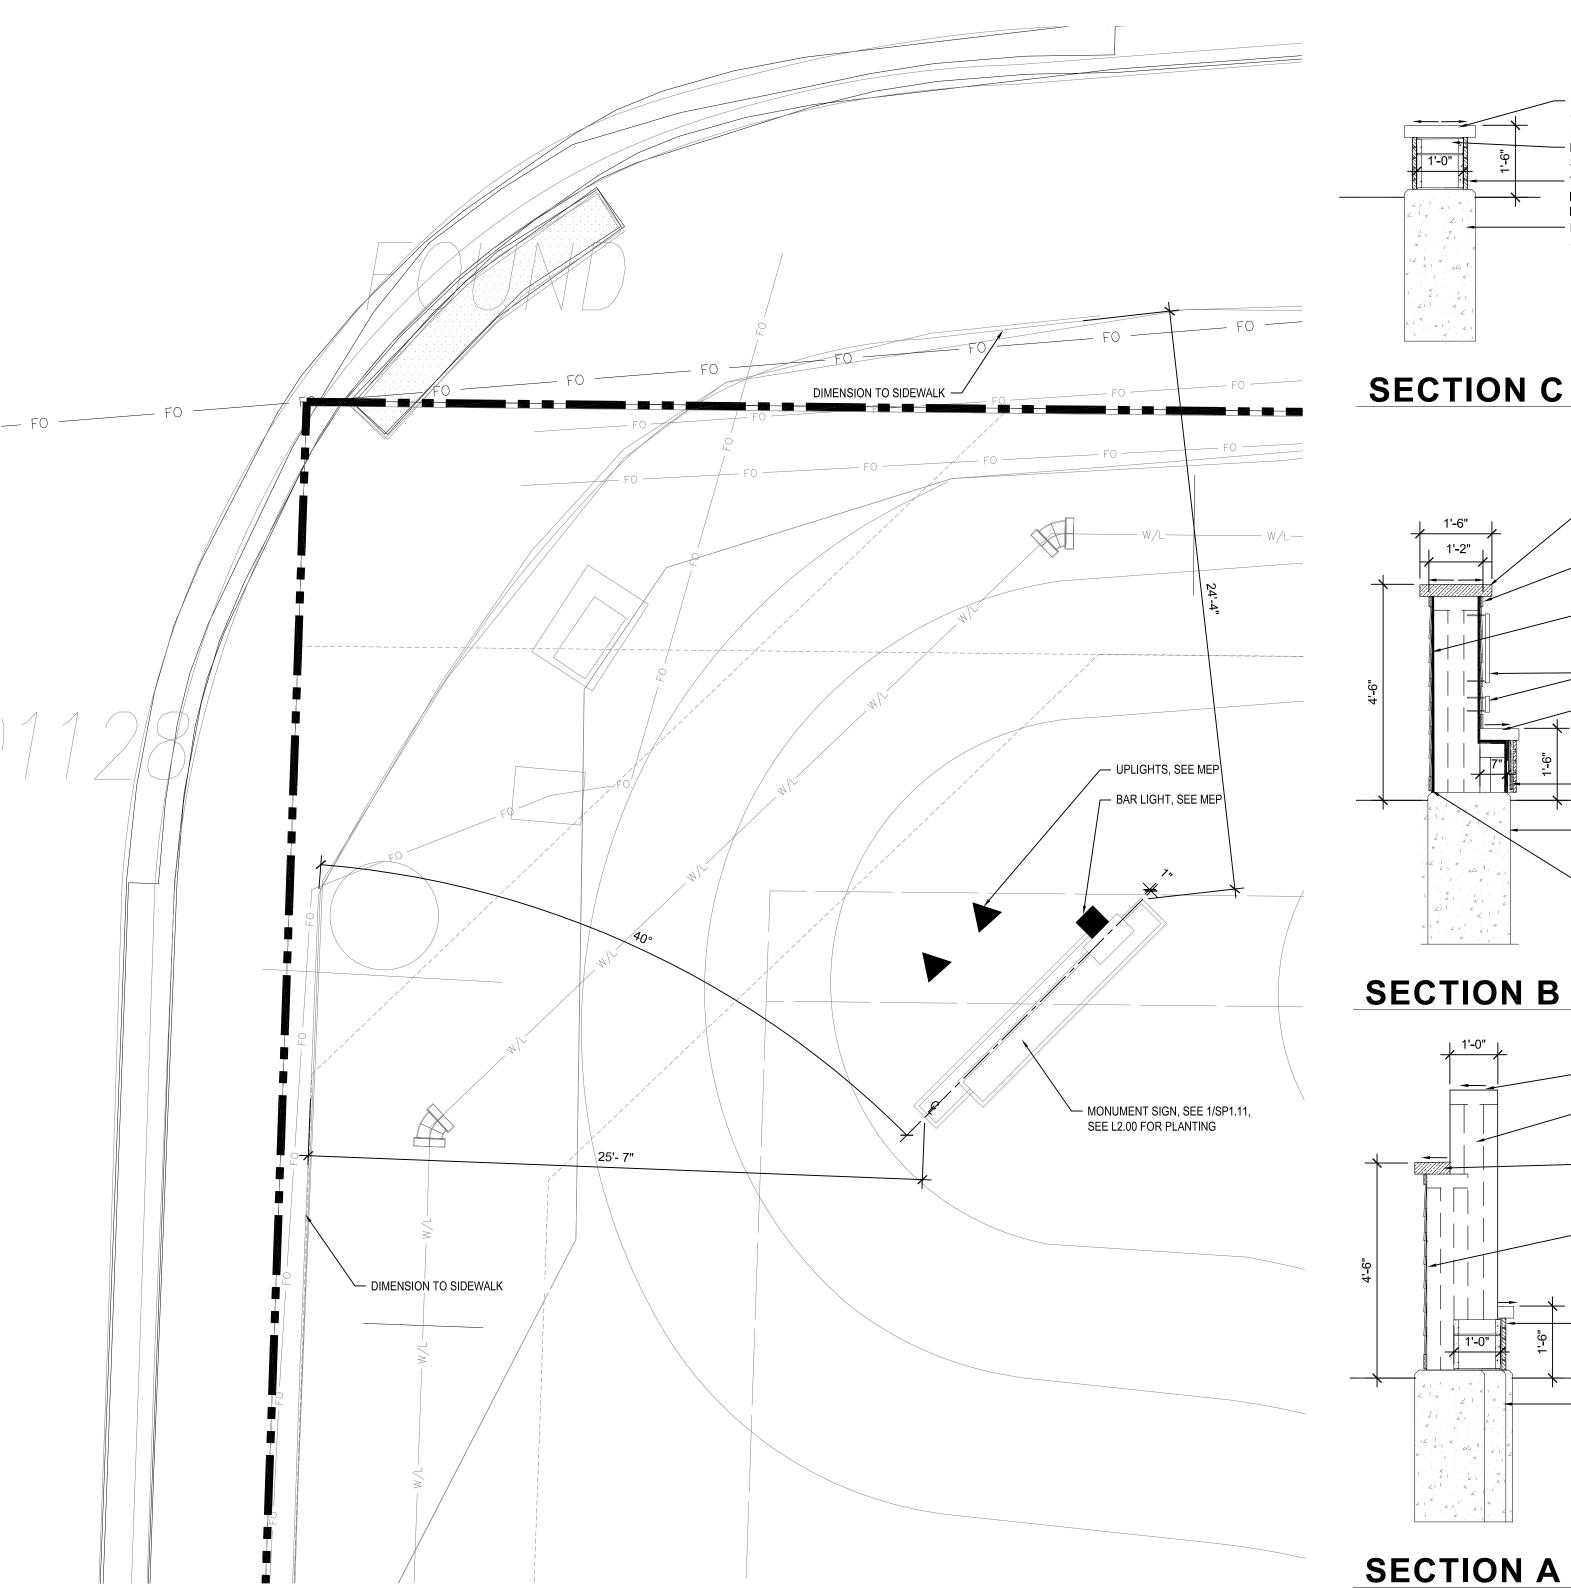

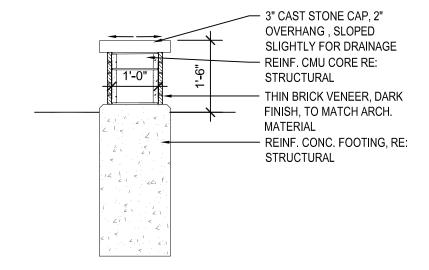

SECTION C

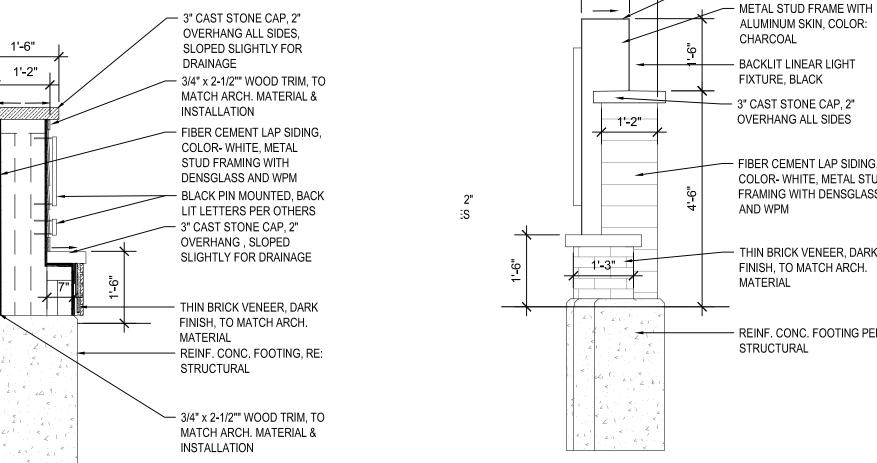

- SLOPE FOR DRAINAGE,

- METAL STUD FRAME WITH

ALUMINUM SKIN, COLOR:

- 3" CAST STONE CAP, 2"

OVERHANG ALL SIDES,

SLOPED SLIGHTLY FOR

COLOR- WHITE, METAL

DENSGLASS AND WPM

- THIN BRICK VENEER, DARK

REINF, CONC, FOOTING PER

FINISH, TO MATCH ARCH.


FIBER CEMENT LAP SIDING,

CHARCOAL


DRAINAGE

MATERIAL


STRUCTURAL

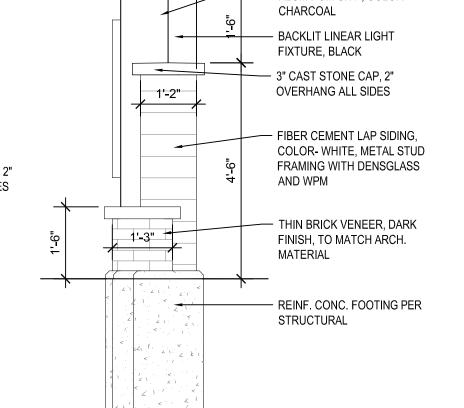



SLOPE FOR DRAINAGE,

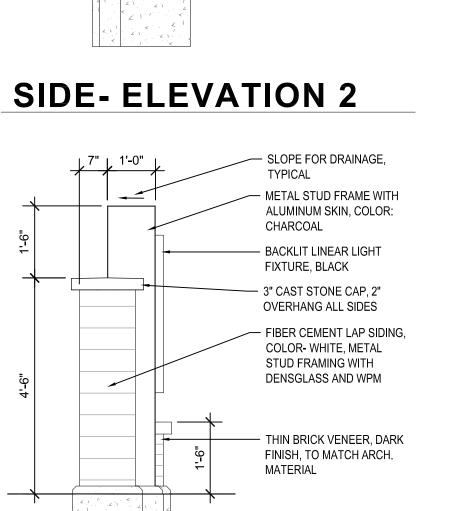

SIDE- ELEVATION 1

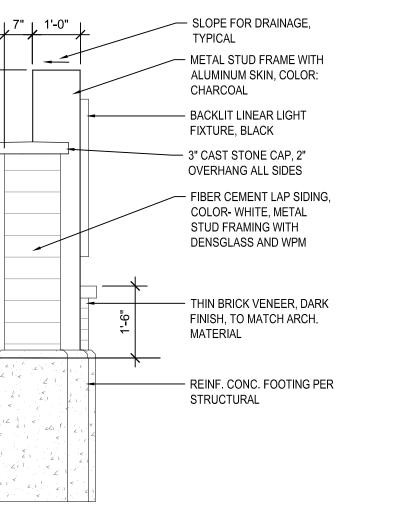

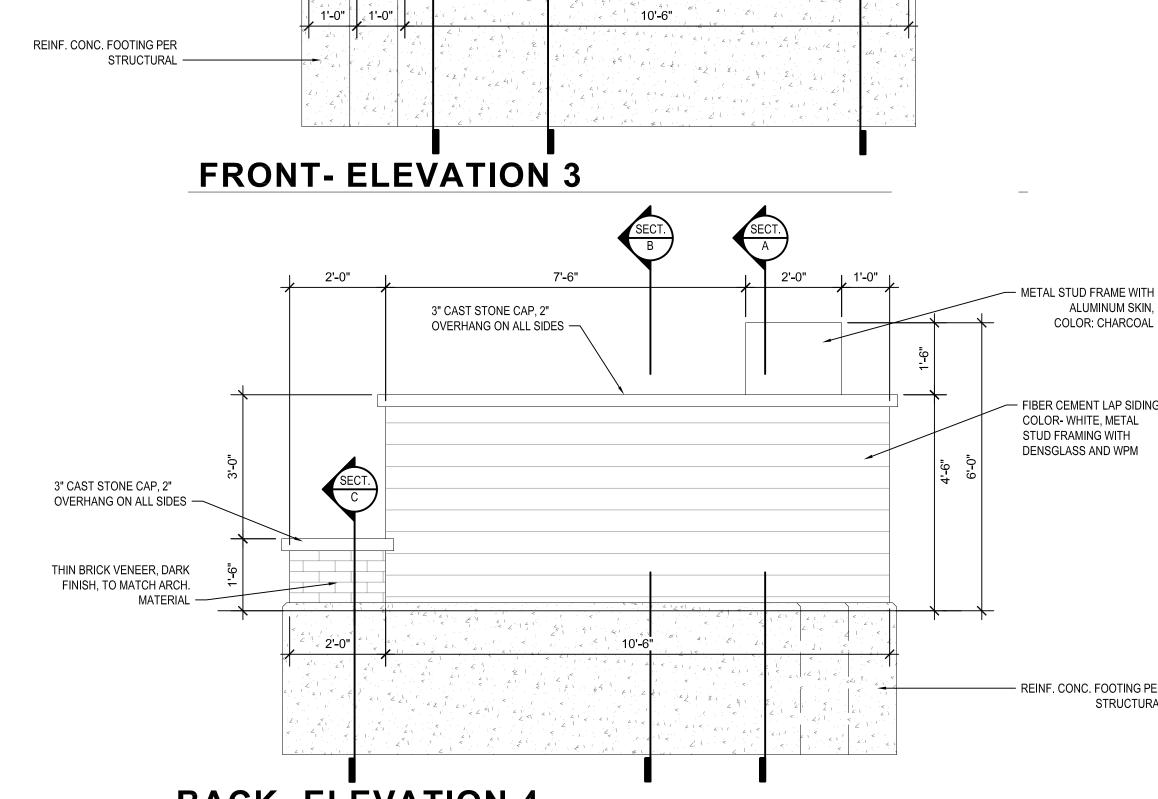

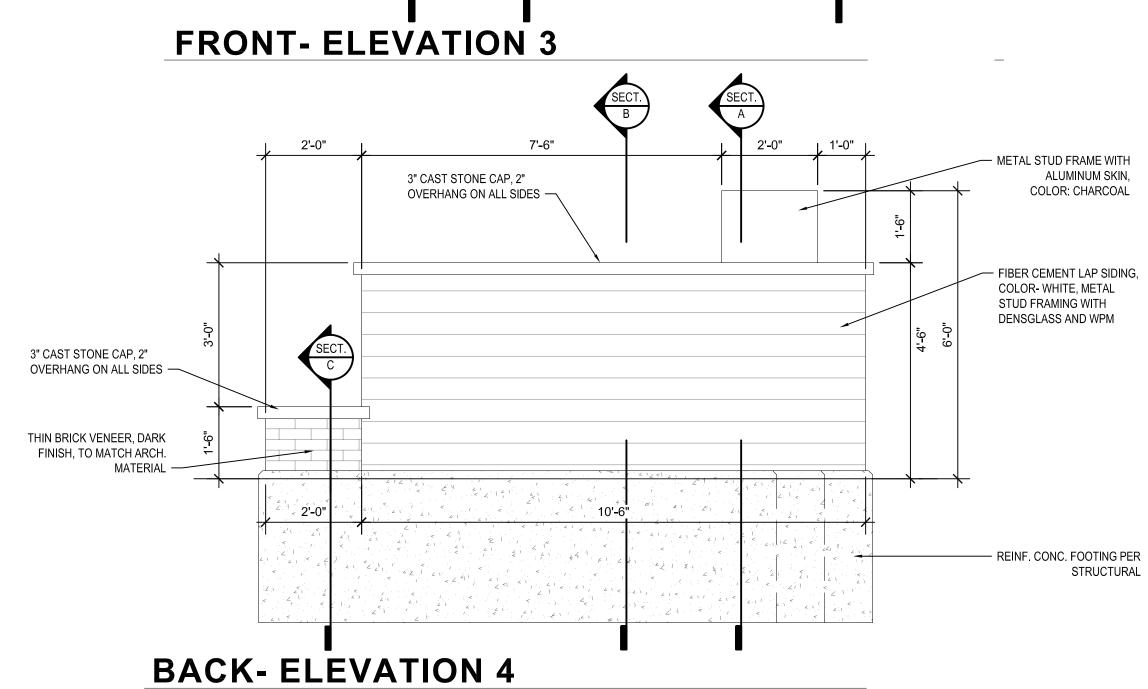

MONUMENT SIGN PLAN- NW CORNER

1/4" = 1'-0"

MONUMENT SIGN

1/2" = 1'-0"

DRAWING RELEASE LOG

• 09.16.24 PERMIT SET • 10.28.24 CITY COMMENTS

 \triangle REVISIONS

720522 09.16.2024 DRAWN BY SLW / KRM PERMIT SET

SHEET NAME SITE DETAILS

P.913.831.1415 NSPJARCH.COM

9415 NALL AVE., #300 PRAIRIE VILLAGE, KANSAS,66207

MINIMUM 20' LANDSCAPE STRIP SHALL BE PROVIDED ALONG THE FULL LENGTH OF ANY

THE MINIMUM OF 2 SHRUBS PER 5,000 SF OF TOTAL LOT AREA MINUS BUILDING FOOTPRINT

LOT AREA (570,200 SITE SF-134,070 BUILDINGS/ STRUCTURES SF= 436,130 SF /5,000SF) X 2

ONE SHRUB SHALL BE PROVIDED FOR EACH 20 FEET OF STREET FRONTAGE.

OPEN AREAS NOT COVERED WITH OTHER MATERIALS SHALL BE COVERED IN SOD.

LANDSCAPE REQUIREMENTS (LEE'S SUMMIT)

STREET FRONTAGE SHRUBS (SECTION 8.790A.3)

NE DOUGLAS AVE. = 425 LF /30 = TUDOR ROAD = 1,047 LF /30 = COMMERCE = 630 LF /30 =

NE DOUGLAS AVE. = 425 LF /20 = TUDOR ROAD = 1,047 LF /20 = COMMERCE = 630 LF /20 =

STREET FRONTAGE

STREET FRONTAGE TREES (SECTION 8.790.A.1): 1 TREE PER 30 L.F

OPEN YARD TREE REQUIREMENT (SECTION 8.790.B.3) THE MINIMUM OF 1 TREE PER 5,000 SF OF TOTAL LANDSCAPED OPEN SPACE 134,070 BUILDINGS/ STRUCTURES SF-11,383 SF PARKING ISLANDS 138,780 SF PARKING (270 SF X 514)= 285,967 SF /5,000SF) X 1

WITH THE LANDSCAPING PLANS. SEE A8.30 AND L2.12 & L2.14

PARKING LOT LANDSCAPE ISLANDS (SECTION 8.810.A.) LANDSCAPE ISLANDS, STRIPS OR OTHER PLANTING AREAS SHALL BE LOCATED WITHIN THE PARKING LOT AND SHALL CONSTITUTE AT LEAST 5% OF THE ENTIRE AREA DEVOTED TO PARKING SPACES, AISLES AND DRIVEWAYS.

PARKING LOT AREA 227,669 SF X 5%

LANDSCAPE ISLAND PLACEMENT (SECTION 8.810.B) A LANDSCAPING ISLAND SHALL BE LOCATED AT THE END OF EVERY PARKING BAY BETWEEN THE LAST PARKING SPACE AND AN ADJACENT TRAVEL AISLE OR DRIVEWAY. THE ISLAND SHALL BE NO LESS THAN 9 FEET WIDE FOR AT LEAST ONE-HALF THE LENGTH OF THE ADJACENT PARKING SPACE. THE ISLAND SHALL BE PLANTED IN TREES, SHRUBS, GRASS AND GROUNDCOVER, EXCEPT FOR THOSE AREAS THAT ARE MULCHED.

ISLAND WIDTH (SECTION 8.810.C.) TREE PLANTING SHALL BE NO LESS THAN 10 FEET IN WIDTH. NO TREE SHALL BE LOCATED LESS THAN 4 FEET FROM THE BACK OF CURB. ALL PARKING LOT LANDSCAPE ISLANDS, STRIPS OR

BUFFER/SCREEN REQUIREMENTS (SECTION 8.870 BUFFER/SCREEN BETWEEN DEVELOPMENTS OF DIFFERING LAND USES ADJOINING ONE ANOTHER OR SEPARATED FROM ONE ANOTHER BY ONLY A STREET OR ALLEY SHALL COMPLY WITH TABLE 8.890 TYPICAL BUFFERS.

OTHER PLANTING AREAS SHALL BE CURBED WITH MINIMUM 6 INCH HIGH CURBS.

ZONING RP-4 ADJACENT TO ZONING PO- MEDIUM BUFFER, SCREEN TYPE B

SHADE TREES 1/1000 SF X 35,186 SF ORNAMENTAL TREES 1/500 SF X 35,186 SF EVERGREEN TREES 1/300 SF X 35,186 SF SHRUBS 1/200 SF X 35,186 SF (SEE L2.00-L2.15) 176

AFTER JULY15TH.

THEIR SECOND SEASON OF GROWTH.

GENERAL NOTES:

1. EACH BIDDER SHALL VISIT THE SITE OF THE PROPOSED WORK AND EXAMINE THE SITE CONDITIONS. HE SHALL ALSO CAREFULLY EXAMINE THE DRAWINGS FOR THE PROPOSED WORK AND FAMILIARIZE HIMSELF WITH ALL CONDITIONS, WHICH MAY AFFECT THE PROPOSED WORK.

2. THE PLANTING PLAN GRAPHICALLY ILLUSTRATES OVERALL PLANT MASSINGS. EACH PLANT SPECIES MASSING SHALL BE PLACED IN THE FIELD TO UTILIZE GREATEST COVERAGE OF GROUND PLANE. THE FOLLOWING APPLIES FOR INDIVIDUAL PLANTINGS: A. CREEPING GROUNDCOVER SHALL BE A MINIMUM OF 6" FROM PAVING EDGE. B. ALL TREES SHALL BE A MINIMUM OF 3' FROM PAVING EDGE.

C. ALL PLANTS OF THE SAME SPECIES SHALL BE EQUALLY SPACED APART AND PLACED FOR BEST AESTHETIC VIEWING. D. ALL SHRUBS SHALL BE A MINIMUM OF 2' FROM PAVED EDGE.

3. NOTIFY LANDSCAPE ARCHITECT 1 WEEK PRIOR TO ANTICIPATED START OF PLANT MATERIAL INSTALLATION. LANDSCAPE CONTRACTOR SHALL STAKE ALL PROPOSED PLANTING BED EDGES, SET OUT SHRUBS IN INTENDED LOCATIONS, AND STAKE TREE LOCATIONS FOR APPROVAL BY LANDSCAPE ARCHITECT PRIOR TO INSTALLATION.

4. ALL NEW PLANT BED AREAS TO BE IRRIGATED. REFER TO SPECIFICATIONS FOR IRRIGATION SYSTEM

5. REFER TO L1.00 SERIES SHEETS FOR TREE PLANTINGS.

6. REFER TO L2.00 SERIES SHEETS FOR SHRUB PLANTINGS & ROCK MATERIALS.

7. REFER TO L3.00 SERIES SHEETS FOR PLANTING DETAILS & SPECIFICATIONS.

EQUAL. ALL ROCK BED AREAS SHALL HAVE FILTER FABRIC & BE 4" MIN. DEPTH.

8. REFER TO L4.00 SERIES SHEETS FOR BMP/CONSERVATION EASEMENT NATIVE PLANTINGS & LIMITS OF

9. IN THE EVENT OF WORK IN OR ON THE JCW SANITARY MAIN. ANY TREES OR PLANTINGS PLACED WITHIN THE SEWER EASEMENT MAY BE REMOVED WITHOUT REPLACEMENT OR COMPENSATION THERE OF AND SHALL BE REPLACED BY THE PROPERTY OWNER AS REQUIRED BY THE CITY. 10. STRIP TOP SOIL & SAVE FOR PLANTING AREAS. REFER TO L3.00 FOR PLANTING SOIL MIX.

11. STEPPING STONES SHALL BE HICKORY GREY FLAGSTONE AS PROVIDED BY SEMCO MATERIALS OR APPROVED EQUAL. 24" SQ. MIN. SIZE, 2-3" THICK. 12. ROCK BEDS SHALL BE SALT & PEPPER COBBLES, 5"-10" SIZE, BY SEMCO DISTRIBUTORS OR APPROVED

PLANT LIST:

Code	Common Name	Botanical Name	Size	Note
Overst	ory Trees			335034-9503838-952
ASM	Armstrong Maple	Acer freemani 'Armstrong'	2.5" Cal.	B&B
CSO	Crimson Spire Oak	Quercus robur x alba 'Crimschmidt'	2.5" Cal.	B&B
FFM	Fall Fiesta Sugar Maple	Acer saccharum 'Fall Fiesta'	2.5" Cal.	B&B
FEM	Frontier Elm	Ulmus carpinifolia x parvifolia 'Frontier'	2.5" Cal.	B&B
OGM	October Glory Red Maple	Acer rubrum 'October Glory'	2.5" Cal.	B&B
SWO	Swamp White Oak	Quercus bicolor	2.5" Cal.	B&B
ZEL	Zelkova	Zelkova serrata 'Green Vase'	2.5" Cal.	B&B
Evergre	een Trees			
BBS	Bacheri Blue Spruce	Picea pungens 'Bacheri'	8' Ht. Min.	B&B
CBS	Colorado Blue Spruce	Picea pungens	8' Ht. Min.	B&B
KTJ	Keteleeri Juniper	Juniperus chinensis 'Keteleeri'	8' Ht. Min.	B&B
RSS	Riverside Spruce	Picea omorika 'Riverside'	8' Ht. Min.	B&B
SBS	Serbian Spruce	Picea omorika	8' Ht. Min.	B&B
SPJ	Spartan Juniper	Juniperus chinensis 'Spartan'	8' Ht. Min.	B&B
Orname	ental Trees			
PFC	Prairiefire Crabapple	Malus x 'Prairifire'	1.5" Cal.	B&B
RVB	Riverbirch	Betula nigra	1.5" Cal.	B&B
SBM	Sweetbay Magnolia	Magnolia virginiana	1.5" Cal.	B&B
SVB	Serviceberry (Multi-Stem)	Amelanchier grandiflora 'Autumn Brilliance'	1.5" Cal.	B&B

Maintenance Strip **Common Name Botanical Name Buffalo Grass** Buchloe dactyloides

NATIVE SEED PLANT LIST:

Prairie Panorama Native Seed Mix by CritSite **Botanical Name** Common Name Little Bluestem Schizachyrium scoparium Canada Wild Rye Elymus canadensis Sideoats Grama Bouteloua curtipendula Sorghastrum nutans Black-Eyed Susan Purple Coneflower Echinacea purpurea Lance Leaf Coreopsis Coreopsis lanceolata Agropyron x Triticum Regreen sterile wheat cover cop 30 bulk lbs / acre Mycorrhizal inoculant: GroLife will be applied at 40 lbs / acre

AN APPROVED EQUAL MAY BE SUBMITTED BY CONTRACTOR FOR APPROVAL.

2. CONTRACTOR TO CONTACT CITY OF LEE'S SUMMIT STORMWATER SPECIALIST TO COORDINATE STORMWATER

ESTABLISHMENT AND MAINTENANCE INSTRUCTIONS: NATIVE PLANTINGS AND WATER QUALITY COLLECTION AREAS REQUIRE MONITORING AND MAINTENANCE TO INSURE THEY REMAIN EFFECTIVE AND HAVE A NICE APPEARANCE. UTILIZE THE MARC BMP MANUAL TO SERVE AS AN ONGOING GUIDE TO KEEP NATIVE AREAS EFFECTIVE IN SERVING THEIR WATER QUALITY FUNCTION AND MAINTAINING AN ACCEPTABLE APPEARANCE.

ESTABLISHMENT (1-3 YEARS)

1. PLANTS SHALL BE OBTAINED FROM A COMMERCIAL SOURCE NORMALLY DEALING IN NATIVE PLANT MATERIAL. 2. ALL SPECIES SHALL BE SUPPLIED AS PURE LIVE SEED. THE SEED NATIVE TO EASTERN KANSAS OR WESTERN MISSOURI WILL BE FROM A SUPPLIER WITHIN 100 MILE RADIUS OF THE SITE.

1. NATIVE SEED MIX IS TO BE SPREAD AT A MINIMUM RATE OF 22 LBS / ACRE FOR BROADCAST APPLICATIONS OR 15 LBS / ACRE FOR NATIVE SEED DRILL APPLICATIONS. HIGHER SEEDING RATES WILL HELP CONTROL WEED INTRUSION. 2.BUFFALO GRASS AREA FOR MAINTENANCE STRIP IS TO BE SEEDED AT A RATE OF 2-3 LBS

3. WINTERSTRAW™ EROSION CONTROL BLANKET BY CRITSITE (OR APPROVED EQUAL) TO BE USED FOR EROSION CONTROL IN NATIVE SEED AREA. ANY STRAW, HAY, OR CURLEX BLANKET USED USED MUST BE CLEAN AND SEED-FREE. IF HAY OR STRAW IS USED, IT 4. ALL LEGUMES WILL BE INOCULATED WITH RHIZOBIA AT THE PROPER TIME BEFORE

5. SEEDING CAN BE DONE BETWEEN THE MONTHS OF NOVEMBER AND JULY. DO NOT SEED AFTER JULY15TH. 6.SEED CAN BE APPLIED WITH A DRILL, NO-TILL PLANTER, BROADCAST SPREADER, HAND BROADCASTING, OR HYDRO SEEDER. 7. SCARIFY SOIL TO A DEPTH OF $\frac{1}{4}$ " BEFORE SEEDING.

1. WATER 2-3 TIMES PER WEEK FOR 4-6 WEEKS, USING A TOTAL OF 1" OF WATER PER WEEK, AS NEEDED UNTIL PLANT MATERIAL IS FULLY ESTABLISHED. THEN WATER AS A SUPPLEMENTAL SOURCE ONCE A WEEK THEREAFTER 2.DURING THE SECOND AND THIRD YEARS, WATER PLANTINGS AS NECESSARY DURING DRY PERIODS.

FERTILIZING 1. FERTILIZER SHOULD NOT BE APPLIED EITHER IN OR AROUND THE BMP'S ESPECIALLY WHERE DRAINAGE WILL RUN OVER FERTILIZED AREAS INTO THE BASIN. 2. WATER QUALITY AREAS DO NOT NEED FERTILIZER WHICH WOULD ONLY PROMOTE GROWTH OF WEEDS AND, POTENTIALLY, TALL SPINDLY PLANTS WHICH WILL BE STRUCTURALLY WEAKENED.

ACCEPTABLE COVERAGE OF PLANTED AREA 1. FINAL ACCEPTANCE OF THE WORK WILL BE DETERMINED BY A SITE VISIT BY THE LANDSCAPE ARCHITECT OF THE NATIVE PLANTING AREAS AT THE END OF THE ONE YEAR PERIOD FROM INITIAL ACCEPTANCE WHEN PLANTS HAVE STARTED ACTIVELY GROWING IN THEIR SECOND SEASON OF GROWTH. 2.IF THE SITE VISIT INSPECTION DOES NOT MEET THE MINIMUM ACCEPTABLE STANDARD AS DETERMINED BY THE PROJECT LANDSCAPE ARCHITECT, THE AREA SHALL BE REPLANTED

AS NECESSARY TO OBTAIN THE DESIRED RESULTS.

ACCEPTABLE COVERAGE OF PLANTED ARE FINAL ACCEPTANCE OF THE WORK WILL BE DETERMINED BY A SITE VISIT BY THE LANDSCAPE ARCHITECT OF THE NATIVE PLANTING AREAS AT THE END OF THE ONE YEAR PERIOD FROM INITIAL ACCEPTANCE WHEN PLANTS HAVE STARTED ACTIVELY GROWING IN

DETERMINED BY THE PROJECT LANDSCAPE ARCHITECT, THE AREA SHALL BE REPLANTED AS NECESSARY TO OBTAIN THE DESIRED RESULTS.

2.IF THE SITE VISIT INSPECTION DOES NOT MEET THE MINIMUM ACCEPTABLE STANDARD AS

MAINTENANCE (3+ YEARS, ESTABLISHMENT ACTIVITIES MAY CARRY OVER, AS NEEDED)

1. SEEDING CAN BE DONE BETWEEN THE MONTHS OF NOVEMBER AND JULY. DO NOT SEED

1. AFTER FINAL ACCEPTANCE, PLANT MATERIAL SHOULD BE INSPECTED WEEKLY, AND SUPPLEMENTAL WATER SHOULD ONLY BE APPLIED AS NEEDED TO MAINTAIN VIGOROUS PLANT GROWTH AND GENERAL HEALTH.

2.IF RAINS ARE OCCURRING AND NATIVE PLANTINGS ARE RECEIVING PLENTY OF MOISTURE, SUPPLEMENTAL WATERING SHOULD BE ELIMINATED. 3.DURING THE SUMMER MONTHS OF JULY AND AUGUST, SUPPLEMENTAL WATERING MAY BE NECESSARY DURING DRY PERIODS.

I. ANY PLANTS THAT ARE NOT SPECIFIED FROM THE ORIGINAL PLAN SHOULD BE

CONSIDERED WEEDS. a. HERBICIDES: ONLY HERBICIDES FORMULATED TO USE WITH NATIVE PLANT MATERIAL MAY BE USED, AND MAY ONLY BE APPLIED AT THE CORRECT APPLICATION RATE AS SPECIFIED ON THE PRODUCT LABEL. FREQUENCY OF APPLICATION IS ON AN AS NEEDED BASIS (WITHOUT EXCEEDING PRODUCT LABEL REQUIREMENTS), UNTIL

NATIVE PLANT MATERIAL IS ESTABLISHED. b. REMOVAL: PULL WEEDS AS NEEDED, TAKING CARE NOT TO DISLODGE ROOTS OF NATIVE PLANT MATERIAL, UNTIL NATIVE PLANT MATERIAL IS ESTABLISHED. c. MOWING: MOW WHEN PLANTS HAVE GONE DORMANT SO THEY WILL RE-SEED. WHEN VEGETATION HAS REACHED 1' IN HEIGHT, MOW TO A HEIGHT OF 6". RAKE OFF LARGE PIECES OF VEGETATION.

2, IN PERPETUITY AFTER ESTABLISHMENT, PERFORM WEED CONTROL AS NECESSARY.

1 \09.13.24 FDP COMMENTS 1

2\10.28.24 FDP COMMENTS 2


720522 09.16.2024 DRAWN BY SLW / KRM


DRAWING RELEASE LOG


10.28.24 CITY COMMENTS

SHEET NAME TREE PLANTING PLAN

PERMIT SET

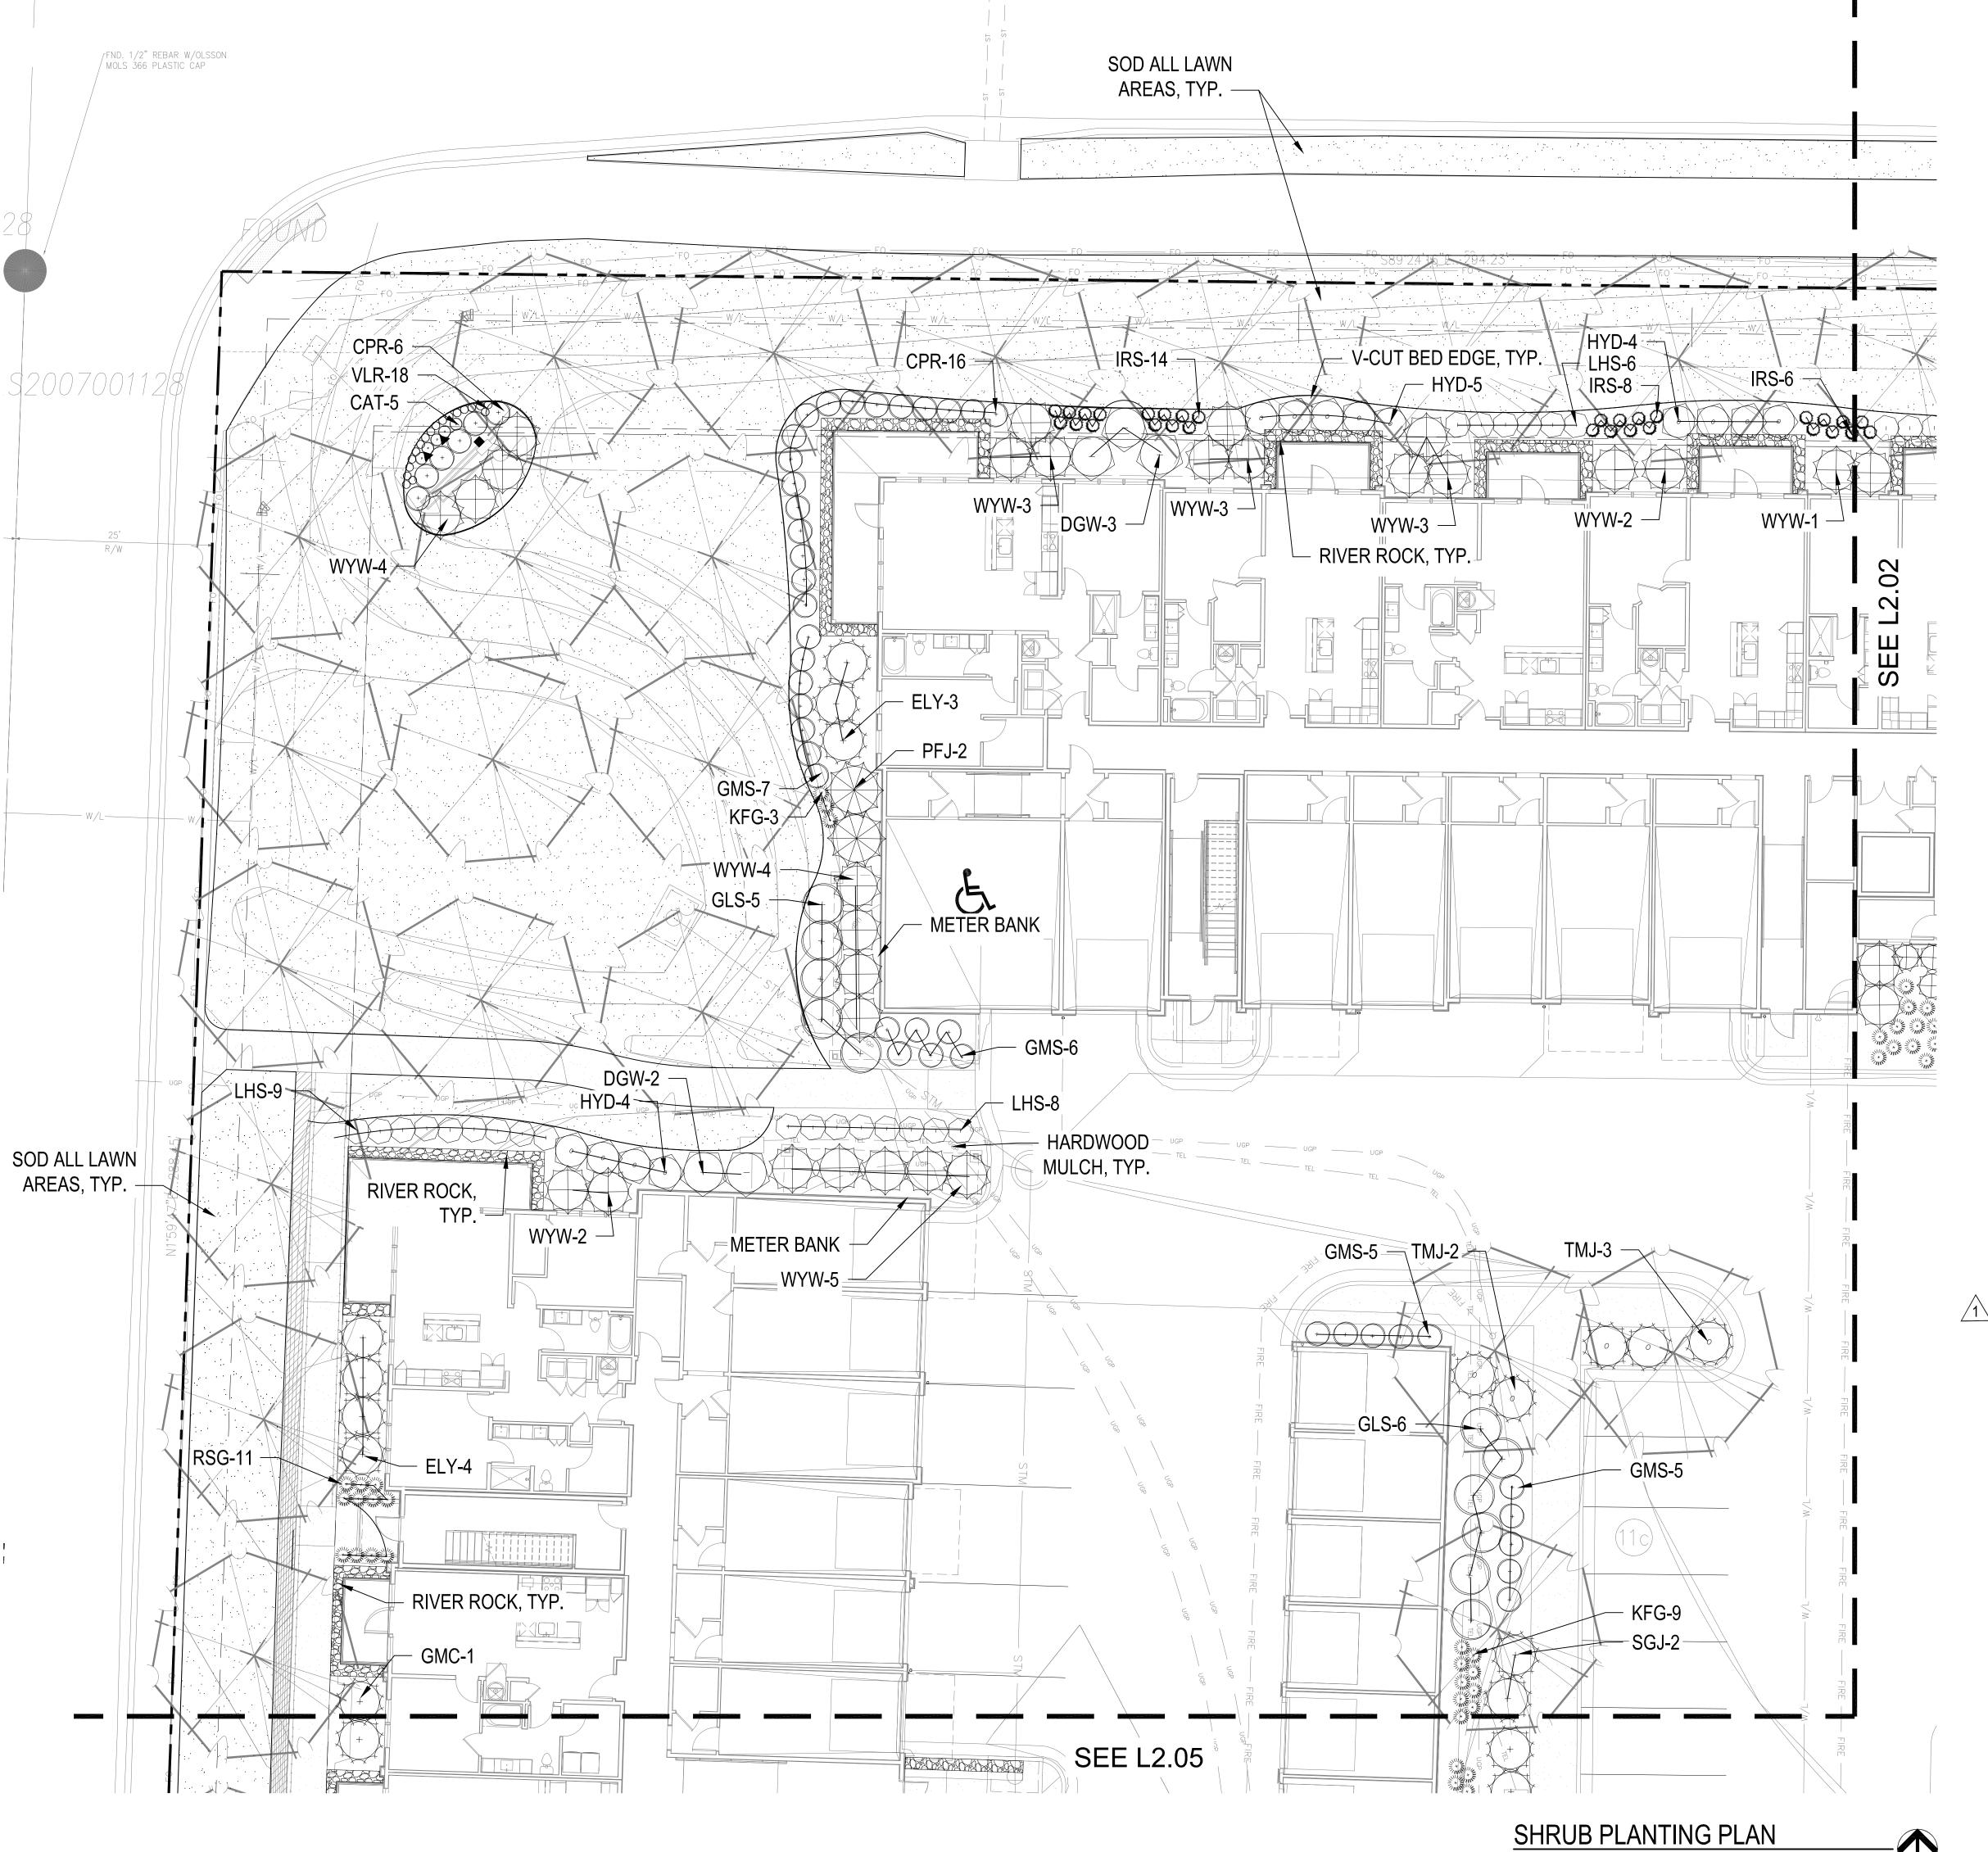

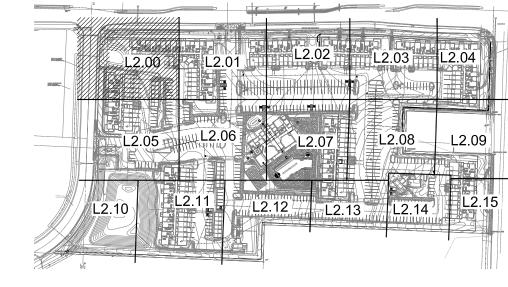

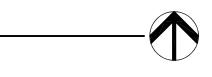

PLANT LIST

Code	Common Name	Botanical Name	S
Evergr	een Shrubs		II.
CGH	China Boy Holly	llex x meserveae 'Mesdob'	5 (
CGH	China Girl Holly	llex x meserveae 'Mesog'	5 (
DFY	Densifomis Yew	Taxus x media 'Densiformis'	5 (
ELY	Everlow Yew	Taxus x media 'Everlow'	5 (
GBS	Globe Blue Spruce	Picea pungens 'Glauca globosa'	5 (
GGB	Green Gem Boxwood	Buxus microphylla x 'Green Gem'	5 (
GMC	Gold Mop Cypress	Chamaecyparis pisifera 'Yellow Thread Branch'	5 (
PFJ	Perfecta Juniper	Juniperus chinensis 'Perfecta'	5 (
PRB	Green Mountain Boxwood (Pyramidal)	Buxus microphylla 'Green Mountain'	5 (
SJG	Sea Green Juniper	Juniperus chinensis 'Sea Green'	5
TMJ	Tam Juniper	Juniperus sabina 'Tamariscifolia'	5 (
WGB	Winter Green Boxwood	Buxus microphylla 'Winter Green'	5 (
WTB	Red Sprite Winterberry	llex verticillata 'Nana'	5 (
WYW	Wardii Yew	Taxus x media 'Wardii'	5 (
	ous Shrubs		
CPR	Red Carpet Rose	Rosa 'Flower Carpet Red'	2 (
DGW	Variegated Red Twigged Dogwood	Cornus alba 'Ivory Halo'	2 (
DRT	Dwarf Red Twig Dogwood	Cornus sericea 'Kelseyi"	2 (
ESH	Endless Summer Hydrangea	Hydrangea macrophylla 'Bailmer'	2 (
GLS	Gro-Low Sumac	Rhus aromatica 'Gro-Low'	2 (
GMS	Goldmound Spirea	Spiraea japonica 'Goldmound'	2 (
HYD	Annabelle Hydrangea	Hydrangea arborescens 'Annabelle'	2 (
KNR	Knockout Rose	Rosa knockout	2 (
LHS	Little Henry Sweetspire	Itea virginica 'Little Henry'	20
LPS	Little Princess Spirea	Spiraea japonica 'Little Princess'	2 (
MCS	Magic Carpet Spirea	Spiraea japonica 'Magic Carpet'	2 (
ROS	Rose of Sharon - Lavender Chiffon	Hibiscus syriacus 'Notwoodone'	20
WIG	Fine Wine Weigela	Weigela florida 'Bramwell'	2 (
Perenn			
CAT	Catmint	Nepeta x faassenii 'Walker's Low'	1 (
DAY	Rosy Returns Daylily	Hemerocallis 'Rosy Returns'	1 (
DSY	Daisy	Leucanthemum x superbum 'Becky'	1 (
HOS	Sum & Substance Hosta	Hosta 'Sum & Substance'	1 (
IRS	Blue Flag Iris	Iris virginica v. shrevei	1 (
MSG	Blue Salvia	Salvia nemorosa 'May Night'	1 (
SBA	Summer Beauty Allium	Allium 'Summer Beauty'	1 (
Grasse	S		
KFG	Karl Foerster Grass	Calamagrostis x acutiflora 'Karl Foerster'	1 (
MLG	Morning Light Maiden Grass	Miscanthus sinensis 'Morning Light'	1 (
NWG	Northwind Switch Grass	Panicum virgatum 'Northwind'	1 (
RSG	Red Switch Grass	Panicum virgatum 'Prairie Fire'	1 (
VLR	Variegated Liriope	Liriope muscari variegata	10

GENERAL NOTES:

1. EACH BIDDER SHALL VISIT THE SITE OF THE PROPOSED WORK AND EXAMINE THE SITE CONDITIONS. HE SHALL ALSO CAREFULLY EXAMINE THE DRAWINGS FOR THE PROPOSED WORK AND FAMILIARIZE HIMSELF WITH ALL CONDITIONS, WHICH MAY AFFECT THE PROPOSED WORK.

2. THE PLANTING PLAN GRAPHICALLY ILLUSTRATES OVERALL PLANT MASSINGS. EACH PLANT SPECIES MASSING SHALL BE PLACED IN THE FIELD TO UTILIZE GREATEST COVERAGE OF GROUND PLANE. THE FOLLOWING APPLIES FOR INDIVIDUAL PLANTINGS:

A. CREEPING GROUNDCOVER SHALL BE A MINIMUM OF 6" FROM PAVING EDGE. B. ALL TREES SHALL BE A MINIMUM OF 3' FROM PAVING EDGE. C. ALL PLANTS OF THE SAME SPECIES SHALL BE EQUALLY SPACED APART AND PLACED FOR BEST AESTHETIC VIEWING.

3. NOTIFY LANDSCAPE ARCHITECT 1 WEEK PRIOR TO ANTICIPATED START OF PLANT MATERIAL INSTALLATION. LANDSCAPE CONTRACTOR SHALL STAKE ALL PROPOSED PLANTING BED EDGES, SET OUT SHRUBS IN INTENDED LOCATIONS, AND STAKE TREE LOCATIONS FOR APPROVAL BY

4. ALL NEW PLANT BED AREAS TO BE IRRIGATED. REFER TO SPECIFICATIONS FOR IRRIGATION SYSTEM DESCRIPTION.

5. REFER TO L1.00 SERIES SHEETS FOR TREE PLANTINGS.

LANDSCAPE ARCHITECT PRIOR TO INSTALLATION.

6. REFER TO L2.00 SERIES SHEETS FOR SHRUB PLANTINGS & ROCK MATERIALS.

7. REFER TO L3.00 SERIES SHEETS FOR PLANTING DETAILS & SPECIFICATIONS.

D. ALL SHRUBS SHALL BE A MINIMUM OF 2' FROM PAVED EDGE.

8. IN THE EVENT OF WORK IN OR ON THE JCW SANITARY MAIN. ANY TREES OR PLANTINGS PLACED WITHIN THE SEWER EASEMENT MAY BE REMOVED WITHOUT REPLACEMENT OR

COMPENSATION THERE OF AND SHALL BE REPLACED BY THE PROPERTY OWNER AS REQUIRED 9. STRIP TOP SOIL & SAVE FOR PLANTING AREAS. REFER TO L3.00 FOR PLANTING SOIL MIX. 10. ROCK BEDS SHALL BE BUFFALO RIVER ROCK, 1"-2.5" SIZE, BY HOUSE OF ROCKS OR APPROVED EQUAL. ALL ROCK BED AREAS SHALL HAVE FILTER FABRIC & BE 4" MIN. DEPTH.

11. ALL LANDSCAPE BEDS WITHIN POOL ENCLOSURE TO INCLUDE RIVER ROCK PER SPECS.

12. FINISHED GRADE TO BE TOP OF MULCH OR TURF FOR ALL LANDSCAPE AREAS. REFER TO CIVIL PLANS FOR GRADING INFORMATION.

SEEDING & SOD NOTES:

- REFER TO GENERAL NOTES ON PLANTING DETAILS PAGE FOR SEED MIX AND SOD MATERIAL. 2. REFER TO PROJECT SPECIFICATIONS SECTION 3.1 FOR TURF AREA PREPARATION, AND THE KANSAS
- CITY METROPOLITAN CHAPTER OF THE APWA, DIVISION II, SECTION 2406.2 FOR ADDITIONAL GRADING AND TILLAGE GUIDELINES & PROCEDURES. 3. REFER TO THE KANSAS CITY METROPOLITAN CHAPTER OF THE APWA, DIVISION II, SECTION 2406.3
- FOR FERTILIZATION GUIDELINES & PROCEDURES. 4. REFER TO PROJECT SPECIFICATION SECTION 3.3, AND THE KANSAS CITY METROPOLITAN CHAPTER OF THE APWA, DIVISION II, SECTION 2406.4.D FOR SOD INSTALLATION GUIDELINES & PROCEDURES.
- SEEDING OPTIONS: 5.1. <u>HYDROSEEDING</u> - REFER TO KANSAS CITY METROPOLITAN CHAPTER OF THE APWA, DIVISION
- II, SECTION 2406.4.C FOR HYDROSEEDING GUIDELINES & PROCEDURES.
- 5.2. <u>SOWING</u> REFER TO PROJECT SPECIFICATIONS SECTION 3.2 AND THE KANSAS CITY METROPOLITAN CHAPTER OF THE APWA, DIVISION II, SECTION 2406.4.B FOR SEED SOWING
- 6. SOWN SEED PROTECTION & SECURING METHODS. PROTECT ALL SEEDED AREAS WITH SLOPES NOT
- EXCEEDING 6:1 (15+%) BY EITHER METHOD LISTED IN THE PROJECT SPECIFICATION SECTION 3.2.D.
- 7. IF ANY DISCREPANCIES ARE FOUND BETWEEN THE PROJECT GENERAL NOTES, PROJECT SPECIFICATIONS, AND APWA SECTION 2400, THE MOST STRINGENT GUIDELINE APPLIES.



DRAWING RELEASE LOG


● 09.16.24 PERMIT SET • 10.28.24 CITY COMMENTS

ARCHITECTS

ARCHITECTURE

L A N D S C A P E ARCHITECTURE

P.913.831.1415 NSPJARCH.COM

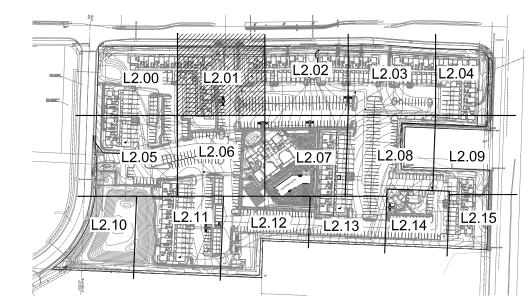

PLANT LIST

Code	Common Name	Botanical Name	S
Evergre	een Shrubs		
CGH	China Boy Holly	llex x meserveae 'Mesdob'	5
CGH	China Girl Holly	llex x meserveae 'Mesog'	5
DFY	Densifomis Yew	Taxus x media 'Densiformis'	5
ELY	Everlow Yew	Taxus x media 'Everlow'	5
GBS	Globe Blue Spruce	Picea pungens 'Glauca globosa'	5
GGB	Green Gem Boxwood	Buxus microphylla x 'Green Gem'	5
GMC	Gold Mop Cypress	Chamaecyparis pisifera 'Yellow Thread Branch'	5
PFJ	Perfecta Juniper	Juniperus chinensis 'Perfecta'	5
PRB	Green Mountain Boxwood (Pyramidal)	Buxus microphylla 'Green Mountain'	5
SJG	Sea Green Juniper	Juniperus chinensis 'Sea Green'	5
TMJ	Tam Juniper	Juniperus sabina 'Tamariscifolia'	5
WGB	Winter Green Boxwood	Buxus microphylla 'Winter Green'	5
WTB	Red Sprite Winterberry	llex verticillata 'Nana'	5
WYW	Wardii Yew	Taxus x media 'Wardii'	5
Decidio	us Shrubs		
CPR	Red Carpet Rose	Rosa 'Flower Carpet Red'	2
DGW	Variegated Red Twigged Dogwood	Cornus alba 'Ivory Halo'	2
DRT	Dwarf Red Twig Dogwood	Cornus sericea 'Kelseyi"	2
ESH	Endless Summer Hydrangea	Hydrangea macrophylla 'Bailmer'	2
GLS	Gro-Low Sumac	Rhus aromatica 'Gro-Low'	2
GMS	Goldmound Spirea	Spiraea japonica 'Goldmound'	2
HYD	Annabelle Hydrangea	Hydrangea arborescens 'Annabelle'	2
KNR	Knockout Rose	Rosa knockout	2
LHS	Little Henry Sweetspire	Itea virginica 'Little Henry'	2
LPS	Little Princess Spirea	Spiraea japonica 'Little Princess'	2
MCS	Magic Carpet Spirea	Spiraea japonica 'Magic Carpet'	2
ROS	Rose of Sharon - Lavender Chiffon	Hibiscus syriacus 'Notwoodone'	2
WIG	Fine Wine Weigela	Weigela florida 'Bramwell'	2
Perenn			
CAT	Catmint	Nepeta x faassenii 'Walker's Low'	1
DAY	Rosy Returns Daylily	Hemerocallis 'Rosy Returns'	1
DSY	Daisy	Leucanthemum x superbum 'Becky'	1
HOS	Sum & Substance Hosta	Hosta 'Sum & Substance'	1
IRS	Blue Flag Iris	Iris virginica v. shrevei	1
MSG	Blue Salvia	Salvia nemorosa 'May Night'	1
SBA	Summer Beauty Allium	Allium 'Summer Beauty'	1
Grasse			
KFG	Karl Foerster Grass	Calamagrostis x acutiflora 'Karl Foerster'	1
MLG	Morning Light Maiden Grass	Miscanthus sinensis 'Morning Light'	1
NWG	Northwind Switch Grass	Panicum virgatum 'Northwind'	1
RSG	Red Switch Grass	Panicum virgatum 'Prairie Fire'	1
VLR	Variegated Liriope	Liriope muscari variegata	1

GENERAL NOTES:

1. EACH BIDDER SHALL VISIT THE SITE OF THE PROPOSED WORK AND EXAMINE THE SITE CONDITIONS. HE SHALL ALSO CAREFULLY EXAMINE THE DRAWINGS FOR THE PROPOSED WORK

2. THE PLANTING PLAN GRAPHICALLY ILLUSTRATES OVERALL PLANT MASSINGS. EACH PLANT SPECIES MASSING SHALL BE PLACED IN THE FIELD TO UTILIZE GREATEST COVERAGE OF GROUND PLANE. THE FOLLOWING APPLIES FOR INDIVIDUAL PLANTINGS:

B. ALL TREES SHALL BE A MINIMUM OF 3' FROM PAVING EDGE. C. ALL PLANTS OF THE SAME SPECIES SHALL BE EQUALLY SPACED APART AND PLACED FOR BEST AESTHETIC VIEWING.

3. NOTIFY LANDSCAPE ARCHITECT 1 WEEK PRIOR TO ANTICIPATED START OF PLANT MATERIAL INSTALLATION. LANDSCAPE CONTRACTOR SHALL STAKE ALL PROPOSED PLANTING BED EDGES, SET OUT SHRUBS IN INTENDED LOCATIONS, AND STAKE TREE LOCATIONS FOR APPROVAL BY LANDSCAPE ARCHITECT PRIOR TO INSTALLATION.

4. ALL NEW PLANT BED AREAS TO BE IRRIGATED. REFER TO SPECIFICATIONS FOR IRRIGATION SYSTEM DESCRIPTION.

- 5. REFER TO L1.00 SERIES SHEETS FOR TREE PLANTINGS.
- 6. REFER TO L2.00 SERIES SHEETS FOR SHRUB PLANTINGS & ROCK MATERIALS.
- 8. IN THE EVENT OF WORK IN OR ON THE JCW SANITARY MAIN. ANY TREES OR PLANTINGS PLACED WITHIN THE SEWER EASEMENT MAY BE REMOVED WITHOUT REPLACEMENT OR

- 10. ROCK BEDS SHALL BE BUFFALO RIVER ROCK, 1"-2.5" SIZE, BY HOUSE OF ROCKS OR APPROVED EQUAL. ALL ROCK BED AREAS SHALL HAVE FILTER FABRIC & BE 4" MIN. DEPTH.
- 12. FINISHED GRADE TO BE TOP OF MULCH OR TURF FOR ALL LANDSCAPE AREAS. REFER TO

SEEDING & SOD NOTES:

SHRUB PLANTING PLAN

- 1. REFER TO GENERAL NOTES ON PLANTING DETAILS PAGE FOR SEED MIX AND SOD MATERIAL. 2. REFER TO PROJECT SPECIFICATIONS SECTION 3.1 FOR TURF AREA PREPARATION, AND THE KANSAS
- CITY METROPOLITAN CHAPTER OF THE APWA, DIVISION II, SECTION 2406.2 FOR ADDITIONAL GRADING AND TILLAGE GUIDELINES & PROCEDURES.
- FOR FERTILIZATION GUIDELINES & PROCEDURES. 4. REFER TO PROJECT SPECIFICATION SECTION 3.3, AND THE KANSAS CITY METROPOLITAN CHAPTER
- SEEDING OPTIONS:
- II, SECTION 2406.4.C FOR HYDROSEEDING GUIDELINES & PROCEDURES.
- 5.2. SOWING REFER TO PROJECT SPECIFICATIONS SECTION 3.2 AND THE KANSAS CITY METROPOLITAN CHAPTER OF THE APWA, DIVISION II, SECTION 2406.4.B FOR SEED SOWING
- 6. SOWN SEED PROTECTION & SECURING METHODS. PROTECT ALL SEEDED AREAS WITH SLOPES NOT
- EXCEEDING 6:1 (15+%) BY EITHER METHOD LISTED IN THE PROJECT SPECIFICATION SECTION 3.2.D. 7. IF ANY DISCREPANCIES ARE FOUND BETWEEN THE PROJECT GENERAL NOTES, PROJECT SPECIFICATIONS, AND APWA SECTION 2400, THE MOST STRINGENT GUIDELINE APPLIES.

ARCHITECTS

ARCHITECTURE

L A N D S C A P E ARCHITECTURE

P.913.831.1415 NSPJARCH.COM

9415 NALL AVE., #300 PRAIRIE VILLAGE, KANSAS, 66207


AND FAMILIARIZE HIMSELF WITH ALL CONDITIONS, WHICH MAY AFFECT THE PROPOSED WORK. A. CREEPING GROUNDCOVER SHALL BE A MINIMUM OF 6" FROM PAVING EDGE. D. ALL SHRUBS SHALL BE A MINIMUM OF 2' FROM PAVED EDGE. 7. REFER TO L3.00 SERIES SHEETS FOR PLANTING DETAILS & SPECIFICATIONS. COMPENSATION THERE OF AND SHALL BE REPLACED BY THE PROPERTY OWNER AS REQUIRED 11. ALL LANDSCAPE BEDS WITHIN POOL ENCLOSURE TO INCLUDE RIVER ROCK PER SPECS. CIVIL PLANS FOR GRADING INFORMATION. 3. REFER TO THE KANSAS CITY METROPOLITAN CHAPTER OF THE APWA, DIVISION II, SECTION 2406.3 OF THE APWA, DIVISION II, SECTION 2406.4.D FOR SOD INSTALLATION GUIDELINES & PROCEDURES. 5.1. <u>HYDROSEEDING</u> - REFER TO KANSAS CITY METROPOLITAN CHAPTER OF THE APWA, DIVISION DRAWING RELEASE LOG


• 09.16.24 PERMIT SET • 10.28.24 CITY COMMENTS REVISIONS 1\10.28.24 FDP COMMENTS 2

- ELY-3 - DAY-7 _LHS-6_ ____ GMS-5 - MSG-14 GMS-3

NWG-6

SEE L2.06

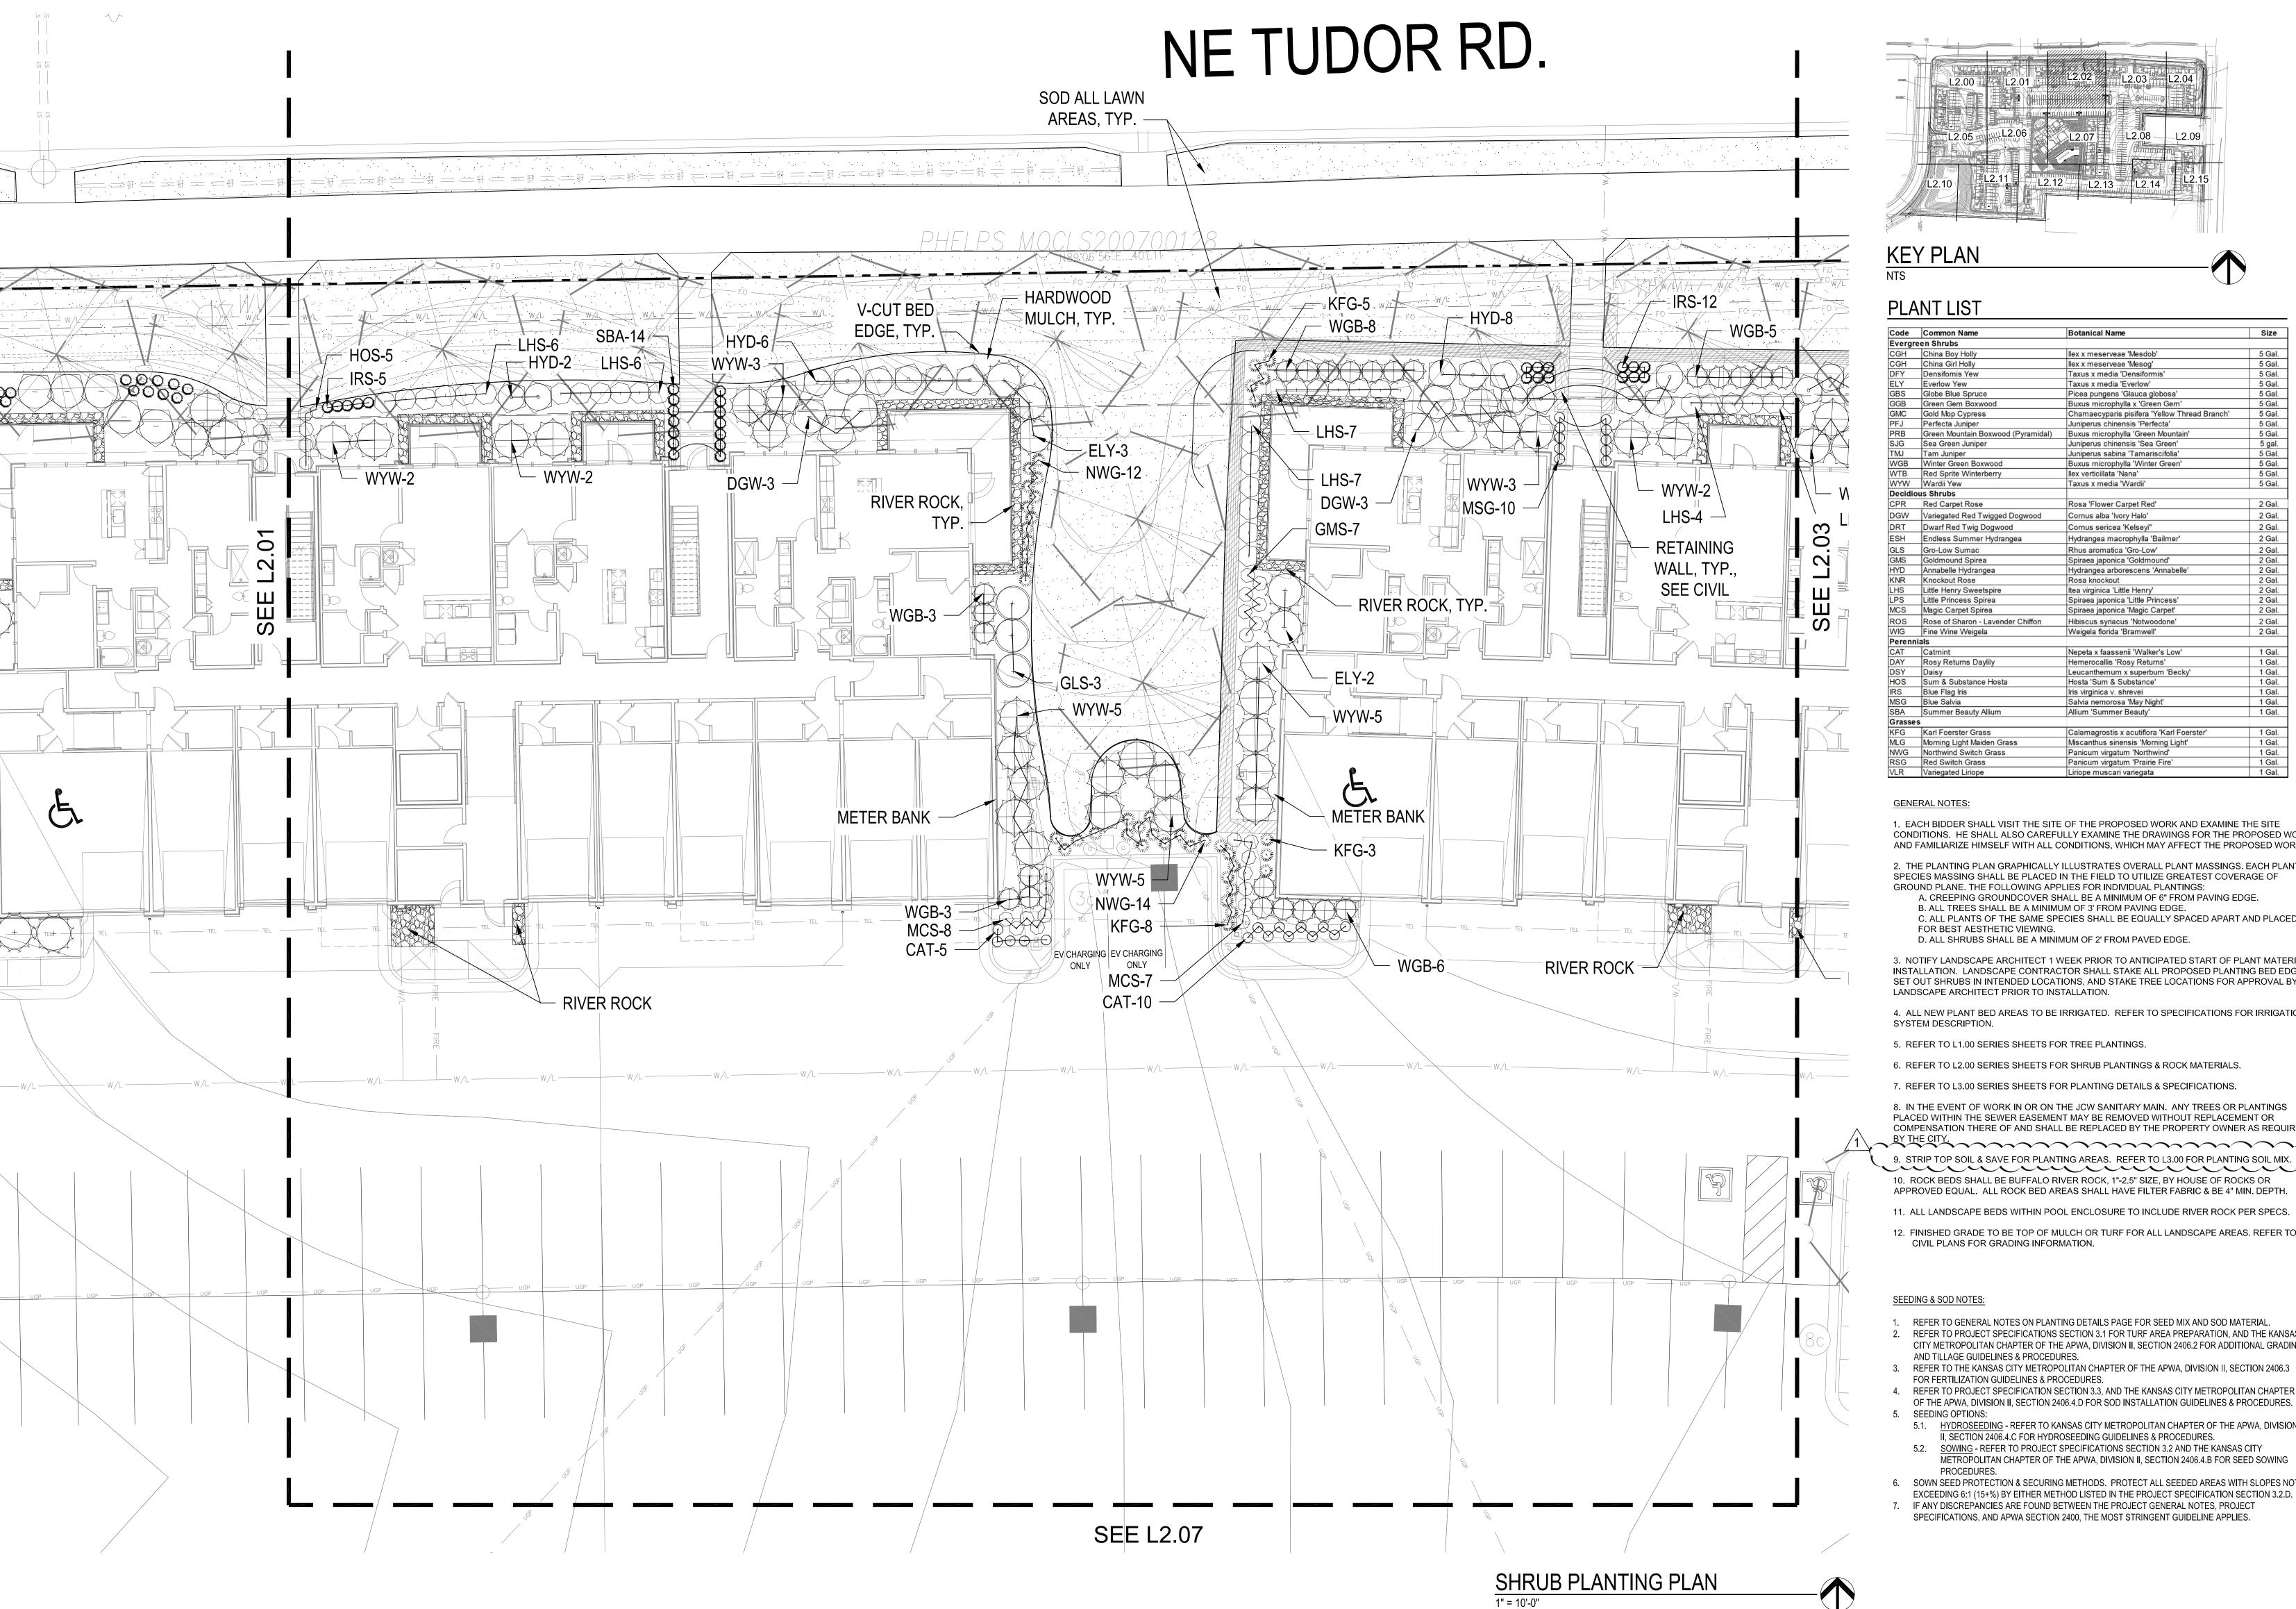

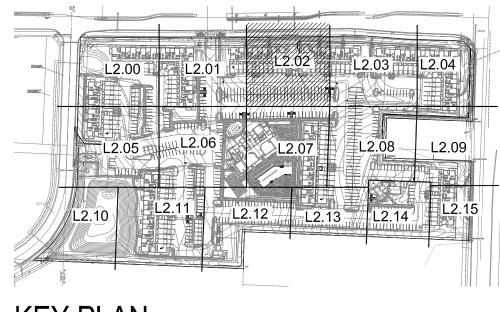

PLANT LIST

Code	Common Name	Botanical Name	Si
Evergr	een Shrubs		
CGH	China Boy Holly	llex x meserveae 'Mesdob'	5 (
CGH	China Girl Holly	llex x meserveae 'Mesog'	5 (
DFY	Densifomis Yew	Taxus x media 'Densiformis'	5 (
ELY	Everlow Yew	Taxus x media 'Everlow'	5 (
GBS	Globe Blue Spruce	Picea pungens 'Glauca globosa'	5 (
GGB	Green Gem Boxwood	Buxus microphylla x 'Green Gem'	5 (
GMC	Gold Mop Cypress	Chamaecyparis pisifera 'Yellow Thread Branch'	5 (
PFJ	Perfecta Juniper	Juniperus chinensis 'Perfecta'	5 (
PRB	Green Mountain Boxwood (Pyramidal)	Buxus microphylla 'Green Mountain'	5 (
SJG	Sea Green Juniper	Juniperus chinensis 'Sea Green'	5 9
TMJ	Tam Juniper	Juniperus sabina 'Tamariscifolia'	5 (
WGB	Winter Green Boxwood	Buxus microphylla 'Winter Green'	5 (
WTB	Red Sprite Winterberry	llex verticillata 'Nana'	5 (
WYW	Wardii Yew	Taxus x media 'Wardii'	5 (
Decidio	ous Shrubs		
CPR	Red Carpet Rose	Rosa 'Flower Carpet Red'	20
DGW	Variegated Red Twigged Dogwood	Cornus alba 'Ivory Halo'	20
DRT	Dwarf Red Twig Dogwood	Cornus sericea 'Kelseyi"	20
ESH	Endless Summer Hydrangea	Hydrangea macrophylla 'Bailmer'	20
GLS	Gro-Low Sumac	Rhus aromatica 'Gro-Low'	2 (
GMS	Goldmound Spirea	Spiraea japonica 'Goldmound'	2 (
HYD	Annabelle Hydrangea	Hydrangea arborescens 'Annabelle'	2 (
KNR	Knockout Rose	Rosa knockout	20
LHS	Little Henry Sweetspire	Itea virginica 'Little Henry'	20
LPS	Little Princess Spirea	Spiraea japonica 'Little Princess'	2 (
MCS	Magic Carpet Spirea	Spiraea japonica 'Magic Carpet'	2 (
ROS	Rose of Sharon - Lavender Chiffon	Hibiscus syriacus 'Notwoodone'	2 (
WIG	Fine Wine Weigela	Weigela florida 'Bramwell'	20
Perenn			
CAT	Catmint	Nepeta x faassenii 'Walker's Low'	10
DAY	Rosy Returns Daylily	Hemerocallis 'Rosy Returns'	10
DSY	Daisy	Leucanthemum x superbum 'Becky'	10
HOS	Sum & Substance Hosta	Hosta 'Sum & Substance'	10
IRS	Blue Flag Iris	Iris virginica v. shrevei	10
MSG	Blue Salvia	Salvia nemorosa 'May Night'	10
SBA	Summer Beauty Allium	Allium 'Summer Beauty'	10
Grasse	s		
KFG	Karl Foerster Grass	Calamagrostis x acutiflora 'Karl Foerster'	10
MLG	Morning Light Maiden Grass	Miscanthus sinensis 'Morning Light'	10
NWG	Northwind Switch Grass	Panicum virgatum 'Northwind'	10
RSG	Red Switch Grass	Panicum virgatum 'Prairie Fire'	10
VLR	Variegated Liriope	Liriope muscari variegata	10

GENERAL NOTES:

1. EACH BIDDER SHALL VISIT THE SITE OF THE PROPOSED WORK AND EXAMINE THE SITE CONDITIONS. HE SHALL ALSO CAREFULLY EXAMINE THE DRAWINGS FOR THE PROPOSED WORK AND FAMILIARIZE HIMSELF WITH ALL CONDITIONS, WHICH MAY AFFECT THE PROPOSED WORK.

2. THE PLANTING PLAN GRAPHICALLY ILLUSTRATES OVERALL PLANT MASSINGS. EACH PLANT SPECIES MASSING SHALL BE PLACED IN THE FIELD TO UTILIZE GREATEST COVERAGE OF GROUND PLANE. THE FOLLOWING APPLIES FOR INDIVIDUAL PLANTINGS:

A. CREEPING GROUNDCOVER SHALL BE A MINIMUM OF 6" FROM PAVING EDGE. B. ALL TREES SHALL BE A MINIMUM OF 3' FROM PAVING EDGE. C. ALL PLANTS OF THE SAME SPECIES SHALL BE EQUALLY SPACED APART AND PLACED

FOR BEST AESTHETIC VIEWING. D. ALL SHRUBS SHALL BE A MINIMUM OF 2' FROM PAVED EDGE.

3. NOTIFY LANDSCAPE ARCHITECT 1 WEEK PRIOR TO ANTICIPATED START OF PLANT MATERIAL INSTALLATION. LANDSCAPE CONTRACTOR SHALL STAKE ALL PROPOSED PLANTING BED EDGES, SET OUT SHRUBS IN INTENDED LOCATIONS, AND STAKE TREE LOCATIONS FOR APPROVAL BY LANDSCAPE ARCHITECT PRIOR TO INSTALLATION.

4. ALL NEW PLANT BED AREAS TO BE IRRIGATED. REFER TO SPECIFICATIONS FOR IRRIGATION SYSTEM DESCRIPTION.

5. REFER TO L1.00 SERIES SHEETS FOR TREE PLANTINGS.

6. REFER TO L2.00 SERIES SHEETS FOR SHRUB PLANTINGS & ROCK MATERIALS.

7. REFER TO L3.00 SERIES SHEETS FOR PLANTING DETAILS & SPECIFICATIONS. 8. IN THE EVENT OF WORK IN OR ON THE JCW SANITARY MAIN. ANY TREES OR PLANTINGS

PLACED WITHIN THE SEWER EASEMENT MAY BE REMOVED WITHOUT REPLACEMENT OR COMPENSATION THERE OF AND SHALL BE REPLACED BY THE PROPERTY OWNER AS REQUIRED BY THE CITY. 9. STRIP TOP SOIL & SAVE FOR PLANTING AREAS. REFER TO L3.00 FOR PLANTING SOIL MIX. 10. ROCK BEDS SHALL BE BUFFALO RIVER ROCK, 1"-2.5" SIZE, BY HOUSE OF ROCKS OR

APPROVED EQUAL. ALL ROCK BED AREAS SHALL HAVE FILTER FABRIC & BE 4" MIN. DEPTH. 11. ALL LANDSCAPE BEDS WITHIN POOL ENCLOSURE TO INCLUDE RIVER ROCK PER SPECS.

12. FINISHED GRADE TO BE TOP OF MULCH OR TURF FOR ALL LANDSCAPE AREAS. REFER TO CIVIL PLANS FOR GRADING INFORMATION.

SEEDING & SOD NOTES:

- 1. REFER TO GENERAL NOTES ON PLANTING DETAILS PAGE FOR SEED MIX AND SOD MATERIAL. 2. REFER TO PROJECT SPECIFICATIONS SECTION 3.1 FOR TURF AREA PREPARATION, AND THE KANSAS CITY METROPOLITAN CHAPTER OF THE APWA, DIVISION II, SECTION 2406.2 FOR ADDITIONAL GRADING AND TILLAGE GUIDELINES & PROCEDURES.
- FOR FERTILIZATION GUIDELINES & PROCEDURES. 4. REFER TO PROJECT SPECIFICATION SECTION 3.3, AND THE KANSAS CITY METROPOLITAN CHAPTER
- OF THE APWA, DIVISION II, SECTION 2406.4.D FOR SOD INSTALLATION GUIDELINES & PROCEDURES. SEEDING OPTIONS: 5.1. HYDROSEEDING - REFER TO KANSAS CITY METROPOLITAN CHAPTER OF THE APWA, DIVISION
- II, SECTION 2406.4.C FOR HYDROSEEDING GUIDELINES & PROCEDURES. 5.2. SOWING - REFER TO PROJECT SPECIFICATIONS SECTION 3.2 AND THE KANSAS CITY METROPOLITAN CHAPTER OF THE APWA, DIVISION II, SECTION 2406.4.B FOR SEED SOWING
- 6. SOWN SEED PROTECTION & SECURING METHODS. PROTECT ALL SEEDED AREAS WITH SLOPES NOT EXCEEDING 6:1 (15+%) BY EITHER METHOD LISTED IN THE PROJECT SPECIFICATION SECTION 3.2.D. 7. IF ANY DISCREPANCIES ARE FOUND BETWEEN THE PROJECT GENERAL NOTES, PROJECT SPECIFICATIONS, AND APWA SECTION 2400, THE MOST STRINGENT GUIDELINE APPLIES.

REVISIONS 1\10.28.24 FDP COMMENTS 2

DRAWING RELEASE LOG

● 09.16.24 PERMIT SET


10.28.24 CITY COMMENTS

ARCHITECTS

ARCHITECTURE

L A N D S C A P E ARCHITECTURE

P.913.831.1415 NSPJARCH.COM

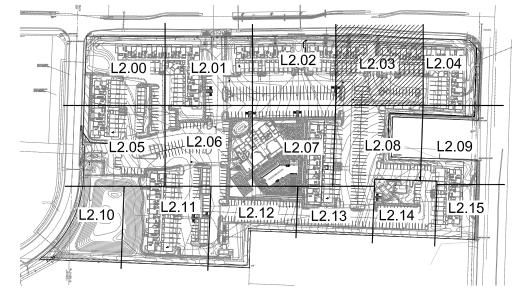



ARCHITECTS

ARCHITECTURE

L A N D S C A P E ARCHITECTURE

P.913.831.1415 NSPJARCH.COM

9415 NALL AVE., #300 PRAIRIE VILLAGE, KANSAS, 66207

PLANT LIST

Code	Common Name	Botanical Name	Si
Evergr	een Shrubs		
CGH	China Boy Holly	llex x meserveae 'Mesdob'	5 (
CGH	China Girl Holly	llex x meserveae 'Mesog'	5 (
DFY	Densifomis Yew	Taxus x media 'Densiformis'	5 (
ELY	Everlow Yew	Taxus x media 'Everlow'	5 (
GBS	Globe Blue Spruce	Picea pungens 'Glauca globosa'	5 (
GGB	Green Gem Boxwood	Buxus microphylla x 'Green Gem'	5 (
GMC	Gold Mop Cypress	Chamaecyparis pisifera 'Yellow Thread Branch'	5 (
PFJ	Perfecta Juniper	Juniperus chinensis 'Perfecta'	5 (
PRB	Green Mountain Boxwood (Pyramidal)	Buxus microphylla 'Green Mountain'	5 (
SJG	Sea Green Juniper	Juniperus chinensis 'Sea Green'	5 9
TMJ	Tam Juniper	Juniperus sabina 'Tamariscifolia'	5 (
WGB	Winter Green Boxwood	Buxus microphylla 'Winter Green'	5 (
WTB	Red Sprite Winterberry	llex verticillata 'Nana'	5 (
WYW	Wardii Yew	Taxus x media 'Wardii'	5 (
Decidio	ous Shrubs		
CPR	Red Carpet Rose	Rosa 'Flower Carpet Red'	20
DGW	Variegated Red Twigged Dogwood	Cornus alba 'Ivory Halo'	2 (
DRT	Dwarf Red Twig Dogwood	Cornus sericea 'Kelseyi"	2 (
ESH	Endless Summer Hydrangea	Hydrangea macrophylla 'Bailmer'	20
GLS	Gro-Low Sumac	Rhus aromatica 'Gro-Low'	20
GMS	Goldmound Spirea	Spiraea japonica 'Goldmound'	20
HYD	Annabelle Hydrangea	Hydrangea arborescens 'Annabelle'	2 (
KNR	Knockout Rose	Rosa knockout	2 (
LHS	Little Henry Sweetspire	Itea virginica 'Little Henry'	20
LPS	Little Princess Spirea	Spiraea japonica 'Little Princess'	2 (
MCS	Magic Carpet Spirea	Spiraea japonica 'Magic Carpet'	20
ROS	Rose of Sharon - Lavender Chiffon	Hibiscus syriacus 'Notwoodone'	20
WIG	Fine Wine Weigela	Weigela florida 'Bramwell'	20
Perenn	- Contract		
CAT	Catmint	Nepeta x faassenii 'Walker's Low'	10
DAY	Rosy Returns Daylily	Hemerocallis 'Rosy Returns'	1 (
DSY	Daisy	Leucanthemum x superbum 'Becky'	1 (
HOS	Sum & Substance Hosta	Hosta 'Sum & Substance'	1 (
IRS	Blue Flag Iris	Iris virginica v. shrevei	1 (
MSG	Blue Salvia	Salvia nemorosa 'May Night'	1 (
SBA	Summer Beauty Allium	Allium 'Summer Beauty'	1 (
Grasse	S		
KFG	Karl Foerster Grass	Calamagrostis x acutiflora 'Karl Foerster'	10
MLG	Morning Light Maiden Grass	Miscanthus sinensis 'Morning Light'	10
NWG	Northwind Switch Grass	Panicum virgatum 'Northwind'	10
RSG	Red Switch Grass	Panicum virgatum 'Prairie Fire'	10
VLR	Variegated Liriope	Liriope muscari variegata	10

GENERAL NOTES:

1. EACH BIDDER SHALL VISIT THE SITE OF THE PROPOSED WORK AND EXAMINE THE SITE CONDITIONS. HE SHALL ALSO CAREFULLY EXAMINE THE DRAWINGS FOR THE PROPOSED WORK AND FAMILIARIZE HIMSELF WITH ALL CONDITIONS, WHICH MAY AFFECT THE PROPOSED WORK.

2. THE PLANTING PLAN GRAPHICALLY ILLUSTRATES OVERALL PLANT MASSINGS. EACH PLANT SPECIES MASSING SHALL BE PLACED IN THE FIELD TO UTILIZE GREATEST COVERAGE OF GROUND PLANE. THE FOLLOWING APPLIES FOR INDIVIDUAL PLANTINGS: A. CREEPING GROUNDCOVER SHALL BE A MINIMUM OF 6" FROM PAVING EDGE.

B. ALL TREES SHALL BE A MINIMUM OF 3' FROM PAVING EDGE. C. ALL PLANTS OF THE SAME SPECIES SHALL BE EQUALLY SPACED APART AND PLACED FOR BEST AESTHETIC VIEWING. D. ALL SHRUBS SHALL BE A MINIMUM OF 2' FROM PAVED EDGE.

3. NOTIFY LANDSCAPE ARCHITECT 1 WEEK PRIOR TO ANTICIPATED START OF PLANT MATERIAL INSTALLATION. LANDSCAPE CONTRACTOR SHALL STAKE ALL PROPOSED PLANTING BED EDGES, SET OUT SHRUBS IN INTENDED LOCATIONS, AND STAKE TREE LOCATIONS FOR APPROVAL BY

4. ALL NEW PLANT BED AREAS TO BE IRRIGATED. REFER TO SPECIFICATIONS FOR IRRIGATION SYSTEM DESCRIPTION.

5. REFER TO L1.00 SERIES SHEETS FOR TREE PLANTINGS.

6. REFER TO L2.00 SERIES SHEETS FOR SHRUB PLANTINGS & ROCK MATERIALS.

7. REFER TO L3.00 SERIES SHEETS FOR PLANTING DETAILS & SPECIFICATIONS.

8. IN THE EVENT OF WORK IN OR ON THE JCW SANITARY MAIN. ANY TREES OR PLANTINGS PLACED WITHIN THE SEWER EASEMENT MAY BE REMOVED WITHOUT REPLACEMENT OR COMPENSATION THERE OF AND SHALL BE REPLACED BY THE PROPERTY OWNER AS REQUIRED

9. STRIP TOP SOIL & SAVE FOR PLANTING AREAS. REFER TO L3.00 FOR PLANTING SOIL MIX. 10. ROCK BEDS SHALL BE BUFFALO RIVER ROCK, 1"-2.5" SIZE, BY HOUSE OF ROCKS OR APPROVED EQUAL. ALL ROCK BED AREAS SHALL HAVE FILTER FABRIC & BE 4" MIN. DEPTH.

11. ALL LANDSCAPE BEDS WITHIN POOL ENCLOSURE TO INCLUDE RIVER ROCK PER SPECS.

12. FINISHED GRADE TO BE TOP OF MULCH OR TURF FOR ALL LANDSCAPE AREAS. REFER TO CIVIL PLANS FOR GRADING INFORMATION.


SEEDING & SOD NOTES:


- REFER TO GENERAL NOTES ON PLANTING DETAILS PAGE FOR SEED MIX AND SOD MATERIAL. 2. REFER TO PROJECT SPECIFICATIONS SECTION 3.1 FOR TURF AREA PREPARATION, AND THE KANSAS CITY METROPOLITAN CHAPTER OF THE APWA, DIVISION II, SECTION 2406.2 FOR ADDITIONAL GRADING AND TILLAGE GUIDELINES & PROCEDURES.
- REFER TO THE KANSAS CITY METROPOLITAN CHAPTER OF THE APWA, DIVISION II, SECTION 2406.3 FOR FERTILIZATION GUIDELINES & PROCEDURES.
- REFER TO PROJECT SPECIFICATION SECTION 3.3, AND THE KANSAS CITY METROPOLITAN CHAPTER OF THE APWA, DIVISION II, SECTION 2406.4.D FOR SOD INSTALLATION GUIDELINES & PROCEDURES.
- SEEDING OPTIONS: 5.1. <u>HYDROSEEDING</u> - REFER TO KANSAS CITY METROPOLITAN CHAPTER OF THE APWA, DIVISION II, SECTION 2406.4.C FOR HYDROSEEDING GUIDELINES & PROCEDURES.
- 5.2. <u>SOWING</u> REFER TO PROJECT SPECIFICATIONS SECTION 3.2 AND THE KANSAS CITY METROPOLITAN CHAPTER OF THE APWA, DIVISION II, SECTION 2406.4.B FOR SEED SOWING SOWN SEED PROTECTION & SECURING METHODS. PROTECT ALL SEEDED AREAS WITH SLOPES NOT
- EXCEEDING 6:1 (15+%) BY EITHER METHOD LISTED IN THE PROJECT SPECIFICATION SECTION 3.2.D. 7. IF ANY DISCREPANCIES ARE FOUND BETWEEN THE PROJECT GENERAL NOTES, PROJECT SPECIFICATIONS, AND APWA SECTION 2400, THE MOST STRINGENT GUIDELINE APPLIES.



• 09 16 24 PERMIT SET • 10.28.24 CITY COMMENTS

DRAWING RELEASE LOG

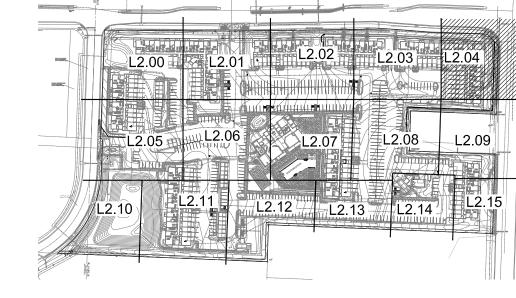

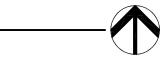

ARCHITECTS

ARCHITECTURE

L A N D S C A P E ARCHITECTURE

P.913.831.1415

NSPJARCH.COM

9415 NALL AVE., #300 PRAIRIE VILLAGE, KANSAS, 66207

PLANT LIST

Code	Common Name	Botanical Name	Si
Evergr	een Shrubs		
CGH	China Boy Holly	llex x meserveae 'Mesdob'	5 0
CGH	China Girl Holly	llex x meserveae 'Mesog'	5 0
DFY	Densifomis Yew	Taxus x media 'Densiformis'	5 0
ELY	Everlow Yew	Taxus x media 'Everlow'	5 0
GBS	Globe Blue Spruce	Picea pungens 'Glauca globosa'	5 0
GGB	Green Gem Boxwood	Buxus microphylla x 'Green Gem'	5 0
GMC	Gold Mop Cypress	Chamaecyparis pisifera 'Yellow Thread Branch'	5 0
PFJ	Perfecta Juniper	Juniperus chinensis 'Perfecta'	5 0
PRB	Green Mountain Boxwood (Pyramidal)	Buxus microphylla 'Green Mountain'	5 0
SJG	Sea Green Juniper	Juniperus chinensis 'Sea Green'	5 g
TMJ	Tam Juniper	Juniperus sabina 'Tamariscifolia'	5 0
WGB	Winter Green Boxwood	Buxus microphylla 'Winter Green'	5 0
WTB	Red Sprite Winterberry	llex verticillata 'Nana'	5 0
WYW	Wardii Yew	Taxus x media 'Wardii'	5 0
Decidio	ous Shrubs		
CPR	Red Carpet Rose	Rosa 'Flower Carpet Red'	20
DGW	Variegated Red Twigged Dogwood	Cornus alba 'Ivory Halo'	20
DRT	Dwarf Red Twig Dogwood	Cornus sericea 'Kelseyi"	20
ESH	Endless Summer Hydrangea	Hydrangea macrophylla 'Bailmer'	20
GLS	Gro-Low Sumac	Rhus aromatica 'Gro-Low'	20
GMS	Goldmound Spirea	Spiraea japonica 'Goldmound'	20
HYD	Annabelle Hydrangea	Hydrangea arborescens 'Annabelle'	20
KNR	Knockout Rose	Rosa knockout	2 0
LHS	Little Henry Sweetspire	Itea virginica 'Little Henry'	20
LPS	Little Princess Spirea	Spiraea japonica 'Little Princess'	2 0
MCS	Magic Carpet Spirea	Spiraea japonica 'Magic Carpet'	2 (
ROS	Rose of Sharon - Lavender Chiffon	Hibiscus syriacus 'Notwoodone'	20
WIG	Fine Wine Weigela	Weigela florida 'Bramwell'	20
Perenn	ials		
CAT	Catmint	Nepeta x faassenii 'Walker's Low'	10
DAY	Rosy Returns Daylily	Hemerocallis 'Rosy Returns'	10
DSY	Daisy	Leucanthemum x superbum 'Becky'	10
HOS	Sum & Substance Hosta	Hosta 'Sum & Substance'	10
IRS	Blue Flag Iris	Iris virginica v. shrevei	10
MSG	Blue Salvia	Salvia nemorosa 'May Night'	10
SBA	Summer Beauty Allium	Allium 'Summer Beauty'	10
Grasse	s		
KFG	Karl Foerster Grass	Calamagrostis x acutiflora 'Karl Foerster'	10
MLG	Morning Light Maiden Grass	Miscanthus sinensis 'Morning Light'	10
NWG	Northwind Switch Grass	Panicum virgatum 'Northwind'	10

1. EACH BIDDER SHALL VISIT THE SITE OF THE PROPOSED WORK AND EXAMINE THE SITE CONDITIONS. HE SHALL ALSO CAREFULLY EXAMINE THE DRAWINGS FOR THE PROPOSED WORK AND FAMILIARIZE HIMSELF WITH ALL CONDITIONS, WHICH MAY AFFECT THE PROPOSED WORK.

2. THE PLANTING PLAN GRAPHICALLY ILLUSTRATES OVERALL PLANT MASSINGS. EACH PLANT SPECIES MASSING SHALL BE PLACED IN THE FIELD TO UTILIZE GREATEST COVERAGE OF GROUND PLANE. THE FOLLOWING APPLIES FOR INDIVIDUAL PLANTINGS:

A. CREEPING GROUNDCOVER SHALL BE A MINIMUM OF 6" FROM PAVING EDGE.

B. ALL TREES SHALL BE A MINIMUM OF 3" FROM PAVING EDGE.

C. ALL PLANTS OF THE SAME SPECIES SHALL BE EQUALLY SPACED APART AND PLACED FOR BEST AESTHETIC VIEWING.
D. ALL SHRUBS SHALL BE A MINIMUM OF 2' FROM PAVED EDGE.

3. NOTIFY LANDSCAPE ARCHITECT 1 WEEK PRIOR TO ANTICIPATED START OF PLANT MATERIAL INSTALLATION. LANDSCAPE CONTRACTOR SHALL STAKE ALL PROPOSED PLANTING BED EDGES,

SET OUT SHRUBS IN INTENDED LOCATIONS, AND STAKE TREE LOCATIONS FOR APPROVAL BY LANDSCAPE ARCHITECT PRIOR TO INSTALLATION.

4. ALL NEW PLANT BED AREAS TO BE IRRIGATED. REFER TO SPECIFICATIONS FOR IRRIGATION SYSTEM DESCRIPTION.

5. REFER TO L1.00 SERIES SHEETS FOR TREE PLANTINGS.

6. REFER TO L2.00 SERIES SHEETS FOR SHRUB PLANTINGS & ROCK MATERIALS.

7. REFER TO L3.00 SERIES SHEETS FOR PLANTING DETAILS & SPECIFICATIONS.

8. IN THE EVENT OF WORK IN OR ON THE JCW SANITARY MAIN. ANY TREES OR PLANTINGS PLACED WITHIN THE SEWER EASEMENT MAY BE REMOVED WITHOUT REPLACEMENT OR COMPENSATION THERE OF AND SHALL BE REPLACED BY THE PROPERTY OWNER AS REQUIRED BY THE CITY.

9. STRIP TOP SOIL & SAVE FOR PLANTING AREAS. REFER TO L3.00 FOR PLANTING SOIL MIX.

10. ROCK BEDS SHALL BE BUFFALO RIVER ROCK, 1"-2.5" SIZE, BY HOUSE OF ROCKS OR APPROVED EQUAL. ALL ROCK BED AREAS SHALL HAVE FILTER FABRIC & BE 4" MIN. DEPTH.

11. ALL LANDSCAPE BEDS WITHIN POOL ENCLOSURE TO INCLUDE RIVER ROCK PER SPECS.

12. FINISHED GRADE TO BE TOP OF MULCH OR TURF FOR ALL LANDSCAPE AREAS. REFER TO CIVIL PLANS FOR GRADING INFORMATION.

SEEDING & SOD NOTES:

- REFER TO GENERAL NOTES ON PLANTING DETAILS PAGE FOR SEED MIX AND SOD MATERIAL.
 REFER TO PROJECT SPECIFICATIONS SECTION 3.1 FOR TURF AREA PREPARATION, AND THE KANSAS
 CITY METROPOLITAN CHAPTER OF THE APWA, DIVISION II, SECTION 2406.2 FOR ADDITIONAL GRADING
 AND TILLAGE GUIDELINES & PROCEDURES.
- 3. REFER TO THE KANSAS CITY METROPOLITAN CHAPTER OF THE APWA, DIVISION II, SECTION 2406.3 FOR FERTILIZATION GUIDELINES & PROCEDURES.
- 4. REFER TO PROJECT SPECIFICATION SECTION 3.3, AND THE KANSAS CITY METROPOLITAN CHAPTER OF THE APWA, DIVISION II, SECTION 2406.4.D FOR SOD INSTALLATION GUIDELINES & PROCEDURES.
 5. SEEDING OPTIONS:
- 5.1. <u>HYDROSEEDING</u> REFER TO KANSAS CITY METROPOLITAN CHAPTER OF THE APWA, DIVISION II, SECTION 2406.4.C FOR HYDROSEEDING GUIDELINES & PROCEDURES.
 5.2. <u>SOWING</u> REFER TO PROJECT SPECIFICATIONS SECTION 3.2 AND THE KANSAS CITY
- METROPOLITAN CHAPTER OF THE APWA, DIVISION II, SECTION 2406.4.B FOR SEED SOWING PROCEDURES.

 6. SOWN SEED PROTECTION & SECURING METHODS. PROTECT ALL SEEDED AREAS WITH SLOPES NOT

SOWN SEED PROTECTION & SECURING METHODS. PROTECT ALL SEEDED AREAS WITH SLOPES NOT EXCEEDING 6:1 (15+%) BY EITHER METHOD LISTED IN THE PROJECT SPECIFICATION SECTION 3.2.D.
 IF ANY DISCREPANCIES ARE FOUND BETWEEN THE PROJECT GENERAL NOTES, PROJECT SPECIFICATIONS, AND APWA SECTION 2400, THE MOST STRINGENT GUIDELINE APPLIES.

REVISIONS
1 10.28.24 FDP COMMENTS 2

DRAWING RELEASE LOG

● 09.16.24 PERMIT SET


• 10.28.24 CITY COMMENTS


WN BY
W / KRM

RMIT SET

EET NAME
RUB PLANTING

2.04

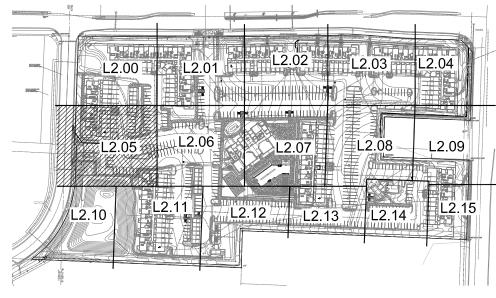

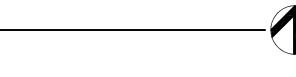

Botanical Name

PLANT LIST

Evergr	een Shrubs		
CGH	China Boy Holly	llex x meserveae 'Mesdob'	5 (
CGH	China Girl Holly	llex x meserveae 'Mesog'	5 (
DFY	Densifomis Yew	Taxus x media 'Densiformis'	5 (
ELY	Everlow Yew	Taxus x media 'Everlow'	5 (
GBS	Globe Blue Spruce	Picea pungens 'Glauca globosa'	5 (
GGB	Green Gem Boxwood	Buxus microphylla x 'Green Gem'	5 (
GMC	Gold Mop Cypress	Chamaecyparis pisifera 'Yellow Thread Branch'	5 (
PFJ	Perfecta Juniper	Juniperus chinensis 'Perfecta'	5 (
PRB	Green Mountain Boxwood (Pyramidal)	Buxus microphylla 'Green Mountain'	5 (
SJG	Sea Green Juniper	Juniperus chinensis 'Sea Green'	5
TMJ	Tam Juniper	Juniperus sabina 'Tamariscifolia'	5 (
WGB	Winter Green Boxwood	Buxus microphylla 'Winter Green'	5 (
WTB	Red Sprite Winterberry	llex verticillata 'Nana'	5 (
WYW	Wardii Yew	Taxus x media 'Wardii'	5 (
Decidio	ous Shrubs		
CPR	Red Carpet Rose	Rosa 'Flower Carpet Red'	2 (
DGW	Variegated Red Twigged Dogwood	Cornus alba 'Ivory Halo'	2 (
DRT	Dwarf Red Twig Dogwood	Cornus sericea 'Kelseyi"	20
ESH	Endless Summer Hydrangea	Hydrangea macrophylla 'Bailmer'	20
GLS	Gro-Low Sumac	Rhus aromatica 'Gro-Low'	2 (
GMS	Goldmound Spirea	Spiraea japonica 'Goldmound'	2 (
HYD	Annabelle Hydrangea	Hydrangea arborescens 'Annabelle'	2 (
KNR	Knockout Rose	Rosa knockout	2 (
LHS	Little Henry Sweetspire	Itea virginica 'Little Henry'	20
LPS	Little Princess Spirea	Spiraea japonica 'Little Princess'	2 (
MCS	Magic Carpet Spirea	Spiraea japonica 'Magic Carpet'	2 (
ROS	Rose of Sharon - Lavender Chiffon	Hibiscus syriacus 'Notwoodone'	2 (
WIG	Fine Wine Weigela	Weigela florida 'Bramwell'	2 (
Perenn	ials		
CAT	Catmint	Nepeta x faassenii 'Walker's Low'	1 (
DAY	Rosy Returns Daylily	Hemerocallis 'Rosy Returns'	1 (
DSY	Daisy	Leucanthemum x superbum 'Becky'	1 (
HOS	Sum & Substance Hosta	Hosta 'Sum & Substance'	1 (
IRS	Blue Flag Iris	Iris virginica v. shrevei	1 (
MSG	Blue Salvia	Salvia nemorosa 'May Night'	1 (
SBA	Summer Beauty Allium	Allium 'Summer Beauty'	1 (
Grasse	S		
KFG	Karl Foerster Grass	Calamagrostis x acutiflora 'Karl Foerster'	1 (
MLG	Morning Light Maiden Grass	Miscanthus sinensis 'Morning Light'	1 (
NWG	Northwind Switch Grass	Panicum virgatum 'Northwind'	1 (
RSG	Red Switch Grass	Panicum virgatum 'Prairie Fire'	1 (
VLR	Variegated Liriope	Liriope muscari variegata	1 (

1. EACH BIDDER SHALL VISIT THE SITE OF THE PROPOSED WORK AND EXAMINE THE SITE CONDITIONS. HE SHALL ALSO CAREFULLY EXAMINE THE DRAWINGS FOR THE PROPOSED WORK AND FAMILIARIZE HIMSELF WITH ALL CONDITIONS, WHICH MAY AFFECT THE PROPOSED WORK.

2. THE PLANTING PLAN GRAPHICALLY ILLUSTRATES OVERALL PLANT MASSINGS. EACH PLANT SPECIES MASSING SHALL BE PLACED IN THE FIELD TO UTILIZE GREATEST COVERAGE OF GROUND PLANE. THE FOLLOWING APPLIES FOR INDIVIDUAL PLANTINGS:

A. CREEPING GROUNDCOVER SHALL BE A MINIMUM OF 6" FROM PAVING EDGE. B. ALL TREES SHALL BE A MINIMUM OF 3' FROM PAVING EDGE. C. ALL PLANTS OF THE SAME SPECIES SHALL BE EQUALLY SPACED APART AND PLACED

FOR BEST AESTHETIC VIEWING. D. ALL SHRUBS SHALL BE A MINIMUM OF 2' FROM PAVED EDGE.

3. NOTIFY LANDSCAPE ARCHITECT 1 WEEK PRIOR TO ANTICIPATED START OF PLANT MATERIAL INSTALLATION. LANDSCAPE CONTRACTOR SHALL STAKE ALL PROPOSED PLANTING BED EDGES, SET OUT SHRUBS IN INTENDED LOCATIONS, AND STAKE TREE LOCATIONS FOR APPROVAL BY LANDSCAPE ARCHITECT PRIOR TO INSTALLATION.

4. ALL NEW PLANT BED AREAS TO BE IRRIGATED. REFER TO SPECIFICATIONS FOR IRRIGATION SYSTEM DESCRIPTION.

5. REFER TO L1.00 SERIES SHEETS FOR TREE PLANTINGS.

6. REFER TO L2.00 SERIES SHEETS FOR SHRUB PLANTINGS & ROCK MATERIALS.

7. REFER TO L3.00 SERIES SHEETS FOR PLANTING DETAILS & SPECIFICATIONS.

8. IN THE EVENT OF WORK IN OR ON THE JCW SANITARY MAIN. ANY TREES OR PLANTINGS PLACED WITHIN THE SEWER EASEMENT MAY BE REMOVED WITHOUT REPLACEMENT OR COMPENSATION THERE OF AND SHALL BE REPLACED BY THE PROPERTY OWNER AS REQUIRED $\sqrt{2}$ 9. STRIP TOP SOIL & SAVE FOR PLANTING AREAS. REFER TO L3.00 FOR PLANTING SOIL MIX.

10. ROCK BEDS SHALL BE BUFFALO RIVER ROCK, 1"-2.5" SIZE, BY HOUSE OF ROCKS OR APPROVED EQUAL. ALL ROCK BED AREAS SHALL HAVE FILTER FABRIC & BE 4" MIN. DEPTH.

11. ALL LANDSCAPE BEDS WITHIN POOL ENCLOSURE TO INCLUDE RIVER ROCK PER SPECS. 12. FINISHED GRADE TO BE TOP OF MULCH OR TURF FOR ALL LANDSCAPE AREAS. REFER TO CIVIL PLANS FOR GRADING INFORMATION.

SEEDING & SOD NOTES:

- REFER TO GENERAL NOTES ON PLANTING DETAILS PAGE FOR SEED MIX AND SOD MATERIAL. REFER TO PROJECT SPECIFICATIONS SECTION 3.1 FOR TURF AREA PREPARATION, AND THE KANSAS CITY METROPOLITAN CHAPTER OF THE APWA, DIVISION II, SECTION 2406.2 FOR ADDITIONAL GRADING AND TILLAGE GUIDELINES & PROCEDURES.
- REFER TO THE KANSAS CITY METROPOLITAN CHAPTER OF THE APWA, DIVISION II, SECTION 2406.3 FOR FERTILIZATION GUIDELINES & PROCEDURES.
- REFER TO PROJECT SPECIFICATION SECTION 3.3, AND THE KANSAS CITY METROPOLITAN CHAPTER OF THE APWA, DIVISION II, SECTION 2406.4.D FOR SOD INSTALLATION GUIDELINES & PROCEDURES. SEEDING OPTIONS:
- 5.1. HYDROSEEDING REFER TO KANSAS CITY METROPOLITAN CHAPTER OF THE APWA, DIVISION II, SECTION 2406.4.C FOR HYDROSEEDING GUIDELINES & PROCEDURES. 5.2. SOWING - REFER TO PROJECT SPECIFICATIONS SECTION 3.2 AND THE KANSAS CITY
- METROPOLITAN CHAPTER OF THE APWA, DIVISION II, SECTION 2406.4.B FOR SEED SOWING 6. SOWN SEED PROTECTION & SECURING METHODS. PROTECT ALL SEEDED AREAS WITH SLOPES NOT
- EXCEEDING 6:1 (15+%) BY EITHER METHOD LISTED IN THE PROJECT SPECIFICATION SECTION 3.2.D. 7. IF ANY DISCREPANCIES ARE FOUND BETWEEN THE PROJECT GENERAL NOTES, PROJECT SPECIFICATIONS, AND APWA SECTION 2400, THE MOST STRINGENT GUIDELINE APPLIES.

REVISIONS 1\10.28.24 FDP COMMENTS 2

DRAWING RELEASE LOG

• 09.16.24 PERMIT SET

• 10.28.24 CITY COMMENTS


ARCHITECTS

ARCHITECTURE


L A N D S C A P E ARCHITECTURE

P.913.831.1415 NSPJARCH.COM

SEE L2.11

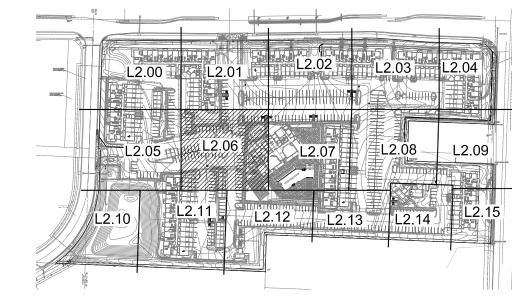

KEY PLAN

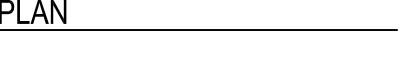

PLANT LIST

Code	Common Name	Botanical Name	5
Evergr	een Shrubs		
CGH	China Boy Holly	llex x meserveae 'Mesdob'	5
CGH	China Girl Holly	llex x meserveae 'Mesog'	5
DFY	Densifomis Yew	Taxus x media 'Densiformis'	5
ELY	Everlow Yew	Taxus x media 'Everlow'	5
GBS	Globe Blue Spruce	Picea pungens 'Glauca globosa'	5
GGB	Green Gem Boxwood	Buxus microphylla x 'Green Gem'	5
GMC	Gold Mop Cypress	Chamaecyparis pisifera 'Yellow Thread Branch'	5
PFJ	Perfecta Juniper	Juniperus chinensis 'Perfecta'	5
PRB	Green Mountain Boxwood (Pyramidal)	Buxus microphylla 'Green Mountain'	5
SJG	Sea Green Juniper	Juniperus chinensis 'Sea Green'	5
TMJ	Tam Juniper	Juniperus sabina 'Tamariscifolia'	5
WGB	Winter Green Boxwood	Buxus microphylla 'Winter Green'	5
WTB	Red Sprite Winterberry	llex verticillata 'Nana'	5
WYW	Wardii Yew	Taxus x media 'Wardii'	5
Decidio	ous Shrubs		
CPR	Red Carpet Rose	Rosa 'Flower Carpet Red'	2
DGW	Variegated Red Twigged Dogwood	Cornus alba 'Ivory Halo'	2
DRT	Dwarf Red Twig Dogwood	Cornus sericea 'Kelseyi"	2
ESH	Endless Summer Hydrangea	Hydrangea macrophylla 'Bailmer'	2
GLS	Gro-Low Sumac	Rhus aromatica 'Gro-Low'	2
GMS	Goldmound Spirea	Spiraea japonica 'Goldmound'	2
HYD	Annabelle Hydrangea	Hydrangea arborescens 'Annabelle'	2
KNR	Knockout Rose	Rosa knockout	2
LHS	Little Henry Sweetspire	Itea virginica 'Little Henry'	2
LPS	Little Princess Spirea	Spiraea japonica 'Little Princess'	2
MCS	Magic Carpet Spirea	Spiraea japonica 'Magic Carpet'	2
ROS	Rose of Sharon - Lavender Chiffon	Hibiscus syriacus 'Notwoodone'	2
WIG	Fine Wine Weigela	Weigela florida 'Bramwell'	2
Perenn	Confidence of the Confidence o		
CAT	Catmint	Nepeta x faassenii 'Walker's Low'	1
DAY	Rosy Returns Daylily	Hemerocallis 'Rosy Returns'	1
DSY	Daisy	Leucanthemum x superbum 'Becky'	1
HOS	Sum & Substance Hosta	Hosta 'Sum & Substance'	1
IRS	Blue Flag Iris	Iris virginica v. shrevei	1
MSG	Blue Salvia	Salvia nemorosa 'May Night'	1
SBA	Summer Beauty Allium	Allium 'Summer Beauty'	1
Grasse	S		
KFG	Karl Foerster Grass	Calamagrostis x acutiflora 'Karl Foerster'	1
MLG	Morning Light Maiden Grass	Miscanthus sinensis 'Morning Light'	1
NWG	Northwind Switch Grass	Panicum virgatum 'Northwind'	1
RSG	Red Switch Grass	Panicum virgatum 'Prairie Fire'	1
VLR	Variegated Liriope	Liriope muscari variegata	1

GENERAL NOTES:

1. EACH BIDDER SHALL VISIT THE SITE OF THE PROPOSED WORK AND EXAMINE THE SITE CONDITIONS. HE SHALL ALSO CAREFULLY EXAMINE THE DRAWINGS FOR THE PROPOSED WORK AND FAMILIARIZE HIMSELF WITH ALL CONDITIONS, WHICH MAY AFFECT THE PROPOSED WORK.

. THE PLANTING PLAN GRAPHICALLY ILLUSTRATES OVERALL PLANT MASSINGS. EACH PLANT SPECIES MASSING SHALL BE PLACED IN THE FIELD TO UTILIZE GREATEST COVERAGE OF GROUND PLANE. THE FOLLOWING APPLIES FOR INDIVIDUAL PLANTINGS:

A. CREEPING GROUNDCOVER SHALL BE A MINIMUM OF 6" FROM PAVING EDGE. B. ALL TREES SHALL BE A MINIMUM OF 3' FROM PAVING EDGE.

C. ALL PLANTS OF THE SAME SPECIES SHALL BE EQUALLY SPACED APART AND PLACED FOR BEST AESTHETIC VIEWING. D. ALL SHRUBS SHALL BE A MINIMUM OF 2' FROM PAVED EDGE.

3. NOTIFY LANDSCAPE ARCHITECT 1 WEEK PRIOR TO ANTICIPATED START OF PLANT MATERIAL INSTALLATION. LANDSCAPE CONTRACTOR SHALL STAKE ALL PROPOSED PLANTING BED EDGES, SET OUT SHRUBS IN INTENDED LOCATIONS, AND STAKE TREE LOCATIONS FOR APPROVAL BY LANDSCAPE ARCHITECT PRIOR TO INSTALLATION.

4. ALL NEW PLANT BED AREAS TO BE IRRIGATED. REFER TO SPECIFICATIONS FOR IRRIGATION SYSTEM DESCRIPTION.

- 5. REFER TO L1.00 SERIES SHEETS FOR TREE PLANTINGS.
- 6. REFER TO L2.00 SERIES SHEETS FOR SHRUB PLANTINGS & ROCK MATERIALS. 7. REFER TO L3.00 SERIES SHEETS FOR PLANTING DETAILS & SPECIFICATIONS.
- 8. IN THE EVENT OF WORK IN OR ON THE JCW SANITARY MAIN. ANY TREES OR PLANTINGS PLACED WITHIN THE SEWER EASEMENT MAY BE REMOVED WITHOUT REPLACEMENT OR

COMPENSATION THERE OF AND SHALL BE REPLACED BY THE PROPERTY OWNER AS REQUIRED

9. STRIP TOP SOIL & SAVE FOR PLANTING AREAS. REFER TO L3.00 FOR PLANTING SOIL MIX. 10. ROCK BEDS SHALL BE BUFFALO RIVER ROCK, 1"-2.5" SIZE, BY HOUSE OF ROCKS OR APPROVED EQUAL. ALL ROCK BED AREAS SHALL HAVE FILTER FABRIC & BE 4" MIN. DEPTH.

11. ALL LANDSCAPE BEDS WITHIN POOL ENCLOSURE TO INCLUDE RIVER ROCK PER SPECS.

12. FINISHED GRADE TO BE TOP OF MULCH OR TURF FOR ALL LANDSCAPE AREAS. REFER TO CIVIL PLANS FOR GRADING INFORMATION.

SEEDING & SOD NOTES:

SHRUB PLANTING PLAN

- REFER TO GENERAL NOTES ON PLANTING DETAILS PAGE FOR SEED MIX AND SOD MATERIAL. 2. REFER TO PROJECT SPECIFICATIONS SECTION 3.1 FOR TURF AREA PREPARATION, AND THE KANSAS CITY METROPOLITAN CHAPTER OF THE APWA, DIVISION II, SECTION 2406.2 FOR ADDITIONAL GRADING AND TILLAGE GUIDELINES & PROCEDURES.
- REFER TO THE KANSAS CITY METROPOLITAN CHAPTER OF THE APWA, DIVISION II, SECTION 2406.3 FOR FERTILIZATION GUIDELINES & PROCEDURES.
- 4. REFER TO PROJECT SPECIFICATION SECTION 3.3, AND THE KANSAS CITY METROPOLITAN CHAPTER OF THE APWA, DIVISION II, SECTION 2406.4.D FOR SOD INSTALLATION GUIDELINES & PROCEDURES. SEEDING OPTIONS: 5.1. <u>HYDROSEEDING</u> - REFER TO KANSAS CITY METROPOLITAN CHAPTER OF THE APWA, DIVISION
- II, SECTION 2406.4.C FOR HYDROSEEDING GUIDELINES & PROCEDURES. 5.2. SOWING - REFER TO PROJECT SPECIFICATIONS SECTION 3.2 AND THE KANSAS CITY METROPOLITAN CHAPTER OF THE APWA, DIVISION II, SECTION 2406.4.B FOR SEED SOWING
- SOWN SEED PROTECTION & SECURING METHODS. PROTECT ALL SEEDED AREAS WITH SLOPES NOT EXCEEDING 6:1 (15+%) BY EITHER METHOD LISTED IN THE PROJECT SPECIFICATION SECTION 3.2.D. IF ANY DISCREPANCIES ARE FOUND BETWEEN THE PROJECT GENERAL NOTES, PROJECT SPECIFICATIONS, AND APWA SECTION 2400, THE MOST STRINGENT GUIDELINE APPLIES.

ARCHITECTS ARCHITECTURE L A N D S C A P E ARCHITECTURE P.913.831.1415 NSPJARCH.COM

9415 NALL AVE., #300 PRAIRIE VILLAGE, KANSAS, 66207




DRAWING RELEASE LOG

● 09.16.24 PERMIT SET

• 10.28.24 CITY COMMENTS

REVISIONS 1 09.13.24 FDP COMMENTS 1 2 10.28.24 FDP COMMENTS 2

DRAWN BY

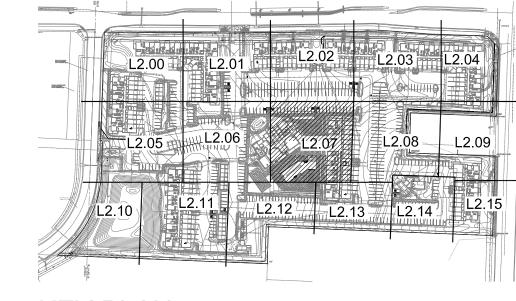



PLANT LIST

Code	Common Name	Botanical Name	S
Evergr	een Shrubs		
CGH	China Boy Holly	llex x meserveae 'Mesdob'	5
CGH	China Girl Holly	llex x meserveae 'Mesog'	5
DFY	Densifomis Yew	Taxus x media 'Densiformis'	5
ELY	Everlow Yew	Taxus x media 'Everlow'	5
GBS	Globe Blue Spruce	Picea pungens 'Glauca globosa'	5
GGB	Green Gem Boxwood	Buxus microphylla x 'Green Gem'	5
GMC	Gold Mop Cypress	Chamaecyparis pisifera 'Yellow Thread Branch'	5
PFJ	Perfecta Juniper	Juniperus chinensis 'Perfecta'	5
PRB	Green Mountain Boxwood (Pyramidal)	Buxus microphylla 'Green Mountain'	5
SJG	Sea Green Juniper	Juniperus chinensis 'Sea Green'	5
TMJ	Tam Juniper	Juniperus sabina 'Tamariscifolia'	5
WGB	Winter Green Boxwood	Buxus microphylla 'Winter Green'	5
WTB	Red Sprite Winterberry	llex verticillata 'Nana'	5
WYW	Wardii Yew	Taxus x media 'Wardii'	5
	ous Shrubs		
CPR	Red Carpet Rose	Rosa 'Flower Carpet Red'	2
DGW	Variegated Red Twigged Dogwood	Cornus alba 'Ivory Halo'	2
DRT	Dwarf Red Twig Dogwood	Cornus sericea 'Kelseyi"	2
ESH	Endless Summer Hydrangea	Hydrangea macrophylla 'Bailmer'	2
GLS	Gro-Low Sumac	Rhus aromatica 'Gro-Low'	2
GMS	Goldmound Spirea	Spiraea japonica 'Goldmound'	2
HYD	Annabelle Hydrangea	Hydrangea arborescens 'Annabelle'	2
KNR	Knockout Rose	Rosa knockout	2
LHS	Little Henry Sweetspire	Itea virginica 'Little Henry'	2
LPS	Little Princess Spirea	Spiraea japonica 'Little Princess'	2
MCS	Magic Carpet Spirea	Spiraea japonica 'Magic Carpet'	2
ROS	Rose of Sharon - Lavender Chiffon	Hibiscus syriacus 'Notwoodone'	2
WIG	Fine Wine Weigela	Weigela florida 'Bramwell'	2
Perenn			T)
CAT	Catmint	Nepeta x faassenii 'Walker's Low'	1
DAY	Rosy Returns Daylily	Hemerocallis 'Rosy Returns'	1
DSY	Daisy	Leucanthemum x superbum 'Becky'	1
HOS	Sum & Substance Hosta	Hosta 'Sum & Substance'	1
IRS	Blue Flag Iris	Iris virginica v. shrevei	1
MSG	Blue Salvia	Salvia nemorosa 'May Night'	1
SBA	Summer Beauty Allium	Allium 'Summer Beauty'	1
Grasse	s		
KFG	Karl Foerster Grass	Calamagrostis x acutiflora 'Karl Foerster'	1
MLG	Morning Light Maiden Grass	Miscanthus sinensis 'Morning Light'	1
NWG	Northwind Switch Grass	Panicum virgatum 'Northwind'	1
RSG	Red Switch Grass	Panicum virgatum 'Prairie Fire'	1
VLR	Variegated Liriope	Liriope muscari variegata	1

GENERAL NOTES:

- 1. EACH BIDDER SHALL VISIT THE SITE OF THE PROPOSED WORK AND EXAMINE THE SITE CONDITIONS. HE SHALL ALSO CAREFULLY EXAMINE THE DRAWINGS FOR THE PROPOSED WORK
- 2. THE PLANTING PLAN GRAPHICALLY ILLUSTRATES OVERALL PLANT MASSINGS. EACH PLANT SPECIES MASSING SHALL BE PLACED IN THE FIELD TO UTILIZE GREATEST COVERAGE OF
- GROUND PLANE. THE FOLLOWING APPLIES FOR INDIVIDUAL PLANTINGS: A. CREEPING GROUNDCOVER SHALL BE A MINIMUM OF 6" FROM PAVING EDGE.
- B. ALL TREES SHALL BE A MINIMUM OF 3' FROM PAVING EDGE. C. ALL PLANTS OF THE SAME SPECIES SHALL BE EQUALLY SPACED APART AND PLACED
- FOR BEST AESTHETIC VIEWING. D. ALL SHRUBS SHALL BE A MINIMUM OF 2' FROM PAVED EDGE.
- 3. NOTIFY LANDSCAPE ARCHITECT 1 WEEK PRIOR TO ANTICIPATED START OF PLANT MATERIAL INSTALLATION. LANDSCAPE CONTRACTOR SHALL STAKE ALL PROPOSED PLANTING BED EDGES, SET OUT SHRUBS IN INTENDED LOCATIONS, AND STAKE TREE LOCATIONS FOR APPROVAL BY LANDSCAPE ARCHITECT PRIOR TO INSTALLATION.

4. ALL NEW PLANT BED AREAS TO BE IRRIGATED. REFER TO SPECIFICATIONS FOR IRRIGATION

- 5. REFER TO L1.00 SERIES SHEETS FOR TREE PLANTINGS.
- 6. REFER TO L2.00 SERIES SHEETS FOR SHRUB PLANTINGS & ROCK MATERIALS.
- 7. REFER TO L3.00 SERIES SHEETS FOR PLANTING DETAILS & SPECIFICATIONS.
- 8. IN THE EVENT OF WORK IN OR ON THE JCW SANITARY MAIN. ANY TREES OR PLANTINGS PLACED WITHIN THE SEWER EASEMENT MAY BE REMOVED WITHOUT REPLACEMENT OR COMPENSATION THERE OF AND SHALL BE REPLACED BY THE PROPERTY OWNER AS REQUIRED
- 9. STRIP TOP SOIL & SAVE FOR PLANTING AREAS. REFER TO L3.00 FOR PLANTING SOIL MIX. 10. ROCK BEDS SHALL BE BUFFALO RIVER ROCK, 1"-2.5" SIZE, BY HOUSE OF ROCKS OR APPROVED EQUAL. ALL ROCK BED AREAS SHALL HAVE FILTER FABRIC & BE 4" MIN. DEPTH.
- 11. ALL LANDSCAPE BEDS WITHIN POOL ENCLOSURE TO INCLUDE RIVER ROCK PER SPECS.
- 12. FINISHED GRADE TO BE TOP OF MULCH OR TURF FOR ALL LANDSCAPE AREAS. REFER TO CIVIL PLANS FOR GRADING INFORMATION.

SEEDING & SOD NOTES:

- REFER TO GENERAL NOTES ON PLANTING DETAILS PAGE FOR SEED MIX AND SOD MATERIAL. REFER TO PROJECT SPECIFICATIONS SECTION 3.1 FOR TURF AREA PREPARATION, AND THE KANSAS CITY METROPOLITAN CHAPTER OF THE APWA, DIVISION II, SECTION 2406.2 FOR ADDITIONAL GRADING AND TILLAGE GUIDELINES & PROCEDURES.
- 3. REFER TO THE KANSAS CITY METROPOLITAN CHAPTER OF THE APWA, DIVISION II, SECTION 2406.3 FOR FERTILIZATION GUIDELINES & PROCEDURES.
- 4. REFER TO PROJECT SPECIFICATION SECTION 3.3, AND THE KANSAS CITY METROPOLITAN CHAPTER OF THE APWA, DIVISION II, SECTION 2406.4.D FOR SOD INSTALLATION GUIDELINES & PROCEDURES.
- SEEDING OPTIONS: 5.1. <u>HYDROSEEDING</u> - REFER TO KANSAS CITY METROPOLITAN CHAPTER OF THE APWA, DIVISION II, SECTION 2406.4.C FOR HYDROSEEDING GUIDELINES & PROCEDURES.
- 5.2. SOWING REFER TO PROJECT SPECIFICATIONS SECTION 3.2 AND THE KANSAS CITY METROPOLITAN CHAPTER OF THE APWA, DIVISION II, SECTION 2406.4.B FOR SEED SOWING
- 6. SOWN SEED PROTECTION & SECURING METHODS. PROTECT ALL SEEDED AREAS WITH SLOPES NOT EXCEEDING 6:1 (15+%) BY EITHER METHOD LISTED IN THE PROJECT SPECIFICATION SECTION 3.2.D. 7. IF ANY DISCREPANCIES ARE FOUND BETWEEN THE PROJECT GENERAL NOTES, PROJECT SPECIFICATIONS, AND APWA SECTION 2400, THE MOST STRINGENT GUIDELINE APPLIES.

REVISIONS 1 09.13.24 FDP COMMENTS 1 2 10.28.24 FDP COMMENTS 2

DRAWING RELEASE LOG

• 09.16.24 PERMIT SET


• 10.28.24 CITY COMMENTS


P.913.831.1415 NSPJARCH.COM 9415 NALL AVE., #300 PRAIRIE VILLAGE, KANSAS, 66207 © 2024

ARCHITECTS

ARCHITECTURE

L A N D S C A P E ARCHITECTURE

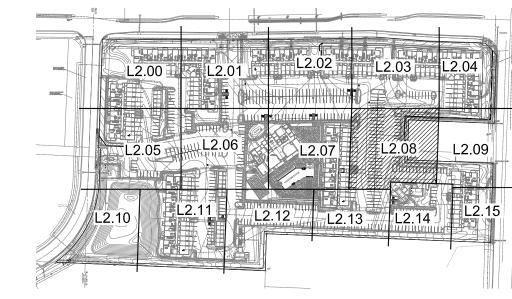

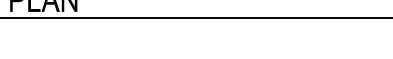

PLANT LIST

Code	Common Name	Botanical Name	Si
Evergr	een Shrubs		
CGH	China Boy Holly	llex x meserveae 'Mesdob'	5 0
CGH	China Girl Holly	llex x meserveae 'Mesog'	5 0
DFY	Densifomis Yew	Taxus x media 'Densiformis'	5 (
ELY	Everlow Yew	Taxus x media 'Everlow'	5 (
GBS	Globe Blue Spruce	Picea pungens 'Glauca globosa'	5 (
GGB	Green Gem Boxwood	Buxus microphylla x 'Green Gem'	5 0
GMC	Gold Mop Cypress	Chamaecyparis pisifera 'Yellow Thread Branch'	5 (
PFJ	Perfecta Juniper	Juniperus chinensis 'Perfecta'	5 0
PRB	Green Mountain Boxwood (Pyramidal)	Buxus microphylla 'Green Mountain'	5 (
SJG	Sea Green Juniper	Juniperus chinensis 'Sea Green'	5 g
TMJ	Tam Juniper	Juniperus sabina 'Tamariscifolia'	5 0
WGB	Winter Green Boxwood	Buxus microphylla 'Winter Green'	5 (
WTB	Red Sprite Winterberry	llex verticillata 'Nana'	5 0
WYW	Wardii Yew	Taxus x media 'Wardii'	5 0
Decidio	ous Shrubs		
CPR	Red Carpet Rose	Rosa 'Flower Carpet Red'	2 (
DGW	Variegated Red Twigged Dogwood	Cornus alba 'Ivory Halo'	20
DRT	Dwarf Red Twig Dogwood	Cornus sericea 'Kelseyi"	20
ESH	Endless Summer Hydrangea	Hydrangea macrophylla 'Bailmer'	20
GLS	Gro-Low Sumac	Rhus aromatica 'Gro-Low'	2 0
GMS	Goldmound Spirea	Spiraea japonica 'Goldmound'	20
HYD	Annabelle Hydrangea	Hydrangea arborescens 'Annabelle'	20
KNR	Knockout Rose	Rosa knockout	2 0
LHS	Little Henry Sweetspire	Itea virginica 'Little Henry'	20
LPS	Little Princess Spirea	Spiraea japonica 'Little Princess'	2 (
MCS	Magic Carpet Spirea	Spiraea japonica 'Magic Carpet'	2 0
ROS	Rose of Sharon - Lavender Chiffon	Hibiscus syriacus 'Notwoodone'	2 0
WIG	Fine Wine Weigela	Weigela florida 'Bramwell'	20
Perenn	75 ¹ / ₁		
CAT	Catmint	Nepeta x faassenii 'Walker's Low'	10
DAY	Rosy Returns Daylily	Hemerocallis 'Rosy Returns'	10
DSY	Daisy	Leucanthemum x superbum 'Becky'	10
HOS	Sum & Substance Hosta	Hosta 'Sum & Substance'	10
IRS	Blue Flag Iris	Iris virginica v. shrevei	10
MSG	Blue Salvia	Salvia nemorosa 'May Night'	10
SBA	Summer Beauty Allium	Allium 'Summer Beauty'	10
Grasse	s		
KFG	Karl Foerster Grass	Calamagrostis x acutiflora 'Karl Foerster'	10
MLG	Morning Light Maiden Grass	Miscanthus sinensis 'Morning Light'	10
NWG	Northwind Switch Grass	Panicum virgatum 'Northwind'	1 0
RSG	Red Switch Grass	Panicum virgatum 'Prairie Fire'	10
VLR	Variegated Liriope	Liriope muscari variegata	10

1. EACH BIDDER SHALL VISIT THE SITE OF THE PROPOSED WORK AND EXAMINE THE SITE CONDITIONS. HE SHALL ALSO CAREFULLY EXAMINE THE DRAWINGS FOR THE PROPOSED WORK AND FAMILIARIZE HIMSELF WITH ALL CONDITIONS, WHICH MAY AFFECT THE PROPOSED WORK.

2. THE PLANTING PLAN GRAPHICALLY ILLUSTRATES OVERALL PLANT MASSINGS. EACH PLANT SPECIES MASSING SHALL BE PLACED IN THE FIELD TO UTILIZE GREATEST COVERAGE OF

GROUND PLANE. THE FOLLOWING APPLIES FOR INDIVIDUAL PLANTINGS: A. CREEPING GROUNDCOVER SHALL BE A MINIMUM OF 6" FROM PAVING EDGE. B. ALL TREES SHALL BE A MINIMUM OF 3' FROM PAVING EDGE.

C. ALL PLANTS OF THE SAME SPECIES SHALL BE EQUALLY SPACED APART AND PLACED FOR BEST AESTHETIC VIEWING. D. ALL SHRUBS SHALL BE A MINIMUM OF 2' FROM PAVED EDGE.

3. NOTIFY LANDSCAPE ARCHITECT 1 WEEK PRIOR TO ANTICIPATED START OF PLANT MATERIAL INSTALLATION. LANDSCAPE CONTRACTOR SHALL STAKE ALL PROPOSED PLANTING BED EDGES, SET OUT SHRUBS IN INTENDED LOCATIONS, AND STAKE TREE LOCATIONS FOR APPROVAL BY LANDSCAPE ARCHITECT PRIOR TO INSTALLATION.

4. ALL NEW PLANT BED AREAS TO BE IRRIGATED. REFER TO SPECIFICATIONS FOR IRRIGATION SYSTEM DESCRIPTION.

- 5. REFER TO L1.00 SERIES SHEETS FOR TREE PLANTINGS.
- 6. REFER TO L2.00 SERIES SHEETS FOR SHRUB PLANTINGS & ROCK MATERIALS.
- 7. REFER TO L3.00 SERIES SHEETS FOR PLANTING DETAILS & SPECIFICATIONS.

8. IN THE EVENT OF WORK IN OR ON THE JCW SANITARY MAIN. ANY TREES OR PLANTINGS PLACED WITHIN THE SEWER EASEMENT MAY BE REMOVED WITHOUT REPLACEMENT OR COMPENSATION THERE OF AND SHALL BE REPLACED BY THE PROPERTY OWNER AS REQUIRED

9. STRIP TOP SOIL & SAVE FOR PLANTING AREAS. REFER TO L3.00 FOR PLANTING SOIL MIX. 10. ROCK BEDS SHALL BE BUFFALO RIVER ROCK, 1"-2.5" SIZE, BY HOUSE OF ROCKS OR APPROVED EQUAL. ALL ROCK BED AREAS SHALL HAVE FILTER FABRIC & BE 4" MIN. DEPTH.

11. ALL LANDSCAPE BEDS WITHIN POOL ENCLOSURE TO INCLUDE RIVER ROCK PER SPECS.

12. FINISHED GRADE TO BE TOP OF MULCH OR TURF FOR ALL LANDSCAPE AREAS. REFER TO CIVIL PLANS FOR GRADING INFORMATION.

- REFER TO GENERAL NOTES ON PLANTING DETAILS PAGE FOR SEED MIX AND SOD MATERIAL. 2. REFER TO PROJECT SPECIFICATIONS SECTION 3.1 FOR TURF AREA PREPARATION, AND THE KANSAS CITY METROPOLITAN CHAPTER OF THE APWA, DIVISION II, SECTION 2406.2 FOR ADDITIONAL GRADING AND TILLAGE GUIDELINES & PROCEDURES.
- 3. REFER TO THE KANSAS CITY METROPOLITAN CHAPTER OF THE APWA, DIVISION II, SECTION 2406.3 FOR FERTILIZATION GUIDELINES & PROCEDURES. 4. REFER TO PROJECT SPECIFICATION SECTION 3.3, AND THE KANSAS CITY METROPOLITAN CHAPTER
- OF THE APWA, DIVISION II, SECTION 2406.4.D FOR SOD INSTALLATION GUIDELINES & PROCEDURES.
- 5.1. <u>HYDROSEEDING</u> REFER TO KANSAS CITY METROPOLITAN CHAPTER OF THE APWA, DIVISION II, SECTION 2406.4.C FOR HYDROSEEDING GUIDELINES & PROCEDURES.
- 5.2. SOWING REFER TO PROJECT SPECIFICATIONS SECTION 3.2 AND THE KANSAS CITY METROPOLITAN CHAPTER OF THE APWA, DIVISION II, SECTION 2406.4.B FOR SEED SOWING
- 6. SOWN SEED PROTECTION & SECURING METHODS. PROTECT ALL SEEDED AREAS WITH SLOPES NOT
- EXCEEDING 6:1 (15+%) BY EITHER METHOD LISTED IN THE PROJECT SPECIFICATION SECTION 3.2.D. 7. IF ANY DISCREPANCIES ARE FOUND BETWEEN THE PROJECT GENERAL NOTES, PROJECT SPECIFICATIONS, AND APWA SECTION 2400, THE MOST STRINGENT GUIDELINE APPLIES.



DRAWING RELEASE LOG

● 09.16.24 PERMIT SET


■ 10.28.24 CITY COMMENTS


ARCHITECTS

ARCHITECTURE

L A N D S C A P E ARCHITECTURE

P.913.831.1415 NSPJARCH.COM

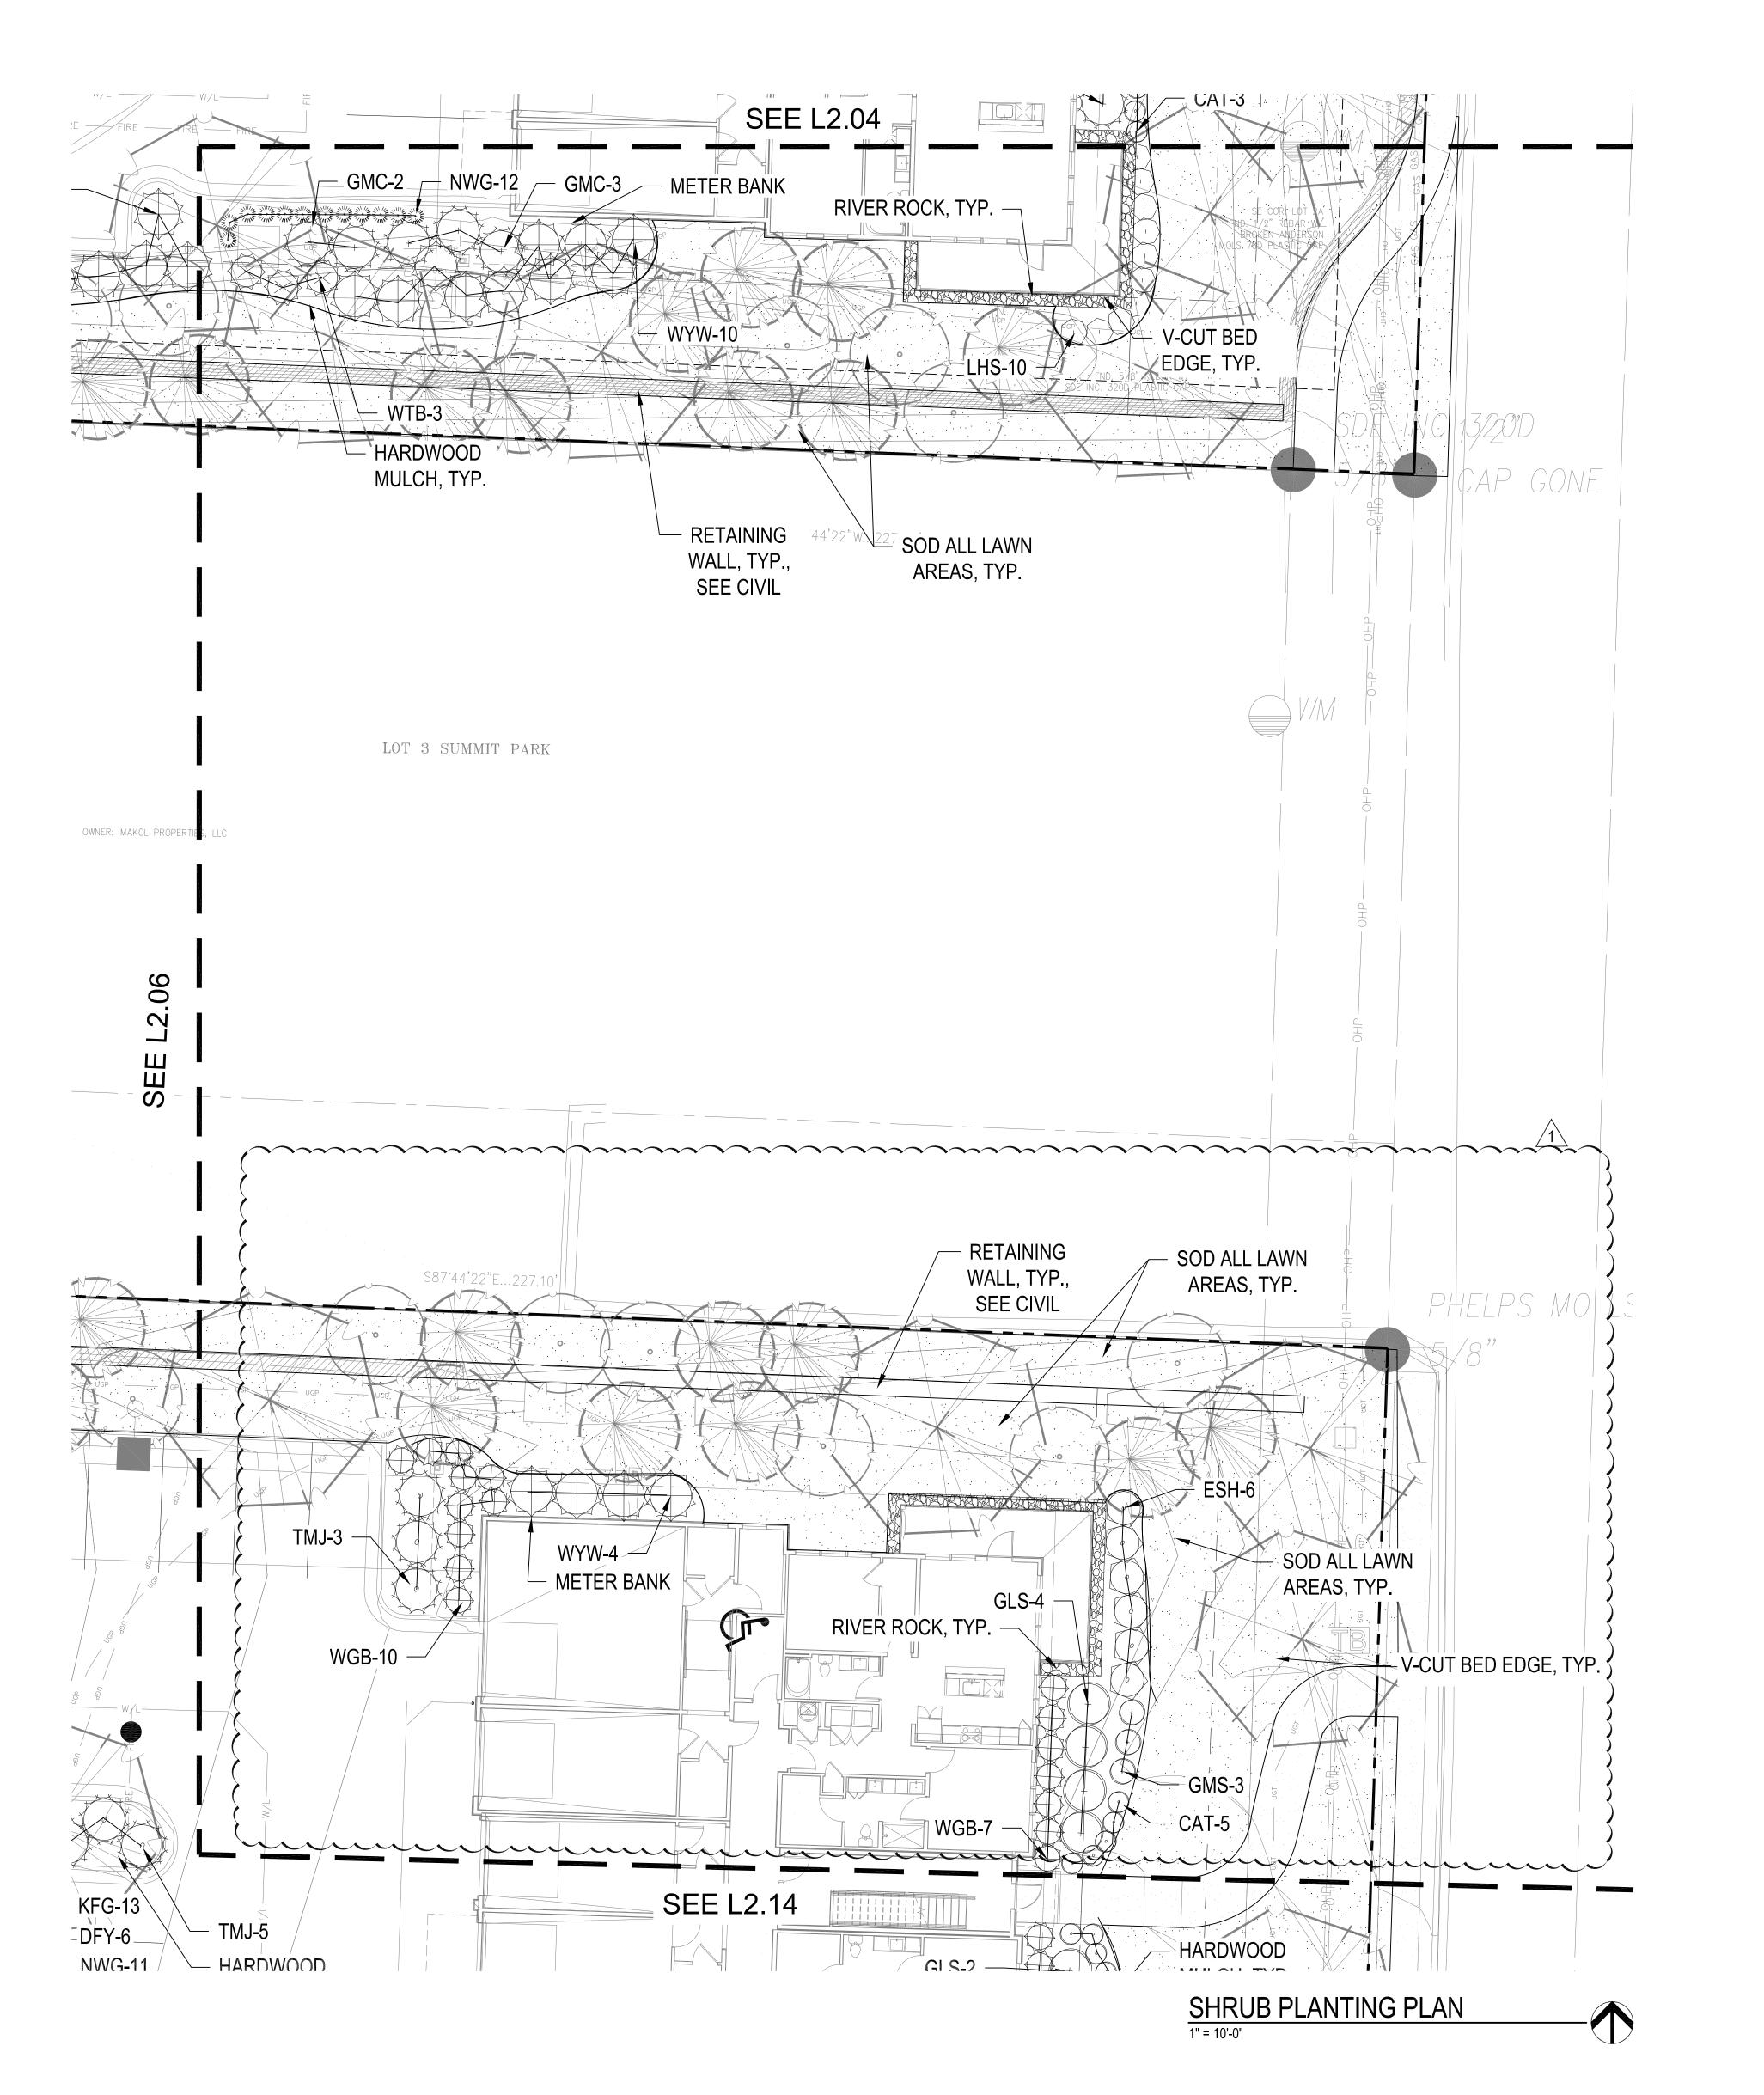

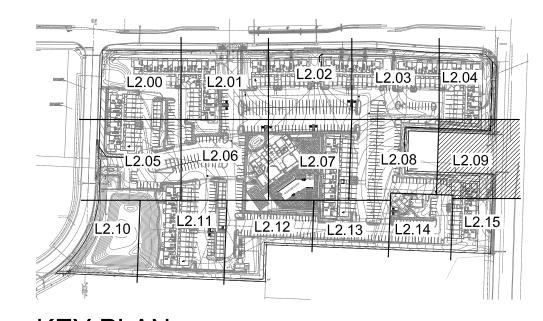



PLANT LIST

Code	Common Name	Botanical Name	
	een Shrubs		
CGH	China Boy Holly	llex x meserveae 'Mesdob'	
CGH	China Girl Holly	llex x meserveae 'Mesog'	
DFY	Densifomis Yew	Taxus x media 'Densiformis'	
ELY	Everlow Yew	Taxus x media 'Everlow'	
GBS	Globe Blue Spruce	Picea pungens 'Glauca globosa'	
GGB	Green Gem Boxwood	Buxus microphylla x 'Green Gem'	
GMC	Gold Mop Cypress	Chamaecyparis pisifera 'Yellow Thread Branch'	
PFJ	Perfecta Juniper	Juniperus chinensis 'Perfecta'	
PRB	Green Mountain Boxwood (Pyramidal)	Buxus microphylla 'Green Mountain'	
SJG	Sea Green Juniper	Juniperus chinensis 'Sea Green'	
TMJ	Tam Juniper	Juniperus sabina 'Tamariscifolia'	
WGB	Winter Green Boxwood	Buxus microphylla 'Winter Green'	
WTB	Red Sprite Winterberry	llex verticillata 'Nana'	
WYW	Wardii Yew	Taxus x media 'Wardii'	
Decidio	ous Shrubs		
CPR	Red Carpet Rose	Rosa 'Flower Carpet Red'	
DGW	Variegated Red Twigged Dogwood	Cornus alba 'Ivory Halo'	
DRT	Dwarf Red Twig Dogwood	Cornus sericea 'Kelseyi"	
ESH	Endless Summer Hydrangea	Hydrangea macrophylla 'Bailmer'	
GLS	Gro-Low Sumac	Rhus aromatica 'Gro-Low'	
GMS	Goldmound Spirea	Spiraea japonica 'Goldmound'	
HYD	Annabelle Hydrangea	Hydrangea arborescens 'Annabelle'	
KNR	Knockout Rose	Rosa knockout	
LHS	Little Henry Sweetspire	Itea virginica 'Little Henry'	
LPS	Little Princess Spirea	Spiraea japonica 'Little Princess'	
MCS	Magic Carpet Spirea	Spiraea japonica 'Magic Carpet'	
ROS	Rose of Sharon - Lavender Chiffon	Hibiscus syriacus 'Notwoodone'	
WIG	Fine Wine Weigela	Weigela florida 'Bramwell'	
Perenn	violation of		
CAT	Catmint	Nepeta x faassenii 'Walker's Low'	
DAY	Rosy Returns Daylily	Hemerocallis 'Rosy Returns'	
DSY	Daisy	Leucanthemum x superbum 'Becky'	
HOS	Sum & Substance Hosta	Hosta 'Sum & Substance'	
IRS	Blue Flag Iris	Iris virginica v. shrevei	
MSG	Blue Salvia	Salvia nemorosa 'May Night'	
SBA	Summer Beauty Allium	Allium 'Summer Beauty'	
Grasse	S	***************************************	
KFG	Karl Foerster Grass	Calamagrostis x acutiflora 'Karl Foerster'	
MLG	Morning Light Maiden Grass	Miscanthus sinensis 'Morning Light'	
NWG	Northwind Switch Grass	Panicum virgatum 'Northwind'	
RSG	Red Switch Grass	Panicum virgatum 'Prairie Fire'	
VLR	Variegated Liriope	Liriope muscari variegata	

GENERAL NOTES:

1. EACH BIDDER SHALL VISIT THE SITE OF THE PROPOSED WORK AND EXAMINE THE SITE CONDITIONS. HE SHALL ALSO CAREFULLY EXAMINE THE DRAWINGS FOR THE PROPOSED WORK AND FAMILIARIZE HIMSELF WITH ALL CONDITIONS, WHICH MAY AFFECT THE PROPOSED WORK.

SPECIES MASSING SHALL BE PLACED IN THE FIELD TO UTILIZE GREATEST COVERAGE OF GROUND PLANE. THE FOLLOWING APPLIES FOR INDIVIDUAL PLANTINGS: A. CREEPING GROUNDCOVER SHALL BE A MINIMUM OF 6" FROM PAVING EDGE. B. ALL TREES SHALL BE A MINIMUM OF 3' FROM PAVING EDGE.

2. THE PLANTING PLAN GRAPHICALLY ILLUSTRATES OVERALL PLANT MASSINGS. EACH PLANT

C. ALL PLANTS OF THE SAME SPECIES SHALL BE EQUALLY SPACED APART AND PLACED FOR BEST AESTHETIC VIEWING. D. ALL SHRUBS SHALL BE A MINIMUM OF 2' FROM PAVED EDGE.

3. NOTIFY LANDSCAPE ARCHITECT 1 WEEK PRIOR TO ANTICIPATED START OF PLANT MATERIAL INSTALLATION. LANDSCAPE CONTRACTOR SHALL STAKE ALL PROPOSED PLANTING BED EDGES, SET OUT SHRUBS IN INTENDED LOCATIONS, AND STAKE TREE LOCATIONS FOR APPROVAL BY LANDSCAPE ARCHITECT PRIOR TO INSTALLATION.

4. ALL NEW PLANT BED AREAS TO BE IRRIGATED. REFER TO SPECIFICATIONS FOR IRRIGATION SYSTEM DESCRIPTION.

5. REFER TO L1.00 SERIES SHEETS FOR TREE PLANTINGS.

6. REFER TO L2.00 SERIES SHEETS FOR SHRUB PLANTINGS & ROCK MATERIALS.

7. REFER TO L3.00 SERIES SHEETS FOR PLANTING DETAILS & SPECIFICATIONS.

PLACED WITHIN THE SEWER EASEMENT MAY BE REMOVED WITHOUT REPLACEMENT OR COMPENSATION THERE OF AND SHALL BE REPLACED BY THE PROPERTY OWNER AS REQUIRED $\sqrt{2}$ 9. STRIP TOP SOIL & SAVE FOR PLANTING AREAS. REFER TO L3.00 FOR PLANTING SOIL MIX.

8. IN THE EVENT OF WORK IN OR ON THE JCW SANITARY MAIN. ANY TREES OR PLANTINGS

10. ROCK BEDS SHALL BE BUFFALO RIVER ROCK, 1"-2.5" SIZE, BY HOUSE OF ROCKS OR APPROVED EQUAL. ALL ROCK BED AREAS SHALL HAVE FILTER FABRIC & BE 4" MIN. DEPTH.

11. ALL LANDSCAPE BEDS WITHIN POOL ENCLOSURE TO INCLUDE RIVER ROCK PER SPECS.

12. FINISHED GRADE TO BE TOP OF MULCH OR TURF FOR ALL LANDSCAPE AREAS. REFER TO CIVIL PLANS FOR GRADING INFORMATION.

SEEDING & SOD NOTES:

- REFER TO GENERAL NOTES ON PLANTING DETAILS PAGE FOR SEED MIX AND SOD MATERIAL. REFER TO PROJECT SPECIFICATIONS SECTION 3.1 FOR TURF AREA PREPARATION, AND THE KANSAS CITY METROPOLITAN CHAPTER OF THE APWA, DIVISION II, SECTION 2406.2 FOR ADDITIONAL GRADING AND TILLAGE GUIDELINES & PROCEDURES.
- 3. REFER TO THE KANSAS CITY METROPOLITAN CHAPTER OF THE APWA, DIVISION II, SECTION 2406.3 FOR FERTILIZATION GUIDELINES & PROCEDURES. 4. REFER TO PROJECT SPECIFICATION SECTION 3.3, AND THE KANSAS CITY METROPOLITAN CHAPTER
- OF THE APWA, DIVISION II, SECTION 2406.4.D FOR SOD INSTALLATION GUIDELINES & PROCEDURES. SEEDING OPTIONS:
- 5.1. <u>HYDROSEEDING</u> REFER TO KANSAS CITY METROPOLITAN CHAPTER OF THE APWA, DIVISION II, SECTION 2406.4.C FOR HYDROSEEDING GUIDELINES & PROCEDURES.
- 5.2. <u>SOWING</u> REFER TO PROJECT SPECIFICATIONS SECTION 3.2 AND THE KANSAS CITY METROPOLITAN CHAPTER OF THE APWA, DIVISION II, SECTION 2406.4.B FOR SEED SOWING PROCEDURES.
- 6. SOWN SEED PROTECTION & SECURING METHODS. PROTECT ALL SEEDED AREAS WITH SLOPES NOT EXCEEDING 6:1 (15+%) BY EITHER METHOD LISTED IN THE PROJECT SPECIFICATION SECTION 3.2.D. 7. IF ANY DISCREPANCIES ARE FOUND BETWEEN THE PROJECT GENERAL NOTES, PROJECT SPECIFICATIONS, AND APWA SECTION 2400, THE MOST STRINGENT GUIDELINE APPLIES.







DRAWING RELEASE LOG

● 09.16.24 PERMIT SET

• 10.28.24 CITY COMMENTS

REVISIONS 1\10.28.24 FDP COMMENTS 2



PLANT LIST

Code	Common Name	Botanical Name
	een Shrubs	
CGH	China Boy Holly	llex x meserveae 'Mesdob'
CGH	China Girl Holly	llex x meserveae 'Mesog'
DFY	Densifomis Yew	Taxus x media 'Densiformis'
ELY	Everlow Yew	Taxus x media 'Everlow'
GBS	Globe Blue Spruce	Picea pungens 'Glauca globosa'
GGB	Green Gem Boxwood	Buxus microphylla x 'Green Gem'
GMC	Gold Mop Cypress	Chamaecyparis pisifera 'Yellow Thread Branch
PFJ	Perfecta Juniper	Juniperus chinensis 'Perfecta'
PRB	Green Mountain Boxwood (Pyramidal)	Buxus microphylla 'Green Mountain'
SJG	Sea Green Juniper	Juniperus chinensis 'Sea Green'
TMJ	Tam Juniper	Juniperus sabina 'Tamariscifolia'
WGB	Winter Green Boxwood	Buxus microphylla 'Winter Green'
WTB	Red Sprite Winterberry	llex verticillata 'Nana'
WYW	Wardii Yew	Taxus x media 'Wardii'
	ous Shrubs	
CPR	Red Carpet Rose	Rosa 'Flower Carpet Red'
DGW	Variegated Red Twigged Dogwood	Cornus alba 'Ivory Halo'
DRT	Dwarf Red Twig Dogwood	Cornus sericea 'Kelseyi"
ESH	Endless Summer Hydrangea	Hydrangea macrophylla 'Bailmer'
GLS	Gro-Low Sumac	Rhus aromatica 'Gro-Low'
GMS	Goldmound Spirea	Spiraea japonica 'Goldmound'
HYD	Annabelle Hydrangea	Hydrangea arborescens 'Annabelle'
KNR	Knockout Rose	Rosa knockout
LHS	Little Henry Sweetspire	Itea virginica 'Little Henry'
LPS	Little Princess Spirea	Spiraea japonica 'Little Princess'
MCS	Magic Carpet Spirea	Spiraea japonica 'Magic Carpet'
A O E UNIDATE		
ROS	Rose of Sharon - Lavender Chiffon	Hibiscus syriacus 'Notwoodone'
WIG	Fine Wine Weigela	Weigela florida 'Bramwell'
Perenn	The state of the s	
CAT	Catmint	Nepeta x faassenii 'Walker's Low'
DAY	Rosy Returns Daylily	Hemerocallis 'Rosy Returns'
DSY	Daisy	Leucanthemum x superbum 'Becky'
HOS	Sum & Substance Hosta	Hosta 'Sum & Substance'
IRS	Blue Flag Iris	Iris virginica v. shrevei
MSG	Blue Salvia	Salvia nemorosa 'May Night'
SBA	Summer Beauty Allium	Allium 'Summer Beauty'
Grasse		
KFG	Karl Foerster Grass	Calamagrostis x acutiflora 'Karl Foerster'
MLG	Morning Light Maiden Grass	Miscanthus sinensis 'Morning Light'
NWG	Northwind Switch Grass	Panicum virgatum 'Northwind'
RSG	Red Switch Grass	Panicum virgatum 'Prairie Fire'
VLR	Variegated Liriope	Liriope muscari variegata

1. EACH BIDDER SHALL VISIT THE SITE OF THE PROPOSED WORK AND EXAMINE THE SITE CONDITIONS. HE SHALL ALSO CAREFULLY EXAMINE THE DRAWINGS FOR THE PROPOSED WORK AND FAMILIARIZE HIMSELF WITH ALL CONDITIONS, WHICH MAY AFFECT THE PROPOSED WORK.

2. THE PLANTING PLAN GRAPHICALLY ILLUSTRATES OVERALL PLANT MASSINGS. EACH PLANT SPECIES MASSING SHALL BE PLACED IN THE FIELD TO UTILIZE GREATEST COVERAGE OF GROUND PLANE. THE FOLLOWING APPLIES FOR INDIVIDUAL PLANTINGS:

A. CREEPING GROUNDCOVER SHALL BE A MINIMUM OF 6" FROM PAVING EDGE. B. ALL TREES SHALL BE A MINIMUM OF 3' FROM PAVING EDGE. C. ALL PLANTS OF THE SAME SPECIES SHALL BE EQUALLY SPACED APART AND PLACED FOR BEST AESTHETIC VIEWING.

3. NOTIFY LANDSCAPE ARCHITECT 1 WEEK PRIOR TO ANTICIPATED START OF PLANT MATERIAL INSTALLATION. LANDSCAPE CONTRACTOR SHALL STAKE ALL PROPOSED PLANTING BED EDGES, SET OUT SHRUBS IN INTENDED LOCATIONS, AND STAKE TREE LOCATIONS FOR APPROVAL BY LANDSCAPE ARCHITECT PRIOR TO INSTALLATION.

4. ALL NEW PLANT BED AREAS TO BE IRRIGATED. REFER TO SPECIFICATIONS FOR IRRIGATION SYSTEM DESCRIPTION.

- 5. REFER TO L1.00 SERIES SHEETS FOR TREE PLANTINGS.
- 6. REFER TO L2.00 SERIES SHEETS FOR SHRUB PLANTINGS & ROCK MATERIALS.
- 7. REFER TO L3.00 SERIES SHEETS FOR PLANTING DETAILS & SPECIFICATIONS.

8. IN THE EVENT OF WORK IN OR ON THE JCW SANITARY MAIN. ANY TREES OR PLANTINGS PLACED WITHIN THE SEWER EASEMENT MAY BE REMOVED WITHOUT REPLACEMENT OR COMPENSATION THERE OF AND SHALL BE REPLACED BY THE PROPERTY OWNER AS REQUIRED

9. STRIP TOP SOIL & SAVE FOR PLANTING AREAS. REFER TO L3.00 FOR PLANTING SOIL MIX. 10. ROCK BEDS SHALL BE BUFFALO RIVER ROCK, 1"-2.5" SIZE, BY HOUSE OF ROCKS OR APPROVED EQUAL. ALL ROCK BED AREAS SHALL HAVE FILTER FABRIC & BE 4" MIN. DEPTH.

- 11. ALL LANDSCAPE BEDS WITHIN POOL ENCLOSURE TO INCLUDE RIVER ROCK PER SPECS.
- 12. FINISHED GRADE TO BE TOP OF MULCH OR TURF FOR ALL LANDSCAPE AREAS. REFER TO CIVIL PLANS FOR GRADING INFORMATION.

SEEDING & SOD NOTES:

1" = 10'-0"

- REFER TO GENERAL NOTES ON PLANTING DETAILS PAGE FOR SEED MIX AND SOD MATERIAL. REFER TO PROJECT SPECIFICATIONS SECTION 3.1 FOR TURF AREA PREPARATION, AND THE KANSAS CITY METROPOLITAN CHAPTER OF THE APWA, DIVISION II, SECTION 2406.2 FOR ADDITIONAL GRADING
- REFER TO THE KANSAS CITY METROPOLITAN CHAPTER OF THE APWA, DIVISION II, SECTION 2406.3 FOR FERTILIZATION GUIDELINES & PROCEDURES.
- 4. REFER TO PROJECT SPECIFICATION SECTION 3.3, AND THE KANSAS CITY METROPOLITAN CHAPTER OF THE APWA, DIVISION II, SECTION 2406.4.D FOR SOD INSTALLATION GUIDELINES & PROCEDURES. SEEDING OPTIONS:
- 5.1. HYDROSEEDING REFER TO KANSAS CITY METROPOLITAN CHAPTER OF THE APWA, DIVISION II, SECTION 2406.4.C FOR HYDROSEEDING GUIDELINES & PROCEDURES.
- 5.2. <u>SOWING</u> REFER TO PROJECT SPECIFICATIONS SECTION 3.2 AND THE KANSAS CITY METROPOLITAN CHAPTER OF THE APWA, DIVISION II, SECTION 2406.4.B FOR SEED SOWING
- 6. SOWN SEED PROTECTION & SECURING METHODS. PROTECT ALL SEEDED AREAS WITH SLOPES NOT EXCEEDING 6:1 (15+%) BY EITHER METHOD LISTED IN THE PROJECT SPECIFICATION SECTION 3.2.D. 7. IF ANY DISCREPANCIES ARE FOUND BETWEEN THE PROJECT GENERAL NOTES, PROJECT SPECIFICATIONS, AND APWA SECTION 2400, THE MOST STRINGENT GUIDELINE APPLIES.



DRAWING RELEASE LOG

• 09.16.24 PERMIT SET

• 10.28.24 CITY COMMENTS

ARCHITECTS

ARCHITECTURE


L A N D S C A P E ARCHITECTURE

P.913.831.1415 NSPJARCH.COM

9415 NALL AVE., #300 PRAIRIE VILLAGE, KANSAS, 66207

REVISIONS 1\10.28.24 FDP COMMENTS 2



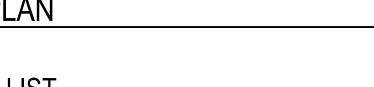

PLANT LIST

Code	Common Name	Botanical Name	S
Evergr	een Shrubs		
CGH	China Boy Holly	llex x meserveae 'Mesdob'	5
CGH	China Girl Holly	llex x meserveae 'Mesog'	5
DFY	Densifomis Yew	Taxus x media 'Densiformis'	5
ELY	Everlow Yew	Taxus x media 'Everlow'	5
GBS	Globe Blue Spruce	Picea pungens 'Glauca globosa'	5
GGB	Green Gem Boxwood	Buxus microphylla x 'Green Gem'	5
GMC	Gold Mop Cypress	Chamaecyparis pisifera 'Yellow Thread Branch'	5
PFJ	Perfecta Juniper	Juniperus chinensis 'Perfecta'	5
PRB	Green Mountain Boxwood (Pyramidal)	Buxus microphylla 'Green Mountain'	5
SJG	Sea Green Juniper	Juniperus chinensis 'Sea Green'	5
TMJ	Tam Juniper	Juniperus sabina 'Tamariscifolia'	5
WGB	Winter Green Boxwood	Buxus microphylla 'Winter Green'	5
WTB	Red Sprite Winterberry	llex verticillata 'Nana'	5
WYW	Wardii Yew	Taxus x media 'Wardii'	5
Decidio	ous Shrubs		
CPR	Red Carpet Rose	Rosa 'Flower Carpet Red'	2
DGW	Variegated Red Twigged Dogwood	Cornus alba 'Ivory Halo'	2
DRT	Dwarf Red Twig Dogwood	Cornus sericea 'Kelseyi"	2
ESH	Endless Summer Hydrangea	Hydrangea macrophylla 'Bailmer'	2
GLS	Gro-Low Sumac	Rhus aromatica 'Gro-Low'	2
GMS	Goldmound Spirea	Spiraea japonica 'Goldmound'	2
HYD	Annabelle Hydrangea	Hydrangea arborescens 'Annabelle'	2
KNR	Knockout Rose	Rosa knockout	2
LHS	Little Henry Sweetspire	Itea virginica 'Little Henry'	2
LPS	Little Princess Spirea	Spiraea japonica 'Little Princess'	2
MCS	Magic Carpet Spirea	Spiraea japonica 'Magic Carpet'	2
ROS	Rose of Sharon - Lavender Chiffon	Hibiscus syriacus 'Notwoodone'	2
WIG	Fine Wine Weigela	Weigela florida 'Bramwell'	2
Perenn	ials		
CAT	Catmint	Nepeta x faassenii 'Walker's Low'	1
DAY	Rosy Returns Daylily	Hemerocallis 'Rosy Returns'	1
DSY	Daisy	Leucanthemum x superbum 'Becky'	1
HOS	Sum & Substance Hosta	Hosta 'Sum & Substance'	1
IRS	Blue Flag Iris	Iris virginica v. shrevei	1
MSG	Blue Salvia	Salvia nemorosa 'May Night'	1
SBA	Summer Beauty Allium	Allium 'Summer Beauty'	1
Grasse	s		
KFG	Karl Foerster Grass	Calamagrostis x acutiflora 'Karl Foerster'	1
MLG	Morning Light Maiden Grass	Miscanthus sinensis 'Morning Light'	1
NWG	Northwind Switch Grass	Panicum virgatum 'Northwind'	1
RSG	Red Switch Grass	Panicum virgatum 'Prairie Fire'	1
VLR	Variegated Liriope	Liriope muscari variegata	1

GENERAL NOTES:

1. EACH BIDDER SHALL VISIT THE SITE OF THE PROPOSED WORK AND EXAMINE THE SITE CONDITIONS. HE SHALL ALSO CAREFULLY EXAMINE THE DRAWINGS FOR THE PROPOSED WORK AND FAMILIARIZE HIMSELF WITH ALL CONDITIONS, WHICH MAY AFFECT THE PROPOSED WORK.

2. THE PLANTING PLAN GRAPHICALLY ILLUSTRATES OVERALL PLANT MASSINGS. EACH PLANT SPECIES MASSING SHALL BE PLACED IN THE FIELD TO UTILIZE GREATEST COVERAGE OF GROUND PLANE. THE FOLLOWING APPLIES FOR INDIVIDUAL PLANTINGS: A. CREEPING GROUNDCOVER SHALL BE A MINIMUM OF 6" FROM PAVING EDGE. B. ALL TREES SHALL BE A MINIMUM OF 3' FROM PAVING EDGE.

C. ALL PLANTS OF THE SAME SPECIES SHALL BE EQUALLY SPACED APART AND PLACED FOR BEST AESTHETIC VIEWING. D. ALL SHRUBS SHALL BE A MINIMUM OF 2' FROM PAVED EDGE.

INSTALLATION. LANDSCAPE CONTRACTOR SHALL STAKE ALL PROPOSED PLANTING BED EDGES, SET OUT SHRUBS IN INTENDED LOCATIONS, AND STAKE TREE LOCATIONS FOR APPROVAL BY LANDSCAPE ARCHITECT PRIOR TO INSTALLATION.

4. ALL NEW PLANT BED AREAS TO BE IRRIGATED. REFER TO SPECIFICATIONS FOR IRRIGATION SYSTEM DESCRIPTION.

5. REFER TO L1.00 SERIES SHEETS FOR TREE PLANTINGS.

6. REFER TO L2.00 SERIES SHEETS FOR SHRUB PLANTINGS & ROCK MATERIALS. 7. REFER TO L3.00 SERIES SHEETS FOR PLANTING DETAILS & SPECIFICATIONS.

8. IN THE EVENT OF WORK IN OR ON THE JCW SANITARY MAIN. ANY TREES OR PLANTINGS PLACED WITHIN THE SEWER EASEMENT MAY BE REMOVED WITHOUT REPLACEMENT OR COMPENSATION THERE OF AND SHALL BE REPLACED BY THE PROPERTY OWNER AS REQUIRED

 \bigvee 9. STRIP TOP SOIL & SAVE FOR PLANTING AREAS. REFER TO L3.00 FOR PLANTING SOIL MIX. 10. ROCK BEDS SHALL BE BUFFALO RIVER ROCK, 1"-2.5" SIZE, BY HOUSE OF ROCKS OR APPROVED EQUAL. ALL ROCK BED AREAS SHALL HAVE FILTER FABRIC & BE 4" MIN. DEPTH.

11. ALL LANDSCAPE BEDS WITHIN POOL ENCLOSURE TO INCLUDE RIVER ROCK PER SPECS.

12. FINISHED GRADE TO BE TOP OF MULCH OR TURF FOR ALL LANDSCAPE AREAS. REFER TO CIVIL PLANS FOR GRADING INFORMATION.

SEEDING & SOD NOTES:

- REFER TO GENERAL NOTES ON PLANTING DETAILS PAGE FOR SEED MIX AND SOD MATERIAL. REFER TO PROJECT SPECIFICATIONS SECTION 3.1 FOR TURF AREA PREPARATION, AND THE KANSAS CITY METROPOLITAN CHAPTER OF THE APWA, DIVISION II, SECTION 2406.2 FOR ADDITIONAL GRADING AND TILLAGE GUIDELINES & PROCEDURES. REFER TO THE KANSAS CITY METROPOLITAN CHAPTER OF THE APWA, DIVISION II, SECTION 2406.3
- FOR FERTILIZATION GUIDELINES & PROCEDURES. REFER TO PROJECT SPECIFICATION SECTION 3.3, AND THE KANSAS CITY METROPOLITAN CHAPTER OF THE APWA, DIVISION II, SECTION 2406.4.D FOR SOD INSTALLATION GUIDELINES & PROCEDURES.
- 5.1. <u>HYDROSEEDING</u> REFER TO KANSAS CITY METROPOLITAN CHAPTER OF THE APWA, DIVISION II, SECTION 2406.4.C FOR HYDROSEEDING GUIDELINES & PROCEDURES. SOWING - REFER TO PROJECT SPECIFICATIONS SECTION 3.2 AND THE KANSAS CITY
- METROPOLITAN CHAPTER OF THE APWA, DIVISION II, SECTION 2406.4.B FOR SEED SOWING PROCEDURES. SOWN SEED PROTECTION & SECURING METHODS. PROTECT ALL SEEDED AREAS WITH SLOPES NOT
- EXCEEDING 6:1 (15+%) BY EITHER METHOD LISTED IN THE PROJECT SPECIFICATION SECTION 3.2.D. IF ANY DISCREPANCIES ARE FOUND BETWEEN THE PROJECT GENERAL NOTES, PROJECT SPECIFICATIONS, AND APWA SECTION 2400, THE MOST STRINGENT GUIDELINE APPLIES.



DRAWING RELEASE LOG

● 09.16.24 PERMIT SET


• 10.28.24 CITY COMMENTS

ARCHITECTS

ARCHITECTURE

L A N D S C A P E ARCHITECTURE

P.913.831.1415 NSPJARCH.COM

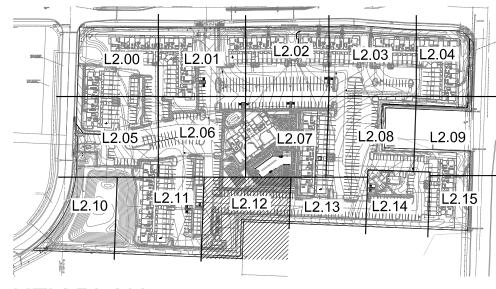

Code	Common Name	Botanical Name	S
Evergr	een Shrubs		
CGH	China Boy Holly	llex x meserveae 'Mesdob'	5
CGH	China Girl Holly	llex x meserveae 'Mesog'	5
DFY	Densifomis Yew	Taxus x media 'Densiformis'	5
ELY	Everlow Yew	Taxus x media 'Everlow'	5
GBS	Globe Blue Spruce	Picea pungens 'Glauca globosa'	5
GGB	Green Gem Boxwood	Buxus microphylla x 'Green Gem'	5
GMC	Gold Mop Cypress	Chamaecyparis pisifera 'Yellow Thread Branch'	5
PFJ	Perfecta Juniper	Juniperus chinensis 'Perfecta'	5
PRB	Green Mountain Boxwood (Pyramidal)	Buxus microphylla 'Green Mountain'	5
SJG	Sea Green Juniper	Juniperus chinensis 'Sea Green'	5
TMJ	Tam Juniper	Juniperus sabina 'Tamariscifolia'	
WGB	Winter Green Boxwood	Buxus microphylla 'Winter Green'	5
WTB	Red Sprite Winterberry	llex verticillata 'Nana'	5
WYW	Wardii Yew	Taxus x media 'Wardii'	5
	ous Shrubs		
CPR	Red Carpet Rose	Rosa 'Flower Carpet Red'	2
DGW	Variegated Red Twigged Dogwood	Cornus alba 'Ivory Halo'	2
DRT	Dwarf Red Twig Dogwood	Cornus sericea 'Kelseyi"	2
ESH	Endless Summer Hydrangea	Hydrangea macrophylla 'Bailmer'	2
GLS	Gro-Low Sumac	Rhus aromatica 'Gro-Low'	2
GMS	Goldmound Spirea	Spiraea japonica 'Goldmound'	2
HYD	Annabelle Hydrangea	Hydrangea arborescens 'Annabelle'	2
KNR	Knockout Rose	Rosa knockout	2
LHS	Little Henry Sweetspire	Itea virginica 'Little Henry'	2
LPS	Little Princess Spirea	Spiraea japonica 'Little Princess'	2
MCS	Magic Carpet Spirea	Spiraea japonica 'Magic Carpet'	2
ROS	Rose of Sharon - Lavender Chiffon	Hibiscus syriacus 'Notwoodone'	2
WIG	Fine Wine Weigela	Weigela florida 'Bramwell'	2
Perenn	ials		Ť
CAT	Catmint	Nepeta x faassenii 'Walker's Low'	1
DAY	Rosy Returns Daylily	Hemerocallis 'Rosy Returns'	1
DSY	Daisy	Leucanthemum x superbum 'Becky'	1
HOS	Sum & Substance Hosta	Hosta 'Sum & Substance'	1
IRS	Blue Flag Iris	Iris virginica v. shrevei	1
MSG	Blue Salvia	Salvia nemorosa 'May Night'	1
SBA	Summer Beauty Allium	Allium 'Summer Beauty'	1
Grasse	= 1/2		
KFG	Karl Foerster Grass	Calamagrostis x acutiflora 'Karl Foerster'	1
MLG	Morning Light Maiden Grass	Miscanthus sinensis 'Morning Light'	1
NWG	Northwind Switch Grass	Panicum virgatum 'Northwind'	1
RSG	Red Switch Grass	Panicum virgatum 'Prairie Fire'	1
VLR	Variegated Liriope	Liriope muscari variegata	1

1. EACH BIDDER SHALL VISIT THE SITE OF THE PROPOSED WORK AND EXAMINE THE SITE CONDITIONS. HE SHALL ALSO CAREFULLY EXAMINE THE DRAWINGS FOR THE PROPOSED WORK AND FAMILIARIZE HIMSELF WITH ALL CONDITIONS, WHICH MAY AFFECT THE PROPOSED WORK.

2. THE PLANTING PLAN GRAPHICALLY ILLUSTRATES OVERALL PLANT MASSINGS. EACH PLANT SPECIES MASSING SHALL BE PLACED IN THE FIELD TO UTILIZE GREATEST COVERAGE OF GROUND PLANE. THE FOLLOWING APPLIES FOR INDIVIDUAL PLANTINGS: A. CREEPING GROUNDCOVER SHALL BE A MINIMUM OF 6" FROM PAVING EDGE.

B. ALL TREES SHALL BE A MINIMUM OF 3' FROM PAVING EDGE. C. ALL PLANTS OF THE SAME SPECIES SHALL BE EQUALLY SPACED APART AND PLACED FOR BEST AESTHETIC VIEWING.

D. ALL SHRUBS SHALL BE A MINIMUM OF 2' FROM PAVED EDGE.

3. NOTIFY LANDSCAPE ARCHITECT 1 WEEK PRIOR TO ANTICIPATED START OF PLANT MATERIAL INSTALLATION. LANDSCAPE CONTRACTOR SHALL STAKE ALL PROPOSED PLANTING BED EDGES, SET OUT SHRUBS IN INTENDED LOCATIONS, AND STAKE TREE LOCATIONS FOR APPROVAL BY LANDSCAPE ARCHITECT PRIOR TO INSTALLATION.

4. ALL NEW PLANT BED AREAS TO BE IRRIGATED. REFER TO SPECIFICATIONS FOR IRRIGATION SYSTEM DESCRIPTION.

5. REFER TO L1.00 SERIES SHEETS FOR TREE PLANTINGS.

6. REFER TO L2.00 SERIES SHEETS FOR SHRUB PLANTINGS & ROCK MATERIALS.

8. IN THE EVENT OF WORK IN OR ON THE JCW SANITARY MAIN. ANY TREES OR PLANTINGS PLACED WITHIN THE SEWER EASEMENT MAY BE REMOVED WITHOUT REPLACEMENT OR

19. STRIP TOP SOIL & SAVE FOR PLANTING AREAS. REFER TO L3.00 FOR PLANTING SOIL MIX. 10. ROCK BEDS SHALL BE BUFFALO RIVER ROCK, 1"-2.5" SIZE, BY HOUSE OF ROCKS OR

APPROVED EQUAL. ALL ROCK BED AREAS SHALL HAVE FILTER FABRIC & BE 4" MIN. DEPTH. 11. ALL LANDSCAPE BEDS WITHIN POOL ENCLOSURE TO INCLUDE RIVER ROCK PER SPECS.

12. FINISHED GRADE TO BE TOP OF MULCH OR TURF FOR ALL LANDSCAPE AREAS. REFER TO CIVIL PLANS FOR GRADING INFORMATION.

SEEDING & SOD NOTES:

- . REFER TO GENERAL NOTES ON PLANTING DETAILS PAGE FOR SEED MIX AND SOD MATERIAL. 2. REFER TO PROJECT SPECIFICATIONS SECTION 3.1 FOR TURF AREA PREPARATION, AND THE KANSAS CITY METROPOLITAN CHAPTER OF THE APWA, DIVISION II, SECTION 2406.2 FOR ADDITIONAL GRADING AND TILLAGE GUIDELINES & PROCEDURES.
- 3. REFER TO THE KANSAS CITY METROPOLITAN CHAPTER OF THE APWA, DIVISION II, SECTION 2406.3 FOR FERTILIZATION GUIDELINES & PROCEDURES.
- OF THE APWA, DIVISION II, SECTION 2406.4.D FOR SOD INSTALLATION GUIDELINES & PROCEDURES. SEEDING OPTIONS: 5.1. HYDROSEEDING - REFER TO KANSAS CITY METROPOLITAN CHAPTER OF THE APWA, DIVISION
- II, SECTION 2406.4.C FOR HYDROSEEDING GUIDELINES & PROCEDURES.
- 5.2. <u>SOWING</u> REFER TO PROJECT SPECIFICATIONS SECTION 3.2 AND THE KANSAS CITY METROPOLITAN CHAPTER OF THE APWA, DIVISION II, SECTION 2406.4.B FOR SEED SOWING PROCEDURES.
- 6. SOWN SEED PROTECTION & SECURING METHODS. PROTECT ALL SEEDED AREAS WITH SLOPES NOT EXCEEDING 6:1 (15+%) BY EITHER METHOD LISTED IN THE PROJECT SPECIFICATION SECTION 3.2.D. 7. IF ANY DISCREPANCIES ARE FOUND BETWEEN THE PROJECT GENERAL NOTES, PROJECT SPECIFICATIONS, AND APWA SECTION 2400, THE MOST STRINGENT GUIDELINE APPLIES.

SHRUB PLANTING PLAN



ARCHITECTS ARCHITECTURE L A N D S C A P E ARCHITECTURE P.913.831.1415 NSPJARCH.COM

9415 NALL AVE., #300 PRAIRIE VILLAGE, KANSAS, 66207




DRAWING RELEASE LOG

● 09.16.24 PERMIT SET

REVISIONS 1\10.28.24 FDP COMMENTS 2

• 10.28.24 CITY COMMENTS

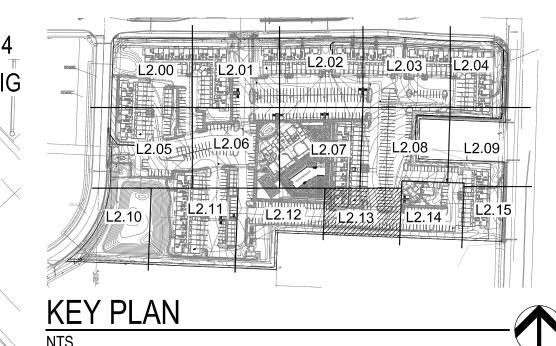

PLANT LIST

Code	Common Name	Botanical Name	
Evergr	een Shrubs		
CGH	China Boy Holly	llex x meserveae 'Mesdob'	5
CGH	China Girl Holly	llex x meserveae 'Mesog'	5
DFY	Densifomis Yew	Taxus x media 'Densiformis'	5
ELY	Everlow Yew	Taxus x media 'Everlow'	5
GBS	Globe Blue Spruce	Picea pungens 'Glauca globosa'	5
GGB	Green Gem Boxwood	Buxus microphylla x 'Green Gem'	5
GMC	Gold Mop Cypress	Chamaecyparis pisifera 'Yellow Thread Branch'	5
PFJ	Perfecta Juniper	Juniperus chinensis 'Perfecta'	5
PRB	Green Mountain Boxwood (Pyramidal)	Buxus microphylla 'Green Mountain'	5
SJG	Sea Green Juniper	Juniperus chinensis 'Sea Green'	5
TMJ	Tam Juniper	Juniperus sabina 'Tamariscifolia'	5
WGB	Winter Green Boxwood	Buxus microphylla 'Winter Green'	5
WTB	Red Sprite Winterberry	llex verticillata 'Nana'	5
WYW	Wardii Yew	Taxus x media 'Wardii'	5
Decidio	ous Shrubs		
CPR	Red Carpet Rose	Rosa 'Flower Carpet Red'	2
DGW	Variegated Red Twigged Dogwood	Cornus alba 'Ivory Halo'	2
DRT	Dwarf Red Twig Dogwood	Cornus sericea 'Kelseyi"	2
ESH	Endless Summer Hydrangea	Hydrangea macrophylla 'Bailmer'	2
GLS	Gro-Low Sumac	Rhus aromatica 'Gro-Low'	2
GMS	Goldmound Spirea	Spiraea japonica 'Goldmound'	2
HYD	Annabelle Hydrangea	Hydrangea arborescens 'Annabelle'	2
KNR	Knockout Rose	Rosa knockout	2
LHS	Little Henry Sweetspire	Itea virginica 'Little Henry'	2
LPS	Little Princess Spirea	Spiraea japonica 'Little Princess'	2
MCS	Magic Carpet Spirea	Spiraea japonica 'Magic Carpet'	2
ROS	Rose of Sharon - Lavender Chiffon	Hibiscus syriacus 'Notwoodone'	2
WIG	Fine Wine Weigela	Weigela florida 'Bramwell'	2
Perenn		3	
CAT	Catmint	Nepeta x faassenii 'Walker's Low'	1
DAY	Rosy Returns Daylily	Hemerocallis 'Rosy Returns'	1
DSY	Daisy	Leucanthemum x superbum 'Becky'	1
HOS	Sum & Substance Hosta	Hosta 'Sum & Substance'	1
IRS	Blue Flag Iris	Iris virginica v. shrevei	1
MSG	Blue Salvia	Salvia nemorosa 'May Night'	1
SBA	Summer Beauty Allium	Allium 'Summer Beauty'	1
Grasse	S		
KFG	Karl Foerster Grass	Calamagrostis x acutiflora 'Karl Foerster'	1
MLG	Morning Light Maiden Grass	Miscanthus sinensis 'Morning Light'	1
NWG	Northwind Switch Grass	Panicum virgatum 'Northwind'	1
RSG	Red Switch Grass	Panicum virgatum 'Prairie Fire'	1
VLR	Variegated Liriope	Liriope muscari variegata	1

GENERAL NOTES:

1. EACH BIDDER SHALL VISIT THE SITE OF THE PROPOSED WORK AND EXAMINE THE SITE CONDITIONS. HE SHALL ALSO CAREFULLY EXAMINE THE DRAWINGS FOR THE PROPOSED WORK AND FAMILIARIZE HIMSELF WITH ALL CONDITIONS, WHICH MAY AFFECT THE PROPOSED WORK.

2. THE PLANTING PLAN GRAPHICALLY ILLUSTRATES OVERALL PLANT MASSINGS. EACH PLANT SPECIES MASSING SHALL BE PLACED IN THE FIELD TO UTILIZE GREATEST COVERAGE OF

GROUND PLANE. THE FOLLOWING APPLIES FOR INDIVIDUAL PLANTINGS: A. CREEPING GROUNDCOVER SHALL BE A MINIMUM OF 6" FROM PAVING EDGE. B. ALL TREES SHALL BE A MINIMUM OF 3' FROM PAVING EDGE. C. ALL PLANTS OF THE SAME SPECIES SHALL BE EQUALLY SPACED APART AND PLACED

D. ALL SHRUBS SHALL BE A MINIMUM OF 2' FROM PAVED EDGE. 3. NOTIFY LANDSCAPE ARCHITECT 1 WEEK PRIOR TO ANTICIPATED START OF PLANT MATERIAL INSTALLATION. LANDSCAPE CONTRACTOR SHALL STAKE ALL PROPOSED PLANTING BED EDGES, SET OUT SHRUBS IN INTENDED LOCATIONS, AND STAKE TREE LOCATIONS FOR APPROVAL BY

4. ALL NEW PLANT BED AREAS TO BE IRRIGATED. REFER TO SPECIFICATIONS FOR IRRIGATION SYSTEM DESCRIPTION.

5. REFER TO L1.00 SERIES SHEETS FOR TREE PLANTINGS.

FOR BEST AESTHETIC VIEWING.

LANDSCAPE ARCHITECT PRIOR TO INSTALLATION.

6. REFER TO L2.00 SERIES SHEETS FOR SHRUB PLANTINGS & ROCK MATERIALS.

7. REFER TO L3.00 SERIES SHEETS FOR PLANTING DETAILS & SPECIFICATIONS.

8. IN THE EVENT OF WORK IN OR ON THE JCW SANITARY MAIN. ANY TREES OR PLANTINGS PLACED WITHIN THE SEWER EASEMENT MAY BE REMOVED WITHOUT REPLACEMENT OR COMPENSATION THERE OF AND SHALL BE REPLACED BY THE PROPERTY OWNER AS REQUIRED /29. STRIP TOP SOIL & SAVE FOR PLANTING AREAS. REFER TO L3.00 FOR PLANTING SOIL MIX.

10. ROCK BEDS SHALL BE BUFFALO RIVER ROCK, 1"-2.5" SIZE, BY HOUSE OF ROCKS OR APPROVED EQUAL. ALL ROCK BED AREAS SHALL HAVE FILTER FABRIC & BE 4" MIN. DEPTH.

11. ALL LANDSCAPE BEDS WITHIN POOL ENCLOSURE TO INCLUDE RIVER ROCK PER SPECS.

12. FINISHED GRADE TO BE TOP OF MULCH OR TURF FOR ALL LANDSCAPE AREAS. REFER TO CIVIL PLANS FOR GRADING INFORMATION.

SEEDING & SOD NOTES:

- 1. REFER TO GENERAL NOTES ON PLANTING DETAILS PAGE FOR SEED MIX AND SOD MATERIAL. 2. REFER TO PROJECT SPECIFICATIONS SECTION 3.1 FOR TURF AREA PREPARATION, AND THE KANSAS CITY METROPOLITAN CHAPTER OF THE APWA, DIVISION II, SECTION 2406.2 FOR ADDITIONAL GRADING AND TILLAGE GUIDELINES & PROCEDURES.
- 3. REFER TO THE KANSAS CITY METROPOLITAN CHAPTER OF THE APWA, DIVISION II, SECTION 2406.3 FOR FERTILIZATION GUIDELINES & PROCEDURES.
- 4. REFER TO PROJECT SPECIFICATION SECTION 3.3, AND THE KANSAS CITY METROPOLITAN CHAPTER OF THE APWA, DIVISION II, SECTION 2406.4.D FOR SOD INSTALLATION GUIDELINES & PROCEDURES.
- SEEDING OPTIONS: 5.1. HYDROSEEDING - REFER TO KANSAS CITY METROPOLITAN CHAPTER OF THE APWA, DIVISION II, SECTION 2406.4.C FOR HYDROSEEDING GUIDELINES & PROCEDURES.
- 5.2. SOWING REFER TO PROJECT SPECIFICATIONS SECTION 3.2 AND THE KANSAS CITY METROPOLITAN CHAPTER OF THE APWA, DIVISION II, SECTION 2406.4.B FOR SEED SOWING
- PROCEDURES.
- 6. SOWN SEED PROTECTION & SECURING METHODS. PROTECT ALL SEEDED AREAS WITH SLOPES NOT EXCEEDING 6:1 (15+%) BY EITHER METHOD LISTED IN THE PROJECT SPECIFICATION SECTION 3.2.D. 7. IF ANY DISCREPANCIES ARE FOUND BETWEEN THE PROJECT GENERAL NOTES, PROJECT

SPECIFICATIONS, AND APWA SECTION 2400, THE MOST STRINGENT GUIDELINE APPLIES.

ARCHITECTS ARCHITECTURE L A N D S C A P E ARCHITECTURE P.913.831.1415 NSPJARCH.COM 9415 NALL AVE., #300 PRAIRIE VILLAGE, KANSAS, 66207



DRAWING RELEASE LOG


• 09.16.24 PERMIT SET • 10.28.24 CITY COMMENTS

REVISIONS 2 10.28.24 FDP COMMENTS 2

09.16.2024 DRAWN BY SLW / KRM

PERMIT SET

SHRUB PLANTING

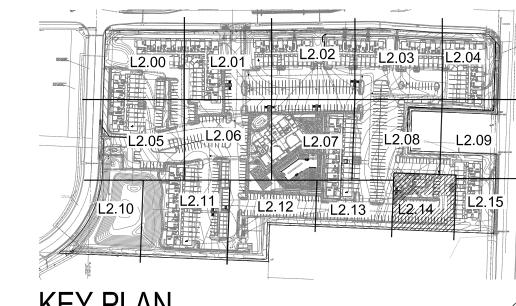

PLANT LIST

Code	Common Name	Botanical Name	Siz
Evergr	een Shrubs		
CGH	China Boy Holly	llex x meserveae 'Mesdob'	5 Ga
CGH	China Girl Holly	llex x meserveae 'Mesog'	5 Ga
DFY	Densifomis Yew	Taxus x media 'Densiformis'	5 Ga
ELY	Everlow Yew	Taxus x media 'Everlow'	5 Ga
GBS	Globe Blue Spruce	Picea pungens 'Glauca globosa'	5 Ga
GGB	Green Gem Boxwood	Buxus microphylla x 'Green Gem'	5 Ga
GMC	Gold Mop Cypress	Chamaecyparis pisifera 'Yellow Thread Branch'	5 Ga
PFJ	Perfecta Juniper	Juniperus chinensis 'Perfecta'	5 Ga
PRB	Green Mountain Boxwood (Pyramidal)	Buxus microphylla 'Green Mountain'	5 Ga
SJG	Sea Green Juniper	Juniperus chinensis 'Sea Green'	5 ga
TMJ	Tam Juniper	Juniperus sabina 'Tamariscifolia'	5 Ga
WGB	Winter Green Boxwood	Buxus microphylla 'Winter Green'	5 Ga
WTB	Red Sprite Winterberry	llex verticillata 'Nana'	5 Ga
WYW	Wardii Yew	Taxus x media 'Wardii'	5 Ga
Decidio	ous Shrubs		
CPR	Red Carpet Rose	Rosa 'Flower Carpet Red'	2 Ga
DGW	Variegated Red Twigged Dogwood	Cornus alba 'Ivory Halo'	2 G
DRT	Dwarf Red Twig Dogwood	Cornus sericea 'Kelseyi"	2 Ga
ESH	Endless Summer Hydrangea	Hydrangea macrophylla 'Bailmer'	2 Ga
GLS	Gro-Low Sumac	Rhus aromatica 'Gro-Low'	2 Ga
GMS	Goldmound Spirea	Spiraea japonica 'Goldmound'	2 G
HYD	Annabelle Hydrangea	Hydrangea arborescens 'Annabelle'	2 Ga
KNR	Knockout Rose	Rosa knockout	2 Ga
LHS	Little Henry Sweetspire	Itea virginica 'Little Henry'	2 Ga
LPS	Little Princess Spirea	Spiraea japonica 'Little Princess'	2 Ga
MCS	Magic Carpet Spirea	Spiraea japonica 'Magic Carpet'	2 G
ROS	Rose of Sharon - Lavender Chiffon	Hibiscus syriacus 'Notwoodone'	2 G
WIG	Fine Wine Weigela	Weigela florida 'Bramwell'	2 Ga
Perenn	- -		
CAT	Catmint	Nepeta x faassenii 'Walker's Low'	1 G
DAY	Rosy Returns Daylily	Hemerocallis 'Rosy Returns'	1 G
DSY	Daisy	Leucanthemum x superbum 'Becky'	1 G
HOS	Sum & Substance Hosta	Hosta 'Sum & Substance'	1 Ga
IRS	Blue Flag Iris	Iris virginica v. shrevei	1 G
MSG	Blue Salvia	Salvia nemorosa 'May Night'	1 G
SBA	Summer Beauty Allium	Allium 'Summer Beauty'	1 G
Grasse	s		
KFG	Karl Foerster Grass	Calamagrostis x acutiflora 'Karl Foerster'	1 G
MLG	Morning Light Maiden Grass	Miscanthus sinensis 'Morning Light'	1 G
NWG	Northwind Switch Grass	Panicum virgatum 'Northwind'	1 Ga
RSG	Red Switch Grass	Panicum virgatum 'Prairie Fire'	1 Ga
VLR	Variegated Liriope	Liriope muscari variegata	1 Ga

GENERAL NOTES:

1. EACH BIDDER SHALL VISIT THE SITE OF THE PROPOSED WORK AND EXAMINE THE SITE CONDITIONS. HE SHALL ALSO CAREFULLY EXAMINE THE DRAWINGS FOR THE PROPOSED WORK AND FAMILIARIZE HIMSELF WITH ALL CONDITIONS, WHICH MAY AFFECT THE PROPOSED WORK.

2. THE PLANTING PLAN GRAPHICALLY ILLUSTRATES OVERALL PLANT MASSINGS. EACH PLANT SPECIES MASSING SHALL BE PLACED IN THE FIELD TO UTILIZE GREATEST COVERAGE OF

A. CREEPING GROUNDCOVER SHALL BE A MINIMUM OF 6" FROM PAVING EDGE. B. ALL TREES SHALL BE A MINIMUM OF 3' FROM PAVING EDGE.

C. ALL PLANTS OF THE SAME SPECIES SHALL BE EQUALLY SPACED APART AND PLACED FOR BEST AESTHETIC VIEWING.

D. ALL SHRUBS SHALL BE A MINIMUM OF 2' FROM PAVED EDGE.

3. NOTIFY LANDSCAPE ARCHITECT 1 WEEK PRIOR TO ANTICIPATED START OF PLANT MATERIAL

INSTALLATION. LANDSCAPE CONTRACTOR SHALL STAKE ALL PROPOSED PLANTING BED EDGES, SET OUT SHRUBS IN INTENDED LOCATIONS, AND STAKE TREE LOCATIONS FOR APPROVAL BY LANDSCAPE ARCHITECT PRIOR TO INSTALLATION.

4. ALL NEW PLANT BED AREAS TO BE IRRIGATED. REFER TO SPECIFICATIONS FOR IRRIGATION SYSTEM DESCRIPTION.

5. REFER TO L1.00 SERIES SHEETS FOR TREE PLANTINGS.

6. REFER TO L2.00 SERIES SHEETS FOR SHRUB PLANTINGS & ROCK MATERIALS.

GROUND PLANE. THE FOLLOWING APPLIES FOR INDIVIDUAL PLANTINGS:

7. REFER TO L3.00 SERIES SHEETS FOR PLANTING DETAILS & SPECIFICATIONS.

8. IN THE EVENT OF WORK IN OR ON THE JCW SANITARY MAIN. ANY TREES OR PLANTINGS PLACED WITHIN THE SEWER EASEMENT MAY BE REMOVED WITHOUT REPLACEMENT OR COMPENSATION THERE OF AND SHALL BE REPLACED BY THE PROPERTY OWNER AS REQUIRED BY THE CITY.

9. STRIP TOP SOIL & SAVE FOR PLANTING AREAS. REFER TO L3.00 FOR PLANTING SOIL MIX. 10. ROCK BEDS SHALL BE BUFFALO RIVER ROCK, 1"-2.5" SIZE, BY HOUSE OF ROCKS OR APPROVED EQUAL. ALL ROCK BED AREAS SHALL HAVE FILTER FABRIC & BE 4" MIN. DEPTH.

11. ALL LANDSCAPE BEDS WITHIN POOL ENCLOSURE TO INCLUDE RIVER ROCK PER SPECS.

12. FINISHED GRADE TO BE TOP OF MULCH OR TURF FOR ALL LANDSCAPE AREAS. REFER TO CIVIL PLANS FOR GRADING INFORMATION.

SEEDING & SOD NOTES:

- REFER TO GENERAL NOTES ON PLANTING DETAILS PAGE FOR SEED MIX AND SOD MATERIAL. REFER TO PROJECT SPECIFICATIONS SECTION 3.1 FOR TURF AREA PREPARATION, AND THE KANSAS CITY METROPOLITAN CHAPTER OF THE APWA, DIVISION II, SECTION 2406.2 FOR ADDITIONAL GRADING AND TILLAGE GUIDELINES & PROCEDURES.
- 3. REFER TO THE KANSAS CITY METROPOLITAN CHAPTER OF THE APWA, DIVISION II, SECTION 2406.3 FOR FERTILIZATION GUIDELINES & PROCEDURES. 4. REFER TO PROJECT SPECIFICATION SECTION 3.3, AND THE KANSAS CITY METROPOLITAN CHAPTER
- OF THE APWA, DIVISION II, SECTION 2406.4.D FOR SOD INSTALLATION GUIDELINES & PROCEDURES. SEEDING OPTIONS: 5.1. HYDROSEEDING - REFER TO KANSAS CITY METROPOLITAN CHAPTER OF THE APWA, DIVISION II, SECTION 2406.4.C FOR HYDROSEEDING GUIDELINES & PROCEDURES.
- 5.2. SOWING REFER TO PROJECT SPECIFICATIONS SECTION 3.2 AND THE KANSAS CITY METROPOLITAN CHAPTER OF THE APWA, DIVISION II, SECTION 2406.4.B FOR SEED SOWING
- 6. SOWN SEED PROTECTION & SECURING METHODS. PROTECT ALL SEEDED AREAS WITH SLOPES NOT EXCEEDING 6:1 (15+%) BY EITHER METHOD LISTED IN THE PROJECT SPECIFICATION SECTION 3.2.D. 7. IF ANY DISCREPANCIES ARE FOUND BETWEEN THE PROJECT GENERAL NOTES, PROJECT SPECIFICATIONS, AND APWA SECTION 2400, THE MOST STRINGENT GUIDELINE APPLIES.




9415 NALL AVE., #300 PRAIRIE VILLAGE, KANSAS, 66207




DRAWING RELEASE LOG

● 09 16 24 PERMIT SET 10.28.24 CITY COMMENTS

REVISIONS 1\10.28.24 FDP COMMENTS 2

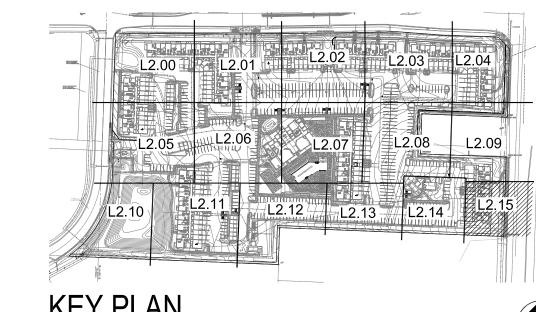

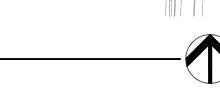

PLANT LIST

Code	Common Name	Botanical Name	5
Evergr	een Shrubs		
CGH	China Boy Holly	llex x meserveae 'Mesdob'	5
CGH	China Girl Holly	llex x meserveae 'Mesog'	5
DFY	Densifomis Yew	Taxus x media 'Densiformis'	5
ELY	Everlow Yew	Taxus x media 'Everlow'	5
GBS	Globe Blue Spruce	Picea pungens 'Glauca globosa'	5
GGB	Green Gem Boxwood	Buxus microphylla x 'Green Gem'	5
GMC	Gold Mop Cypress	Chamaecyparis pisifera 'Yellow Thread Branch'	5
PFJ	Perfecta Juniper	Juniperus chinensis 'Perfecta'	5
PRB	Green Mountain Boxwood (Pyramidal)	Buxus microphylla 'Green Mountain'	5
SJG	Sea Green Juniper	Juniperus chinensis 'Sea Green'	5
TMJ	Tam Juniper	Juniperus sabina 'Tamariscifolia'	5
WGB	Winter Green Boxwood	Buxus microphylla 'Winter Green'	5
WTB	Red Sprite Winterberry	llex verticillata 'Nana'	5
WYW	Wardii Yew	Taxus x media 'Wardii'	5
Decidio	ous Shrubs		
CPR	Red Carpet Rose	Rosa 'Flower Carpet Red'	2
DGW	Variegated Red Twigged Dogwood	Cornus alba 'Ivory Halo'	2
DRT	Dwarf Red Twig Dogwood	Cornus sericea 'Kelseyi"	2
ESH	Endless Summer Hydrangea	Hydrangea macrophylla 'Bailmer'	2
GLS	Gro-Low Sumac	Rhus aromatica 'Gro-Low'	2
GMS	Goldmound Spirea	Spiraea japonica 'Goldmound'	2
HYD	Annabelle Hydrangea	Hydrangea arborescens 'Annabelle'	2
KNR	Knockout Rose	Rosa knockout	2
LHS	Little Henry Sweetspire	Itea virginica 'Little Henry'	2
LPS	Little Princess Spirea	Spiraea japonica 'Little Princess'	2
MCS	Magic Carpet Spirea	Spiraea japonica 'Magic Carpet'	2
ROS	Rose of Sharon - Lavender Chiffon	Hibiscus syriacus 'Notwoodone'	2
WIG	Fine Wine Weigela	Weigela florida 'Bramwell'	2
Perenn	ials		
CAT	Catmint	Nepeta x faassenii 'Walker's Low'	1
DAY	Rosy Returns Daylily	Hemerocallis 'Rosy Returns'	1
DSY	Daisy	Leucanthemum x superbum 'Becky'	1
HOS	Sum & Substance Hosta	Hosta 'Sum & Substance'	1
IRS	Blue Flag Iris	Iris virginica v. shrevei	1
MSG	Blue Salvia	Salvia nemorosa 'May Night'	1
SBA	Summer Beauty Allium	Allium 'Summer Beauty'	1
Grasse	S		
KFG	Karl Foerster Grass	Calamagrostis x acutiflora 'Karl Foerster'	1
MLG	Morning Light Maiden Grass	Miscanthus sinensis 'Morning Light'	1
NWG	Northwind Switch Grass	Panicum virgatum 'Northwind'	1
RSG	Red Switch Grass	Panicum virgatum 'Prairie Fire'	1
VLR	Variegated Liriope	Liriope muscari variegata	1

GENERAL NOTES:

1. EACH BIDDER SHALL VISIT THE SITE OF THE PROPOSED WORK AND EXAMINE THE SITE CONDITIONS. HE SHALL ALSO CAREFULLY EXAMINE THE DRAWINGS FOR THE PROPOSED WORK AND FAMILIARIZE HIMSELF WITH ALL CONDITIONS, WHICH MAY AFFECT THE PROPOSED WORK.

- 2. THE PLANTING PLAN GRAPHICALLY ILLUSTRATES OVERALL PLANT MASSINGS. EACH PLANT SPECIES MASSING SHALL BE PLACED IN THE FIELD TO UTILIZE GREATEST COVERAGE OF GROUND PLANE. THE FOLLOWING APPLIES FOR INDIVIDUAL PLANTINGS:
- A. CREEPING GROUNDCOVER SHALL BE A MINIMUM OF 6" FROM PAVING EDGE. B. ALL TREES SHALL BE A MINIMUM OF 3' FROM PAVING EDGE. C. ALL PLANTS OF THE SAME SPECIES SHALL BE EQUALLY SPACED APART AND PLACED FOR BEST AESTHETIC VIEWING. D. ALL SHRUBS SHALL BE A MINIMUM OF 2' FROM PAVED EDGE.
- 3. NOTIFY LANDSCAPE ARCHITECT 1 WEEK PRIOR TO ANTICIPATED START OF PLANT MATERIAL INSTALLATION. LANDSCAPE CONTRACTOR SHALL STAKE ALL PROPOSED PLANTING BED EDGES, SET OUT SHRUBS IN INTENDED LOCATIONS, AND STAKE TREE LOCATIONS FOR APPROVAL BY LANDSCAPE ARCHITECT PRIOR TO INSTALLATION.

4. ALL NEW PLANT BED AREAS TO BE IRRIGATED. REFER TO SPECIFICATIONS FOR IRRIGATION SYSTEM DESCRIPTION.

- 5. REFER TO L1.00 SERIES SHEETS FOR TREE PLANTINGS.
- 6. REFER TO L2.00 SERIES SHEETS FOR SHRUB PLANTINGS & ROCK MATERIALS.
- 7. REFER TO L3.00 SERIES SHEETS FOR PLANTING DETAILS & SPECIFICATIONS.

8. IN THE EVENT OF WORK IN OR ON THE JCW SANITARY MAIN. ANY TREES OR PLANTINGS PLACED WITHIN THE SEWER EASEMENT MAY BE REMOVED WITHOUT REPLACEMENT OR COMPENSATION THERE OF AND SHALL BE REPLACED BY THE PROPERTY OWNER AS REQUIRED

9. STRIP TOP SOIL & SAVE FOR PLANTING AREAS. REFER TO L3.00 FOR PLANTING SOIL MIX. 10. ROCK BEDS SHALL BE BUFFALO RIVER ROCK, 1"-2.5" SIZE, BY HOUSE OF ROCKS OR

- APPROVED EQUAL. ALL ROCK BED AREAS SHALL HAVE FILTER FABRIC & BE 4" MIN. DEPTH. 11. ALL LANDSCAPE BEDS WITHIN POOL ENCLOSURE TO INCLUDE RIVER ROCK PER SPECS.
- 12. FINISHED GRADE TO BE TOP OF MULCH OR TURF FOR ALL LANDSCAPE AREAS. REFER TO CIVIL PLANS FOR GRADING INFORMATION.

SEEDING & SOD NOTES:

- 1. REFER TO GENERAL NOTES ON PLANTING DETAILS PAGE FOR SEED MIX AND SOD MATERIAL. 2. REFER TO PROJECT SPECIFICATIONS SECTION 3.1 FOR TURF AREA PREPARATION, AND THE KANSAS CITY METROPOLITAN CHAPTER OF THE APWA, DIVISION II, SECTION 2406.2 FOR ADDITIONAL GRADING AND TILLAGE GUIDELINES & PROCEDURES.
- 3. REFER TO THE KANSAS CITY METROPOLITAN CHAPTER OF THE APWA, DIVISION II, SECTION 2406.3 FOR FERTILIZATION GUIDELINES & PROCEDURES.
- 4. REFER TO PROJECT SPECIFICATION SECTION 3.3, AND THE KANSAS CITY METROPOLITAN CHAPTER OF THE APWA, DIVISION II, SECTION 2406.4.D FOR SOD INSTALLATION GUIDELINES & PROCEDURES.
- SEEDING OPTIONS: 5.1. <u>HYDROSEEDING</u> - REFER TO KANSAS CITY METROPOLITAN CHAPTER OF THE APWA, DIVISION II, SECTION 2406.4.C FOR HYDROSEEDING GUIDELINES & PROCEDURES. 5.2. SOWING - REFER TO PROJECT SPECIFICATIONS SECTION 3.2 AND THE KANSAS CITY
- METROPOLITAN CHAPTER OF THE APWA, DIVISION II, SECTION 2406.4.B FOR SEED SOWING
- 6. SOWN SEED PROTECTION & SECURING METHODS. PROTECT ALL SEEDED AREAS WITH SLOPES NOT EXCEEDING 6:1 (15+%) BY EITHER METHOD LISTED IN THE PROJECT SPECIFICATION SECTION 3.2.D. 7. IF ANY DISCREPANCIES ARE FOUND BETWEEN THE PROJECT GENERAL NOTES, PROJECT

SPECIFICATIONS, AND APWA SECTION 2400, THE MOST STRINGENT GUIDELINE APPLIES.

ARCHITECTS

ARCHITECTURE

L A N D S C A P E ARCHITECTURE

P.913.831.1415 NSPJARCH.COM

9415 NALL AVE., #300 PRAIRIE VILLAGE, KANSAS, 66207


• 10.28.24 CITY COMMENTS

DRAWING RELEASE LOG

● 09.16.24 PERMIT SET

REVISIONS 1\10.28.24 FDP COMMENTS 2

SHRUB PLANTING PLAN

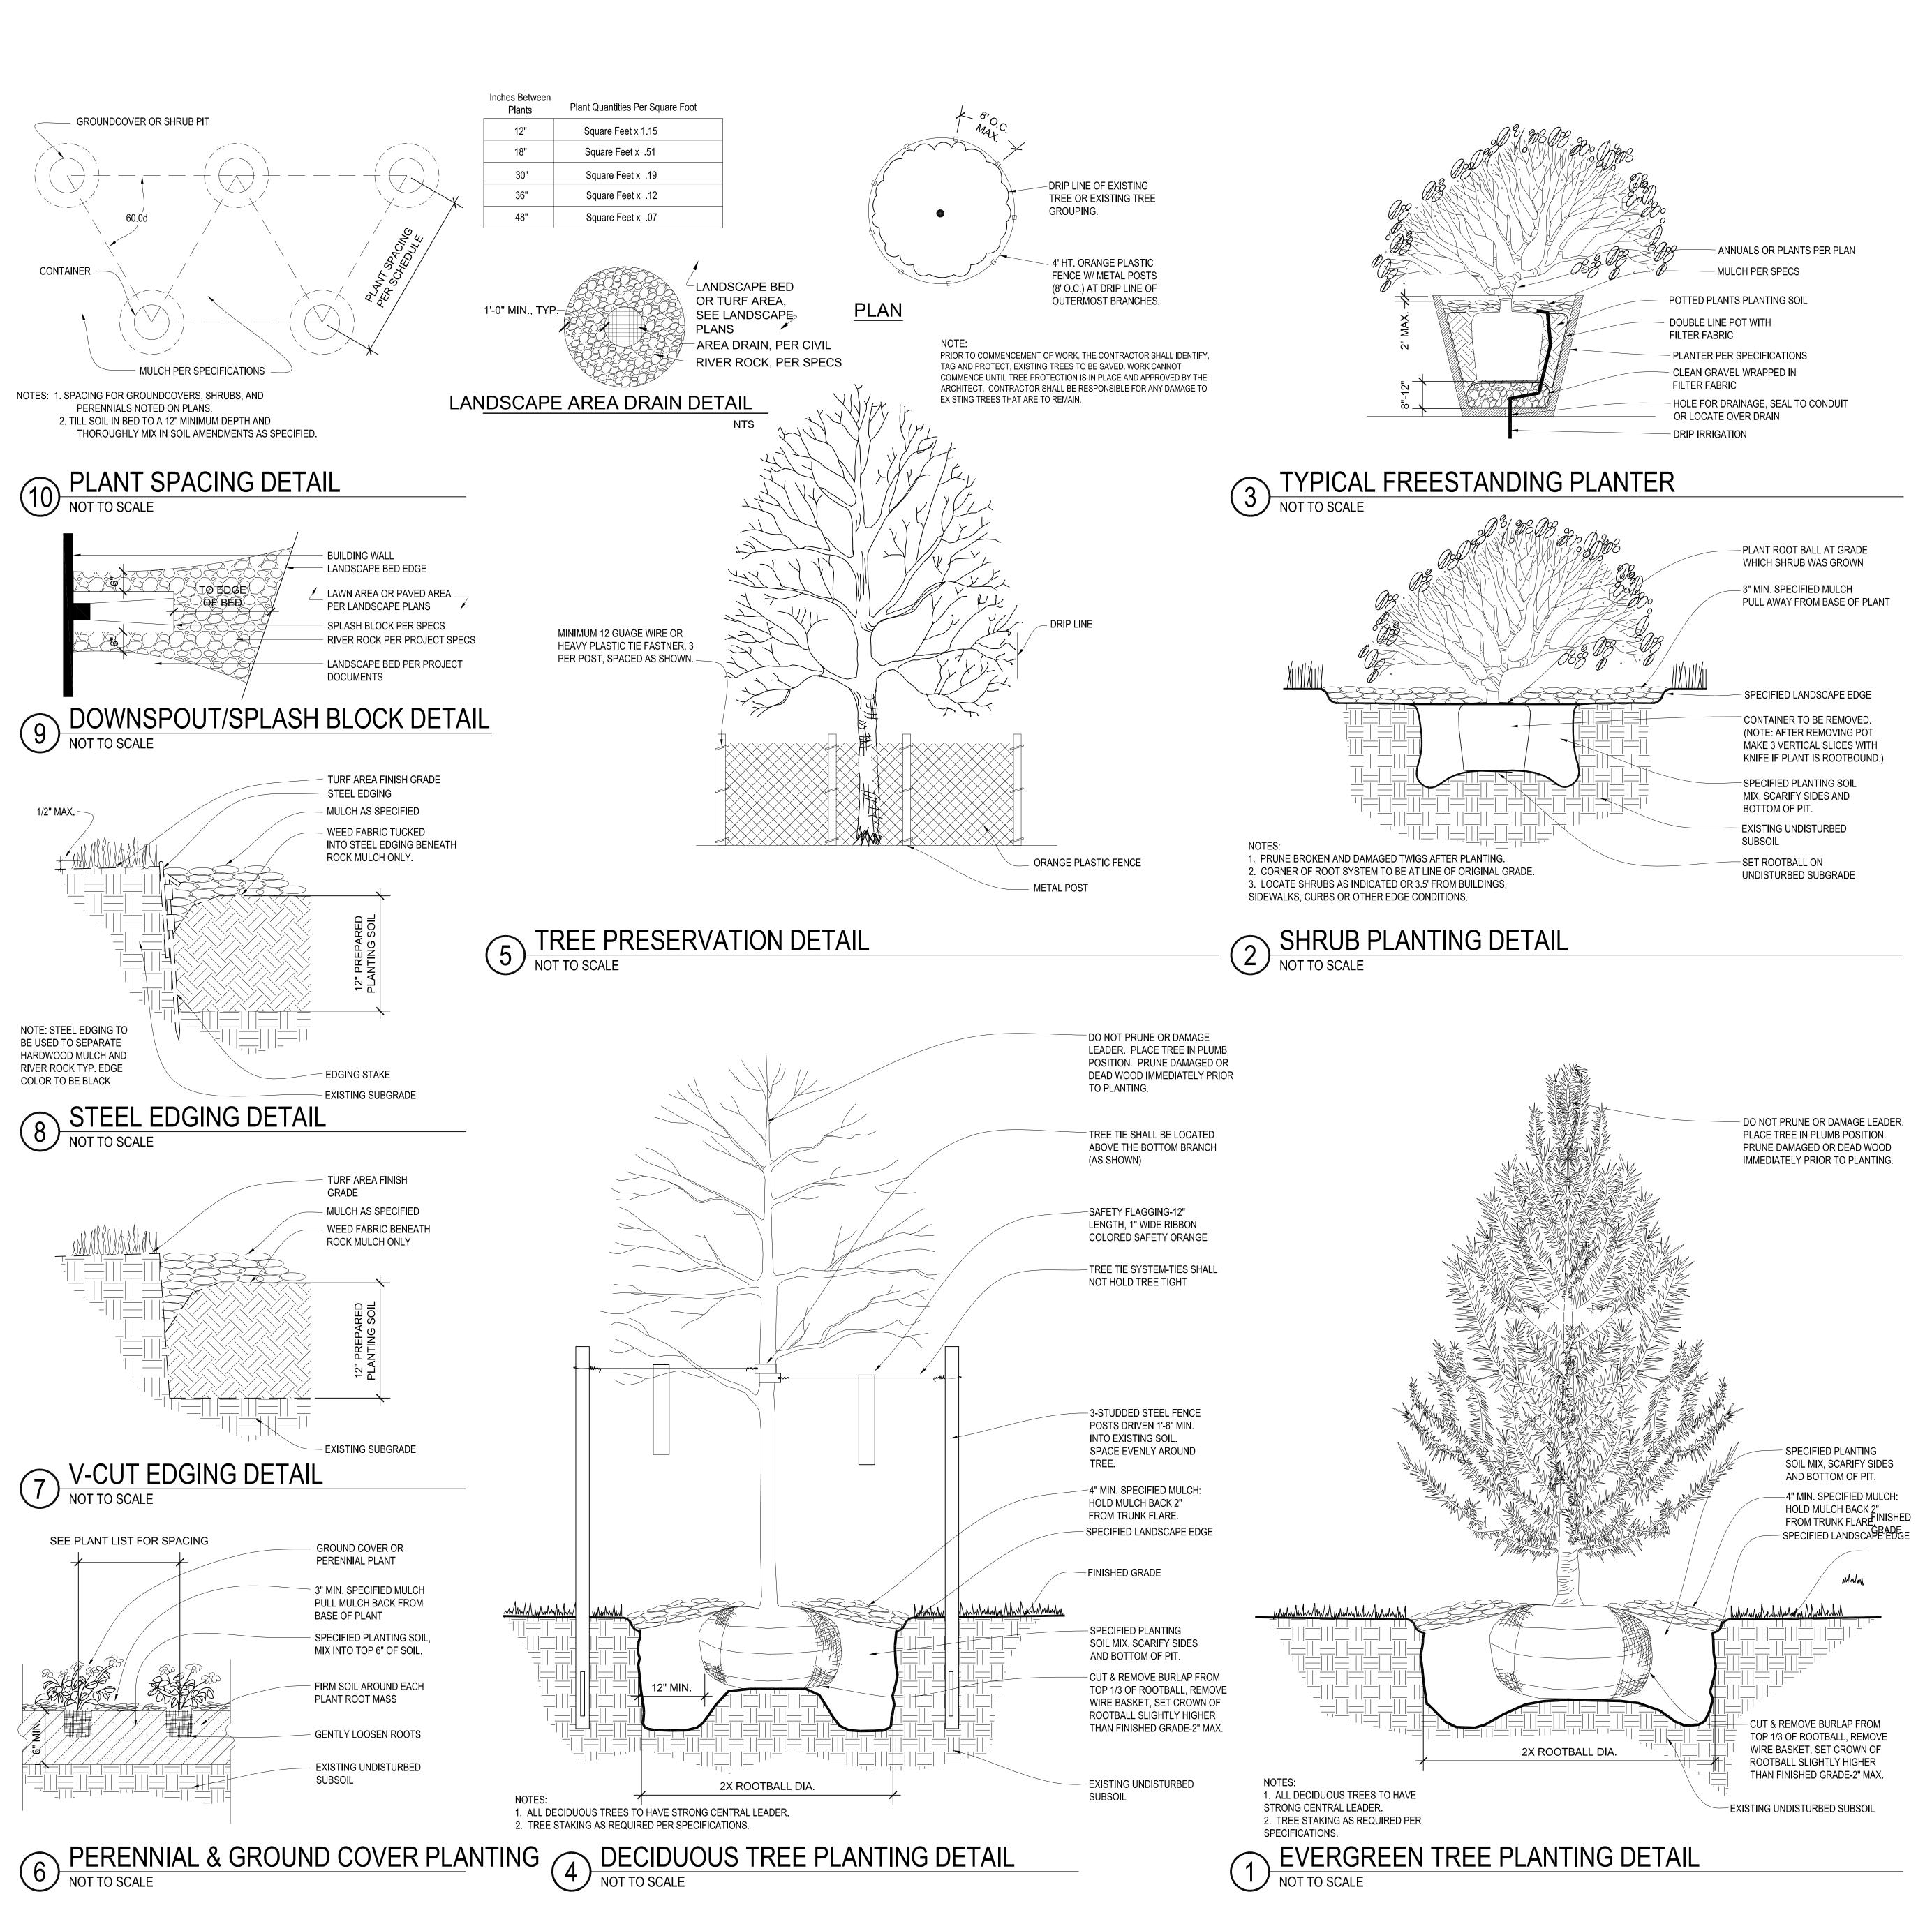

GENERAL NOTES:

- 1. EACH BIDDER SHALL VISIT THE SITE OF THE PROPOSED WORK AND EXAMINE THE SITE CONDITIONS. HE SHALL ALSO CAREFULLY EXAMINE THE DRAWINGS FOR THE PROPOSED WORK AND FAMILIARIZE HIMSELF WITH ALL CONDITIONS, WHICH MAY AFFECT THE PROPOSED WORK.
- 2. THE PLANTING PLAN GRAPHICALLY ILLUSTRATES OVERALL PLANT MASSING. EACH PLANT SPECIES MASSING SHALL BE PLACED IN THE FIELD TO UTILIZE GREATEST COVERAGE OF GROUND PLANE. THE FOLLOWING APPLIES FOR INDIVIDUAL PLANTINGS: CREEPING GROUNDCOVER SHALL BE A MINIMUM OF 6" FROM PAVING EDGE.
- ALL TREES SHALL BE A MINIMUM OF 3' FROM PAVING EDGE. ALL PLANTS OF THE SAME SPECIES SHALL BE EQUALLY SPACED APART AND PLACED FOR BEST AESTHETIC VIEWING. ALL SHRUBS SHALL BE A MINIMUM OF 2' FROM PAVED EDGE.
- . NOTIFY LANDSCAPE ARCHITECT 1 WEEK PRIOR TO ANTICIPATED START OF PLANT MATERIAL INSTALLATION. LANDSCAPE CONTRACTOR SHALL STAKE ALL PROPOSED PLANTING BED EDGES, SET OUT SHRUBS IN INTENDED LOCATIONS, AND STAKE TREE LOCATIONS FOR APPROVAL BY LANDSCAPE ARCHITECT PRIOR TO INSTALLATION.
- 4. LANDSCAPE ARCHITECT RESERVES THE RIGHT TO REJECT ANY AND ALL PLANT MATERIALS PROPOSED FOR USE ON THE
- 5. CONTRACTOR WILL BE RESPONSIBLE FOR PLANTING ALL PLANT MATERIAL INDICATED ON THE PLANS. PLANT SCHEDULE IS FOR SUMMARY ONLY. VERIFY ALL PLANT QUANTITIES PRIOR TO BIDDING.
- 6. CONTRACTOR WILL BE RESPONSIBLE FOR REMOVAL OF EXISTING TREES & PLANT MATERIAL AS INDICATED ON PLAN AND AS DIRECTED BY LANDSCAPE ARCHITECT. RELOCATE PERENNIALS & SHRUBS TO LOCATION INDICATED ON PLAN AND AS DIRECTED
- 7. REPORT ANY DISCREPANCIES FOUND WITH REGARD TO EXISTING CONDITIONS OR PROPOSED DESIGN IMMEDIATELY TO THE LANDSCAPE ARCHITECT. DO NOT WILLFULLY PROCEED WITH CONSTRUCTION AS DESIGNED WHERE IT IS FOUND THAT KNOWN DISCREPANCIES EXIST. THE CONTRACTOR SHALL ASSUME FULL RESPONSIBILITY FOR ALL NECESSARY REVISIONS DUE TO
- 8. THE CONTRACTOR SHALL BE RESPONSIBLE FOR ANY COORDINATION WITH OTHER RELATED SITE WORK BEING PERFORMED TO ACCOMPLISH SITE CONSTRUCTION OPERATIONS.
- 9. THE CONTRACTOR SHALL DETERMINE THE EXACT LOCATION OF ALL EXISTING UTILITIES BEFORE COMMENCING WORK, AND AGREES TO BE FULLY RESPONSIBLE FOR ANY AND ALL DAMAGES WHICH MIGHT BE OCCASIONED BY THE CONTRACTOR'S FAILURE

TO EXACTLY LOCATE AND PRESERVE ANY AND ALL UNDERGROUND UTILITIES.

- 10. PLANT MATERIAL SHALL BE MAINTAINED AND GUARANTEED FOR A PERIOD OF ONE YEAR AFTER OWNER'S ACCEPTANCE OF FINISHED JOB. ALL DEAD OR DAMAGED PLANT MATERIAL SHALL BE REPLACED AT LANDSCAPE CONTRACTOR'S EXPENSE PRIOR TO ACCEPTANCE. RECOMMENDED DATES FOR PLANT MATERIAL INSTALLATION SHALL BE FEBRUARY 15 - MAY 15 AND SEPTEMBER 15 - DECEMBER 15.
- 11. THE PROJECT MAY BE AWARDED COMPLETION IN PHASES BUT IT IS THE RESPONSIBILITY OF THE CONTRACTOR TO NOTIFY THE OWNER & LANDSCAPE ARCHITECT WHEN A PHASE IS COMPLETE & A FINAL WALK THROUGH CAN TAKE PLACE. CONTRACTOR SHALL IDENTIFY ON THE PLANS THE LIMITS OF COMPLETED WORK AND/OR PHASES PRIOR TO THE WALK THROUGH.
- 12. LANDSCAPE CONTRACTOR SHALL MAINTAIN ALL PLANT MATERIAL UNTIL FINAL ACCEPTANCE, AT WHICH POINT THE ONE YEAR
- 13. FINISHED GRADE TO BE TOP OF MULCH OR TURF FOR ALL LANDSCAPE AREAS. REFER TO CIVIL PLANS FOR GRADING INFORMATION.

BY LANDSCAPE ARCHITECT.

FAILURE TO GIVE SUCH NOTIFICATION.

- 14. PLANT MATERIAL SHALL BE HEALTHY, VIGOROUS, AND FREE OF DISEASE AND INSECTS AS PER AMERICAN ASSOCIATION OF NURSERYMEN STANDARDS.
- 15. PLANT MATERIAL SHALL NOT BE PRUNED PRIOR TO INSTALLATION. AFTER PLANTS HAVE BEEN INSTALLED, EACH PLANT SHALL BE PRUNED TO UNIFORMITY.
- 16. SHREDDED BARK MULCH SHALL BE FINELY CHIPPED AND SHREDDED DARK BROWN HARDWOOD CHIPS CONSISTING OF PURE
- WOOD PRODUCTS AND FREE OF ALL FOREIGN SUBSTANCES.
- 17. CONTRACTOR SHALL USE AN APPROVED TREE TIE SYSTEM THAT IS EASILY ADJUSTABLE, STRONG IN ALL WEATHER, AND EASILY ATTACHED AND REMOVED. HOSE AND WIRE ARE NOT ACCEPTABLE FOR STAKED TREES. PROVIDE THE FOLLOWING OR APPROVED EQUAL: "CINCH TIES" BY J. LICHTENTHALER, "ADJ-A-TYPE" BY HEAVYWEIGHT ONLY, A PLASTIC CHAIN TWIST TIE, OR "PLASTIC BINDER TYE" A TIE WITH TAPERED BEADS THAT SNAP LOCK BY A.M. LEONARD AND SONS.
- SOD SHALL BE CERTIFIED TURFGRASS SOD COMPLYING WITH ASPA SPECIFICATIONS FOR MACHINE-CUT THICKNESS, SIZE, STRENGTH, MOISTURE CONTENT, AND MOWED HEIGHT, AND FREE OF WEEDS AND UNDESIRABLE NATIVE GRASSES. SOD SHAL BE A BLEND OF NOT LESS THAN 3 IMPROVED KENTUCKY BLUEGRASS (POSPARATENSIS) VARIETIES, A NATIVE MIXTURE OF HOUNDOG, REBEL, OR FALCON, FINE LEAFED TALL FESCUE (FESTUCA ARUNDINACEA), AND RYE (LOLIUM JULTIFLORUM AND PERENE DOMESTIC). IT SHALL BE A MIX OF 20% KENTUCKY BLUEGRASS, 70% FINELEAFED TALL FESCUE, AND 10% RYE. SOI SHALL BE WELL ROOTED, 2 YEAR OLD STOCK, HARVESTED IN ROLLS, FERTILIZED 2-3 WEEKS PRIOR TO CUTTING. ALL SOD SHALL BE MACHINE CUT AND VIGOROUSLY GROWING (NOT DORMANT). MAXIMUM TIME FROM STRIPPING TO PLANTING SHALL BE 24
- 19. ALL NEW PLANT BED AREAS TO BE IRRIGATED. REFER TO SPECIFICATIONS.
- 20. STEPPING STONES SHALL BE JAMES CREEK (RECTILINEAR OR ASHLAR AS IDENTIFIED IN THE PLANS), BY HOUSE OF ROCKS OR APPROVED EQUAL. 1"-3" THICK.
- 21. ROCK BEDS SHALL SHALL BE BUFFALO RIVER ROCK, 1"-2.5", BY HOUSE OF ROCKS OR APPROVED EQUAL. ALL ROCK BED AREAS SHALL HAVE FILTER FABRIC & BE 4" MIN. DEPTH.
- $\overline{\hspace{1cm}}$ RECOMMENDED DATES FOR TREE AND SHRUB PLANTING SHALL BE FEBRUARY 15 - MAY 31 AND SEPTEMBER 15 - DECEMBER 15. STRIP TOP SOIL & SAVE FOR PLANTING AREAS. EXCAVATE TO A DEPTH OF 6" FOR ALL LAWN AREAS AND AMEND WITH PLANTING SOIL MIX. A 10-10-10 FERTILIZER SHALL BE SPREAD OVER ALL PLANTING AREAS PRIOR TO PLANTING, AT A RATE OF 50 POUNDS
- PER 2,000 SQUARE FEET. REFER TO PLANTING DETAILS FOR PLANTING SOIL MIX DEPTHS FOR PERENNIAL, GROUNDCOVER, SHRUB BEDS AND TREE PLANTING.STRIP TOP SOIL & SAVE FOR PLANTING AREAS. EXCAVATE TO A DEPTH OF 12" FOR ALL PLANTING BEDS AND REPLACE WITH PLANTING SOIL MIX.
- 3. A 10-10-10 FERTILIZER SHALL BE SPREAD OVER ALL PLANTING AREAS PRIOR TO PLANTING, AT A RATE OF 50 POUNDS PER 2,000
- PRIOR TO MULCH APPLICATION. 5. PLANT PIT BACKFILL FOR TREES AND SHRUBS SHALL BE 25% COTTON BOLL COMPOST, AND 25% TOPSOIL, AND 50% EXISTING SOIL. TOPSOIL SHALL BE NATURAL FERTILE, FRIABLE SOIL POSSESSING CHARACTERISTICS OF REPRESENTATIVE PRODUCTIVE

4. AFTER PLANTS HAVE BEEN INSTALLED, ALL PLANTING BEDS SHALL BE TREATED WITH DACTHAL PRE-EMERGENT HERBICIDE

- ALSO, FREE OF CLAY LUMPS, STONES, STUMPS, ROOTS OR SUBSTANCE 2" OR MORE IN DIAMETER. 6. PLANTED BED EDGES SHALL BE IN STRAIGHT LINES OR GENTLE FLOWING CURVES. SUDDEN CURVES OR SHARP ANGLES SHOULD

SOILS IN THE AREA. SOIL SHALL NOT BE EXCESSIVELY ACID, ALKALINE OR TOXIC THAT MAY BE HARMFUL TO PLANT GROWTH.

- 7. V-CUT EDGE SHALL BE DUG TO 6" DEPTH WITH ANGLED EDGE ON LANDSCAPE BED SIDE, AND VERTICAL EDGE ON TURF SIDE. BACKFILL V-CUT EDGE WITH SHREDDED HARDWOOD MULCH TO GRADE.
- 8. MULCH ALL PLANTING BED AREAS TO A MINIMUM DEPTH OF 3". MULCH INDIVIDUAL TREES TO A MINIMUM DEPTH OF 4".

PROVIDE 100% COVERAGE COMPLETE WORKING IRRIGATION SYSTEM FOR ALL NEW TURF AREAS (SEED AND/OR SOD), ALL NEW PLANTING BEDS, AND ALL NEW TREES AND EXISTING TREES TO REMAIN. INCLUDE ELECTRICAL CONNECTION AND IRRIGATION SLEEVES AS NECESSARY. DRIP IRRIGATE ALL PLANTING BEDS. PRIOR TO INSTALLATION, PROVIDE PLAN SHOWING ALL IRRIGATION MATERIALS INCLUDING ALL EQUIPMENT SIZES AND DETAILS TO LANDSCAPE ARCHITECT FOR APPROVAL. COMPLY WITH REQUIREMENTS OF AUTHORITY WITH JURISDICTION FOR IRRIGATION SYSTEMS & BACKFLOW PREVENTOR. CONTRACTOR SHALL SUBMIT AS-BUILT DRAWINGS TO LANDSCAPE ARCHITECT & OWNER AFTER FINAL INSTALLATION AND PRIOR TO FINAL ACCEPTANCE. INCLUDING ALL HEAD & EQUIPMENT LOCATIONS & MAINTENANCE DATA FOR ALL EQUIPMENT PROVIDED. CONTRACTOR SHALL PROVIDE AN ON-SITE WALK THROUGH OF THE SYSTEM AND FULLY DESCRIBE ITS OPERATION WITH OWNER. CONTRACTOR SHALL ACHIEVE FINAL ACCEPTANCE WHEN SYSTEM IS FULLY OPERATIONAL, AND APPROVED BY OWNER, AND AS-BUILT DRAWINGS AND PROJECT MANUALS HAVE BEEN ACCEPTED AND APPROVED.

PIPING SPECIFICATIONS:

- A. MINIMUM WORKING PRESSURE RATINGS: 1. PRESSURE PIPING: 150 PSIG (1035 KPA)
- 2. CIRCUIT AND DRAIN PIPING: 100 PSIG (690 KPA) B. MAIN LINE TO BE CL-200 POLYVINYL CHLORIDE PIPE OR ASTM D 1785, PVC 1120, SCHEDULE 40, SOCKET-TYPE FITTINGS; AND SOLVENT-CEMENTED JOINTS OR APPROVED EQUAL.
- 1. PIPE UP TO AND INCLUDING 2-1/2 INCHES IN DIAMETER SHALL HAVE BELL AND SOCKET JOINTS. 2. PIPE GREATER THAT 2-1/2 INCHES IN DIAMETER SHALL HAVE SNAP CONNECTIONS WITH RUBBER GASKET JOINTS.
- A. THRUST BLOCKS SHALL BE REQUIRED IN CONJUNCTION WITH RUBBER GASKET JOINT PIPE. C. LATERAL LINES TO BE CL-200 PVC PIPE OR APPROVED EQUAL. D. DRIP TUBING: POLY TUBING OR APPROVED EQUAL.
- E. SLEEVES: MINIMUM DIAMETER OF 2 TIMES LARGER THAN THE PIPE OR PIPE(S) SCHEDULED TO PASS THROUGH THEM. SLEEVES SHALL BE A MINIMUM OF 2 INCH DIAMETER AND SHALL BE SCHEDULE 40 PVC PIPE. F. PLASTIC FITTINGS:
- 1. UTILIZED THROUGHOUT THE SYSTEM (MAINS AND LATERALS) IN WARM CLIMATES AND MAIN LINES IN COLDER CLIMATES: SCHEDULE 40 PVC PIPE. 2. UTILIZED FOR LATERALS OF FLEXIBLE POLYETHYLENE PIPE, TYPE 1 PVC INSERT FITTINGS DESIGNED FOR USE WITH THIS TYPE OF PIPE CONFORMING TO ASTM D 2609.
- A. PIPE AND FITTINGS SHALL BE JOINED WITH STAINLESS STEEL LOCKING PINCH CLAMPS OR STAINLESS STEEL SCREW CLAMPS.
- G. MINIMUM COVER: 1. IN LAWN AND PLANTING AREAS:
- A. MAINS MINIMUM 18 INCHES BELOW FINISH GRADE. B. LATERALS AND CONTROL VALVES - MINIMUM 12 INCHES BELOW FINISH GRADE.
- 2. ROADWAYS OR PARKING AREAS: MINIMUM 24 INCHES BELOW FINISH GRADE. H. CLEARANCES: MINIMUM OF 3-INCHES BETWEEN PARALLEL LINES IN THE SAME TRENCH OR VERTICAL CLEARANCE BETWEEN LINES CROSSING AT ANGLES.

ARCHITECTURE LANDSCAPE ARCHITECTURE

NSPJARCH.COM 9415 NALL AVE., #300 PRAIRIE VILLAGE, KANSAS,66207

P.913.831.1415



DRAWING RELEASE LOG

• 10.28.24 CITY COMMENTS

REVISIONS

1\10.28.24 FDP COMMENTS 2

720522 09.16.2024 **DRAWN BY** SLW / KRM PERMIT SET

SHEET NAME **PLANTING DETAILS**