


1/10/2025 9:33:39 AM

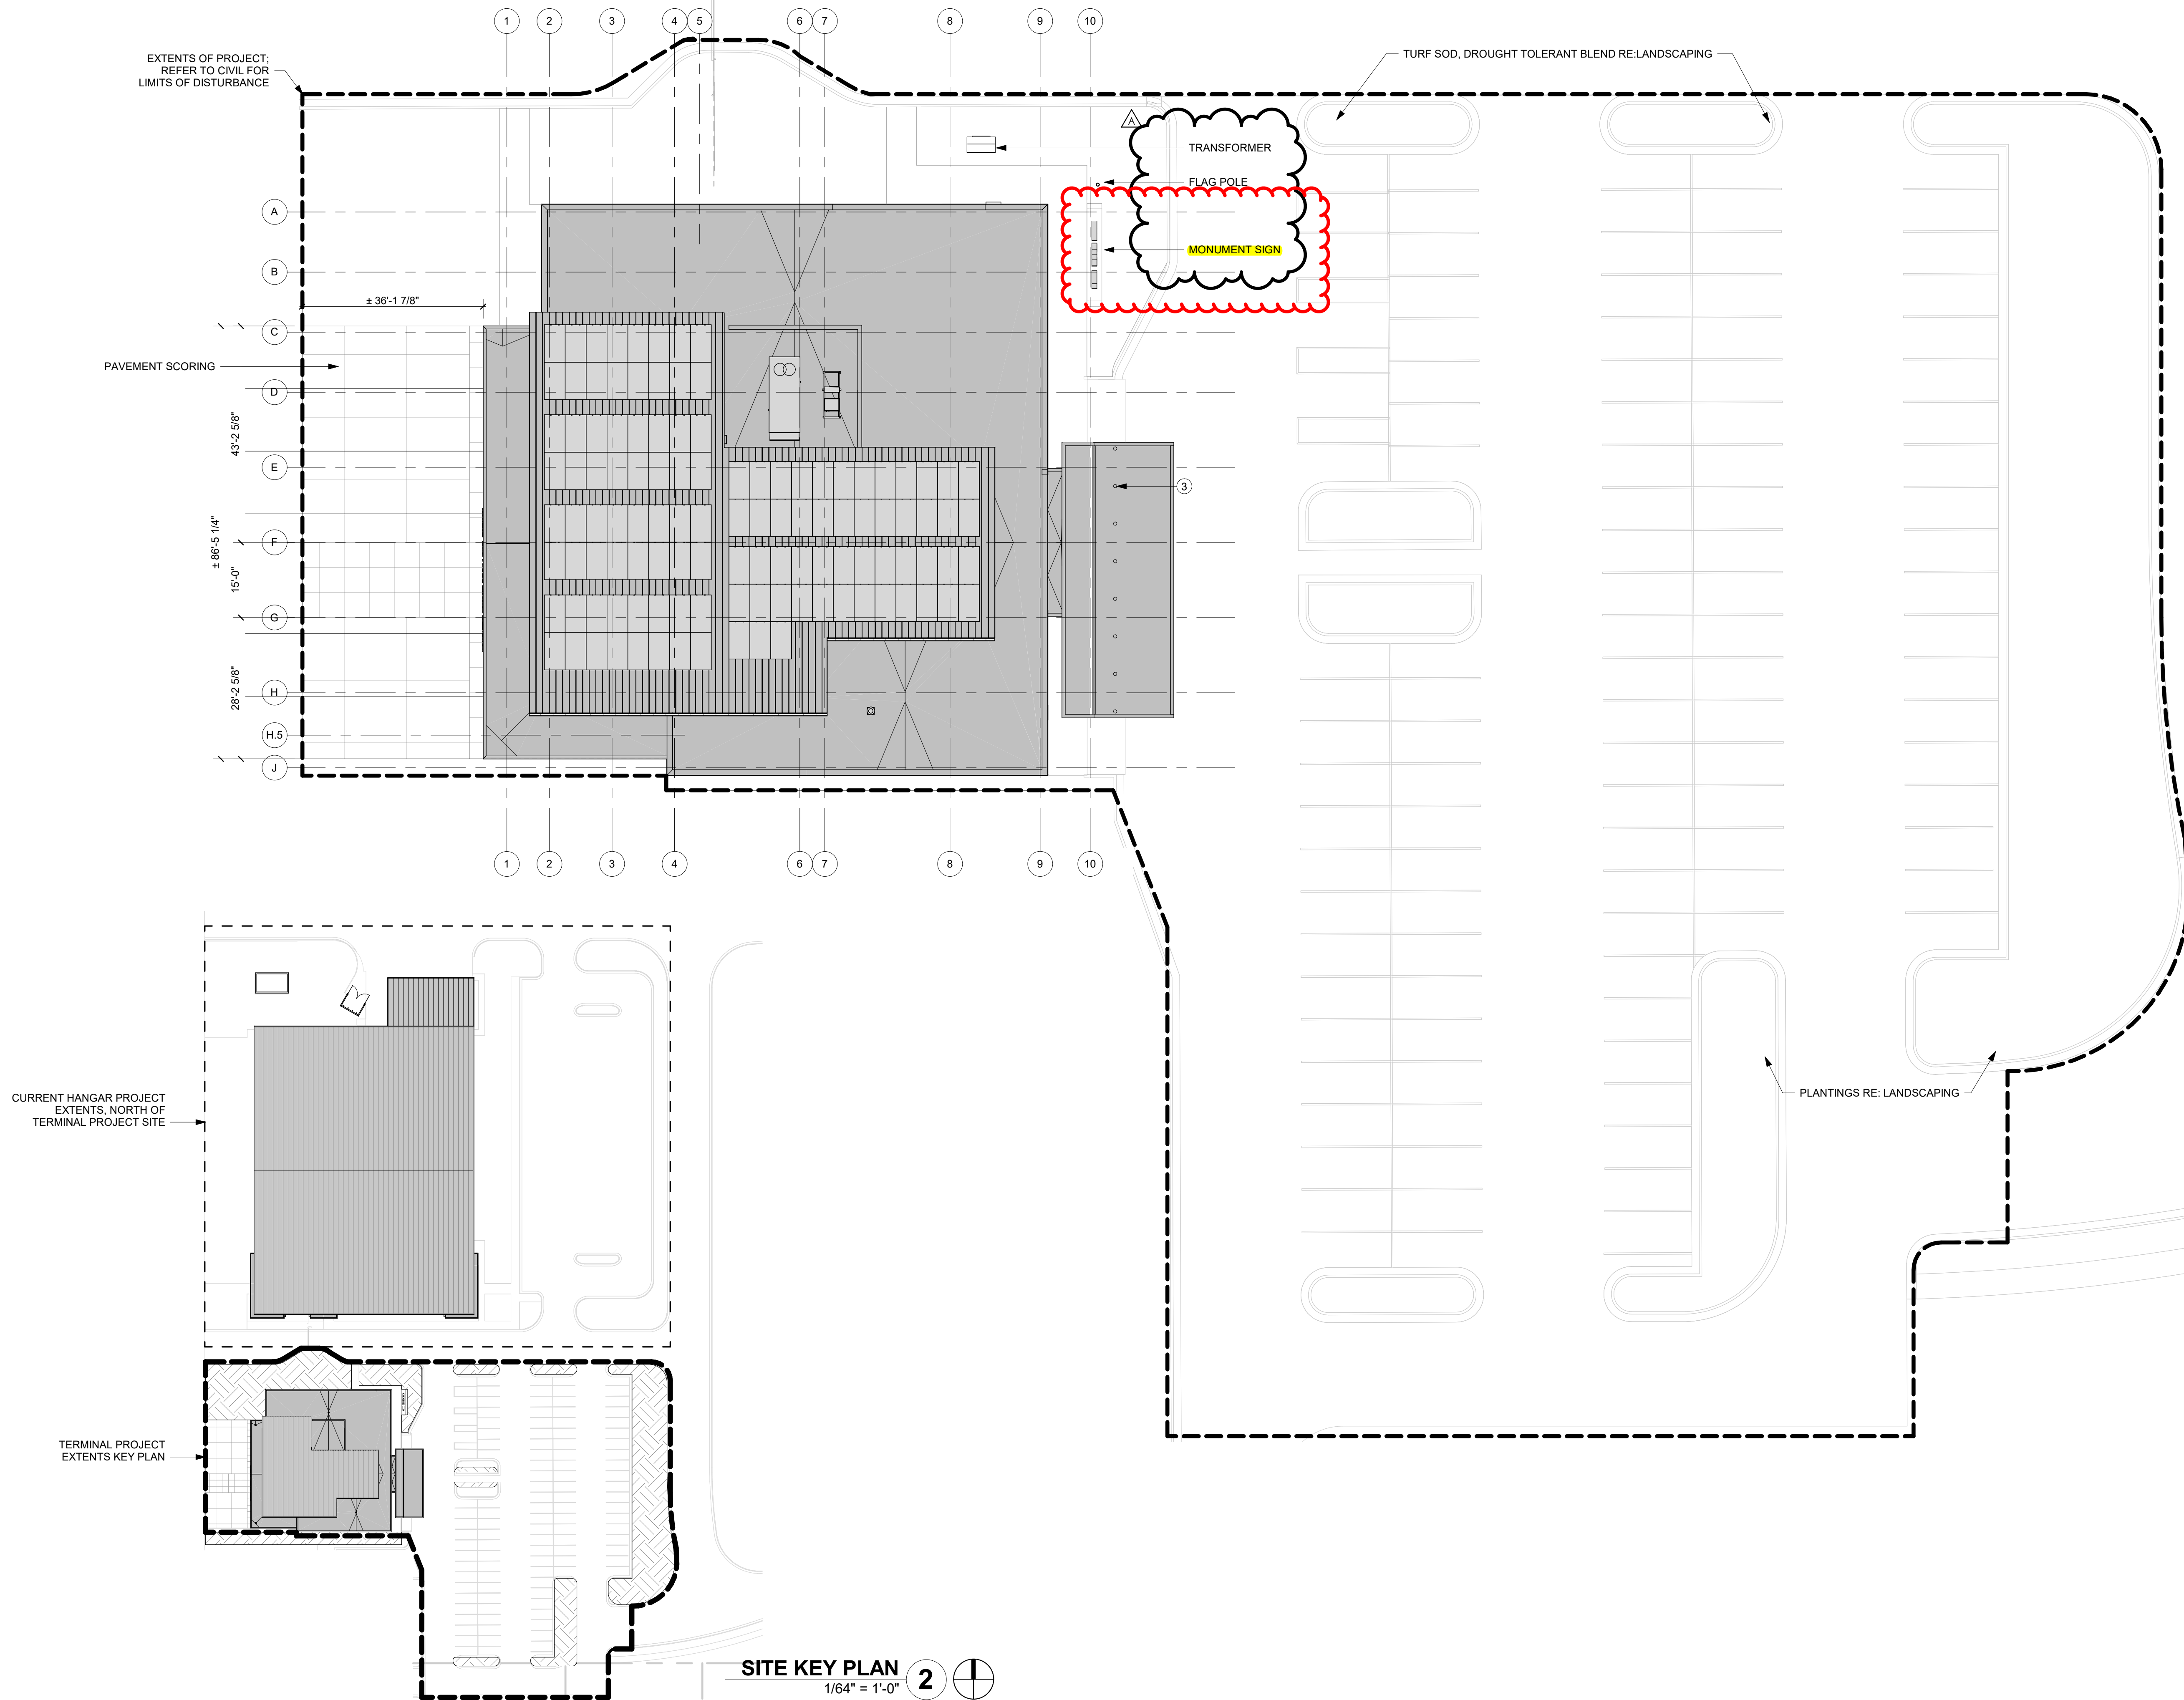

PLAN NOTES

3 DECORATIVE BOLLARD WITH INTEGRAL LIGHTING



1627 MAIN STREET, SUITE 600
KANSAS CITY, MO 64108



1627 MAIN STREET, SUITE 100
KANSAS CITY, MO 64108



1701 WALNUT STREET, SUITE 300
KANSAS CITY, MO 64108

KC - LEE'S SUMMIT REGIONAL
LEE'S SUMMIT, MISSOURI

GENERAL AVIATION TERMINAL
CITY PROJECT NO. - 17932172



LEES SUMMIT MUNICIPAL AIRPORT
LEES SUMMIT, MO

01.03.25 CITY REVIEW COMMENTS

PROJECT NO: 2403
REVIT FILE: 2403 Lee's Summit Terminal-R24.rvt
DESIGNED BY: Designer
DRAWN BY: EM
CHECKED BY: JSB
APPROVED BY: Approver
COPYRIGHT 2024


SHEET TITLE

SITE PLAN


A-100

SHEET OF


1/10/2025 9:38:43 AM

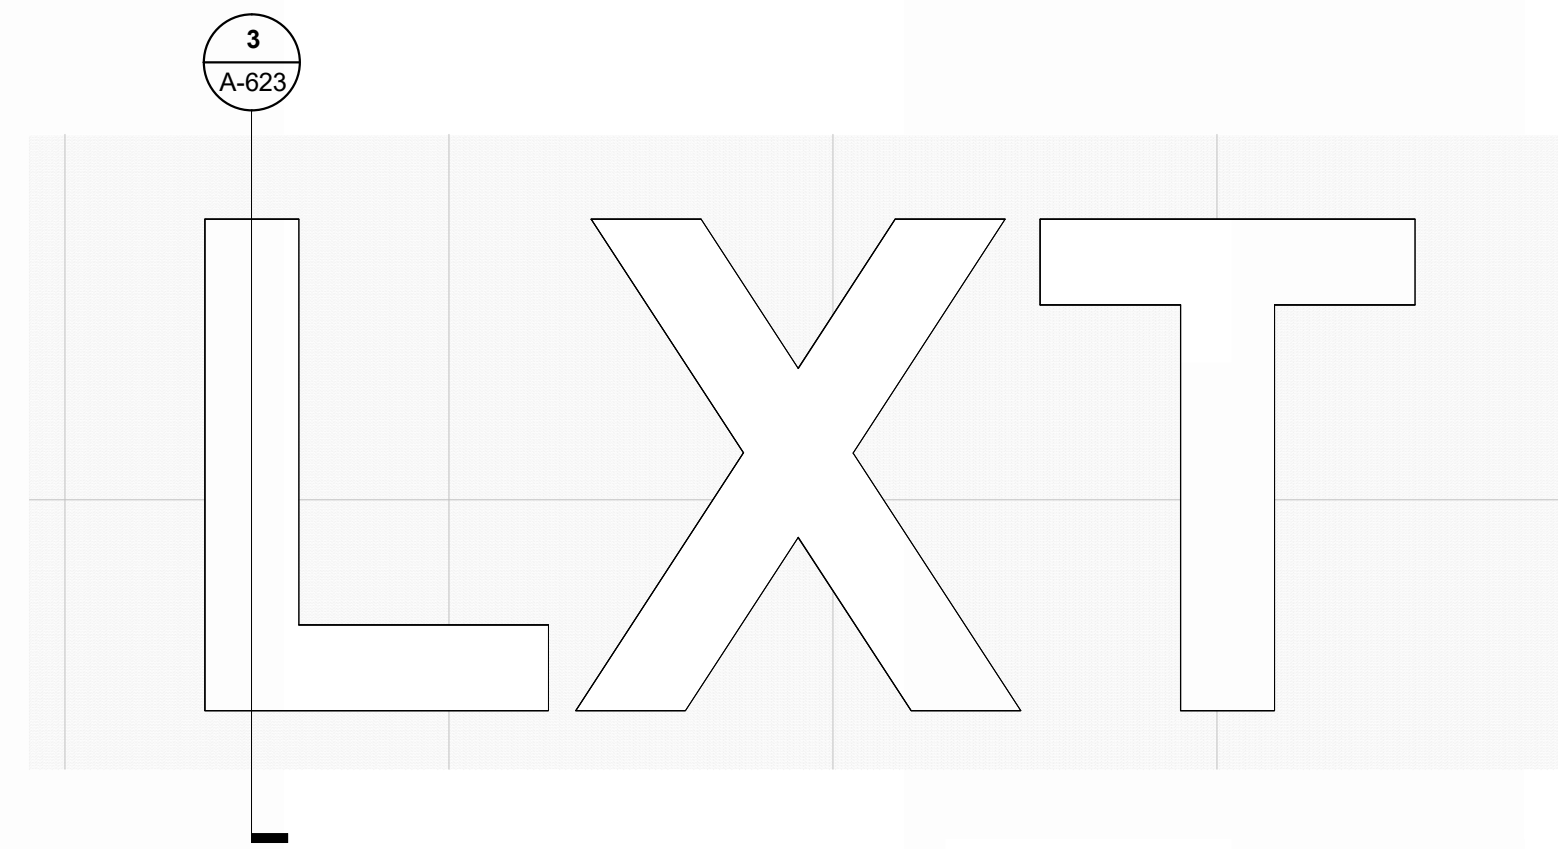


FRONT ELEVATION - INTERIOR LXT SIGNAGE 7
REFERENCED FROM 1 / A-403 1/2" = 1'-0"

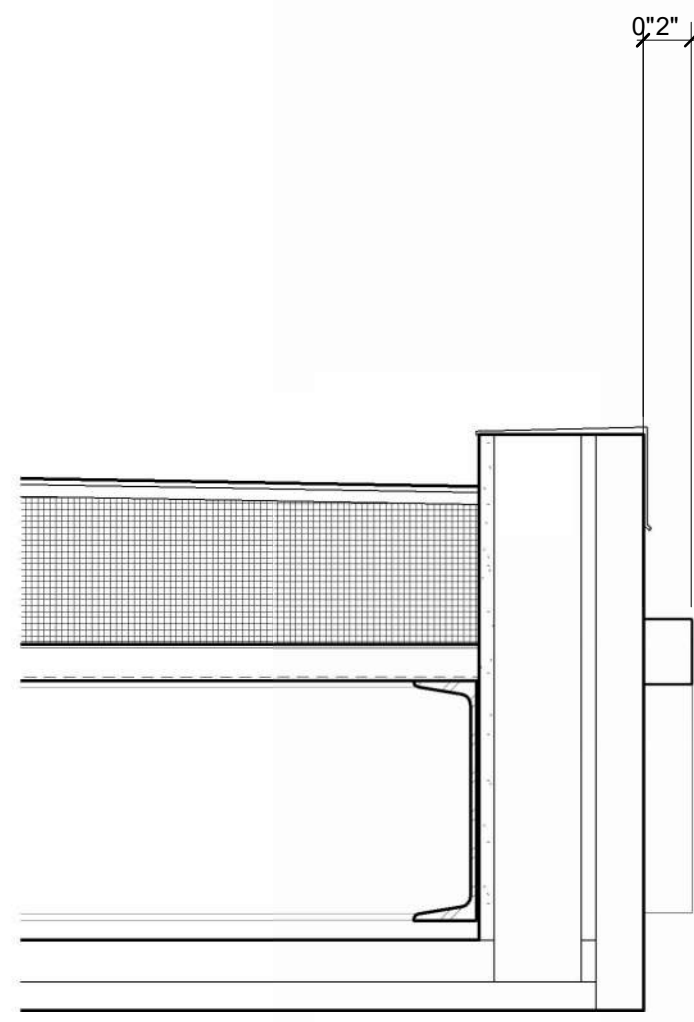


SECTION THRU AIRSIDE SIGNAGE 6
REFERENCED FROM 5 / A-623 1 1/2" = 1'-0"

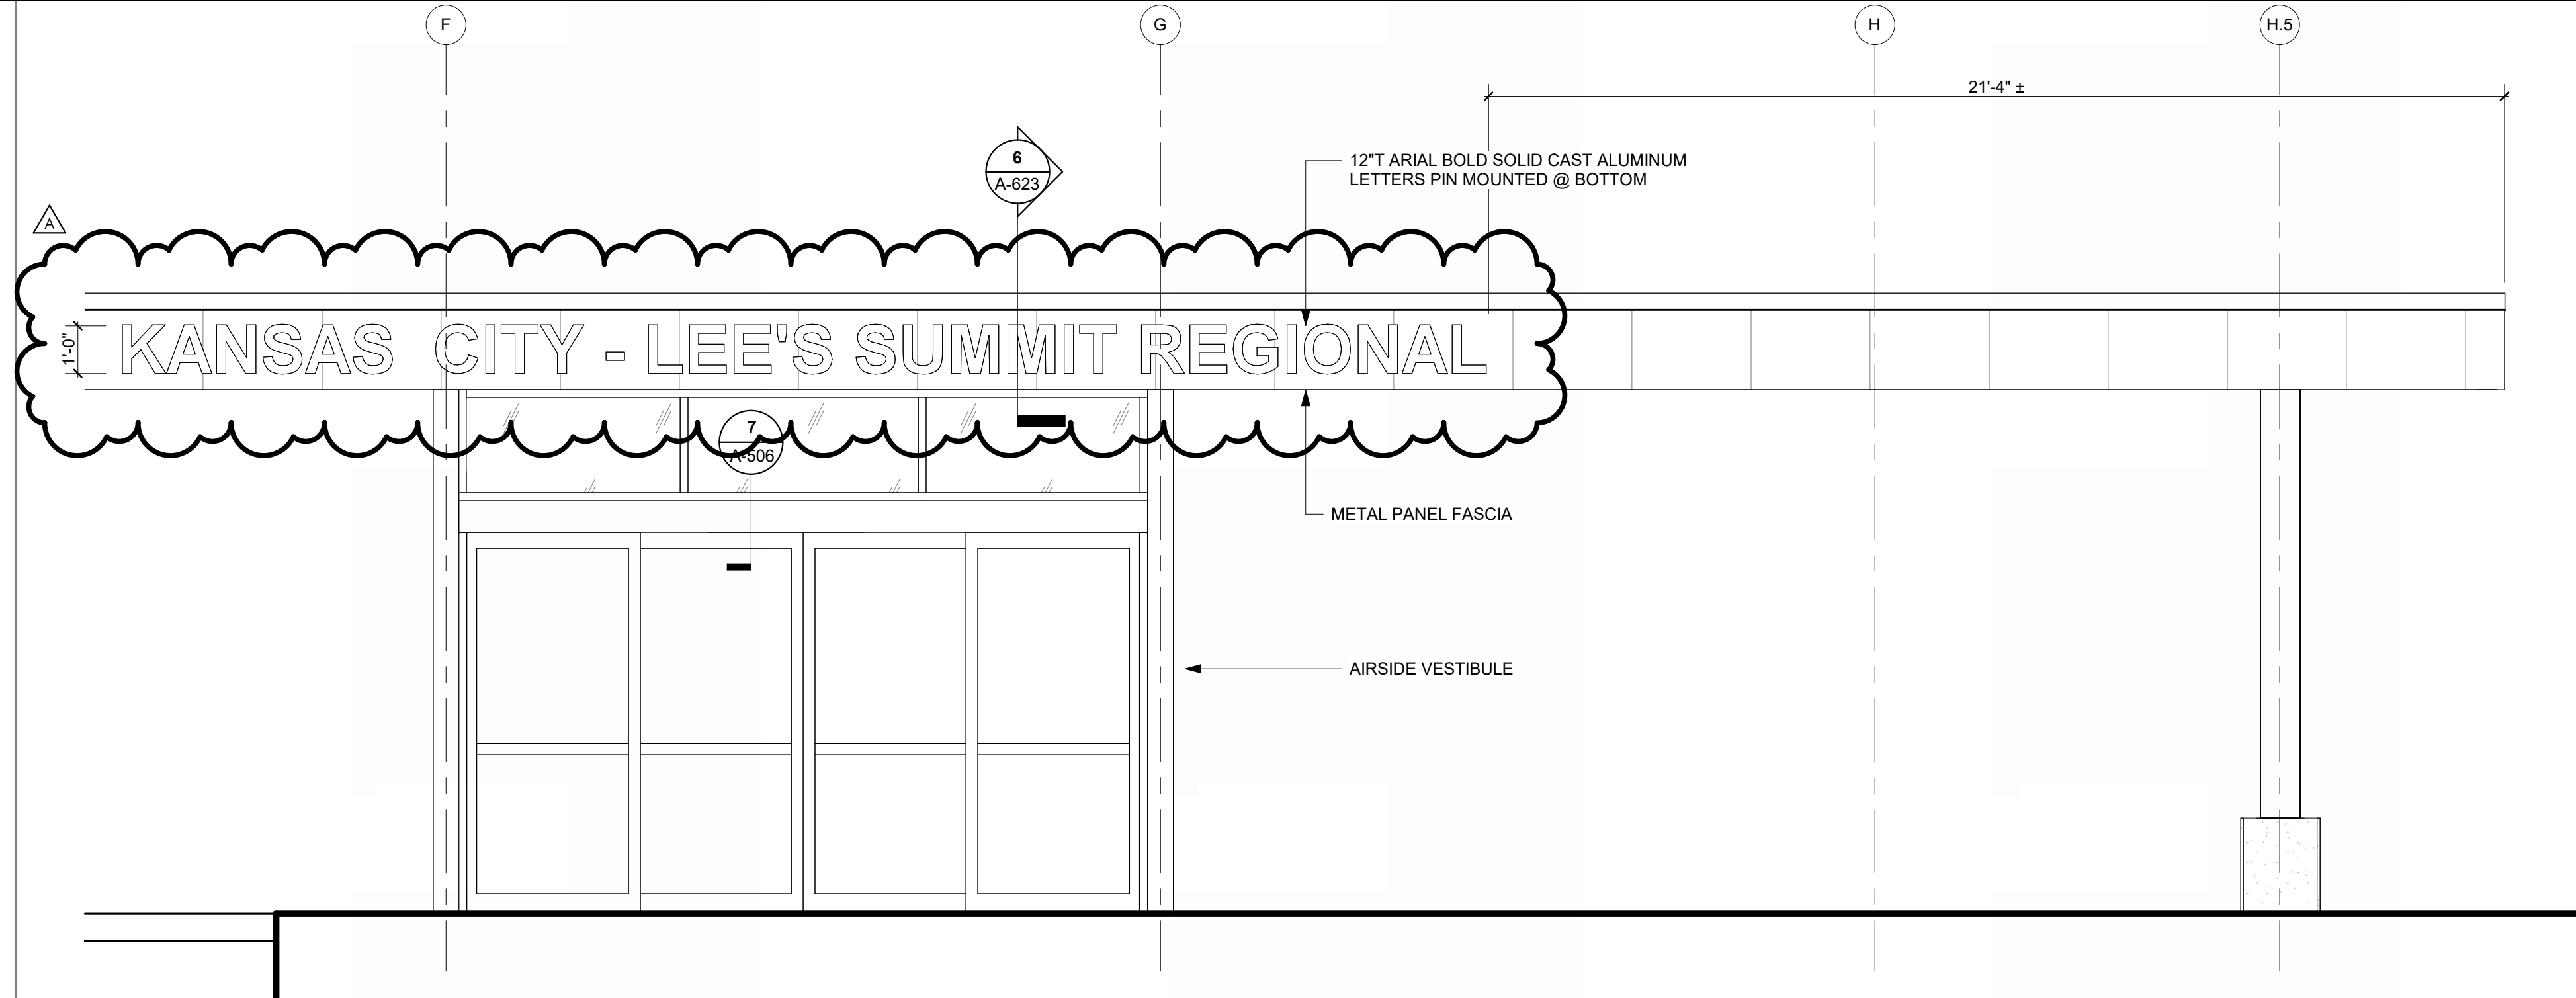


ENLARGED ELEVATION, AIRSIDE SIGNAGE 5
REFERENCED FROM 1 / A-102 3/8" = 1'-0"

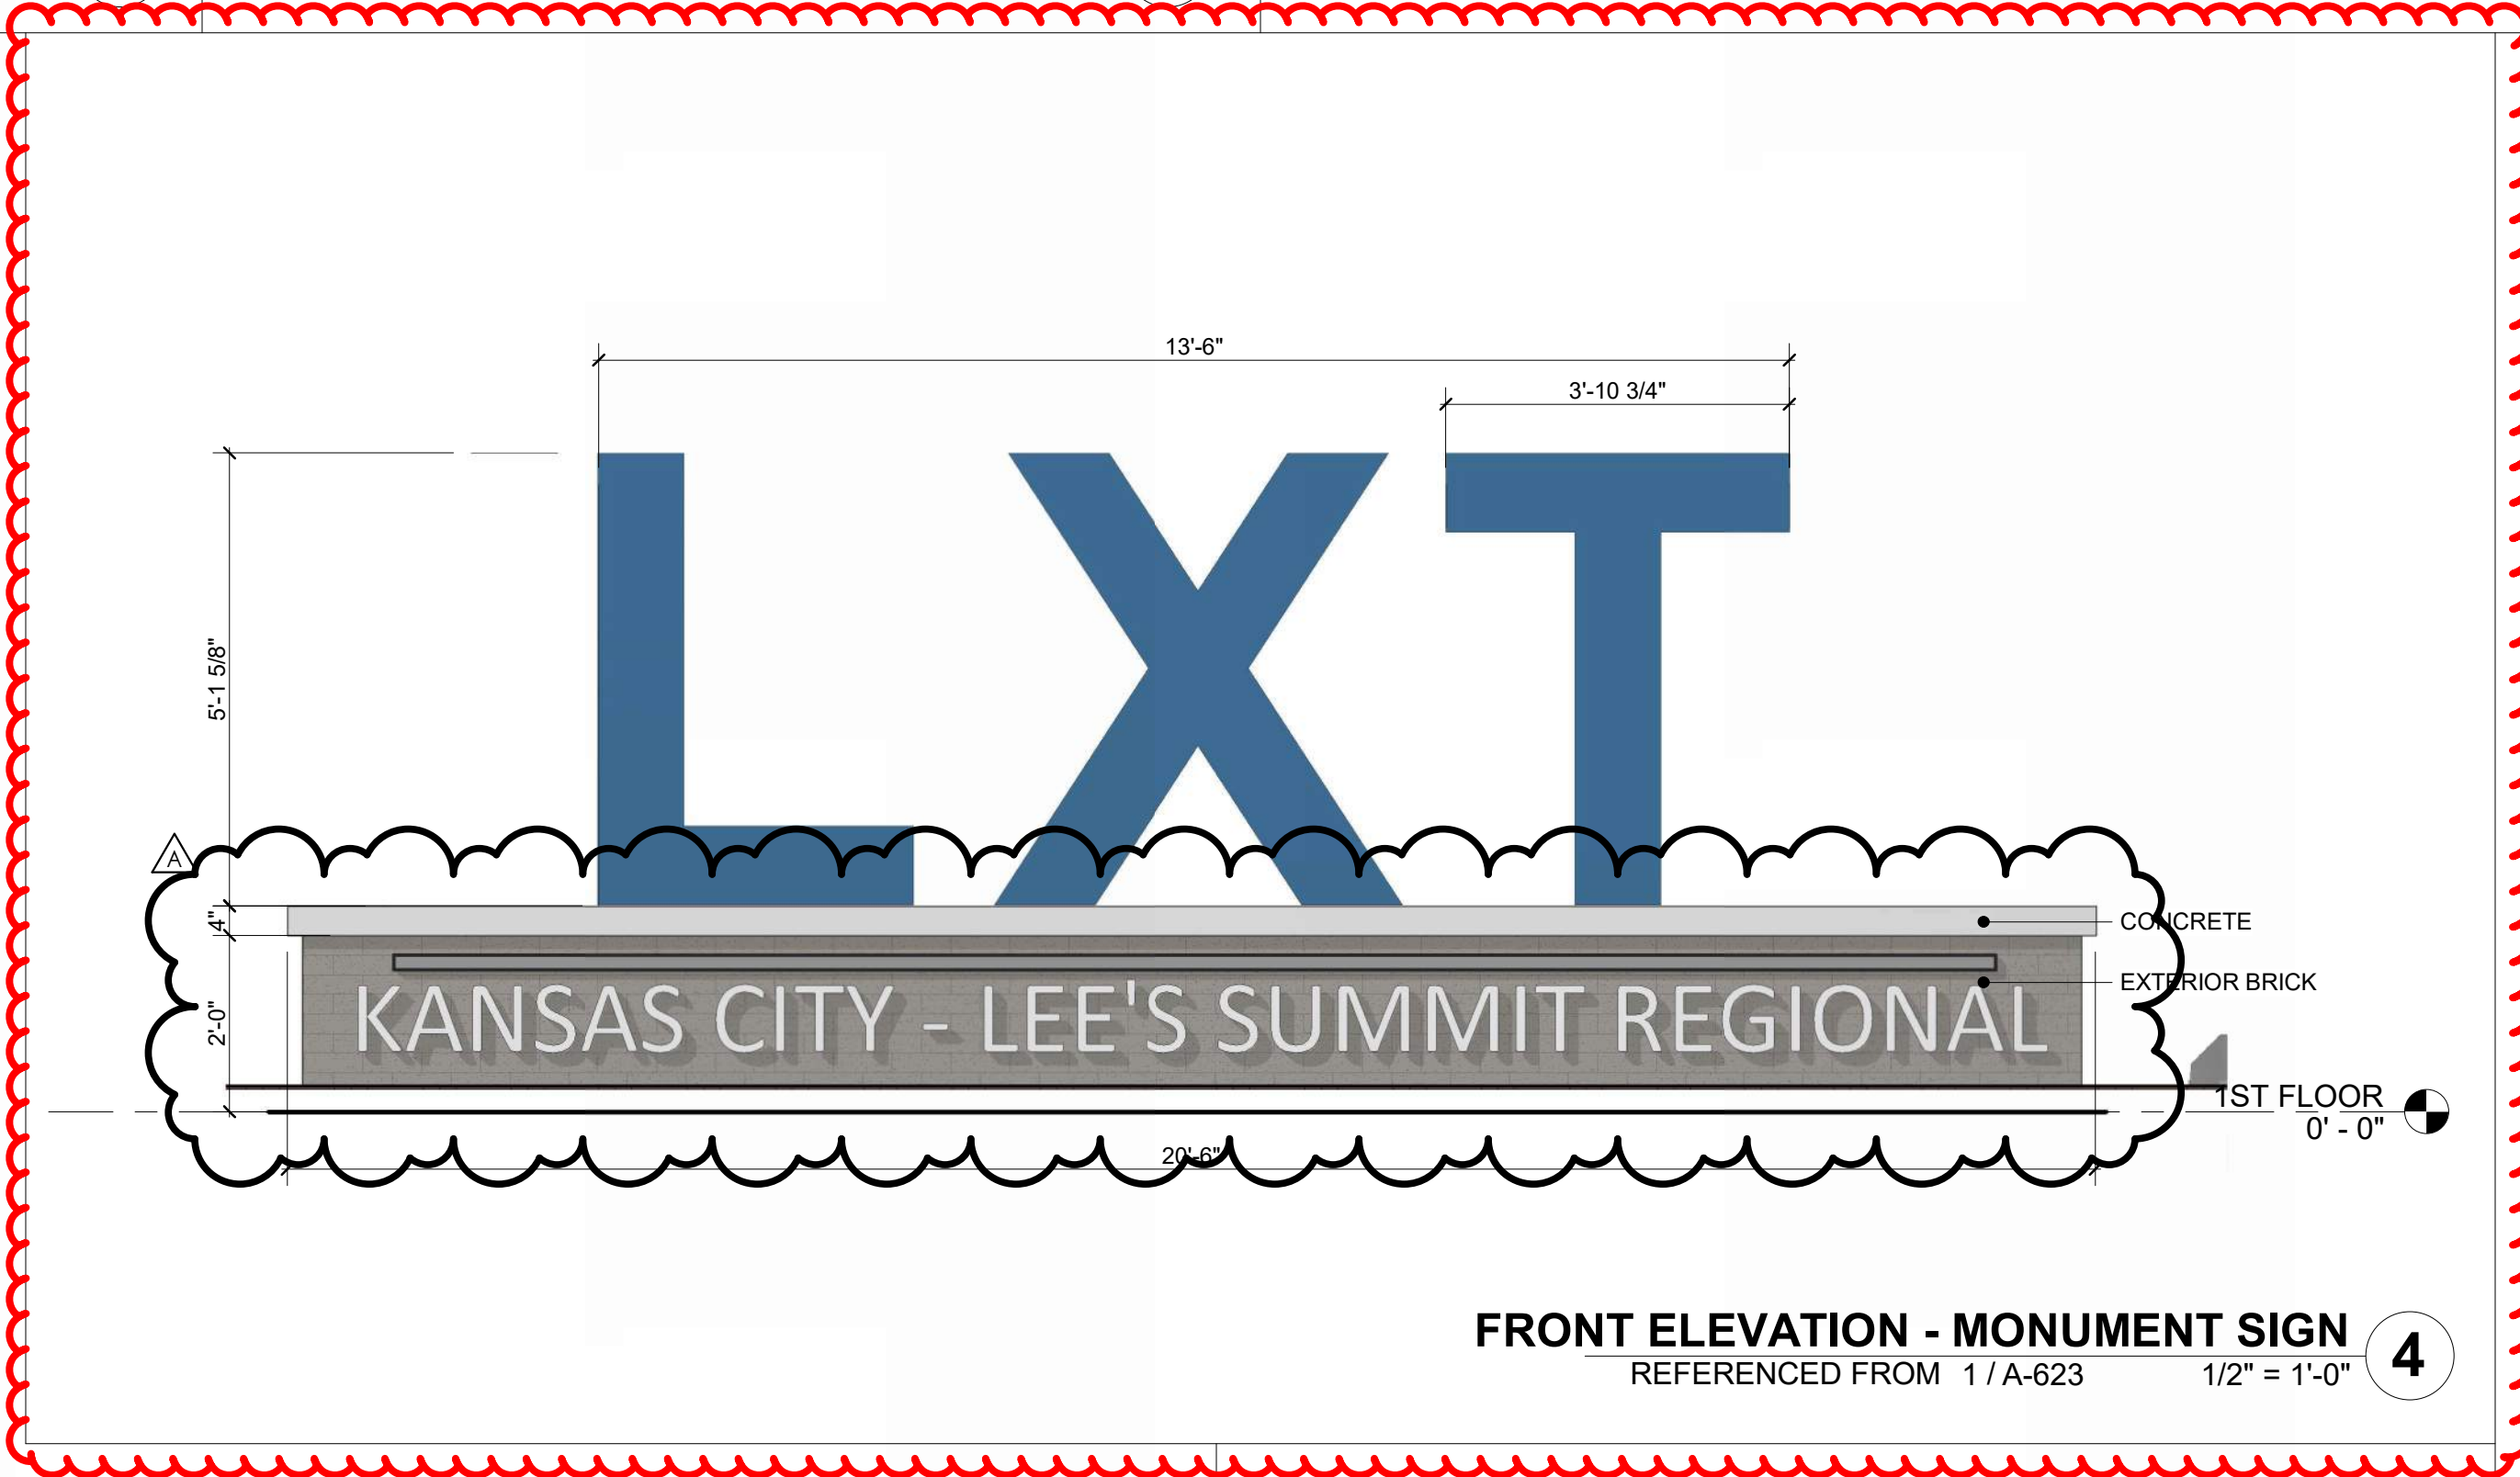


FRONT ELEVATION - MONUMENT SIGN 4
REFERENCED FROM 1 / A-623 1/2" = 1'-0"

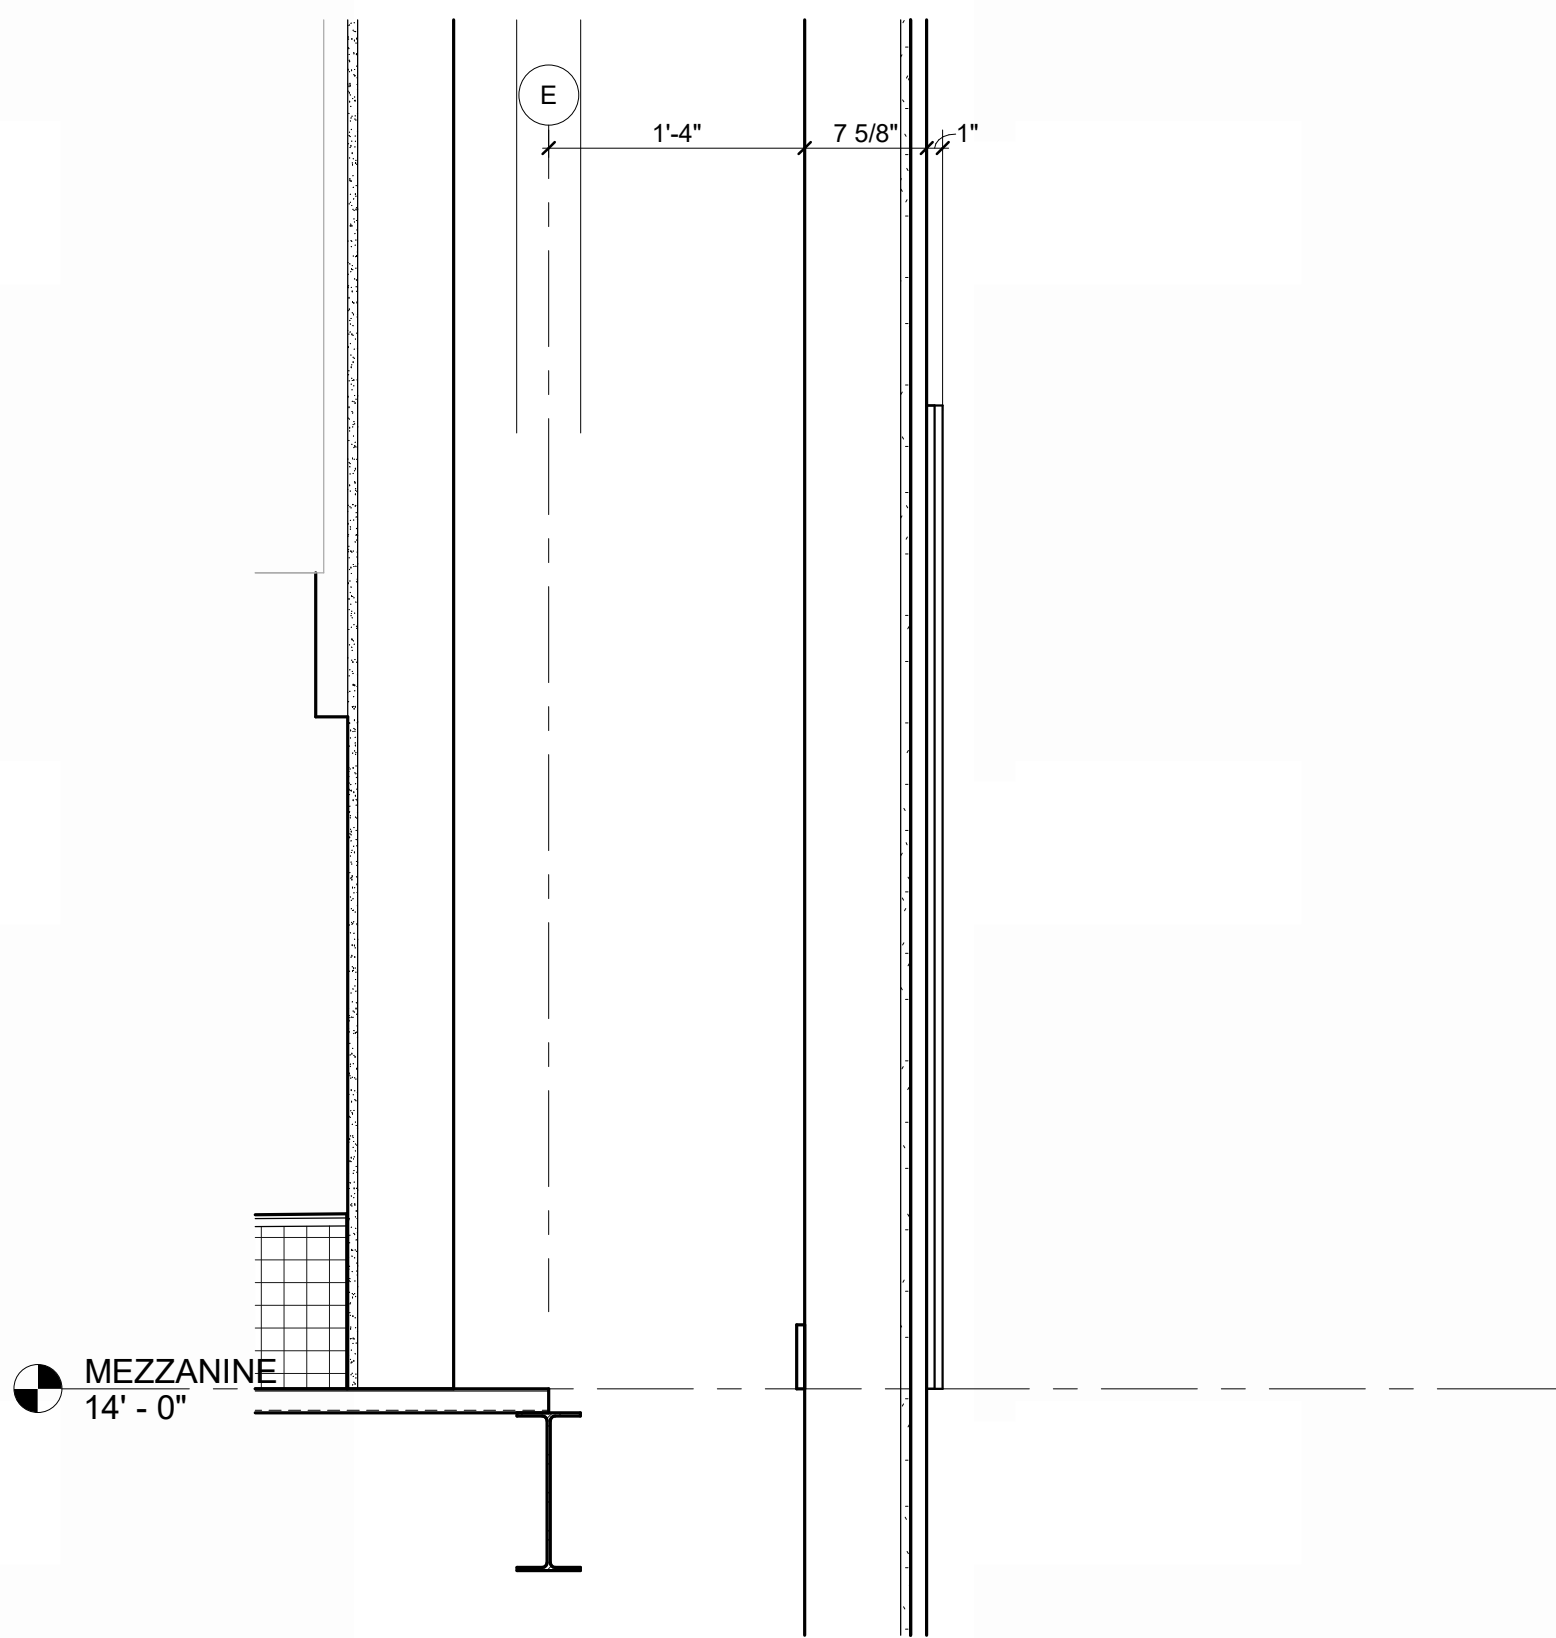

SECTION - INTERIOR LXT SIGNAGE 3
REFERENCED FROM 7 / A-623 1" = 1'-0"

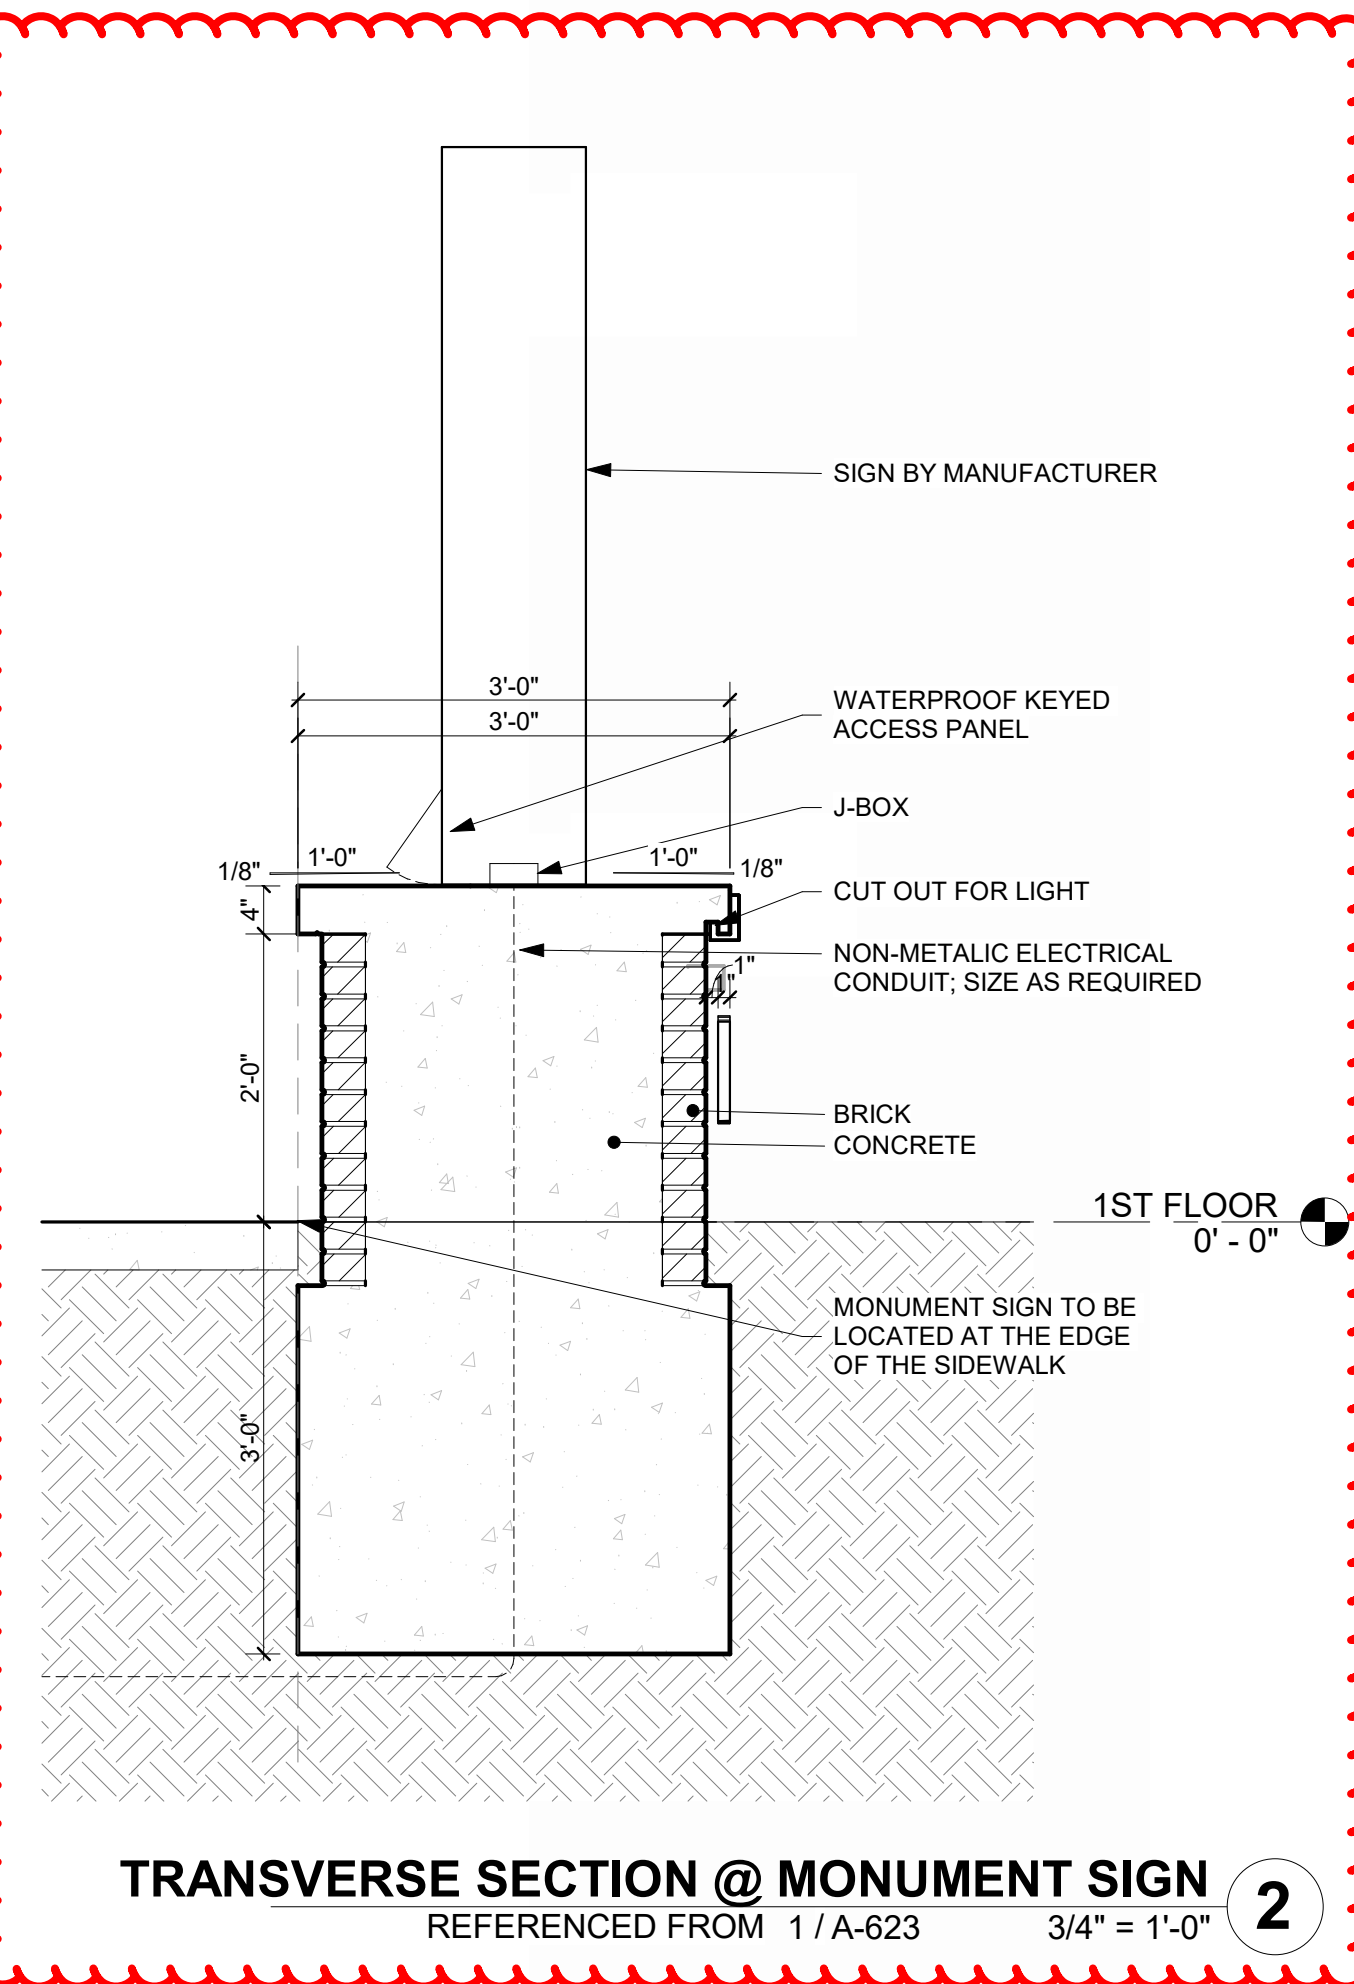

TRANSVERSE SECTION @ MONUMENT SIGN 2
REFERENCED FROM 1 / A-623 3/4" = 1'-0"

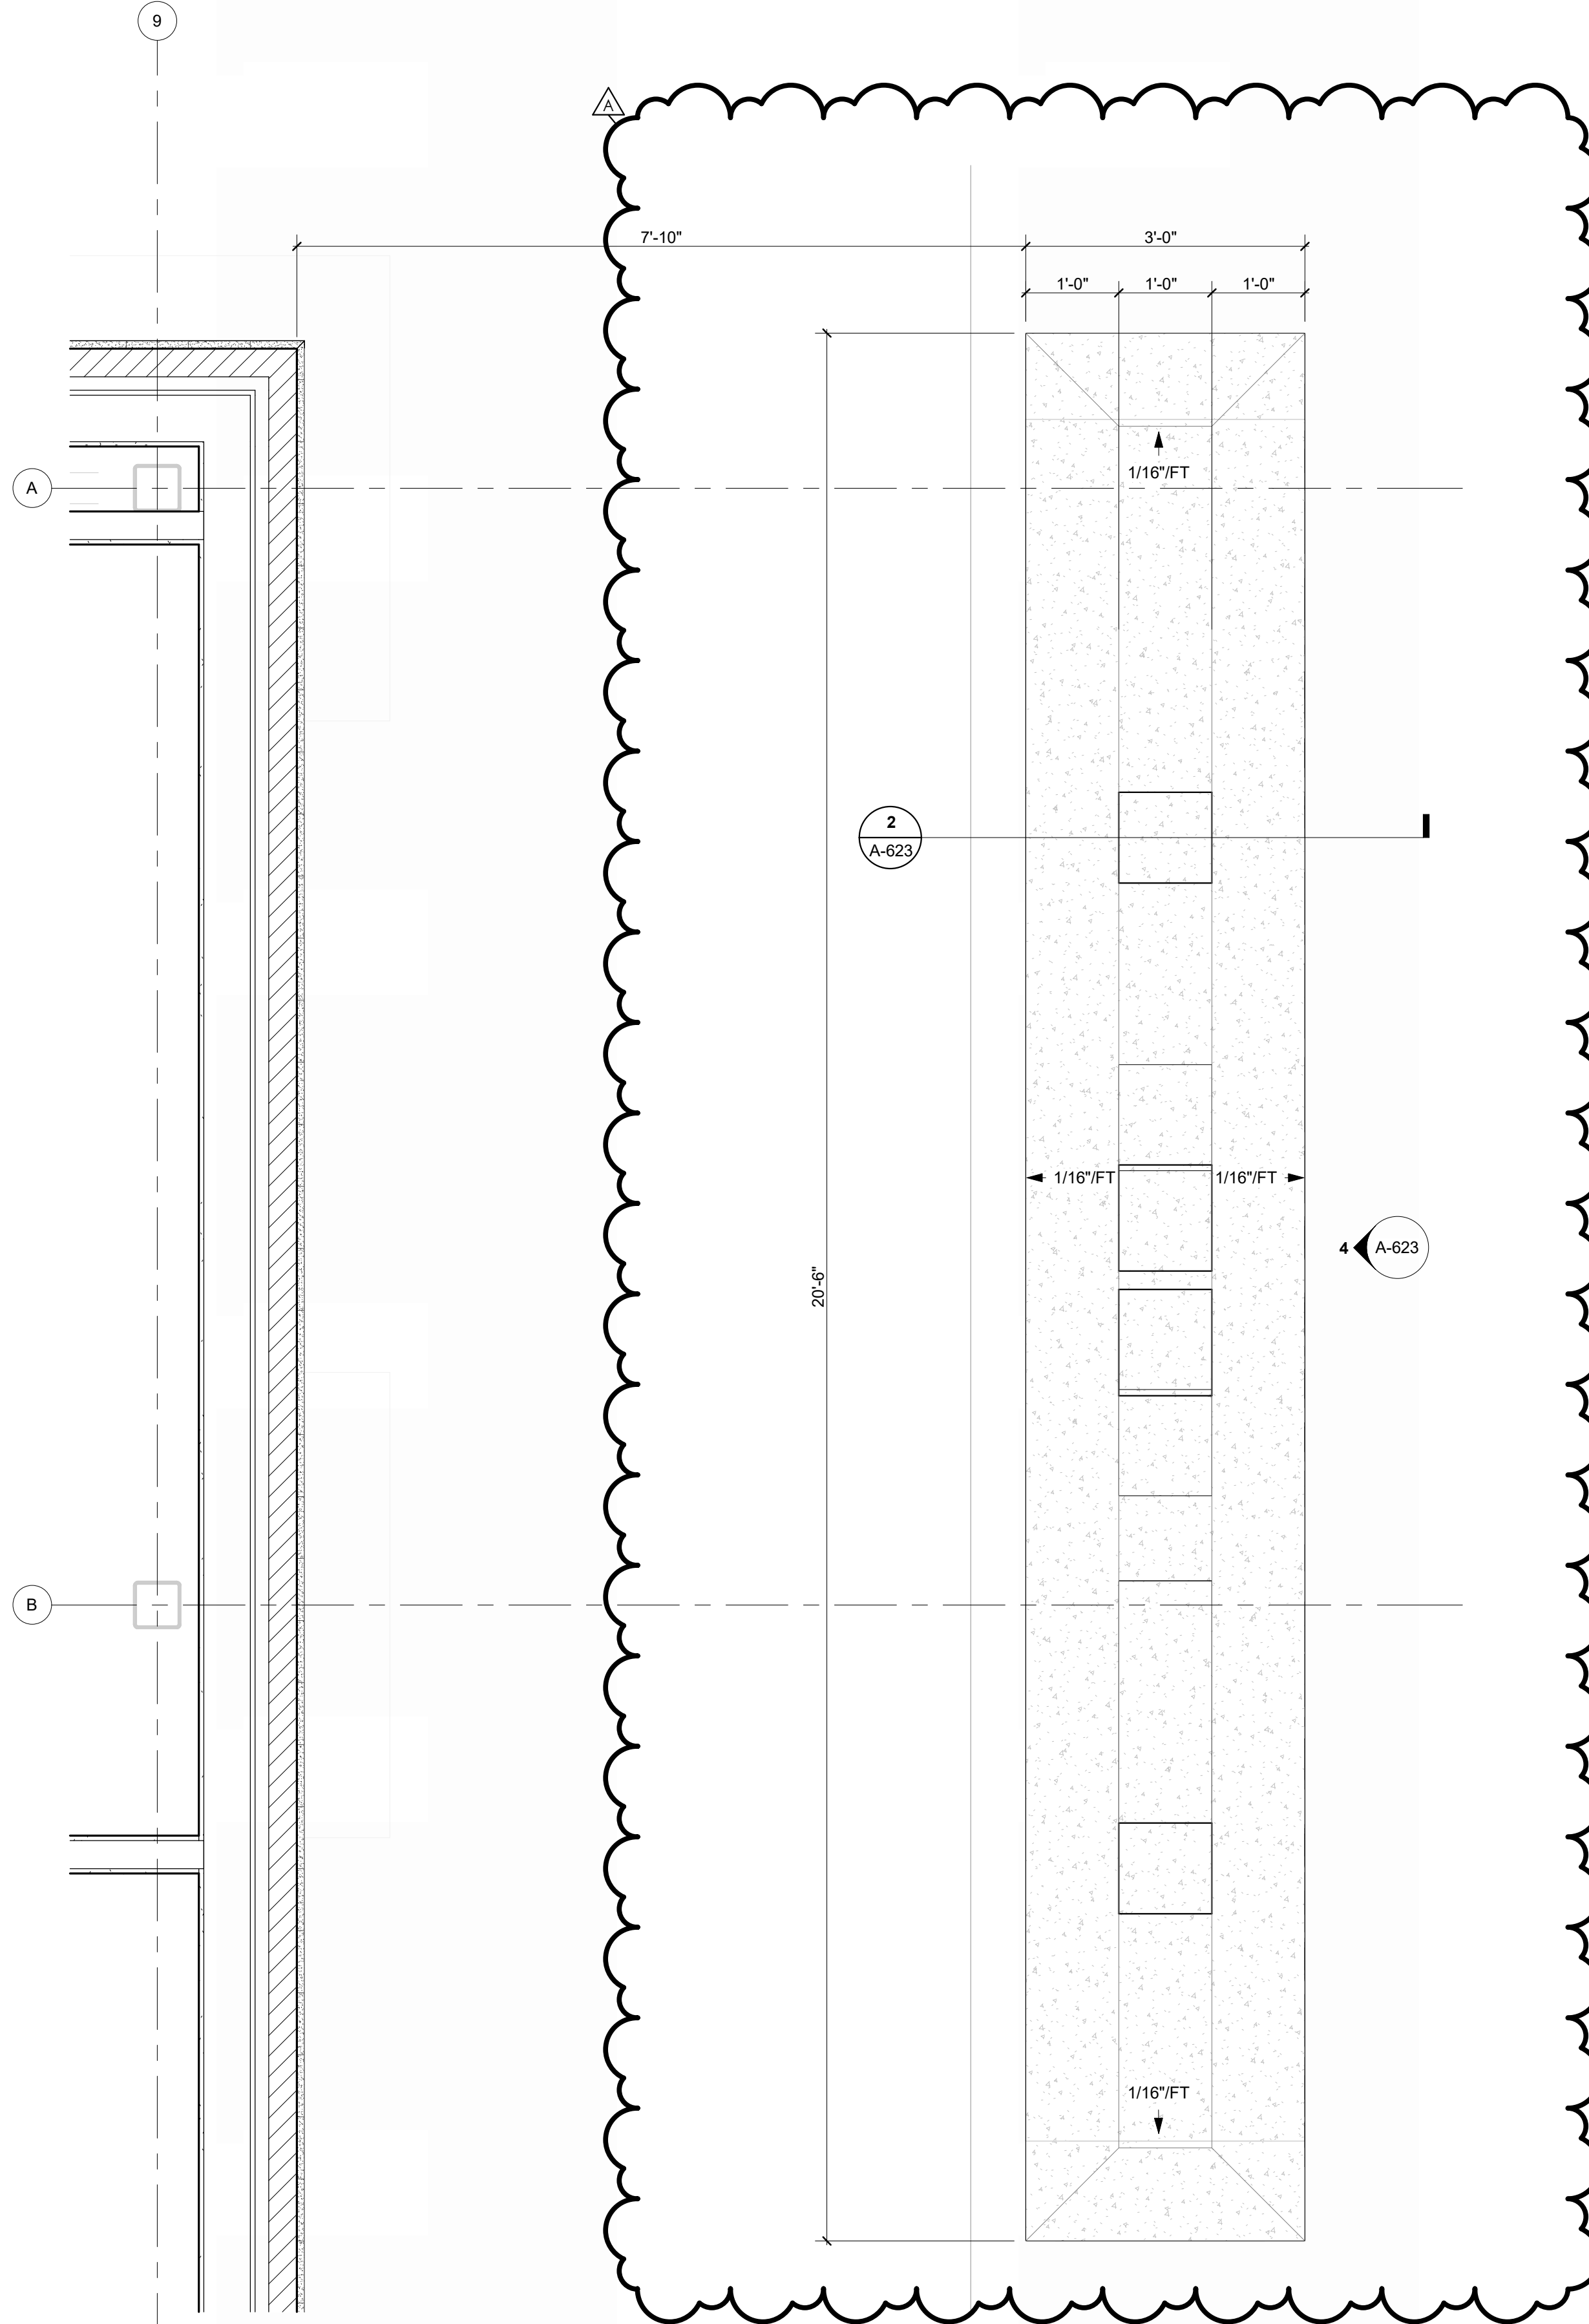

ENLARGED PLAN - MONUMENT SIGN 1
REFERENCED FROM 1 / A-101 3/4" = 1'-0"



1627 MAIN STREET, SUITE 600
KANSAS CITY, MO 64108



1627 MAIN STREET, SUITE 100
KANSAS CITY, MO 64108



1701 WALNUT STREET, SUITE 300
KANSAS CITY, MO 64108

KC - LEE'S SUMMIT REGIONAL
LEE'S SUMMIT, MISSOURI
GENERAL AVIATION TERMINAL
CITY PORJECT NO. - 17932172



LEES SUMMIT MUNICIPAL AIRPORT
LEES SUMMIT, MO


PROJECT NO: 2403
REVIT FILE: 2403 Lee's Summit Terminal-R24.rvt
DESIGNED BY: Designer
DRAWN BY: HUM
CHECKED BY: JSB
APPROVED BY: Approver
COPYRIGHT 2024

SHEET TITLE

EXTERIOR SIGNAGE

A-623

SHEET OF

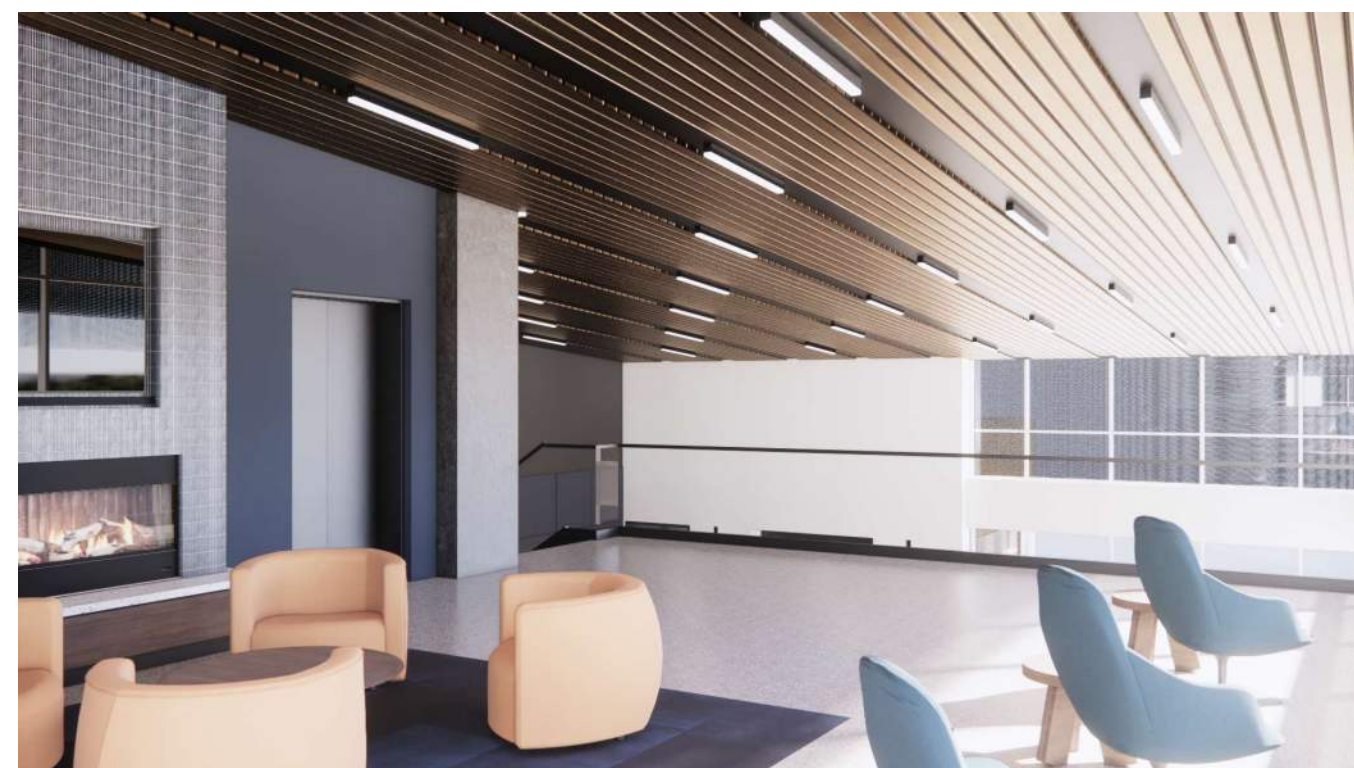

1627 MAIN STREET, SUITE 600
KANSAS CITY, MO 64108



1627 MAIN STREET, SUITE 100
KANSAS CITY, MO 64108



1701 WALNUT STREET, SUITE 300
KANSAS CITY, MO 64108

KC - LEE'S SUMMIT REGIONAL
LEE'S SUMMIT, MISSOURI
GENERAL AVIATION TERMINAL
CITY PORJECT NO. - 17932172



LEES SUMMIT MUNICIPAL AIRPORT
LEES SUMMIT, MO

MARK	DATE	DESCRIPTION
------	------	-------------

PROJECT NO:	2403
REVIT FILE:	2403 Lee's Summit Terminal-R24.rvt
DESIGNED BY:	Designer
DRAWN BY:	EM
CHECKED BY:	JSB
APPROVED BY:	Approver
COPYRIGHT	2024

SHEET TITLE

3D VIEWS

A-901

SHEET OF

A-623 EXTERIOR SIGNAGE

1. **REVISE** on enlarged plan 1- ENLARGED PLAN - MONUMENT SIGN adjust the size and dimensions.
2. **REVISE** on detail 4-FRONT ELEVATION - MONUMENT SIGN the building name to “Kansas City – Lee’s Summit Regional”.
3. **REVISE** on detail 5-ENLARGED ELEVATION, AIRSIDE SIGNAGE the building name to “Kansas City – Lee’s Summit Regional”.

SUPPLEMENTARY RENDERING



Thank you,

A handwritten signature in blue ink, appearing to read 'Jason Barker'.

Jason Barker AIA LEED® AP BD+C