


OSAGE
SECOND PLAT
STREET & STORM SEWER PLANS

NE 1/4 SECTION 35, TOWNSHIP 47 N, RANGE 32 W.
IN LEE'S SUMMIT, JACKSON COUNTY, MISSOURI

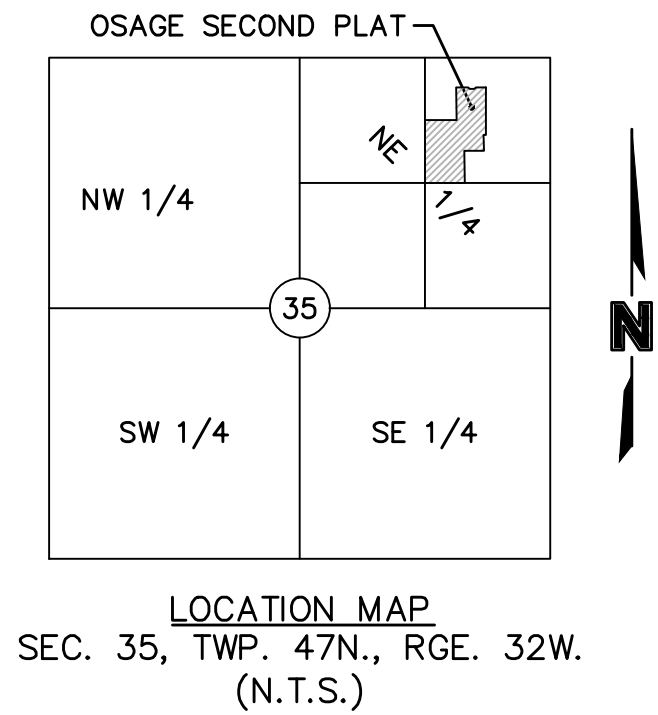

PROJECT TEAM & UTILITY CONTACT LIST	
OWNER / DEVELOPER CLAYTON PROPERTIES GROUP, INC. D.B.A. SUMMIT HOMES 120 SE 30TH STREET CONTACT: VINCENT WALKER LEE'S SUMMIT, MO 64082 PHONE: 816.246.6700 EMAIL: VINCENT@SUMMITHOMESKC.COM	UTILITY SERVICE NUMBERS NAME: LEE'S SUMMIT PUBLIC WORKS PHONE: 816-969-1800 NAME: LEE'S SUMMIT WATER & SERVICES DEPARTMENT PHONE: 816-969-1940 NAME: SPIRE (MGE) PHONE: 314-342-0500 NAME: AT&T PHONE: 800-286-8313 NAME: EVERGY PHONE: 816-471-5275 NAME: SPECTRUM (TWC) PHONE: 877-772-2253 NAME: GOOGLE FIBER PHONE: 877-454-6959
ENGINEER OLSSON 1301 BURLINGTON ST. SUITE 100 NORTH KANSAS CITY, MO 64116 CONTACT: JULIE SELLERS, PE PHONE: 816.361.1177 EMAIL: JSSELLERS@OLSSON.COM	
SURVEYOR OLSSON 1301 BURLINGTON ST. SUITE 100 NORTH KANSAS CITY, MO 64116 CONTACT: JASON ROUDEBUSH PHONE: 816.361.1177 EMAIL: JROUDEBUSH@OLSSON.COM	

☐ NOT FOR CONSTRUCTION

☒ REVIEWED FOR CONSTRUCTION



PROPERTY DESCRIPTION:

A tract of land in the Northeast Quarter of the Northeast Quarter of Section 35, Township 47 North, Range 32 West of the 5th Principal Meridian in Lee's Summit, Jackson County, Missouri being bounded and described by or under the direct supervision of Jeffrey P. Means P.L.S. 2000147866 as follows: Commencing at the Northeast corner of said Northeast Quarter; thence North 88°07'14" West, on the North line of said Northeast Quarter, 1,319.40 feet to the Northwest corner of the Northeast Quarter of said Northeast Quarter; thence leaving said North line, South 02°10'22" West, on the West line of said Northeast Quarter of said Northeast Quarter, 659.27 feet to the Southwest corner of the North Half of said Northeast Quarter of said Northeast Quarter, also being the Point of Beginning of the tract of land to be herein described; thence South 88°08'29" East, on South line of said North Half of said Northeast Quarter of said Northeast Quarter, 329.96 feet to the Southwest corner of the East Half of the Northwest Quarter of said Northeast Quarter of said Northeast Quarter; thence North 02°09'46" East, on the West line of said East Half of said Northwest Quarter of said Northeast Quarter of said Northeast Quarter, 346.14 feet to a point on the proposed Westerly line of OSAGE FIRST PLAT (LOTS 1 THRU 41, INCLUSIVE AND TRACTS A, B, C, D, E, F, G AND H; thence South 88°11'07" East, on said Westerly line, 127.17 feet; thence South 43°11'07" East, on said Westerly line, 19.80 feet; thence South 88°11'07" East, on said Westerly line, 50.00 feet; thence North 46°48'53" East, on said Westerly line, 19.80 feet; thence South 88°11'07" East, on said Westerly line, 106.00 feet; thence South 01°48'53" West, on said Westerly line, 500.00 feet; thence North 88°11'07" West, on said Westerly line, 21.62 feet; thence South 01°48'53" West, on said Westerly line, 170.00 feet; thence North 88°11'07" West, on said Westerly line, 202.50 feet; thence South 01°48'53" West, on said Westerly line, 335.30 feet to a point on the South line of said Northeast Quarter of said Northeast Quarter; thence North 88°09'45" West, on said South line, 423.24 feet to the Southwest corner of said Northeast Quarter of said Northeast Quarter; thence North 02°10'22" East, on the West line of said Northeast Quarter of said Northeast Quarter, 659.27 feet to the Point of Beginning. Containing 453,717 square feet or 10.42 acres, more or less.

BENCHMARK

BENCHMARK NO. 1
CHISELED PLUS ON THE EAST FLANGED BOLT OF THE FIRE HYDRANT ON THE WEST SIDE OF SW PRYOR ROAD ON ADJOINING PROPERTY SOUTH OF THE SOUTHWEST CORNER OF SUBJECT PROPERTY.
ELEVATION = 1014.830

BENCHMARK NO. 2
RAILROAD SPIKE IN THE NORTH FACE OF POWER POLE LOCATED ON THE SOUTH SIDE MISSOURI STATE HIGHWAY 150 AT THE WEST SIDE OF THE DRIVEWAY TO 2025 MISSOURI STATE HIGHWAY 150, LEE'S SUMMIT, MO.
ELEVATION = 1031.313

Sheet List Table



Sheet Number	Sheet Title
C101	TITLE SHEET
C102	GENERAL NOTES
C103	GENERAL LAYOUT
C104	TYPICAL SECTIONS
C105	GRADING PLAN (FOR REFERENCE ONLY)
C106	SWALE 1 PLAN & PROFILE
C107	SWALE 1 PLAN & PROFILE (CONT'D)
C108	SWALE 2 PLAN & PROFILE
C109	SWALE 3 PLAN & PROFILE
C110	ROADWAY PLAN & PROFILE (SW CLAYTON PLACE)
C111	ROADWAY PLAN & PROFILE (SW OSAGE DRIVE)
C112	ROADWAY PLAN & PROFILE (SW OSAGE DRIVE CONT'D)
C113	ROADWAY PLAN & PROFILE (SW RIVENGATE PLACE)
C114	ROADWAY PLAN & PROFILE (SW RUTHERFORD DRIVE)
C115	SW OSAGE DRIVE AND SW CLAYTON PLACE INTERSECTION
C116	SW OSAGE DRIVE AND SW RIVENGATE PLACE INTERSECTION
C117	SW RIVENGATE PLACE AND SW RUTHERFORD DRIVE INTERSECTION
C118	STORM SEWER PLAN & PROFILE (LINE 1)
C119	STORM SEWER PLAN & PROFILE (LINE 2)
C120	STORM SEWER PLAN & PROFILE (LINE 3)
C121	STORM SEWER PLAN & PROFILE (LINES 4 & 5)
C122	STORM SEWER PLAN & PROFILE (LINE 6)
C123	STORM SEWER PLAN & PROFILE (LINE 6 CONT'D)
C124	STORM SEWER PLAN & PROFILE (LINE 7)
C125	STORM SEWER PLAN & PROFILE (LINES 8 & 9)
C126	MASTER DRAINAGE PLAN
C127	DRAINAGE PLAN
C128	DRAINAGE TABLES
C129	DETAILS
C130	DETAILS (CONT'D)
C131	DETAILS (CONT'D)

OLSSON HAS BEEN RETAINED TO PROVIDE AS-BUILT DRAWINGS FOR THIS PROJECT.

Julie Sellers
JULIE SELLERS, P.E.
CIVIL ENGINEER
MO#2017000367

3/6/2025
DATE

ASBUILT
02-03-2022

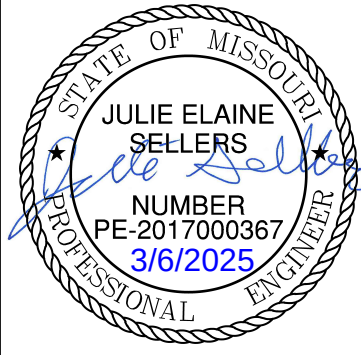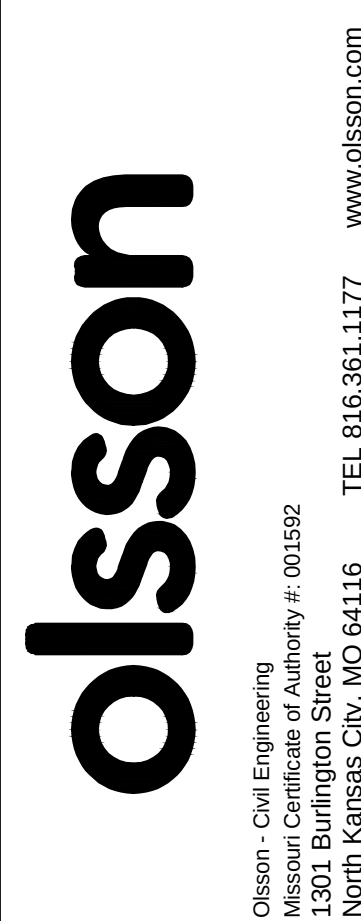

REV. NO.	DATE	REVISIONS DESCRIPTION
1	03.06.2025	REVISED PER LINE 9 PIPE SLOPE


TITLE SHEET STREET & STORM SEWER PLANS	OSAGE SECOND PLAT	2020
drawn by: D.F./M.O./A.A.	checked by: C.G.W.	designed by: A.A.
QA/QC by: J.E.S.	project no.: C19-2339	drawing no.: 2022.05.26
date:		
SHEET C101		

DWG: F:\2019\2001-2500\019-2339-CA 10-Design\AutoCAD\Final Plans - As-Built\Sheets\GNC\A STREET & STORM\AC_DEM01_C192339.dwg USER: esayder
DATE: May 26, 2022 7:32am XREFS: C_PBDY_C192339 C_PBASE_C192339 C_PSTRM_C192339 C_PSSWR_C192339 C_PWATR_C192339

Structure Table		
STRUCTURE ID	NORTHING	EASTING
C.I. 1-2	977598.7777	2811350.3990
C.I. 1-3	977608.0764	2811056.9286
C.I. 1-4	977642.5988	2811040.9780
C.I. 2-1	977712.5148	2811423.6554
C.I. 2-2	977711.4380	2811457.6384
C.I. 3-1	977468.0529	2811116.5240
C.I. 3-2	977486.1870	2811083.0816
C.I. 4-1	977326.0305	2811239.2055
C.I. 4-2	977319.1371	2811077.7885
C.I. 5-1	977292.0475	2811238.1288
C.I. 6-2	977158.1391	2811106.7044
C.I. 6-3	977159.2158	2811072.7214
C.I. 8-1	978110.2379	2811470.2744
C.I. 9-1	977632.7606	2811351.4758
EX C.I. 1	977320.8051	2811404.1227
EX C.I. 2	977588.7590	2811666.5942
EX C.I. 3	978147.4055	2811402.4174
EX C.I. 4	978150.5883	2811301.9679
EX F.I. 1	977145.2863	2811509.1437
EX F.I. 2	977150.3910	2811351.1993
EX F.I. 3	977453.5763	2811573.4124
EX F.I. 4	977460.3060	2811361.0190
EX F.I. 5	978052.0411	2811295.4838
EX F.I. 6	978111.3146	2811436.2915
F.I. 6-1	977155.8549	2811178.7819

Structure Table		
STRUCTURE ID	NORTHING	EASTING
F.I. 6-4	977163.6498	2810932.7838
F.I. 6-5	977331.7198	2810938.6323
F.I. 6-6	977490.5887	2810944.1607
F.I. 7-1	977786.8342	2811287.1599
F.I. 7-2	977794.6401	2811040.8007
M.H. 1-1	977596.5729	2811419.9818

NOT AS-BUILT

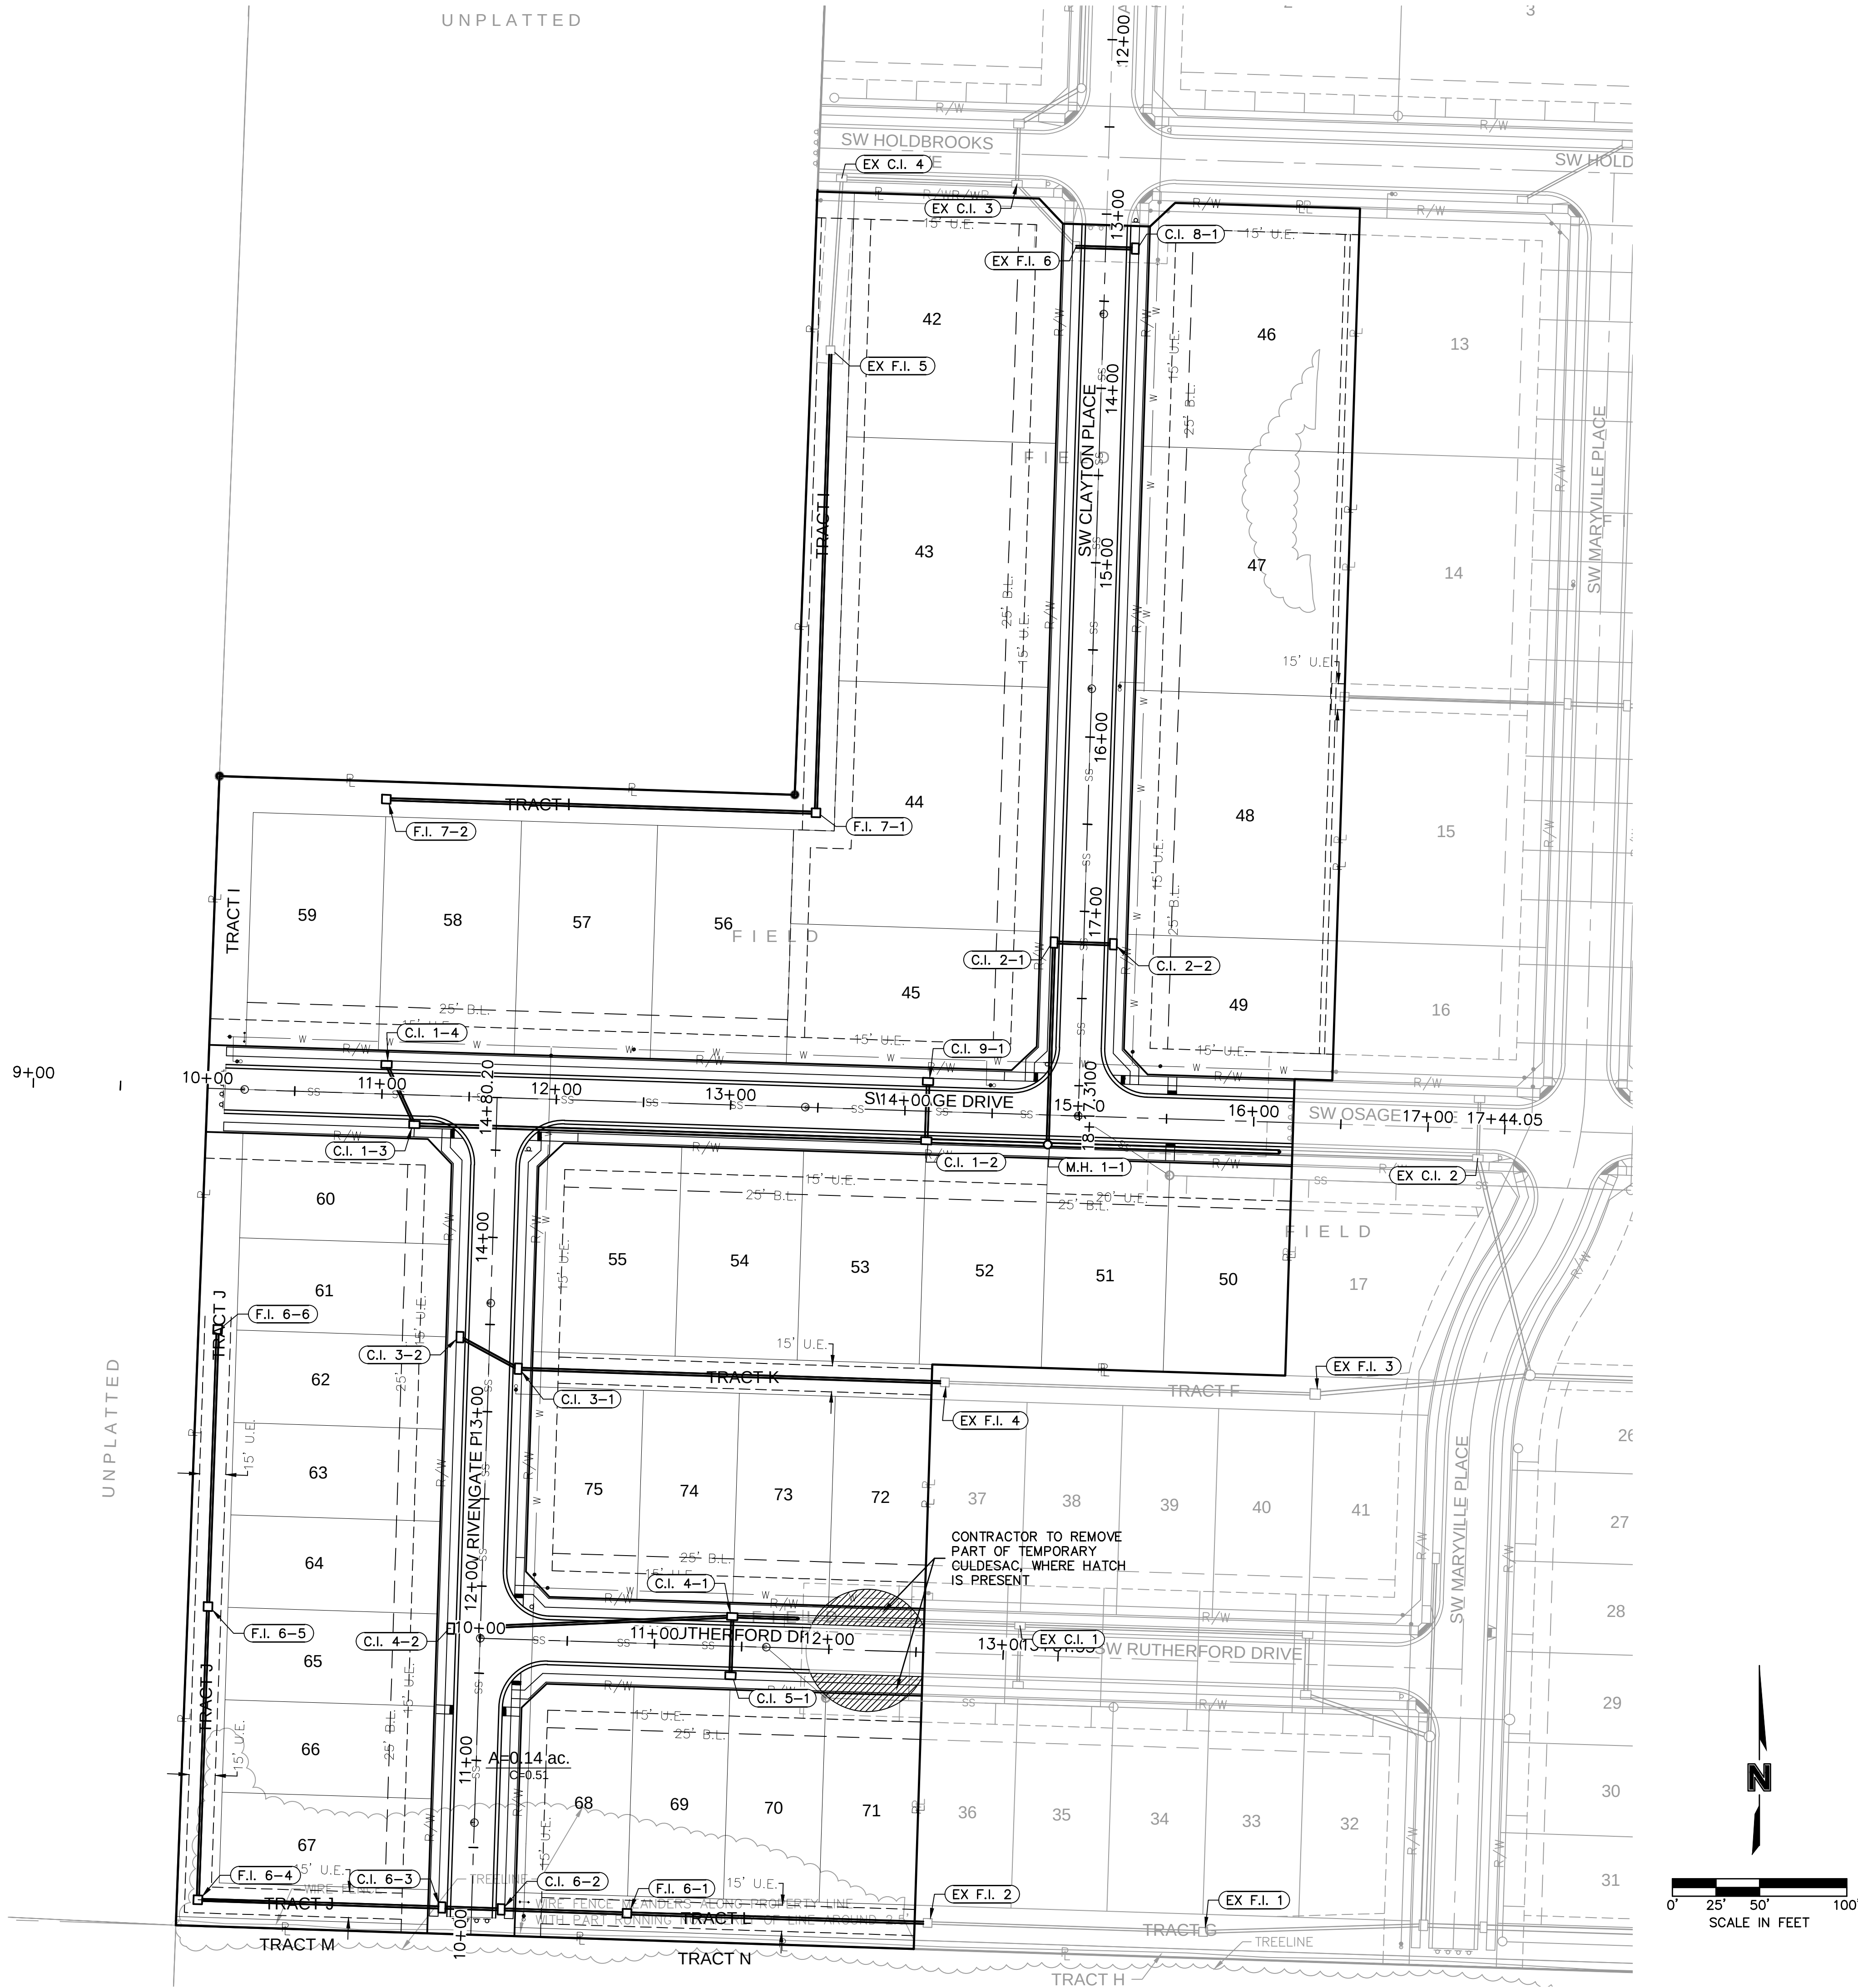

olsson

Olsson - Civil Engineering
Missouri Certificate of Authority #: 001592
1301 Burlington Street
North Kansas City, MO 64116
TEL 816.361.1177
www.olsson.com

STATE OF MISSOURI
JULIE ELAINE SELLERS
Professional Engineer
NUMBER PE-2017/000367
3/6/2025

REVISIONS


2020

GENERAL LAYOUT
STREET & STORM SEWER PLANS

OSAGE
SECOND PLAT


SHEET
C103

drawn by: D.F./M.O./A.A.
checked by: C.G.W.
designed by: A.A.
QA/QC by: J.E.S.
project no.: C19-2339
drawing no.:
date: 2022.05.26

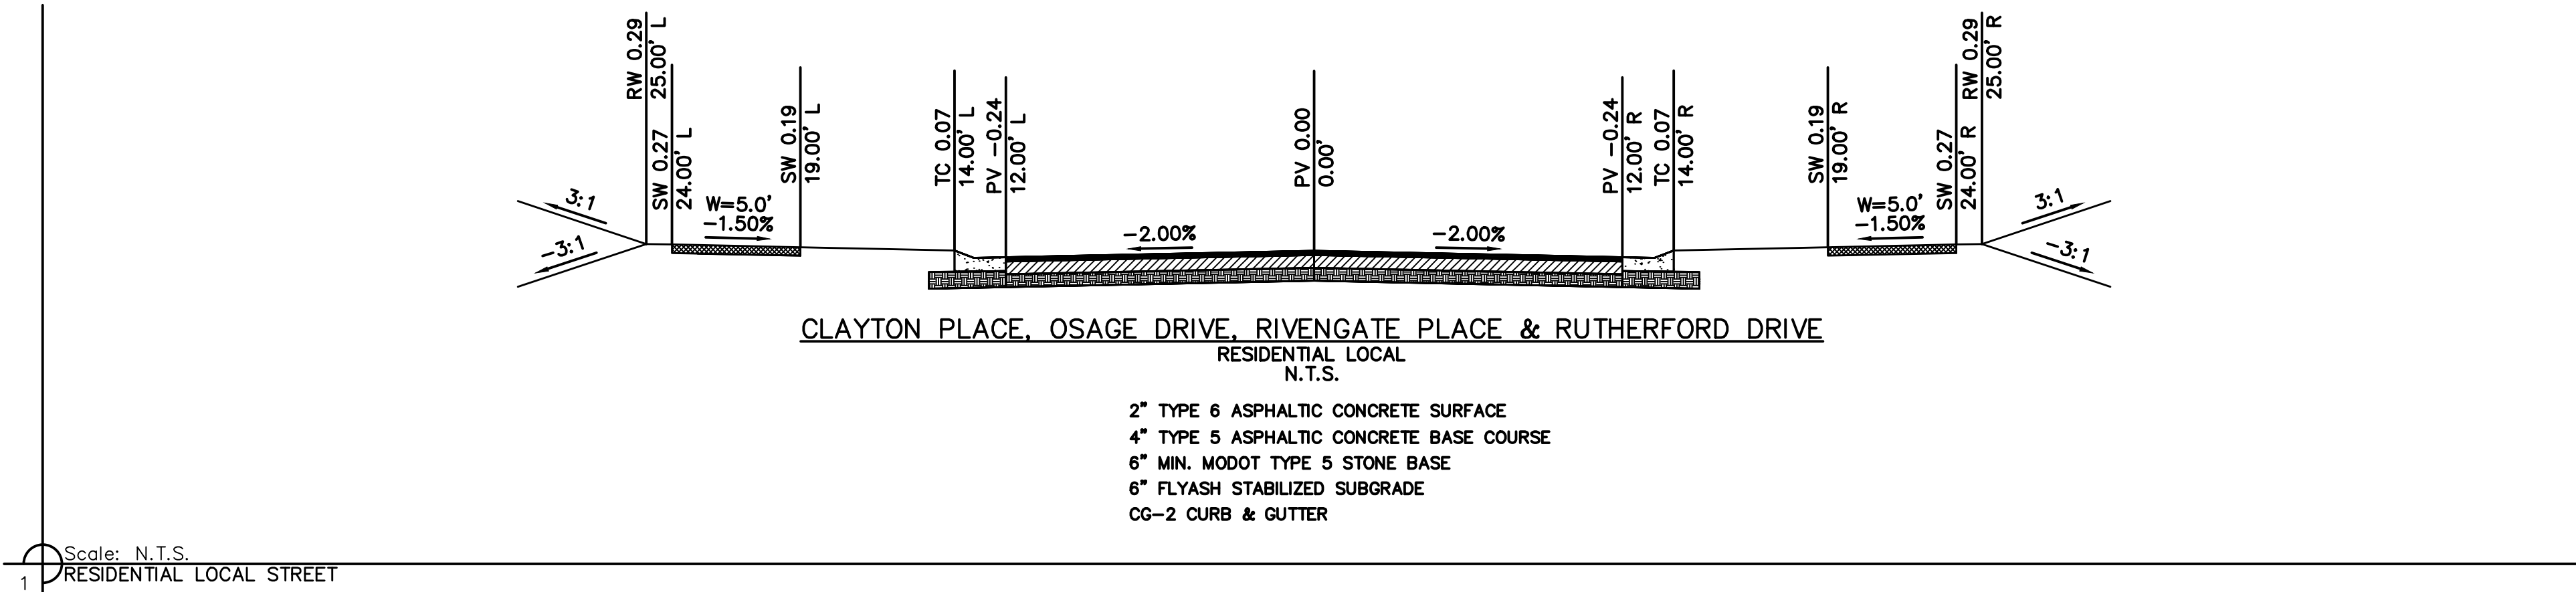

NOT AS-BUILT


drawn by: D.F./M.O./A.A. checked by: C.G.W. designed by: A.A. QA/QC by: J.E.S. project no.: C19-2339 drawing no.: date: 2022.05.26		TYPICAL SECTIONS STREET & STORM SEWER PLANS		REV. NO.	DATE	REVISIONS DESCRIPTION
OSAGE SECOND PLAT		2020		REVISIONS		
SHEET C104		 Olsson - Civil Engineering Missouri Certificate of Authority #: 001592 1301 Burlington Street North Kansas City, MO 64116 TEL 816.361.1177 www.olsson.com				

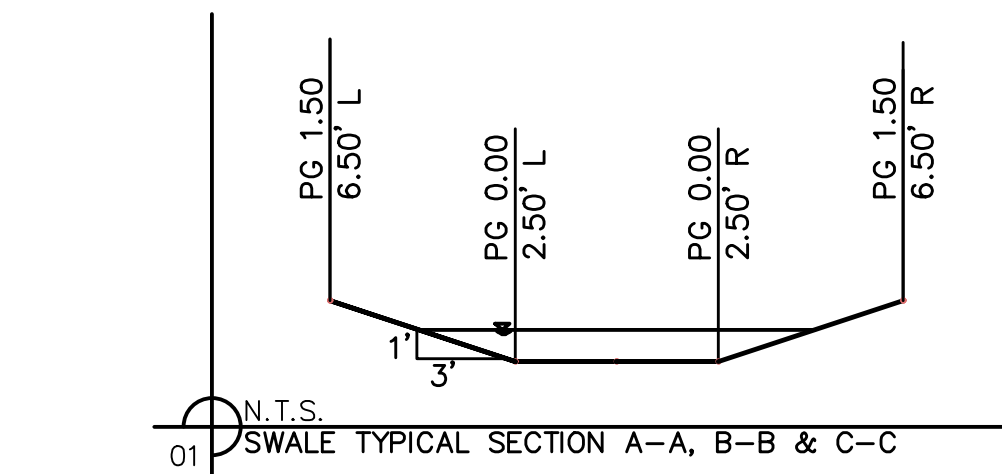

1. CONTRACTOR SHALL CONSTRUCT SWALES WITH MINIMUM SLOPE, WIDTH AND DEPTH AS SHOWN IN THE SWALE DESIGN TABLES.

2. AS-BUILT SURVEY IS REQUIRED/APPROVED BY CITY FOR ALL SWALES AND PRIOR TO APPROVAL FOR ANY BUILDING FOUNDATION PERMIT. CONTRACTOR SHALL BE REQUIRED TO REGRADE SWALES AT CONTRACTOR'S EXPENSE IF ABOVE REQUIREMENTS ARE NOT MET.

Section	Drainage Area	C	Tc	i	K	Peak Flow
	(ac.)		(min)	(in/hr)		(cfs)
A-A	1.18	0.51	5	10.32	1.25	7.76
B-B	3.36	0.51	5	10.32	1.25	22.11
C-C	0.92	0.51	9.16	10.32	1.25	6.05


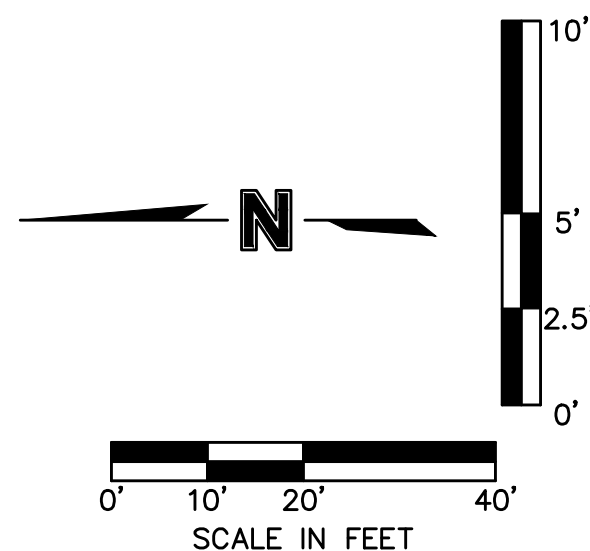


NOT AS-BUILT
PER OSAGE 3RD PLAT PLANS,
SWALE WAS ELIMINATED DUE
TO REDUCTION IN DRAINAGE
AREA. OSAGE 3RD PLAT IS
ACTIVELY UNDER
CONSTRUCTION AT TIME OF
THESE AS-BUILTS

DWG: F:\2019\2001-2500\019-2339-C140-Design\AutoCAD\Final Plans - As-Built\Sheets\GNC\A\STREET & STORM\C_SWL01_C192339.dwg USER: aswilder
DATE: May 26, 2022 7:34am XREFS: C_PBASE_C192339 C_PBN0Y_C192339 C_PBLK_C192339 C_PSTRM_C192339 C_PSSWR_C192339 C_PWATR_C192339 C_PSURF_C192339



SWALE GRADING NOTES:

1. CONTRACTOR SHALL CONSTRUCT SWALES WITH MINIMUM SLOPE, WIDTH AND DEPTH AS SHOWN IN THE SWALE DESIGN TABLES.
2. AS-BUILT SURVEY IS REQUIRED/APPROVED BY CITY FOR ALL SWALES AND PRIOR TO APPROVAL FOR ANY BUILDING FOUNDATION PERMIT. CONTRACTOR SHALL BE REQUIRED TO REGRADE SWALES AT CONTRACTOR'S EXPENSE IF ABOVE REQUIREMENTS ARE NOT MET.

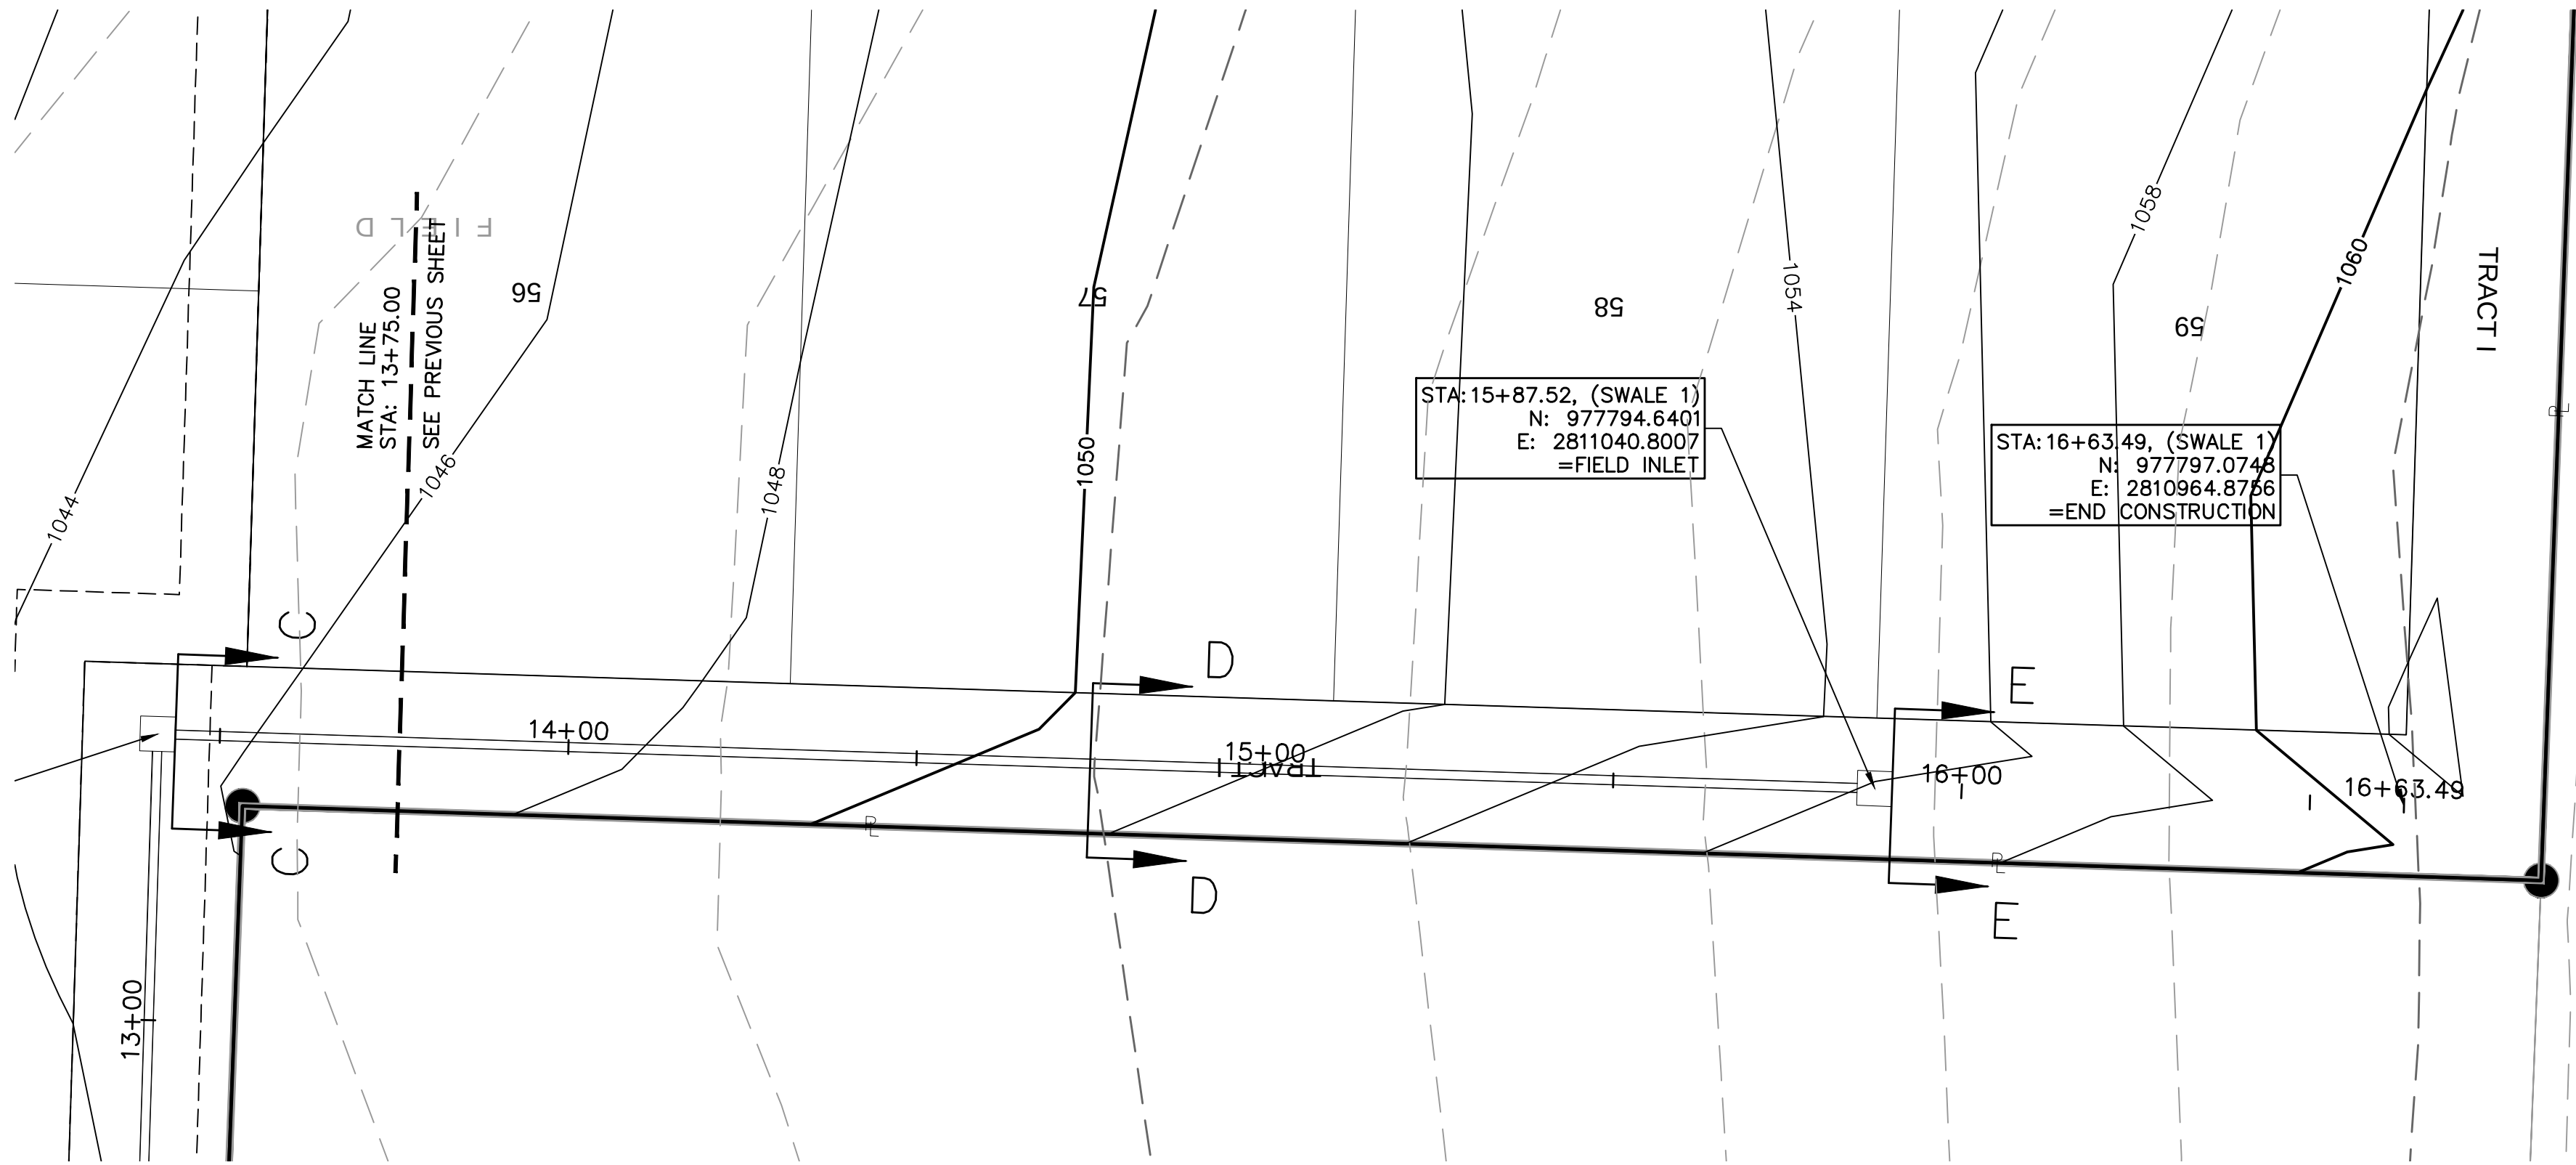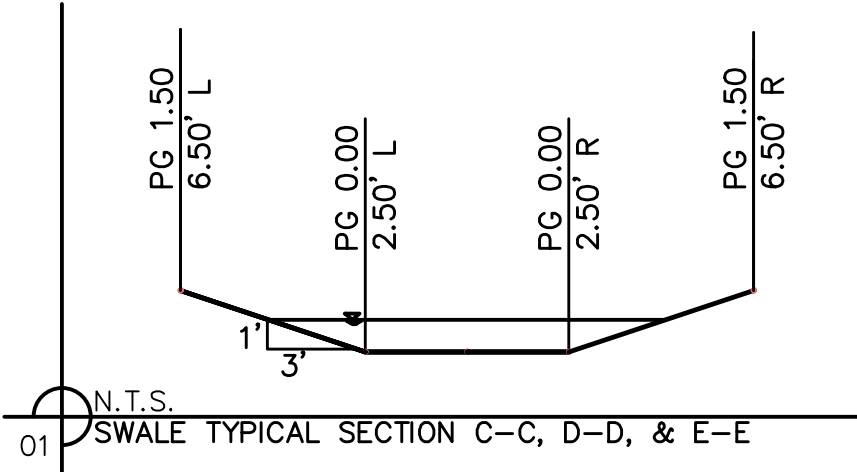

SWALE DESIGN TABLE (100-YEAR RETURN FREQUENCY)												
SECTION DATA							RESULTS					
SECTION	Mannings Coefficient	Channel Slope (%)	Swale Depth (ft)	Left Side Slope (H:V)	Right Side Slope (H:V)	Bottom Width (ft)	Discharge (cfs)	Water Depth (ft)	Flow Area (ft²)	Velocity (ft/sec)	Wetted Perimeter (ft)	Top Width (ft)
C-C	0.03	2.75%	1.5	3:1	3:1	5	6.05	0.31	1.84	3.29	6.96	6.86
D-D	0.03	5.23%	1.5	3:1	3:1	5	1.64	0.12	0.64	2.55	5.76	5.72
E-E	0.03	5.23%	1.5	3:1	3:1	5	1.71	0.13	0.70	2.44	5.82	5.78

Swale Drainage Area Table (100 year Return Frequency)					
Section	Drainage Area (ac.)	C	Tc (min)	i (in/hr)	K
C-C	0.92	0.51	9.16	10.32	1.25
D-D	0.25	0.51	9.16	10.32	1.25
E-E	0.26	0.51	5.00	10.32	1.25

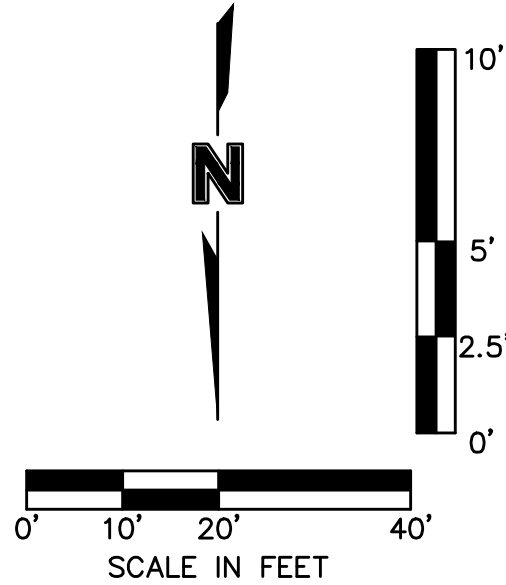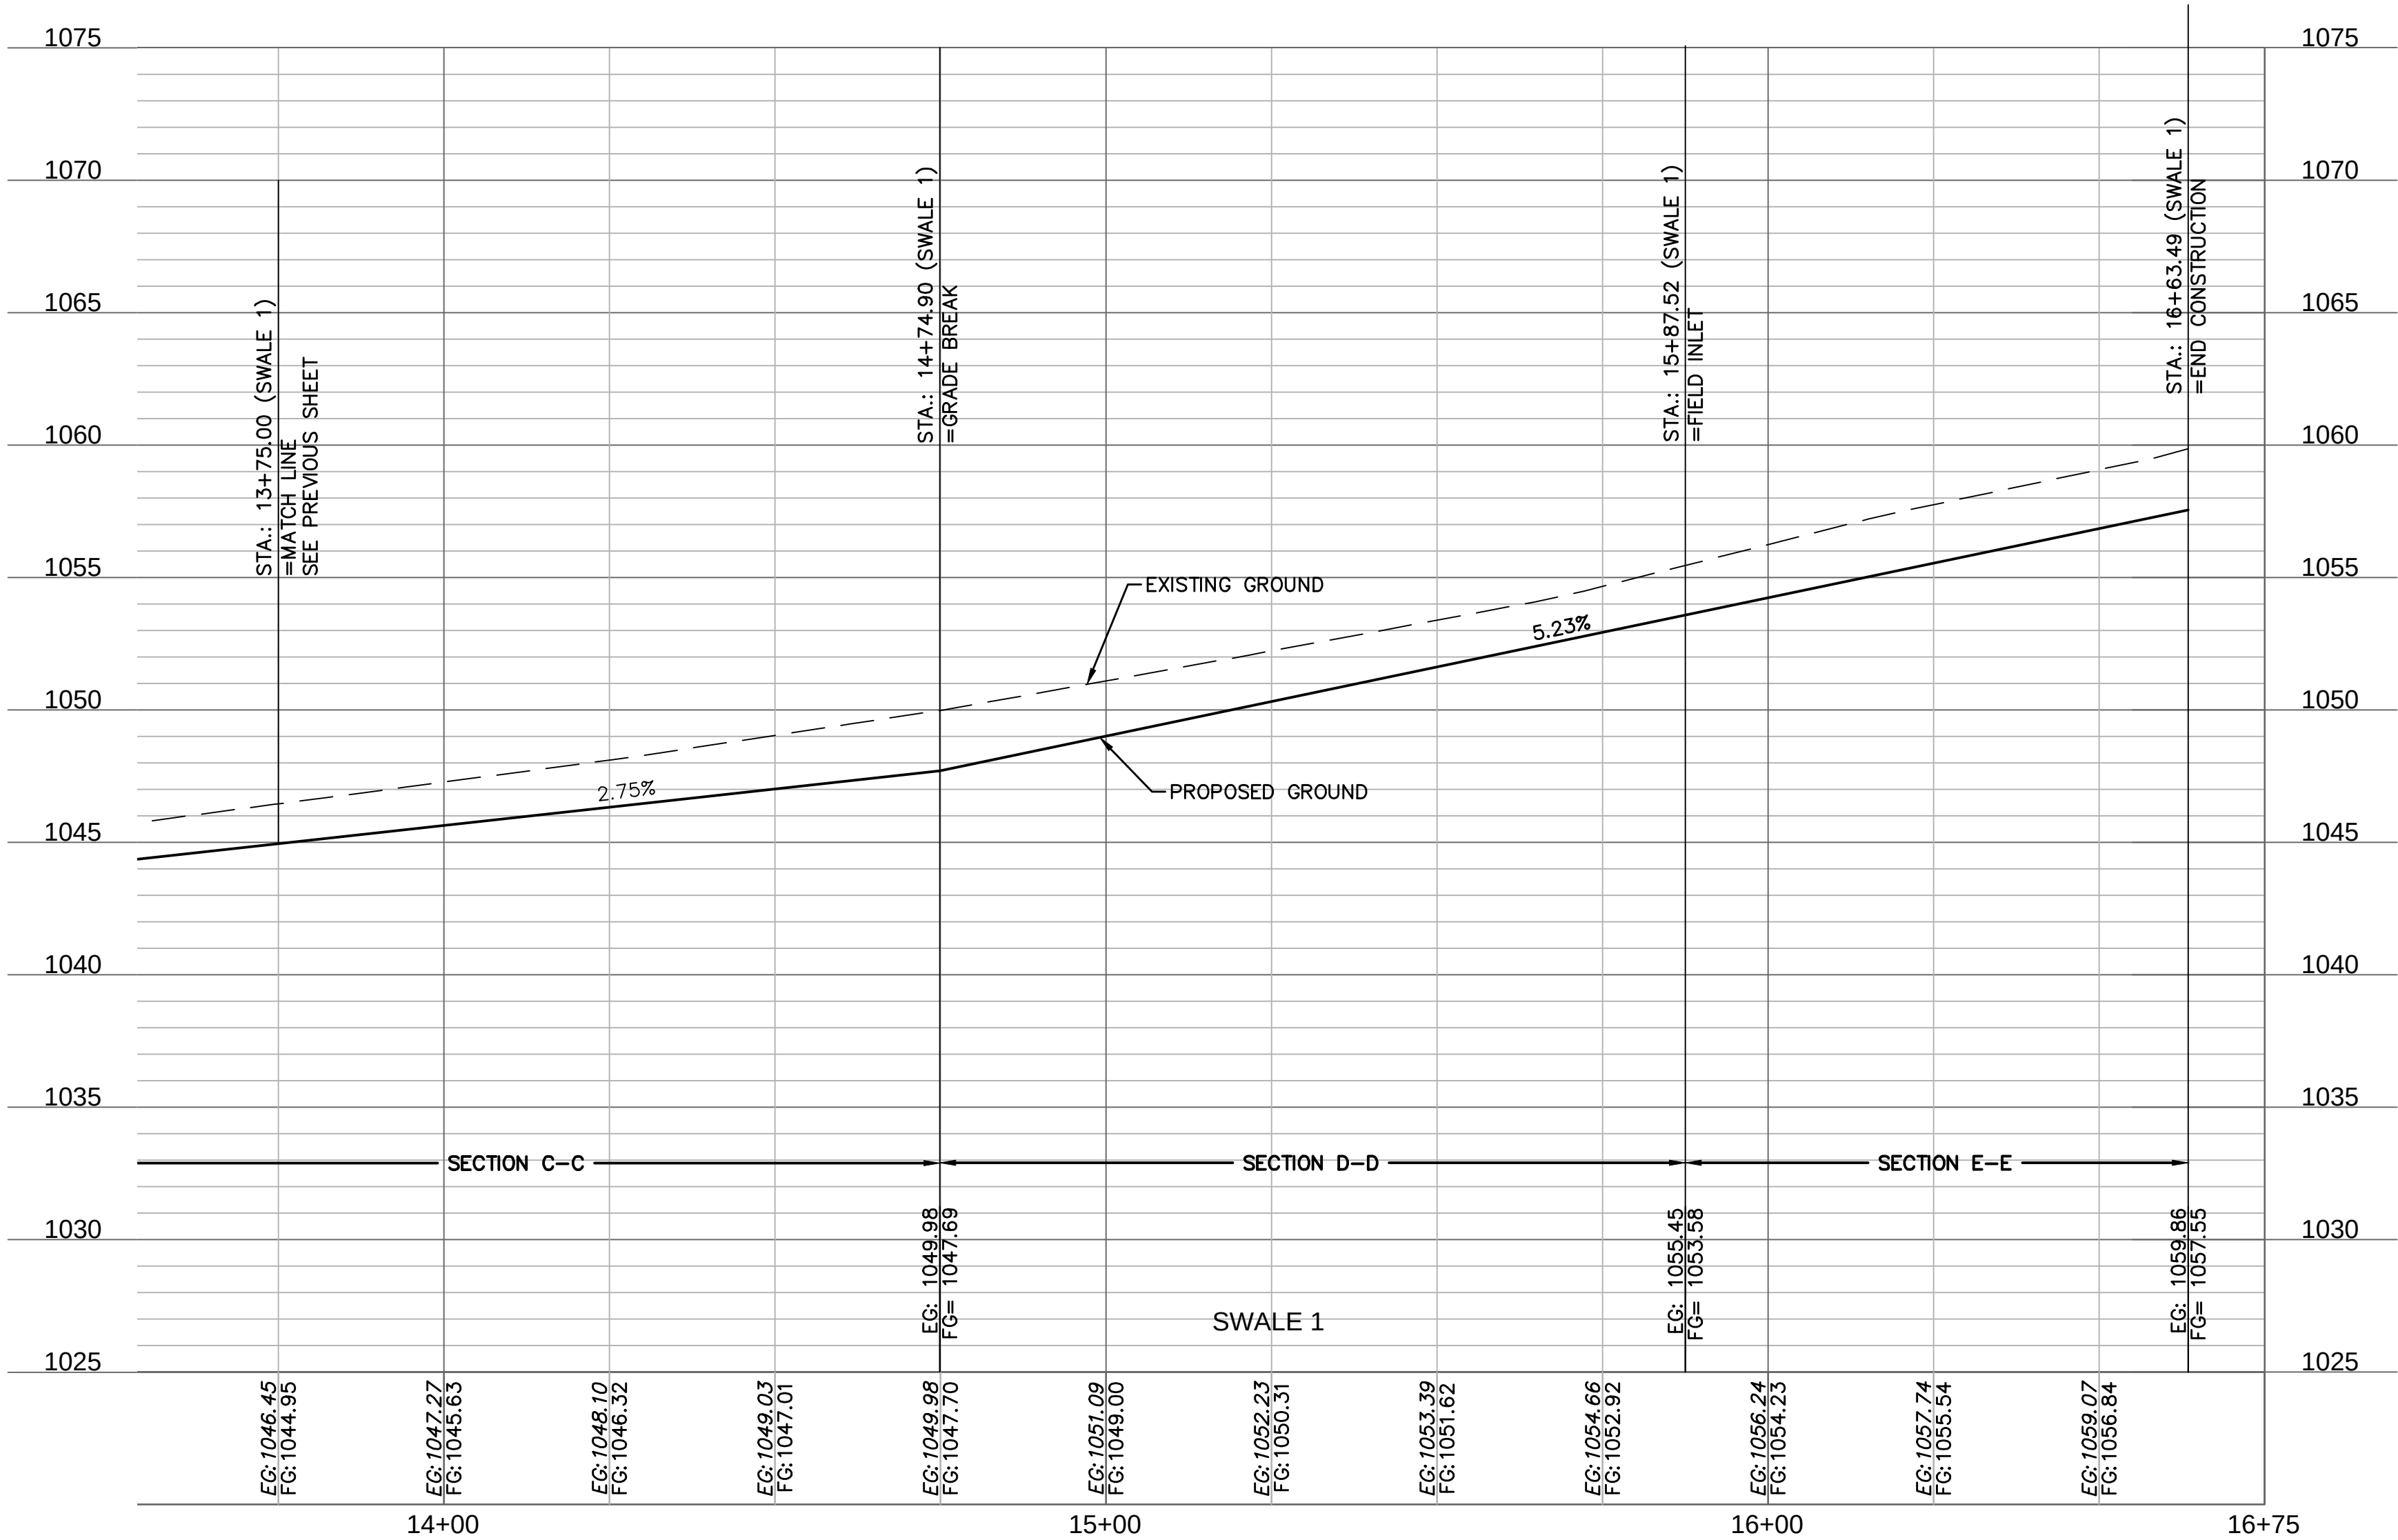

NOT AS-BUILT
PER OSAGE 3RD PLAT PLANS,
SWALE WAS ELIMINATED DUE
TO REDUCTION IN DRAINAGE
AREA. OSAGE 3RD PLAT IS
ACTIVELY UNDER
CONSTRUCTION AT TIME OF
THESE AS-BUILTS

olsson

Olsson - Civil Engineering
Missouri Certificate of Authority #: 001592
1301 Burlington Street
North Kansas City, MO 64116
TEL 816.361.1177
www.olsson.com

STATE OF MISSOURI
JULIE ELAINE
SELLERS
Professional Engineer
NUMBER
PE-2017/000367
3/6/2025

SWALE 1 PLAN & PROFILE (CONT'D)
STREET & STORM SEWER PLANS
OSAGE
SECOND PLAT

2020

drawn by: D.F./M.O./A.A.
checked by: C.G.W.
designed by: A.A.
QA/QC by: J.E.S.
project no.: C19-2339
drawing no.:
date: 2022.05.26



SHEET
C107

REVISIONS

DWG: F:\2019\2001-2500\019-2339-C140-Design\AutoCAD\Final Plans - As-Built\Sheets\GNCV\STREET & STORM\C_SWL01_C192339.dwg
DATE: May 26, 2022 7:34am
USER: esnyder
C_PSSWR_C192339 C_PWATR_C192339 C_PSTRM_C192339 C_PBLK_C192339 C_PBNY_C192339 C_PBASE_C192339 XREFS: C_PBASE_C192339

SWALE GRADING NOTES:

1. CONTRACTOR SHALL CONSTRUCT SWALES WITH MINIMUM SLOPE, WIDTH AND DEPTH AS SHOWN IN THE SWALE DESIGN TABLES.
2. AS-BUILT SURVEY IS REQUIRED/APPROVED BY CITY FOR ALL SWALES AND PRIOR TO APPROVAL FOR ANY BUILDING FOUNDATION PERMIT. CONTRACTOR SHALL BE REQUIRED TO REGRADE SWALES AT CONTRACTOR'S EXPENSE IF ABOVE REQUIREMENTS ARE NOT MET.

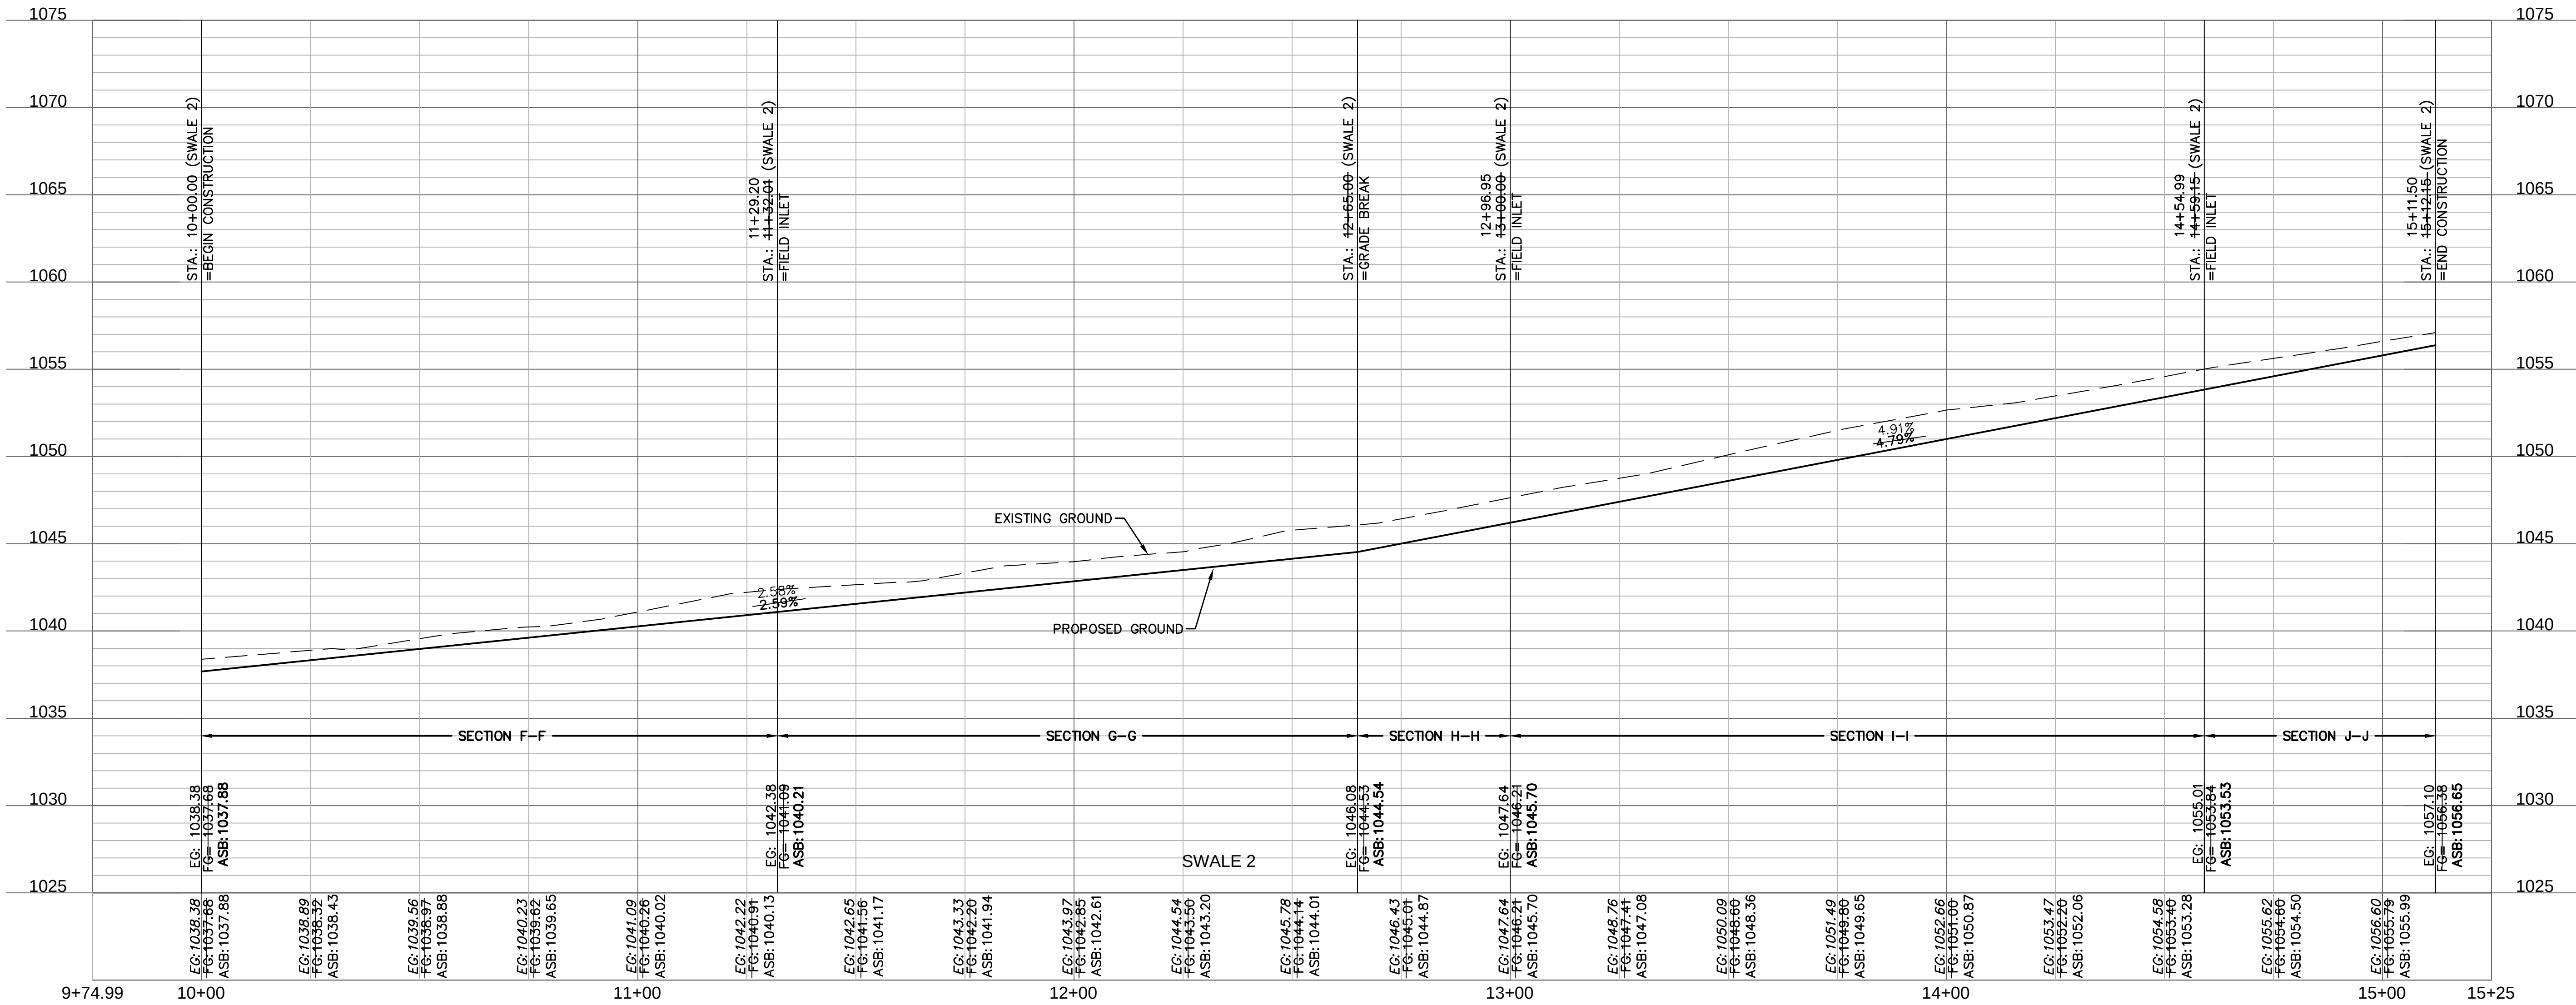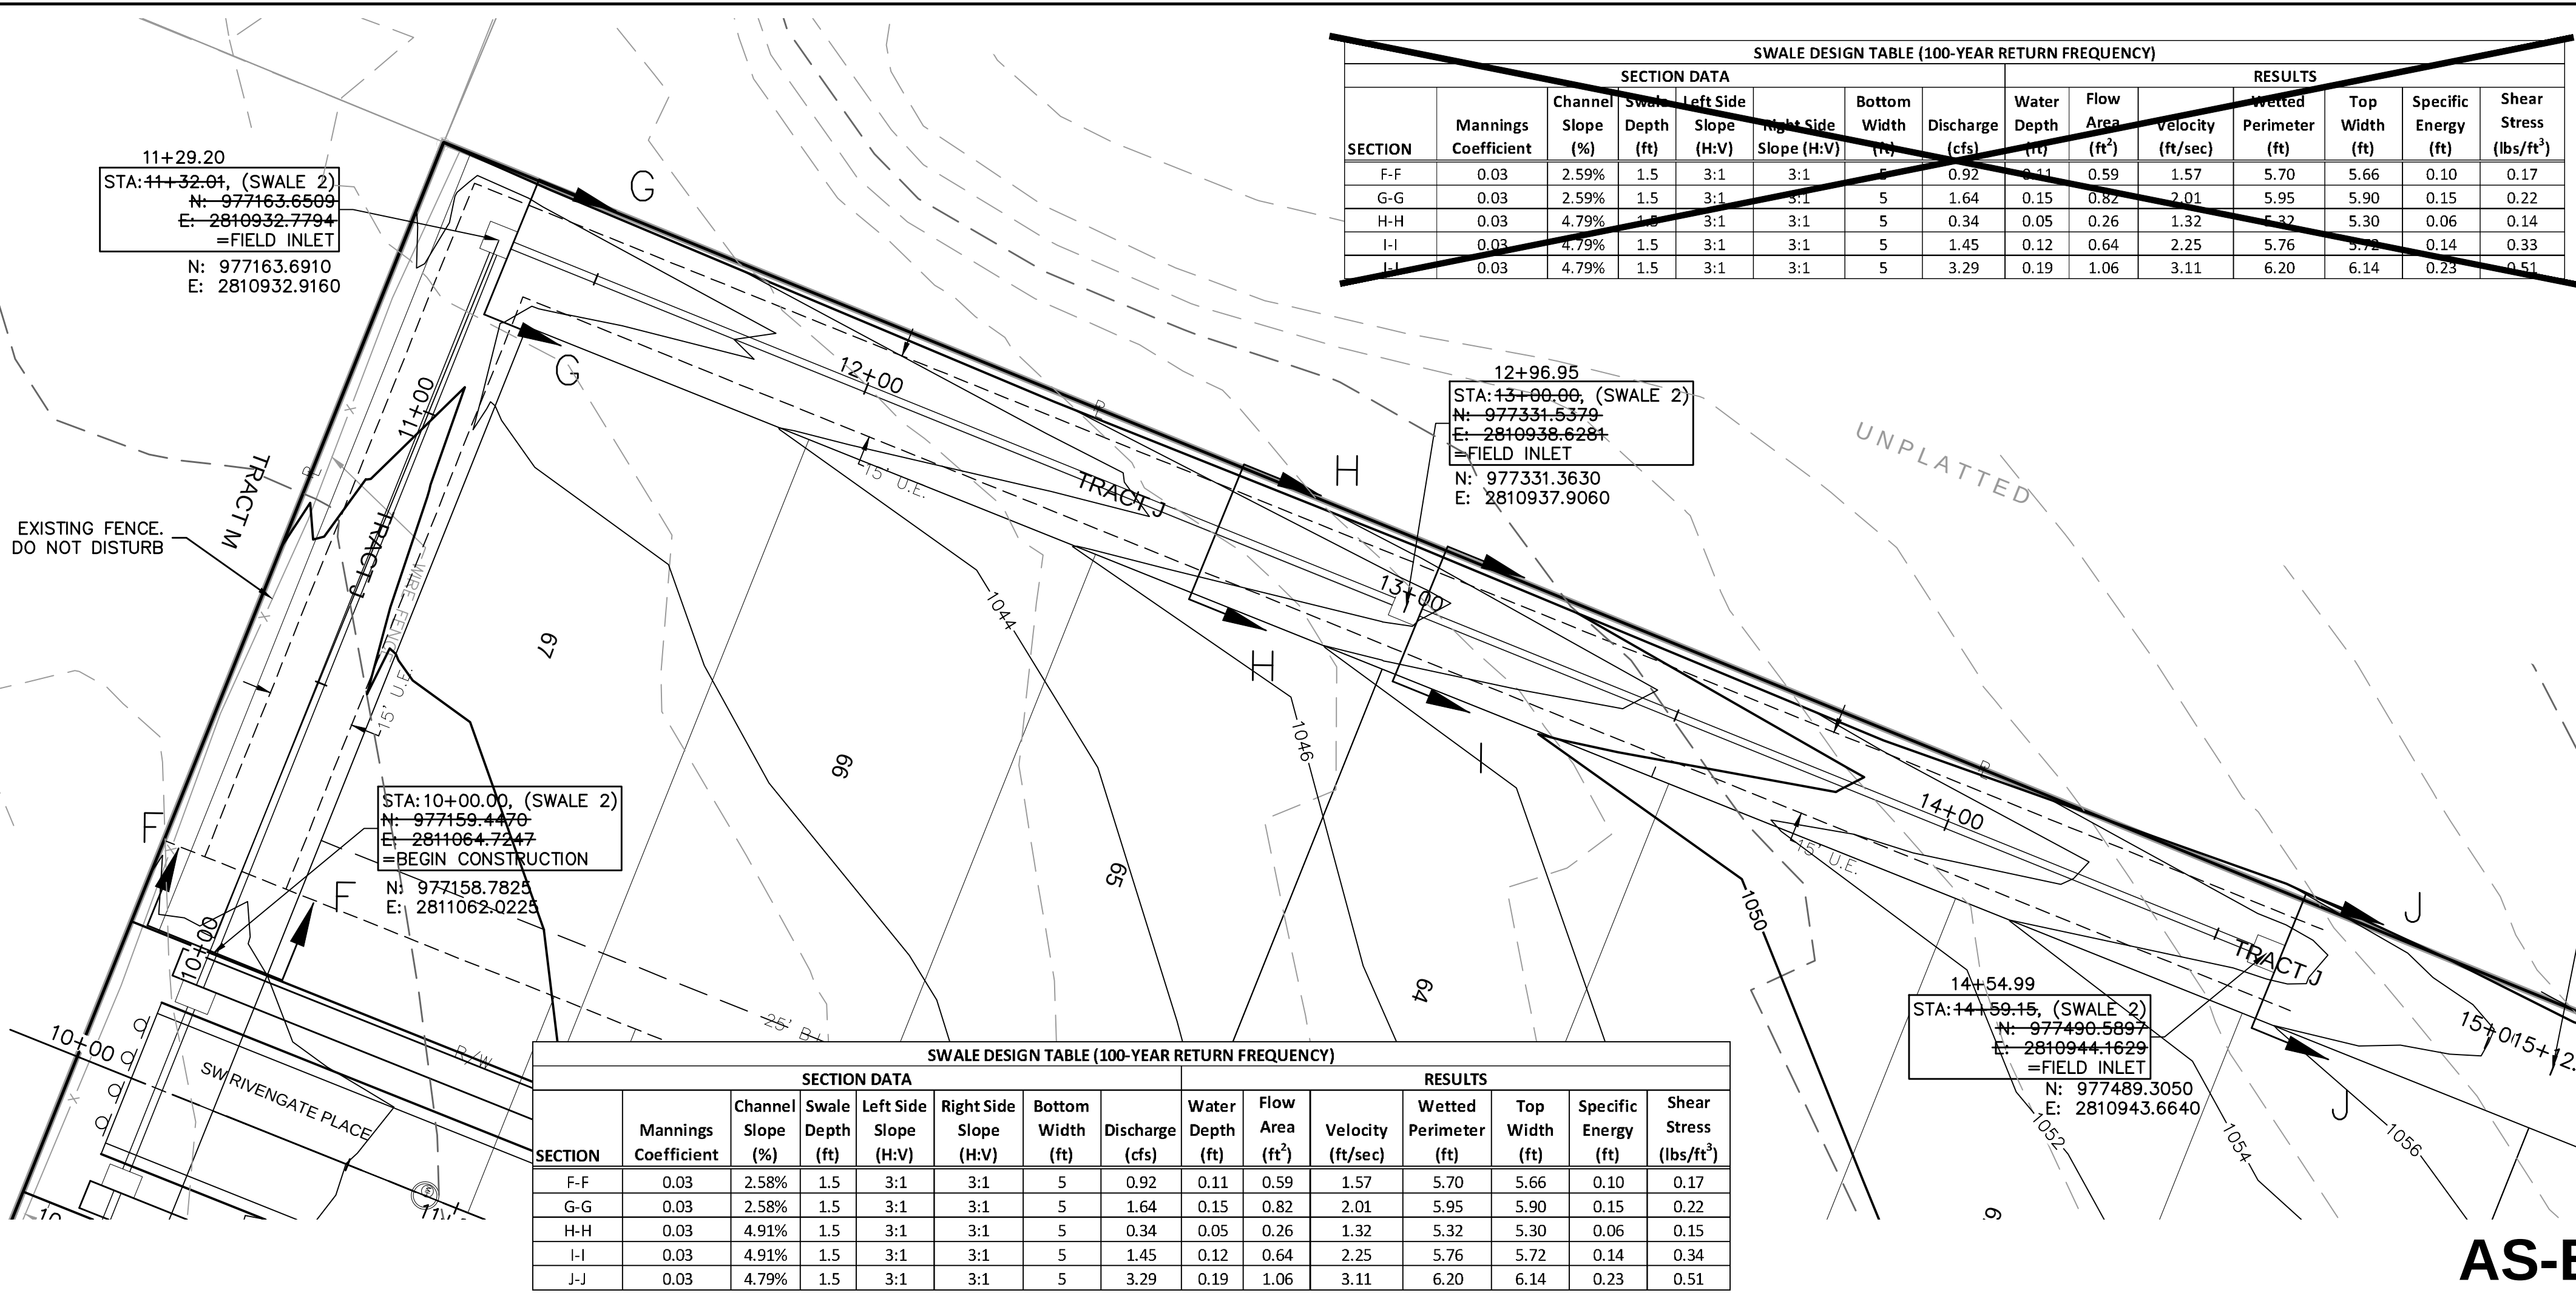

olsson

Olsson - Civil Engineering
Missouri Certificate of Authority #: 001592
1301 Burlington Street
North Kansas City, MO 64116
TEL 816.361.1177
www.olsson.com

STATE OF MISSOURI
JULIE ELAINE
SELLERS
NUMBER
PE-2017000387
3/6/2025
PROFESSIONAL ENGINEER

SWALE 2 PLAN & PROFILE
STREET & STORM SEWER PLANS
OSAGE
SECOND PLAT

2020

drawn by: D.F./M.O./A.A.
checked by: C.G.W.
designed by: A.A.
QA/QC by: J.E.S.
project no.: C19-2339
drawing no.:
date: 2022.05.26


SHEET
C108

REVISIONS DESCRIPTION

DATE


REV. NO.

2020

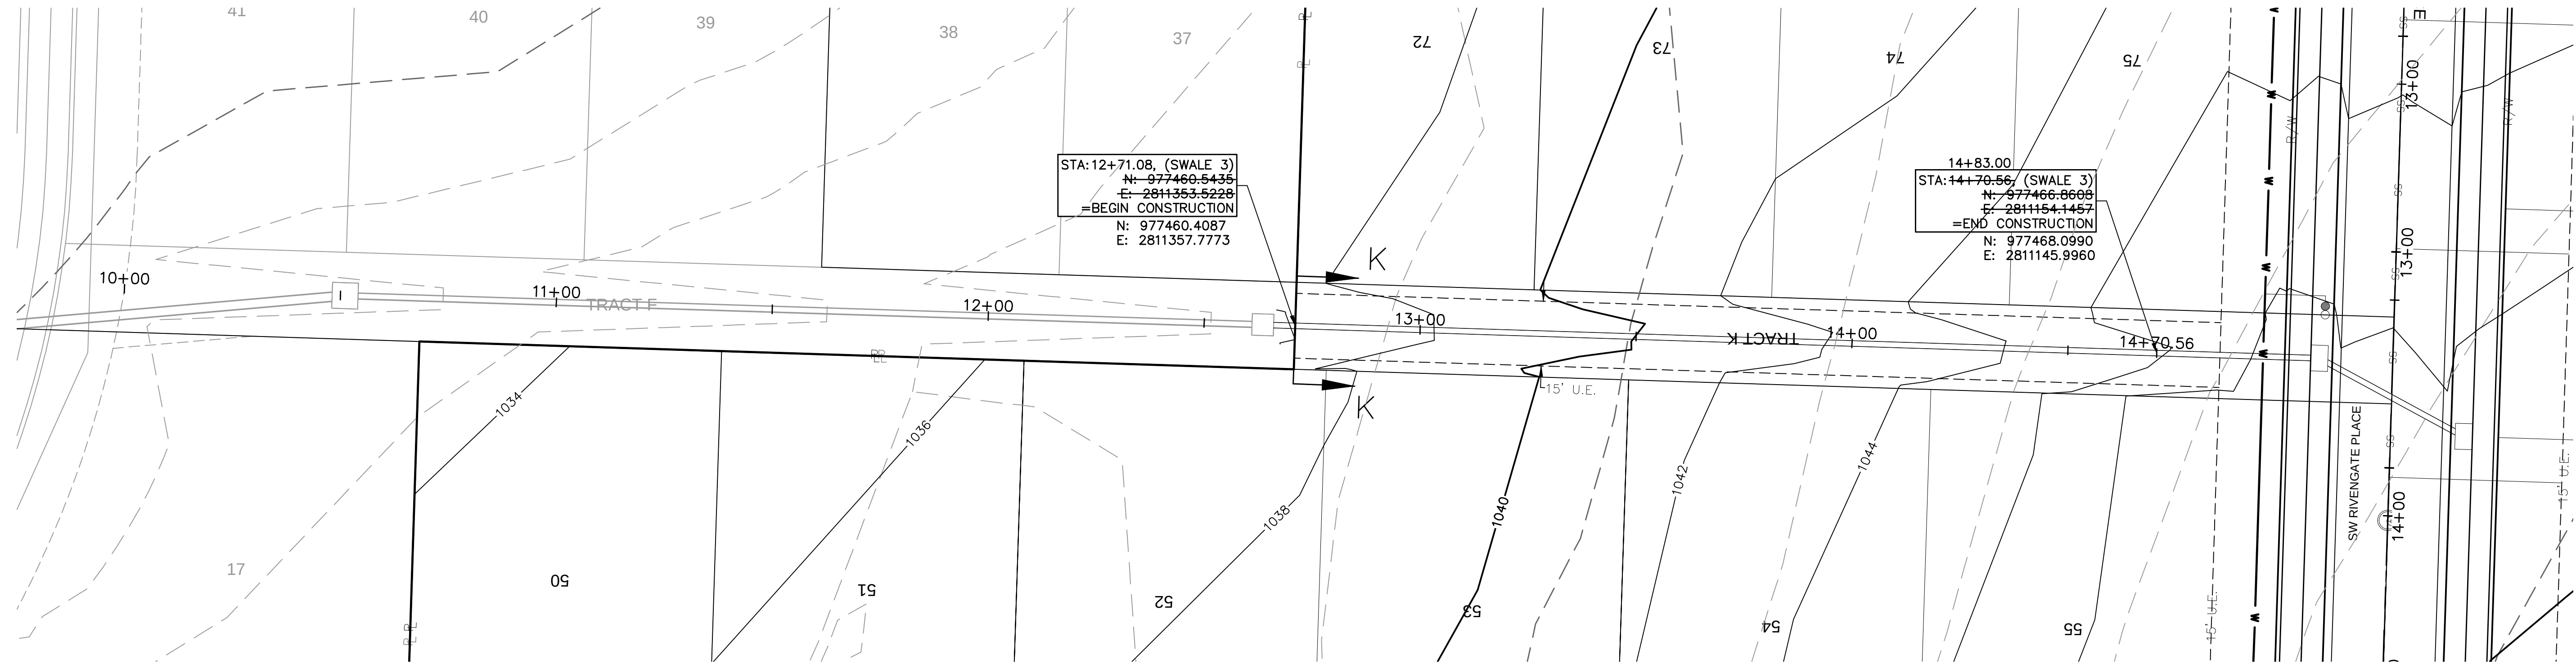

1. CONTRACTOR SHALL CONSTRUCT SWALES WITH MINIMUM SLOPE, WIDTH AND DEPTH AS SHOWN IN THE SWALE DESIGN TABLES.



2. AS-BUILT SURVEY IS REQUIRED/APPROVED BY CITY FOR ALL SWALES AND PRIOR TO APPROVAL FOR ANY BUILDING FOUNDATION PERMIT. CONTRACTOR SHALL BE REQUIRED TO REGRADE SWALES AT CONTRACTOR'S EXPENSE IF ABOVE REQUIREMENTS ARE NOT MET.

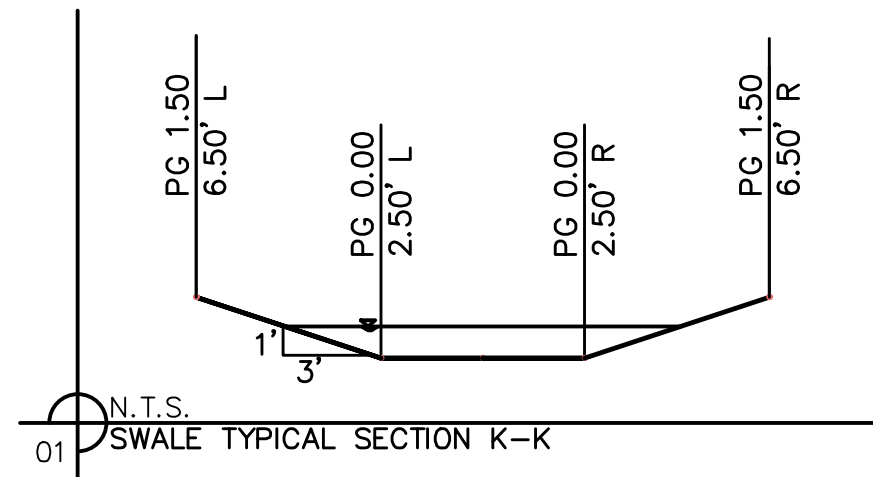


SWALE DESIGN TABLE (100-YEAR RETURN FREQUENCY)														
SECTION DATA								RESULTS						
SECTION	Mannings Coefficient	Channel Slope (%)	Swale Depth (ft)	Left Side Slope (H:V)	Right Side Slope (H:V)	Bottom Width (ft)	Discharge (cfs)	Water Depth (ft)	Flow Area (ft ²)	Velocity (ft/sec)	Wetted Perimeter (ft)	Top Width (ft)	Specific Energy (ft)	Shear Stress (lbs/ft ²)
K-K	0.03	4.33%	1.5	3:1	3:1	5	1.68	0.13	0.70	2.40	5.82	5.78	0.15	0.33

SWALE DESIGN TABLE (100-YEAR RETURN FREQUENCY)														
SECTION DATA								RESULTS						
SECTION	Mannings Coefficient	Channel Slope (%)	Swale Depth (ft)	Left Side Slope (H:V)	Right Side Slope (H:V)	Bottom Width (ft)	Discharge (cfs)	Water Depth (ft)	Flow Area (ft ²)	Velocity (ft/sec)	Wetted Perimeter (ft)	Top Width (ft)	Specific Energy (ft)	Shear Stress (lbs/ft ²)
K-K	0.03	4.70%	1.5	3:1	3:1	5	1.68	0.13	0.70	2.40	5.82	5.78	0.15	0.35

Section	Drainage Area	C	Tc	i	K	Peak Flow
	(ac.)		(min)	(in/hr)		(cfs)
K-K	0.26	0.51	5	10.32	1.25	1.68

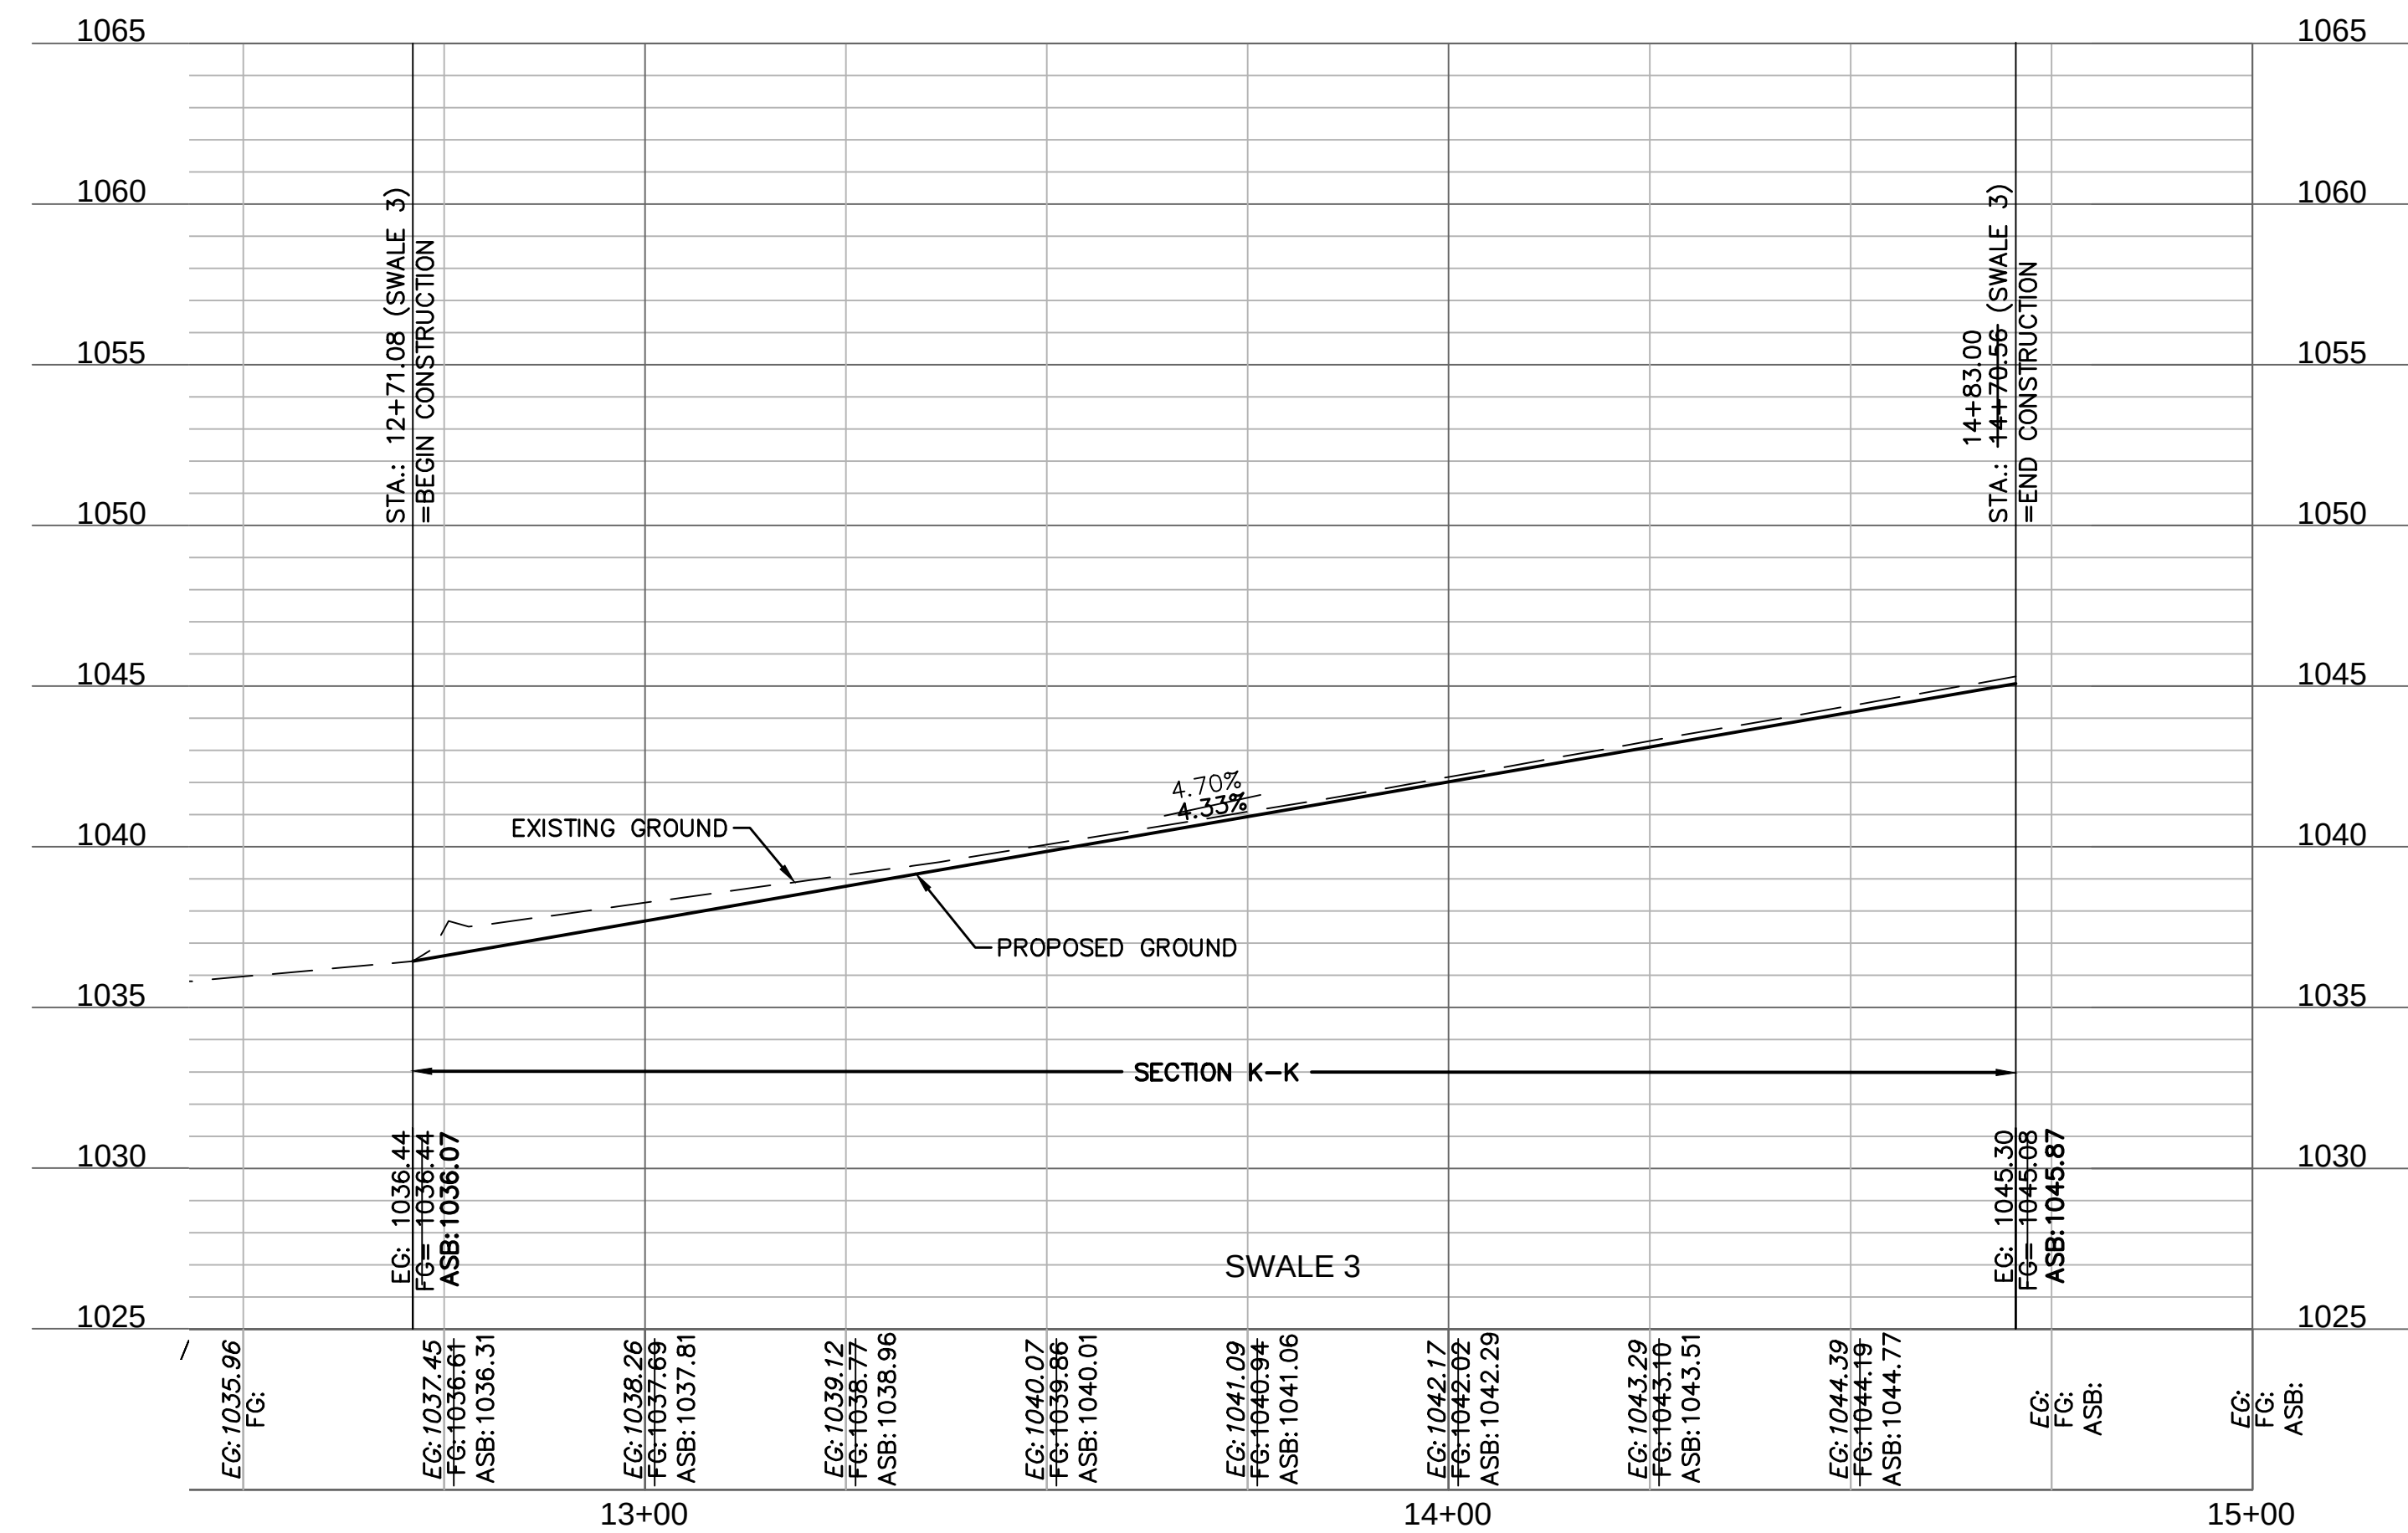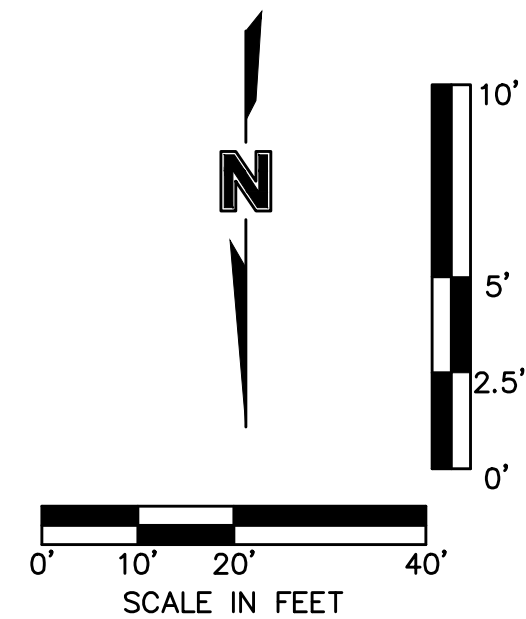

AS-BUILT

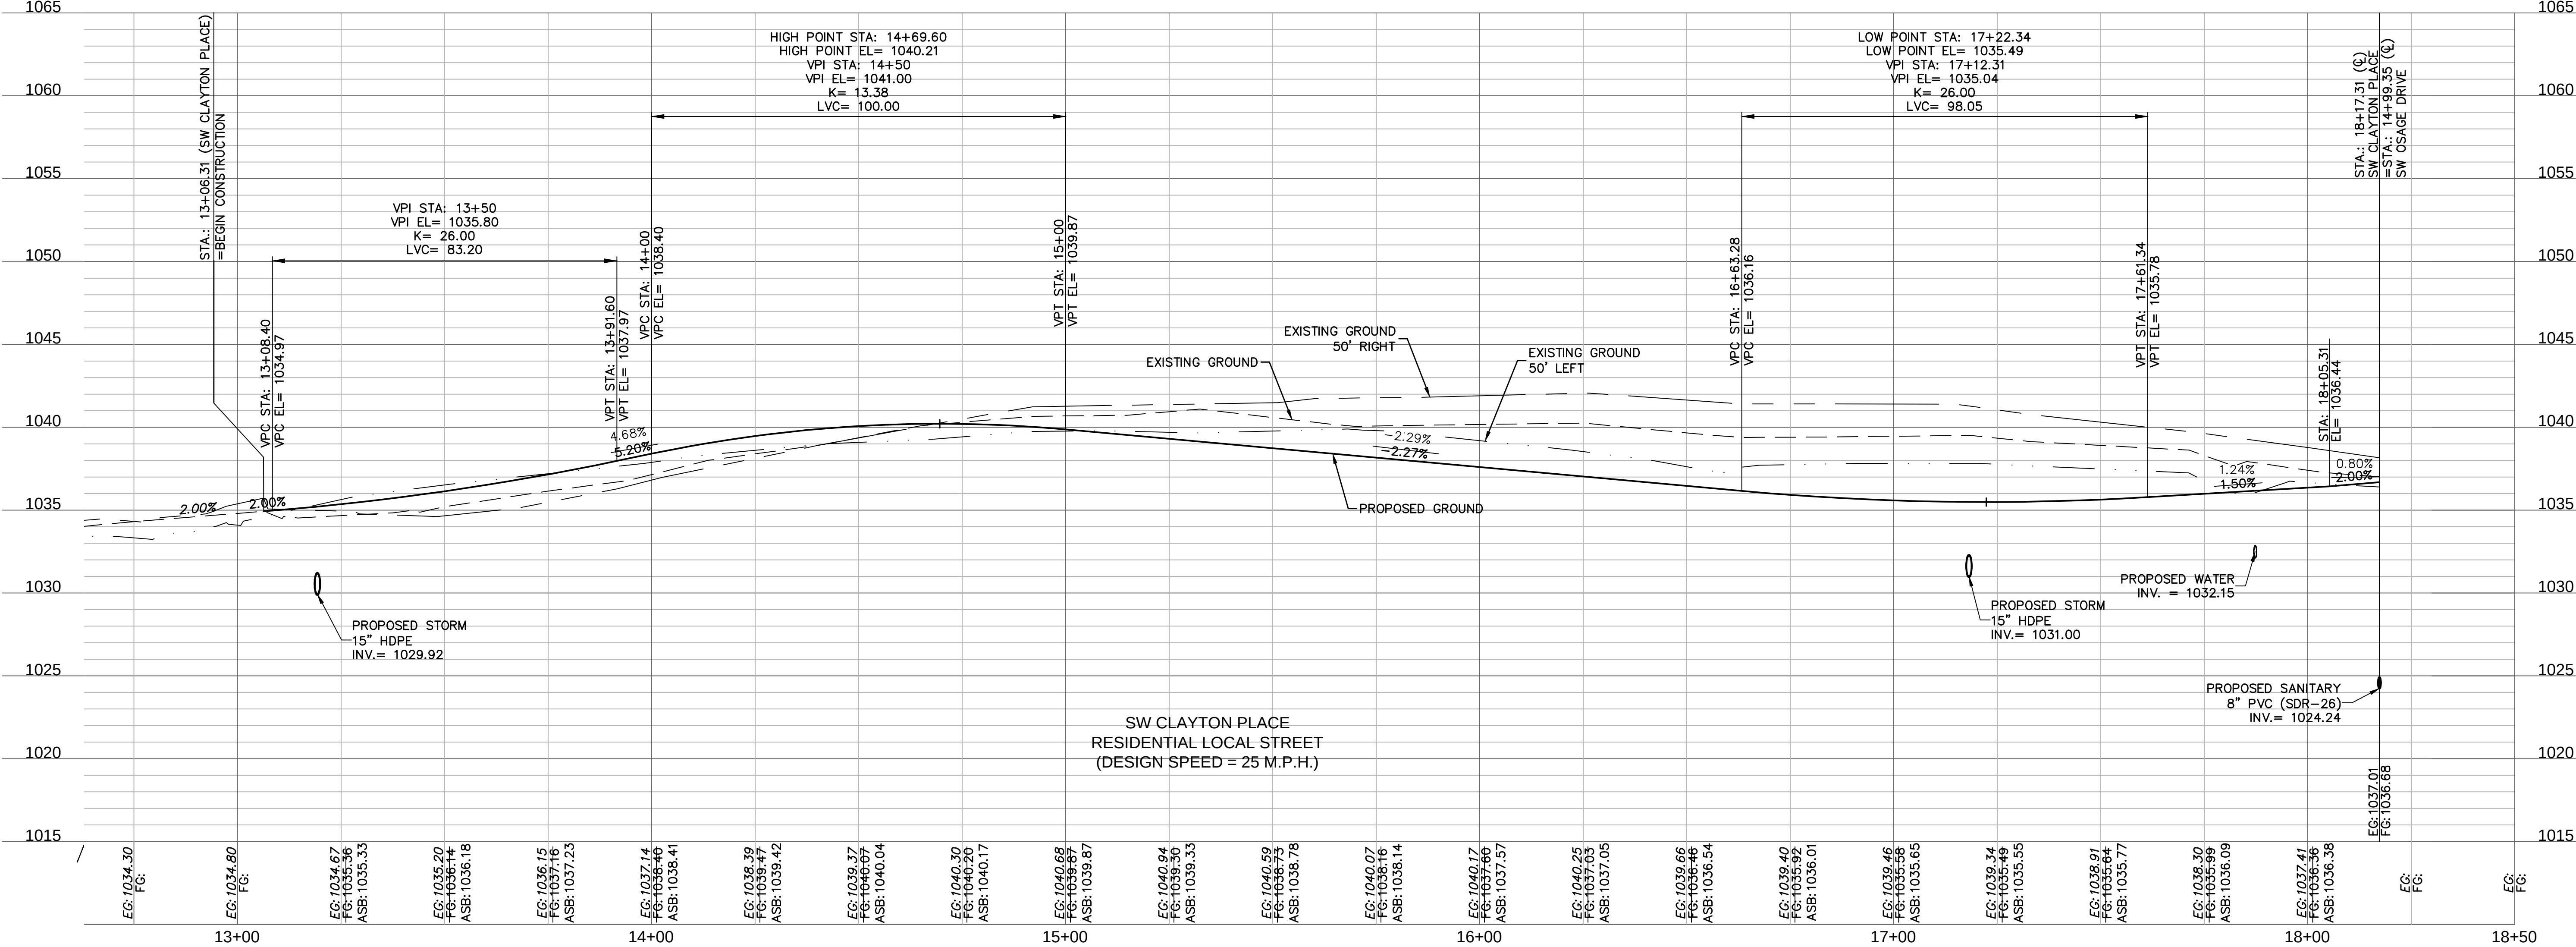


BROADWAY PLAN & PROFILE (SW CLAYTON PLACE) STREET & STORM SEWER PLANS

OSAGE
SECOND PLAT

2020

SHEET
C110


drawn by: _____ D.F. / M.O. / A.A.
checked by: _____ C.G.W.
designed by: _____ A.A.
QA/QC by: _____ J.E.S.
project no.: _____ C19-2339
drawing no.: _____
date: _____ 2022.05.26

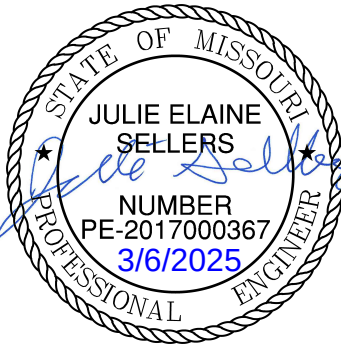


Olsson - Civil Engineering
Missouri Certificate of Authority #: 001592
11301 Burlington Street
North Kansas City, MO 64116

olson

TEL 816.361.1177 www.olsson.com

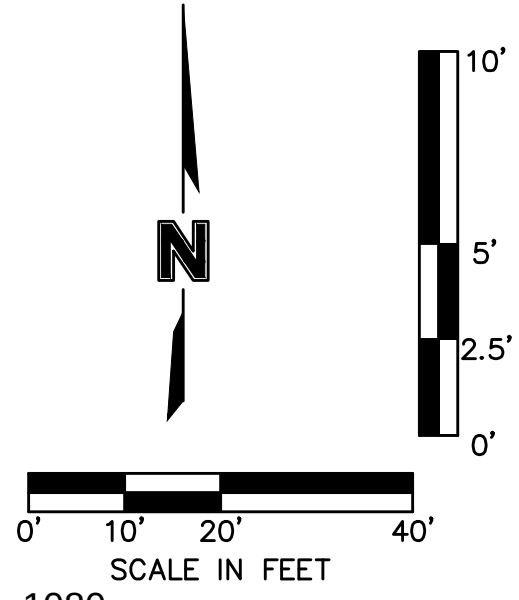

LEGEND	
	ADA ACCESS ROUTE
	ASPHALT PAVEMENT
	CONCRETE SIDEWALK
	CG-2 CURB & GUTTER

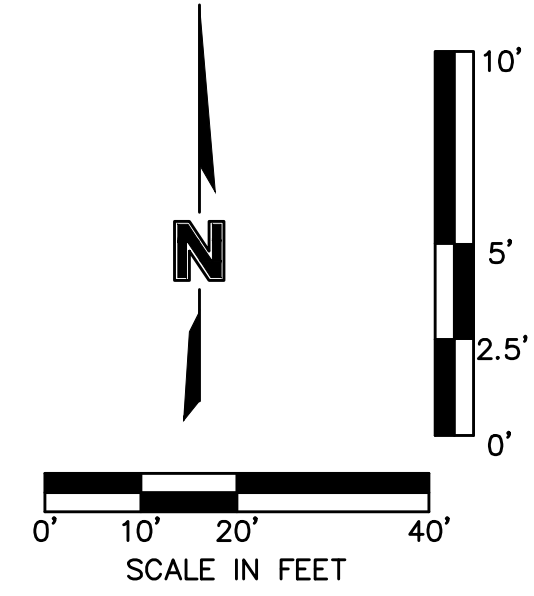

ROADWAY PLAN & PROFILE (SW OSAGE DRIVE CONT'D)
STREET & STORM SEWER PLANS

PLAN & PROFILE (SW OSAGE DRIVE)
STREET & STORM SEWER PLANS

2020

REVISIONS

[illegible]


Olsson - Civil Engineering
Missouri Certificate of Authority #: 001592
1301 Burlington Street
North Kansas City, MO 64116




TEL 816.361.1177

www.djssson.com

olson

DWG: F:\2019\2001-2500\019-2339-C140-Design\AutoCAD\Final Plans - As-Built\Sheets\GNC\A STREET & STORM\A_C_RP01_C192339.dwg USER: asw/dor
DATE: May 26, 2022 7:35am XREFS: C_PBASE_C192339 C_PBN0Y_C192339 C_PBLK_C192339 C_PSTRM_C192339 C_PSSWR_C192339 C_PWATR_C192339 C_PPSURF_C192339 C_PPATT_C192339 C_PSPOT_C192339

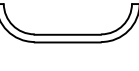LEGEND	
	ADA ACCESS ROUTE
	ASPHALT PAVEMENT
	CONCRETE SIDEWALK
	CG-2 CURB & GUTTER

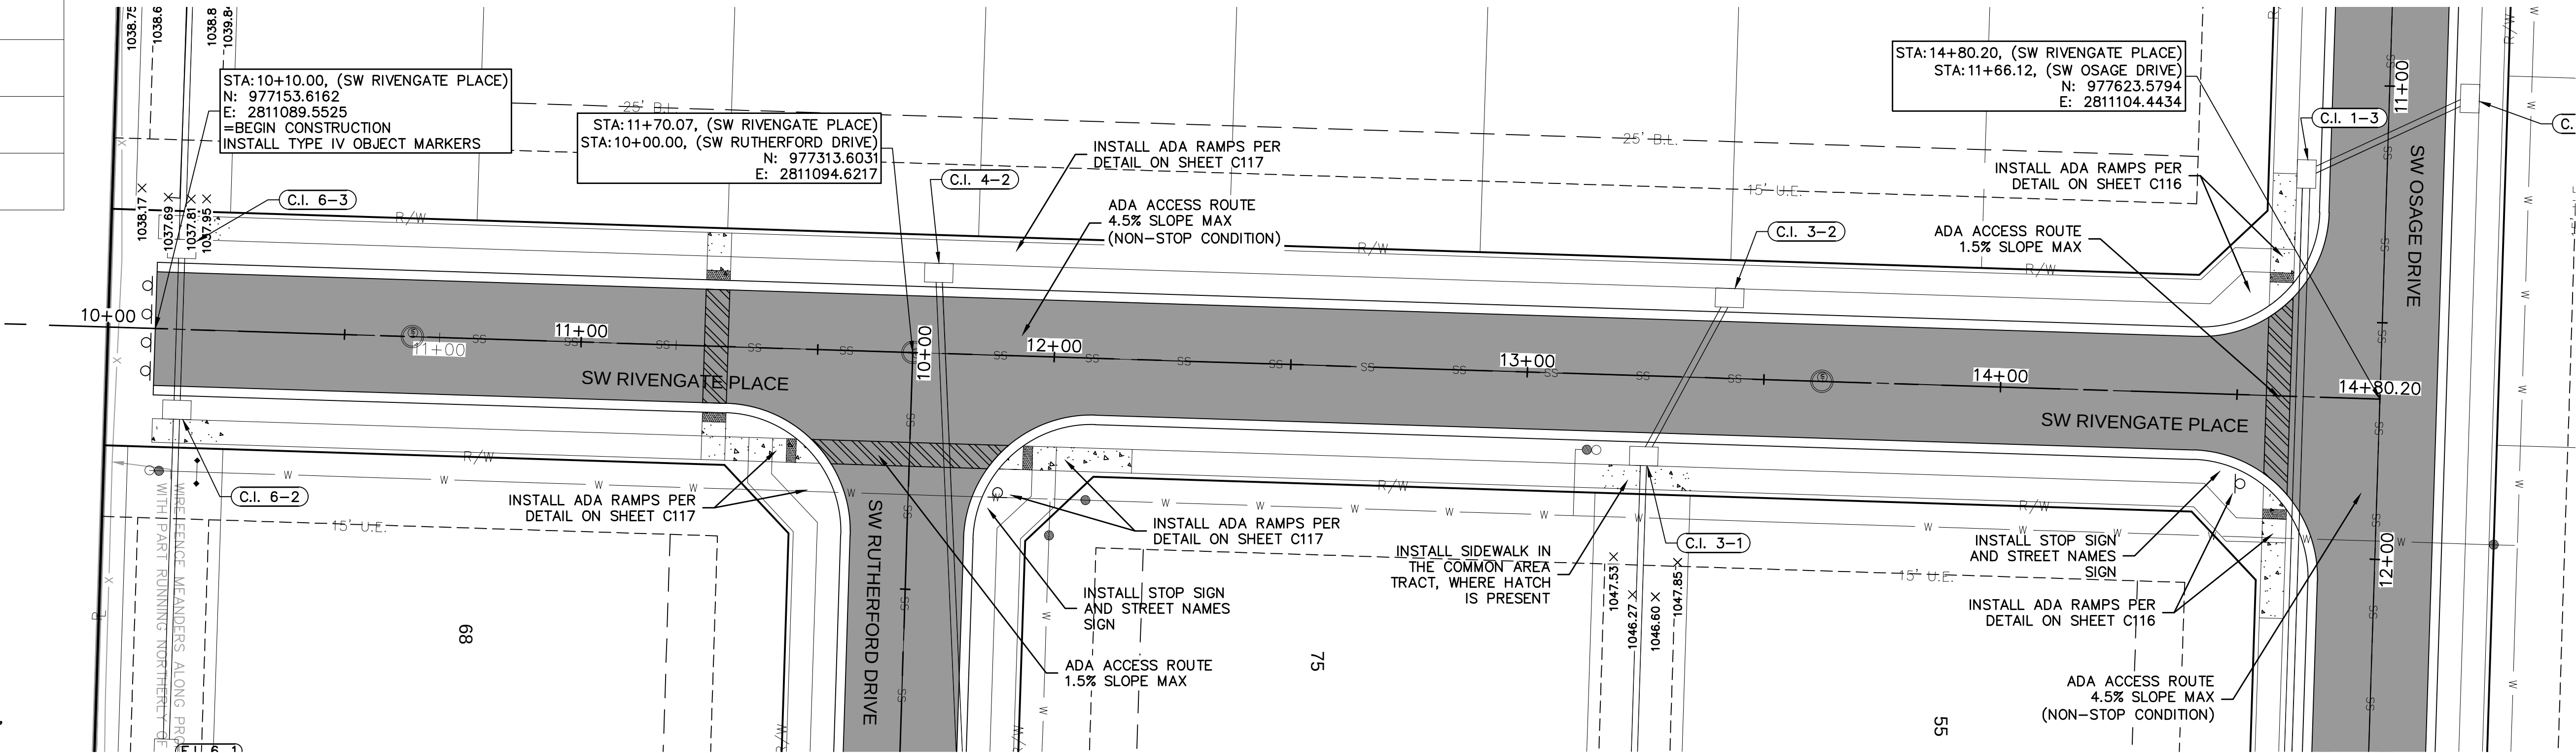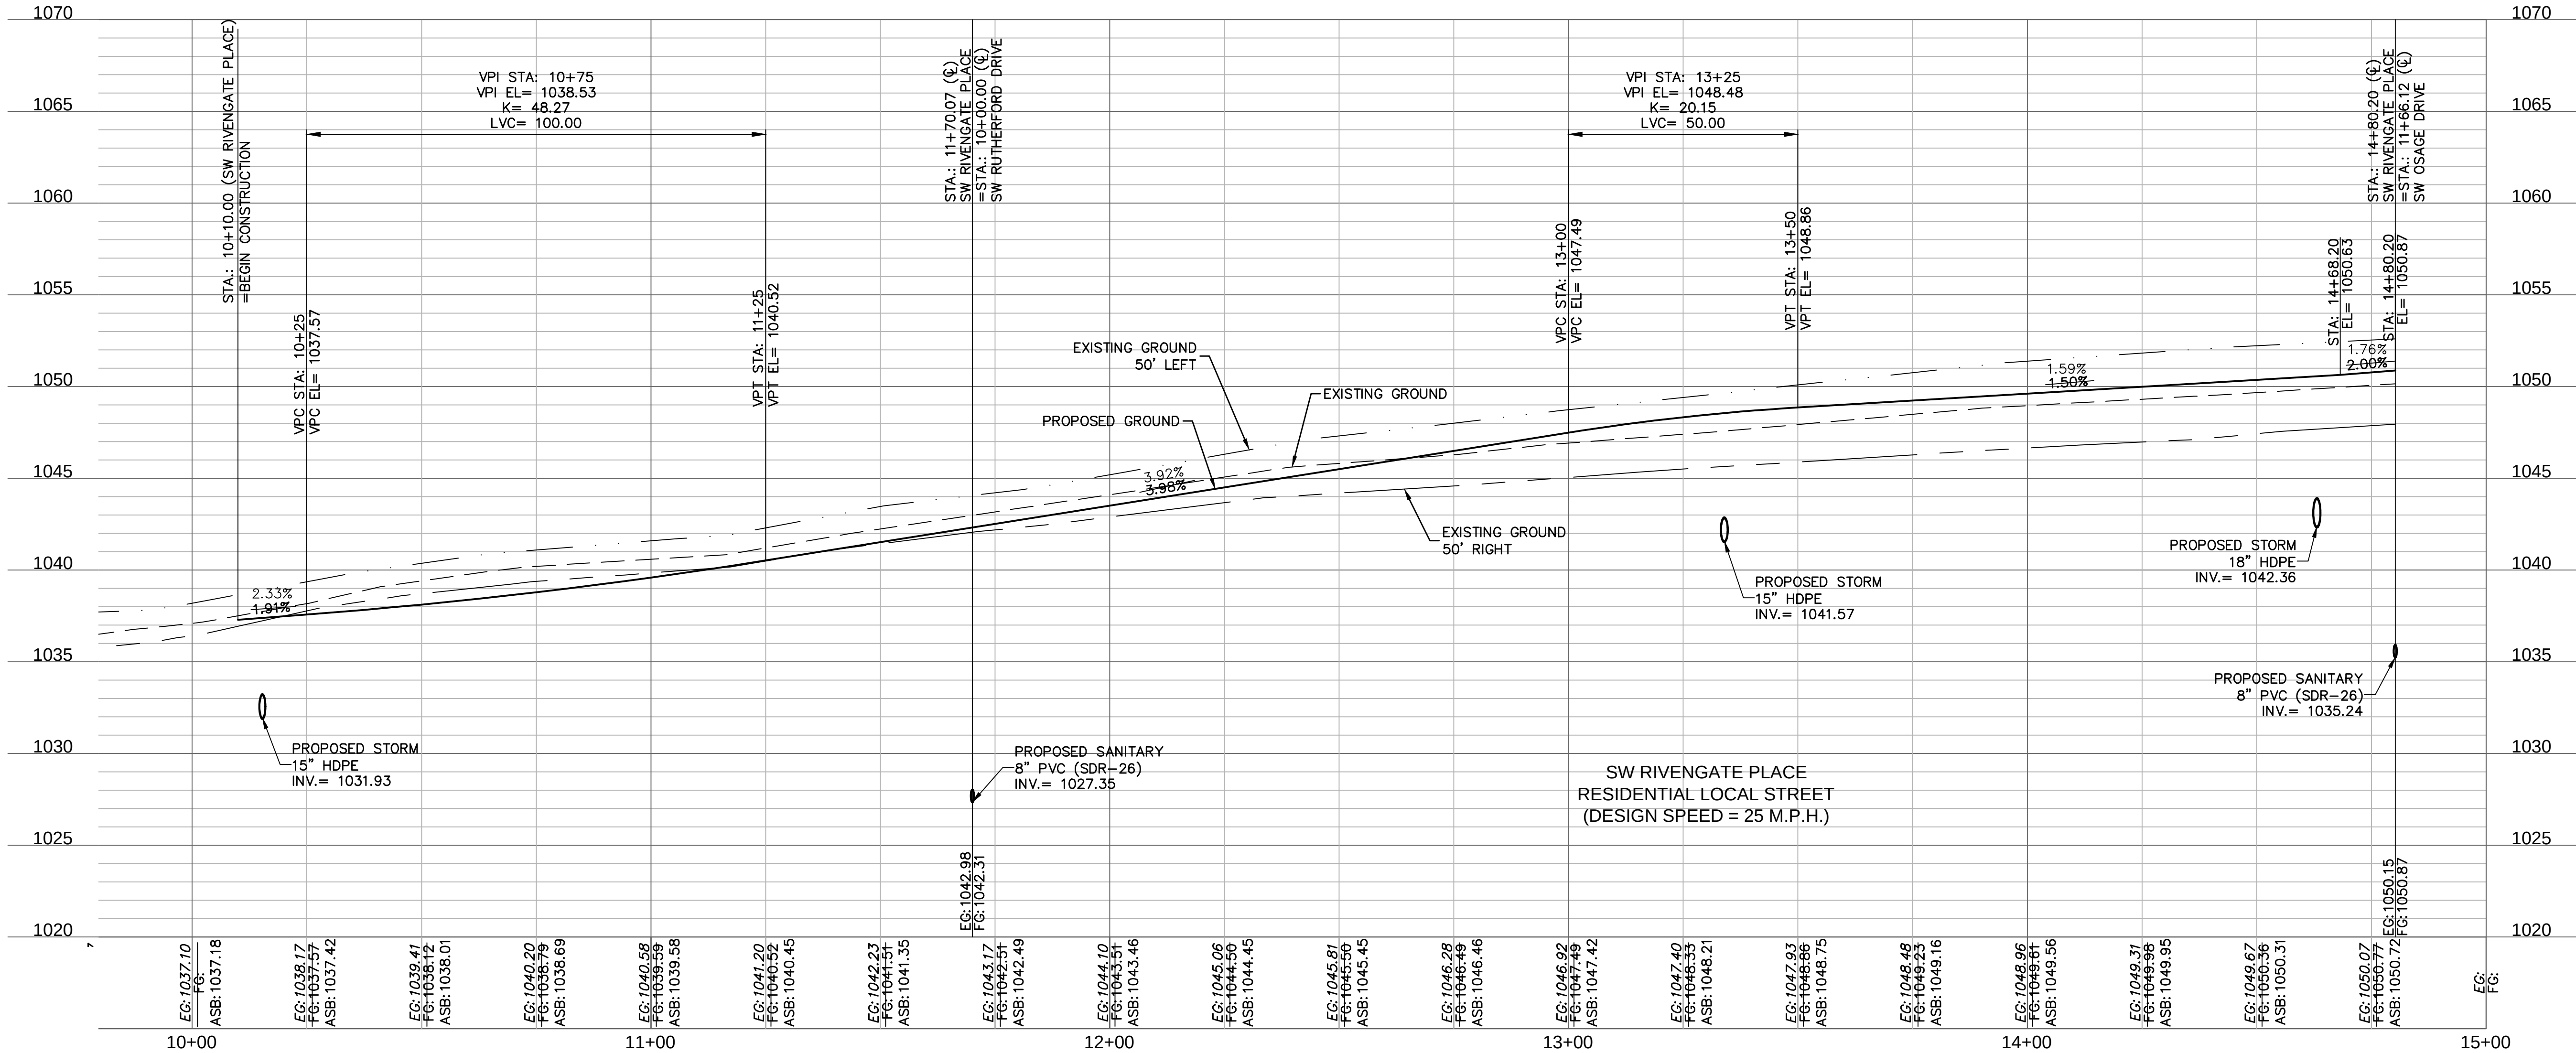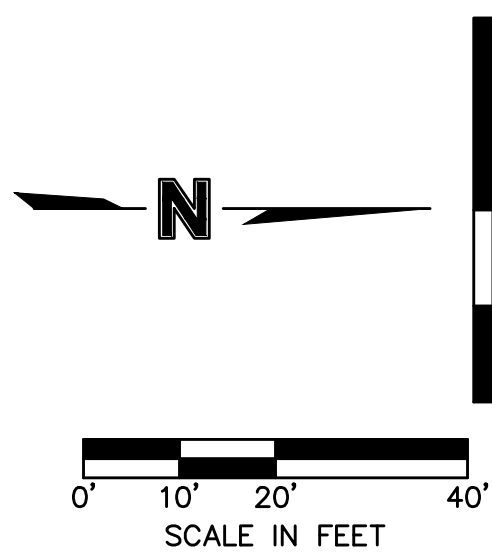

AS-BUILT

ROADWAY PLAN & PROFILE (SW RIVENGATE PLACE)
STREET & STORM SEWER PLANS

OSAGE
SECOND PLAT

2020

REVISIONS


REV. NO.	DATE	REVISIONS DESCRIPTION
1	2020.10.23	REVISED PER CITY COMMENTS





olsson
Olsson - Civil Engineering
Missouri Certificate of Authority #: 001592
1301 Burlington Street
North Kansas City, MO 64116
TEL 816.361.1177
www.olson.com

drawn by: D.F./M.O./J.A.
checked by: C.G.W.
designed by: A.A.
QA/QC by: J.E.S.
project no.: C19-2339
drawing no.:
date: 2022.05.26

SHEET
C113

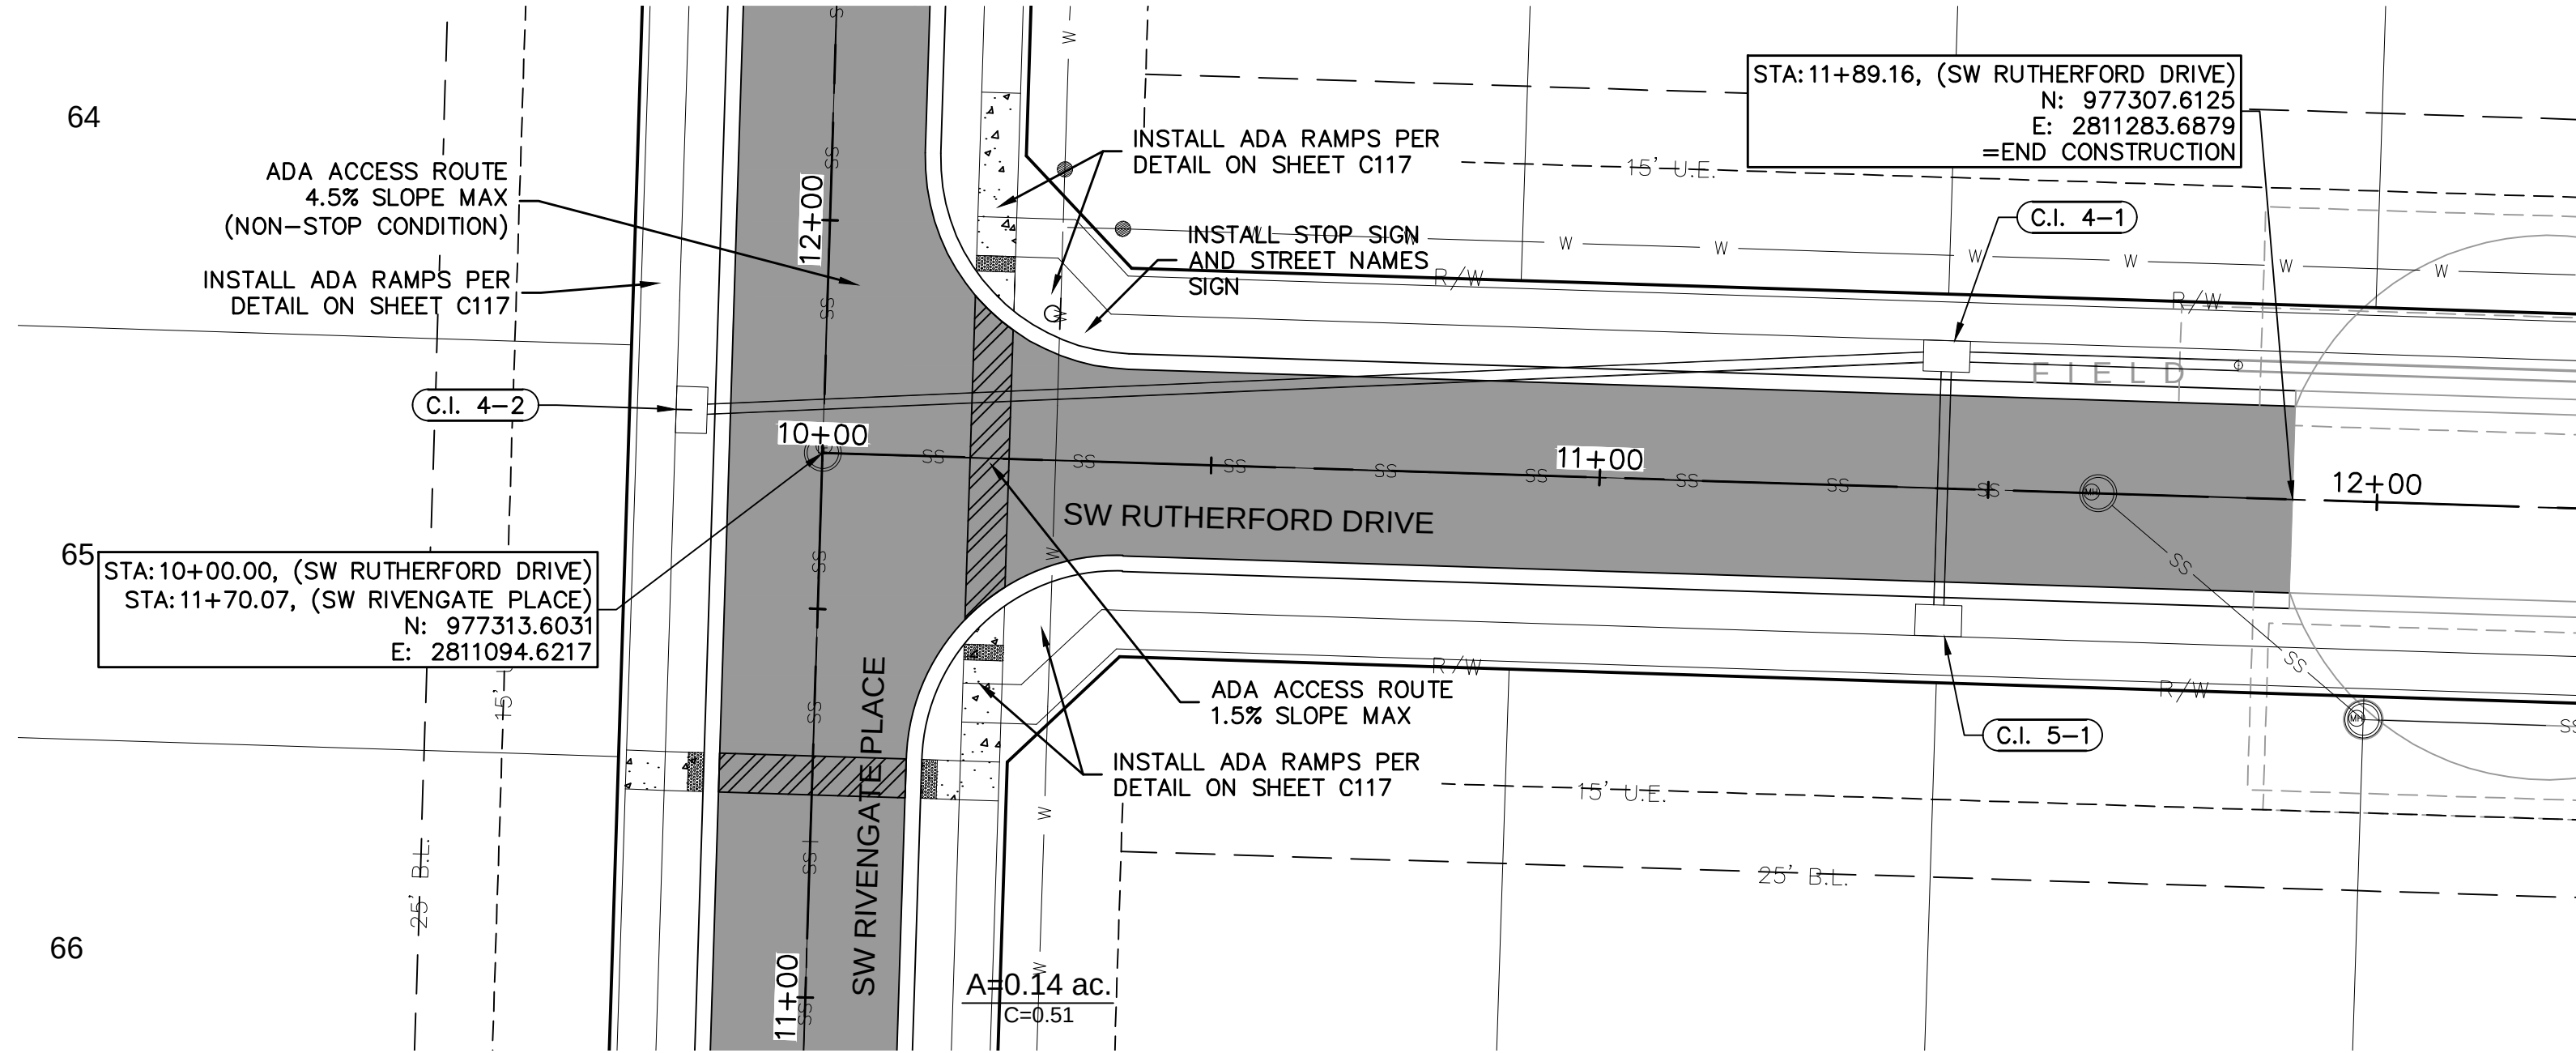

LEGEND	
	ADA ACCESS ROUTE
	ASPHALT PAVEMENT
	CONCRETE SIDEWALK
	CG-2 CURB & GUTTER

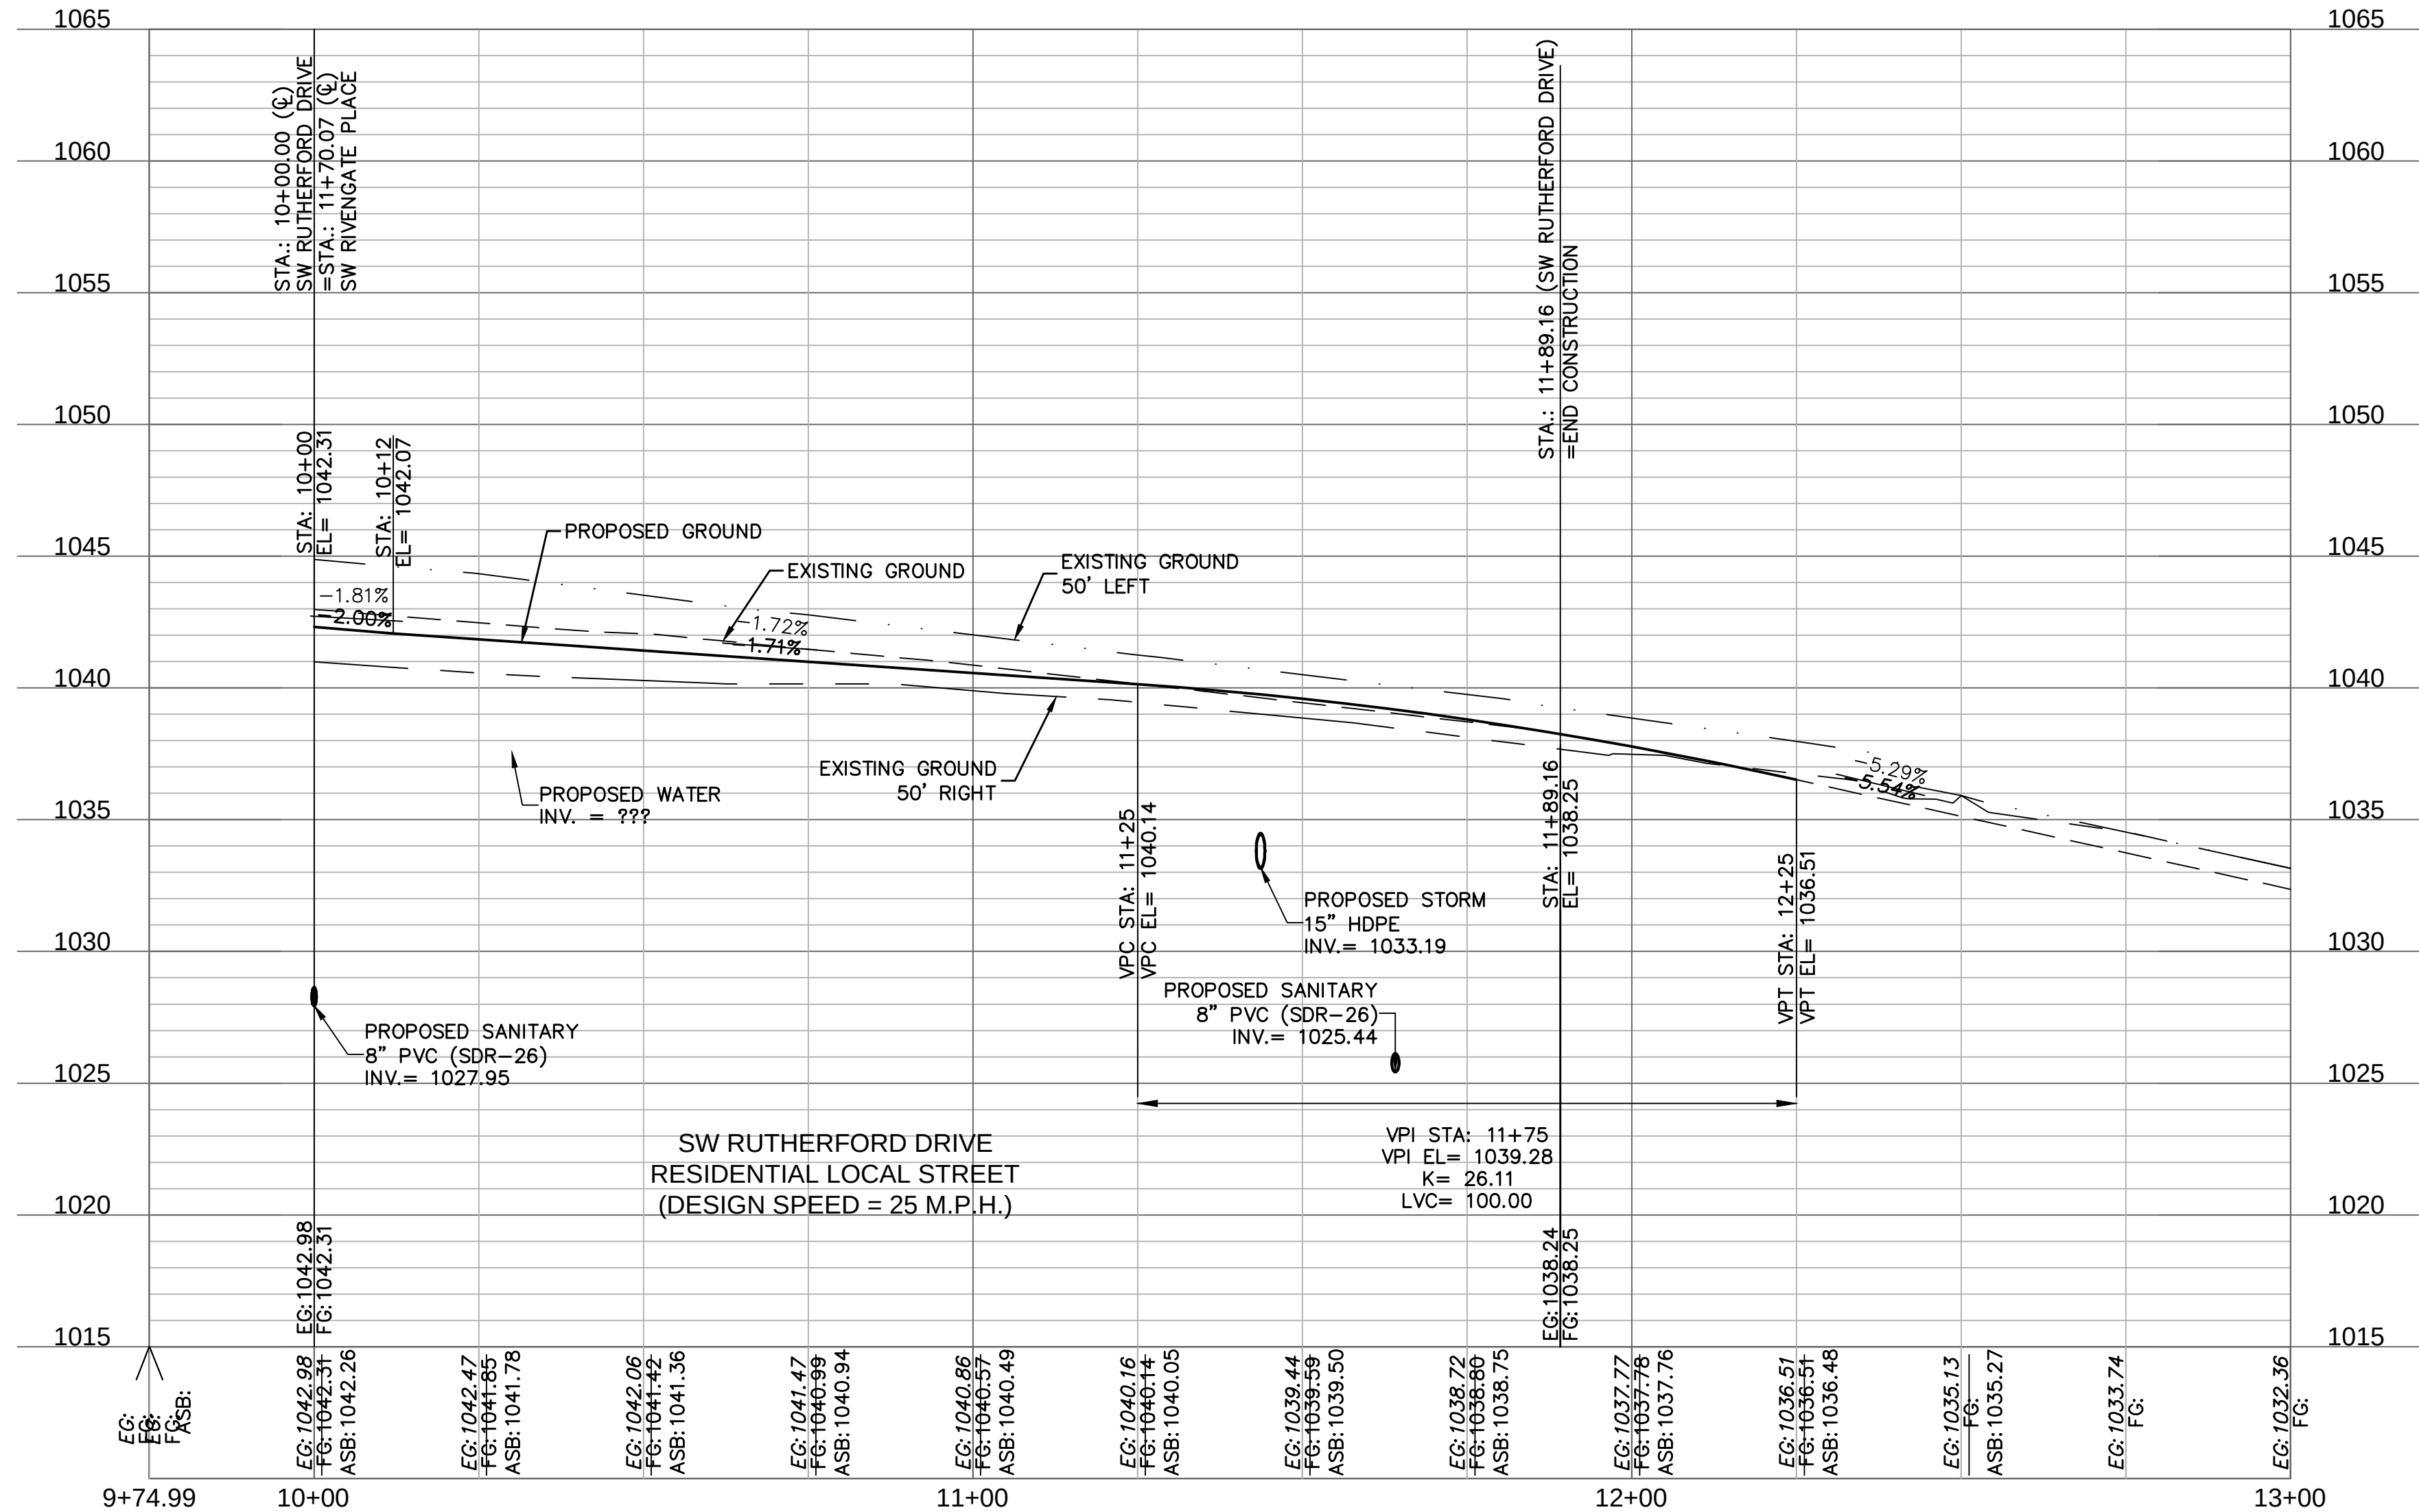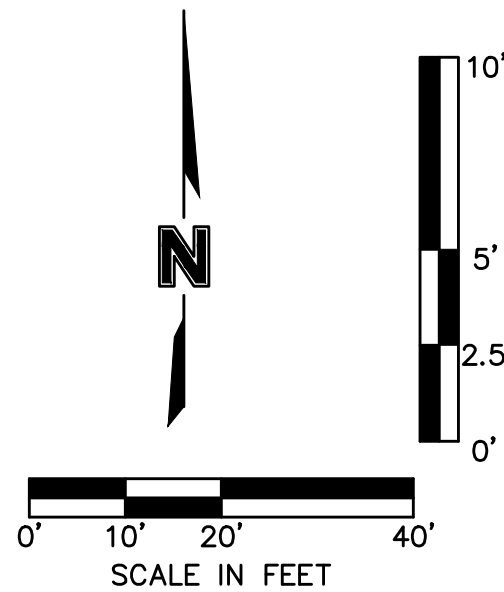

AS-BUILT


ROADWAY PLAN & PROFILE (SW RUTHERFORD DRIVE)
STREET & STORM SEWER PLANS

OSAGE
SECOND PLAT

2020

REVISIONS

REV. NO.	DATE	REVISIONS DESCRIPTION
1	2020.10.23	REVISER PER CITY COMMENTS

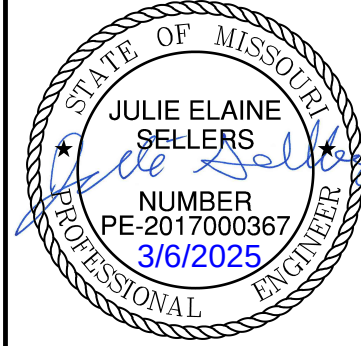


olsson

Olsson - Civil Engineering
Missouri Certificate of Authority #: 001592
1301 Burlington Street
North Kansas City, MO 64116
TEL 816.361.1177
www.olsson.com


drawn by: D.F./M.O./A.A.
checked by: C.G.W.
designed by: A.A.
QA/QC by: J.E.S.
project no.: C19-2339
drawing no.:
date: 2022.05.26

SHEET
C114

DWG: F:\2019\2001-2500\019-2339-C\40-Design\AutoCAD\Final Plans - As-Built\Sheets\GNCV\STREET & STORM\C_192339.dwg
DATE: May 26, 2022 7:36am XREFS: C:\PBASE\C192339 C:\XBASE\C192339 C:\PBDY\C192339 C:\PBLK\C192339 C:\PSTRM\C192339 USER: ssavor

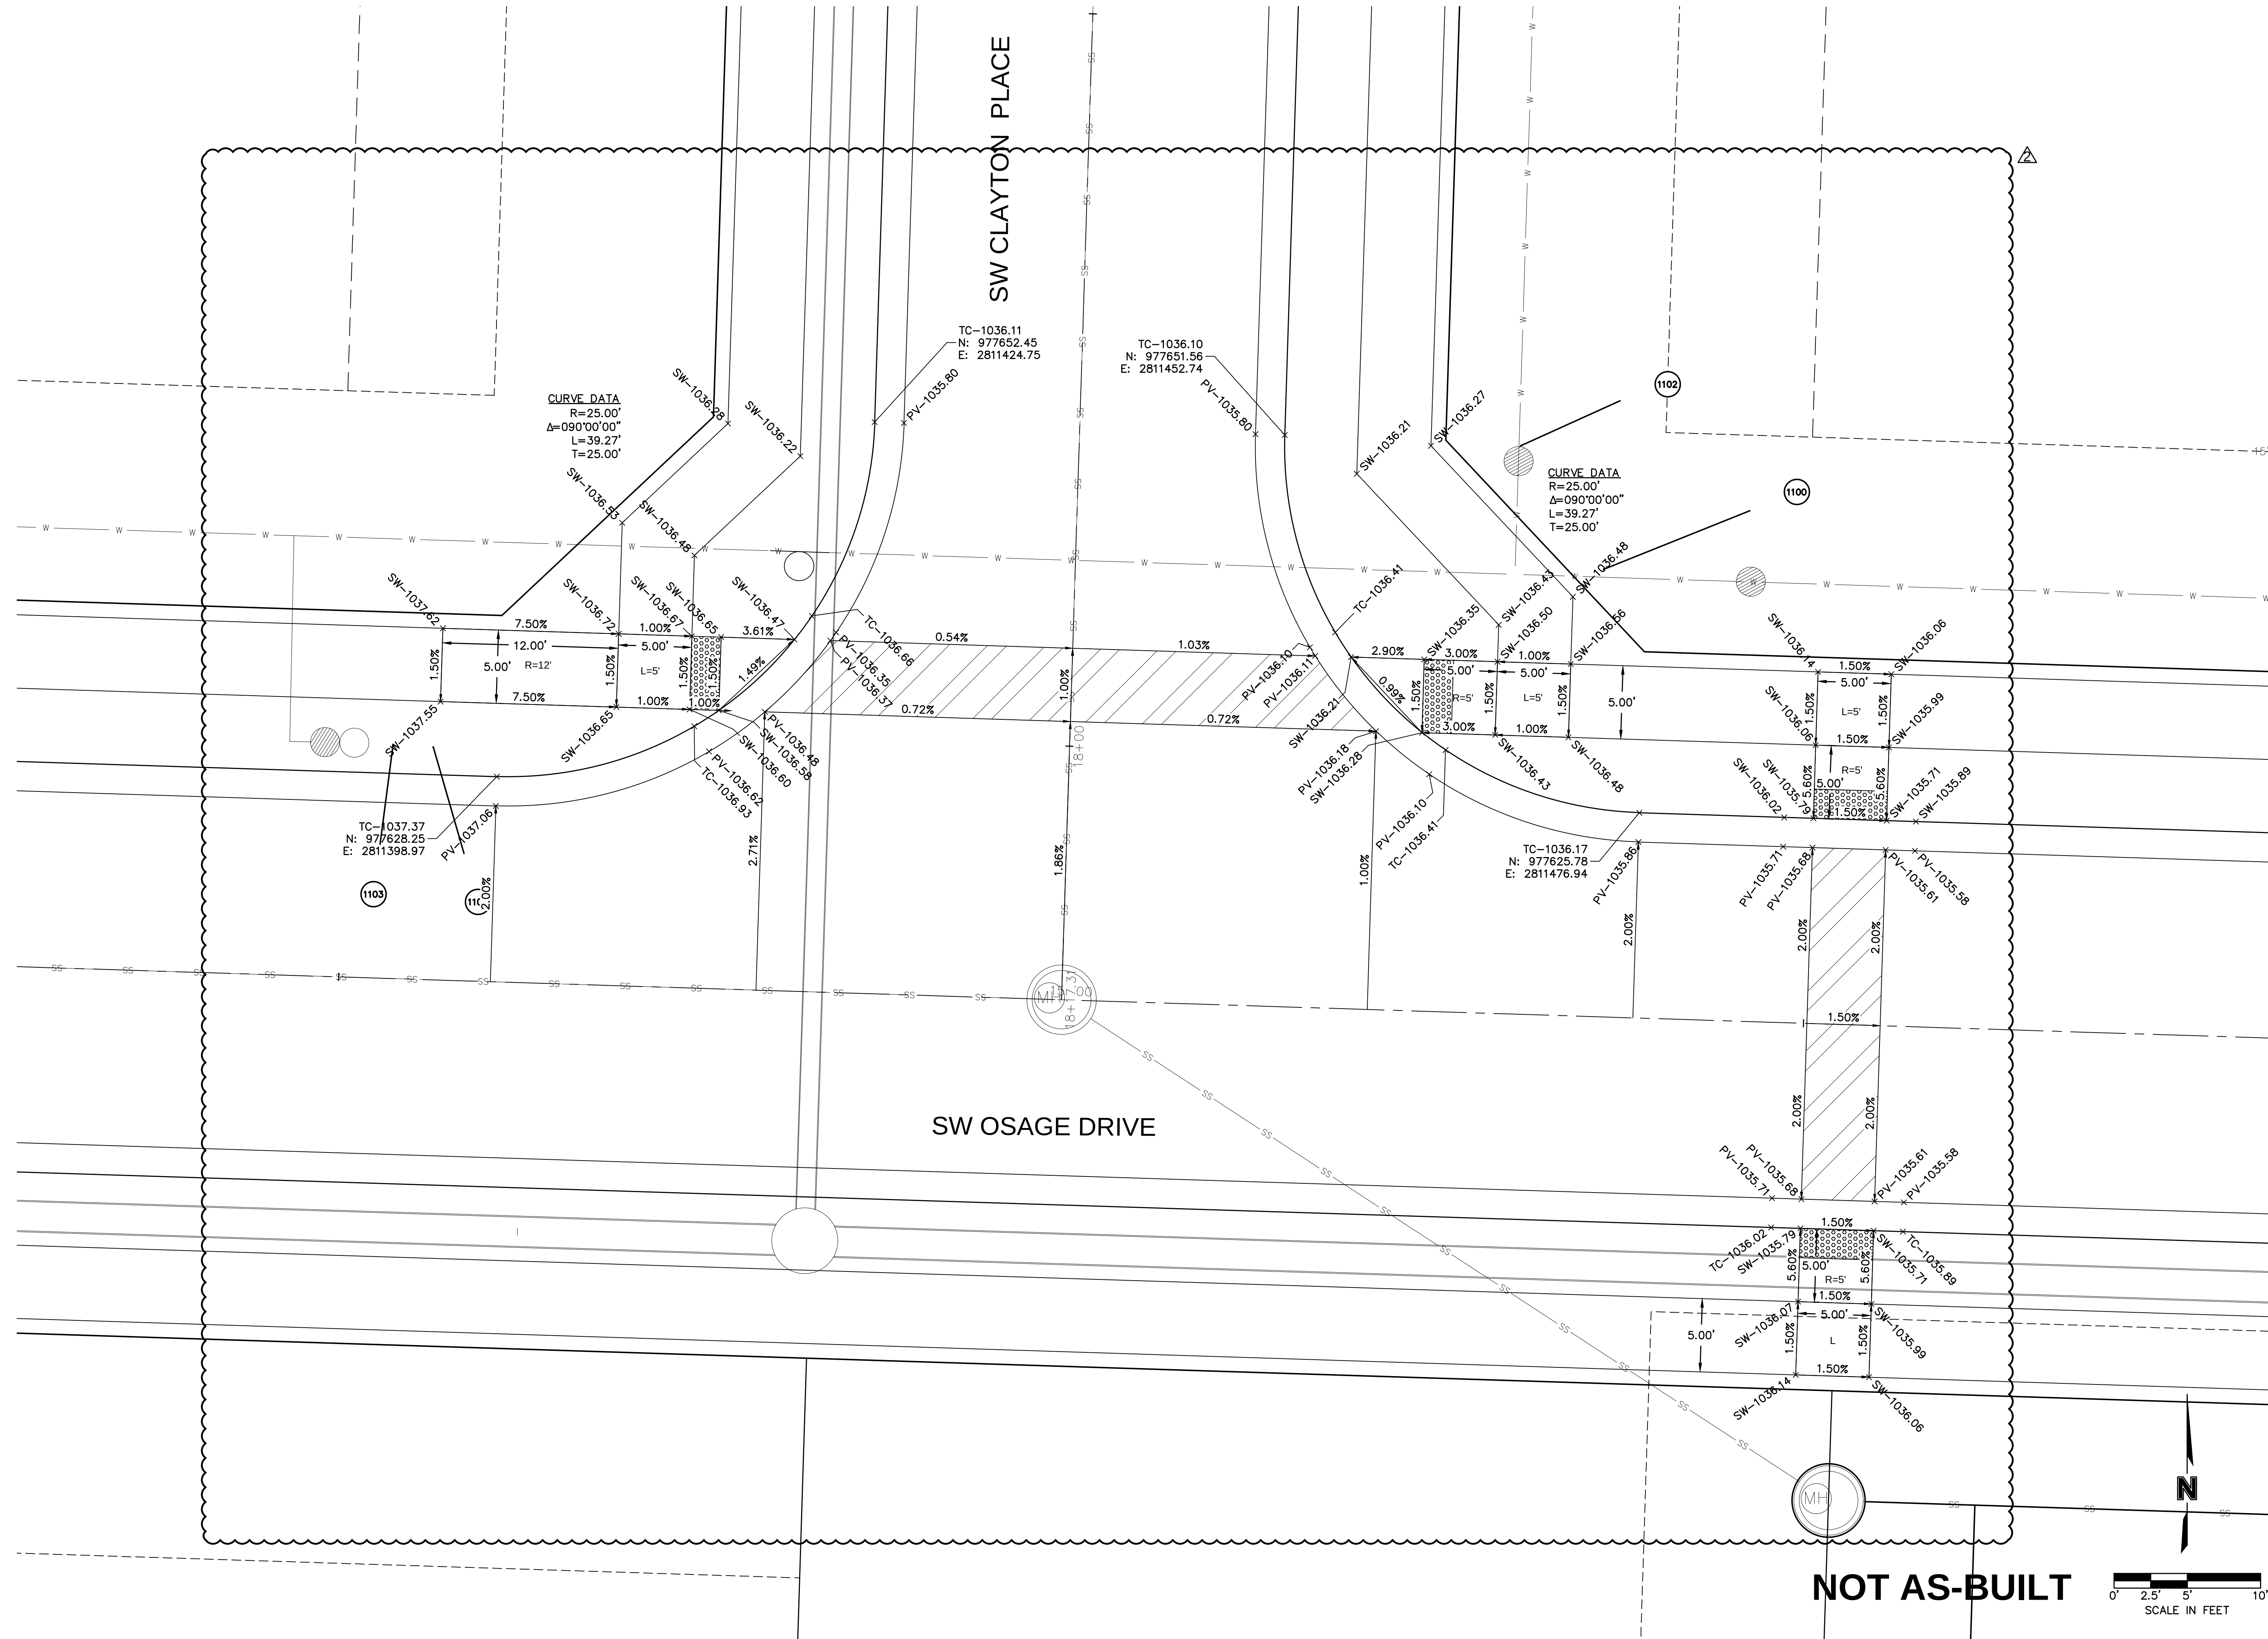

NOT AS-BUILT

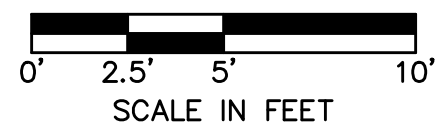


SW OSAGE DRIVE AND SW CLAYTON PLACE INTERSECTION STREET & STORM SEWER PLANS

OSAGE
SECOND PLAT

2020

[illegible]


6011

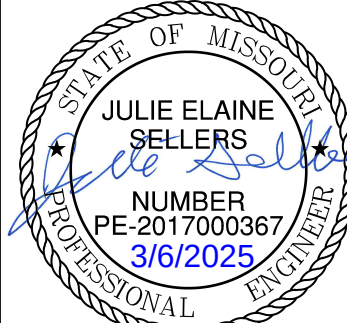

olsson

Olsson - Civil Engineering
Missouri Certificate of Authority #: 001592
1301 Burlington Street

DWG: F:\2019\2001-2500\019-2339-CA 40-Design\AutoCAD\Final Plans - As-Built\Sheets\GNC\A STREET & STORM\CA_INT01_C192339.dwg USER: asyfor
DATE: May 26, 2022 7:36am XREFS: C_PBASE_C192339 C_PBDY_C192339 C_PSTRM_C192339 C_PSSWR_C192339 C_PWATR_C192339 C_PSPOT_C192339

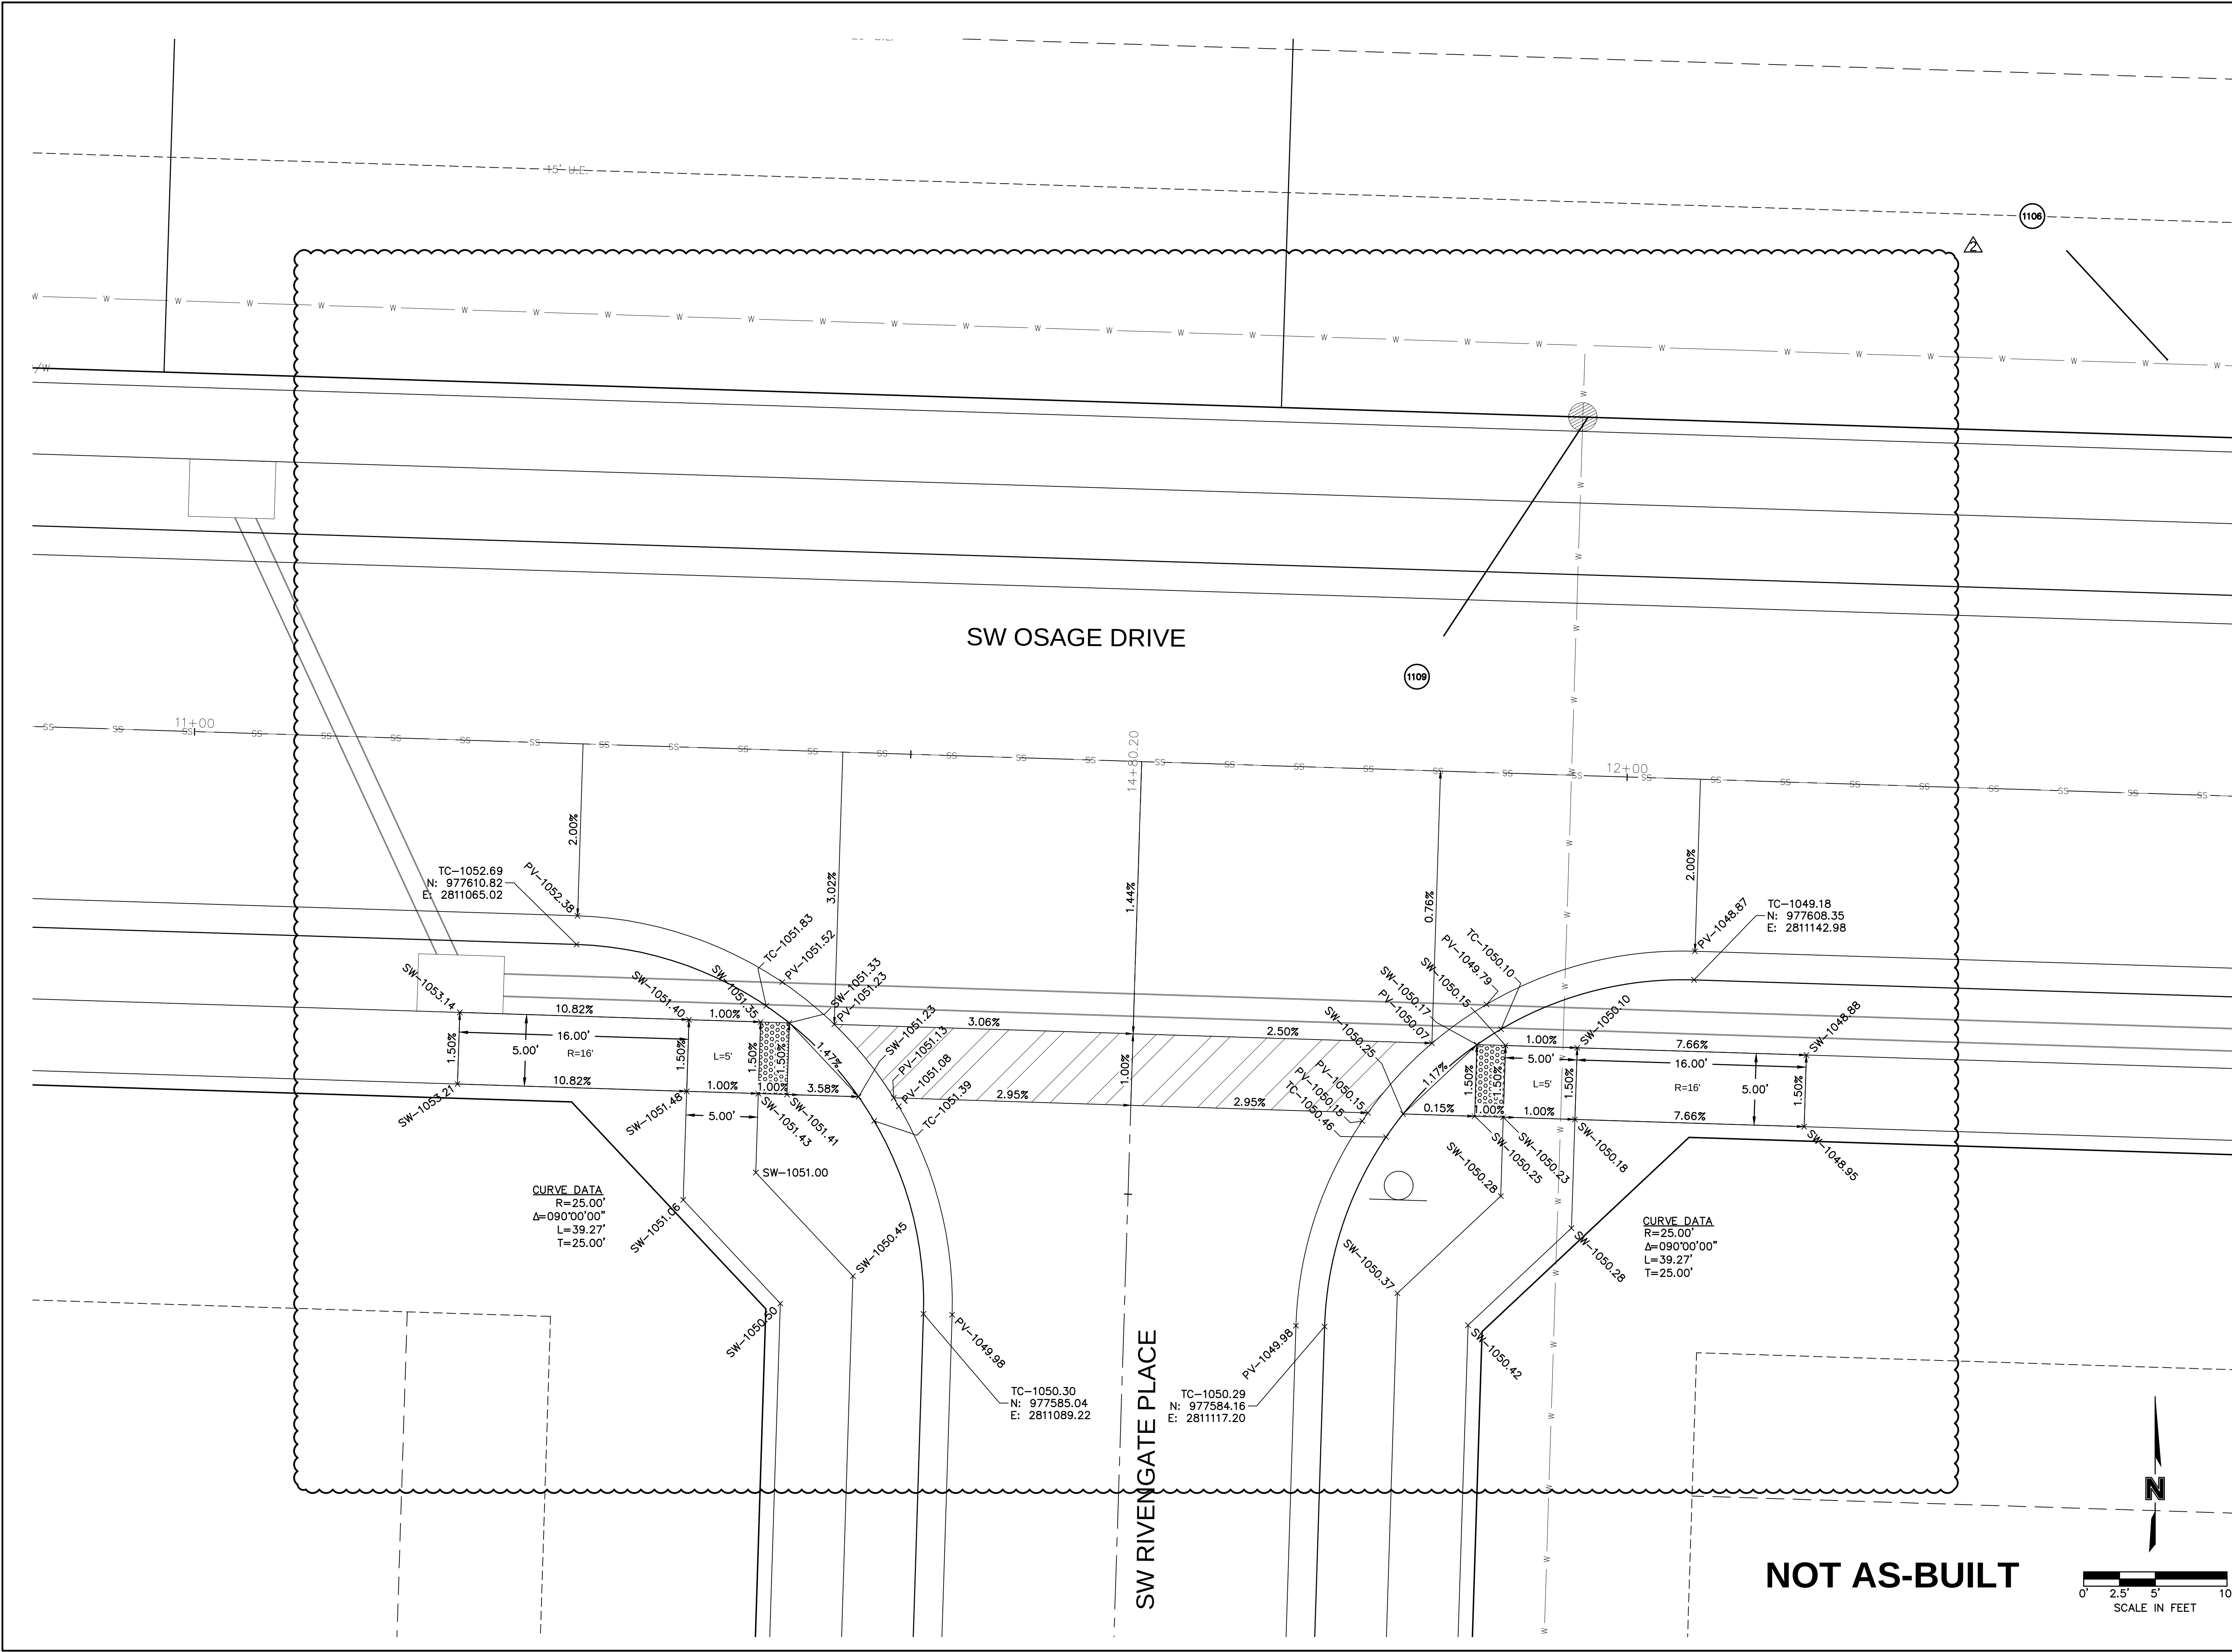

olsson

Olsson - Civil Engineering
Missouri Certificate of Authority #: 001592
1301 Burlington Street
North Kansas City, MO 64116
TEL 816.361.1177
www.olsson.com

STATE OF MISSOURI
JULIE ELAINE SELLERS
Professional Engineer
NUMBER PE-2017000367
3/6/2025

REV. NO.	DATE	REVISIONS DESCRIPTION
2	2021.10.22	REVISED PER CITY COMMENTS

SW OSAGE DRIVE AND SW RIVENGATE PLACE INTERSECTION
STREET & STORM SEWER PLANS


OSAGE
SECOND PLAT

2020


drawn by: D.F./M.O./A.A.
checked by: C.G.W.
designed by: A.A.
QA/QC by: J.E.S.
project no.: C19-2339
drawing no.:
date: 2022.05.26

SHEET
C116

DWG: F:\2019\2001-2500\019-2339-C\40-Design\AutoCAD\Final Plans - As-builts\Sheets\GNVC\STREET & STORM\C_INT01_C192339.dwg
DATE: May 26, 2022 7:36am XREFS: C_PBASE_C192339 C_PBASE_C192339 C_PBDY_C192339 C_PTELK_C192339 C_PSTRM_C192339 USER: ssqvor

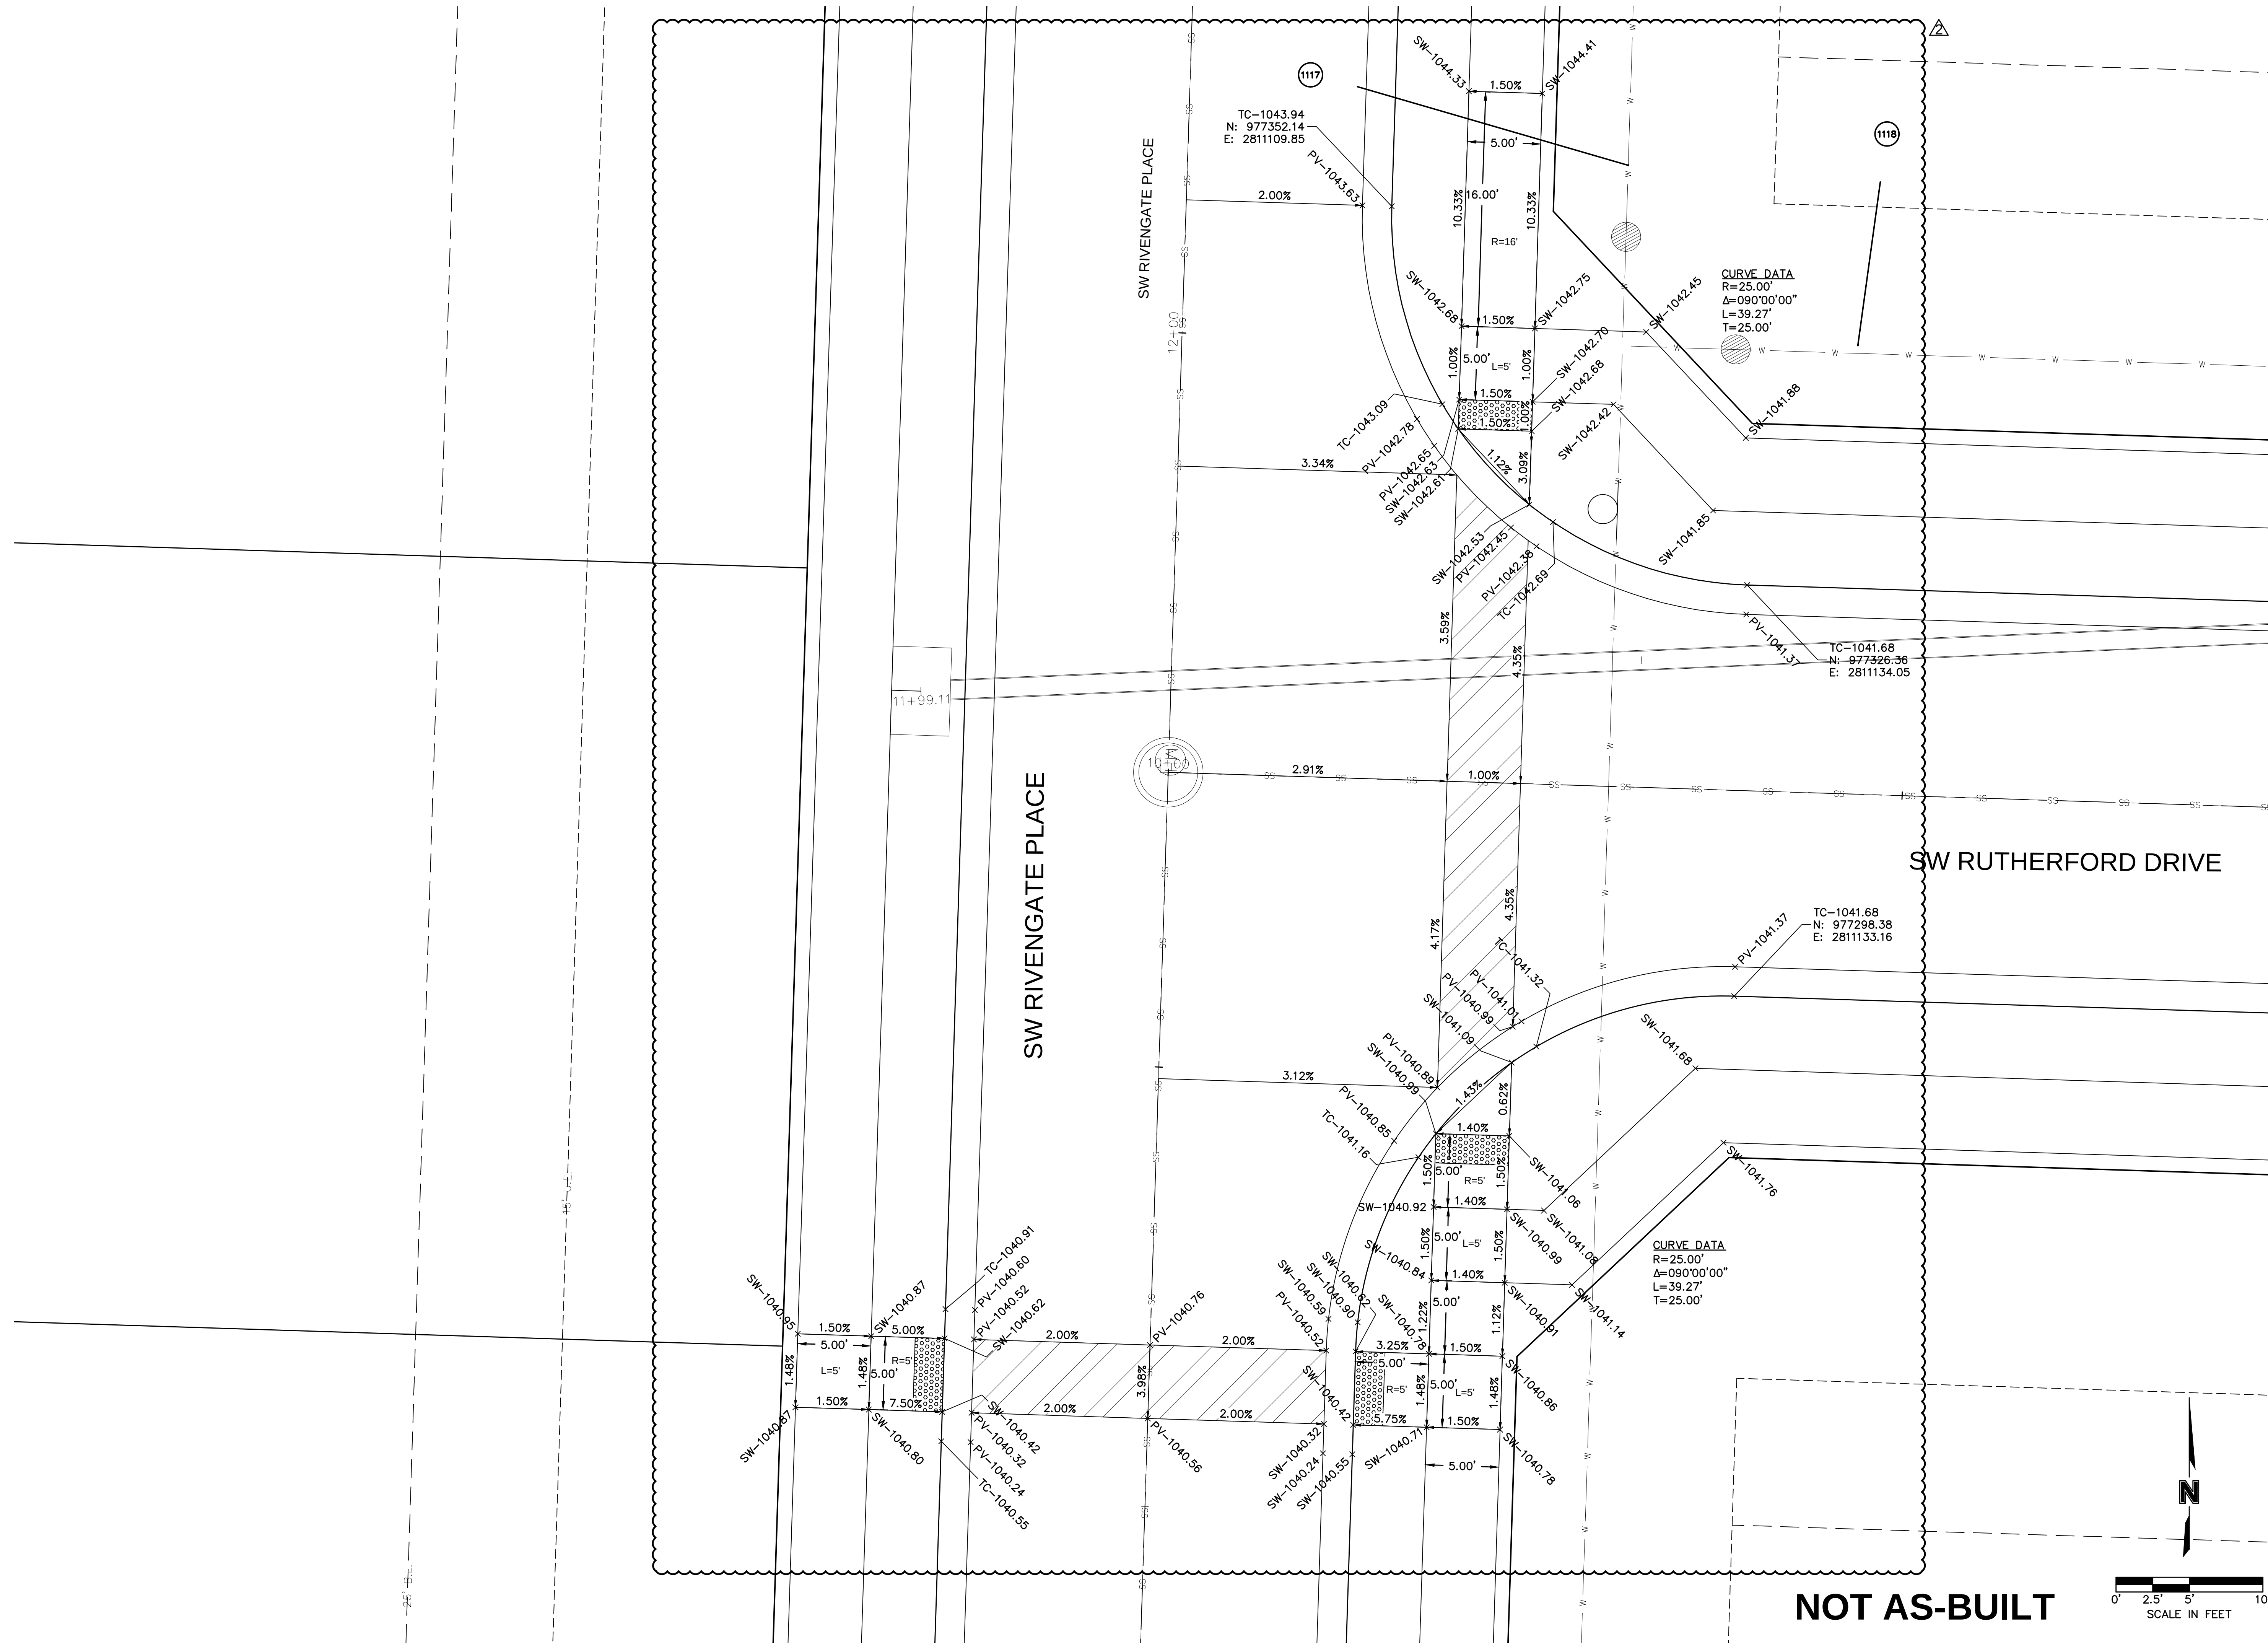


NOT AS-BUILT

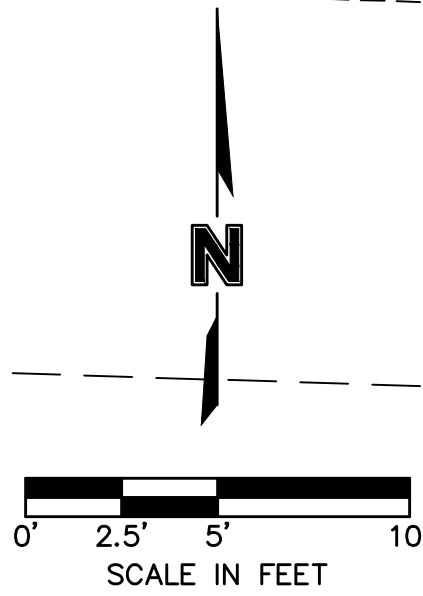

SW RIVENGATE PLACE AND SW RUTHERFORD DRIVE INTERSECTION STREET & STORM SEWER PLANS

OSAGE
SECOND PLAT

2020



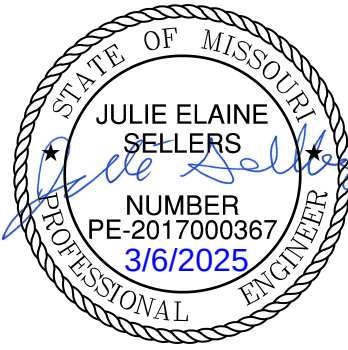
[illegible]

olson

Olsson - Civil Engineering
Missouri Certificate of Authority #: 001592
1301 Burlington Street
North Kansas City, MO 64116

TEL 816.361.1177 www.olsson.com


DWG: F:\2019\2001-2500\019-2339-C\40-Design\AutoCAD\Final Plans - As-Built\Sheets\GNCV\STREET & STORM\C_STM01_C192339.dwg
DATE: May 26, 2022 7:36am XREFS: C_PBASE_C192339 C_PBASE_C192339 C_PBNY_C192339 C_PBLK_C192339 C_PSTM_C192339 USER: ssaylor

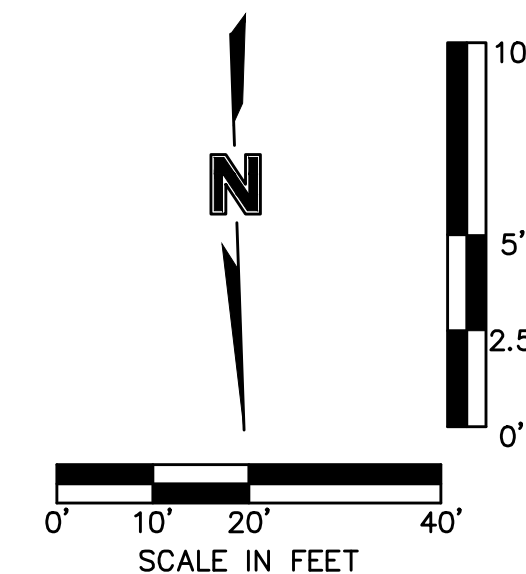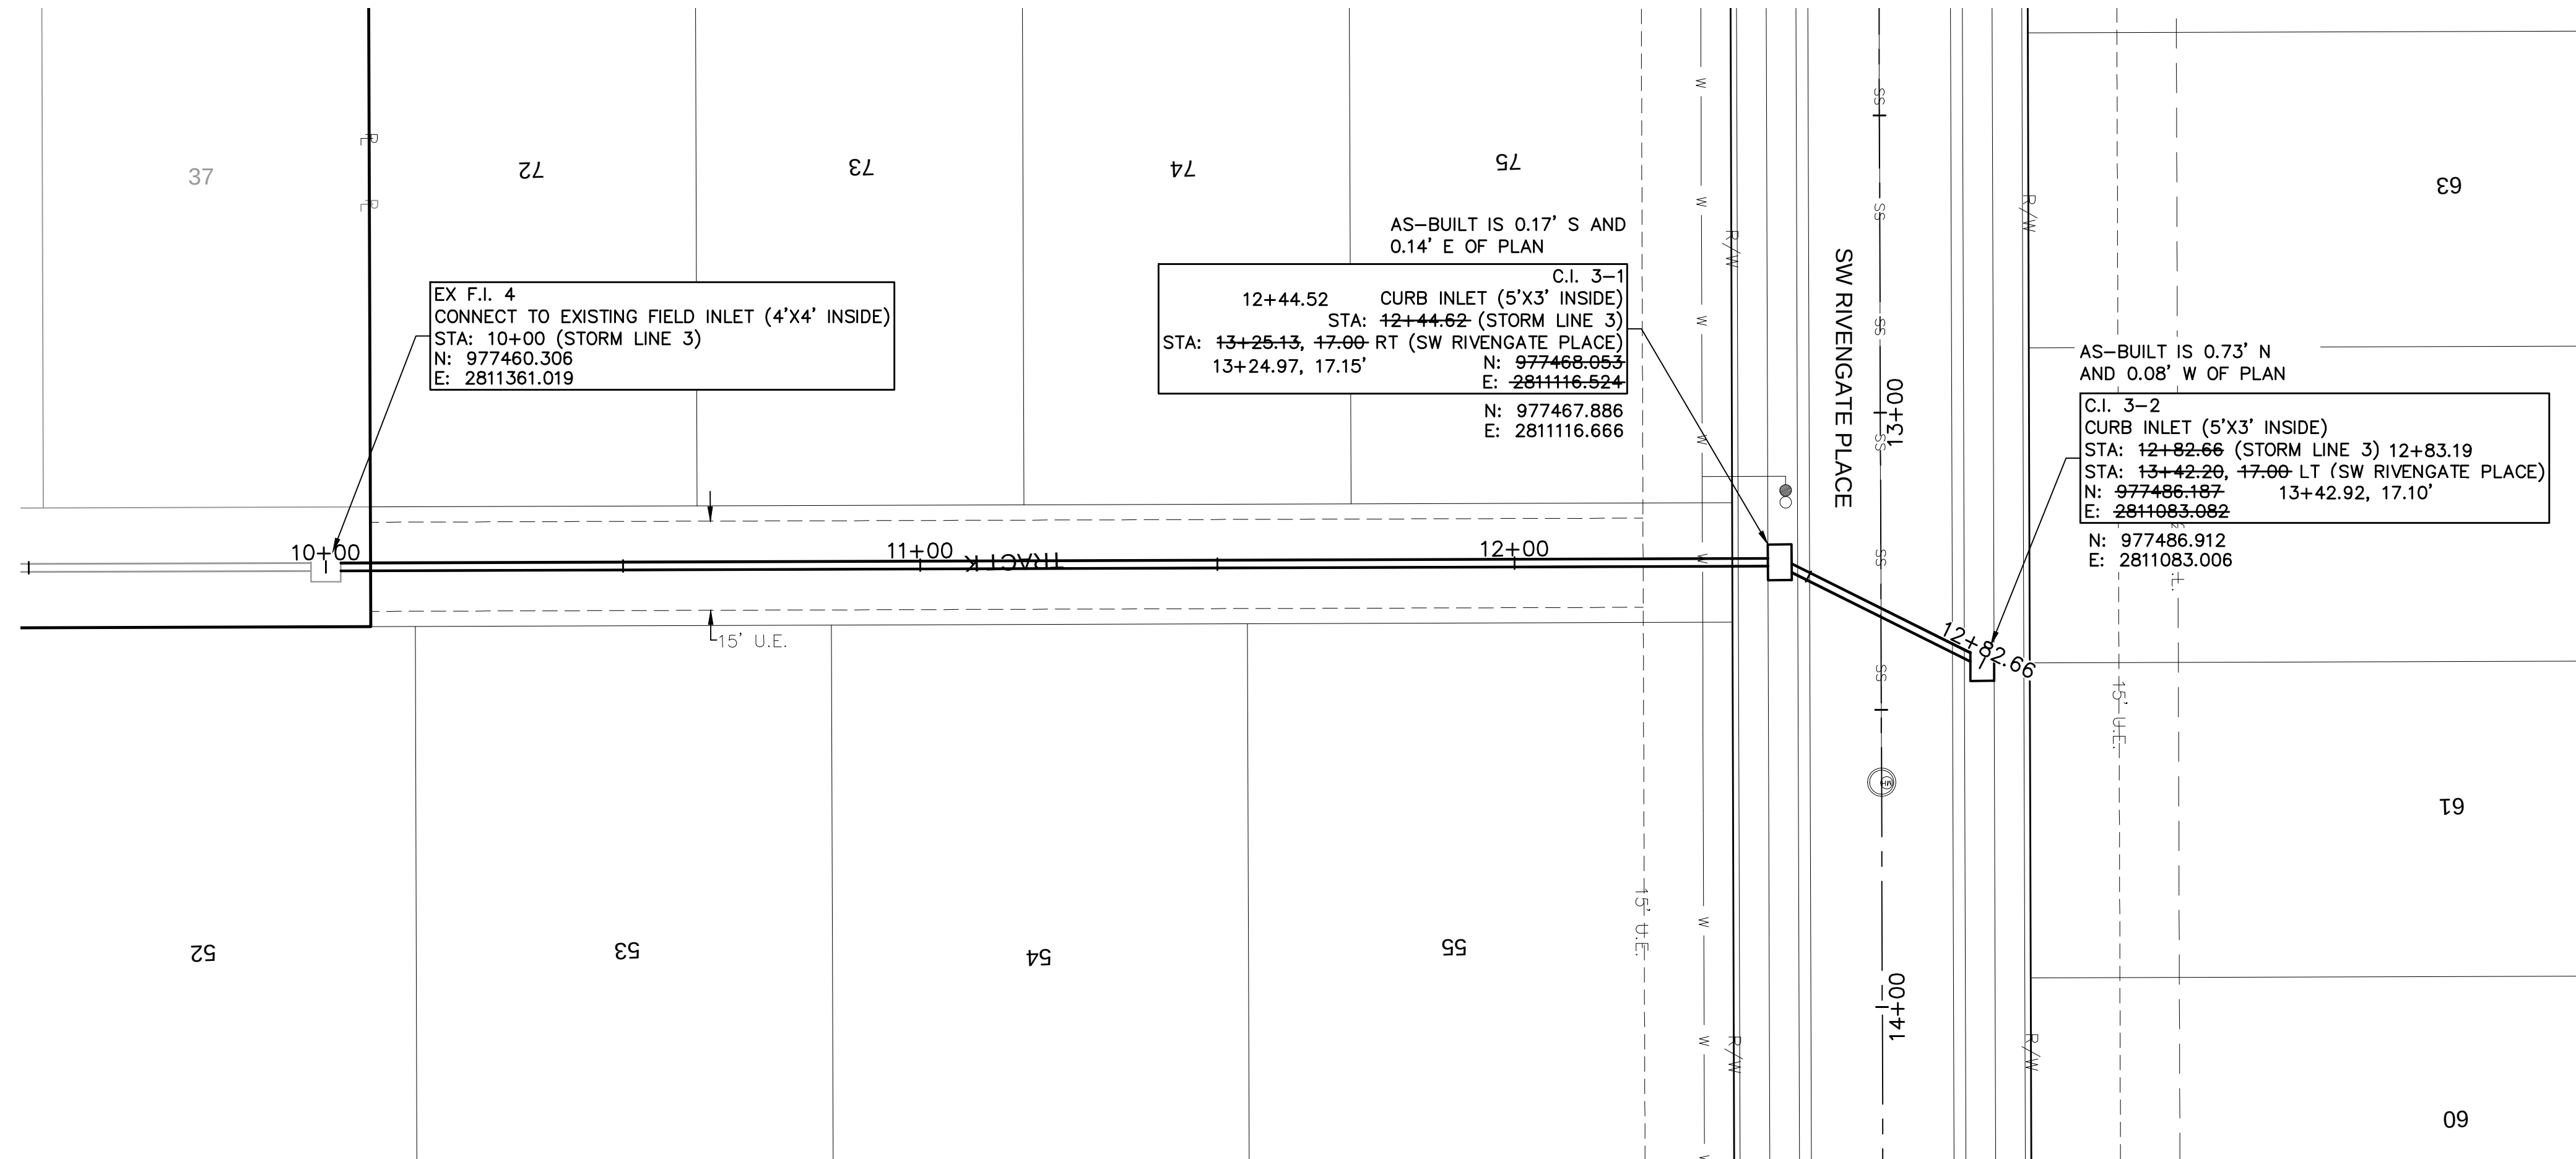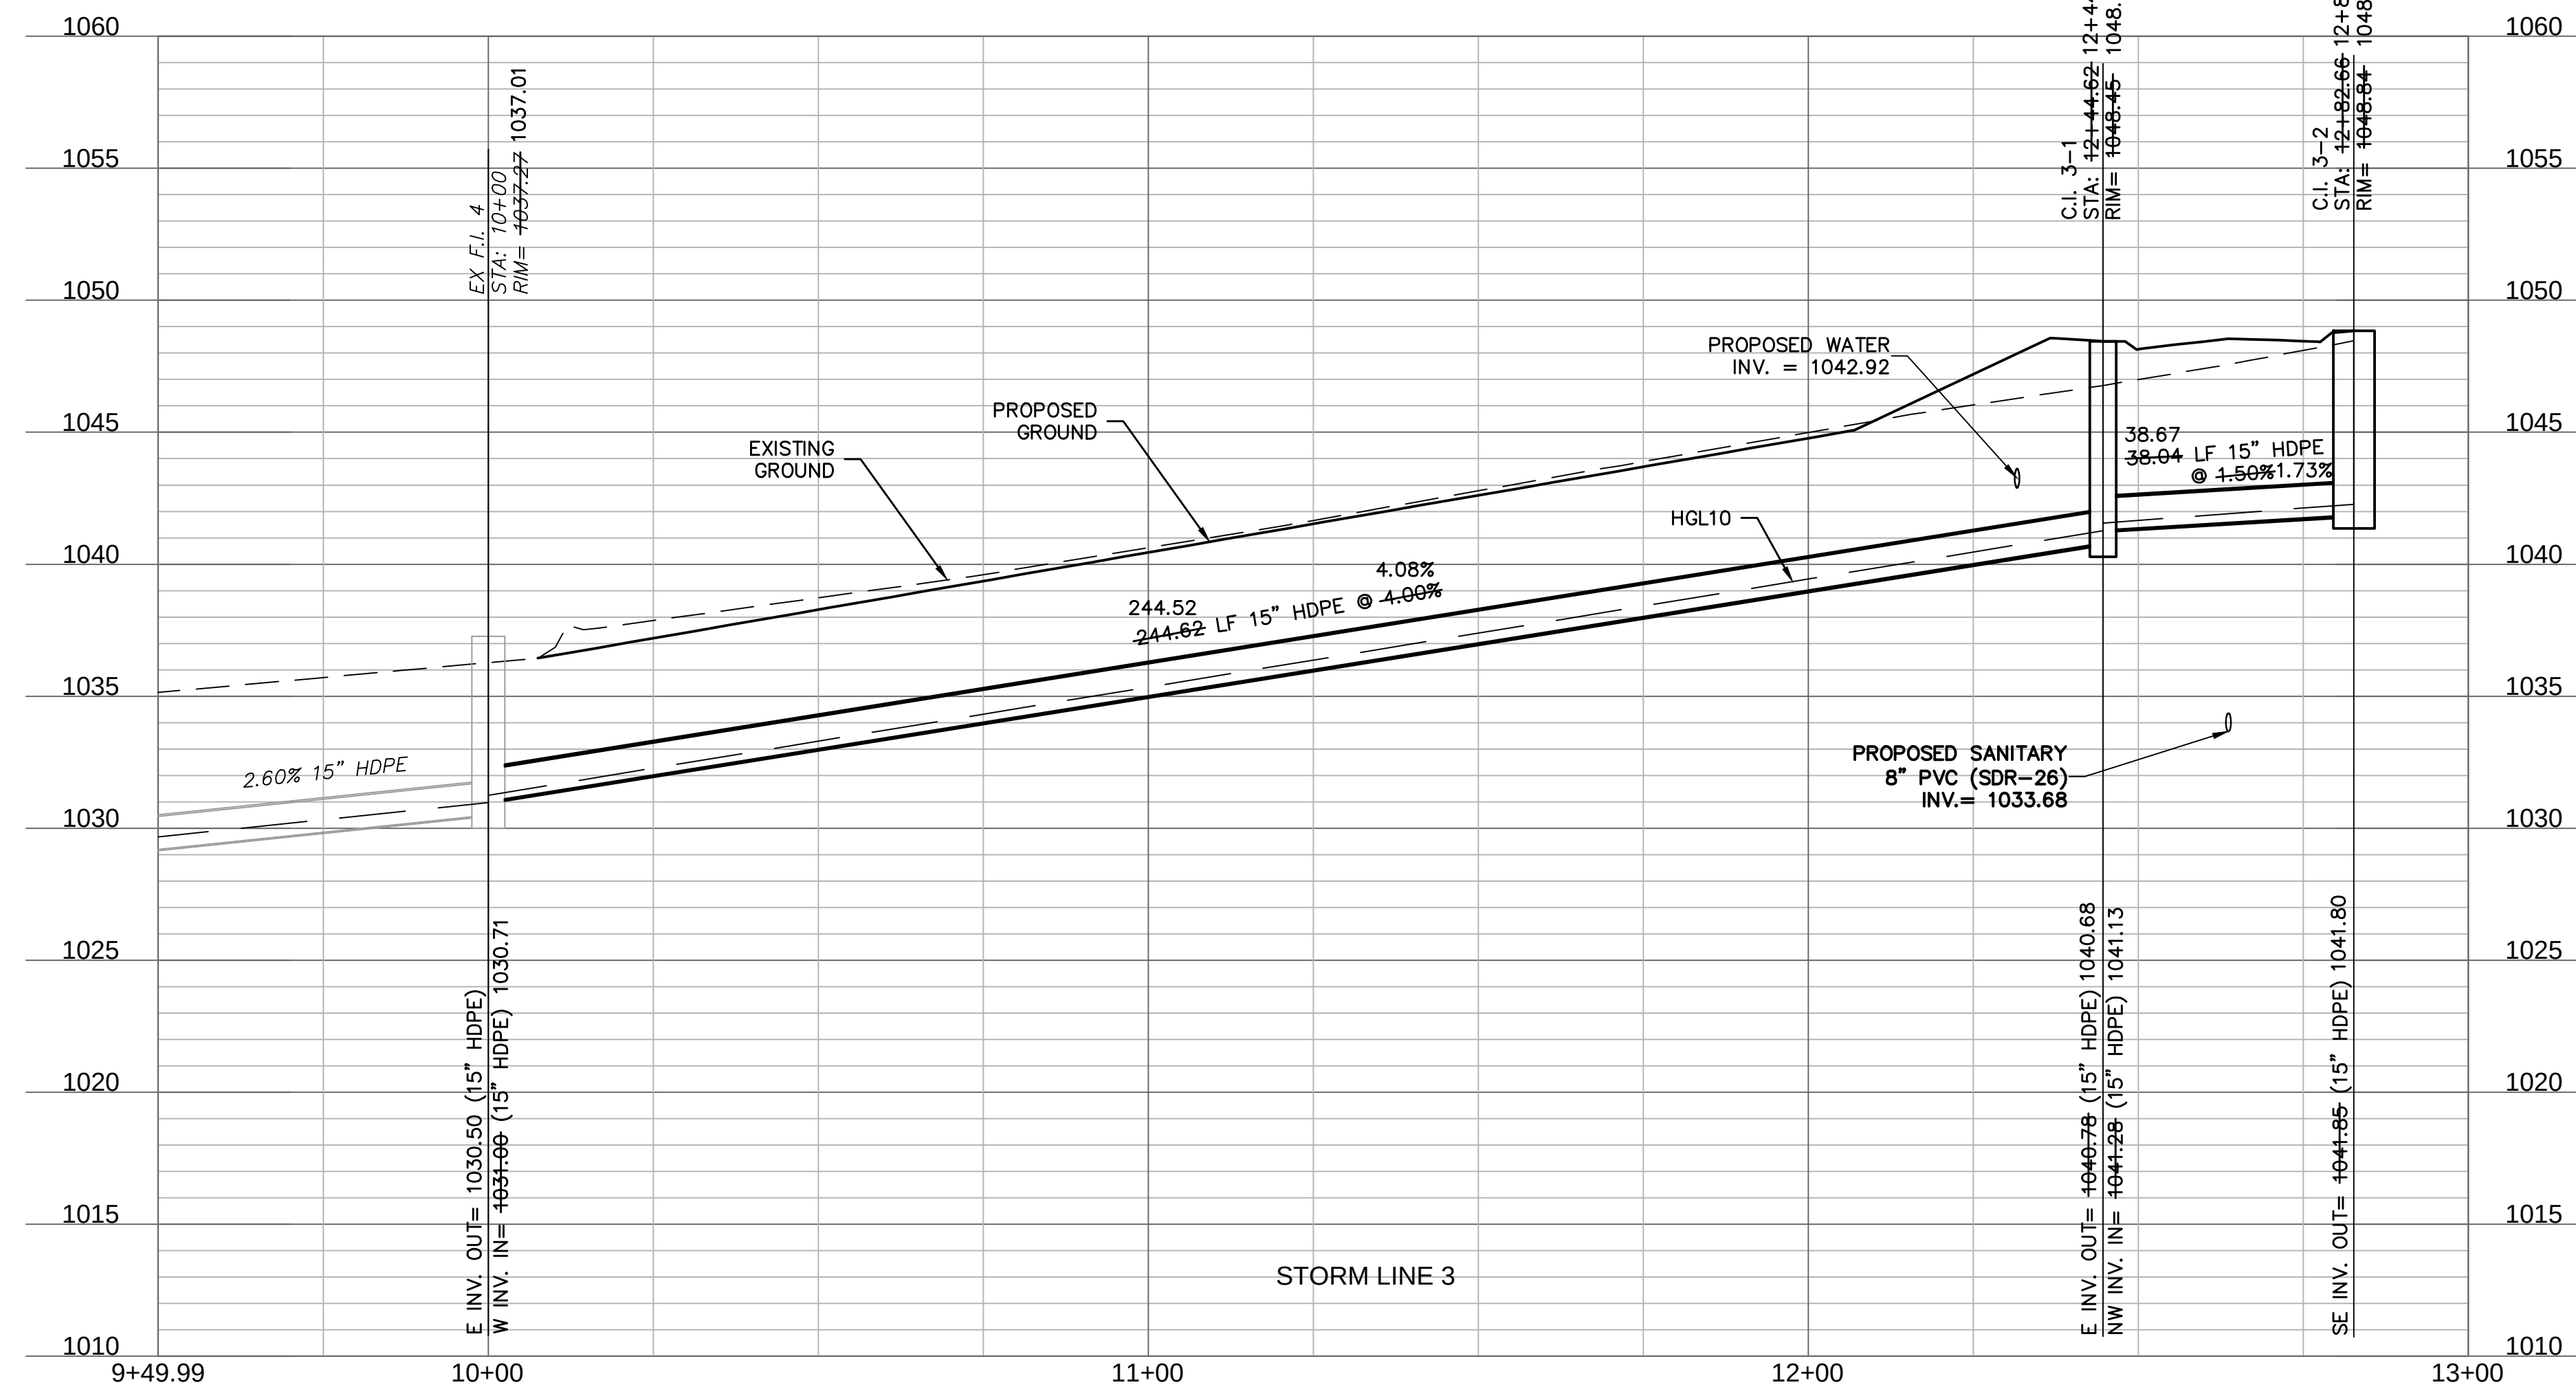


AS-BUILT

STORM SEWER PLAN & PROFILE (LINE 3) STREET & STORM SEWER PLANS		REV. NO.		DATE	REVISIONS DESCRIPTION
OSAGE SECOND PLAT					
2020					
drawing by: _____ D.F. / M.O. / A.A.					
checked by: _____ C.G.W.					
designed by: _____ A.A.					
QA/QC by: _____ J.E.S.					
project no.: _____ C19-2339					
drawing no.: _____					
date: _____ 2022.05.26					
SHEET C120					

DWG: F:\2019\2001-2500\019-2339-CA40-Design\AutoCAD\Final Plans - As-Built\Sheets\GNCV\STREET & STORM\C_STM02_C192339.dwg USER: ssc/dor
DATE: May 26, 2022 7:37am XREFS: C_PBASE_C192339 C_PBDY_C192339 C_PBLK_C192339 C_PSTRM_C192339 C_PSSWR_C192339 C_PWATR_C192339

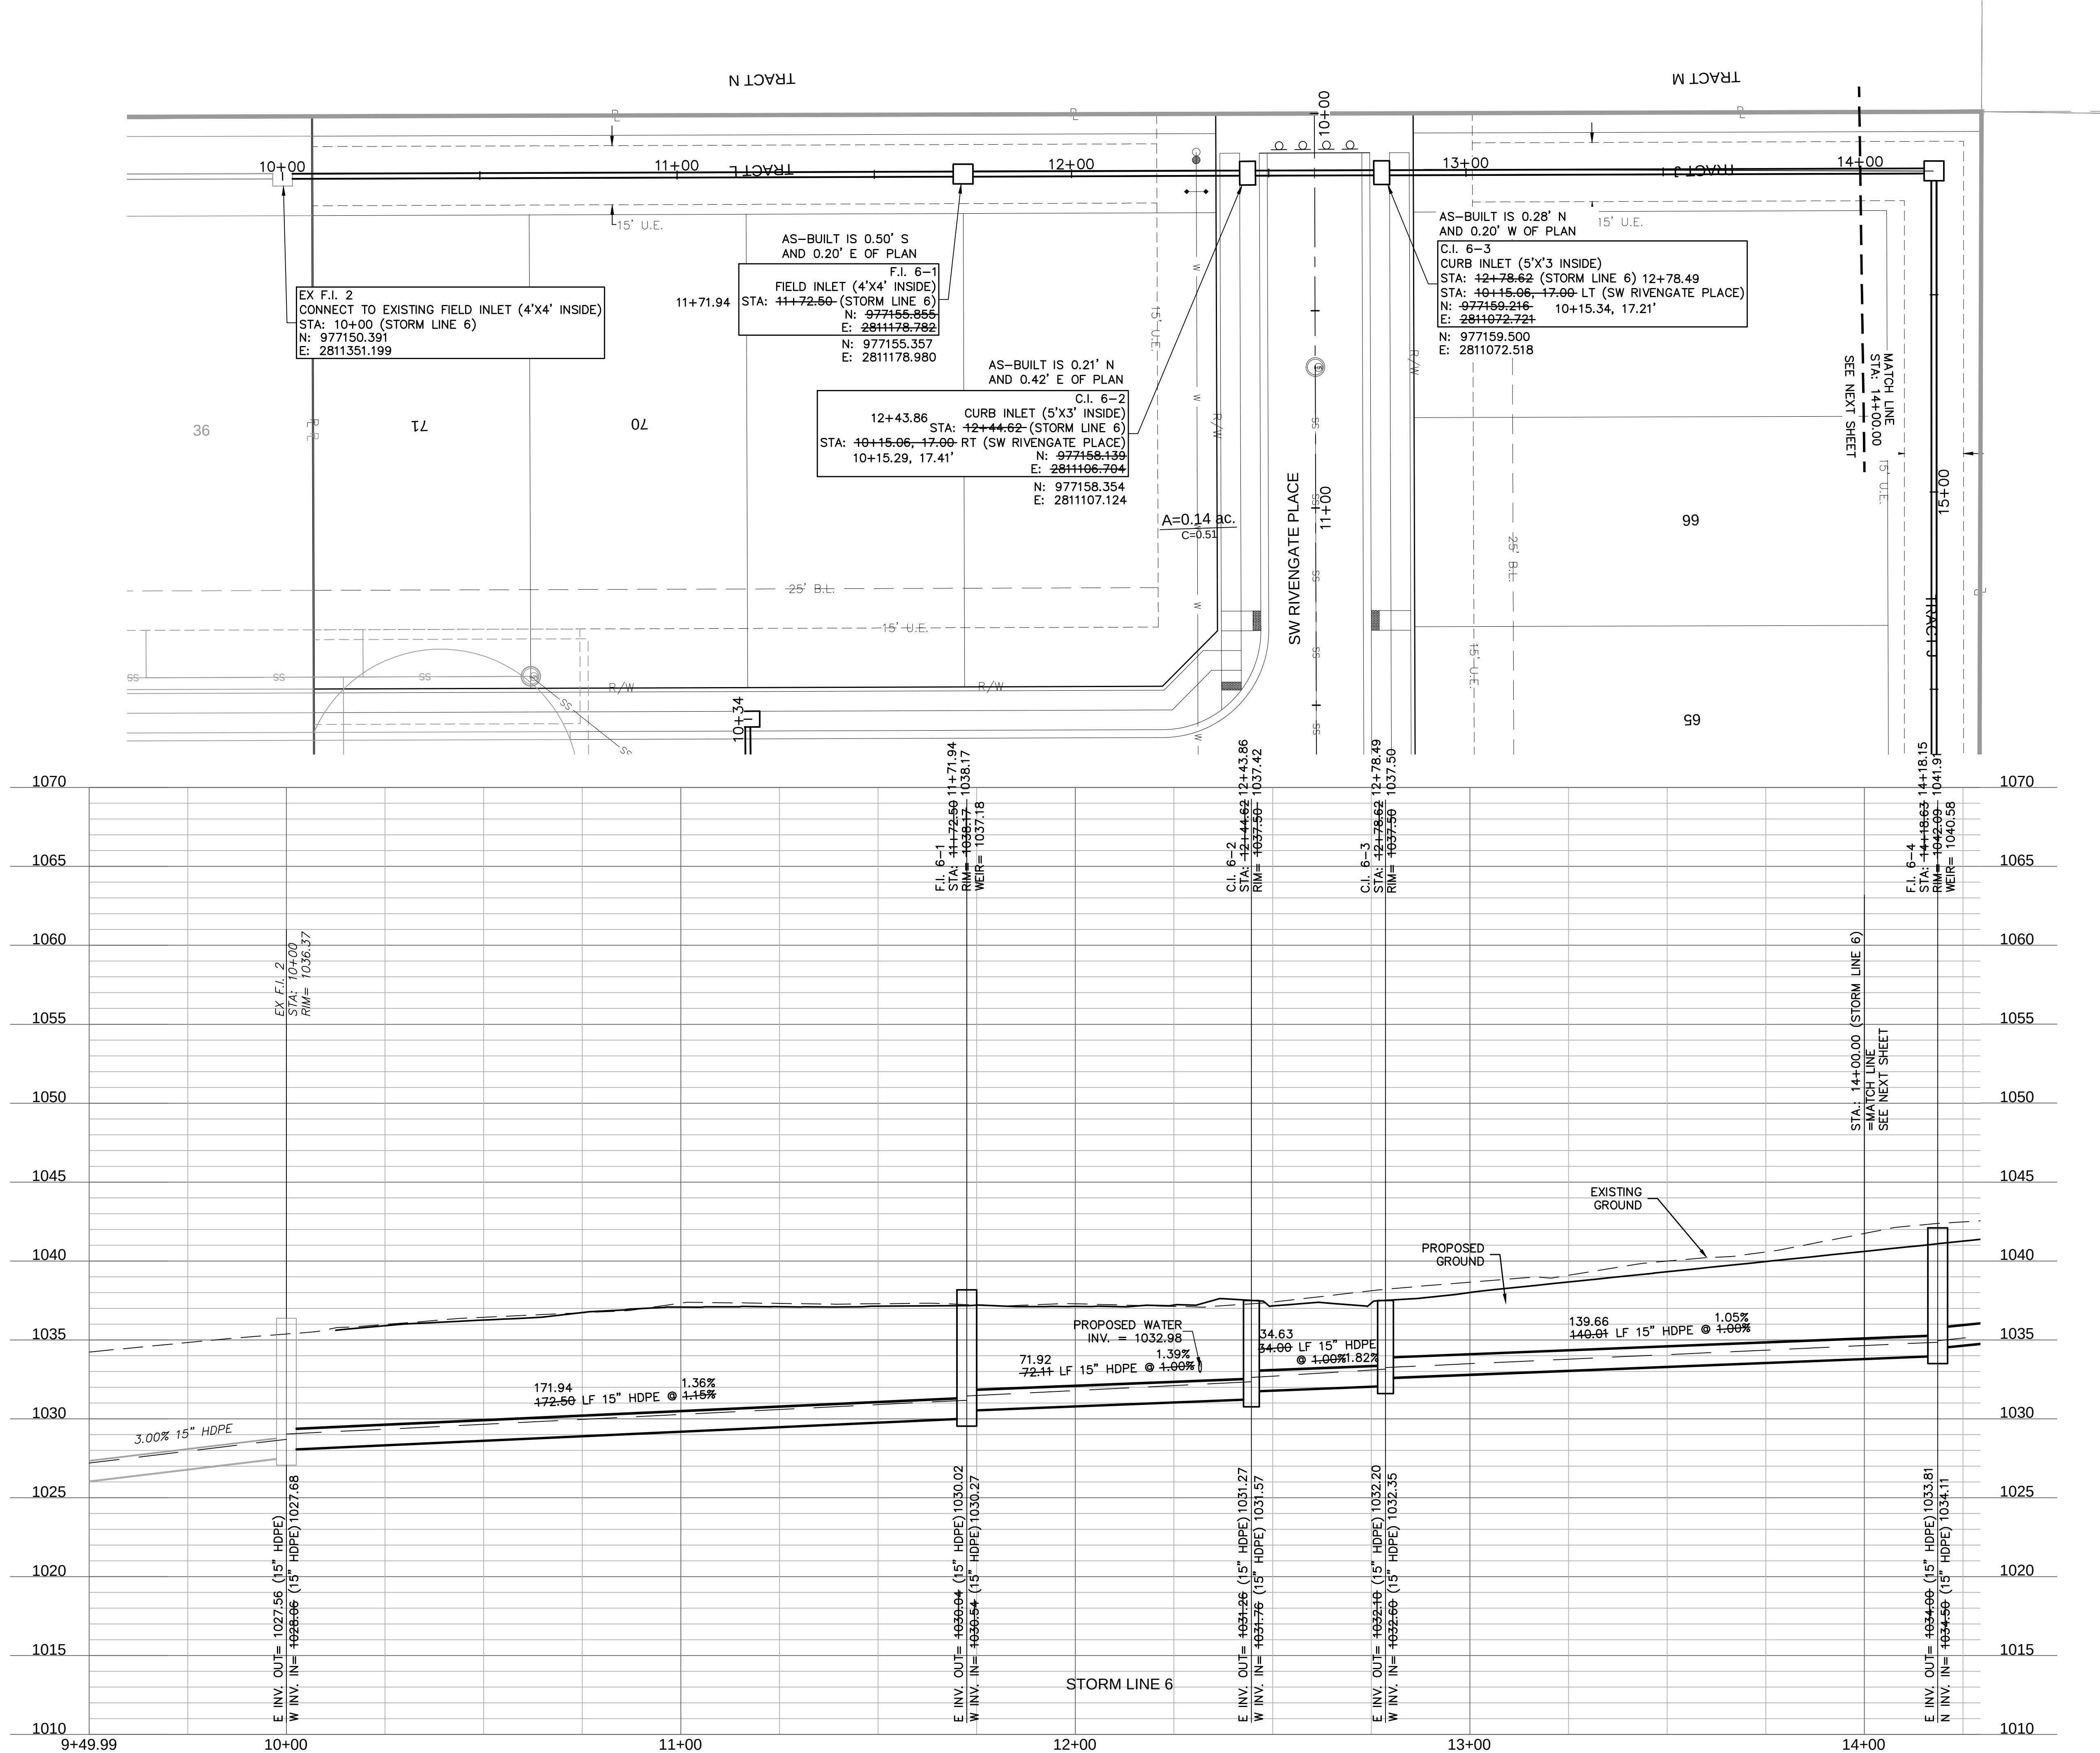

AS-BUILT

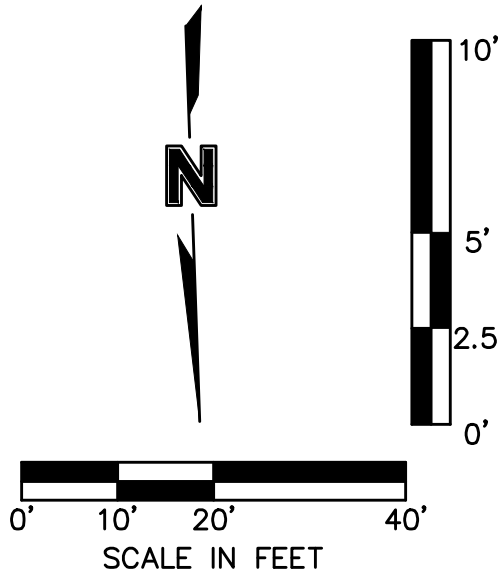

olsson

Olsson - Civil Engineering
Missouri Certificate of Authority #: 001592
1301 Burlington Street
North Kansas City, MO 64116
TEL 816.361.1177
www.olsson.com

STATE OF MISSOURI
JULIE ELAINE
SELLERS
Professional Engineer
NUMBER
PE-2017000367
3/6/2025

REVISIONS







2020

STORM SEWER PLAN & PROFILE (LINE 6)
STREET & STORM SEWER PLANS
SECOND PLAT
OSAGE

drawn by: D.F./M.O./A.A.
checked by: C.G.W.
designed by: A.A.
QA/QC by: J.E.S.
project no.: C19-2339
drawing no.:
date: 2022.05.26

SHEET
C122

DWG: F:\2019\2001-2500\019-2339-CL40-Design\AutoCAD\Final Plans - As-Built\Sheets\GNC\A\STREET & STORM\CL40-2339-CL40-2339.dwg USER: secdor
DATE: May 26, 2022 7:37am XREFS: C_PBASE_C192339 C_PBDY_C192339 C_PBLK_C192339 C_PSTRM_C192339 C_PSSWR_C192339 C_PWATR_C192339

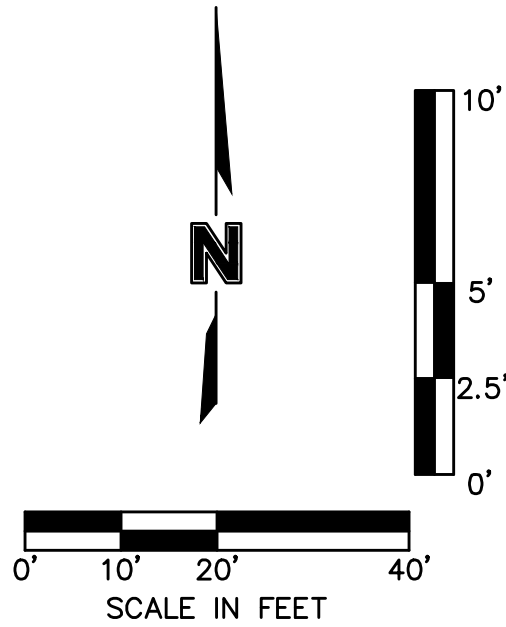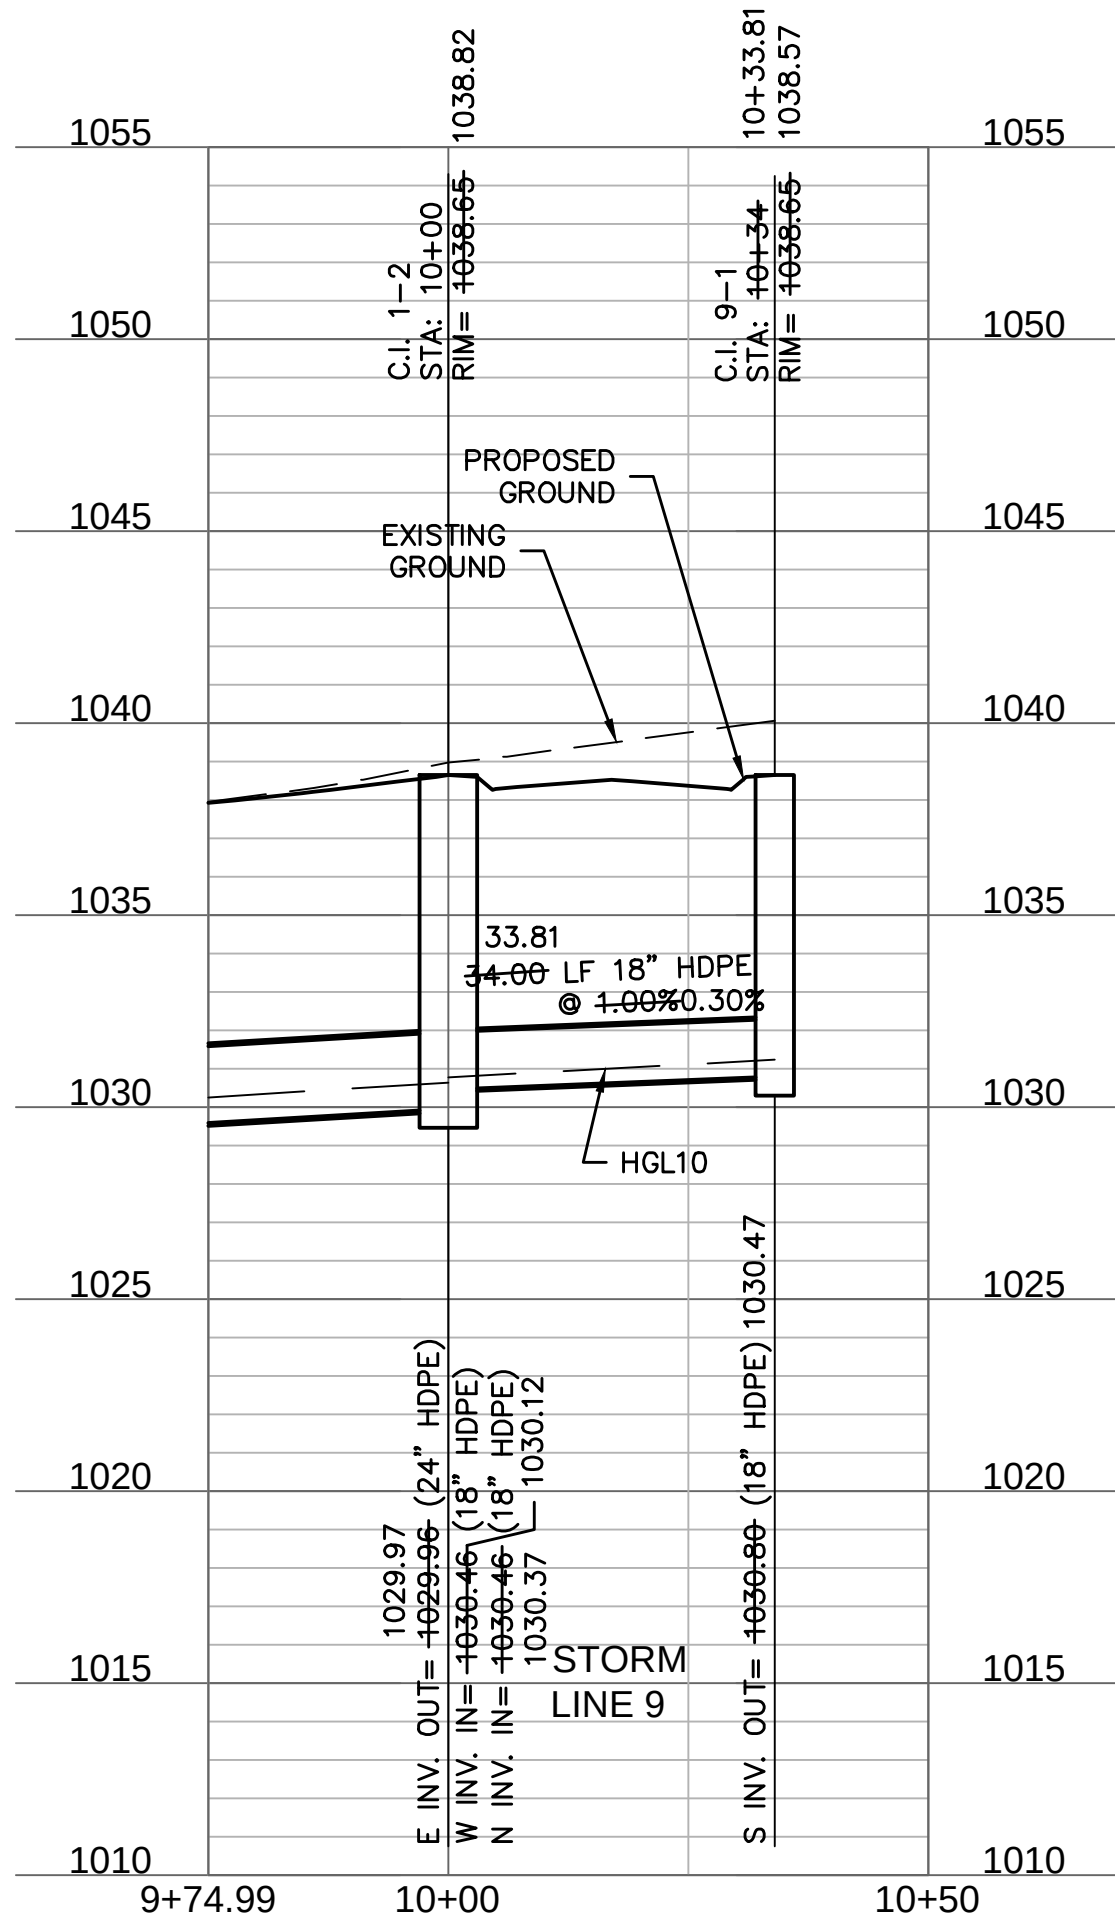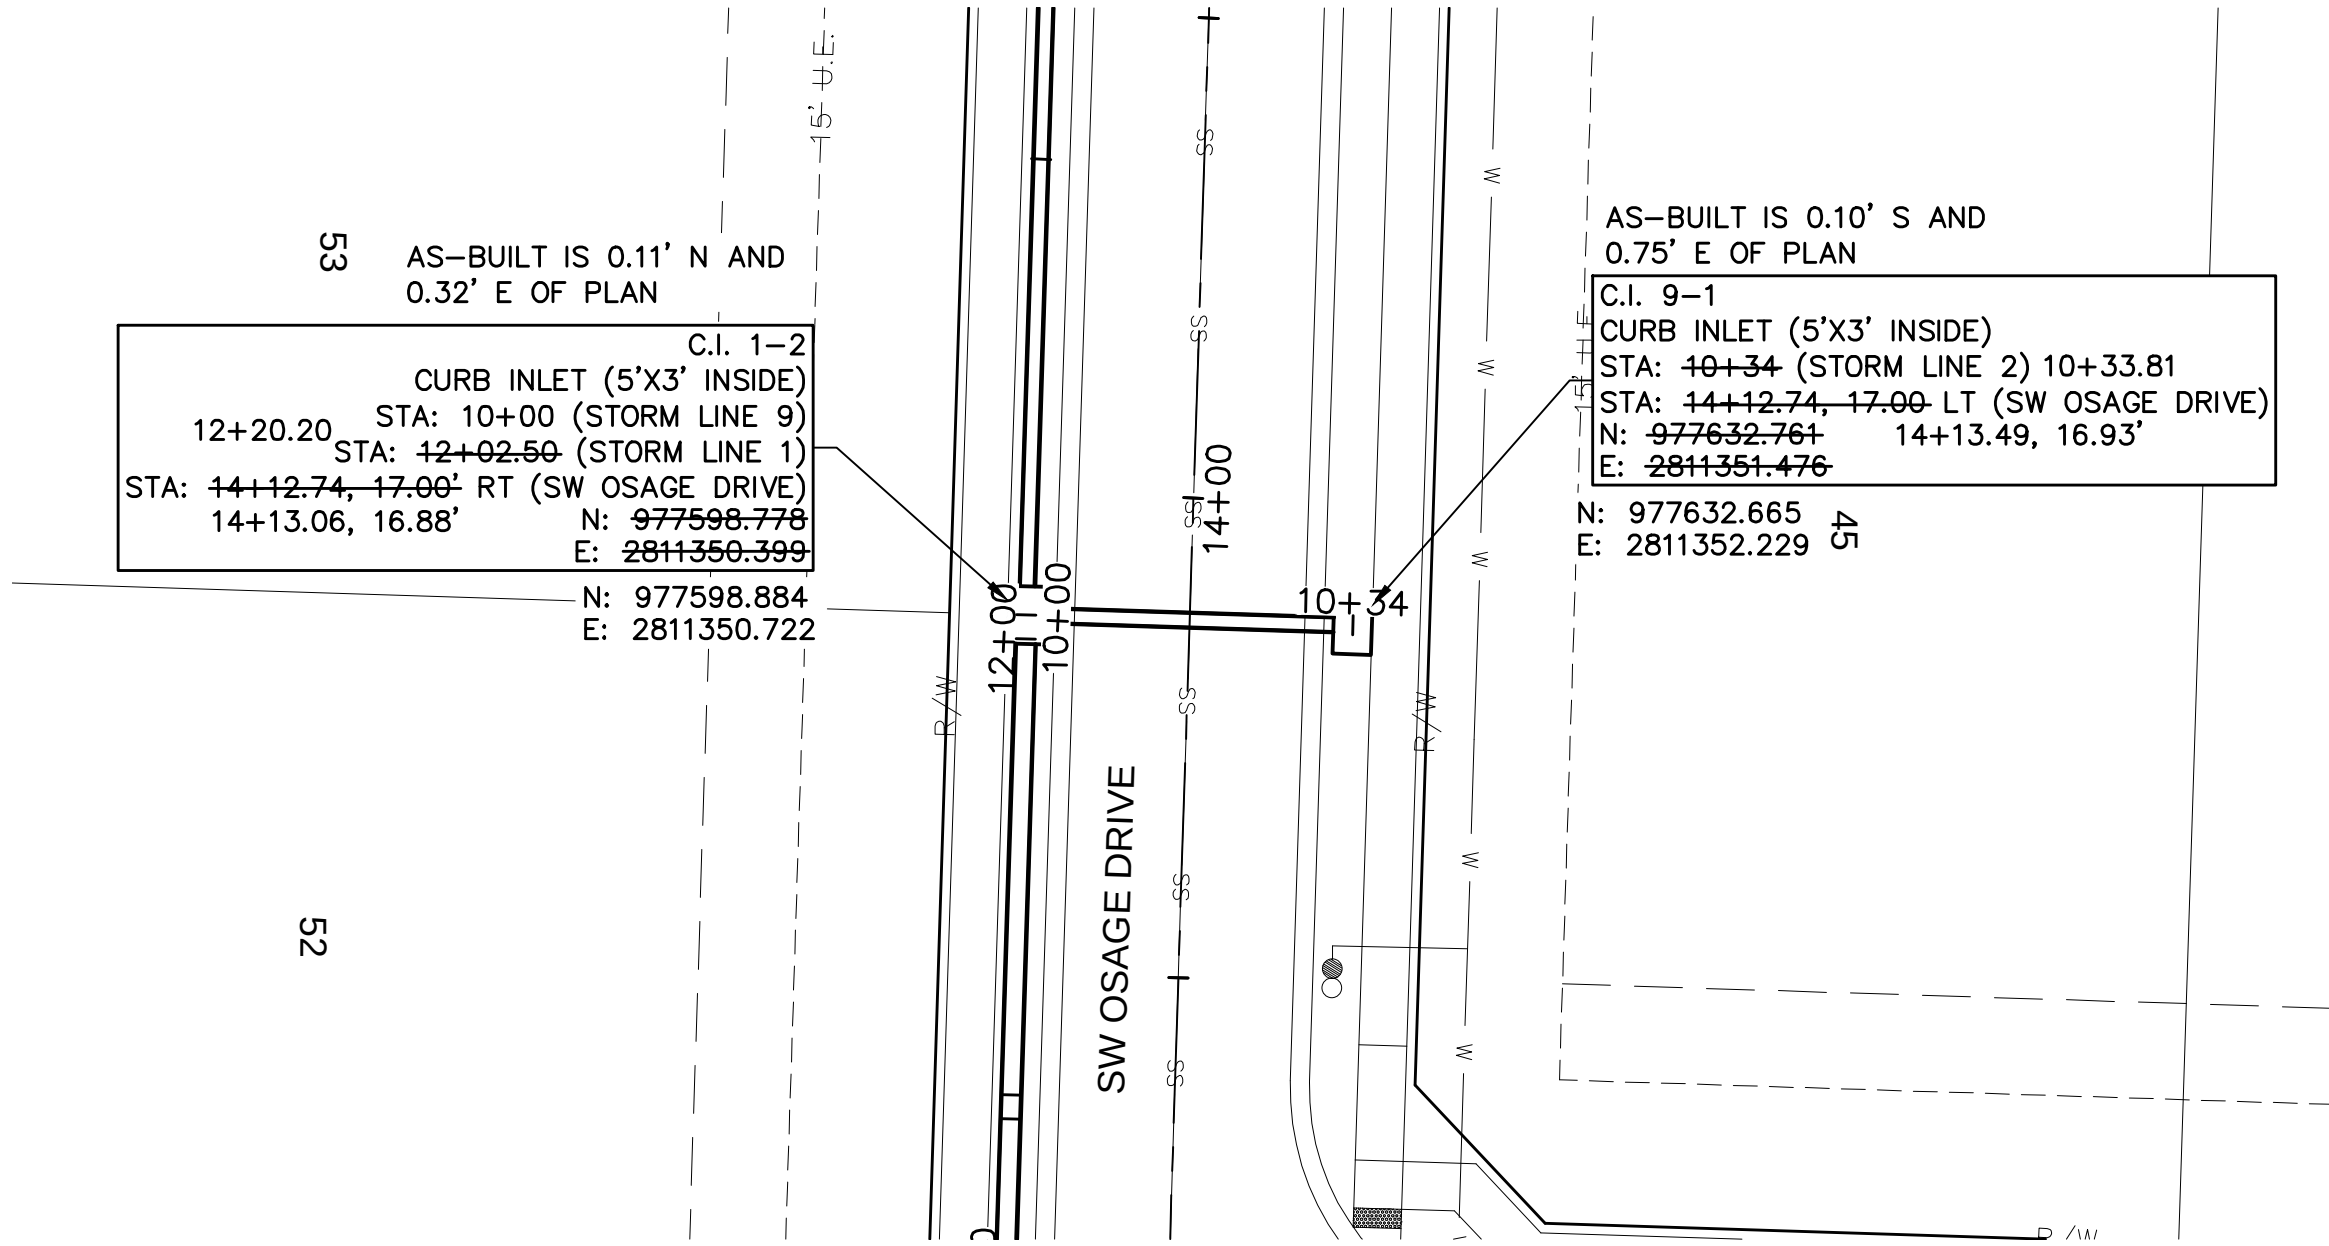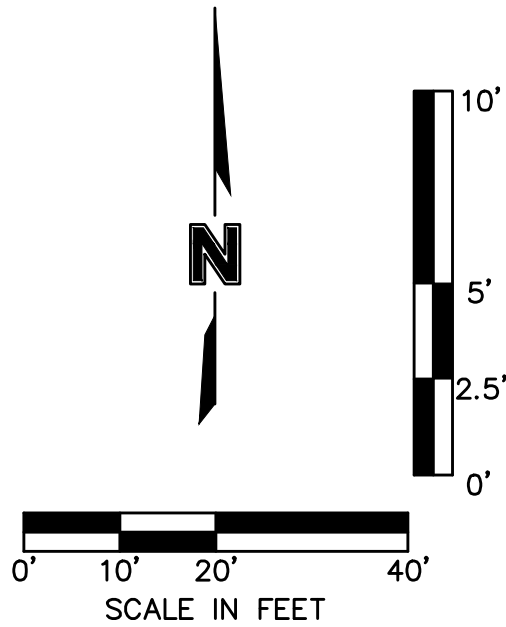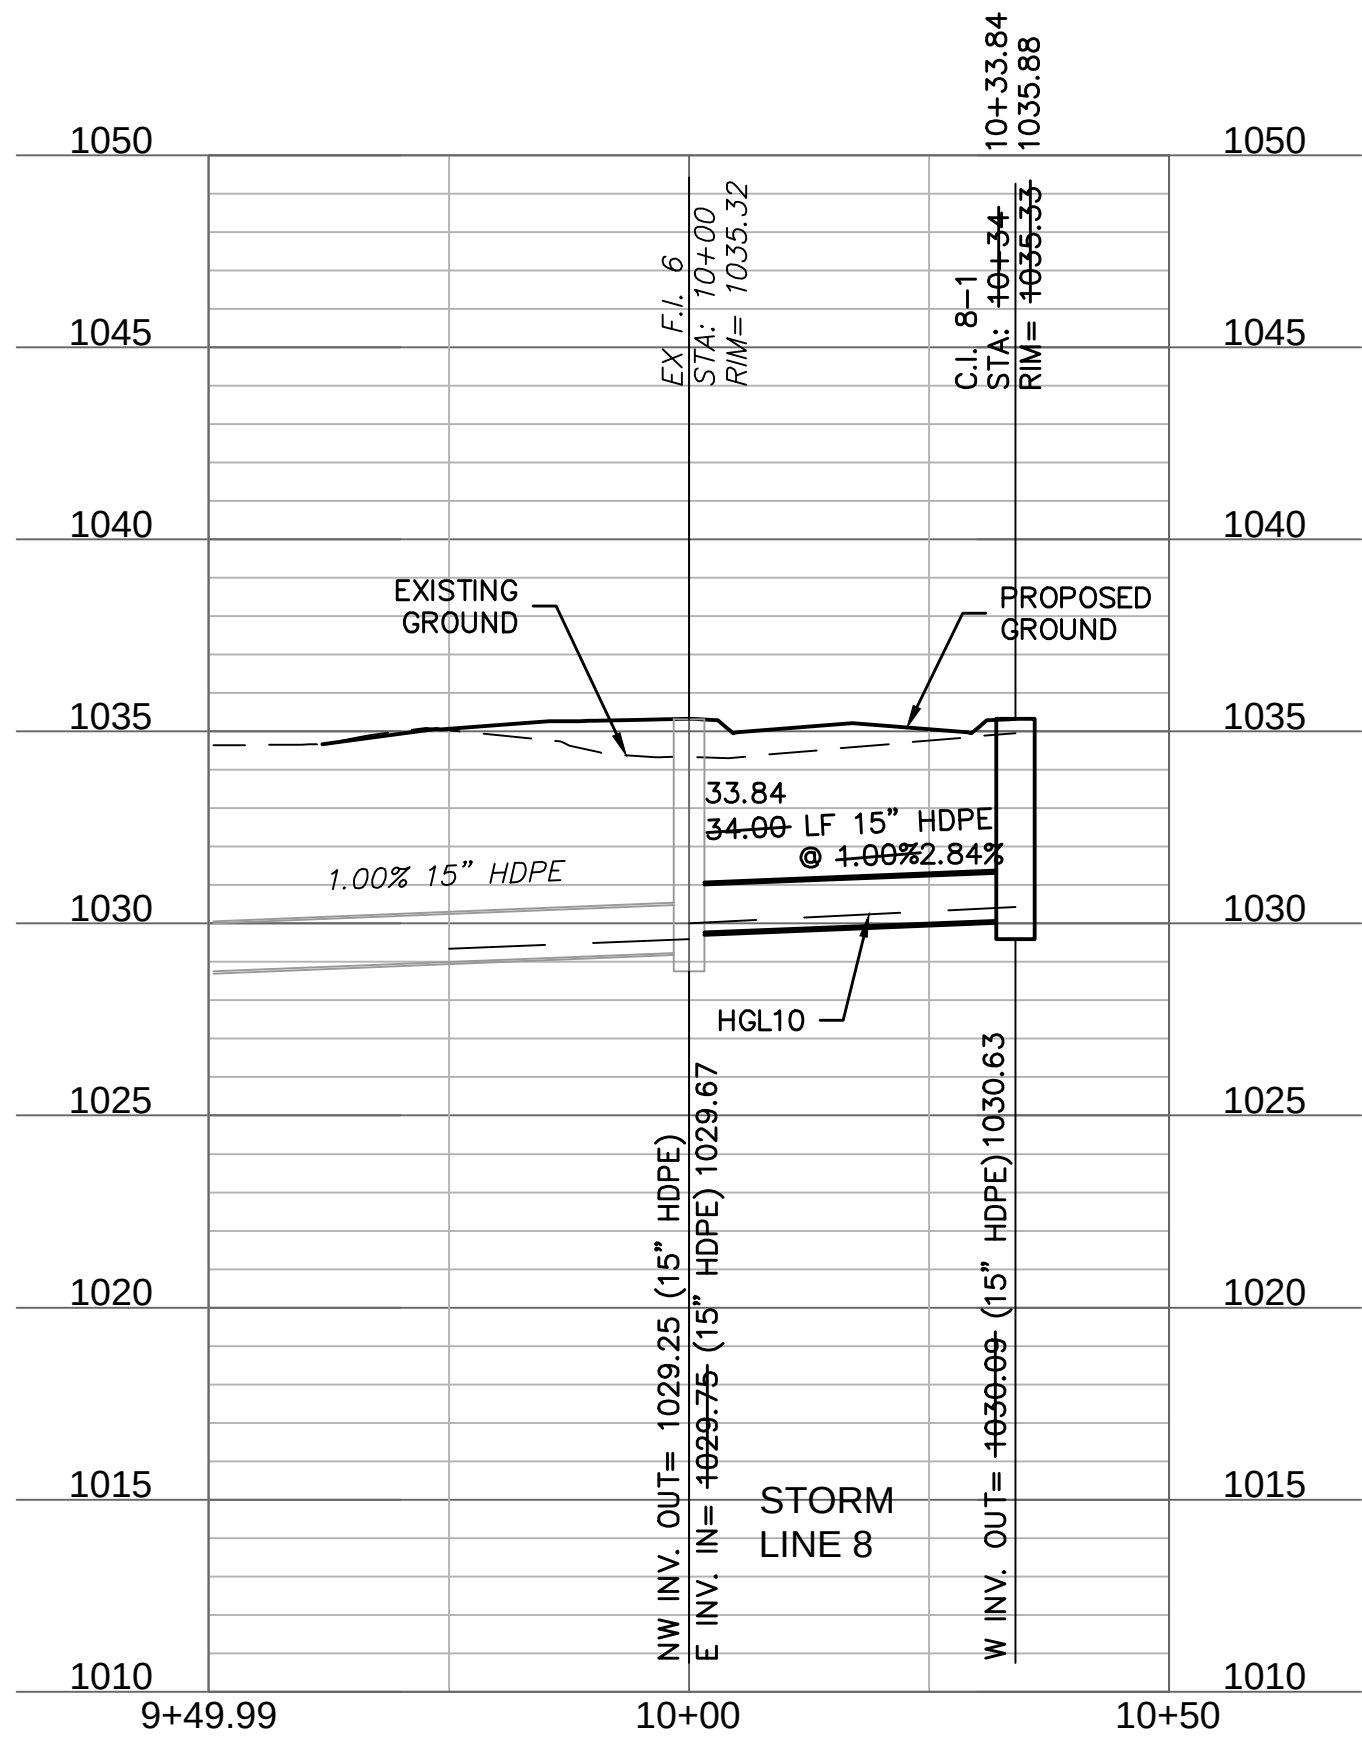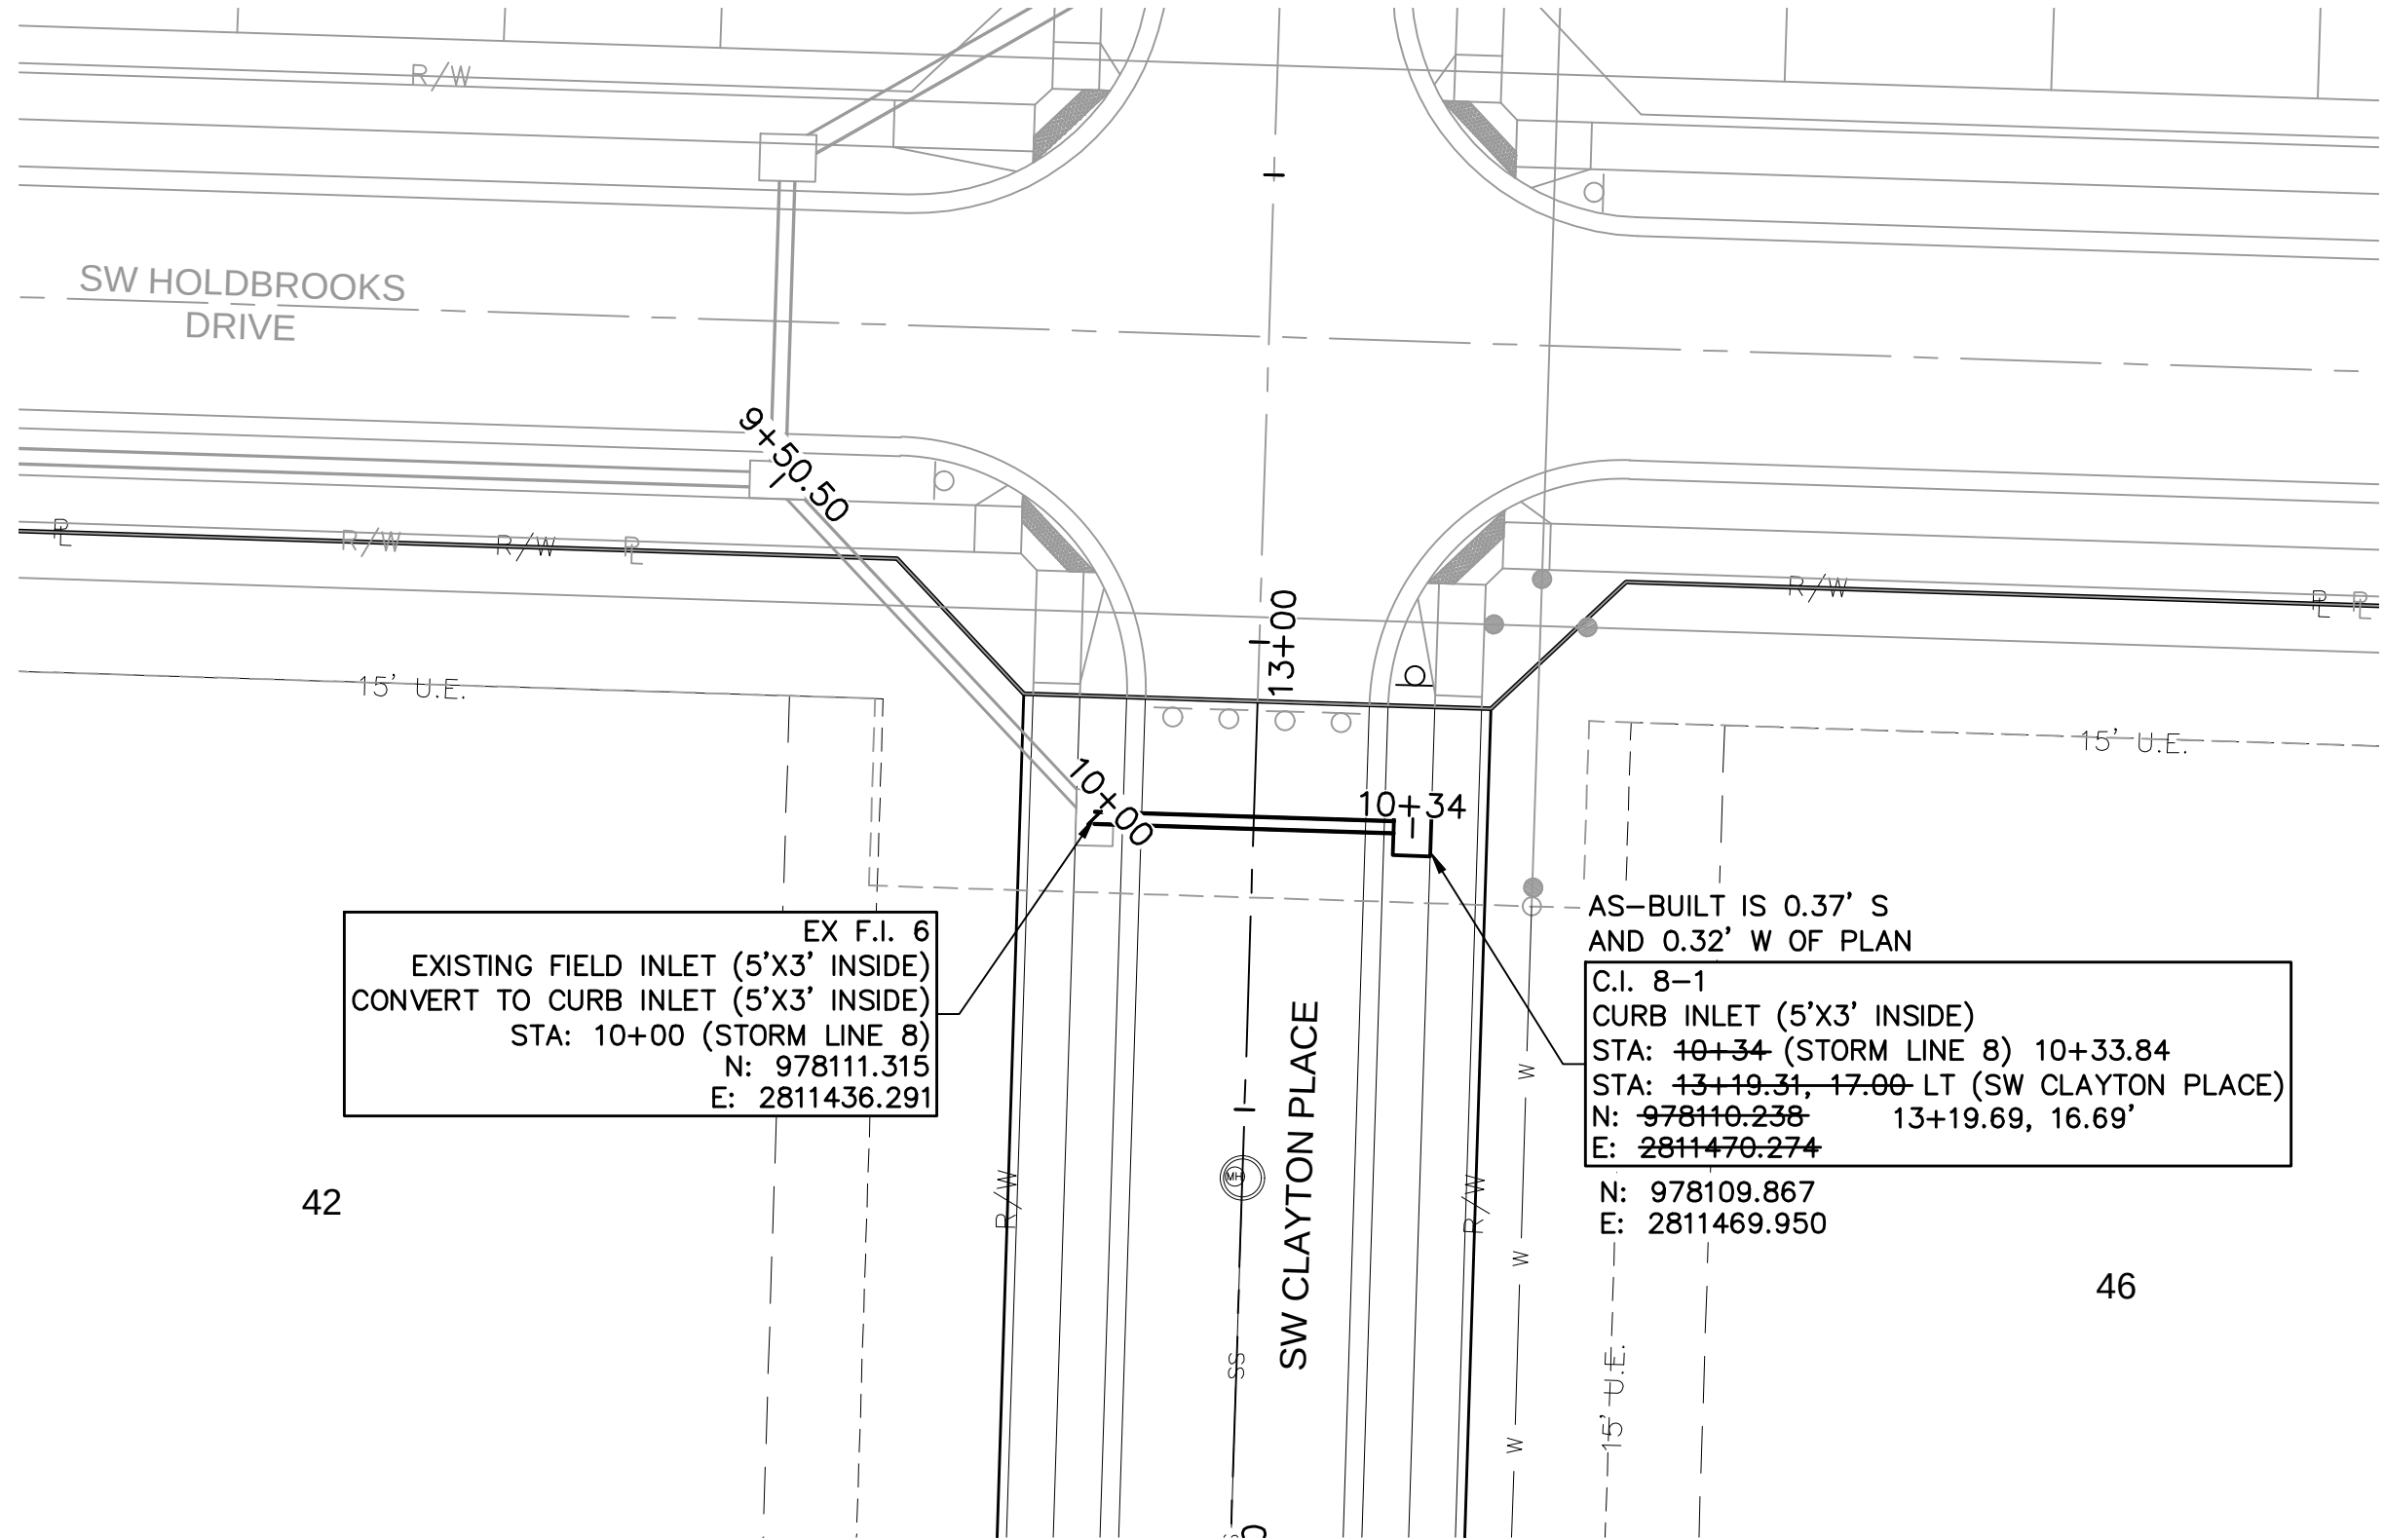

AS-BUILT

STORM SEWER PLAN & PROFILE (LINES 8 & 9)
STREET & STORM SEWER PLANS

OSAGE
SECOND PLAT


2020

REVISIONS DESCRIPTION

DATE

REV. NO.

REVISIONS

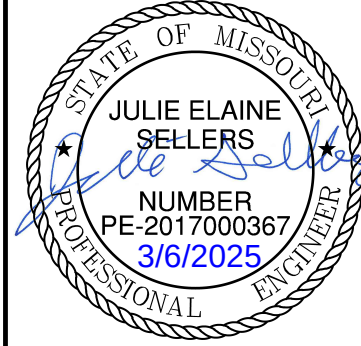

olsson

Olsson - Civil Engineering
Missouri Certificate of Authority #: 001592
1301 Burlington Street
North Kansas City, MO 64116
TEL 816.361.1177
www.olson.com

drawn by: D.F./M.O./A.A.
checked by: C.G.W.
designed by: A.A.
QA/QC by: J.E.S.
project no.: C19-2339
drawing no.:
date: 2022.05.26

SHEET
C125

LEGEND	
	FINISHED INDEX CONTOURS
	FINISHED INTERMEDIATE CONTOURS

BASEMENT TYPES

- ☐ S STANDARD
☐ W WALKOUT
☐ D DAYLIGHT

NOTES:

MBOE – MINIMUM BUILDING OPENING ELEVATION

NOTES:

1. INDIVIDUAL LOT OWNERS SHALL NOT CHANGE OR OBSTRUCT THE DRAINAGE FLOW LINES OR PATHS ON THE LOTS, AS SHOWN ON THE MASTER DRAINAGE PLAN, UNLESS SPECIFIC APPLICATION IS MADE AND APPROVED BY THE CITY ENGINEER.

2. PLAT IS LOCATION IN ZONE X, "AREAS OUTSIDE THE 1-PERCENT ANNUAL CHANCE FLOODPLAINS, AREAS OF 1-PERCENT ANNUAL CHANCE SHEET FLOOD FLOODING WHERE THE AVERAGE DEPTHS ARE LESS THAN 1 FOOT, AREAS OF 1-PERCENT ANNUAL CHANCE STREAM FLOODING WHERE THE CONTRIBUTING DRAINAGE AREA IS LESS THAN 1 SQUARE MILE, OR AREAS PROTECTED FROM THE 1-PERCENT ANNUAL CHANCE FLOOD BY LEVEES. NO BASE FLOOD ELEVATIONS OR DEPTHS ARE SHOWN WITHIN THIS ZONE"

3. PLAT IS LOCATED OUTSIDE OF ANY REQUIRED BUFFER ZONES FOR NATURAL STREAMS.

4. MBOE ELEVATIONS HAVE BEEN PROVIDED AT EACH LOT CORNER. INTERPOLATION WILL BE ALLOWED BETWEEN THE RIGHT AND LEFT SIDE MBOE'S SHOWN ON THE MASTER DRAINAGE PLAN, DEPENDING ON THE LOCATION OF THE LOWEST OPENING ON THE PROPOSED STRUCTURE.

5. REFER TO SHEET C106-C109 FOR SWALE GRADING DETAILS.

6. DRAINAGE PATHS TO BE CONSTRUCTED BETWEEN EACH OF THE LOTS LABELED AS STANDARD LOTS TO DRAIN WEST.


7. NO BUILDING PERMITS WILL BE ISSUED UNTIL AN AS-GRADED MASTER DRAINAGE PLAN HAS BEEN SUBMITTED TO THE CITY AND APPROVED BY THE CITY.

Osage 2nd Plat			
Minimum Building Opening Elevation			
Lot	Rear Left MBOE	Rear Right MBOE	As-Built Grading Required
46	1033.80	1034.73	X
47	1034.73	1033.11	X
48	1033.10	1034.51	X
49	1034.21	1035.60	X
50	1033.54	1035.51	X
51	1035.51	1036.67	X
52	1036.67	1038.18	X
53	1038.18	1041.50	X
54	1041.50	1044.88	X
55	1044.88	1049.20	X
56	1048.96	1046.24	X
57	1051.93	1048.96	X
58	1054.80	1051.93	X
59	1062.78	1054.80	X
60	1038.02	1038.19	X
68	1037.77	1038.02	X
70	1036.89	1037.77	X
71	1036.08	1036.89	X
72	1040.45	1038.25	X
73	1043.08	1040.45	X
74	1045.58	1043.08	X
75	1048.76	1045.58	X

X indicates condition applies to the lot.
MBOE's have been provided per lot lines,
facing the lot from the street. Interpolation
will be allowed between the right and left
side MBOE's provided, depending on the

X indicates condition applies to the lot.
MBOE's have been provided per lot lines,
facing the lot from the street. Interpolation
will be allowed between the right and left
side MBOE's provided, depending on the

AS-BUILT

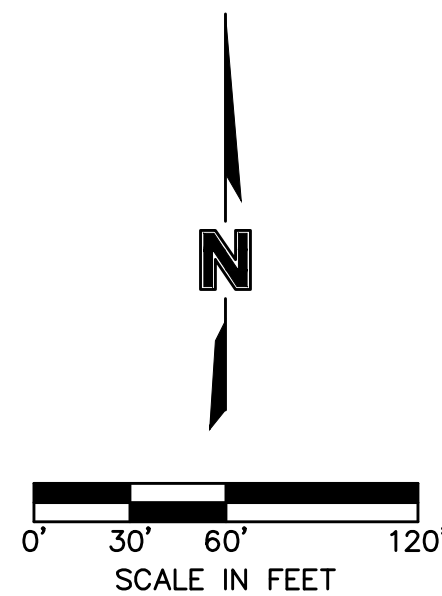

MASTER DRAINAGE PLAN
STREET & STORM SEWER PLANS

OSAGE
SECOND PLAT

|

DATE	
------	--

REVISIONS DESCRIPTION

2020

REVISIONS



Olsson



Olsson - Civil Engineering
Missouri Certificate of Authority #: 001592
1301 Burlington Street
North Kansas City, MO 64116

drawn by: D.F. / M.O. / A.A.
checked by: C.G.W.
designed by: A.A.
QA/QC by: J.E.S.
project no.: C19-2339
drawing no.: _____
date: 2022.05.26

SHEET
C126

DWG: F:\2019\2001-2500\019-2339-C140-Design\AutoCAD\Final Plans - As-Built\Sheets\GNC\A\STREET & STORM\A_C_DRW01_C192339.dwg USER: asr/dor
DATE: May 26, 2022 7:38am XREFS: C_PBASE_C192339 C_PBLK_C192339 C_PSTRM_C192339 C_PSSWR_C192339 C_PWATR_C192339

NOT AS-BUILT

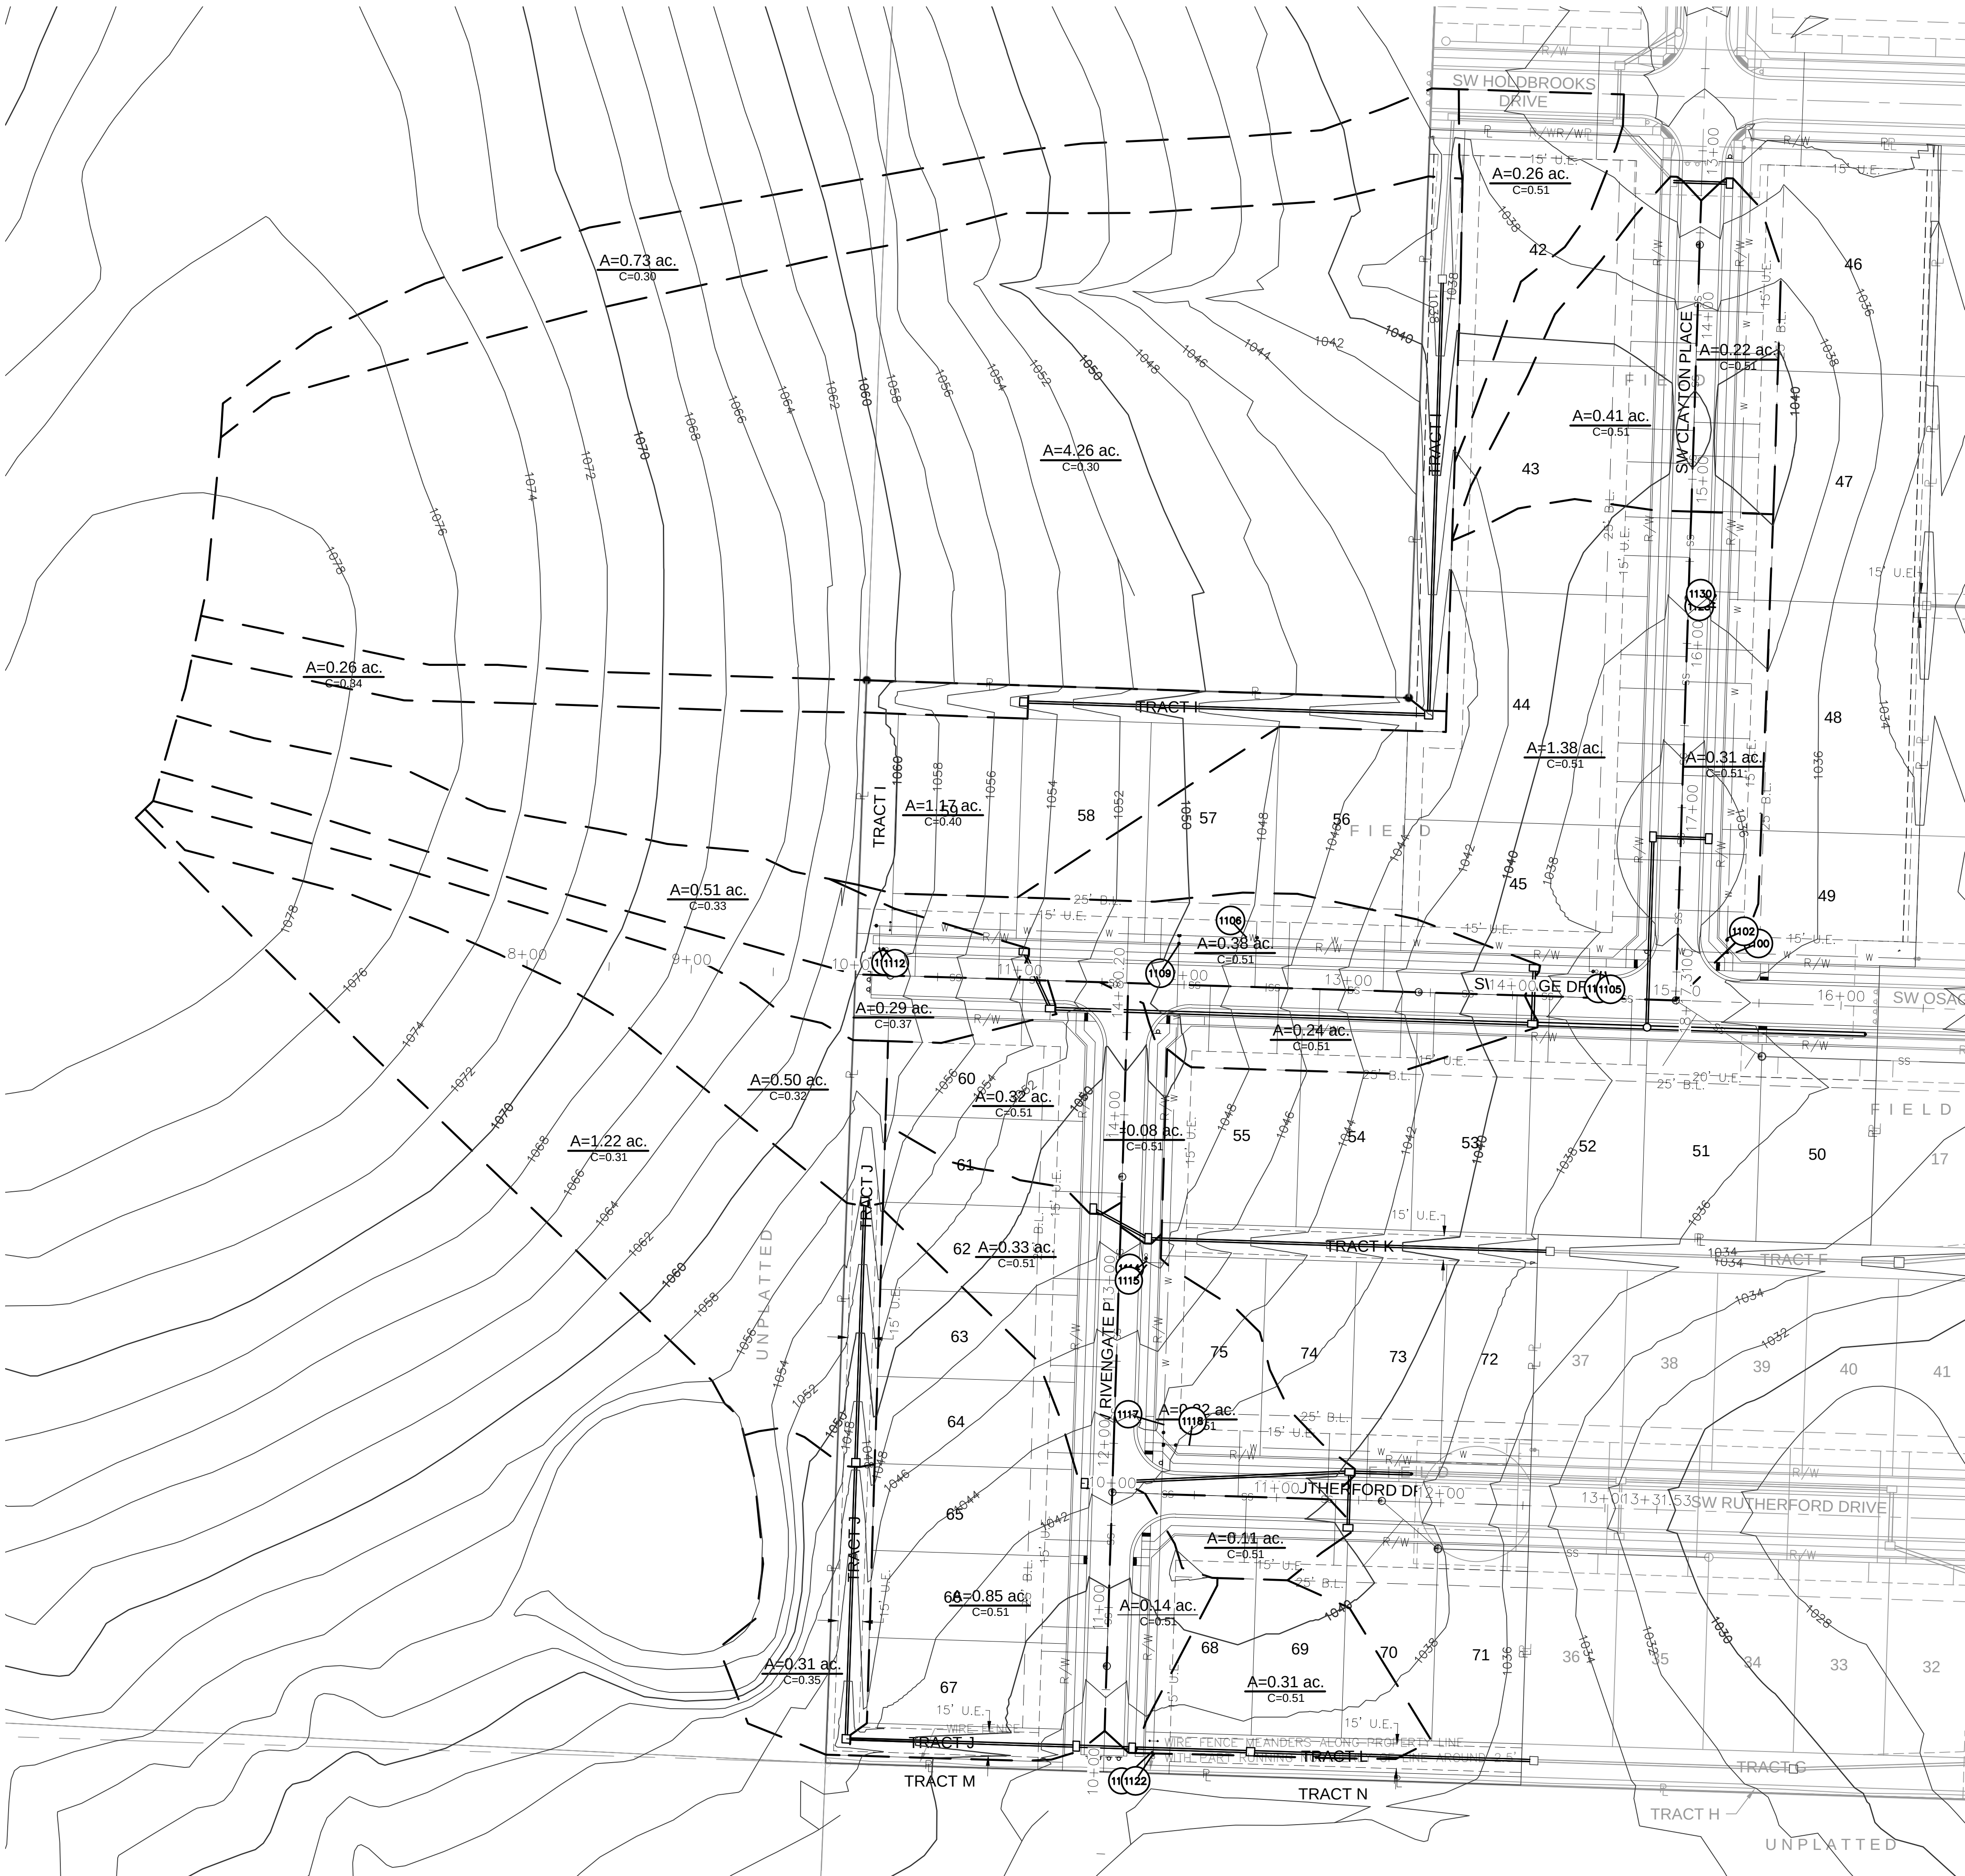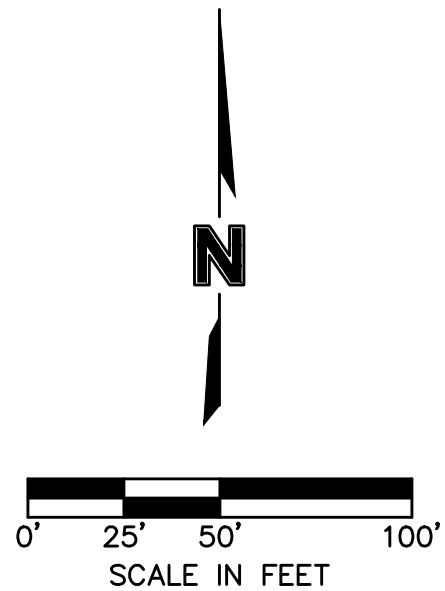

Inlet Design Table						
10 Year Return Frequency						
Inlet ID	Captured Flow	Bypass Flow	Inlet Efficiency (Note 2)	Gutter Depth	Gutter Spread	Ponding Depth
	(cfs)	(cfs)	(%)	(ft)	(ft)	(ft)
C.I. 1-2	0.80	0.10	88.43%	0.10	5.13	...
C.I. 1-3	0.69	0.10	86.80%	0.09	4.57	...
C.I. 1-4	0.98	0.27	78.25%	0.11	5.30	...
C.I. 2-1(L)	...	...	...	0.11	5.50	...
C.I. 2-1(R)	...	...	...	0.14	7.10	...
C.I. 2-1	5.18	0.00	100.00%	...	...	...
C.I. 2-2(L)	...	...	...	0.05	2.34	...
C.I. 2-2(R)	...	...	...	0.09	4.71	...
C.I. 2-2	1.16	0.00	100.00%	...	...	...
C.I. 3-1	0.29	0.01	97.21%	0.07	3.52	...
C.I. 3-2	1.15	0.15	88.48%	0.13	6.52	...
C.I. 4-1	1.05	0.15	87.26%	0.12	6.05	...
C.I. 4-2	1.11	0.28	80.00%	0.12	5.82	...
C.I. 5-1	0.40	0.02	96.15%	0.08	4.04	...
F.I. 6-1	1.16	0.00	100.00%	...	...	0.08
C.I. 6-2	0.54	0.03	95.46%	0.10	4.76	...
C.I. 6-3	2.41	0.90	72.75%	0.19	9.25	...
F.I. 6-4	0.81	0.00	100.00%	...	...	0.06
F.I. 6-5	2.47	0.00	100.00%	...	...	0.13
F.I. 6-6	1.18	0.00	100.00%	...	...	0.08
F.I. 7-1	2.92	0.00	100.00%	...	...	0.15
F.I. 7-2	0.65	0.00	100.00%	...	...	0.05
C.I. 8-1	0.78	0.05	94.15%	0.11	5.75	...
C.I. 9-1	1.34	0.36	78.82%	0.13	6.51	...
Notes:						
1. Inlet capacity at sag location has been reduced by a clogging factor of 0.80, reducing Both theoretical capacity and reduced capacity are shown.						
2. Inlet efficiency shown in the tables is Captured Flow/Total Flow, denoting the actual						


Inlet Design Table						
100 Year Return Frequency						
Inlet ID	Captured Flow	Bypass Flow	Inlet Efficiency (Note 2)	Gutter Depth	Gutter Spread	Ponding Depth
	(cfs)	(cfs)	(%)	(ft)	(ft)	(ft)
C.I. 1-2	1.27	0.31	80.14%	0.13	6.34	...
C.I. 1-3	1.08	0.31	77.66%	0.11	5.64	...
C.I. 1-4	1.43	0.76	65.42%	0.13	6.55	...
C.I. 2-1(L)	...	...	...	0.16	7.76	...
C.I. 2-1(R)	...	...	...	0.18	8.77	...
C.I. 2-1	9.08	0.00	100.00%	...	...	...
C.I. 2-2(L)	...	...	...	0.06	2.89	...
C.I. 2-2(R)	...	...	...	0.12	5.81	...
C.I. 2-2	2.04	0.00	100.00%	...	...	...
C.I. 3-1	0.50	0.03	94.35%	0.09	4.34	...
C.I. 3-2	1.92	0.50	79.24%	0.16	8.22	...
C.I. 4-1	1.67	0.46	78.23%	0.15	7.49	...
C.I. 4-2	1.75	0.92	65.42%	0.15	7.44	...
C.I. 5-1	0.67	0.05	92.55%	0.10	4.99	...
F.I. 6-1	2.04	0.00	100.00%	...	...	0.11
C.I. 6-2	0.90	0.08	91.39%	0.12	5.88	...
C.I. 6-3	3.51	2.75	56.02%	0.24	11.75	...
F.I. 6-4	1.42	0.00	100.00%	...	...	0.09
F.I. 6-5	4.36	0.00	100.00%	...	...	0.19
F.I. 6-6	2.07	0.00	100.00%	...	...	0.12
F.I. 7-1	5.16	0.00	100.00%	...	...	0.21
F.I. 7-2	1.14	0.00	100.00%	...	...	0.08
C.I. 8-1	1.29	0.16	89.23%	0.14	7.10	...
C.I. 9-1	2.08	1.18	63.82%	0.17	8.31	...
Notes:						
1. Inlet capacity at sag location has been reduced by a clogging factor of 0.80, reducing Both theoretical capacity and reduced capacity are shown.						
2. Inlet efficiency shown in the tables is Captured Flow/Total Flow, denoting the actual						

Drainage Area Design Table						
10 Year Return Frequency						
Inlet ID	Drainage Area	C	Tc	i	K	Peak Flow
	(ac)		(min)	(in/hr)		(cfs)
C.I. 1-2	0.24	0.51	5.00	7.35	1.00	0.90
C.I. 1-3	0.29	0.51	5.00	7.35	1.00	0.79
C.I. 1-4	0.51	0.37	5.00	7.35	1.00	1.25
C.I. 2-1(L)	0.10	0.33	5.00	7.35	1.00	0.38
C.I. 2-1(R)	0.45	0.51	5.00	7.35	1.00	1.69
C.I. 2-1(B)	0.83	0.51	5.00	7.35	1.00	3.11
C.I. 2-1	1.38	0.51	5.00	7.35	1.00	5.18
C.I. 2-2(L)	0.02	0.51	5.00	7.35	1.00	0.08
C.I. 2-2(R)	0.15	0.51	5.00	7.35	1.00	0.56
C.I. 2-2(B)	0.14	0.51	5.00	7.35	1.00	0.53
C.I. 2-2	0.31	0.51	5.00	7.35	1.00	1.16
C.I. 3-1	0.08	0.51	5.00	7.35	1.00	0.30
C.I. 3-2	0.32	0.51	5.00	7.35	1.00	1.20
C.I. 4-1	0.32	0.51	5.00	7.35	1.00	1.20
C.I. 4-2	0.33	0.51	5.00	7.35	1.00	1.24
C.I. 5-1	0.11	0.51	5.00	7.35	1.00	0.41
F.I. 6-1	0.31	0.51	5.00	7.35	1.00	1.16
C.I. 6-2	0.15	0.51	5.00	7.35	1.00	0.56
C.I. 6-3	0.86	0.51	6.49	6.92	1.00	3.03
F.I. 6-4	0.31	0.51	5.00	7.35	1.00	0.81
F.I. 6-5	1.22	0.35	8.31	6.46	1.00	2.47
F.I. 6-6	0.50	0.31	5.00	7.35	1.00	1.18
F.I. 7-1	1.17	0.32	9.16	6.26	1.00	2.92
F.I. 7-2	0.26	0.40	5.00	7.35	1.00	0.65
C.I. 8-1	0.22	0.34	5.00	7.35	1.00	0.83
C.I. 9-1	0.38	0.51	5.00	7.35	1.00	1.43

Drainage Area Design Table						
100 Year Return Frequency						
Inlet ID	Drainage Area	C	Tc	i	K	Peak Flow
	(ac)		(min)	(in/hr)		(cfs)
C.I. 1-2	0.24	0.51	5.00	10.32	1.25	1.58
C.I. 1-3	0.29	0.51	5.00	10.32	1.25	1.39
C.I. 1-4	0.51	0.37	5.00	10.32	1.25	2.19
C.I. 2-1(L)	0.10	0.33	5.00	10.32	1.25	0.66
C.I. 2-1(R)	0.45	0.51	5.00	10.32	1.25	2.96
C.I. 2-1(B)	0.83	0.51	5.00	10.32	1.25	5.46
C.I. 2-1	1.38	0.51	5.00	10.32	1.25	9.08
C.I. 2-2(L)	0.02	0.51	5.00	10.32	1.25	0.13
C.I. 2-2(R)	0.15	0.51	5.00	10.32	1.25	0.99
C.I. 2-2(B)	0.14	0.51	5.00	10.32	1.25	0.92
C.I. 2-2	0.31	0.51	5.00	10.32	1.25	2.04
C.I. 3-1	0.08	0.51	5.00	10.32	1.25	0.53
C.I. 3-2	0.32	0.51	5.00	10.32	1.25	2.11
C.I. 4-1	0.32	0.51	5.00	10.32	1.25	2.11
C.I. 4-2	0.33	0.51	5.00	10.32	1.25	2.17
C.I. 5-1	0.11	0.51	5.00	10.32	1.25	0.72
F.I. 6-1	0.31	0.51	5.00	10.32	1.25	2.04
C.I. 6-2	0.15	0.51	5.00	10.32	1.25	0.99
C.I. 6-3	0.86	0.51	6.49	9.74	1.25	5.34
F.I. 6-4	0.31	0.51	5.00	10.32	1.25	1.42
F.I. 6-5	1.22	0.35	8.31	9.11	1.25	4.36
F.I. 6-6	0.50	0.31	5.00	10.32	1.25	2.07
F.I. 7-1	1.17	0.32	9.16	8.84	1.25	5.16
F.I. 7-2	0.26	0.40	5.00	10.32	1.25	1.14
C.I. 8-1	0.22	0.34	5.00	10.32	1.25	1.45
C.I. 9-1	0.38	0.51	5.00	10.32	1.25	2.50

Storm Sewer Design Calculation Table													
10 Year Return Frequency													
Upstream Structure	Downstream Structure	Length (ft)	Upstream Invert (ft)	Downstream Invert (ft)	Slope (%)	Diameter (in)	Manning's n	Total Flow (cfs)	Velocity (ft/s)	Capacity (cfs)	Flow Depth (ft)	Upstream Struct. HGL (ft)	Upstream Top Elev. (ft)
CONNECT TO EX. 1	EX C.I. 2	113.85	1026.43	1024.72	1.50	24	0.010	10.15	9.85	36.04	1.14	1027.57	1028.70
M.H. 1-1	CONNECT TO EX. 1	132.88	1028.42	1026.43	1.50	24	0.010	10.15	5.49	36.01	1.14	1029.56	1037.06
C.I. 1-2	M.H. 1-1	69.62	1029.96	1028.92	1.49	24	0.010	3.81	4.38	35.94	0.68	1030.64	1038.65
C.I. 1-3	C.I. 1-2	293.62	1044.65	1030.46	4.83	18	0.010	1.67	9.12	30.01	0.49	1045.14	1053.11
C.I. 1-4	C.I. 1-3	38.03	1046.10	1045.15	2.50	15	0.010	0.98	6.31	13.27	0.39	1046.49	1053.96
C.I. 2-1	M.H. 1-1	116.00	1030.33	1029.17	1.00	15	0.010	6.34	7.51	8.39	1.01	1031.35	1035.61
C.I. 2-2	C.I. 2-1	34.00	1031.17	1030.83	1.00	15	0.010	1.16	2.43	8.40	0.42	1031.59	1035.61
C.I. 9-1	C.I. 1-2	33.81	1030.47	1030.37	0.30	18	0.010	1.34	3.18	7.42	0.43	1030.90	1038.65
EX F.I. 4	EX F.I. 3	212.50	1030.50	1024.98	2.60	15	0.010	1.45	7.18	13.53	0.48	1030.98	1037.27
C.I. 3-1	EX F.I. 4	244.62	1040.79	1031.00	4.00	15	0.010	1.45	8.37	16.79	0.48	1041.27	1048.45
C.I. 3-2	C.I. 3-1	38.04	1041.85	1041.28	1.50	15	0.010	1.15	5.53	10.28	0.42	1042.27	1048.84
EX F.I. 2	EX F.I. 1	158.03	1027.56	1022.82	3.00	15	0.010	8.57	12.33	14.54	1.14	1028.70	1036.37
F.I. 6-1	EX F.I. 2	172.50	1030.04	1028.06	1.15	15	0.010	8.57	8.34	8.99	1.14	1031.18	1038.17
C.I. 6-2	F.I. 6-1	72.11	1031.26	1030.54	1.00	15	0.010	7.41	7.71	8.39	1.08	1032.34	1037.50
C.I. 6-3	C.I. 6-2	34.00	1032.10	1031.76	1.00	15	0.010	6.87	7.63	8.39	1.05	1033.15	1037.50
F.I. 6-4	C.I. 6-3	140.01	1034.00	1032.60	1.00	15	0.010	4.46	6.94	8.39	0.86	1034.86	1042.09
F.I. 6-5	F.I. 6-4	168.17	1038.70	1034.50	2.50	15	0.010	3.65	9.22	13.27	0.77	1039.47	1047.22
F.I. 6-6	F.I. 6-5	158.97	1045.56	1039.20	4.00	15	0.010	1.18	6.02	16.79	0.43	1045.99	1054.84
EX F.I. 5	EX C.I. 5	98.76	1031.25	1030.26	1.00	18	0.010	3.57	6.50	13.67	0.72	1031.97	1037.71
F.I. 7-1	EX F.I. 5	265.34	1037.06	1031.75	2.00	15	0.010	3.57	8.46	11.88	0.76	1037.82	1045.01
F.I. 7-2	F.I. 7-1	246.48	1045.57	1037.56	3.25	15	0.010	0.65	3.48	15.13	0.31	1045.89	1054.58
CONNECT TO EX. 2	EX C.I. 1	127.46	1030.64	1024.27	5.00	15	0.010	2.69	10.84	18.77	0.66	1031.30	1032.33
C.I. 4-1	CONNECT TO EX. 2	37.54	1032.52	1030.64	5.01	15	0.010	2.69	4.11	18.79	0.66	1033.18	1039.86
C.I. 4-2	C.I. 4-1	161.56	1034.64	1033.02	1.00	15	0.010	1.24	4.90	8.41	0.44	1035.08	1042.63
C.I. 5-1	C.I. 4-1	34.00	1033.36	1033.02	1.00	15	0.010	0.40	3.51	8.39	0.25	1033.61	1039.86
EX C.I. 4	EX C.I. 3	49.50	1029.25	1028.76	0.99	15	0.010	0.78	4.26	8.39	0.35	1029.60	1035.32
C.I. 8-1	EX C.I. 4	34.00	1030.09	1029.75	1.00	15	0.010	0.78	4.27	8.39	0.35	1030.44	1035.33


DWG: F:\2019\2001-2500\019-2339-C140-Design\AutoCAD\Final Plans - As-Built\Sheets\GNCV\STREET & STORM\C_DET01_C192339.dwg
DATE: May 26, 2022 7:38am
USER: ssaylor
XREFS: C_PTBLC_C192339

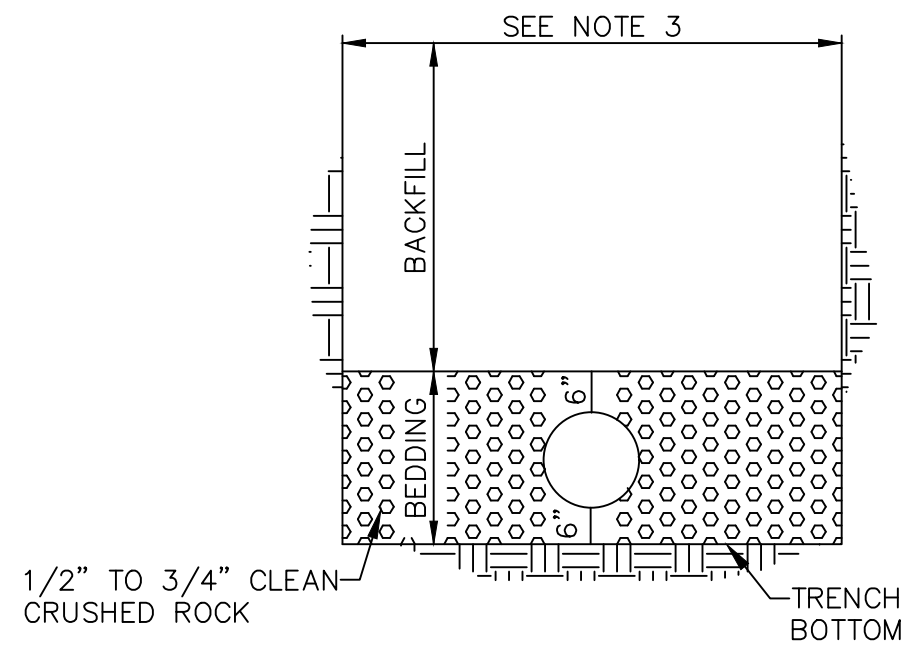


TYPICAL SECTION FOR PLASTIC PIPE
(IN ROCK OR SOIL)

UNDERGROUND PIPE INSTALLATION FOR STORM SEWER LINES
N.T.S.


- BACKFILL SHALL BE JOB EXCAVATED MATERIAL FREE FROM DEBRIS AND STONES COMPACTED TO 90% OF MAXIMUM DENSITY AT OPTIMUM MOISTURE CONTENT AS DETERMINED BY ASTM D698. BACKFILL UNDER PAVEMENT (EXISTING OR PROPOSED), SHALL BE FLOWABLE FILL.
- TRENCH BANKS MAY BE CUT BACK ON SLOPES IN ACCORDANCE WITH CURRENT OSHA REGULATIONS, BUT ONLY IN AREAS WHERE THE INCREASED TRENCH WIDTH WILL NOT INTERFERE WITH SURFACE FEATURES. SLOPES MUST NOT EXTEND BELOW TOP OF BEDDING.
- MINIMUM AND MAXIMUM WIDTHS SHALL BE IN ACCORDANCE WITH PIPE MANUFACTURER'S RECOMMENDATION AS APPROVED ON ENGINEERING PLANS.

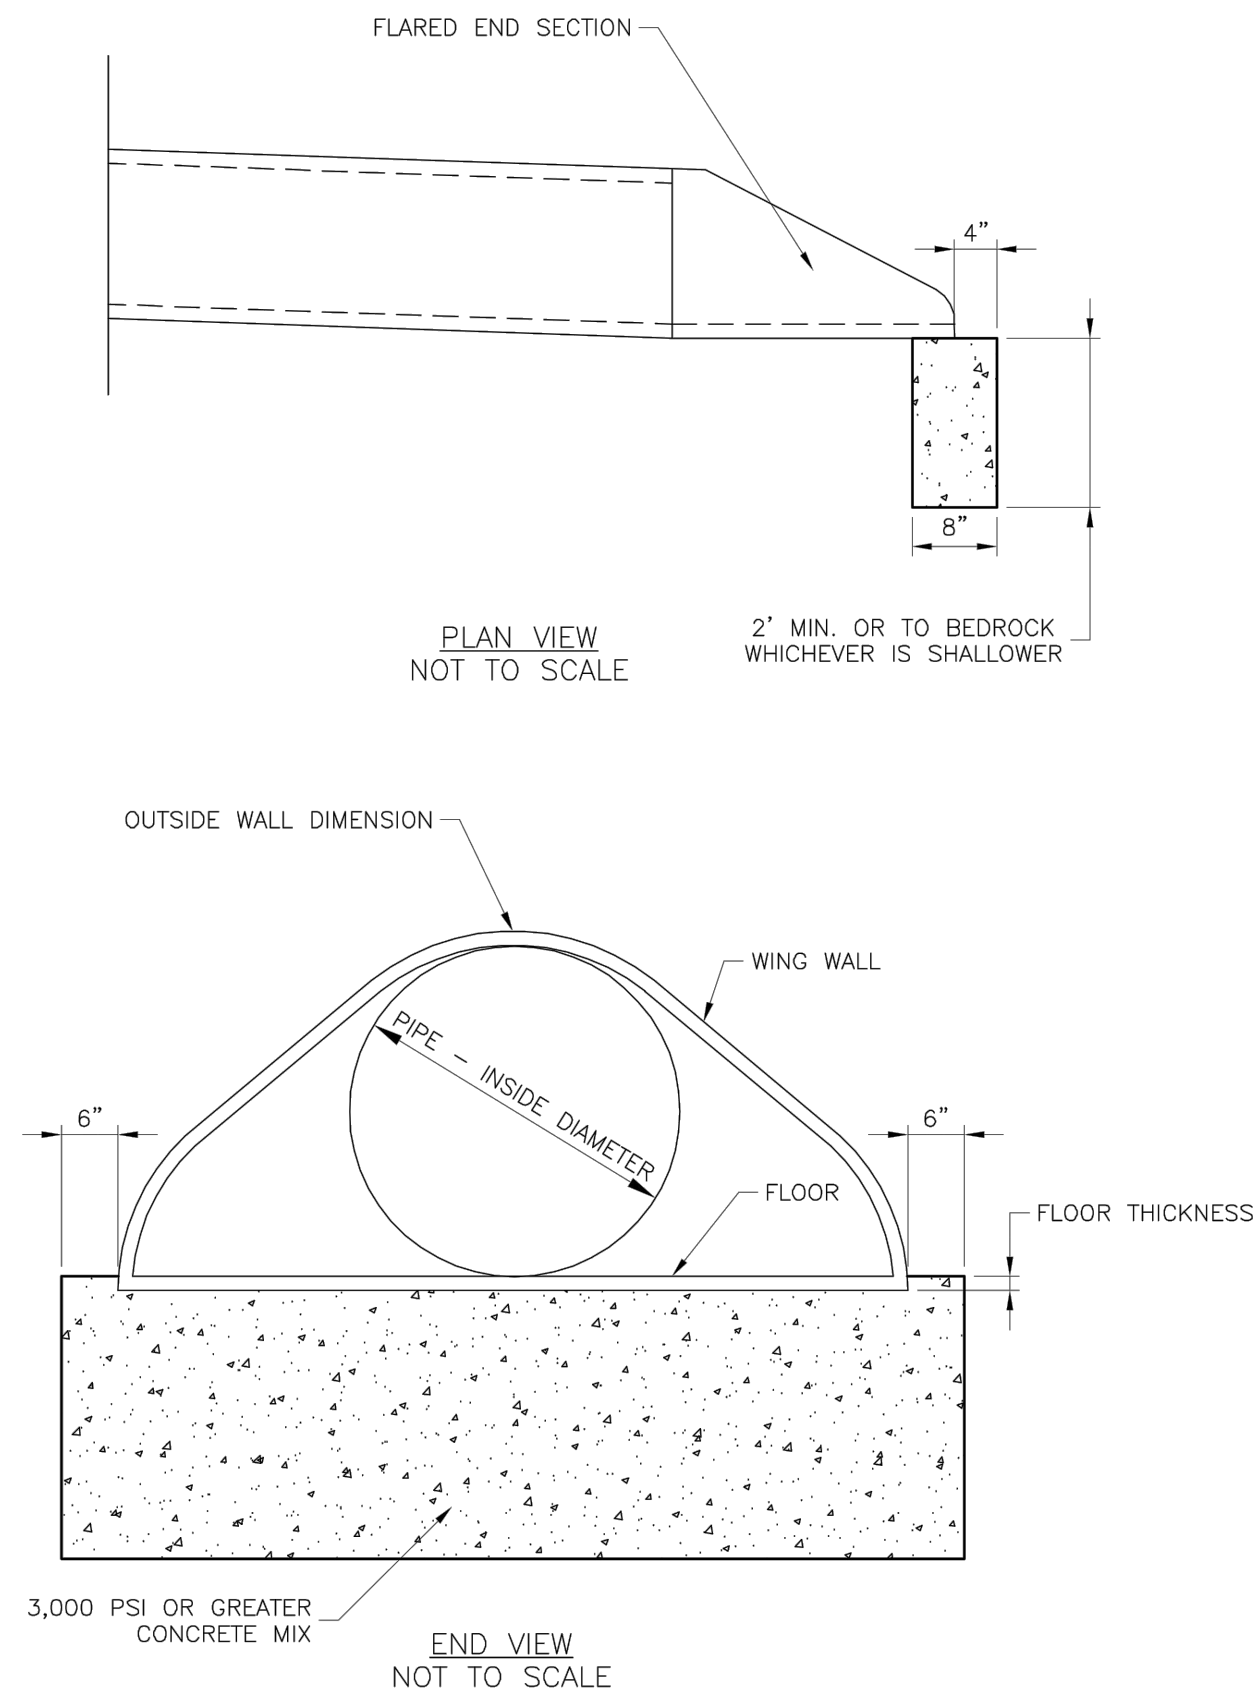

LS	LEE'S SUMMIT MISSOURI PUBLIC WORKS ENGINEERING DIVISION 220 SE GREEN STREET LEE'S SUMMIT, MO 64063	Date: 04/17 Drawn By: MIF Checked By: DL
	FLARED END SECTION SUPPORT DETAIL	STM-5

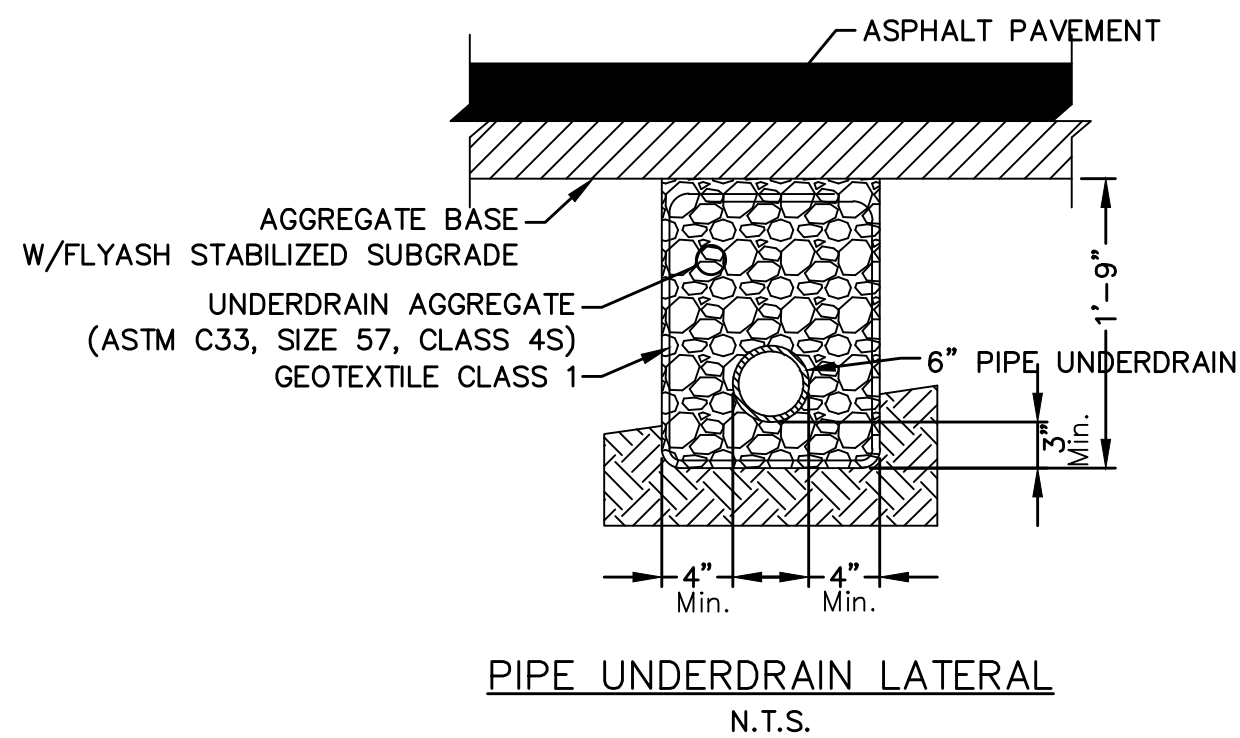


- NOTES:
- Where Pipe Underdrains are used, all Underdrain Outlet Pipes shall be solid wall with watertight joints. All Outlets Pipes shall be tied into the nearest storm sewer inlets at roadway sag locations as indicated in the street profile.
 - All Underdrain Pipes shall be installed at a minimum slope of 1%.
 - Underdrain Pipe shall be installed with the perforations placed down.
 - Blanket Underdrain Aggregate, Pipe Underdrain Aggregate, Pipe Underdrain, Edge Underdrain and Outlet Pipe shall conform to City of Lee's Summit Specifications.
 - Overlap geotextile at top of trench a minimum of 12\"/>

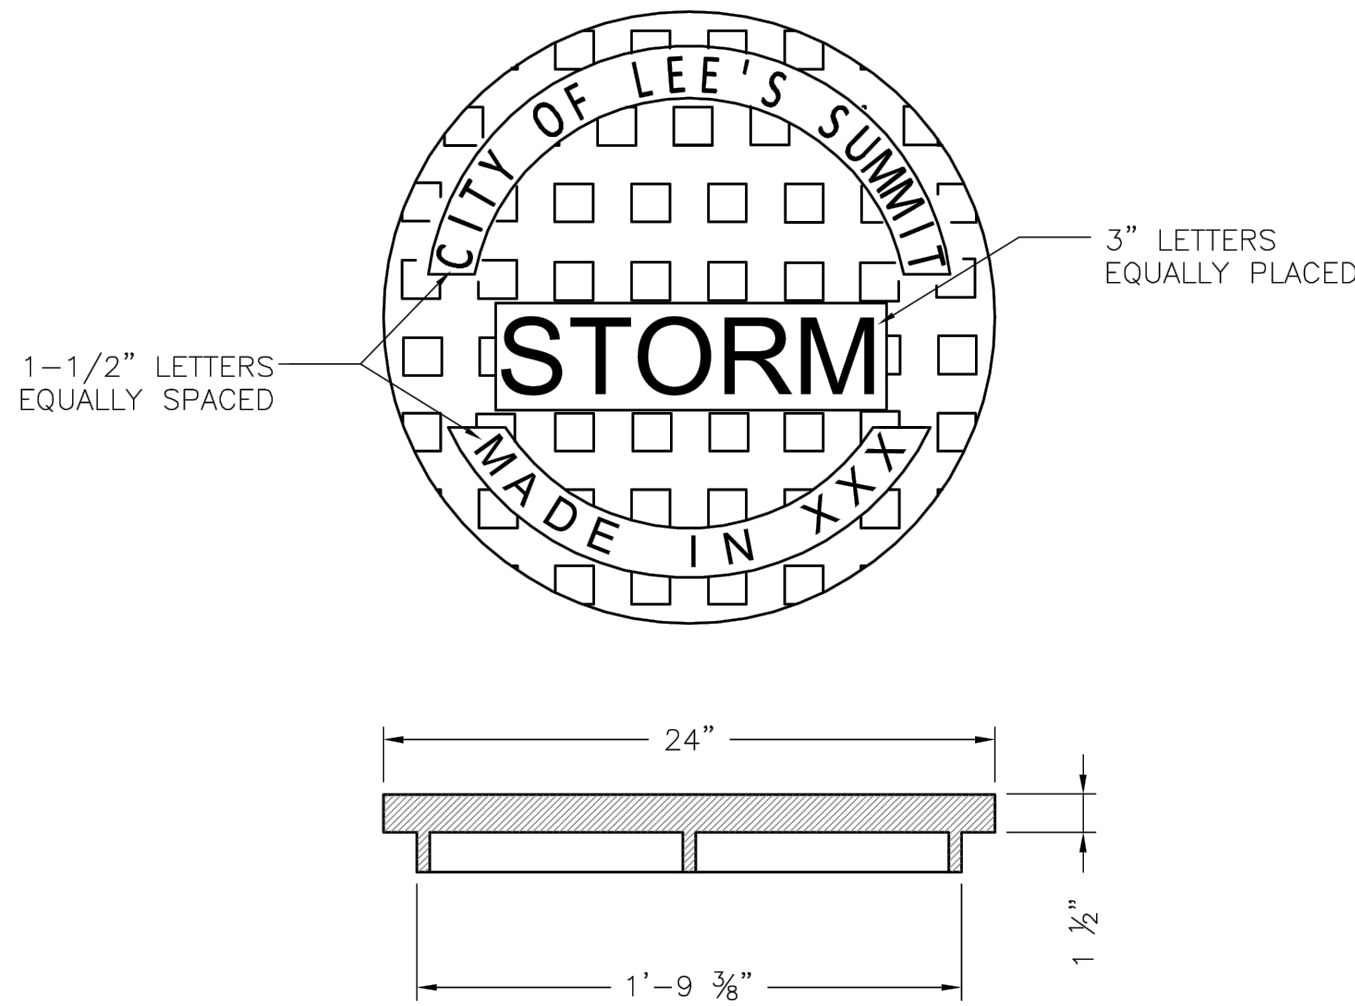


STANDARD 24" MANHOLE COVER
MINIMUM WEIGHT = 160 LB
NOTE: PICK HOLES NOT SHOWN
*COVER AND FRAME MODEL INFORMATION REFER TO THE STORMWATER APPROVED PRODUCT LIST.

LS	LEE'S SUMMIT MISSOURI PUBLIC WORKS ENGINEERING DIVISION 220 SE GREEN STREET LEE'S SUMMIT, MO 64063	Date: 04/17 Drawn By: MIF Checked By: DL
	STORM MANHOLE COVER DETAIL	STM-6

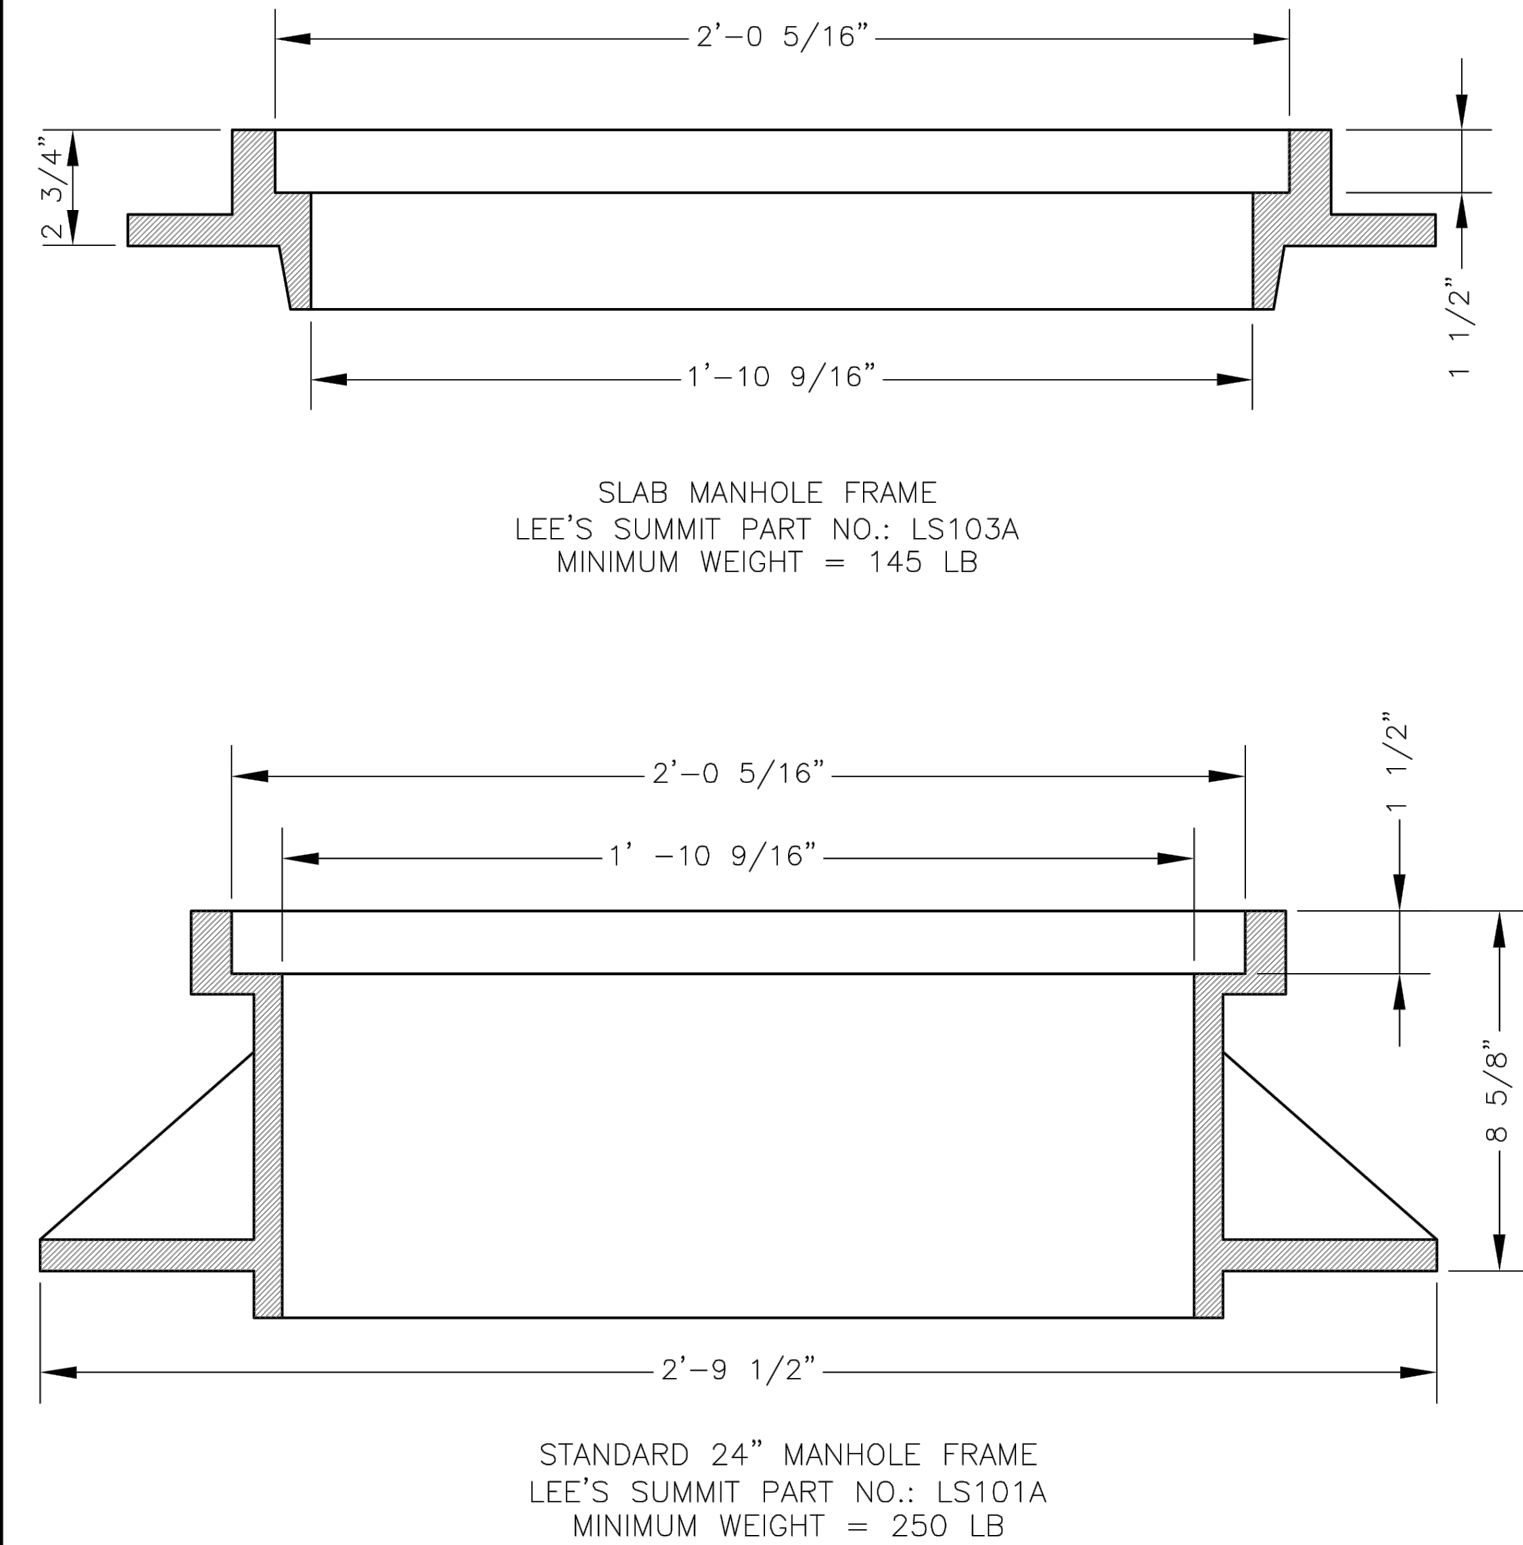

*COVER AND FRAME MODEL INFORMATION REFER TO THE STORMWATER APPROVED PRODUCTS LIST.

LS	LEE'S SUMMIT MISSOURI PUBLIC WORKS ENGINEERING DIVISION 220 SE GREEN STREET LEE'S SUMMIT, MO 64063	Date: 04/17 Drawn By: MIF Checked By: DL
	STORM MANHOLE FRAME DETAIL	STM-7

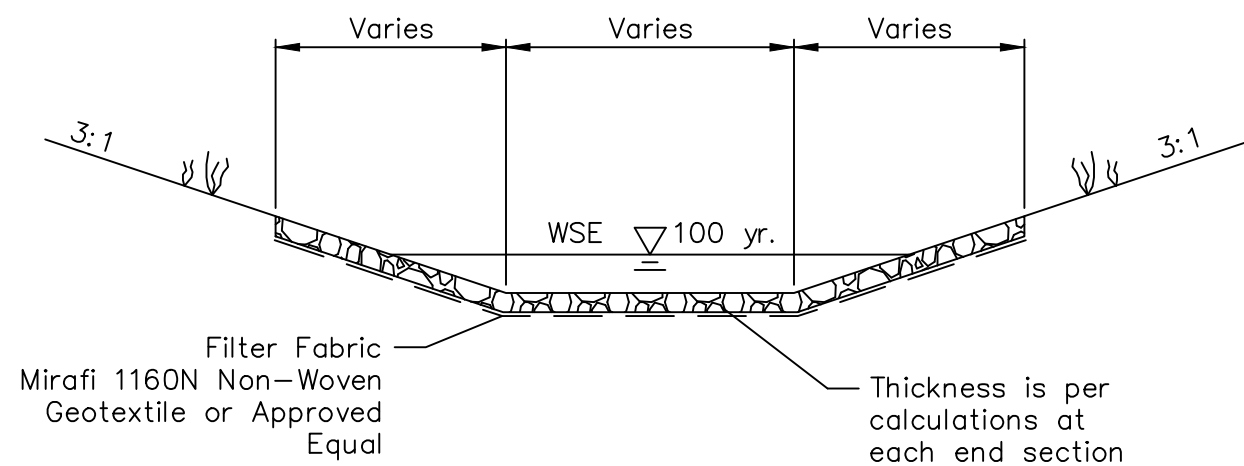

NOTE: DIMENSIONS ARE PER CALCULATIONS AT EACH END SECTION

RIPRAP DETAIL
N.T.S.

NOT AS-BUILT





olsson
Olsson - Civil Engineering
Missouri Certificate of Authority #: 001592
1301 Burlington Street
North Kansas City, MO 64116
TEL 816.361.1177
www.olson.com

STATE OF MISSOURI
JULIE ELAINE SELLERS
Professional Engineer
NUMBER PE-2017000367
3/6/2025

REV. NO.	DATE	REVISIONS DESCRIPTION

DETAILS	STREET & STORM SEWER PLANS	OSAGE SECOND PLAT	2020
---------	----------------------------	-------------------	------

drawn by:	D.F./M.O./A.A.
checked by:	C.G.W.
designed by:	A.A.
QA/QC by:	J.E.S.
project no.:	C19-2339
drawing no.:	2022.05.26

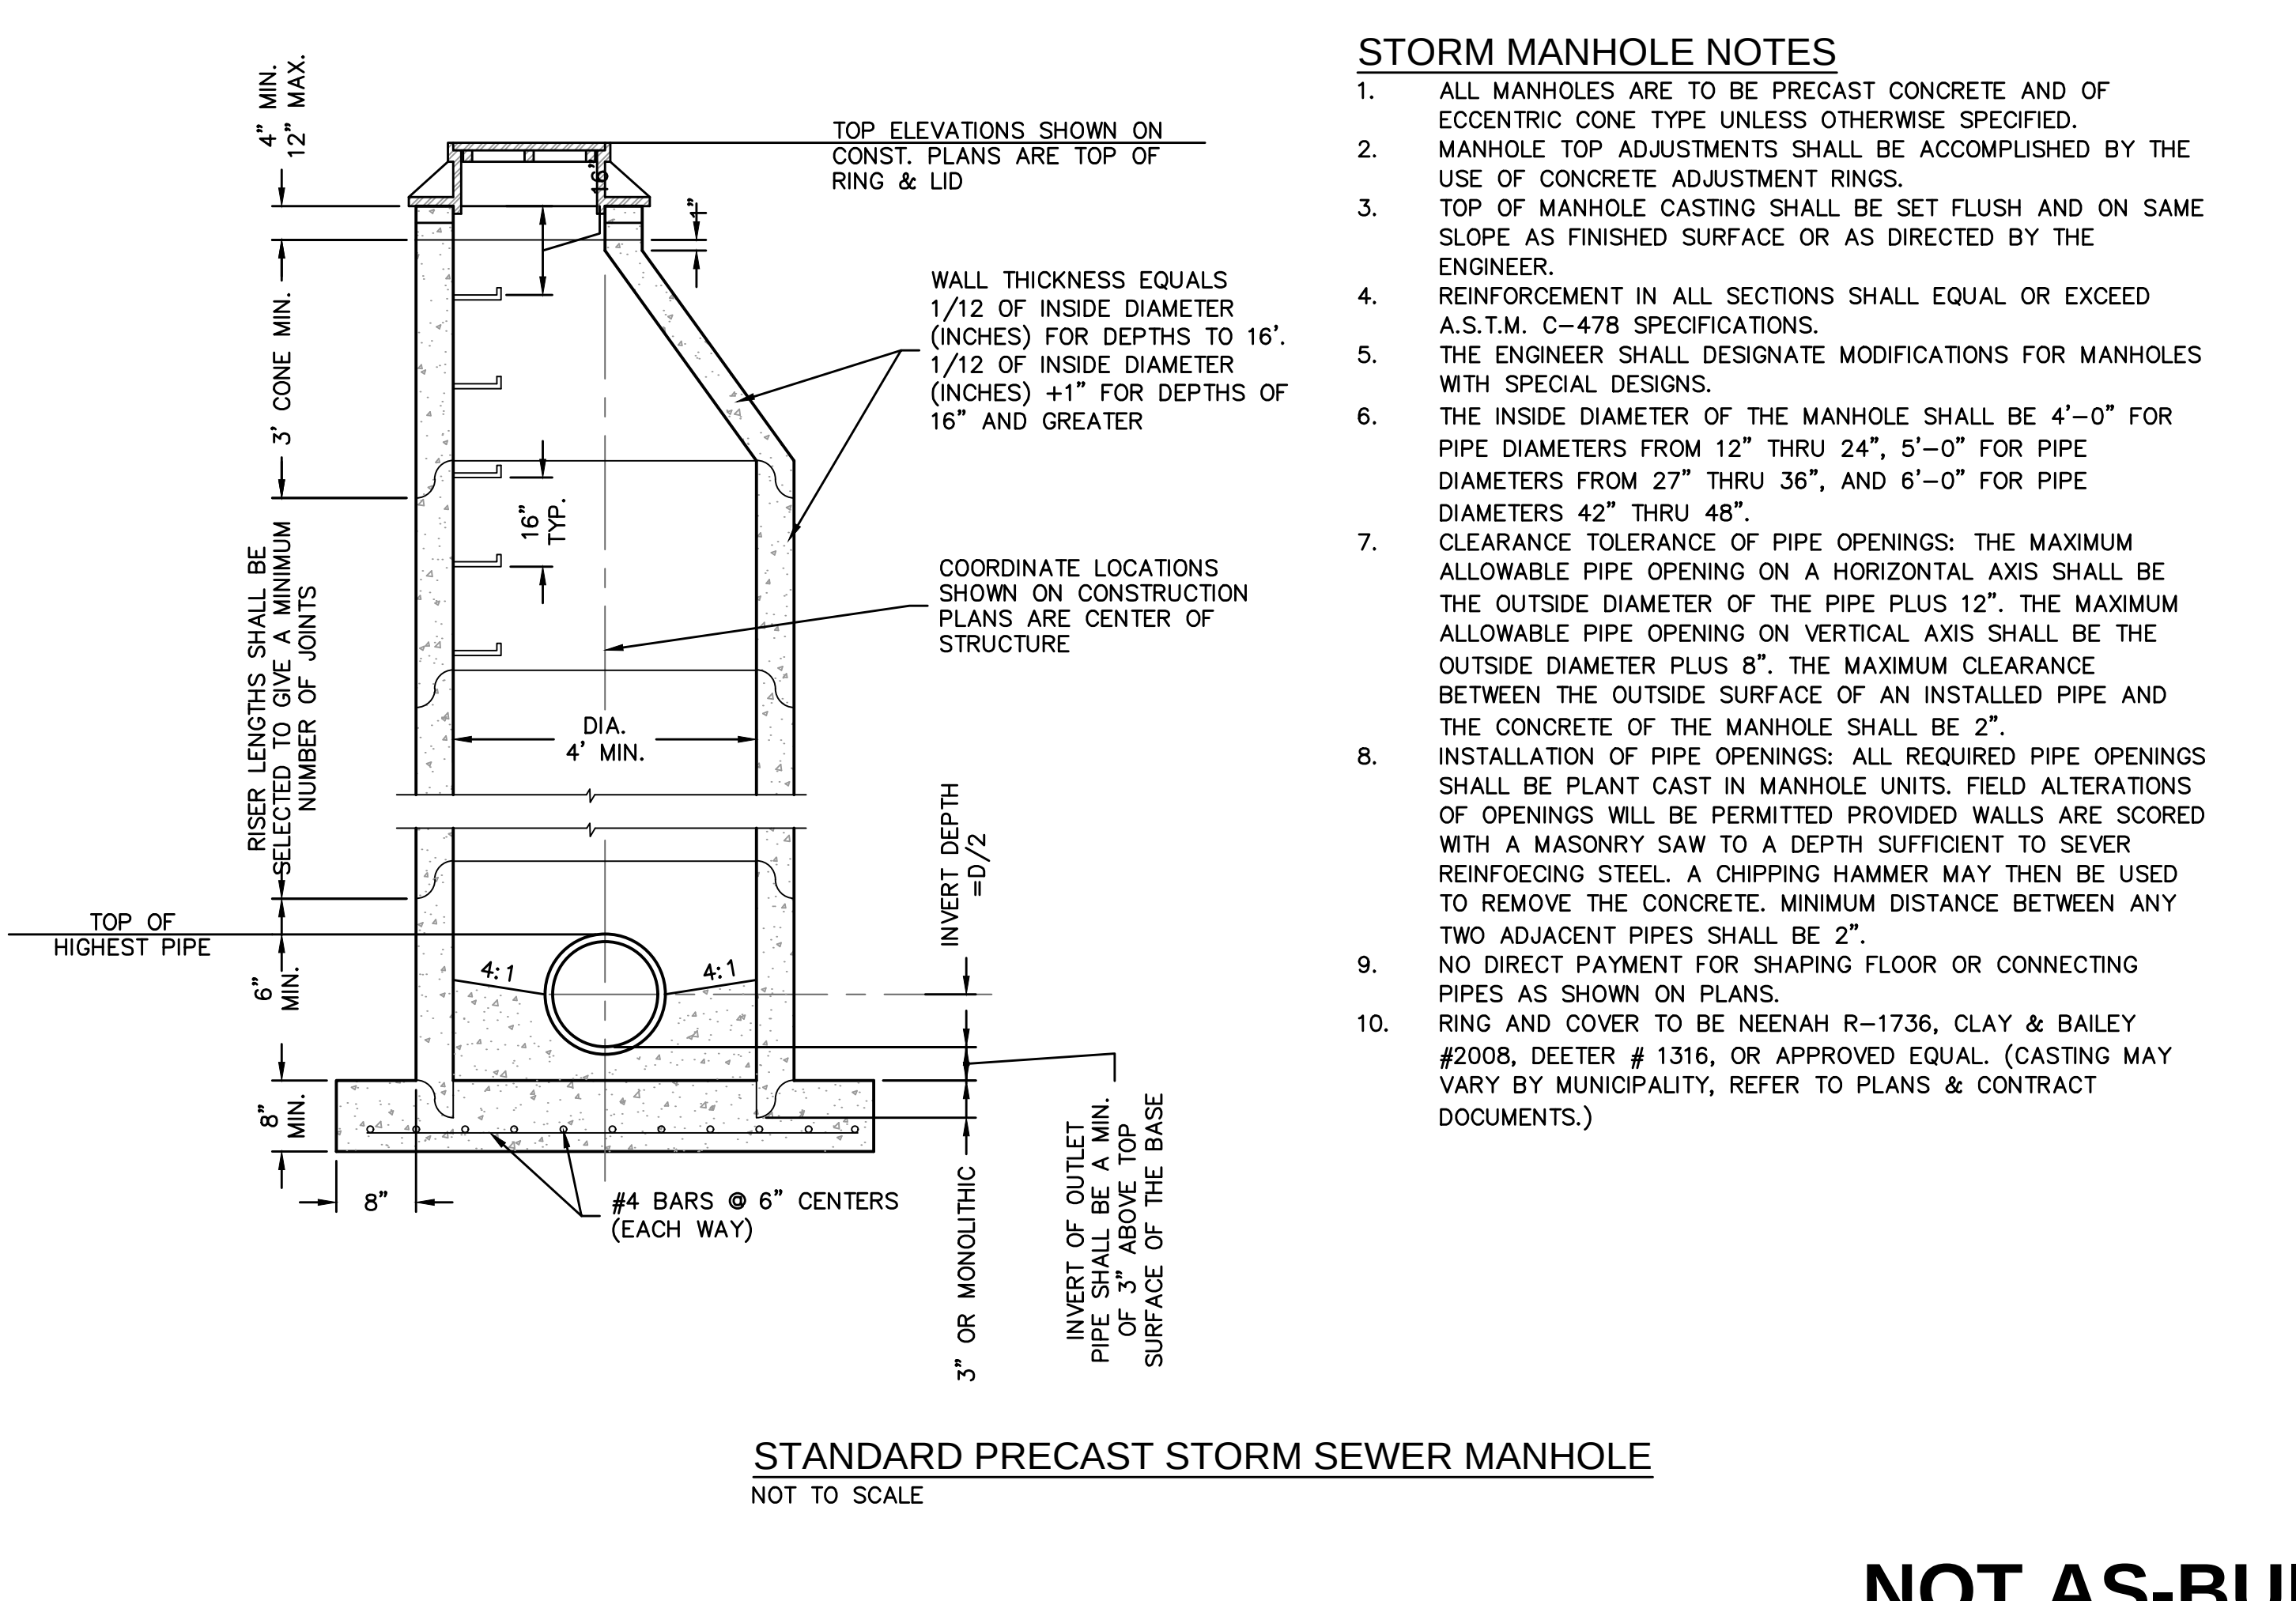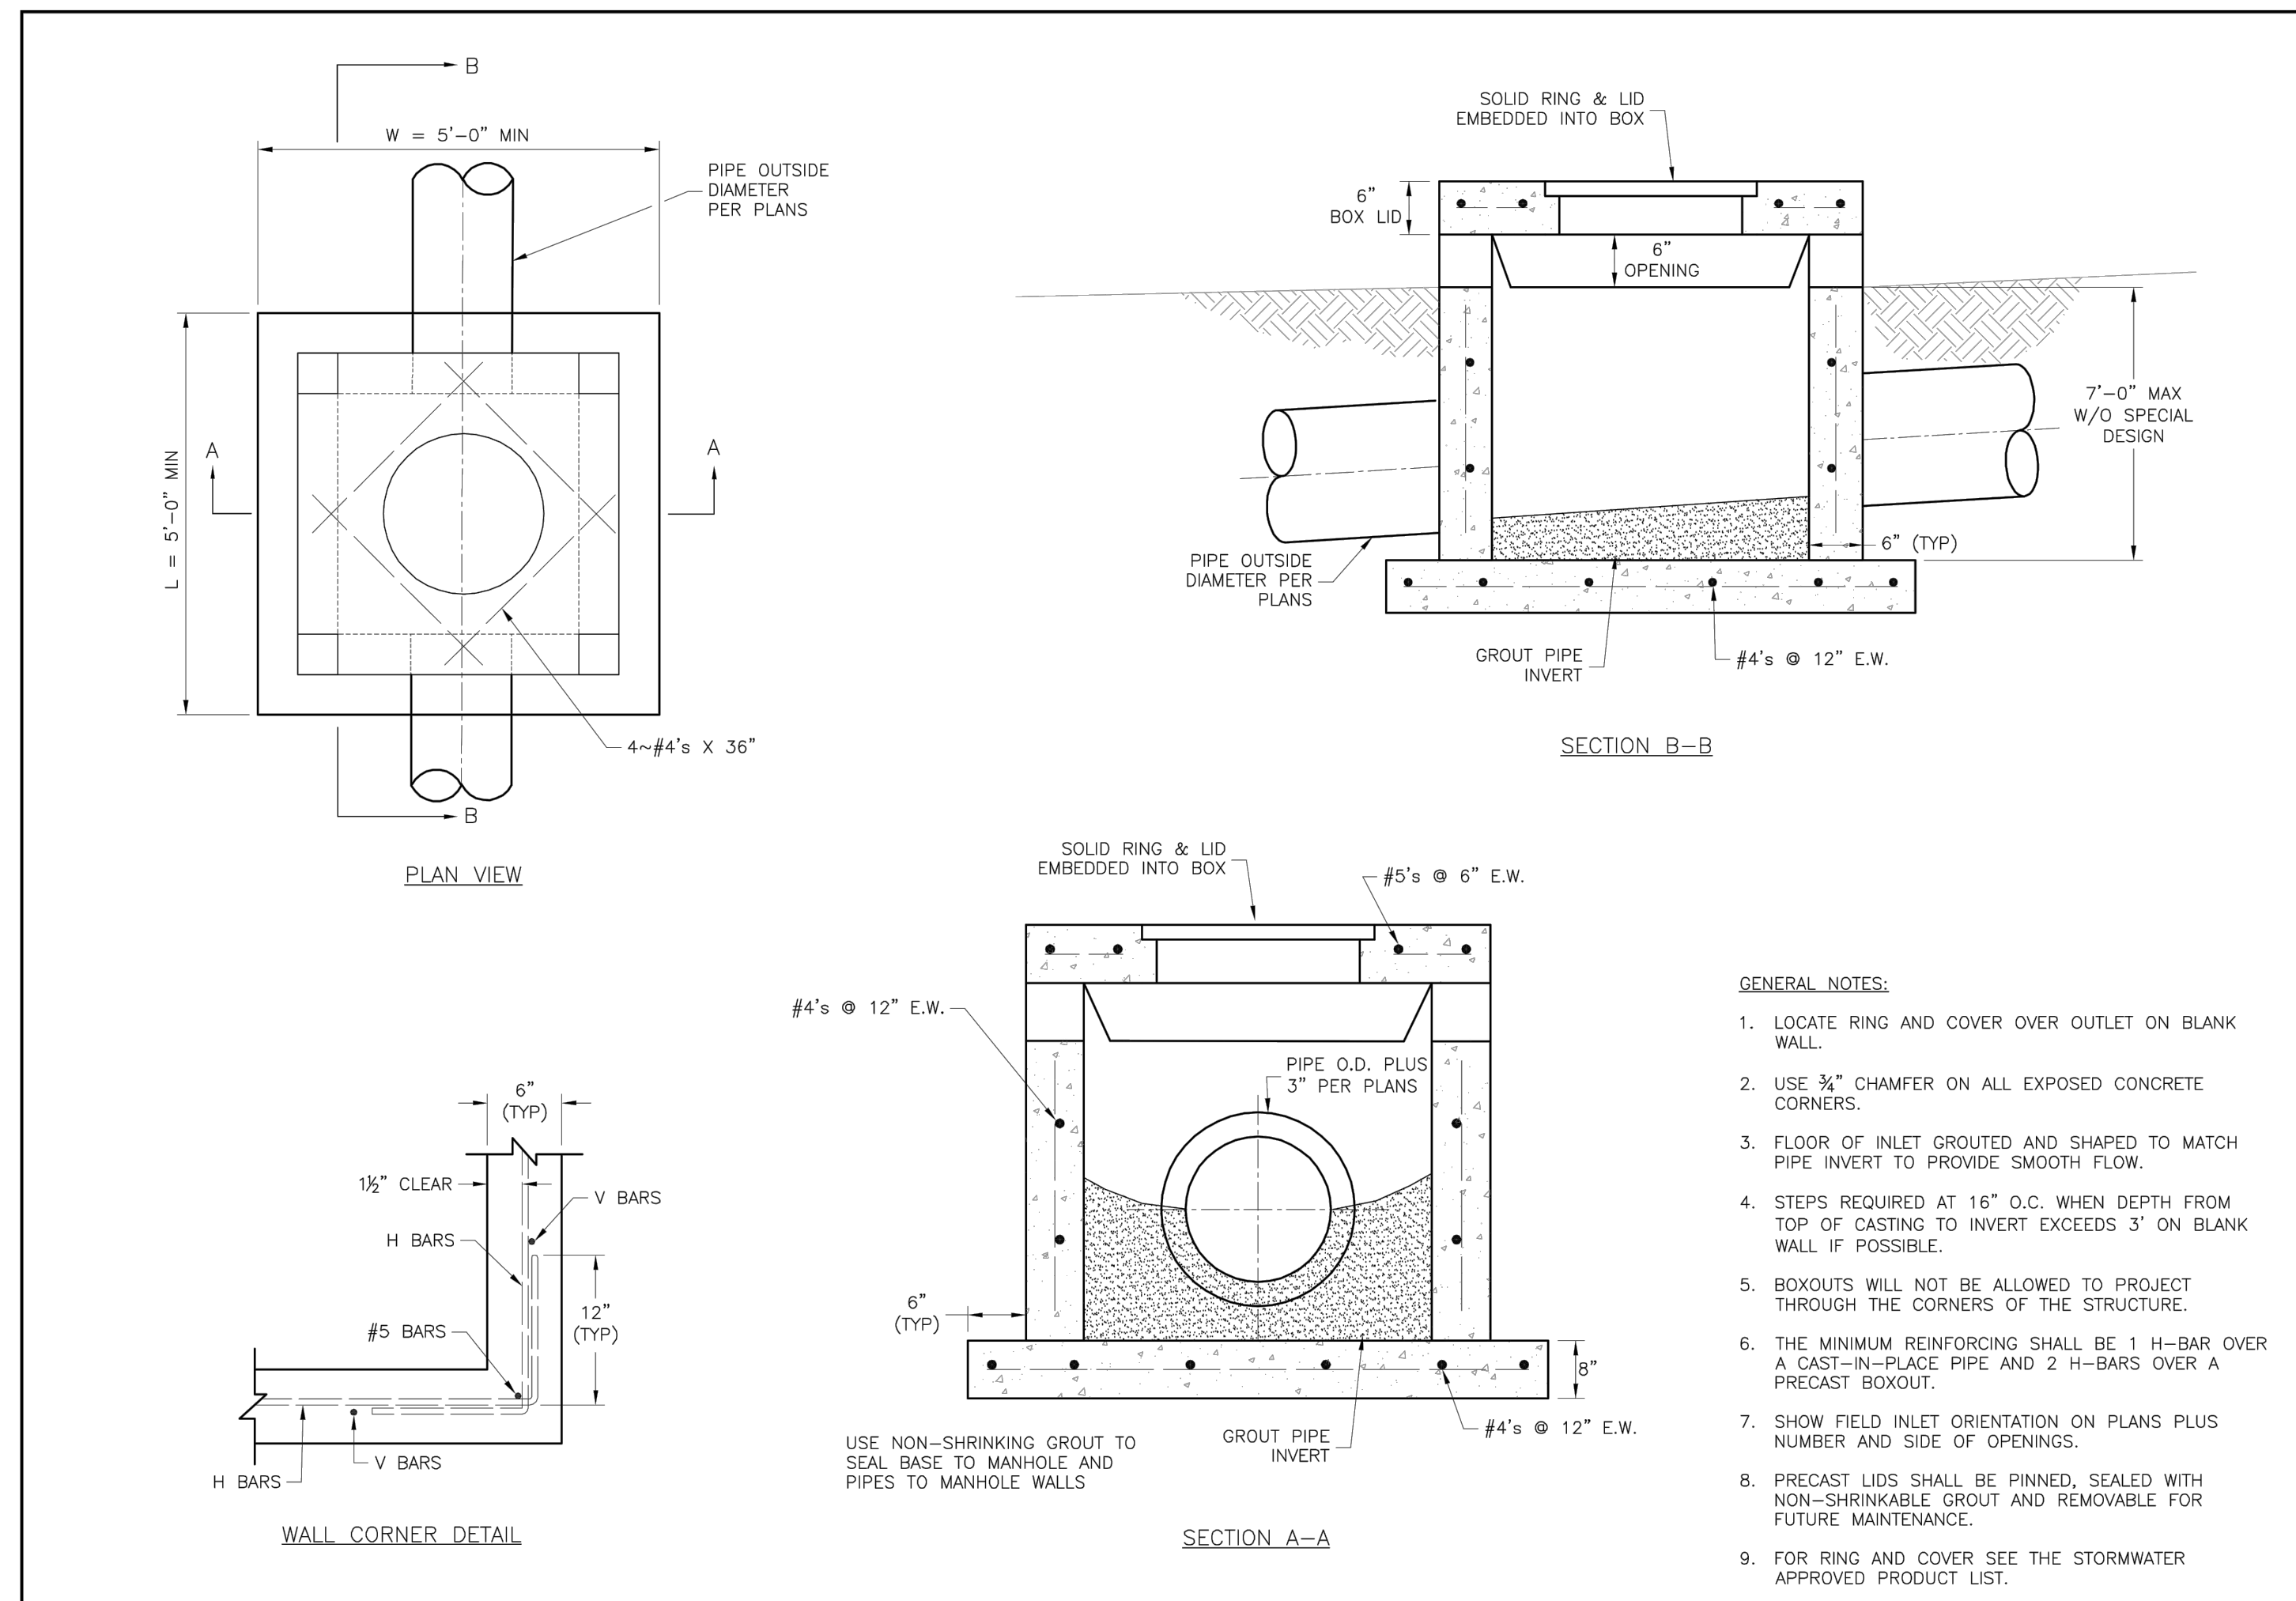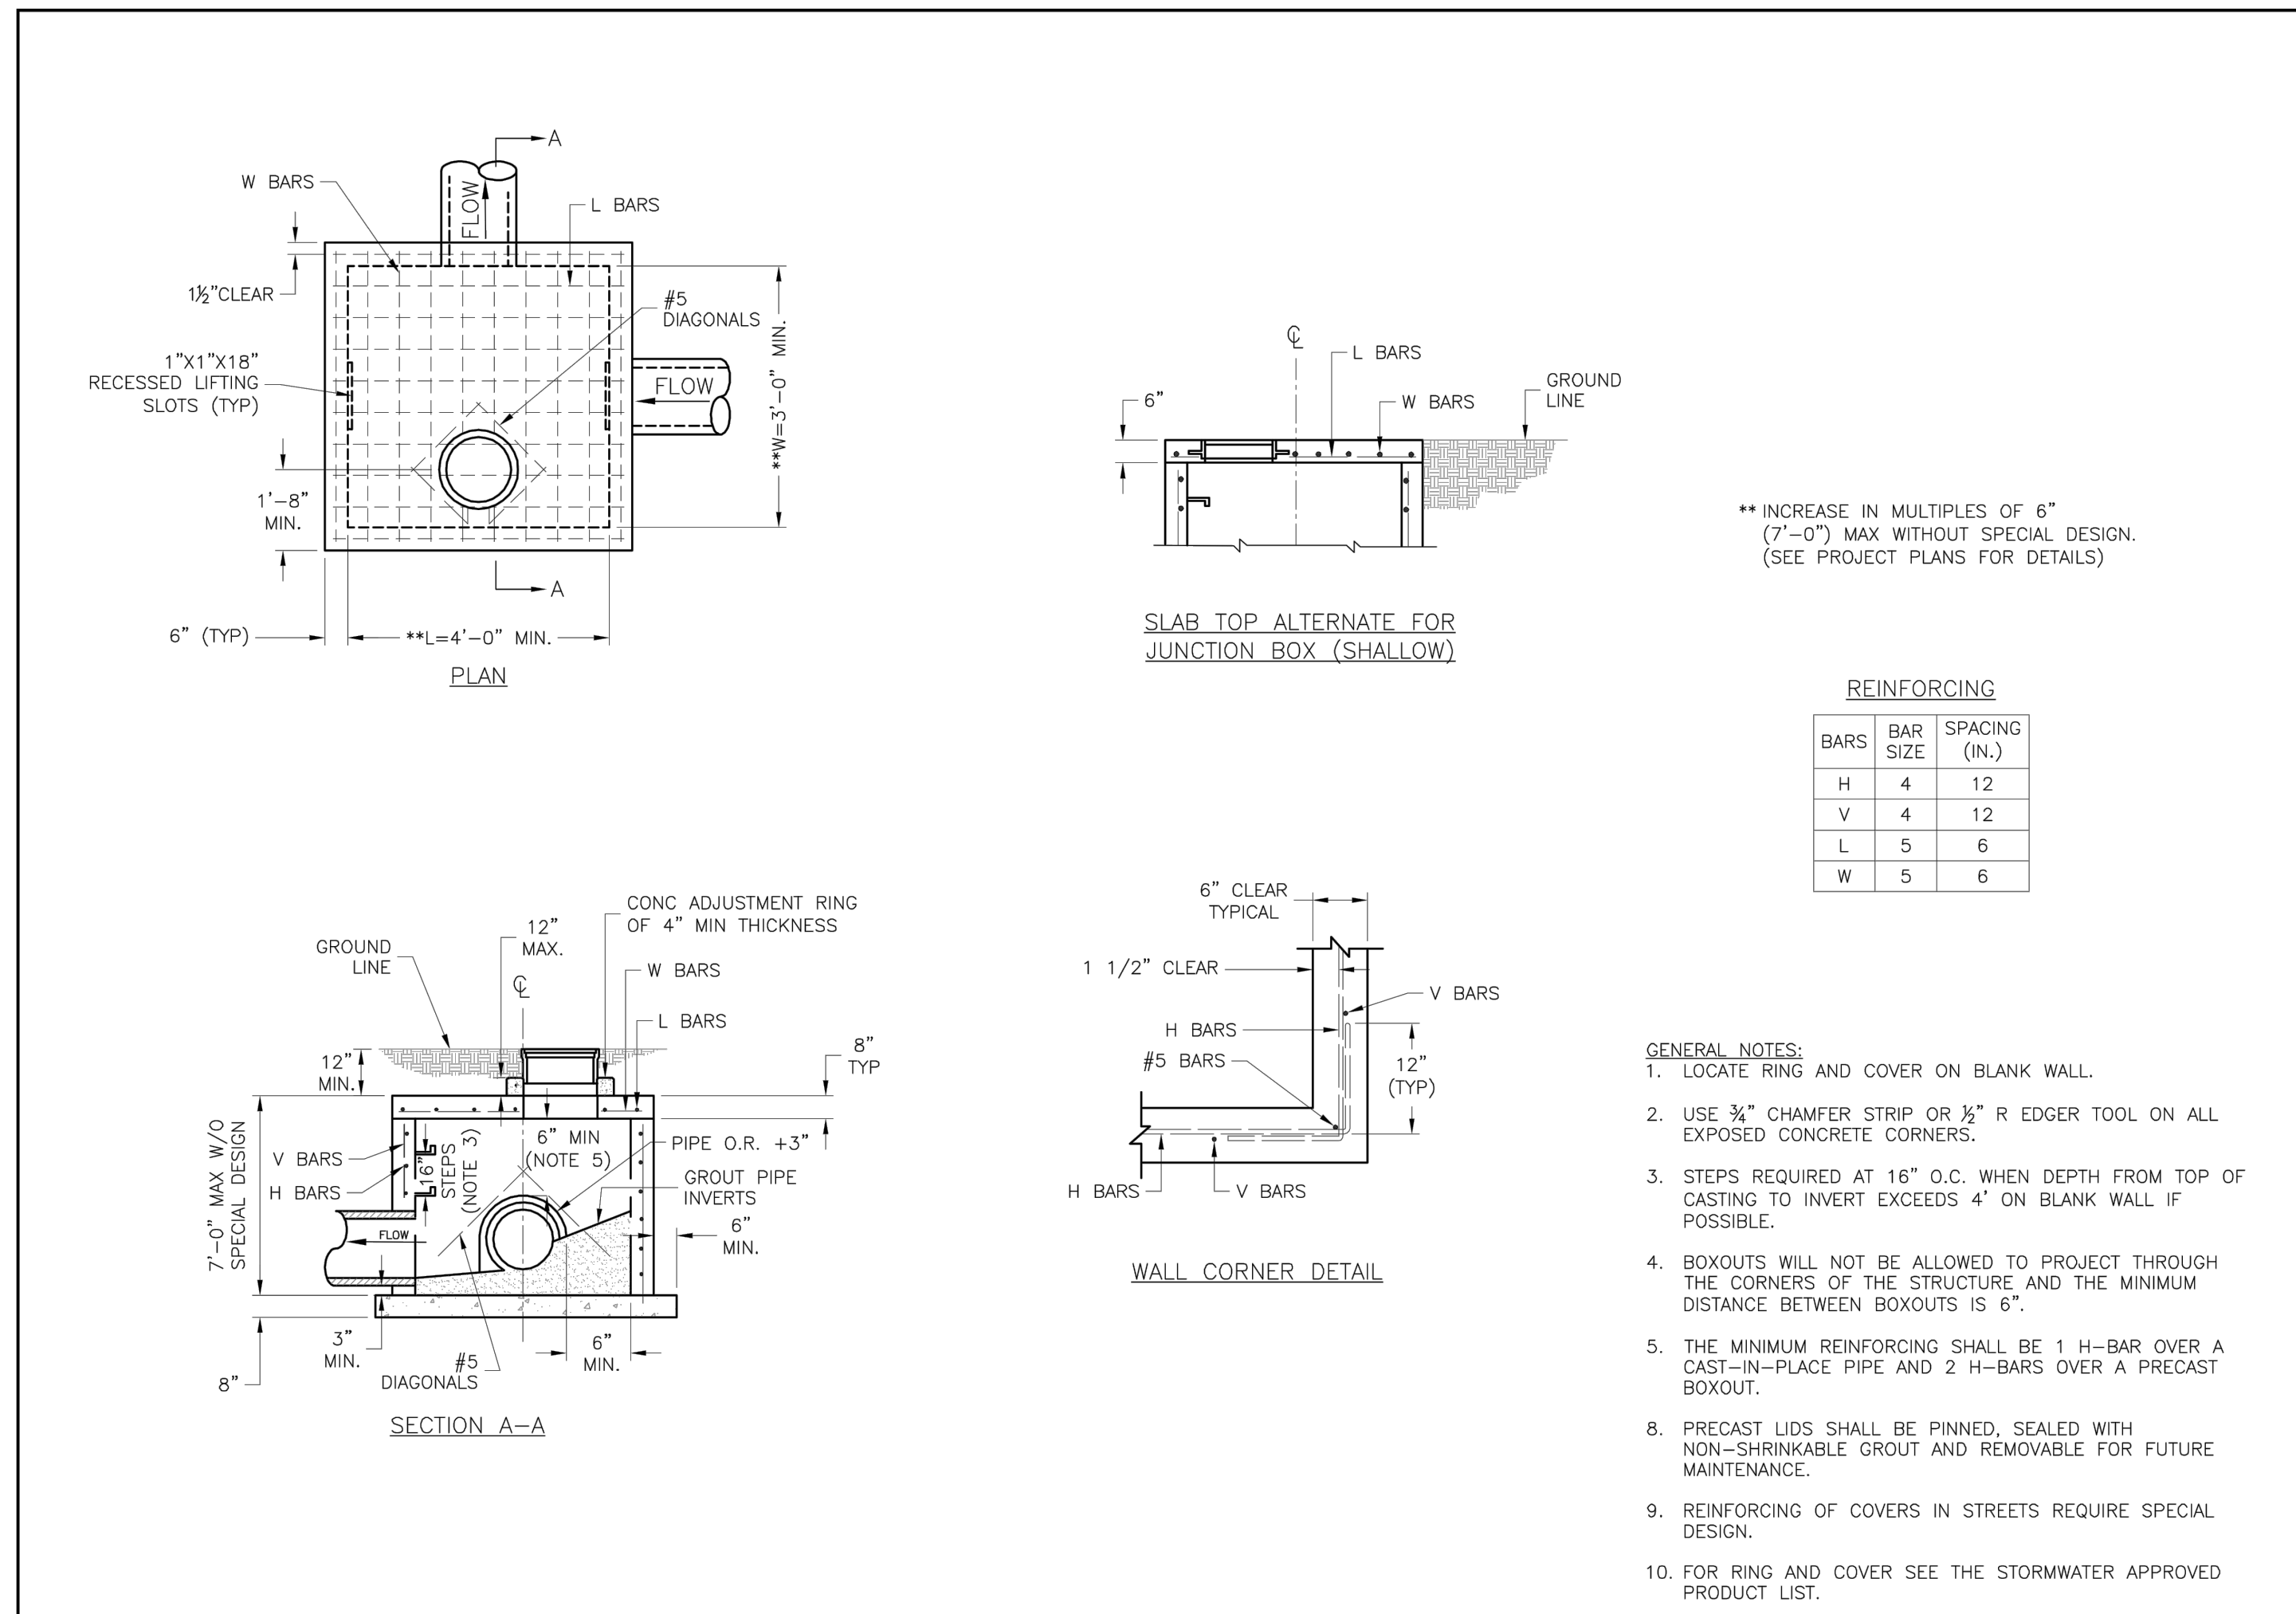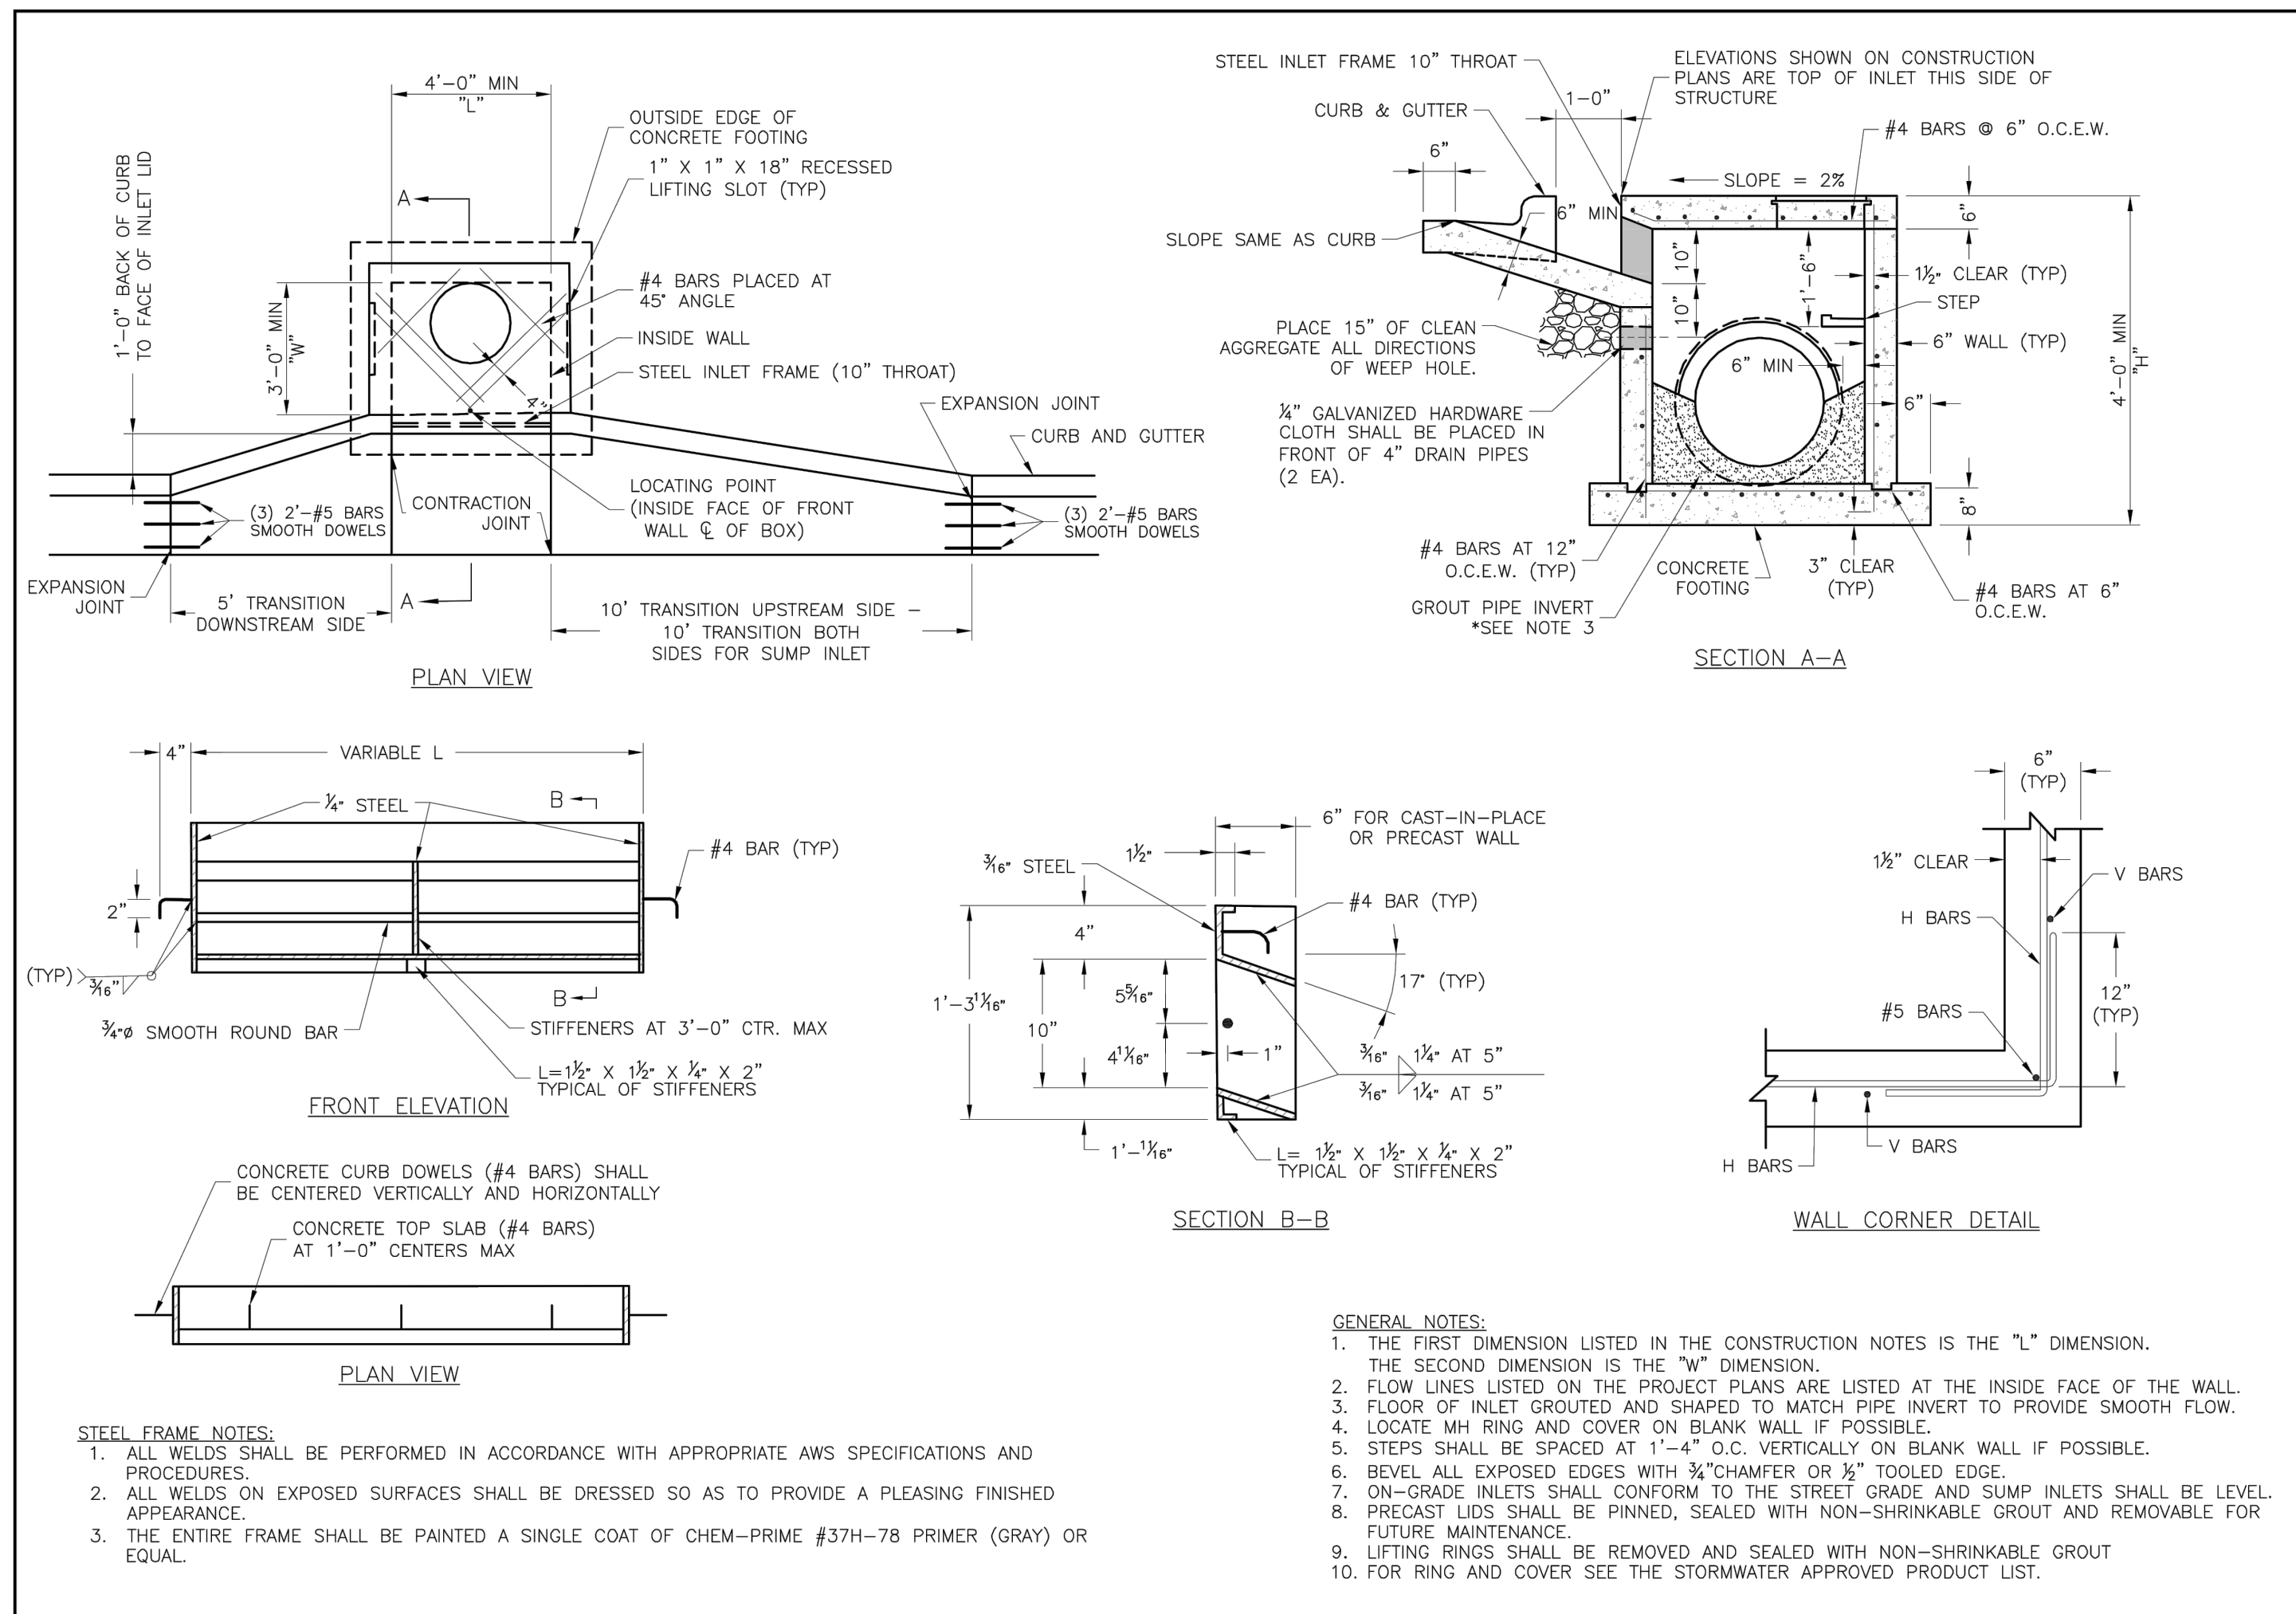

NOT AS-BUILT

