


OSAGE  
SECOND PLAT  
STREET & STORM SEWER PLANS

NE 1/4 SECTION 35, TOWNSHIP 47 N, RANGE 32 W.  
IN LEE'S SUMMIT, JACKSON COUNTY, MISSOURI

Record Drawing  
Gene Williams

Digitally signed by Gene Williams  
DN: CN=Gene Williams, OU=Development, OU=LS Users,  
DC=COLS, DC=LOC  
Date: 2025.03.07 16:05:07-06'00'

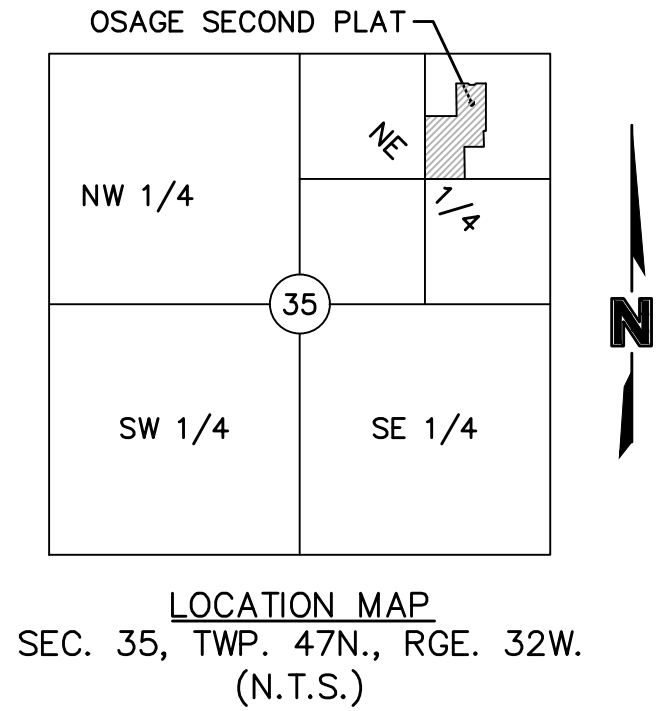

| PROJECT TEAM & UTILITY CONTACT LIST                                                                                                                                                                                     |                                                                                                                                                                                                                                                                                                                                                                                                                  |
|-------------------------------------------------------------------------------------------------------------------------------------------------------------------------------------------------------------------------|------------------------------------------------------------------------------------------------------------------------------------------------------------------------------------------------------------------------------------------------------------------------------------------------------------------------------------------------------------------------------------------------------------------|
| <b>OWNER / DEVELOPER</b><br>CLAYTON PROPERTIES GROUP, INC.<br>D.B.A. SUMMIT HOMES<br>120 SE 30TH STREET<br>CONTACT: VINCENT WALKER<br>LEE'S SUMMIT, MO 64082<br>PHONE: 816.246.6700<br>EMAIL: VINCENT@SUMMITHOMESKC.COM | <b>UTILITY SERVICE NUMBERS</b><br>NAME: LEE'S SUMMIT PUBLIC WORKS<br>PHONE: 816-969-1800<br><br>NAME: LEE'S SUMMIT WATER & SERVICES<br>DEPARTMENT<br>PHONE: 816-969-1940<br><br>NAME: SPIRE (MGE)<br>PHONE: 314-342-0500<br><br>NAME: AT&T<br>PHONE: 800-286-8313<br><br>NAME: EVERGY<br>PHONE: 816-471-5275<br><br>NAME: SPECTRUM (TWC)<br>PHONE: 877-772-2253<br><br>NAME: GOOGLE FIBER<br>PHONE: 877-454-6959 |
| <b>ENGINEER</b><br>OLSSON<br>1301 BURLINGTON ST. SUITE 100<br>NORTH KANSAS CITY, MO 64116<br>CONTACT: JULIE SELLERS, PE<br>PHONE: 816.361.1177<br>EMAIL: JSSELLERS@OLSSON.COM                                           |                                                                                                                                                                                                                                                                                                                                                                                                                  |
| <b>SURVEYOR</b><br>OLSSON<br>1301 BURLINGTON ST. SUITE 100<br>NORTH KANSAS CITY, MO 64116<br>CONTACT: JASON ROUDEBUSH<br>PHONE: 816.361.1177<br>EMAIL: JROUDEBUSH@OLSSON.COM                                            |                                                                                                                                                                                                                                                                                                                                                                                                                  |



PROPERTY DESCRIPTION:

A tract of land in the Northeast Quarter of the Northeast Quarter of Section 35, Township 47 North, Range 32 West of the 5th Principal Meridian in Lee's Summit, Jackson County, Missouri being bounded and described by or under the direct supervision of Jeffrey P. Means P.L.S. 2000147866 as follows: Commencing at the Northeast corner of said Northeast Quarter; thence North 88°07'14" West, on the North line of said Northeast Quarter, 1,319.40 feet to the Northwest corner of the Northeast Quarter of said Northeast Quarter; thence leaving said North line, South 02°10'22" West, on the West line of said Northeast Quarter of said Northeast Quarter, 659.27 feet to the Southwest corner of the North Half of said Northeast Quarter of said Northeast Quarter, also being the Point of Beginning of the tract of land to be herein described; thence South 88°08'29" East, on South line of said North Half of said Northeast Quarter of said Northeast Quarter, 329.96 feet to the Southwest corner of the East Half of the Northwest Quarter of said Northeast Quarter of said Northeast Quarter; thence North 02°09'46" East, on the West line of said East Half of said Northwest Quarter of said Northeast Quarter of said Northeast Quarter, 346.14 feet to a point on the proposed Westerly line of OSAGE FIRST PLAT (LOTS 1 THRU 41, INCLUSIVE AND TRACTS A, B, C, D, E, F, G AND H; thence South 88°11'07" East, on said Westerly line, 127.17 feet; thence South 43°11'07" East, on said Westerly line, 19.80 feet; thence South 88°11'07" East, on said Westerly line, 50.00 feet; thence North 46°48'53" East, on said Westerly line, 19.80 feet; thence South 88°11'07" East, on said Westerly line, 106.00 feet; thence South 01°48'53" West, on said Westerly line, 500.00 feet; thence North 88°11'07" West, on said Westerly line, 21.62 feet; thence South 01°48'53" West, on said Westerly line, 170.00 feet; thence North 88°11'07" West, on said Westerly line, 202.50 feet; thence South 01°48'53" West, on said Westerly line, 335.30 feet to a point on the South line of said Northeast Quarter of said Northeast Quarter; thence North 88°09'45" West, on said South line, 423.24 feet to the Southwest corner of said Northeast Quarter of said Northeast Quarter; thence North 02°10'22" East, on the West line of said Northeast Quarter of said Northeast Quarter, 659.27 feet to the Point of Beginning. Containing 453,717 square feet or 10.42 acres, more or less.

BENCHMARK

BENCHMARK NO. 1  
CHISELED PLUS ON THE EAST FLANGED BOLT OF THE FIRE HYDRANT ON THE WEST SIDE OF SW PRYOR ROAD ON ADJOINING PROPERTY SOUTH OF THE SOUTHWEST CORNER OF SUBJECT PROPERTY.  
ELEVATION = 1014.830

BENCHMARK NO. 2  
RAILROAD SPIKE IN THE NORTH FACE OF POWER POLE LOCATED ON THE SOUTH SIDE MISSOURI STATE HIGHWAY 150 AT THE WEST SIDE OF THE DRIVEWAY TO 2025 MISSOURI STATE HIGHWAY 150, LEE'S SUMMIT, MO.  
ELEVATION = 1031.313


| Sheet Number | Sheet Title                                             |
|--------------|---------------------------------------------------------|
| C101         | TITLE SHEET                                             |
| C102         | GENERAL NOTES                                           |
| C103         | GENERAL LAYOUT                                          |
| C104         | TYPICAL SECTIONS                                        |
| C105         | GRADING PLAN (FOR REFERENCE ONLY)                       |
| C106         | SWALE 1 PLAN & PROFILE                                  |
| C107         | SWALE 1 PLAN & PROFILE (CONT'D)                         |
| C108         | SWALE 2 PLAN & PROFILE                                  |
| C109         | SWALE 3 PLAN & PROFILE                                  |
| C110         | ROADWAY PLAN & PROFILE (SW CLAYTON PLACE)               |
| C111         | ROADWAY PLAN & PROFILE (SW OSAGE DRIVE)                 |
| C112         | ROADWAY PLAN & PROFILE (SW OSAGE DRIVE CONT'D)          |
| C113         | ROADWAY PLAN & PROFILE (SW RIVENGATE PLACE)             |
| C114         | ROADWAY PLAN & PROFILE (SW RUTHERFORD DRIVE)            |
| C115         | SW OSAGE DRIVE AND SW CLAYTON PLACE INTERSECTION        |
| C116         | SW OSAGE DRIVE AND SW RIVENGATE PLACE INTERSECTION      |
| C117         | SW RIVENGATE PLACE AND SW RUTHERFORD DRIVE INTERSECTION |
| C118         | STORM SEWER PLAN & PROFILE (LINE 1)                     |
| C119         | STORM SEWER PLAN & PROFILE (LINE 2)                     |
| C120         | STORM SEWER PLAN & PROFILE (LINE 3)                     |
| C121         | STORM SEWER PLAN & PROFILE (LINES 4 & 5)                |
| C122         | STORM SEWER PLAN & PROFILE (LINE 6)                     |
| C123         | STORM SEWER PLAN & PROFILE (LINE 6 CONT'D)              |
| C124         | STORM SEWER PLAN & PROFILE (LINE 7)                     |
| C125         | STORM SEWER PLAN & PROFILE (LINES 8 & 9)                |
| C126         | MASTER DRAINAGE PLAN                                    |
| C127         | DRAINAGE PLAN                                           |
| C128         | DRAINAGE TABLES                                         |
| C129         | DETAILS                                                 |
| C130         | DETAILS (CONT'D)                                        |
| C131         | DETAILS (CONT'D)                                        |

OLSSON HAS BEEN RETAINED TO PROVIDE AS-BUILT DRAWINGS FOR THIS PROJECT.

*Julie Sellers*  
JULIE SELLERS, P.E.  
CIVIL ENGINEER  
MO#2017000367

3/6/2025  
DATE

ASBUILT  
02-03-2022

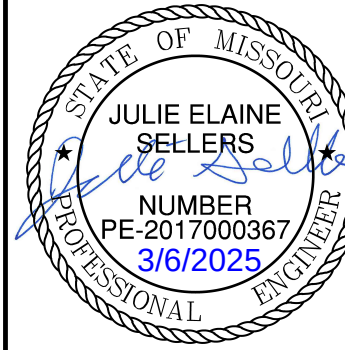

| REV. NO. | DATE       | REVISIONS DESCRIPTION         |
|----------|------------|-------------------------------|
| 1        | 03.06.2025 | REVISED PER LINE 9 PIPE SLOPE |

2020

TITLE SHEET  
STREET & STORM SEWER PLANS

OSAGE  
SECOND PLAT

drawn by: D.F./M.O./A.A.  
checked by: C.G.W.  
designed by: A.A.  
QA/QC by: J.E.S.  
project no.: C19-2339  
drawing no.:  
date: 2022.05.26

SHEET  
C101

REVISIONS

olsson

Olsson - Civil Engineering  
Missouri Certificate of Authority #: 001592  
1301 Burlington Street  
North Kansas City, MO 64116  
TEL 816.361.1177  
www.olsson.com








DWG: F:\2019\2001-2500\019-2339-CA 10-Design\AutoCAD\Final Plans - As-Built\Sheets\GNV\STREET & STORM\AC\_DEM01\_C192339.dwg USER: esayler  
DATE: May 26, 2022 7:32am XREFS: C\_PBDY\_C192339 C\_PBASE\_C192339 C\_PSTRM\_C192339 C\_PBLK\_C192339 C\_PSSWR\_C192339 C\_PWATR\_C192339

| Structure Table |             |              |
|-----------------|-------------|--------------|
| STRUCTURE ID    | NORTHING    | EASTING      |
| C.I. 1-2        | 977598.7777 | 2811350.3990 |
| C.I. 1-3        | 977608.0764 | 2811056.9286 |
| C.I. 1-4        | 977642.5988 | 2811040.9780 |
| C.I. 2-1        | 977712.5148 | 2811423.6554 |
| C.I. 2-2        | 977711.4380 | 2811457.6384 |
| C.I. 3-1        | 977468.0529 | 2811116.5240 |
| C.I. 3-2        | 977486.1870 | 2811083.0816 |
| C.I. 4-1        | 977326.0305 | 2811239.2055 |
| C.I. 4-2        | 977319.1371 | 2811077.7885 |
| C.I. 5-1        | 977292.0475 | 2811238.1288 |
| C.I. 6-2        | 977158.1391 | 2811106.7044 |
| C.I. 6-3        | 977159.2158 | 2811072.7214 |
| C.I. 8-1        | 978110.2379 | 2811470.2744 |
| C.I. 9-1        | 977632.7606 | 2811351.4758 |
| EX C.I. 1       | 977320.8051 | 2811404.1227 |
| EX C.I. 2       | 977588.7590 | 2811666.5942 |
| EX C.I. 3       | 978147.4055 | 2811402.4174 |
| EX C.I. 4       | 978150.5883 | 2811301.9679 |
| EX F.I. 1       | 977145.2863 | 2811509.1437 |
| EX F.I. 2       | 977150.3910 | 2811351.1993 |
| EX F.I. 3       | 977453.5763 | 2811573.4124 |
| EX F.I. 4       | 977460.3060 | 2811361.0190 |
| EX F.I. 5       | 978052.0411 | 2811295.4838 |
| EX F.I. 6       | 978111.3146 | 2811436.2915 |
| F.I. 6-1        | 977155.8549 | 2811178.7819 |

| Structure Table |             |              |
|-----------------|-------------|--------------|
| STRUCTURE ID    | NORTHING    | EASTING      |
| F.I. 6-4        | 977163.6498 | 2810932.7838 |
| F.I. 6-5        | 977331.7198 | 2810938.6323 |
| F.I. 6-6        | 977490.5887 | 2810944.1607 |
| F.I. 7-1        | 977786.8342 | 2811287.1599 |
| F.I. 7-2        | 977794.6401 | 2811040.8007 |
| M.H. 1-1        | 977596.5729 | 2811419.9818 |

NOT AS-BUILT

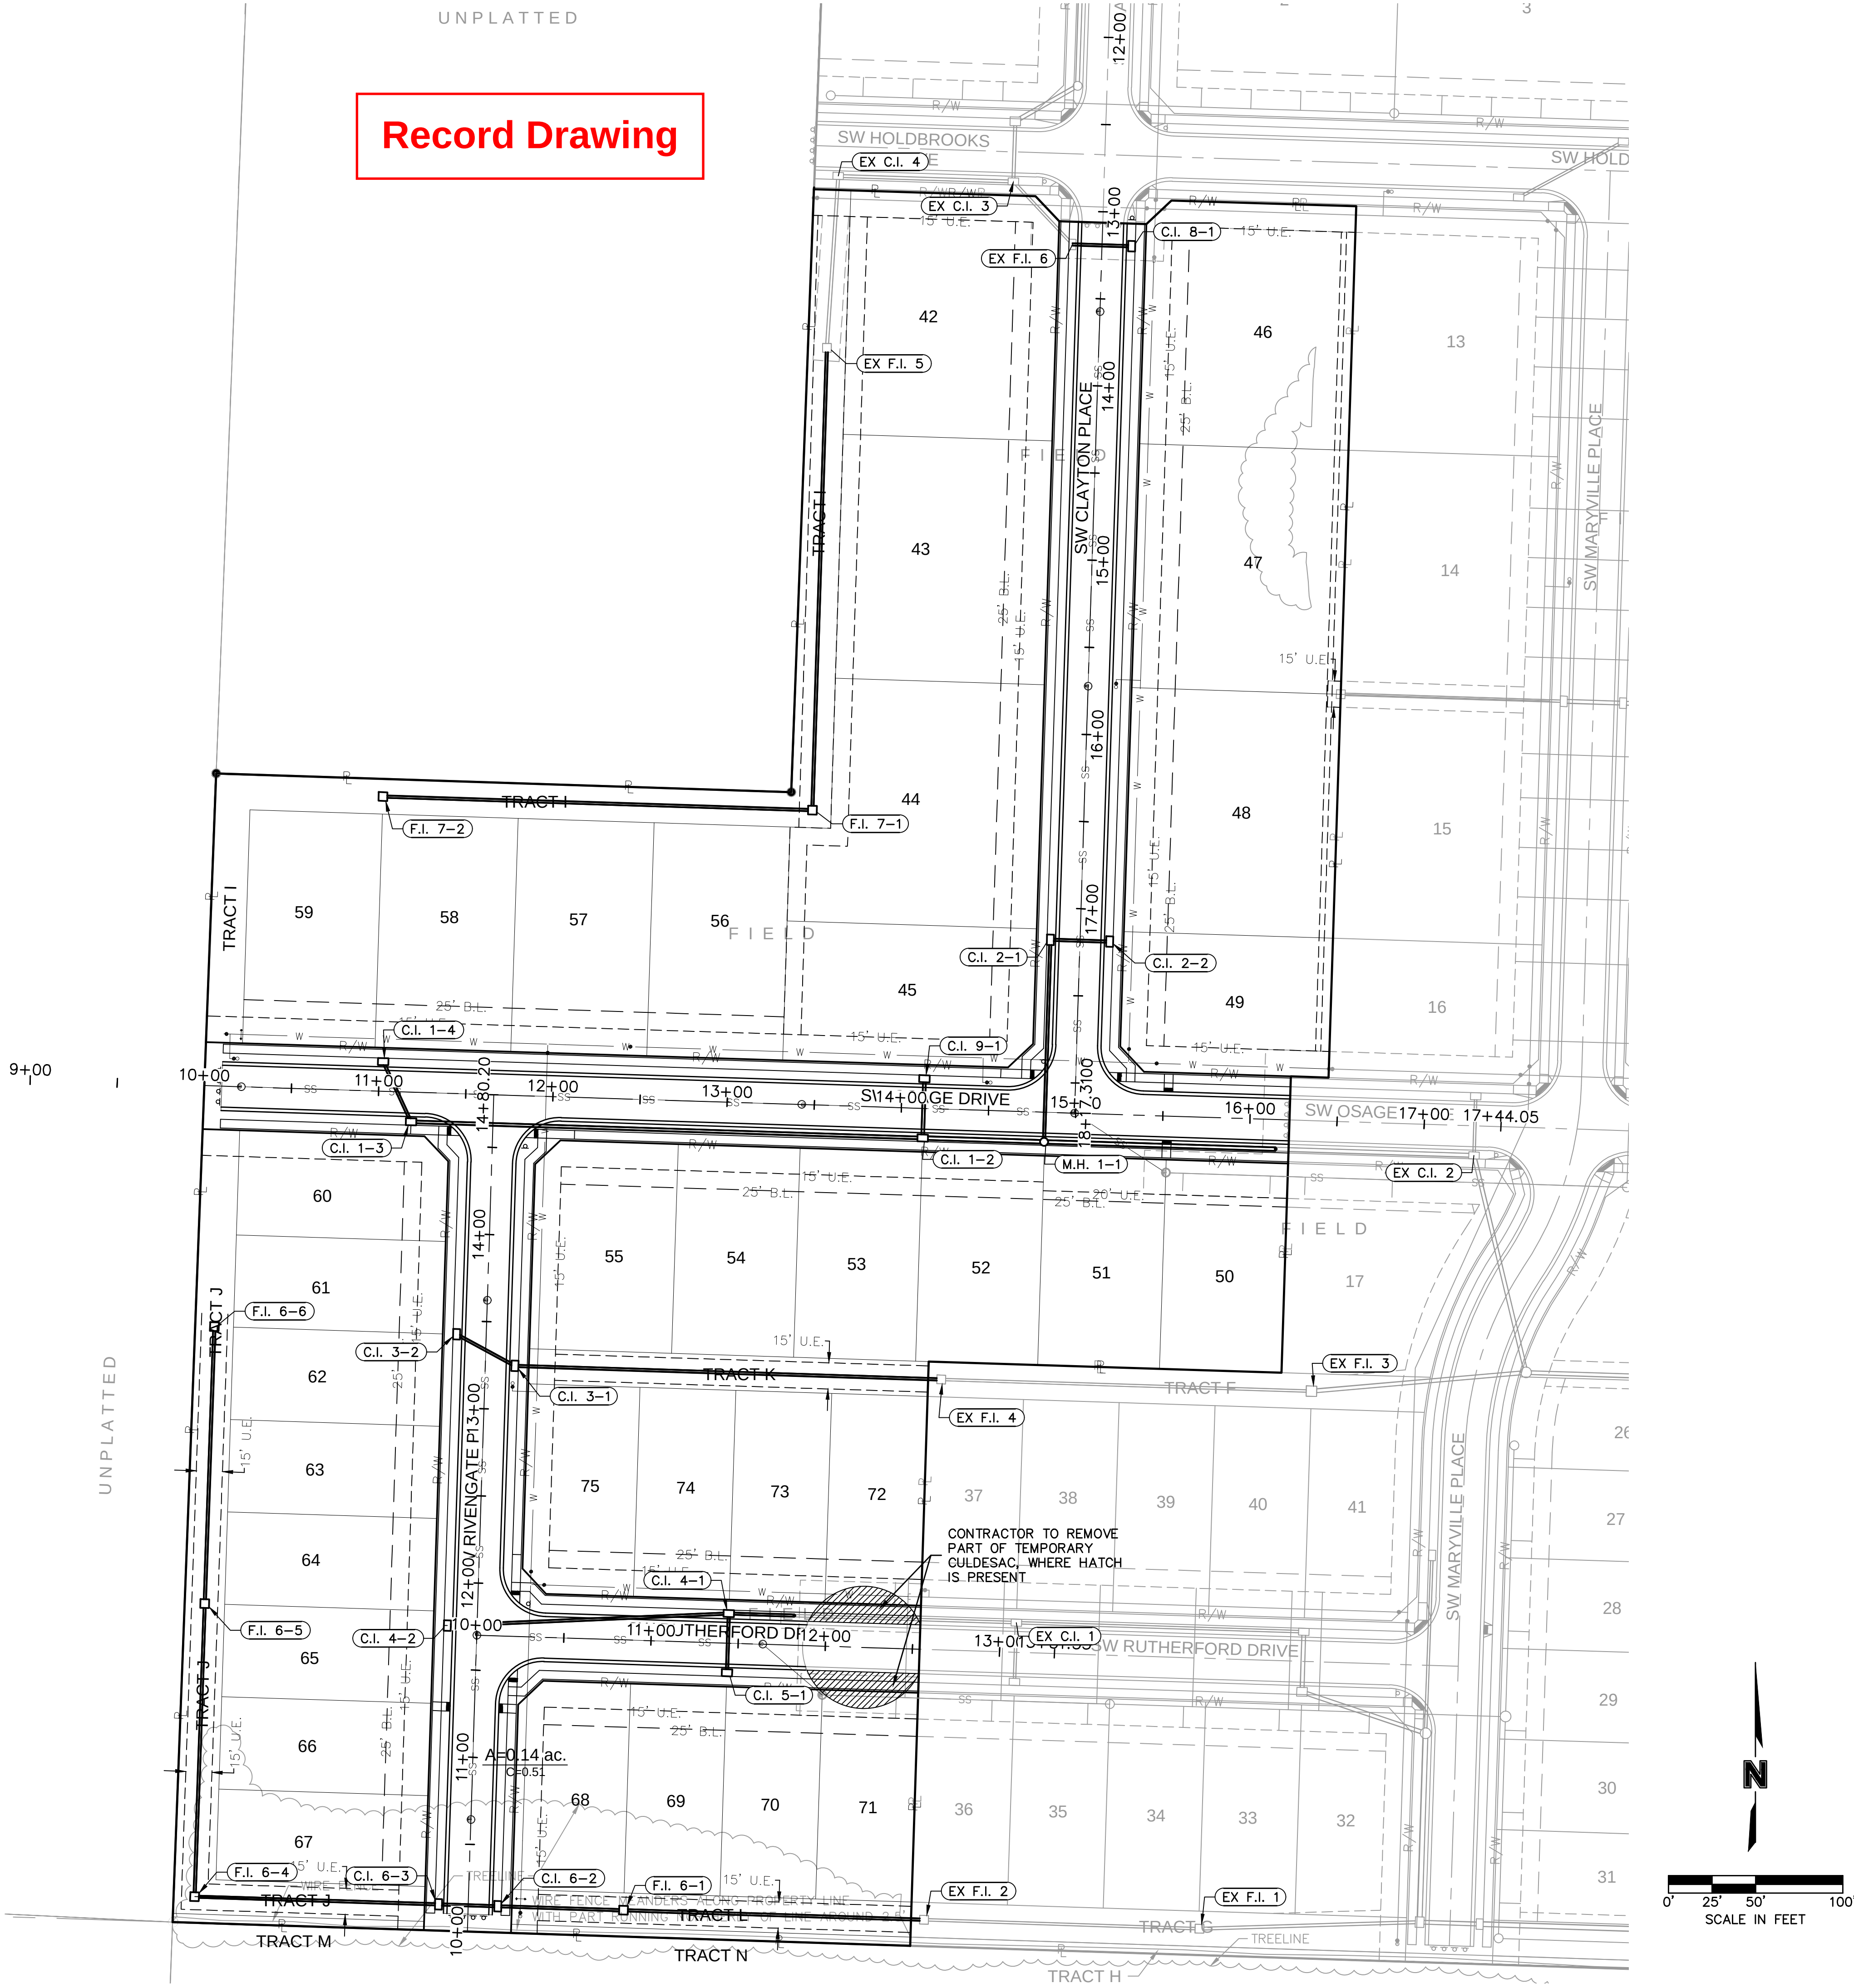

olsson

Olsson - Civil Engineering  
Missouri Certificate of Authority #: 001592  
1301 Burlington Street  
North Kansas City, MO 64116  
TEL 816.361.1177  
www.olsson.com

STATE OF MISSOURI  
JULIE ELAINE SELLERS  
Professional Engineer  
NUMBER PE-2017/000367  
3/6/2025

GENERAL LAYOUT  
STREET & STORM SEWER PLANS

OSAGE  
SECOND PLAT

2020

drawn by: D.F./M.O./A.A.  
checked by: C.G.W.  
designed by: A.A.  
QA/QC by: J.E.S.  
project no.: C19-2339  
drawing no.:  
date: 2022.05.26

SHEET  
C103


REVISIONS DESCRIPTION

DATE

REV. NO.

2020



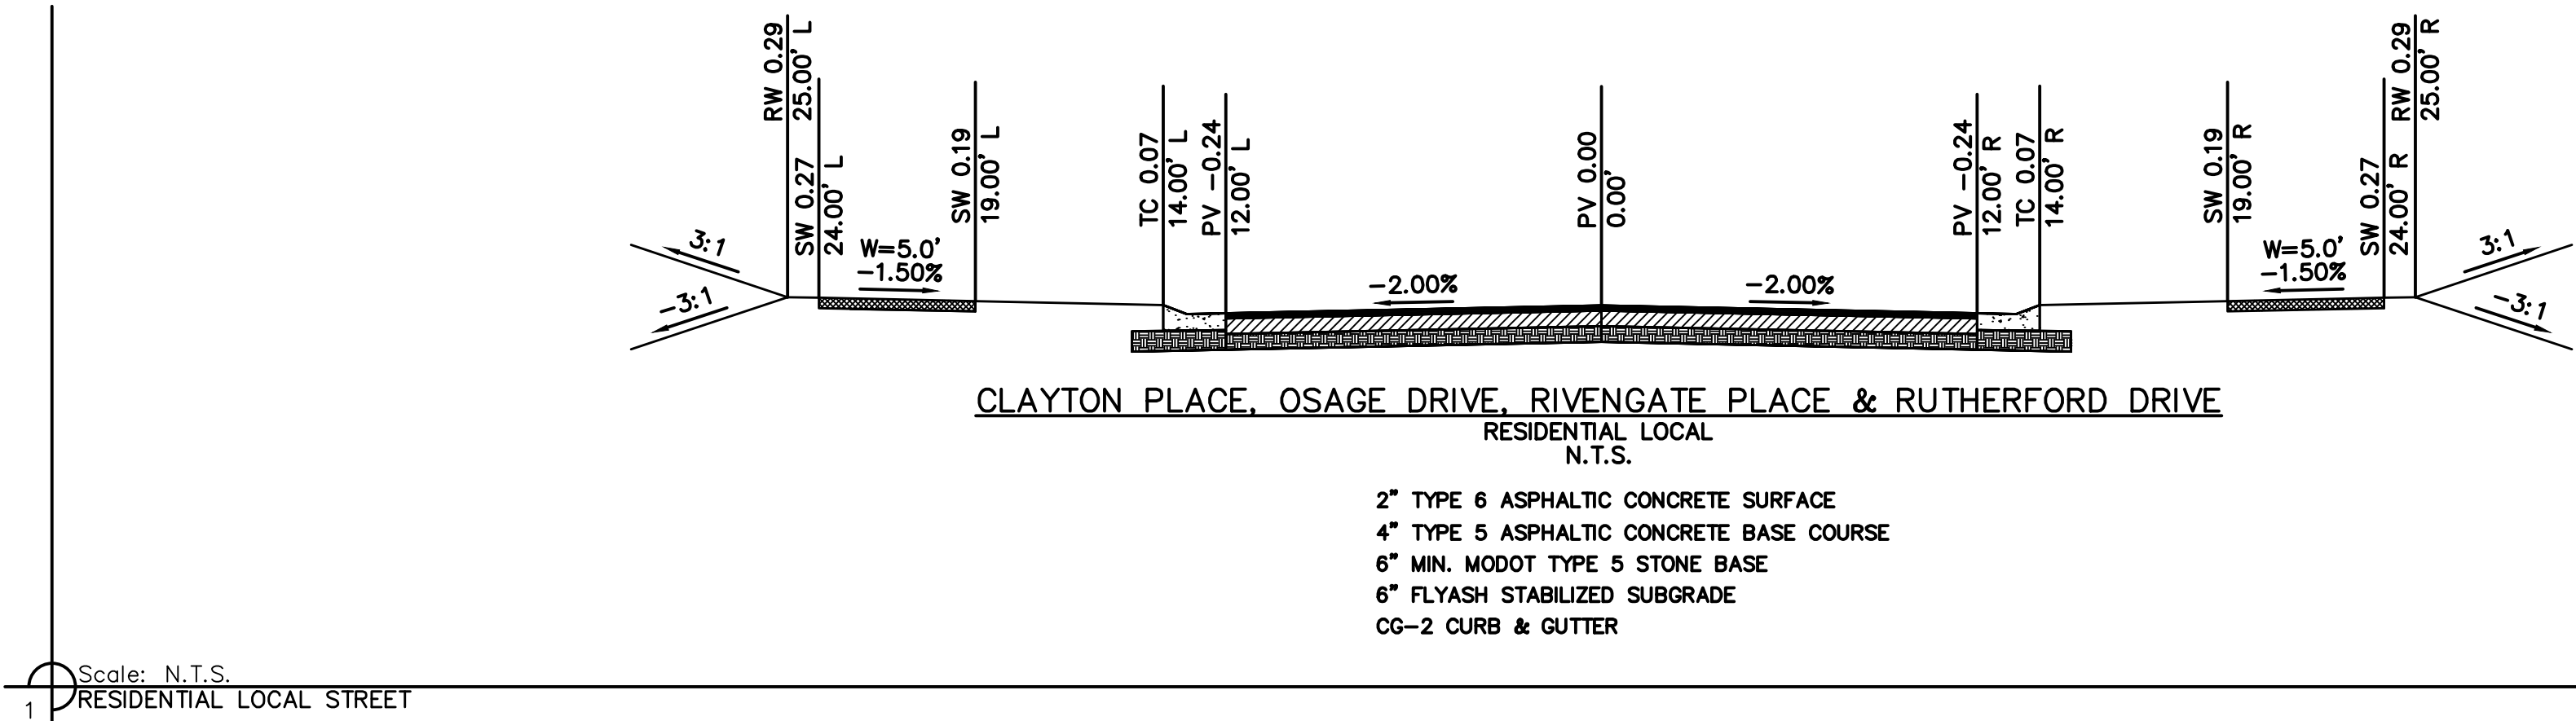


# NOT AS-BUILT

# Record Drawing

|                                                                                                                                                                                                          |          |           |                       |
|----------------------------------------------------------------------------------------------------------------------------------------------------------------------------------------------------------|----------|-----------|-----------------------|
| TYPICAL SECTIONS<br>STREET & STORM SEWER PLANS                                                                                                                                                           | REV. NO. | DATE      | REVISIONS DESCRIPTION |
|                                                                                                                                                                                                          |          |           |                       |
| OSAGE<br>SECOND PLAT                                                                                                                                                                                     |          |           |                       |
|                                                                                                                                                                                                          |          |           |                       |
| drawn by: <u>D.F. / M.O. / A.A.</u><br>checked by: <u>C.G.W.</u><br>designed by: <u>A.J.</u><br>QA/QC by: <u>J.E.S.</u><br>project no.: <u>C19-2339</u><br>drawing no.: _____<br>date: <u>2022.05.26</u> | 2020     | REVISIONS |                       |
| SHEET<br>C104                                                                                                                                                                                            |          |           |                       |

|              |                    |
|--------------|--------------------|
| drawn by:    | D.F. / M.O. / A.A. |
| checked by:  | C.G.W.             |
| designed by: | A.A.               |
| QA/QC by:    | J.E.S.             |
| project no.: | C19-23399          |
| drawing no.: |                    |
| date:        | 2022.05.26         |

SHEET  
C104

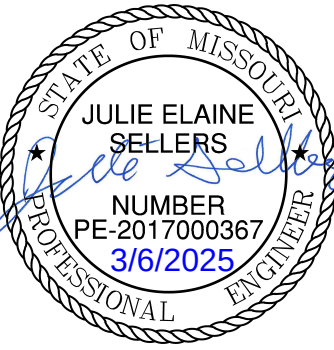

**olsen**

Olsson - Civil Engineering  
Missouri Certificate of Authority #: 001592  
1301 Burlington Street  
North Kansas City, MO 64116



[illegible]

|                      |      |
|----------------------|------|
| OSAGE<br>SECOND PLAT | 2020 |
|----------------------|------|

|              |                    |
|--------------|--------------------|
| drawn by:    | D.F. / M.O. / A.A. |
| checked by:  | C.G.W.             |
| designed by: | A.A.               |
| QA/QC by:    | J.E.S.             |
| project no.: | C19-2339           |
| drawing no.: |                    |
| date:        | 2022.05.26         |


SHEET  
C105

1. CONTRACTOR SHALL ADHERE TO THE "DESIGN AND CONSTRUCTION MANUAL" SECTION 2100 AS ADOPTED BY THE CITY OF LEE'S SUMMIT (LATEST EDITION), FOR EXCAVATION AND EMBANKMENT WORK WITHIN THE PROPOSED RIGHT-OF-WAY.

2. AREAS OF CONSTRUCTION SHALL BE STRIPPED OF ALL VEGETATION, ORGANIC MATTER AND TOPSOIL TO A DEPTH AS RECOMMENDED BY GEOTECHNICAL ENGINEER AND OR TESTING AGENCY. SOILS REMOVED DURING SITE STRIPPING SHOULD BE EVALUATED TO DETERMINE IF PORTIONS OF THE TOPSOIL STRATUM MAY BE UTILIZED AS STRUCTURAL FILL WITHIN PAVEMENT AREAS. ANY MATERIAL NOT DEEMED AS SUITABLE FILL MATERIAL BY THE GEOTECHNICAL ENGINEER AND OR TESTING AGENCY SHALL BE REMOVED FROM THE JOB SITE BY THE CONTRACTOR AT HIS EXPENSE.

3. ALL EMBANKMENT OUTSIDE OF RIGHT-OF-WAY SHOULD BE PLACED IN CONTROLLED LIFTS HAVING A MAXIMUM LOOSE LIFT THICKNESS OF 8". EMBANKMENT SHOULD BE COMPACTED TO A MINIMUM OF 95% OF THE MATERIALS MAXIMUM DRY DENSITY AS DETERMINED BY ASTM D-698 (STANDARD PROCTOR COMPACTION). MOISTURE CONTENT OF THE FILL AT THE TIME OF COMPACTION SHALL BE WITHIN A RANGE OF -0 TO +4 PERCENT OF OPTIMUM MOISTURE CONTENT.

**NOT AS-BUILT**

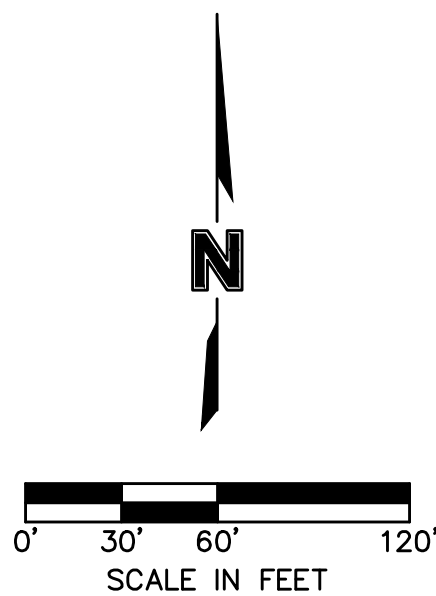


| LEGEND                                                                              |                                |
|-------------------------------------------------------------------------------------|--------------------------------|
|  | EXISTING INDEX CONTOURS        |
|  | EXISTING INTERMEDIATE CONTOURS |
|  | PROPOSED INDEX CONTOURS        |
|  | PROPOSED INTERMEDIATE CONTOURS |

| EARTHWORK QUANTITIES |            |             |
|----------------------|------------|-------------|
| LOCATION             | CUT (C.Y.) | FILL (C.Y.) |
| STREET               | 2,438      | 827         |
| SITE                 | 7,812      | 5,520       |
| TOTAL                | 10,250     | 6,347       |


1. EARTHWORK QUANTITIES BASED ON FINISHED GRADE SURFACE AND DO NOT INCLUDE ADJUSTMENTS FOR TOPSOIL AND SHRINKAGE.

2. EARTHWORK QUANTITIES DO NOT TAKE INTO CONSIDERATION EXCAVATION, REMOVAL AND DISPOSAL OF MATERIAL DEEMED UNSUITABLE BY A GEOTECHNICAL ENGINEER. THE EARTHWORK CONTRACTOR IS RESPONSIBLE FOR EXCAVATION, REMOVAL AND DISPOSAL OF UNSUITABLE MATERIAL AND FOR REPLACING IT WITH SUITABLE MATERIAL.

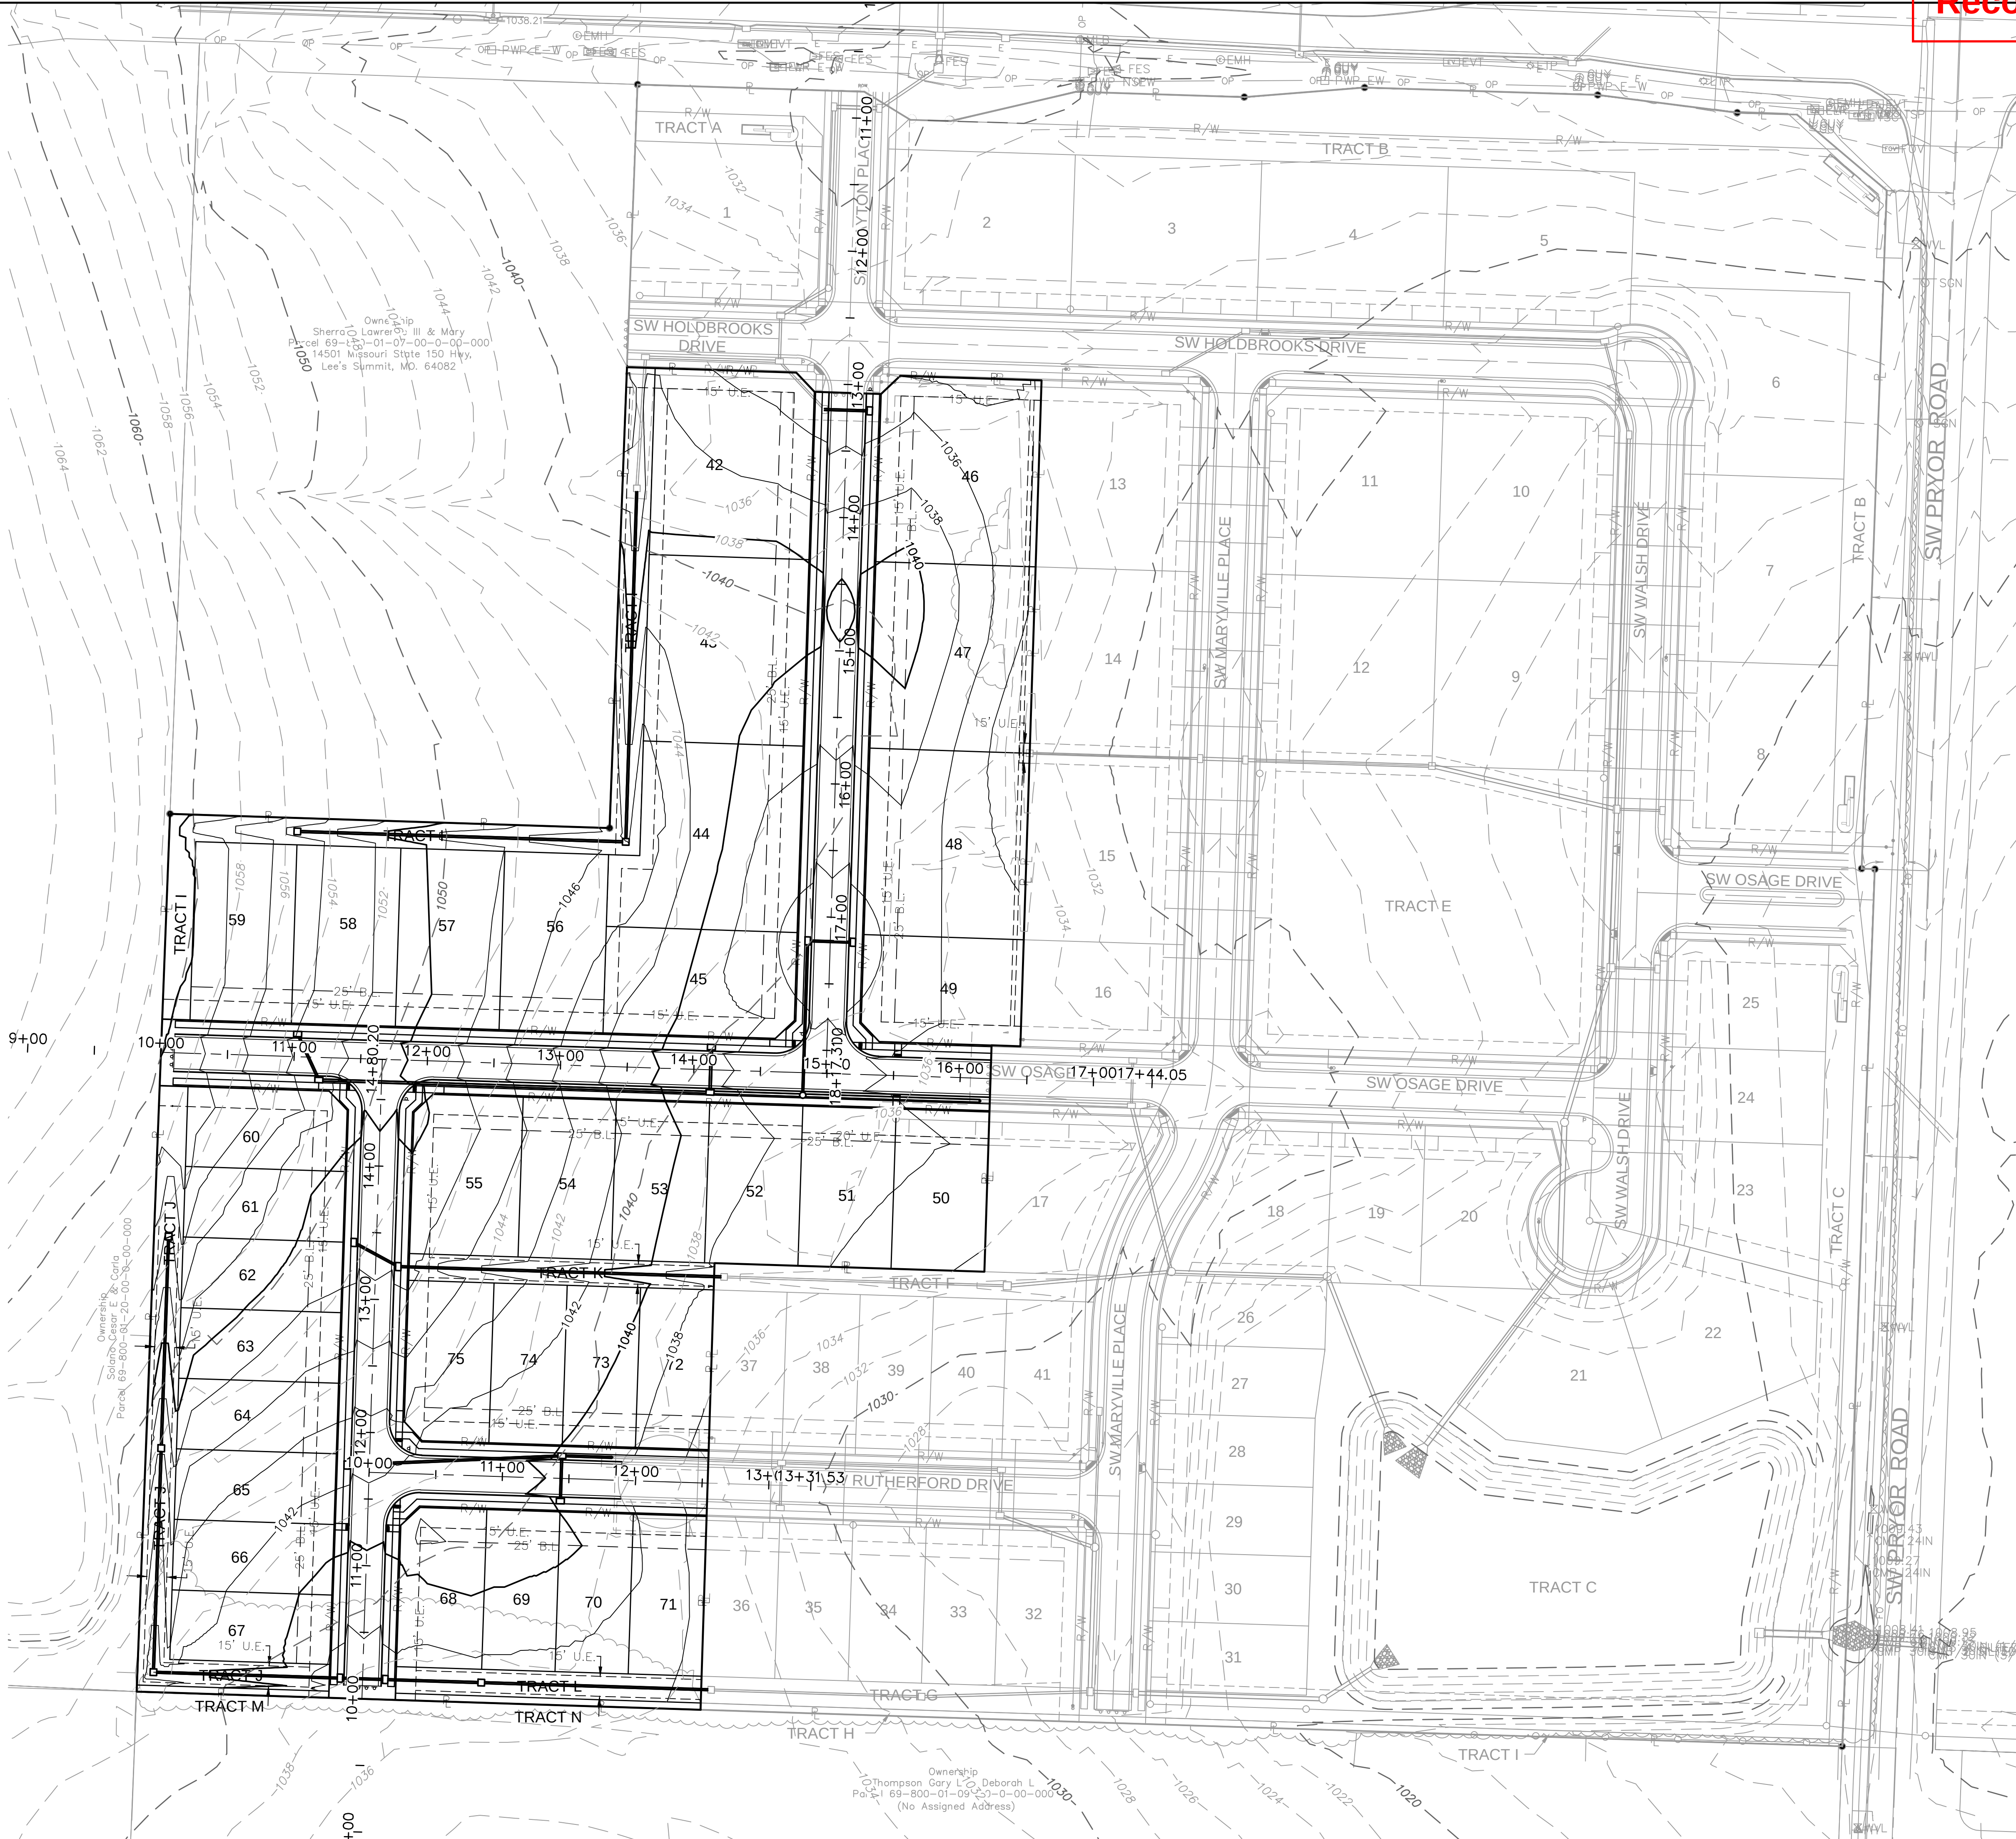

DWG: F:\2019\2001-2500\019-2339-C\40-Design\AutoCAD\Final Plans - As-builts\Sheets\GNVC\STREET & STORE\A\_C192339.dwg USER: ssaylor  
XREFS: C:\BASE\_C192339 C\_PBASE\_C192339 C\_PSTRM\_C192339 C\_PBNDY\_C192339 C\_PTLK\_C192339  
DATE: May 26, 2022 7:35am



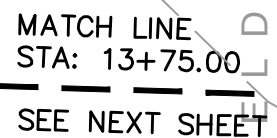


1. CONTRACTOR SHALL CONSTRUCT SWALES WITH MINIMUM SLOPE, WIDTH AND DEPTH AS SHOWN IN THE SWALE DESIGN TABLES.

2. AS-BUILT SURVEY IS REQUIRED/APPROVED BY CITY FOR ALL SWALES AND PRIOR TO APPROVAL FOR ANY BUILDING FOUNDATION PERMIT. CONTRACTOR SHALL BE REQUIRED TO REGRADE SWALES AT CONTRACTOR'S EXPENSE IF ABOVE REQUIREMENTS ARE NOT MET.



| SWALE DESIGN TABLE (100-YEAR RETURN FREQUENCY) |                      |                   |                  |                       |                        |                   |                 |                  |                 |                   |                       |                |                      |                        |
|------------------------------------------------|----------------------|-------------------|------------------|-----------------------|------------------------|-------------------|-----------------|------------------|-----------------|-------------------|-----------------------|----------------|----------------------|------------------------|
| SECTION                                        | Mannings Coefficient | Channel Slope (%) | SECTION DATA     |                       |                        |                   |                 | RESULTS          |                 |                   |                       |                |                      |                        |
|                                                |                      |                   | Swale Depth (ft) | Left Side Slope (H:V) | Right Side Slope (H:V) | Bottom Width (ft) | Discharge (cfs) | Water Depth (ft) | Flow Area (ft²) | Velocity (ft/sec) | Wetted Perimeter (ft) | Top Width (ft) | Specific Energy (ft) | Shear Stress (lbs/ft²) |
| A-A                                            | 0.03                 | 2.02%             | 1.5              | 3:1                   | 3:1                    | 5                 | 7.76            | 0.39             | 2.41            | 3.22              | 7.47                  | 7.34           | 0.39                 | 0.41                   |
| B-B                                            | 0.03                 | 2.75%             | 1.5              | 3:1                   | 3:1                    | 5                 | 22.11           | 0.64             | 4.43            | 4.99              | 9.05                  | 8.84           | 0.73                 | 0.84                   |
| C-C                                            | 0.03                 | 2.75%             | 1.5              | 3:1                   | 3:1                    | 6                 | 6.05            | 0.31             | 1.84            | 3.29              | 6.96                  | 6.86           | 0.34                 | 0.45                   |

| Section | Drainage Area<br>(ac.) | C    | Tc<br>(min) | i<br>(in/hr) | K    | Peak Flow<br>(cfs) |
|---------|------------------------|------|-------------|--------------|------|--------------------|
| A-A     | 1.18                   | 0.51 | 5           | 10.32        | 1.25 | 7.76               |
| B-B     | 3.36                   | 0.51 | 5           | 10.32        | 1.25 | 22.11              |
| C-C     | 0.92                   | 0.51 | 9.16        | 10.32        | 1.25 | 6.05               |

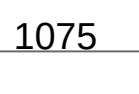



PER OSAGE 3RD PLAT PLANS,  
SWALE WAS ELIMINATED DUE  
TO REDUCTION IN DRAINAGE  
AREA. OSAGE 3RD PLAT IS  
— ACTIVELY UNDER  
CONSTRUCTION AT TIME OF  
THESE AS-BUILTS



DWG: F:\2019\2001-2500\019-2339-C140-Design\AutoCAD\Final Plans - As-Built\Sheets\GNC\A STREET & STORM\C\_SWL01\_C192339.dwg USER: aswyler  
DATE: May 26, 2022 7:34am XREFS: C\_PBASE\_C192339 C\_PBN0Y\_C192339 C\_PSTRM\_C192339 C\_PSTRM\_C192339 C\_PSSWR\_C192339 C\_PWATR\_C192339 C\_PSURF\_C192339



SWALE GRADING NOTES:

1. CONTRACTOR SHALL CONSTRUCT SWALES WITH MINIMUM SLOPE, WIDTH AND DEPTH AS SHOWN IN THE SWALE DESIGN TABLES.
2. AS-BUILT SURVEY IS REQUIRED/APPROVED BY CITY FOR ALL SWALES AND PRIOR TO APPROVAL FOR ANY BUILDING FOUNDATION PERMIT. CONTRACTOR SHALL BE REQUIRED TO REGRADE SWALES AT CONTRACTOR'S EXPENSE IF ABOVE REQUIREMENTS ARE NOT MET.

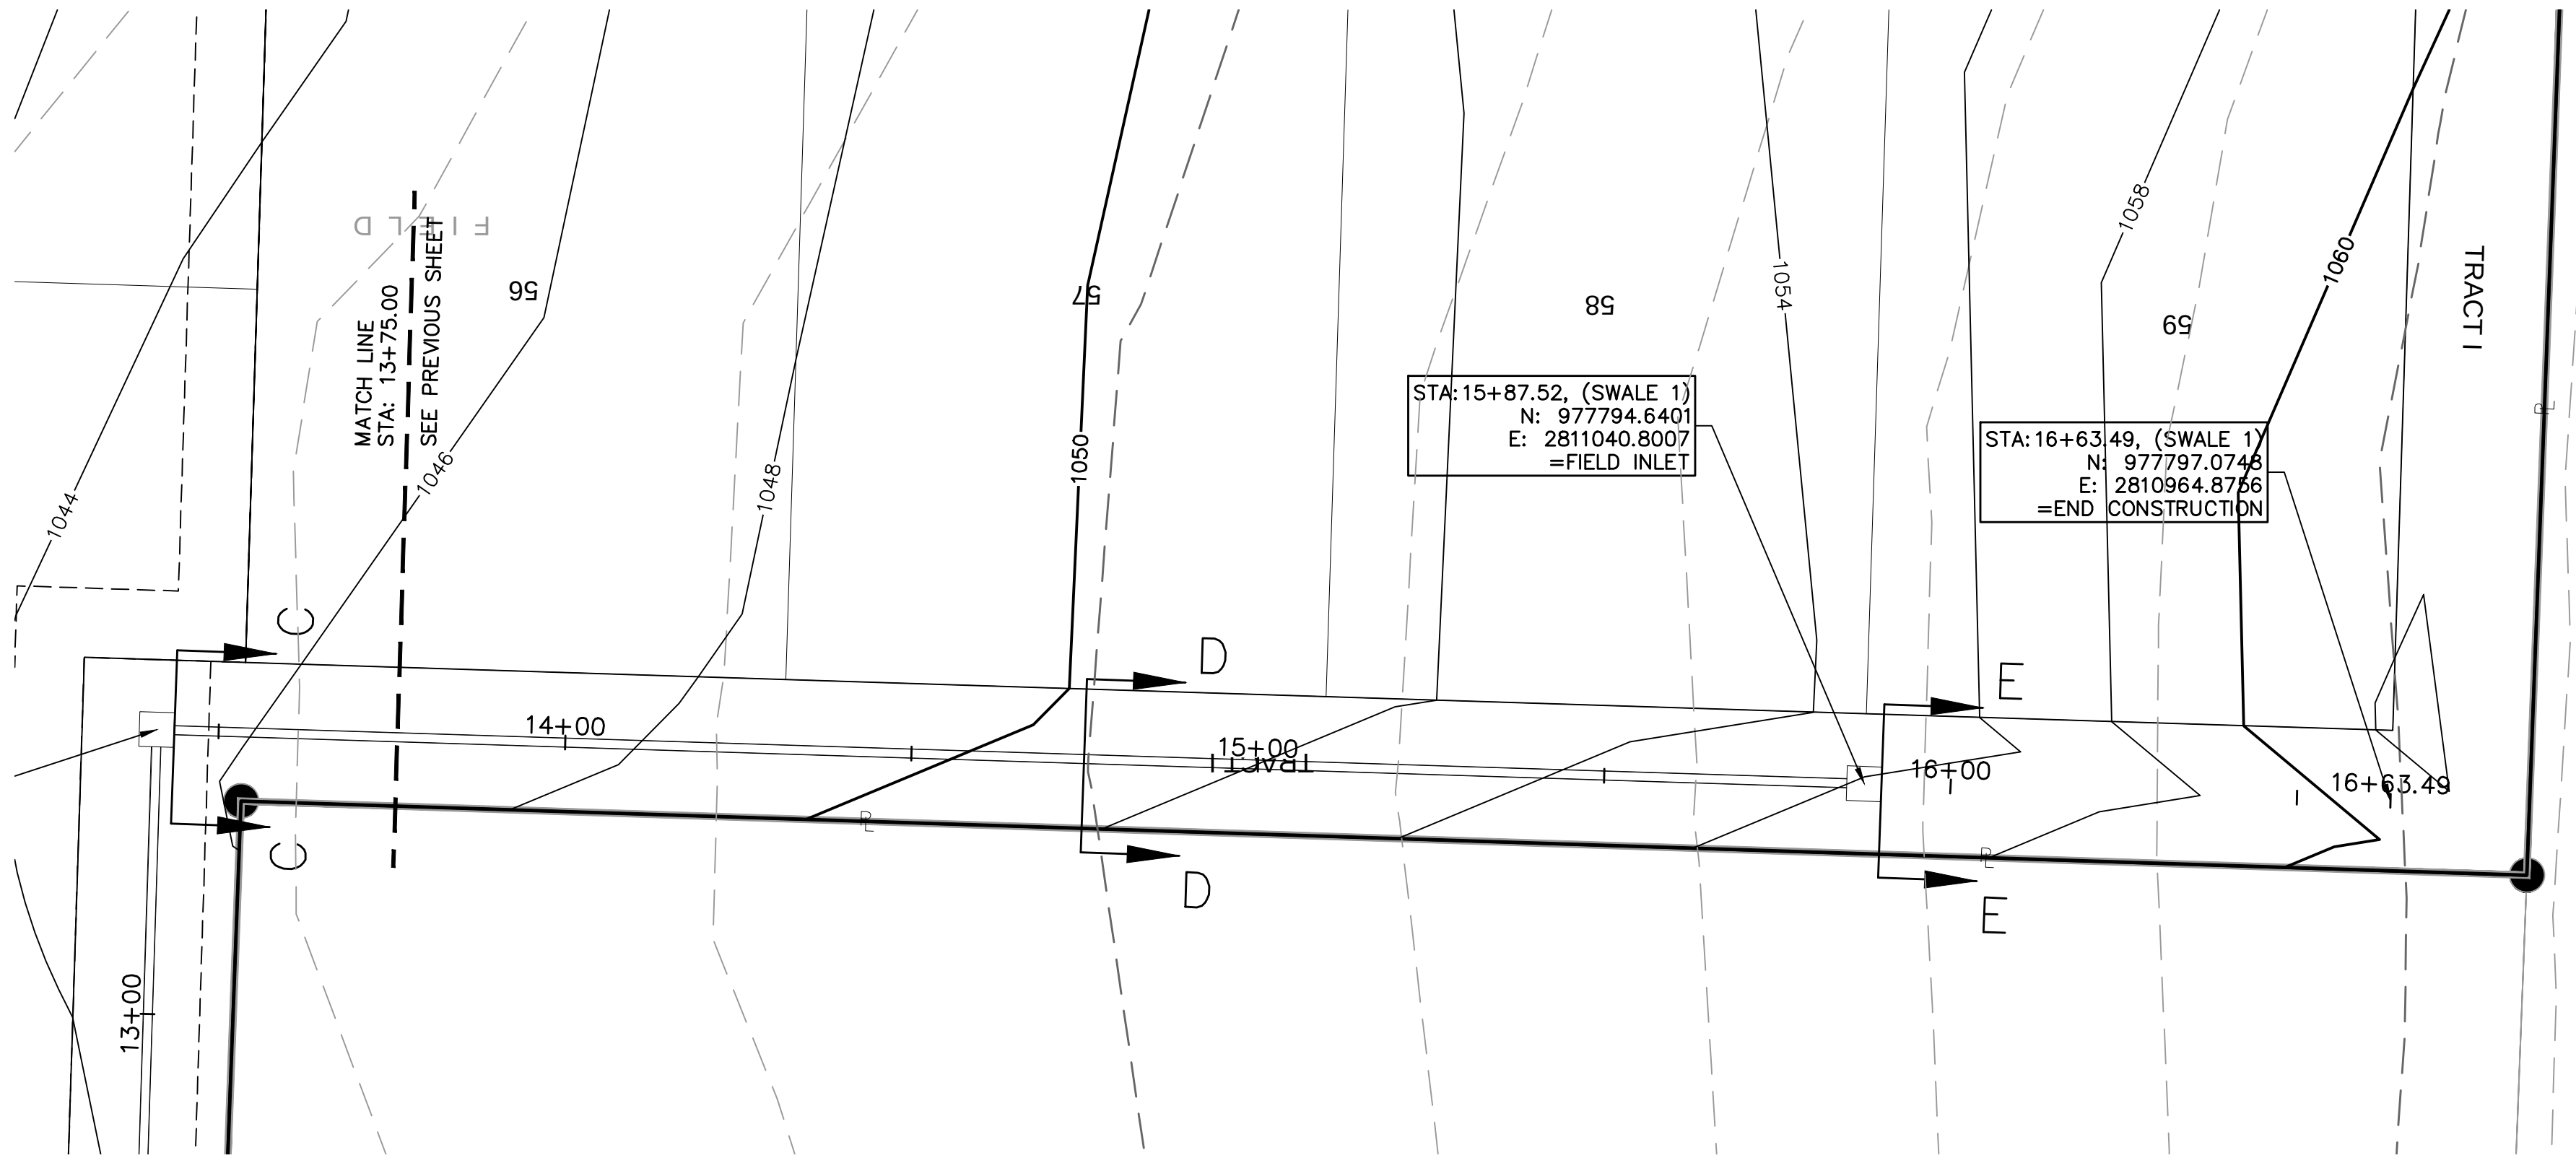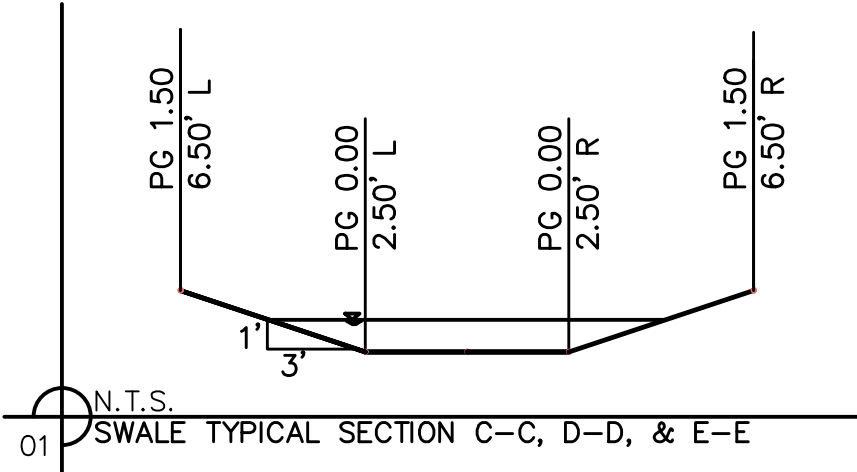

| SWALE DESIGN TABLE (100-YEAR RETURN FREQUENCY) |                      |                   |                  |                       |                        |                   |                 |                  |                 |                   |                       |                |
|------------------------------------------------|----------------------|-------------------|------------------|-----------------------|------------------------|-------------------|-----------------|------------------|-----------------|-------------------|-----------------------|----------------|
| SECTION DATA                                   |                      |                   |                  |                       |                        |                   | RESULTS         |                  |                 |                   |                       |                |
| SECTION                                        | Mannings Coefficient | Channel Slope (%) | Swale Depth (ft) | Left Side Slope (H:V) | Right Side Slope (H:V) | Bottom Width (ft) | Discharge (cfs) | Water Depth (ft) | Flow Area (ft²) | Velocity (ft/sec) | Wetted Perimeter (ft) | Top Width (ft) |
| C-C                                            | 0.03                 | 2.75%             | 1.5              | 3:1                   | 3:1                    | 5                 | 6.05            | 0.31             | 1.84            | 3.29              | 6.96                  | 6.86           |
| D-D                                            | 0.03                 | 5.23%             | 1.5              | 3:1                   | 3:1                    | 5                 | 1.64            | 0.12             | 0.64            | 2.55              | 5.76                  | 5.72           |
| E-E                                            | 0.03                 | 5.23%             | 1.5              | 3:1                   | 3:1                    | 5                 | 1.71            | 0.13             | 0.70            | 2.44              | 5.82                  | 5.78           |

| Swale Drainage Area Table (100 year Return Frequency) |                     |      |          |           |      |
|-------------------------------------------------------|---------------------|------|----------|-----------|------|
| Section                                               | Drainage Area (ac.) | C    | Tc (min) | i (in/hr) | K    |
| C-C                                                   | 0.92                | 0.51 | 9.16     | 10.32     | 1.25 |
| D-D                                                   | 0.25                | 0.51 | 9.16     | 10.32     | 1.25 |
| E-E                                                   | 0.26                | 0.51 | 5.00     | 10.32     | 1.25 |

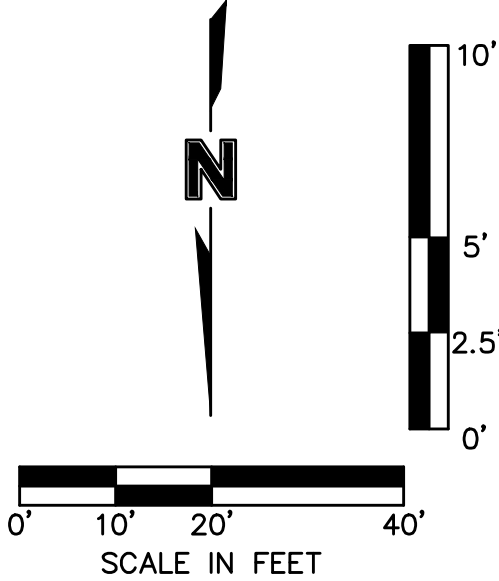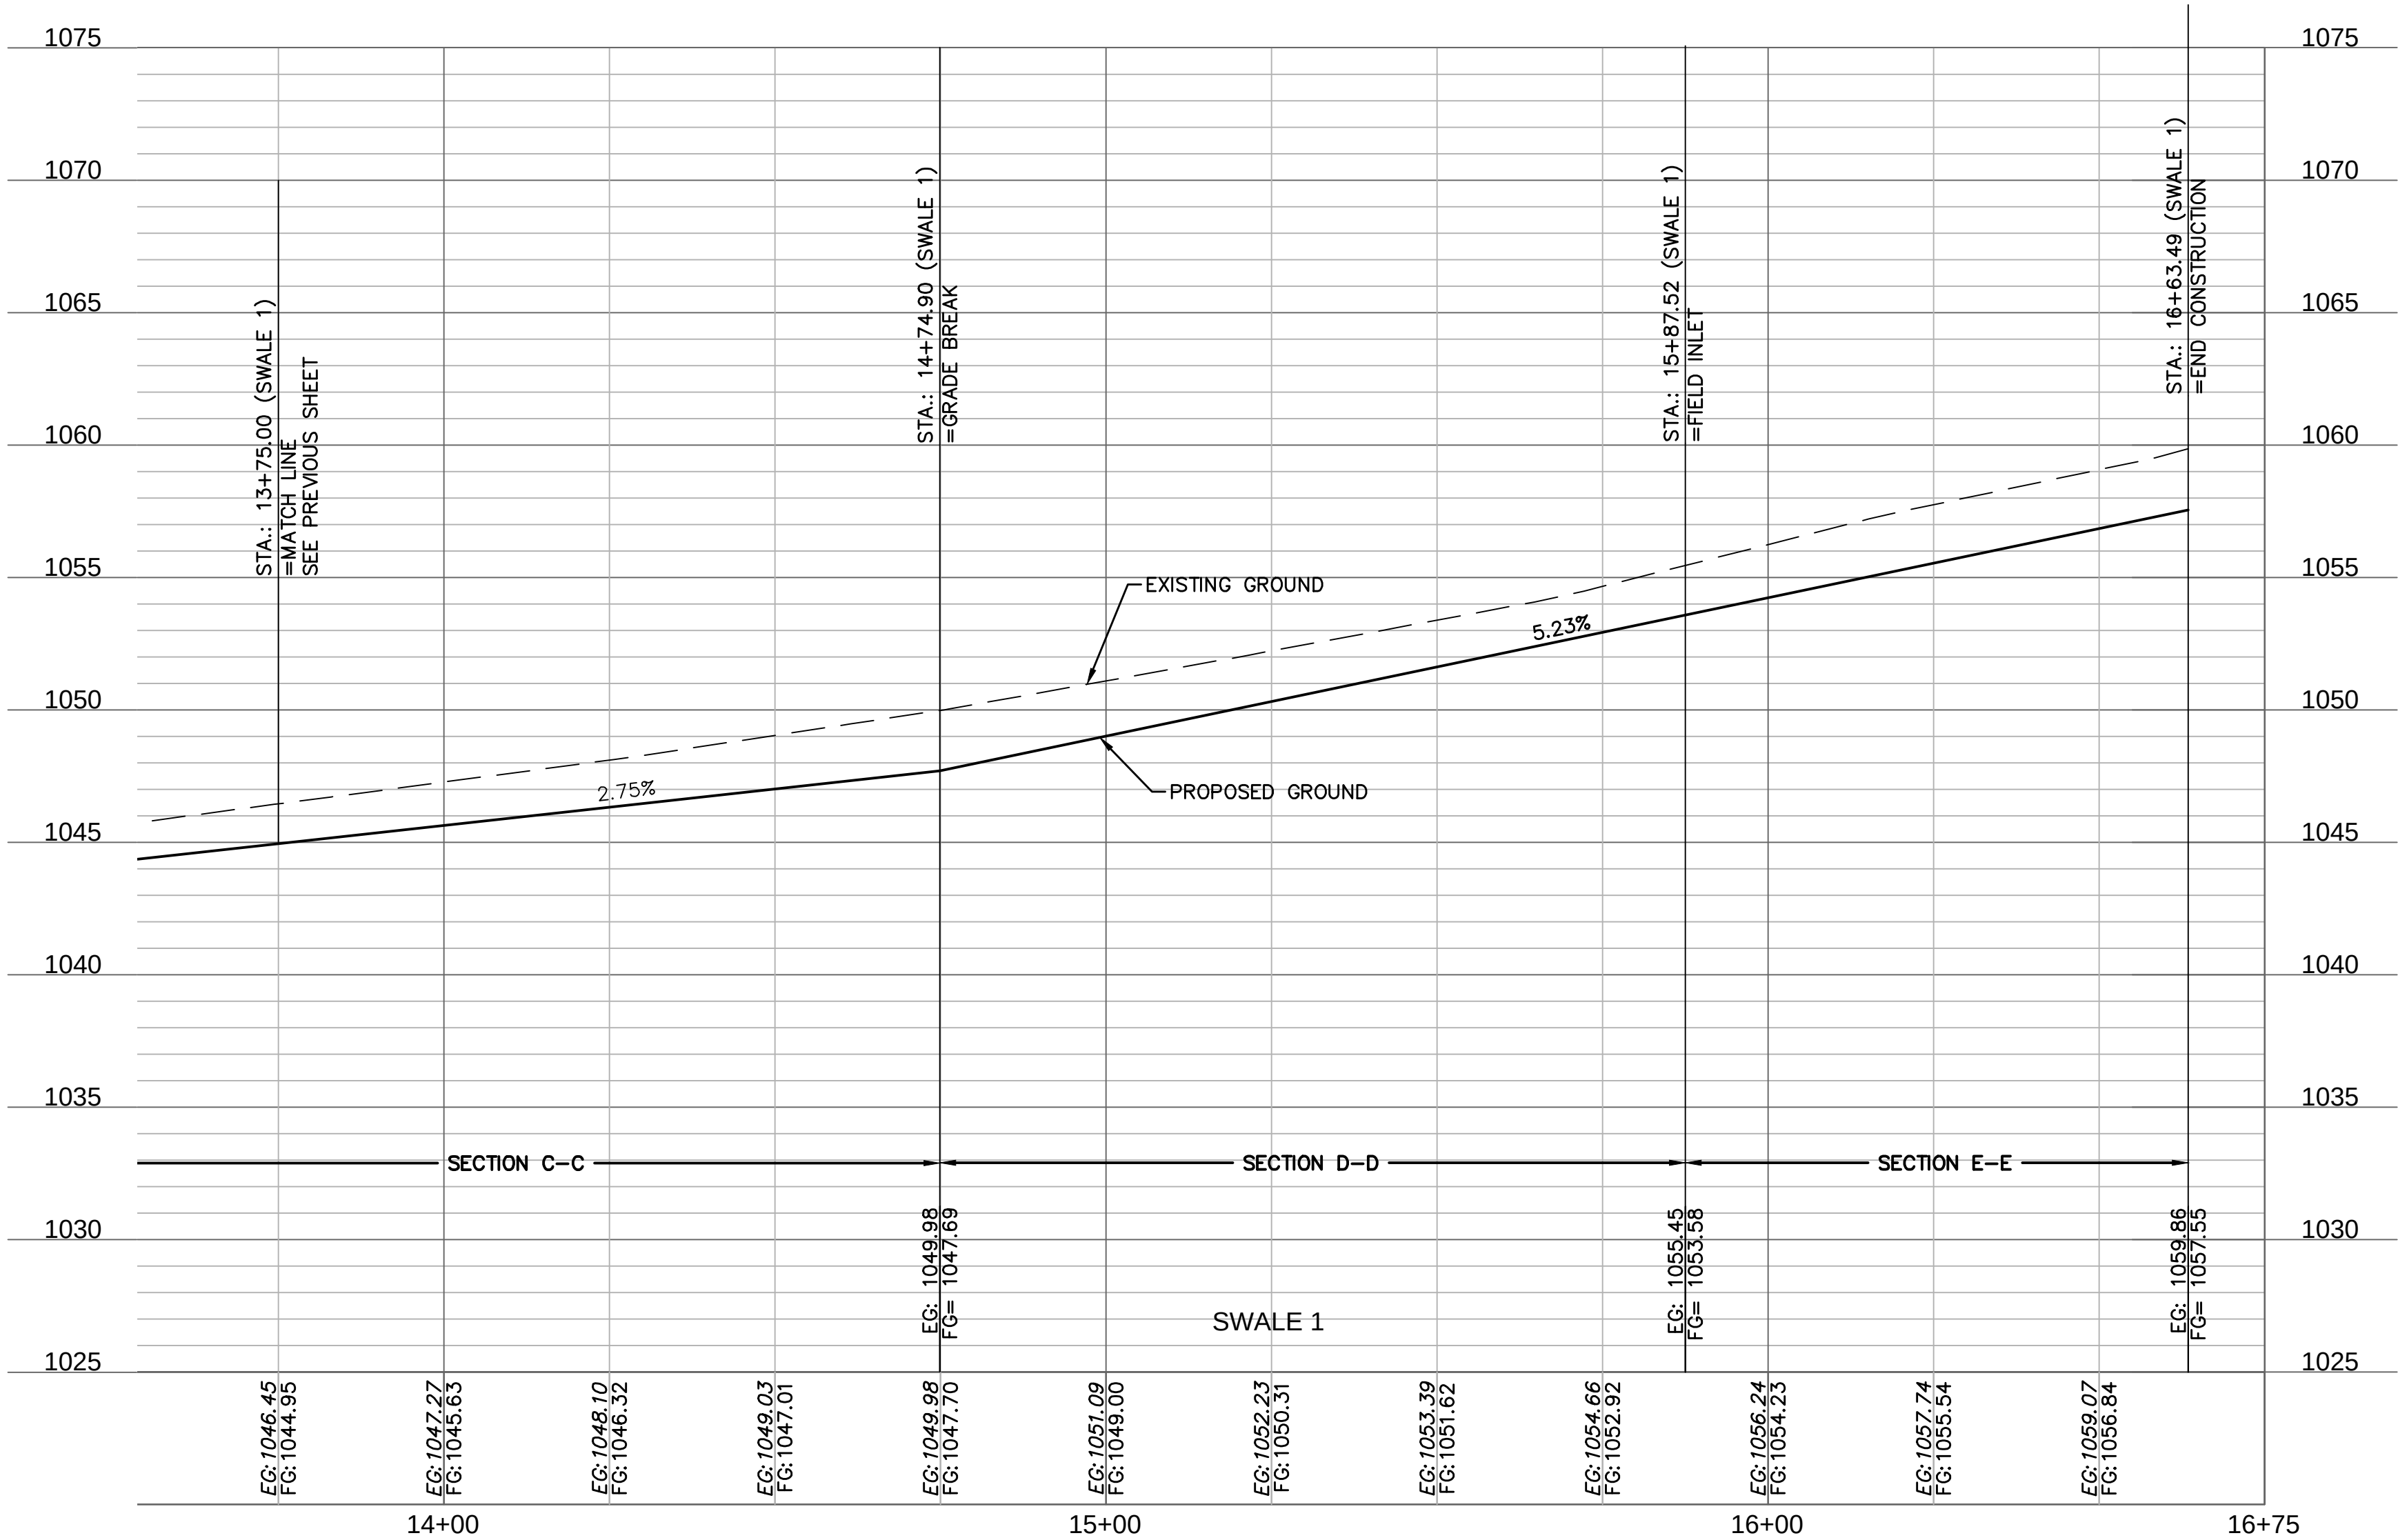

**NOT AS-BUILT**  
PER OSAGE 3RD PLAT PLANS,  
SWALE WAS ELIMINATED DUE  
TO REDUCTION IN DRAINAGE  
AREA. OSAGE 3RD PLAT IS  
ACTIVELY UNDER  
CONSTRUCTION AT TIME OF  
THESE AS-BUILTS

olsson

Olsson - Civil Engineering  
Missouri Certificate of Authority #: 001592  
1301 Burlington Street  
North Kansas City, MO 64116  
TEL 816.361.1177  
www.olsson.com



| REV. NO. |  | DATE | REVISIONS DESCRIPTION |
|----------|--|------|-----------------------|
|          |  |      |                       |
|          |  |      |                       |
|                                                               |  |      |
|---------------------------------------------------------------|--|------|
| SWALE 1 PLAN & PROFILE (CONT'D)<br>STREET & STORM SEWER PLANS |  | 2020 |
| OSAGE<br>SECOND PLAT                                          |  |      |

drawn by: D.F./M.O./A.A.  
checked by: C.G.W.  
designed by: A.A.  
QA/QC by: J.E.S.  
project no.: C19-2339  
drawing no.:  
date: 2022.05.26

SHEET  
C107





USER: ssaylor  
M\_C192339

1. CONTRACTOR SHALL  
CONSTRUCT SWALES WITH  
MINIMUM SLOPE, WIDTH  
AND DEPTH AS SHOWN IN  
THE SWALE DESIGN  
TABLES.

2. AS-BUILT SURVEY IS  
REQUIRED/APPROVED BY  
CITY FOR ALL SWALES  
AND PRIOR TO APPROVAL  
FOR ANY BUILDING  
FOUNDATION PERMIT.

CONTRACTOR SHALL BE  
REQUIRED TO REGRADE  
SWALES AT  
CONTRACTOR'S EXPENSE  
IF ABOVE REQUIREMENTS  
ARE NOT MET.

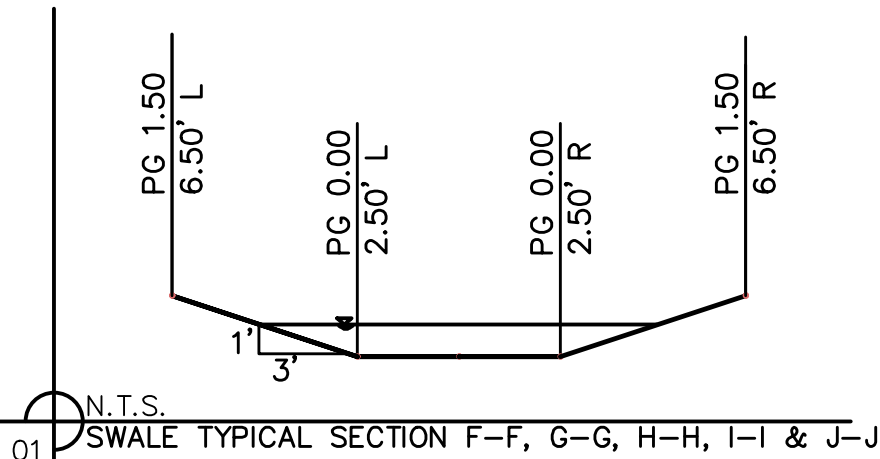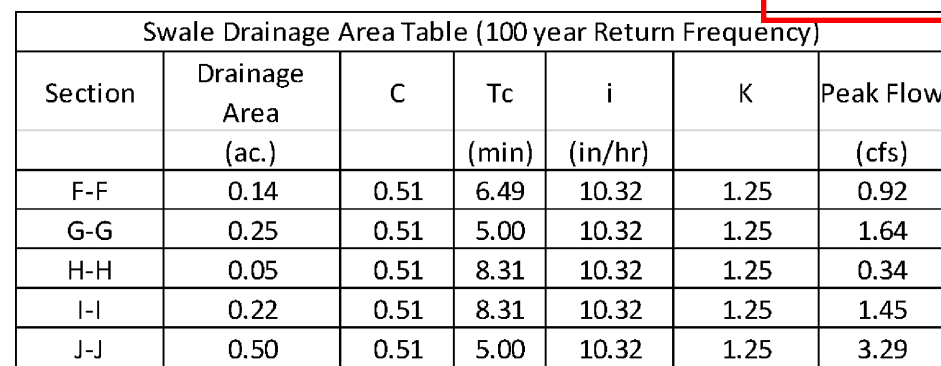

## REVISIONS DESCRIPTION

REVISIONS DESCRIPTION

STATE OF MISSOURI  
JULIE ELAINE  
SELLERS  
NUMBER  
PE-2017000367  
3/6/2025  
PROFESSIONAL ENGINEER

**olson**

Olsson - Civil Engineering  
Missouri Certificate of Authority #: 001592  
1301 Burlington Street  
North Kansas City, MO 64116

## REVISIONS

2020

drawn by: D.F. / M.O. / A.A.  
checked by: C.G.W.  
designed by: A.A.  
QA/QC by: J.E.S.  
project no.: C19-2339  
drawing no.: \_\_\_\_\_  
date: 2022.05.26

SHEET  
C108









DWG: F:\May2020\2500\019-2339\C40-Design\AutoCAD\Final  
 DATE: May 26, 2022 7:35am XREFS: C\_PBASE\_C192339  
 C\_PBDY\_C192339 C\_PBLK\_C192339 C\_PSTRM\_C192339  
 C\_PSSWR\_C192339 C\_PWATR\_C192339 C\_PSPAT\_C192339  
 C\_PSPOT\_C192339 USER: ssaylor  
 C\_PSURF\_C192339 C\_STORM\_C192339.dwg  
 C\_RPP01\_C192339  
 C\_PBASE\_C192339 C\_PBDY\_C192339 C\_PBLK\_C192339 C\_PSTRM\_C192339  
 C\_PSSWR\_C192339 C\_PWATR\_C192339 C\_PSPAT\_C192339 C\_PSPOT\_C192339


DWG: F:\May2020\2500\019-2339\C40-Design\AutoCAD\Final  
 DATE: May 26, 2022 7:35am XREFS: C\_PBASE\_C192339  
 C\_PBDY\_C192339 C\_PBLK\_C192339 C\_PSTRM\_C192339  
 C\_PSSWR\_C192339 C\_PWATR\_C192339 C\_PSPAT\_C192339  
 C\_PSPOT\_C192339 USER: ssaylor  
 C\_PSURF\_C192339 C\_STORM\_C192339.dwg  
 C\_RPP01\_C192339  
 C\_PBASE\_C192339 C\_PBDY\_C192339 C\_PBLK\_C192339 C\_PSTRM\_C192339  
 C\_PSSWR\_C192339 C\_PWATR\_C192339 C\_PSPAT\_C192339 C\_PSPOT\_C192339








DWG: F:\2019\2001-2500\019-2339-C140-Design\AutoCAD\Final Plans - As-Built\Sheets\GNC\A\STREET & STORM\C\_PSP01\_C192339.dwg USER: asw/dor  
DATE: May 26, 2022 7:35am XREFS: C\_PBASE\_C192339 C\_PBN0Y\_C192339 C\_PBLK\_C192339 C\_PWATR\_C192339 C\_PSSWR\_C192339 C\_PSTRM\_C192339 C\_PSP01\_C192339

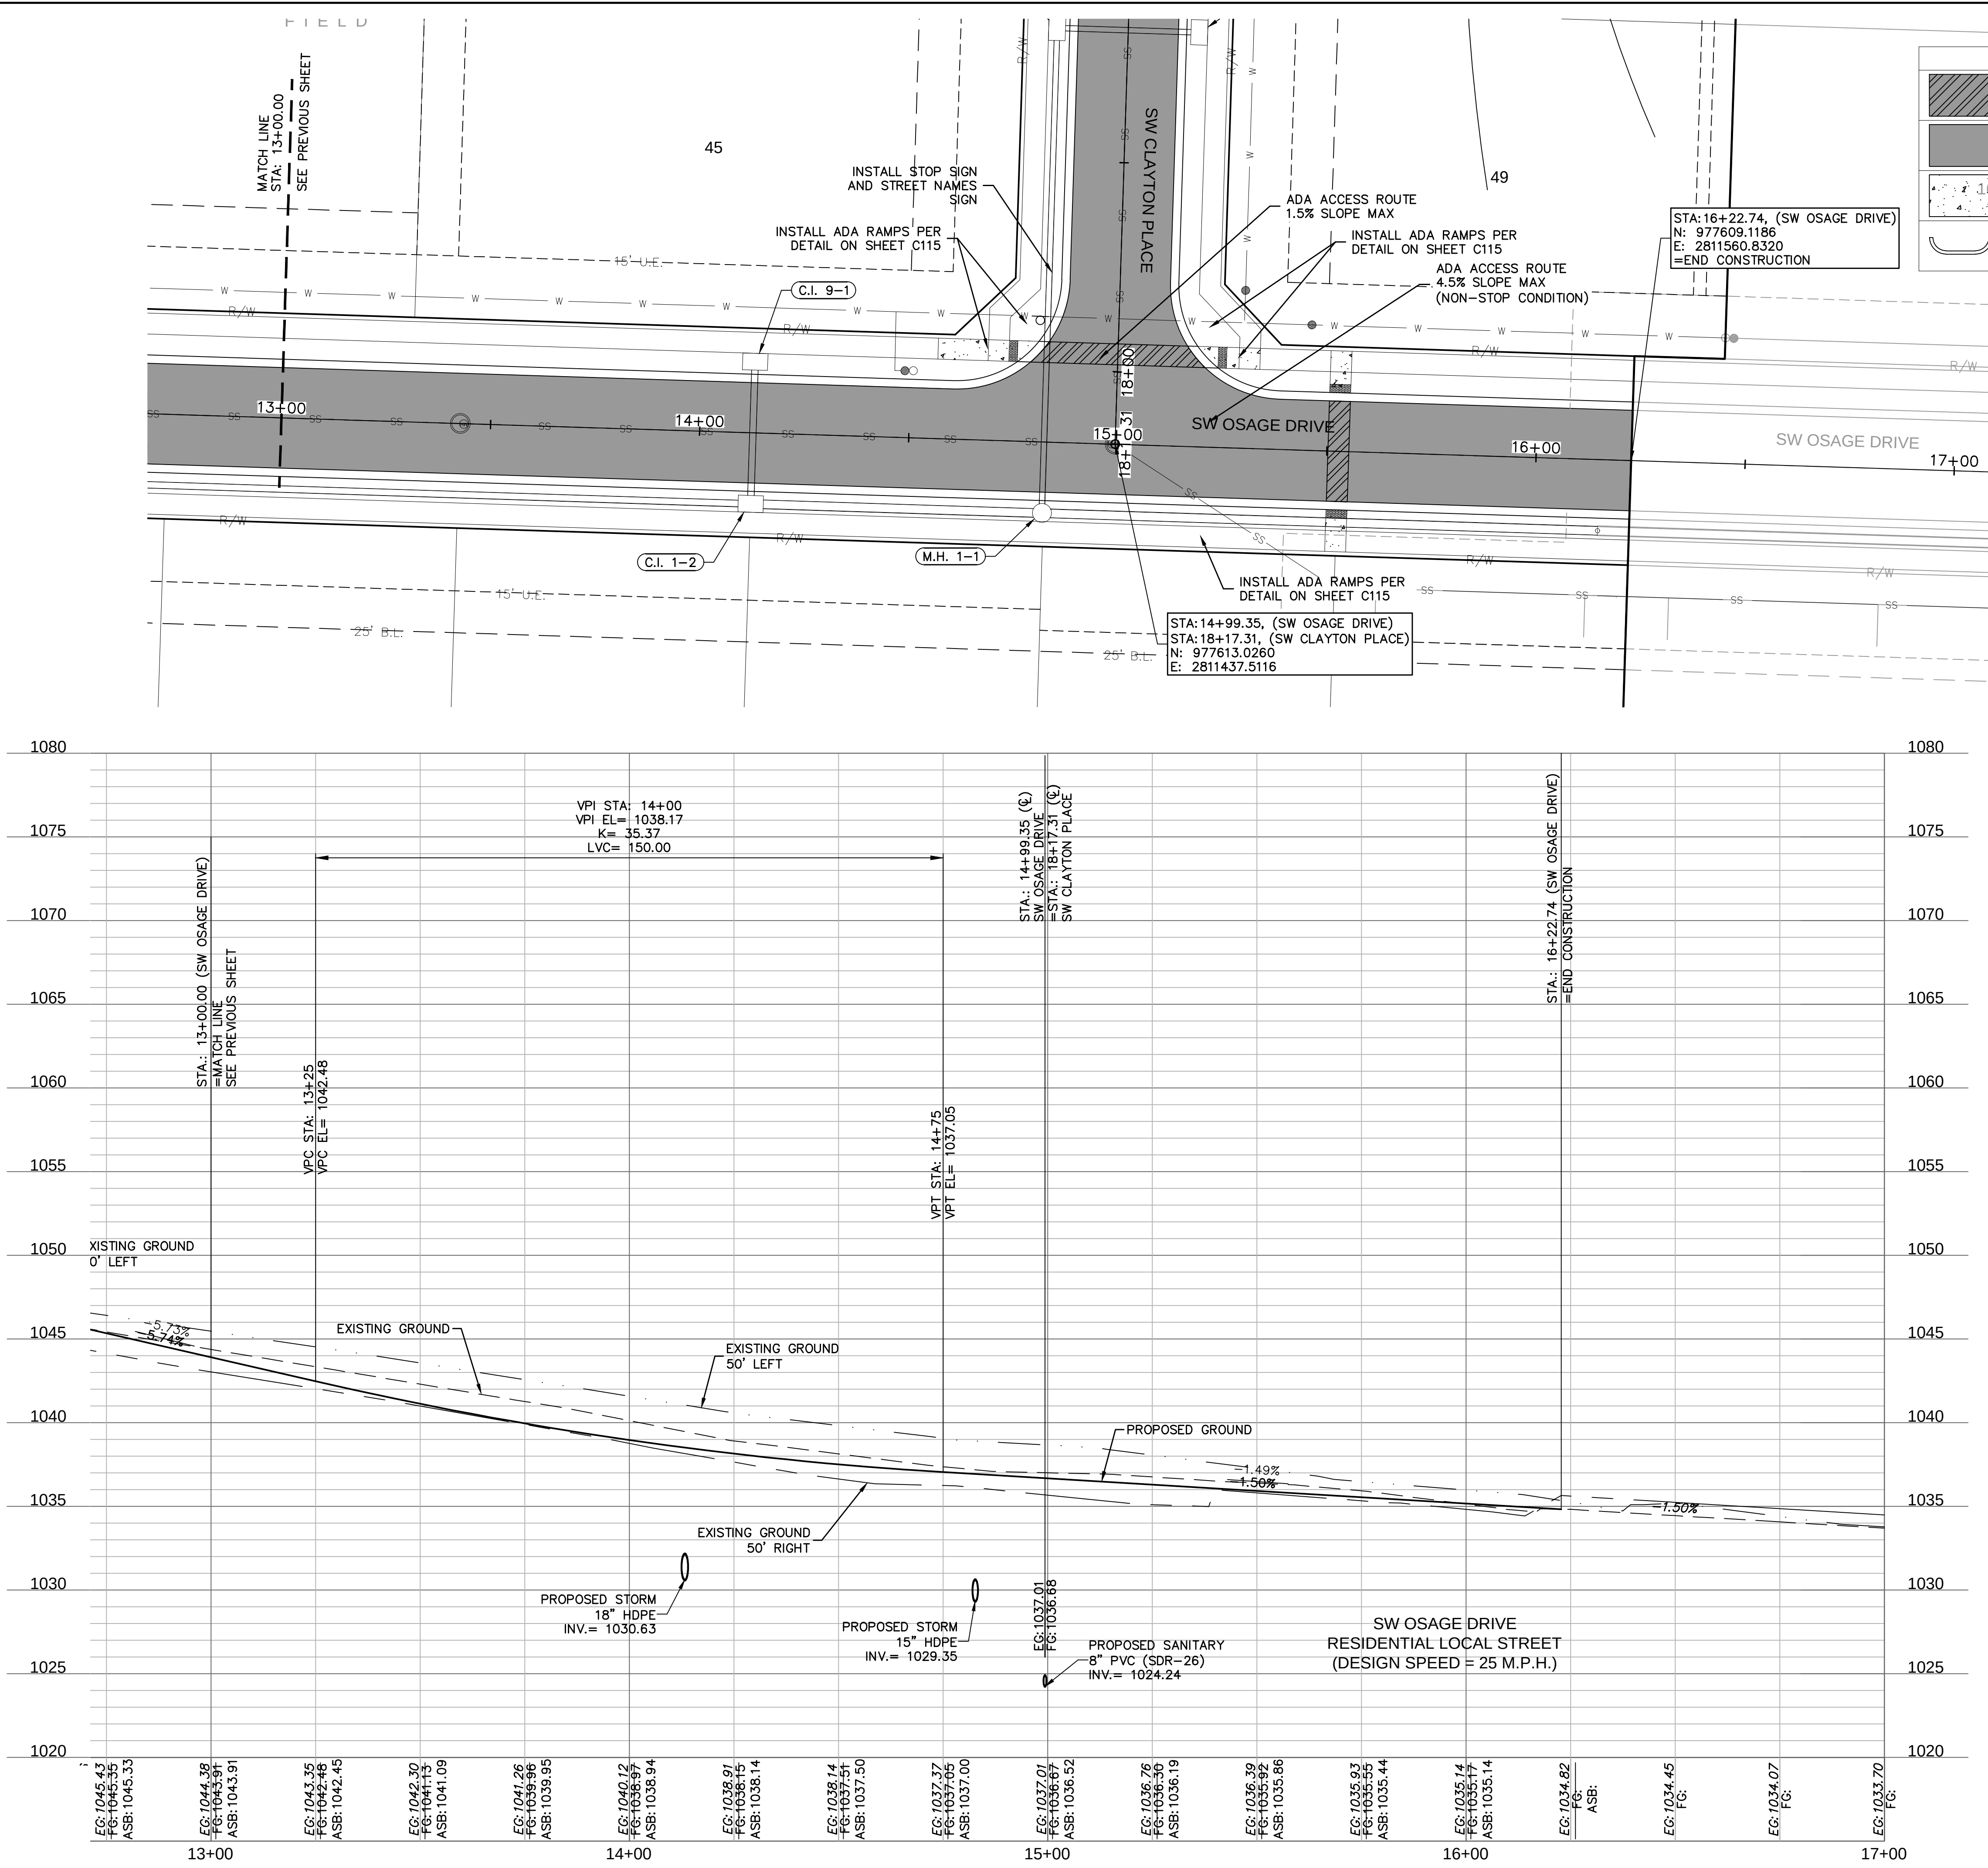

AS-BUILT

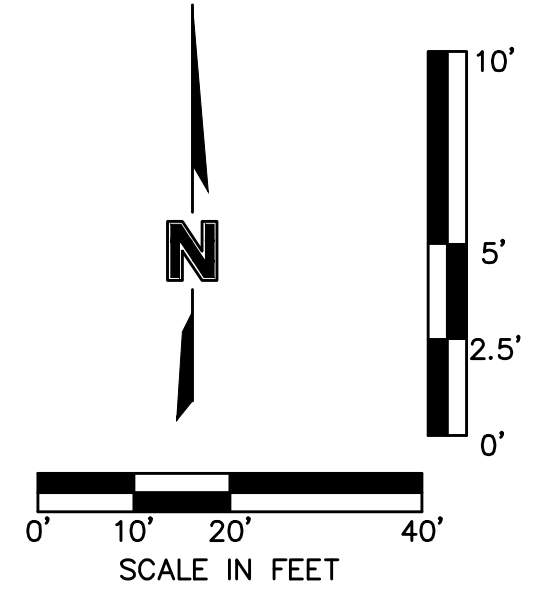

| LEGEND |                    |
|--------|--------------------|
|        | ADA ACCESS ROUTE   |
|        | ASPHALT PAVEMENT   |
|        | CONCRETE SIDEWALK  |
|        | CG-2 CURB & GUTTER |

drawn by: D.F./M.O./A.A.  
checked by: C.G.W.  
designed by: A.A.  
QA/QC by: J.E.S.  
project no.: C19-2339  
drawing no.:  
date: 2022.05.26

ROADWAY PLAN & PROFILE (SW OSAGE DRIVE CONT'D)  
STREET & STORM SEWER PLANS  
OSAGE  
SECOND PLAT

| REV. | NO. | DATE       | REVISIONS DESCRIPTION     |
|------|-----|------------|---------------------------|
| 1    |     | 2020.10.23 | REVISED PER CITY COMMENTS |
|      |     |            |                           |
|      |     |            |                           |
|      |     |            |                           |
|      |     |            |                           |

STATE OF MISSOURI  
JULIE ELAINE  
SELLERS  
NUMBER  
PE-2017000367  
3/6/2025  
PROFESSIONAL ENGINEER


olsson  
Olsson - Civil Engineering  
Missouri Certificate of Authority #: 001592  
1301 Burlington Street  
North Kansas City, MO 64116  
TEL 816.361.1177  
www.olsson.com









DWG: F:\2019\2001-2500\019-2339-C140-Design\AutoCAD\Final Plans - As-Built\Sheets\GNC\A STREET & STORM\A\_C\_RPD01\_C192339.dwg  
DATE: May 26, 2022 7:35am  
XREFS: C\_PBASE\_C192339 C\_PBN0Y\_C192339 C\_PBLK\_C192339 C\_PSTRM\_C192339 C\_PSSWR\_C192339 C\_PWATR\_C192339 C\_PPSURF\_C192339 C\_PPAT1\_C192339 C\_PSPOT\_C192339  
USER: asw/lor

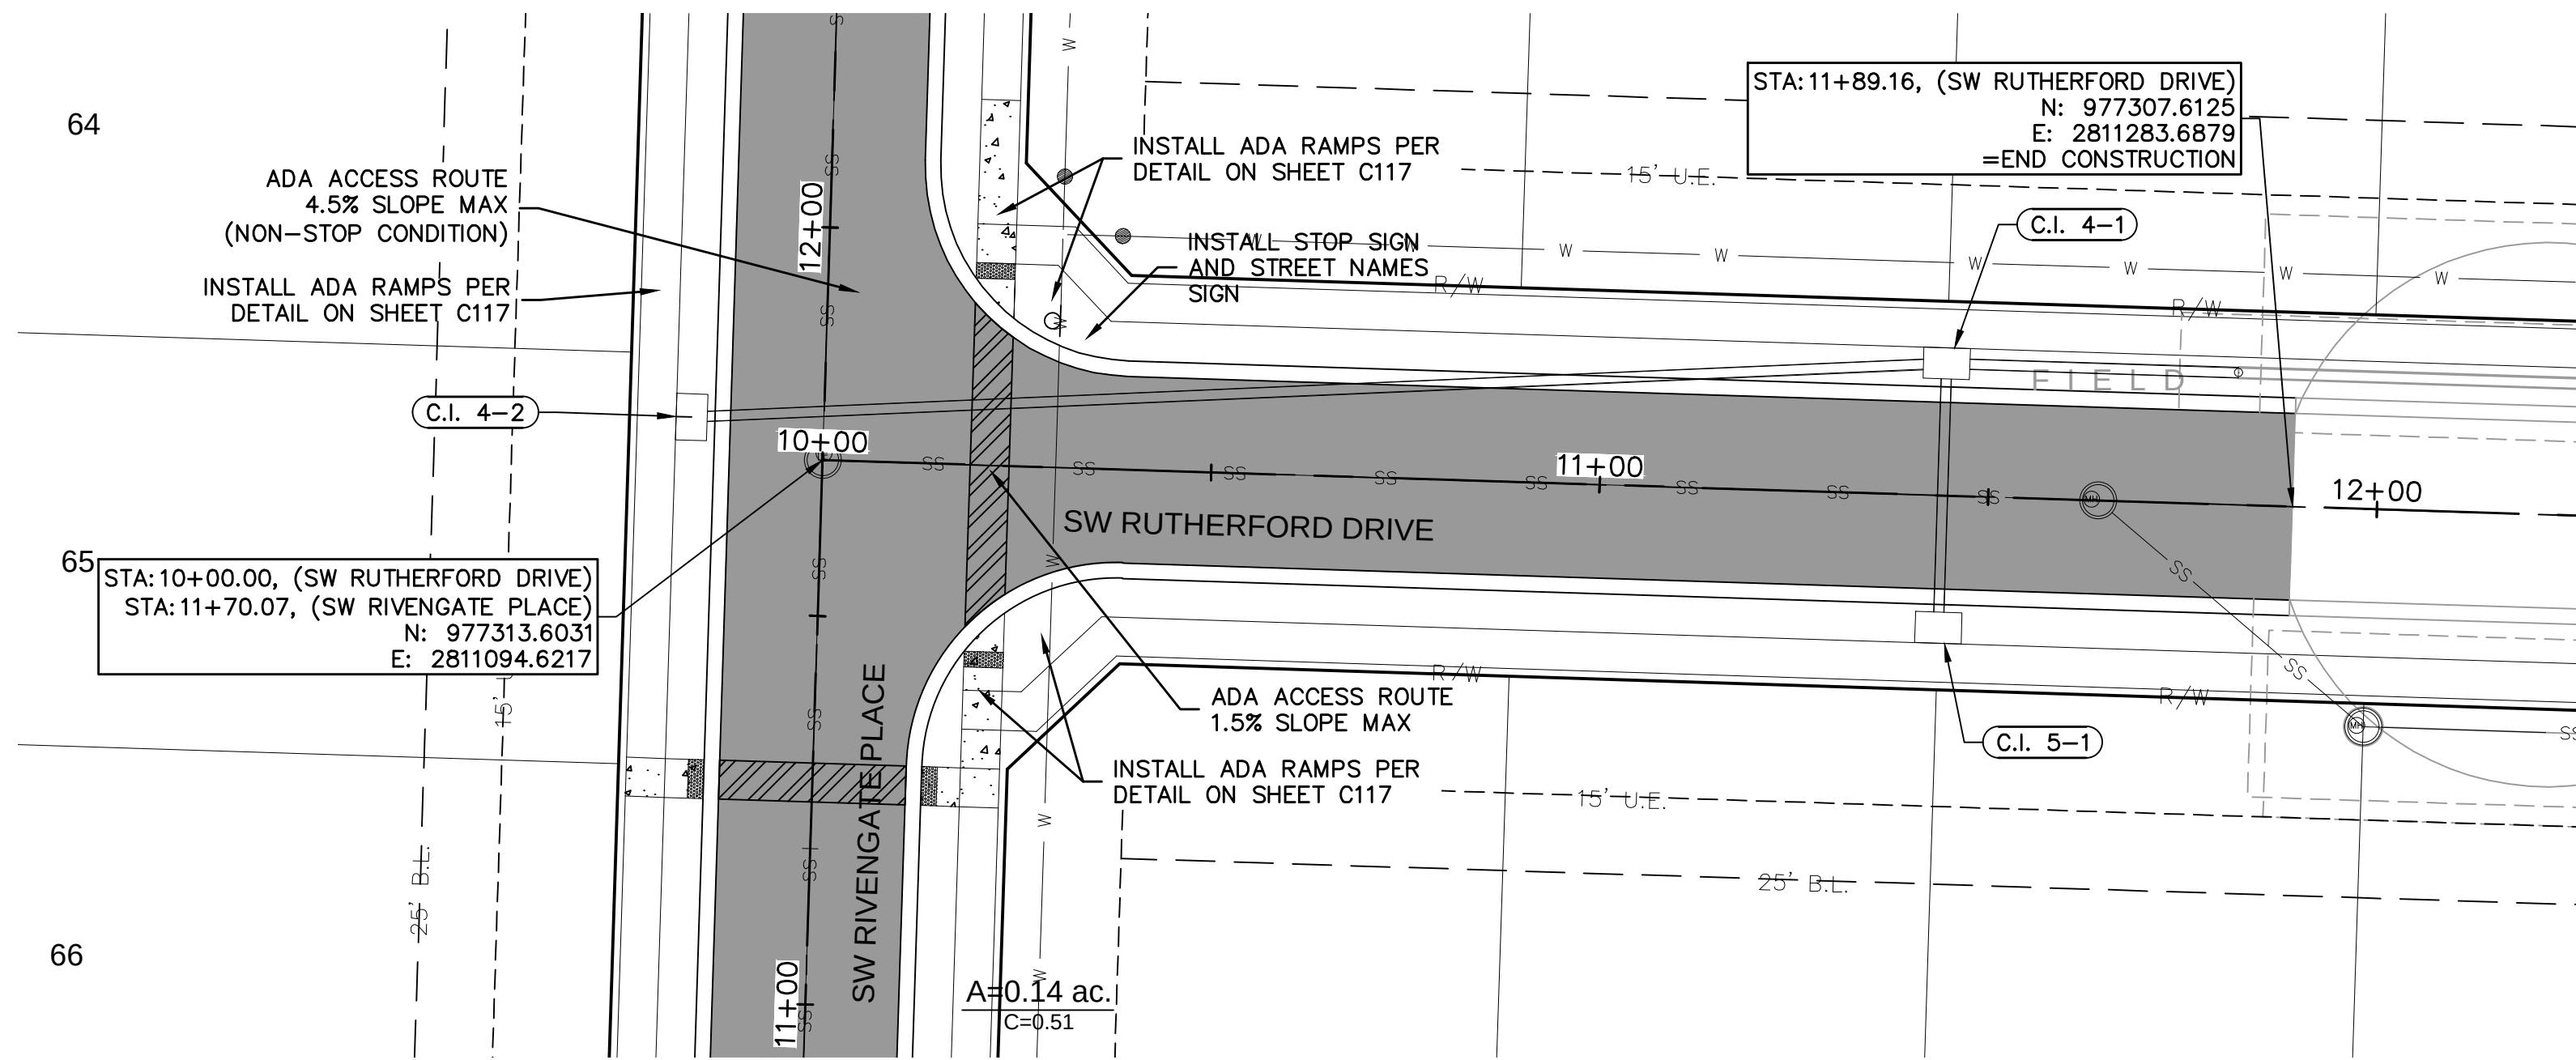

| LEGEND |                    |
|--------|--------------------|
|        | ADA ACCESS ROUTE   |
|        | ASPHALT PAVEMENT   |
|        | CONCRETE SIDEWALK  |
|        | CG-2 CURB & GUTTER |

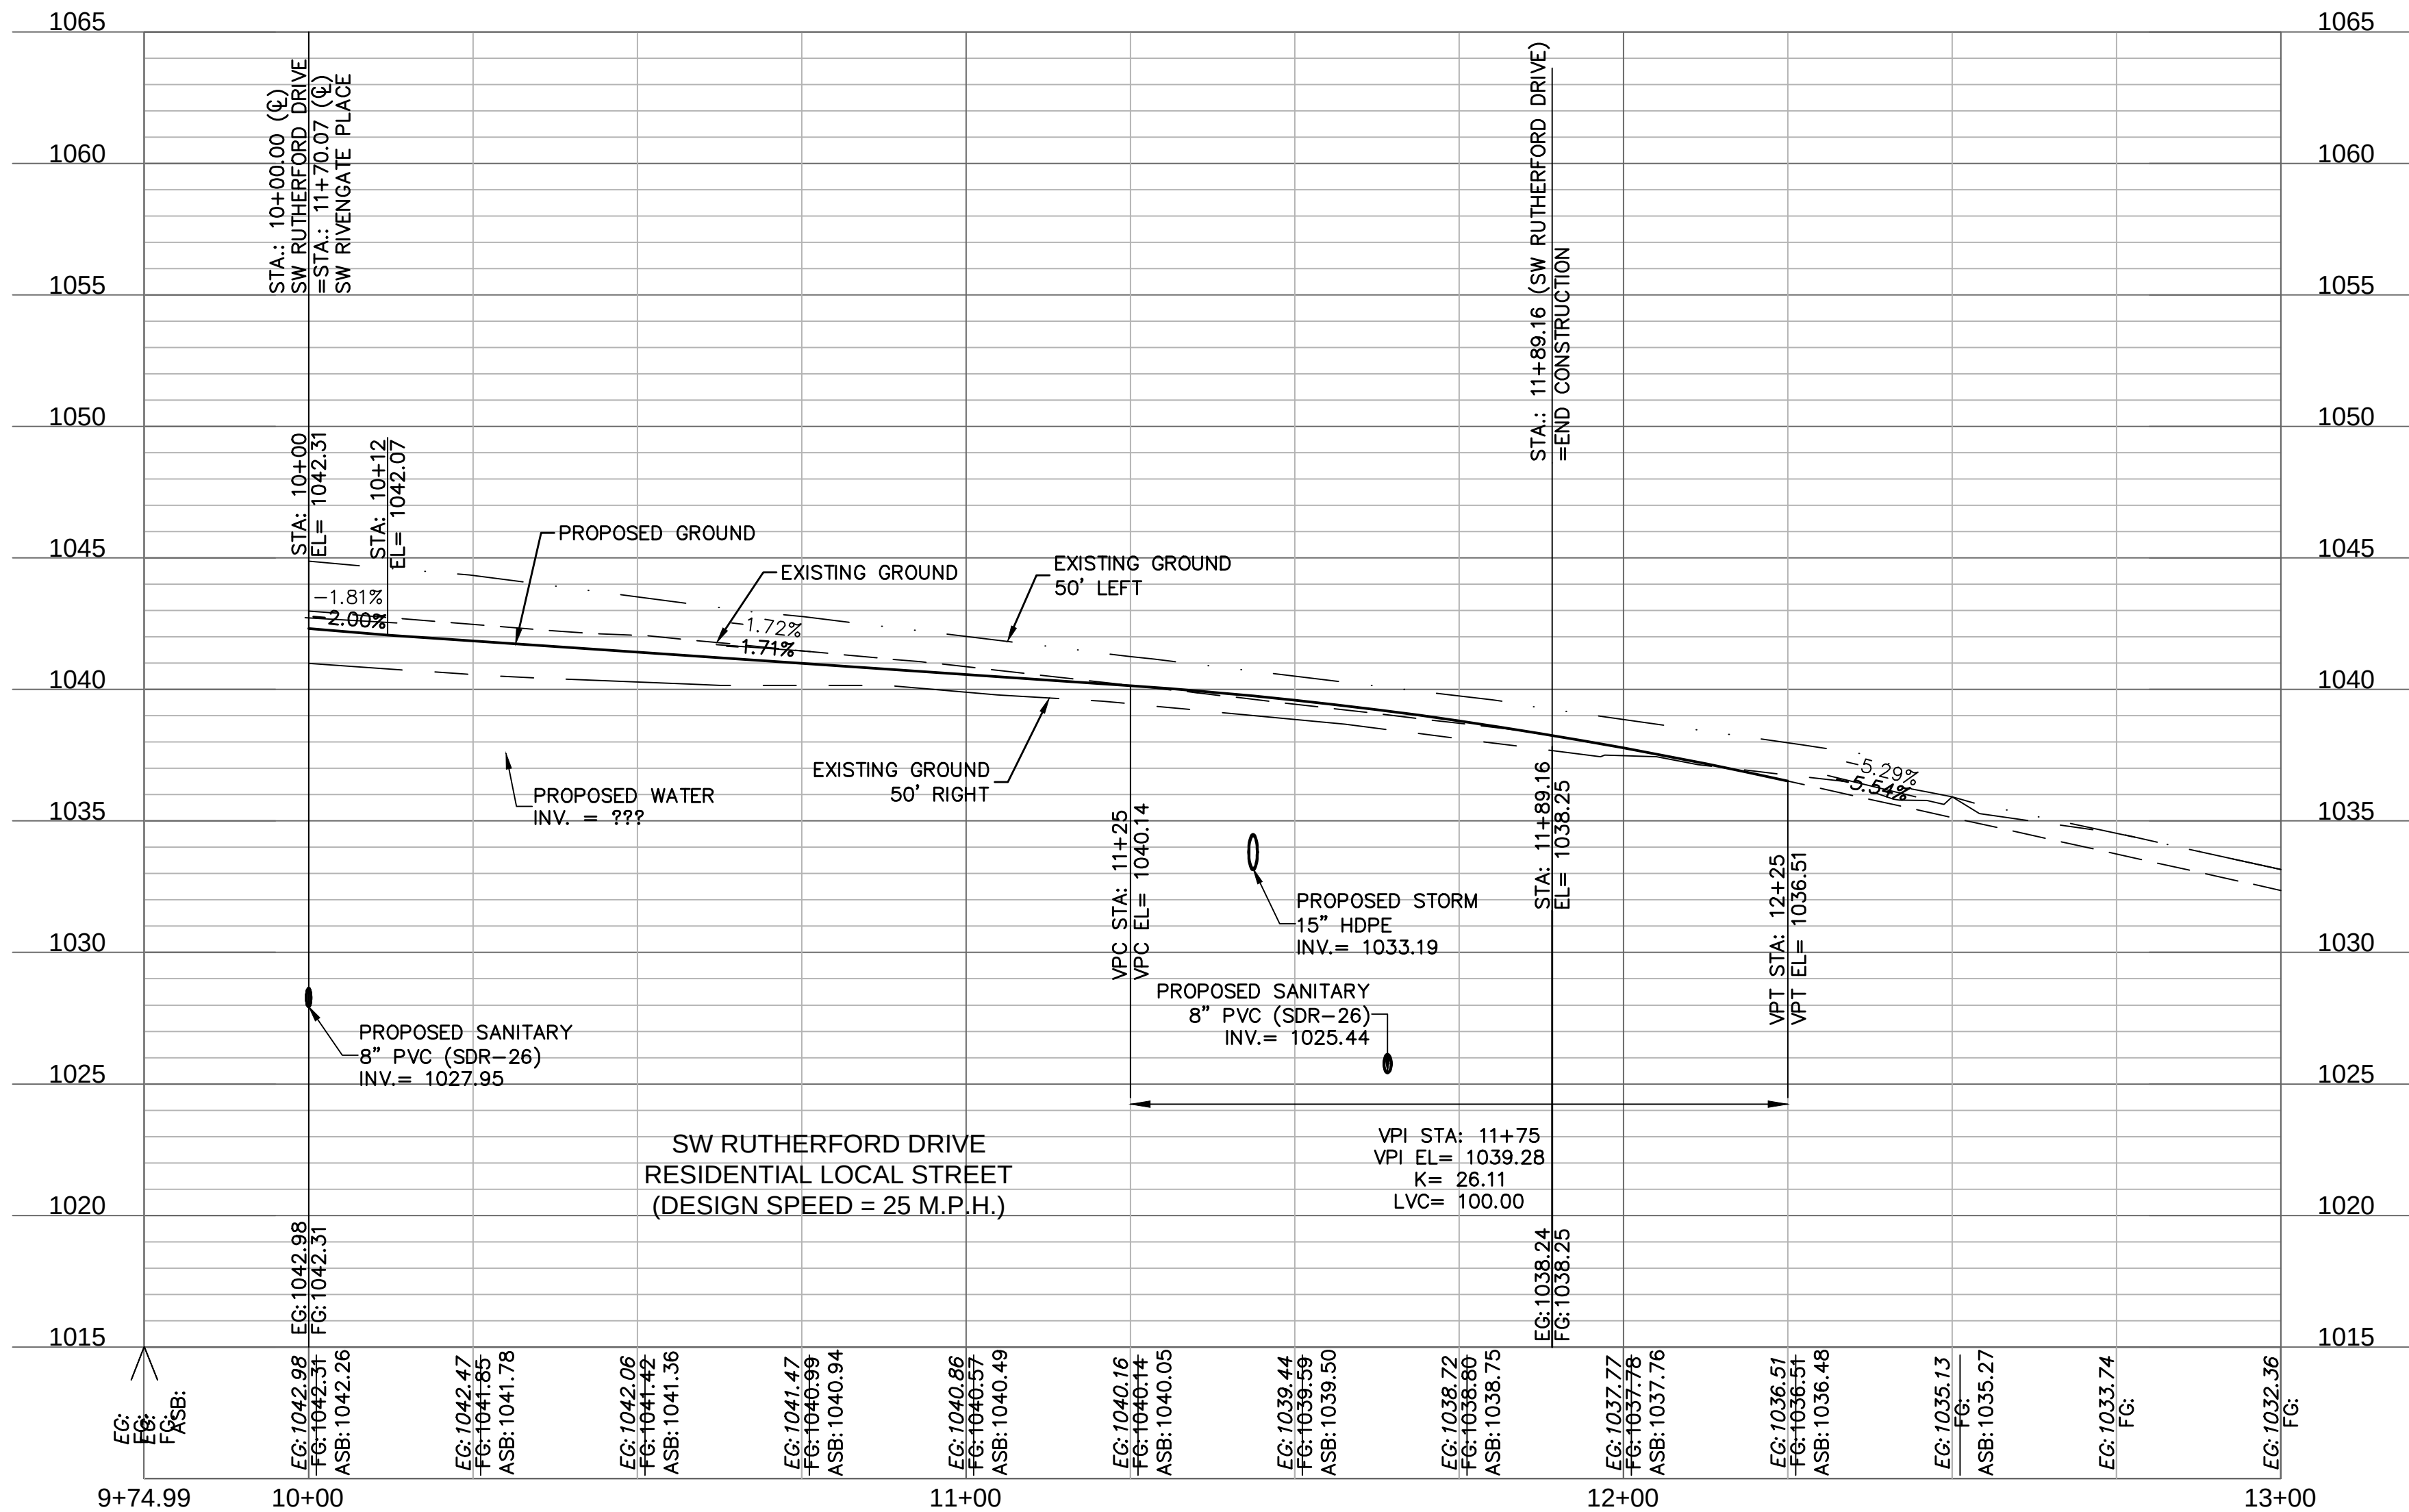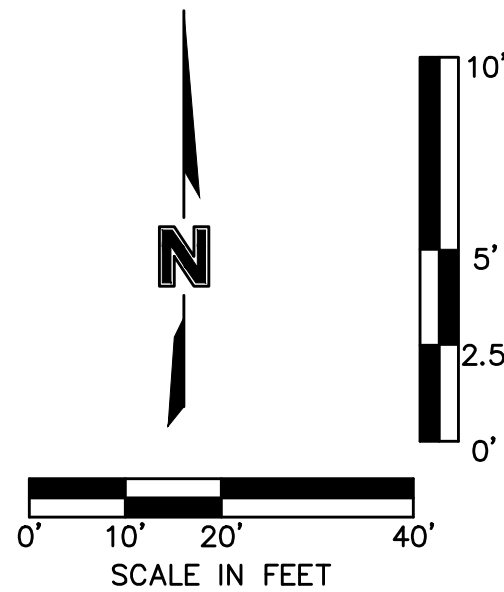


AS-BUILT

ROADWAY PLAN & PROFILE (SW RUTHERFORD DRIVE)  
STREET & STORM SEWER PLANS

OSAGE  
SECOND PLAT

2020

| REV. NO. | DATE       | REVISIONS DESCRIPTION     |
|----------|------------|---------------------------|
| 1        | 2020.10.23 | REVISER PER CITY COMMENTS |

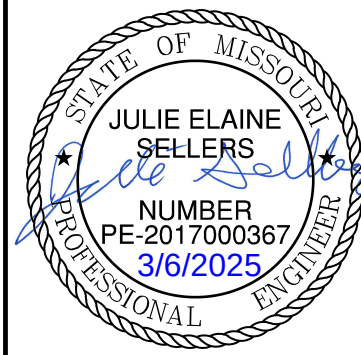

**olsson**  
Olsson - Civil Engineering  
Missouri Certificate of Authority #: 001592  
1301 Burlington Street  
North Kansas City, MO 64116  
TEL 816.361.1177  
www.olson.com

SHEET  
C114


drawn by: D.F./M.O./A.A.  
checked by: C.G.W.  
designed by: A.A.  
QA/QC by: J.E.S.  
project no.: C19-2339  
drawing no.:  
date: 2022.05.26

Record Drawing







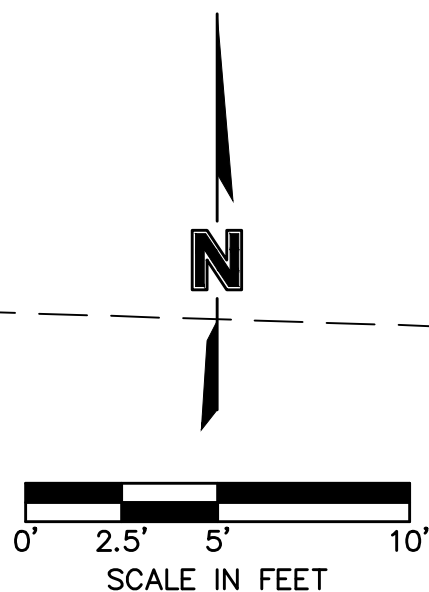







[illegible]



STORM SEWER PLAN & PROFILE (LINE 1)  
STREET & STORM SEWER PLANS

OSAGE  
SECOND PLAT



2020

drawn by: D.F. / M.O. / A.A.  
checked by: C.G.W.  
designed by: A.A.  
QA/QC by: J.E.S.  
project no.: C19-2339  
drawing no.: \_\_\_\_\_  
date: 2022.05.26


SHEET  
C118

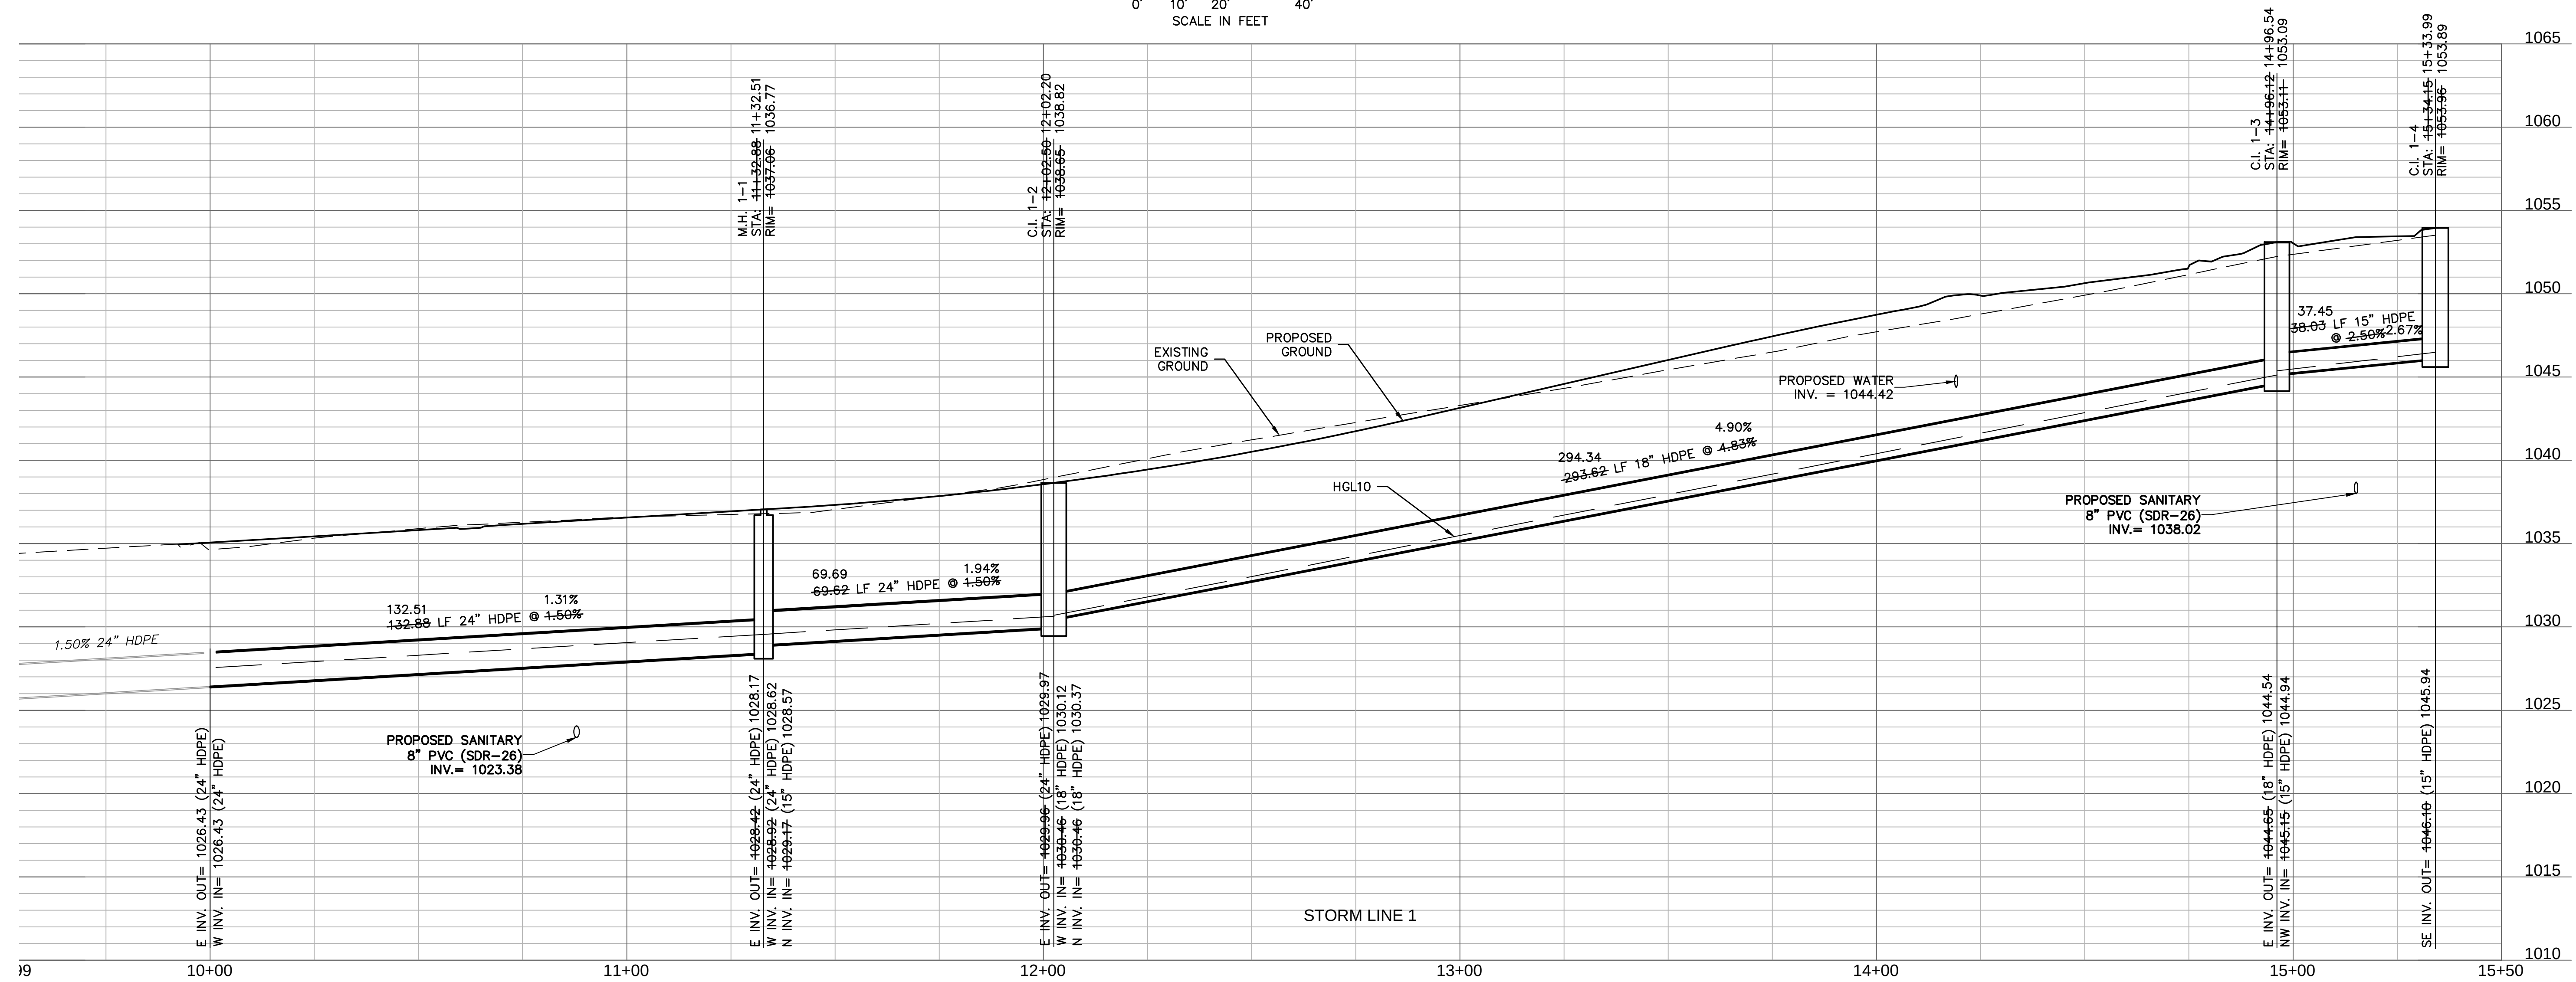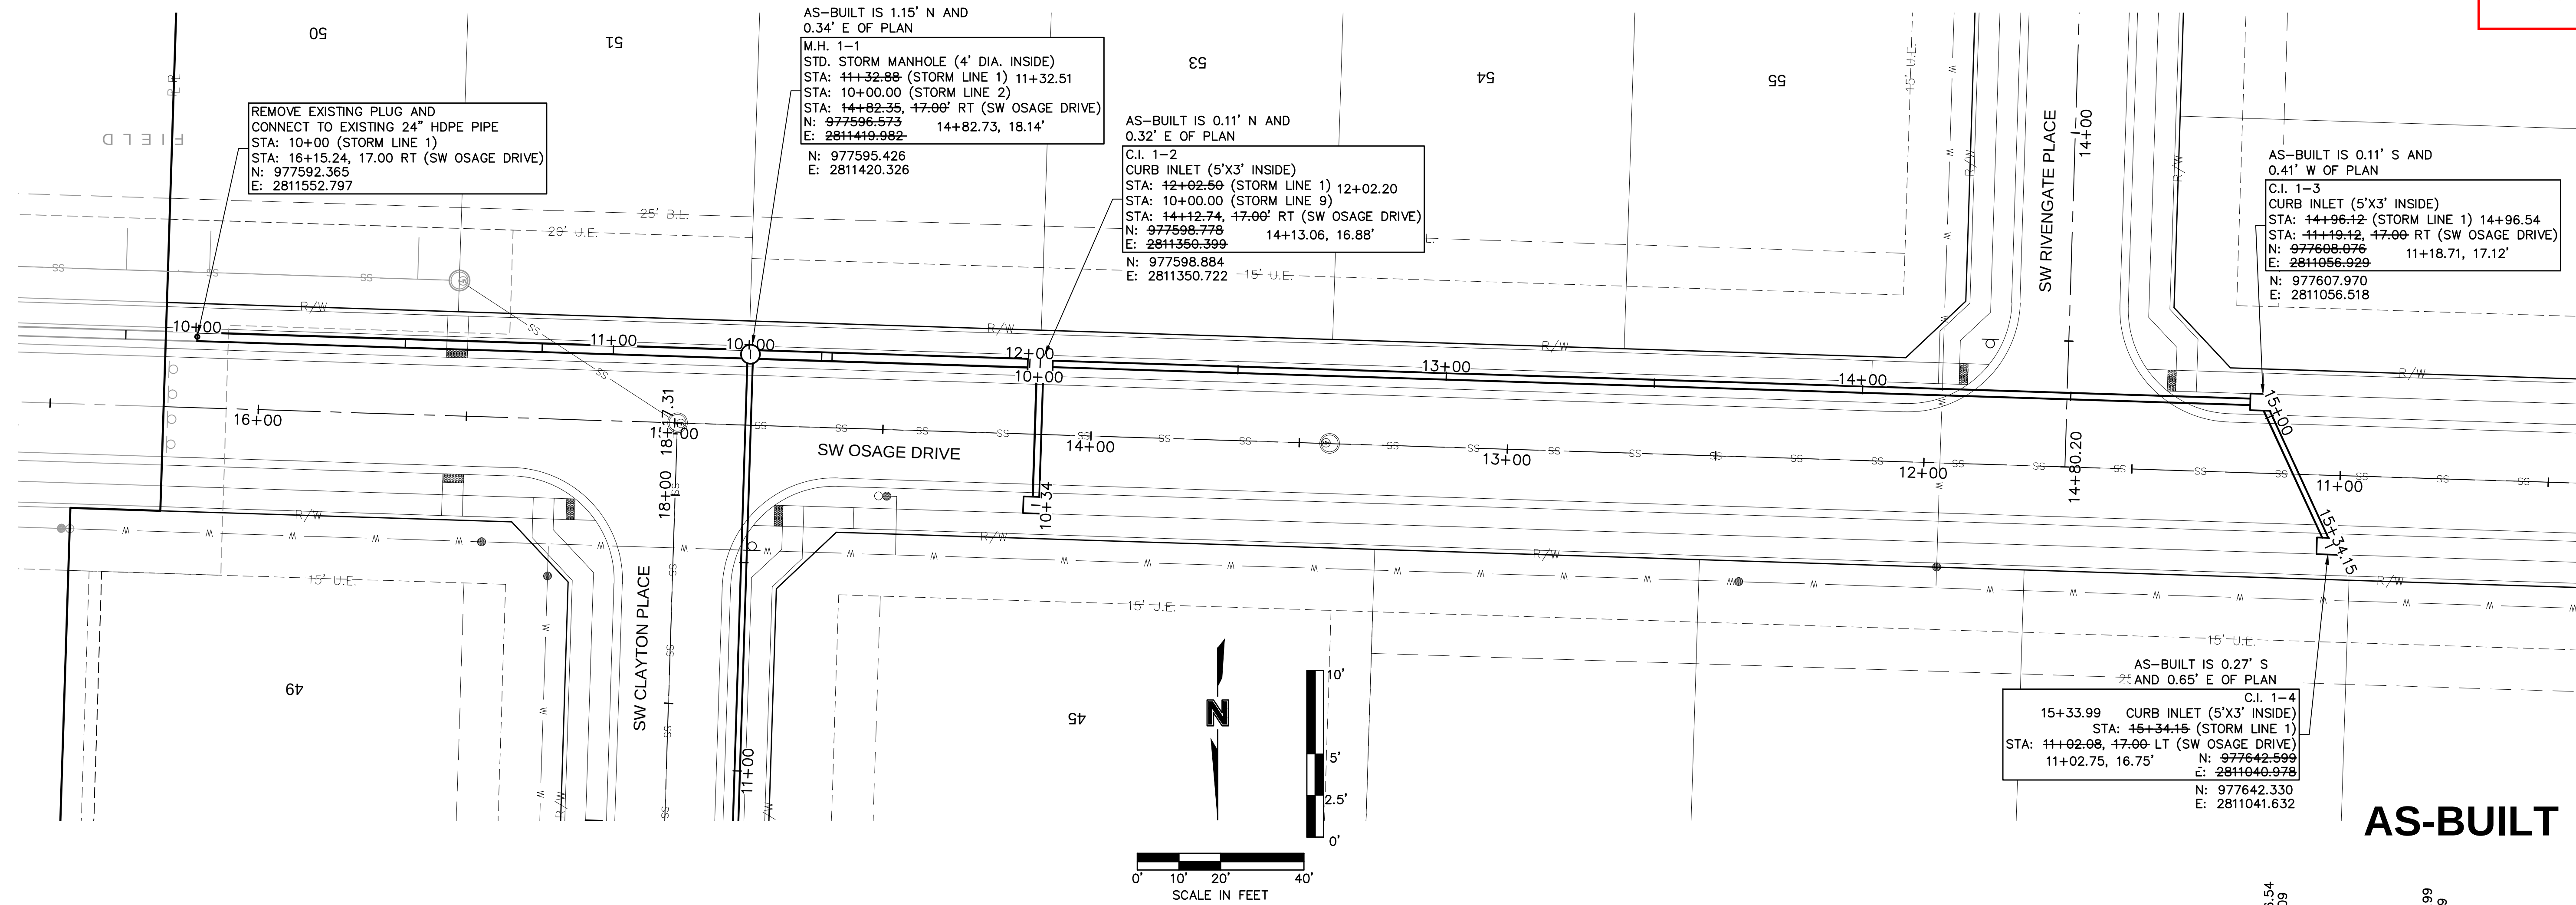



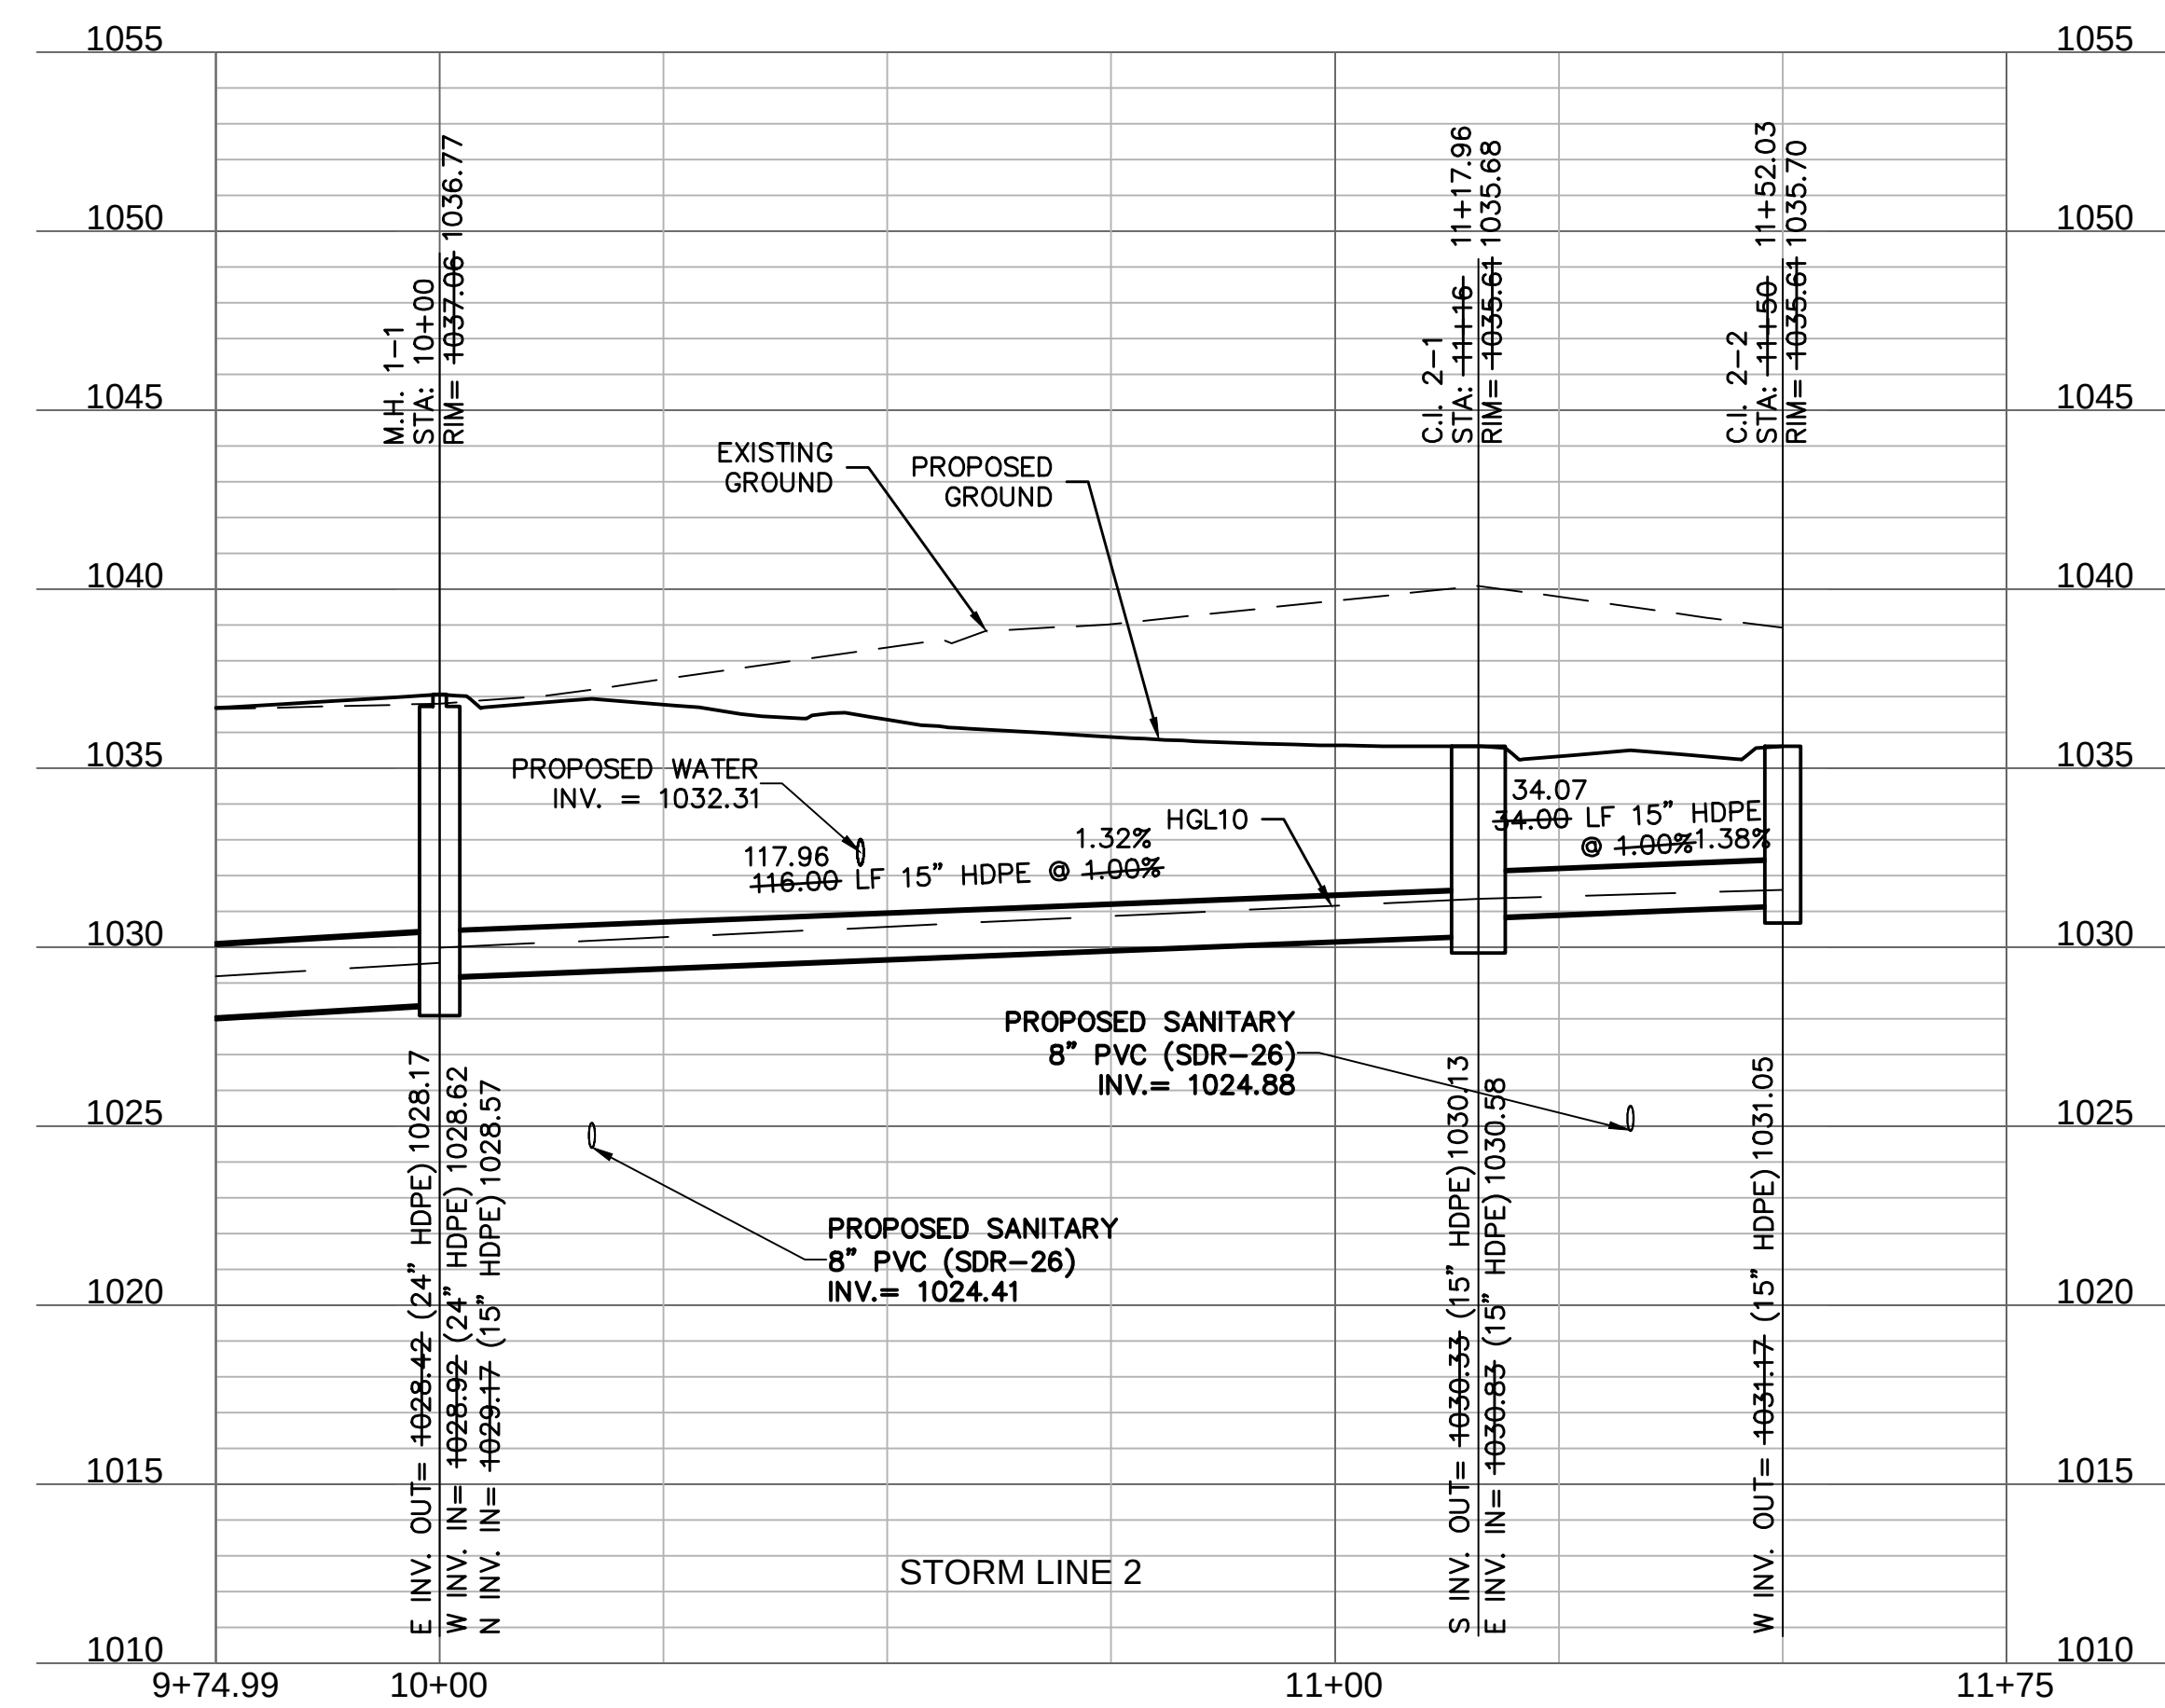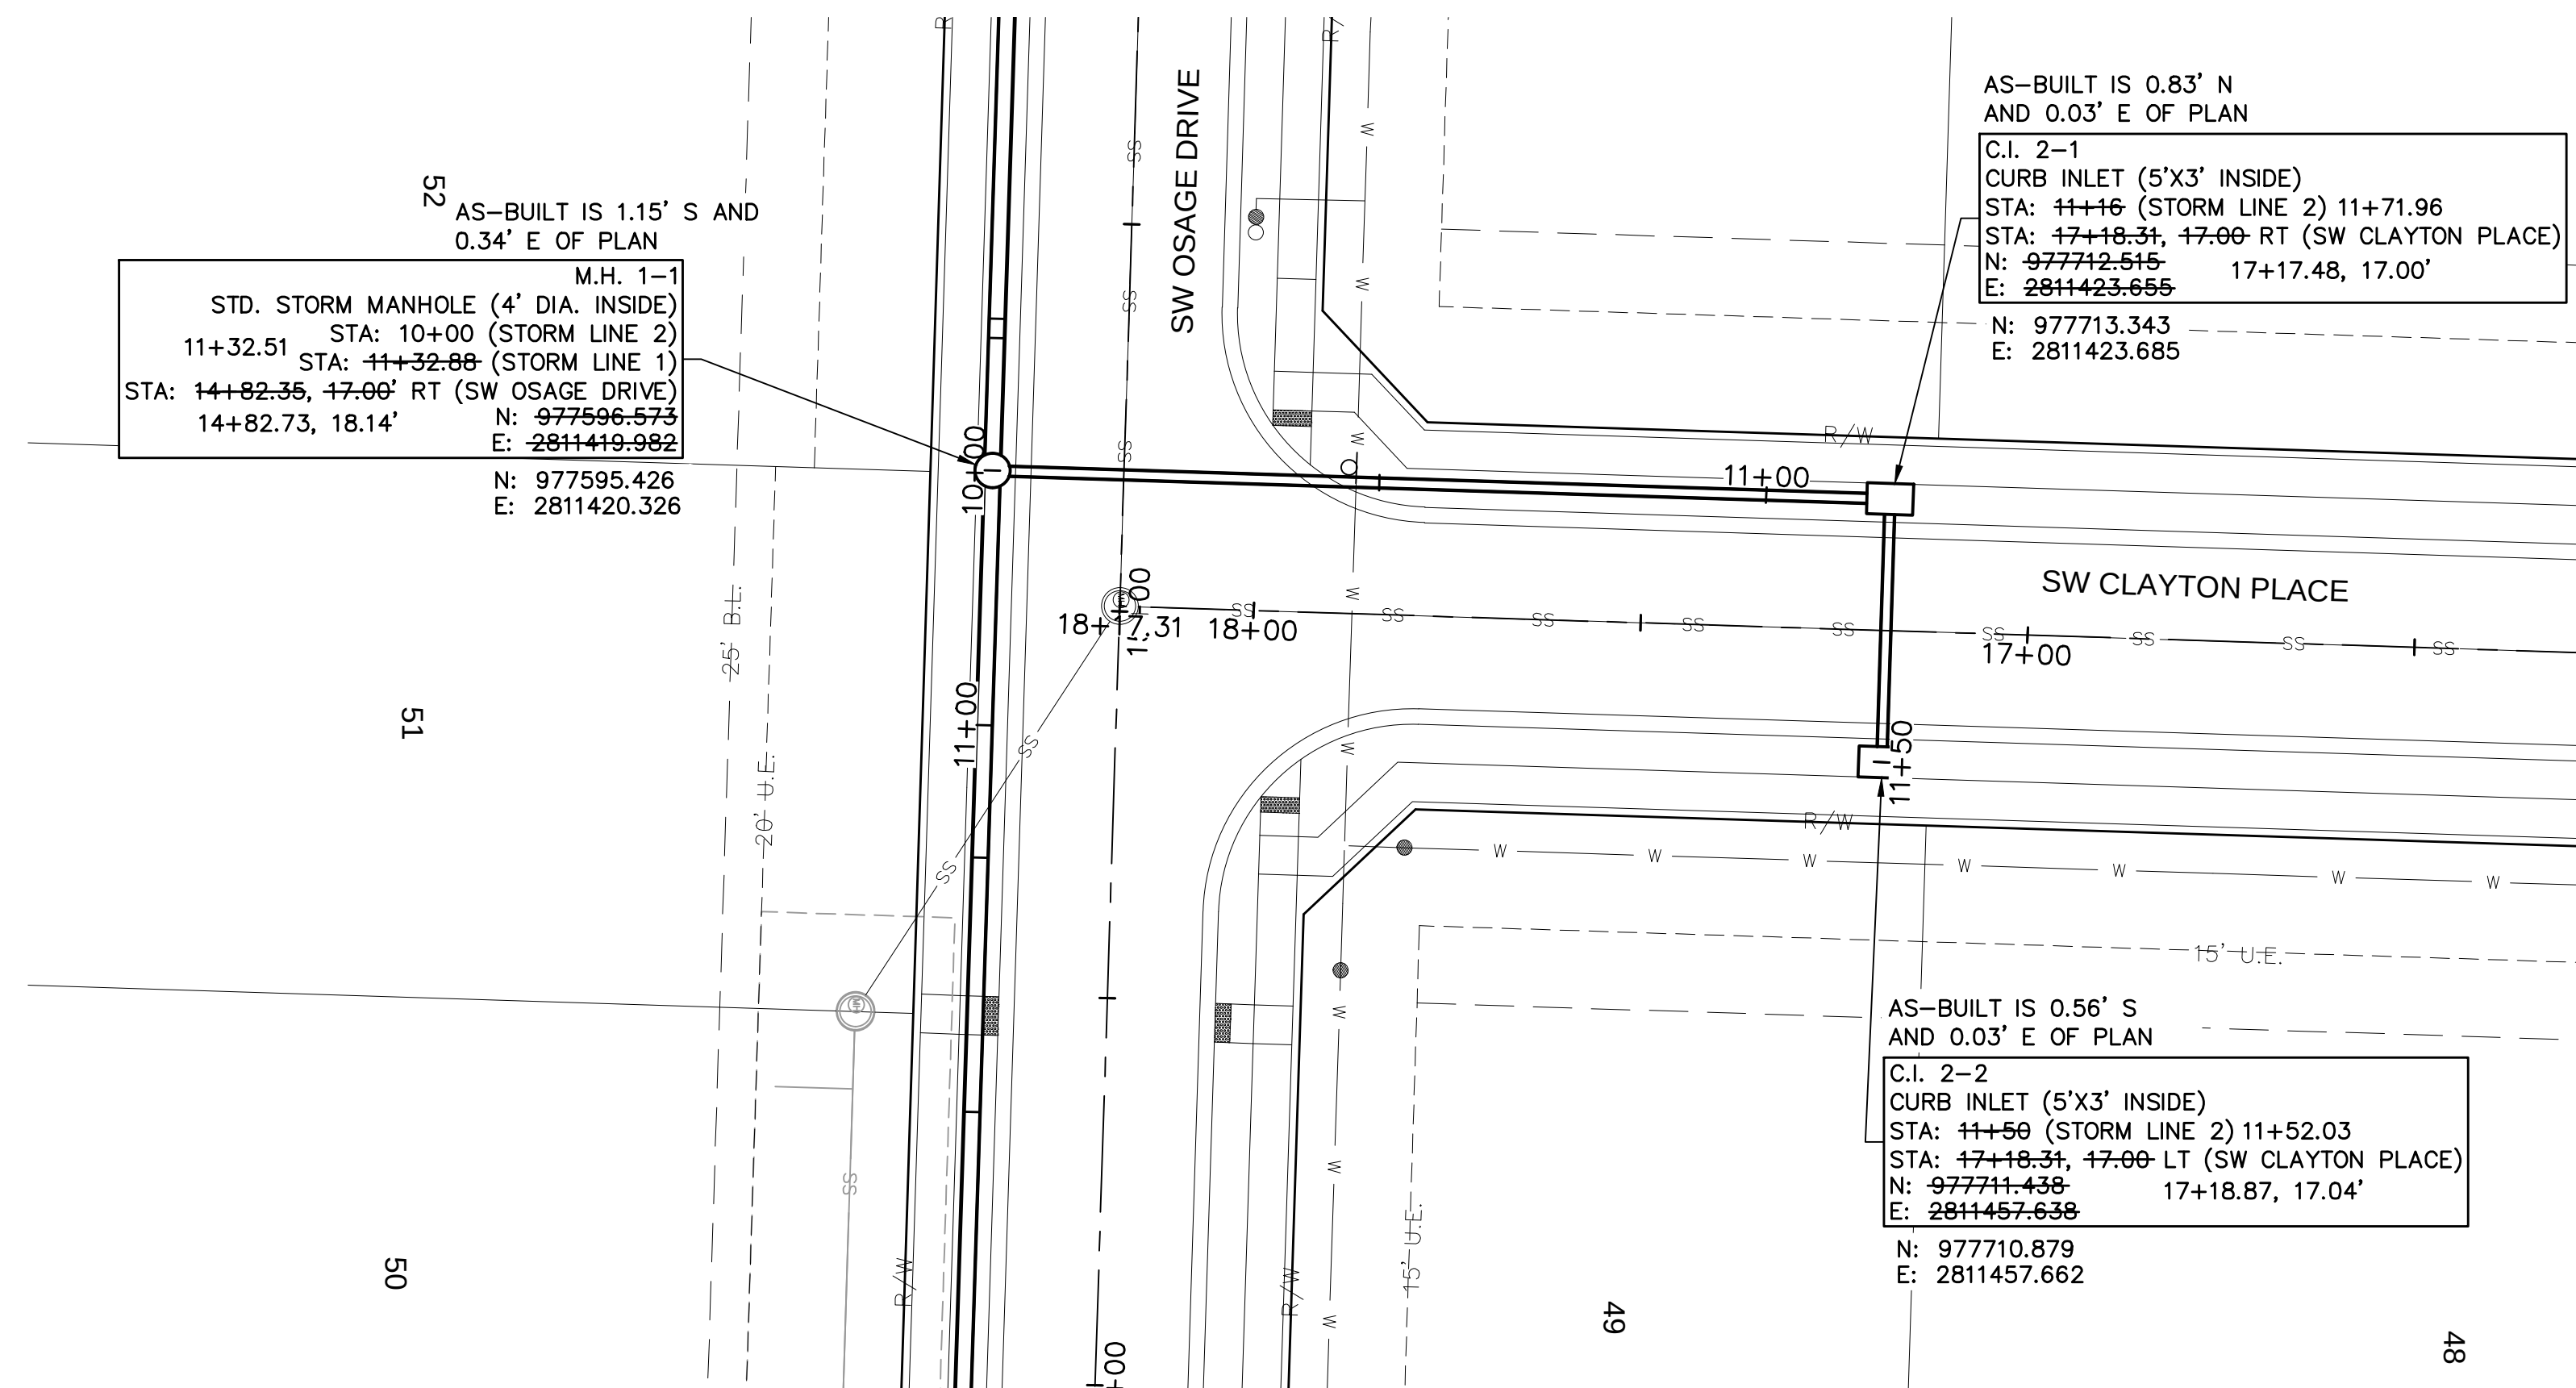


## AS-BUILT

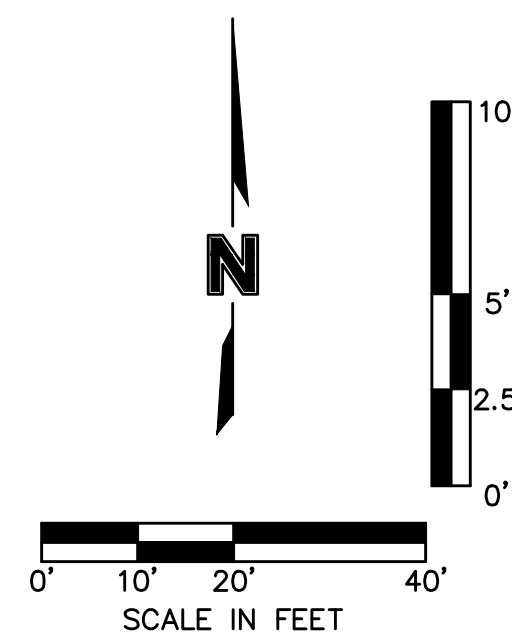[illegible]

|                                                                   |      |
|-------------------------------------------------------------------|------|
| STORM SEWER PLAN & PROFILE (LINE 2)<br>STREET & STORM SEWER PLANS |      |
| OSAGE<br>SECOND PLAT                                              |      |
|                                                                   | 2020 |

drawn by: D.F. / M.O. / A.A.  
checked by: C.G.W.  
designed by: A.A.  
QA/QC by: J.E.S.  
project no.: C19-2339  
drawing no.: \_\_\_\_\_  
date: 2022.05.26



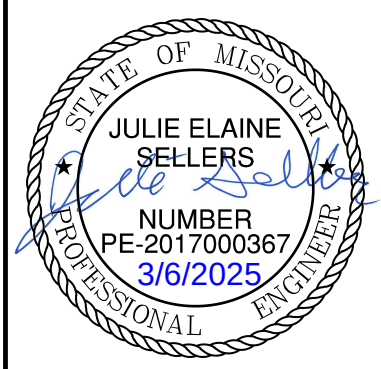


**Olsson**

Olsson - Civil Engineering  
Missouri Certificate of Authority #: 001592  
1301 Burlington Street  
North Kansas City, MO 64116  
TEL 816.361.1177  
www.olson.com



DWG: F:\2019\2001-2500\019-2339-C140-Design\AutoCAD\Final Plans - As-Built\Sheets\GNC\A\STREET & STORM\C\_STM01\_C192339.dwg USER: esayder  
DATE: May 26, 2022 7:36am XREFS: C\_PBASE\_C192339 C\_PBDY\_C192339 C\_PBLK\_C192339 C\_PSSWR\_C192339 C\_PSTRM\_C192339 C\_PWATR\_C192339

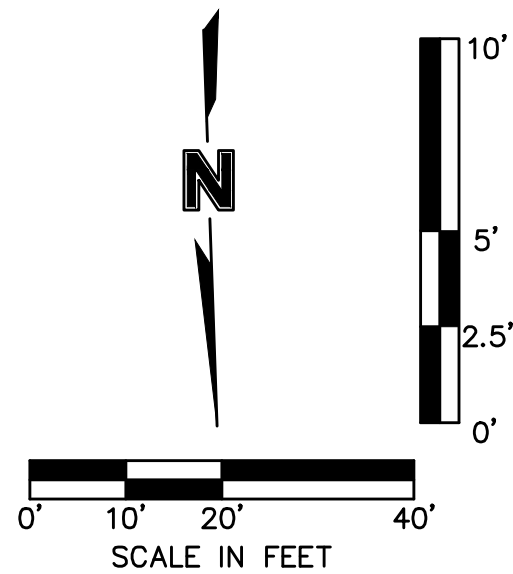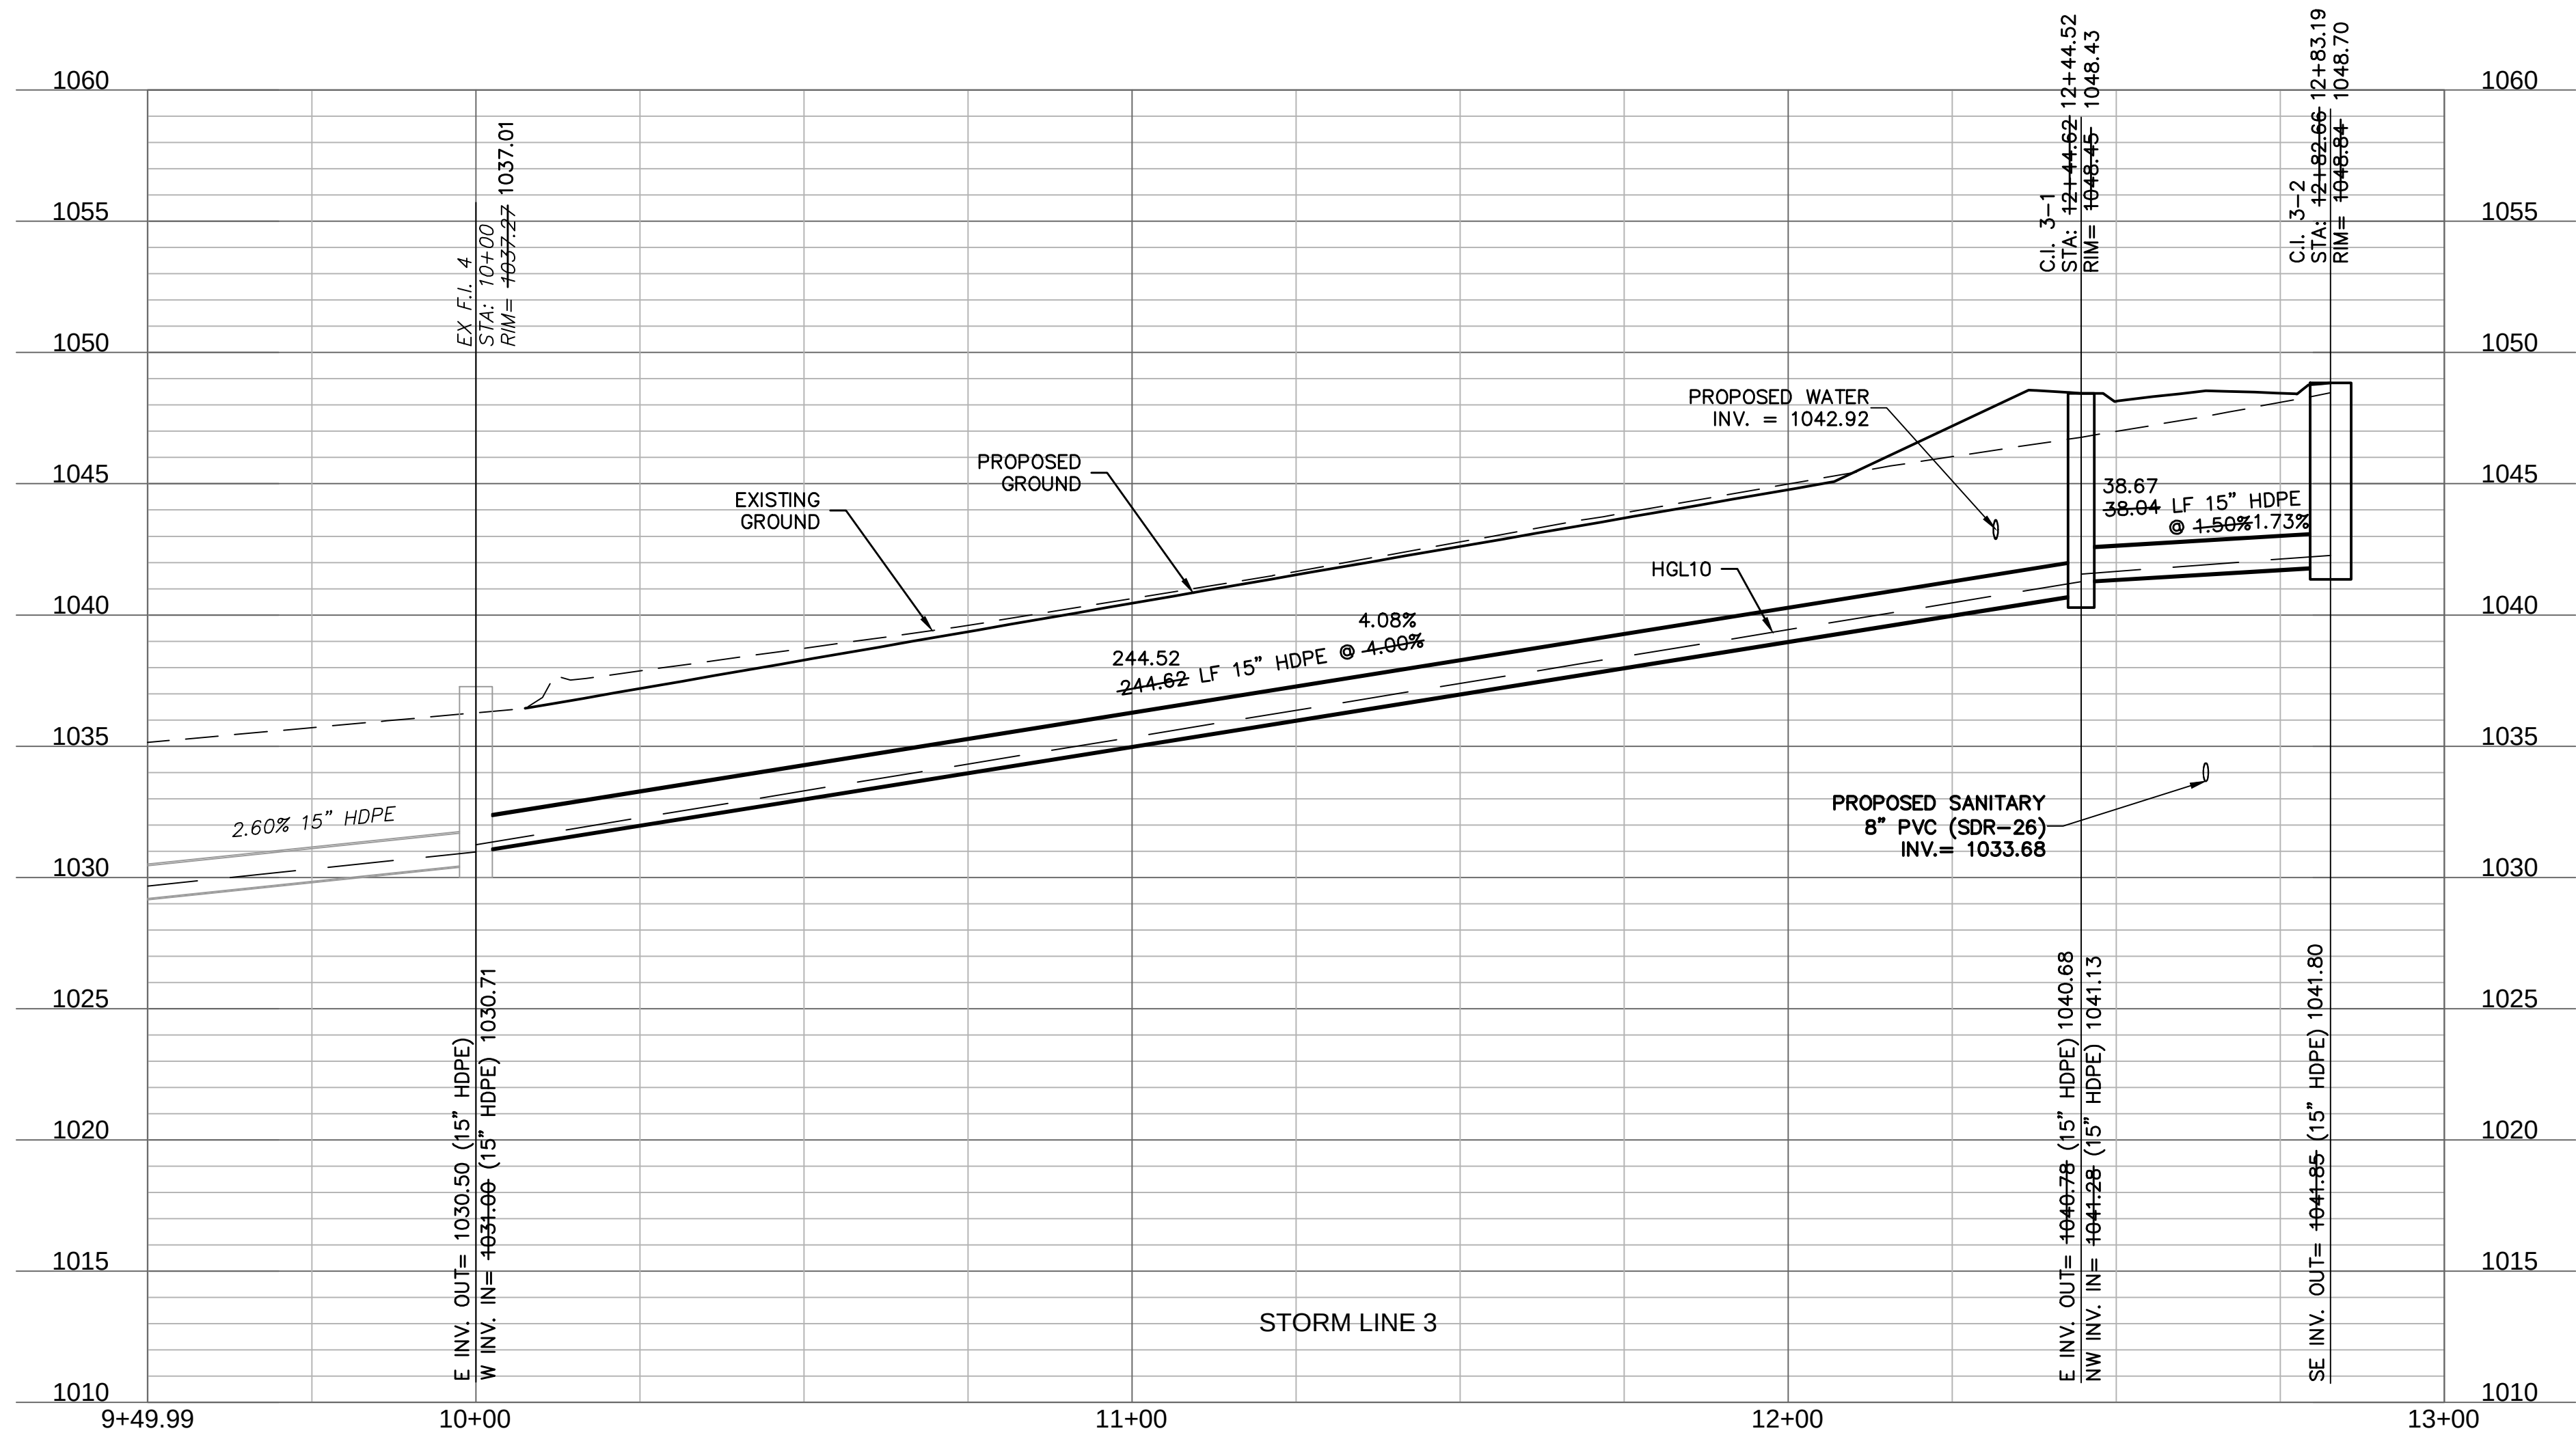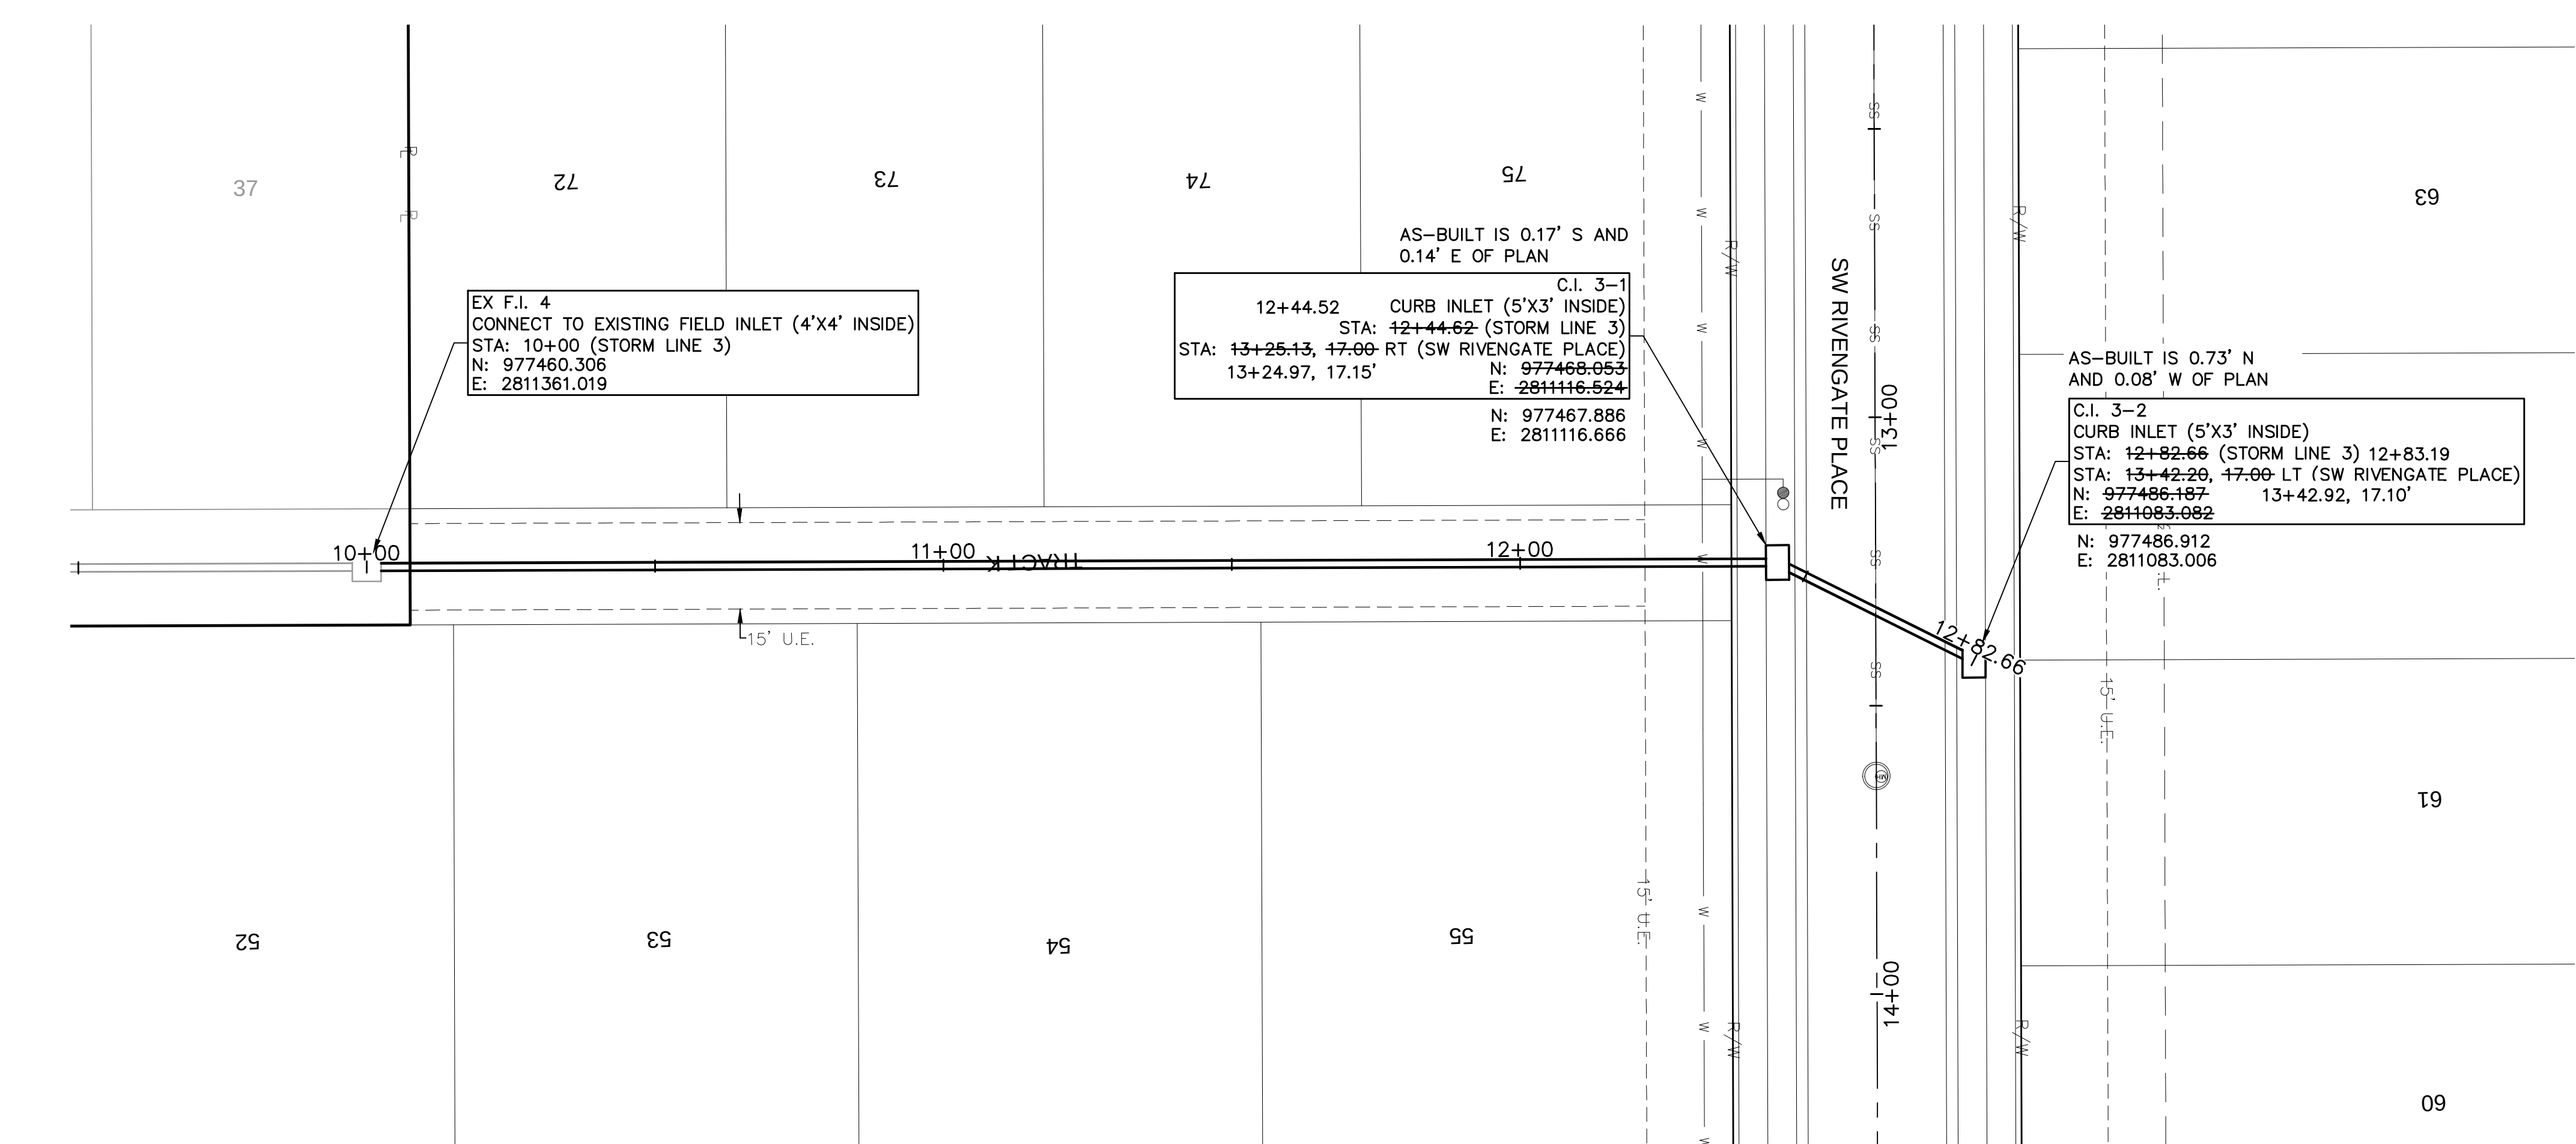

AS-BUILT

olsson

Olsson - Civil Engineering

Missouri Certificate of Authority #: 001592

1301 Burlington Street

North Kansas City, MO 64116

TEL 816.361.1177

www.olsson.com

STATE OF MISSOURI

JULIE ELAINE SELLERS

*Julie Sellers*

NUMBER PE-2017000367

3/6/2025

PROFESSIONAL ENGINEER

| REV. NO. | DATE | REVISIONS DESCRIPTION |
|----------|------|-----------------------|
|          |      |                       |
|          |      |                       |
| STORM SEWER PLAN & PROFILE (LINE 3)<br>STREET & STORM SEWER PLANS |      |
|-------------------------------------------------------------------|------|
| OSAGE<br>SECOND PLAT                                              | 2020 |

drawn by: D.F./M.O./A.A.

checked by: C.G.W.

designed by: A.A.

QA/QC by: J.E.S.




project no.: C19-2339

drawing no.:

date: 2022.05.26

SHEET  
C120




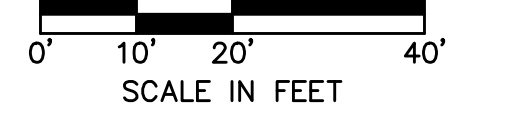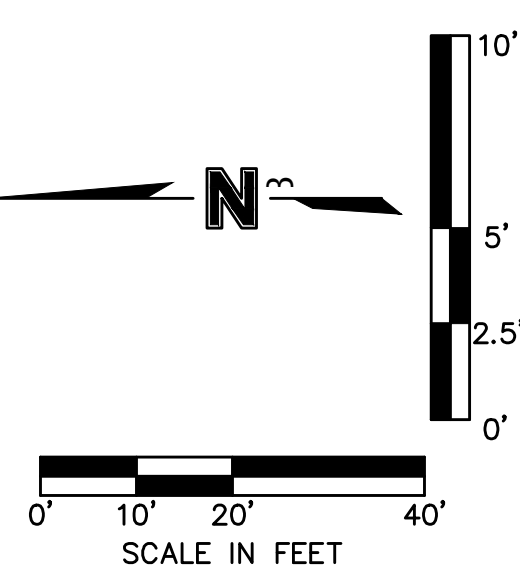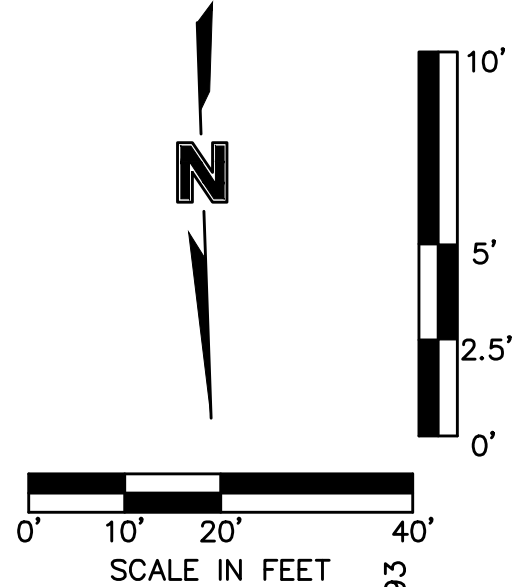


## AS-BUILT




DWG: F:\2019\2001-2500\019-2339-CA40-Design\AutoCAD\Final Plans - As-Built\Sheets\GNCV\STREET & STORM\C\_STM02\_C192339.dwg USER: ssc/dor  
DATE: May 26, 2022 7:37am XREFS: C\_PBASE\_C192339 C\_PBNDR\_C192339 C\_PBLK\_C192339 C\_PSSWR\_C192339 C\_PWATR\_C192339

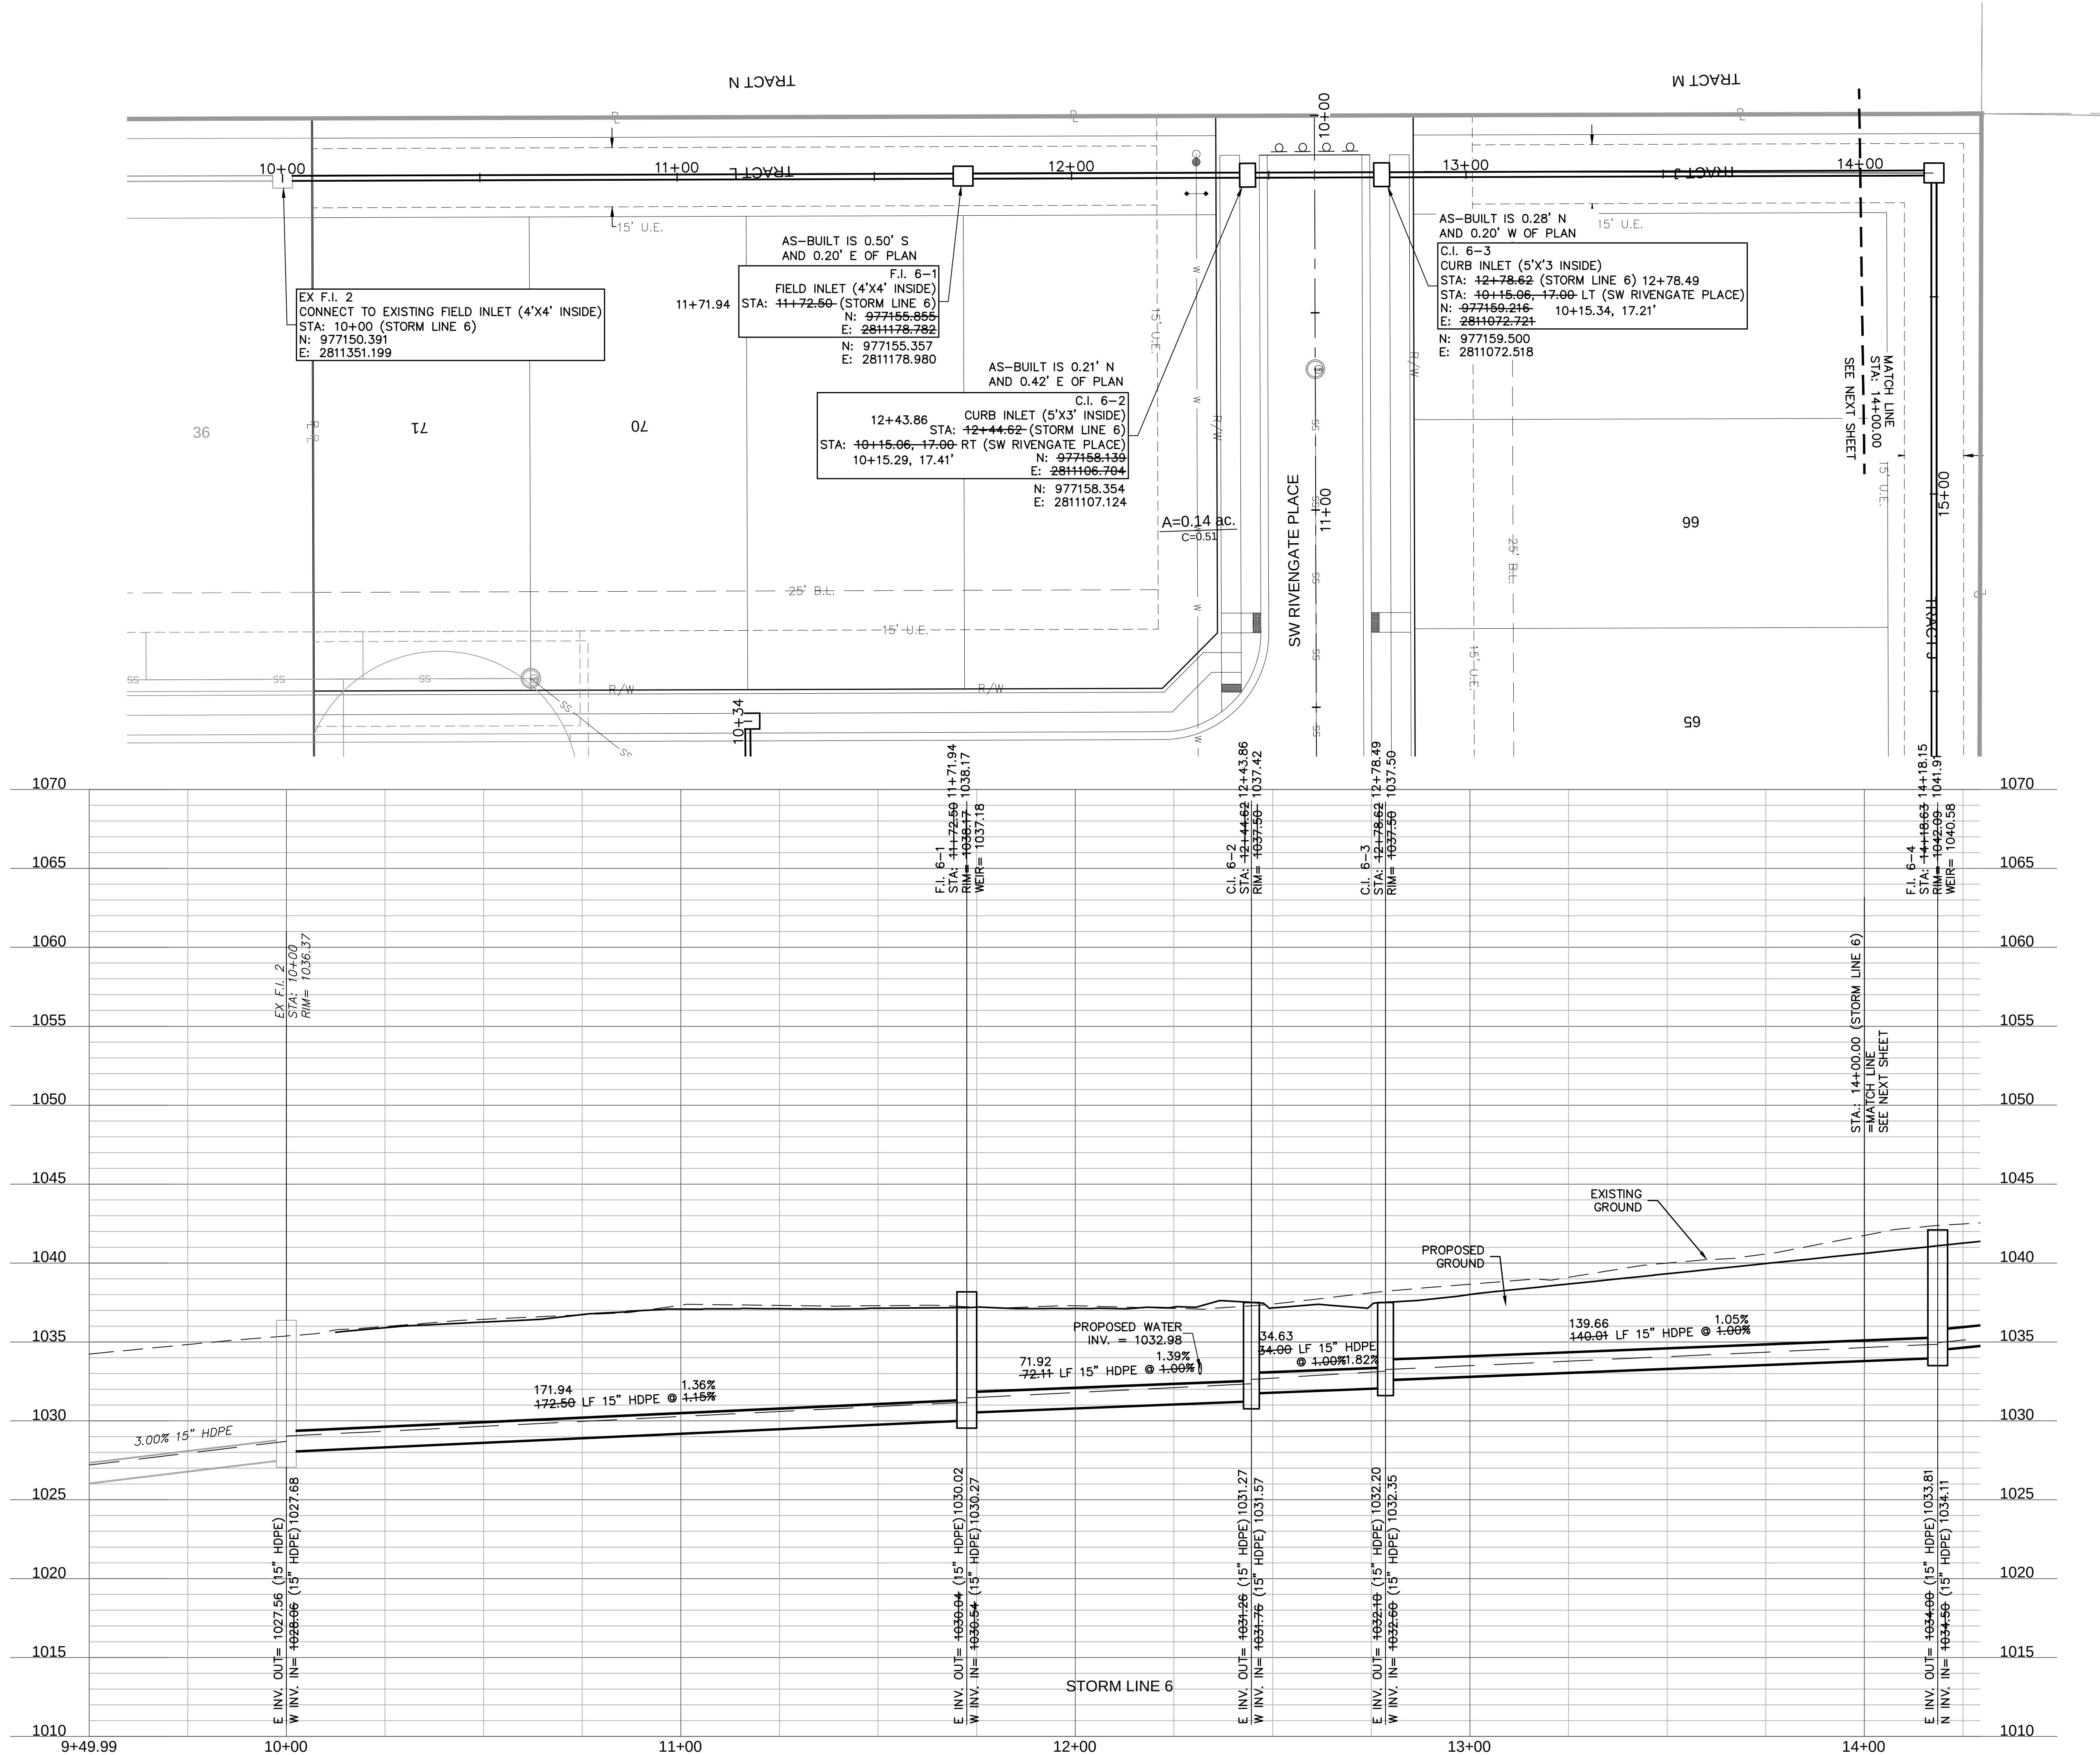

AS-BUILT

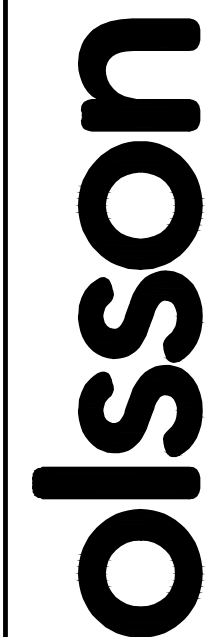

Olsson - Civil Engineering  
Missouri Certificate of Authority #: 001592  
1301 Burlington Street  
North Kansas City, MO 64116  
TEL 816.361.1177  
www.olsson.com

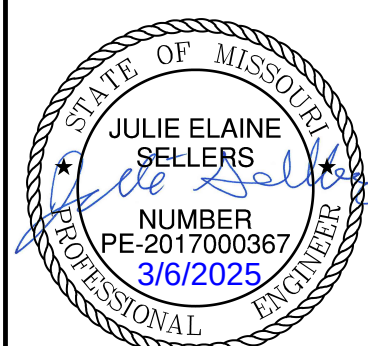

JULIE ELAINE SELLERS  
NUMBER PE-2017000367  
3/6/2025  
PROFESSIONAL ENGINEER

| REV. NO. | DATE | REVISIONS DESCRIPTION |
|----------|------|-----------------------|
|          |      |                       |
|          |      |                       |
|          |      |                       |
|          |      |                       |

| STORM SEWER PLAN & PROFILE (LINE 6)<br>STREET & STORM SEWER PLANS<br>SECOND PLAT |      |
|----------------------------------------------------------------------------------|------|
| OSAGE                                                                            | 2020 |

|                          |
|--------------------------|
| drawn by: D.F./M.O./A.A. |
| checked by: C.G.W.       |
| designed by: A.A.        |
| QA/QC by: J.E.S.         |
| project no.: C19-2339    |
| drawing no.: 2022.05.26  |

SHEET  
C122







DWG: F:\2019\2001-2500\019-2339-C\40-Design\AutoCAD\Final Plans - As-Built\Sheets\GNV\STREET & STORM\C\_STM02\_C192339.dwg USER: sso\jor  
DATE: May 26, 2022 7:37am XREFS: C\_PBASE\_C192339 C\_XBASE\_C192339 C\_PBLK\_C192339 C\_PSTRM\_C192339 C\_PSSWR\_C192339 C\_PWATR\_C192339

DWG: F:\2019\2001-2500\019-2339-C\40-Design\AutoCAD\Final Plans - As-Built\Sheets\GNVC\STREET & STORM\C\_STM02\_C192339.dwg USER: ssavlor  
DATE: May 26, 2022 7:37am XREFS: C\_PBASE\_C192339 C\_PBNDY\_C192339 C\_PBLK\_C192339 C\_PSTRM\_C192339





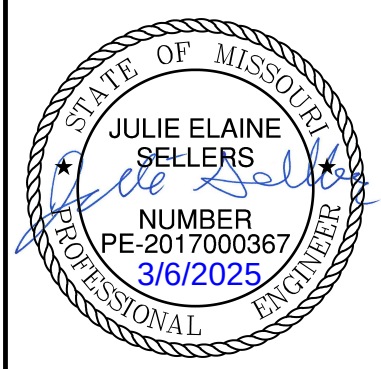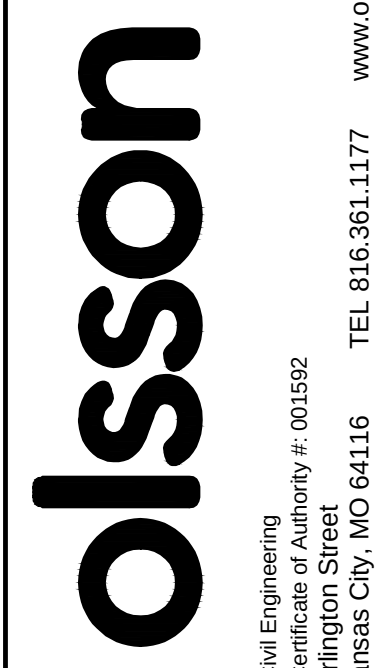

| REVISIONS |                       |
|-----------|-----------------------|
| REV. NO.  | REVISIONS DESCRIPTION |
|           |                       |
|           |                       |
|                                     |  |
|-------------------------------------|--|
| STORM SEWER PLAN & PROFILE (LINE 7) |  |
| STREET & STORM SEWER PLANS          |  |
| OSAGE SECOND PLAT                   |  |
| 2020                                |  |
| SHEET C124                          |  |

drawn by: D.F./M.O./A.A.  
checked by: C.G.W.  
designed by: A.A.  
QA/QC by: J.E.S.  
project no.: C19-2339  
drawing no.:  
date: 2022.05.26

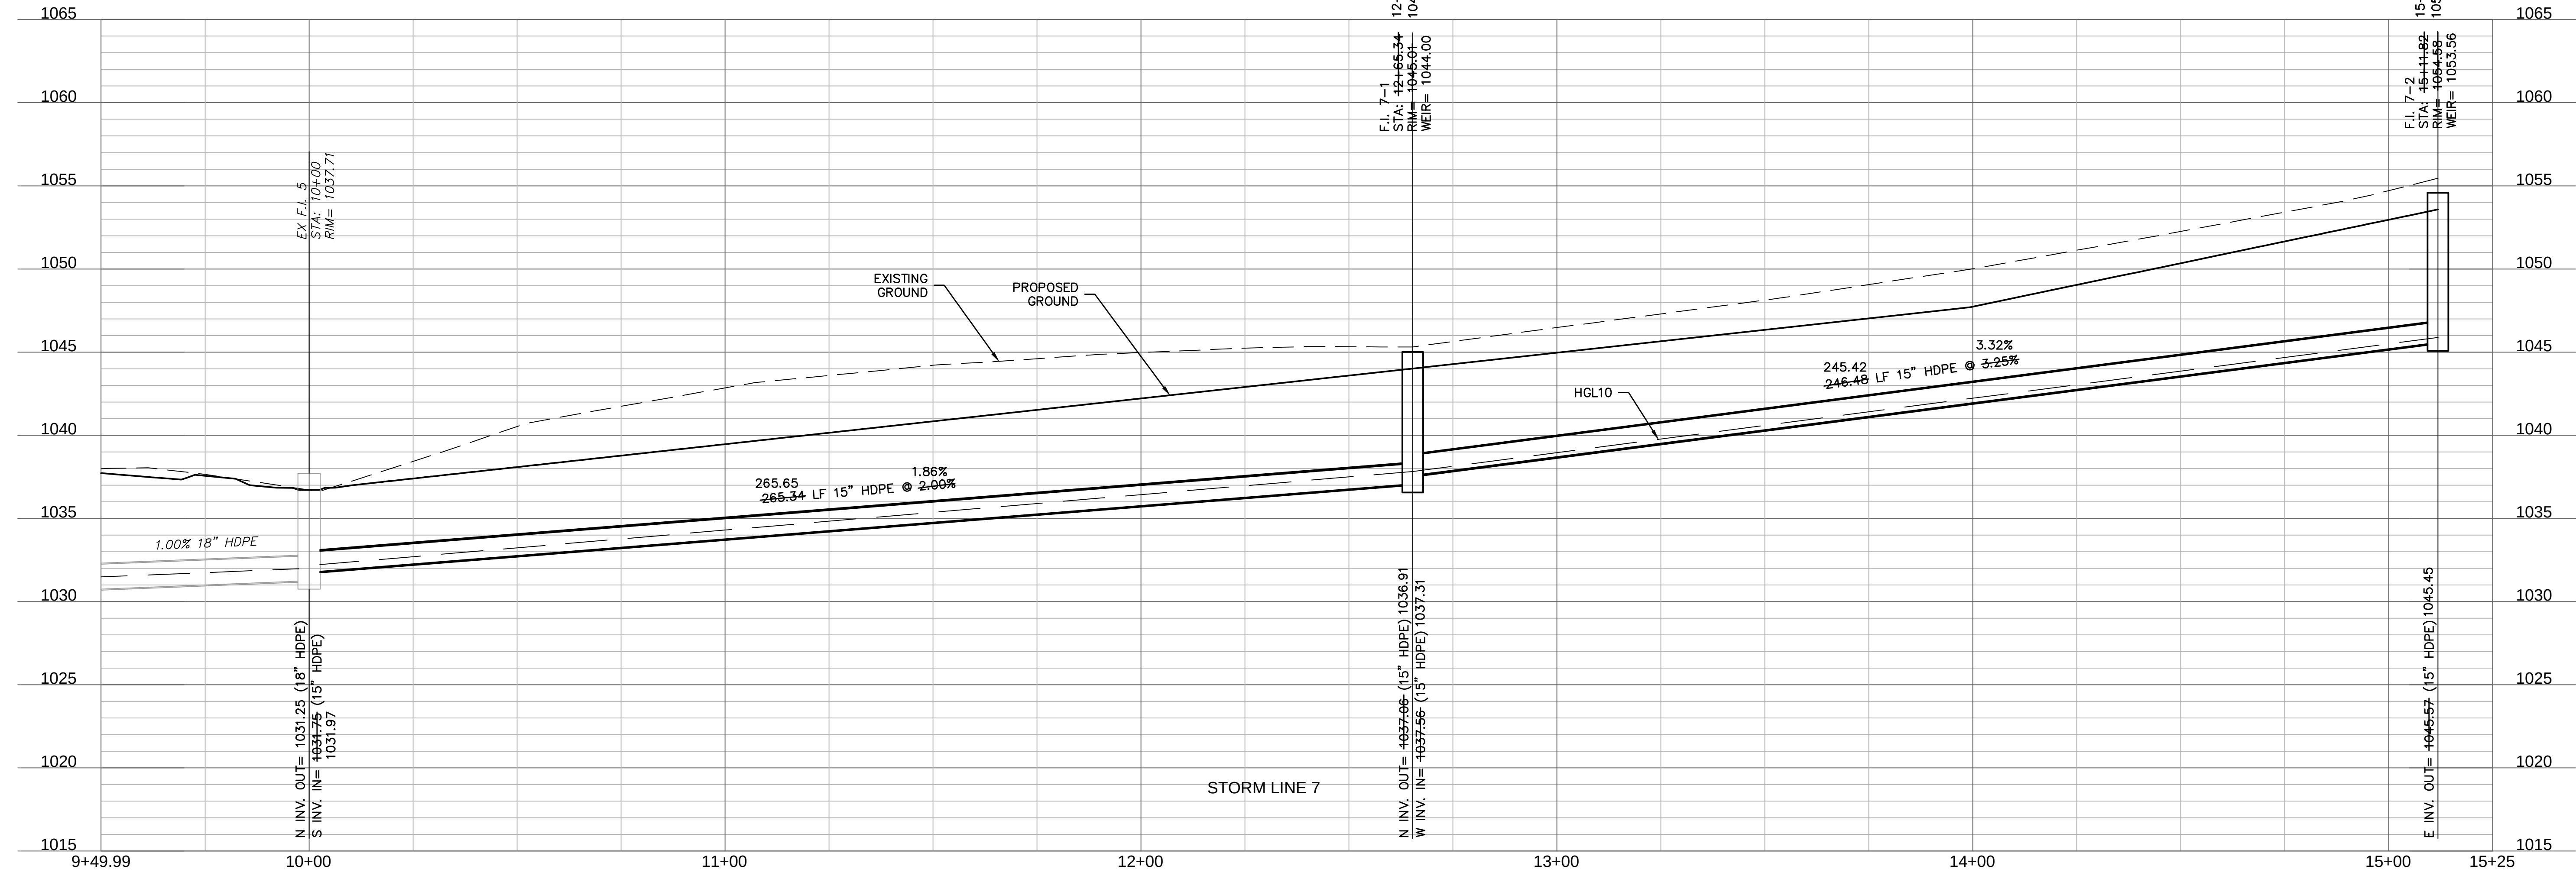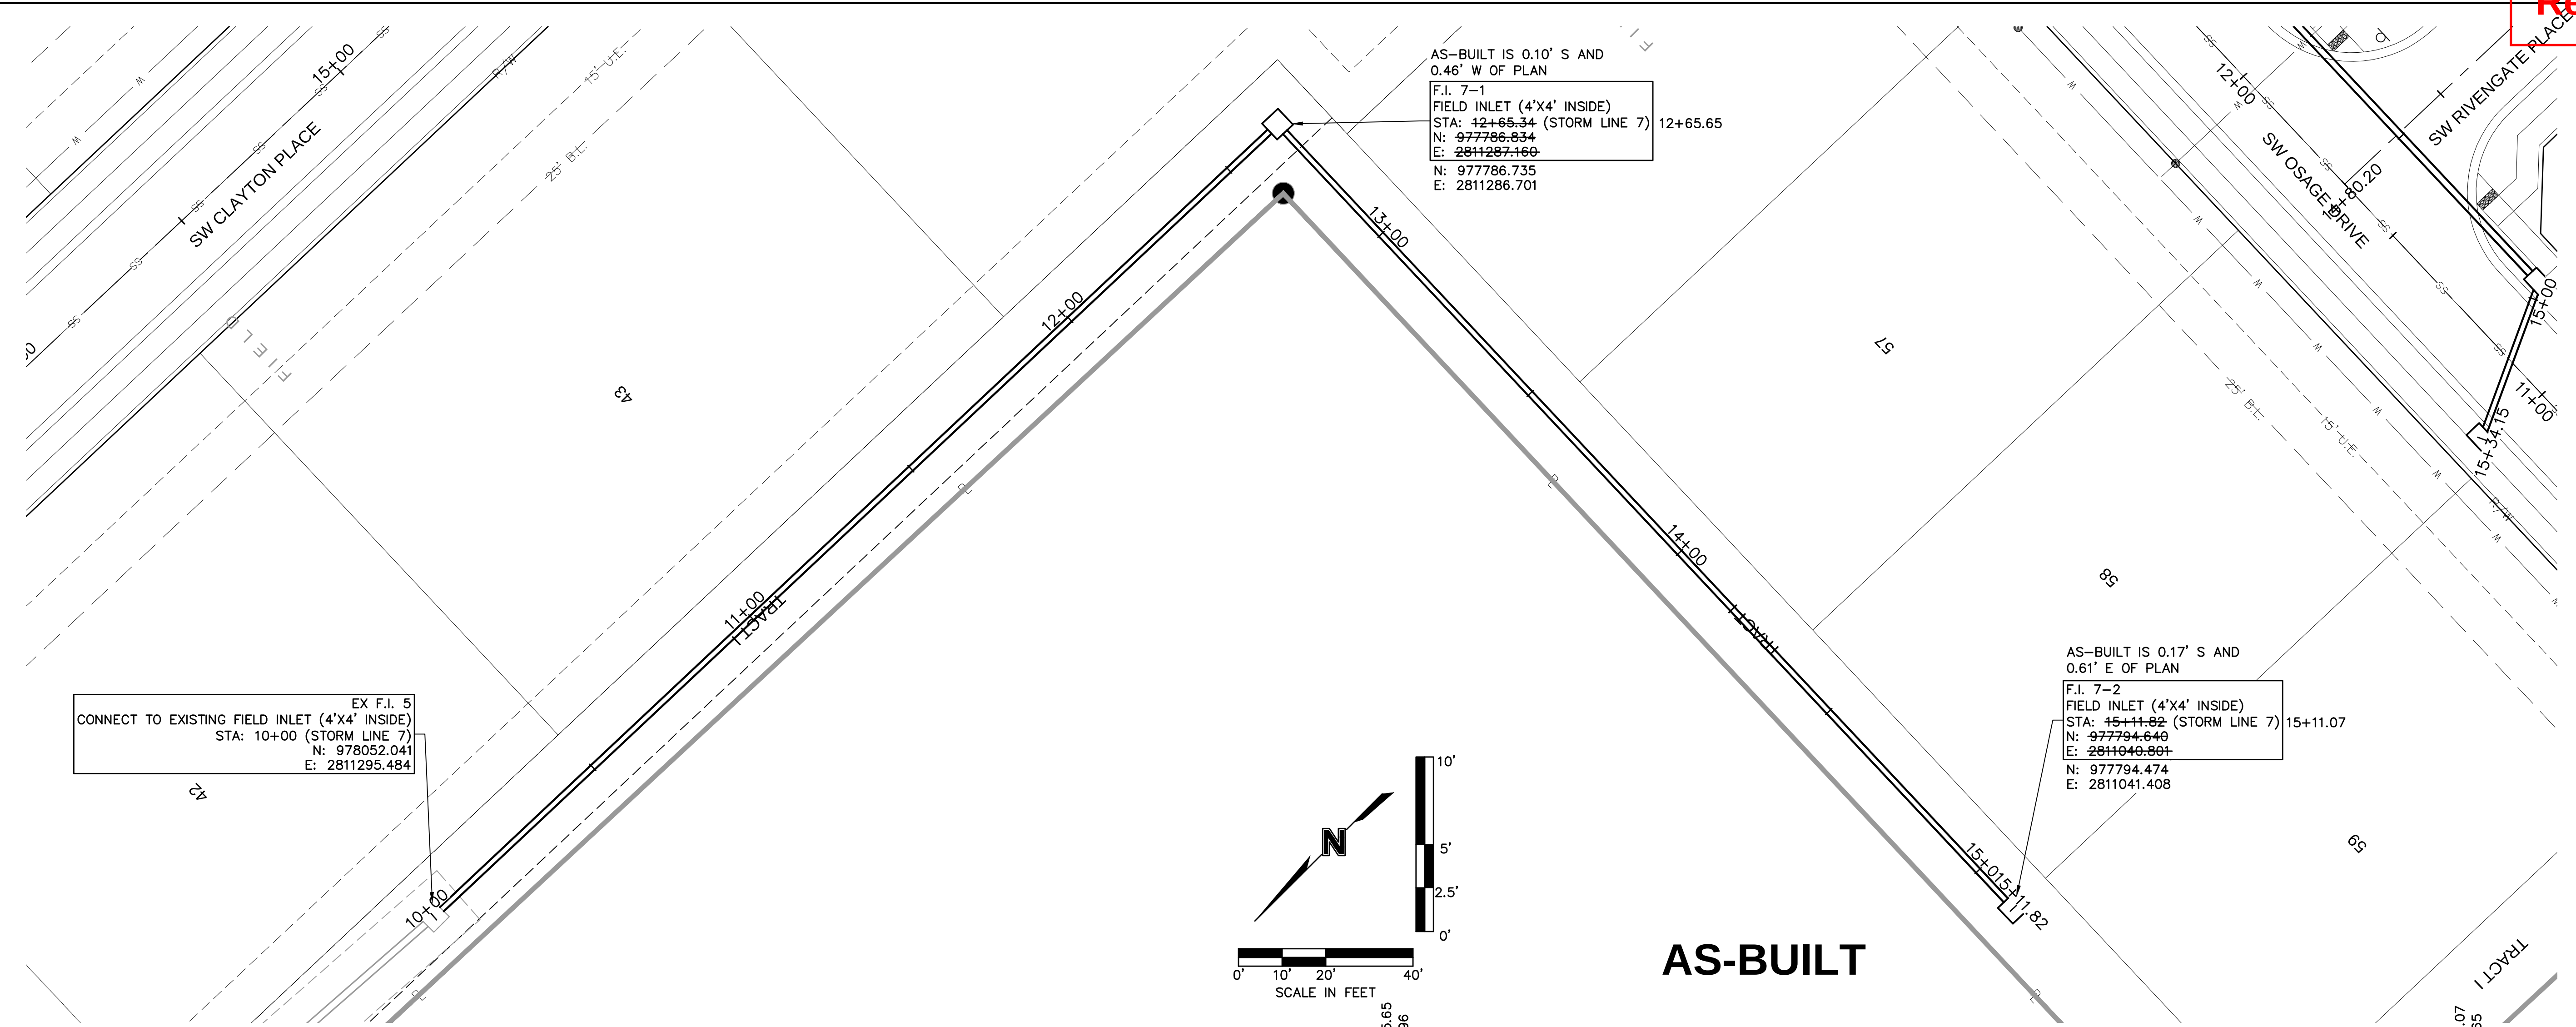

F:\2019\2001-2500\019-2339-C140-Design\AutoCAD\Final Plans - As-Built\Sheets\GNC\A\STREET & STORM\A\_C\_STM02\_C192339.dwg USER: ascdor  
DATE: May 26, 2022 7:37am XREFS: C:\BASE\_C192339 C:\PBDY\_C192339 C:\PBLK\_C192339 C:\PSTRM\_C192339 C:\PSSWR\_C192339 C:\PWATR\_C192339



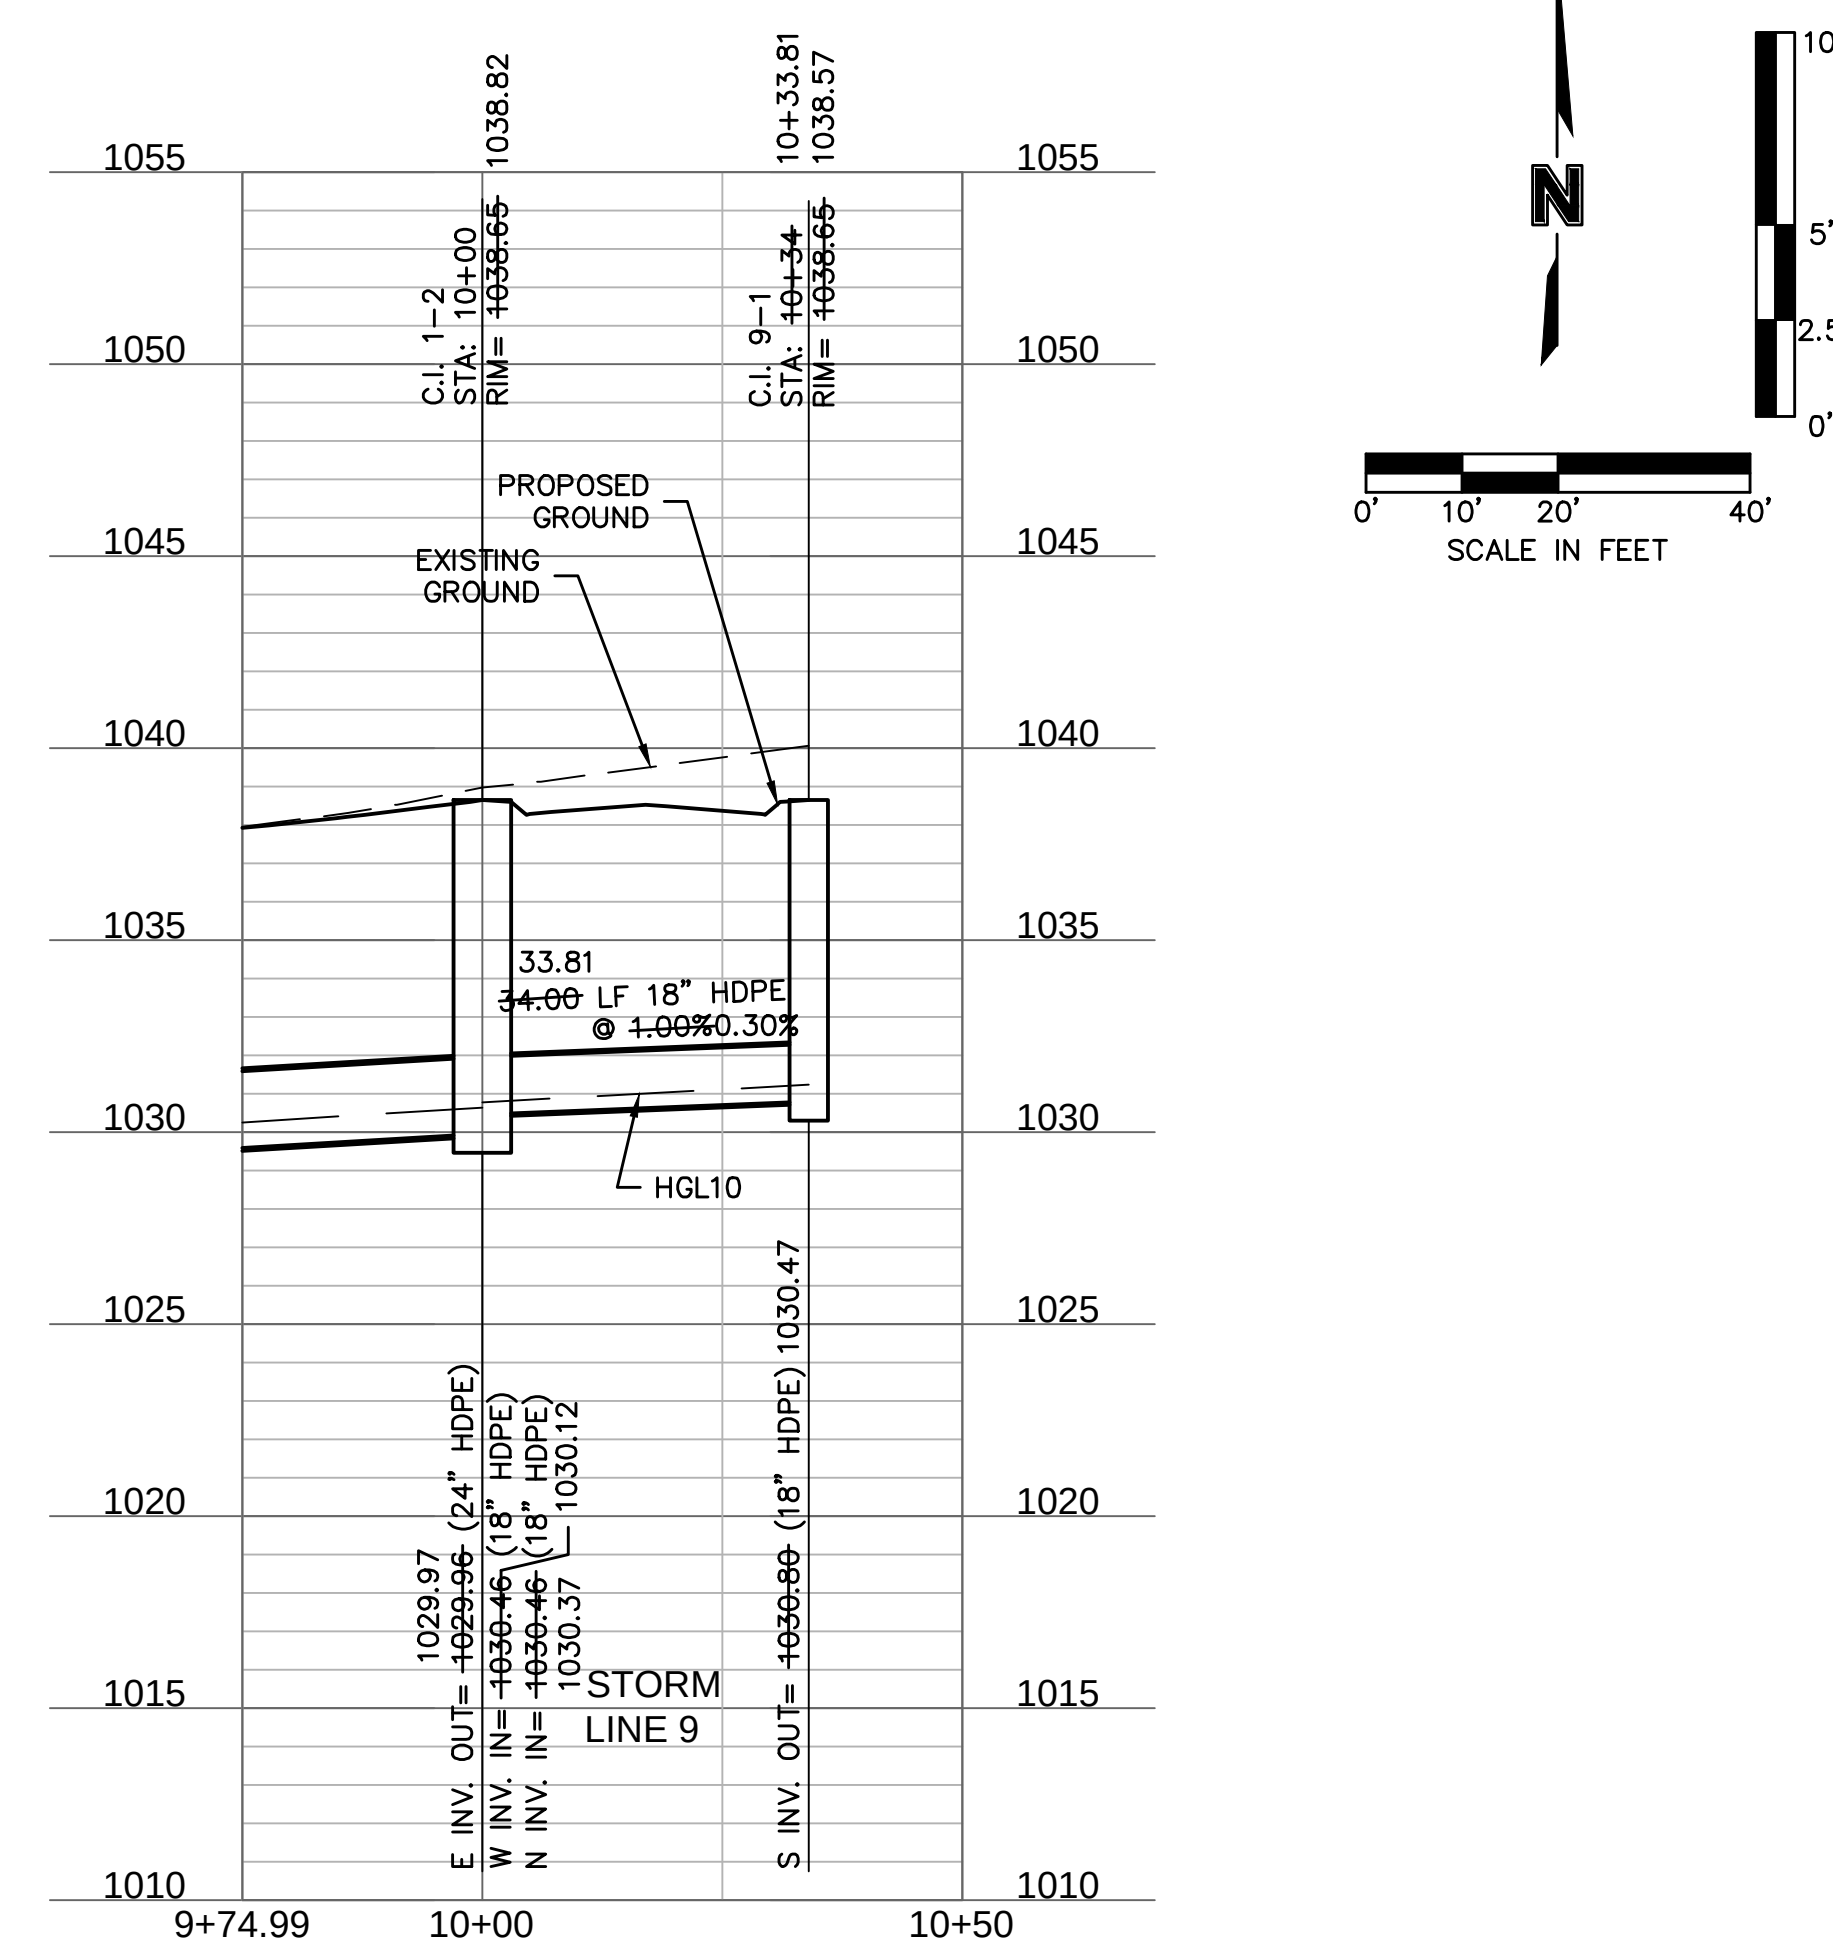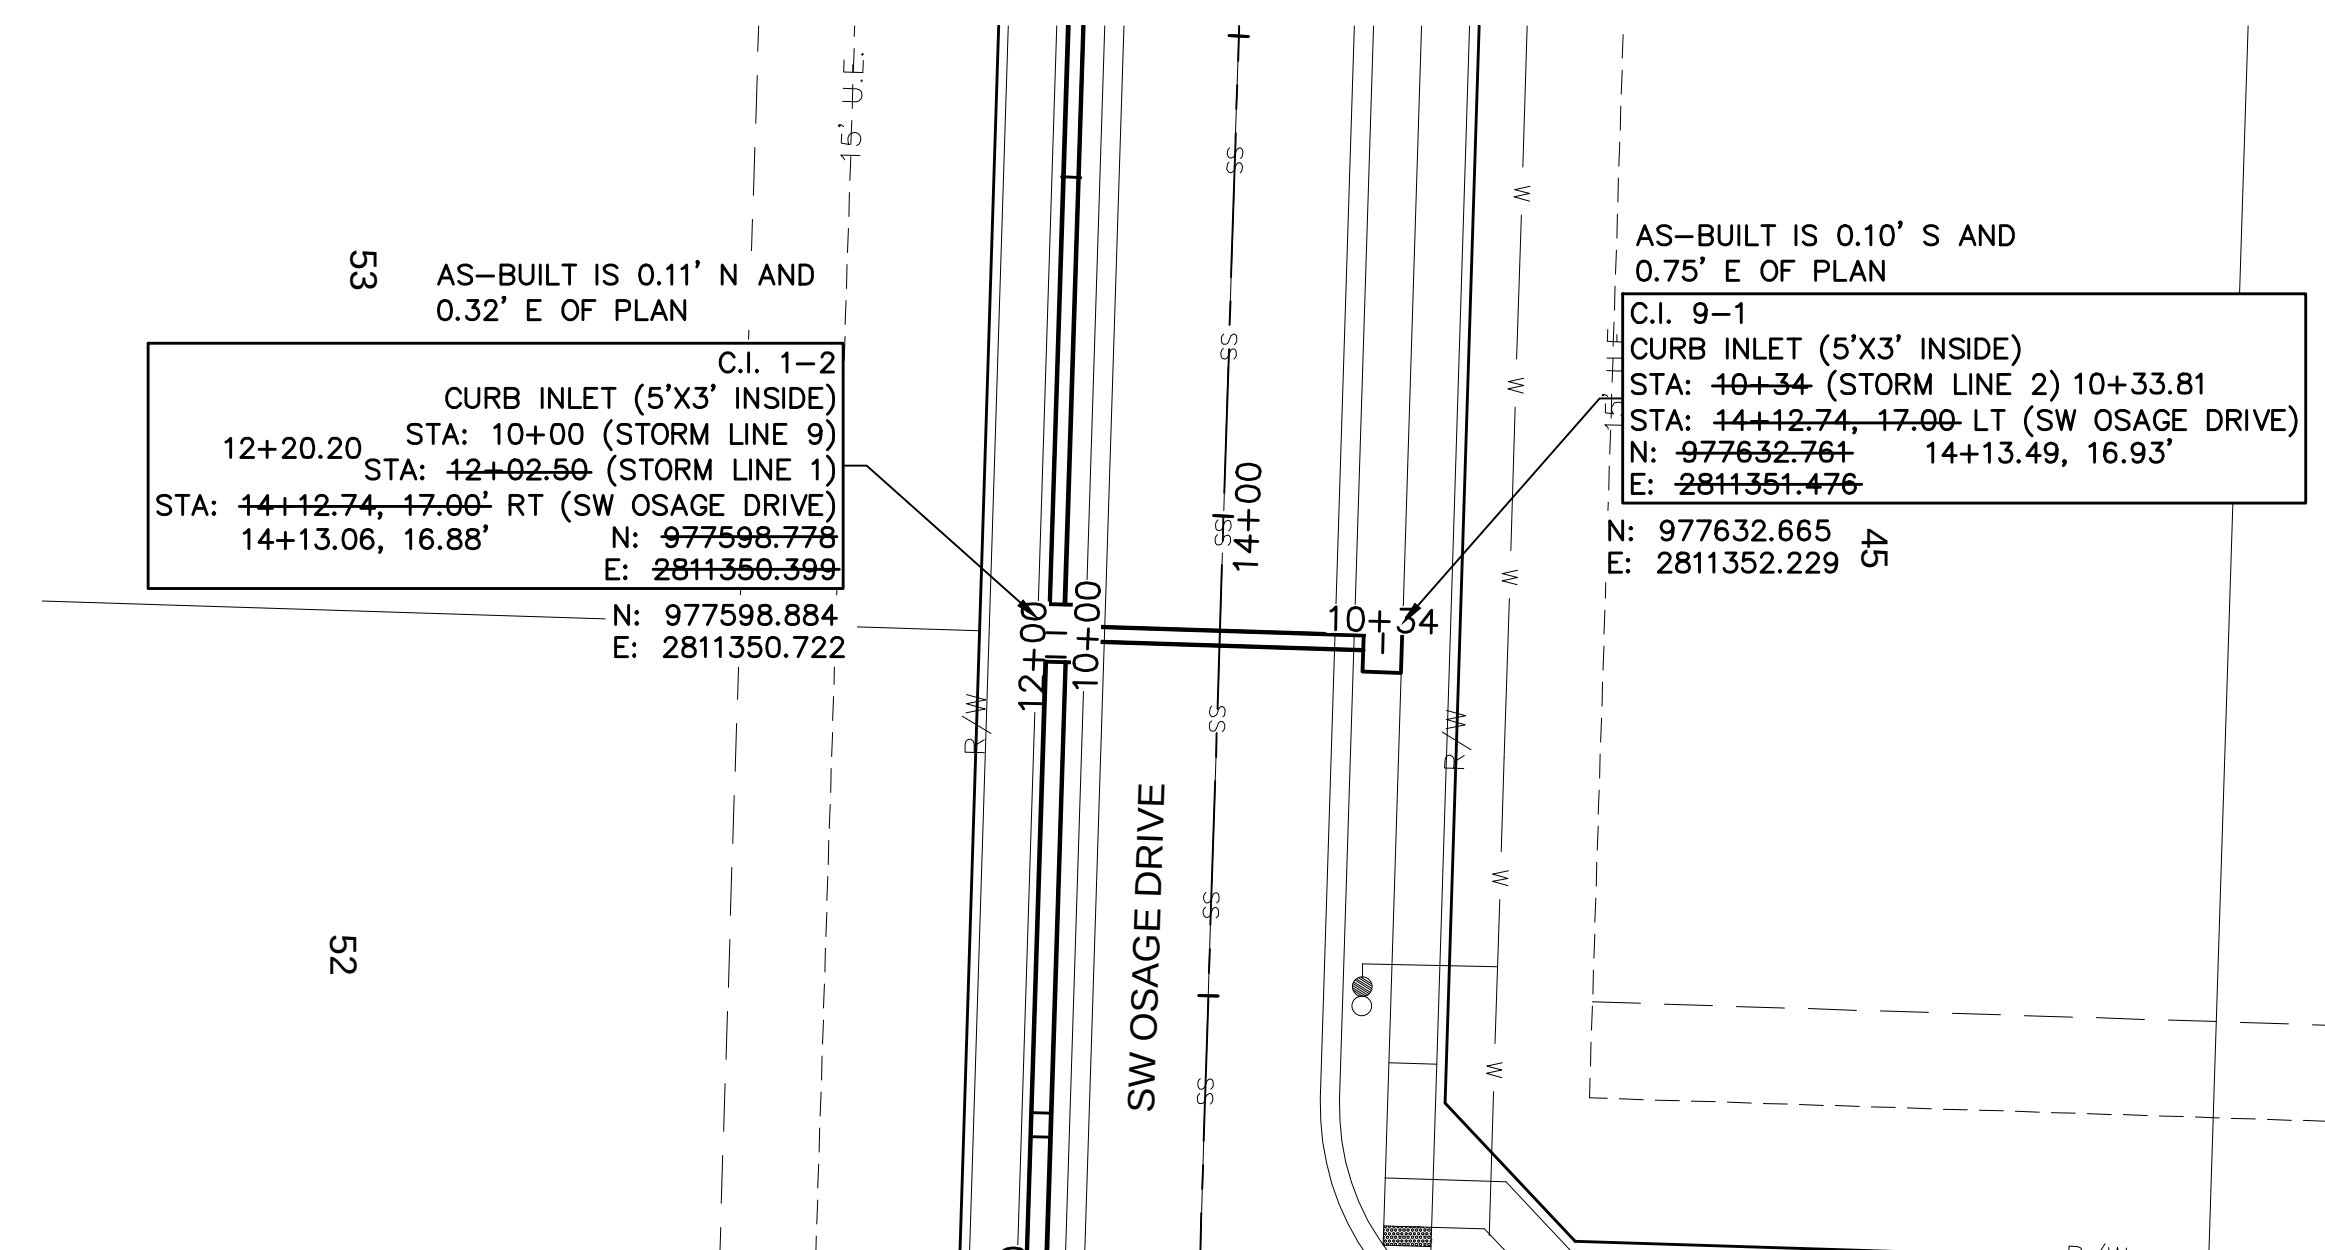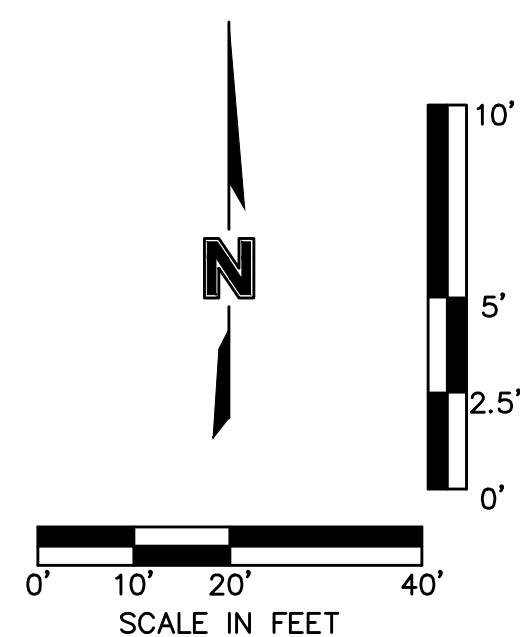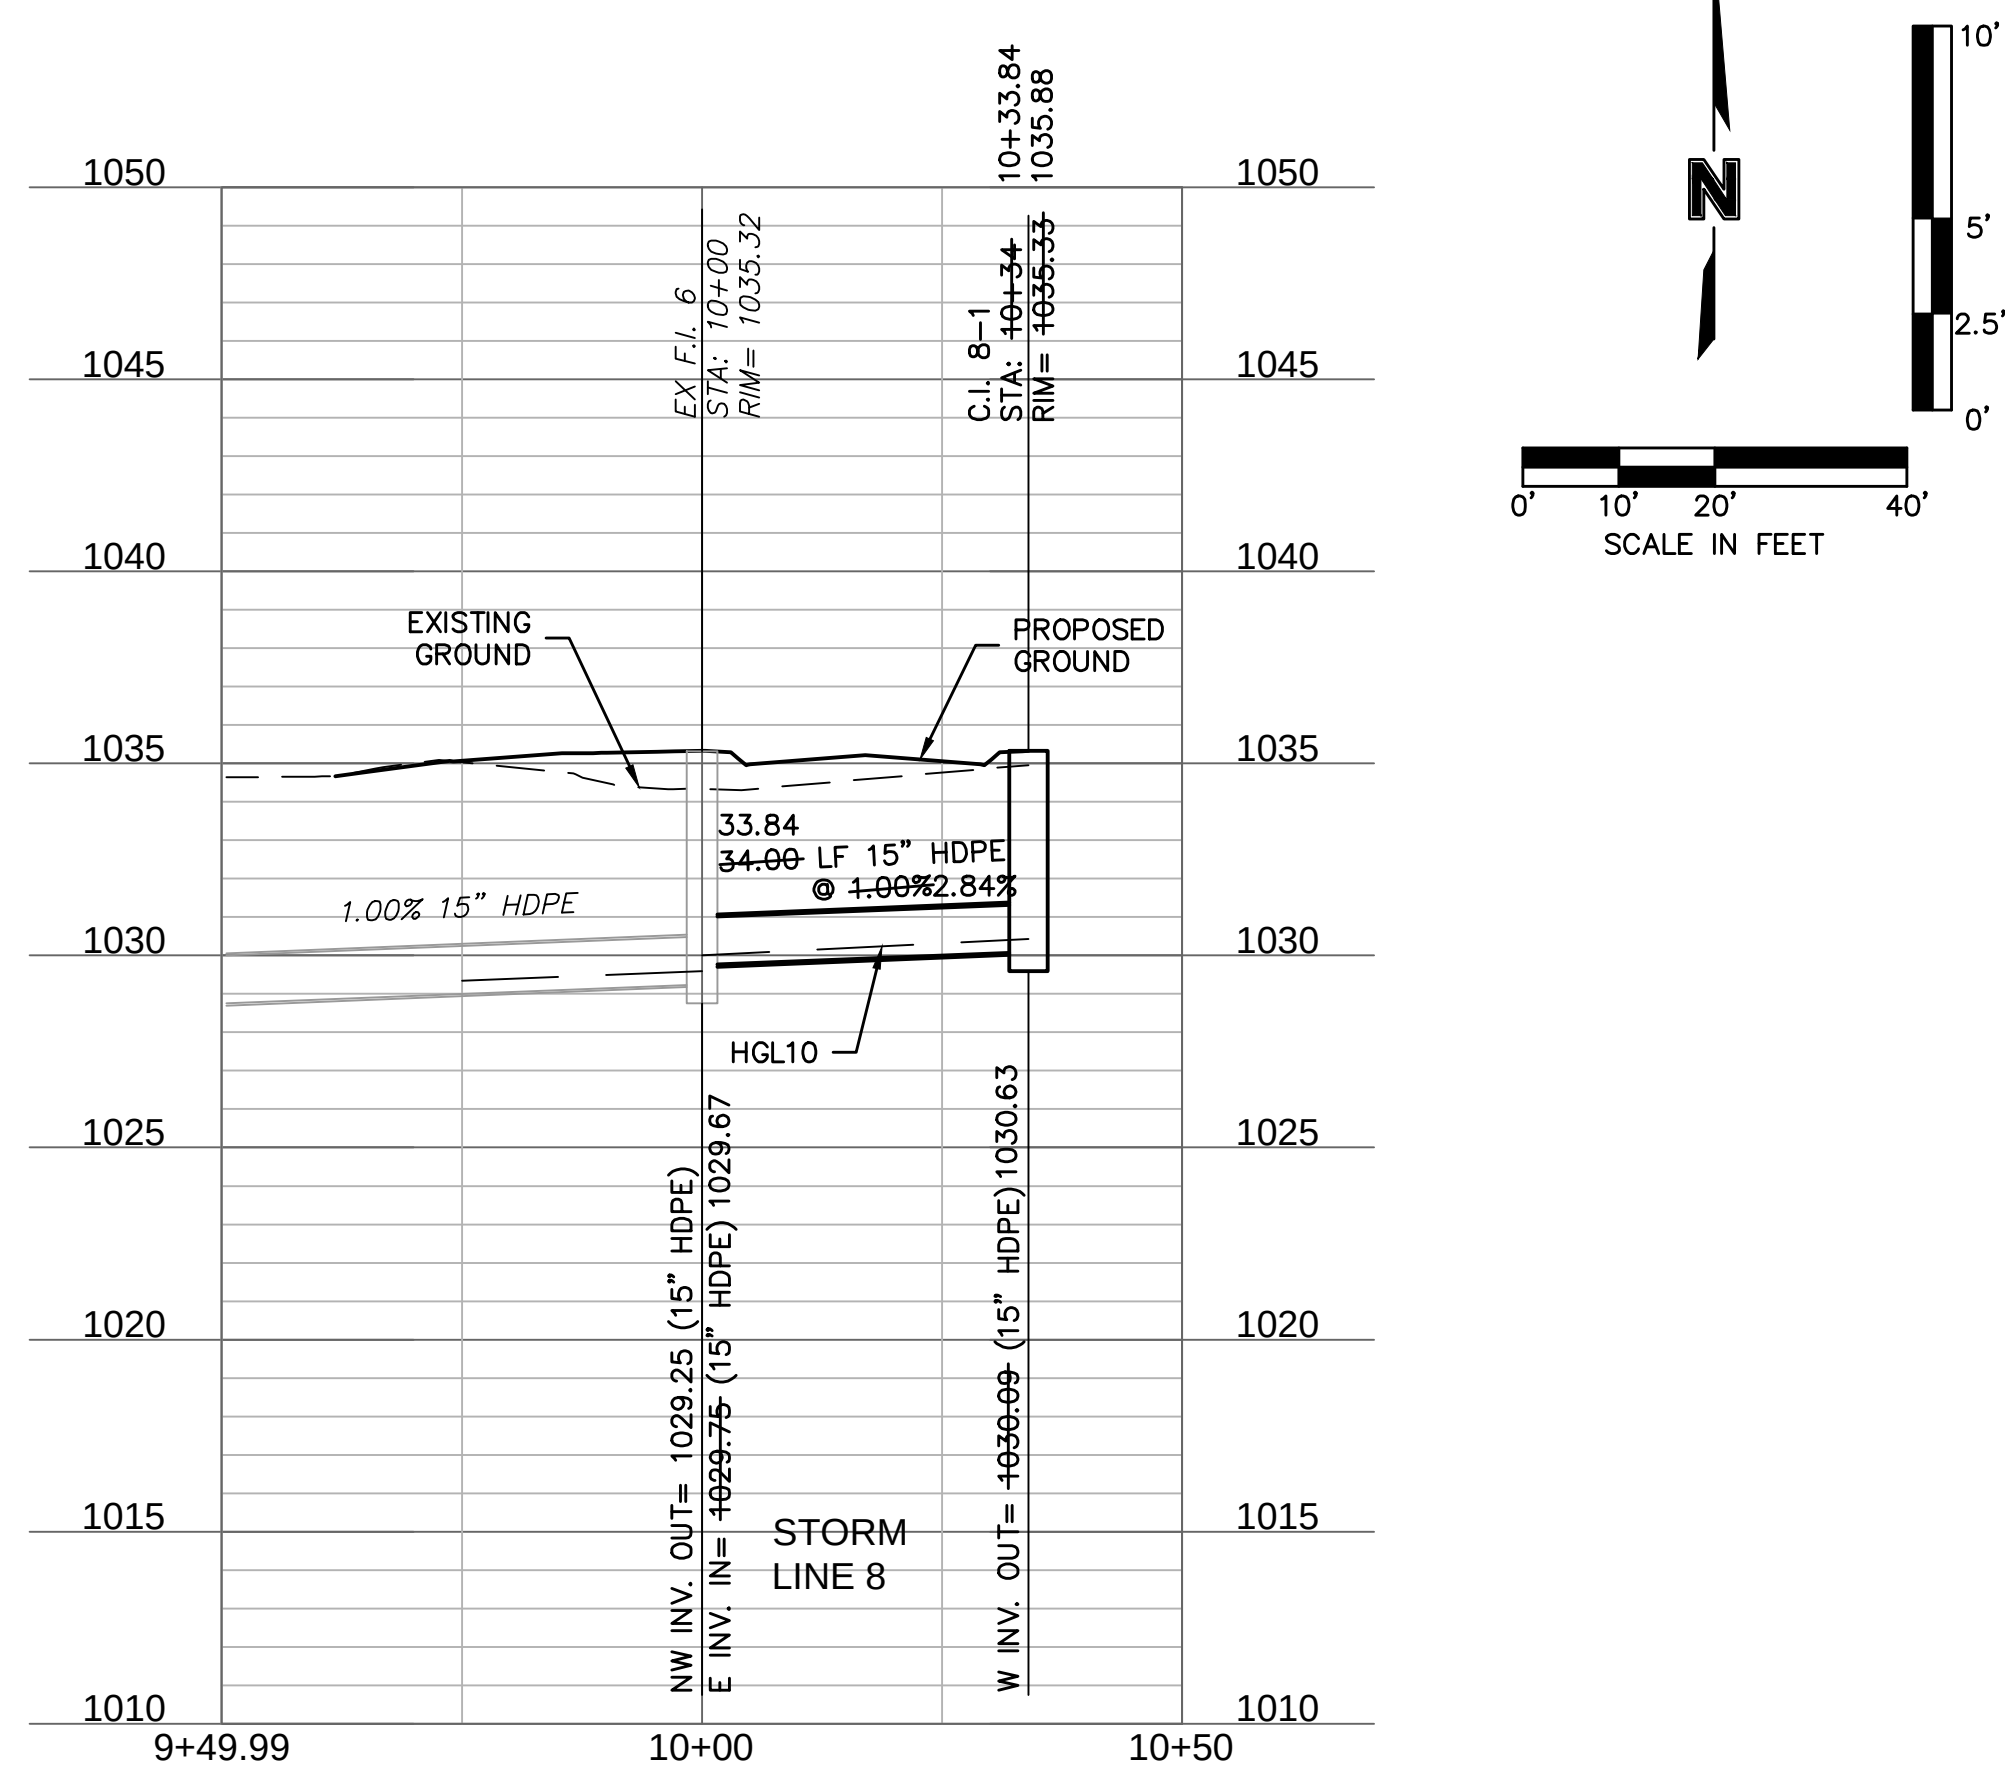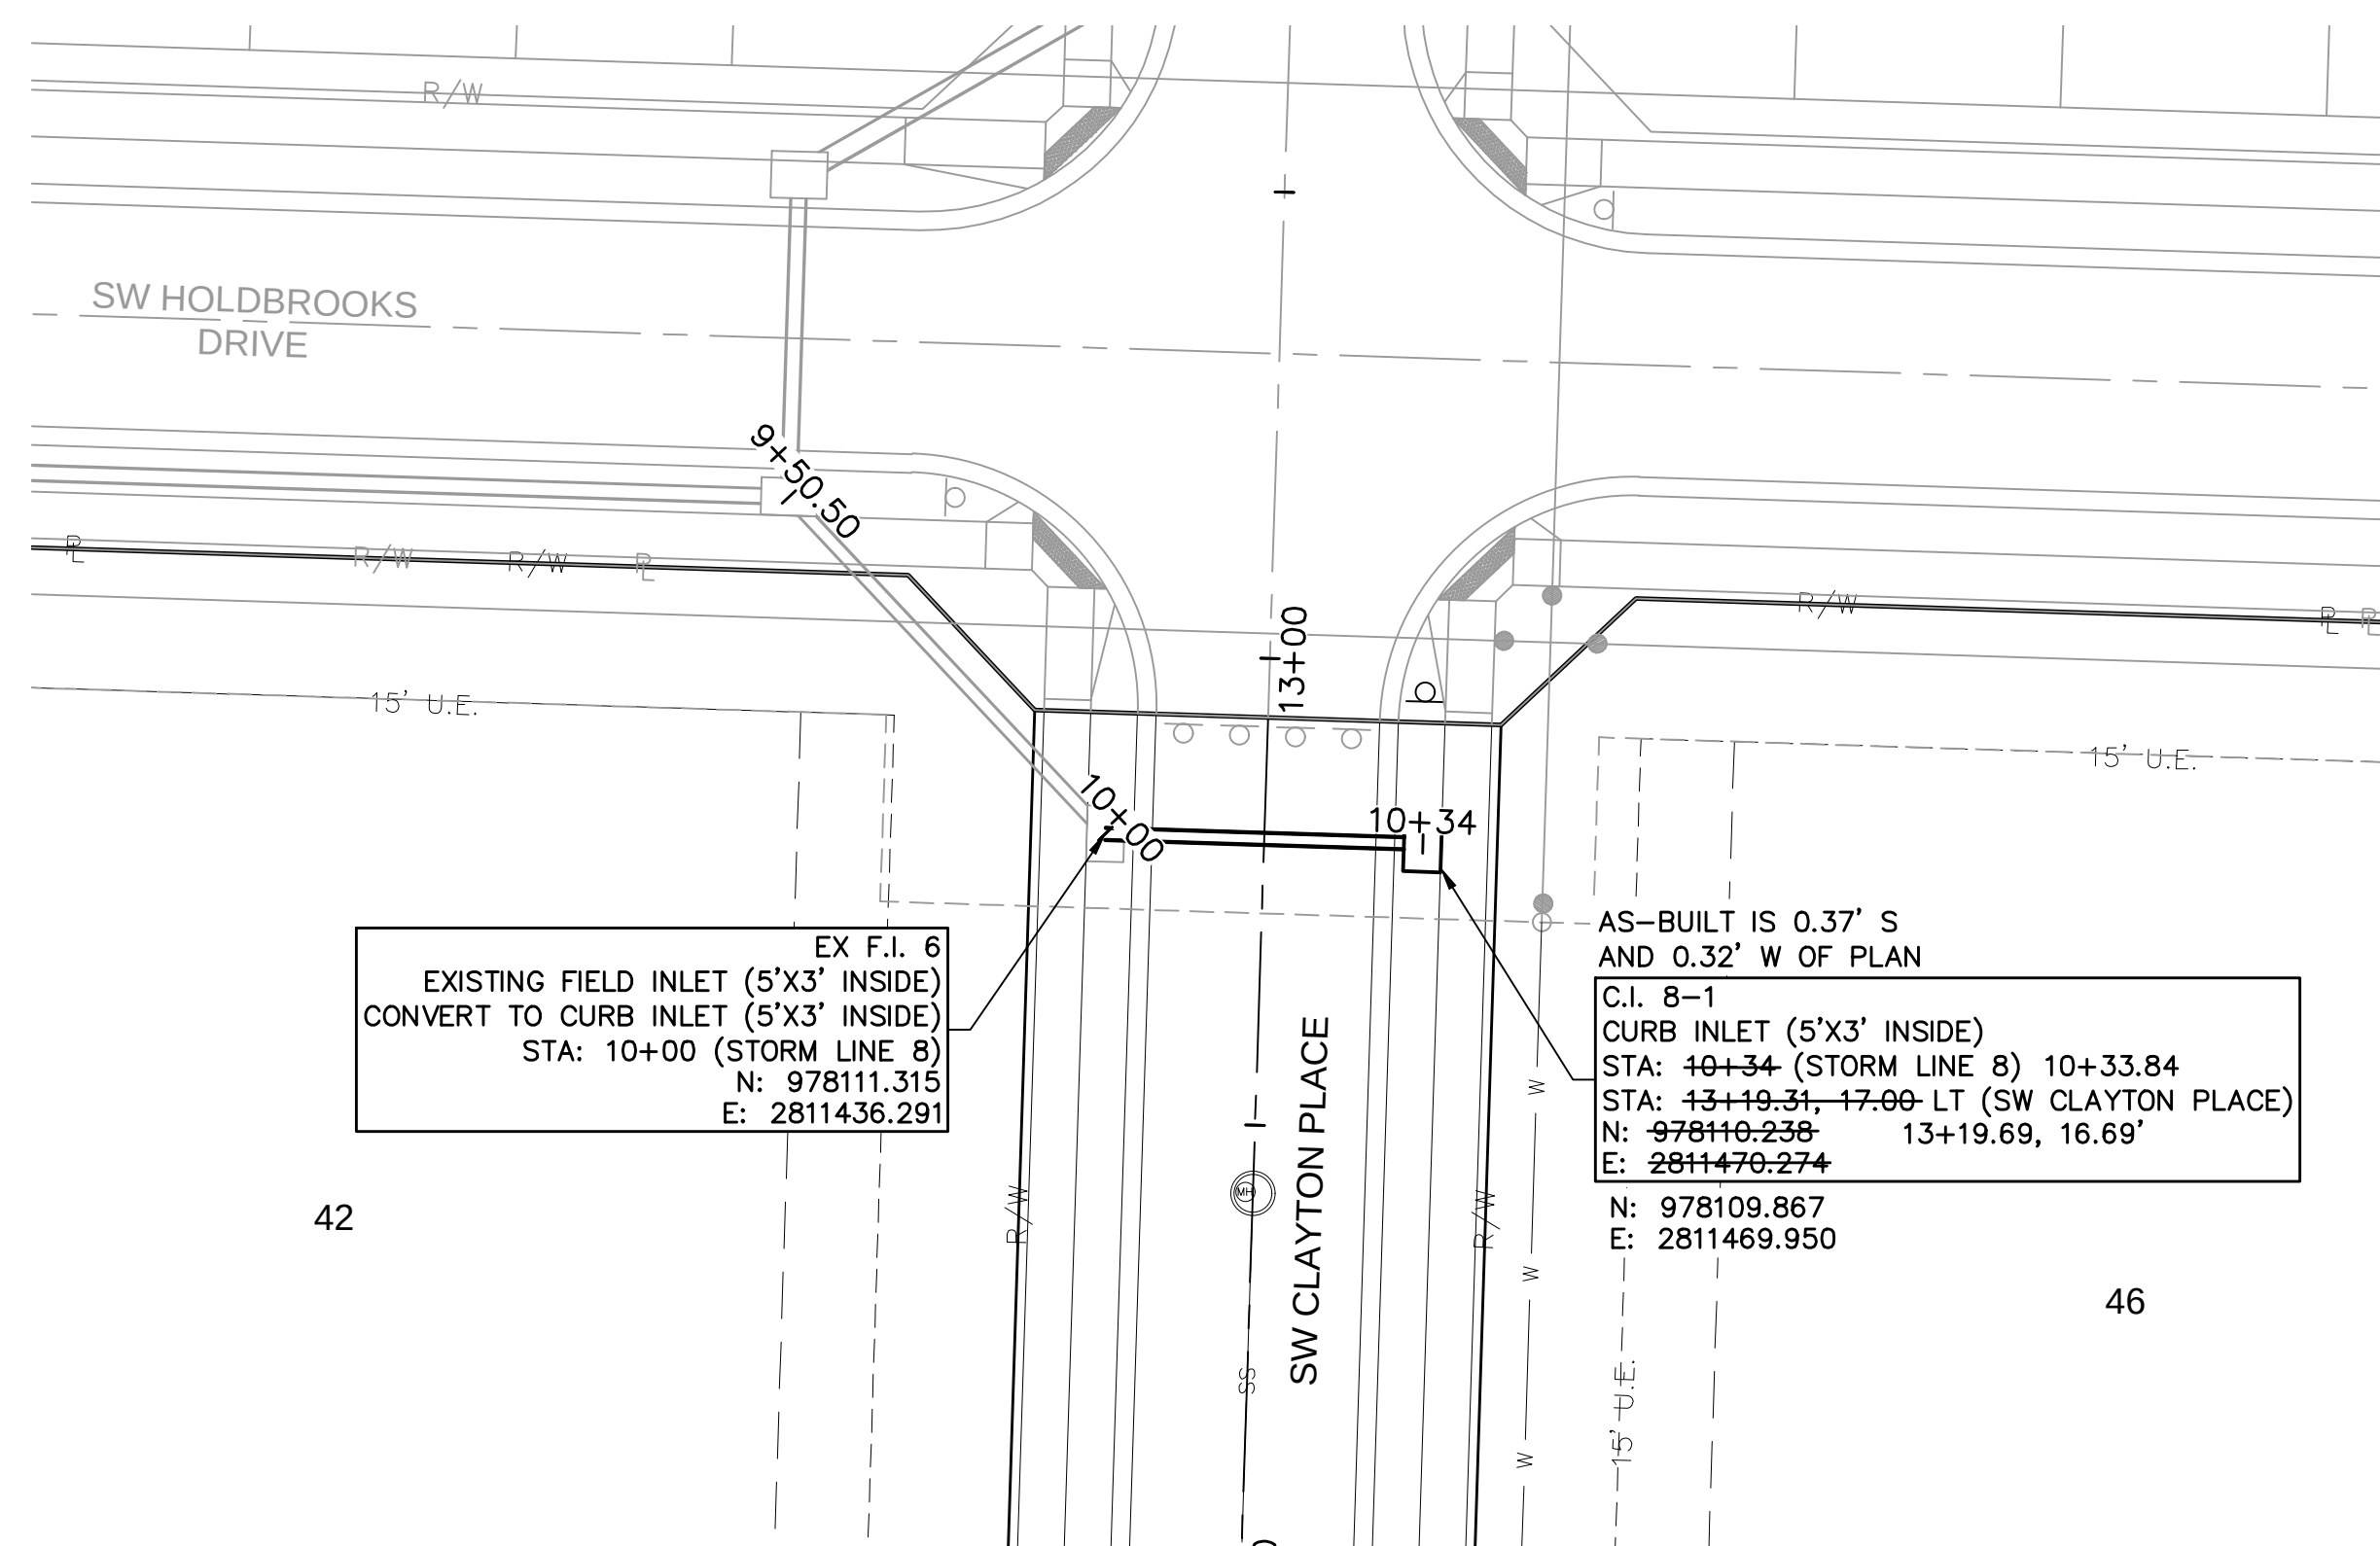

## AS-BUILT









DWG: F:\2019\2001-2500\019-2339-C140-Design\AutoCAD\Final Plans - As-Built\Sheets\GNC\A\STREET & STORM\A\_C\_DRW01\_C192339.dwg USER: asr/dor  
DATE: May 26, 2022 7:38am XREFS: C\_PBASE\_C192339 C\_PBLK\_C192339 C\_PSTRM\_C192339 C\_PSSWR\_C192339 C\_PWATR\_C192339

NOT AS-BUILT

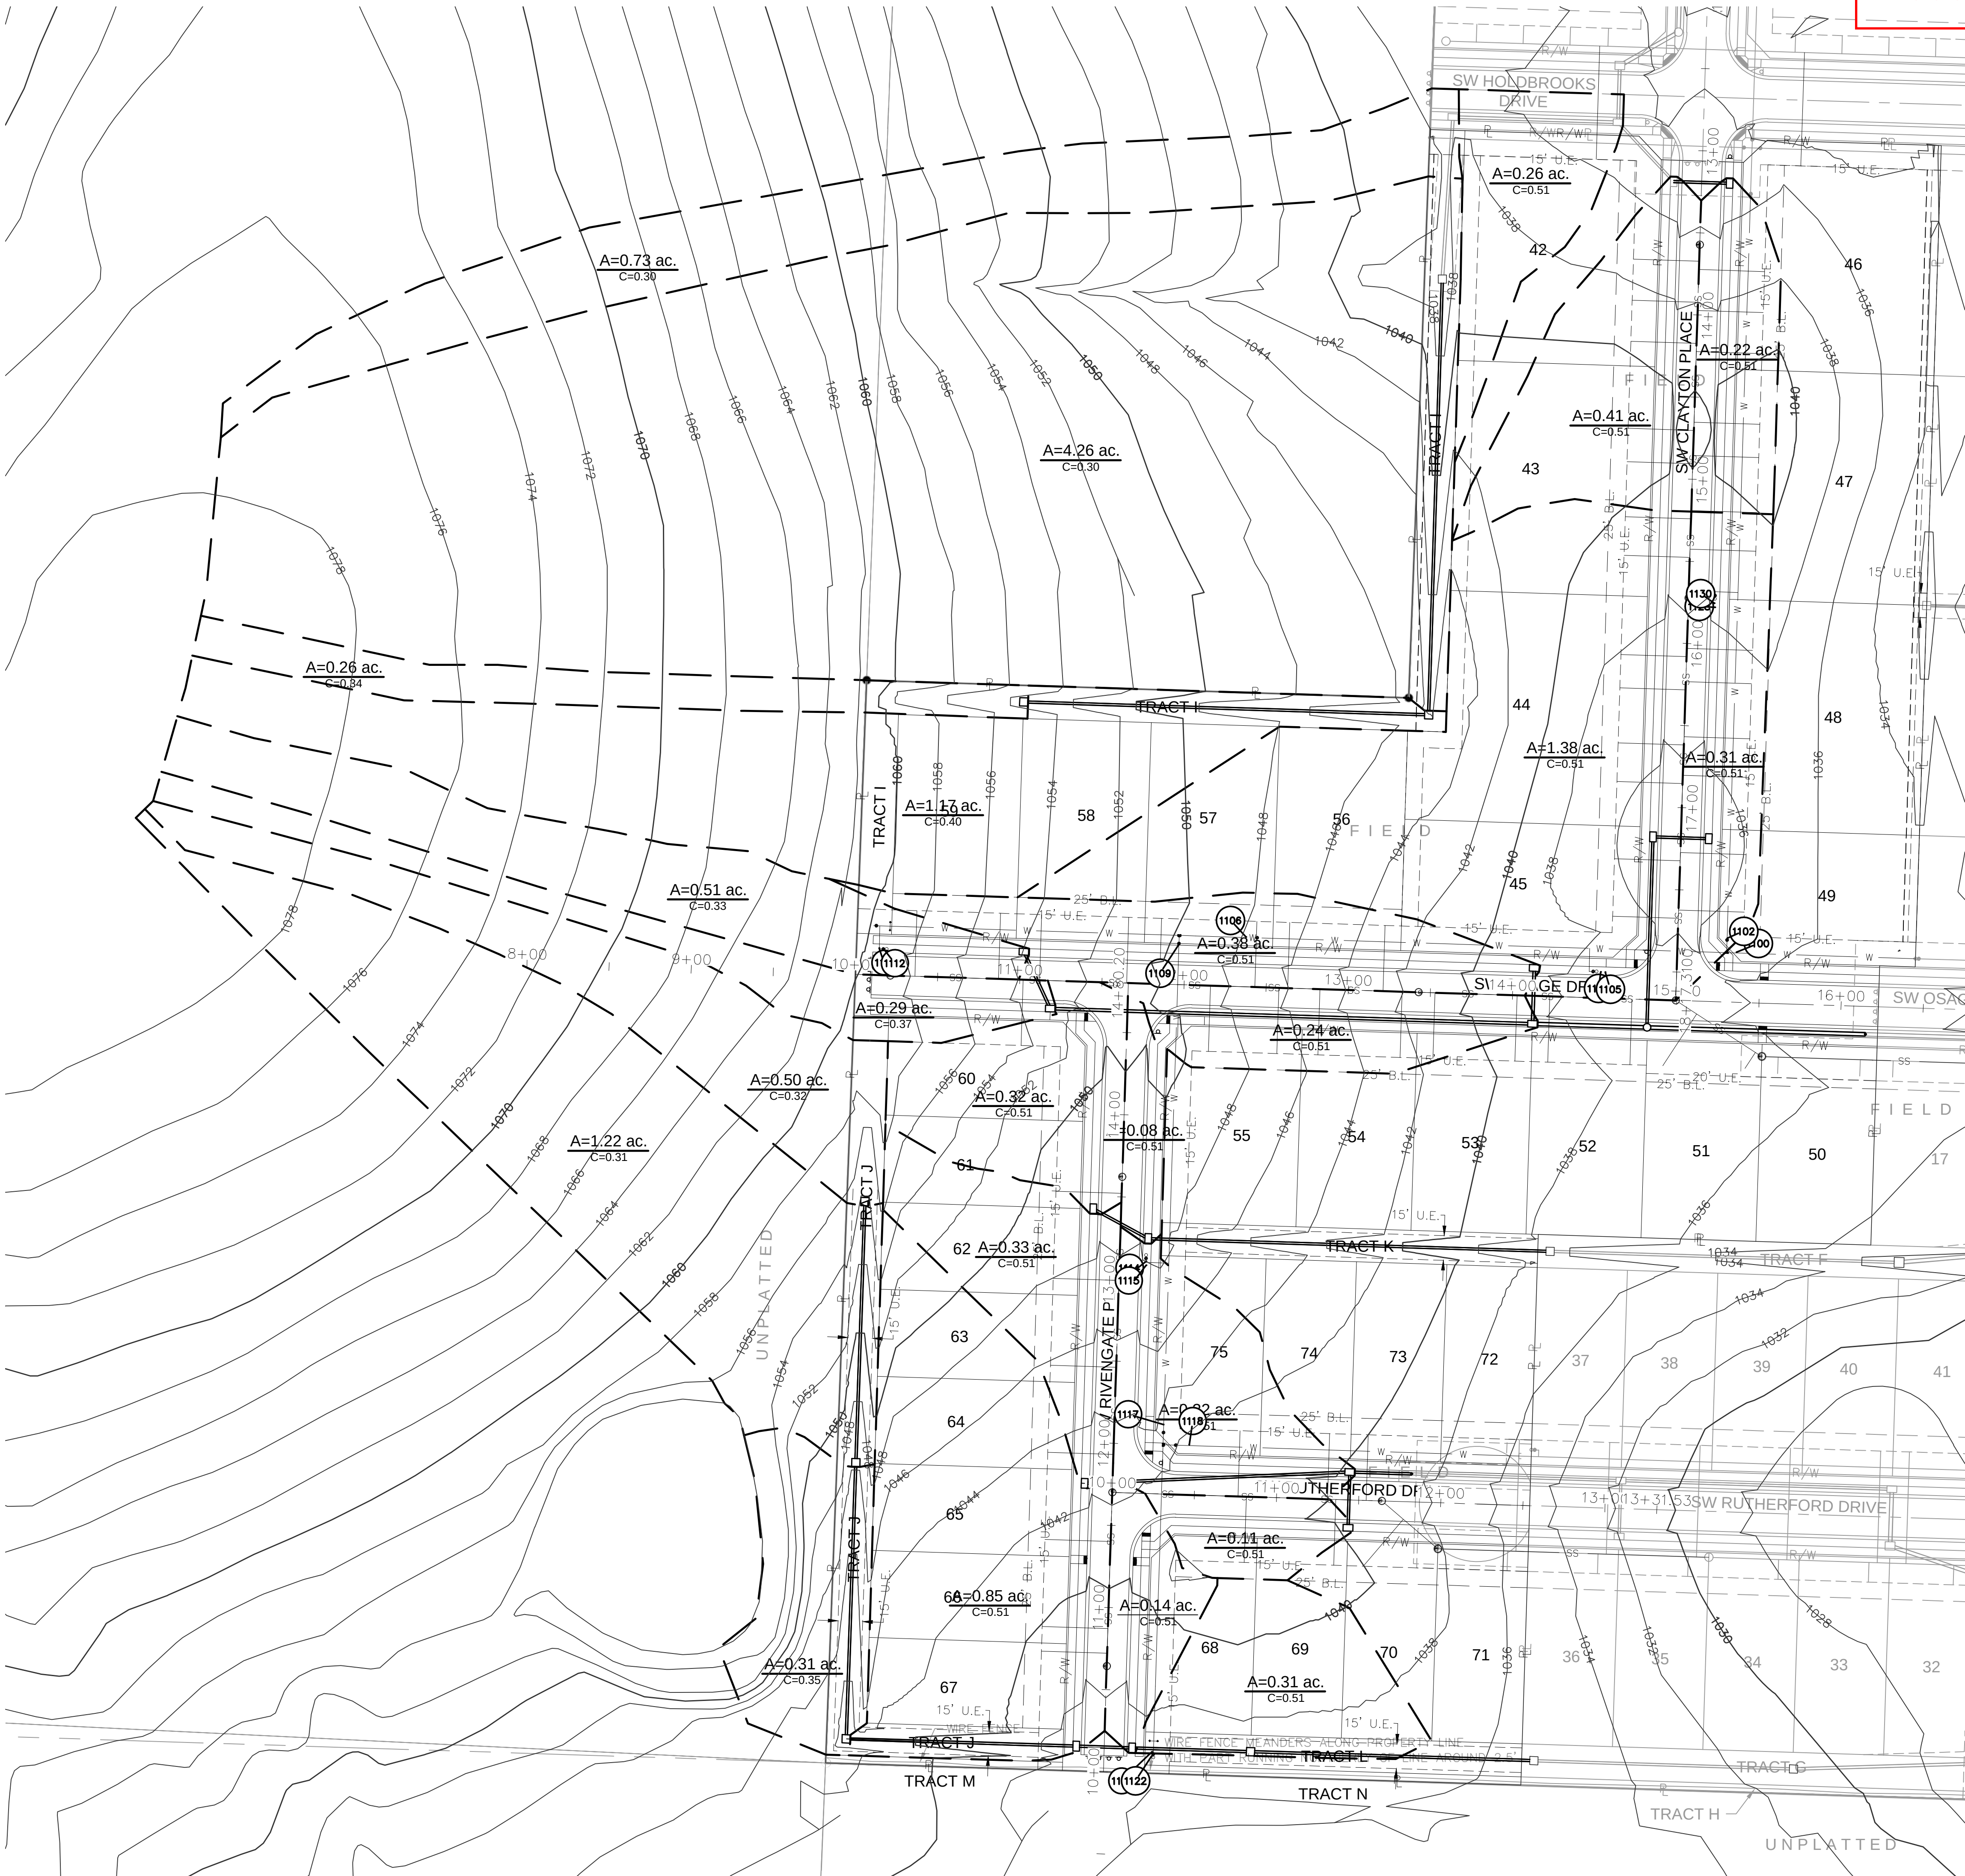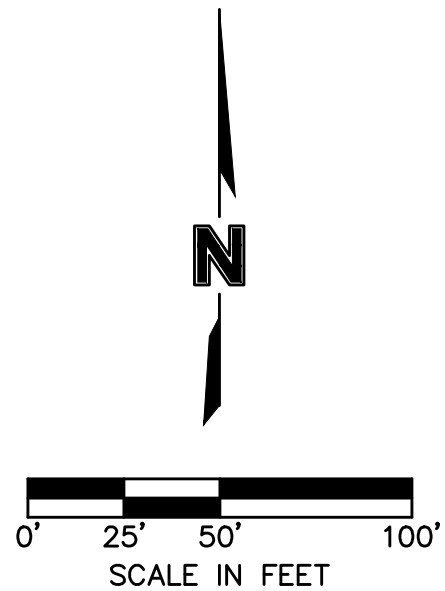

DRAINAGE PLAN  
STREET & STORM SEWER PLANS  
OSAGE  
SECOND PLAT

drawn by: D.F./M.O./A.A.  
checked by: C.G.W.  
designed by: A.A.  
QA/QC by: J.E.S.  
project no.: C19-2339  
drawing no.:  
date: 2022.05.26

SHEET  
C127


REVISIONS DESCRIPTION

DATE

REV. NO.

REVISIONS

2020

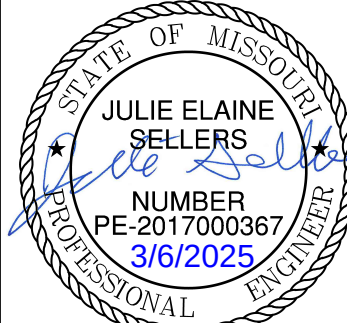

olsson

Olsson - Civil Engineering  
Missouri Certificate of Authority #: 001592  
1301 Burlington Street  
North Kansas City, MO 64116  
TEL 816.361.1177  
www.olson.com

Record Drawing



DWG: F:\2019\2001-2500\019-2339-C\40-Design\AutoCAD\Final Plans - As-Built\Sheets\GNC\A STREET & STORM\A\_C\_DRW01\_C192339.dwg USER: ssn/dor  
DATE: Mar 06, 2025 10:35am XREFS: C:\BASE\_C192339 C:\PBASE\_C192339 C:\PBDN\_C192339 C:\PSTRM\_C192339 C:\PWATR\_C192339

| Inlet Design Table                                                                                                                                  |               |             |                           |              |               |               |
|-----------------------------------------------------------------------------------------------------------------------------------------------------|---------------|-------------|---------------------------|--------------|---------------|---------------|
| 10 Year Return Frequency                                                                                                                            |               |             |                           |              |               |               |
| Inlet ID                                                                                                                                            | Captured Flow | Bypass Flow | Inlet Efficiency (Note 2) | Gutter Depth | Gutter Spread | Ponding Depth |
|                                                                                                                                                     | (cfs)         | (cfs)       | (%)                       | (ft)         | (ft)          | (ft)          |
| C.I. 1-2                                                                                                                                            | 0.80          | 0.10        | 88.43%                    | 0.10         | 5.13          | ...           |
| C.I. 1-3                                                                                                                                            | 0.69          | 0.10        | 86.80%                    | 0.09         | 4.57          | ...           |
| C.I. 1-4                                                                                                                                            | 0.98          | 0.27        | 78.25%                    | 0.11         | 5.30          | ...           |
| C.I. 2-1(L)                                                                                                                                         | ...           | ...         | ...                       | 0.11         | 5.50          | ...           |
| C.I. 2-1(R)                                                                                                                                         | ...           | ...         | ...                       | 0.14         | 7.10          | ...           |
| C.I. 2-1                                                                                                                                            | 5.18          | 0.00        | 100.00%                   | ...          | ...           | ...           |
| C.I. 2-2(L)                                                                                                                                         | ...           | ...         | ...                       | 0.05         | 2.34          | ...           |
| C.I. 2-2(R)                                                                                                                                         | ...           | ...         | ...                       | 0.09         | 4.71          | ...           |
| C.I. 2-2                                                                                                                                            | 1.16          | 0.00        | 100.00%                   | ...          | ...           | ...           |
| C.I. 3-1                                                                                                                                            | 0.29          | 0.01        | 97.21%                    | 0.07         | 3.52          | ...           |
| C.I. 3-2                                                                                                                                            | 1.15          | 0.15        | 88.48%                    | 0.13         | 6.52          | ...           |
| C.I. 4-1                                                                                                                                            | 1.05          | 0.15        | 87.26%                    | 0.12         | 6.05          | ...           |
| C.I. 4-2                                                                                                                                            | 1.11          | 0.28        | 80.00%                    | 0.12         | 5.82          | ...           |
| C.I. 5-1                                                                                                                                            | 0.40          | 0.02        | 96.15%                    | 0.08         | 4.04          | ...           |
| F.I. 6-1                                                                                                                                            | 1.16          | 0.00        | 100.00%                   | ...          | ...           | 0.08          |
| C.I. 6-2                                                                                                                                            | 0.54          | 0.03        | 95.46%                    | 0.10         | 4.76          | ...           |
| C.I. 6-3                                                                                                                                            | 2.41          | 0.90        | 72.75%                    | 0.19         | 9.25          | ...           |
| F.I. 6-4                                                                                                                                            | 0.81          | 0.00        | 100.00%                   | ...          | ...           | 0.06          |
| F.I. 6-5                                                                                                                                            | 2.47          | 0.00        | 100.00%                   | ...          | ...           | 0.13          |
| F.I. 6-6                                                                                                                                            | 1.18          | 0.00        | 100.00%                   | ...          | ...           | 0.08          |
| F.I. 7-1                                                                                                                                            | 2.92          | 0.00        | 100.00%                   | ...          | ...           | 0.15          |
| F.I. 7-2                                                                                                                                            | 0.65          | 0.00        | 100.00%                   | ...          | ...           | 0.05          |
| C.I. 8-1                                                                                                                                            | 0.78          | 0.05        | 94.15%                    | 0.11         | 5.75          | ...           |
| C.I. 9-1                                                                                                                                            | 1.34          | 0.36        | 78.82%                    | 0.13         | 6.51          | ...           |
| Notes:                                                                                                                                              |               |             |                           |              |               |               |
| 1. Inlet capacity at sag location has been reduced by a clogging factor of 0.80, reducing Both theoretical capacity and reduced capacity are shown. |               |             |                           |              |               |               |
| 2. Inlet efficiency shown in the tables is Captured Flow/Total Flow, denoting the actual                                                            |               |             |                           |              |               |               |

| Drainage Area Design Table |               |      |       |         |      |           |
|----------------------------|---------------|------|-------|---------|------|-----------|
| 10 Year Return Frequency   |               |      |       |         |      |           |
| Inlet ID                   | Drainage Area | C    | Tc    | i       | K    | Peak Flow |
|                            | (ac)          |      | (min) | (in/hr) |      | (cfs)     |
| C.I. 1-2                   | 0.24          | 0.51 | 5.00  | 7.35    | 1.00 | 0.90      |
| C.I. 1-3                   | 0.29          | 0.51 | 5.00  | 7.35    | 1.00 | 0.79      |
| C.I. 1-4                   | 0.51          | 0.37 | 5.00  | 7.35    | 1.00 | 1.25      |
| C.I. 2-1(L)                | 0.10          | 0.33 | 5.00  | 7.35    | 1.00 | 0.38      |
| C.I. 2-1(R)                | 0.45          | 0.51 | 5.00  | 7.35    | 1.00 | 1.69      |
| C.I. 2-1(B)                | 0.83          | 0.51 | 5.00  | 7.35    | 1.00 | 3.11      |
| C.I. 2-1                   | 1.38          | 0.51 | 5.00  | 7.35    | 1.00 | 5.18      |
| C.I. 2-2(L)                | 0.02          | 0.51 | 5.00  | 7.35    | 1.00 | 0.08      |
| C.I. 2-2(R)                | 0.15          | 0.51 | 5.00  | 7.35    | 1.00 | 0.56      |
| C.I. 2-2(B)                | 0.14          | 0.51 | 5.00  | 7.35    | 1.00 | 0.53      |
| C.I. 2-2                   | 0.31          | 0.51 | 5.00  | 7.35    | 1.00 | 1.16      |
| C.I. 3-1                   | 0.08          | 0.51 | 5.00  | 7.35    | 1.00 | 0.30      |
| C.I. 3-2                   | 0.32          | 0.51 | 5.00  | 7.35    | 1.00 | 1.20      |
| C.I. 4-1                   | 0.32          | 0.51 | 5.00  | 7.35    | 1.00 | 1.20      |
| C.I. 4-2                   | 0.33          | 0.51 | 5.00  | 7.35    | 1.00 | 1.24      |
| C.I. 5-1                   | 0.11          | 0.51 | 5.00  | 7.35    | 1.00 | 0.41      |
| F.I. 6-1                   | 0.31          | 0.51 | 5.00  | 7.35    | 1.00 | 1.16      |
| C.I. 6-2                   | 0.15          | 0.51 | 5.00  | 7.35    | 1.00 | 0.56      |
| C.I. 6-3                   | 0.86          | 0.51 | 6.49  | 6.92    | 1.00 | 3.03      |
| F.I. 6-4                   | 0.31          | 0.51 | 5.00  | 7.35    | 1.00 | 0.81      |
| F.I. 6-5                   | 1.22          | 0.35 | 8.31  | 6.46    | 1.00 | 2.47      |
| F.I. 6-6                   | 0.50          | 0.31 | 5.00  | 7.35    | 1.00 | 1.18      |
| F.I. 7-1                   | 1.17          | 0.32 | 9.16  | 6.26    | 1.00 | 2.92      |
| F.I. 7-2                   | 0.26          | 0.40 | 5.00  | 7.35    | 1.00 | 0.65      |
| C.I. 8-1                   | 0.22          | 0.34 | 5.00  | 7.35    | 1.00 | 0.83      |
| C.I. 9-1                   | 0.38          | 0.51 | 5.00  | 7.35    | 1.00 | 1.43      |

| Storm Sewer Design Calculation Table |                      |             |                      |                        |           |               |             |                  |                 |                |                 |                           |                         |
|--------------------------------------|----------------------|-------------|----------------------|------------------------|-----------|---------------|-------------|------------------|-----------------|----------------|-----------------|---------------------------|-------------------------|
| 10 Year Return Frequency             |                      |             |                      |                        |           |               |             |                  |                 |                |                 |                           |                         |
| Upstream Structure                   | Downstream Structure | Length (ft) | Upstream Invert (ft) | Downstream Invert (ft) | Slope (%) | Diameter (in) | Manning's n | Total Flow (cfs) | Velocity (ft/s) | Capacity (cfs) | Flow Depth (ft) | Upstream Struct. HGL (ft) | Upstream Top Elev. (ft) |
| CONNECT TO EX. 1                     | EX C.I. 2            | 113.85      | 1026.43              | 1024.72                | 1.50      | 24            | 0.010       | 10.15            | 9.85            | 36.04          | 1.14            | 1027.57                   | 1028.70                 |
| M.H. 1-1                             | CONNECT TO EX. 1     | 132.88      | 1028.42              | 1026.43                | 1.50      | 24            | 0.010       | 10.15            | 5.49            | 36.01          | 1.14            | 1029.56                   | 1037.06                 |
| C.I. 1-2                             | M.H. 1-1             | 69.62       | 1029.96              | 1028.92                | 1.49      | 24            | 0.010       | 3.81             | 4.38            | 35.94          | 0.68            | 1030.64                   | 1038.65                 |
| C.I. 1-3                             | C.I. 1-2             | 293.62      | 1044.65              | 1030.46                | 4.83      | 18            | 0.010       | 1.67             | 9.12            | 30.01          | 0.49            | 1045.14                   | 1053.11                 |
| C.I. 1-4                             | C.I. 1-3             | 38.03       | 1046.10              | 1045.15                | 2.50      | 15            | 0.010       | 0.98             | 6.31            | 13.27          | 0.39            | 1046.49                   | 1053.96                 |
| C.I. 2-1                             | M.H. 1-1             | 116.00      | 1030.33              | 1029.17                | 1.00      | 15            | 0.010       | 6.34             | 7.51            | 8.39           | 1.01            | 1031.35                   | 1035.61                 |
| C.I. 2-2                             | C.I. 2-1             | 34.00       | 1031.17              | 1030.83                | 1.00      | 15            | 0.010       | 1.16             | 2.43            | 8.40           | 0.42            | 1031.59                   | 1035.61                 |
| C.I. 9-1                             | C.I. 1-2             | 33.81       | 1030.47              | 1030.37                | 0.30      | 18            | 0.010       | 1.34             | 3.18            | 7.42           | 0.43            | 1030.90                   | 1038.65                 |
| EX F.I. 4                            | EX F.I. 3            | 212.50      | 1030.50              | 1024.98                | 2.60      | 15            | 0.010       | 1.45             | 7.18            | 13.53          | 0.48            | 1030.98                   | 1037.27                 |
| C.I. 3-1                             | EX F.I. 4            | 244.62      | 1040.79              | 1031.00                | 4.00      | 15            | 0.010       | 1.45             | 8.37            | 16.79          | 0.48            | 1041.27                   | 1048.45                 |
| C.I. 3-2                             | C.I. 3-1             | 38.04       | 1041.85              | 1041.28                | 1.50      | 15            | 0.010       | 1.15             | 5.53            | 10.28          | 0.42            | 1042.27                   | 1048.84                 |
| EX F.I. 2                            | EX F.I. 1            | 158.03      | 1027.56              | 1022.82                | 3.00      | 15            | 0.010       | 8.57             | 12.33           | 14.54          | 1.14            | 1028.70                   | 1036.37                 |
| F.I. 6-1                             | EX F.I. 2            | 172.50      | 1030.04              | 1028.06                | 1.15      | 15            | 0.010       | 8.57             | 8.34            | 8.99           | 1.14            | 1031.18                   | 1038.17                 |
| C.I. 6-2                             | F.I. 6-1             | 72.11       | 1031.26              | 1030.54                | 1.00      | 15            | 0.010       | 7.41             | 7.71            | 8.39           | 1.08            | 1032.34                   | 1037.50                 |
| C.I. 6-3                             | C.I. 6-2             | 34.00       | 1032.10              | 1031.76                | 1.00      | 15            | 0.010       | 6.87             | 7.63            | 8.39           | 1.05            | 1033.15                   | 1037.50                 |
| F.I. 6-4                             | C.I. 6-3             | 140.01      | 1034.00              | 1032.60                | 1.00      | 15            | 0.010       | 4.46             | 6.94            | 8.39           | 0.86            | 1034.86                   | 1042.09                 |
| F.I. 6-5                             | F.I. 6-4             | 168.17      | 1038.70              | 1034.50                | 2.50      | 15            | 0.010       | 3.65             | 9.22            | 13.27          | 0.77            | 1039.47                   | 1047.22                 |
| F.I. 6-6                             | F.I. 6-5             | 158.97      | 1045.56              | 1039.20                | 4.00      | 15            | 0.010       | 1.18             | 6.02            | 16.79          | 0.43            | 1045.99                   | 1054.84                 |
| EX F.I. 5                            | EX C.I. 5            | 98.76       | 1031.25              | 1030.26                | 1.00      | 18            | 0.010       | 3.57             | 6.50            | 13.67          | 0.72            | 1031.97                   | 1037.71                 |
| F.I. 7-1                             | EX F.I. 5            | 265.34      | 1037.06              | 1031.75                | 2.00      | 15            | 0.010       | 3.57             | 8.46            | 11.88          | 0.76            | 1037.82                   | 1045.01                 |
| F.I. 7-2                             | F.I. 7-1             | 246.48      | 1045.57              | 1037.56                | 3.25      | 15            | 0.010       | 0.65             | 3.48            | 15.13          | 0.31            | 1045.89                   | 1054.58                 |
| CONNECT TO EX. 2                     | EX C.I. 1            | 127.46      | 1030.64              | 1024.27                | 5.00      | 15            | 0.010       | 2.69             | 10.84           | 18.77          | 0.66            | 1031.30                   | 1032.33                 |
| C.I. 4-1                             | CONNECT TO EX. 2     | 37.54       | 1032.52              | 1030.64                | 5.01      | 15            | 0.010       | 2.69             | 4.11            | 18.79          | 0.66            | 1033.18                   | 1039.86                 |
| C.I. 4-2                             | C.I. 4-1             | 161.56      | 1034.64              | 1033.02                | 1.00      | 15            | 0.010       | 1.24             | 4.90            | 8.41           | 0.44            | 1035.08                   | 1042.63                 |
| C.I. 5-1                             | C.I. 4-1             | 34.00       | 1033.36              | 1033.02                | 1.00      | 15            | 0.010       | 0.40             | 3.51            | 8.39           | 0.25            | 1033.61                   | 1039.86                 |
| EX C.I. 4                            | EX C.I. 3            | 49.50       | 1029.25              | 1028.76                | 0.99      | 15            | 0.010       | 0.78             | 4.26            | 8.35           | 0.35            | 1029.60                   | 1035.32                 |
| C.I. 8-1                             | EX C.I. 4            | 34.00       | 1030.09              | 1029.75                | 1.00      | 15            | 0.010       | 0.78             | 4.27            | 8.39           | 0.35            | 1030.44                   | 1035.33                 |




| Inlet Design Table                                                                                                                                  |               |             |                           |              |               |               |
|-----------------------------------------------------------------------------------------------------------------------------------------------------|---------------|-------------|---------------------------|--------------|---------------|---------------|
| 100 Year Return Frequency                                                                                                                           |               |             |                           |              |               |               |
| Inlet ID                                                                                                                                            | Captured Flow | Bypass Flow | Inlet Efficiency (Note 2) | Gutter Depth | Gutter Spread | Ponding Depth |
|                                                                                                                                                     | (cfs)         | (cfs)       | (%)                       | (ft)         | (ft)          | (ft)          |
| C.I. 1-2                                                                                                                                            | 1.27          | 0.31        | 80.14%                    | 0.13         | 6.34          | ...           |
| C.I. 1-3                                                                                                                                            | 1.08          | 0.31        | 77.66%                    | 0.11         | 5.64          | ...           |
| C.I. 1-4                                                                                                                                            | 1.43          | 0.76        | 65.42%                    | 0.13         | 6.55          | ...           |
| C.I. 2-1(L)                                                                                                                                         | ...           | ...         | ...                       | 0.16         | 7.76          | ...           |
| C.I. 2-1(R)                                                                                                                                         | ...           | ...         | ...                       | 0.18         | 8.77          | ...           |
| C.I. 2-1                                                                                                                                            | 9.08          | 0.00        | 100.00%                   | ...          | ...           | ...           |
| C.I. 2-2(L)                                                                                                                                         | ...           | ...         | ...                       | 0.06         | 2.89          | ...           |
| C.I. 2-2(R)                                                                                                                                         | ...           | ...         | ...                       | 0.12         | 5.81          | ...           |
| C.I. 2-2                                                                                                                                            | 2.04          | 0.00        | 100.00%                   | ...          | ...           | ...           |
| C.I. 3-1                                                                                                                                            | 0.50          | 0.03        | 94.35%                    | 0.09         | 4.34          | ...           |
| C.I. 3-2                                                                                                                                            | 1.92          | 0.50        | 79.24%                    | 0.16         | 8.22          | ...           |
| C.I. 4-1                                                                                                                                            | 1.67          | 0.46        | 78.23%                    | 0.15         | 7.49          | ...           |
| C.I. 4-2                                                                                                                                            | 1.75          | 0.92        | 65.42%                    | 0.15         | 7.44          | ...           |
| C.I. 5-1                                                                                                                                            | 0.67          | 0.05        | 92.55%                    | 0.10         | 4.99          | ...           |
| F.I. 6-1                                                                                                                                            | 2.04          | 0.00        | 100.00%                   | ...          | ...           | 0.11          |
| C.I. 6-2                                                                                                                                            | 0.90          | 0.08        | 91.39%                    | 0.12         | 5.88          | ...           |
| C.I. 6-3                                                                                                                                            | 3.51          | 2.75        | 56.02%                    | 0.24         | 11.75         | ...           |
| F.I. 6-4                                                                                                                                            | 1.42          | 0.00        | 100.00%                   | ...          | ...           | 0.09          |
| F.I. 6-5                                                                                                                                            | 4.36          | 0.00        | 100.00%                   | ...          | ...           | 0.19          |
| F.I. 6-6                                                                                                                                            | 2.07          | 0.00        | 100.00%                   | ...          | ...           | 0.12          |
| F.I. 7-1                                                                                                                                            | 5.16          | 0.00        | 100.00%                   | ...          | ...           | 0.21          |
| F.I. 7-2                                                                                                                                            | 1.14          | 0.00        | 100.00%                   | ...          | ...           | 0.08          |
| C.I. 8-1                                                                                                                                            | 1.29          | 0.16        | 89.23%                    | 0.14         | 7.10          | ...           |
| C.I. 9-1                                                                                                                                            | 2.08          | 1.18        | 63.82%                    | 0.17         | 8.31          | ...           |
| Notes:                                                                                                                                              |               |             |                           |              |               |               |
| 1. Inlet capacity at sag location has been reduced by a clogging factor of 0.80, reducing Both theoretical capacity and reduced capacity are shown. |               |             |                           |              |               |               |
| 2. Inlet efficiency shown in the tables is Captured Flow/Total Flow, denoting the actual                                                            |               |             |                           |              |               |               |

| Drainage Area Design Table |               |      |       |         |      |           |
|----------------------------|---------------|------|-------|---------|------|-----------|
| 100 Year Return Frequency  |               |      |       |         |      |           |
| Inlet ID                   | Drainage Area | C    | Tc    | i       | K    | Peak Flow |
|                            | (ac)          |      | (min) | (in/hr) |      | (cfs)     |
| C.I. 1-2                   | 0.24          | 0.51 | 5.00  | 10.32   | 1.25 | 1.58      |
| C.I. 1-3                   | 0.29          | 0.51 | 5.00  | 10.32   | 1.25 | 1.39      |
| C.I. 1-4                   | 0.51          | 0.37 | 5.00  | 10.32   | 1.25 | 2.19      |
| C.I. 2-1(L)                | 0.10          | 0.33 | 5.00  | 10.32   | 1.25 | 0.66      |
| C.I. 2-1(R)                | 0.45          | 0.51 | 5.00  | 10.32   | 1.25 | 2.96      |
| C.I. 2-1(B)                | 0.83          | 0.51 | 5.00  | 10.32   | 1.25 | 5.46      |
| C.I. 2-1                   | 1.38          | 0.51 | 5.00  | 10.32   | 1.25 | 9.08      |
| C.I. 2-2(L)                | 0.02          | 0.51 | 5.00  | 10.32   | 1.25 | 0.13      |
| C.I. 2-2(R)                | 0.15          | 0.51 | 5.00  | 10.32   | 1.25 | 0.99      |
| C.I. 2-2(B)                | 0.14          | 0.51 | 5.00  | 10.32   | 1.25 | 0.92      |
| C.I. 2-2                   | 0.31          | 0.51 | 5.00  | 10.32   | 1.25 | 2.04      |
| C.I. 3-1                   | 0.08          | 0.51 | 5.00  | 10.32   | 1.25 | 0.53      |
| C.I. 3-2                   | 0.32          | 0.51 | 5.00  | 10.32   | 1.25 | 2.11      |
| C.I. 4-1                   | 0.32          | 0.51 | 5.00  | 10.32   | 1.25 | 2.11      |
| C.I. 4-2                   | 0.33          | 0.51 | 5.00  | 10.32   | 1.25 | 2.17      |
| C.I. 5-1                   | 0.11          | 0.51 | 5.00  | 10.32   | 1.25 | 0.72      |
| F.I. 6-1                   | 0.31          | 0.51 | 5.00  | 10.32   | 1.25 | 2.04      |
| C.I. 6-2                   | 0.15          | 0.51 | 5.00  | 10.32   | 1.25 | 0.99      |
| C.I. 6-3                   | 0.86          | 0.51 | 6.49  | 9.74    | 1.25 | 5.34      |
| F.I. 6-4                   | 0.31          | 0.51 | 5.00  | 10.32   | 1.25 | 1.42      |
| F.I. 6-5                   | 1.22          | 0.35 | 8.31  | 9.11    | 1.25 | 4.36      |
| F.I. 6-6                   | 0.50          | 0.31 | 5.00  | 10.32   | 1.25 | 2.07      |
| F.I. 7-1                   | 1.17          | 0.32 | 9.16  | 8.84    | 1.25 | 5.16      |
| F.I. 7-2                   | 0.26          | 0.40 | 5.00  | 10.32   | 1.25 | 1.14      |
| C.I. 8-1                   | 0.22          | 0.34 | 5.00  | 10.32   | 1.25 | 1.45      |
| C.I. 9-1                   | 0.38          | 0.51 | 5.00  | 10.32   | 1.25 | 2.50      |







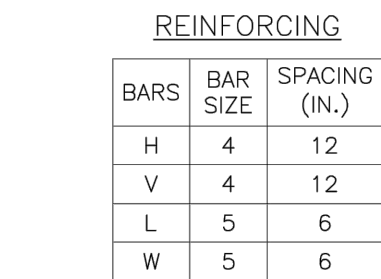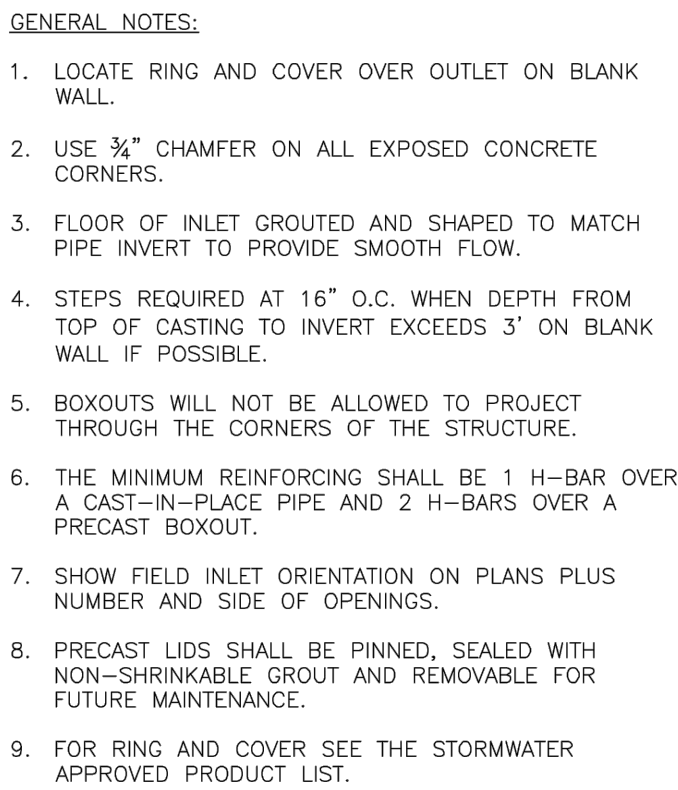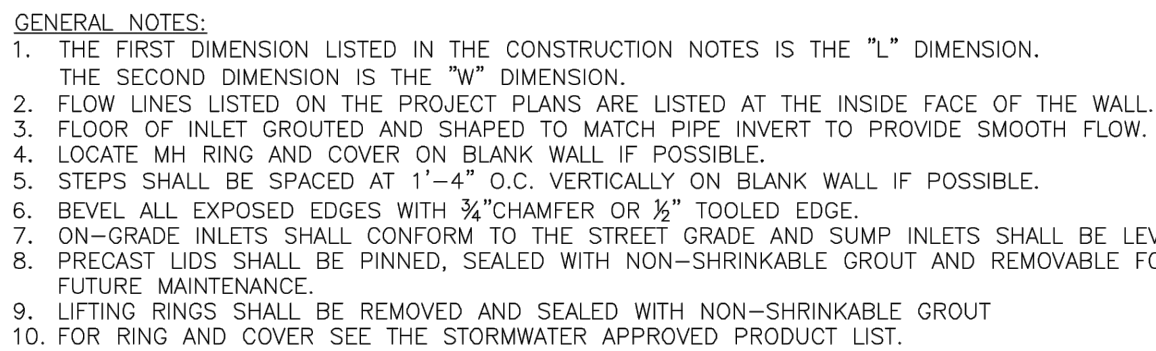

1. ALL MANHOLES ARE TO BE PRECAST CONCRETE AND OF ECCENTRIC CONE TYPE UNLESS OTHERWISE SPECIFIED.
2. MANHOLE TOP ADJUSTMENTS SHALL BE ACCOMPLISHED BY THE USE OF CONCRETE ADJUSTMENT RINGS.
3. TOP OF MANHOLE CASTING SHALL BE SET FLUSH AND ON SAME SLOPE AS FINISHED SURFACE OR AS DIRECTED BY THE ENGINEER.
4. REINFORCEMENT IN ALL SECTIONS SHALL EQUAL OR EXCEED A.S.T.M. C-478 SPECIFICATIONS.
5. THE ENGINEER SHALL DESIGNATE MODIFICATIONS FOR MANHOLES WITH SPECIAL DESIGNS.
6. THE INSIDE DIAMETER OF THE MANHOLE SHALL BE 4'-0" FOR PIPE DIAMETERS FROM 12" THRU 24", 5'-0" FOR PIPE DIAMETERS FROM 27" THRU 36", AND 6'-0" FOR PIPE DIAMETERS 42" THRU 48".
7. CLEARANCE TOLERANCE OF PIPE OPENINGS: THE MAXIMUM ALLOWABLE PIPE OPENING ON A HORIZONTAL AXIS SHALL BE THE OUTSIDE DIAMETER OF THE PIPE PLUS 12". THE MAXIMUM ALLOWABLE PIPE OPENING ON VERTICAL AXIS SHALL BE THE OUTSIDE DIAMETER PLUS 8". THE MAXIMUM CLEARANCE BETWEEN THE OUTSIDE SURFACE OF AN INSTALLED PIPE AND THE CONCRETE OF THE MANHOLE SHALL BE 2".
8. INSTALLATION OF PIPE OPENINGS: ALL REQUIRED PIPE OPENINGS SHALL BE PLANT CAST IN MANHOLE UNITS. FIELD ALTERATIONS OF OPENINGS WILL BE PERMITTED PROVIDED WALLS ARE SCORED WITH A MASONRY SAW TO A DEPTH SUFFICIENT TO SEVER REINFORCING STEEL. A CHIPPING HAMMER MAY THEN BE USED TO REMOVE THE CONCRETE. MINIMUM DISTANCE BETWEEN ANY TWO ADJACENT PIPES SHALL BE 2".
9. NO DIRECT PAYMENT FOR SHAPING FLOOR OR CONNECTING PIPES AS SHOWN ON PLANS.
10. RING AND COVER TO BE NEEHAN R-1736, CLAY & BAILEY #2008, DEETER # 1316, OR APPROVED EQUAL. (CASTING MAY VARY BY MUNICIPALITY, REFER TO PLANS & CONTRACT DOCUMENTS.)

# NOT AS-BUILT



