


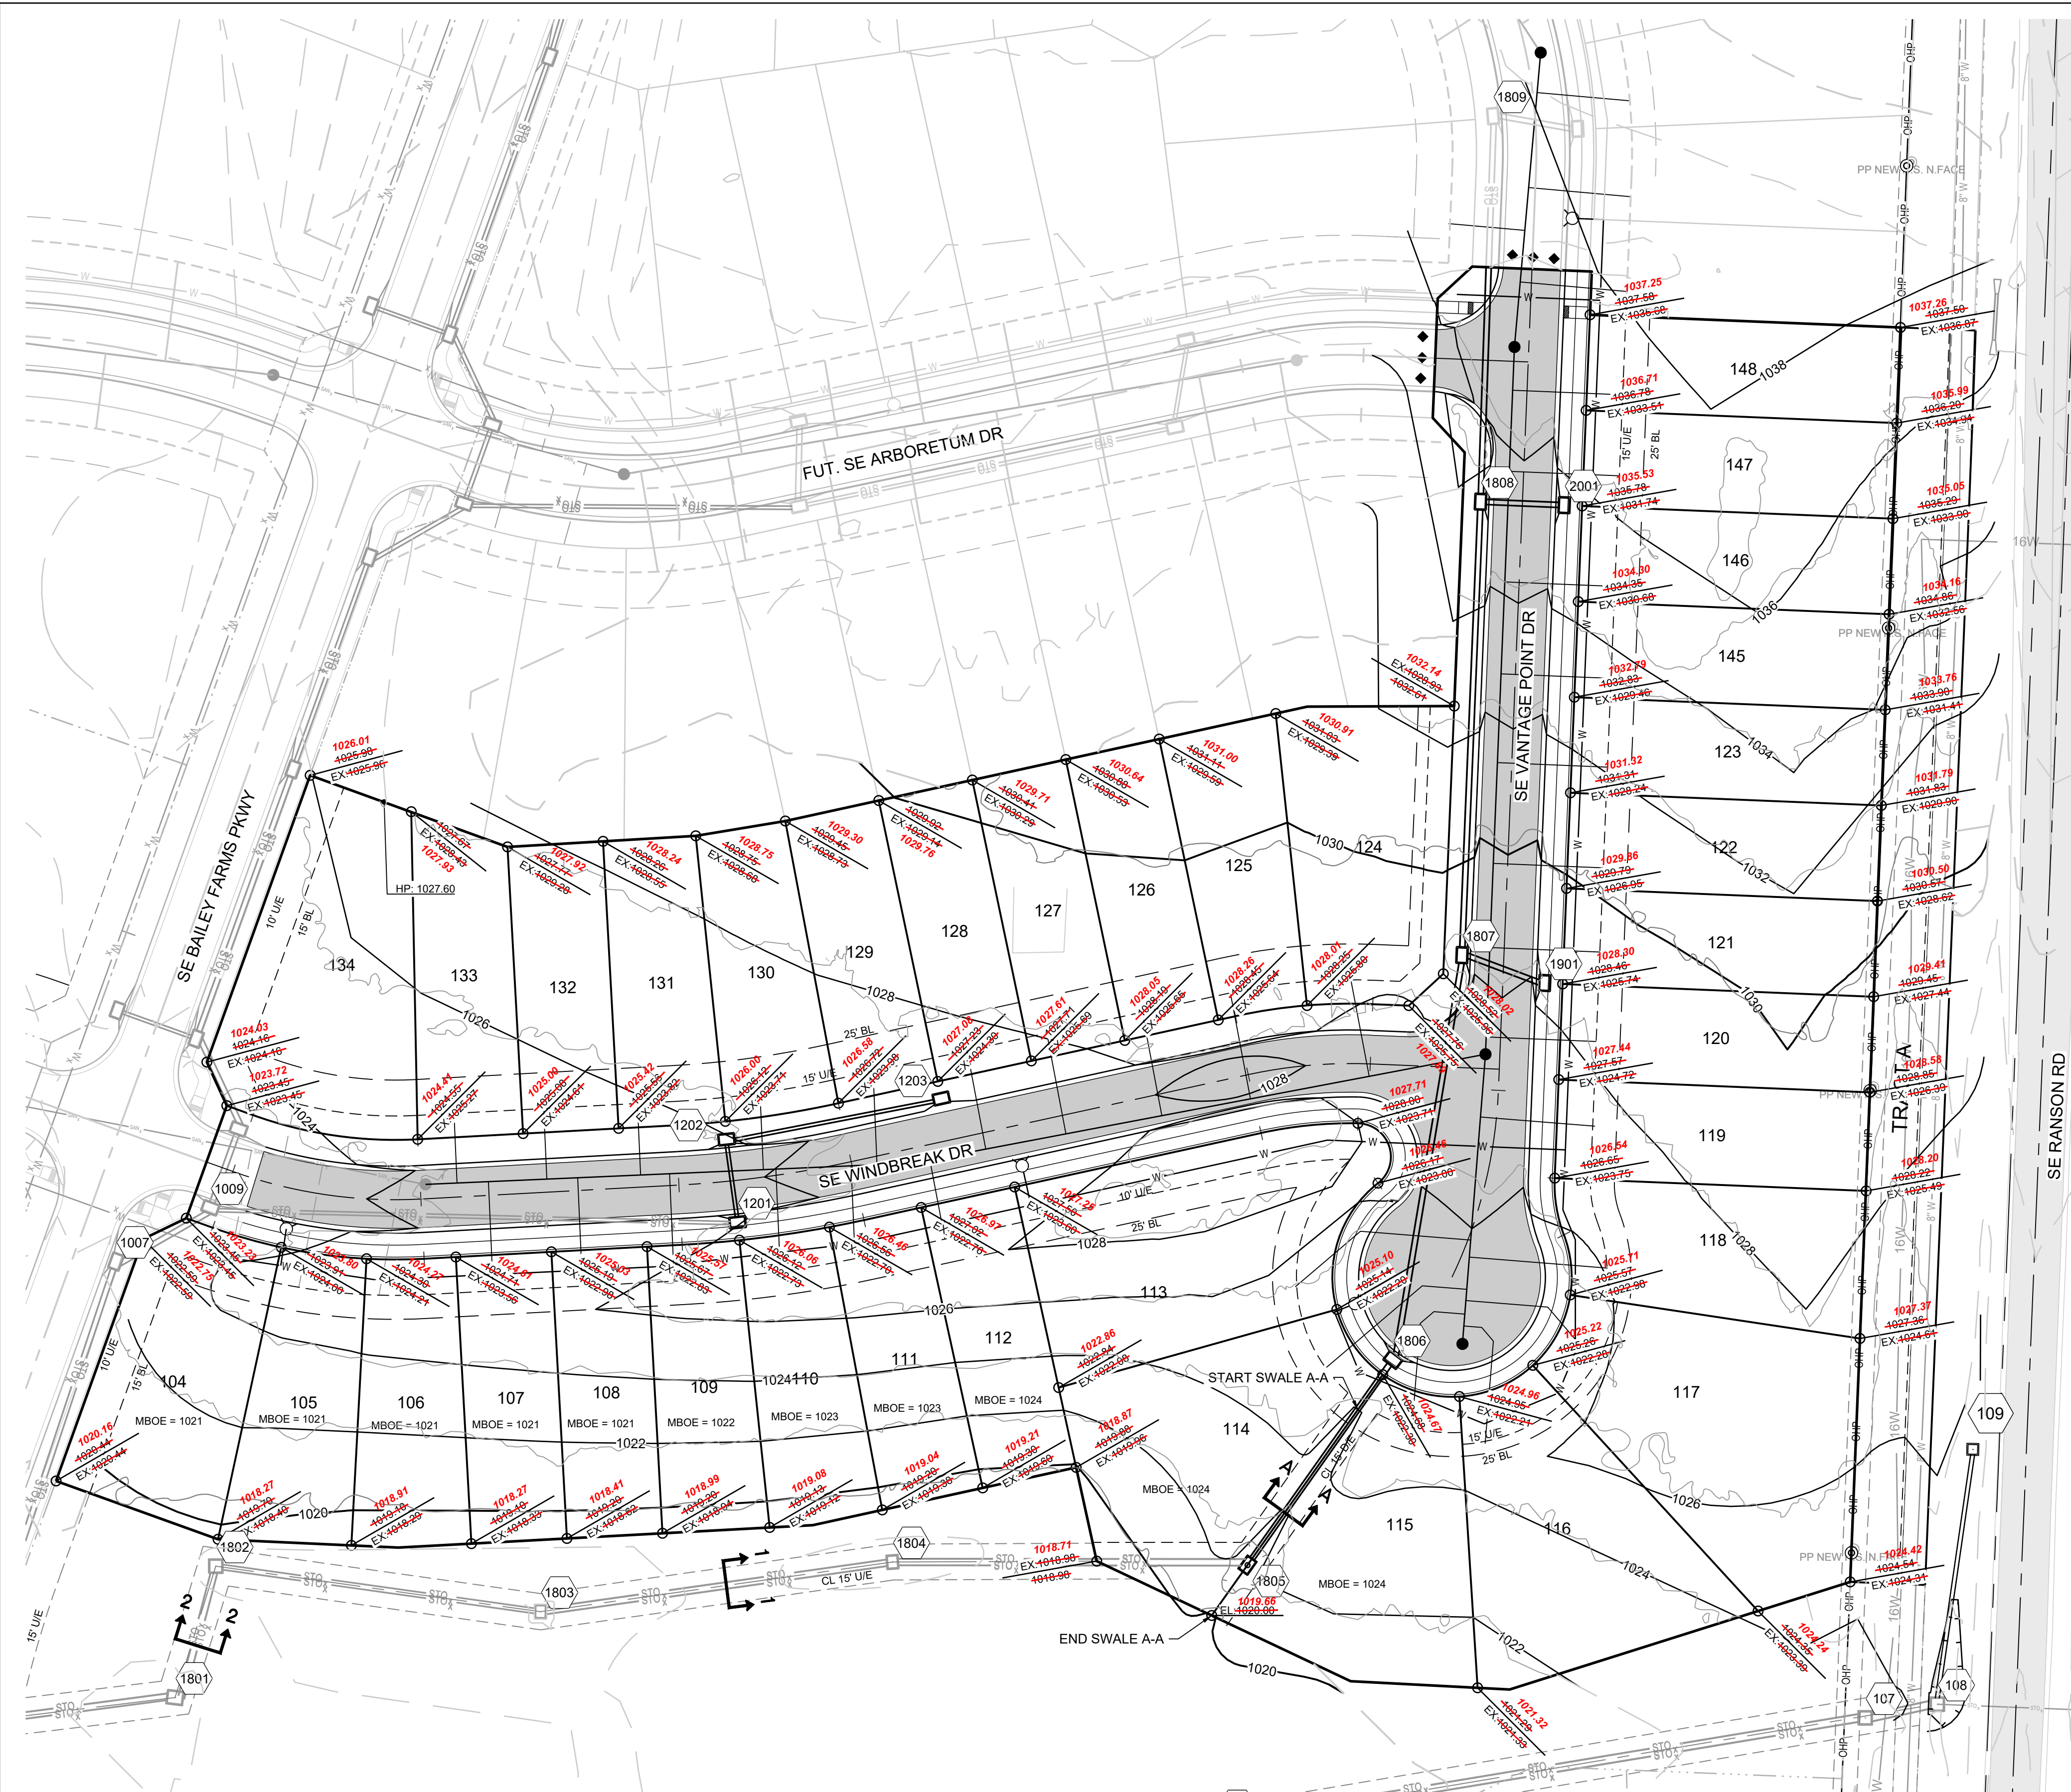

GRADING LEGEND:

- DENOTES OVERFLOW SWALE
- DENOTES FINISHED AS-BUILT GRADE ELEVATION
- DENOTES FINISHED GRADE ELEVATION
- DENOTES EXISTING GRADE ELEVATION
- HP 000.00 DENOTES LOT HIGH POINT ELEVATION
- DENOTES PROPOSED MAJOR CONTOUR
- DENOTES PROPOSED MINOR CONTOUR
- DENOTES EXISTING MAJOR CONTOUR
- DENOTES EXISTING MINOR CONTOUR
- DENOTES AS-BUILT MAJOR CONTOUR
- DENOTES AS-BUILT MINOR CONTOUR
- MWSE

BASIS OF BEARINGS:

MISSOURI STATE PLANE COORDINATE SYSTEM
(NAD) 1983, MISSOURI, WEST ZONE

NOTES:

ALL CONSTRUCTION ON THIS PROJECT SHALL CONFORM TO THE CITY OF LEES SUMMIT TECHNICAL SPECIFICATIONS.

THE CONTRACTOR IS RESPONSIBLE FOR VERIFYING ALL EXISTING UTILITY LOCATIONS PRIOR TO EXCAVATION.

Record Drawing

LOT TYPE TABLE		
LOT NUMBER	BASEMENT TYPE	MBOE
104	DAYLIGHT	1021
105	DAYLIGHT	1021
106	DAYLIGHT	1021
107	DAYLIGHT	1021
108	DAYLIGHT	1021
109	DAYLIGHT	1022
110	DAYLIGHT	1023
111	DAYLIGHT	1023
112	DAYLIGHT	1024
113	STANDARD	1026
114	STANDARD	1024
115	STANDARD	1024
116	STANDARD	
117	STANDARD	
118	STANDARD	
119	STANDARD	
120	STANDARD	
121	STANDARD	
122	STANDARD	
123	STANDARD	
145	STANDARD	
146	STANDARD	
147	STANDARD	
148	STANDARD	
124	STANDARD	
125	STANDARD	
126	STANDARD	
127	STANDARD	
128	STANDARD	
129	STANDARD	
130	STANDARD	
131	STANDARD	
132	STANDARD	
133	STANDARD	
134	STANDARD	

NOTES:

- MBOE = MINIMUM BUILDING OPENING ELEVATION FOR HOUSES ADJACENT TO ENGINEERED OVERFLOW SWALES SHALL BE MINIMUM 2 FEET ABOVE THE 100 YR WATER SURFACE ELEVATION.
- EGL = ENERGY GRADE LINE (100 YR)
- WSE = WATER SURFACE ELEVATION (100 YR)
- ENGINEERED SWALES TO BE GRADED TO NORMAL DEPTH OF FLOW (WATER SURFACE ELEVATION) OR 1.0 FT. WHICHEVER IS GREATER. MINIMUM SLOPE OF ENGINEERED SWALES SHALL BE AS NOTED.
- MBOE'S ADJACENT TO SUMPED INLETS SHALL BE A MINIMUM OF 1 FOOT ABOVE TOP OF ADJACENT BERM.

RECORD DRAWING

The information provided on this drawing conforms to construction records; it is not intended for construction, implementation or recording purposes, and it is solely based on information obtained by Schlager and Associates.

"100-00 100.10", "1-00% 1.15% slope", or "8-inch HDPE PVC pipe" are all typical examples of revisions that indicate that design data has been replaced with "as-built" information. All other data is as designed and has not been field verified.


Date: 3/13/2025
Certified by: JLL
Title: Senior Project Engineer
Firm: Schlager and Associates, P.A.

WEIR CALCULATIONS (Q = CLH ^{3/2})							
SECTION	DRAINAGE AREA (AC.)	Q100 (CFS)	DESIGN OVERFLOW (CFS)	WEIR ELEVATION	WEIR COEFFICIENT	LENGTH	WSE
1	4.07	34.65	34.65	1018.50	3.33	10'-0"	1019.53
2	5.12	43.60	43.60	1018.50	3.33	10'-0"	1019.70


100 YEAR OVERFLOW SWALES										
SECTION	DRAINAGE AREA (AC.)	Q100 (CFS)	Q10 (CFS)	DESIGN OVERFLOW (CFS)	BED SLOPE (%)	BASE WIDTH (FT.)	SIDE SLOPE	TOP WIDTH (FT.)	NORMAL DEPTH (FT.)	EGL (FT.)
A-A	3.11	26.50	15.10	11.40	3.80	5	4:1	8.12	0.39	0.70

RUNOFF CALCULATIONS:


$Q = K \cdot C \cdot I \cdot A$
 $K_{10} = 1.0$ $K_{100} = 1.25$ $C = 0.66$ $I =$ INTENSITY
DESIGN OVERFLOW = $Q_{OVERFLOW} = Q_{100} - Q_{10}$
MANNINGS "n" = 0.030 FOR SWALES

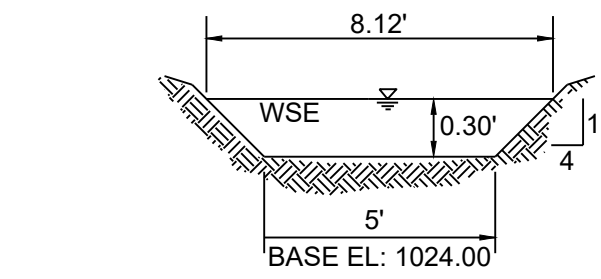

100 YEAR OVERFLOW SWALE SECTIONS

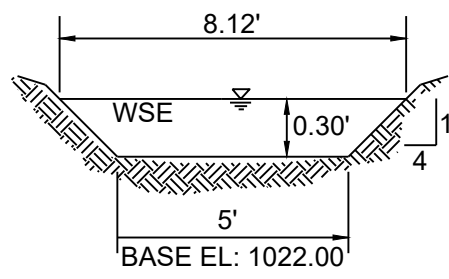

100 YEAR OVERFLOW SWALE SECTIONS

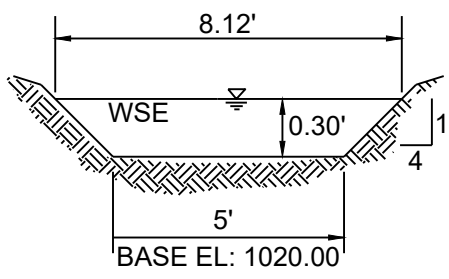

100 YEAR OVERFLOW SWALE SECTIONS



0 40' 80'
SCALE: 1" = 40'

SCHLAGEL
ENGINEERS PLANNERS SURVEYORS LANDSCAPE ARCHITECTS
14920 West 107th Street • Lenexa, Kansas 66215
(913) 492-5158 • Fax: (913) 492-8400
WWW.SCHLAGELASSOCIATES.COM
Missouri State Certificates of Authority
#E200203600-F #LAC2001005237 #LS200200859-F

PREPARED BY:

JAMES L. LONG
NUMBER PE-2014010495
3/13/2025
PROFESSIONAL ENGINEER

SCHLAGEL & ASSOCIATES, P.A.


RETREAT AT BAILEY FARMS, FIRST PLAT
STREET, STORMWATER, AND MASTER
DRAINAGE PLAN
SE BAILEY ROAD AND SE RANSON ROAD
LEE'S SUMMIT, MISSOURI

REVISION DATE	DESCRIPTION
03/21/2022	PER CITY COMMENTS
04/20/2022	PER CITY COMMENTS DATED 02/25/2022
08/25/2022	ADD FIELD INLET
09/08/2022	REVISED FIELD INLET
11/01/2022	Updated INLET 09 TO MATCH S1 INLET
02/09/2023	Updated City Details to 2023 Details
11/30/2023	Added "New City Requirements" Note
03/13/2025	AS-BUILT'S

MASTER
DRAINAGE
PLAN-GRADING
PLAN

SHEET

3

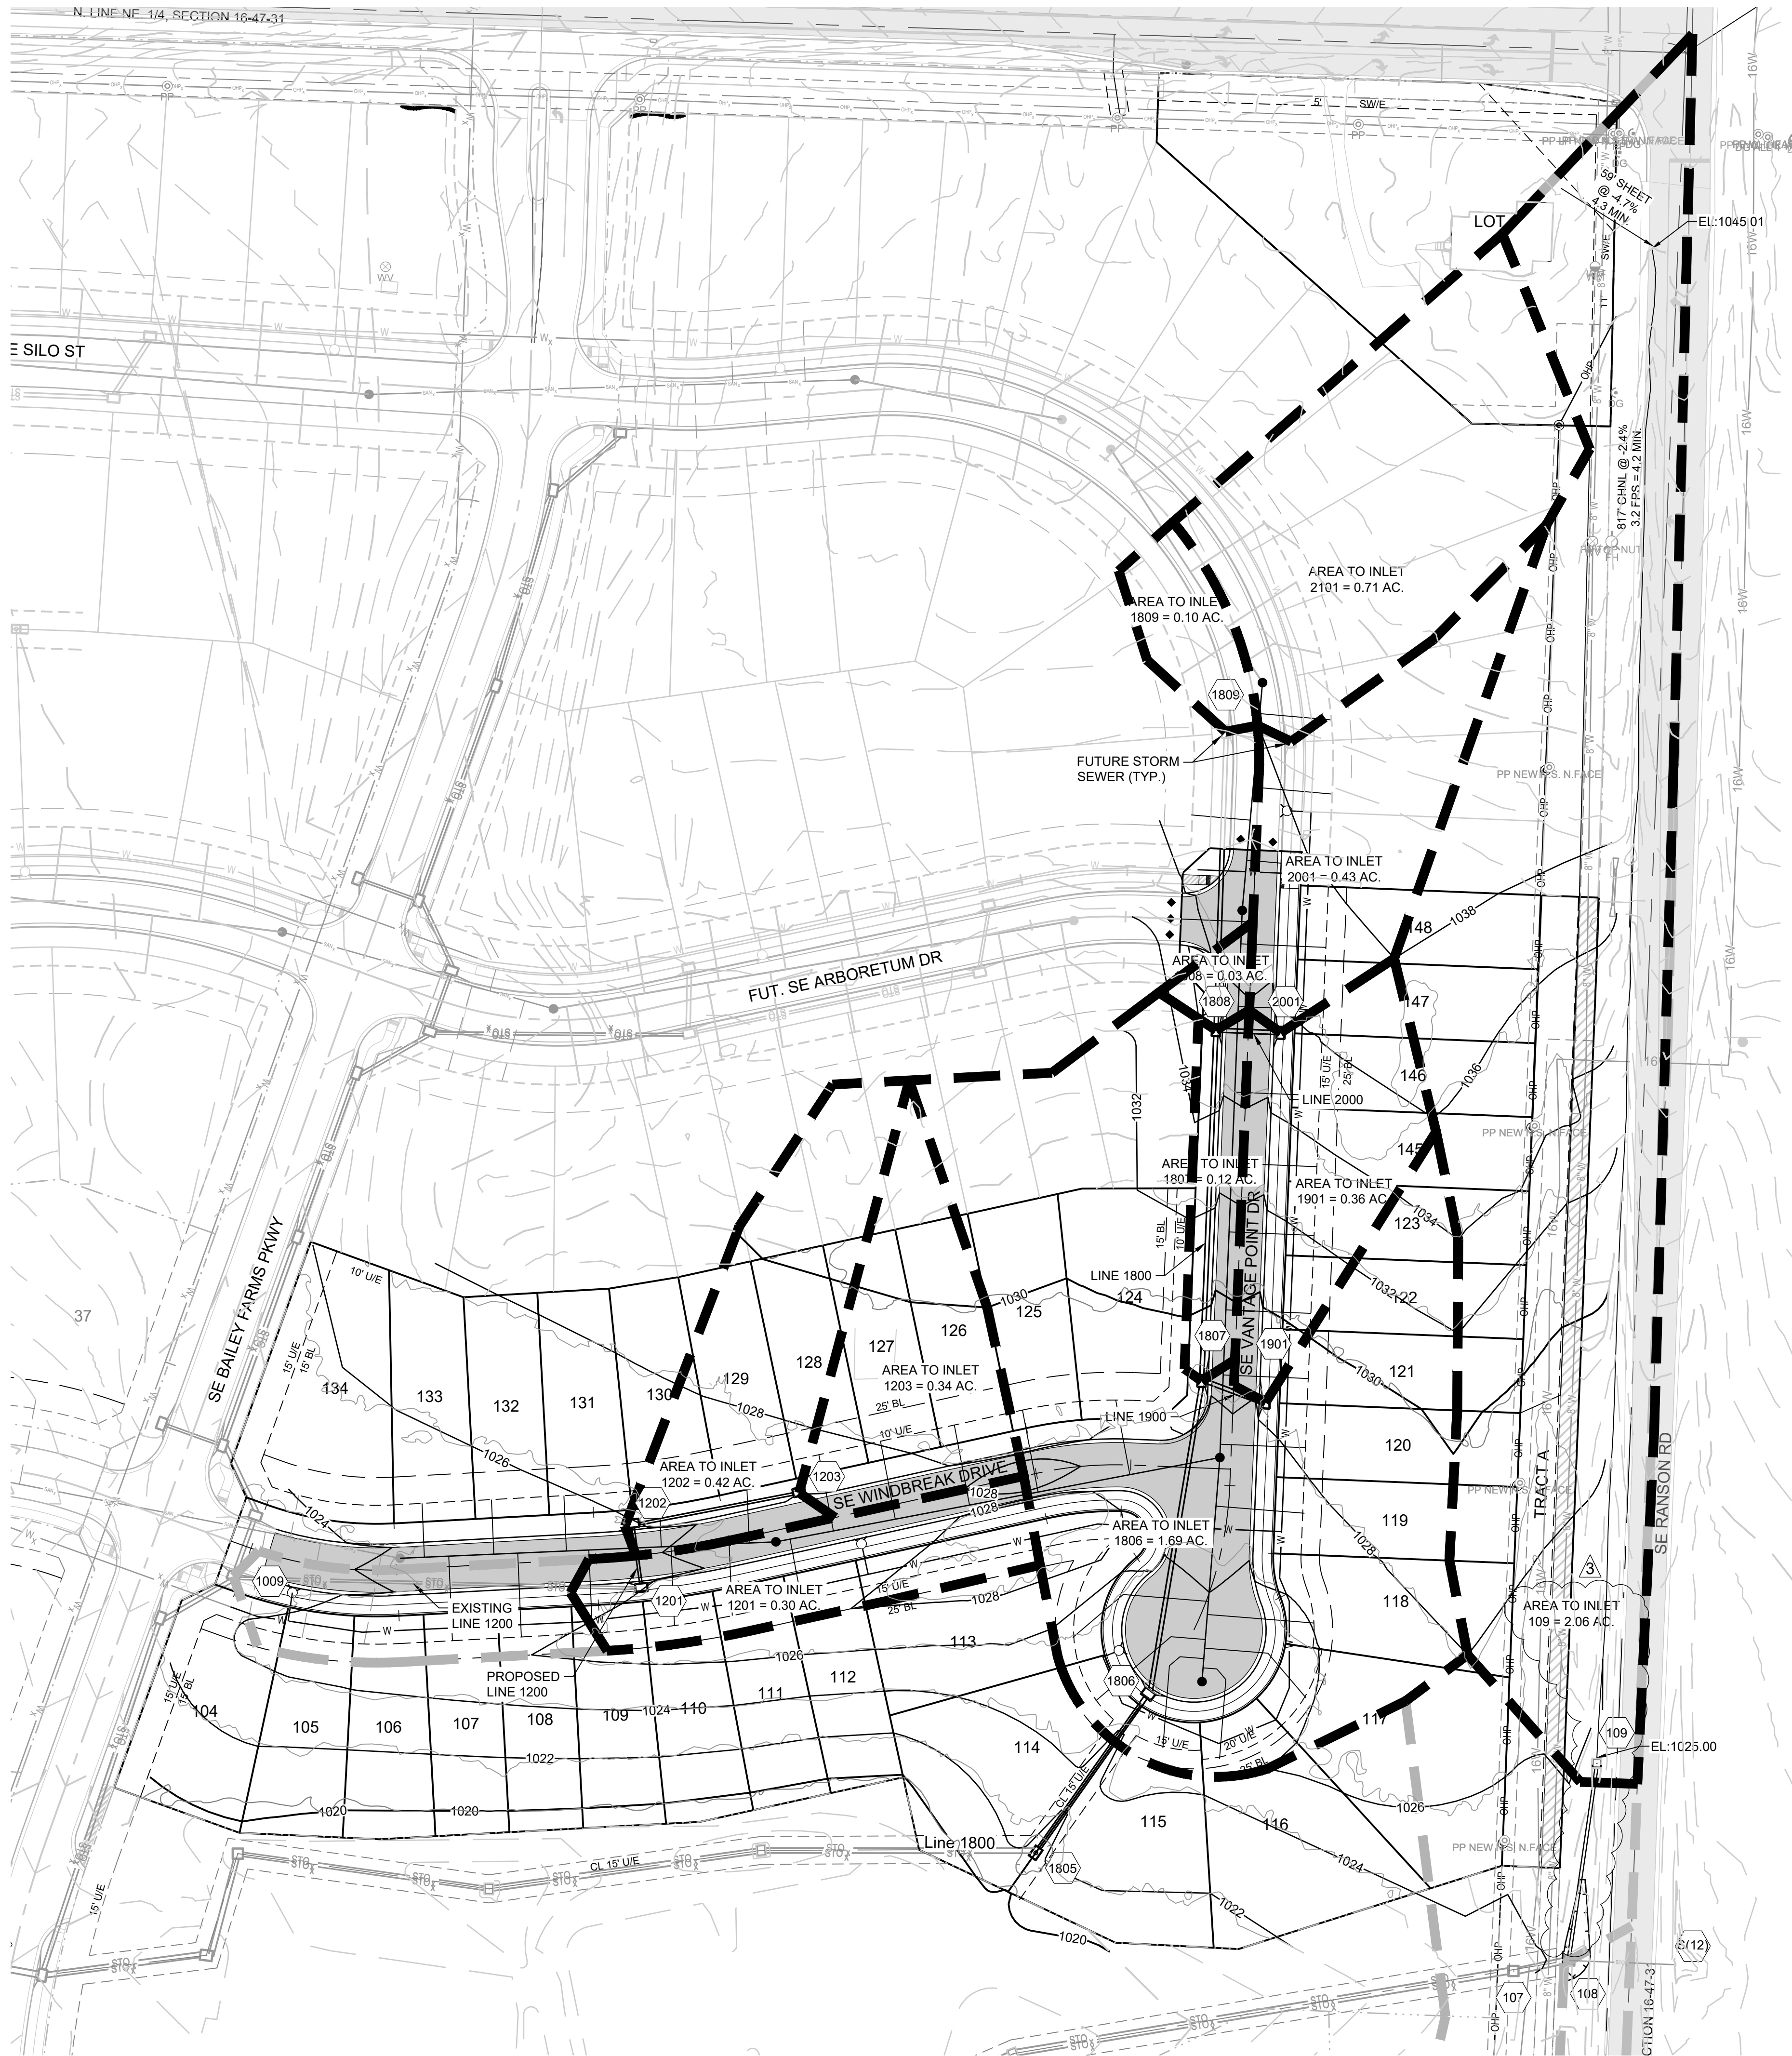

MISSOURI GEOGRAPHIC REFERENCE SYSTEM BENCHMARK:

BM JA-45, IS A KC METRO ALUMINUM GRS DISK SET IN CONCRETE AND ABOUT 3 INCHES BELOW THE PAVEMENT ON THE SHOULDER OF SE RANSON ROAD. IT IS STAMPED JA45, 1987.

ELEV. = 1046.25

BASIS OF BEARINGS:

MISSOURI STATE PLANE COORDINATE SYSTEM (NAD) 1983, MISSOURI, WEST ZONE

NOTES:

ALL CONSTRUCTION ON THIS PROJECT SHALL CONFORM TO THE CITY OF LEES SUMMIT TECHNICAL SPECIFICATIONS.

THE CONTRACTOR IS RESPONSIBLE FOR VERIFYING ALL EXISTING UTILITY LOCATIONS PRIOR TO EXCAVATION.

Record Drawing

LEGEND


- EXISTING DRAINAGE AREA
- PROPOSED DRAINAGE AREA

RECORD DRAWING

The information provided on this drawing conforms to construction records; it is not intended for construction, implementation or recording purposes; and it is solely based on information obtained by Schlager and Associates.

"100-00 100.10", "1.00% 1.15% slope", or "8-inch HDPE PVC pipe" are all typical examples of revisions that indicate that design data has been replaced with "as-built" information. All other data is as designed and has not been field verified.

Date: 3/13/2025
Certified by: JLL
Title: Senior Project Engineer
Firm: Schlager and Associates, P.A.

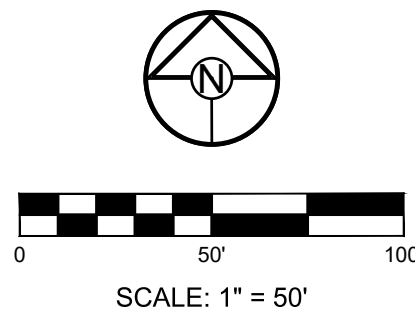

SCHLAGEL
ENGINEERS PLANNERS SURVEYORS LANDSCAPE ARCHITECTS
14920 West 107th Street • Lenexa, Kansas 66215
(913) 492-5158 • Fax: (913) 492-8400
WWW.SCHLAGELASSOCIATES.COM
Missouri State Certificates of Authority
#E2002003600-F #LAC2001005237 #LS2002008659-F

PREPARED BY:



SCHLAGEL & ASSOCIATES, P.A.

RETREAT AT BAILEY FARMS, FIRST PLAT
STREET, STORMWATER, AND MASTER
DRAINAGE PLAN
SE BAILEY ROAD AND SE RANSON ROAD
LEE'S SUMMIT, MISSOURI

REVISION DATE	DESCRIPTION
03/21/2022	PER CITY COMMENTS DATED 02/25/2022
04/20/2022	PER CITY COMMENTS DATED 02/25/2022
08/25/2022	ADD FIELD INLET
09/08/2022	REVISED FIELD INLET
11/01/2022	Updated INLET 09 TO MCDOT S1 INLET
02/09/2023	Updated City Details to 2023 Details
03/13/2025	Added "New City Requirements" Note
21-133	AS-BUILTS

MASTER
DRAINAGE
PLAN-DRAINAGE
MAP

SHEET

7

MISSOURI GEOGRAPHIC REFERENCE SYSTEM
BENCHMARK:


BM JA-45, IS A KC METRO ALUMINUM GRS DISK SET IN CONCRETE AND ABOUT 3 INCHES BELOW THE PAVEMENT ON THE SHOULDER OF SE RANSON ROAD. IT IS STAMPED JA45, 1987.

ELEV. = 1046.25

Record Drawing



PREPARED BY:

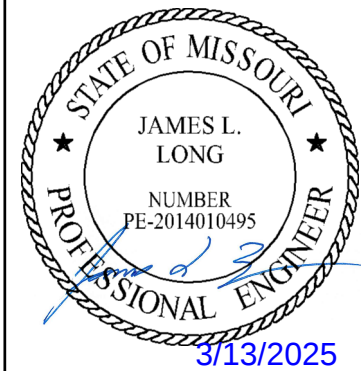

SCHLAGEL & ASSOCIATES, P.A.

RETREAT AT BAILEY FARMS, FIRST PLAT
STREET, STORMWATER, AND MASTER
DRAINAGE PLAN
SE BAILEY ROAD AND SE RANSON ROAD
LEE'S SUMMIT, MISSOURI

REVISION DATE	DESCRIPTION
03/21/2022	PER CITY COMMENTS DATED 02/25/2022
04/20/2022	PER CITY COMMENTS DATED 02/25/2022
08/25/2022	ADD FIELD INLET
09/08/2022	REVISED FIELD INLET
11/01/2022	REVISED INLET 09 TO M&DOT S1 INLET
10/27/2023	Updated City Details to 2023 Details
11/30/2023	Added "New City Requirements" Note
03/13/2025	AS-BUILT

DRAWN BY:	JRL
CHECKED BY:	JLL
DATE PREPARED:	02/09/2022
PROJ. NUMBER:	21-133

MASTER
DRAINAGE
PLAN-DRAINAGE
CALCS

SHEET
8

10-YEAR RUNOFF CALCULATIONS

Design Storm:	10
"K" Value:	1.00
"F" Factor:	1.00

Runoff Calculations										Pipe Properties															
Inlet #	Area (acres)	"C" Value	Cumul. Area (acres)	Cumul. CxA	Tc	Intensity	Runoff To Inlet	Cumul. Runoff	Pipe Cap.	Pipe Vel.	Up Piped Inlet 1	Up Piped Inlet 2	Up Area (acres)	Up CxA	Up Inlet	Down Inlet	Pipe Type	"n" Value	Pipe Size	Length	Slope %	Drop In Inlet	FL Up	FL Down	Inlet Top
DS TAILWATER @ STR #100																									
LINE 100																									
108	13.00	0.51	15.06	7.66	15.0	5.18	34.33	39.66	81.69	11.56			0.00	0.00	108	107	RCP	0.013	36	30.70	1.50	0.50	1018.77	1018.31	1024.32
109	2.06	0.50	2.06	1.03	8.5	6.41	6.60	6.60	27.66	8.80			0.00	0.00	109	108	RCP	0.013	24	107.57	1.50	N/A	1020.88	1019.27	1026.00
Drop in Inlet 1009																									
LINE 1200																									
1201	0.30	0.66	1.06	0.70	5.0	7.35	1.46	5.14	16.09	9.11			0.00	0.00	1201	1009	HDPE	0.012	18	220.44	2.00	0.50	1019.15	1014.74	1023.40
1202	0.42	0.66	0.76	0.50	5.2	7.29	2.02	3.66	12.12	9.88			0.00	0.00	1202	1201	HDPE	0.012	15	34.53	3.00	0.50	1020.68	1019.65	1025.95
1203	0.34	0.66	0.34	0.22	5.0	7.35	1.65	1.65	9.90	8.06			0.00	0.00	1203	1202	HDPE	0.012	15	91.48	2.00	N/A	1023.01	1021.18	1027.08
Drop in Inlet 1007																									
LINE 1800																									
1805	0.00	0.66	3.42	2.26	6.5	6.92	0.00	15.63	29.00	9.23			0.00	0.00	1805	1804	HDPE	0.012	24	148.37	1.40	0.50	1015.30	1013.22	1020.98
1806	1.69	0.66	3.42	2.26	6.2	6.99	7.79	15.77	23.25	7.40			0.00	0.00	1806	1805	HDPE	0.012	24	105.15	0.90	0.50	1016.74	1015.80	1024.53
1807	0.12	0.66	1.73	1.14	5.8	7.11	0.56	8.12	12.04	6.82	1901		0.36	0.24	1807	1806	HDPE	0.012	18	171.66	1.12	4.00	1019.17	1017.24	1026.61
1808	0.03	0.66	1.25	0.83	5.4	7.22	0.14	5.96	9.90	8.06	2001		0.43	0.28	1808	1807	HDPE	0.012	15	189.72	2.00	0.50	1026.96	1023.17	1035.63
1809	0.10	0.66	0.79	0.52	5.0	7.35	0.49	3.83	7.67	6.25	2101		0.69	0.46	1809	1808	HDPE	0.012	15	161.32	1.20	N/A	1029.40	1027.46	1039.10
Drop in Inlet 1807																									
LINE 1900																									
1901	0.36	0.66	0.36	0.24	5.0	7.35	1.75	1.75	7.00	5.70			0.00	0.00	1901	1807	HDPE	0.012	15	36.46	1.00	0.20	1024.29	1023.93	1028.40
Drop in Inlet 1808																									
LINE 2000																									
2001	0.43	0.66	0.43	0.28	5.0	7.35	2.09	2.09	7.00	5.70			0.00	0.00	2001	1808	HDPE	0.012	15	35.00	1.00	0.20	1029.31	1028.96	1035.54

GUTTER SPREAD AND INLET CAPACITY CALCULATIONS - RETREAT AT BAILEY FARMS, FIRST PLAT

DESIGN STORM 10
"K" FACTOR 1.00
CURB TYPE "A" = LAZY BACK
CURB TYPE "B" = HIGH BACK

RUNOFF CALCULATIONS											INLET DESIGN										GUTTER DESIGN			
INLET #	COMPOSITE "C"	AREA	INLET Tc	INTENSITY	RUNOFF	UPSTREAM INLET	UPSTREAM INLET	UPSTREAM INLET	UPSTREAM INLET	BYPASS FROM UPSTREAM INLET	TOTAL RUNOFF	STREET GRADE	STREET CROSS SLOPE	CURB TYPE	INLET LENGTH	EFFECTIVE LENGTH 80% CAP	INLET INTERCEPTION	BYPASS TO DOWNSTREAM INLET	STREET GRADE	STREET CROSS SLOPE	DEPTH AT CURB	SPREAD OF FLOW		
LINE 1200																								
1201	0.66	0.30	5	7.35	1.46					0.00	1.46	1.20	2.08	A	6	4.8	1.32	0.14	1.20	2.08	0.15	7.94		
1202	0.66	0.42	5	7.35	2.04	1203				0.18	2.22	1.20	2.08	A	6	4.8	1.89	0.32	1.20	2.08	0.18	9.22		
1203	0.66	0.34	5	7.35	1.65					0.00	1.65	1.20	2.08	A	6	4.8	1.47	0.18	1.20	2.08	0.16	8.30		
LINE 1800																								
1806	0.66	1.69	5	7.35	8.20	1807	1901			0.67	8.87	SUMP	2.08	A	6	4.8	13.44	0.00	SUMP	2.08	< 0.21	< 10.50		
1807	0.66	0.12	5	7.35	0.58	1808				0.00	0.58	3.80	2.08	A	6	4.8	0.53	0.05	3.80	2.08	0.09	4.75		
1808	0.66	0.03	5	7.35	0.15					0.00	0.15	2.00	2.08	A	6	4.8	0.14	0.00	2.00	2.08	0.06	3.35		
1809	0.66	0.10	5	7.35	0.49					0.00	0.49	2.00	2.08	A	6	6	0.47	0.01	2.00	2.08	0.09	4.98		
LINE 1900																								
1901	0.66	0.36	5	7.35	1.75	2001				0.40	2.15	3.80	2.08	A	6	4.8	1.53	0.62	3.80	2.08	0.14	7.44		
LINE 2000																								
2001	0.66	0.43	5	7.35	2.09					0.00	2.09	2.00	2.08	A	6	4.8	1.68	0.40	2.00	2.08	0.16	8.24		
NOTES: 1. CAPACITY OF INLETS ON GRADE DETERMINED USING ROUTINE OUTLINED ON PGS 56-95 TO 56-97, SECTION 5600 APWA 2. CAPACITY OF SUMP INLETS CALCULATED USING FIGURE 5604-21, SECTION 5600 APWA 3. MANNINGS "n" VALUE FOR COMBINED ASPHALT PAVEMENT AND CONCRETE CURB - 0.014																								

RECORD DRAWING

The information provided on this drawing conforms to construction records; it is not intended for construction, implementation or recording purposes; and it is solely based on information obtained by Schlagel and Associates.

Date: 3/13/2025
Certified by: JLL
Title: Senior Project Engineer
Firm: Schlagel and Associates, P.A.