

LEE'S SUMMIT, MO OLDHAM VILLAGE **ADDENDUM 1** 06/20/25

PROJECT SUMMARY

- EXTERIOR STEEL STUD FRAMING EXTERIOR FINISHES EXTERIOR CANOPY

CODE SUMMARY

LANDSCAPING

REF LOCAL CODE AMENDMENTS IN ADDITION TO THE CODES BELOW APPLICABLE CODES BUILDING CODE 2018 INTERNATIONAL BUILDING CODE ELECTRICAL CODE 2017 NATIONAL ELECTRICAL CODE PLUMBING CODE 2018 INTERNATIONAL PLUMBING CODE 2018 INTERNATIONAL MECHANICAL CODE MECHANICAL CODE FIRE CODE 2018 INTERNATIONAL FIRE CODE ACCESSIBILITY ICC/ANSI A117.1-2009, ACCESSIBLE AND USABLE BUILDINGS AND FACILITIES **ENERGY CODE** 2018 INTERNATIONAL ENERGY CODE 2018 INTERNATIONAL FUEL GAS CODE FUEL GAS CODE

FUTURE / SEPARATE SUBMITTALS FUTURE INTERIOR SCOPE PLANNING AND ZONING

TOTAL ALLOWABLE AREA

ALLOWABLE HEIGHT

STRUCTURAL FRAME

TOTAL BUILDING AREA

CODE ANALYSIS

PROPOSED PRIMARY OCCUPANCY GROUP (MIXED OCCUPANCY) RESTAURANT STORAGE **BUILDABLE AREA**

CONSTRUCTION TYPE (ALL WOOD TO ACHIEVE CLASS "C" FLAME SPREAD PER CONSTRUCTION TYPE VB; FULLY SPRINKLERED

FIRE PROTECTION (HOURLY FIRE RESISTANCE RATING REQUIREMENTS PER TABLE LOCATION REQUIRED / PROVIDED

ROOF CONSTRUCTION **EXTERIOR NONBEARING WALLS EXTERIOR BEARING WALLS** INTERIOR NONBEARING WALLS INTERIOR BEARING WALLS FLOOR CONSTRUCTION

ACCESSIBILITY NOTES

- 1. FLOOR SURFACES ARE SLIP RESISTANT. 2. ALL CHANGES IN FLOOR ELEVATION ALONG ACCESSIBLE ROUTE SHALL NOT EXCEED 1/2" IN HEIGHT. CHANGES BETWEEN 1/4" AND 1/2" SHALL BE CUT OR **GROUND TO A BEVEL WITH 1:2 STEEPNESS** LATCHING AND LOCKING DOORS ARE SPECIFIED TO BE OPERABLE WITH A SINGLE EFFORT BY HARDWARE THAT DOES NOT REQUIRE TIGHT GRASPING. PINCHING OR TWISTING OF THE WRIST. DOOR OPENING HARDWARE IS
- SPECIFIED TO BE MOUNTED BETWEEN 34" AND 48" ABOVE FLOOR FINISH. I. CLOSERS FOR FIRE-RATED DOORS ARE SPECIFIED TO BE POWER LEVEL 3 FOR INTERIOR DOORS 38" OR LESS IN WIDTH. MAXIMUM PULL OR PUSH EFFORT TO OPERATE NON-FIRE-RATED DOORS SHALL NOT EXCEED 8.5 POUNDS FOR EXTERIOR DOORS AND 5 POUNDS FOR INTERIOR DOORS, MEASURED AT RIGHT ANGLES TO HINGED DOORS AND AT CENTER PLANE OF SLIDING OR FOLDING DOORS. SPECIFIED CLOSERS TO BE ADJUSTED
- 6. ALL DOORS ARE SPECIFIED 3'-0" MINIMUM IN WIDTH AND 6'-8" MINIMUM IN HEIGHT, DOORS ARE CAPABLE OF OPENING AT LEAST 90 DEGREES WITH A MINIMUM OF 32" CLEAR WIDTH. FLOOR AREAS ON EACH SIDE OF DOORS ARE SPECIFIED TO BE LEVEL AND
- CLEAR. THE DIMENSIONS OF THE LEVEL AREAS ARE SPECIFIED TO MEET ICC A117.1 2009, IAC AND ADA CLEARANCE REQUIREMENTS. A MAXIMUM CHANGE IN LEVEL OF 1/2" ALLOWED AT THRESHOLD OF THE DOORWAY. CHANGES BETWEEN 1/4" AND 1/2" SHALL BE CUT OR GROUND TO A BEVEL WITH 1:2 STEEPNESS.

MOUNT ALL SWITCHES, RECEPTACLES, THERMOSTATS, ETC IN COMPLIANCE

MOLD/MILDEW REQUIREMENTS

- IN THE EVENT THE CONTRACTOR DISCOVERS, AT ANY TIME DURING DEMOLITION, CONSTRUCTION AND/OR REMODELING OPERATIONS, EXISTING CONDITIONS POTENTIALLY INCLUDING THE PRESENCE OF MOLD AND/OR MILDEW, IMMEDIATELY NOTIFY CLIENT AND THE PROFESSIONAL OF RECORD, IN WRITING, OF THE CONCERNS AND/OR SUSPICIONS. RETAIN A MOLD AND MILDEW CERTIFIED TESTING AGENCY TO PERFORM AN
- INVESTIGATION AND TESTING AS REQUIRED TO EVALUATE THE NATURE AND EXTENT OF DAMAGES. IF THE TESTING AGENCY CONFIRMS HAZARDS, OBTAIN A MINIMUM OF TWO (2) BIDS FROM COMPANIES QUALIFIED AND LICENSED TO PERFORM ALL NECESSARY REMEDIATION WORK, COMPLYING WITH ALL LOCAL, STATE AND FEDERAL ENVIRONMENTAL REGULATIONS, CODES, AND STATUTES. ONCE DISCOVERY OR SUSPICION OF MOLD AND/OR MILDEW IS MADE, TAKE ALL RESPONSIBLE MEASURES AND PRACTICE PRECAUTIONS TO PROTECT ALL CONSTRUCTION PERSONNEL AND THE PUBLIC FROM EXPOSURE TO MOLD AND/OR MILDEW, AND SUCH PRECAUTIONS SHALL REMAIN IN PLACE UNTIL SUCH A TIME AS THE CLIENT OR HEALTH AUTHORITY DIRECTS OTHERWISE. CONSTRUCTION OPERATIONS SHALL NOT BE STOPPED OR CURTAILED, EXCEPT IN THE AREA OF MOLD/MILDEW CONCERN, DUE TO THESE REQUIRED
- MAKE ALL REASONABLE EFFORTS TO AVOID CONDITIONS FAVORABLE TO THE DEVELOPMENT OF MOLD AND MILDEW, ESPECIALLY IN NON-VENTILATED VOIDS OR WALL CAVITIES. IN ALL CASES. INTERIOR SPACES AND INTERIOR FINISHED CONSTRUCTION SHALL BE MAINTAINED IN DRY AND WELL-VENTILATED
- . COMPLY WITH FEDERAL ENVIRONMENTAL AND OSHA REGULATIONS AND ALL LOCAL AND STATE HEALTH DEPARTMENT REQUIREMENTS AND RECOMMENDATIONS REGARDING MOLD AND MILDEW. ALL PENETRATIONS SHALL BE SEALED WATER-TIGHT TO PREVENT MOISTURE MIGRATION FROM PENETRATING THE WEATHER BARRIER LOCATED WITHIN THE EXTERIOR BUILDING WALLS
- ENSURE PLUMBING CHASES ARE FREE OF ANY LEAKING PIPES CAUSING ADDED MOISTURE. ALL EXISTING SUPPLY AIR PATHS AND ALL EXISTING RETURN AIR PATHS AND PLENUMS SHALL BE KEPT DRY.
- . CLEAN AND TREAT ALL REUSED DUCTWORK FOR REMOVAL OF ANY POTENTIAL MOLD AND MILDEW. ALL DAMP AREAS SHALL BE DRIED THOROUGHLY INSIDE AND OUTSIDE OF THE DUCT WORK PRIOR TO ENCLOSURE.

SIGNAGE REQUIREMENTS

REQUIRED ACCESSIBLE ELEMENTS SHALL BE IDENTIFIED BY THE

- INTERNATIONAL SYMBOL OF ACCESSIBILITY AT THE FOLLOWING LOCATIONS: -ACCESSIBLE ENTRANCES WHERE NOT ALL ENTRANCES ARE ACCESSIBLE. -ACCESSIBLE ROOMS WHERE MULTIPLE SINGLE-USER TOILETS ARE CLUSTERED AT A SINGLE LOCATION. -ACCESSIBLE CHECK-OUT AISLES WHERE NOT ALL AISLES ARE ACCESSIBLE. HE SIGN. WHERE PROVIDED. SHALL BE ABOVE THE CHECK-OUT AISLE IN TH SAME LOCATION AS THE CHECK-OUT AISLE NUMBER OR TYPE OF CHECK-OUT -UNISEX TOILET AND BATHING ROOMS.
- DIRECTIONAL SIGNAGE INDICATING THE ROUTE TO THE NEAREST LIKE ACCESSIBLE ELEMENT SHALL BE PROVIDED AT THE ABOVE LISTED LOCATIONS. THESE DIRECTIONAL SIGNS SHALL INCLUDE THE INTERNAL SYMBOL OF ACCESSIBILITY AT EACH SEPARATE -SEX TOILET INDICATING THE LOCATION OF THE NEAREST UNISEX TOILET. THE INTERNATIONAL SYMBOL OF ACCESSIBILITY SHALL CONSIST OF A WHITE FIGURE ON A BLUE BACKGROUND. THE BLUE SHALL BE EQUAL TO COLOR NO. 15090 IN FEDERAL STANDARD 599B. PICTOGRAMS AND THEIR FIELDS SHALL
- HAVE A NON-GLARE FINISH, PICTOGRAMS SHALL CONTRAST THEIR FIELDS, WITH EITHER A LIGHT PICTOGRAM ON A DARK FIELD OR A DARK PICTOGRAM ON A LIGHT FIELD. CHARACTER AND SYMBOLS OF SIGNS SHALL BE IN CONTRAST WITH THEIR BACKGROUND AND SHALL BE EGGSHELL, MATTE, OR OTHER NON-GLARE MATERIAL OR FINISHES. THE UPPERCASE LETTER "O" SHALL BE USED TO DETERMINE THE ALLOWABLE WIDTH OF ALL CHARACTERS OF A FONT. THE WIDTH OF THE UPPERCASE
- LETTER "O" OF THE FONT SHALL BE 55 PERCENT MINIMUM AND 110 PERCENT MAXIMUM OF THE HEIGHT OF THE UPPERCASE "I" OF THE FONT. 2010 ADA SECTION 703.2 CHARACTER HEIGHT MEASURED FROM THE BASELINE OF THE CHARACTER SHALL BE 5/8" (16 MM) MINIMUM AND 2 INCHES (51 MM) MAXIMUM BASED ON THE HEIGHT OF THE UPPERCASE LETTER "I". WHEN RAISED CHARACTERS OR SYMBOLS ARE USED, THEY SHALL CONFORM TO THE FOLLOWING: - LETTERS AND NUMBERS ON SIGNS SHALL BE RAISED 1/32" MINIMUM AND SHALL BE SANS-SERIF UPPERCASE CHARACTERS. - RAISED CHARACTERS OR SYMBOLS SHALL BE A MINIMUM OF 5/8" HIGH AND 2"

MAXIMUM BASED ON THE HEIGHT OF THE UPPERCASE LETTER "I".

- PICTORIAL SYMBOL SIGNS (PICTOGRAMS) SHALL BE ACCOMPANIED BY THE EQUIVALENT VERBAL DESCRIPTION PLACED DIRECTLY BELOW THE PICTOGRAM. THE BORDER DIMENSION OF THE PICTOGRAM SHALL BE A MINIMUM OF 6" IN HEIGHT. ACCESSIBLE SIGNAGE SHALL USE GRADE II BRAILLE.
- 8. A TACTILE SIGN STATING "EXIT" SHALL BE PROVIDED ADJACENT TO EACH DOOR TO AN EXIT PASSAGEWAY AND THE EXIT DISCHARGE. REFERENCE DOOR

GENERAL REQUIREMENTS

- THE GENERAL CONTRACTOR AND EACH SUBCONTRACTOR IS RESPONSIBLE FOR HAVING A THOROUGH KNOWLEDGE OF ALL CONTRACT DOCUMENTS. THE FAILURE TO REVIEW AND UNDERSTAND DOCUMENTS DOES NOT RELIEVE ANY RESPONSIBILITY FOR PROPERLY PREFORMING WORK. NO ADDITIONAL COMPENSATION SHALL BE ALLOWED BECAUSE OF CONDITIONS THAT OCCUR DUE TO FAILURE TO FAMILIARIZE WORKERS WITH THIS KNOWLEDGE.
- REVIEW AND BID ALL CONTRACT DOCUMENTS. INCLUDING DRAWINGS. SPECIFICATIONS, AND ANY ADDITIONAL REQUIREMENTS DELIVERED AS RESPONSES TO BID QUESTIONS AND ADDENDUMS. BUILLETINS OR REVISIONS ALSO REVIEW AND BID CLIENT PROVIDED DOCUMENTS, SUCH AS THE DESIGN DEVELOPMENT PACKAGE, EQUIPMENT CUT SHEETS, AND VENDOR SHOP DRAWINGS. NOTIFY THE ARCHITECT AND CLIENT OF QUESTIONS OR DISCREPANCIES PRIOR TO BID SUBMISSIONS.
- DO NOT SCALE DRAWINGS. DIMENSIONS SHOWN ON PLANS ARE TO FACE OF FINISH OR CENTER LINE OF COLUMN, UNO. FOLLOW SUBSTITUTION REQUESTS AS DESCRIBED WITHIN PROJECT MANUAL. NO DEVIATION FROM CONTRACT DRAWINGS AND SPECIFICATIONS ALLOWED
- WITHOUT APPROVAL OF THE ARCHITECT OR CLIENT. . FOLLOW TYPICAL CONDITION DETAILS IN ASSUMPTION THAT ALL LIKE OR SIMILAR CONDITIONS ARE THE SAME UNLESS SPECIFICALLY NOTED OR DETAILED OTHERWISE. BRING ANY DISCREPANCY QUESTIONS OF APPLICABLE DETAILS TO THE ATTENTION OF THE ARCHITECT FOR REVIEW IMMEDIATELY
- REPORT ANY DRAWING DISCREPANCIES FOUND IN THE FIELD IMMEDIATELY TO CLIENT AND THE ARCHITECT PRIOR TO MAKING ANY STRUCTURAL MODIFICATIONS OR ORDERING ANY MATERIALS. GENERAL CONTRACTOR IS SOLELY RESPONSIBLE FOR CONSTRUCTION MEANS, METHODS, TECHNIQUES, SEQUENCES AND PROCEDURES AND FOR
- COORDINATING ALL PORTIONS OF CONSTRUCTION ACTIVITIES. PROVIDE ALL REQUIRED NOTICES FOR INSPECTIONS AND APPROVALS OF THE WORK BY THE AUTHORITY HAVING JURISDICTION. THE MOST RESTRICTIVE CODE REQUIREMENTS AS INTERPRETED BY LOCAL OFFICIALS APPLY. FURNISH AND INSTALL ALL EQUIPMENT AND MATERIALS UNLESS IT IS SPECIFICALLY NOTED AS BEING FURNISHED BY CLIENT. EVEN EQUIPMENT OR MATERIALS FURNISHED BY CLIENT MAY REQUIRE UNLOADING BY THE GENERAL
- CONTRACTOR. 0. ORDER MATERIALS TO PROHIBIT DELAYS OF THE CONSTRUCTION SCHEDULE OF THIS PROJECT. COORDINATE DELIVERY OF ALL MATERIALS IN A TIMELY MANNER UPON A CLIENT APPROVED CONSTRUCTION SCHEDULE. . ARRANGE PRECONSTRUCTION MEETING WITH ALL TRADES AND CLIENT. MEETING SHALL TAKE PLACE PRIOR TO COMMENCING WORK OR ORDERING
- MATERIALS. 2. PROVIDE OR MAINTAIN EXISTING SANITARY FACILITIES DURING THE DURATION OF THIS PROJECT IN ACCORDANCE WITH INTERNATIONAL PLUMBING CODE AND 13. WORK IN A SAFE AND PROFESSIONAL MANNER AND IN STRICT ACCORDANCE WITH THE APPLICABLE HEALTH AND SAFETY, BUILDING CODES, AND
- 14. KEEP WORK AREA CLEAN AND FREE OF DEBRIS AND IS TO REMOVE ALL TRASH AND DEBRIS FROM THE CONSTRUCTION AREA DAILY. 15. PROTECT SLAB FROM DAMAGE OR STAINING. 16. REPAIR OR REPLACE ANY DAMAGE TO PROPERTY (ADJACENT OR EXISTING), WHICH OCCURS DURING THE PROCESS OF CONSTRUCTION AT NO ADDITIONAL
- 17. CLEAN MUD AND REMOVE DEBRIS TRACKED ONTO EXTERIOR PAVING OR CITY STREETS DURING CONSTRUCTION ACTIVITIES. 18. COORDINATE CONCRETE WASH DOWN AREA WITH CLIENT 19. PROVIDE FINAL CLEANING AND SANITIZATION FOR ALL FOOD PREPARATION ROOMS, EQUIPMENT, AND RESTROOM AREAS. CLIENT MUST INSPECT AND APPROVE THIS WORK.

CONJUNCTION WITH THE CERTIFICATE OF OCCUPANCY. RECORD DRAWINGS

20. PROVIDE RECORD DRAWINGS AND WARRANTY DOCUMENTATION IN

- SHALL PROVIDE AS BUILT INFORMATION INCLUDING GRAPHIC MODIFICATIONS OF ALL DEVIATIONS OCCURRING IN THE FIELD DURING CONSTRUCTION ACTIVITIES, CONSOLIDATE AND INCORPORATE ALL SUBCONTRACTORS' MODIFICATIONS INTO THE RECORD DRAWINGS. CONFIRM FORMAT WITH 1. PROVIDE 1/4" CONTINUOUS CAULK / SEALANT AT ALL DISSIMILAR MATERIAL TRANSITIONS, PLUMBING FIXTURES, COUNTERS, ETC. UNO, COORDINATE WITH CLIENT AND REFERENCE PROJECT MANUAL FOR SPECIFICATIONS. 22. AVOID EXPOSED UTILITY PIPING OR CONDUIT ALONG COOLER FREEZER
- PANELS. HOWEVER, WHERE UTILITIES MUST BE EXPOSED AT COOLER FREEZER PANELS, CONTRACTOR SHALL PROVIDE INSTALL FOLLOWING AN OPTION DESCRIBED BELOW: - SURFACE MOUNT UTILITIES WITH NON-CORROSIVE ANCHORS; SEAL PANEL CONTINUOUSLY WITH SEALANT. - INSTALL UTILITIES 1/2" OFF FACE OF PANEL TO ALLOW FOR CLEANING, USE ONLY NON-CORROSIVE MATERIALS FOR SPACERS AND ANCHORS. - COVER UTILITIES WITH 20 GAUGE STAINLESS STEEL BENT PLATES MOUNTED TO WALL WITH NON-CORROSIVE ANCHORS; APPLY CONTINUOUS SEALANT ALONG EDGES AND JOINTS.
- 23. PROVIDE LETTERING INDICATING UNIT NUMBERS ON ALL ROOF TOP UNITS. 24. ALL BLOCKING BY GC, COORDINATE WITH CLIENT AND REFERENCE DETAILS AND SECTIONS FOR LOCATIONS, CUT TO SIZE AS REQUIRED. 25. NO VISIBLE INSULATION AT GLAZING OR FRAMING. 26. ALL EXTERIOR WALLS TO HAVE INSULATION R25 PER COMCHECK __CALCULATIONS. NOT SHOWN IN DETAILS FOR CLARITY. _____

27. PROVIDE WEATHER BARRIER FOR THE ENTIRE EXTERIOR, REF SPECS FOR



PROJECT SITE

A101

101 ROOM NAME

SYMBOLS LEGEND

NEW

EXISTING

DEMOLISHED

NOT IN SCOPE

SECTION INDICATOR

ELEVATION INDICATOR

DETAIL INDICATOR

GRIDLINE INDICATOR

LEVEL INDICATOR

ROOM TAG

REVISION TAG

INTERIOR WALL TAG

EXTERIOR WALL TAG

FINISH TAG

DOOR TAG

WINDOW TAG

EQUIPMENT TAG

VICINITY MAP

FIRE SAFETY REQUIREMENTS

- REQUIRED BY LOCAL STATE, AND FEDERAL AUTHORITIES HAVING JURISDICTION AT ALL TIMES DURING DEMOLITION AND NEW CONSTRUCTION. MAKE FIELD ADJUSTMENTS TO ALL EXIT SIGNS AND EMERGENCY LIGHTING PER INSPECTIONS FROM THE FIRE MARSHAL HAVING AUTHORITY PRIOR FOR FINAL APPROVALS. LIGHTS SHOWN ON ELECTRICAL DRAWINGS ARE SUBJECT TO CHANGE BASED ON INSPECTIONS.
- CLIENT DEMISED PREMISE. 4. PROVIDE FIRE EXTINGUISHERS IN ACCORDANCE WITH NFPA 10. AUTHORITY HAVING JURISDICTION SHALL APPROVE FINAL FIRE EXTINGUISHER QUANTITY AND LOCATIONS. FOR BIDDING PURPOSES. PROVIDE COST PER UNIT. PORTABLE FIRE EXTINGUISHER SHALL BE LOCATED WITHIN 30 FEET OF COMMERCIAL COOKING EQUIPMENT. FIRE EXTINGUISHERS ARE TO BE MOUNTED SUCH THAT THE BOTTOM OF THE UNIT IS 26" AFF MAX PROVIDE (1) UL LISTED 2A:20BC DRY CHEMICAL FIRE EXTINGUISHER, OR (1)
- SQFT OF WORK AREA OR FRACTION THEREOF (MINIMUM OF TWO AVAILABLE IN ALL CONSTRUCTION AREAS AT ALL TIMES) DURING ENTIRE CONSTRUCTION 6. PROVIDE AND INSTALL KNOX BOX. COORDINATE TYPE OF BOX AND LOCATION WITH FIRE DEPARTMENT OFFICIAL. SEAL ALL FIRE RATED EGRESS CORRIDORS WITH INTUMESCENT SEALING SYSTEMS TO DECK. SEAL BOTH SIDES OF VERTICAL JOINTS AT CMU / GYPSUM

BOARD WALLS. SEAL WALL PENETRATIONS SUCH AS BAR JOISTS, PIPING,

- CONDUIT, DUCTWORK, ETC. PER FIRE STOP MANUFACTURER'S RECOMMENDATIONS. 8. PROVIDE FIRE-STOPPED MATERIAL IN ACCORDANCE WITH LOCAL CODES FOR PENETRATIONS IN WALLS, FLOORS OR ROOF REQUIRING PROTECTED HIRE A LICENSED SPRINKLER CONTRACTOR. CONTRACTOR IS TO SUBMIT SIGNED AND SEALED SPRINKLER DRAWINGS FOR APPROVAL PRIOR TO ANY PERMIT. SUBMIT PLANS TO ARCHITECT AND ENGINEER FOR REVIEW. CONFIRM ALL WATER FLOW TEST INFORMATION WITH LOCAL FIRE DEPARTMENT AND
- AREA WITH REQUIRED ADJUSTMENTS TO EXISTING WORK, FURNISHED AND INSTALLED BY A LICENSED SPRINKLER CONTRACTOR, ANY MODIFICATION TO EXISTING SPRINKLER MAIN LINES MUST BE COORDINATED WITH ARCHITECT AND ENGINEER FOR CLIENT APPROVAL. 10. PROVIDE FIRE BLOCKING IN ACCORANCE WITH SECTION 718.2 AT THE **FOLLOWING LOCATIONS:** - IN CONCEALED SPACES OF STUD WALLS AND PARTITIONS, INCLUDING FURRED SPACES AT THE CEILING AND FLOOR LEVELS. - IN CONCEALED SPACES OF STUD WALLS AND PARTIOITNS, INCLUDING FURRED SPACES, AT 10-FOOT INTERVALS ALONG THE LENGTH OF THE WALL - AT ALL INTERCONNECTIONS BETWEEN CONCEALED VERTICAL AND HORIZONTALS SPACES SUCH AS THOSE OCCURING AT SOFFITS, DROP
- CEILINGS AND COVE CEILINGS.

ABBREVIATION	DEFINITION	
BH	BUGLE HEAD (FLAT HEAD, COUNTERSUNK)	
BP	BLACK PHOSPHATE OVER CARBON STEEL	
HEX	SLOTTED HEX WASHER	
H/L	HIGH / LOW	
KS	KNURLED SHANK	
PAF	POWDER ACTUATED FASTENER	
SD	SELF DRILLING	
ST	SELF TAPPING	

FASTENER SCHEDULE

THESE ARE MINIMUM REQUIREMENTS FOR CONNECTING AND ATTACHING INTERIOR NON-STRUCTURAL FRAMING MEMBERS AND SHALL NOT SUPERSEDE STRUCTURAL REQUIREMENTS

DRAWING INDEX

COVER SHEET

A002 COMCHECK REPORT

A003 SIGHT LINE STUDY

LIFE SAFETY PLAN

DEMOLITION PLAN

DIMENSION PLAN

00 - GENERAL

C100

- MAINTAIN EXISTING FIRE PROTECTION. MEANS OF EGRESS, AND LIFE SAFETY
- PREVENT FLAMMABLE MATERIALS OR LIQUID STORAGE WITHIN BUILDING OR STANDARD UL LISTED 2-1/2 GALLON WATER (E-10) AND (1) UL LISTED 10BC
- CARBON DIOXIDE FIRE EXTINGUISHER MOUNTED TOGETHER IN EACH 3000
- WATER DEPARTMENT VIA SPRINKLER CONTRACTOR. INSTALL IBC APPROVE AUTOMATIC FIRE SPRINKLER SYSTEM THROUGHOUT NEW SCOPE OF WORK

- IN CONCEALED SPACES BETWEEN STAIRWAY STRINGERS AT THE TOP AND BOTTOM OF THE RUN AND BETWEEN STUDS ALONG AND IN LINE WITH THE RUN OF STAIRS IF THE WALL UNDER THE STAIR IS UNFINISHED.
- IN OPENINGS AROUND VENTS, PIPES, DUCTS, CHIMNEYS, FIREPLACES AND SIMILAR OPENINGS WHICH AFFORD A PASSAGE FOR FIRE AT CEILING AND FLOOR LEVELS, WITH NONCOMBUSTIBLE MATERIALS.

ABBREVIATION	DEFINITION
	BUGLE HEAD (FLAT HEAD, COUNTERSUNK
	BLACK PHOSPHATE OVER CARBON STEEL
	SLOTTED HEX WASHER
	HIGH / LOW
	KNURLED SHANK
	POWDER ACTUATED FASTENER
	SELF DRILLING
	SELF TAPPING

MATERIALS	SIZE	DRIVER DESIGN	HEAD	LENGTH	TIP	THREADS	QUANTITY
DRYWALL TO METAL FRAMING	#10 WITH SERRATIONS	PHILLIPS #2	PANCAKE	1/2" MIN PENETRATION BEYOND METAL FRAMING	SD	FINE	TO MEET THE GYPSUM ASSOCIATION GUIDELINES
METAL STUD TO TRACKS	#10 WITH SERRATIONS	PHILLIPS #2	PANCAKE	3/4" MIN	SD		ONE PER STUD FLANGE
METAL TO METAL FRAMING	#10 WITH SERRATIONS	HEX	HEX	3/4" MIN	SD		AS SHOWN ON DETAILS WITH M 1-1/2" BETWEEN EACH (MIN 3)
DRYWALL TO METAL FRAMING	#8	PHILLIPS #2	ВН	1/2" MIN PENETRATION BEYOND THE STUD	ST	FINE	TO MEET THE GYPSUM ASSOCIATION GUIDELINES
SHEET METAL TO STEEL	#12	HEX	HEX	1/2" MIN PENETRATION BEYOND THE STEEL THICKNESS	SD		AS SHOWN ON DETAILS WITH M 1-1/2" BETWEEN EACH
CEMENT BOARD TO METAL FRAMING	#8 COATED	PHILLIPS #2	WAFER	1/2" MIN PENETRATION BEYOND METAL FRAMING	SD	H/L	TO MEET THE GYPSUM ASSOCIATION GUIDELINES
CEMENT BOARD TO WOOD FRAMING	#9 COATED	PHILLIPS #2	WAFER	3/4" PENETRATION INTO WOOD	ST	H/L	TO MEET THE GYPSUM ASSOCIATION GUIDELINES
WOOD TO STEEL	#12	HEX	HEX	1/2" MIN PENETRATION BEYOND THE STEEL THICKNESS	SD		AS SHOWN ON DETAILS
WOOD TO STEEL	.157" DIA	PAF		PENETRATION THROUGH STEEL	KS		AS SHOWN ON DETAILS
WOOD TO METAL FRAMING	#12	PHILLIPS #3	FLAT	1/2" MIN PENETRATION BEYOND METAL FRAMING	SD		AS SHOWN ON DETAILS
METAL STUD TRACK TO CONCRETE FLOOR	1/4"	HEX	HEX	1-1/2" MIN EMBEDMENT			(2) AT 16" OC - LOCATE 1/4" FRO EDGE OF TRACK
METAL STUD TRACK TO CONCRETE FLOOR	.157" DIA	PAF		1-1/4" MIN EMBEDMENT	KS		(2) AT 16" OC - LOCATE 1/4" FRO EDGE OF TRACK
METAL STUD TRACK TO COOLER PANEL	#12	HEX	HEX	1-1/2" MAX EMBEDMENT	SD		AS SHOWN ON DETAILS

ADDENDUM 1 06/20/25 C400 GRADING PLAN ADDENDUM 1 06/20/25 DETAILED GRADING 06/20/25 PRE-CONSTRUCTION EROSION **ADDENDUM 1** MID-CONSTRUCTION EROSION **ADDENDUM 1** 06/20/25 POST-CONSTRUCTION EROSION **ADDENDUM 1** 06/20/25 06/20/25 **EXISTING DRAINAGE MAP** ADDENDUM 1 **ADDENDUM 1** PROPOSED DRAINAGE MAP 06/20/25 **ADDENDUM 1** 06/20/25 ADDENDUM 1 STORM LINE 200 & 300 ADDENDUM 1 06/20/25 DOWNSPOUT PIPE PLAN 06/20/25 ADDENDUM 1 UTILITY PLAN 06/20/25 **EROSION CONTROL DETAILS ADDENDUM 1** 06/20/25 CONSTRUCTION DETAILS ADDENDUM 1 CONSTRUCTION DETAILS 06/20/25 ADDENDUM 1 CONSTRUCTION DETAILS ADDENDUM 1 LANDSCAPE PLAN ADDENDUM 1 PLANTING DETAILS ORIGINAL ISSUE 3 - ARCHITECTURAL A100 SITE PLAN ADDENDUM 1 A101 PARTITION PLAN ADDENDUM 1 A102 PARTITION DETAILS ADDENDUM 1 CANOPY ENLARGED PLAN AND DETAILS **ADDENDUM 1** CANOPY DETAILS **ADDENDUM 1** A300 ROOF PLAN ADDENDUM 1 A301 ROOF DETAILS ORIGINAL ISSUE A302 BUILDING SECTIONS ADDENDUM 1 **EXTERIOR ELEVATIONS** ADDENDUM 1 WALL SECTIONS **ADDENDUM 1** WALL SECTIONS **ADDENDUM 1** TRASH ENCLOSURE PLAN AND DETAILS ORIGINAL ISSUE ENLARGED PATIO PLAN AND DETAILS **ADDENDUM 1** ENLARGED STORAGE ROOF PLAN AND DETAILS **ADDENDUM 1** A800 DOOR AND WINDOW INFORMATION ADDENDUM 1 03 - STRUCTURAL S001 GENERAL NOTES **ORIGINAL ISSUE ORIGINAL ISSUE** S002 SPECIAL INSPECTIONS CONCRETE TABLES ORIGINAL ISSUE LOADING DIAGRAMS **ADDENDUM 1** S101 FOUNDATION PLAN **ADDENDUM 1** S102 **ADDENDUM 1** ROOF FRAMING PLAN TYPICAL FOUNDATION DETAILS & SECTIONS ORIGINAL ISSUE S211 FOUNDATION DETAILS & SECTIONS ORIGINAL ISSUE TYPICAL FRAMING DETAILS & SECTIONS ORIGINAL ISSUE FRAMING DETAILS & SECTIONS ADDENDUM 1 S312 FRAMING DETAILS & SECTIONS **ADDENDUM 1** S321 STEEL SCHEDULES ADDENDUM 1 S401 SITE DETAILS 05/01/25 **ORIGINAL ISSUE** 06/20/25 S501 MASONRY SCHEDULES AND DETAILS ADDENDUM 1 04 - MECHANICAL M100 FLOOR PLAN - MECHANICAL 06/20/25 ADDENDUM 1 06/20/25 M200 ROOF PLAN - MECHANICAL ADDENDUM 1 05/01/25 M300 MECHANICAL DETAILS, GEN. NOTES, & SYMBOLS ORIGINAL ISSUE MEP100 | SPECIFICATIONS 05/01/25 ORIGINAL ISSUE MEP101 | SPECIFICATIONS 05/01/25 ORIGINAL ISSUE 05/01/25 MEP102 | SPECIFICATIONS ORIGINAL ISSUE MEP103 MEP SCHEDULES 06/20/25 **ADDENDUM 1** 05 - PLUMBING P100 FLOOR PLAN - PLUMBING ADDENDUM 1 06/20/25 P200 ROOF PLAN - PLUMBING ADDENDUM 1 06/20/25 06/20/25 P300 PLUMBING SCHEDULES, GEN. NOTES, & SYMBOLS ADDENDUM 1 06 - ELECTRICAL E001 SITE PLAN - ELECTRICAL 05/01/25 ORIGINAL ISSUE 06/20/25 E002 SITE PLAN - PHOTOMETRIC ADDENDUM 1 E100 FLOOR PLAN - POWER 06/20/25 **ADDENDUM 1** 06/20/25 E200 FLOOR PLAN - LIGHTING **ADDENDUM 1** E300 FLOOR PLAN - SYSTEMS ADDENDUM 1 06/20/25 E400 ROOF PLAN - ELECTRICAL ADDENDUM 1 06/20/25 E500 ELECTRICAL DETAILS 05/01/25 ORIGINAL ISSUE E600 ELECTRICAL SCHEDULES, GEN. NOTES, & SYMBOLS 06/20/25 ADDENDUM 1 09 - FIRE PROTECTION FP100 | FLOOR PLAN - FIRE PROTECTION ADDENDUM 1 06/20/25 ABBREVIATION I FGFND ARREVIATION LEGEND

BREVIATION LEGEND		ABBREVIATION LEGEND		
XX	DEFINITION	XX	DEFINITION	
	ACOUSTICAL CEILING TILE	MDF	MEDIUM DENSITY FIBERBOARD	
	AMERICANS WITH DISABILITIES ACT	MECH	MECHANICAL	
	ABOVE FINISHED FLOOR	MEPFR	MECHANICAL, ELECTRICAL, PLUMBING, FIRE, REFRIGERATION	
	AIR HANDLING UNIT	MFR	MANUFACTURER	
	AMERICAN INSTITUTE OF STEEL CONSTRUCTION	MIN	MINIMUM	
	ARCHITECTURAL	MISC	MISCELLANEOUS	
	AMERICAN SOCIETY OF TESTING AND MATERIALS	MTL	METAL	
	BELOW FINISHED FLOOR	MW	MILLWORK	
	BUILDING	NIC	NOT IN CONTRACT	
	BOTTOM OF	NO	NUMBER	
	BACK OF HOUSE	NTS	NOT TO SCALE	
	BOTTOM OF STEEL OR BOTTOM OF STUD	OC	ON CENTER	
	CONTROL JOINT	OCV	ON CENTER VERTICALLY	
	CENTERLINE	ОН	OPPOSITE HAND	
	CLEAR	OTS	OPEN TO STRUCTURE	
	CONSTRUCTION MANAGER	PAF	POWDER ACTUATED FASTENER	
	CONCRETE MASONRY UNIT	PCF	POUNDS PER CUBIC FOOT	
	CONTINUOUS	PLAM	PLASTIC LAMINATE	
	DEMOLISH/DEMOLITION	PLF	POUNDS PER LINEAR FOOT	
	DIAMETER	PLY	PLYWOOD	
	DIMENSION/DIMENSIONAL	PSF	POUNDS PER SQUARE FOOT	
	EXTERIOR INSULATION AND FINISH SYSTEM	PSI	POUNDS PER SQUARE INCH	
	ELECTRICAL	PT	PRESSURE TREATED	
	EQUAL	PVC	POLYVINYL CHLORIDE	
	EXISTING TO REMAIN	QTY	QUANTITY	
	EXTERIOR	RCP	REFLECTED CEILING PLAN	
	FINISHED FLOOR	REF	REFER TO	
	FRONT OF HOUSE	REINF	REINFORCING	
	FIBERGLASS REINFORCED PLASTIC	RO	ROUGH OPENING	
	FIRE RETARDANT TREATED	RR	RESTROOM	
	GAUGE	RTU	ROOF TOP UNIT	
	GENERAL CONTRACTOR	SCHED	SCHEDULE	
	GYPSUM BOARD	SIM	SIMILAR	
	HEIGHT	SPECS	SPECIFICATIONS	
	HOLLOW METAL	SQ	SQUARE	
	HORIZONTAL	SS	STAINLESS STEEL	
	HOLLOW STRUCTURAL SECTION	STR	STRUCTURAL	
	HEATING, VENTILATION, AIR CONDITIONING	TI	TENANT IMPROVEMENT	
	INTERNATIONAL BUILDING CODE	ТО	TOP OF	
	INTERNATIONAL CODE COUNCIL	TOS	TOP OF STEEL OR TOP OF STUD	
	INFORMATION	TYP	TYPICAL	
	ISOLATION	UNO	UNLESS NOTED OTHERWISE	
	LENGTH	VERT	VERTICAL	
		1 1		

POUNDS

LANDLORD

MAXIMUM

LONG LEG HORIZONTAL

LONG LEG VERTICAL

J			
6/20/25			
6/20/25			
5/01/25			
3			
6/20/25			
6/20/25			
5/01/25			
6/20/25			
6/20/25			
6/20/25			
6/20/25			
5/01/25			
6/20/25			
6/20/25			
6/20/25			
		\cup	
5/01/25			
5/01/25		>	
5/01/25			
6/20/25		D	
6/20/25		I -	
6/20/25			Ш
5/01/25			Ŋ
5/01/25			4
5/01/25		_	VILLAG
6/20/25			
6/20/25			>
GIODIOE D			

ARCHITECT OF RECORD

LATEST REVISION

ADDENDUM 1

ADDENDUM 1

REVISED

06/20/25 06/20/25

06/20/25


06/20/25

06/20/25

8131 METCALF AVENUE

OVERLAND PARK, KS 66204

62500002 CHECKED BY TM ROFESSIONAL SEAL

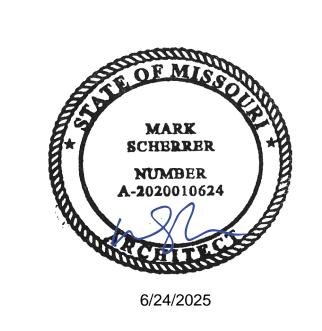

THIS DRAWING WAS PREPARED FOR USE ON A SPECIFIC SITE CONTEMPORANEOUSLY WITH ITS ISSUE DATE AND IT IS NOT SUITABLE FOR USE ON A DIFFERENT PROJECT SITE OR AT A LATER TIME. USE OF THIS DRAWING FOR REFERENCE OR EXAMPLE ON ANOTHER PROJECT REQUIRES THE SERVICES OF PROPERLY LICENSED ARCHITECTS AND ENGINEERS.
REPRODUCTION OF THIS DRAWING FOR REUSE ON ANOTHER PROJECT IS NOT AUTHORIZED AND MAY BE CONTRARY TO THE LAW. BRR DOES NOT GUARANTEE THAT <u>CAD</u> FILES ARE SUFFICIENT OR APPROPRIATE FOR USER'S PURPOSES. USER USES OR ALTERS THESE FILES AT USER'S SOLE RISK AND AGREES TO INDEMNIFY BRR FROM LIABILITY ARISING FROM USER'S USE.

ISSUES AND REVISIONS			
NUMBER	DATE	DESCRIPTION	
0	05/01/25	ORIGINAL ISSUE	
1	06/20/25	ADDENDUM 1	

COVER SHEET

VERIFY IN FIELD

WALL TO DECK

BRR ORIGINAL PRINTED ON RECYCLED PAPER

VOLATILE ORGANIC COMPOUND

WITH ADA STANDARDS.

PROJECT TEAM

Q39

OWNER

1000 W 39TH ST KANSAS CITY, MO 64111

(913) 205-7370

ARCHITECT

SCHEDULE FOR LOCATIONS.

BRR ARCHITECTURE INC.

> 8131 METCALF AVENUE **OVERLAND PARK, KS 66204** (913) 262-9095

STRUCTURAL ENGINEER

SCHAEFER

2800 NORTH CENTRAL AVENUE, SUITE 1250 PHOENIX, ARIZONA 85004

(602) 362-1100

TYPES AND LOCATIONS, TYP

MECHANICAL ENGINEER **LANKFORD** FENDLER + **ASSOCIATES**

1730 WALNUT ST

KANSAS CITY, MO 64108

(816) 221-1411

(816) 221-1411

ELECTRICAL ENGINEER LANKFORD FENDLER + **ASSOCIATES** 1730 WALNUT ST KANSAS CITY, MO 64108

PLUMBING ENGINEER **LANKFORD** FENDLER + **ASSOCIATES** 1730 WALNUT ST **KANSAS CITY, MO 64108**

(816) 221-1411

DEMO


FIRE PROTECTION ENGINEER LANKFORD FENDLER + **ASSOCIATES** 1730 WALNUT ST KANSAS CITY, MO 64108


(816) 221-1411

BHC 7101 COLLEGE BLVD., STE. 400 **OVERLAND PARK, KS 66210**

CIVIL ENGINEER

(913) 663-1900

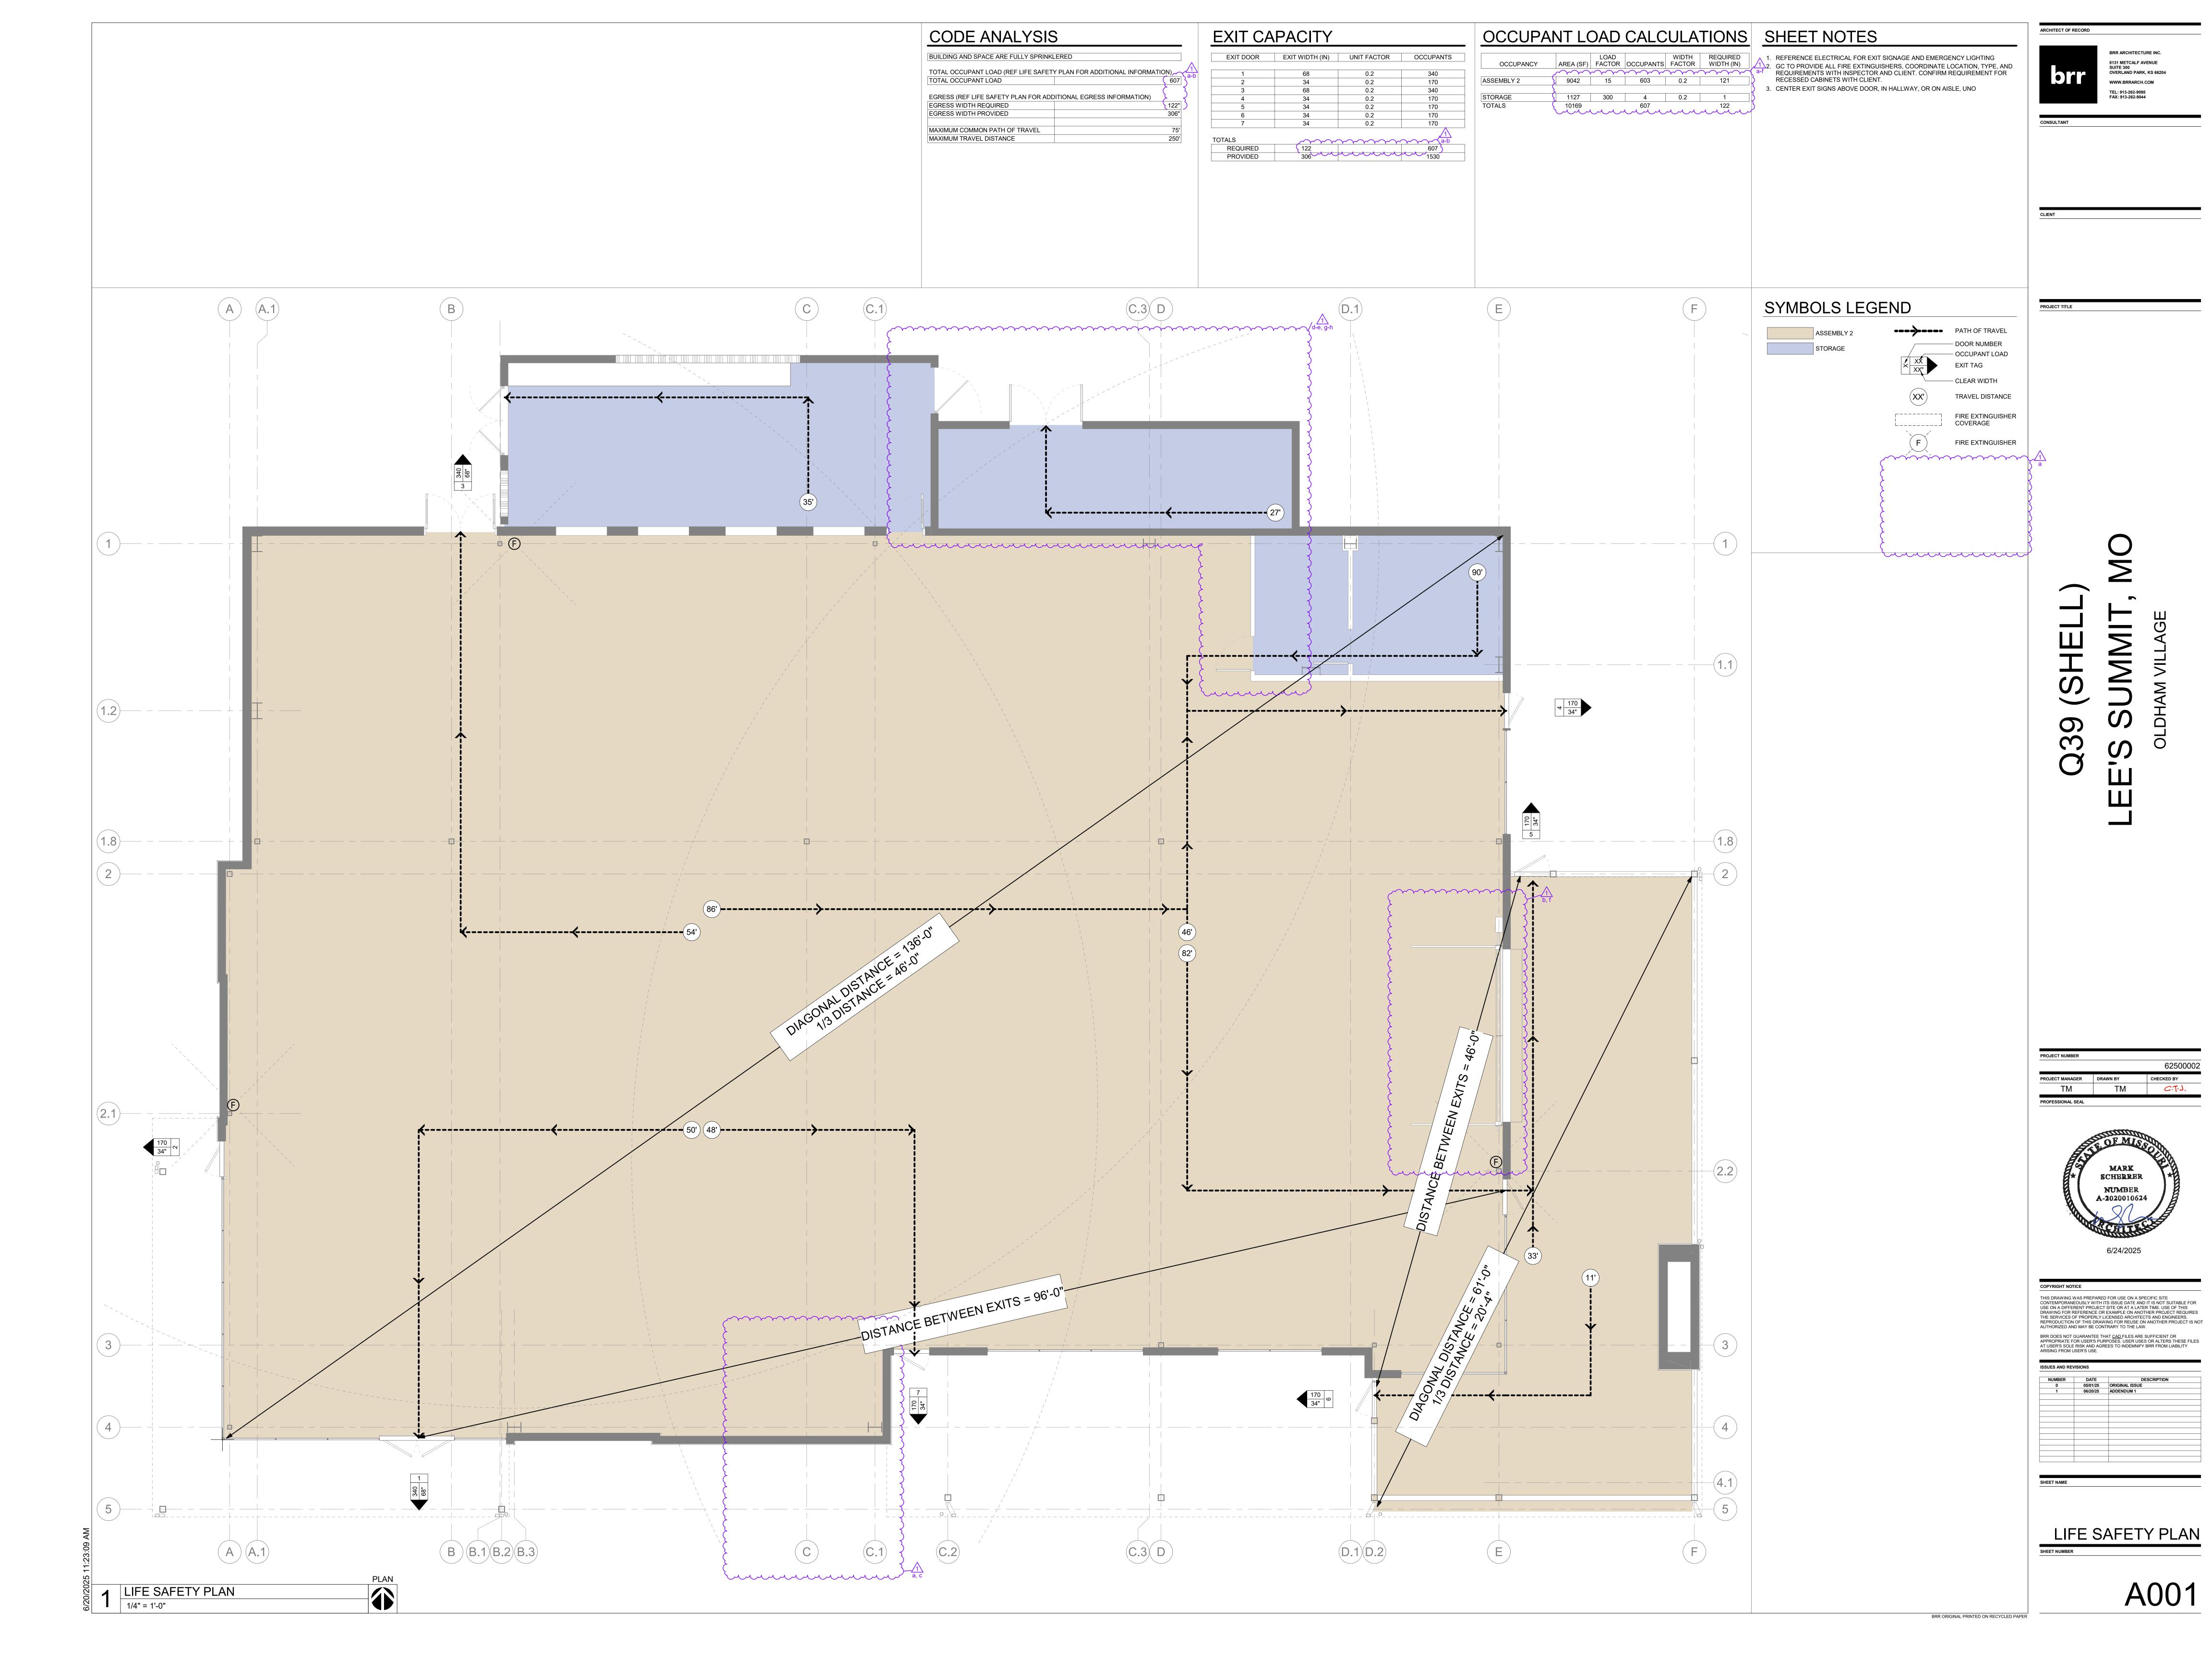

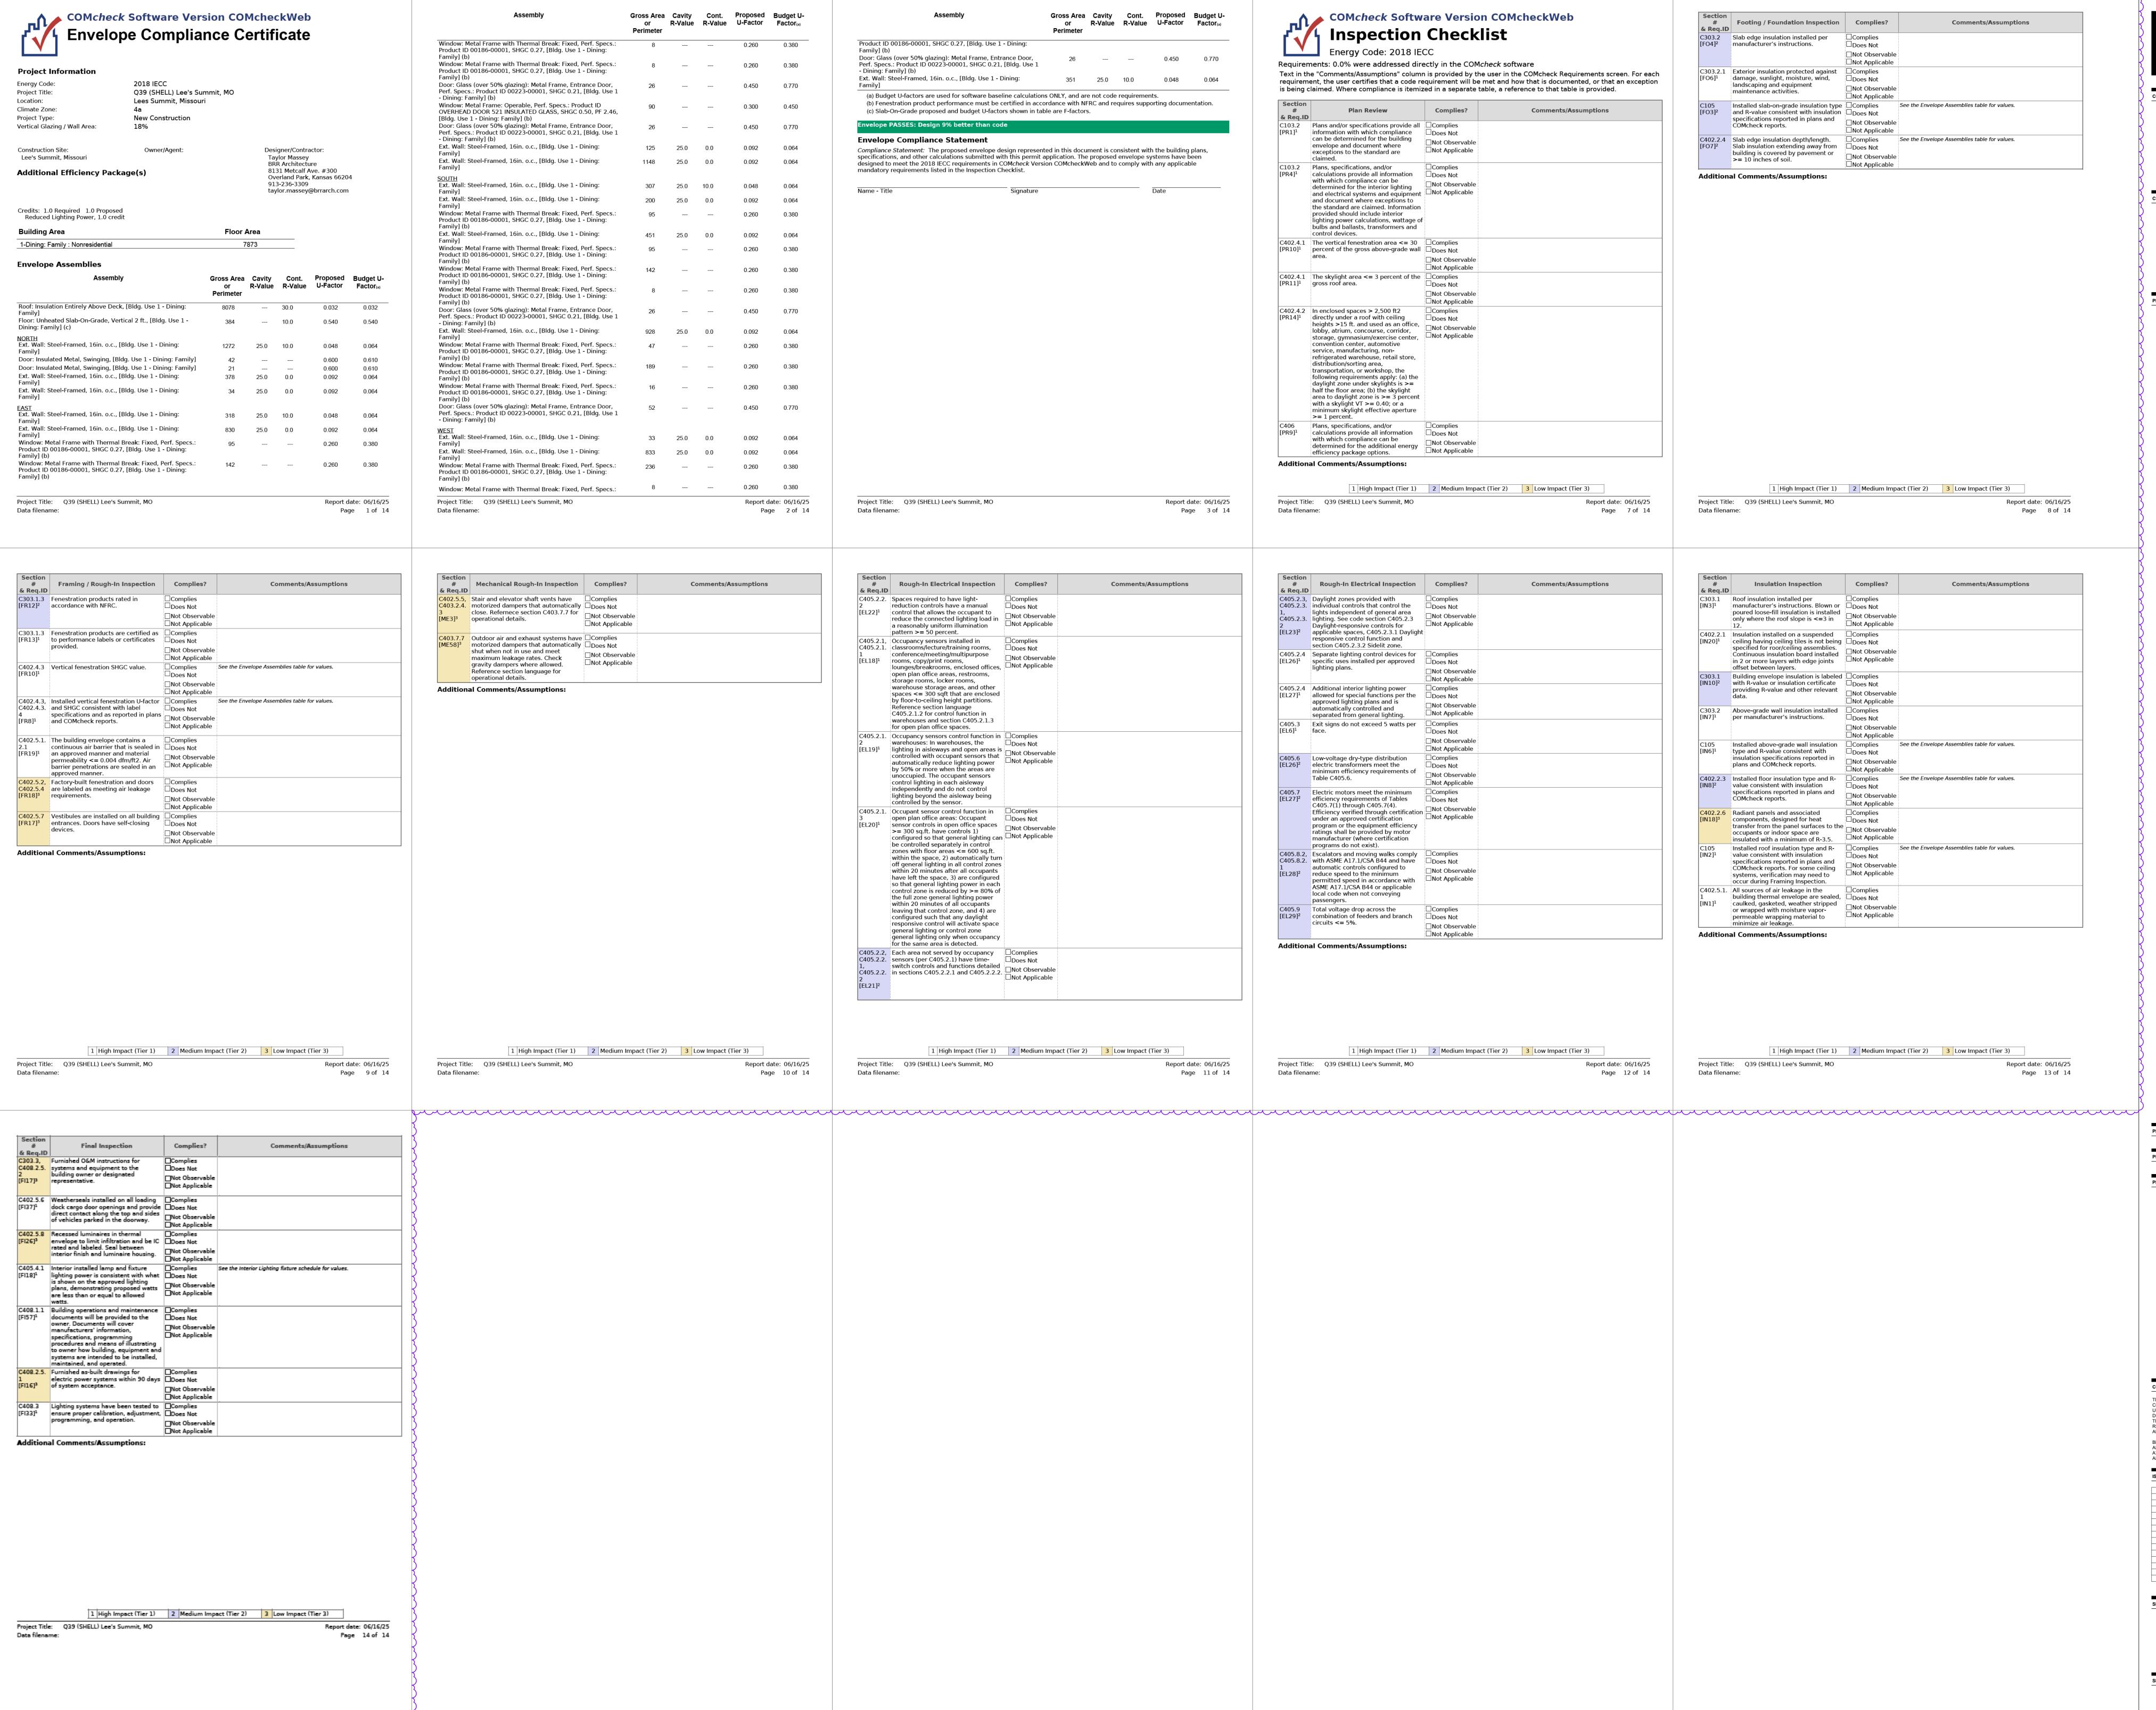

ARCHITECT OF RECORD BRR ARCHITECTURE INC 8131 METCALF AVENUE **OVERLAND PARK, KS 66204** WWW.BRRARCH.COM TEL: 913-262-9095 FAX: 913-262-9044

62500002 TM TM





THIS DRAWING WAS PREPARED FOR USE ON A SPECIFIC SITE CONTEMPORANEOUSLY WITH ITS ISSUE DATE AND IT IS NOT SUITABLE FOR USE ON A DIFFERENT PROJECT SITE OR AT A LATER TIME. USE OF THIS DRAWING FOR REFERENCE OR EXAMPLE ON ANOTHER PROJECT REQUIRES. THE SERVICES OF PROPERLY LICENSED ARCHITECTS AND ENGINEERS.
REPRODUCTION OF THIS DRAWING FOR REUSE ON ANOTHER PROJECT IS NOT AUTHORIZED AND MAY BE CONTRARY TO THE LAW. BRR DOES NOT GUARANTEE THAT <u>CAD</u> FILES ARE SUFFICIENT OR APPROPRIATE FOR USER'S PURPOSES. USER USES OR ALTERS THESE FILES AT USER'S SOLE RISK AND AGREES TO INDEMNIFY BRR FROM LIABILITY ARISING FROM USER'S USE. ISSUES AND REVISIONS


05/01/25 ORIGINAL ISSUE 06/20/25 ADDENDUM 1

BRR ORIGINAL PRINTED ON RECYCLED PAPER


REPORT

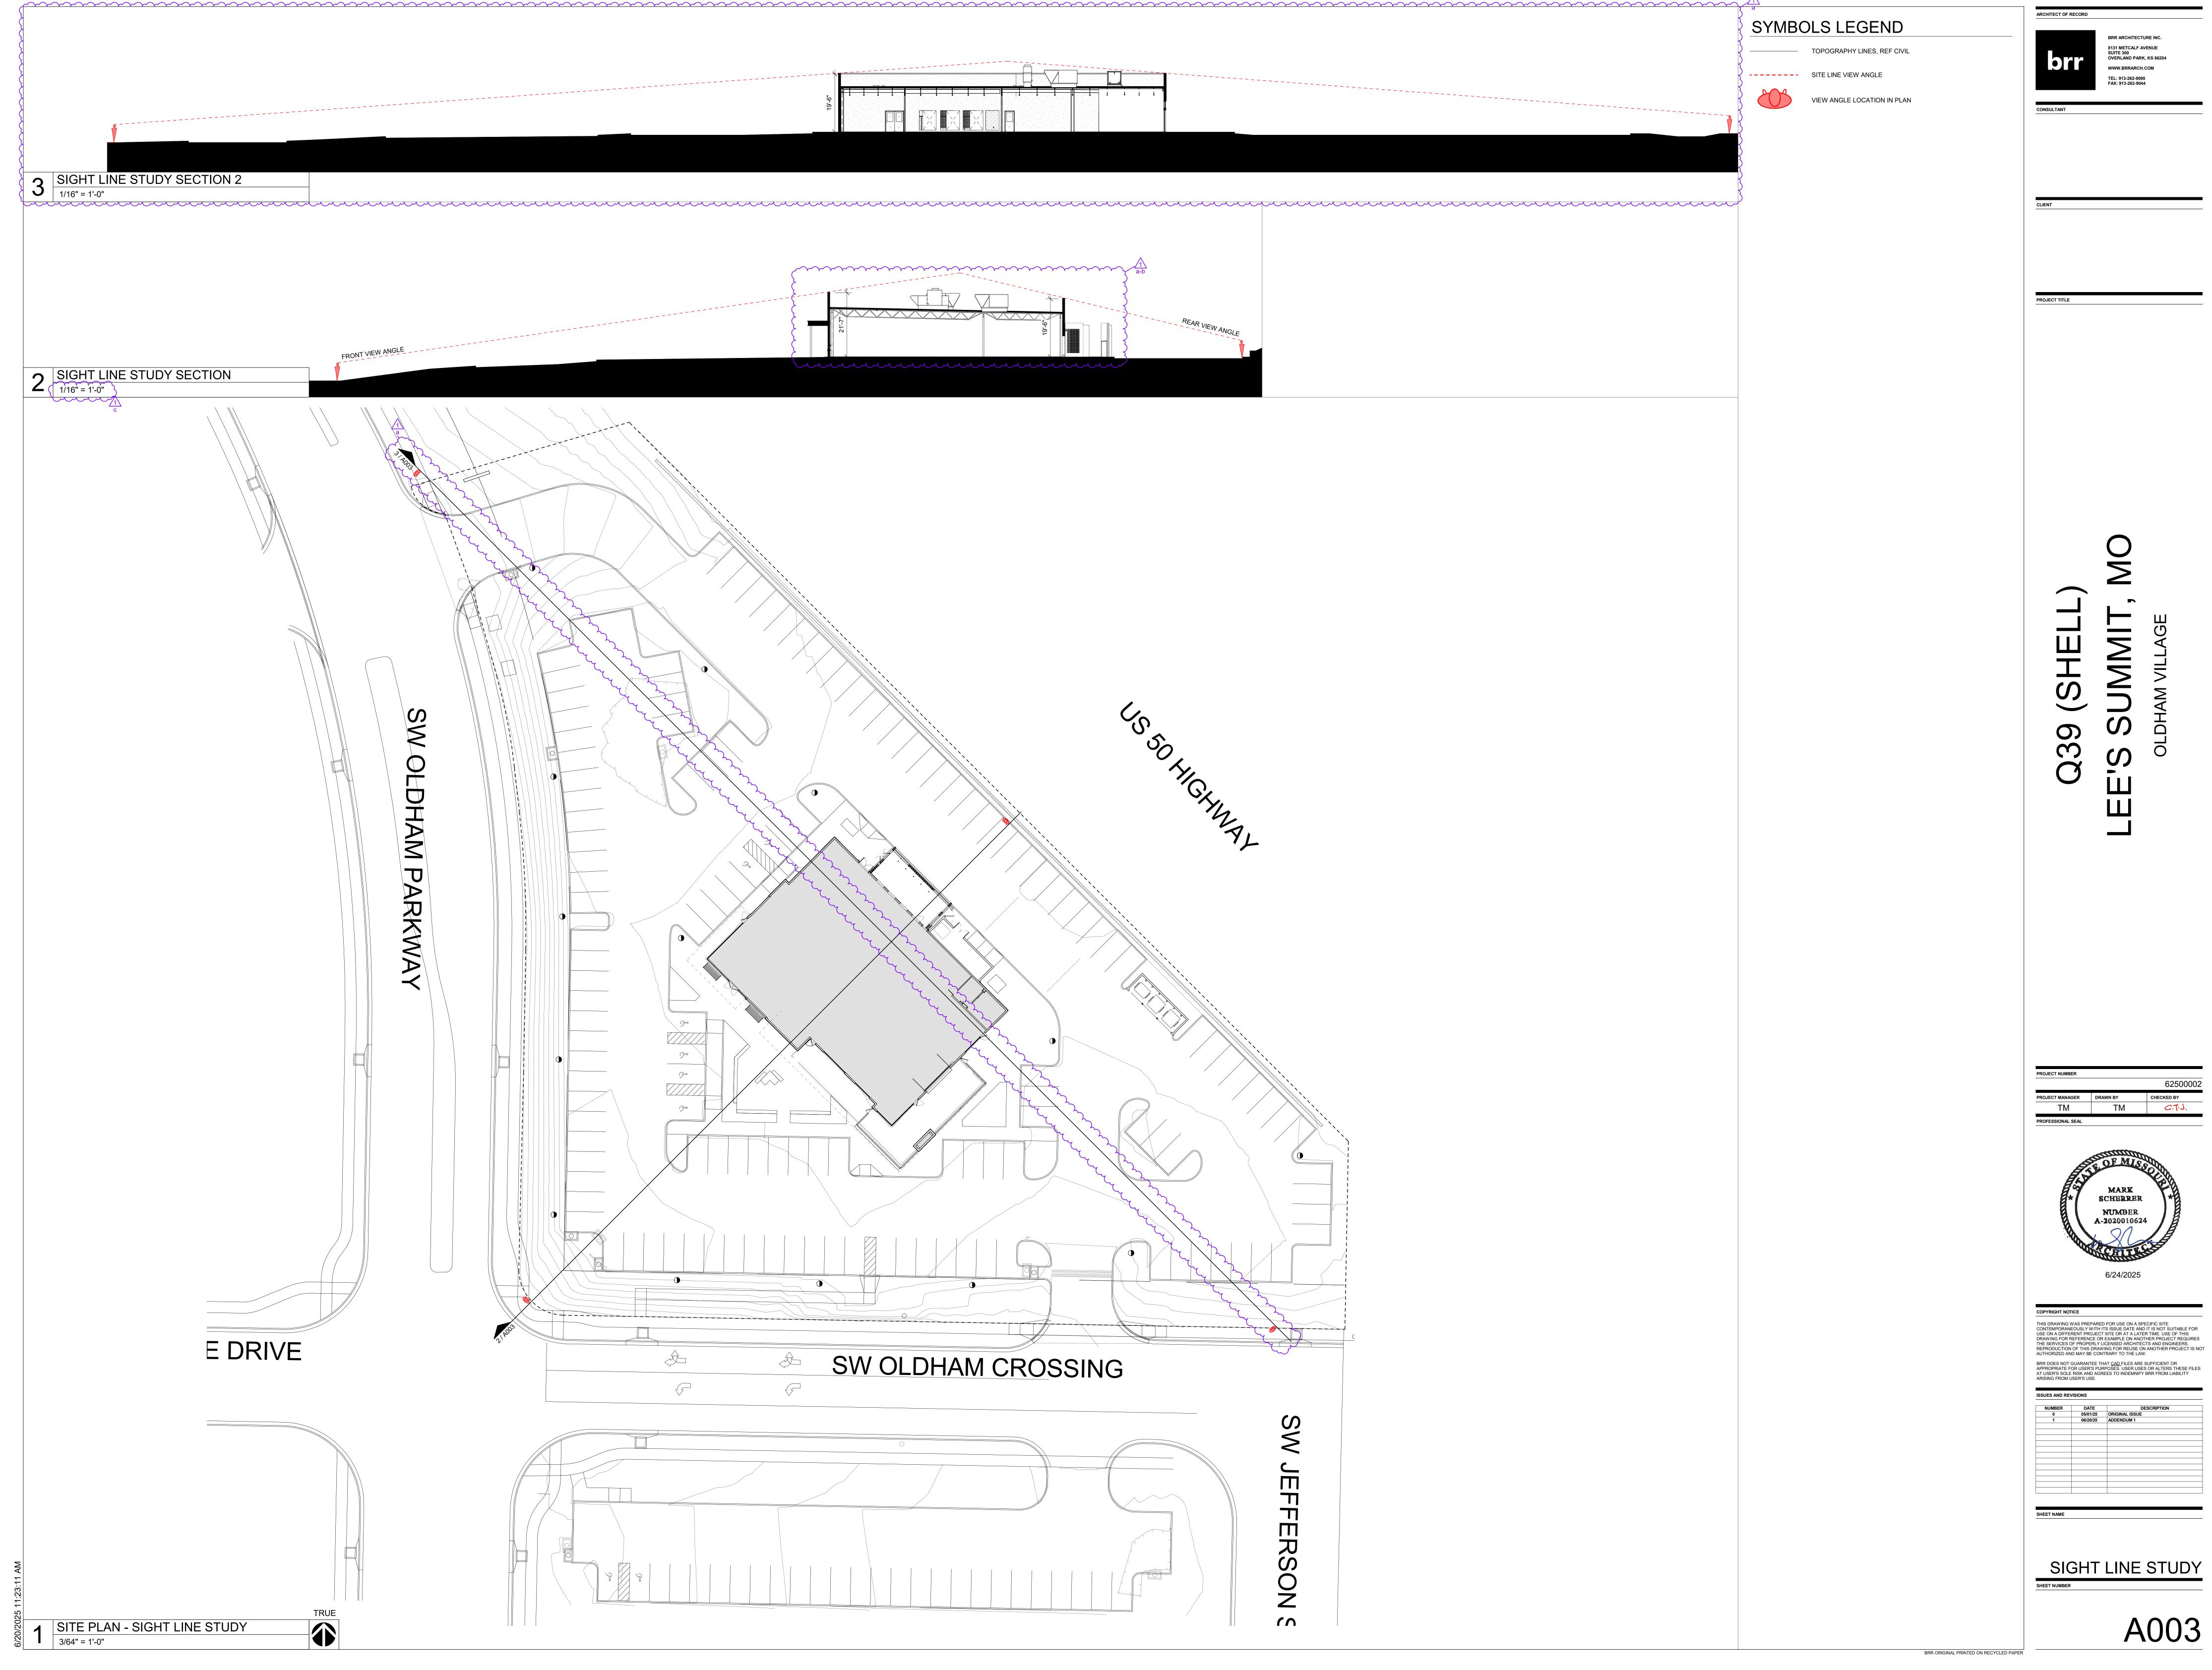


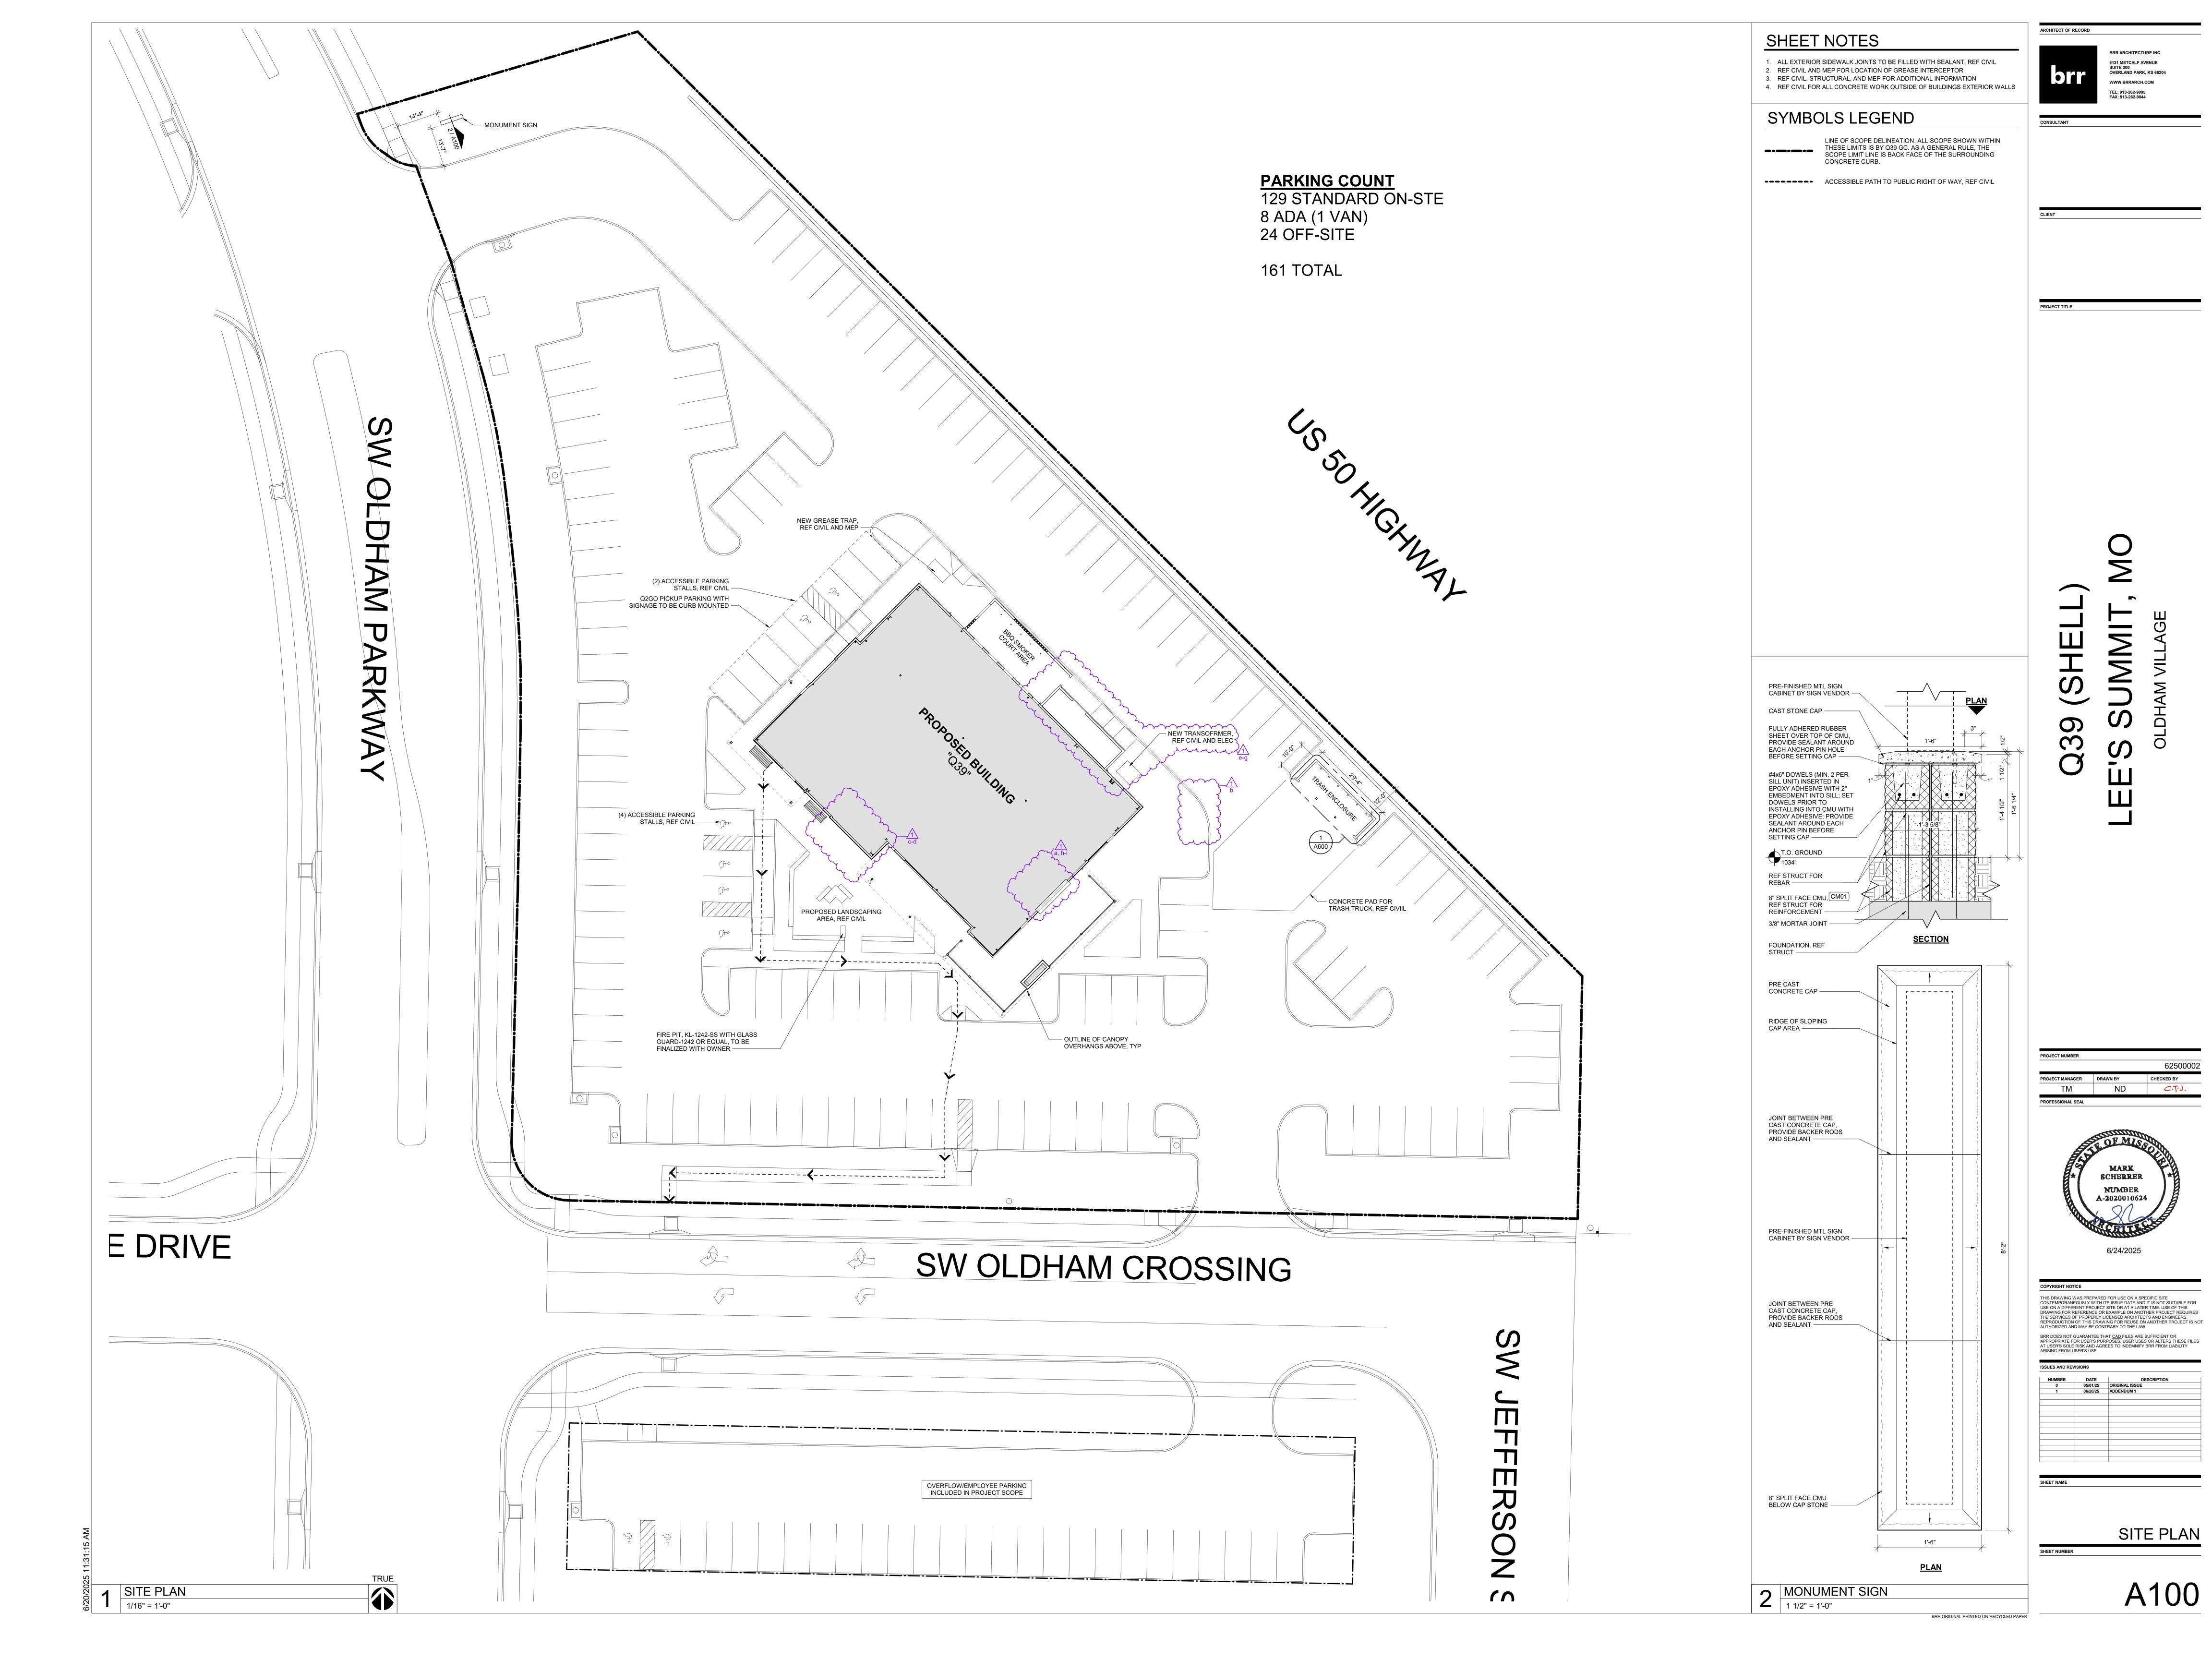

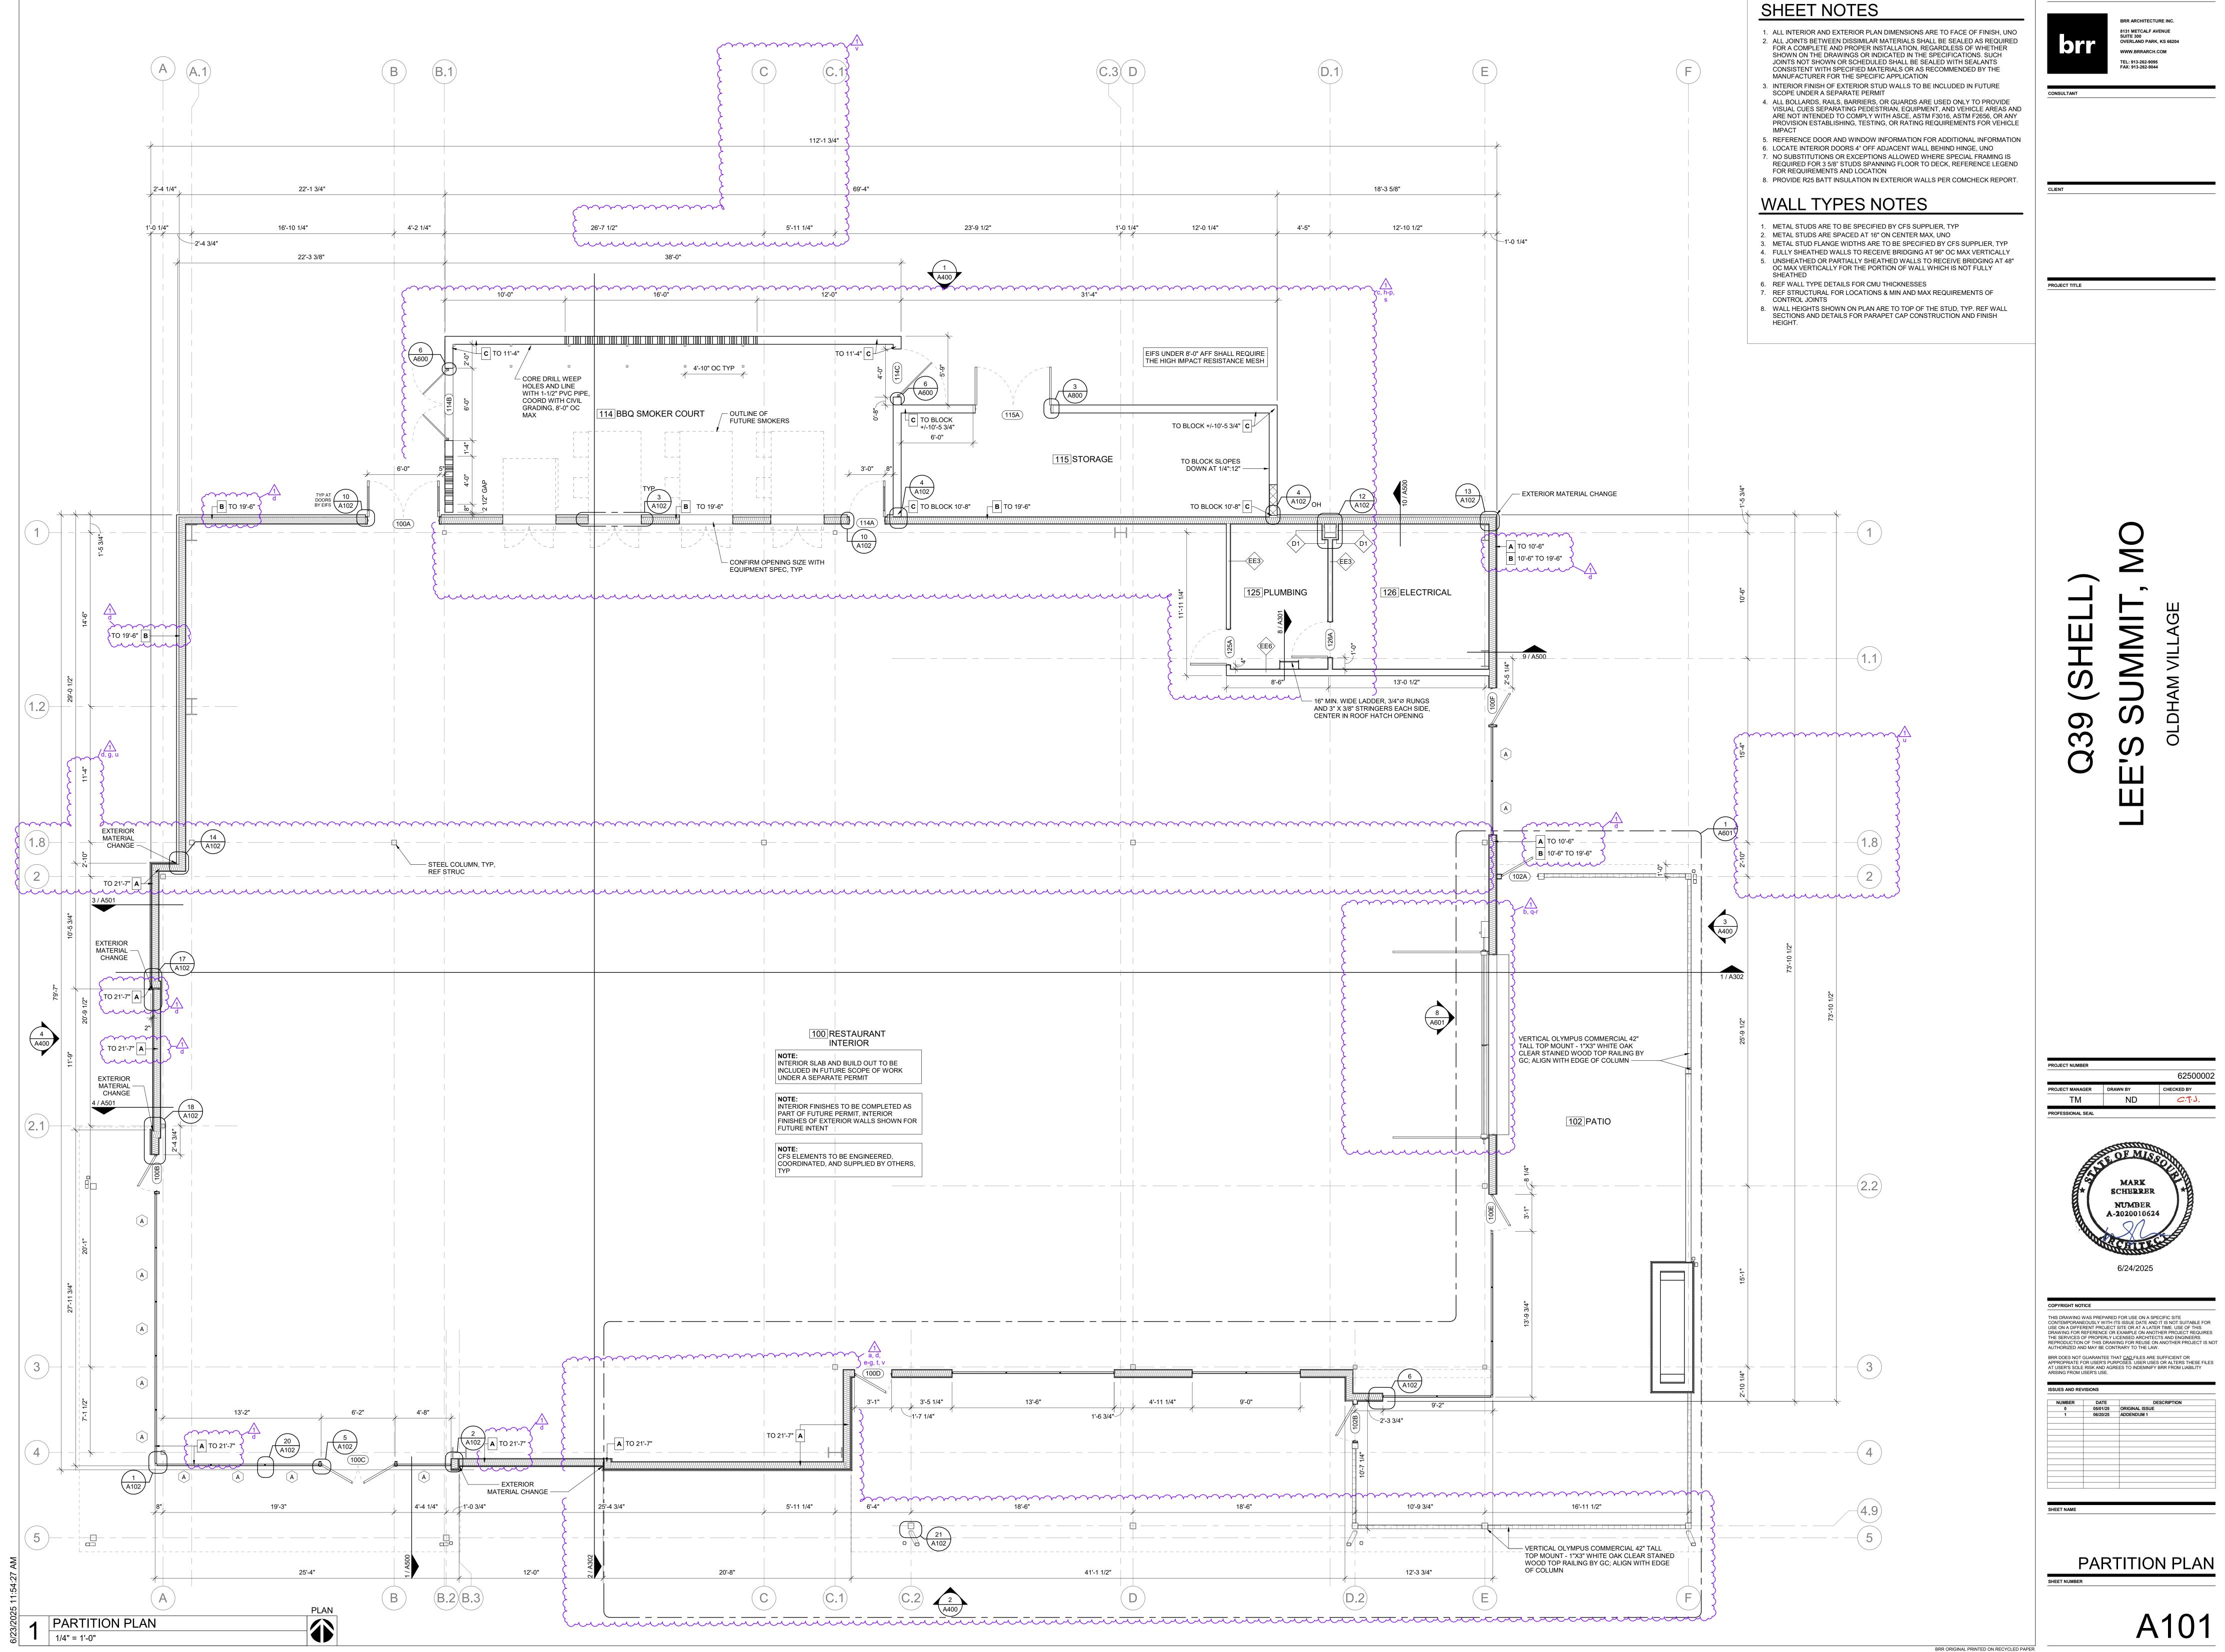

ARCHITECT OF RECORD

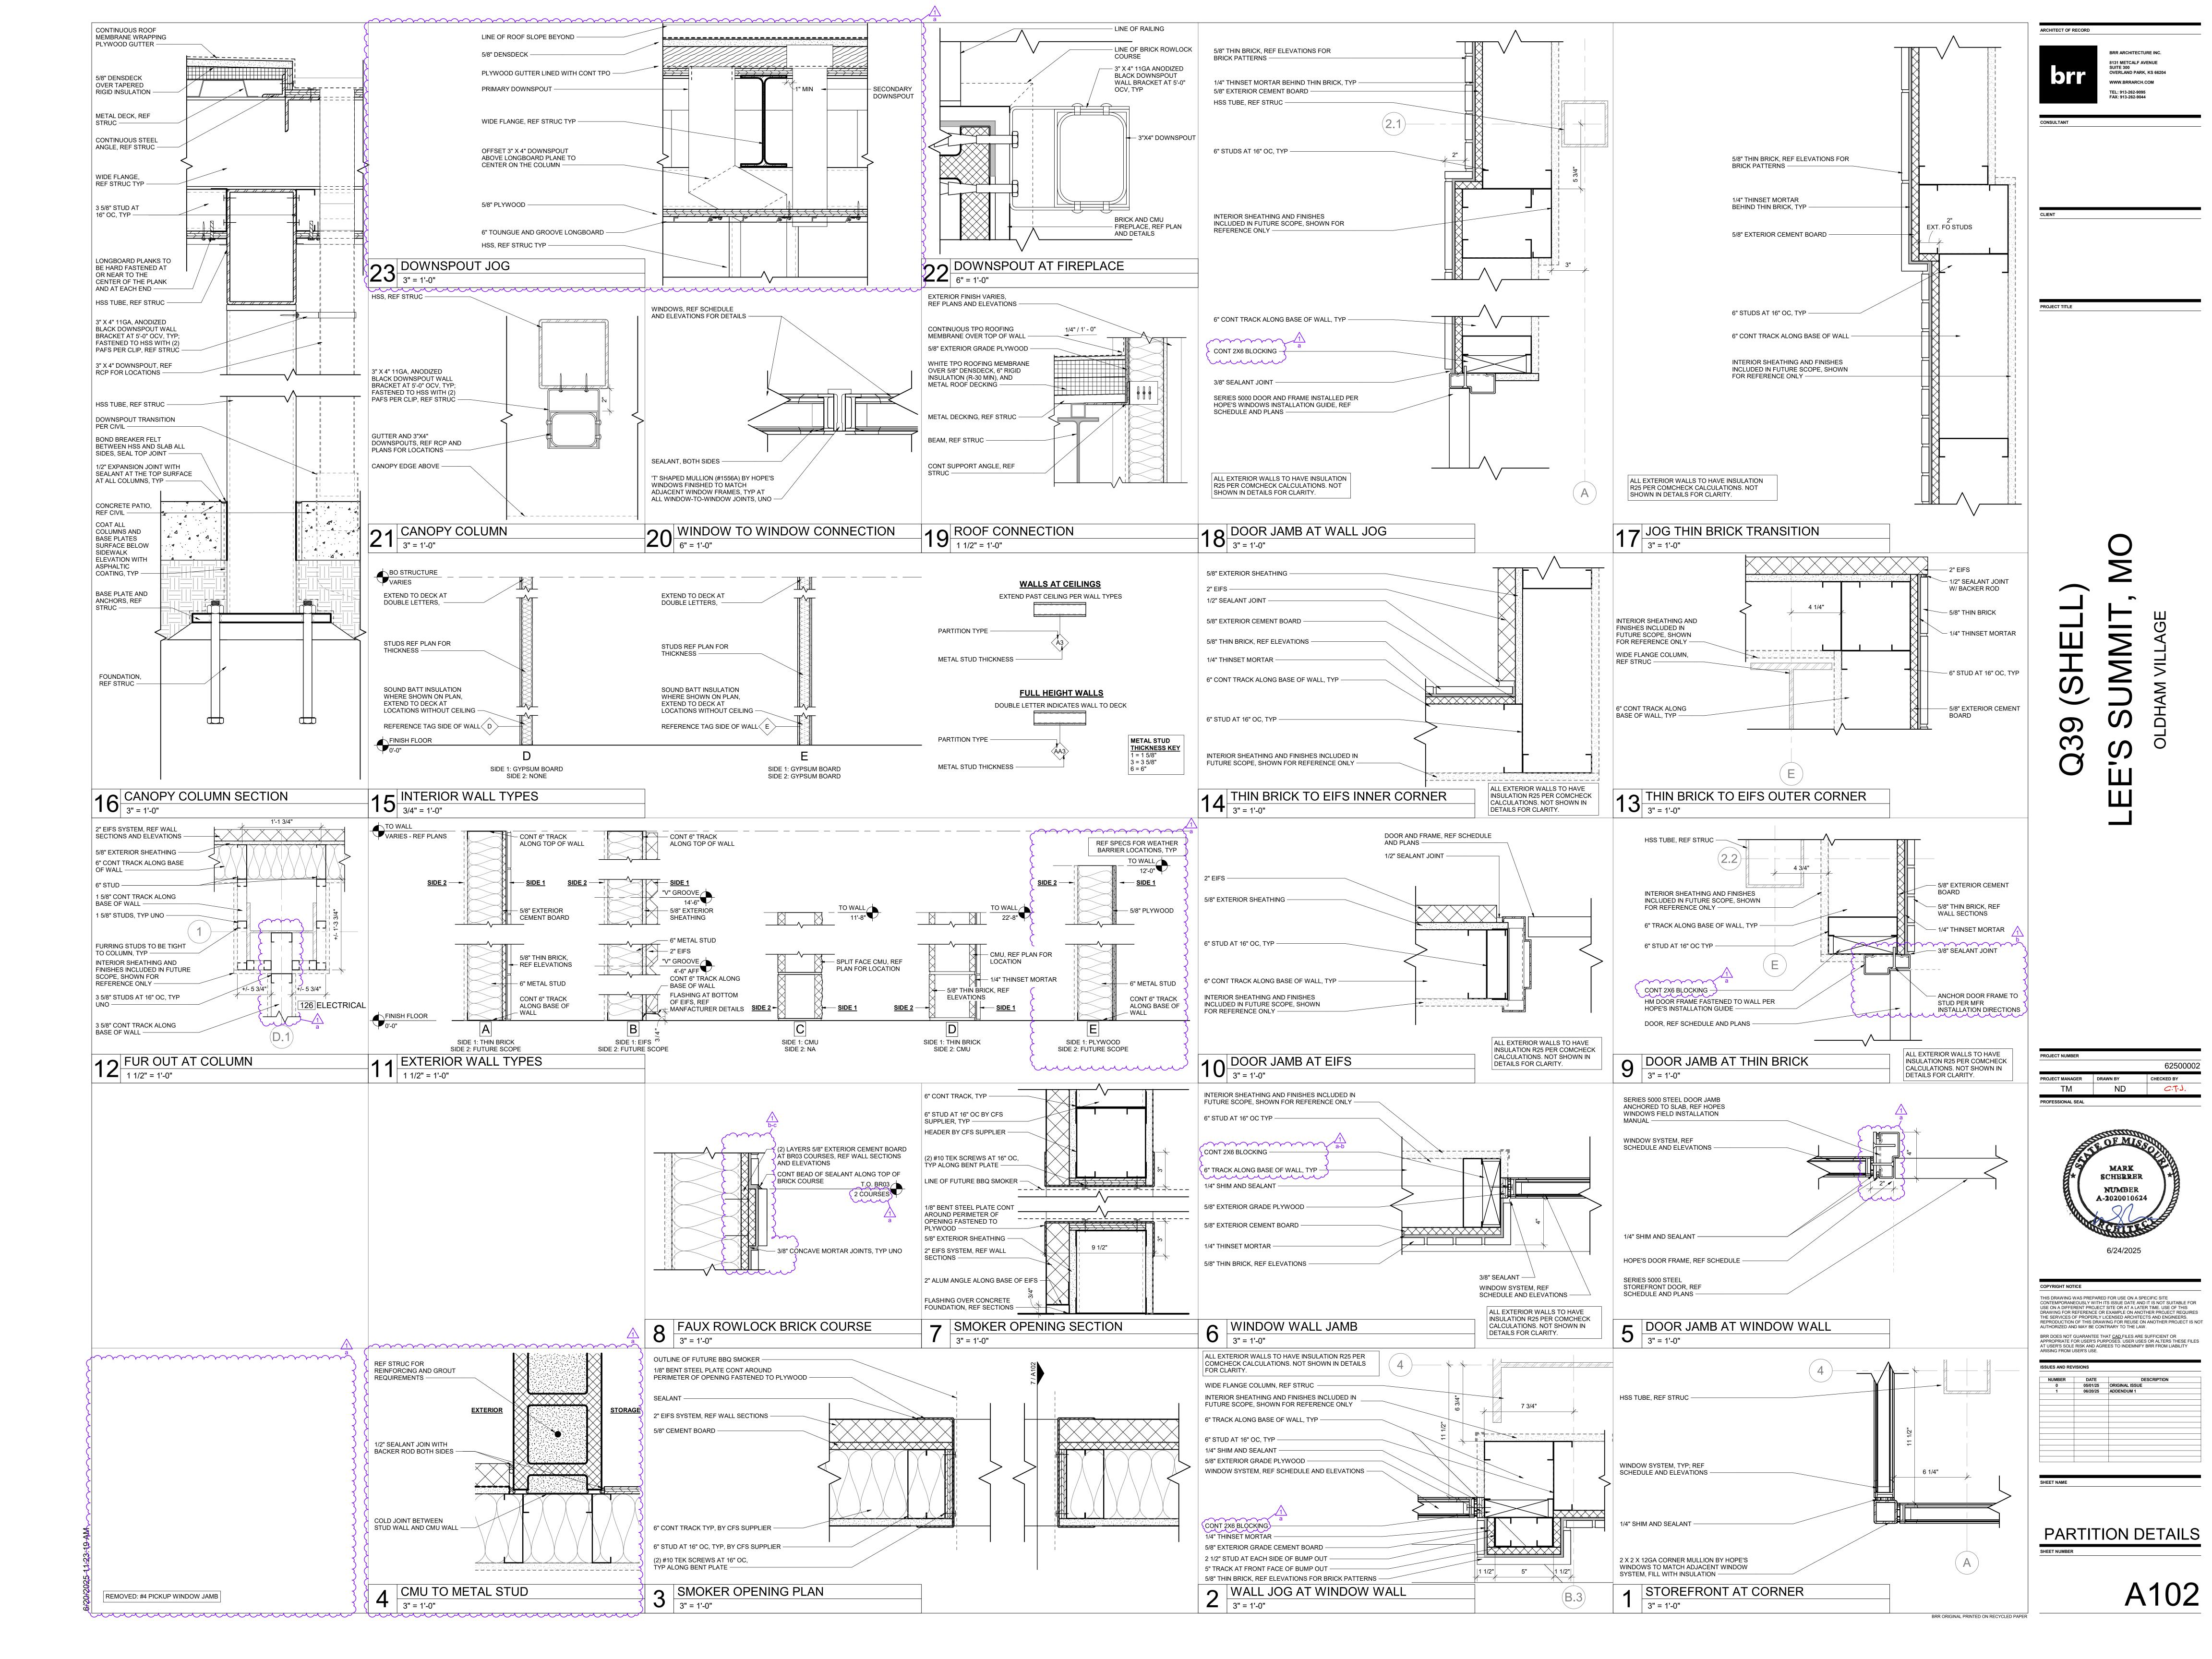

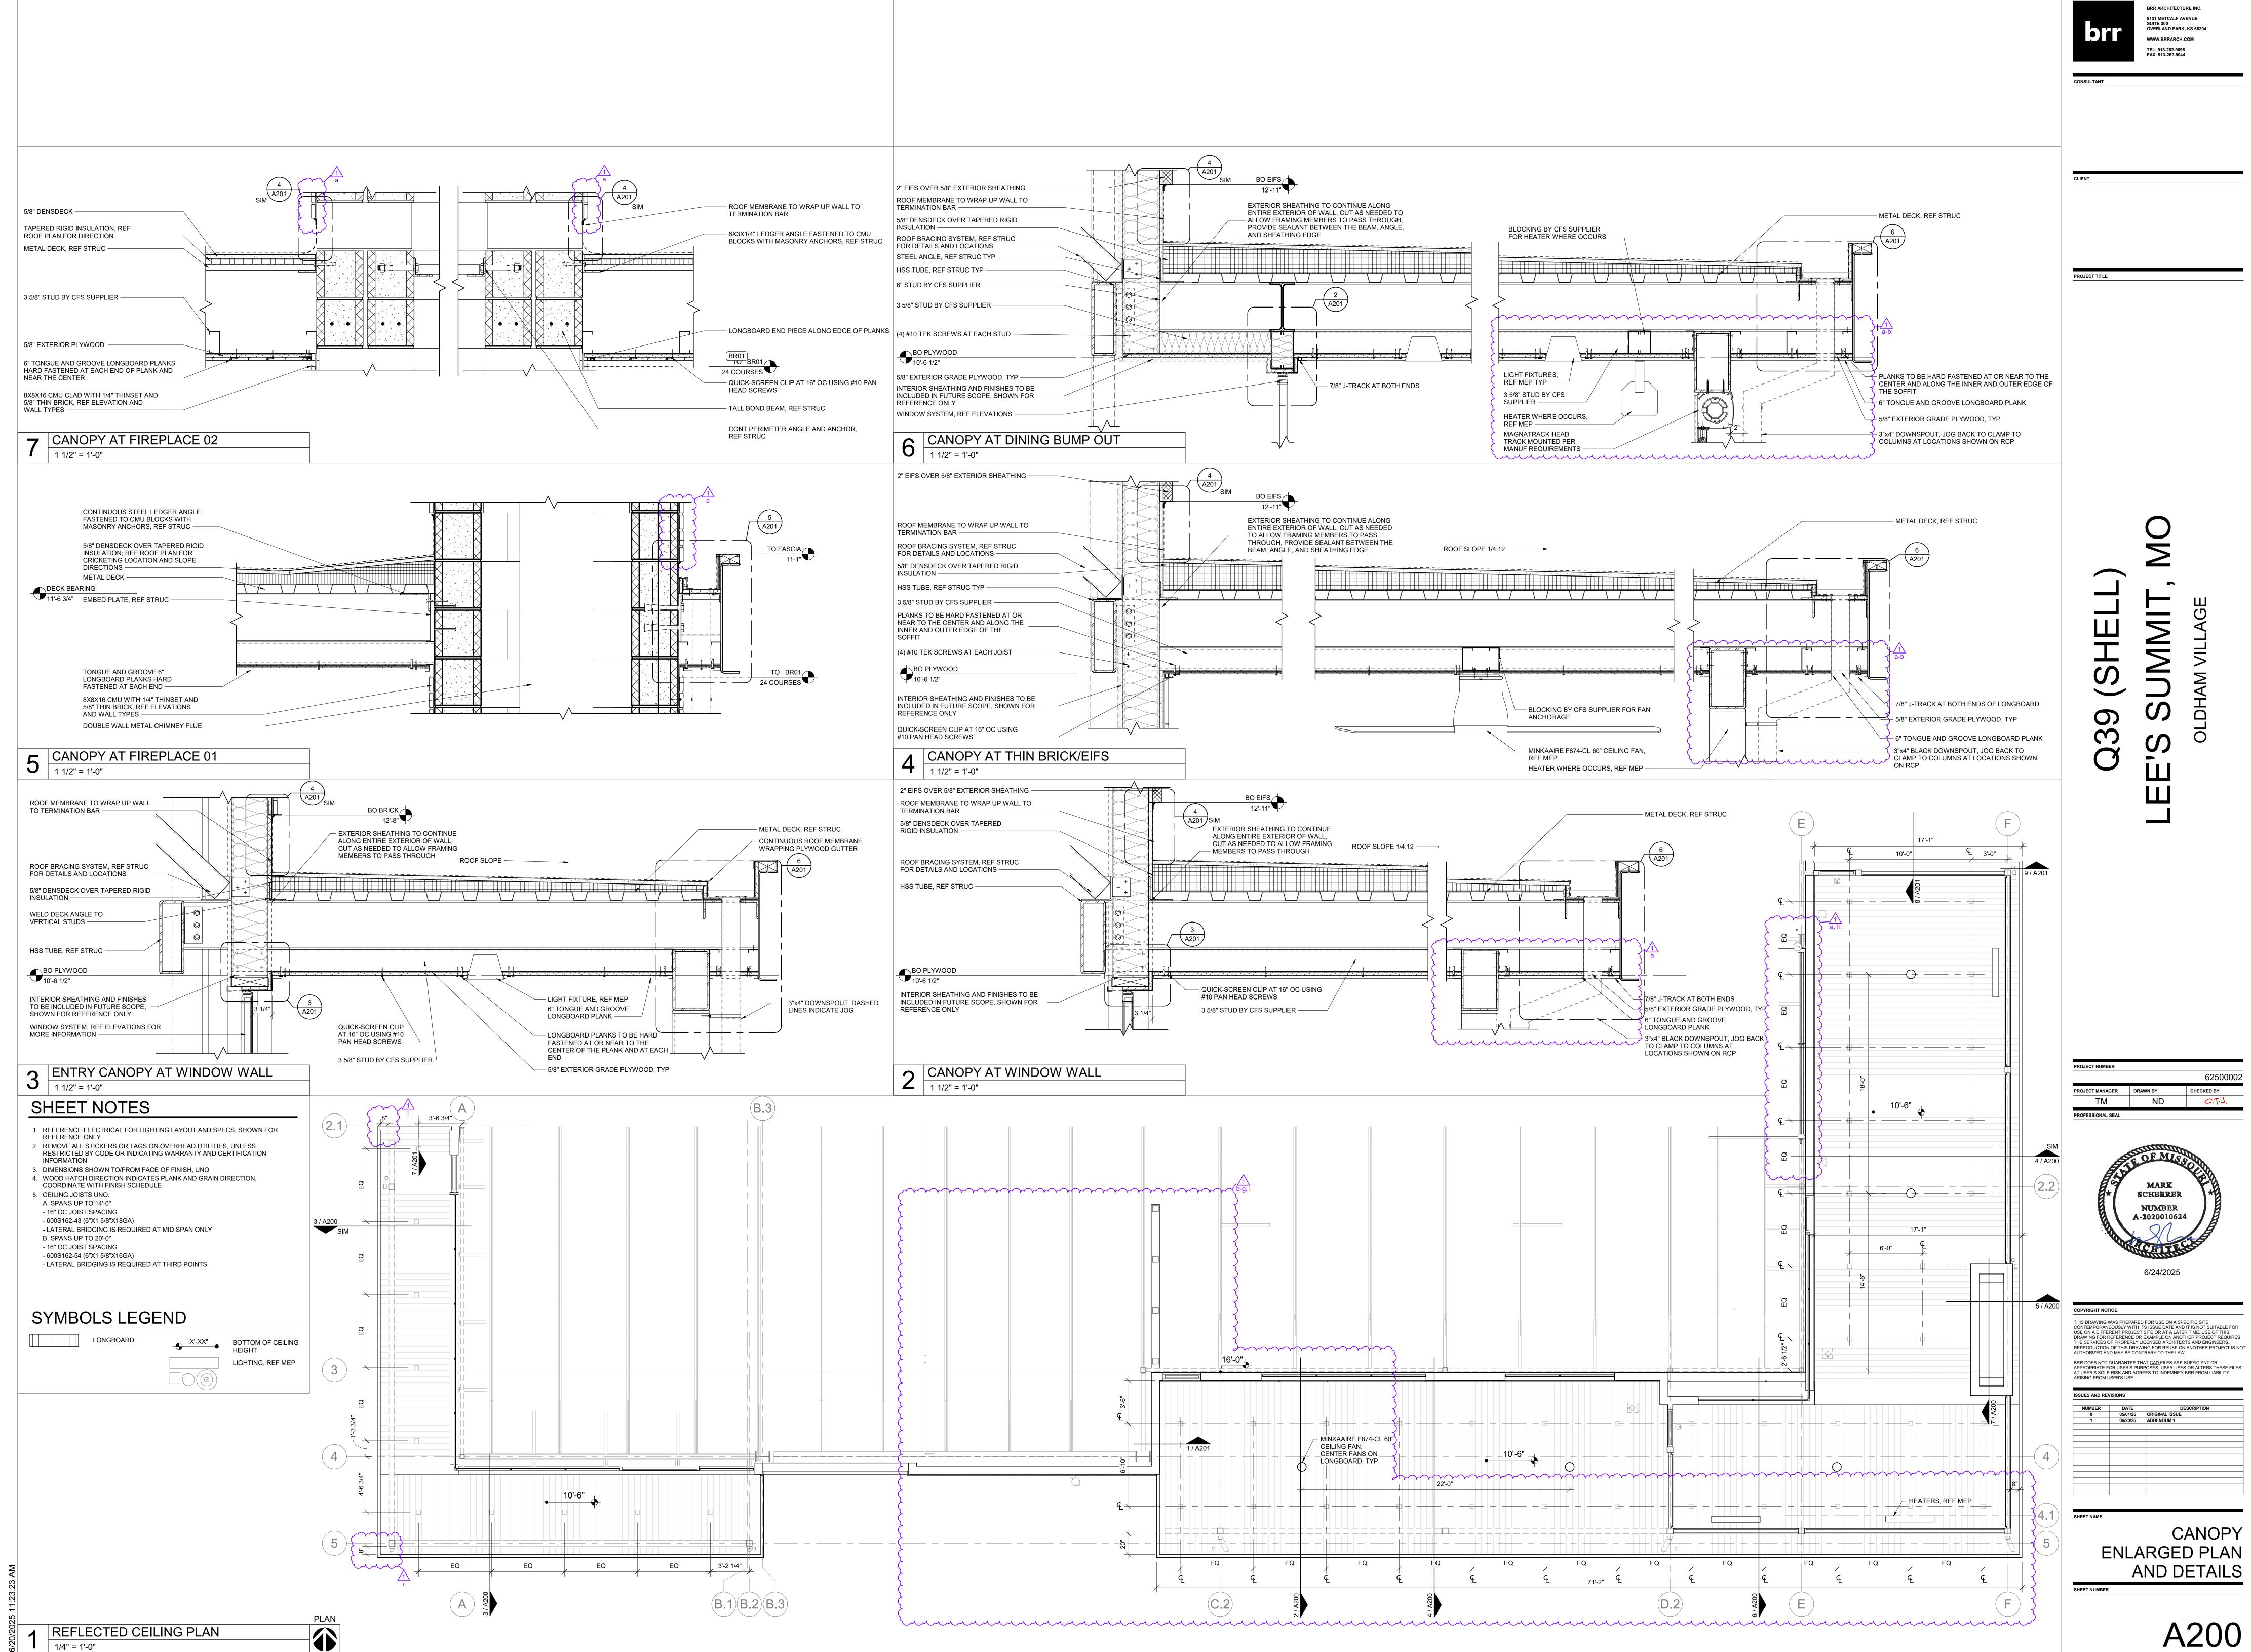






ARCHITECT OF RECORD


CANOPY AND DETAILS

BRR ORIGINAL PRINTED ON RECYCLED PAPER

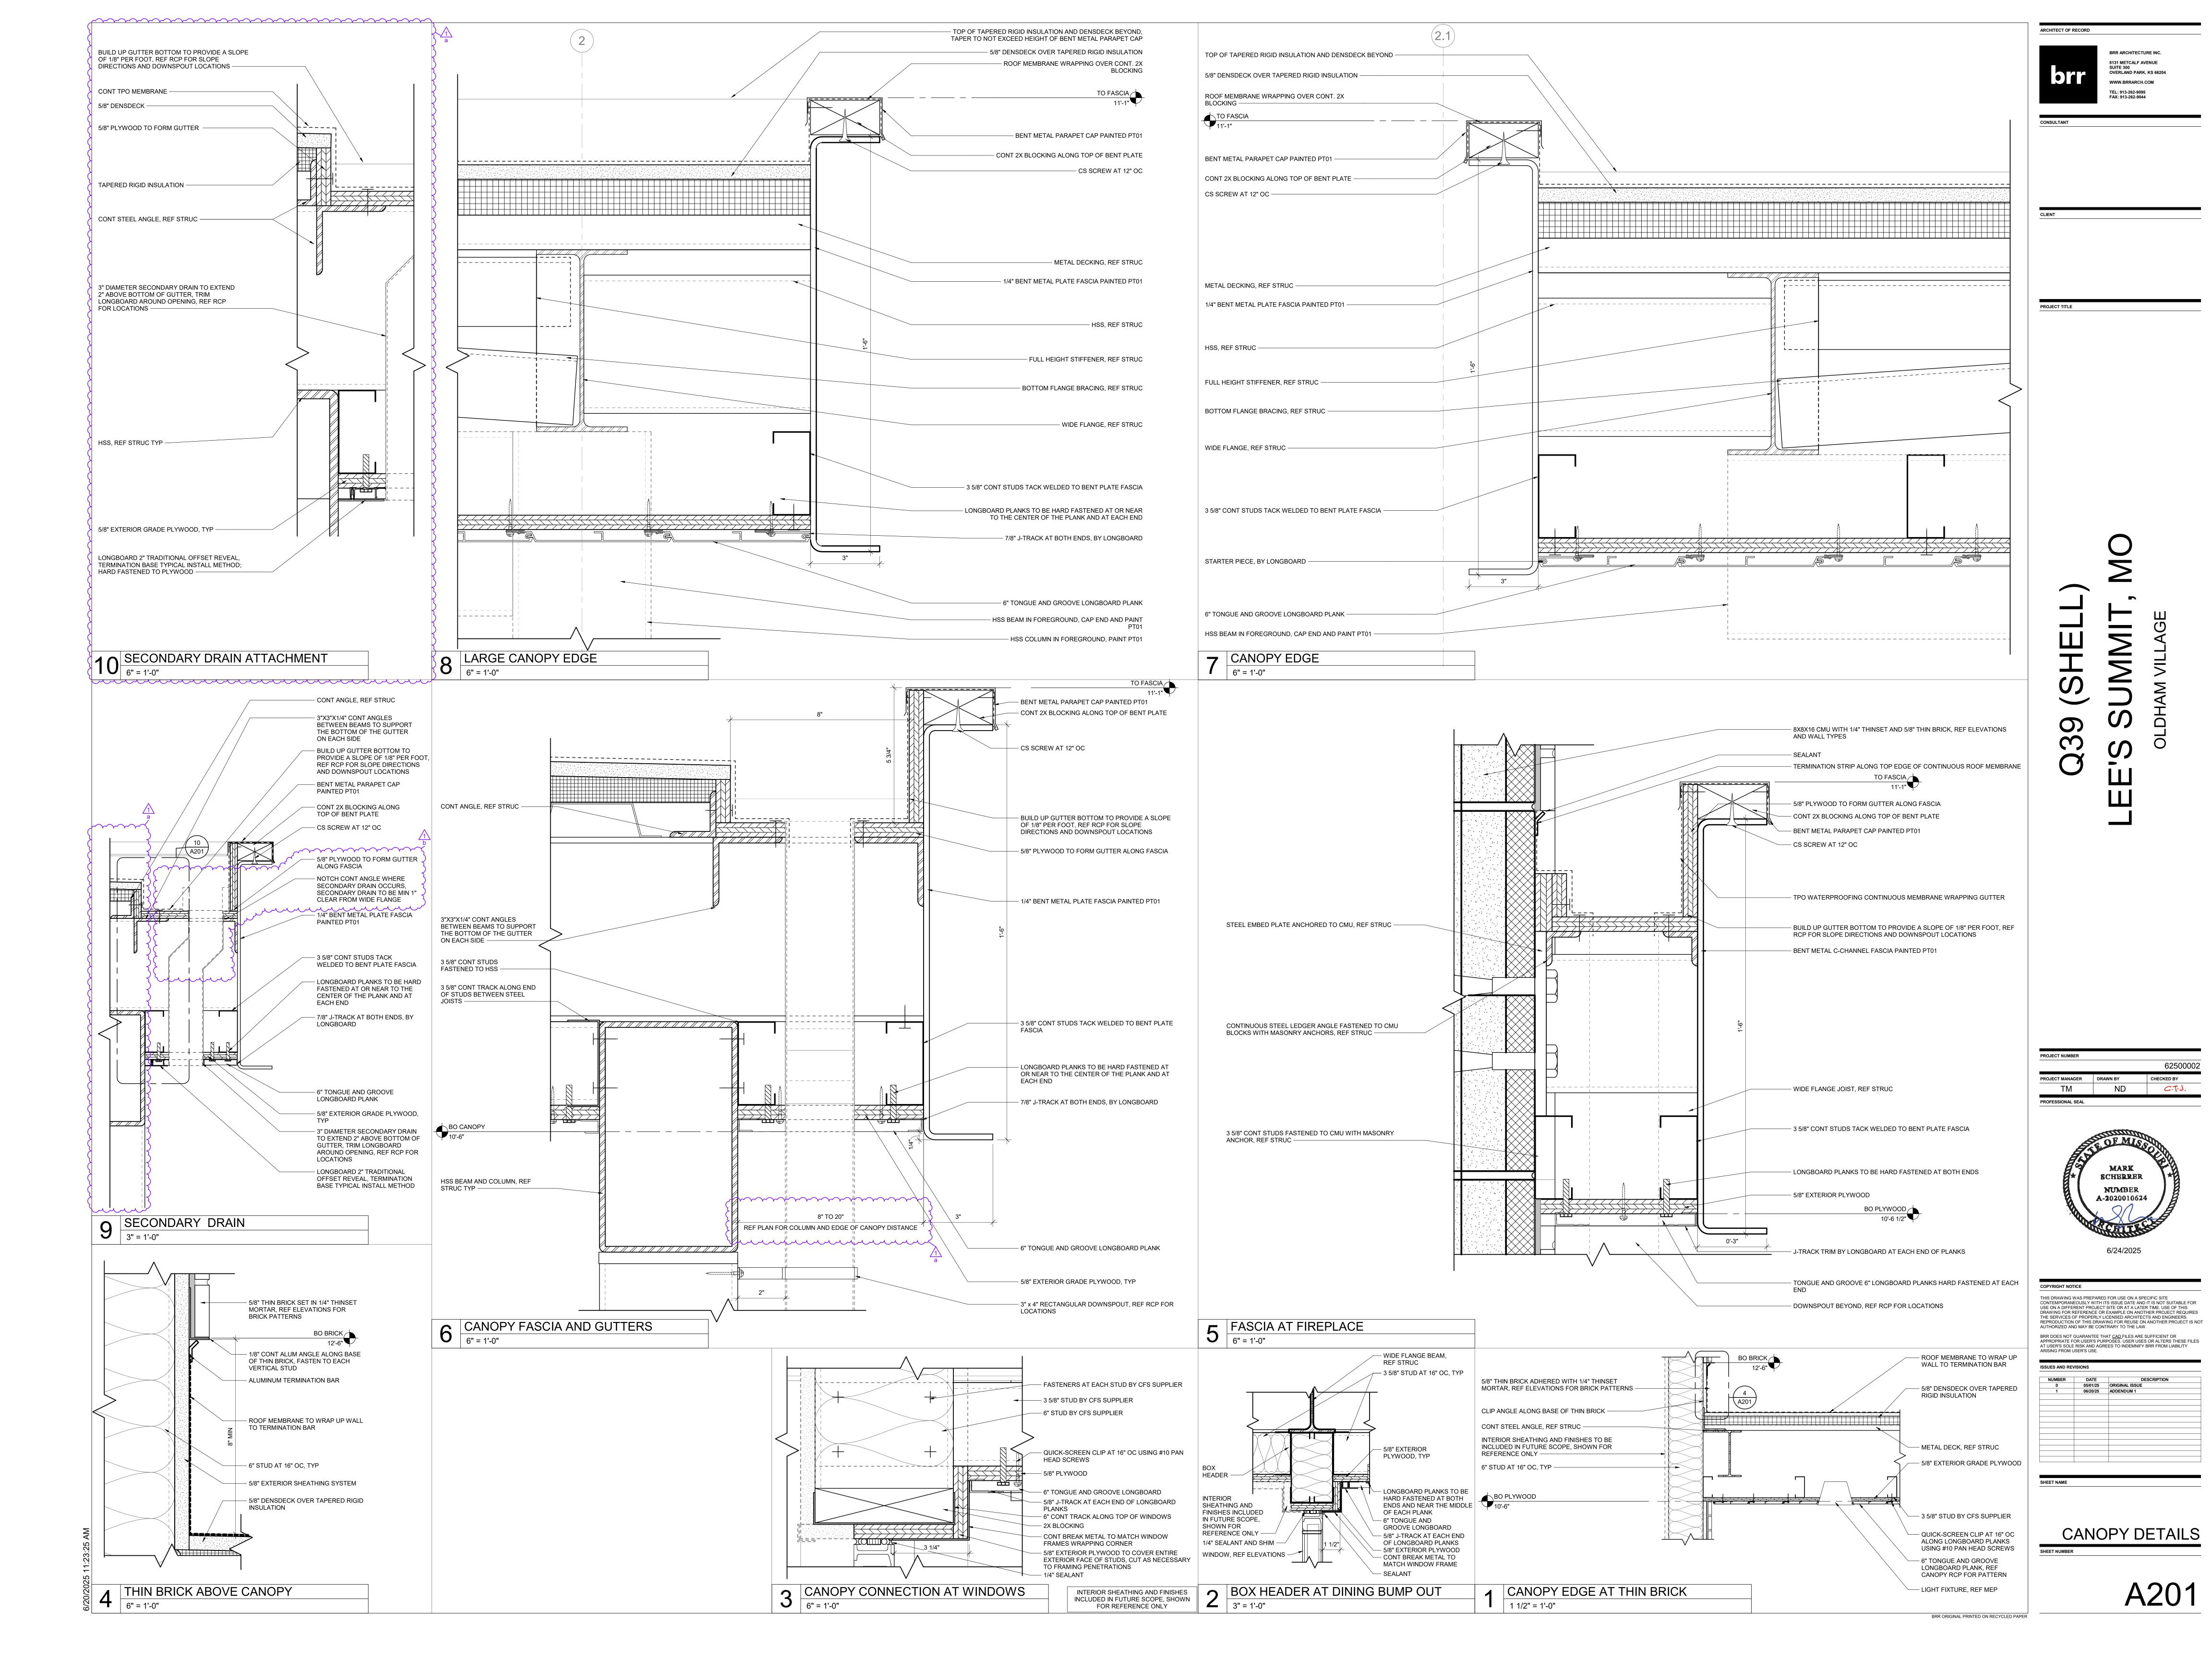

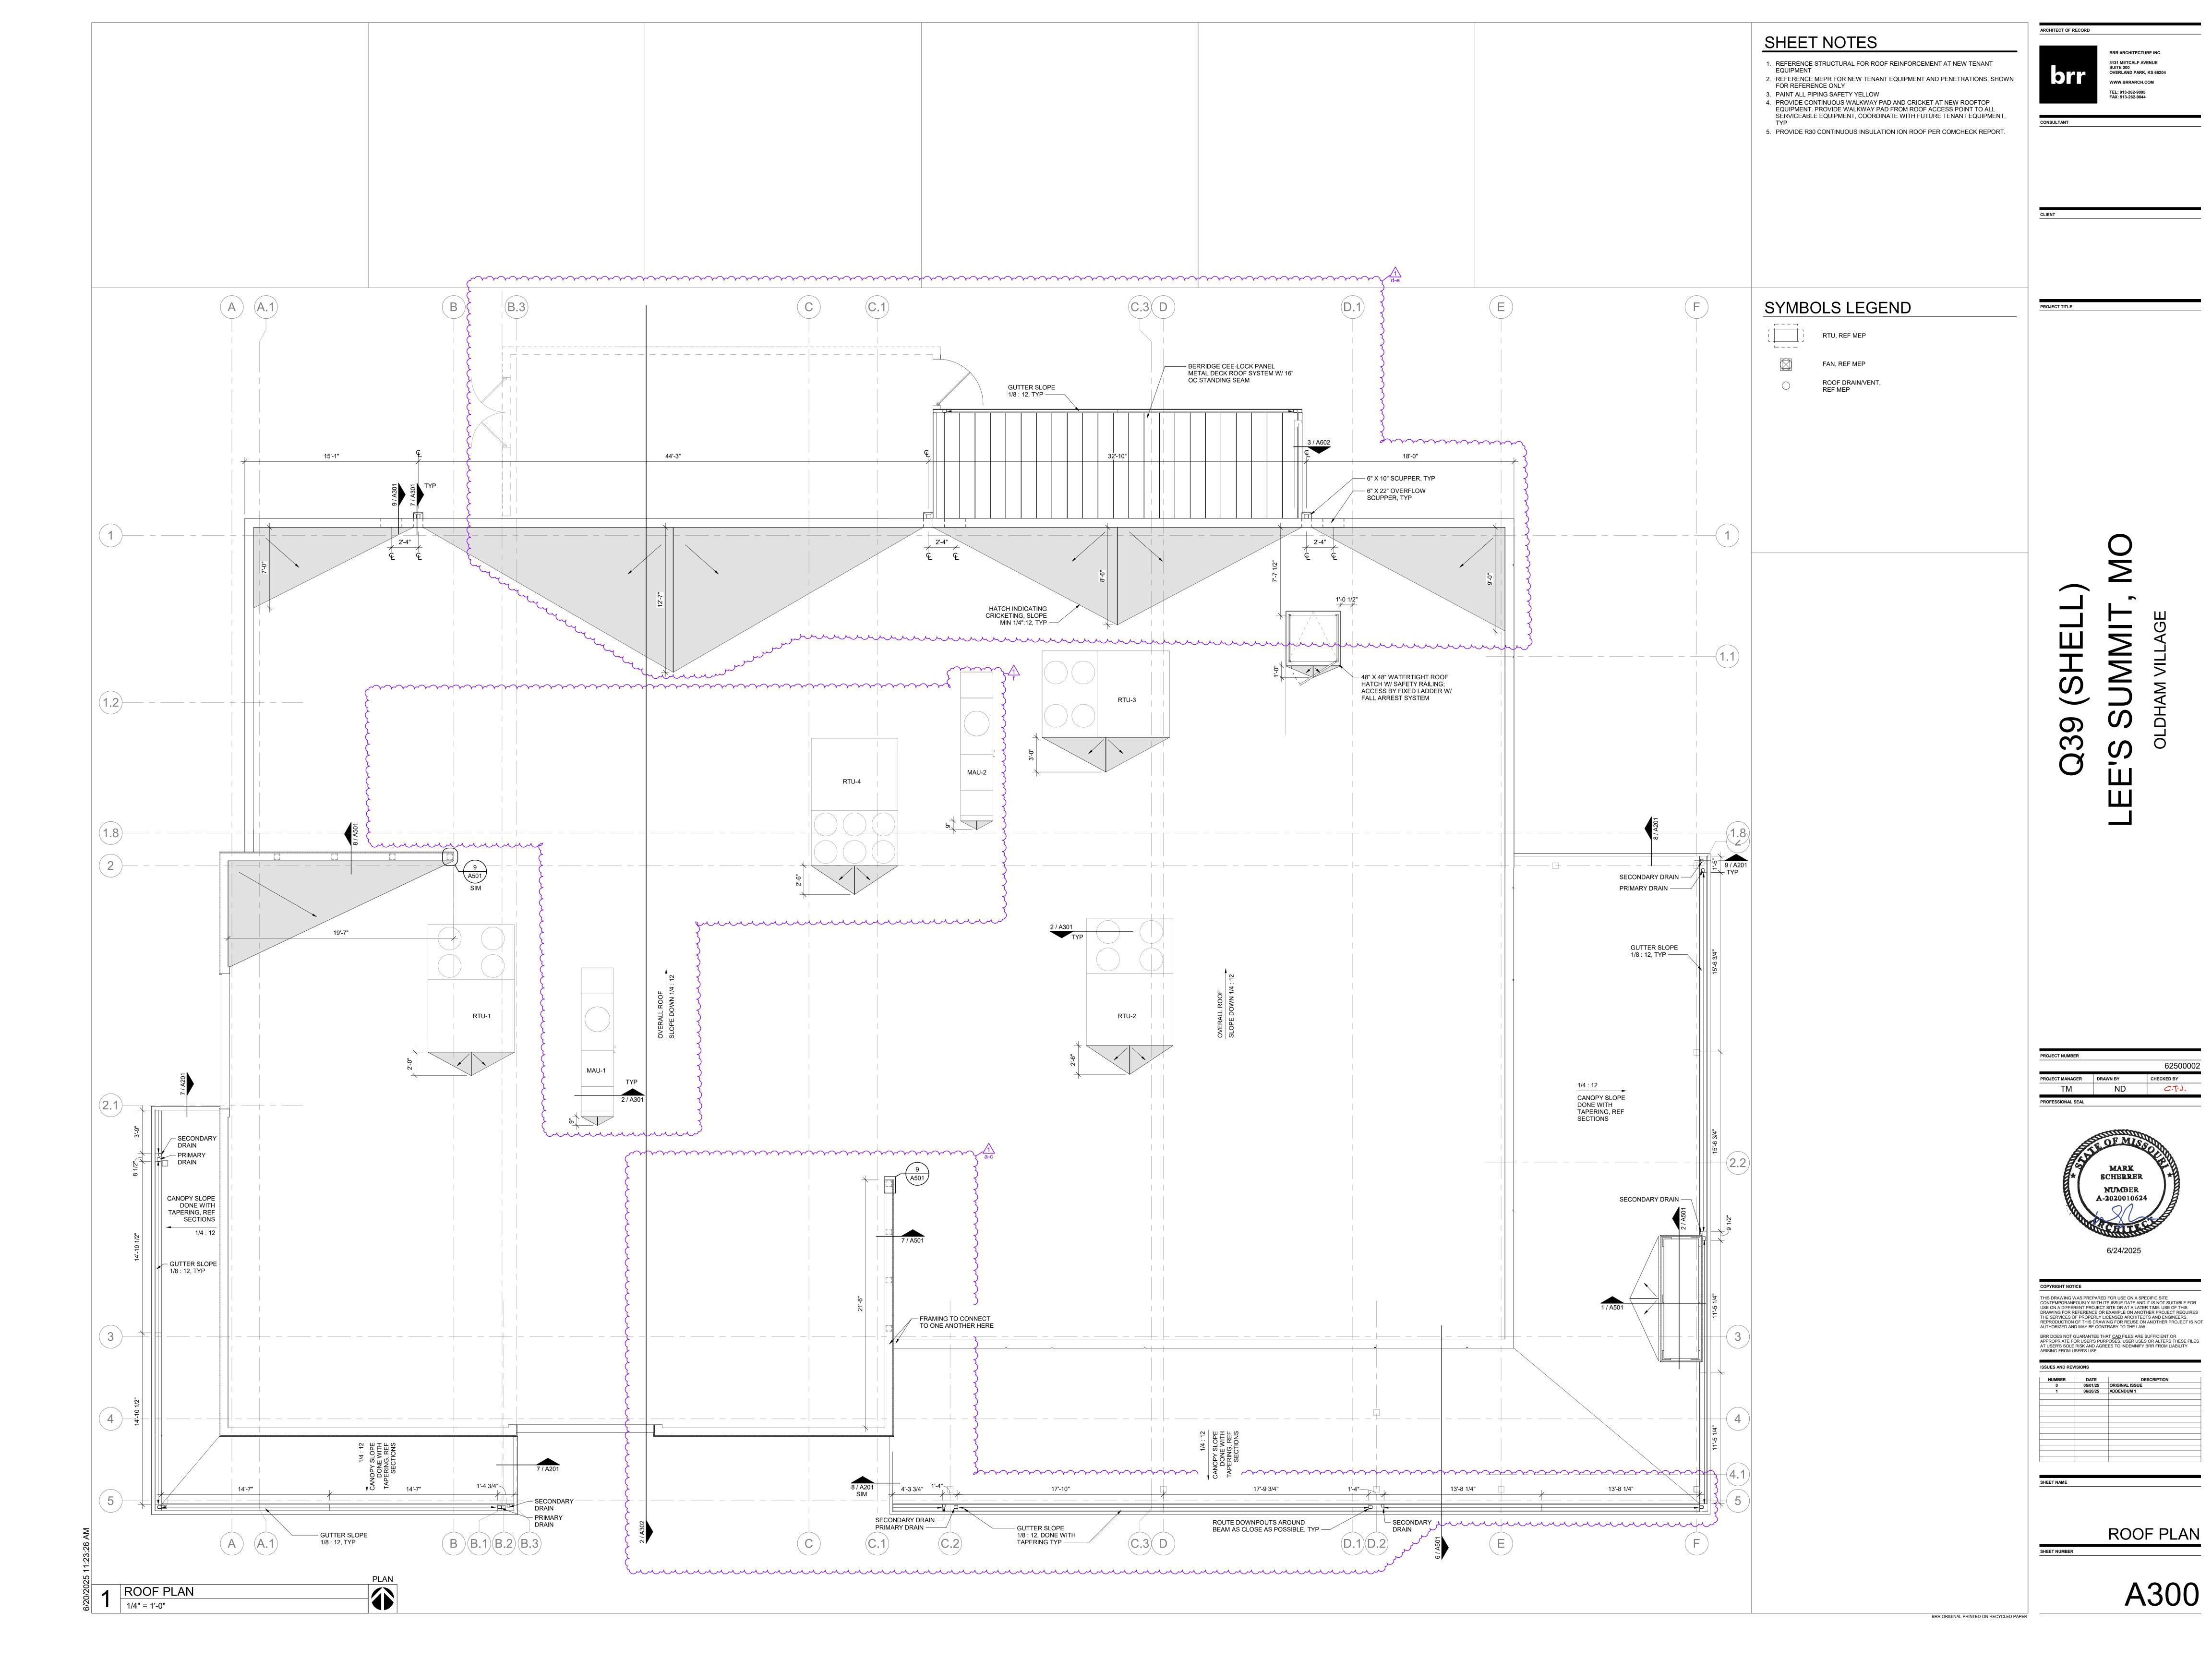

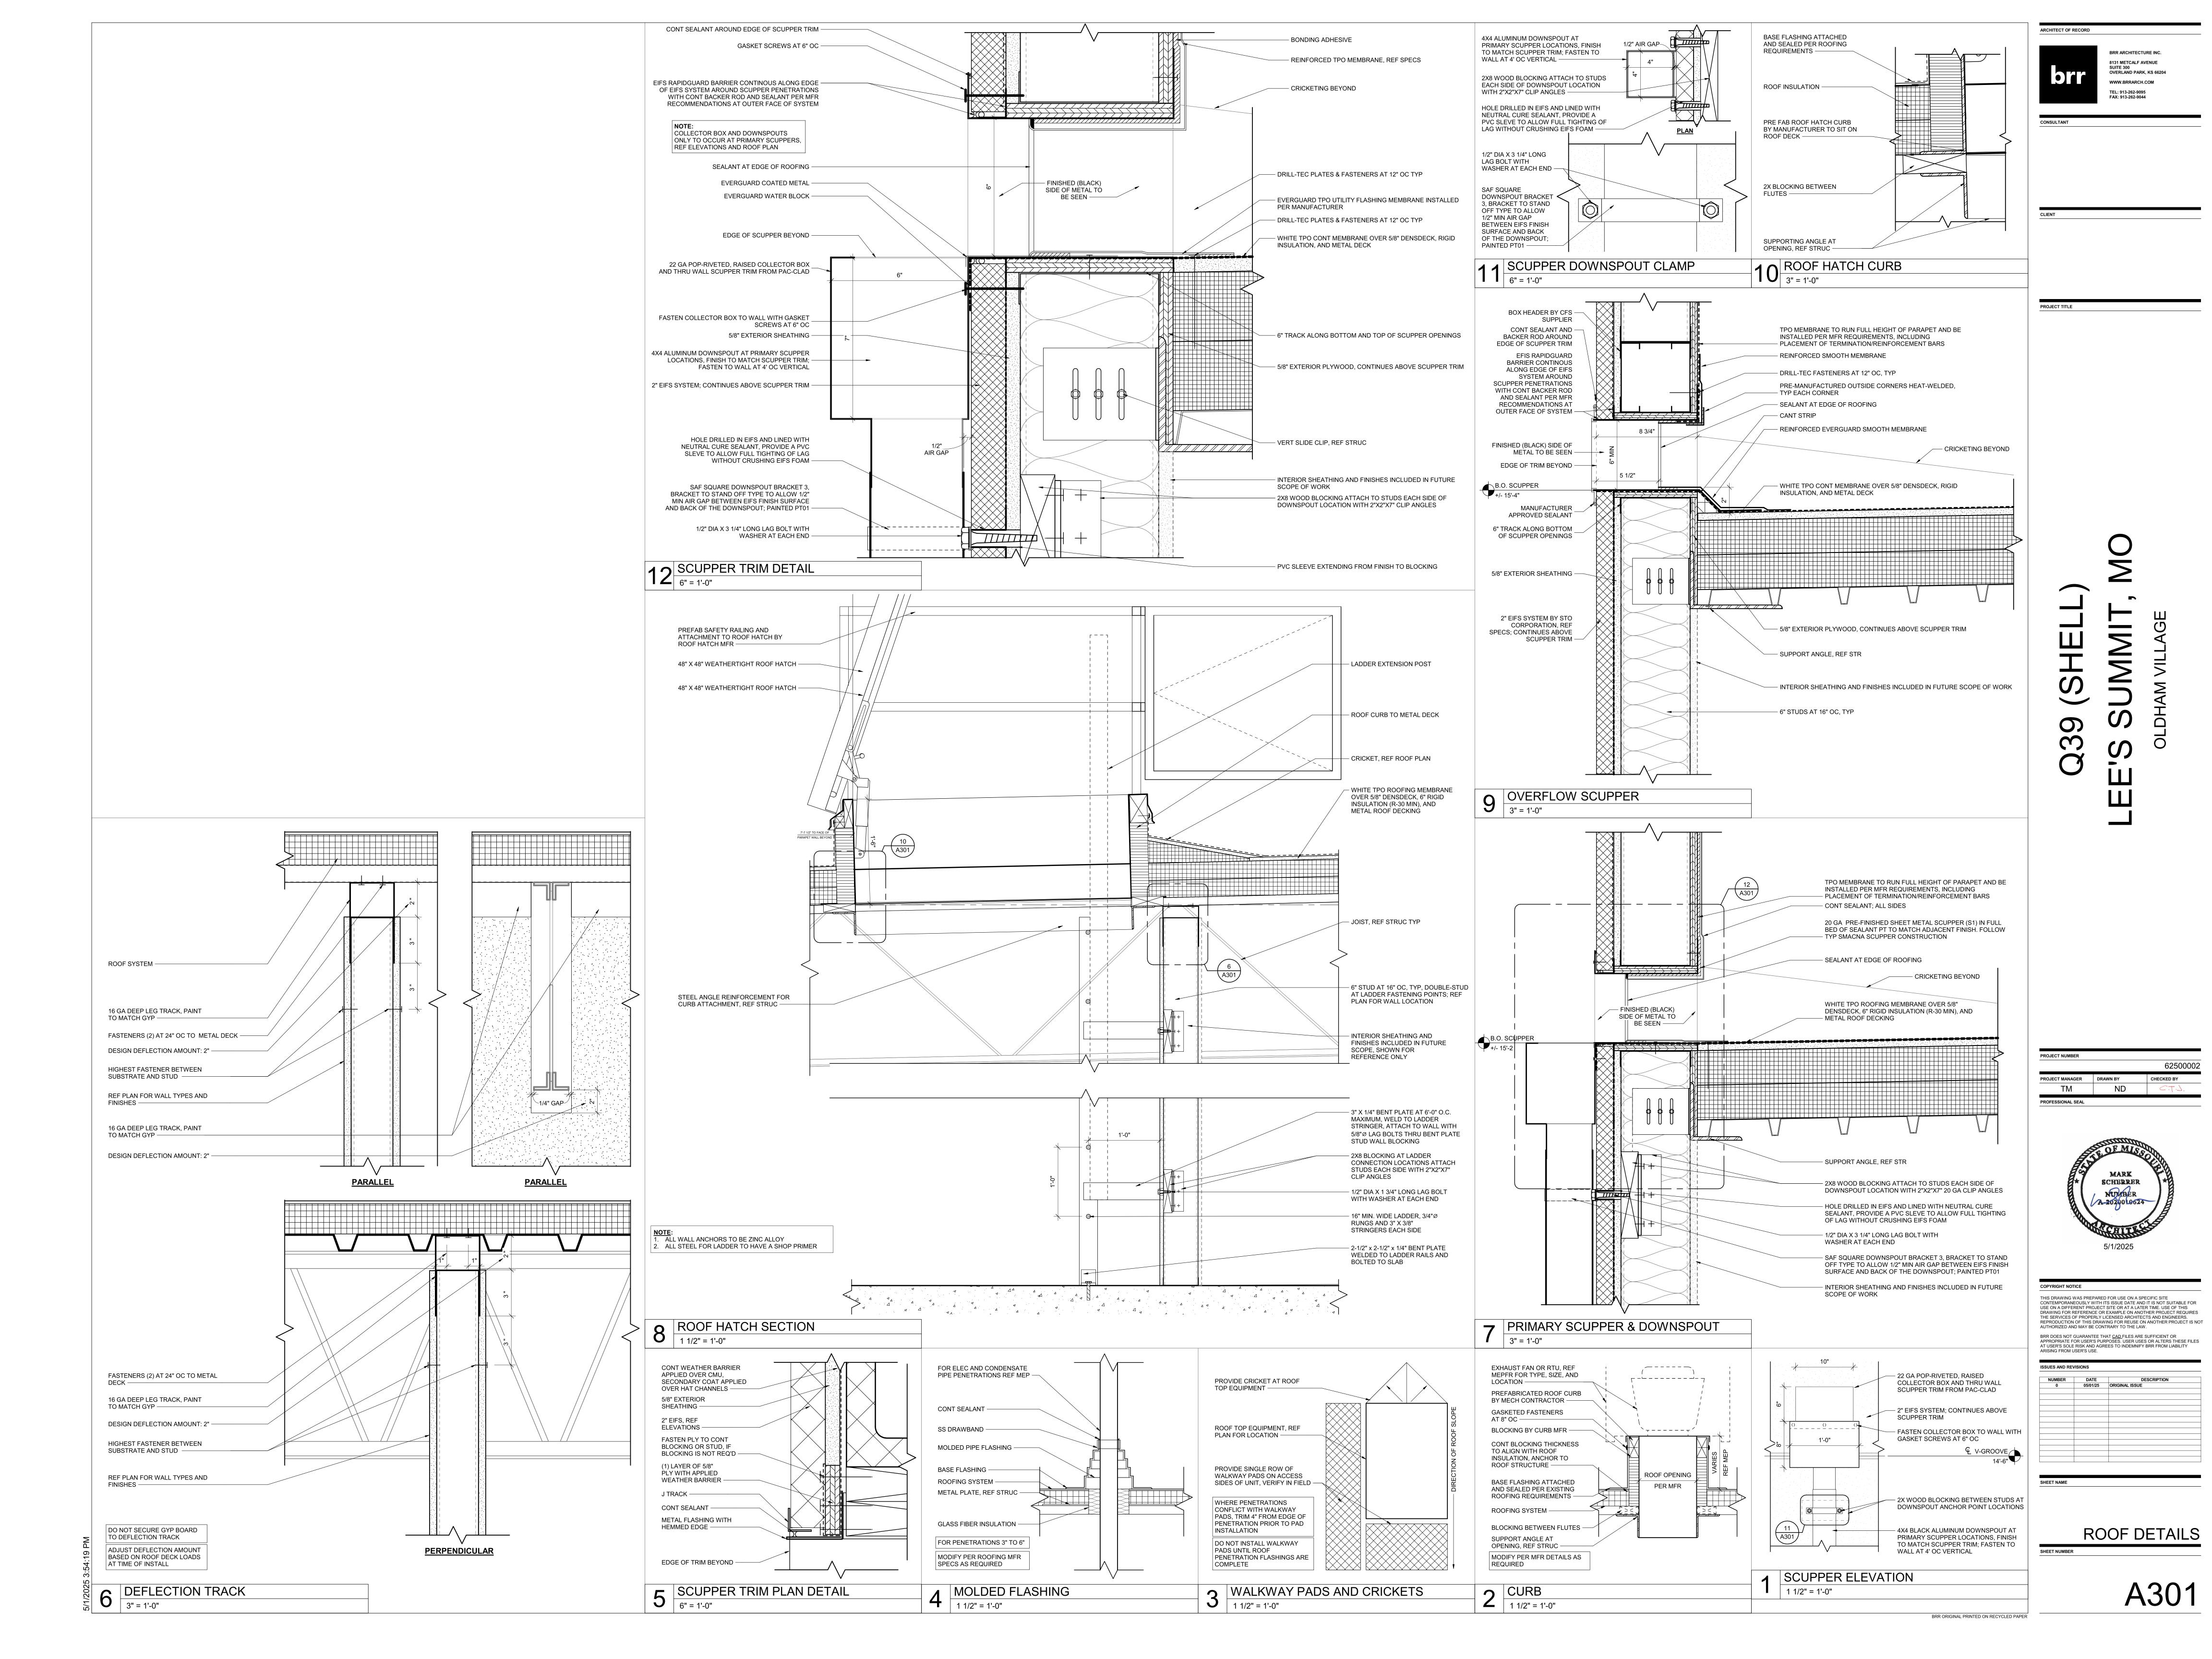

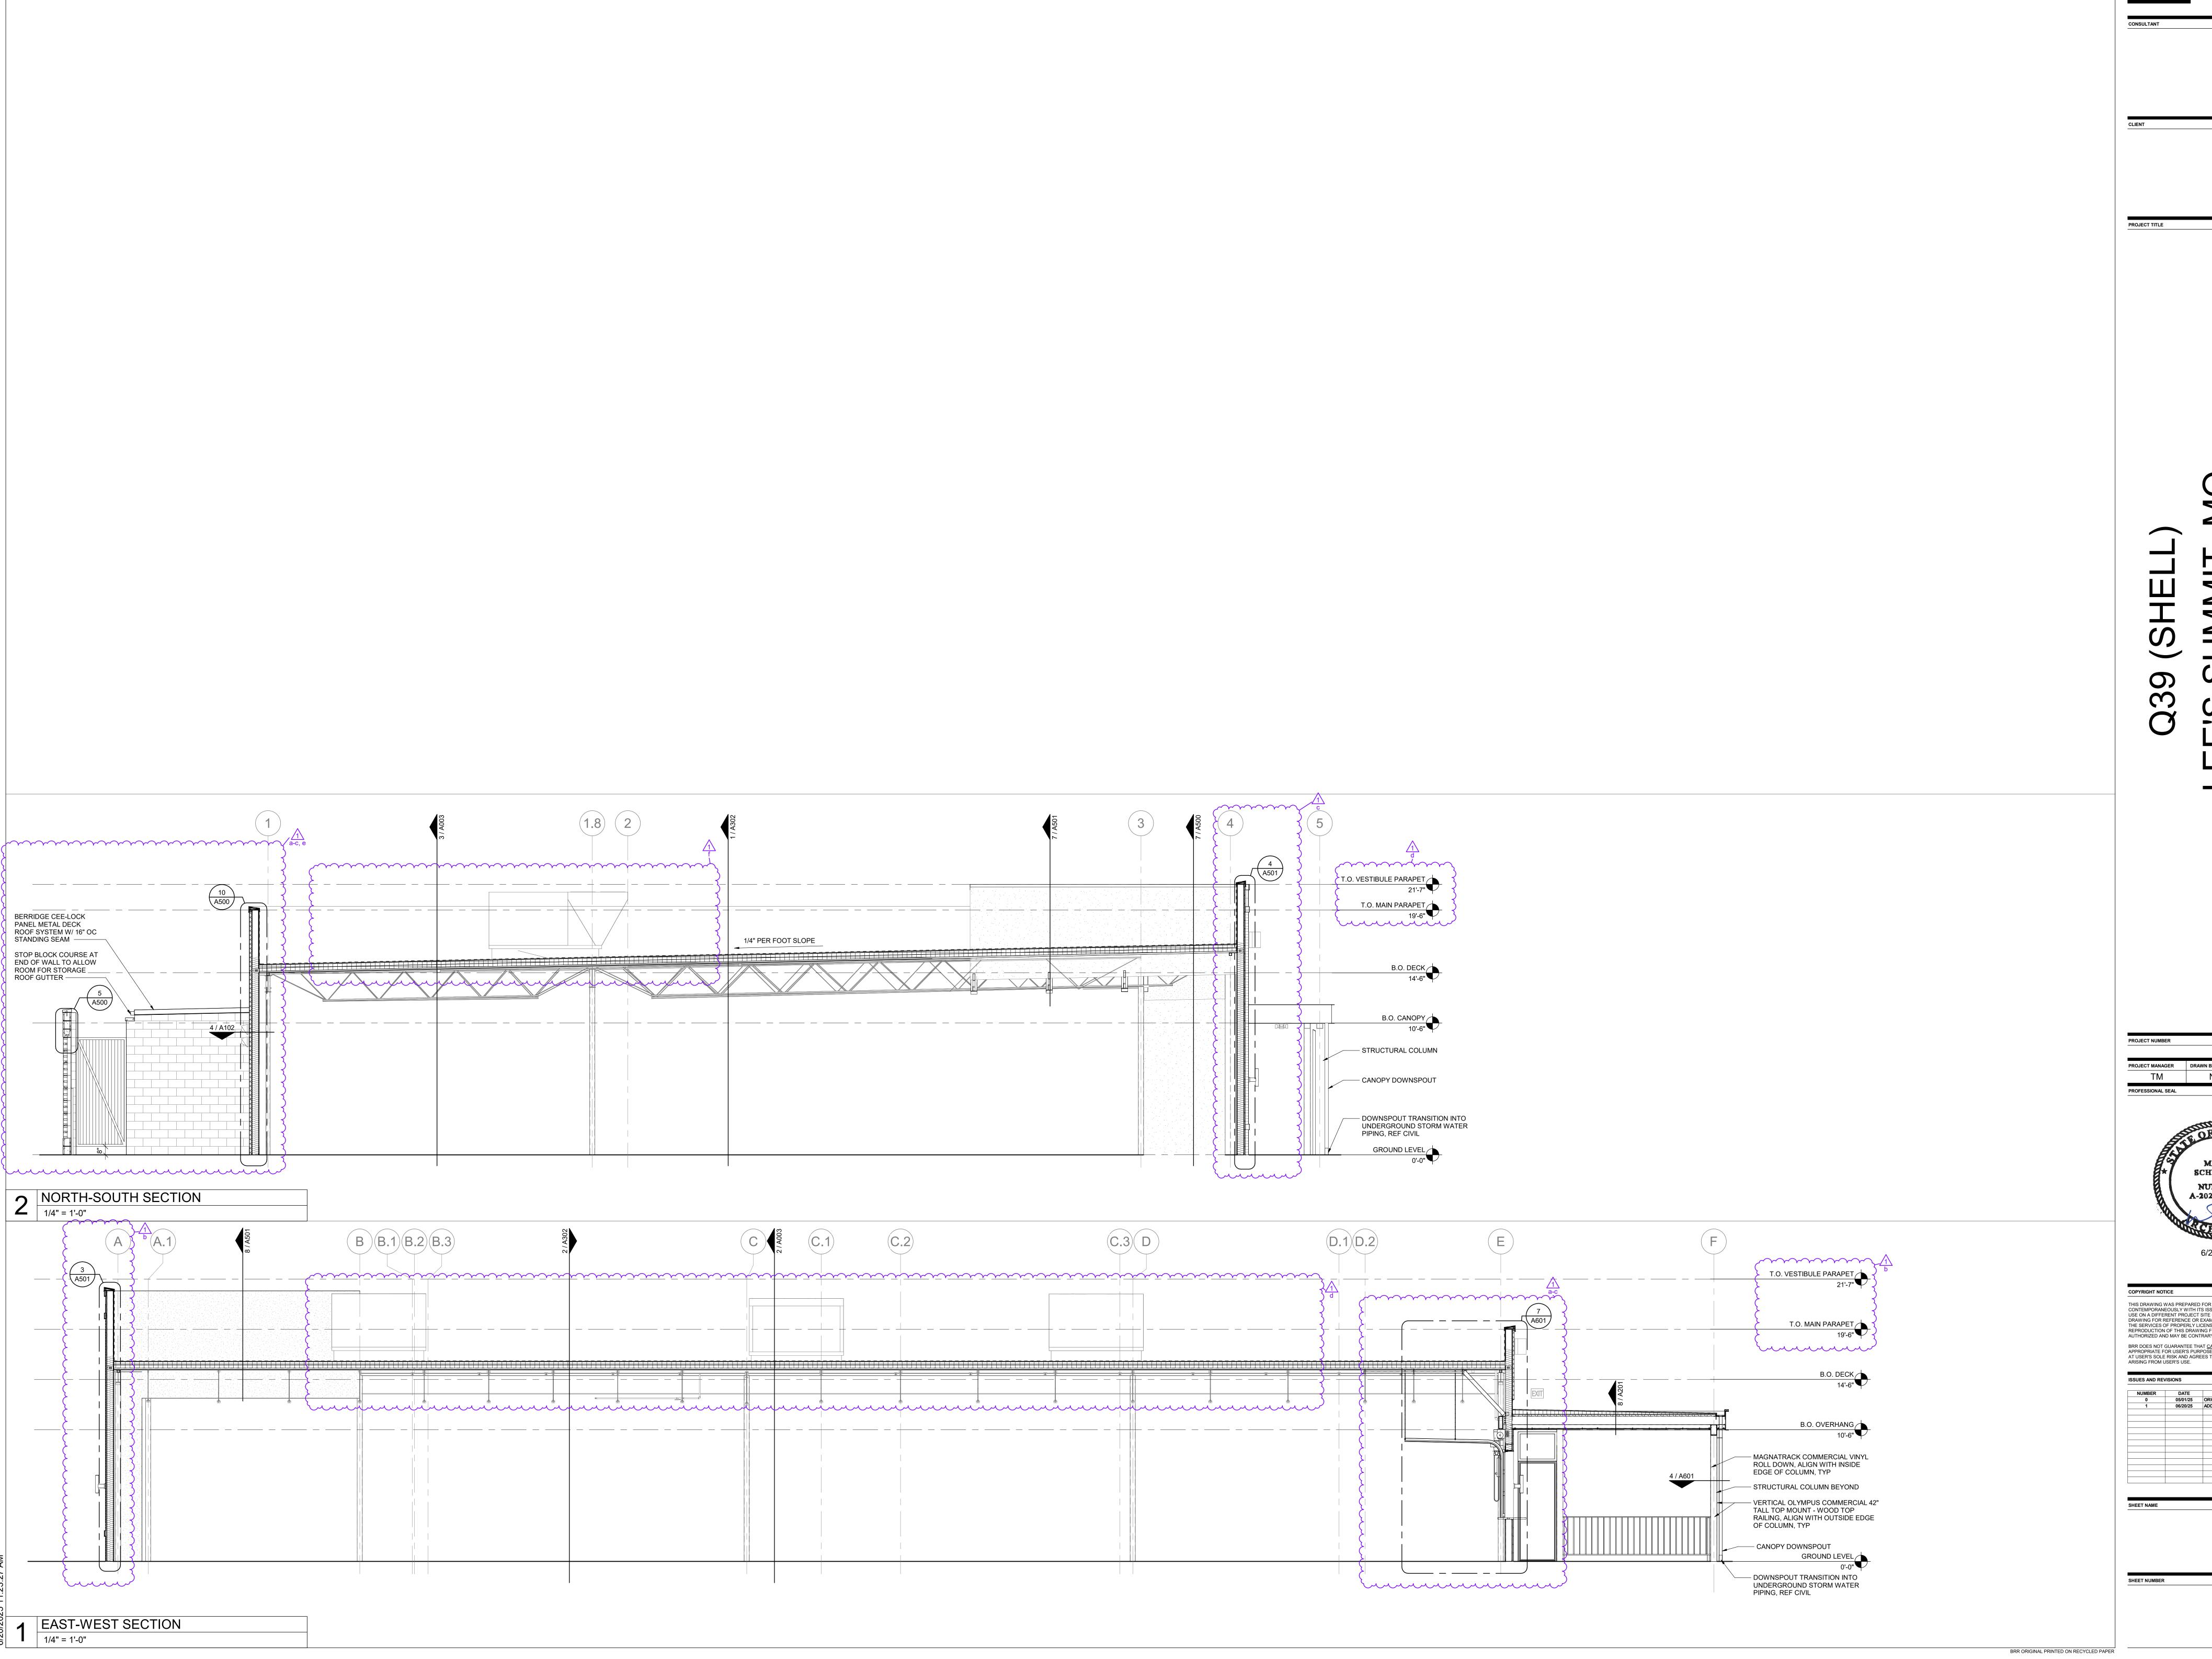


62500002



THIS DRAWING WAS PREPARED FOR USE ON A SPECIFIC SITE CONTEMPORANEOUSLY WITH ITS ISSUE DATE AND IT IS NOT SUITABLE FOR USE ON A DIFFERENT PROJECT SITE OR AT A LATER TIME. USE OF THIS DRAWING FOR REFERENCE OR EXAMPLE ON ANOTHER PROJECT REQUIRES THE SERVICES OF PROPERLY LICENSED ARCHITECTS AND ENGINEERS. REPRODUCTION OF THIS DRAWING FOR REUSE ON ANOTHER PROJECT IS NOT AUTHORIZED AND MAY BE CONTRARY TO THE LAW. BRR DOES NOT GUARANTEE THAT <u>CAD</u> FILES ARE SUFFICIENT OR APPROPRIATE FOR USER'S PURPOSES. USER USES OR ALTERS THESE FILES AT USER'S SOLE RISK AND AGREES TO INDEMNIFY BRR FROM LIABILITY ARISING FROM USER'S USE.


05/01/25 ORIGINAL ISSUE 06/20/25 ADDENDUM 1


BUILDING SECTIONS

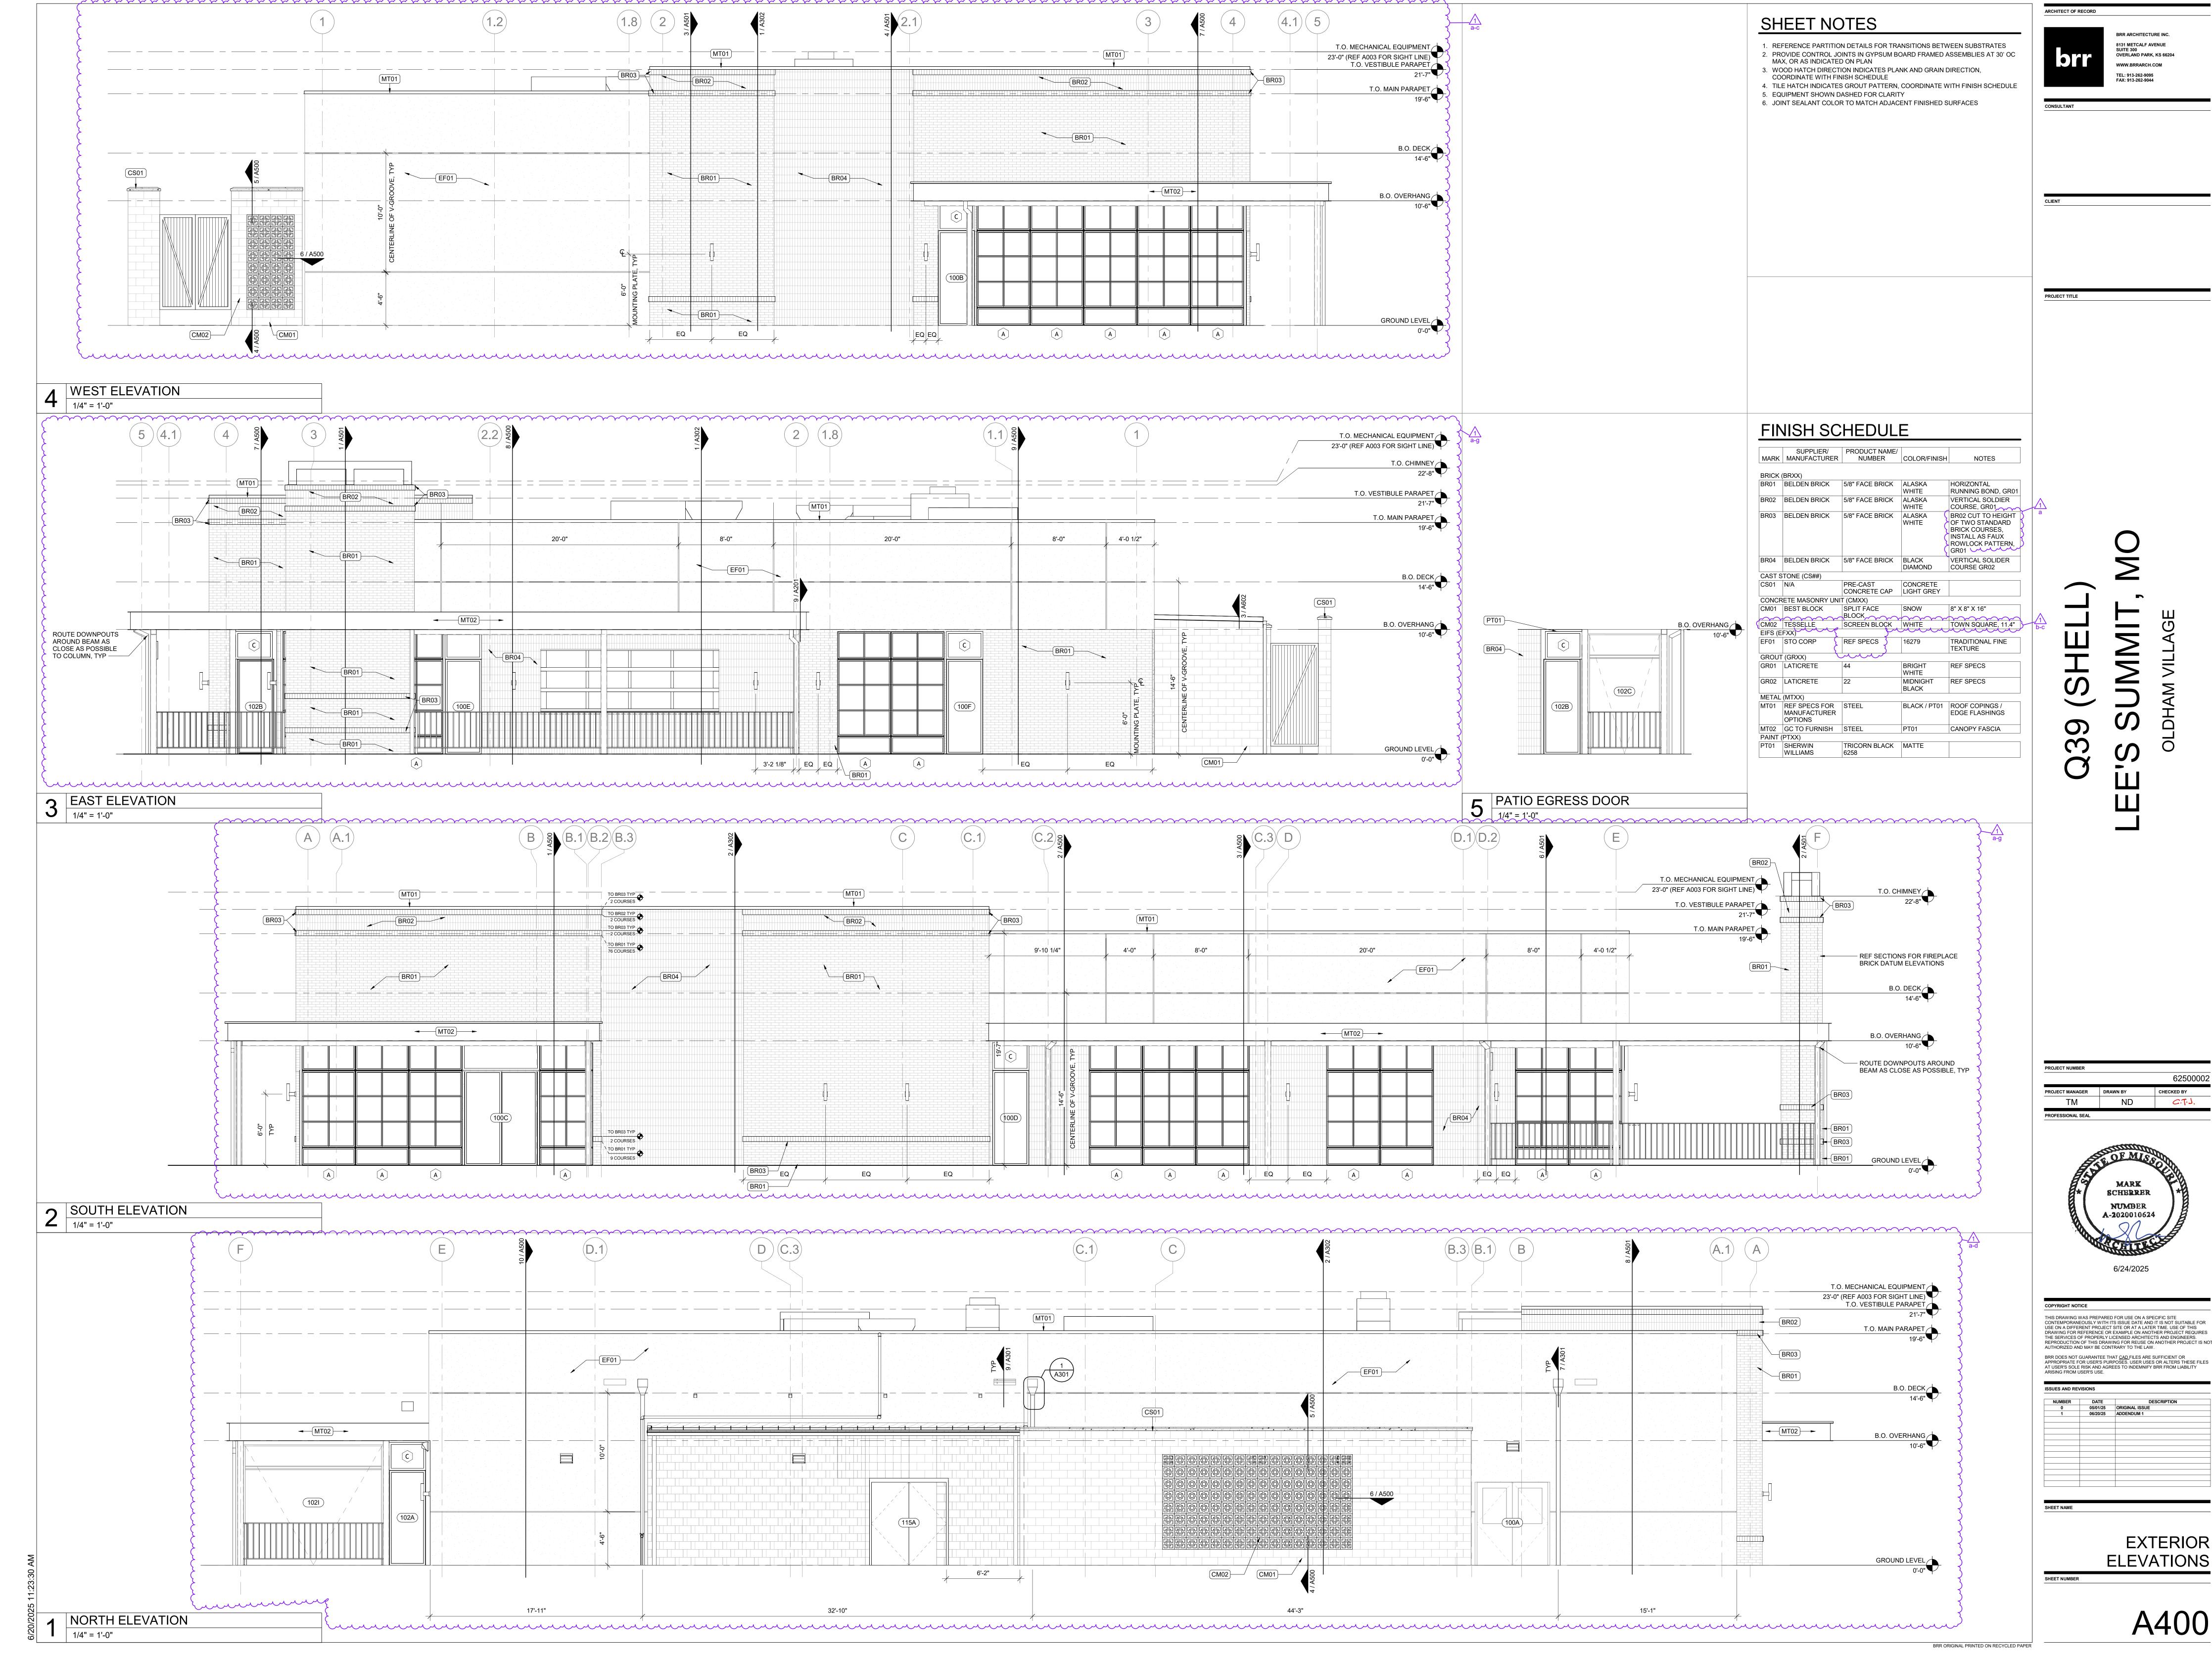



THIS DRAWING WAS PREPARED FOR USE ON A SPECIFIC SITE CONTEMPORANEOUSLY WITH ITS ISSUE DATE AND IT IS NOT SUITABLE FOR USE ON A DIFFERENT PROJECT SITE OR AT A LATER TIME. USE OF THIS DRAWING FOR REFERENCE OR EXAMPLE ON ANOTHER PROJECT REQUIRES THE SERVICES OF PROPERLY LICENSED ARCHITECTS AND ENGINEERS.
REPRODUCTION OF THIS DRAWING FOR REUSE ON ANOTHER PROJECT IS NOT AUTHORIZED AND MAY BE CONTRARY TO THE LAW.


EXTERIOR

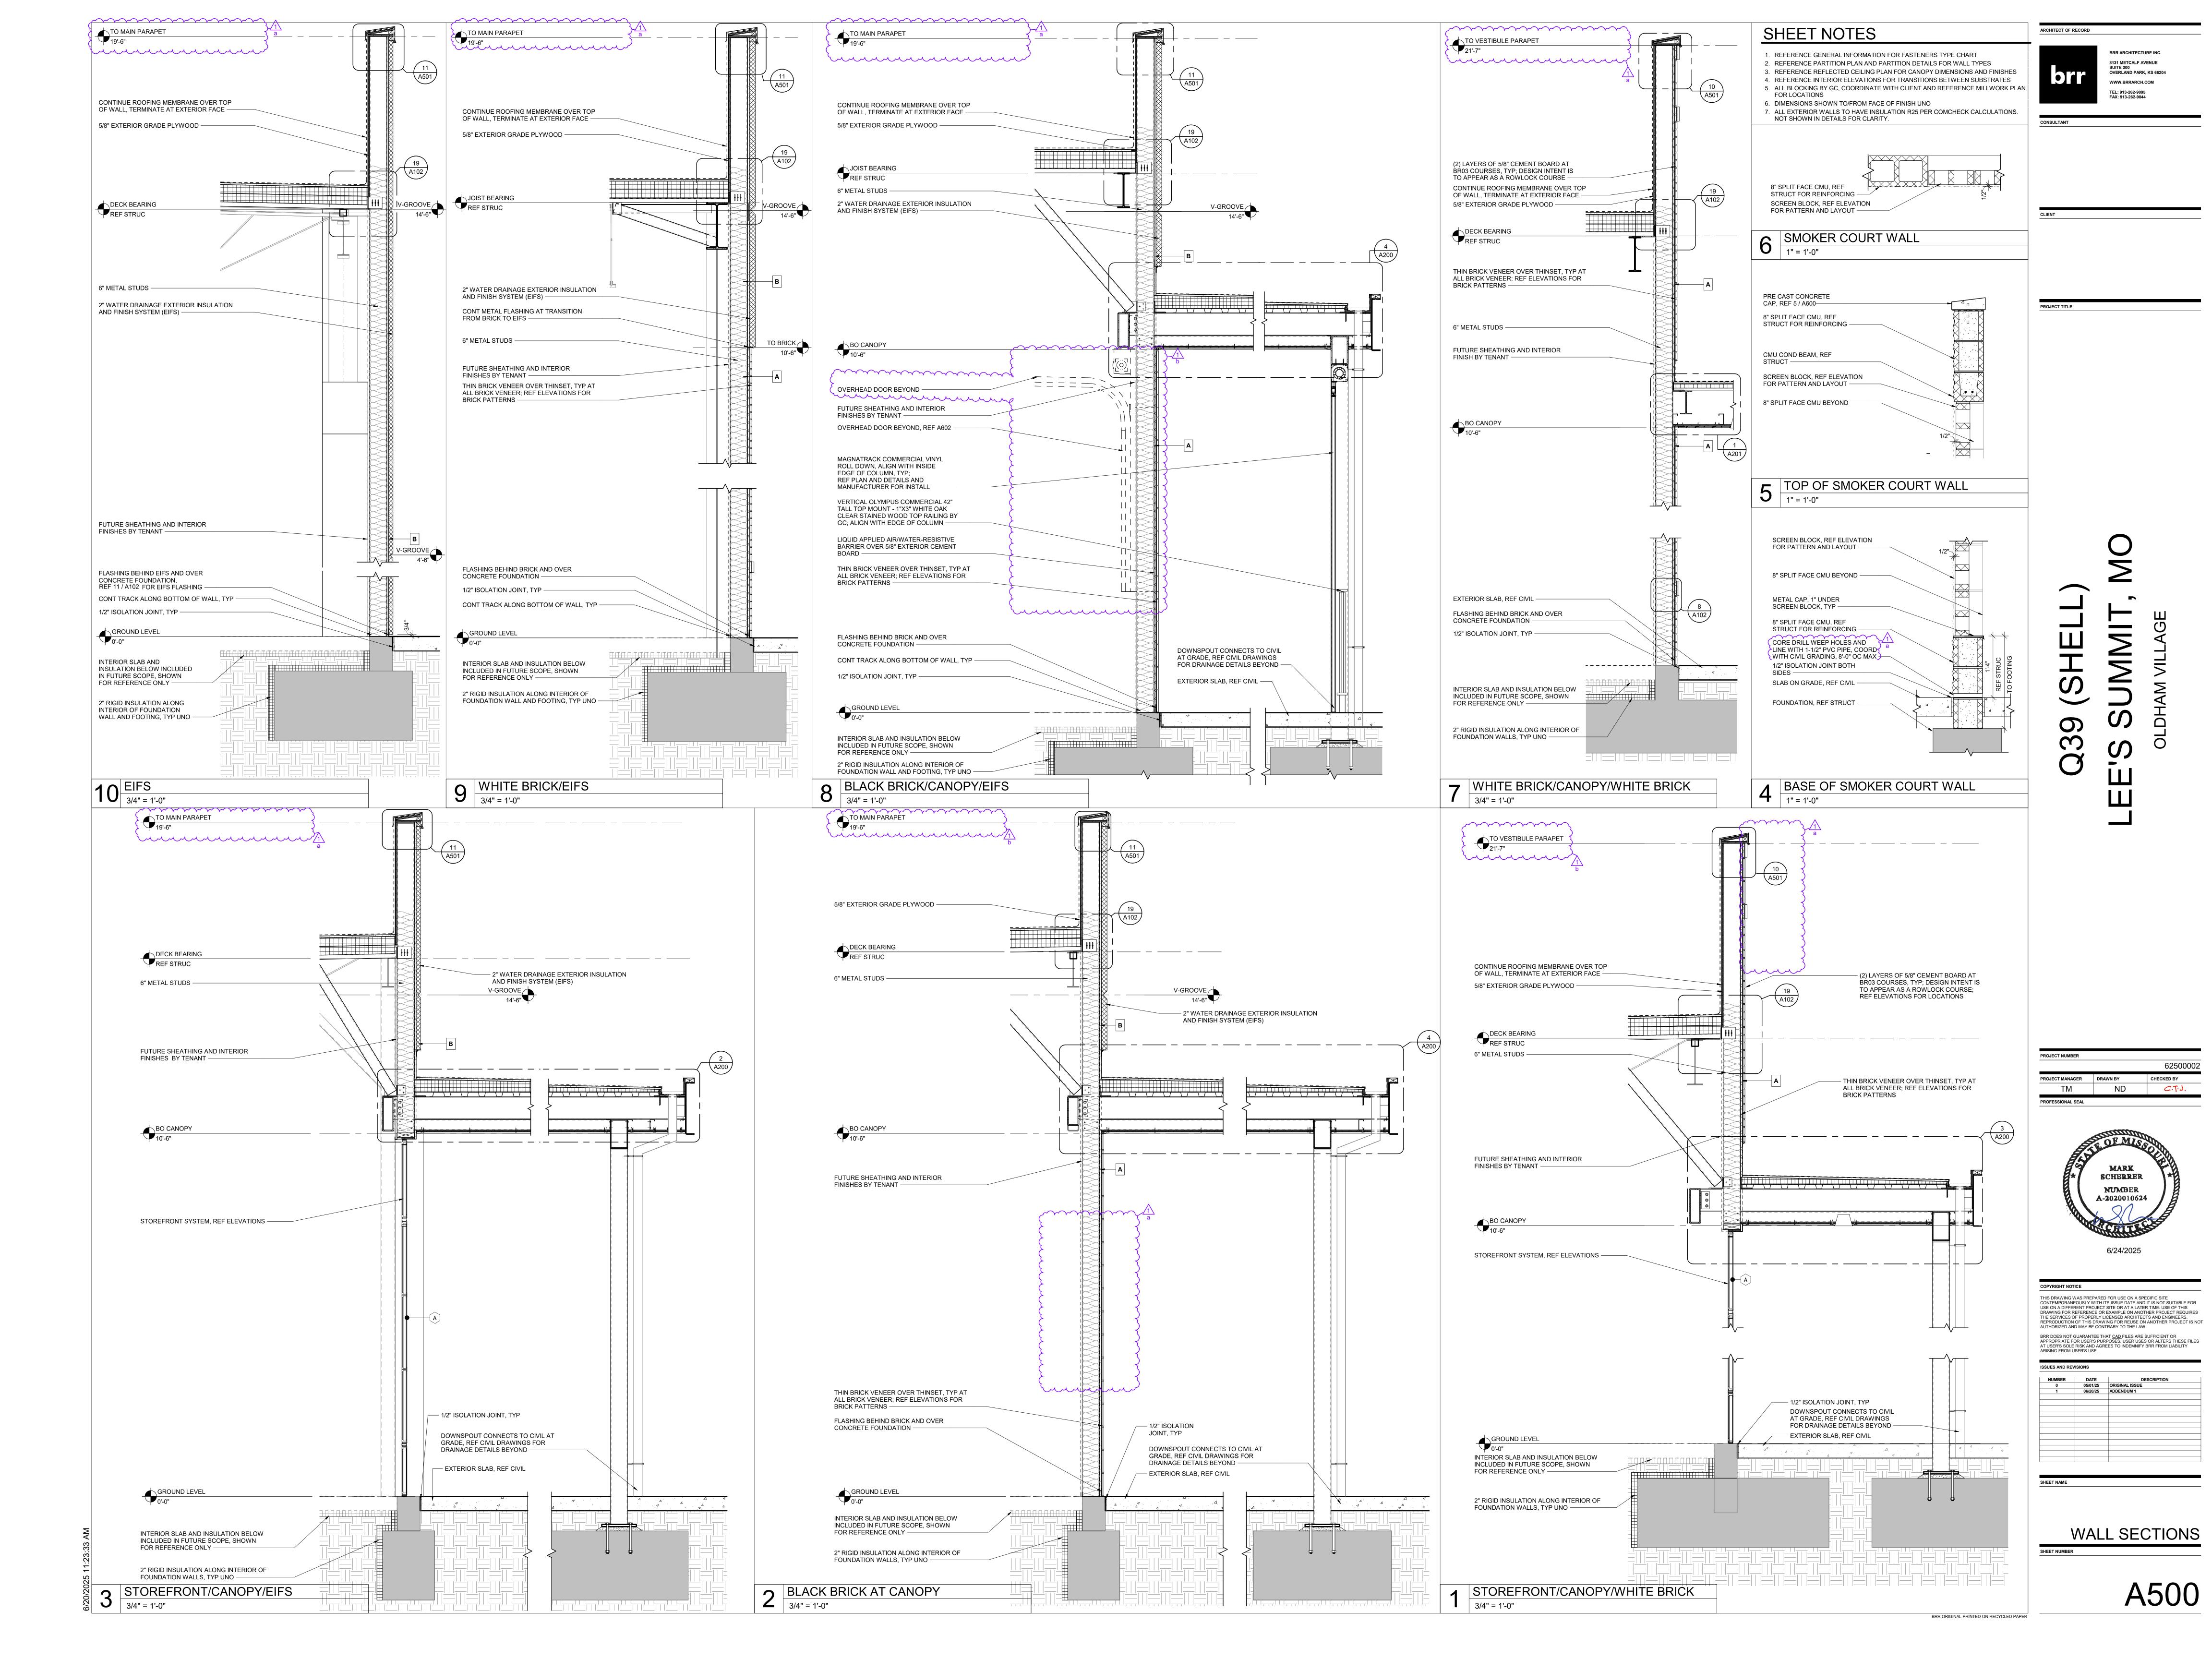


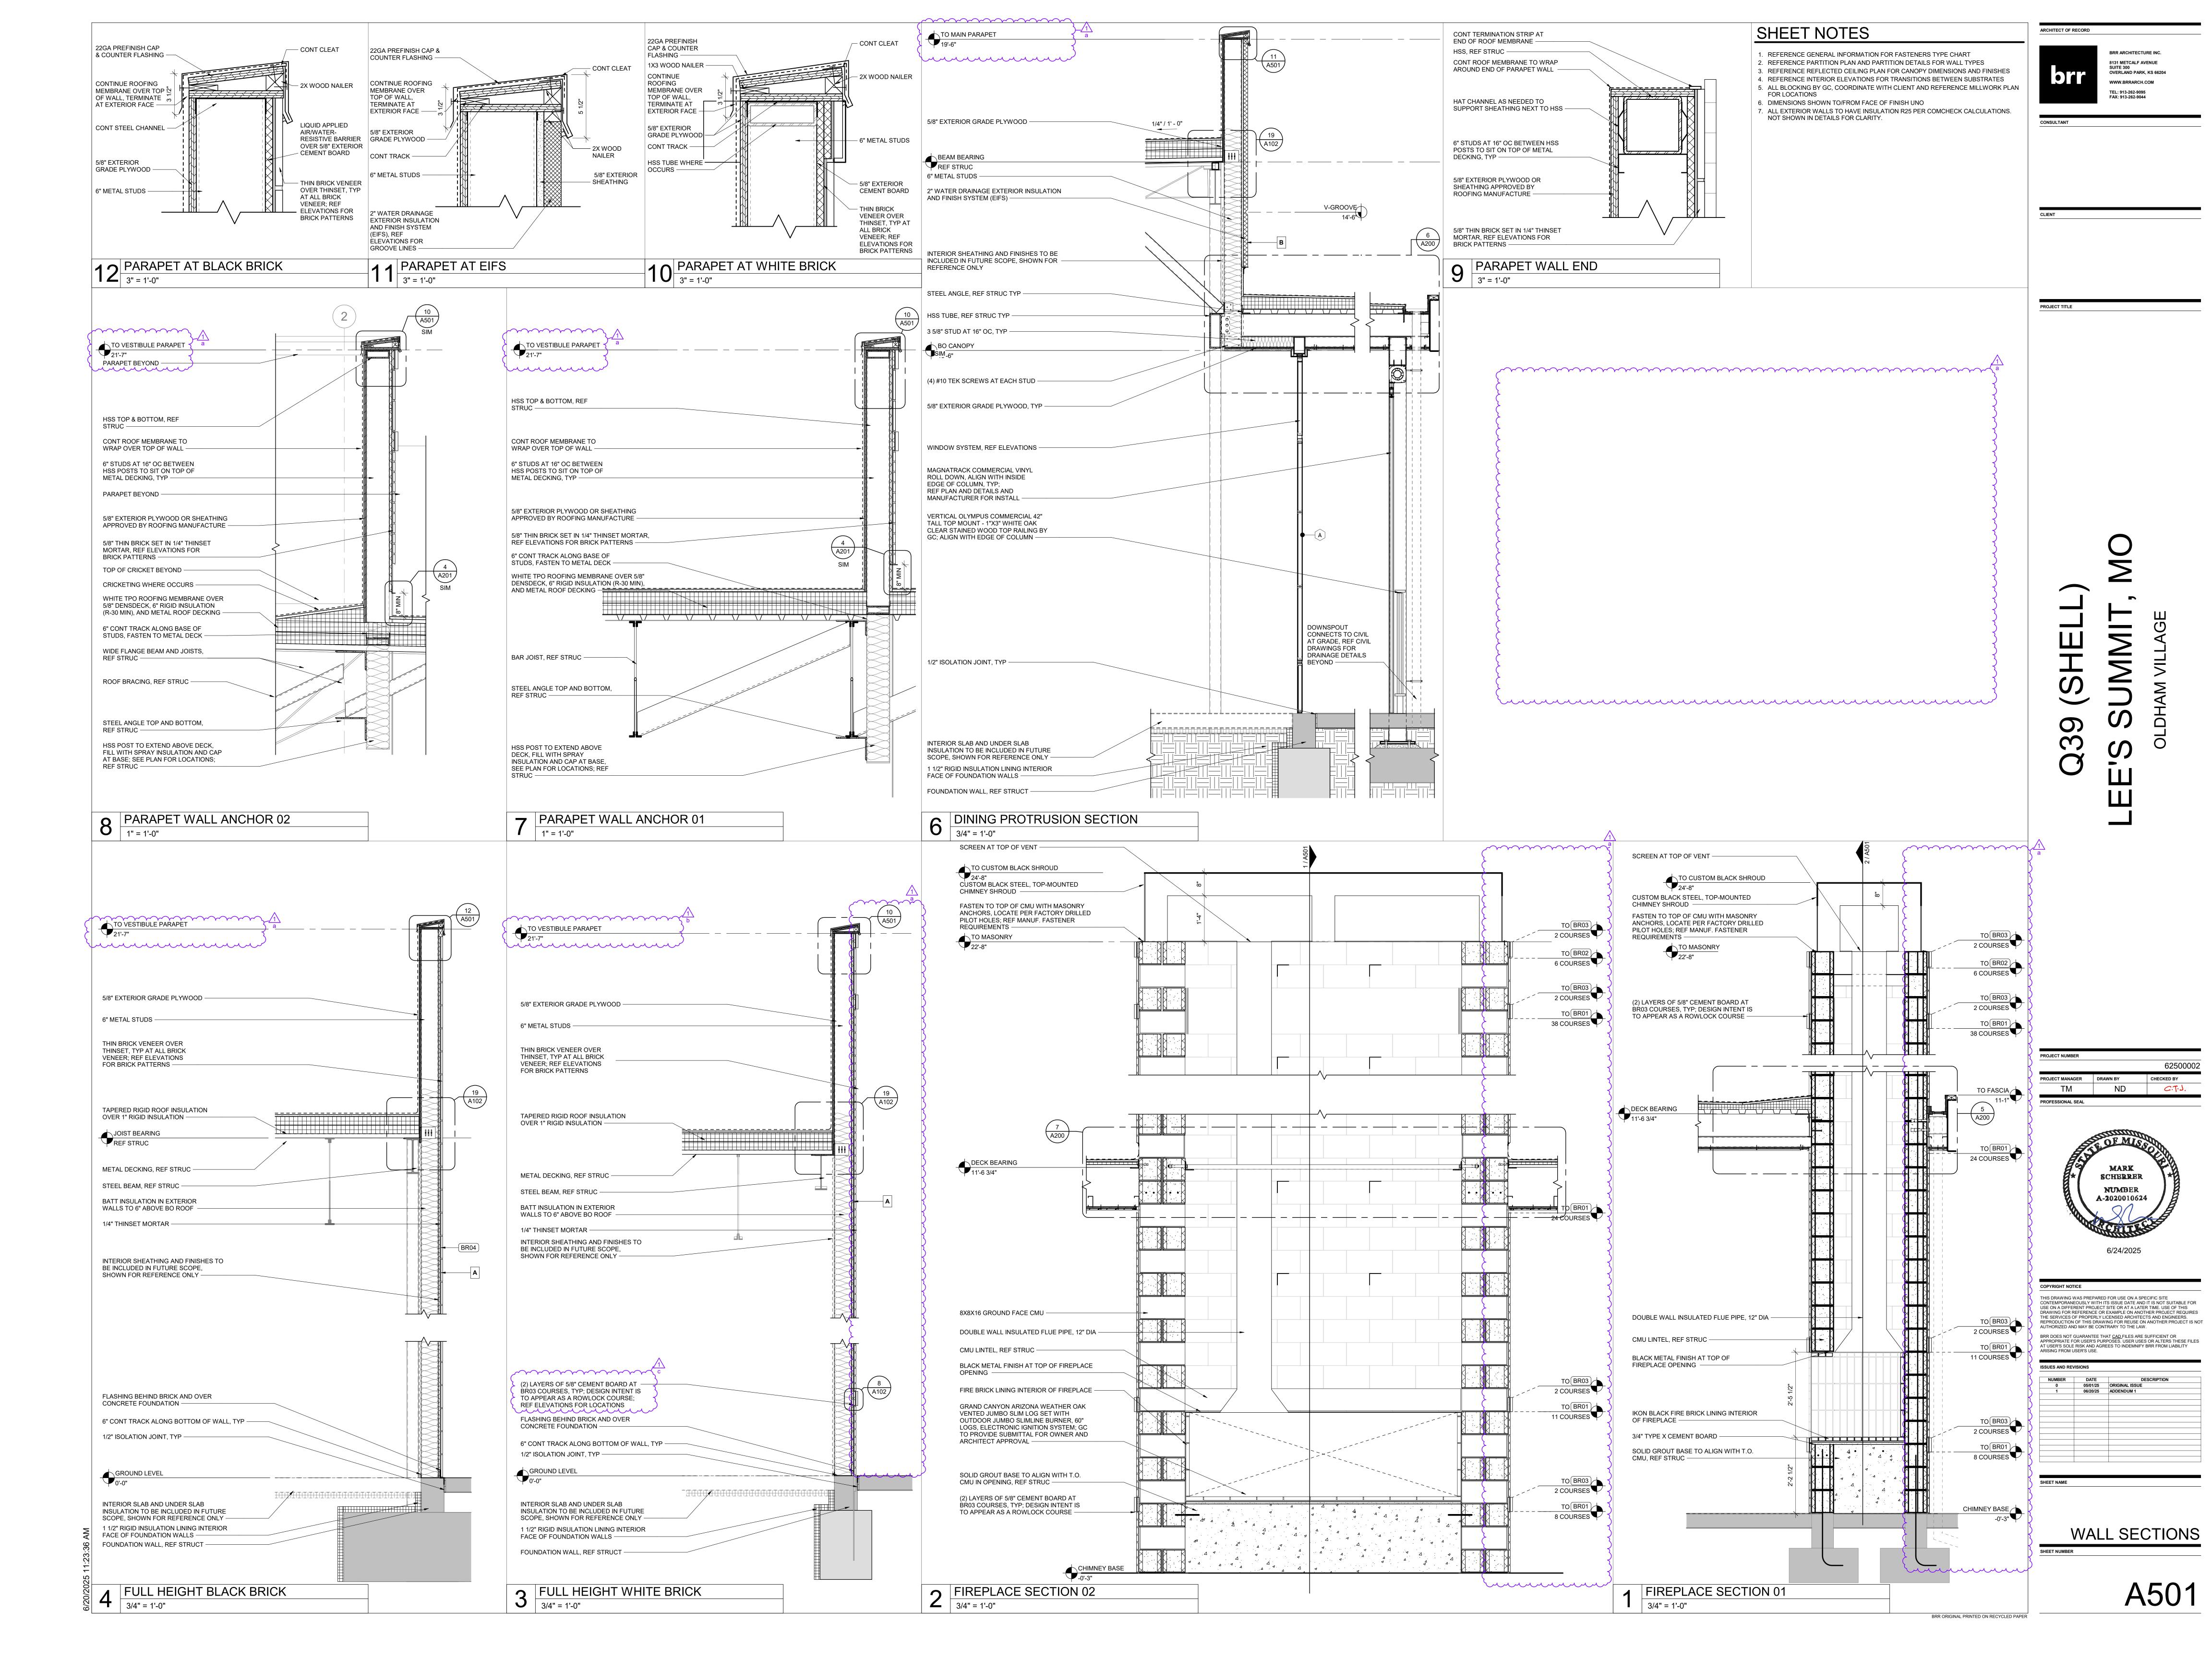

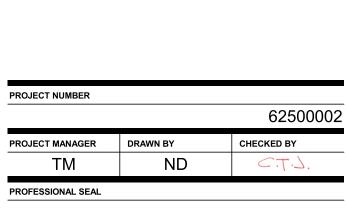

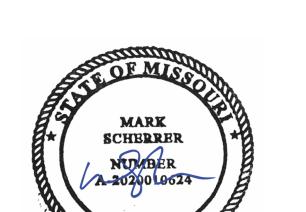


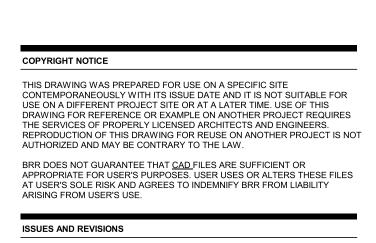

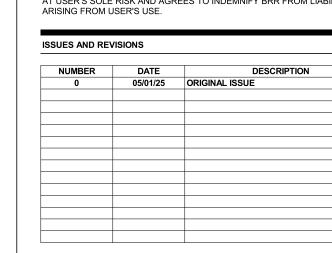


TRASH ENCLOSURE PLAN AND DETAILS

BRR ORIGINAL PRINTED ON RECYCLED PAPER

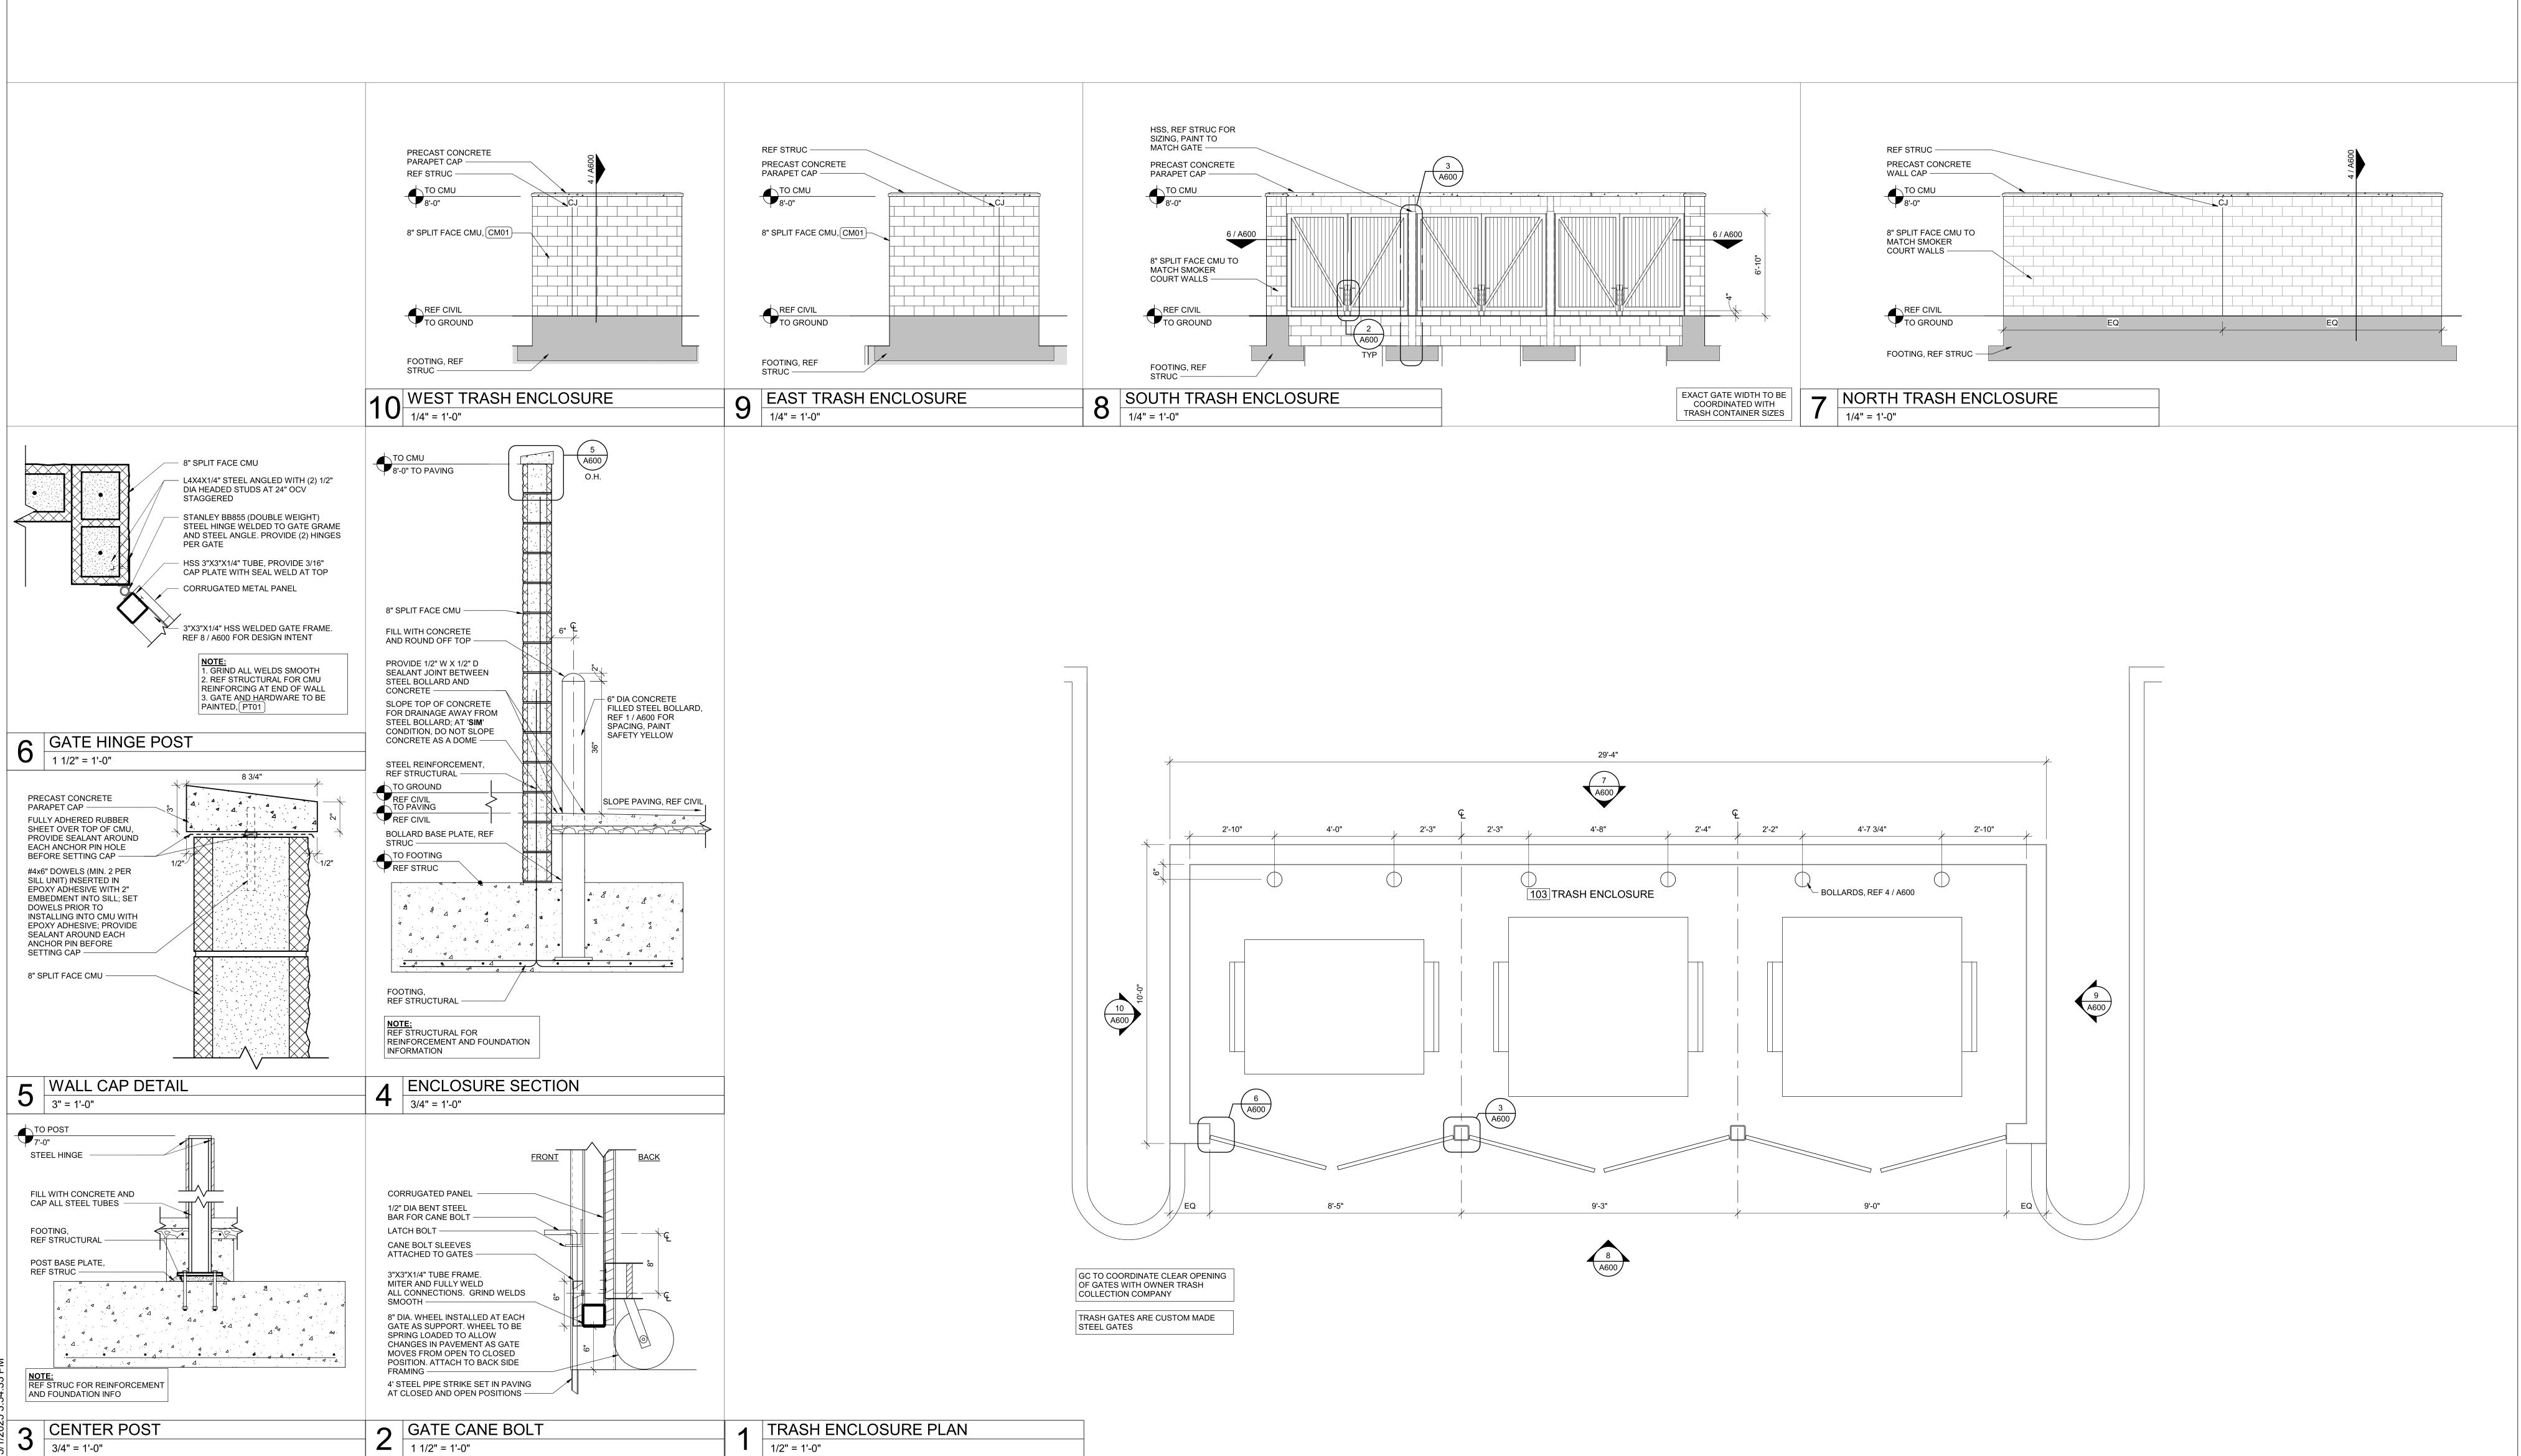



1/2" = 1'-0"


3/4" = 1'-0"

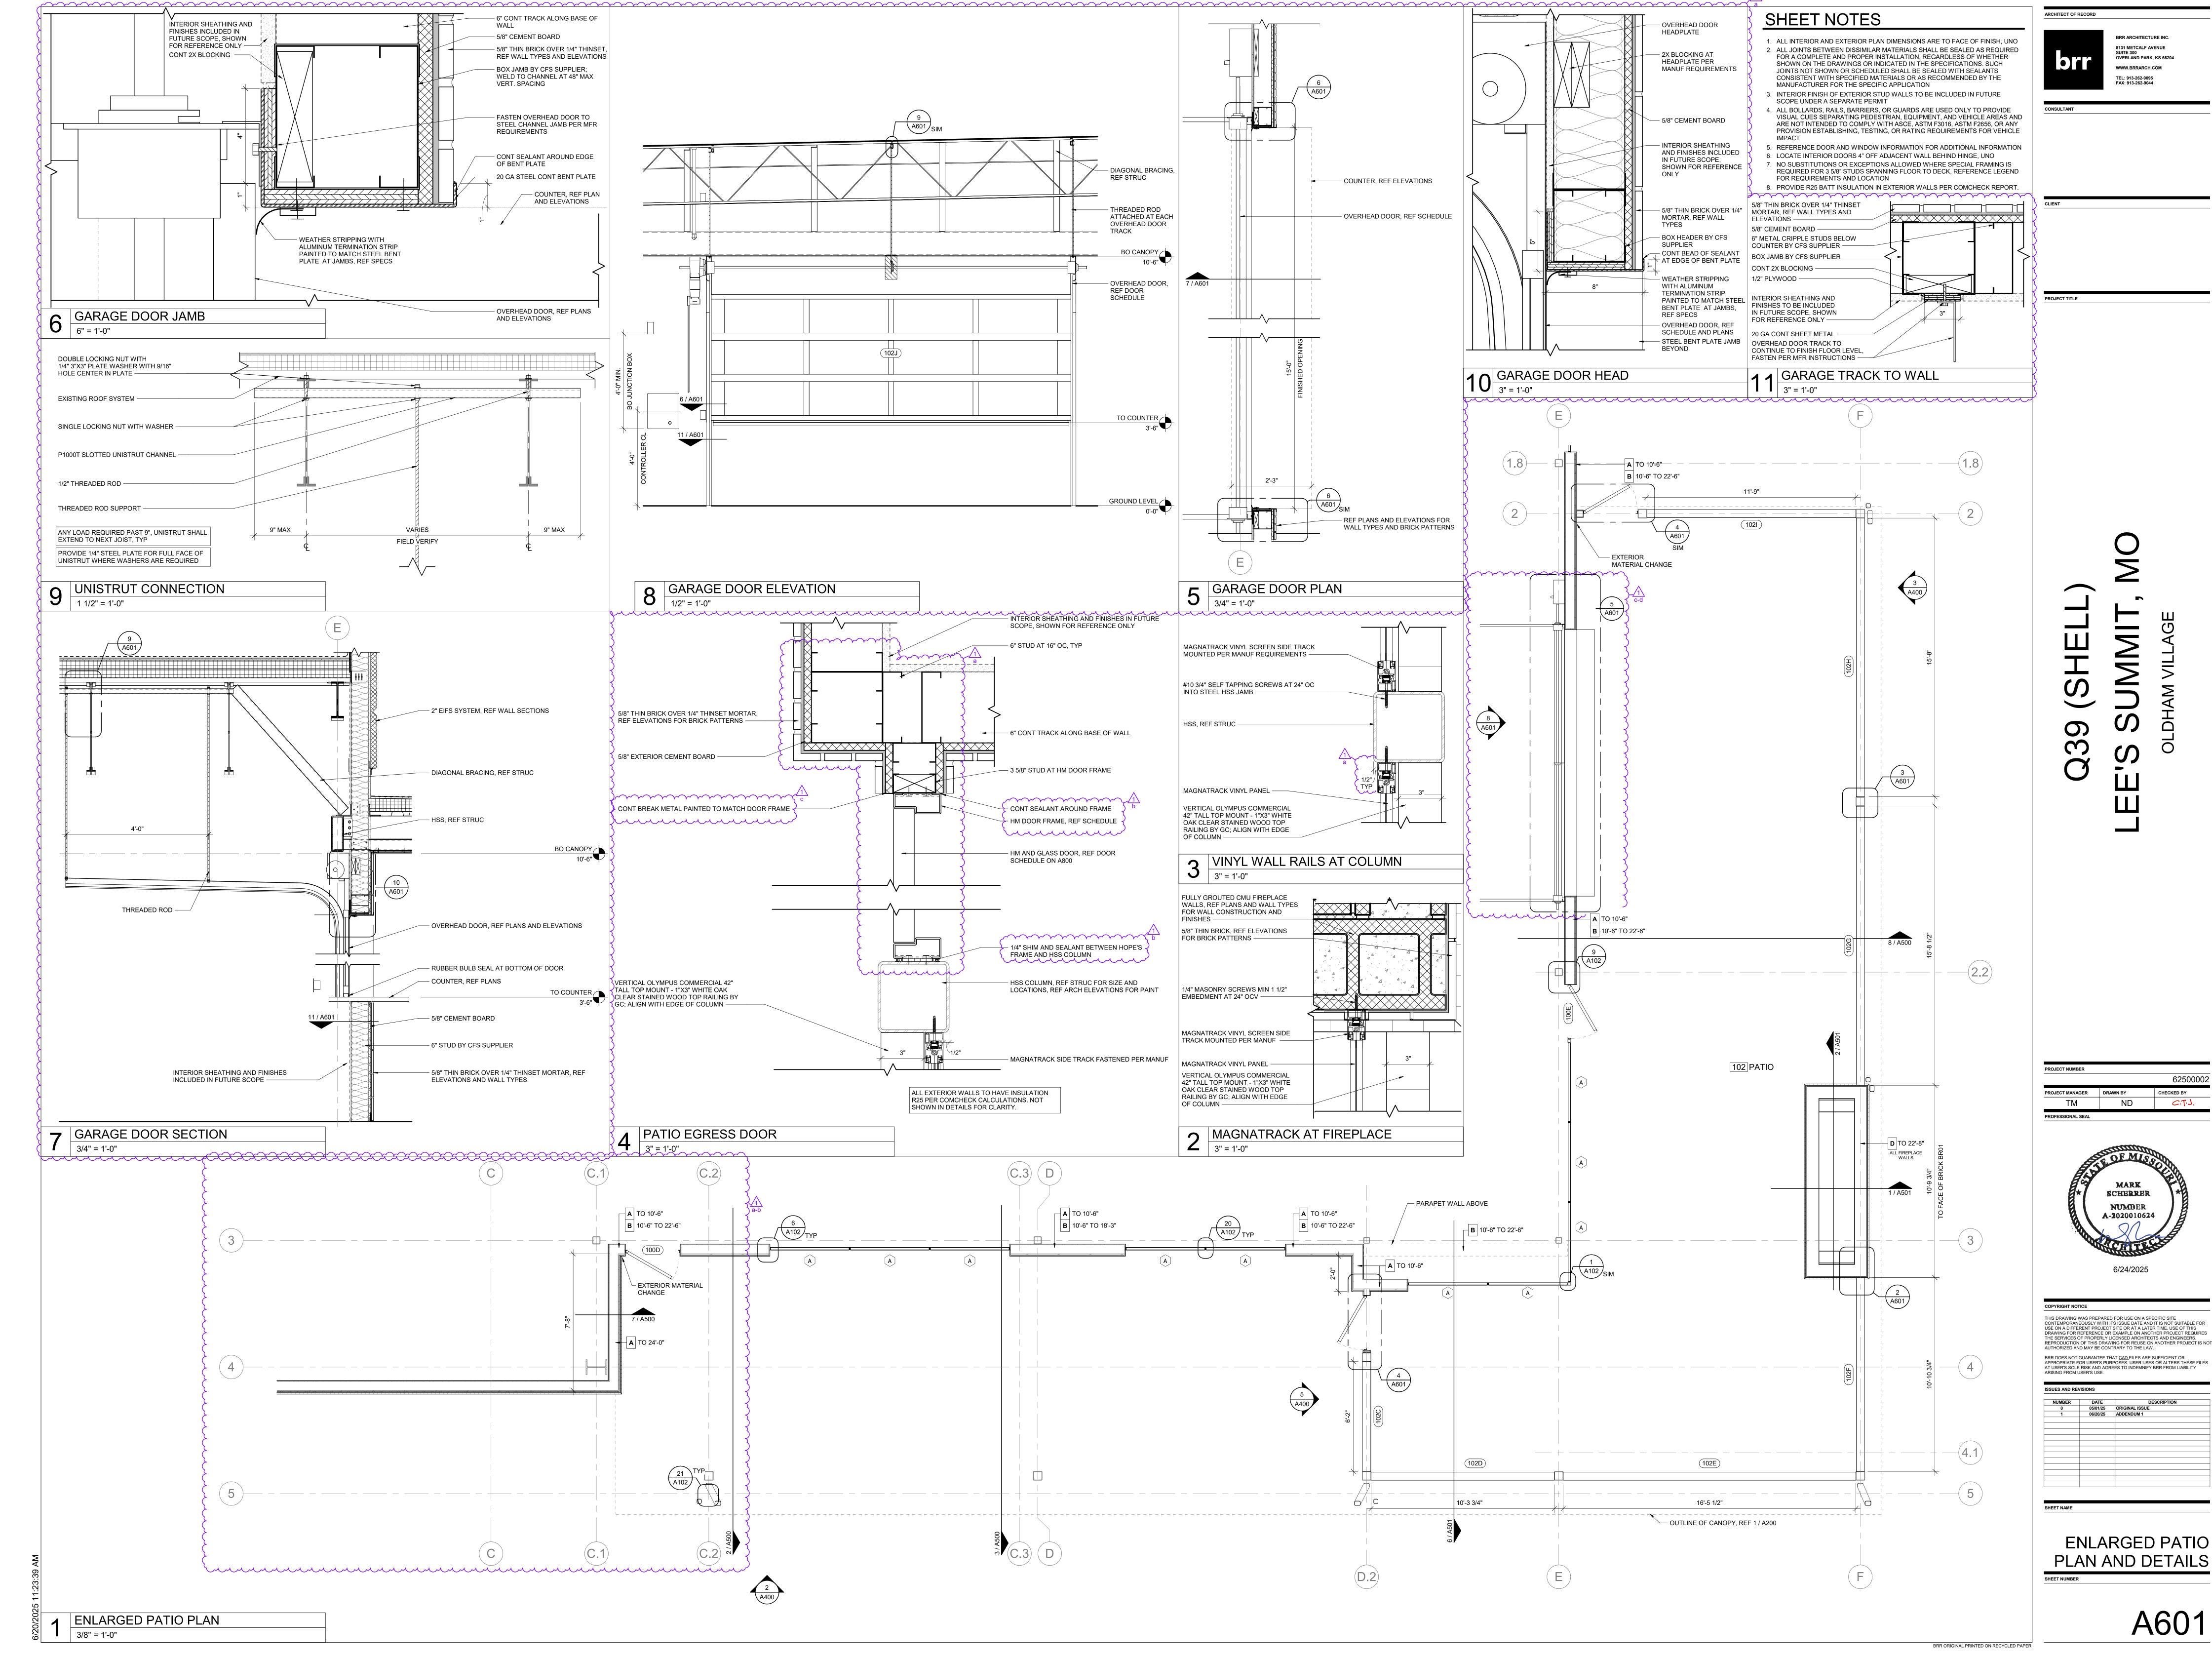


THE SERVICES OF PROPERLY LICENSED ARCHITECTS AND ENGINEERS.
REPRODUCTION OF THIS DRAWING FOR REUSE ON ANOTHER PROJECT IS NOT AUTHORIZED AND MAY BE CONTRARY TO THE LAW.

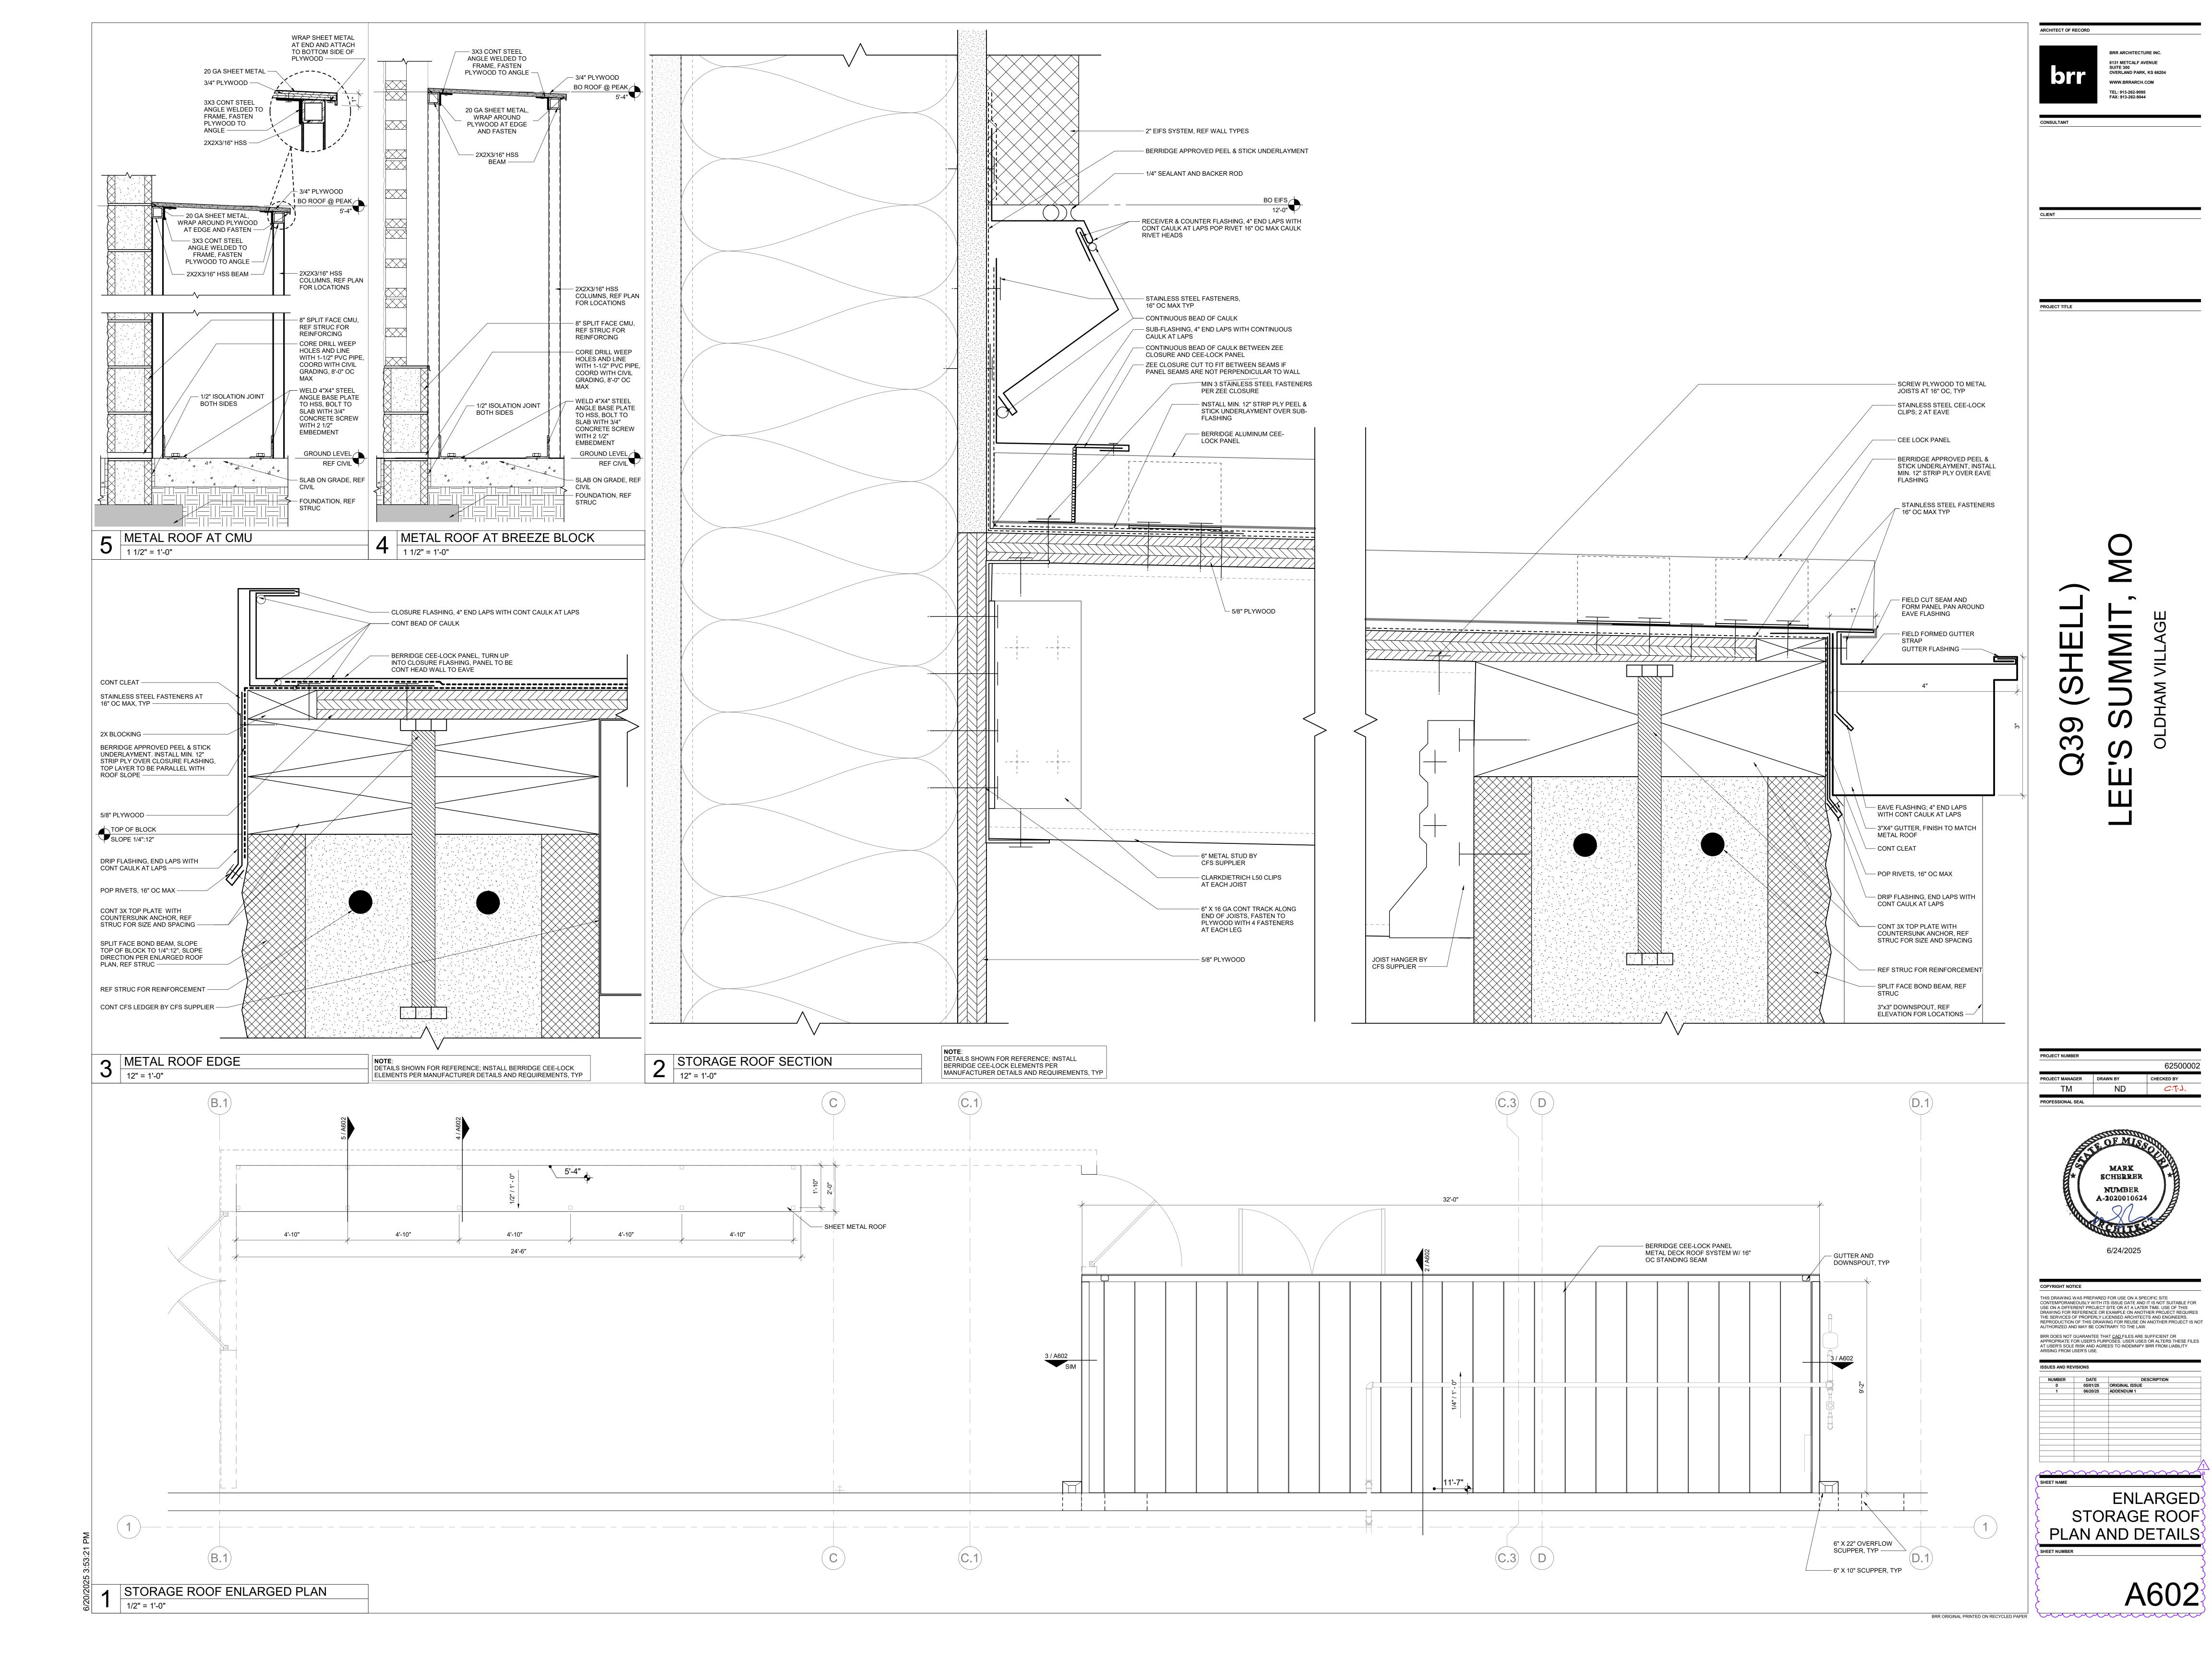

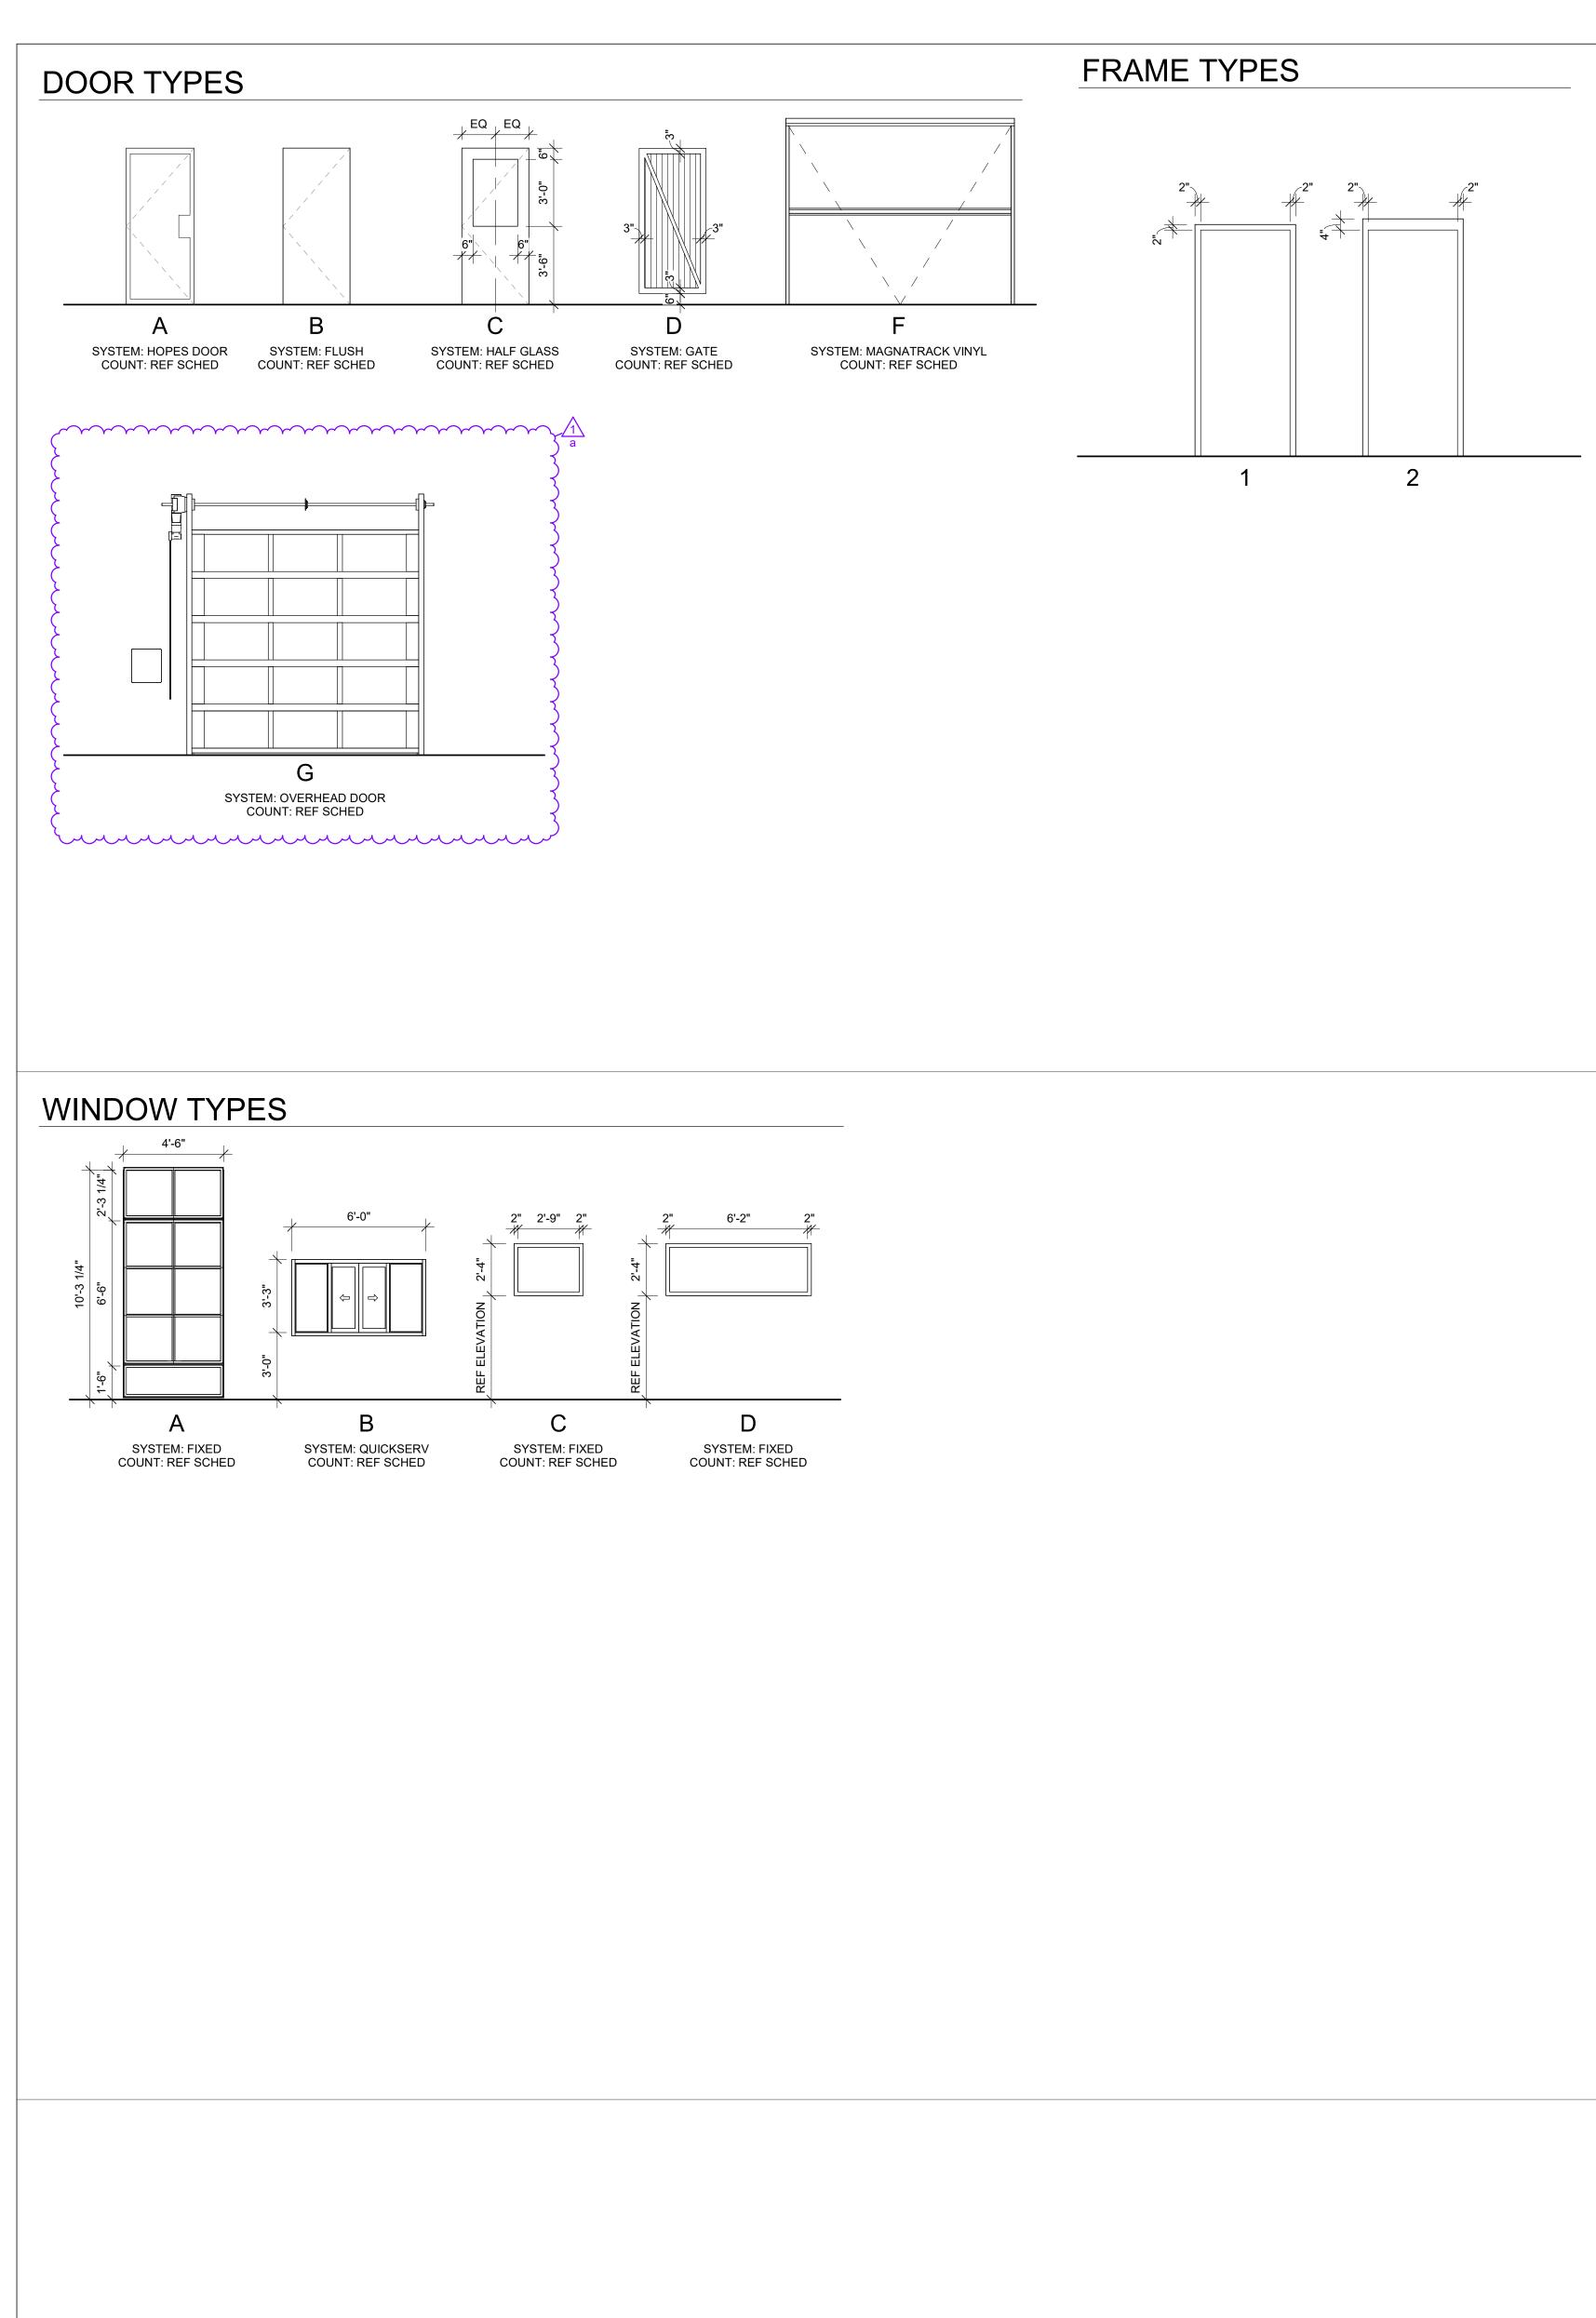

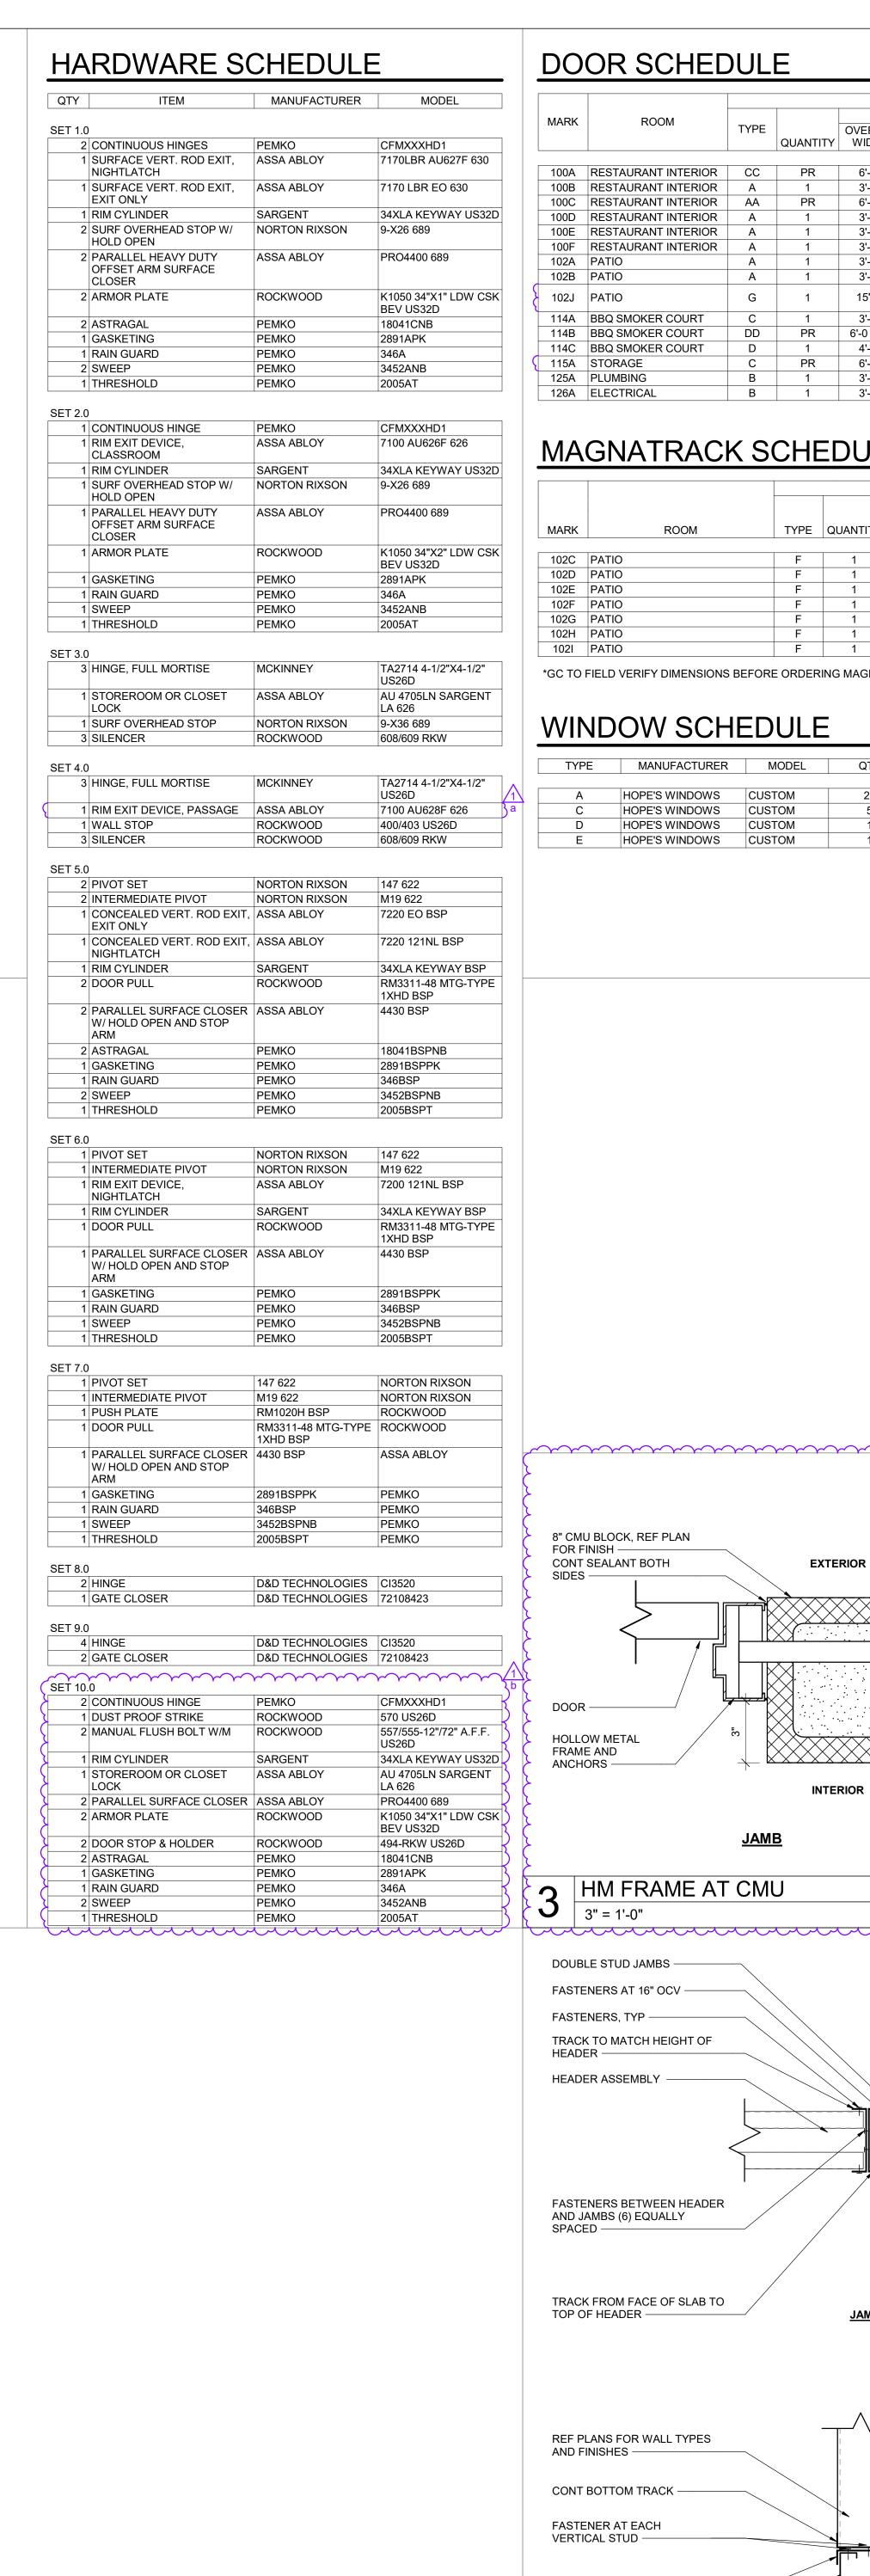

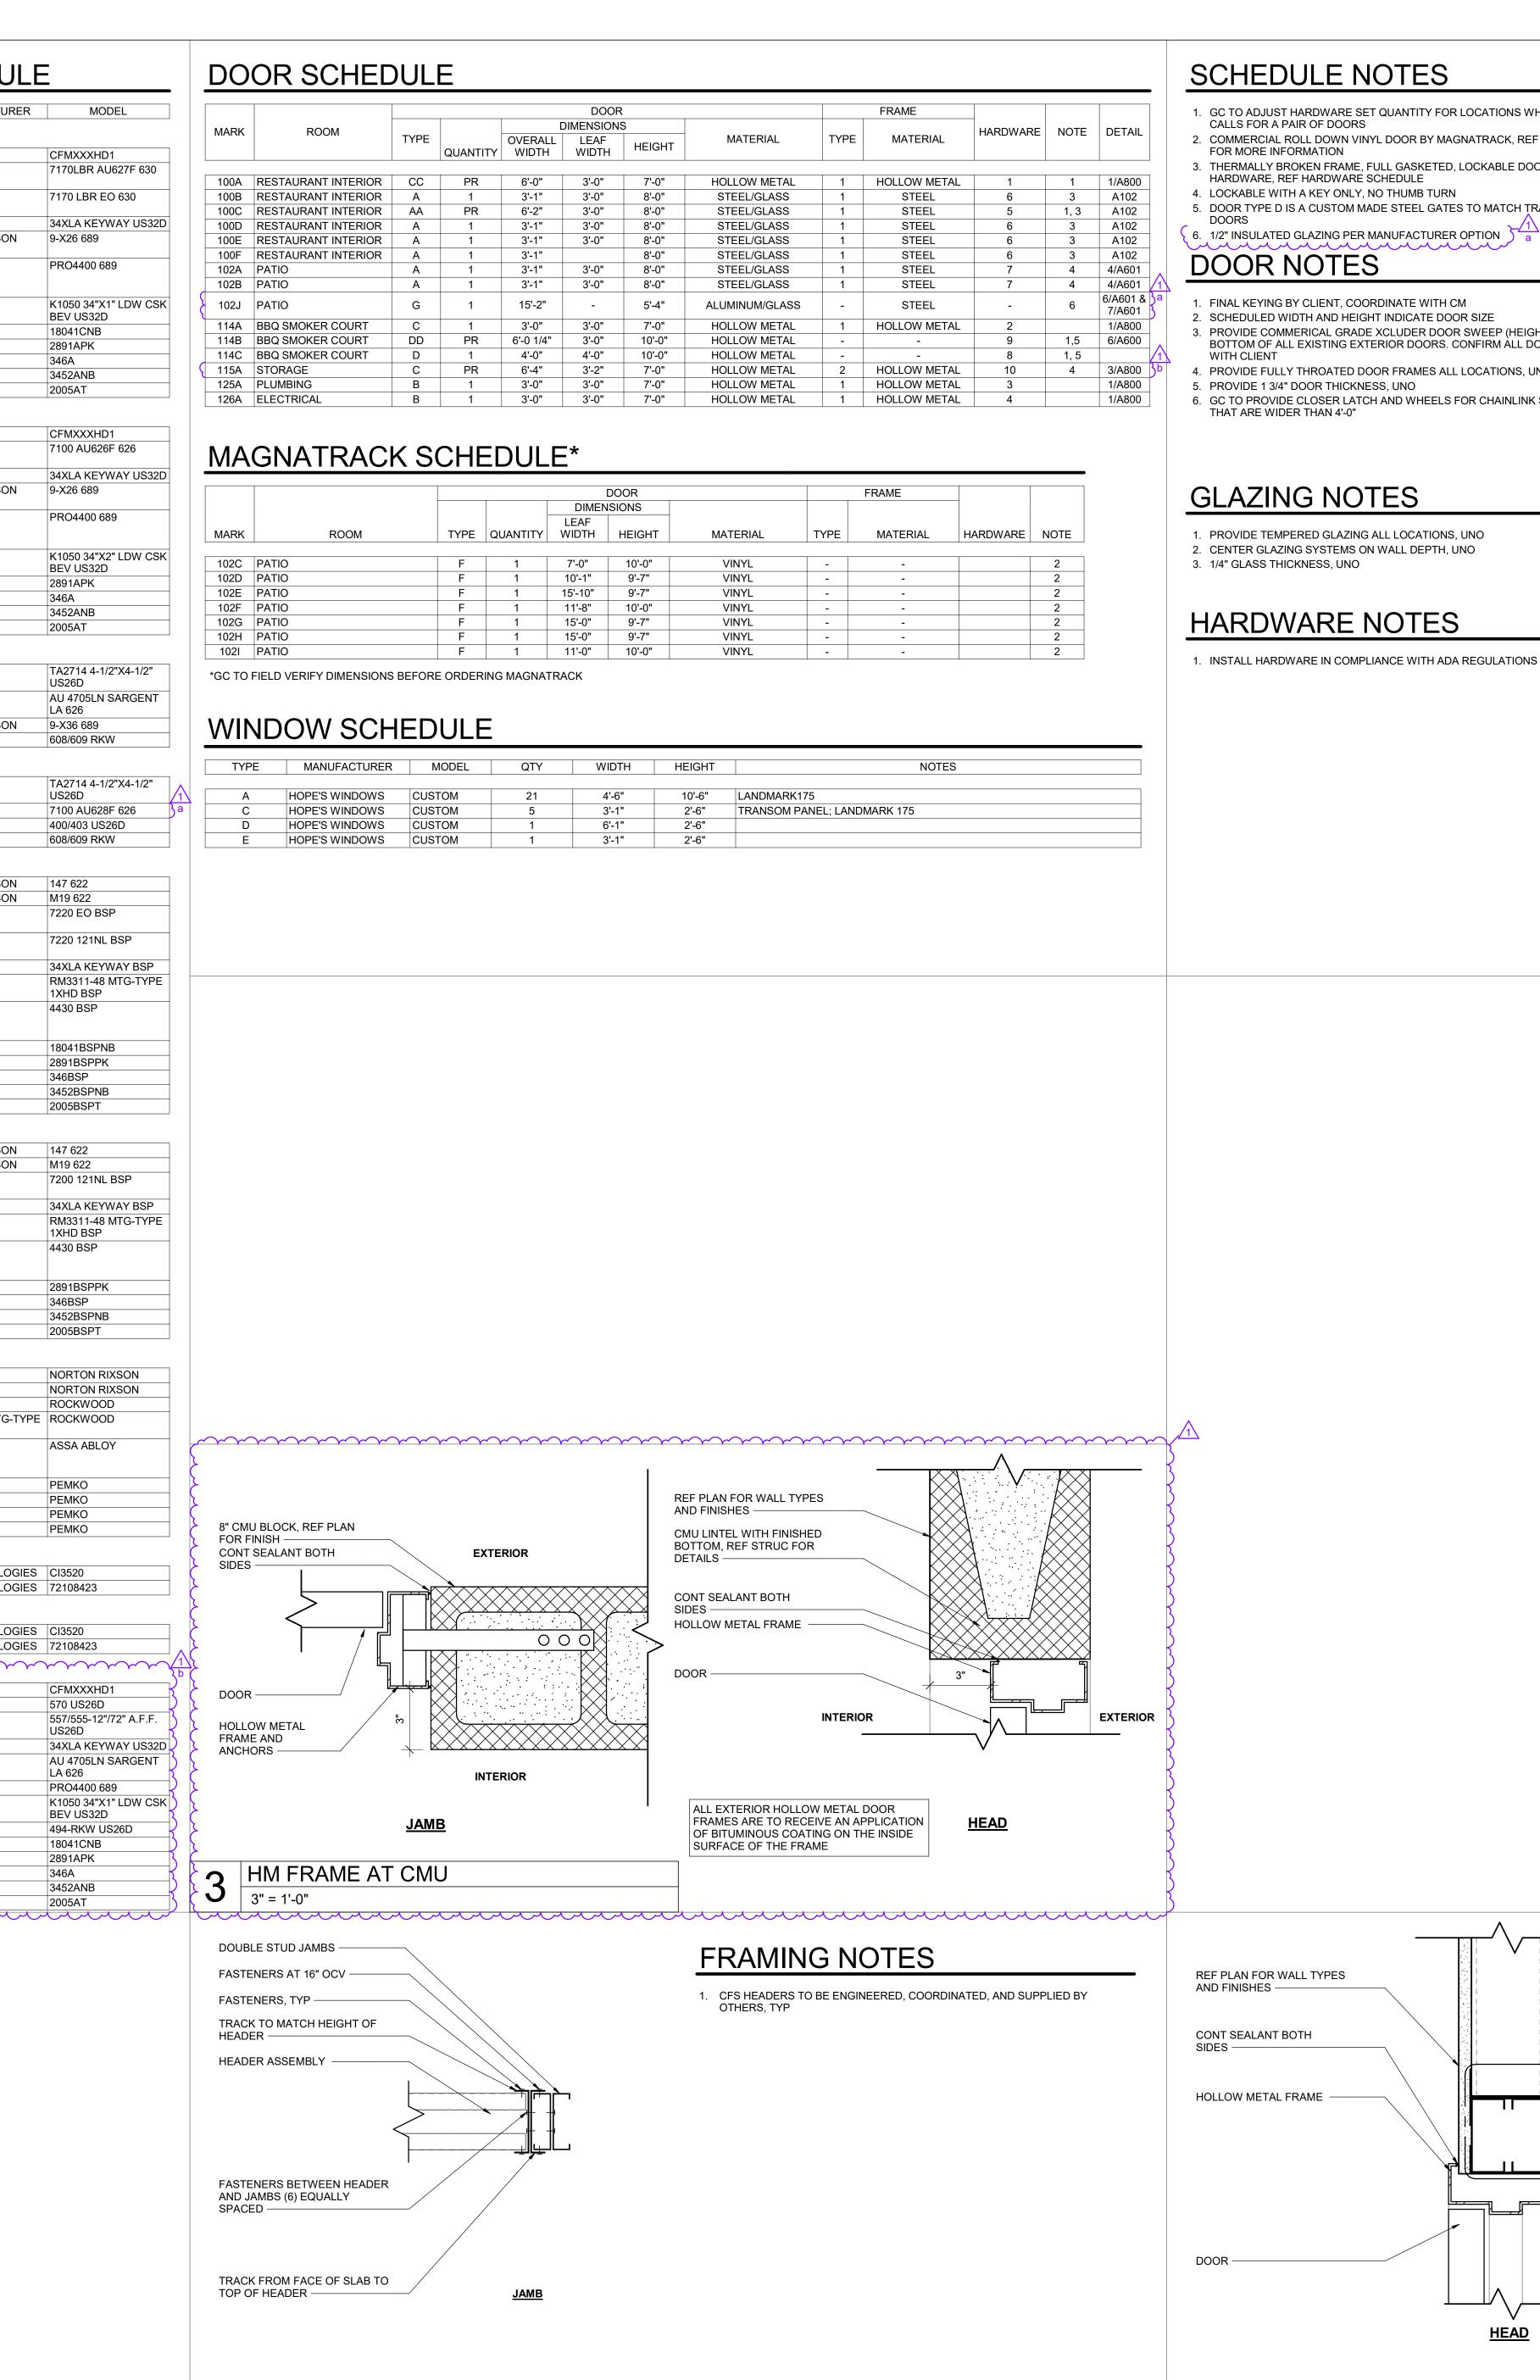

- 1. GC TO ADJUST HARDWARE SET QUANTITY FOR LOCATIONS WHERE OPENING
- 2. COMMERCIAL ROLL DOWN VINYL DOOR BY MAGNATRACK, REF MANUFACTURER
- 3. THERMALLY BROKEN FRAME, FULL GASKETED, LOCKABLE DOOR WITH PANIC
- 5. DOOR TYPE D IS A CUSTOM MADE STEEL GATES TO MATCH TRASH ENCLOSURE
- 2. SCHEDULED WIDTH AND HEIGHT INDICATE DOOR SIZE 3. PROVIDE COMMERICAL GRADE XCLUDER DOOR SWEEP (HEIGHT MAY VERY) AT BOTTOM OF ALL EXISTING EXTERIOR DOORS. CONFIRM ALL DOOR LOCATIONS
- 4. PROVIDE FULLY THROATED DOOR FRAMES ALL LOCATIONS, UNO
- 6. GC TO PROVIDE CLOSER LATCH AND WHEELS FOR CHAINLINK SWING GATES

S

ARCHITECT OF RECORD

CONSULTANT

PROJECT TITLE

BRR ARCHITECTURE INC.

8131 METCALF AVENUE SUITE 300 OVERLAND PARK, KS 66204


WWW.BRRARCH.COM

TEL: 913-262-9095 FAX: 913-262-9044

2 (A800)

BRR ORIGINAL PRINTED ON RECYCLED PAPER

62500002 CHECKED BY TM ND C.T.J. PROFESSIONAL SEAL

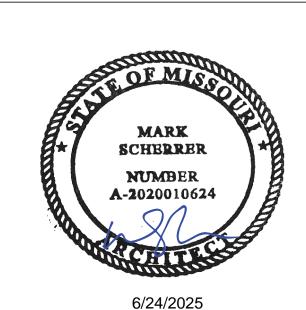

THIS DRAWING WAS PREPARED FOR USE ON A SPECIFIC SITE CONTEMPORANEOUSLY WITH ITS ISSUE DATE AND IT IS NOT SUITABLE FOR USE ON A DIFFERENT PROJECT SITE OR AT A LATER TIME. USE OF THIS DRAWING FOR REFERENCE OR EXAMPLE ON ANOTHER PROJECT REQUIRES THE SERVICES OF PROPERLY LICENSED ARCHITECTS AND ENGINEERS.
REPRODUCTION OF THIS DRAWING FOR REUSE ON ANOTHER PROJECT IS NOT AUTHORIZED AND MAY BE CONTRARY TO THE LAW. BRR DOES NOT GUARANTEE THAT <u>CAD</u> FILES ARE SUFFICIENT OR APPROPRIATE FOR USER'S PURPOSES. USER USES OR ALTERS THESE FILES AT USER'S SOLE RISK AND AGREES TO INDEMNIFY BRR FROM LIABILITY ARISING FROM USER'S USE.

DOOR AND WINDOW

CONT TOP TRACK CONT STUD HEADERS -CONT BOTTOM TRACK -FASTENERS AT 12" OC -FASTENERS, TYP -

STUD HEADER

1 1/2" = 1'-0"

FASTENERS (3) PER LEG — TRACK TO MATCH HEIGHT OF HEADER — METAL STUD HEADER — TRACK FROM FACE OF SLAB TO TOP OF HEADER — DOUBLE STUD JAMBS -

WALL ABOVE, REF PLANS FOR

WALL TYPES AND FINISHES -

ELEVATION _____

FRAME AT HM

POSSIBLE SIDE WALL

LOCATION, REF PLAN -

HOLLOW METAL FRAME

CONT SEALANT BOTH

AND FINISHES —

3" = 1'-0"

REF PLAN FOR WALL TYPES

SIDES -

AND ANCHORS —