HANGER NAILING FOR UNIFORMLY LOADED BEAMS

Joist & Beam Hanger Face Nailing Requirements* for 3 & 4 Ply Supporting Members

For IUS or THF Hangers - Use 10d (0.148") x 3" nails.

For U, MIU, HU, HHUS, HGUS or HD, THD, THDH Hangers - Use 16d (0.162") x 3 ½" nails.

*For hangers that have joist fasteners/connections, fill all holes with the manufacturer's recommended fasteners.

MULTIPLE PLY CONNECTION NAILING FOR UNIFORMLY LOADED BEAMS

2&3 PLY BEAMS	NAILED CONNECTION
9½" - 11⅞" Depth	(3) Rows of 10d (0.128") x 3" Box Nails at 12" o.c.
14" - 24" Depth	(4) Rows of 10d (0.128") x 3" Box Nails at 12" o.c.
4 PLY BEAM	**NAILED CONNECTION**
9½" - 24" Depth	(4) Rows of 10d (0.128") x 3" Box Nails at 12" o.c.

- 16d (0.131") pneumatic nails may be substituted for 10d (0.128") Box nails.
- Stagger nails by 6" per ply
- All plies must be same material, grade, and 1¾" thickness.
-Joist Hanger's connecting into the side of the beam must be installed with minimum 3" long nails.

MULTIPLE PLY CONNECTION NAILING FOR POINT LOADS

Hanger shown for reference. Install screws from side opposite of hanger. Install ½ the required screws on each side of hanger

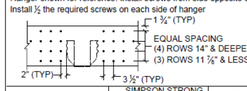

		SIMPSON STRONG-TIE® HANGERS				USP HANGERS		
	3 PLY SUPPORT BEAM	U	HU	HHUS	HGUS	HD	THD	THDH
Typ.	TOTAL # OF 3 ½" TRUSSLOK® SCREWS	4	6	8	14	6	12	16
Max.	TOTAL # OF 3 ½" SIMPSON SDS SCREWS	4	4	6	12	6	10	12
	4 PLY SUPPORT BEAM	U	HU	HHUS	HGUS	HD	THD	THDH
Typ.	TOTAL # OF 6 ¾" TRUSSLOK® SCREWS	4	6	10	20	8	16	20
Max.	TOTAL # OF 6" SIMPSON SDS SCREWS	6	8	12	24	10	20	26

- Connections based on FastenMaster TrussLok® and Simpson Strong-Tie® code reports.
- All plies assumed to be the same material, grade, and 1 ¾" in thickness
- Connections based on given hangers maximum capacity at 100% Load Duration Factor. Adequate for 115% and 125% Load Duration Factor as well.
- Connection assumes the use of 16d nails and max nailing in hangers.
-See TB-300 for alternate connector types and loading.

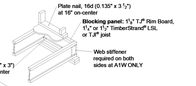

A1 A1W Attach blocking per Rim Board Details and Installation in *Weyerhaeuser Installation Guide for Floor and Roof Framing, TJ-9001.*

When sheathing thickness exceeds 7/8", trim sheathing tongue at rim board

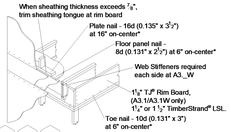

A3 A3.1 A3.2 A3.3

A3W A3.1 W A3.2 W A3.3 W

* For A3.1-A3.3 installation specifications see Rim Board Details and Installation in *Weyerhaeuser Installation Guide for Floor and Roof Framing, TJ-9001.*

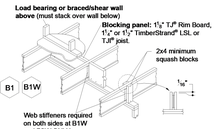

B1 B1W

B2 B2W Blocking panels may be required with braced/shear walls above or below — see detail B1

No load bearing wall above

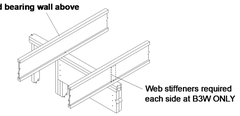

B3 B3W Blocking panels may be required with braced/shear walls above or below — see detail B1

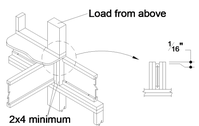

CS ***Use 2x4 minimum squash blocks to transfer load around TJI® joist***

SCAN WITH YOUR SMARTPHONE
INSTALLATION GUIDE FOR FLOOR AND ROOF FRAMING
wy.com/woodproducts/document-library/tj-9001

SCAN WITH YOUR SMARTPHONE
DAMAGE REPORTING MOBILE TOOL
damagereport.woodbyway.com

Actual materials and quantities may vary due to jobsite conditions, design changes and installation variations. It is the responsibility of the Builder for this Layout to be reviewed and Approved by an appropriate Design Professional as required by the permitting authority.

ALL ROOF LOADS ASSUMED TO BE SUPPORTED AT EXTERIOR WALLS AND BEAMS BY OTHERS, IF APPLICABLE, UNLESS OTHERWISE NOTED.
NO ROOF LOADS APPLIED TO FLOOR MEMBERS.

11 7/8" TJI
210'S 16" O.C.
UNLESS OTHERWISE NOTED

EVERSTEAD
SHOP DRAWINGS/SUBMITTAL REVIEW

SUBMITTAL WAS REVIEWED FOR DESIGN CONFORMITY AND GENERAL CONFORMANCE TO CONTRACT DOCUMENTS ONLY. THE CONTRACTOR IS RESPONSIBLE FOR CONFIRMING AND CORRELATING DIMENSIONS AT JOBSITE FOR TOLERANCE, CLEARANCE, QUANTITIES, FABRICATION, COORDINATION OF HIS OR HER WORK WITH OTHER TRADES, AND FULL COMPLIANCE WITH CONTRACT DOCUMENTS.

STATUS:
APPROVED
09/22/2025
REVIEWED BY:
JTC
ENGINEER, EVERSTEAD ENGINEERING & DESIGN LLC.

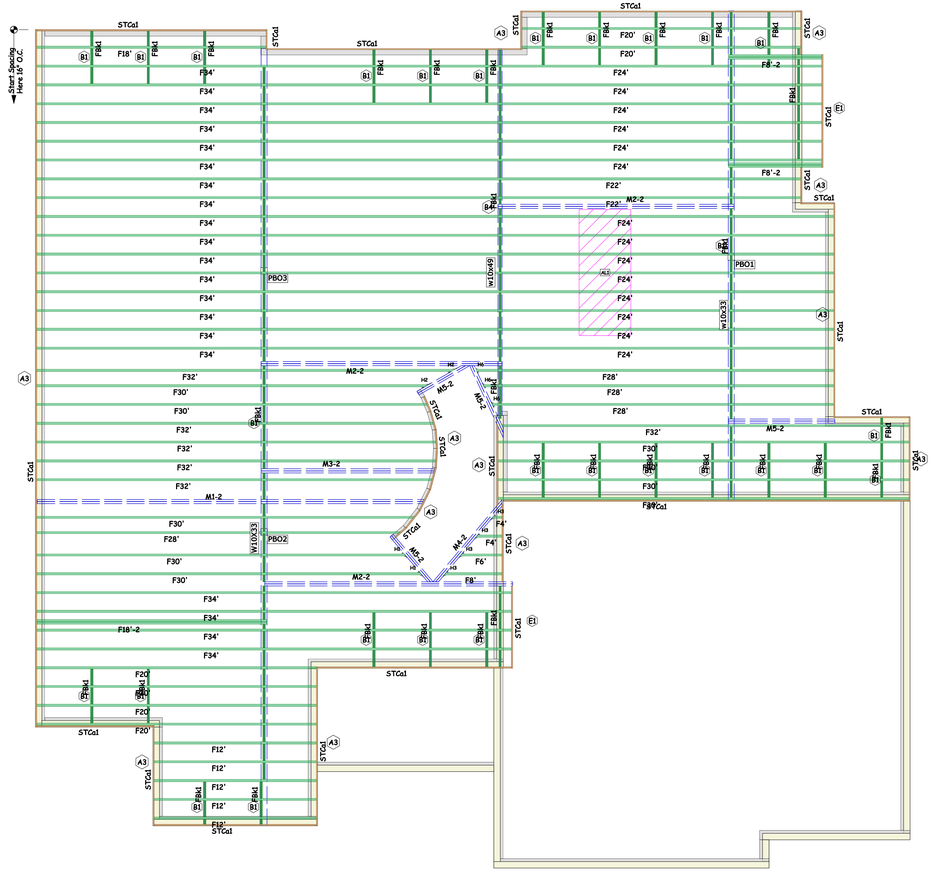

Framing Connector Summary												
PlotID	Qty	Manuf	Product	Design Method	Face Nails	Top Nails	Member Nails	Skew	Slope	Backer Blks	Filler	Web Stiff
H1	2	Simpson	LSSR2.1Z	Geometry Only	13- 10dx2.5	-	9- 10dx1.5	40 (L)	-	No	No	Yes
H2	2	Simpson	HU21/9X SKR60	Geometry Only	14- 10dx1.5	-	6- 10dx1.5	60 (R)	-	No	No	Yes
H3	4	Simpson	LSSR2.1Z	Geometry Only	13- 10dx2.5	-	9- 10dx1.5	40 (R)	-	No	No	Yes
H6	3	Simpson	LSSR2.1Z	Geometry Only	13- 10dx2.5	-	9- 10dx1.5	25 (L)	-	No	No	Yes

LEVEL NOTES	
Current Date:	9/12/2025
File Name:	fpm25-922.jvl
Level Name:	Foundation
Building Code:	IBC/IRC 2018
Members with Design Overridden:	M2-2, M5-2
TJ-Pro Rating (Weighted Average):	44
Minimum Level TJ - Pro Rating & Joist:	TJ-Pro rating = 42, joist = F34'(i3281)
Maximum Level TJ - Pro Rating & Joist:	TJ-Pro rating = 73, joist = F8'-2(i3486)
FLOOR	
Floor Container:	FC1
Use/Occupancy:	ResidentialLivingAreas
Floor Area Loading is:	40.0 lb/ft² Live Load & 12.0 lb/ft² Dead Load
	Operator Added Additional Loads
Maximum Allowed Deflection:	L/480 Live Load & L/240 Total Load
TJ-Pro Rating Information:	
Weighted Average:	44
Directly Applied Ceiling:	None
Decking Attachment:	Glue and Nail
Decking Material:	23/32"x48"x96" Weyerhaeuser Edge Panel (0/24) T&G FF
Perpendicular Partition:	No
Strapping at max 8' o.c.:	None
Blocking at max 8' o.c.:	No
Poured Flooring:	No

Accessories				
PlotID	Length	Product	Plies	Net Qty
	9 1/8"	3/4" x 2 5/16" Web Stiffeners	1	22
		23/32"x48"x96" Weyerhaeuser Edge Panel (0/24) T&G FF	1	78

Products				
PlotID	Length	Product	Plies	Net Qty
F34'	34' 0"	11 7/8" TJI 210 joist	1	20
F32'	32' 0"	11 7/8" TJI 210 joist	1	6
F30'	30' 0"	11 7/8" TJI 210 joist	1	9
F28'	28' 0"	11 7/8" TJI 210 joist	1	4
F24'	24' 0"	11 7/8" TJI 210 joist	1	14
F22'	22' 0"	11 7/8" TJI 210 joist	1	2
F20'	20' 0"	11 7/8" TJI 210 joist	1	6
F18'-2	18' 0"	11 7/8" TJI 210 joist	2	2
F18'	18' 0"	11 7/8" TJI 210 joist	1	1
F12'	12' 0"	11 7/8" TJI 210 joist	1	5
F8'-2	8' 0"	11 7/8" TJI 210 joist	2	4
F8'	8' 0"	11 7/8" TJI 210 joist	1	1
F6'	6' 0"	11 7/8" TJI 210 joist	1	1
F4'	4' 0"	11 7/8" TJI 210 joist	1	2
M1-2	30' 0"	1 3/4" x 11 7/8" 2.0E Microllam LVL	2	2
M2-2	18' 0"	1 3/4" x 11 7/8" 2.0E Microllam LVL	2	6
M3-2	16' 0"	1 3/4" x 11 7/8" 2.0E Microllam LVL	2	2
M4-2	10' 0"	1 3/4" x 11 7/8" 2.0E Microllam LVL	2	2
M5-2	8' 0"	1 3/4" x 11 7/8" 2.0E Microllam LVL	2	8
STCa1	16' 0"	1 1/8" x 11 7/8" TJ Rim Board	1	17

Blocking				
PlotID	Length	Product	Plies	Net Qty
F8k1	2' 0"	11 7/8" TJI 210 joist	1	148
F8k1	1' 0"	11 7/8" TJI 210 joist	1	34

Total Lengths	
Length	Product
2252' 0"	11 7/8" TJI 210 joist
284' 0"	1 3/4" x 11 7/8" 2.0E Microllam LVL
286' 0"	1 1/2" x 5 1/2" 1.3E StrandGuard TimberStrand LSL
272' 0"	1 1/8" x 11 7/8" TJ Rim Board
16' 8 3/4"	3/4" x 2 5/16" Web Stiffeners

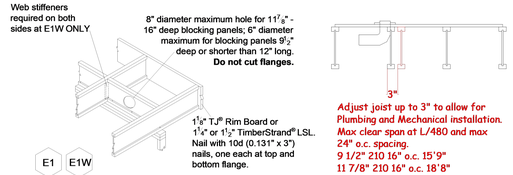

Adjust joist up to 3" to allow for Plumbing and Mechanical installation. Max clear span at L/480 and max 24" o.c. spacing.
9 1/2" 210 16" o.c. 15'9"
11 7/8" 210 16" o.c. 18'8"

WARNING

Joists are unstable until braced laterally

Bracing Includes:

- Blocking
- Hangers
- Sheathing
- Rim Board
- Strut Lines
- Rim Joist

DO NOT walk on joists until braced. INJURY MAY RESULT. ***DO NOT walk on joists that are lying flat.*** ***DO NOT stack building materials on unsheathed joists. Stack only over beams or walls.***

WARNING NOTES:

Lack of proper bracing during construction can result in serious accidents. Observe the following guidelines:

1. All blocking, hangers, rim boards and rim joists at the end supports of the TJI® joists must be completely installed and properly nailed.
2. Lateral strength, like braced end wall or an existing deck, must be established at the ends of the bay. This can also be accomplished by a temporary or permanent deck (sheathing) fastened to the first 4 feet of joists at the end of the bay.
3. Safety bracing of 1x4 (minimum) must be nailed to a braced end wall or sheathed area (as in note 2) and to each joist. Install bracing with 2 - 8d(.0113" x 2.5") nails each joist and end support at 8 ft on center (6 ft for TJI 110 joists). Without this bracing, buckling sideways or rollover is highly probable under light construction loads - such as a worker or one layer of unnailed sheathing.
4. Sheathing must be completely attached to each TJI® joist before additional loads can be placed on the system.
5. Ends of cantilevers require safety bracing on both the top and bottom flanges.
6. The flanges must remain straight within 1/2" from true alignment.
7. See www.wy.com/beisafe for additional installation information.

Weyerhaeuser, Microllam, Parallam, TimberStrand, TJI, TJ, and Trus Joist are registered trademarks of Weyerhaeuser NR. © 2022 Weyerhaeuser NR Company. All rights reserved.

NAILING AT BEARING (FLOOR)

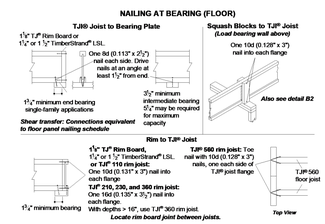

This layout is intended for product application assurance and is not intended to circumvent the need for a design professional as determined by the Building Codes. The designer of record and/ or builder/ framer is responsible to assure these drawings are compatible with the overall project.

Weyerhaeuser
ENGINEERED WOOD PRODUCTS
TrusJoist

Symbol Legend

- User Defined Point Load
- User Defined Line Load
- User Defined Area Load
- BBO Beam By Others
- PBO Post By Others
- Layout Start Location
- Construction Detail Callout (See Framer's Pocket Guide)
- FL 12K Excessive Point Load (WARNING: Member design did not include this load. Special consideration is required by the designer of record.)
- Required Bearing Length (Only placed at insufficient bearing locations.)

FOREST PRODUCTS SUPPLY CO

PREPARED BY
MATT LIPPERT
FOREST PRODUCTS SUPPLY
913-441-7000

2214 NW KILLARNEY
MEAD LUMBER
WR-186

STRUCTURAL DATE:
ARCHITECTURAL DATE: 9.5.2025

SCALE: NTS
PROJECT #: FPS 24-
9/12/2025
SHEET
1OF 2

RELEASE FOR CONSTRUCTION
AS NOTED ON PLANS REVIEW
DEVELOPMENT SERVICES
LEE'S SUMMIT, MISSOURI
10/02/2025 3:48:03

HANGER NAILING FOR UNIFORMLY LOADED BEAMS

Joist & Beam Hanger Face Nailing Requirements* for 3 & 4 Ply Supporting Members

For IUS or THF Hangers - Use 10d (0.148") x 3" nails.

For U, MIU, HU, HHUS, HGUS or HD, THD, THDH Hangers - Use 16d (0.162") x 3 ½" nails.

*For hangers that have joist fasteners/connections, fill all holes with the manufacturer's recommended fasteners.

MULTIPLE PLY CONNECTION NAILING FOR UNIFORMLY LOADED BEAMS

2&3 PLY BEAMS	NAILED CONNECTION
9½" - 11⅞" Depth	(3) Rows of 10d (0.128") x 3" Box Nails at 12" o.c.
14" - 24" Depth	(4) Rows of 10d (0.128") x 3" Box Nails at 12" o.c.
4 PLY BEAM	**NAILED CONNECTION**
9½" - 24" Depth	(4) Rows of 10d (0.128") x 3" Box Nails at 12" o.c.

- 16d (0.131") pneumatic nails may be substituted for 10d (0.128") Box nails.
- Stagger nails by 6" per ply
- All plies must be same material, grade, and 1¾" thickness.
-Joist Hanger's connecting into the side of the beam must be installed with minimum 3" long nails.

MULTIPLE PLY CONNECTION NAILING FOR POINT LOADS

Hanger shown for reference. Install screws from side opposite of hanger. Install ½ the required screws on each side of hanger

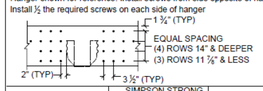

		SIMPSON STRONG-TIE® HANGERS				USP HANGERS		
	3 PLY SUPPORT BEAM	U	HU	HHUS	HGUS	HD	THD	THDH
Trusses	TOTAL # OF 3 ½" TRUSSLOK® SCREWS	4	6	8	14	6	12	16
	TOTAL # OF 3 ½" SIMPSON SDS SCREWS	4	4	6	12	6	10	12
	4 PLY SUPPORT BEAM	U	HU	HHUS	HGUS	HD	THD	THDH
Trusses	TOTAL # OF 6 ¾" TRUSSLOK® SCREWS	4	6	10	20	8	16	20
	TOTAL # OF 6" SIMPSON SDS SCREWS	6	8	12	24	10	20	26

- Connections based on FastenMaster TrussLok® and Simpson Strong-Tie® code reports.
- All plies assumed to be the same material, grade, and 1 ¾" in thickness
- Connections based on given hangers maximum capacity at 100% Load Duration Factor. Adequate for 115% and 125% Load Duration Factor as well.
- Connection assumes the use of 16d nails and max nailing in hangers.
-See TB-300 for alternate connector types and loading.

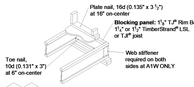

A1 A1W Attach blocking per Rim Board Details and Installation in *Weyerhaeuser Installation Guide for Floor and Roof Framing, TJ-9001.*

When sheathing thickness exceeds 7/8", trim sheathing tongue at rim board

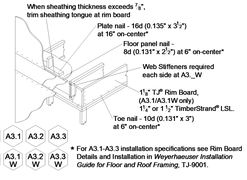

A3 A3.1 A3.2 A3.3

A3W A3.1 W A3.2 W A3.3 W

* For A3.1-A3.3 installation specifications see Rim Board Details and Installation in *Weyerhaeuser Installation Guide for Floor and Roof Framing*, TJ-9001.

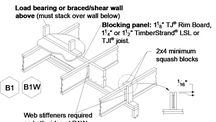

B1 B1W

B2 B2W Blocking panels may be required with braced/shear walls above or below — see detail B1

No load bearing wall above

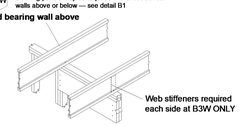

B3 B3W Blocking panels may be required with braced/shear walls above or below — see detail B1

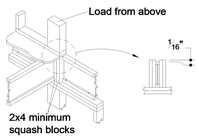

CS ***Use 2x4 minimum squash blocks to transfer load around TJI® joist***

SCAN WITH YOUR SMARTPHONE
INSTALLATION GUIDE FOR FLOOR AND ROOF FRAMING
wy.com/woodproducts/document-library/tj-9001

SCAN WITH YOUR SMARTPHONE
DAMAGE REPORTING MOBILE TOOL
damagereport.woodbywy.com

Web stiffeners required on both sides at E1W ONLY

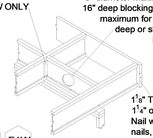

E1 E1W

8" diameter maximum hole for 11⅞" - 16" deep blocking panels; 6" diameter maximum for blocking panels 9½" deep or shorter than 12" long. **Do not cut flanges.**

1⅛" TJI® Rim Board or 1¼" or 1½" TimberStrand® LSL. Nail with 10d (0.131" x 3") nails, one each at top and bottom flange.

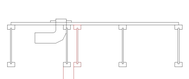

Adjust joist up to 3" to allow for Plumbing and Mechanical installation.
Max clear span at L/480 and max 24" o.c. spacing.
9 1/2" 210 16" o.c. 15'9"
11 7/8" 210 16" o.c. 18'8"

Actual materials and quantities may vary due to jobsite conditions, design changes and installation variations. It is the responsibility of the Builder for this Layout to be reviewed and Approved by an appropriate Design Professional as required by the permitting authority.

ALL ROOF LOADS ASSUMED TO BE SUPPORTED AT EXTERIOR WALLS AND BEAMS BY OTHERS, IF APPLICABLE, UNLESS OTHERWISE NOTED. NO ROOF LOADS APPLIED TO FLOOR MEMBERS.

THIS MEMBER NEEDS TO BE (4) 1-3/4" X 9-1/4" LVL

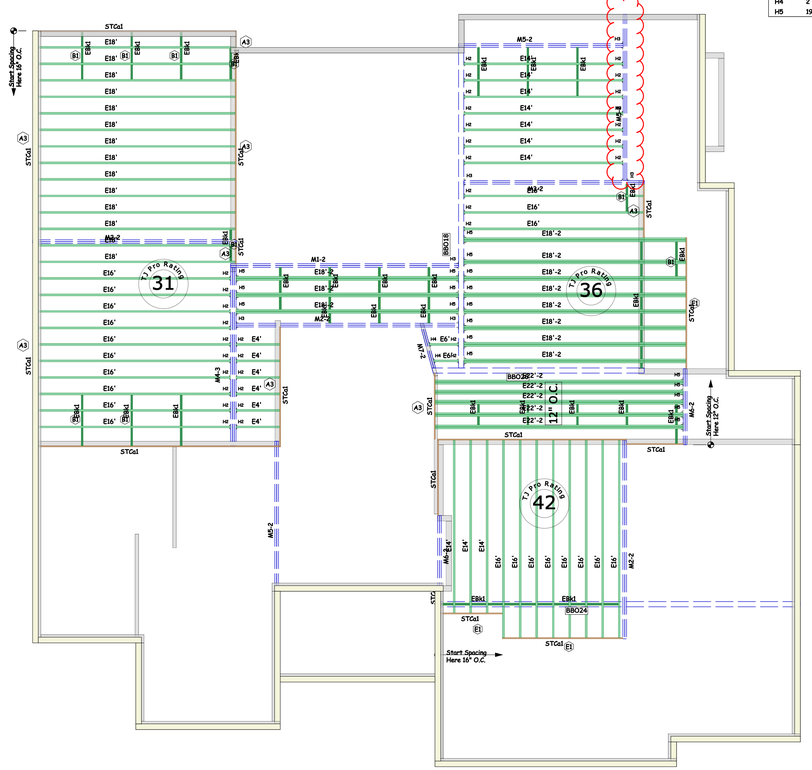

Framing Connector Summary												
PlotID	Qty	Manuf	Product	Design Method	Face Nails	Top Nails	Member Nails	Skew	Slope	Backer Blks	Filler	Web Stiff
H2	35	Simpson	LTS2.06/9.5	Geometry Only	2- 10dx1.5	4- 10dx1.5	2- Strong-Grip	-	-	No	No	No
H3	6	Simpson	MIT49.5	Geometry Only	4- 10dx1.5	4- 10dx1.5	2- 10dx1.5	-	-	No	No	No
H4	2	Simpson	LSS82.1Z	Geometry Only	13- 10dx2.5	-	9- 10dx1.5	15 (L)	-	No	No	Yes
H5	19	Simpson	MIT4.28/9.5	Geometry Only	4- 10dx1.5	4- 10dx1.5	2- 10dx1.5	-	-	No	No	No

LEVEL NOTES	
Current Date:	9/22/2025
File Name:	fpm25-922-2.jvl
Level Name:	1st Floor
Building Code:	IBC/IRC 2018
Members with Design Overridden:	M4-3, E22'-2
TJ-Pro Rating (Weighted Average):	42
Minimum Level TJ - Pro Rating & Joist:	TJ-Pro rating = 42, joist = E14' (I3062)
Maximum Level TJ - Pro Rating & Joist:	TJ-Pro rating = 42, joist = E14' (I3062)
FLOOR	
Floor Container:	FC2, FC3
Use/Occupancy:	ResidentialLivingAreas
Floor Area Loading is:	40.0 lb/ft² Live Load & 12.0 lb/ft² Dead Load
Maximum Allowed Deflection:	L/480 Live Load & L/240 Total Load
TJ-Pro Rating Information:	
Weighted Average:	FC2: 42
Directly Applied Ceiling:	None
Decking Attachment:	Glue and Nail
Decking Material:	23/32"x48"x96" Weyerhaeuser Edge Panel (0/24) T&G FF
Perpendicular Partition:	No
Strapping at max 8' o.c.:	None
Blocking at max 8' o.c.:	No
Poured Flooring:	No

Products				
PlotID	Length	Product	Plies	Net Qty
E22'-2	22' 0"	9 1/2" TJI 210 joist	2	10
E18'-2	18' 0"	9 1/2" TJI 210 joist	2	22
E18'	18' 0"	9 1/2" TJI 210 joist	1	14
E16'	16' 0"	9 1/2" TJI 210 joist	1	21
E14'	14' 0"	9 1/2" TJI 210 joist	1	10
E6'	6' 0"	9 1/2" TJI 210 joist	1	2
E4'	4' 0"	9 1/2" TJI 210 joist	1	6
M1-2	20' 0"	1 3/4" x 9 1/2" 2.0E Microllam LVL	2	2
M2-2	18' 0"	1 3/4" x 9 1/2" 2.0E Microllam LVL	2	6
M4-3	16' 0"	1 3/4" x 9 1/2" 2.0E Microllam LVL	3	3
M3-2	16' 0"	1 3/4" x 9 1/2" 2.0E Microllam LVL	2	2
M5-2	14' 0"	1 3/4" x 9 1/2" 2.0E Microllam LVL	2	6
M6-2	8' 0"	1 3/4" x 9 1/2" 2.0E Microllam LVL	2	4
M7-2	6' 0"	1 3/4" x 9 1/2" 2.0E Microllam LVL	2	2
STGd1	16' 0"	1 1/8" x 9 1/2" TJ Rim Board	1	11

Accessories				
PlotID	Length	Product	Plies	Net Qty
	6 3/4"	3/4" x 2 5/16" Web Stiffeners	1	4
		23/32"x48"x96" Weyerhaeuser Edge Panel (0/24) T&G FF	1	46

Blocking				
PlotID	Length	Product	Plies	Net Qty
E8k1	2' 0"	9 1/2" TJI 210 joist	1	45
E8k1	1' 0"	9 1/2" TJI 210 joist	1	35

Total Lengths	
Length	Product
1505' 0"	9 1/2" TJI 210 joist
356' 0"	1 3/4" x 9 1/2" 2.0E Microllam LVL
176' 0"	1 1/8" x 9 1/2" TJ Rim Board
2' 3"	3/4" x 2 5/16" Web Stiffeners

EVERSTEAD
SHOP DRAWINGS/SUBMITTAL REVIEW

SUBMITTAL WAS REVIEWED FOR DESIGN CONFORMITY AND GENERAL CONFORMANCE TO CONTRACT DOCUMENTS ONLY. THE CONTRACTOR IS RESPONSIBLE FOR CONFIRMING AND CORRELATING DIMENSIONS AT JOBSITE FOR TOLERANCE, CLEARANCE, QUANTITIES, FABRICATION, COORDINATION OF HIS OR HER WORK WITH OTHER TRADES, AND FULL COMPLIANCE WITH CONTRACT DOCUMENTS.

STATUS:
APPROVED AS NOTED
09/30/2025
REVIEWED BY:
JTC
ENGINEER, EVERSTEAD ENGINEERING & DESIGN LLC

Andrea Sessler
Digitally signed by Andrea Sessler
DN: CN=Andrea Sessler, OU=Development, OU=LS Users, DC=COLS, DC=LOC
Date: 2025.10.02 15:49:01-05'00'

RELEASE FOR CONSTRUCTION
AS NOTED ON PLANS REVIEW
DEVELOPMENT SERVICES
LEE'S SUMMIT, MISSOURI
10/02/2025 3:48:03

WARNING

Joists are unstable until braced laterally

Bracing Includes:

- Blocking
- Hangers
- Sheathing
- Rim Board
- Strut Lines
- Rim Joist

DO NOT walk on joists until braced. INJURY MAY RESULT.

DO NOT walk on joists that are lying flat.

DO NOT stack building materials on unsheathed joists. Stack only over beams or walls.

WARNING NOTES:

Lack of proper bracing during construction can result in serious accidents. Observe the following guidelines:

1. All blocking, hangers, rim boards and rim joists at the end supports of the TJI® joists must be completely installed and properly nailed.
2. Lateral strength, like braced end wall or an existing deck, must be established at the ends of the bay. This can also be accomplished by a temporary or permanent deck (sheathing) fastened to the first 4 feet of joists at the end of the bay.
3. Safely bracing of 1x4 (minimum) must be nailed to a braced end wall or sheathed area (as in note 2) and to each joist. Install bracing with 2 - 8d (0.113" x 2.5") nails each joist and end support at 8 ft on center (6 ft for TJI 110 joists). Without this bracing, buckling sideways or rollover is highly probable under light construction loads - such as a worker or one layer of unnailed sheathing.
4. Sheathing must be completely attached to each TJI® joist before additional loads can be placed on the system.
5. Ends of cantilevers require safety bracing on both the top and bottom flanges.
6. The flanges must remain straight within 1/2" from true alignment.
7. See www.wy.com/besafe for additional installation information.

Weyerhaeuser, Microllam, Parallam, TimberStrand, TJI, TJ, and Trus Joist are registered trademarks of Weyerhaeuser NR. © 2022 Weyerhaeuser NR Company. All rights reserved.

BUILT WITH Trus Joist ENGINEERED WOOD PRODUCTS THE BEST

NAILING AT BEARING (FLOOR)

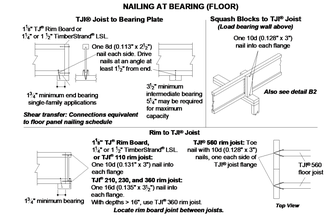

This layout is intended for product application assurance and is not intended to circumvent the need for a design professional as determined by the Building Codes. The designer of record and/ or builder/ framer is responsible to assure these drawings are compatible with the overall project.

TrusJoist ENGINEERED WOOD PRODUCTS
Weyerhaeuser

Symbol Legend

- User Defined Point Load
- User Defined Line Load
- User Defined Area Load
- BBO Beam By Others
- PBO Post By Others
- Layout Start Location
- Construction Detail Callout (See Framer's Pocket Guide)
- Excessive Point Load (WARNING: Member design did not include this load. Special consideration is required by the designer of record.)
- Required Bearing Length (Only placed at insufficient bearing locations.)

FOREST PRODUCTS SUPPLY CO

PREPARED BY
MATT LIPPERT
FOREST PRODUCTS SUPPLY
913-441-7000

STRUCTURAL DATE:

ARCHITECTURAL DATE:

2214 NW KILLARNEY

MEAD LUMBER

WR-186

SCALE
1/4"=1'-0"

PROJECT # :
FPM25-922

9/22/2025

SHEET
2OF 2