PRRES20160568

ResuB

This approval is issued in reliance upon information submitted by the applicant. This permit issued pursuant to this approval may be suspended or revoked whenever the permit is issued in error, or on the basis of incorrect information supplied, or in violation of any ordinance or regulation. Approved plans shall not be changed, modified or altered without authorization. The issuance or granting of a permit or approval of plans shall not be construed to be a permit for, or an approval of, any violation of any of the provisions of the ordinance of the City of Lee's Summit, Missouri.

APPROVED Christina Stanton DATE 3/28/16

PRINT NAME EMPTY

ASBUILT PLOT PLAN IS REQUIRED

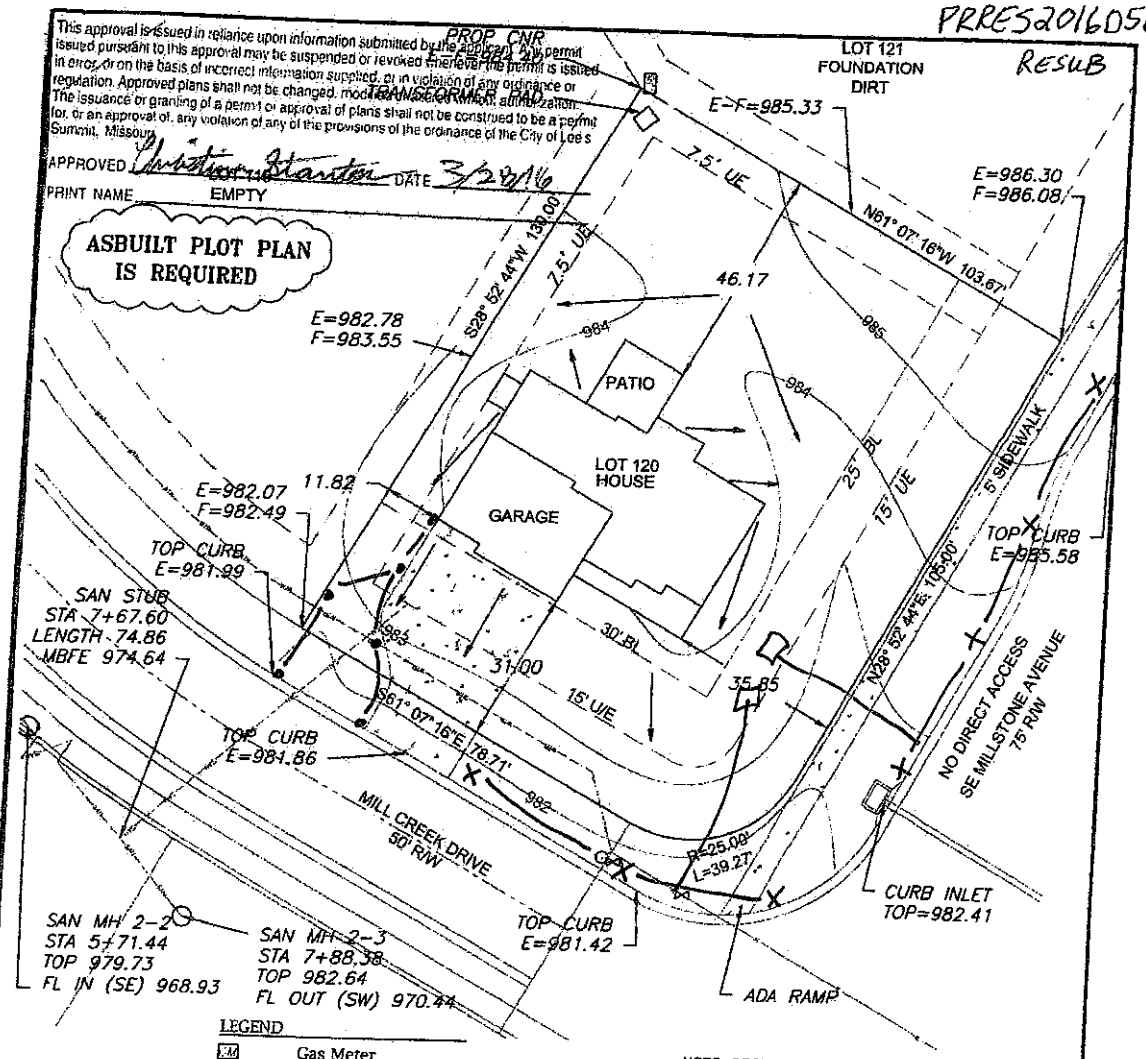

LEGEND

- Gas Meter
- Telephone or Fiber-Optic Pedestal
- Cable TV Pedestal
- Electric Pedestal
- Light Pole
- Mailbox
- Fire Hydrant
- Water Valve

NOTE : DECK APPROVAL WILL BE REQUIRED PRIOR TO (FUTURE) DECK CONSTRUCTION

DRIVEWAY SLOPE = 4.5 %

EXTENDED LOT AREA = 16,872.77 SQ. FT.

SIDEWALK AREA = 674.41 SQ. FT.

Scale 1"=30'

PROPOSED HOUSE

TOP FOUNDATION =985.75
GARAGE FLOOR =983.75
TOP FOOTING =976.75
BASEMENT FLOOR =977.08

E = EXISTING ELEVATION
F = PROPOSED FINAL ELEVATION
G = ADJACENT GRADE AT EGRESS

U.E. = UTILITY EASEMENT
B.L. = BUILDING LINE

LOT INFORMATION

13,343.20 SQ. FT.
MBFE = 974.64
ADDRESS
425 SE MILL CREEK DR.

LEGAL DESCRIPTION

LOT 120, MILL CREEK OF SUMMIT MILL 3RD PLAT, A SUBDIVISION AS RECORDED IN LEE'S SUMMIT, JACKSON COUNTY, MISSOURI.

NOTES

1. BUILDER TO VERIFY ALL BUILDING ELEVATIONS AND DIMENSIONS.

2. THIS PLOT PLAN DOES NOT CONSTITUTE A BOUNDARY SURVEY.

3. THE EASEMENTS SHOWN ON THIS PLOT PLAN ARE TAKEN FROM THE FINAL PLAT. OTHER EASEMENTS MAY EXIST.

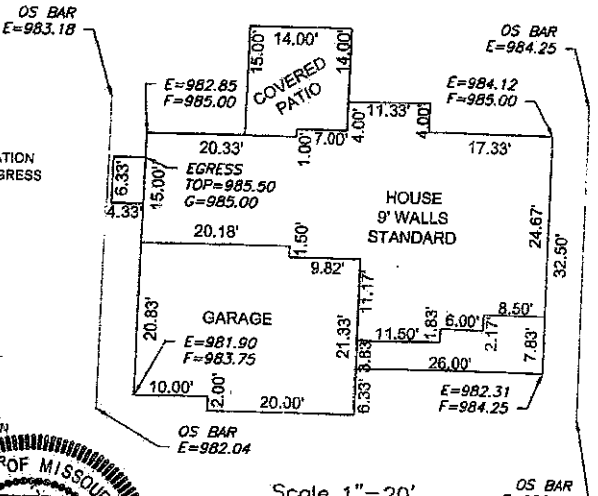

Scale 1"=20'

ENGINEERING SOLUTIONS
ENGINEERING & SURVEYING
50 SE 30TH STREET
LEE'S SUMMIT, MO 64082
P:(816) 623-9888 F:(816)623-9849
WWW.ENGINEERINGSOLUTIONSKC.COM

THIS DRAWING IS NOT VALID UNLESS THE SIGNATURE, DATE AND SEAL OF THE ENGINEER WHO SUPERVISED THE PREPARATION OF THIS DRAWING HAS BEEN AFFIXED HEREIN.

STATE OF MISSOURI
MATTHEW J. SCHECHT
NUMBER
PE2006018708
PROFESSIONAL ENGINEER

PLOT PLAN - LOT 120

MILL CREEK OF SUMMIT MILL 3RD PLAT
LEE'S SUMMIT, JACKSON COUNTY, MISSOURI

SUMMIT CUSTOM HOMES
120 SE 30TH STREET
LEE'S SUMMIT, MISSOURI, 64082

PROJECT NO.	FILE NAME	DATE	SHEET	OF
1	LOT 108,109 & 120, MILL CREEK	02/15/16	1	1

Rev: