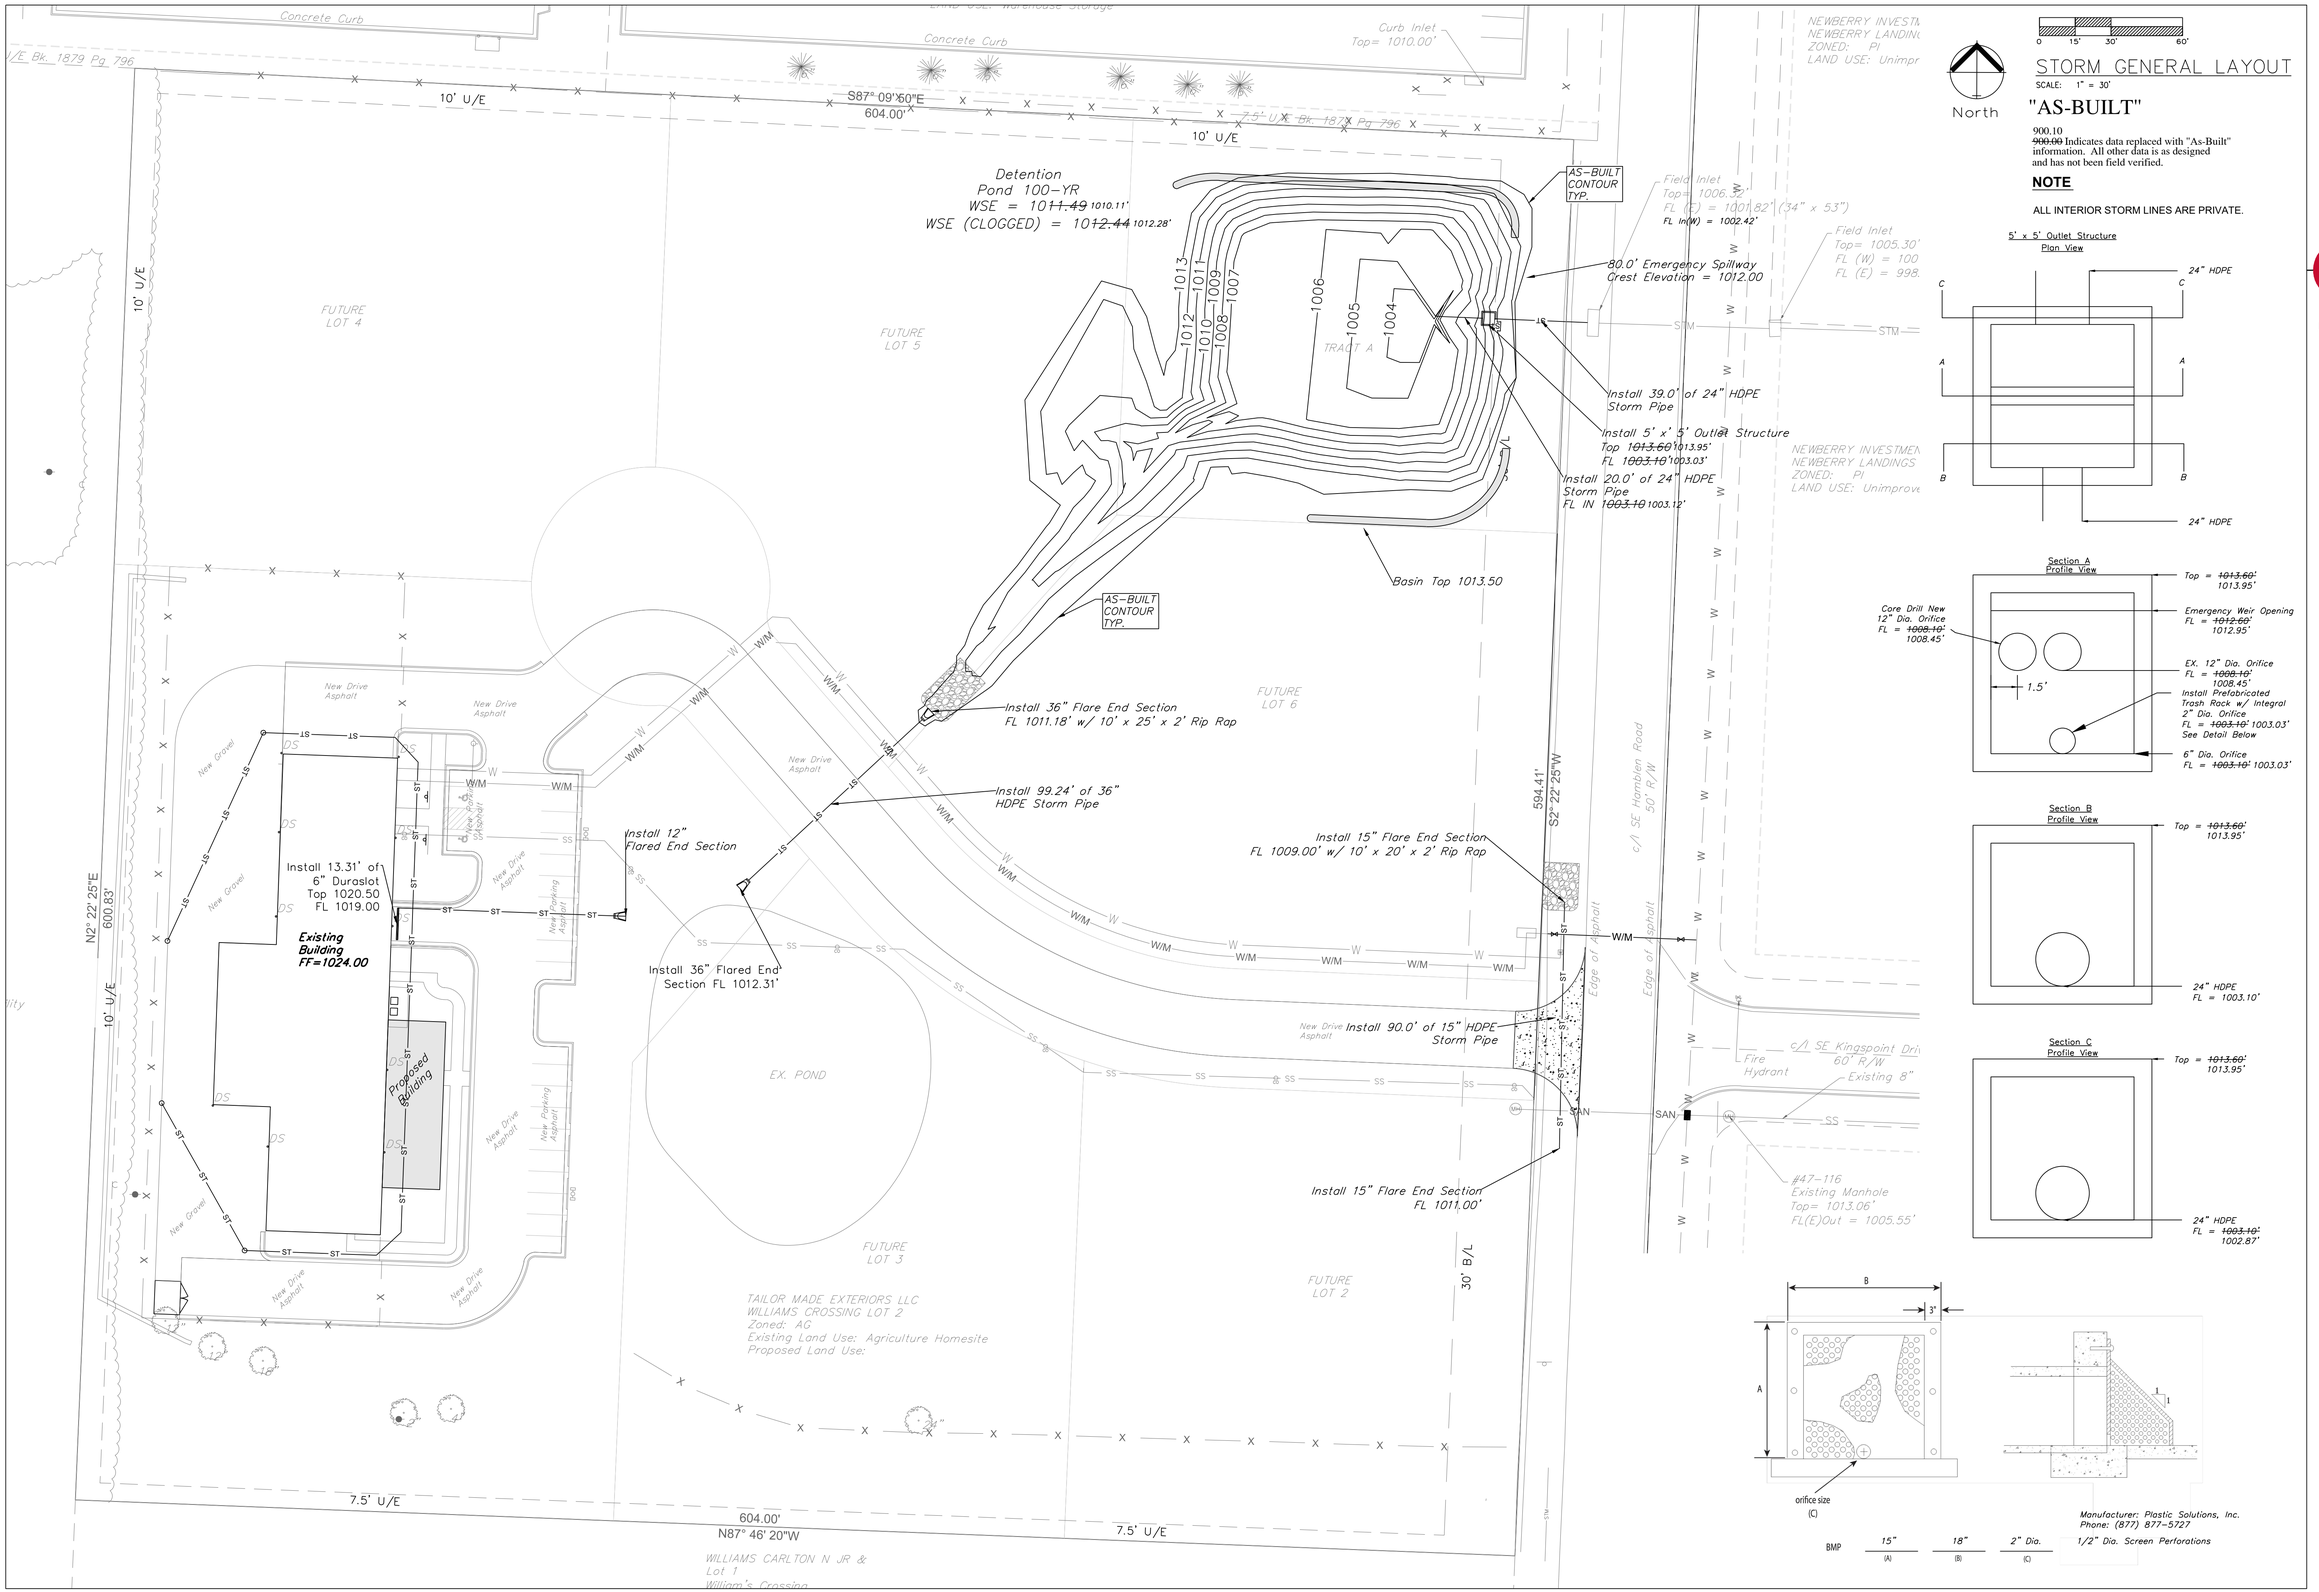

North

0 15' 30' 60'

STORM GENERAL LAYOUT

SCALE: 1" = 30'

"AS-BUILT"

900.10
~~900.00~~ Indicates data replaced with "As-Built" information. All other data is as designed and has not been field verified.

NOTE

ALL INTERIOR STORM LINES ARE PRIVATE.

5' x 5' Outlet Structure
Plan View

Section A
Profile View

Section B
Profile View

Section C
Profile View

BMP	15" (A)	18" (B)	2" Dia. (C)	1/2" Dia. Screen Perforations

Manufacturer: Plastic Solutions, Inc.
Phone: (877) 877-5727

ENGINEERING SOLUTIONS
ENGINEERING & SURVEYING
50 SE 30TH STREET
LEE'S SUMMIT, MO 64082
P:(816) 623-9888 F:(816)623-9849

Professional Registration
Missouri
Engineering 2005002186-D
Surveying 2005008319-D
Kansas
Engineering E-1695
Surveying LS-218
Oklahoma
Engineering 6254
Nebraska
Engineering CA2821

1600 Hamblen Road
Lee's Summit, Jackson County, Missouri

Project
1600 SE HAMBLEN RD LEES SUMMIT, MO
Issue Date:
August 4, 2017

UTILITY PLAN
Tailormade Landing
1600 Hamblen Road
Lee's Summit, Jackson County, Missouri

STATE OF MISSOURI
MATTHEW J. SCHLICHT
NUMBER
PE2006019708
PROFESSIONAL ENGINEER

Matthew J. Schlicht
MO PE 2006019708
KS PE 19071
OK PE 25226
NE PE E-14335

REVISIONS
5-24-19

C.300