NOTE : DECK APPROVAL WILL BE REQUIRED PRIOR TO (FUTURE) DECK CONSTRUCTION

X=###.## = Actual asbuilt ground shots taken on November 3, 2020

Contours shown are asbuilt.

PROPOSED CONTOURS

AS-GRADED CONTOURS

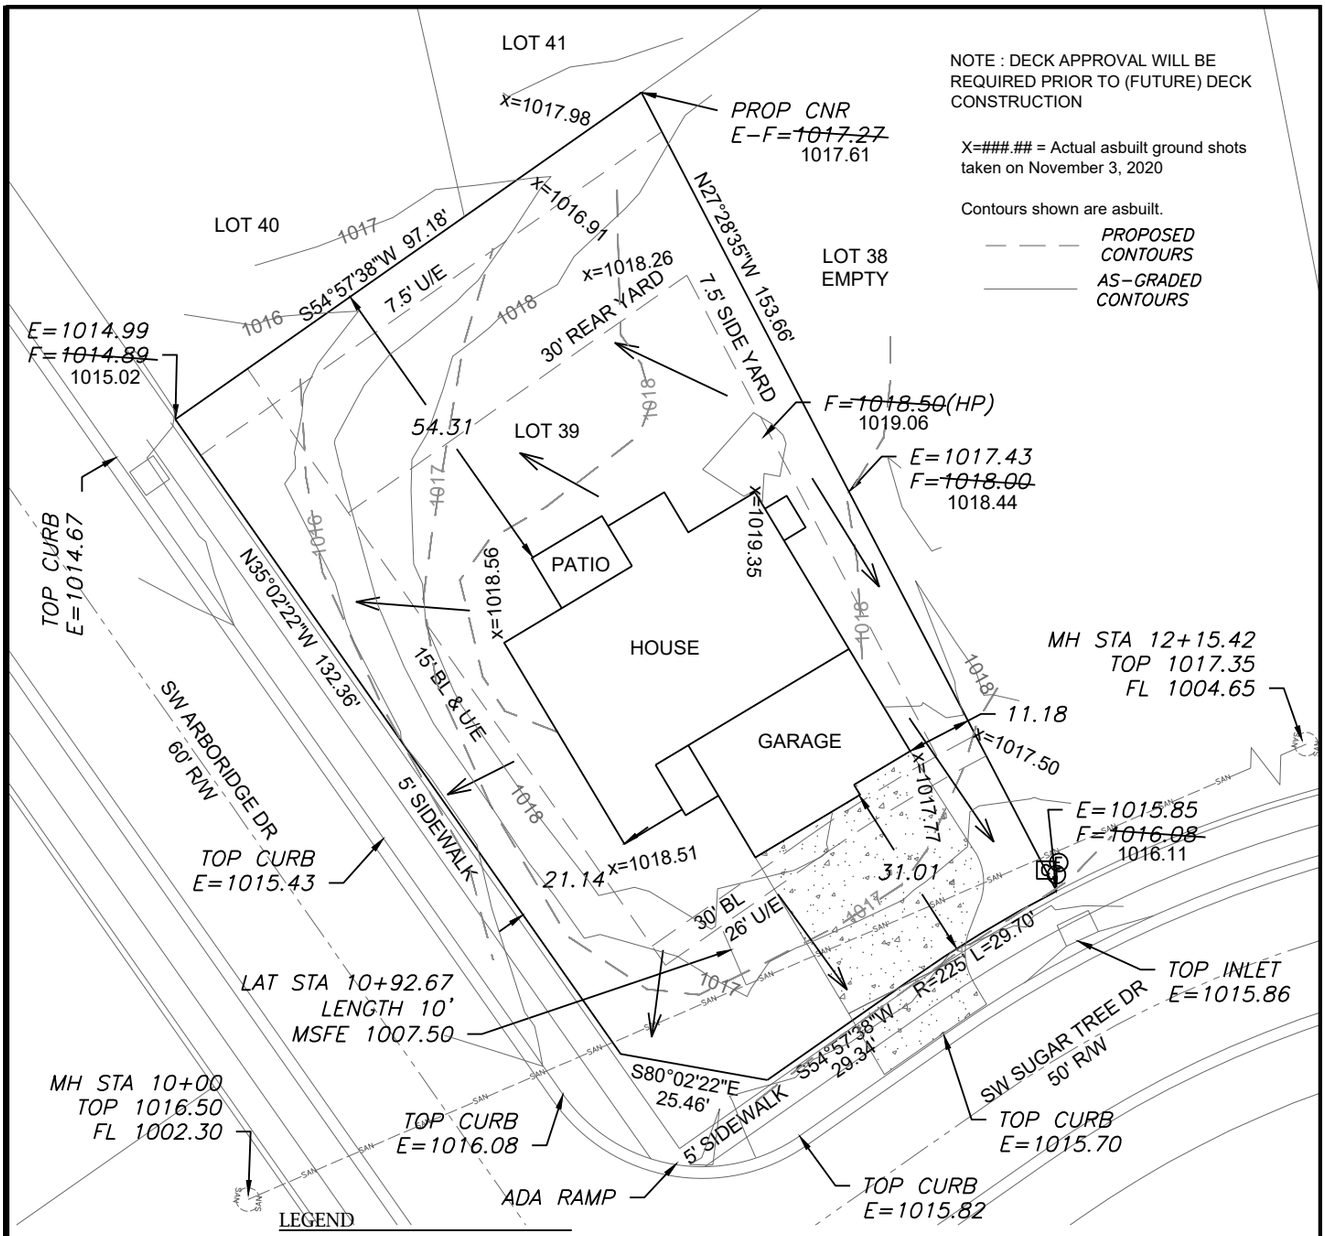

LEGEND

- Gas Meter
- Telephone or Fiber-Optic Pedestal
- Cable TV Pedestal
- Electric Pedestal
- Light Pole
- Mailbox
- Fire Hydrant
- Water Valve

EXTENDED LOT AREA = 15,726 SF
DRIVE AREA = 1,014 SF
APPROACH AREA = 234 SF
SIDEWALK AREA = 1,027 SF
DRIVEWAY SLOPE = 5.9%

N

Scale 1"=30'

PROPOSED HOUSE

TOP FOUNDATION = 1019.75
GARAGE FLOOR = 1017.75
TOP FOOTING = 1010.75
BASEMENT FLOOR = 1011.08

E = EXISTING ELEVATION
F = PROPOSED FINAL ELEVATION
G = ADJACENT GRADE AT EGRESS
U/E = UTILITY EASEMENT
B/L = BUILDING LINE
S/Y/S = SIDE YARD SETBACK
R/Y/S = REAR YARD SETBACK

NOTES

1. BUILDER TO VERIFY ALL BUILDING ELEVATIONS AND DIMENSIONS.

2. THIS PLOT PLAN DOES NOT CONSTITUTE A BOUNDARY SURVEY.

3. THE EASEMENTS SHOWN ON THIS PLOT PLAN ARE TAKEN FROM THE FINAL PLAT. OTHER EASEMENTS MAY EXIST.

LOT INFORMATION

12,969 SQ. FT.
RMBOE (LEFT) = 1018.85
FMBOE (LEFT) = 1017.08
RMBOE (RIGHT) = 1018.85
FMBOE (RIGHT) = 1017.08
MBFE = 1010.37
ADDRESS
1528 SW SUGAR TREE DRIVE

LEGAL DESCRIPTION

LOT 39, HAWTHORN RIDGE 1ST PLAT, A SUBDIVISION AS RECORDED IN LEE'S SUMMIT, JACKSON COUNTY, MISSOURI.

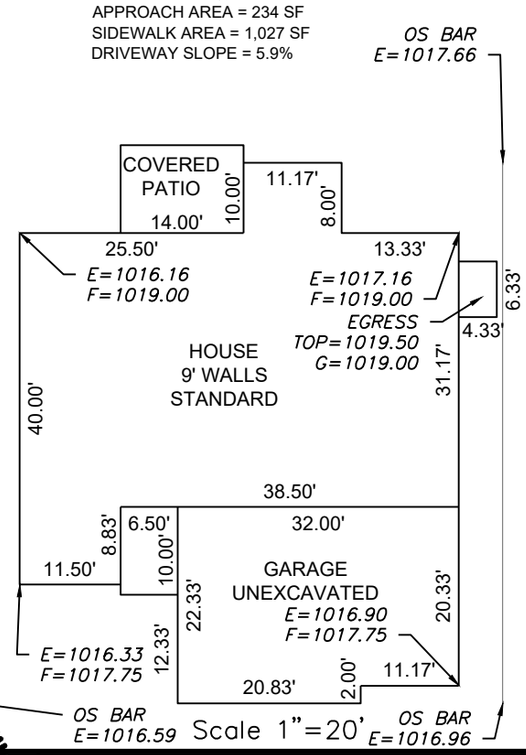

ENGINEERING SOLUTIONS
ENGINEERING & SURVEYING
50 SE 30TH STREET
LEE'S SUMMIT, MO 64082
P:(816) 623-9888 F:(816)623-9849
WWW.ENGINEERINGSOLUTIONKC.COM

THIS DRAWING IS NOT VALID UNLESS THE SIGNATURE, DATE AND SEAL OF THE ENGINEER WHO SUPERVISED THE PREPARATION OF THIS DRAWING HAS BEEN AFFIXED HERETO.

STATE OF MISSOURI
MATTHEW J. SCHLICHT
NUMBER
PE-2006019708
PROFESSIONAL ENGINEER
REVIEWED
12/2/2020

AS-GRADED PLOT PLAN - LOT 39

HAWTHORN RIDGE 1ST PLAT
LEE'S SUMMIT, JACKSON COUNTY, MISSOURI

SUMMIT HOMES
120 SE 30TH STREET
LEE'S SUMMIT, MO 64082

PROJECT NO.	FILE NAME	DATE	SHEET	OF
1	LOT 39, HAWTHORN RIDGE	3/23/2020	1	1

Rev: