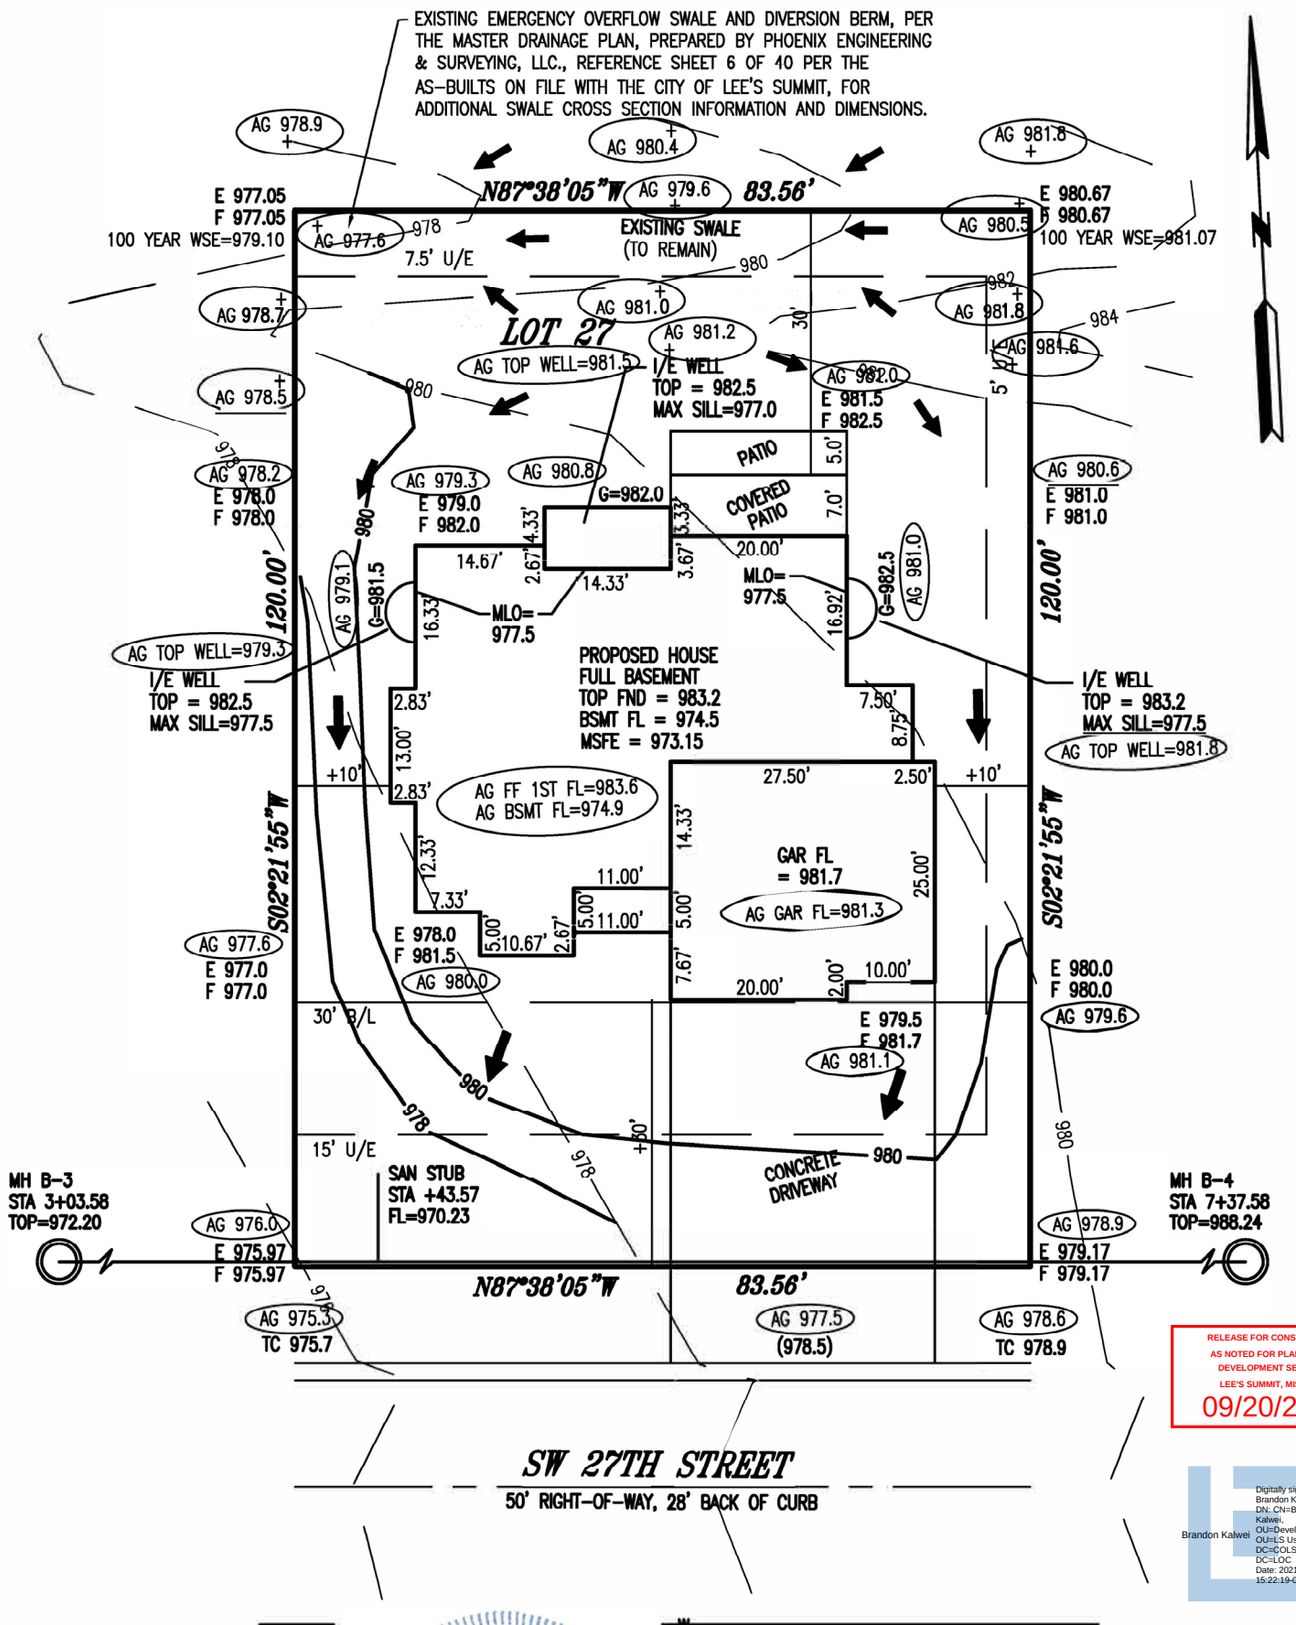

RELEASE FOR CONSTRUCTION
AS NOTED FOR PLAN REVIEW
DEVELOPMENT SERVICES
LEE'S SUMMIT, MISSOURI
09/20/2021

Brandon Kalwei
Digitally signed by Brandon Kalwei
DN: CN=Brandon Kalwei, OU=Development, OU=LS Users, DC=COLS, DC=LOC
Date: 2021.09.20 15:22:19-05'00'

STATE OF MISSOURI
BRANTON LADWIG
NUMBER LS-2004016633
PROFESSIONAL LAND SURVEYOR

KEY:
U/E = UTILITY EASEMENT
TC = TOP OF CURB
B/L = BUILDING LINE
E = EXISITNG GRADE
F = FINISH GRADE
G = LOWEST ADJACENT GRADE

AS-GRADED PLOT PLAN

AG = AS GRADED ELEVATION

AS-GRADED PLOT PLAN PER FIELD SHOTS TAKEN 9/11/20
UPDATED SHOTS TAKEN 9/20/21

NOTES:
ALL GRADES TAKEN FROM SUBDIVISION GRADING PLANS

ADDRESS: 1708 SW 27TH STREET

NOTES: SEPT. 20, 2021

1. LEGAL DESCRIPTION OF PROPERTY PROVIDED BY CONTRACTOR. THIS PLOT PLAN DOES NOT CONSTITUTE OR REPRESENT A BOUNDARY SURVEY. THE CONTRACTOR AND/OR OWNER SHALL BE RESPONSIBLE FOR VERIFICATION OF PROPERTY BOUNDARY, PROPERTY CORNERS, DEED DESCRIPTIONS AND LOCATIONS OF PROPOSED HOUSE WITH RESPECT TO PROPERTY LINES.
2. EASEMENTS, BUILDING LINES AND SET-BACKS TAKEN FROM RECORDED PLAT ONLY.
3. CONTRACTOR TO VERIFY LOCATION AND DEPTH OF SANITARY SEWER SERVICE PRIOR TO CONSTRUCTION.
4. CONTRACTOR TO VERIFY ALL DIMENSIONS, ELEVATIONS AND LOCATIONS PRIOR TO CONSTRUCTION
5. CONTRACTOR TO VERIFY CONDITION OF ALL FILL PRIOR TO CONSTRUCTION.
6. GRADES ARE PROPOSED GRADES ONLY. FINAL GRADING AND ELEVATIONS SHALL BE CONTRACTORS RESPONSIBILITY.

JFE CONSTRUCTION

PLOT PLAN

LOT 27
WHISPERING WOODS - 1ST PLAT
LEE'S SUMMIT MISSOURI

LADWIG and ASSOCIATES, L.L.C.
LAND SURVEYORS
816-309-6621

DRAWN BY:	SCALE:
JDH	1" = 20'
DATE: 2/9/20	DRAWING NO. WW-27