AS-GRADED PLOT PLAN

ORDERED BY: ROB WASHAM HOMES
DESCRIPTION: LOT 23 WHISPERING WOODS FIRST PLAT, LEES SUMMIT, MO.

1713 SW 26th Terrace

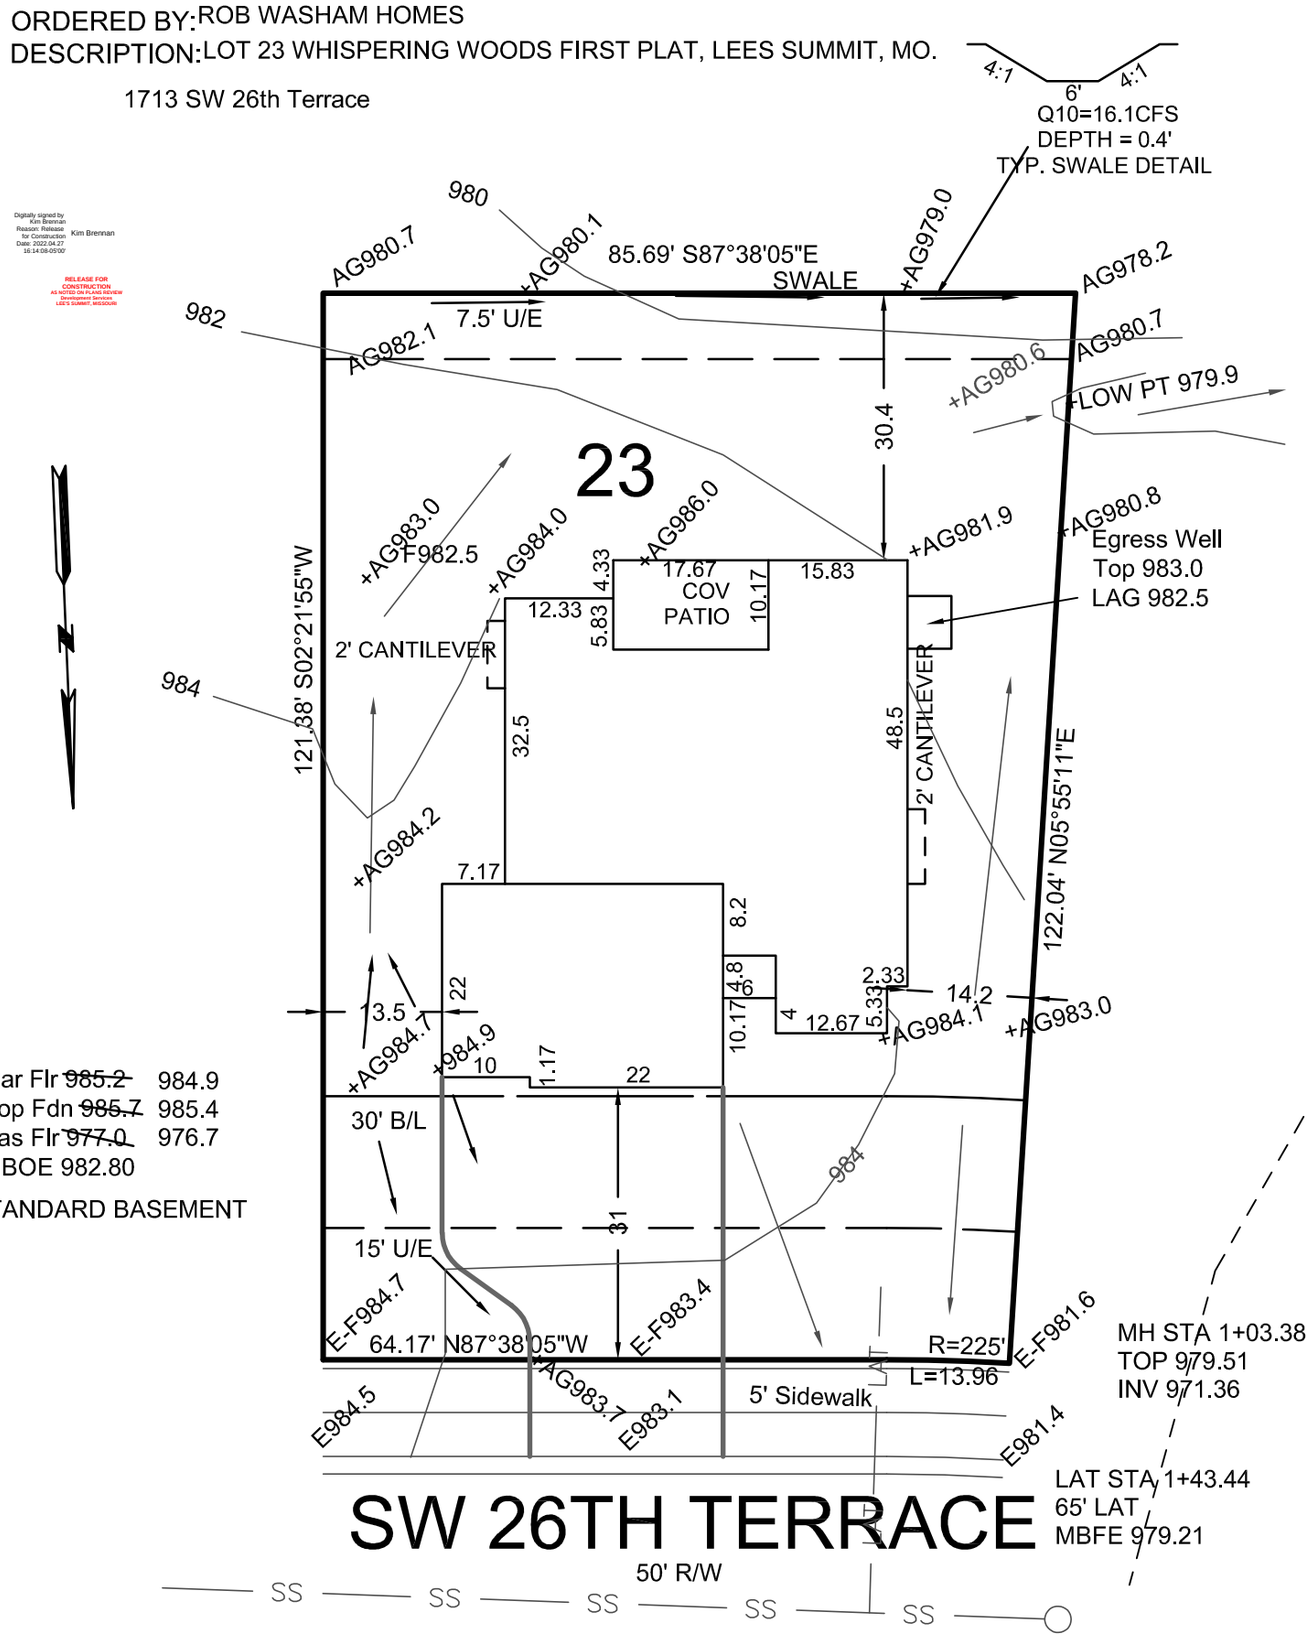

Gar Flr ~~985.2~~ 984.9
Top Fdn ~~985.7~~ 985.4
Bas Flr ~~977.0~~ 976.7
MBOE 982.80

STANDARD BASEMENT

MH STA 1+03.38
TOP 979.51
INV 971.36

LAT STA 1+43.44
65' LAT
MBFE 979.21

AG= AS GRADED ON 04-26-2022

= DRAINAGE PATTERN

STATE OF MISSOURI
LEE N. BODENHEIMER
NUMBER LS-2114
REGISTERED LAND SURVEYOR
02-08-2021

CONSTRUCTION ENGINEERING SERVICES, INC.
16810-C East 40 Highway
Independence, MO 64055
(816)478-2323
lee@engineeringkc.com

SCALE: 1"=20'
DATE: 12/21/2020 & 04-25-2022
JOB NO: 17488 18324

LEE BODENHEIMER, L.S.
Land Surveyor