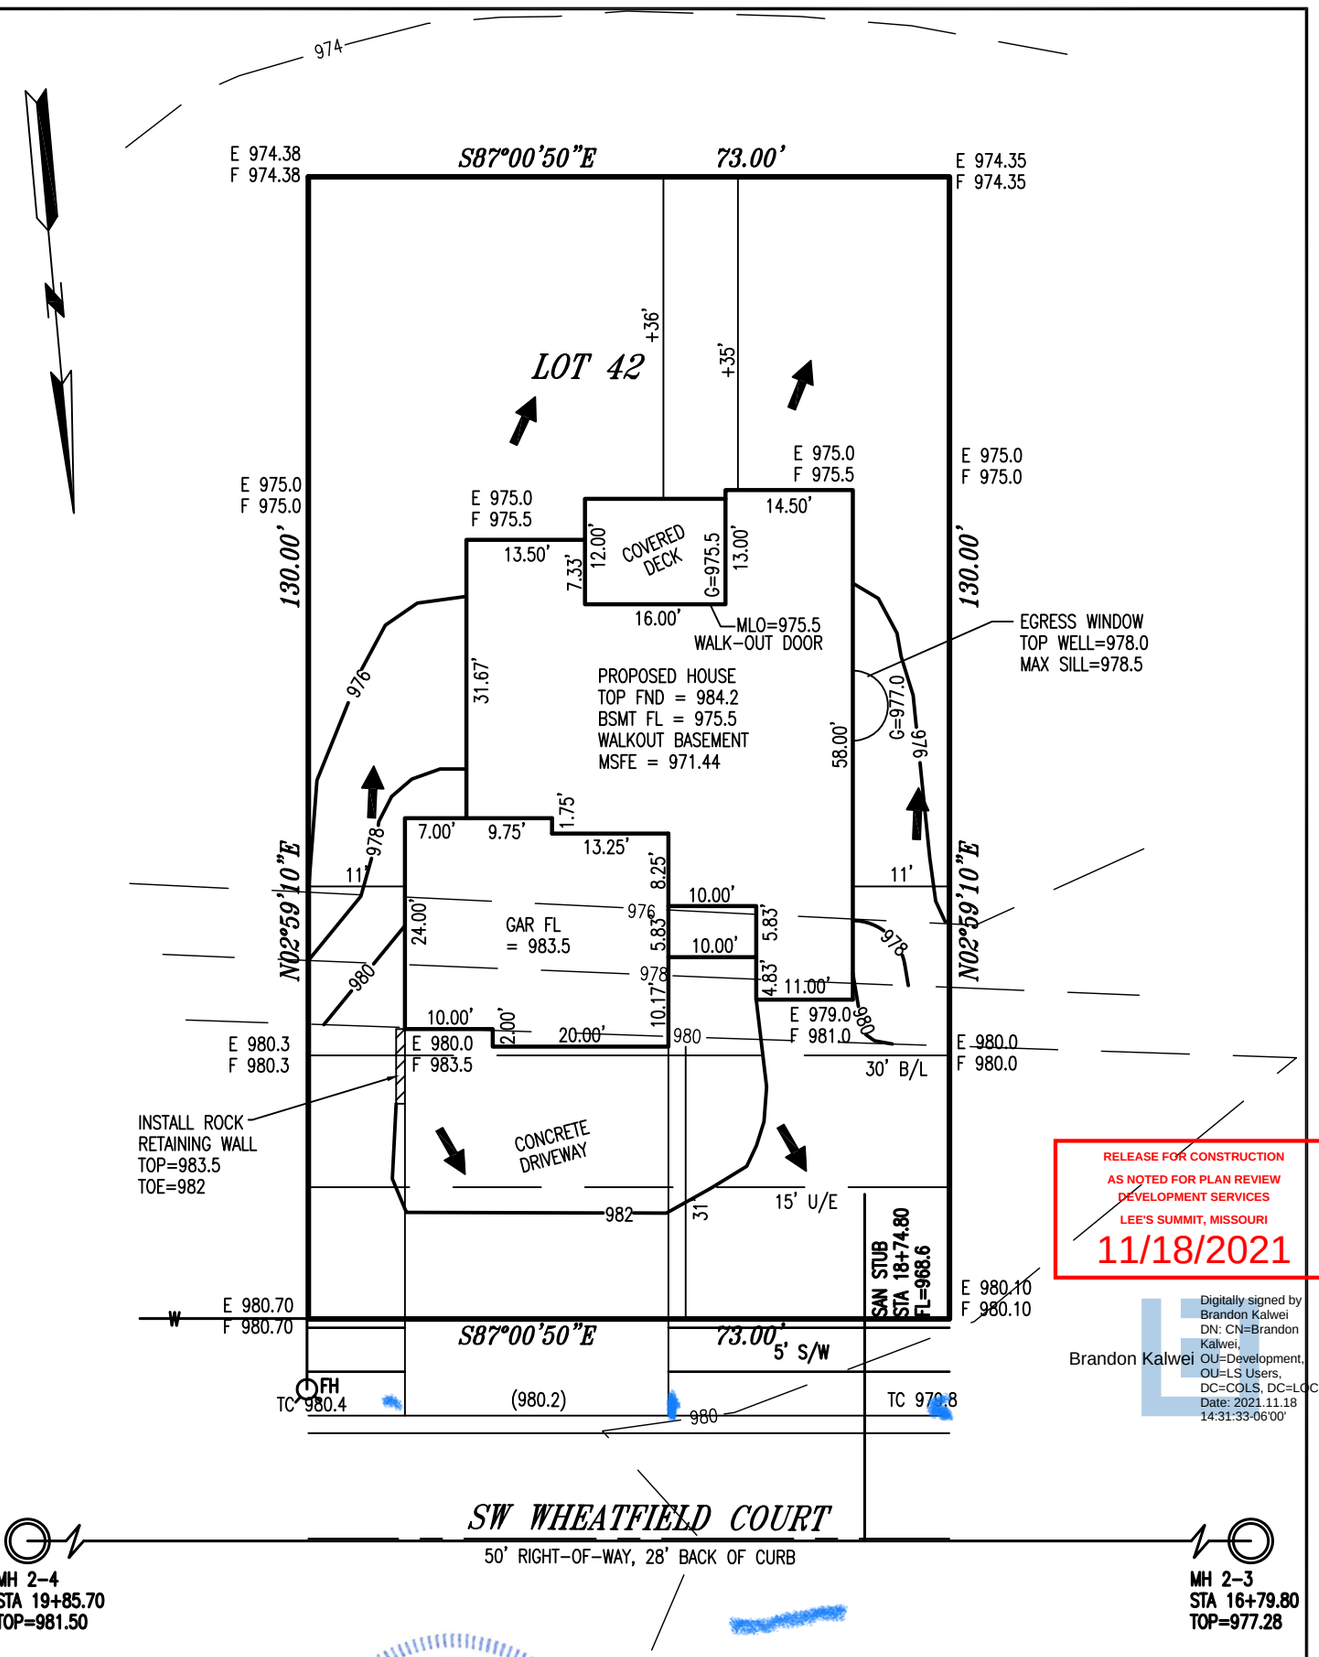

RELEASE FOR CONSTRUCTION
AS NOTED FOR PLAN REVIEW
DEVELOPMENT SERVICES
LEE'S SUMMIT, MISSOURI
11/18/2021

Brandon Kalwei
Digitally signed by Brandon Kalwei
DN: CN=Brandon Kalwei, OU=Development, OU=LS Users, DC=COLS, DC=LOC
Date: 2021.11.18 14:31:33-06'00'

STATE OF MISSOURI
BRANDON LADWIG
NUMBER LS-2008016633
PROFESSIONAL LAND SURVEYOR

KEY:
U/E = UTILITY EASEMENT
TC = TOP OF CURB
B/L = BUILDING LINE
E = EXISITNG GRADE
F = FINISH GRADE
G = LOWEST ADJACENT GRADE

NOTES:
ALL GRADES TAKEN FROM SUBDIVISION GRADING PLANS

ADDRESS: 2027 SW WHEATFIELD COURT

NOV. 12, 2021

NOTES:

1. LEGAL DESCRIPTION OF PROPERTY PROVIDED BY CONTRACTOR. THIS PLOT PLAN DOES NOT CONSTITUTE OR REPRESENT A BOUNDARY SURVEY. THE CONTRACTOR AND/OR OWNER SHALL BE RESPONSIBLE FOR VERIFICATION OF PROPERTY BOUNDARY, PROPERTY CORNERS, DEED DESCRIPTIONS AND LOCATIONS OF PROPOSED HOUSE WITH RESPECT TO PROPERTY LINES.
2. EASEMENTS, BUILDING LINES AND SET-BACKS TAKEN FROM RECORDED PLAT ONLY.
3. CONTRACTOR TO VERIFY LOCATION AND DEPTH OF SANITARY SEWER SERVICE PRIOR TO CONSTRUCTION.
4. CONTRACTOR TO VERIFY ALL DIMENSIONS, ELEVATIONS AND LOCATIONS PRIOR TO CONSTRUCTION
5. CONTRACTOR TO VERIFY CONDITION OF ALL FILL PRIOR TO CONSTRUCTION.
6. GRADES ARE PROPOSED GRADES ONLY. FINAL GRADING AND ELEVATIONS SHALL BE CONTRACTORS RESPONSIBILITY.

JFE CONSTRUCTION

PLOT PLAN

LOT 42

HOOK FARMS 1ST PLAT

LEE'S SUMMIT MISSOURI

LADWIG and ASSOCIATES, L.L.C.
LAND SURVEYORS
816-309-6621

DRAWN BY:	SCALE:
JDH	1" = 20'
DATE:	DRAWING NO.
11/3/21	HF-42