AS GRADED PLOT PLAN

Ordered by: ROB WASHAM HOMES
Description: Lot 37, WHISPERING WOODS 2nd Plat in Lee's Summit, MO
Address: 1617 SW 27th Street

RELEASE FOR CONSTRUCTION
AS NOTED FOR PLAN REVIEW
DEVELOPMENT SERVICES
LEE'S SUMMIT, MISSOURI
09/23/2022

Brandon Kalwei
Digitally signed by Brandon Kalwei
DN: CN=Brandon Kalwei, OU=Development, OU=LS Users, DC=COLS, DC=LOC
Date: 2022.09.23 10:52:02-05'00'

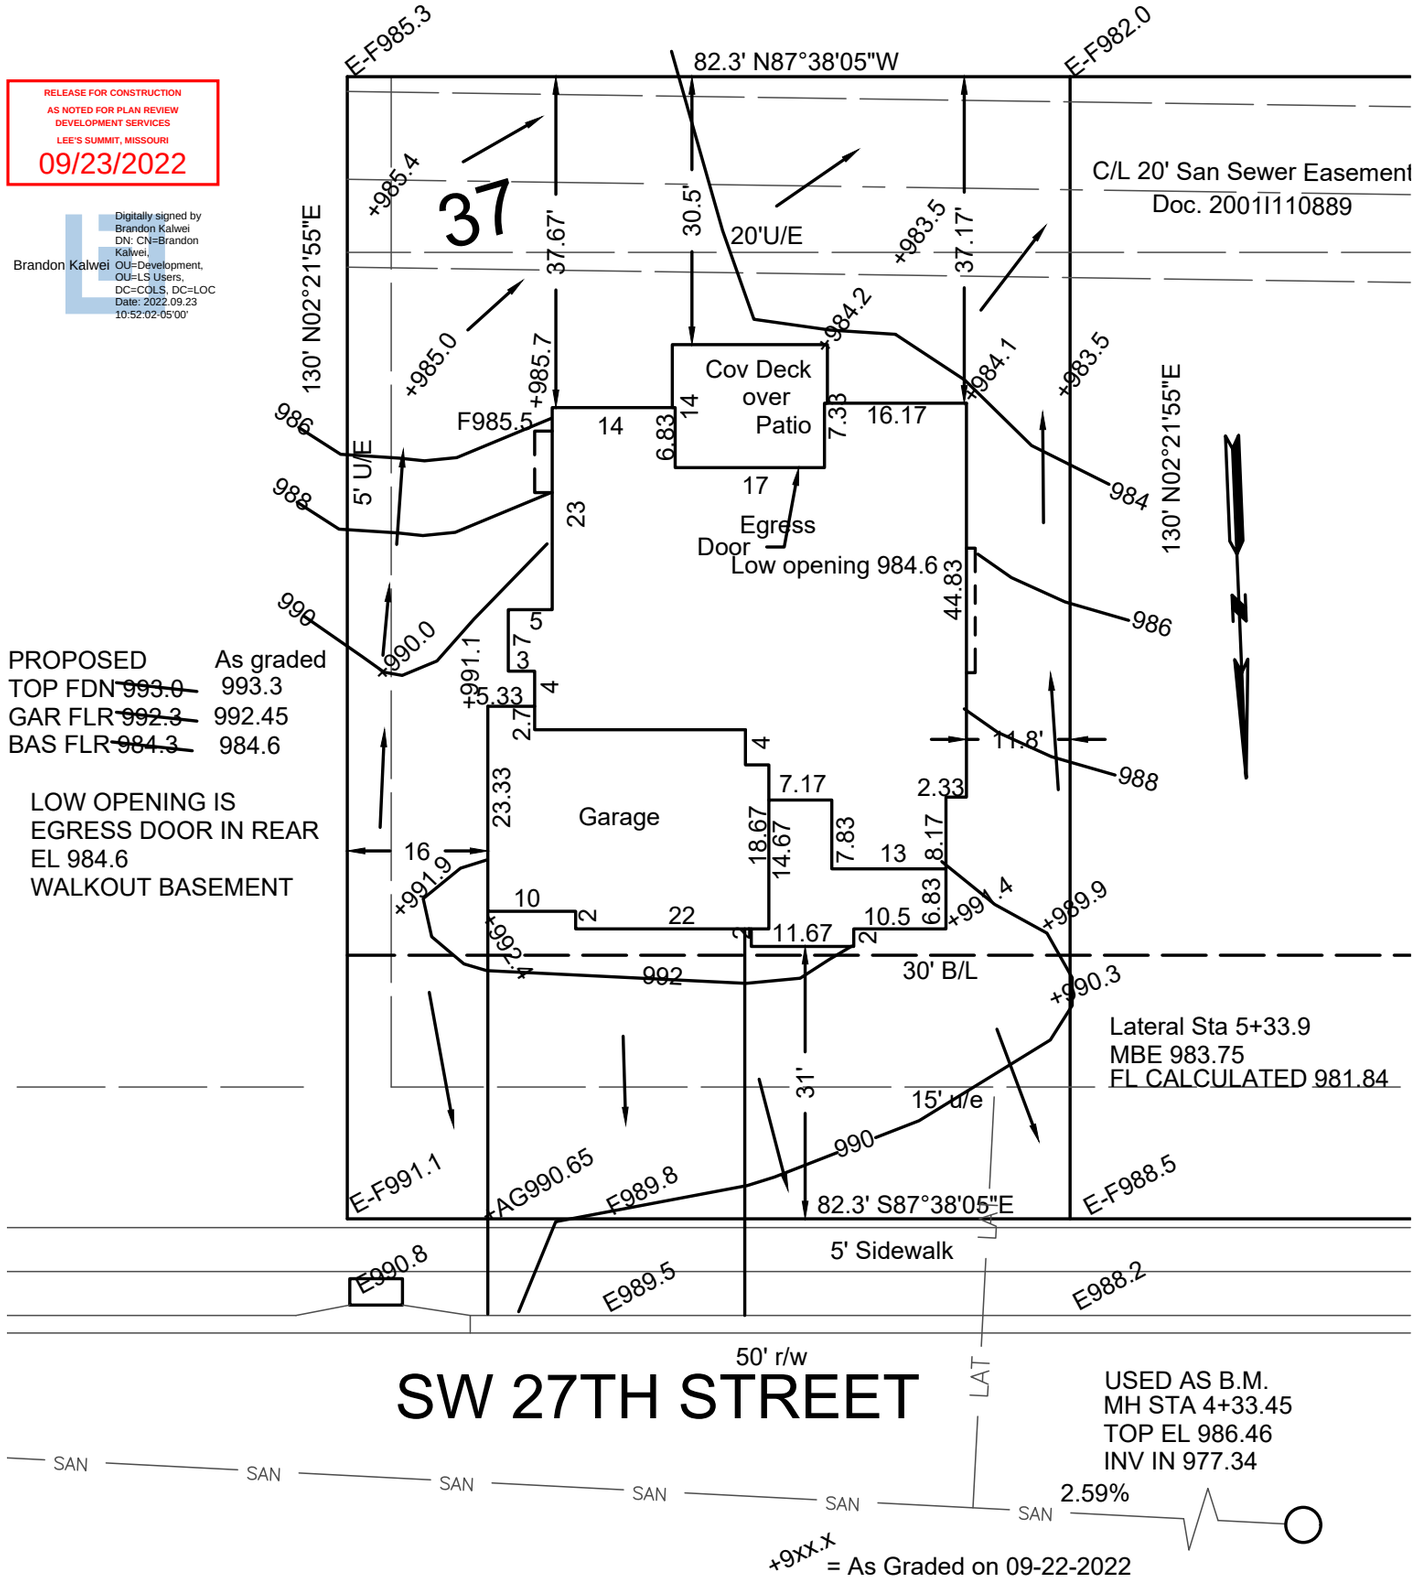

PROPOSED		As graded
TOP FDN	~~993.0~~	993.3
GAR FLR	~~992.3~~	992.45
BAS FLR	~~984.3~~	984.6

LOW OPENING IS
EGRESS DOOR IN REAR
EL 984.6
WALKOUT BASEMENT

→ = DRAINAGE PATTERN

STATE OF MISSOURI
LEE N. BODENHEIMER
NUMBER LS-2114
REGISTERED LAND SURVEYOR
09-22-2022

CONSTRUCTION ENGINEERING SERVICES, INC.
16810-C East 40 Highway
Independence, MO 64055
(816)478-2323
lee@engineeringkc.com

SCALE: 1"=20'
DATE: 09-14-2021 & 09-22-2022
JOB NO: 17939 & 18504

LEE BODENHEIMER, L.S.
Land Surveyor