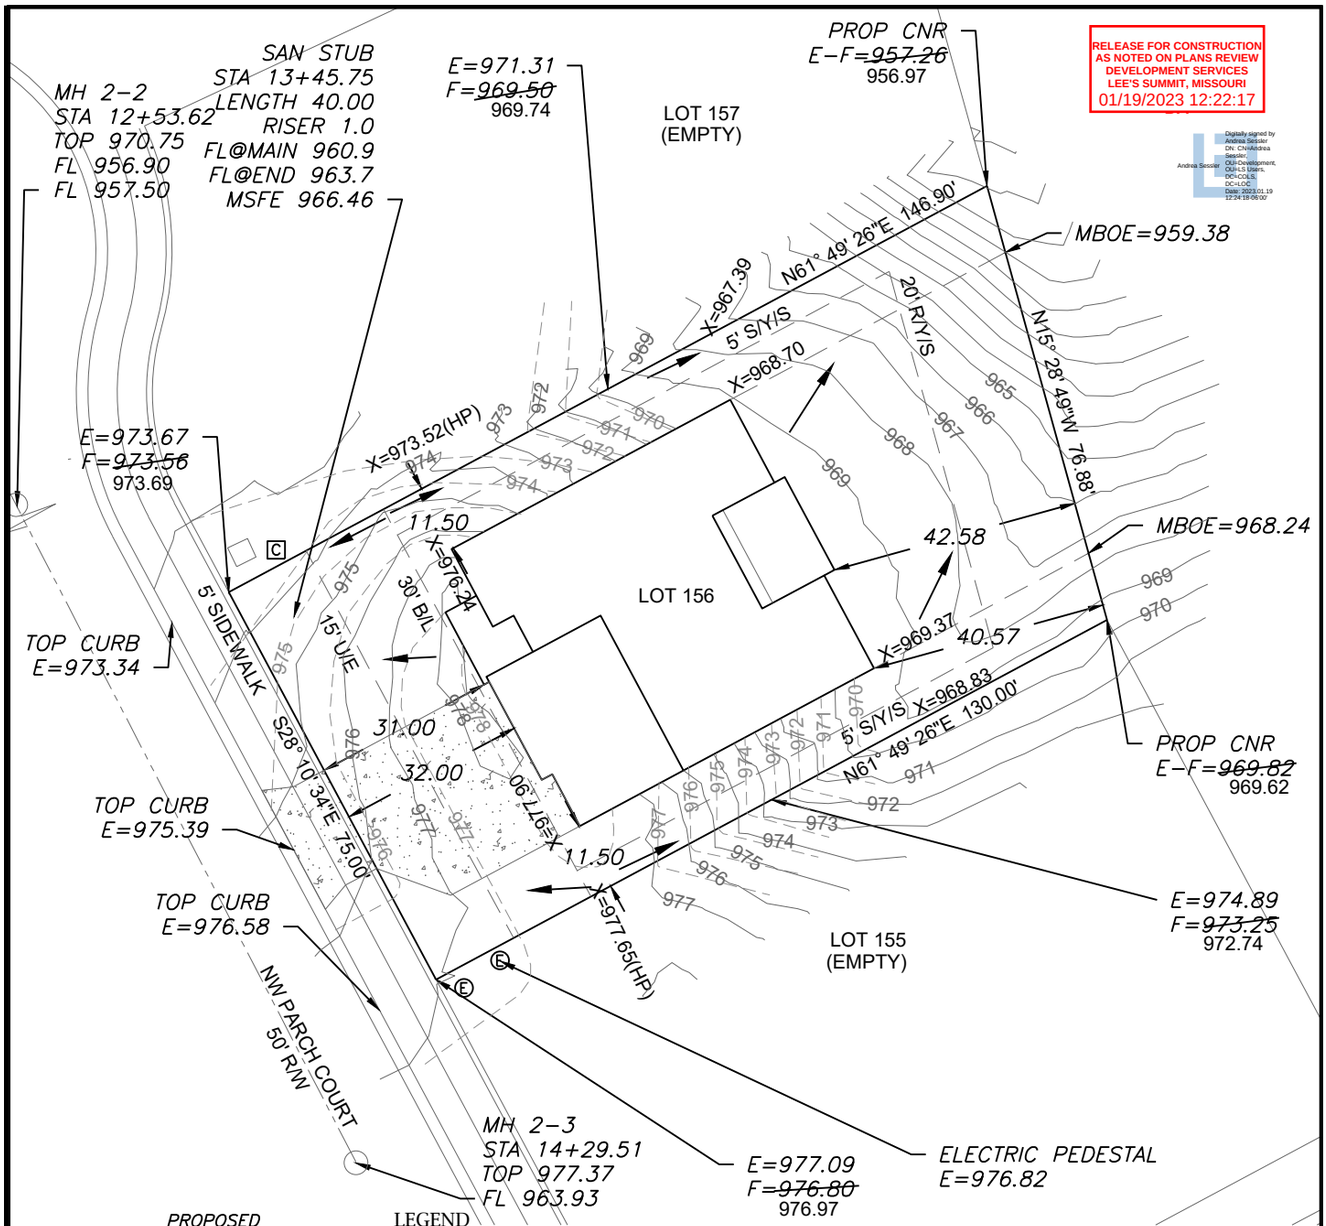

PROPOSED CONTOURS

AS-GRADED CONTOURS

X=###.## = Actual asbuilt ground shots taken on December 6, 2022.

Contours shown are asbuilt.

Scale 1"=30'

LEGEND

- Gas Meter
- Telephone or Fiber-Optic Pedestal
- Cable TV Pedestal
- Electric Pedestal
- Light Pole
- Mailbox
- Fire Hydrant
- Water Valve

PROPOSED HOUSE

TOP FOUNDATION = 979.15
GARAGE FLOOR = 978.15
TOP FOOTING = 970.15
BASEMENT FLOOR = 970.48
DRIVE SLOPE = 8.0%

E = EXISTING ELEVATION
F = PROPOSED FINAL ELEVATION
G = ADJACENT GRADE AT EGRESS
U/E = UTILITY EASEMENT
B/L = BUILDING LINE
S/Y/S = SIDE YARD SETBACK
R/Y/S = REAR YARD SETBACK

NOTES

1. BUILDER TO VERIFY ALL BUILDING ELEVATIONS AND DIMENSIONS.

2. THIS PLOT PLAN DOES NOT CONSTITUTE A BOUNDARY SURVEY.

3. THE EASEMENTS SHOWN ON THIS PLOT PLAN ARE TAKEN FROM THE FINAL PLAT. EASEMENTS MAY EXIST

EXTENDED LOT AREA = 11,208.6 SF
DRIVE AREA = 903.0 SF
APPROACH AREA = 219.0 SF
SIDEWALK AREA = 280.0 SF

LOT INFORMATION

10,384.0 SQ. FT.
REAR LEFT MBOE =957.42
REAR RIGHT MBOE =970.20
MSFE= 966.46
ADDRESS
365 NW PATCH COURT

LEGAL DESCRIPTION

LOT 156, WOODSIDE RIDGE 2ND PLAT, A SUBDIVISION AS RECORDED IN LEE'S SUMMIT, JACKSON COUNTY, MISSOURI.

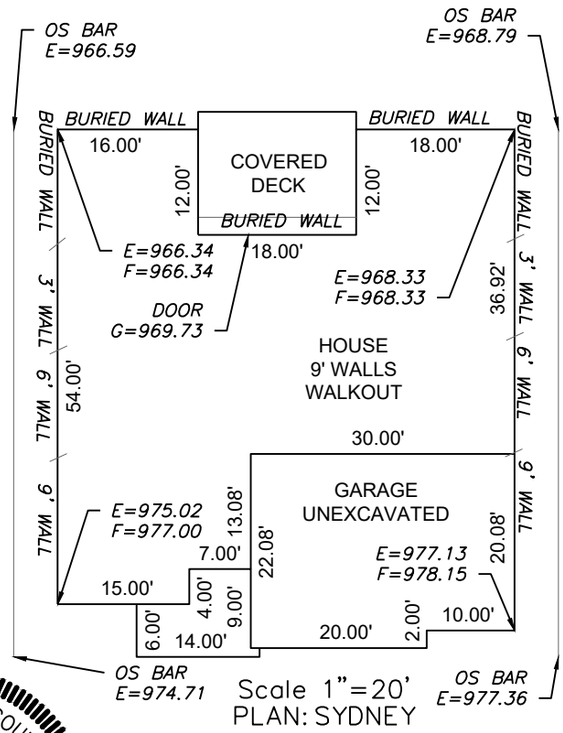

Scale 1"=20'
PLAN: SYDNEY

ENGINEERING SOLUTIONS
ENGINEERING & SURVEYING
50 SE 30TH STREET
LEE'S SUMMIT, MO 64082
P:(816) 623-9888 F:(816)623-9849
WWW.ENGINEERINGSOLUTIONSKC.COM

THIS DRAWING IS NOT VALID UNLESS THE SIGNATURE, DATE AND SEAL OF THE ENGINEER WHO SUPERVISED THE PREPARATION OF THIS DRAWING HAS BEEN AFFIXED HERETO.

STATE OF MISSOURI
MATTHEW J. SCHLICHT
NUMBER
PE-2006019708
PROFESSIONAL ENGINEER
12/7/2022

AS-GRADED PLOT PLAN - LOT 156

WOODSIDE RIDGE 2ND PLAT
LEE'S SUMMIT, JACKSON COUNTY, MISSOURI

SUMMIT HOMES
120 SE 30TH STREET
LEE'S SUMMIT, MO 64082

PROJECT NO.	FILE NAME	DATE	SHEET	OF
1	LOT 156, WOODSIDE RIDGE	4/29/22	1	1

Rev: