



MiTek USA, Inc.
16023 Swingley Ridge Rd
Chesterfield, MO 63017
314-434-1200

Re: 3564895
Summit/161 Highland Meadows

The truss drawing(s) referenced below have been prepared by MiTek USA, Inc. under my direct supervision based on the parameters provided by Builders FirstSource (Valley Center).

Pages or sheets covered by this seal: I58837488 thru I58837562

My license renewal date for the state of Missouri is December 31, 2023.

Missouri COA: Engineering 001193




June 12, 2023

Sevier, Scott, Engineer

IMPORTANT NOTE: The seal on these truss component designs is a certification that the engineer named is licensed in the jurisdiction(s) identified and that the designs comply with ANSI/TPI 1. These designs are based upon parameters shown (e.g., loads, supports, dimensions, shapes and design codes), which were given to MiTek or TRENCO. Any project specific information included is for MiTek's or TRENCO's customers file reference purpose only, and was not taken into account in the preparation of these designs. MiTek or TRENCO has not independently verified the applicability of the design parameters or the designs for any particular building. Before use, the building designer should verify applicability of design parameters and properly incorporate these designs into the overall building design per ANSI/TPI 1, Chapter 2.

Job	Truss	Truss Type	Qty	Ply	Summit/161 Highland Meadows	RELEASE FOR CONSTRUCTION
3564895	A1	Hip Girder	1	1		AS NOTED FOR PLAN REVIEW
					Job Reference (optional)	DEVELOPMENT SERVICES
						LEE'S SUMMIT, MISSOURI

Builders FirstSource (Valley Center), Valley Center, KS - 67147, 8.630 s Nov 19 2022 MiTek Industries, Inc. Thu Jun 9 4:12:37 2023 Page 1
ID:icBMJaMgT1gasuUyx9?RhvzDEHb-RfC?PsB70Hq3NSuPqnL8v3uITxb6KVrCg17JzJIC? 07/03/2023
1-10-8 3-8-14 7-2-4 11-6-4 16-0-0 20-5-12 24-9-12 28-3-2 32-0-0 33-10-8
1-10-8 3-8-14 3-5-6 4-4-0 4-5-12 4-5-12 4-4-0 3-5-6 3-8-14 1-10-8
Scale = 1:60.2

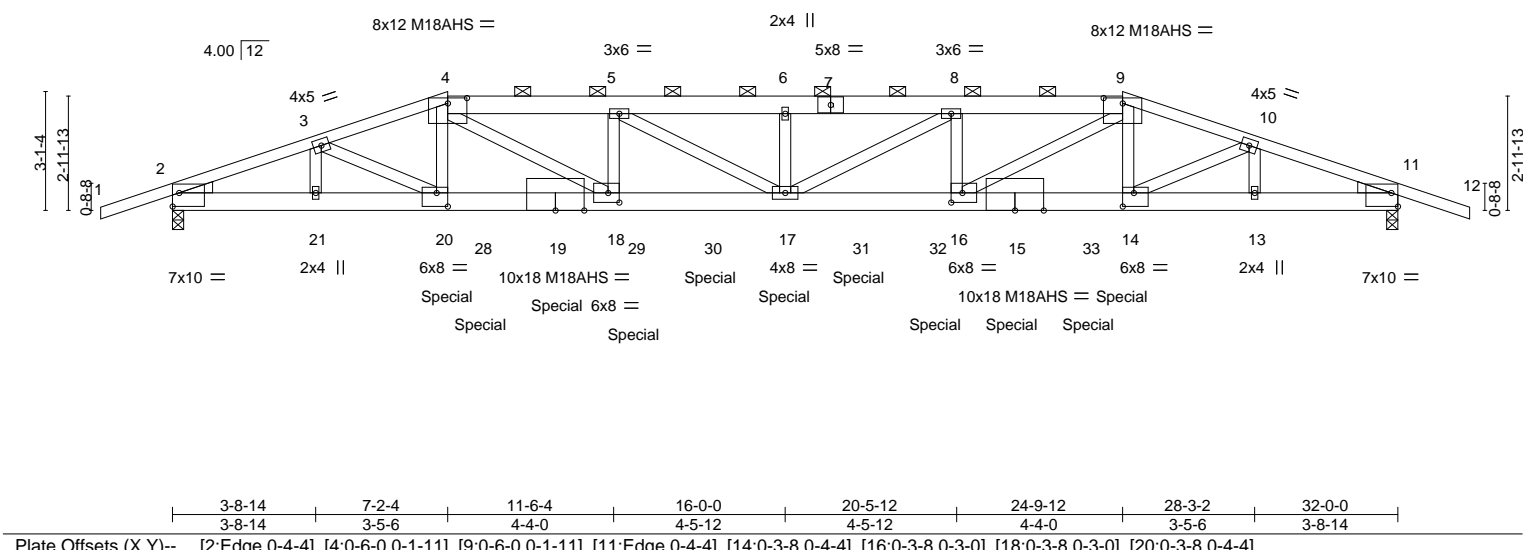

LOADING (psf)	SPACING-	2-0-0	CSI.	DEFL.	in	(loc)	l/defl	L/d	PLATES	GRIP
TCLL 25.0	Plate Grip DOL	1.15	TC 0.83	Vert(LL)	-0.59	17	>654	240	MT20	197/144
TCDL 10.0	Lumber DOL	1.15	BC 0.96	Vert(CT)	-1.05	17	>365	180	M18AHS	142/136
BCLL 0.0	Rep Stress Incr	NO	WB 0.86	Horz(CT)	0.17	11	n/a	n/a		
BCDL 10.0	Code IRC2018/TPI2014		Matrix-MS						Weight: 174 lb	FT = 20%

LUMBER-	BRACING-
TOP CHORD 2x4 SP 2400F 2.0E *Except* 4-7,7-9: 2x6 SPF 2100F 1.8E	TOP CHORD Structural wood sheathing directly applied or 2-0-13 oc purlins, except 2-0-0 oc purlins (2-4-1 max.): 4-9.
BOT CHORD 2x6 SP 2400F 2.0E *Except* 15-19: 2x6 SPF 2100F 1.8E	BOT CHORD Rigid ceiling directly applied or 6-3-10 oc bracing.
WEBS 2x4 SPF No.2	
WEDGE Left: 2x4 SPF No.2, Right: 2x4 SPF No.2	

REACTIONS.	(size) 2=0-3-8, 11=0-3-8 Max Horz 2=45(LC 25) Max Uplift 2=790(LC 4), 11=790(LC 5) Max Grav 2=3398(LC 1), 11=3398(LC 1)
-------------------	--

FORCES.	(lb) - Max. Comp./Max. Ten. - All forces 250 (lb) or less except when shown.
TOP CHORD	2-3=-7148/1577, 3-4=-8415/1909, 4-5=-10926/2522, 5-6=-11885/2732, 6-8=-11885/2732, 8-9=-10926/2522, 9-10=-8415/1910, 10-11=-7148/1578
BOT CHORD	2-21=-1466/6701, 20-21=-1466/6701, 18-20=-1762/7978, 17-18=-2452/10919, 16-17=-2421/10919, 14-16=-1717/7978, 13-14=-1422/6702, 11-13=-1422/6702
WEBS	3-21=-902/250, 3-20=-362/1573, 4-20=-122/682, 4-18=-847/3525, 5-18=-1162/314, 5-17=-325/1180, 6-17=-343/115, 8-17=-326/1179, 8-16=-1162/314, 9-16=-847/3524, 9-14=-122/682, 10-14=-363/1573, 10-13=-902/250

- NOTES-**
- Unbalanced roof live loads have been considered for this design.
 - Wind: ASCE 7-16; Vult=115mph (3-second gust) Vasd=91mph; TCDL=6.0psf; BCDL=4.2psf; h=15ft; Cat. II; Exp C; Enclosed; MWFRS (envelope) gable end zone; cantilever left and right exposed; end vertical left and right exposed; Lumber DOL=1.60 plate grip DOL=1.60
 - Provide adequate drainage to prevent water ponding.
 - All plates are MT20 plates unless otherwise indicated.
 - This truss has been designed for a 10.0 psf bottom chord live load nonconcurrent with any other live loads.
 - Provide mechanical connection (by others) of truss to bearing plate capable of withstanding 790 lb uplift at joint 2 and 790 lb uplift at joint 11.
 - This truss is designed in accordance with the 2018 International Residential Code sections R502.11.1 and R802.10.2 and referenced standard ANSI/TPI 1.
 - Graphical purlin representation does not depict the size or the orientation of the purlin along the top and/or bottom chord.
 - Hanger(s) or other connection device(s) shall be provided sufficient to support concentrated load(s) 547 lb down and 132 lb up at 7-2-4, 284 lb down and 91 lb up at 8-0-12, 284 lb down and 91 lb up at 10-0-12, 284 lb down and 91 lb up at 12-0-12, 284 lb down and 91 lb up at 14-0-12, 284 lb down and 91 lb up at 16-0-0, 284 lb down and 91 lb up at 17-11-4, 284 lb down and 91 lb up at 19-11-4, 284 lb down and 91 lb up at 21-11-4, and 284 lb down and 91 lb up at 23-11-4, and 547 lb down and 132 lb up at 24-9-12 on bottom chord. The design/selection of such connection device(s) is the responsibility of others.
- On the CASE(S) section, loads applied to the face of the truss are noted as front (F) or back (B).



June 12, 2023

Job	Truss	Truss Type	Qty	Ply	Summit/161 Highland Meadows	RELEASE FOR CONSTRUCTION
3564895	A1	Hip Girder	1	1	Job Reference (optional)	AS NOTED FOR PLAN REVIEW DEVELOPMENT SERVICES LEE'S SUMMIT, MISSOURI

Builders FirstSource (Valley Center), Valley Center, KS - 67147,

8.630 s Nov 19 2022 MiTek Industries, Inc. Thu Jun 07 12:37:37 2023 Page 2
ID:icBMJaMgT1gasuUyx9?RhvzDEHb-RfC?PsB70Hq3NSpPqnL8v3uITxbS KV rCm7J4ZICP

LOAD CASE(S) Standard

- 1) Dead + Roof Live (balanced): Lumber Increase=1.15, Plate Increase=1.15
 - Uniform Loads (plf)
 - Vert: 1-4=-70, 4-9=-70, 9-12=-70, 22-25=-20
 - Concentrated Loads (lb)
 - Vert: 19=-284(B) 20=-547(B) 17=-284(B) 14=-547(B) 15=-284(B) 28=-284(B) 29=-284(B) 30=-284(B) 31=-284(B) 32=-284(B) 33=-284(B)

Job	Truss	Truss Type	Qty	Ply	Summit/161 Highland Meadows	RELEASE FOR CONSTRUCTION
3564895	A2	Hip	1	1		AS NOTED FOR PLAN REVIEW
					Job Reference (optional)	DEVELOPMENT SERVICES
						LEE'S SUMMIT, MISSOURI


Builders FirstSource (Valley Center), Valley Center, KS - 67147,

8.630 s Nov 19 2022 MiTek Industries, Inc. Thu Jun 8 7 12 38 2023 Page 1

ID:icBMJaMgT1gasuUyx9?RhvzDEHb-RfC?PsB70Hq3NSpPqnL8v3uITxb6KVrCg17J4ZICP?

-1-10-8	5-7-6	9-2-4	16-0-0	22-9-12	26-4-10	32-0-0	33-10-8
1-10-8	5-7-6	3-6-15	6-9-12	6-9-12	3-6-15	5-7-6	1-10-8

Scale = 1:59.2

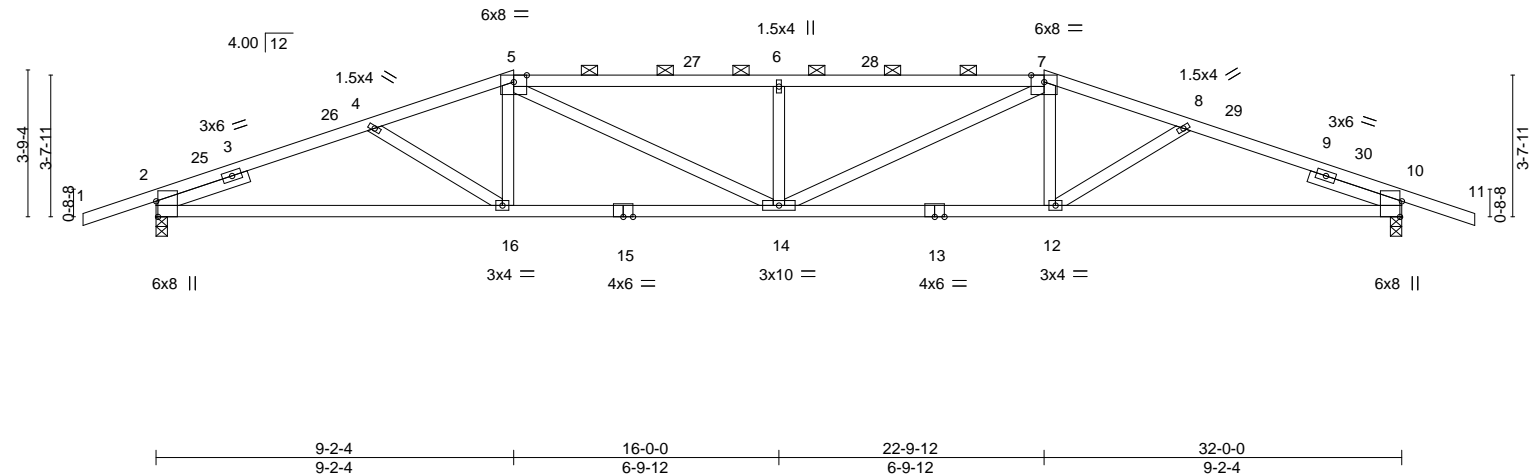

LOADING (psf)		SPACING-		CSI.		DEFL.		PLATES		GRIP	
TCLL	25.0	Plate Grip DOL	1.15	TC	0.76	Vert(LL)	-0.31 14 >999	MT20	197/144		
TCDL	10.0	Lumber DOL	1.15	BC	0.97	Vert(CT)	-0.56 12-14 >692				
BCLL	0.0	Rep Stress Incr	YES	WB	0.23	Horz(CT)	0.14 10 n/a n/a				
BCDL	10.0	Code IRC2018/TPI2014		Matrix-AS						Weight: 121 lb	FT = 20%

LUMBER-
TOP CHORD 2x4 SPF No.2 *Except*
5-7: 2x4 SPF 1650F 1.5E
BOT CHORD 2x4 SPF No.2
WEBS 2x4 SPF No.2
SLIDER Left 2x4 SPF No.2 2-6-0, Right 2x4 SPF No.2 2-6-0

BRACING-
TOP CHORD Structural wood sheathing directly applied, except
2-0-0 oc purlins (3-2-8 max.): 5-7.
BOT CHORD Rigid ceiling directly applied.

REACTIONS. (size) 2=0-3-8, 10=0-3-8
Max Horz 2=-56(LC 13)
Max Uplift 2=-313(LC 8), 10=-313(LC 9)
Max Grav 2=1571(LC 1), 10=1571(LC 1)

FORCES. (lb) - Max. Comp./Max. Ten. - All forces 250 (lb) or less except when shown.
TOP CHORD 2-4=-3016/623, 4-5=-2941/587, 5-6=-3516/725, 6-7=-3516/724, 7-8=-2941/587,
8-10=-3016/623
BOT CHORD 2-16=-508/2789, 14-16=-442/2792, 12-14=-450/2792, 10-12=-517/2789
WEBS 5-16=0/261, 5-14=-197/947, 6-14=-574/195, 7-14=-197/947, 7-12=0/261

- NOTES-**
- 1) Unbalanced roof live loads have been considered for this design.
 - 2) Wind: ASCE 7-16; Vult=115mph (3-second gust) Vasd=91mph; TCDL=6.0psf; BCDL=4.2psf; h=15ft; Cat. II; Exp C; Enclosed; MWFRS (envelope) gable end zone and C-C Exterior(2E) -1-10-8 to 1-3-14, Interior(1) 1-3-14 to 9-2-4, Exterior(2R) 9-2-4 to 13-8-9, Interior(1) 13-8-9 to 22-9-12, Exterior(2R) 22-9-12 to 27-4-1, Interior(1) 27-4-1 to 33-10-8 zone; cantilever left and right exposed ; end vertical left and right exposed;C-C for members and forces & MWFRS for reactions shown; Lumber DOL=1.60 plate grip DOL=1.60
 - 3) Provide adequate drainage to prevent water ponding.
 - 4) This truss has been designed for a 10.0 psf bottom chord live load nonconcurrent with any other live loads.
 - 5) Provide mechanical connection (by others) of truss to bearing plate capable of withstanding 313 lb uplift at joint 2 and 313 lb uplift at joint 10.
 - 6) This truss is designed in accordance with the 2018 International Residential Code sections R502.11.1 and R802.10.2 and referenced standard ANSI/TPI 1.
 - 7) This truss design requires that a minimum of 7/16" structural wood sheathing be applied directly to the top chord and 1/2" gypsum sheetrock be applied directly to the bottom chord.
 - 8) Graphical purlin representation does not depict the size or the orientation of the purlin along the top and/or bottom chord.



June 12, 2023

WARNING - Verify design parameters and READ NOTES ON THIS AND INCLUDED MITEK REFERENCE PAGE MII-7473 rev. 5/19/2020 BEFORE USE.

Design valid for use only with MiTek® connectors. This design is based only upon parameters shown, and is for an individual building component, not a truss system. Before use, the building designer must verify the applicability of design parameters and properly incorporate this design into the overall building design. Bracing indicated is to prevent buckling of individual truss web and/or chord members only. Additional temporary and permanent bracing is always required for stability and to prevent collapse with possible personal injury and property damage. For general guidance regarding the fabrication, storage, delivery, erection and bracing of trusses and truss systems, see **ANSI/TPI1 Quality Criteria, DSB-89 and BCSI Building Component Safety Information** available from Truss Plate Institute, 2670 Crain Highway, Suite 203 Waldorf, MD 20601



16023 Swingley Ridge Rd
Chesterfield, MO 63017

Job	Truss	Truss Type	Qty	Ply	Summit/161 Highland Meadows	AS NOTED FOR PLAN REVIEW DEVELOPMENT SERVICES LEE'S SUMMIT, MISSOURI
3564895	A3	Hip	1	1	Job Reference (optional)	

Builders FirstSource (Valley Center), Valley Center, KS - 67147, 8.630 s Nov 19 2022 MiTek Industries, Inc. Thu Jun 8 7:41:24 2023 Page 1
ID:icBMJaMgT1gasuUyx9?RhvzDEHb-RfC?PsB70Hq3NSqPqnL8v3uITxb6KVrCg17J4ZICP1
-1-10-8 5-8-14 11-2-4 16-0-0 20-9-12 26-3-2 32-0-0 33-10-8
1-10-8 5-8-14 5-5-6 4-9-12 4-9-12 5-5-6 5-8-14 1-10-8

Scale = 1:59.2

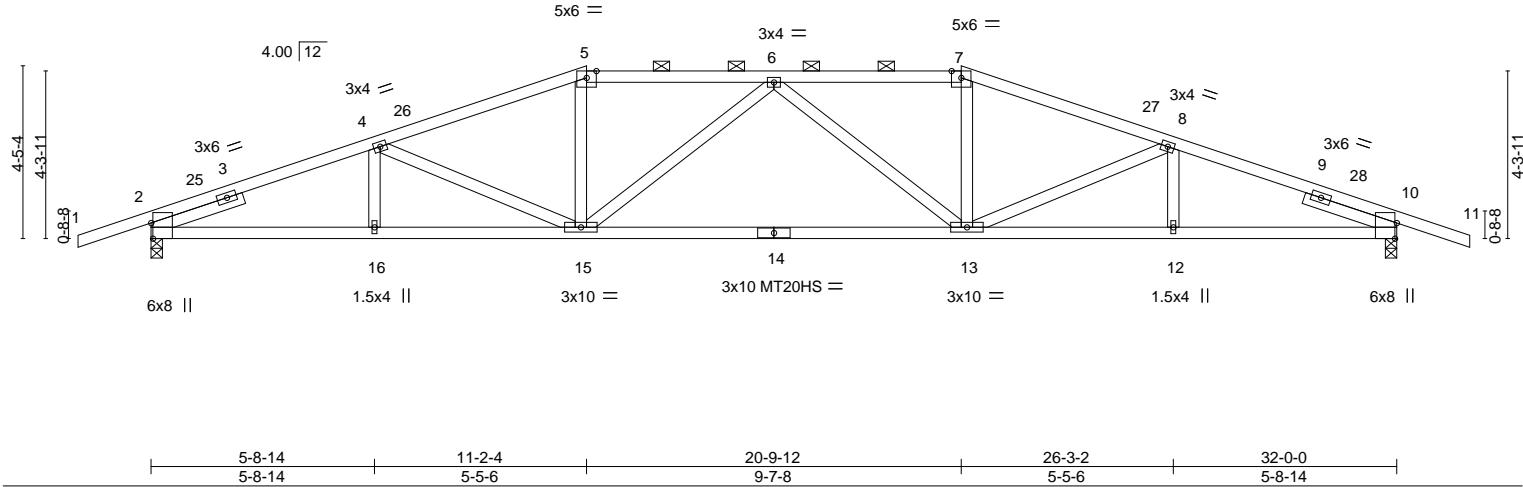


Plate Offsets (X,Y)-- [2:0-4-13,Edge], [10:0-4-13,Edge]		5-8-14 11-2-4 20-9-12 26-3-2 32-0-0		5-8-14 5-5-6 9-7-8 5-5-6 5-8-14	
LOADING (psf)		SPACING- 2-0-0		CSI.	
TCLL	25.0	Plate Grip DOL	1.15	TC	0.76
TCDL	10.0	Lumber DOL	1.15	BC	0.92
BCLL	0.0	Rep Stress Incr	YES	WB	0.34
BCDL	10.0	Code IRC2018/TPI2014		Matrix-AS	
				DEFL.	
				in (loc)	l/defl L/d
				Vert(LL)	-0.27 13-15 >999 240
				Vert(CT)	-0.64 13-15 >605 180
				Horz(CT)	0.14 10 n/a n/a
				PLATES	GRIP
				MT20	197/144
				MT20HS	148/108
				Weight: 125 lb	FT = 20%

LUMBER-		BRACING-	
TOP CHORD	2x4 SPF No.2	TOP CHORD	Structural wood sheathing directly applied, except
BOT CHORD	2x4 SPF 1650F 1.5E		2-0-0 oc purlins (3-5-3 max.): 5-7.
WEBS	2x4 SPF No.2	BOT CHORD	Rigid ceiling directly applied.
SLIDER	Left 2x4 SPF No.2 2-6-0, Right 2x4 SPF No.2 2-6-0		

REACTIONS.	
(size)	2=0-3-8, 10=0-3-8
Max Horz	2=-67(LC 17)
Max Uplift	2=-305(LC 8), 10=-305(LC 9)
Max Grav	2=1571(LC 1), 10=1571(LC 1)

FORCES.	
(lb) - Max. Comp./Max. Ten. - All forces 250 (lb) or less except when shown.	
TOP CHORD	2-4=-3035/617, 4-5=-2789/576, 5-6=-2605/575, 6-7=-2605/575, 7-8=-2789/576, 8-10=-3035/617
BOT CHORD	2-16=-506/2817, 15-16=-506/2817, 13-15=-496/2841, 12-13=-515/2817, 10-12=-515/2817
WEBS	4-15=-258/131, 5-15=-37/478, 6-15=-471/148, 6-13=-471/148, 7-13=-37/478, 8-13=-258/132

- NOTES-**
- 1) Unbalanced roof live loads have been considered for this design.
 - 2) Wind: ASCE 7-16; Vult=115mph (3-second gust) Vasd=91mph; TCDL=6.0psf; BCDL=4.2psf; h=15ft; Cat. II; Exp C; Enclosed; MWFRS (envelope) gable end zone and C-C Exterior(2E) -1-10-8 to 1-3-14, Interior(1) 1-3-14 to 11-2-4, Exterior(2R) 11-2-4 to 16-0-0, Interior(1) 16-0-0 to 20-9-12, Exterior(2R) 20-9-12 to 25-4-1, Interior(1) 25-4-1 to 33-10-8 zone; cantilever left and right exposed; end vertical left and right exposed; C-C for members and forces & MWFRS for reactions shown; Lumber DOL=1.60 plate grip DOL=1.60
 - 3) Provide adequate drainage to prevent water ponding.
 - 4) All plates are MT20 plates unless otherwise indicated.
 - 5) This truss has been designed for a 10.0 psf bottom chord live load nonconcurrent with any other live loads.
 - 6) Provide mechanical connection (by others) of truss to bearing plate capable of withstanding 305 lb uplift at joint 2 and 305 lb uplift at joint 10.
 - 7) This truss is designed in accordance with the 2018 International Residential Code sections R502.11.1 and R802.10.2 and referenced standard ANSI/TPI 1.
 - 8) This truss design requires that a minimum of 7/16" structural wood sheathing be applied directly to the top chord and 1/2" gypsum sheetrock be applied directly to the bottom chord.
 - 9) Graphical purlin representation does not depict the size or the orientation of the purlin along the top and/or bottom chord.



June 12, 2023

Job	Truss	Truss Type	Qty	Ply	Summit/161 Highland Meadows	AS NOTED FOR PLAN REVIEW DEVELOPMENT SERVICES LEE'S SUMMIT, MISSOURI
3564895	A4	Hip	1	1	Job Reference (optional)	


Builders FirstSource (Valley Center), Valley Center, KS - 67147,

8.630 s Nov 19 2022 MiTek Industries, Inc. Thu Jun 8 7 41 24 2023 Page 1

ID:icBMJaMgT1gasuUyx9?RhvzDEHb-RfC?PsB70Hq3NSqPqnL8v3uITxb6KVrCg17J4ZICP?

-1-10-8	6-8-14	13-2-4	18-9-12	25-3-2	32-0-0	33-10-8
1-10-8	6-8-14	6-5-6	5-7-8	6-5-6	6-8-14	1-10-8

Scale = 1:59.2

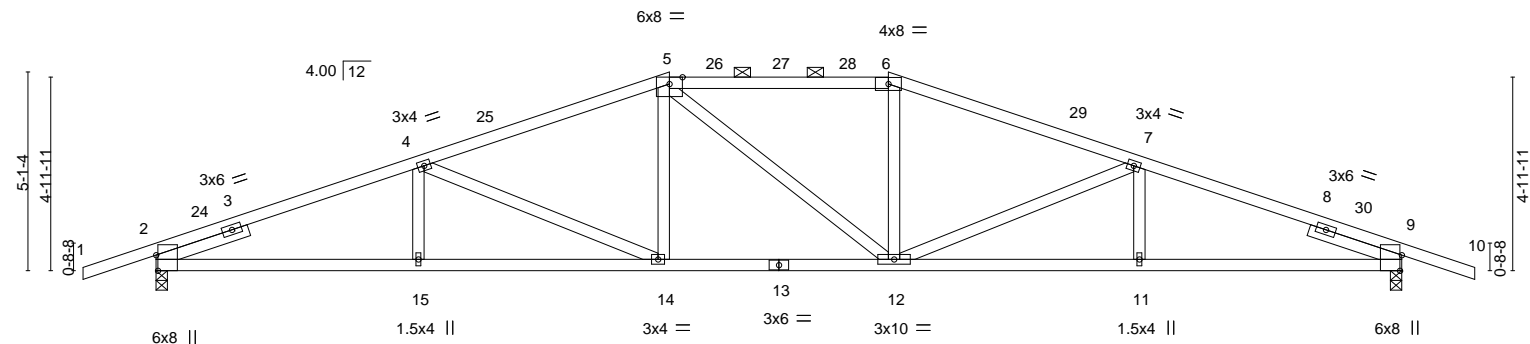

	6-8-14	13-2-4	18-9-12	25-3-2	32-0-0	
	6-8-14	6-5-6	5-7-8	6-5-6	6-8-14	

Plate Offsets (X,Y)-- [2:0-4-13,Edge], [9:0-4-13,Edge]

LOADING (psf)	SPACING-	2-0-0	CSI.	DEFL.	in (loc)	l/defl	L/d	PLATES	GRIP
TCLL 25.0	Plate Grip DOL	1.15	TC 0.87	Vert(LL)	-0.25 14-15	>999	240	MT20	197/144
TCDL 10.0	Lumber DOL	1.15	BC 0.80	Vert(CT)	-0.47 14-15	>816	180		
BCLL 0.0	Rep Stress Incr	YES	WB 0.44	Horz(CT)	0.14 9	n/a	n/a		
BCDL 10.0	Code IRC2018/TPI2014		Matrix-AS						
								Weight: 124 lb	FT = 20%

LUMBER-
TOP CHORD 2x4 SPF No.2
BOT CHORD 2x4 SPF 1650F 1.5E
WEBS 2x4 SPF No.2
SLIDER Left 2x4 SPF No.2 2-6-0, Right 2x4 SPF No.2 2-6-0

BRACING-
TOP CHORD Structural wood sheathing directly applied, except
2-0-0 oc purlins (3-6-2 max.): 5-6.
BOT CHORD Rigid ceiling directly applied.

REACTIONS. (size) 2=0-3-8, 9=0-3-8
Max Horz 2=78(LC 16)
Max Uplift 2=-295(LC 8), 9=-295(LC 9)
Max Grav 2=1571(LC 1), 9=1571(LC 1)

FORCES. (lb) - Max. Comp./Max. Ten. - All forces 250 (lb) or less except when shown.
TOP CHORD 2-4=-3067/618, 4-5=-2579/563, 5-6=-2383/570, 6-7=-2579/563, 7-9=-3067/618
BOT CHORD 2-15=-501/2846, 14-15=-501/2846, 12-14=-380/2382, 11-12=-510/2846, 9-11=-510/2846
WEBS 4-14=-542/169, 5-14=-17/384, 6-12=-14/384, 7-12=-541/170

NOTES-

- Unbalanced roof live loads have been considered for this design.
- Wind: ASCE 7-16; Vult=115mph (3-second gust) Vasd=91mph; TCDL=6.0psf; BCDL=4.2psf; h=15ft; Cat. II; Exp C; Enclosed; MWFRS (envelope) gable end zone and C-C Exterior(2E) -1-10-8 to 1-3-14, Interior(1) 1-3-14 to 13-2-4, Exterior(2R) 13-2-4 to 17-8-9, Interior(1) 17-8-9 to 18-9-12, Exterior(2R) 18-9-12 to 23-4-1, Interior(1) 23-4-1 to 33-10-8 zone; cantilever left and right exposed; end vertical left and right exposed; C-C for members and forces & MWFRS for reactions shown; Lumber DOL=1.60 plate grip DOL=1.60
- Provide adequate drainage to prevent water ponding.
- This truss has been designed for a 10.0 psf bottom chord live load nonconcurrent with any other live loads.
- Provide mechanical connection (by others) of truss to bearing plate capable of withstanding 295 lb uplift at joint 2 and 295 lb uplift at joint 9.
- This truss is designed in accordance with the 2018 International Residential Code sections R502.11.1 and R802.10.2 and referenced standard ANSI/TPI 1.
- This truss design requires that a minimum of 7/16" structural wood sheathing be applied directly to the top chord and 1/2" gypsum sheetrock be applied directly to the bottom chord.
- Graphical purlin representation does not depict the size or the orientation of the purlin along the top and/or bottom chord.



June 12, 2023

WARNING - Verify design parameters and READ NOTES ON THIS AND INCLUDED MITEK REFERENCE PAGE MII-7473 rev. 5/19/2020 BEFORE USE.

Design valid for use only with MiTek® connectors. This design is based only upon parameters shown, and is for an individual building component, not a truss system. Before use, the building designer must verify the applicability of design parameters and properly incorporate this design into the overall building design. Bracing indicated is to prevent buckling of individual truss web and/or chord members only. Additional temporary and permanent bracing is always required for stability and to prevent collapse with possible personal injury and property damage. For general guidance regarding the fabrication, storage, delivery, erection and bracing of trusses and truss systems, see

ANSI/TPI1 Quality Criteria, DSB-89 and BCSI Building Component


Safety Information available from Truss Plate Institute, 2670 Crain Highway, Suite 203 Waldorf, MD 20601



16023 Swingley Ridge Rd
Chesterfield, MO 63017

Job	Truss	Truss Type	Qty	Ply	Summit/161 Highland Meadows	AS NOTED FOR PLAN REVIEW DEVELOPMENT SERVICES LEE'S SUMMIT, MISSOURI
3564895	A5	Common	3	1	Job Reference (optional)	

Builders FirstSource (Valley Center), Valley Center, KS - 67147, 8.630 s Nov 19 2022 MiTek Industries, Inc. Thu Jun 8 7 41 23 2023 Page 1
ID:icBMJaMgT1gasuUyx9?RhvzDEHb-RfC?PsB70Hq3NSqPqnL8v3uITxb6KVrCm7f4Zf1C? 07/03/2023
0-10-8 6-1-6 11-6-11 17-0-0 24-10-4 33-0-0 34-10-8
0-10-8 6-1-6 5-5-5 5-5-5 7-10-4 8-1-12 1-10-8
Scale = 1:57.3

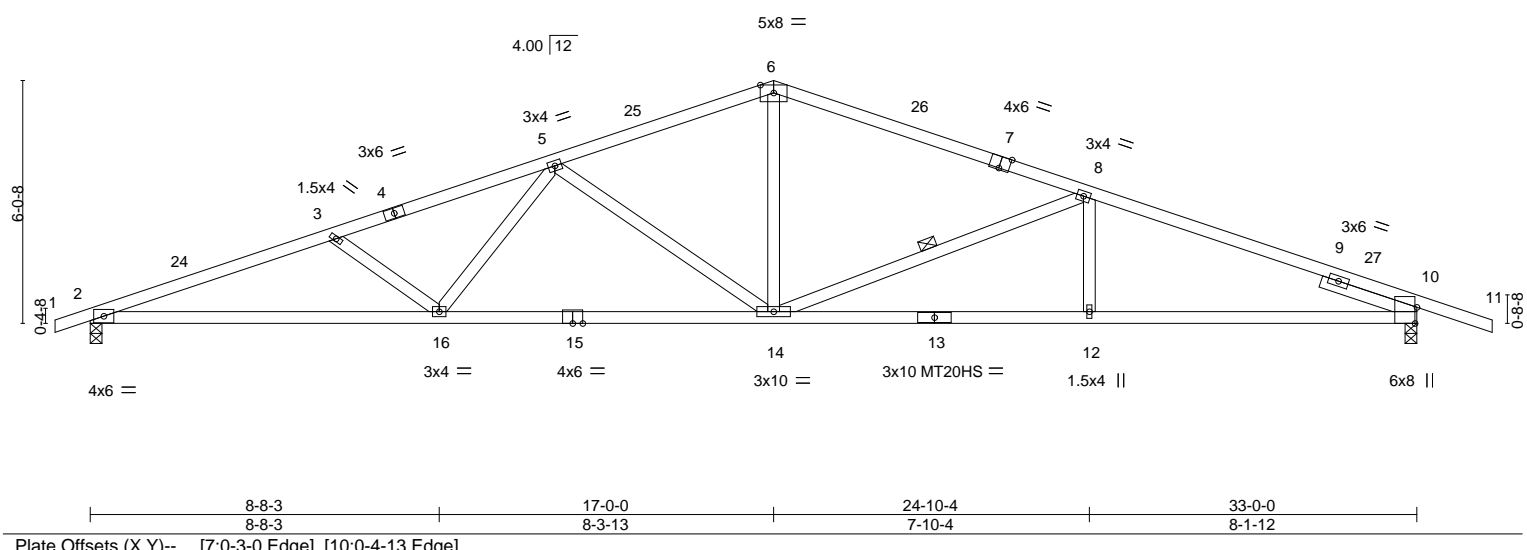

16023 Swingley Ridge Rd
Chesterfield, MO 63017

Job	Truss	Truss Type	Qty	Ply	Summit/161 Highland Meadows	AS NOTED FOR PLAN REVIEW DEVELOPMENT SERVICES LEE'S SUMMIT, MISSOURI
3564895	A7	Hip	1	1	Job Reference (optional)	

Builders FirstSource (Valley Center),	Valley Center, KS - 67147,	8.630 s Nov 19 2022 MiTek Industries, Inc.	Thu Jun 8 7 41 26 2023 Page 1
ID:icBMJaMgT1gasuUyx9?RhvzDEHb-RfC?PsB70Hq3NSuPqnL8v3uITxb6KVrC0g174ZICP?			
6-10-1 6-10-1	13-0-0 6-1-15	19-6-0 6-6-0	21-0-0 1-6-0
		25-7-4 4-7-4	30-2-8 4-7-4
			33-0-0 2-9-8
			34-10-8 1-10-8
Scale = 1:59.2			

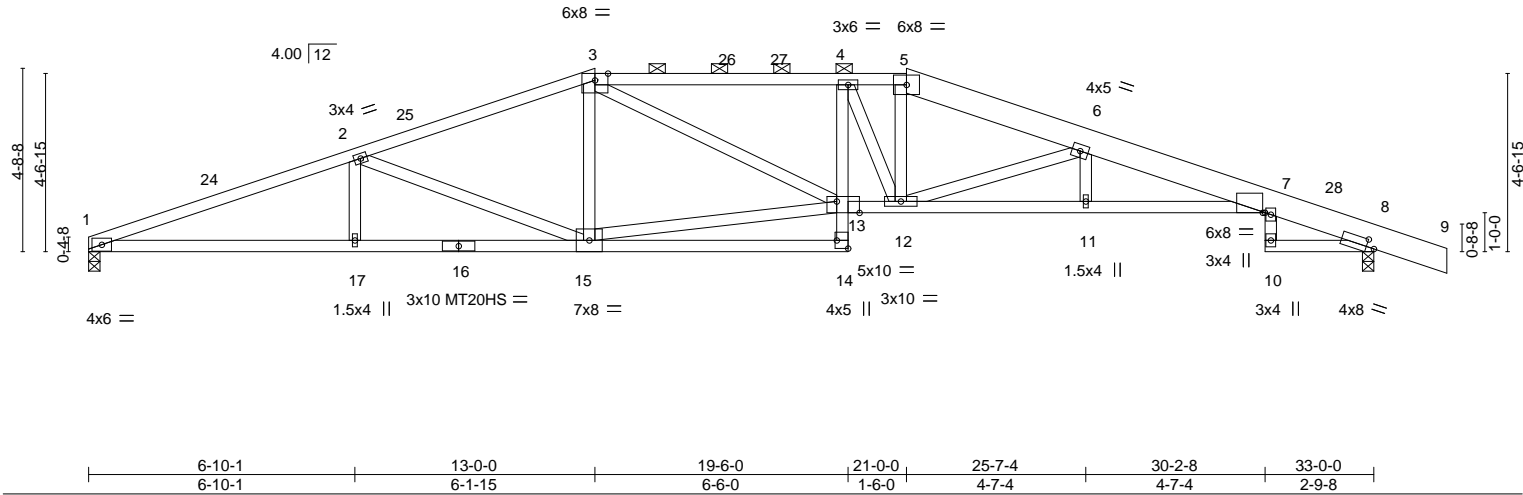


Plate Offsets (X,Y)-- [7:0-0-11,Edge], [8:0-2-7,0-2-5], [13:0-7-0,Edge], [14:Edge,0-3-8]									
LOADING (psf)		SPACING- 2-0-0		CSI.		DEFL. in (loc) l/defl L/d		PLATES	GRIP
TCLL	25.0	Plate Grip DOL	1.15	TC	0.84	Vert(LL)	-0.44 12-13 >903 240	MT20	197/144
TCDL	10.0	Lumber DOL	1.15	BC	0.93	Vert(CT)	-0.79 12-13 >501 180	MT20HS	148/108
BCLL	0.0	Rep Stress Incr	YES	WB	0.73	Horz(CT)	0.35 8 n/a n/a		
BCDL	10.0	Code IRC2018/TPI2014		Matrix-AS				Weight: 160 lb	FT = 20%

LUMBER-	BRACING-
TOP CHORD 2x4 SPF No.2 *Except* 5-9: 2x8 SP 2400F 2.0E	TOP CHORD Structural wood sheathing directly applied, except 2-0-0 oc purlins (2-2-0 max.): 3-5.
BOT CHORD 2x4 SPF No.2 *Except* 7-13: 2x4 SP 2400F 2.0E	BOT CHORD Rigid ceiling directly applied.
WEBS 2x4 SPF No.2	

REACTIONS.	(size) 1=0-3-8, 8=0-3-8 Max Horz 1=-82(LC 17) Max Uplift 1=-239(LC 8), 8=-306(LC 9) Max Grav 1=1481(LC 1), 8=1620(LC 1)
-------------------	--

FORCES. (lb) - Max. Comp./Max. Ten. - All forces 250 (lb) or less except when shown.
TOP CHORD 1-2=-3763/742, 2-3=-2975/627, 3-4=-3587/788, 4-5=-3468/741, 5-6=-3675/749, 6-7=-5115/1003, 7-8=-570/154
BOT CHORD 1-17=-631/3511, 15-17=-631/3511, 14-15=-30/375, 12-13=-607/3586, 11-12=-905/5010, 7-11=-906/5011
WEBS 2-15=-820/224, 13-15=-423/2414, 3-13=-189/1038, 4-12=-429/124, 5-12=-200/1053, 6-12=-1688/366

- NOTES-**
- 1) Unbalanced roof live loads have been considered for this design.
 - 2) Wind: ASCE 7-16; Vult=115mph (3-second gust) Vasd=91mph; TCDL=6.0psf; BCDL=4.2psf; h=15ft; Cat. II; Exp C; Enclosed; MWFRS (envelope) gable end zone and C-C Exterior(2E) 0-0-0 to 3-3-10, Interior(1) 3-3-10 to 13-0-0, Exterior(2R) 13-0-0 to 17-8-0, Interior(1) 17-8-0 to 21-0-0, Exterior(2R) 21-0-0 to 25-7-4, Interior(1) 25-7-4 to 34-10-8 zone; cantilever left and right exposed ; end vertical left and right exposed;C-C for members and forces & MWFRS for reactions shown; Lumber DOL=1.60 plate grip DOL=1.60
 - 3) Provide adequate drainage to prevent water ponding.
 - 4) All plates are MT20 plates unless otherwise indicated.
 - 5) This truss has been designed for a 10.0 psf bottom chord live load nonconcurrent with any other live loads.
 - 6) Provide mechanical connection (by others) of truss to bearing plate capable of withstanding 239 lb uplift at joint 1 and 306 lb uplift at joint 8.
 - 7) This truss is designed in accordance with the 2018 International Residential Code sections R502.11.1 and R802.10.2 and referenced standard ANSI/TPI 1.
 - 8) This truss design requires that a minimum of 7/16" structural wood sheathing be applied directly to the top chord and 1/2" gypsum sheetrock be applied directly to the bottom chord.
 - 9) Graphical purlin representation does not depict the size or the orientation of the purlin along the top and/or bottom chord.




June 12,2023

<p>WARNING - Verify design parameters and READ NOTES ON THIS AND INCLUDED MITEK REFERENCE PAGE MII-7473 rev. 5/19/2020 BEFORE USE.</p> <p>Design valid for use only with MiTek® connectors. This design is based only upon parameters shown, and is for an individual building component, not a truss system. Before use, the building designer must verify the applicability of design parameters and properly incorporate this design into the overall building design. Bracing indicated is to prevent buckling of individual truss web and/or chord members only. Additional temporary and permanent bracing is always required for stability and to prevent collapse with possible personal injury and property damage. For general guidance regarding the fabrication, storage, delivery, erection and bracing of trusses and truss systems, see ANSI/TPI1 Quality Criteria, DSB-89 and BCSI Building Component Safety Information available from Truss Plate Institute, 2670 Crain Highway, Suite 203 Waldorf, MD 20601</p>	<p>MiTek</p> <p>16023 Swingley Ridge Rd Chesterfield, MO 63017</p>
--	---

Job	Truss	Truss Type	Qty	Ply	Summit/161 Highland Meadows	AS NOTED FOR PLAN REVIEW DEVELOPMENT SERVICES LEE'S SUMMIT, MISSOURI
3564895	A8	Hip	1	1	Job Reference (optional)	

Builders FirstSource (Valley Center), Valley Center, KS - 67147, 8.630 s Nov 19 2022 MiTek Industries, Inc. Thu Jun 09 12:47:30 2023 Page 1

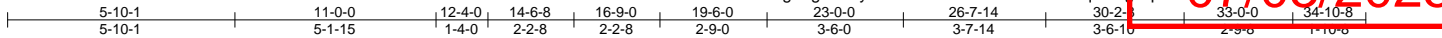

Scale = 1:59.2

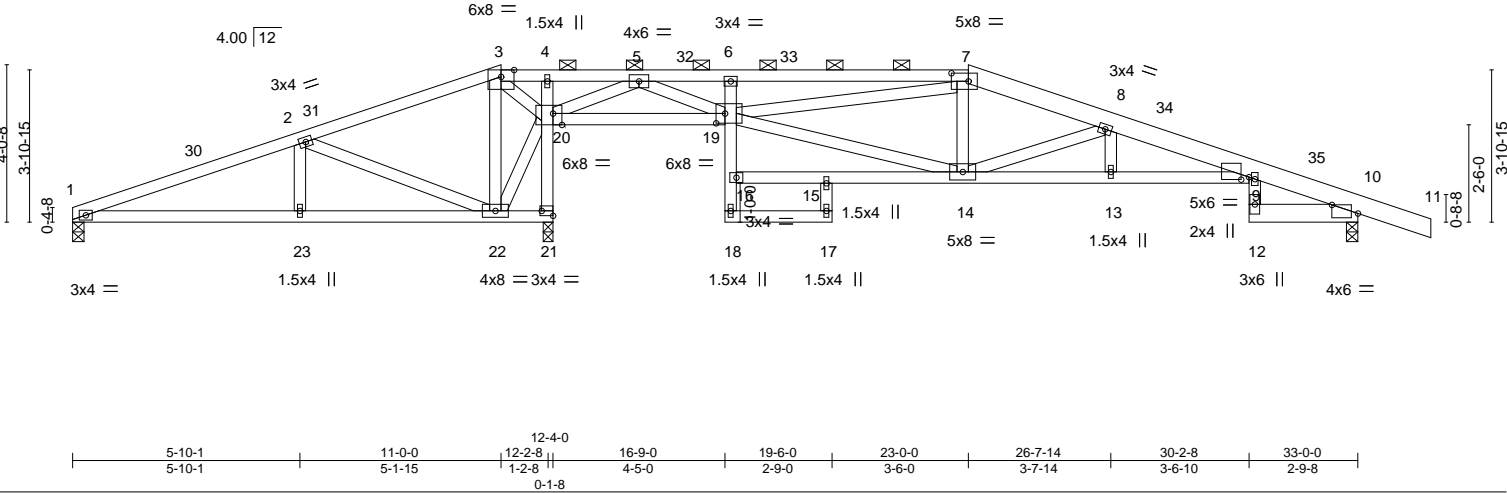


Plate Offsets (X,Y)-- [7:0-5-4,0-2-8], [9:0-2-7,0-0-12], [10:0-8-0,Edge], [19:0-2-12,0-3-0], [20:0-2-12,Edge], [21:Edge,0-1-8]									
LOADING (psf)		SPACING- 2-0-0		CSI.		DEFL. in (loc) l/defl L/d		PLATES GRIP	
TCLL	25.0	Plate Grip DOL	1.15	TC	0.78	Vert(LL)	-0.25 9-13 >984	240	MT20 197/144
TCDL	10.0	Lumber DOL	1.15	BC	0.81	Vert(CT)	-0.46 9-13 >540	180	
BCLL	0.0	Rep Stress Incr	YES	WB	0.45	Horz(CT)	0.11 10 n/a	n/a	
BCDL	10.0	Code IRC2018/TPI2014		Matrix-AS					
								Weight: 144 lb	FT = 20%

LUMBER-	BRACING-
TOP CHORD 2x4 SPF No.2 *Except* 7-11: 2x6 SPF 2100F 1.8E	TOP CHORD Structural wood sheathing directly applied, except 2-0-0 oc purlins (5-2-1 max.): 3-7.
BOT CHORD 2x4 SPF No.2 *Except* 9-16: 2x4 SPF 1650F 1.5E, 10-12: 2x6 SPF No.2	BOT CHORD Rigid ceiling directly applied.
WEBS 2x4 SPF No.2	

REACTIONS.	(size) 1=0-3-8, 21=0-3-0, 10=0-3-8 Max Horz 1=-69(LC 17) Max Uplift 1=-93(LC 12), 21=-283(LC 8), 10=-227(LC 9) Max Grav 1=347(LC 25), 21=1885(LC 1), 10=930(LC 26)
------------	---

FORCES.	(lb) - Max. Comp./Max. Ten. - All forces 250 (lb) or less except when shown.
TOP CHORD	1-2=-441/298, 2-3=-32/682, 3-4=-414/2550, 4-5=-430/2578, 5-6=-988/222, 6-7=-1056/282, 7-8=-1437/331, 8-9=-2369/503, 9-10=-410/114
BOT CHORD	1-23=-260/387, 22-23=-260/387, 20-21=-1902/332, 19-20=-747/204, 6-19=-335/127, 13-14=-423/2334, 9-13=-423/2335, 9-12=-45/319
WEBS	2-22=-864/203, 3-22=-302/1450, 20-22=-1331/316, 3-20=-2707/569, 7-14=-12/260, 8-14=-1076/251, 5-20=-2026/414, 5-19=-301/1830, 14-19=-191/1252, 7-19=-338/114

- NOTES-
- 1) Unbalanced roof live loads have been considered for this design.
 - 2) Wind: ASCE 7-16; Vult=115mph (3-second gust) Vasd=91mph; TCDL=6.0psf; BCDL=4.2psf; h=15ft; Cat. II; Exp C; Enclosed; MWFRS (envelope) gable end zone and C-C Exterior(2E) 0-0-0 to 3-3-10, Interior(1) 3-3-10 to 11-0-0, Exterior(2R) 11-0-0 to 15-8-0, Interior(1) 15-8-0 to 23-0-0, Exterior(2R) 23-0-0 to 27-8-0, Interior(1) 27-8-0 to 34-10-8 zone; cantilever left and right exposed ; end vertical left and right exposed;C-C for members and forces & MWFRS for reactions shown; Lumber DOL=1.60 plate grip DOL=1.60
 - 3) Provide adequate drainage to prevent water ponding.
 - 4) This truss has been designed for a 10.0 psf bottom chord live load nonconcurrent with any other live loads.
 - 5) Provide mechanical connection (by others) of truss to bearing plate capable of withstanding 93 lb uplift at joint 1, 283 lb uplift at joint 21 and 227 lb uplift at joint 10.
 - 6) This truss is designed in accordance with the 2018 International Residential Code sections R502.11.1 and R802.10.2 and referenced standard ANSI/TPI 1.
 - 7) This truss design requires that a minimum of 7/16" structural wood sheathing be applied directly to the top chord and 1/2" gypsum sheetrock be applied directly to the bottom chord.
 - 8) Graphical purlin representation does not depict the size or the orientation of the purlin along the top and/or bottom chord.





June 12, 2023

07/03/2023

8.630 s Nov 19 2022 MiTek Industries, Inc. Thu Jun 8 14:12:50 2023 Page 1

ID:icBMJaMgT1gasuUyx9?RhvzDEHb-RfC?PsB70Hq3NSgPqnL8w3uITXbGKWrcDci7J4zJC?f

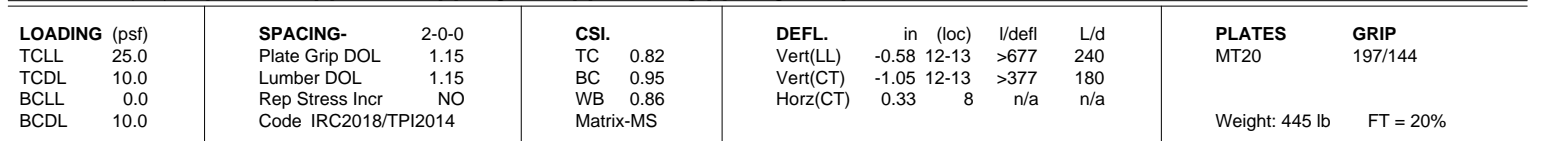 

TOP CHORD	Structural wood sheathing directly applied or 6-0-0 oc purlins, except 2-0-0 oc purlins (5-10-8 max.): 2-5.
BOT CHORD	Rigid ceiling directly applied or 10-0-0 oc bracing.

FORCES. (lb) - Max. Comp./Max. Ten. - All forces 250 (lb) or less except when shown.

TOP CHORD 1-2=-10084/2273, 2-3=-11591/2700, 3-4=-16697/3842, 4-5=-17203/3957,
5-6=-14118/3202, 6-7=-1082/306, 7-8=-1211/319

BOT CHORD 1-17=-2114/9530, 15-17=-2102/9461, 14-15=-315/1398, 13-14=-129/614, 4-13=-289/166,
12-13=-3003/13692, 6-12=-3003/13692

WEBS 2-17=-252/1433, 2-15=-677/2682, 3-15=-2455/606, 13-15=-2376/10505, 3-13=-1211/5336,
5-13=-932/3887, 5-12=-390/1845, 7-10=-47/298

- 1) 3-ply truss to be connected together with 10d (0.131"x3") nails as follows:
 Top chords connected as follows: 2x4 - 1 row at 0-7-0 oc, 2x8 - 2 rows staggered at 0-9-0 oc.
 Bottom chords connected as follows: 2x4 - 2 rows staggered at 0-7-0 oc.
 Webs connected as follows: 2x4 - 1 row at 0-9-0 oc.
- 2) All loads are considered equally applied to all plies, except if noted as front (F) or back (B) face in the LOAD CASE(S) section. Ply to ply connections have been provided to distribute only loads noted as (F) or (B), unless otherwise indicated.
- 3) Unbalanced roof live loads have been considered for this design.
- 4) Wind: ASCE 7-16; Vult=15mph (3-second gust) Vasd=91mph; TCdL=6.0psf; BCDL=4.2psf; h=15ft; Cat. II; Exp C; Enclosed; MWFRS (envelope) gable end zone; cantilever left and right exposed ; end vertical left and right exposed; Lumber DOL=1.60 plate grip DOL=1.60
- 5) Provide adequate drainage to prevent water ponding.
- 6) This truss has been designed for a 10.0 psf bottom chord live load nonconcurrent with any other live loads.
- 7) Provide mechanical connection (by others) of truss to bearing plate capable of withstanding 860 lb uplift at joint 1 and 888 lb uplift at joint 8.
- 8) This truss is designed in accordance with the 2018 International Residential Code sections R502.11.1 and R802.10.2 and referenced standard ANSI/TPI 1.
- 9) Graphical purlin representation does not depict the size or the orientation of the purlin along the top and/or bottom chord.



 WARNING - Verify design parameters and READ NOTES ON THIS AND INCLUDED MITEK REFERENCE PAGE MII-7473 rev. 5/19/2020 BEFORE USE

Before use, the building designer must verify the applicability of design parameters and properly incorporate this design into the overall building design. Bracing indicated is to prevent buckling of individual truss web and/or chord members only. Additional temporary and permanent bracing is always required for stability and to prevent collapse with possible personal injury and property damage. For general guidance regarding the fabrication, storage, delivery, erection and bracing of trusses and truss systems, see **ANSI/TPI1 Quality Criteria, DSB-89 and BCSI Building Component Safety Information** available from Truss Plate Institute, 2670 Crain Highway, Suite 203 Waldorf, MD 20601



16023 Swingley Ridge Rd
Chesterfield, MO 63017

Job	Truss	Truss Type	Qty	Ply	Summit/161 Highland Meadows	RELEASE FOR CONSTRUCTION
3564895	A9	HIP GIRDER	1	3	Job Reference (optional)	AS NOTED FOR PLAN REVIEW DEVELOPMENT SERVICES LEE'S SUMMIT, MISSOURI

Builders FirstSource (Valley Center), Valley Center, KS - 67147,

8.630 s Nov 19 2022 MiTek Industries, Inc. Thu Jun 07 12:50:30 2023 Page 2

ID:icBMJaMgT1gasuUyx9?RhvzDEHb-RfC?PsB70Hq3NSqPqnL8v3uITxb6KVrCm7J4ZIC?P

NOTES-

- 10) Hanger(s) or other connection device(s) shall be provided sufficient to support concentrated load(s) 379 lb down and 89 lb up at 3-0-12, 323 lb down and 79 lb up at 5-0-12, 323 lb down and 79 lb up at 7-0-12, 323 lb down and 100 lb up at 9-0-12, 323 lb down and 100 lb up at 11-0-12, 323 lb down and 100 lb up at 13-0-12, 323 lb down and 100 lb up at 15-0-12, 323 lb down and 100 lb up at 17-0-0, 323 lb down and 100 lb up at 18-11-4, 323 lb down and 99 lb up at 20-11-4, and 323 lb down and 99 lb up at 22-11-4, and 989 lb down and 281 lb up at 24-11-4 on bottom chord. The design/selection of such connection device(s) is the responsibility of others.


LOAD CASE(S) Standard

- 1) Dead + Roof Live (balanced): Lumber Increase=1.15, Plate Increase=1.15
Uniform Loads (plf)
Vert: 1-2=-70, 2-5=-70, 5-9=-70, 14-18=-20, 13-21=-20, 11-24=-20
Concentrated Loads (lb)
Vert: 17=-323(F) 12=-989(F) 27=-379(F) 28=-323(F) 29=-323(F) 30=-323(F) 31=-323(F) 32=-323(F) 33=-323(F) 34=-323(F) 35=-323(F) 36=-323(F)

Job	Truss	Truss Type	Qty	Ply	Summit/161 Highland Meadows	RELEASE FOR CONSTRUCTION
3564895	B1	Roof Special	1	1		AS NOTED FOR PLAN REVIEW
					Job Reference (optional)	DEVELOPMENT SERVICES

Builders FirstSource (Valley Center), Valley Center, KS - 67147, 8.630 s Nov 19 2022 MiTek Industries, Inc. Thu Jun 8 7 41 25 2023 Page 1 of 1
ID:icBMJaMgT1gasuUyx9?RhvzDEHb-RfC?PsB70Hq3NSjPqnL8v3uITxb6KVrCg7i74ZICP
1-10-8 1-10-4 6-3-8 10-8-12 12-4-12 18-0-0 25-10-4 34-0-0 35-10-8
1-10-8 1-10-4 4-5-4 4-5-4 1-8-0 5-7-4 7-10-4 8-1-12 1-10-8

Scale: 3/16"=1'

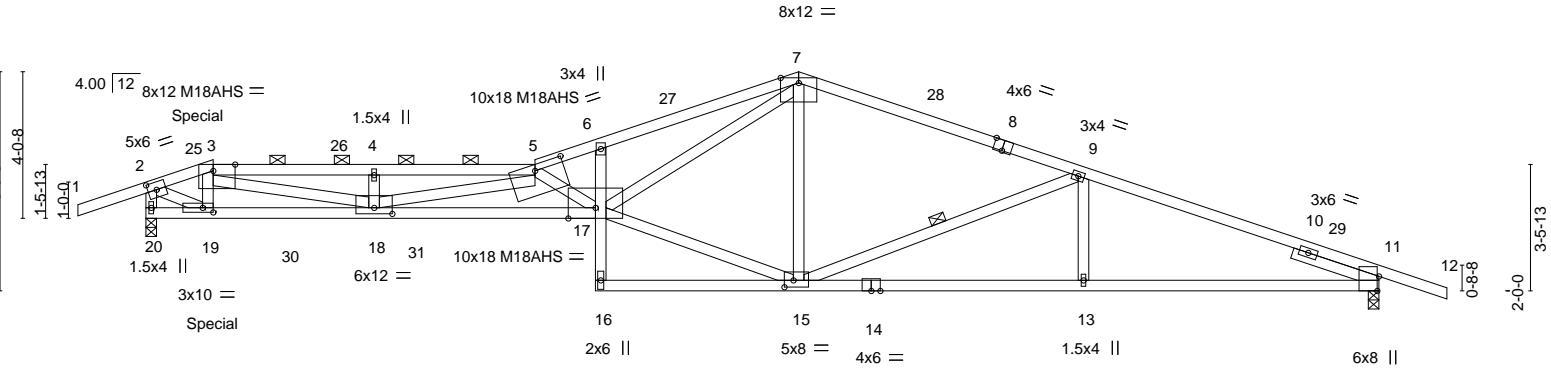

		1-10-4	6-3-8	10-8-12	12-4-12	18-0-0	25-10-4			34-0-0				
		1-10-4	4-5-4	4-5-4	1-8-0	5-7-4	7-10-4			8-1-12				
Plate Offsets (X,Y)--		[2:0-2-14,0-2-8], [3:0-7-4,Edge], [5:0-9-8,0-2-0], [8:0-3-0,Edge], [11:0-4-13,Edge], [15:0-3-0,0-2-4], [18:0-6-0,0-2-0], [19:0-3-8,0-1-8]												
LOADING	(psf)	SPACING-		2-0-0		CSI.		DEFL.		in (loc)	l/defl	L/d	PLATES	GRIP
TCLL	25.0	Plate Grip DOL		1.15		TC	0.82	Vert(LL)	-0.80	17	>511	240	MT20	197/144
TCDL	10.0	Lumber DOL		1.15		BC	0.89	Vert(CT)	-1.43	17-18	>284	180	M18AHS	142/136
BCLL	0.0	Rep Stress Incr		YES		WB	0.72	Horz(CT)	0.26	11	n/a	n/a		
BCDL	10.0	Code IRC2018/TPI2014				Matrix-AS								
												Weight: 144 lb		FT = 20%

LUMBER-		BRACING-	
TOP CHORD	2x4 SPF 1650F 1.5E *Except* 1-3: 2x4 SPF No.2	TOP CHORD	Structural wood sheathing directly applied, except end verticals, and 2-0-0 oc purlins (2-2-0 max.): 3-5.
BOT CHORD	2x4 SPF No.2 *Except* 17-20: 2x4 SP 2400F 2.0E, 11-14: 2x4 SPF 1650F 1.5E	BOT CHORD	Rigid ceiling directly applied.
WEBS	2x4 SPF No.2 *Except* 7-17,5-18,3-18: 2x4 SPF 1650F 1.5E	WEBS	1 Row at midpt 9-15
SLIDER	Right 2x4 SPF No.2 2-6-0		
REACTIONS.			
(size) 20=0-3-8, 11=0-3-8			
Max Horz 20=-129(LC 45)			
Max Uplift 20=-306(LC 8), 11=-288(LC 9)			
Max Grav 20=1634(LC 1), 11=1652(LC 1)			

FORCES. (lb) - Max. Comp./Max. Ten. - All forces 250 (lb) or less except when shown.	
TOP CHORD	2-3=-1960/352, 3-4=-6205/1091, 4-5=-6205/1091, 5-6=-6524/1139, 6-7=-6304/1175, 7-9=-2485/508, 9-11=-3274/597, 2-20=-1659/387
BOT CHORD	18-19=-259/1956, 17-18=-1381/8544, 13-15=-481/3036, 11-13=-481/3036
WEBS	3-19=-779/152, 5-17=-2949/550, 15-17=-290/2233, 7-17=-770/4454, 7-15=-309/112, 9-15=-912/244, 9-13=0/281, 2-19=-380/2120, 4-18=-474/142, 5-18=-2519/510, 3-18=-783/4412

- NOTES-**
- Unbalanced roof live loads have been considered for this design.
 - Wind: ASCE 7-16; Vult=115mph (3-second gust) Vasd=91mph; TCDL=6.0psf; BCDL=4.2psf; h=15ft; Cat. II; Exp C; Enclosed; MWFRS (envelope) gable end zone and C-C Exterior(2E) -1-10-8 to 1-6-5, Interior(1) 1-6-5 to 1-10-4, Exterior(2E) 1-10-4 to 5-3-1, Interior(1) 5-3-1 to 18-0-0, Exterior(2R) 18-0-0 to 21-4-13, Interior(1) 21-4-13 to 35-10-8 zone; cantilever left and right exposed ; end vertical left and right exposed;C-C for members and forces & MWFRS for reactions shown; Lumber DOL=1.60 plate grip DOL=1.60
 - Provide adequate drainage to prevent water ponding.
 - All plates are MT20 plates unless otherwise indicated.
 - This truss has been designed for a 10.0 psf bottom chord live load nonconcurrent with any other live loads.
 - Provide mechanical connection (by others) of truss to bearing plate capable of withstanding 306 lb uplift at joint 20 and 288 lb uplift at joint 11.
 - This truss is designed in accordance with the 2018 International Residential Code sections R502.11.1 and R802.10.2 and referenced standard ANSI/TPI 1.
 - This truss design requires that a minimum of 7/16" structural wood sheathing be applied directly to the top chord and 1/2" gypsum sheetrock be applied directly to the bottom chord.
 - Graphical purlin representation does not depict the size or the orientation of the purlin along the top and/or bottom chord.
 - Hanger(s) or other connection device(s) shall be provided sufficient to support concentrated load(s) 64 lb down and 167 lb up at 1-10-4 on top chord, and 25 lb down and 32 lb up at 1-10-4, 22 lb down and 31 lb up at 1-11-0, and 22 lb down and 31 lb up at 3-11-0, and 22 lb down and 31 lb up at 5-11-0 on bottom chord. The design/selection of such connection device(s) is the responsibility of others.



June 12, 2023

WARNING - Verify design parameters and READ NOTES ON THIS AND INCLUDED MITEK REFERENCE PAGE MII-7473 rev. 5/19/2020 BEFORE USE.
Design valid for use only with MiTek® connectors. This design is based only upon parameters shown, and is for an individual building component, not a truss system. Before use, the building designer must verify the applicability of design parameters and properly incorporate this design into the overall building design. Bracing indicated is to prevent buckling of individual truss web and/or chord members only. Additional temporary and permanent bracing is always required for stability and to prevent collapse with possible personal injury and property damage. For general guidance regarding the fabrication, storage, delivery, erection and bracing of trusses and truss systems, see **ANSI/TPI1 Quality Criteria, DSB-89 and BCSI Building Component Safety Information** available from Truss Plate Institute, 2670 Crain Highway, Suite 203 Waldorf, MD 20601

MiTek
16023 Swingley Ridge Rd
Chesterfield, MO 63017

Job	Truss	Truss Type	Qty	Ply	Summit/161 Highland Meadows	RELEASE FOR CONSTRUCTION
3564895	B1	Roof Special	1	1	Job Reference (optional)	AS NOTED FOR PLAN REVIEW DEVELOPMENT SERVICES LEE'S SUMMIT, MISSOURI

Builders FirstSource (Valley Center),
Valley Center, KS - 67147,
8.630 s Nov 19 2022 MiTek Industries, Inc.
Thu Jun 8 14:12:52 2023 Page 2
ID:icBMJaMgT1gasuUyx9?RhvzDEHb-RfC?PsB70Hq3NSqPqnL8v3uITxbS KV rCj d7 J4ZlIC?

07/03/2023

NOTES-
 11) In the LOAD CASE(S) section, loads applied to the face of the truss are noted as front (F) or back (B).


LOAD CASE(S) Standard
 1) Dead + Roof Live (balanced): Lumber Increase=1.15, Plate Increase=1.15
 Uniform Loads (plf)
 Vert: 1-2=-70, 2-3=-70, 3-5=-70, 5-7=-70, 7-12=-70, 17-20=-20, 16-21=-20
 Concentrated Loads (lb)
 Vert: 3=33(F)

Job	Truss	Truss Type	Qty	Ply	Summit/161 Highland Meadows	AS NOTED FOR PLAN REVIEW DEVELOPMENT SERVICES LEE'S SUMMIT, MISSOURI
3564895	B1A	Roof Special	1	1	Job Reference (optional)	


Builders FirstSource (Valley Center), Valley Center, KS - 67147,

8.630 s Nov 19 2022 MiTek Industries, Inc. Thu Jun 8 7 41 25 2023 Page 1

ID:icBMJaMgT1gasuUyx9?RhvzDEHb-RfC?PsB70Hq3NSyPqnL8v3uITxb6KVrCg7i74ZICP

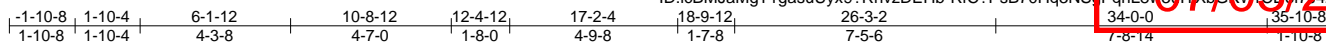

Scale = 1:65.7

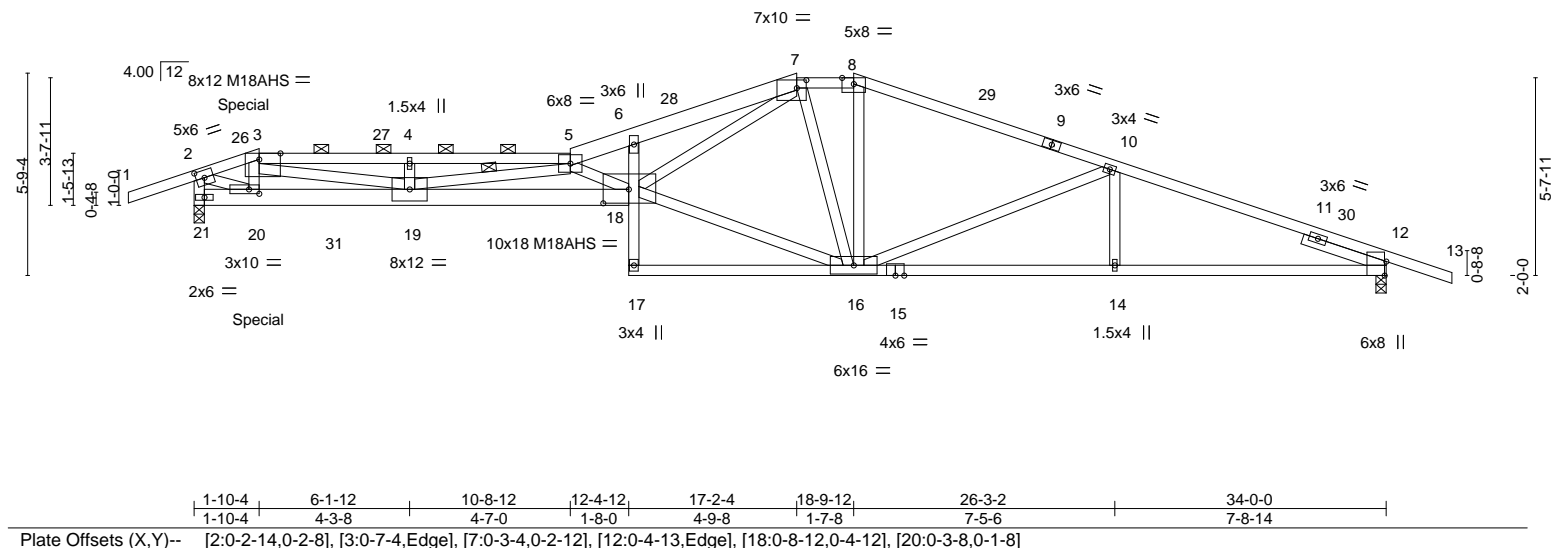

LOADING (psf)	SPACING-	2-0-0	CSI.	DEFL.	in	(loc)	l/defl	L/d	PLATES	GRIP
TCLL 25.0	Plate Grip DOL	1.15	TC 0.90	Vert(LL)	-0.76	17	>537	240	MT20	197/144
TCDL 10.0	Lumber DOL	1.15	BC 0.86	Vert(CT)	-1.36	17	>299	180	M18AHS	142/136
BCLL 0.0	Rep Stress Incr	YES	WB 1.00	Horz(CT)	0.24	12	n/a	n/a		
BCDL 10.0	Code IRC2018/TPI2014		Matrix-AS						Weight: 156 lb	FT = 20%

LUMBER-

TOP CHORD 2x4 SPF No.2 *Except*
3-5,9-13: 2x4 SPF 1650F 1.5E, 5-7: 2x6 SPF No.2
BOT CHORD 2x4 SPF No.2 *Except*
18-21: 2x6 SPF 2100F 1.8E, 12-15: 2x4 SPF 1650F 1.5E
WEBS 2x4 SPF No.2 *Except*
7-18: 2x4 SPF 1650F 1.5E
SLIDER Right 2x4 SPF No.2 2-6-0

BRACING-

TOP CHORD Structural wood sheathing directly applied, except end verticals, and 2-0-0 oc purlins (2-2-0 max.): 3-5, 7-8.
BOT CHORD Rigid ceiling directly applied.
WEBS 1 Row at midpt 5-19

REACTIONS.

(size) 12=0-3-8, 21=0-3-8
Max Horz 21=-125(LC 13)
Max Uplift 12=-293(LC 9), 21=-311(LC 8)
Max Grav 12=1652(LC 1), 21=1634(LC 1)

FORCES. (lb) - Max. Comp./Max. Ten. - All forces 250 (lb) or less except when shown.

TOP CHORD 2-3=-2275/418, 3-4=-6176/1118, 4-5=-6174/1116, 5-6=-6932/1266, 6-7=-6721/1294,
7-8=-2391/539, 8-10=-2592/540, 10-12=-3277/606, 2-21=-1753/409
BOT CHORD 19-20=-292/2232, 18-19=-1608/9407, 14-16=-492/3040, 12-14=-492/3040
WEBS 3-20=-541/110, 5-18=-3411/650, 8-16=-43/488, 10-16=-787/223, 10-14=0/258,
2-20=-434/2323, 4-19=-404/130, 3-19=-727/4085, 7-16=-919/174, 5-19=-3379/674,
16-18=-367/2559, 7-18=-818/4563

NOTES-

- Unbalanced roof live loads have been considered for this design.
- Wind: ASCE 7-16; Vult=115mph (3-second gust) Vasd=91mph; TCDL=6.0psf; BCDL=4.2psf; h=15ft; Cat. II; Exp C; Enclosed; MWFRS (envelope) gable end zone and C-C Exterior(2E) -1-10-8 to 1-6-5, Interior(1) 1-6-5 to 1-10-4, Exterior(2E) 1-10-4 to 5-3-1, Interior(1) 5-3-1 to 17-2-4, Exterior(2E) 17-2-4 to 18-9-12, Exterior(2R) 18-9-12 to 22-2-9, Interior(1) 22-2-9 to 35-10-8 zone; cantilever left and right exposed; end vertical left and right exposed; C-C for members and forces & MWFRS for reactions shown; Lumber DOL=1.60 plate grip DOL=1.60
- Provide adequate drainage to prevent water ponding.
- All plates are MT20 plates unless otherwise indicated.
- The Fabrication Tolerance at joint 18 = 16%
- This truss has been designed for a 10.0 psf bottom chord live load nonconcurrent with any other live loads.
- Bearing at joint(s) 21 considers parallel to grain value using ANSI/TPI 1 angle to grain formula. Building designer should verify capacity of bearing surface.
- Provide mechanical connection (by others) of truss to bearing plate capable of withstanding 293 lb uplift at joint 12 and 311 lb uplift at joint 21.
- This truss is designed in accordance with the 2018 International Residential Code sections R502.11.1 and R802.10.2 and referenced standard ANSI/TPI 1.
- This truss design requires that a minimum of 7/16" structural wood sheathing be applied directly to the top chord and 1/2" gypsum sheetrock be applied directly to the bottom chord.

On the ground plane representation does not depict the size or the orientation of the purlin along the top and/or bottom chord.



June 12, 2023

WARNING - Verify design parameters and READ NOTES ON THIS AND INCLUDED MITEK REFERENCE PAGE MII-7473 rev. 5/19/2020 BEFORE USE.

Design valid for use only with MiTek® connectors. This design is based only upon parameters shown, and is for an individual building component, not a truss system. Before use, the building designer must verify the applicability of design parameters and properly incorporate this design into the overall building design. Bracing indicated is to prevent buckling of individual truss web and/or chord members only. Additional temporary and permanent bracing is always required for stability and to prevent collapse with possible personal injury and property damage. For general guidance regarding the fabrication, storage, delivery, erection and bracing of trusses and truss systems, see

ANSI/TPI1 Quality Criteria, DSB-89 and BCSI Building Component**Safety Information** available from Truss Plate Institute, 2670 Crain Highway, Suite 203 Waldorf, MD 2060116023 Swingley Ridge Rd
Chesterfield, MO 63117

Job	Truss	Truss Type	Qty	Ply	Summit/161 Highland Meadows	RELEASE FOR CONSTRUCTION
3564895	B1A	Roof Special	1	1	Job Reference (optional)	AS NOTED FOR PLAN REVIEW DEVELOPMENT SERVICES LEE'S SUMMIT, MISSOURI

Builders FirstSource (Valley Center), Valley Center, KS - 67147,

8.630 s Nov 19 2022 MiTek Industries, Inc. Thu Jun 8 12:55:30 2023 Page 2

ID:icBMJaMgT1gasuUyx9?RhvzDEHb-RfC?PsB70Hq3NSqPqnL8v3uITxbS KV rCj d7 J4ZICP

NOTES-

- Hanger(s) or other connection device(s) shall be provided sufficient to support concentrated load(s) 64 lb down and 167 lb up at 1-10-4 on top chord, and 25 lb down and 32 lb up at 1-10-4, 22 lb down and 31 lb up at 1-11-0, and 22 lb down and 31 lb up at 3-11-0, and 22 lb down and 31 lb up at 5-11-0 on bottom chord. The design/selection of such connection device(s) is the responsibility of others.
- In the LOAD CASE(S) section, loads applied to the face of the truss are noted as front (F) or back (B).

LOAD CASE(S) Standard

- Dead + Roof Live (balanced): Lumber Increase=1.15, Plate Increase=1.15
 - Uniform Loads (plf)
 - Vert: 1-2=-70, 2-3=-70, 3-5=-70, 5-7=-70, 7-8=-70, 8-13=-70, 18-21=-20, 17-22=-20
 - Concentrated Loads (lb)
 - Vert: 3=33(B)

 **WARNING - Verify design parameters and READ NOTES ON THIS AND INCLUDED MITEK REFERENCE PAGE MII-7473 rev. 5/19/2020 BEFORE USE.**

Design valid for use only with MiTek® connectors. This design is based only upon parameters shown, and is for an individual building component, not a truss system. Before use, the building designer must verify the applicability of design parameters and properly incorporate this design into the overall building design. Bracing indicated is to prevent buckling of individual truss web and/or chord members only. Additional temporary and permanent bracing is always required for stability and to prevent collapse with possible personal injury and property damage. For general guidance regarding the fabrication, storage, delivery, erection and bracing of trusses and truss systems, see **ANSI/TPI1 Quality Criteria, DSB-89 and BCSI Building Component Safety Information** available from Truss Plate Institute, 2670 Crain Highway, Suite 203 Waldorf, MD 20601



16023 Swingley Ridge Rd
Chesterfield, MO 63017

Job	Truss	Truss Type	Qty	Ply	Summit/161 Highland Meadows	AS NOTED FOR PLAN REVIEW DEVELOPMENT SERVICES LEE'S SUMMIT, MISSOURI
3564895	B2	Roof Special	2	1	Job Reference (optional)	


Builders FirstSource (Valley Center), Valley Center, KS - 67147,

8.630 s Nov 19 2022 MiTek Industries, Inc. Thu Jun 8 7 47 12 PM 2023 Page 1

ID:icBMJaMgT1gasuUyx9?RhvzDEHb-RfC?PsB70Hq3NSpPqnL8v3uITxb6KVrCg17J4ZICP

-1-10-8	3-10-4	8-1-8	8-3-8	12-4-12	12-8-12	18-0-0	25-10-4	34-0-0	35-10-8
1-10-8	3-10-4	4-3-4	0-2-0	4-1-4	0-4-0	5-3-4	7-10-4	8-1-12	1-10-8

Scale: 3/16"=1'

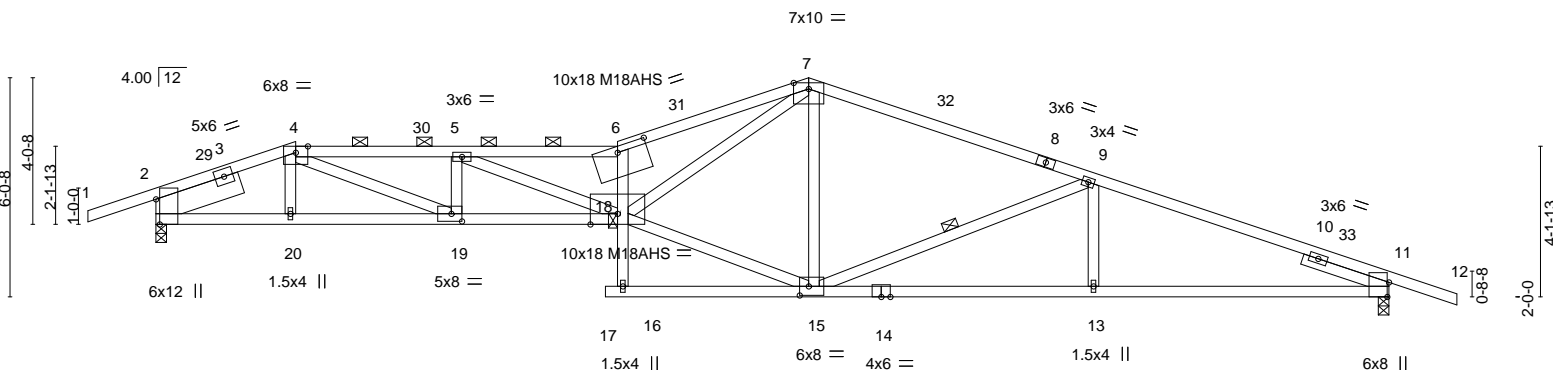

	3-10-4	8-3-8	12-4-12	18-0-0	25-10-4	34-0-0
	3-10-4	4-5-4	4-1-4	5-7-4	7-10-4	8-1-12
Plate Offsets (X,Y)--	[2:0-8-5,Edge], [6:0-9-12,0-2-0], [11:0-4-13,Edge], [15:0-3-0,0-3-0], [19:0-3-8,0-2-8]					

LOADING (psf)	SPACING-	2-0-0	CSI.	DEFL.	in (loc)	l/defl	L/d	PLATES	GRIP
TCLL 25.0	Plate Grip DOL	1.15	TC 0.90	Vert(LL)	-0.65	17	>632	240	MT20
TCDL 10.0	Lumber DOL	1.15	BC 0.96	Vert(CT)	-1.16	17	>351	180	M18AHS
BCLL 0.0	Rep Stress Incr	YES	WB 0.77	Horz(CT)	0.23	11	n/a	n/a	
BCDL 10.0	Code IRC2018/TPI2014		Matrix-AS						
								Weight: 145 lb	FT = 20%

LUMBER-

TOP CHORD 2x4 SPF 1650F 1.5E
 BOT CHORD 2x4 SPF 1650F 1.5E *Except*
 14-17: 2x4 SPF No.2
 WEBS 2x4 SPF No.2 *Except*
 7-18: 2x4 SPF 1650F 1.5E
 SLIDER Left 2x8 SP 2400F 2.0E 2-6-0, Right 2x4 SPF No.2 2-6-0

BRACING-

TOP CHORD Structural wood sheathing directly applied, except
 2-0-0 oc purlins (2-2-14 max.): 4-6.
 BOT CHORD Rigid ceiling directly applied.
 WEBS 1 Row at midpt 6-16, 9-15

REACTIONS.

(size) 2=0-3-8, 11=0-3-8
 Max Horz 2=-142(LC 13)
 Max Uplift 2=-297(LC 8), 11=-282(LC 9)
 Max Grav 2=1665(LC 1), 11=1664(LC 1)

FORCES. (lb) - Max. Comp./Max. Ten. - All forces 250 (lb) or less except when shown.

TOP CHORD 2-4=-2763/501, 4-5=-5191/936, 5-6=-6300/1124, 6-7=-6559/1205, 7-9=-2529/510,
 9-11=-3303/603
 BOT CHORD 2-20=-326/2531, 19-20=-330/2540, 18-19=-787/5188, 13-15=-487/3063, 11-13=-487/3063
 WEBS 6-18=-2298/472, 7-15=-344/113, 9-15=-894/240, 9-13=0/275, 15-18=-312/2349,
 7-18=-786/4713, 5-19=-1025/241, 4-19=-504/2885, 5-18=-217/1203

NOTES-

- Unbalanced roof live loads have been considered for this design.
- Wind: ASCE 7-16; Vult=115mph (3-second gust) Vasd=91mph; TCDL=6.0psf; BCDL=4.2psf; h=15ft; Cat. II; Exp C; Enclosed; MWFRS (envelope) gable end zone and C-C Exterior(2E) -1-10-8 to 1-6-5, Interior(1) 1-6-5 to 3-10-4, Exterior(2R) 3-10-4 to 7-3-1, Interior(1) 7-3-1 to 18-0-0, Exterior(2R) 18-0-0 to 21-4-13, Interior(1) 21-4-13 to 35-10-8 zone; cantilever left and right exposed; end vertical left and right exposed; C-C for members and forces & MWFRS for reactions shown; Lumber DOL=1.60 plate grip DOL=1.60
- Provide adequate drainage to prevent water ponding.
- All plates are MT20 plates unless otherwise indicated.
- This truss has been designed for a 10.0 psf bottom chord live load nonconcurrent with any other live loads.
- Provide mechanical connection (by others) of truss to bearing plate capable of withstanding 297 lb uplift at joint 2 and 282 lb uplift at joint 11.
- This truss is designed in accordance with the 2018 International Residential Code sections R502.11.1 and R802.10.2 and referenced standard ANSI/TPI 1.
- This truss design requires that a minimum of 7/16" structural wood sheathing be applied directly to the top chord and 1/2" gypsum sheetrock be applied directly to the bottom chord.
- Graphical purlin representation does not depict the size or the orientation of the purlin along the top and/or bottom chord.



June 12, 2023

WARNING - Verify design parameters and READ NOTES ON THIS AND INCLUDED MITEK REFERENCE PAGE MII-7473 rev. 5/19/2020 BEFORE USE.

Design valid for use only with MiTek® connectors. This design is based only upon parameters shown, and is for an individual building component, not a truss system. Before use, the building designer must verify the applicability of design parameters and properly incorporate this design into the overall building design. Bracing indicated is to prevent buckling of individual truss web and/or chord members only. Additional temporary and permanent bracing is always required for stability and to prevent collapse with possible personal injury and property damage. For general guidance regarding the fabrication, storage, delivery, erection and bracing of trusses and truss systems, see **ANSI/TPI1 Quality Criteria, DSB-89 and BCSI Building Component Safety Information** available from Truss Plate Institute, 2670 Crain Highway, Suite 203 Waldorf, MD 20601




16023 Swingley Ridge Rd
 Chesterfield, MO 63017

Job	Truss	Truss Type	Qty	Ply	Summit/161 Highland Meadows	AS NOTED FOR PLAN REVIEW DEVELOPMENT SERVICES LEE'S SUMMIT, MISSOURI
3564895	B3	Roof Special	1	1	Job Reference (optional)	


Builders FirstSource (Valley Center), Valley Center, KS - 67147,

8.630 s Nov 19 2022 MiTek Industries, Inc. Thu Jun 8 7 41 25 2023 Page 1

ID:icBMJaMgT1gasuUyx9?RhvzDEHb-RfC?PsB70Hq3NSpPqnL8v3uITxb6KVrCg17J4ZICP

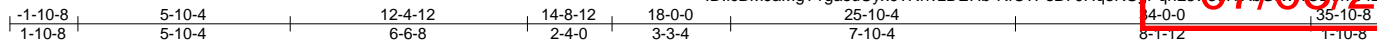

Scale: 3/16"=1'

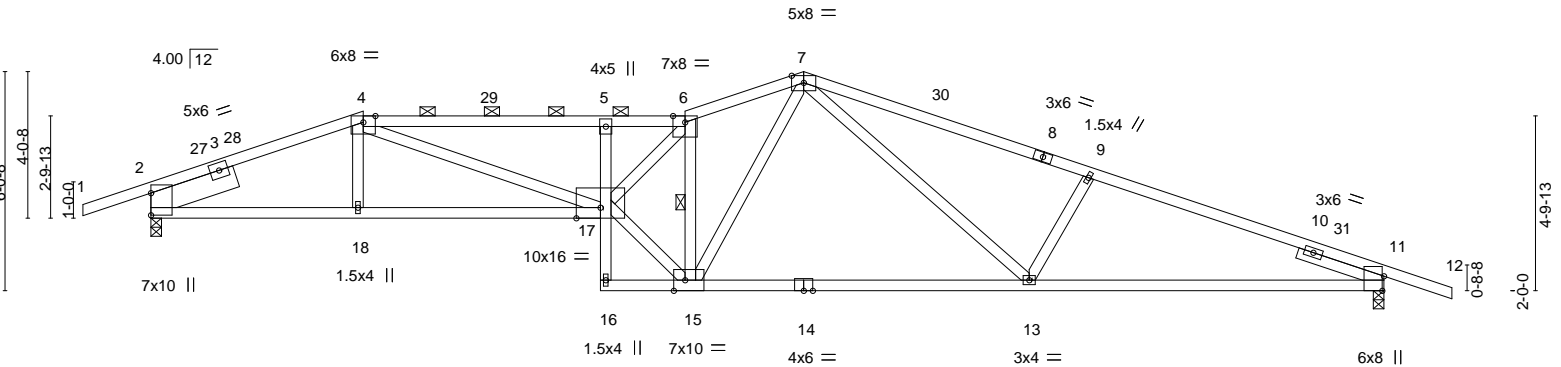

	5-10-4	12-4-12	14-8-12	24-2-10	34-0-0
	5-10-4	6-6-8	2-4-0	9-5-14	9-9-6
Plate Offsets (X,Y)--	[2:Edge,0-0-0], [11:0-4-13,Edge], [15:0-3-12,Edge]				

LOADING (psf)	SPACING-	2-0-0	CSI.	DEFL.	in (loc)	l/defl	L/d	PLATES	GRIP
TCLL 25.0	Plate Grip DOL	1.15	TC 0.87	Vert(LL)	-0.41	5	>999	240	197/144
TCDL 10.0	Lumber DOL	1.15	BC 0.84	Vert(CT)	-0.82	13-15	>495	180	
BCLL 0.0	Rep Stress Incr	YES	WB 0.89	Horz(CT)	0.17	11	n/a	n/a	
BCDL 10.0	Code IRC2018/TPI2014		Matrix-AS						
								Weight: 152 lb	FT = 20%

LUMBER-

TOP CHORD 2x4 SP 2400F 2.0E *Except*

6-7: 2x4 SPF No.2, 7-8,8-12: 2x4 SPF 1650F 1.5E

BOT CHORD 2x4 SPF No.2 *Except*

2-17: 2x4 SP 2400F 2.0E, 11-14: 2x4 SPF 1650F 1.5E

WEBS 2x4 SPF No.2

SLIDER Left 2x8 SP 2400F 2.0E 2-6-0, Right 2x4 SPF No.2 2-6-0

BRACING-

TOP CHORD Structural wood sheathing directly applied, except

2-0-0 oc purlins (2-7-15 max.): 4-6.

BOT CHORD Rigid ceiling directly applied.

WEBS 1 Row at midpt 6-15

REACTIONS. (size) 2=0-3-8, 11=0-3-8

Max Horz 2=-142(LC 13)

Max Uplift 2=-299(LC 8), 11=-281(LC 9)

Max Grav 2=1661(LC 1), 11=1661(LC 1)

FORCES. (lb) - Max. Comp./Max. Ten. - All forces 250 (lb) or less except when shown.

TOP CHORD 2-4=-2987/552, 4-5=-4870/919, 5-6=-4746/897, 6-7=-2916/623, 7-9=-3088/620, 9-11=-3299/625

BOT CHORD 2-18=-367/2755, 17-18=-371/2756, 5-17=-615/187, 13-15=-325/2265, 11-13=-508/3061

WEBS 4-17=-410/2264, 15-17=-507/3645, 6-17=-475/2930, 6-15=-3093/549, 7-15=-179/1045, 7-13=-160/864, 9-13=-479/219

NOTES-

- 1) Unbalanced roof live loads have been considered for this design.
- 2) Wind: ASCE 7-16; Vult=115mph (3-second gust) Vasd=91mph; TCDL=6.0psf; BCDL=4.2psf; h=15ft; Cat. II; Exp C; Enclosed; MWFRS (envelope) gable end zone and C-C Exterior(2E) -1-10-8 to 1-6-5, Interior(1) 1-6-5 to 5-10-4, Exterior(2R) 5-10-4 to 9-3-1, Interior(1) 9-3-1 to 18-0-0, Exterior(2R) 18-0-0 to 21-4-13, Interior(1) 21-4-13 to 35-10-8 zone; cantilever left and right exposed ; end vertical left and right exposed;C-C for members and forces & MWFRS for reactions shown; Lumber DOL=1.60 plate grip DOL=1.60
- 3) Provide adequate drainage to prevent water ponding.
- 4) This truss has been designed for a 10.0 psf bottom chord live load nonconcurrent with any other live loads.
- 5) Provide mechanical connection (by others) of truss to bearing plate capable of withstanding 299 lb uplift at joint 2 and 281 lb uplift at joint 11.
- 6) This truss is designed in accordance with the 2018 International Residential Code sections R502.11.1 and R802.10.2 and referenced standard ANSI/TPI 1.
- 7) This truss design requires that a minimum of 7/16" structural wood sheathing be applied directly to the top chord and 1/2" gypsum sheetrock be applied directly to the bottom chord.
- 8) Graphical purlin representation does not depict the size or the orientation of the purlin along the top and/or bottom chord.



June 12, 2023

WARNING - Verify design parameters and READ NOTES ON THIS AND INCLUDED MITEK REFERENCE PAGE MII-7473 rev. 5/19/2020 BEFORE USE.


Design valid for use only with MiTek® connectors. This design is based only upon parameters shown, and is for an individual building component, not a truss system. Before use, the building designer must verify the applicability of design parameters and properly incorporate this design into the overall building design. Bracing indicated is to prevent buckling of individual truss web and/or chord members only. Additional temporary and permanent bracing is always required for stability and to prevent collapse with possible personal injury and property damage. For general guidance regarding the fabrication, storage, delivery, erection and bracing of trusses and truss systems, see **ANSI/TPI1 Quality Criteria, DSB-89 and BCSI Building Component Safety Information** available from Truss Plate Institute, 2670 Crain Highway, Suite 203 Waldorf, MD 20601



16023 Swingley Ridge Rd
Chesterfield, MO 63017

Builders FirstSource (Valley Center), Valley Center, KS - 67147,

8.630 s Nov 19 2022 MiTek Industries, Inc. Thu Jan 6 14:12:59 2023 Page 1
ID:icBMJaMgT1gasuUyx9?RhvzDEHb-RfC?PsB70Hq3NSyPqnL8v3UitXbGKwRClp7I4zIC/f

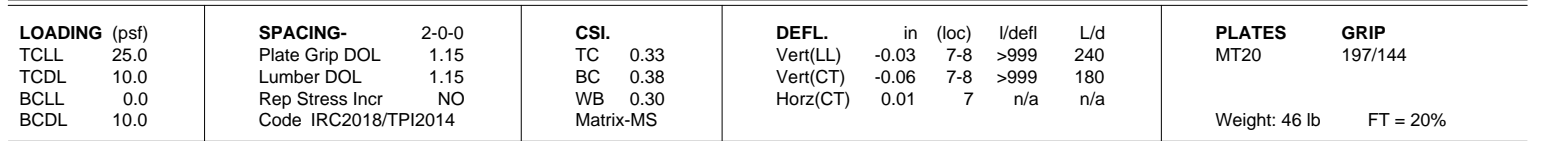

WEDGE
Left: 2x4 SP No.3

FORCES. (lb) - Max. Comp./Max. Ten. - All forces 250 (lb) or less except when shown.

TOP CHORD 2-3=-797/136
BOT CHORD 2-8=-154/731, 7-8=-154/731
WEBS 3-7=-704/168

- 1) Wind: ASCE 7-16; Vult=115mph (3-second gust) Vasd=91mph; TCdL=6.0psf; BCdL=4.2psf; h=15ft; Cat. II; Exp C; Enclosed; MWFRS (envelope) gable end zone; cantilever left and right exposed ; end vertical left and right exposed; Lumber DOL=1.60 plate grip DOL=1.60
- 2) This truss has been designed for a 10.0 psf bottom chord live load nonconcurrent with any other live loads.
- 3) Refer to girder(s) for truss to truss connections.
- 4) Provide mechanical connection (by others) of truss to bearing plate capable of withstanding 191 lb uplift at joint 2 and 103 lb uplift at joint 7.
- 5) This truss is designed in accordance with the 2018 International Residential Code sections R502.11.1 and R802.10.2 and referenced standard ANSI/TPI 1.
- 6) Hanger(s) or other connection device(s) shall be provided sufficient to support concentrated load(s) 83 lb down and 173 lb up at 1-7-11, 12 lb down and 15 lb up at 2-9-8, 15 lb down and 32 lb up at 4-5-10, 35 lb down and 52 lb up at 5-7-7, and 52 lb down and 76 lb up at 7-3-10, and 76 lb down and 87 lb up at 8-5-6 on top chord, and 11 lb down and 64 lb up at 1-7-11, 10 lb down and 6 lb up at 2-9-8, 24 lb down and 7 lb up at 4-5-10, 22 lb down at 5-7-7, and 33 lb down at 7-3-10, and 45 lb down at 8-5-6 on bottom chord. The design/selection of such connection device(s) is the responsibility of others.
- 7) In the LOAD CASE(S) section, loads applied to the face of the truss are noted as front (F) or back (B).

1) Dead + Roof Live (balanced): Lumber Increase=1.15, Plate Increase=1.15

Uniform Loads (plf)

Vert: $1-4=-70$, $4-5=-20$, $6-9=-20$

Concentrated Loads (lb)

Vert: 12=49(F) 15=-6(B) 16=-45(F) 17=-76(B) 18=32(F) 19=6(B) 20=7(F) 21=-12(B) 22=-29(F) 23=-41(B)



June 12, 2023



Design valid for use only with MiTek® connectors. This design is based only upon parameters shown, and is for an individual building component, not a truss system. Before use, the building designer must verify the applicability of design parameters and properly incorporate this design into the overall building design. Bracing indicated is to prevent buckling of individual truss web and/or chord members only. Additional temporary and permanent bracing is always required for stability and to prevent collapse with possible personnel injury and property damage. For general guidance regarding the fabrication, storage, delivery, erection and bracing of trusses and truss systems, see **ANSI/TPI1 Quality Criteria, DSB-89 and BCSI Building Code**.

Safety Information available from Truss Plate Institute, 2670 Crain Highway, Suite 203 Waldorf, MD 20601



16023 Swingley Ridge Rd
Chesterfield, MO 63017


Job	Truss	Truss Type	Qty	Ply	Summit/161 Highland Meadows	RELEASE FOR CONSTRUCTION
3564895	CJ2	Diagonal Hip Girder	1	1		AS NOTED FOR PLAN REVIEW
					Job Reference (optional)	DEVELOPMENT SERVICES
						LEE'S SUMMIT, MISSOURI

Builders FirstSource (Valley Center), Valley Center, KS - 67147,

8.630 s Nov 19 2022 MiTek Industries, Inc. Thu Jun 9 7 47 10 02 2023 Page 1

ID:icBMJaMgT1gasuUyx9?RhvzDEHb-RfC?PsB70Hq3NSqPqnL8v3uITxb6KVrCm7J4ZICP

07/03/2023

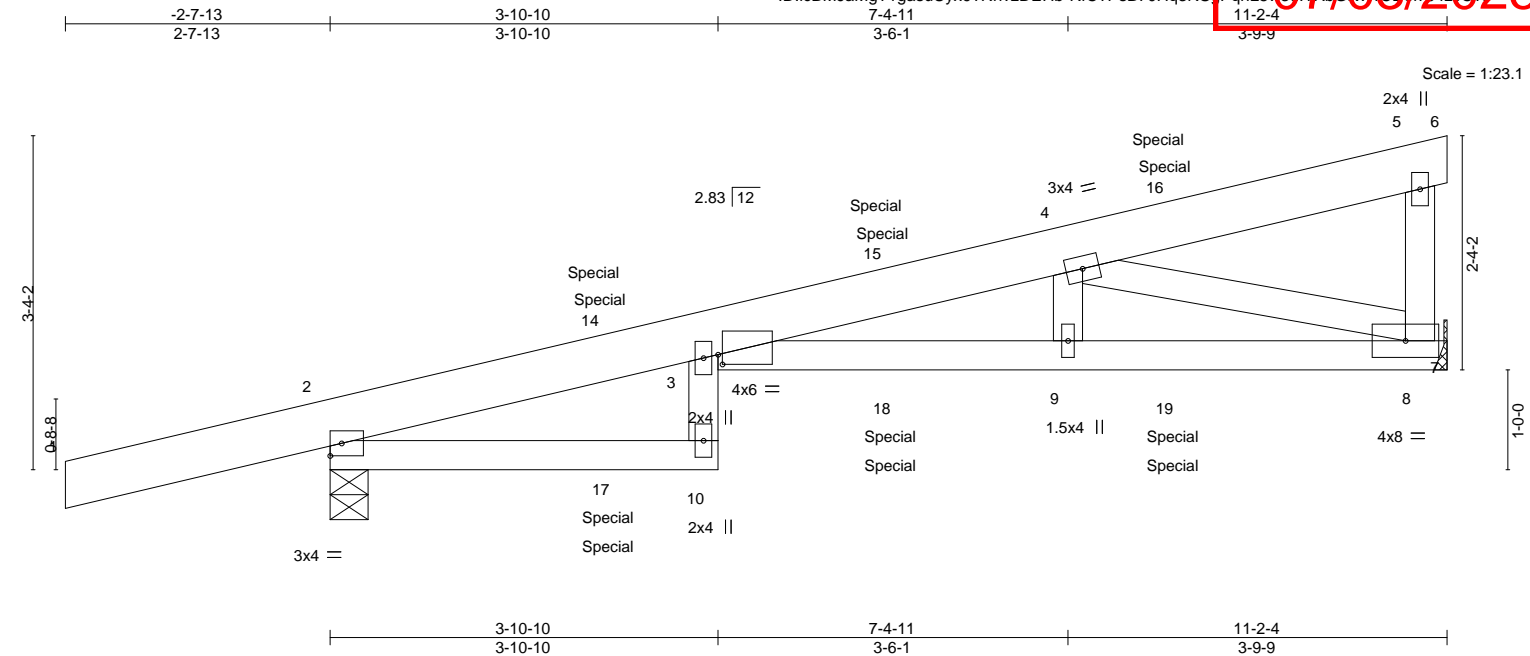

LOADING (psf)	SPACING-	2-0-0	CSI.	DEFL.	in (loc)	l/defl	L/d	PLATES	GRIP
TCLL 25.0	Plate Grip DOL	1.15	TC 0.75	Vert(LL)	-0.22	3-9	>595	240	MT20
TCDL 10.0	Lumber DOL	1.15	BC 0.91	Vert(CT)	-0.41	3-9	>320	180	197/144
BCLL 0.0	Rep Stress Incr	NO	WB 0.42	Horz(CT)	0.17	8	n/a	n/a	
BCDL 10.0	Code IRC2018/TPI2014		Matrix-MS						
								Weight: 46 lb	FT = 20%

LUMBER-

TOP CHORD 2x6 SPF 2100F 1.8E
BOT CHORD 2x4 SPF No.2
WEBS 2x4 SPF No.2

BRACING-

TOP CHORD Structural wood sheathing directly applied or 5-10-8 oc purlins, except end verticals.
BOT CHORD Rigid ceiling directly applied or 8-10-14 oc bracing.

REACTIONS.

(size) 8=Mechanical, 2=0-4-9
Max Horz 2=90(LC 5)
Max Uplift 8=154(LC 8), 2=227(LC 4)
Max Grav 8=694(LC 1), 2=779(LC 1)

FORCES. (lb) - Max. Comp./Max. Ten. - All forces 250 (lb) or less except when shown.

TOP CHORD 3-4=-1695/407
BOT CHORD 3-9=-427/1701, 8-9=-426/1699
WEBS 4-8=-1726/450

NOTES-

- Wind: ASCE 7-16; Vult=115mph (3-second gust) Vasd=91mph; TCDL=6.0psf; BCDL=4.2psf; h=15ft; Cat. II; Exp C; Enclosed; MWFRS (envelope) gable end zone; cantilever left and right exposed; end vertical left and right exposed; Lumber DOL=1.60 plate grip DOL=1.60
- This truss has been designed for a 10.0 psf bottom chord live load nonconcurrent with any other live loads.
- Refer to girder(s) for truss to truss connections.
- Provide mechanical connection (by others) of truss to bearing plate capable of withstanding 154 lb uplift at joint 8 and 227 lb uplift at joint 2.
- This truss is designed in accordance with the 2018 International Residential Code sections R502.11.1 and R802.10.2 and referenced standard ANSI/TPI 1.
- Hanger(s) or other connection device(s) shall be provided sufficient to support concentrated load(s) 12 lb down and 15 lb up at 2-9-8, 12 lb down and 15 lb up at 2-9-8, 32 lb down and 39 lb up at 5-7-7, 32 lb down and 39 lb up at 5-7-7, and 59 lb down and 73 lb up at 8-5-6, and 59 lb down and 73 lb up at 8-5-6 on top chord, and 10 lb down and 6 lb up at 2-9-8, 10 lb down and 6 lb up at 2-9-8, 32 lb down and 25 lb up at 5-7-7, 32 lb down and 25 lb up at 5-7-7, and 61 lb down and 32 lb up at 8-5-6, and 61 lb down and 32 lb up at 8-5-6 on bottom chord. The design/selection of such connection device(s) is the responsibility of others.
- In the LOAD CASE(S) section, loads applied to the face of the truss are noted as front (F) or back (B).

LOAD CASE(S) Standard

- Dead + Roof Live (balanced): Lumber Increase=1.15, Plate Increase=1.15
Uniform Loads (plf)
Vert: 1-3=-70, 3-5=-70, 5-6=-20, 10-11=-20, 3-7=-20
Concentrated Loads (lb)
Vert: 15=-12(F=-6, B=-6) 16=-109(F=-54, B=-54) 17=12(F=6, B=6) 18=-63(F=-32, B=-32) 19=-123(F=-61, B=-61)



June 12, 2023

WARNING - Verify design parameters and READ NOTES ON THIS AND INCLUDED MITEK REFERENCE PAGE MII-7473 rev. 5/19/2020 BEFORE USE.

Design valid for use only with MiTek® connectors. This design is based only upon parameters shown, and is for an individual building component, not a truss system. Before use, the building designer must verify the applicability of design parameters and properly incorporate this design into the overall building design. Bracing indicated is to prevent buckling of individual truss web and/or chord members only. Additional temporary and permanent bracing is always required for stability and to prevent collapse with possible personal injury and property damage. For general guidance regarding the fabrication, storage, delivery, erection and bracing of trusses and truss systems, see **ANSI/TPI1 Quality Criteria, DSB-89 and BCSI Building Component Safety Information** available from Truss Plate Institute, 2670 Crain Highway, Suite 203 Waldorf, MD 20601



16023 Swingley Ridge Rd
Chesterfield, MO 63017

Job	Truss	Truss Type	Qty	Ply	Summit/161 Highland Meadows	RELEASE FOR CONSTRUCTION
3564895	CJ3	Diagonal Hip Girder	1	1	Job Reference (optional)	AS NOTED FOR PLAN REVIEW DEVELOPMENT SERVICES LEE'S SUMMIT, MISSOURI

Builders FirstSource (Valley Center), Valley Center, KS - 67147,

8.630 s Nov 19 2022 MiTek Industries, Inc. Thu Jun 8 7 47 10 PM 2023 Page 1

ID:icBMJaMgT1gasuUyx9?RhvzDEHb-RfC?PsB70Hq3NSuPqnL8v3uITxb6KVrCm7J4ZICP

07/03/2023

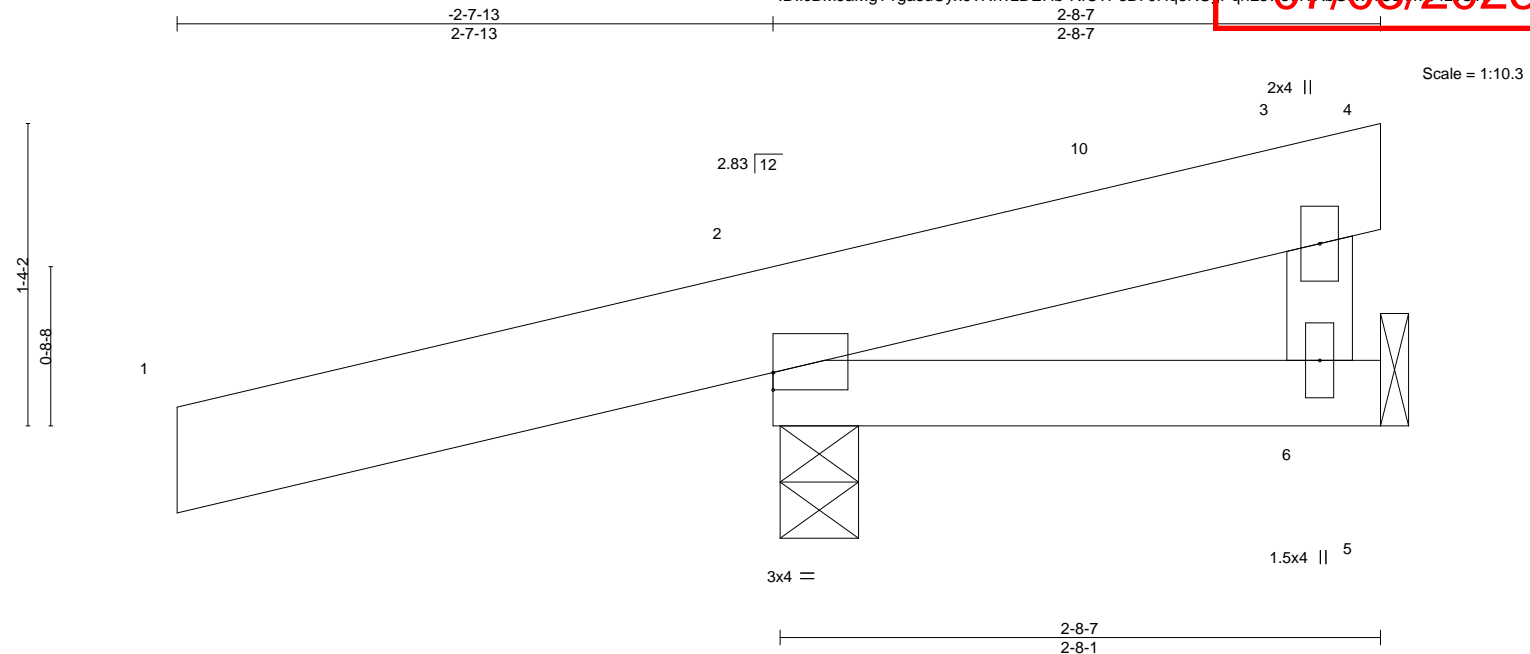


Plate Offsets (X,Y)--	[2:0-0-0,0-0-15]								
LOADING (psf)	SPACING-	2-0-0	CSI.	DEFL.	in (loc)	l/defl	L/d	PLATES	GRIP
TCLL 25.0	Plate Grip DOL	1.15	TC 0.25	Vert(LL)	0.00	6-9	>999	MT20	197/144
TCDL 10.0	Lumber DOL	1.15	BC 0.08	Vert(CT)	0.00	6-9	>999		
BCLL 0.0	Rep Stress Incr	NO	WB 0.00	Horz(CT)	-0.00	2	n/a		
BCDL 10.0	Code IRC2018/TPI2014		Matrix-MP					Weight: 14 lb	FT = 20%

LUMBER-

TOP CHORD 2x6 SPF No.2
BOT CHORD 2x4 SPF No.2
WEBS 2x4 SPF No.2

BRACING-

TOP CHORD Structural wood sheathing directly applied or 2-8-7 oc purlins, except end verticals.
BOT CHORD Rigid ceiling directly applied or 10-0-0 oc bracing.

REACTIONS.

(size) 6=Mechanical, 2=0-4-3
Max Horz 2=43(LC 11)
Max Uplift 6=-1(LC 9), 2=-167(LC 8)
Max Grav 6=61(LC 3), 2=396(LC 1)

FORCES. (lb) - Max. Comp./Max. Ten. - All forces 250 (lb) or less except when shown.

NOTES-

- Wind: ASCE 7-16; Vult=115mph (3-second gust) Vasd=91mph; TCDL=6.0psf; BCDL=4.2psf; h=15ft; Cat. II; Exp C; Enclosed; MWFRS (envelope) gable end zone and C-C Corner(3) -2-7-13 to 1-7-1, Exterior(2R) 1-7-1 to 2-8-7 zone; cantilever left and right exposed; end vertical left and right exposed; C-C for members and forces & MWFRS for reactions shown; Lumber DOL=1.60 plate grip DOL=1.60
- This truss has been designed for a 10.0 psf bottom chord live load nonconcurrent with any other live loads.
- Refer to girder(s) for truss to truss connections.
- Provide mechanical connection (by others) of truss to bearing plate capable of withstanding 1 lb uplift at joint 6 and 167 lb uplift at joint 2.
- This truss is designed in accordance with the 2018 International Residential Code sections R502.11.1 and R802.10.2 and referenced standard ANSI/TPI 1.



June 12, 2023

WARNING - Verify design parameters and READ NOTES ON THIS AND INCLUDED MITEK REFERENCE PAGE MII-7473 rev. 5/19/2020 BEFORE USE.

Design valid for use only with MiTek® connectors. This design is based only upon parameters shown, and is for an individual building component, not a truss system. Before use, the building designer must verify the applicability of design parameters and properly incorporate this design into the overall building design. Bracing indicated is to prevent buckling of individual truss web and/or chord members only. Additional temporary and permanent bracing is always required for stability and to prevent collapse with possible personal injury and property damage. For general guidance regarding the fabrication, storage, delivery, erection and bracing of trusses and truss systems, see

Safety Information available from Truss Plate Institute, 2670 Crain Highway, Suite 203 Waldorf, MD 20601



16023 Swingley Ridge Rd
Chesterfield, MO 63017


Job	Truss	Truss Type	Qty	Ply	Summit/161 Highland Meadows	AS NOTED FOR PLAN REVIEW DEVELOPMENT SERVICES LEE'S SUMMIT, MISSOURI
3564895	CJ4	Diagonal Hip Girder	2	1	Job Reference (optional)	

Builders FirstSource (Valley Center), Valley Center, KS - 67147,

8.630 s Nov 19 2022 MiTek Industries, Inc. Thu Jun 8 4 18 04 2023 Page 1

ID:icBMJaMgT1gasuUyx9?RhvzDEHb-RfC?PsB70Hq3NSqPqnL8v3uITxb6SVrCm7J4ZICP

07/08/2023

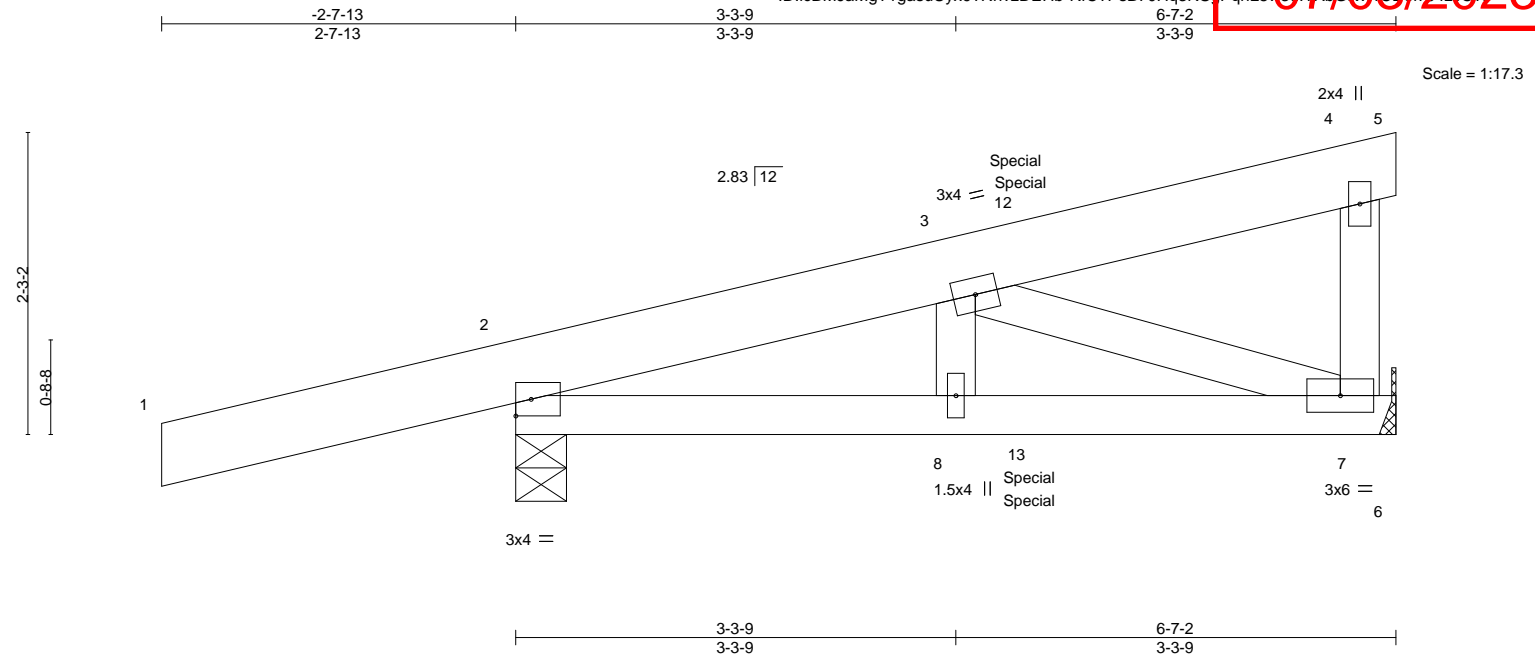

LOADING (psf)	SPACING-	2-0-0	CSI.	DEFL.	in (loc)	I/defl	L/d	PLATES	GRIP
TCLL 25.0	Plate Grip DOL	1.15	TC 0.25	Vert(LL)	-0.01 8	>999	240	MT20	197/144
TCDL 10.0	Lumber DOL	1.15	BC 0.18	Vert(CT)	-0.01 7-8	>999	180		
BCLL 0.0	Rep Stress Incr	NO	WB 0.06	Horz(CT)	0.00 7	n/a	n/a		
BCDL 10.0	Code IRC2018/TPI2014		Matrix-MP					Weight: 31 lb	FT = 20%

LUMBER-

TOP CHORD 2x6 SPF No.2
BOT CHORD 2x4 SPF No.2
WEBS 2x4 SPF No.2

BRACING-

TOP CHORD Structural wood sheathing directly applied or 6-0-0 oc purlins, except end verticals.
BOT CHORD Rigid ceiling directly applied or 10-0-0 oc bracing.

REACTIONS.

(size) 2=0-4-9, 7=Mechanical
Max Horz 2=78(LC 7)
Max Uplift 2=-164(LC 4), 7=-49(LC 8)
Max Grav 2=508(LC 1), 7=256(LC 1)

FORCES. (lb) - Max. Comp./Max. Ten. - All forces 250 (lb) or less except when shown.

TOP CHORD 2-3=-311/36
BOT CHORD 2-8=-36/261, 7-8=-36/261
WEBS 3-7=-278/55

NOTES-

- 1) Wind: ASCE 7-16; Vult=115mph (3-second gust) Vasd=91mph; TCDL=6.0psf; BCDL=4.2psf; h=15ft; Cat. II; Exp C; Enclosed; MWFRS (envelope) gable end zone; cantilever left and right exposed; end vertical left and right exposed; Lumber DOL=1.60 plate grip DOL=1.60
- 2) This truss has been designed for a 10.0 psf bottom chord live load nonconcurrent with any other live loads.
- 3) Refer to girder(s) for truss to truss connections.
- 4) Provide mechanical connection (by others) of truss to bearing plate capable of withstanding 164 lb uplift at joint 2 and 49 lb uplift at joint 7.
- 5) This truss is designed in accordance with the 2018 International Residential Code sections R502.11.1 and R802.10.2 and referenced standard ANSI/TPI 1.
- 6) Hanger(s) or other connection device(s) shall be provided sufficient to support concentrated load(s) 17 lb down and 30 lb up at 3-10-4, and 17 lb down and 30 lb up at 3-10-4 on top chord, and 11 lb down and 1 lb up at 3-10-4, and 11 lb down and 1 lb up at 3-10-4 on bottom chord. The design/selection of such connection device(s) is the responsibility of others.
- 7) In the LOAD CASE(S) section, loads applied to the face of the truss are noted as front (F) or back (B).

LOAD CASE(S) Standard

- 1) Dead + Roof Live (balanced): Lumber Increase=1.15, Plate Increase=1.15
Uniform Loads (plf)
Vert: 1-4=-70, 4-5=-20, 6-9=-20
Concentrated Loads (lb)
Vert: 13=2(F=1, B=1)



June 12, 2023

WARNING - Verify design parameters and READ NOTES ON THIS AND INCLUDED MITEK REFERENCE PAGE MII-7473 rev. 5/19/2020 BEFORE USE.

Design valid for use only with MiTek® connectors. This design is based only upon parameters shown, and is for an individual building component, not a truss system. Before use, the building designer must verify the applicability of design parameters and properly incorporate this design into the overall building design. Bracing indicated is to prevent buckling of individual truss web and/or chord members only. Additional temporary and permanent bracing is always required for stability and to prevent collapse with possible personal injury and property damage. For general guidance regarding the fabrication, storage, delivery, erection and bracing of trusses and truss systems, see

ANSI/TPI1 Quality Criteria, DSB-89 and BCSI Building Component

Safety Information available from Truss Plate Institute, 2670 Crain Highway, Suite 203 Waldorf, MD 20601



16023 Swingley Ridge Rd
Chesterfield, MO 63017

Job	Truss	Truss Type	Qty	Ply	Summit/161 Highland Meadows	AS NOTED FOR PLAN REVIEW DEVELOPMENT SERVICES LEE'S SUMMIT, MISSOURI
3564895	CJ5	Diagonal Hip Girder	1	1	Job Reference (optional)	

Builders FirstSource (Valley Center), Valley Center, KS - 67147,

8.630 s Nov 19 2022 MiTek Industries, Inc. Thu Jun 8 4:10:05 2023 Page 1

ID:icBMJaMgT1gasuUyx9?RhvzDEHb-RfC?PsB70Hq3NSqPqnL8v3uITxb6SVrCm7J4ZICP

07/03/2023

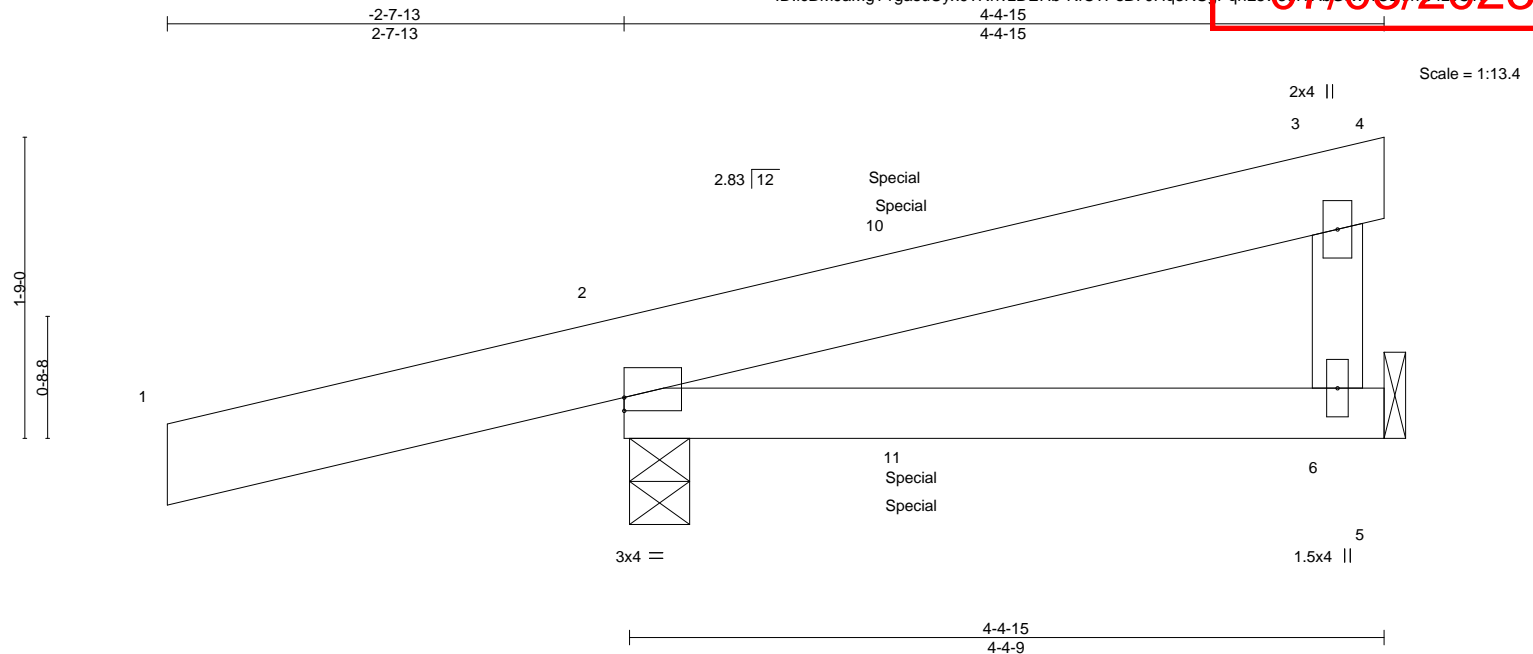


Plate Offsets (X,Y)-- [2:0-0-0,0-0-15]												
LOADING (psf)		SPACING- 2-0-0		CSI.		DEFL. in (loc) l/defl L/d			PLATES	GRIP		
TCLL	25.0	Plate Grip DOL	1.15	TC	0.25	Vert(LL)	0.01	6-9	>999	240	MT20	197/144
TCDL	10.0	Lumber DOL	1.15	BC	0.11	Vert(CT)	0.01	6-9	>999	180		
BCLL	0.0	Rep Stress Incr	NO	WB	0.00	Horz(CT)	-0.00	2	n/a	n/a		
BCDL	10.0	Code IRC2018/TPI2014		Matrix-MP							Weight: 19 lb	FT = 20%

LUMBER-

TOP CHORD 2x6 SPF No.2
BOT CHORD 2x4 SPF No.2
WEBS 2x4 SPF No.2

BRACING-

TOP CHORD Structural wood sheathing directly applied or 4-4-15 oc purlins, except end verticals.
BOT CHORD Rigid ceiling directly applied or 10-0-0 oc bracing.

REACTIONS.

(size) 6=Mechanical, 2=0-4-3
Max Horz 2=58(LC 7)
Max Uplift 6=24(LC 8), 2=158(LC 4)
Max Grav 6=117(LC 37), 2=388(LC 1)

FORCES. (lb) - Max. Comp./Max. Ten. - All forces 250 (lb) or less except when shown.

NOTES-

- Wind: ASCE 7-16; Vult=115mph (3-second gust) Vasd=91mph; TCDL=6.0psf; BCDL=4.2psf; h=15ft; Cat. II; Exp C; Enclosed; MWFRS (envelope) gable end zone; cantilever left and right exposed; end vertical left and right exposed; Lumber DOL=1.60 plate grip DOL=1.60
- This truss has been designed for a 10.0 psf bottom chord live load nonconcurrent with any other live loads.
- Refer to girder(s) for truss to truss connections.
- Provide mechanical connection (by others) of truss to bearing plate capable of withstanding 24 lb uplift at joint 6 and 158 lb uplift at joint 2.
- This truss is designed in accordance with the 2018 International Residential Code sections R502.11.1 and R802.10.2 and referenced standard ANSI/TPI 1.
- Hanger(s) or other connection device(s) shall be provided sufficient to support concentrated load(s) 81 lb down and 170 lb up at 1-8-1, and 14 lb down and 27 lb up at 1-8-1 on top chord, and 11 lb down and 63 lb up at 1-8-1, and 8 lb down and 0 lb up at 1-8-1 on bottom chord. The design/selection of such connection device(s) is the responsibility of others.
- In the LOAD CASE(S) section, loads applied to the face of the truss are noted as front (F) or back (B).

LOAD CASE(S) Standard

- Dead + Roof Live (balanced): Lumber Increase=1.15, Plate Increase=1.15
Uniform Loads (plf)
Vert: 1-3=-70, 3-4=-20, 5-7=-20
Concentrated Loads (lb)
Vert: 10=48(B) 11=24(F=-8, B=32)



June 12, 2023

WARNING - Verify design parameters and READ NOTES ON THIS AND INCLUDED MITEK REFERENCE PAGE MII-7473 rev. 5/19/2020 BEFORE USE.

Design valid for use only with MiTek® connectors. This design is based only upon parameters shown, and is for an individual building component, not a truss system. Before use, the building designer must verify the applicability of design parameters and properly incorporate this design into the overall building design. Bracing indicated is to prevent buckling of individual truss web and/or chord members only. Additional temporary and permanent bracing is always required for stability and to prevent collapse with possible personal injury and property damage. For general guidance regarding the fabrication, storage, delivery, erection and bracing of trusses and truss systems, see

Safety Information available from Truss Plate Institute, 2670 Crain Highway, Suite 203 Waldorf, MD 20601



16023 Swingley Ridge Rd
Chesterfield, MO 63017


Job	Truss	Truss Type	Qty	Ply	Summit/161 Highland Meadows	AS NOTED FOR PLAN REVIEW DEVELOPMENT SERVICES LEE'S SUMMIT, MISSOURI
3564895	CJ6	Diagonal Hip Girder	1	1	Job Reference (optional)	

Builders FirstSource (Valley Center), Valley Center, KS - 67147,

8.630 s Nov 19 2022 MiTek Industries, Inc. Thu Jun 8 7 47 18 06 2023 Page 1

ID:icBMJaMgT1gasuUyx9?RhvzDEHb-RfC?PsB70Hq3NSpPqnL8v3uITxb63vtrCm714ZICP

07/03/2023

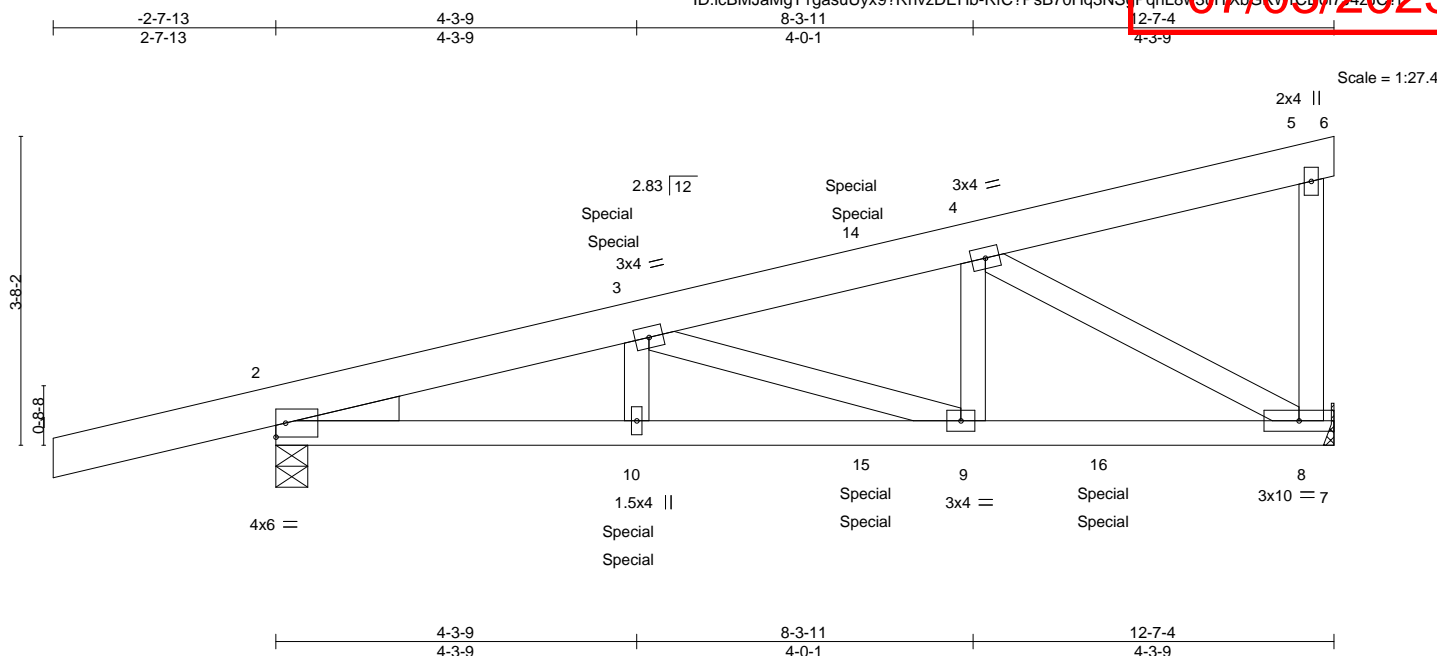

LOADING (psf)	SPACING-	2-0-0	CSI.	DEFL.	in (loc)	l/defl	L/d	PLATES	GRIP
TCLL 25.0	Plate Grip DOL	1.15	TC 0.49	Vert(LL)	-0.06 8-9	>999	240	MT20	197/144
TCDL 10.0	Lumber DOL	1.15	BC 0.88	Vert(CT)	-0.12 8-9	>999	180		
BCLL 0.0	Rep Stress Incr	NO	WB 0.52	Horz(CT)	0.03 8	n/a	n/a		
BCDL 10.0	Code IRC2018/TPI2014		Matrix-MS					Weight: 60 lb	FT = 20%

LUMBER-

TOP CHORD 2x6 SPF No.2
 BOT CHORD 2x4 SPF 1650F 1.5E
 WEBS 2x4 SPF No.2
 WEDGE
 Left: 2x4 SP No.3

BRACING-

TOP CHORD Structural wood sheathing directly applied or 5-4-8 oc purlins, except end verticals.
 BOT CHORD Rigid ceiling directly applied or 10-0-0 oc bracing.

REACTIONS.

(size) 2=0-4-9, 8=Mechanical
 Max Horz 2=114(LC 7)
 Max Uplift 2=232(LC 4), 8=189(LC 8)
 Max Grav 2=923(LC 1), 8=1042(LC 1)

FORCES. (lb) - Max. Comp./Max. Ten. - All forces 250 (lb) or less except when shown.

TOP CHORD 2-3=1501/243, 3-4=1348/243
 BOT CHORD 2-10=260/1397, 9-10=260/1397, 8-9=236/1296
 WEBS 4-9=71/579, 4-8=1429/281

NOTES-

- 1) Wind: ASCE 7-16; Vult=115mph (3-second gust) Vasd=91mph; TCDL=6.0psf; BCDL=4.2psf; h=15ft; Cat. II; Exp C; Enclosed; MWFRS (envelope) gable end zone; cantilever left and right exposed; end vertical left and right exposed; Lumber DOL=1.60 plate grip DOL=1.60
- 2) This truss has been designed for a 10.0 psf bottom chord live load nonconcurrent with any other live loads.
- 3) Refer to girder(s) for truss to truss connections.
- 4) Provide mechanical connection (by others) of truss to bearing plate capable of withstanding 232 lb uplift at joint 2 and 189 lb uplift at joint 8.
- 5) This truss is designed in accordance with the 2018 International Residential Code sections R502.11.1 and R802.10.2 and referenced standard ANSI/TPI 1.
- 6) Hanger(s) or other connection device(s) shall be provided sufficient to support concentrated load(s) 21 lb down and 35 lb up at 4-2-8, 21 lb down and 35 lb up at 4-2-8, and 49 lb down and 72 lb up at 7-0-7, and 49 lb down and 72 lb up at 7-0-7 on top chord, and 12 lb down at 4-2-8, 12 lb down at 4-2-8, 32 lb down at 7-0-7, 32 lb down at 7-0-7, and 263 lb down and 86 lb up at 9-10-6, and 263 lb down and 86 lb up at 9-10-6 on bottom chord. The design/selection of such connection device(s) is the responsibility of others.
- 7) In the LOAD CASE(S) section, loads applied to the face of the truss are noted as front (F) or back (B).

LOAD CASE(S) Standard

- 1) Dead + Roof Live (balanced): Lumber Increase=1.15, Plate Increase=1.15
 Uniform Loads (plf)
 Vert: 1-5=-70, 5-6=-20, 7-11=-20
 Concentrated Loads (lb)
 Vert: 10=-1(F=-1, B=-1) 14=-78(F=-39, B=-39) 15=-54(F=-27, B=-27) 16=-526(F=-263, B=-263)



June 12, 2023

WARNING - Verify design parameters and READ NOTES ON THIS AND INCLUDED MITEK REFERENCE PAGE MII-7473 rev. 5/19/2020 BEFORE USE.

Design valid for use only with MiTek® connectors. This design is based only upon parameters shown, and is for an individual building component, not a truss system. Before use, the building designer must verify the applicability of design parameters and properly incorporate this design into the overall building design. Bracing indicated is to prevent buckling of individual truss web and/or chord members only. Additional temporary and permanent bracing is always required for stability and to prevent collapse with possible personal injury and property damage. For general guidance regarding the fabrication, storage, delivery, erection and bracing of trusses and truss systems, see **ANSI/TPI1 Quality Criteria, DSB-89 and BCSI Building Component Safety Information** available from Truss Plate Institute, 2670 Crain Highway, Suite 203 Waldorf, MD 20601



16023 Swingley Ridge Rd
 Chesterfield, MO 63017

Job	Truss	Truss Type	Qty	Ply	Summit/161 Highland Meadows	RELEASE FOR CONSTRUCTION
3564895	CJ7	Jack-Open	1	1	Job Reference (optional)	AS NOTED FOR PLAN REVIEW DEVELOPMENT SERVICES LEE'S SUMMIT, MISSOURI

Builders FirstSource (Valley Center),

Valley Center, KS - 67147,

8.630 s Nov 19 2022 MiTek Industries, Inc. Thu Jun 8 7 47 10 07 2023 Page 1

ID:icBMJaMgT1gasuUyx9?RhvzDEHb-RfC?PsB70Hq3NSuPqnL8v3uITxb6KVrCm7J4ZICP

07/03/2023

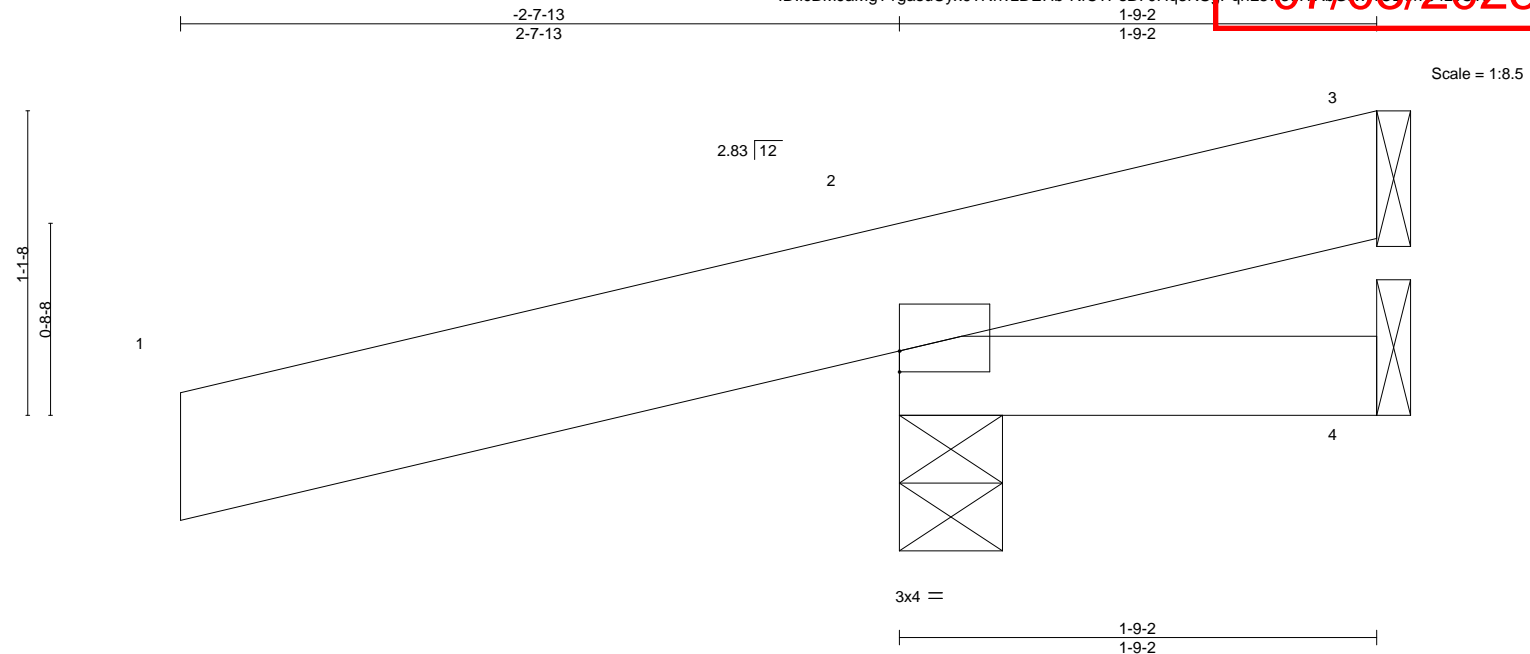


Plate Offsets (X,Y)-- [2:0-0-0,0-0-15]											
LOADING (psf)		SPACING- 2-0-0		CSI.		DEFL. in (loc) l/defl L/d			PLATES GRIP		
TCLL	25.0	Plate Grip DOL	1.15	TC	0.22	Vert(LL)	0.00	7	>999	240	MT20 197/144
TCDL	10.0	Lumber DOL	1.15	BC	0.08	Vert(CT)	0.00	7	>999	180	
BCLL	0.0	Rep Stress Incr	YES	WB	0.00	Horz(CT)	-0.00	3	n/a	n/a	
BCDL	10.0	Code IRC2018/TPI2014		Matrix-MP							Weight: 10 lb FT = 20%

LUMBER-

TOP CHORD 2x6 SPF No.2
BOT CHORD 2x4 SPF No.2

BRACING-

TOP CHORD Structural wood sheathing directly applied or 1-9-2 oc purlins.
BOT CHORD Rigid ceiling directly applied or 10-0-0 oc bracing.

REACTIONS.

(size) 3=Mechanical, 2=0-4-9, 4=Mechanical
Max Horz 2=46(LC 8)
Max Uplift 3=-50(LC 1), 2=-181(LC 8), 4=-12(LC 1)
Max Grav 3=36(LC 8), 2=405(LC 1), 4=19(LC 3)

FORCES. (lb) - Max. Comp./Max. Ten. - All forces 250 (lb) or less except when shown.

NOTES-

- 1) Wind: ASCE 7-16; Vult=115mph (3-second gust) Vasd=91mph; TCDL=6.0psf; BCDL=4.2psf; h=15ft; Cat. II; Exp C; Enclosed; MWFRS (envelope) gable end zone and C-C Corner(3) zone; cantilever left and right exposed; end vertical left and right exposed; C-C for members and forces & MWFRS for reactions shown; Lumber DOL=1.60 plate grip DOL=1.60
- 2) This truss has been designed for a 10.0 psf bottom chord live load nonconcurrent with any other live loads.
- 3) Refer to girder(s) for truss to truss connections.
- 4) Provide mechanical connection (by others) of truss to bearing plate capable of withstanding 50 lb uplift at joint 3, 181 lb uplift at joint 2 and 12 lb uplift at joint 4.
- 5) This truss is designed in accordance with the 2018 International Residential Code sections R502.11.1 and R802.10.2 and referenced standard ANSI/TPI 1.



June 12, 2023

WARNING - Verify design parameters and READ NOTES ON THIS AND INCLUDED MITEK REFERENCE PAGE MII-7473 rev. 5/19/2020 BEFORE USE.

Design valid for use only with MiTek® connectors. This design is based only upon parameters shown, and is for an individual building component, not a truss system. Before use, the building designer must verify the applicability of design parameters and properly incorporate this design into the overall building design. Bracing indicated is to prevent buckling of individual truss web and/or chord members only. Additional temporary and permanent bracing is always required for stability and to prevent collapse with possible personal injury and property damage. For general guidance regarding the fabrication, storage, delivery, erection and bracing of trusses and truss systems, see **ANSI/TPI1 Quality Criteria, DSB-89 and BCSI Building Component**
Safety Information available from Truss Plate Institute, 2670 Crain Highway, Suite 203 Waldorf, MD 20601



16023 Swingley Ridge Rd
Chesterfield, MO 63017


Job	Truss	Truss Type	Qty	Ply	Summit/161 Highland Meadows	RELEASE FOR CONSTRUCTION
3564895	CJ8	Diagonal Hip Girder	1	1		AS NOTED FOR PLAN REVIEW
					Job Reference (optional)	DEVELOPMENT SERVICES
						LEE'S SUMMIT, MISSOURI

Builders FirstSource (Valley Center), Valley Center, KS - 67147,

8.630 s Nov 19 2022 MiTek Industries, Inc. Thu Jun 8 4:10:08 2023 Page 1

ID:icBMJaMgT1gasuUyx9?RhvzDEHb-RfC?PsB70Hq3NSpPqnL8v3uITxb6SVrCm7J4ZICP

07/03/2023

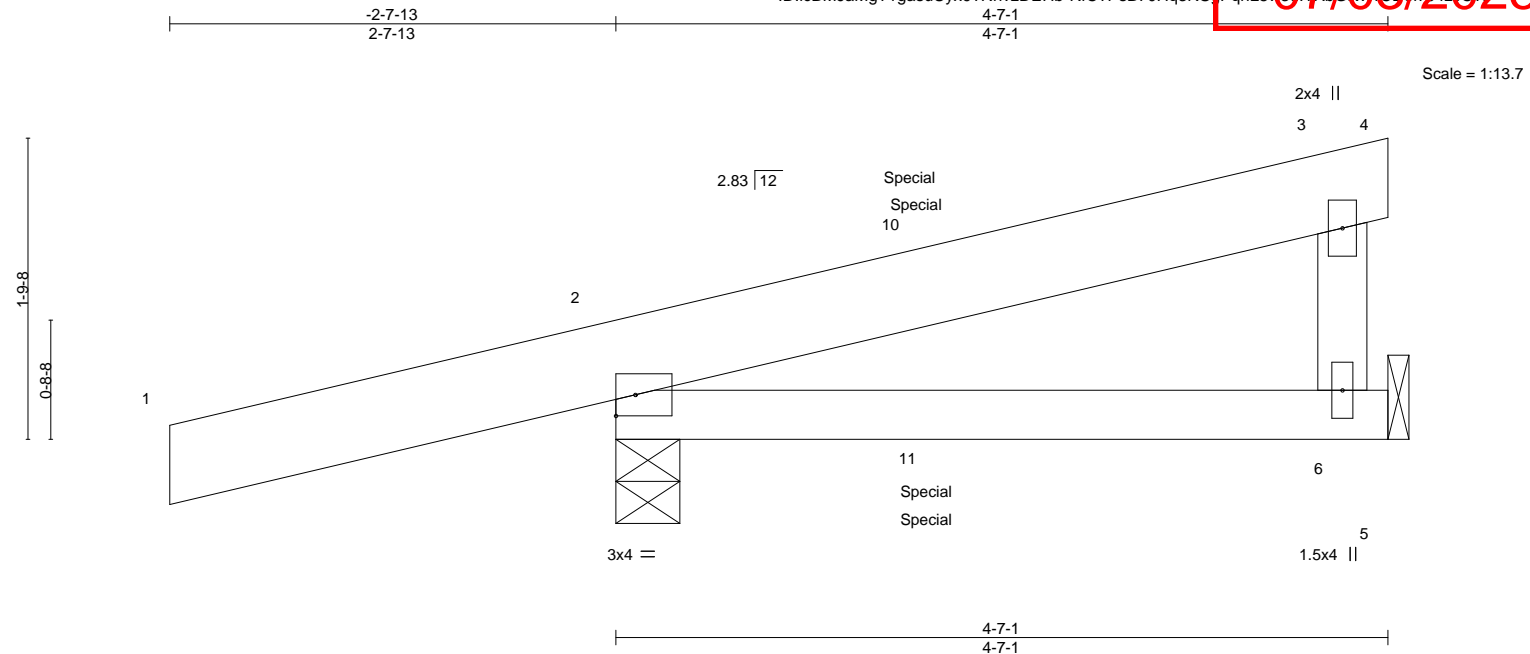

LOADING (psf)	SPACING-	2-0-0	CSI.	DEFL.	in	(loc)	I/defl	L/d	PLATES	GRIP
TCLL 25.0	Plate Grip DOL	1.15	TC 0.31	Vert(LL)	0.02	6-9	>999	240	MT20	197/144
TCDL 10.0	Lumber DOL	1.15	BC 0.23	Vert(CT)	0.03	6-9	>999	180		
BCLL 0.0	Rep Stress Incr	NO	WB 0.00	Horz(CT)	-0.01	2	n/a	n/a		
BCDL 10.0	Code IRC2018/TPI2014		Matrix-MP						Weight: 20 lb	FT = 20%

LUMBER-

TOP CHORD 2x6 SPF No.2
BOT CHORD 2x4 SPF No.2
WEBS 2x4 SPF No.2

BRACING-

TOP CHORD Structural wood sheathing directly applied or 4-7-1 oc purlins, except end verticals.
BOT CHORD Rigid ceiling directly applied or 10-0-0 oc bracing.

REACTIONS.

(size) 6=Mechanical, 2=0-4-9
Max Horz 2=60(LC 7)
Max Uplift 6=31(LC 21), 2=151(LC 4)
Max Grav 6=119(LC 37), 2=354(LC 1)

FORCES. (lb) - Max. Comp./Max. Ten. - All forces 250 (lb) or less except when shown.

NOTES-

- Wind: ASCE 7-16; Vult=115mph (3-second gust) Vasd=91mph; TCDL=6.0psf; BCDL=4.2psf; h=15ft; Cat. II; Exp C; Enclosed; MWFRS (envelope) gable end zone; cantilever left and right exposed; end vertical left and right exposed; Lumber DOL=1.60 plate grip DOL=1.60
- This truss has been designed for a 10.0 psf bottom chord live load nonconcurrent with any other live loads.
- Refer to girder(s) for truss to truss connections.
- Provide mechanical connection (by others) of truss to bearing plate capable of withstanding 31 lb uplift at joint 6 and 151 lb uplift at joint 2.
- This truss is designed in accordance with the 2018 International Residential Code sections R502.11.1 and R802.10.2 and referenced standard ANSI/TPI 1.
- Hanger(s) or other connection device(s) shall be provided sufficient to support concentrated load(s) 73 lb down and 152 lb up at 1-10-3, and 73 lb down and 152 lb up at 1-10-3 on top chord, and 11 lb down and 58 lb up at 1-10-3, and 11 lb down and 58 lb up at 1-10-3 on bottom chord. The design/selection of such connection device(s) is the responsibility of others.
- In the LOAD CASE(S) section, loads applied to the face of the truss are noted as front (F) or back (B).

LOAD CASE(S) Standard

- Dead + Roof Live (balanced): Lumber Increase=1.15, Plate Increase=1.15
Uniform Loads (plf)
Vert: 1-3=-70, 3-4=-20, 5-7=-20
Concentrated Loads (lb)
Vert: 10=86(F=43, B=43) 11=59(F=30, B=30)



June 12, 2023

WARNING - Verify design parameters and READ NOTES ON THIS AND INCLUDED MITEK REFERENCE PAGE MII-7473 rev. 5/19/2020 BEFORE USE.

Design valid for use only with MiTek® connectors. This design is based only upon parameters shown, and is for an individual building component, not a truss system. Before use, the building designer must verify the applicability of design parameters and properly incorporate this design into the overall building design. Bracing indicated is to prevent buckling of individual truss web and/or chord members only. Additional temporary and permanent bracing is always required for stability and to prevent collapse with possible personal injury and property damage. For general guidance regarding the fabrication, storage, delivery, erection and bracing of trusses and truss systems, see

ANSI/TPI1 Quality Criteria, DSB-89 and BCSI Building Component

Safety Information available from Truss Plate Institute, 2670 Crain Highway, Suite 203 Waldorf, MD 20601




16023 Swingley Ridge Rd
Chesterfield, MO 63017

Builders FirstSource (Valley Center), Valley Center, KS - 67147,

8.630 s Nov 19 2022 MiTek Industries, Inc. Thu Jun 8 14:13:09 2023 Page 1

07/03/2023

 

Weight: 11 lb FT = 20%


BRACING-	
TOP CHORD	Structural wood sheathing directly applied or 2-5-15 oc purlins, except end verticals.
BOT CHORD	Rigid ceiling directly applied or 10-0-0 oc bracing.

(size) 6=0-4-9, 5=Mechanical, 3=Mechanical
Max Horz 6=37(LC 11)
Max Uplift 6=177(LC 8), 5=17(LC 25), 3=68(LC 25)
Max Grav 6=421(LC 1), 5=40(LC 3), 3=18(LC 8)

FORCES. (lb) - Max. Comp./Max. Ten. - All forces 250 (lb) or less except when shown.
TOP CHORD 2-6=-361/340

NOTES-

- 1) Unbalanced roof live loads have been considered for this design.
- 2) Wind: ASCE 7-16; Vult=115mph (3-second gust) Vasd=91mph; TCDL=6.0psf; BCDL=4.2psf; h=15ft; Cat. II; Exp C; Enclosed; MWFRS (envelope) gable end zone and C-C Corner(3) -2-7-13 to 1-7-1, Exterior(2R) 1-7-1 to 2-2-7 zone; cantilever left and right exposed ; end vertical left and right exposed;C-C for members and forces & MWFRS for reactions shown; Lumber DOL=1.60 plate grip DOL=1.60
- 3) This truss has been designed for a 10.0 psf bottom chord live load nonconcurrent with any other live loads.
- 4) Refer to girder(s) for truss to truss connections.
- 5) Provide mechanical connection (by others) of truss to bearing plate capable of withstanding 177 lb uplift at joint 6, 17 lb uplift at joint 5 and 68 lb uplift at joint 3.
- 6) This truss is designed in accordance with the 2018 International Residential Code sections R502.11.1 and R802.10.2 and referenced standard ANSI/TPI 1.
- 7) Gap between inside of top chord bearing and first diagonal or vertical web shall not exceed 0.500in.

 


Job	Truss	Truss Type	Qty	Ply	Summit/161 Highland Meadows	AS NOTED FOR PLAN REVIEW DEVELOPMENT SERVICES LEE'S SUMMIT, MISSOURI
3564895	CJ10	Jack-Open	2	1	Job Reference (optional)	158827540

Builders FirstSource (Valley Center), Valley Center, KS - 67147,

8.630 s Nov 19 2022 MiTek Industries, Inc. Thu Jun 8 7 41 10 00 2023 Page 1

ID:icBMJaMgT1gasuUyx9?RhvzDEHb-RfC?PsB70Hq3NSqPqnL8v3uITxb6KVrCg7J4ZICP

07/03/2023

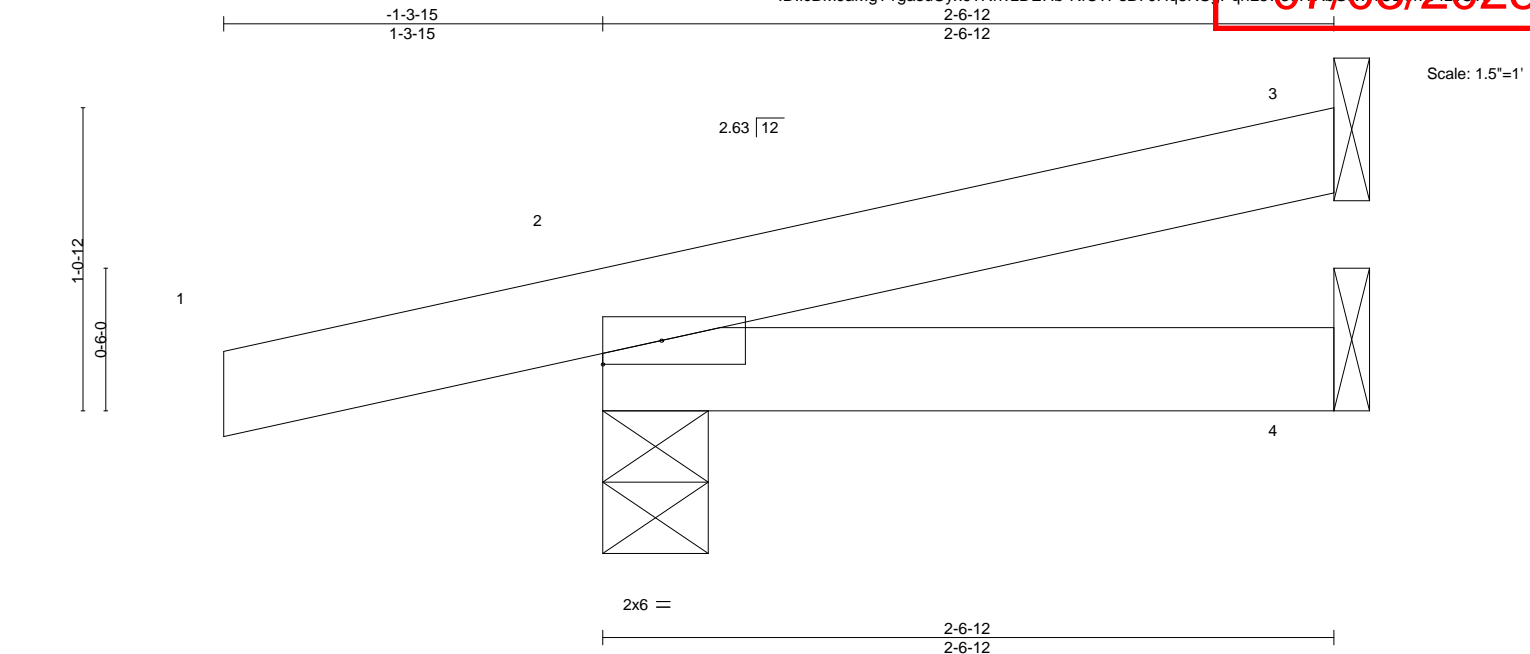

LOADING (psf)	SPACING-	2-0-0	CSI.	DEFL.	in	(loc)	I/defl	L/d	PLATES	GRIP
TCLL 25.0	Plate Grip DOL	1.15	TC 0.11	Vert(LL)	-0.00	7	>999	240	MT20	197/144
TCDL 10.0	Lumber DOL	1.15	BC 0.04	Vert(CT)	-0.00	4-7	>999	180		
BCLL 0.0	Rep Stress Incr	YES	WB 0.00	Horz(CT)	0.00	3	n/a	n/a		
BCDL 10.0	Code IRC2018/TPI2014		Matrix-MP						Weight: 8 lb	FT = 20%

LUMBER-

TOP CHORD 2x4 SPF No.2
BOT CHORD 2x4 SPF No.2

BRACING-

TOP CHORD Structural wood sheathing directly applied or 2-6-12 oc purlins.
BOT CHORD Rigid ceiling directly applied or 10-0-0 oc bracing.

REACTIONS.

(size) 3=Mechanical, 2=0-4-7, 4=Mechanical
Max Horz 2=34(LC 8)
Max Uplift 3=23(LC 12), 2=78(LC 8)
Max Grav 3=64(LC 1), 2=230(LC 1), 4=42(LC 3)

FORCES. (lb) - Max. Comp./Max. Ten. - All forces 250 (lb) or less except when shown.

NOTES-

- 1) Wind: ASCE 7-16; Vult=115mph (3-second gust) Vasd=91mph; TCDL=6.0psf; BCDL=4.2psf; h=15ft; Cat. II; Exp C; Enclosed; MWFRS (envelope) gable end zone and C-C Corner(3) zone; cantilever left and right exposed ; end vertical left and right exposed;C-C for members and forces & MWFRS for reactions shown; Lumber DOL=1.60 plate grip DOL=1.60
- 2) This truss has been designed for a 10.0 psf bottom chord live load nonconcurrent with any other live loads.
- 3) Refer to girder(s) for truss to truss connections.
- 4) Provide mechanical connection (by others) of truss to bearing plate capable of withstanding 23 lb uplift at joint 3 and 78 lb uplift at joint 2.
- 5) This truss is designed in accordance with the 2018 International Residential Code sections R502.11.1 and R802.10.2 and referenced standard ANSI/TPI 1.



June 12, 2023

WARNING - Verify design parameters and READ NOTES ON THIS AND INCLUDED MITEK REFERENCE PAGE MII-7473 rev. 5/19/2020 BEFORE USE.

Design valid for use only with MiTek® connectors. This design is based only upon parameters shown, and is for an individual building component, not a truss system. Before use, the building designer must verify the applicability of design parameters and properly incorporate this design into the overall building design. Bracing indicated is to prevent buckling of individual truss web and/or chord members only. Additional temporary and permanent bracing is always required for stability and to prevent collapse with possible personal injury and property damage. For general guidance regarding the fabrication, storage, delivery, erection and bracing of trusses and truss systems, see

ANSI/TPI1 Quality Criteria, DSB-89 and BCSI Building Component

Safety Information available from Truss Plate Institute, 2670 Crain Highway, Suite 203 Waldorf, MD 20601




16023 Swingley Ridge Rd
Chesterfield, MO 63017

Job	Truss	Truss Type	Qty	Ply	Summit/161 Highland Meadows	RELEASE FOR CONSTRUCTION
3564895	D1	Hip Girder	1	1		AS NOTED FOR PLAN REVIEW
					Job Reference (optional)	DEVELOPMENT SERVICES
						LEE'S SUMMIT, MISSOURI

Builders FirstSource (Valley Center), Valley Center, KS - 67147,

8.630 s Nov 19 2022 MiTek Industries, Inc. Thu Jun 8 7 47 10 2023 Page 1

ID:icBMJaMgT1gasuUyx9?RhvzDEHb-RfC?PsB70Hq3NSqPqnL8v3uITxb6KVrCp7J4ZICP?

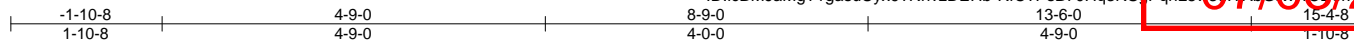

Scale = 1:28.6

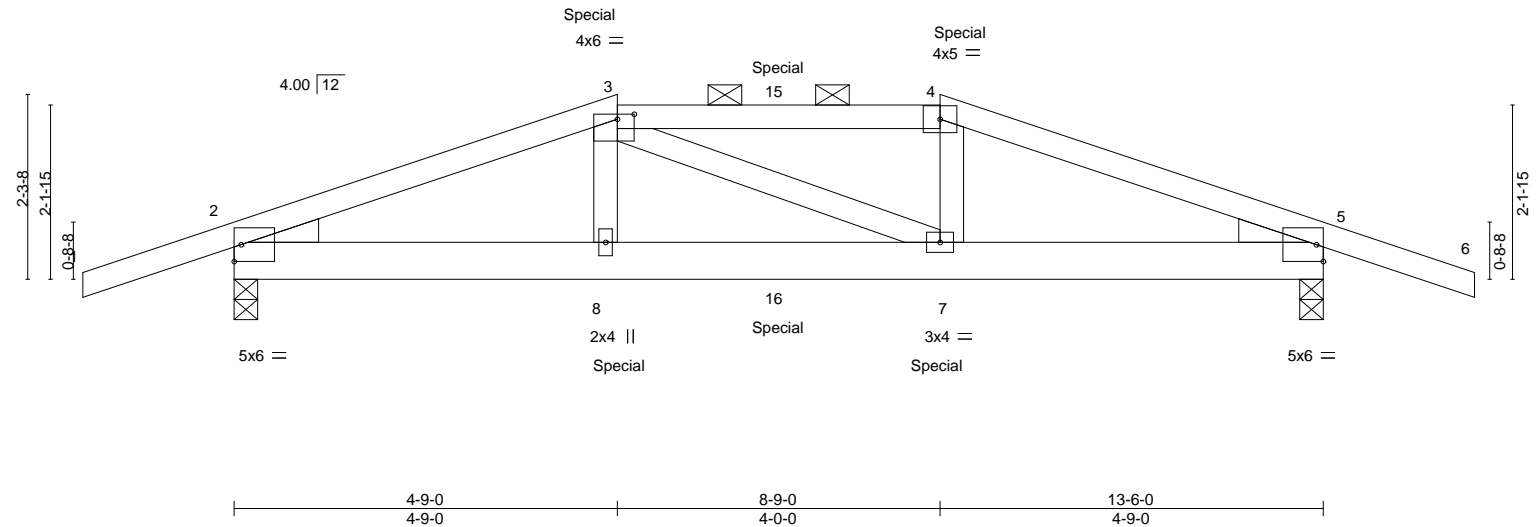


Plate Offsets (X,Y)-- [3:0-2-8,0-0-12]												
LOADING (psf)		SPACING- 2-0-0		CSI.		DEFL. in (loc) l/defl L/d				PLATES GRIP		
TCLL	25.0	Plate Grip DOL	1.15	TC	0.55	Vert(LL)	-0.08	7-8	>999	240	MT20	197/144
TCDL	10.0	Lumber DOL	1.15	BC	0.78	Vert(CT)	-0.14	7-8	>999	180		
BCLL	0.0	Rep Stress Incr	NO	WB	0.07	Horz(CT)	0.03	5	n/a	n/a		
BCDL	10.0	Code IRC2018/TPI2014		Matrix-MS							Weight: 56 lb	FT = 20%

LUMBER-

TOP CHORD 2x4 SPF No.2
BOT CHORD 2x6 SPF No.2
WEBS 2x4 SPF No.2
WEDGE
Left: 2x4 SP No.3, Right: 2x4 SP No.3

BRACING-

TOP CHORD Structural wood sheathing directly applied or 3-8-12 oc purlins, except
2-0-0 oc purlins (3-9-5 max.): 3-4.
BOT CHORD Rigid ceiling directly applied or 10-0-0 oc bracing.

REACTIONS.

(size) 2=0-3-8, 5=0-3-8
Max Horz 2=-36(LC 26)
Max Uplift 2=-260(LC 4), 5=-260(LC 5)
Max Grav 2=1108(LC 1), 5=1108(LC 1)

FORCES. (lb) - Max. Comp./Max. Ten. - All forces 250 (lb) or less except when shown.

TOP CHORD 2-3=-1988/371, 3-4=-1810/369, 4-5=-1980/369
BOT CHORD 2-8=-319/1836, 7-8=-320/1817, 5-7=-305/1828
WEBS 3-8=0/300, 4-7=0/297

NOTES-

- Unbalanced roof live loads have been considered for this design.
- Wind: ASCE 7-16; Vult=115mph (3-second gust) Vasd=91mph; TCDL=6.0psf; BCDL=4.2psf; h=15ft; Cat. II; Exp C; Enclosed; MWFRS (envelope) gable end zone; cantilever left and right exposed; end vertical left and right exposed; Lumber DOL=1.60 plate grip DOL=1.60
- Provide adequate drainage to prevent water ponding.
- This truss has been designed for a 10.0 psf bottom chord live load nonconcurrent with any other live loads.
- Provide mechanical connection (by others) of truss to bearing plate capable of withstanding 260 lb uplift at joint 2 and 260 lb uplift at joint 5.
- This truss is designed in accordance with the 2018 International Residential Code sections R502.11.1 and R802.10.2 and referenced standard ANSI/TPI 1.
- Graphical purlin representation does not depict the size or the orientation of the purlin along the top and/or bottom chord.
- Hanger(s) or other connection device(s) shall be provided sufficient to support concentrated load(s) 85 lb down and 62 lb up at 4-9-0, and 62 lb down and 54 lb up at 6-9-0, and 85 lb down and 62 lb up at 8-9-0 on top chord, and 260 lb down and 77 lb up at 4-9-0, and 40 lb down at 6-9-0, and 260 lb down and 77 lb up at 8-8-4 on bottom chord. The design/selection of such connection device(s) is the responsibility of others.
- In the LOAD CASE(S) section, loads applied to the face of the truss are noted as front (F) or back (B).

LOAD CASE(S) Standard

- Dead + Roof Live (balanced): Lumber Increase=1.15, Plate Increase=1.15
Uniform Loads (plf)
Vert: 1-3=-70, 3-4=-70, 4-6=-70, 9-12=-20



June 12, 2023

Continued on page 2

WARNING - Verify design parameters and READ NOTES ON THIS AND INCLUDED MITEK REFERENCE PAGE MII-7473 rev. 5/19/2020 BEFORE USE.

Design valid for use only with MiTek® connectors. This design is based only upon parameters shown, and is for an individual building component, not a truss system. Before use, the building designer must verify the applicability of the design parameters and properly incorporate this design into the overall building design. Bracing indicated is to prevent buckling of individual truss web and/or chord members only. Additional temporary and permanent bracing is always required for stability and to prevent collapse with possible personal injury and property damage. For general guidance regarding the fabrication, storage, delivery, erection and bracing of trusses and truss systems, see

Safety Information available from Truss Plate Institute, 2670 Crain Highway, Suite 203 Waldorf, MD 20601

ANSI/TPI1 Quality Criteria, DSB-89 and BCSI Building Component



16023 Swingley Ridge Rd
Chesterfield, MO 63017

Job	Truss	Truss Type	Qty	Ply	Summit/161 Highland Meadows	RELEASE FOR CONSTRUCTION
3564895	D1	Hip Girder	1	1	Job Reference (optional)	AS NOTED FOR PLAN REVIEW DEVELOPMENT SERVICES LEE'S SUMMIT, MISSOURI

Builders FirstSource (Valley Center),
Valley Center, KS - 67147,
8.630 s Nov 19 2022 MiTek Industries, Inc.
Thu Jun 8 14:18:11 2023 Page 2
ID:icBMJaMgT1gasuUyx9?RhvzDEHb-RfC?PsB70Hq3NSqPqnL8v3uITxbS KV rCj d7 J4ZIC?

07/03/2023


LOAD CASE(S) Standard
 Concentrated Loads (lb)
 Vert: 3=-62(F) 4=-62(F) 8=-260(F) 7=-260(F) 15=-62(F) 16=-33(F)

Job	Truss	Truss Type	Qty	Ply	Summit/161 Highland Meadows	RELEASE FOR CONSTRUCTION
3564895	D2	Common	2	1		AS NOTED FOR PLAN REVIEW
					Job Reference (optional)	DEVELOPMENT SERVICES
						LEE'S SUMMIT, MISSOURI

Builders FirstSource (Valley Center), Valley Center, KS - 67147,

8.630 s Nov 19 2022 MiTek Industries, Inc. Thu Jun 9 7 47 12 2023 Page 1

ID:icBMJaMgT1gasuUyx9?RhvzDEHb-RfC?PsB70Hq3NSpPqnL8v3uITxb6KVrCSg17J4ZICP

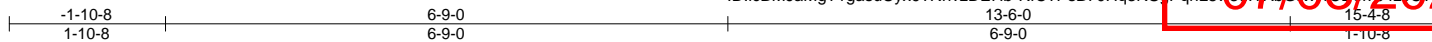

Scale = 1:27.7

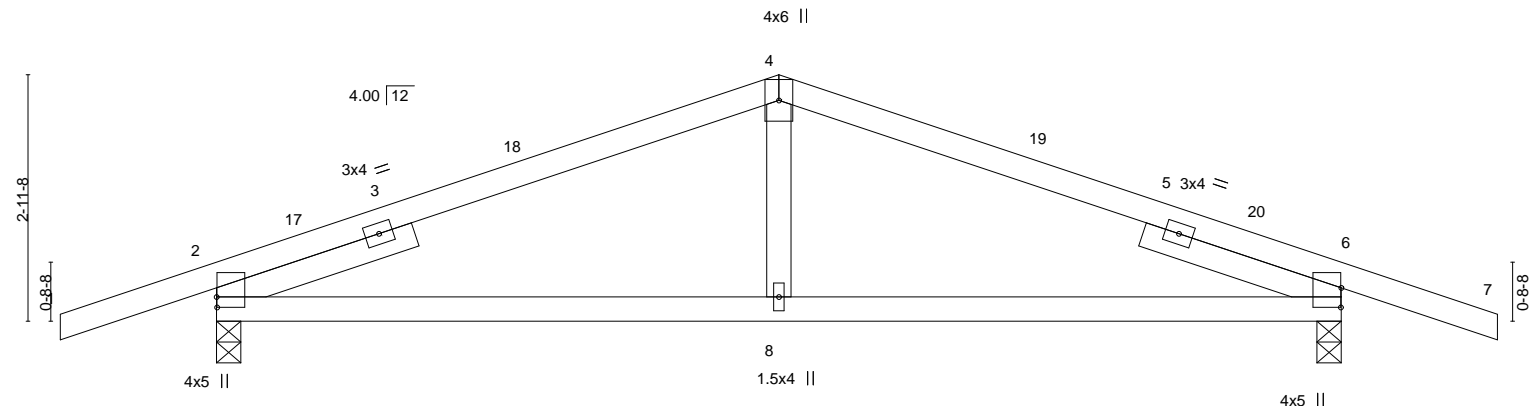


Plate Offsets (X,Y)--	[2:0-1-8,0-0-1], [6:0-2-13,0-0-1]
-----------------------	-----------------------------------

LOADING (psf)	SPACING-	2-0-0	CSI.	DEFL.	in (loc)	l/defl	L/d	PLATES	GRIP
TCLL 25.0	Plate Grip DOL	1.15	TC 0.37	Vert(LL)	-0.05 8-15	>999	240	MT20	197/144
TCDL 10.0	Lumber DOL	1.15	BC 0.34	Vert(CT)	-0.08 8-15	>999	180		
BCLL 0.0	Rep Stress Incr	YES	WB 0.06	Horz(CT)	0.02 2	n/a	n/a		
BCDL 10.0	Code IRC2018/TPI2014		Matrix-AS					Weight: 45 lb	FT = 20%

LUMBER-

TOP CHORD 2x4 SPF No.2
 BOT CHORD 2x4 SPF No.2
 WEBS 2x4 SPF No.2
 SLIDER Left 2x4 SPF No.2 2-6-0, Right 2x4 SPF No.2 2-6-0

BRACING-

TOP CHORD Structural wood sheathing directly applied.
 BOT CHORD Rigid ceiling directly applied.

REACTIONS.

(size) 2=0-3-8, 6=0-3-8
 Max Horz 2=-46(LC 13)
 Max Uplift 2=-160(LC 8), 6=-160(LC 9)
 Max Grav 2=739(LC 1), 6=739(LC 1)

FORCES. (lb) - Max. Comp./Max. Ten. - All forces 250 (lb) or less except when shown.

TOP CHORD 2-4=-862/264, 4-6=-862/264
 BOT CHORD 2-8=-148/813, 6-8=-148/813
 WEBS 4-8=0/264

NOTES-

- 1) Unbalanced roof live loads have been considered for this design.
- 2) Wind: ASCE 7-16; Vult=115mph (3-second gust) Vasd=91mph; TCDL=6.0psf; BCDL=4.2psf; h=15ft; Cat. II; Exp C; Enclosed; MWFRS (envelope) gable end zone and C-C Exterior(2E) -1-10-8 to 1-1-8, Interior(1) 1-1-8 to 6-9-0, Exterior(2R) 6-9-0 to 9-9-0, Interior(1) 9-9-0 to 15-4-8 zone; cantilever left and right exposed; end vertical left and right exposed; C-C for members and forces & MWFRS for reactions shown; Lumber DOL=1.60 plate grip DOL=1.60
- 3) This truss has been designed for a 10.0 psf bottom chord live load nonconcurrent with any other live loads.
- 4) Provide mechanical connection (by others) of truss to bearing plate capable of withstanding 160 lb uplift at joint 2 and 160 lb uplift at joint 6.
- 5) This truss is designed in accordance with the 2018 International Residential Code sections R502.11.1 and R802.10.2 and referenced standard ANSI/TPI 1.
- 6) This truss design requires that a minimum of 7/16" structural wood sheathing be applied directly to the top chord and 1/2" gypsum sheetrock be applied directly to the bottom chord.



June 12, 2023

WARNING - Verify design parameters and READ NOTES ON THIS AND INCLUDED MITEK REFERENCE PAGE MII-7473 rev. 5/19/2020 BEFORE USE.

Design valid for use only with MiTek® connectors. This design is based only upon parameters shown, and is for an individual building component, not a truss system. Before use, the building designer must verify the applicability of design parameters and properly incorporate this design into the overall building design. Bracing indicated is to prevent buckling of individual truss web and/or chord members only. Additional temporary and permanent bracing is always required for stability and to prevent collapse with possible personal injury and property damage. For general guidance regarding the fabrication, storage, delivery, erection and bracing of trusses and truss systems, see

ANSI/TPI1 Quality Criteria, DSB-89 and BCSI Building Component

Safety Information available from Truss Plate Institute, 2670 Crain Highway, Suite 203 Waldorf, MD 20601



16023 Swingley Ridge Rd
 Chesterfield, MO 63017

Job	Truss	Truss Type	Qty	Ply	Summit/161 Highland Meadows	RELEASE FOR CONSTRUCTION
3564895	E1	Hip Girder	1	2		AS NOTED FOR PLAN REVIEW
					Job Reference (optional)	DEVELOPMENT SERVICES
						LEE'S SUMMIT, MISSOURI

Builders FirstSource (Valley Center),	Valley Center, KS - 67147,	8.630 s Nov 19 2022 MiTek Industries, Inc.	Thu Jun 9 4 10 14 2022 Page 1
ID:icBMJaMgT1gasuUyx9?RhvzDEHb-RfC?PsB70Hq3NSuPqnL8v3uITxb6KVrCm7f4ZICP		24-9-12	29-4-0
4-7-12 9-0-0 14-6-0 20-1-12 24-9-12 29-4-0 33-11-15 39-4-0		4-7-12	5-4-1
4-7-12 4-4-4 5-6-0 5-7-12 4-8-0 4-6-4 4-7-15 5-4-1		4-7-12	0-10-8
		Scale = 1:66.8	

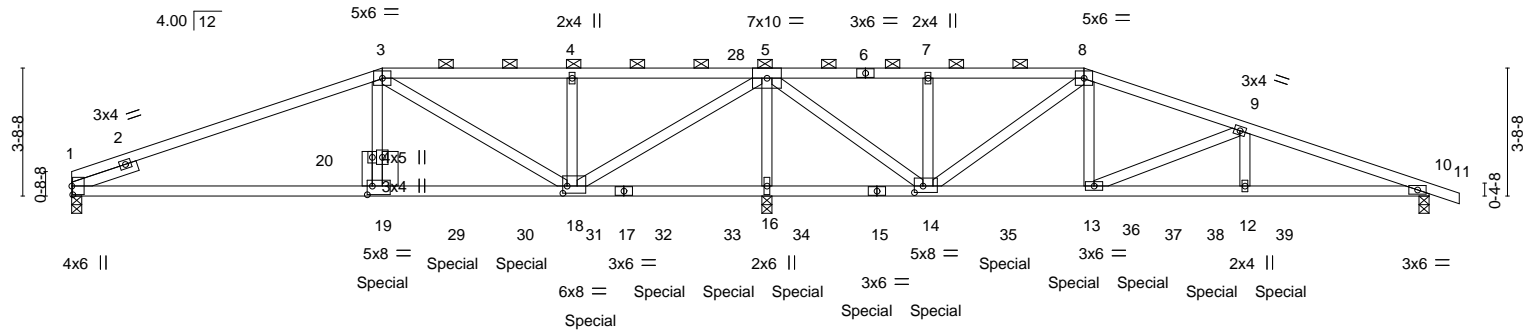


Plate Offsets (X,Y)--		[1:0-3-0,0-0-5], [14:0-3-0,0-2-4], [18:0-1-8,0-2-8], [19:0-1-12,0-3-0]	
LOADING (psf)	SPACING-	2-0-0	CSI.
TCLL 25.0	Plate Grip DOL	1.15	TC 0.91
TCDL 10.0	Lumber DOL	1.15	BC 0.93
BCLL 0.0	Rep Stress Incr	NO	WB 0.74
BCDL 10.0	Code IRC2018/TPI2014		Matrix-MS
		DEFL.	in (loc) l/defl L/d
		Vert(LL)	-0.15 18-19 >999 240
		Vert(CT)	-0.26 18-19 >943 180
		Horz(CT)	0.03 10 n/a n/a
		PLATES	GRIP
		MT20	197/144
		Weight: 302 lb	FT = 20%

LUMBER-	BRACING-
TOP CHORD	TOP CHORD
BOT CHORD	BOT CHORD
WEBS	
SLIDER	

REACTIONS.	(size) 1=0-3-8, 16=0-3-8, 10=0-3-8
	Max Horz 1=-69(LC 9)
	Max Uplift 1=-317(LC 8), 16=-1581(LC 5), 10=-329(LC 5)
	Max Grav 1=1449(LC 21), 16=7028(LC 1), 10=1518(LC 1)

FORCES.	(lb) - Max. Comp./Max. Ten. - All forces 250 (lb) or less except when shown.
TOP CHORD	1-3=-3085/728, 3-4=-817/331, 4-5=-817/331, 5-7=-267/550, 7-8=-267/550, 8-9=-1745/457, 9-10=-3624/799
BOT CHORD	1-19=-646/2838, 18-19=-640/2805, 16-18=-4239/971, 14-16=-4239/971, 13-14=-306/1532, 12-13=-706/3403, 10-12=-706/3403
WEBS	3-19=-314/1775, 3-18=-2411/471, 4-18=-423/144, 5-18=-1218/5503, 5-16=-5914/1360, 5-14=-1022/4573, 7-14=-307/128, 8-14=-2480/515, 8-13=-335/1692, 9-13=-1951/417, 9-12=-142/989

- NOTES-**
- 2-ply truss to be connected together with 10d (0.131"x3") nails as follows:
Top chords connected as follows: 2x4 - 1 row at 0-9-0 oc.
Bottom chords connected as follows: 2x4 - 1 row at 0-2-0 oc.
Webs connected as follows: 2x4 - 1 row at 0-9-0 oc, 2x6 - 2 rows staggered at 0-9-0 oc.
 - All loads are considered equally applied to all plies, except if noted as front (F) or back (B) face in the LOAD CASE(S) section. Ply to ply connections have been provided to distribute only loads noted as (F) or (B), unless otherwise indicated.
 - Unbalanced roof live loads have been considered for this design.
 - Wind: ASCE 7-16; Vult=115mph (3-second gust) Vasd=91mph; TCDL=6.0psf; BCDL=4.2psf; h=15ft; Cat. II; Exp C; Enclosed; MWFRS (envelope) gable end zone; cantilever left and right exposed ; end vertical left and right exposed; Lumber DOL=1.60 plate grip DOL=1.60
 - Provide adequate drainage to prevent water ponding.
 - This truss has been designed for a 10.0 psf bottom chord live load nonconcurrent with any other live loads.
 - Provide mechanical connection (by others) of truss to bearing plate capable of withstanding 317 lb uplift at joint 1, 1581 lb uplift at joint 16 and 329 lb uplift at joint 10.
 - This truss is designed in accordance with the 2018 International Residential Code sections R502.11.1 and R802.10.2 and referenced standard ANSI/TPI 1.
 - Graphical purlin representation does not depict the size or the orientation of the purlin along the top and/or bottom chord.



June 12,2023

Continued on page 2	<p>WARNING - Verify design parameters and READ NOTES ON THIS AND INCLUDED MITEK REFERENCE PAGE MII-7473 rev. 5/19/2020 BEFORE USE.</p> <p>Design valid for use only with MiTek® connectors. This design is based only upon parameters shown, and is for an individual building component, not a truss system. Before use, the building designer must verify the applicability of design parameters and properly incorporate this design into the overall building design. Bracing indicated is to prevent buckling of individual truss web and/or chord members only. Additional temporary and permanent bracing is always required for stability and to prevent collapse with possible personal injury and property damage. For general guidance regarding the fabrication, storage, delivery, erection and bracing of trusses and truss systems, see ANSI/TPI1 Quality Criteria, DSB-89 and BCSI Building Component Safety Information available from Truss Plate Institute, 2670 Crain Highway, Suite 203 Waldorf, MD 20601</p>	<p>MiTek</p> <p>16023 Swingley Ridge Rd Chesterfield, MO 63017</p>
---------------------	--	---

Job	Truss	Truss Type	Qty	Ply	Summit/161 Highland Meadows	RELEASE FOR CONSTRUCTION
3564895	E1	Hip Girder	1	2	Job Reference (optional)	AS NOTED FOR PLAN REVIEW DEVELOPMENT SERVICES LEE'S SUMMIT, MISSOURI

Builders FirstSource (Valley Center),
Valley Center, KS - 67147,
8.630 s Nov 19 2022 MiTek Industries, Inc.
Thu Jun 09 14:18:14 2023 Page 2
ID:icBMJaMgT1gasuUyx9?RhvzDEHb-RfC?PsB70Hq3NSqPqnL8v3uITxb6KVrCm7J4ZUIC?
07/03/2023

NOTES-

10) Hanger(s) or other connection device(s) shall be provided sufficient to support concentrated load(s) 1383 lb down and 328 lb up at 9-0-0, 370 lb down and 111 lb up at 11-0-12, 370 lb down and 111 lb up at 13-0-12, 370 lb down and 111 lb up at 15-0-12, 370 lb down and 111 lb up at 17-0-12, 370 lb down and 111 lb up at 19-0-12, 370 lb down and 111 lb up at 21-0-12, 370 lb down and 111 lb up at 23-0-12, 370 lb down and 111 lb up at 25-0-12, 370 lb down and 111 lb up at 27-0-12, 370 lb down and 111 lb up at 29-0-12, 365 lb down and 92 lb up at 31-0-12, and 365 lb down and 89 lb up at 33-0-12, and 552 lb down and 122 lb up at 35-0-12 on bottom chord. The design/selection of such connection device(s) is the responsibility of others.

LOAD CASE(S) Standard

1) Dead + Roof Live (balanced): Lumber Increase=1.15, Plate Increase=1.15


Uniform Loads (plf)

Vert: 1-3=-70, 3-8=-70, 8-11=-70, 21-25=-20

Concentrated Loads (lb)

Vert: 19=-1383(F) 14=-370(F) 15=-370(F) 29=-370(F) 30=-370(F) 31=-370(F) 32=-370(F) 33=-370(F) 34=-370(F) 35=-370(F) 36=-370(F) 37=-365(F) 38=-365(F) 39=-552(F)

Job	Truss	Truss Type	Qty	Ply	Summit/161 Highland Meadows	RELEASE FOR CONSTRUCTION
3564895	E2	Roof Special Girder	1	1		AS NOTED FOR PLAN REVIEW DEVELOPMENT SERVICES LEE'S SUMMIT, MISSOURI
Builders FirstSource (Valley Center), Valley Center, KS - 67147,						8.630 s Nov 19 2022 MiTek Industries, Inc. Thu Jun 07 10:15:30 2023 Page 1
Job Reference (optional)						ID:icBMJaMgT1gasuUyx9?RhvzDEHb-RfC?PsB70Hq3NSaPqnL8v3uITxb6SVrCm7J4ZIC?07/06/2023

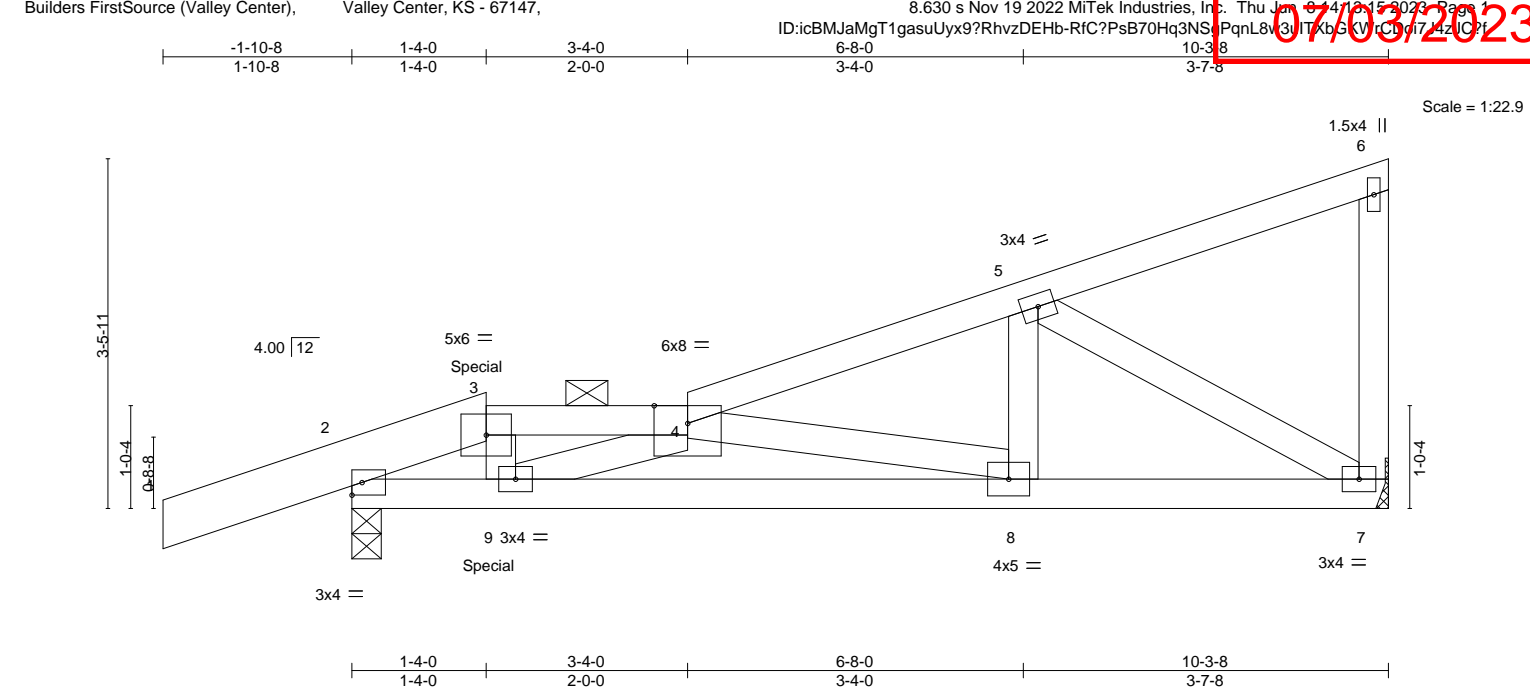

LOADING (psf)	SPACING-	2-0-0	CSI.	DEFL.	in	(loc)	l/defl	L/d	PLATES	GRIP
TCLL 25.0	Plate Grip DOL	1.15	TC 0.18	Vert(LL)	-0.03	8-9	>999	240	MT20	197/144
TCDL 10.0	Lumber DOL	1.15	BC 0.38	Vert(CT)	-0.06	8-9	>999	180		
BCLL 0.0	Rep Stress Incr	NO	WB 0.18	Horz(CT)	0.01	7	n/a	n/a		
BCDL 10.0	Code IRC2018/TPI2014		Matrix-MS						Weight: 44 lb	FT = 20%

LUMBER-			BRACING-	
TOP CHORD	2x4 SPF No.2 *Except*		TOP CHORD	Structural wood sheathing directly applied or 6-0-0 oc purlins, except end verticals, and 2-0-0 oc purlins (6-0-0 max.): 3-4.
	1-3: 2x6 SPF No.2		BOT CHORD	Rigid ceiling directly applied or 10-0-0 oc bracing.
BOT CHORD	2x4 SPF No.2			
WEBS	2x4 SPF No.2			

REACTIONS.	(size) 7=Mechanical, 2=0-3-8
	Max Horz 2=132(LC 7)
	Max Uplift 7=84(LC 8), 2=123(LC 4)
	Max Grav 7=435(LC 1), 2=538(LC 1)

FORCES.	(lb) - Max. Comp./Max. Ten. - All forces 250 (lb) or less except when shown.
TOP CHORD	2-3=-642/22, 3-4=-603/26, 4-5=-611/84
BOT CHORD	2-9=-78/494, 8-9=-192/1056, 7-8=-84/555
WEBS	3-9=-13/282, 4-8=-514/110, 5-8=0/264, 5-7=-626/126, 4-9=-658/212

- NOTES-**
- 1) Wind: ASCE 7-16; Vult=115mph (3-second gust) Vasd=91mph; TCDL=6.0psf; BCDL=4.2psf; h=15ft; Cat. II; Exp C; Enclosed; MWFRS (envelope) gable end zone; cantilever left and right exposed; end vertical left and right exposed; Lumber DOL=1.60 plate grip DOL=1.60
 - 2) Provide adequate drainage to prevent water ponding.
 - 3) This truss has been designed for a 10.0 psf bottom chord live load nonconcurrent with any other live loads.
 - 4) Refer to girder(s) for truss to truss connections.
 - 5) Provide mechanical connection (by others) of truss to bearing plate capable of withstanding 84 lb uplift at joint 7 and 123 lb uplift at joint 2.
 - 6) This truss is designed in accordance with the 2018 International Residential Code sections R502.11.1 and R802.10.2 and referenced standard ANSI/TPI 1.
 - 7) Graphical purlin representation does not depict the size or the orientation of the purlin along the top and/or bottom chord.
 - 8) Hanger(s) or other connection device(s) shall be provided sufficient to support concentrated load(s) 139 lb down and 262 lb up at 1-4-0 on top chord, and 41 lb down and 44 lb up at 1-4-0 on bottom chord. The design/selection of such connection device(s) is the responsibility of others.
 - 9) In the LOAD CASE(S) section, loads applied to the face of the truss are noted as front (F) or back (B).

LOAD CASE(S)	Standard
1) Dead + Roof Live (balanced):	Lumber Increase=1.15, Plate Increase=1.15
Uniform Loads (plf)	
	Vert: 1-3=-70, 3-4=-70, 4-6=-70, 7-10=-20
Concentrated Loads (lb)	
	Vert: 3=71(F)



Job	Truss	Truss Type	Qty	Ply	Summit/161 Highland Meadows	AS NOTED FOR PLAN REVIEW DEVELOPMENT SERVICES LEE'S SUMMIT, MISSOURI
3564895	E3	Roof Special	1	1	Job Reference (optional)	

Builders FirstSource (Valley Center), Valley Center, KS - 67147,

8.630 s Nov 19 2022 MiTek Industries, Inc. Thu Jun 8 7:47:16 2023 Page 1

ID:icBMJaMgT1gasuUyx9?RhvzDEHb-RfC?PsB70Hq3NSqPqnL8v3uITxb6KVrCg7J4ZICP

07/05/2023

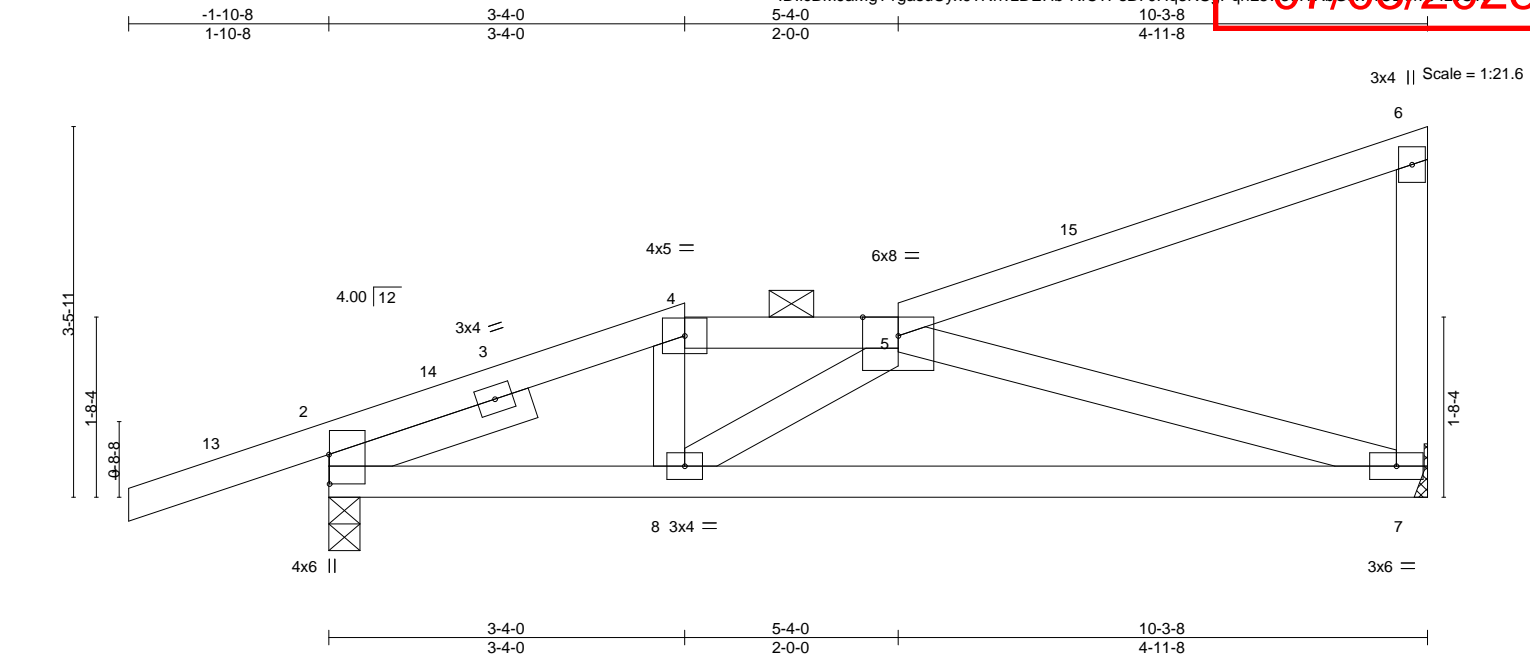


Plate Offsets (X,Y)--		[2:0-3-5,0-0-1]	
LOADING (psf)	SPACING-	2-0-0	CSI.
TCLL 25.0	Plate Grip DOL	1.15	TC 0.24
TCDL 10.0	Lumber DOL	1.15	BC 0.37
BCLL 0.0	Rep Stress Incr	YES	WB 0.35
BCDL 10.0	Code	IRC2018/TPI2014	Matrix-AS
			DEFL. in (loc) l/defl L/d
			Vert(LL) -0.07 7-8 >999 240
			Vert(CT) -0.14 7-8 >883 180
			Horz(CT) 0.01 7 n/a n/a
			PLATES GRIP
			MT20 197/144
			Weight: 42 lb FT = 20%

LUMBER-

TOP CHORD 2x4 SPF No.2
BOT CHORD 2x4 SPF No.2
WEBS 2x4 SPF No.2
SLIDER Left 2x4 SPF No.2 2-0-0

BRACING-

TOP CHORD Structural wood sheathing directly applied, except end verticals, and 2-0-0 oc purlins (6-0-0 max.): 4-5.
BOT CHORD Rigid ceiling directly applied.

REACTIONS.

(size) 7=Mechanical, 2=0-3-8
Max Horz 2=131(LC 11)
Max Uplift 7=-88(LC 12), 2=-149(LC 8)
Max Grav 7=444(LC 1), 2=600(LC 1)

FORCES. (lb) - Max. Comp./Max. Ten. - All forces 250 (lb) or less except when shown.

TOP CHORD 2-4=-713/135, 4-5=-635/145
BOT CHORD 2-8=-293/653, 7-8=-320/768
WEBS 5-7=-754/286

NOTES-

- 1) Wind: ASCE 7-16; Vult=115mph (3-second gust) Vasd=91mph; TCDL=6.0psf; BCDL=4.2psf; h=15ft; Cat. II; Exp C; Enclosed; MWFRS (envelope) gable end zone and C-C Exterior(2E) -1-10-8 to 1-1-8, Interior(1) 1-1-8 to 3-4-0, Exterior(2E) 3-4-0 to 5-4-0, Interior(1) 5-4-0 to 10-1-12 zone; cantilever left and right exposed; end vertical left and right exposed; C-C for members and forces & MWFRS for reactions shown; Lumber DOL=1.60 plate grip DOL=1.60
- 2) Provide adequate drainage to prevent water ponding.
- 3) This truss has been designed for a 10.0 psf bottom chord live load nonconcurrent with any other live loads.
- 4) Refer to girder(s) for truss to truss connections.
- 5) Provide mechanical connection (by others) of truss to bearing plate capable of withstanding 88 lb uplift at joint 7 and 149 lb uplift at joint 2.
- 6) This truss is designed in accordance with the 2018 International Residential Code sections R502.11.1 and R802.10.2 and referenced standard ANSI/TPI 1.
- 7) This truss design requires that a minimum of 7/16" structural wood sheathing be applied directly to the top chord and 1/2" gypsum sheetrock be applied directly to the bottom chord.
- 8) Graphical purlin representation does not depict the size or the orientation of the purlin along the top and/or bottom chord.



June 12, 2023

WARNING - Verify design parameters and READ NOTES ON THIS AND INCLUDED MITEK REFERENCE PAGE MII-7473 rev. 5/19/2020 BEFORE USE.

Design valid for use only with MiTek® connectors. This design is based only upon parameters shown, and is for an individual building component, not a truss system. Before use, the building designer must verify the applicability of design parameters and properly incorporate this design into the overall building design. Bracing indicated is to prevent buckling of individual truss web and/or chord members only. Additional temporary and permanent bracing is always required for stability and to prevent collapse with possible personal injury and property damage. For general guidance regarding the fabrication, storage, delivery, erection and bracing of trusses and truss systems, see

Safety Information available from Truss Plate Institute, 2670 Crain Highway, Suite 203 Waldorf, MD 20601



16023 Swingley Ridge Rd
Chesterfield, MO 63017

Job	Truss	Truss Type	Qty	Ply	Summit/161 Highland Meadows	RELEASE FOR CONSTRUCTION
3564895	E4	Half Hip Girder	1	1		AS NOTED FOR PLAN REVIEW DEVELOPMENT SERVICES LEE'S SUMMIT, MISSOURI
Builders FirstSource (Valley Center), Valley Center, KS - 67147,						8.630 s Nov 19 2022 MiTek Industries, Inc. Thu Jun 07 14:18:18 2023 Page 1
Job Reference (optional)						158827546

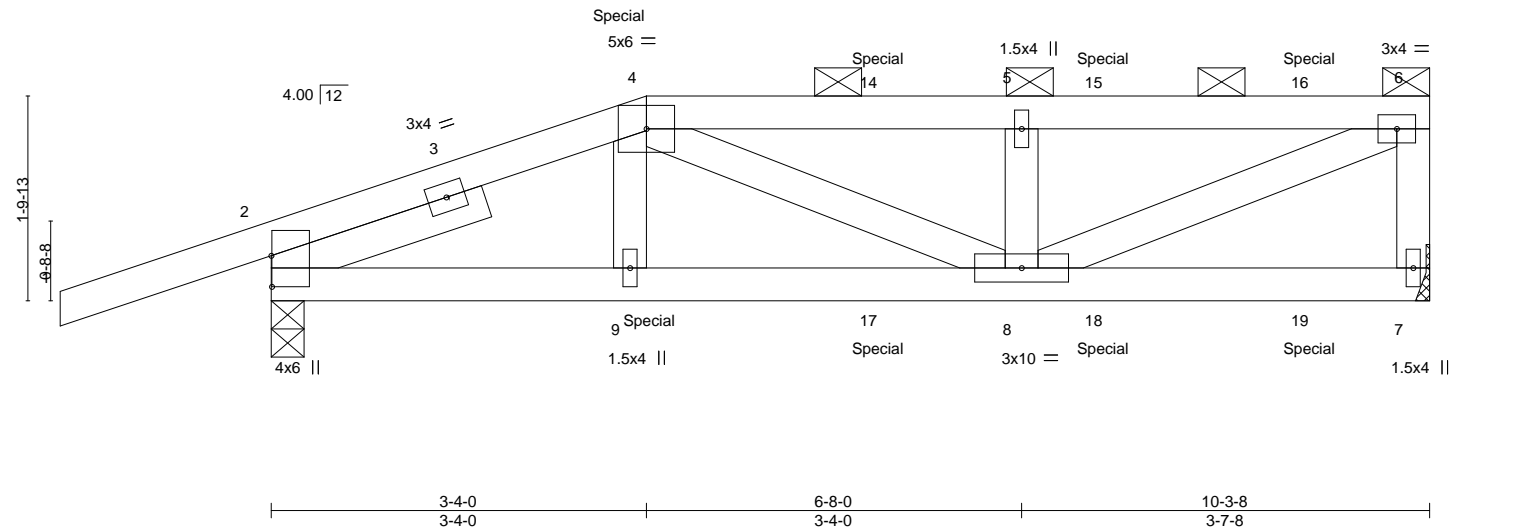
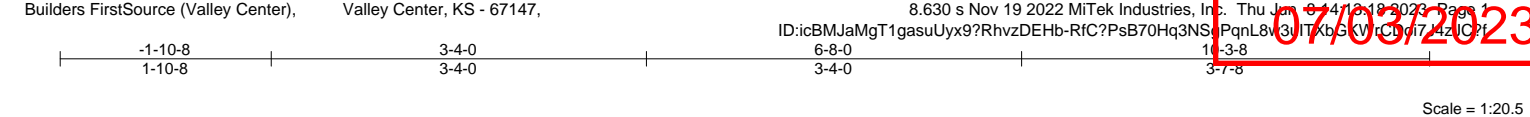


Plate Offsets (X,Y)-- [2:0-3-5,0-0-1]									
LOADING (psf)		SPACING- 2-0-0		CSI.		DEFL. in (loc) l/defl L/d		PLATES	GRIP
TCLL	25.0	Plate Grip DOL	1.15	TC	0.27	Vert(LL)	-0.02 8-9 >999	240	MT20 197/144
TCDL	10.0	Lumber DOL	1.15	BC	0.36	Vert(CT)	-0.04 8-9 >999	180	
BCLL	0.0	Rep Stress Incr	NO	WB	0.21	Horz(CT)	0.01 7 n/a	n/a	
BCDL	10.0	Code IRC2018/TPI2014		Matrix-MS					Weight: 40 lb FT = 20%

LUMBER-	BRACING-
TOP CHORD 2x4 SPF No.2	TOP CHORD Structural wood sheathing directly applied or 6-0-0 oc purlins, except end verticals, and 2-0-0 oc purlins (6-0-0 max.): 4-6.
BOT CHORD 2x4 SPF No.2	BOT CHORD Rigid ceiling directly applied or 10-0-0 oc bracing.
WEBS 2x4 SPF No.2	
SLIDER Left 2x4 SPF No.2 2-0-0	

REACTIONS.	(size) 7=Mechanical, 2=0-3-8
	Max Horz 2=67(LC 7)
	Max Uplift 7=102(LC 5), 2=179(LC 4)
	Max Grav 7=518(LC 1), 2=676(LC 1)

FORCES.	(lb) - Max. Comp./Max. Ten. - All forces 250 (lb) or less except when shown.
TOP CHORD	2-4=-841/165, 4-5=-837/175, 5-6=-837/175, 6-7=-471/115
BOT CHORD	2-9=-168/769, 8-9=-170/760
WEBS	5-8=-293/114, 6-8=-175/871

- NOTES-**
- Unbalanced roof live loads have been considered for this design.
 - Wind: ASCE 7-16; Vult=115mph (3-second gust) Vasd=91mph; TCDL=6.0psf; BCDL=4.2psf; h=15ft; Cat. II; Exp C; Enclosed; MWFRS (envelope) gable end zone; cantilever left and right exposed ; end vertical left and right exposed; Lumber DOL=1.60 plate grip DOL=1.60
 - Provide adequate drainage to prevent water ponding.
 - This truss has been designed for a 10.0 psf bottom chord live load nonconcurrent with any other live loads.
 - Refer to girder(s) for truss to truss connections.
 - Provide mechanical connection (by others) of truss to bearing plate capable of withstanding 102 lb uplift at joint 7 and 179 lb uplift at joint 2.
 - This truss is designed in accordance with the 2018 International Residential Code sections R502.11.1 and R802.10.2 and referenced standard ANSI/TPI 1.
 - Graphical purlin representation does not depict the size or the orientation of the purlin along the top and/or bottom chord.
 - Hanger(s) or other connection device(s) shall be provided sufficient to support concentrated load(s) 33 lb down and 38 lb up at 3-4-0, 30 lb down and 38 lb up at 5-4-12, and 30 lb down and 37 lb up at 7-4-12, and 30 lb down and 39 lb up at 9-2-12 on top chord, and 103 lb down and 44 lb up at 3-4-0, 19 lb down at 5-4-12, and 19 lb down at 7-4-12, and 19 lb down at 9-2-12 on bottom chord. The design/selection of such connection device(s) is the responsibility of others.
 - In the LOAD CASE(S) section, loads applied to the face of the truss are noted as front (F) or back (B).

LOAD CASE(S)	Standard
1) Dead + Roof Live (balanced):	Lumber Increase=1.15, Plate Increase=1.15
Uniform Loads (plf)	
Vert:	1-4=-70, 4-6=-70, 7-10=-20



June 12, 2023

Job	Truss	Truss Type	Qty	Ply	Summit/161 Highland Meadows	RELEASE FOR CONSTRUCTION
3564895	E4	Half Hip Girder	1	1	Job Reference (optional)	AS NOTED FOR PLAN REVIEW DEVELOPMENT SERVICES LEE'S SUMMIT, MISSOURI

Builders FirstSource (Valley Center), Valley Center, KS - 67147,

8.630 s Nov 19 2022 MiTek Industries, Inc. Thu Jun 8 14:18:18 2023 Page 2
ID:icBMJaMgT1gasuUyx9?RhvzDEHb-RfC?PsB70Hq3NSqPqnL8v3uITxbS KV rCm7J4ZIC?

LOAD CASE(S) Standard
Concentrated Loads (lb)
Vert: 9=-78(B) 4=-9(B) 14=-9(B) 15=-9(B) 16=-12(B) 17=-10(B) 18=-10(B) 19=-11(B)

16023 Swingley Ridge Rd
Chesterfield, MO 63017

Job	Truss	Truss Type	Qty	Ply	Summit/161 Highland Meadows	RELEASE FOR CONSTRUCTION
3564895	F1	Half Hip Girder	1	1	Job Reference (optional)	AS NOTED FOR PLAN REVIEW DEVELOPMENT SERVICES LEE'S SUMMIT, MISSOURI

Builders FirstSource (Valley Center), Valley Center, KS - 67147,

8.630 s Nov 19 2022 MiTek Industries, Inc. Thu Jun 8 7 47 18 19 2023 Page 2
ID:icBMJaMgT1gasuUyx9?RhvzDEHb-RfC?PsB70Hq3NSqPqnL8v3uITxbS KV rC d7 J4ZIC?

LOAD CASE(S) Standard

Concentrated Loads (lb)

Vert: 4=-54(F) 9=-117(F) 14=-54(F) 15=-54(F) 16=-36(F) 17=-36(F)

07/03/2023

 **WARNING - Verify design parameters and READ NOTES ON THIS AND INCLUDED MITEK REFERENCE PAGE MII-7473 rev. 5/19/2020 BEFORE USE.**

Design valid for use only with MiTek® connectors. This design is based only upon parameters shown, and is for an individual building component, not a truss system. Before use, the building designer must verify the applicability of design parameters and properly incorporate this design into the overall building design. Bracing indicated is to prevent buckling of individual truss web and/or chord members only. Additional temporary and permanent bracing is always required for stability and to prevent collapse with possible personal injury and property damage. For general guidance regarding the fabrication, storage, delivery, erection and bracing of trusses and truss systems, see **ANSI/TPI1 Quality Criteria, DSB-89 and BCSI Building Component Safety Information** available from Truss Plate Institute, 2670 Crain Highway, Suite 203 Waldorf, MD 20601




16023 Swingley Ridge Rd
Chesterfield, MO 63017

Builders FirstSource (Valley Center).	Valley Center, KS - 67147.
---------------------------------------	----------------------------

8.630 s Nov 19 2022 MiTek Industries, Inc. Thu Jun 8 14:13:20 2023 Page
ID:icBMJaMaT1gasuUvx9?RhvzDEHb-RfC?PsB70Ha3NSQPanL8v3uITb3G5VRChg7HzjOC

07/03/2023

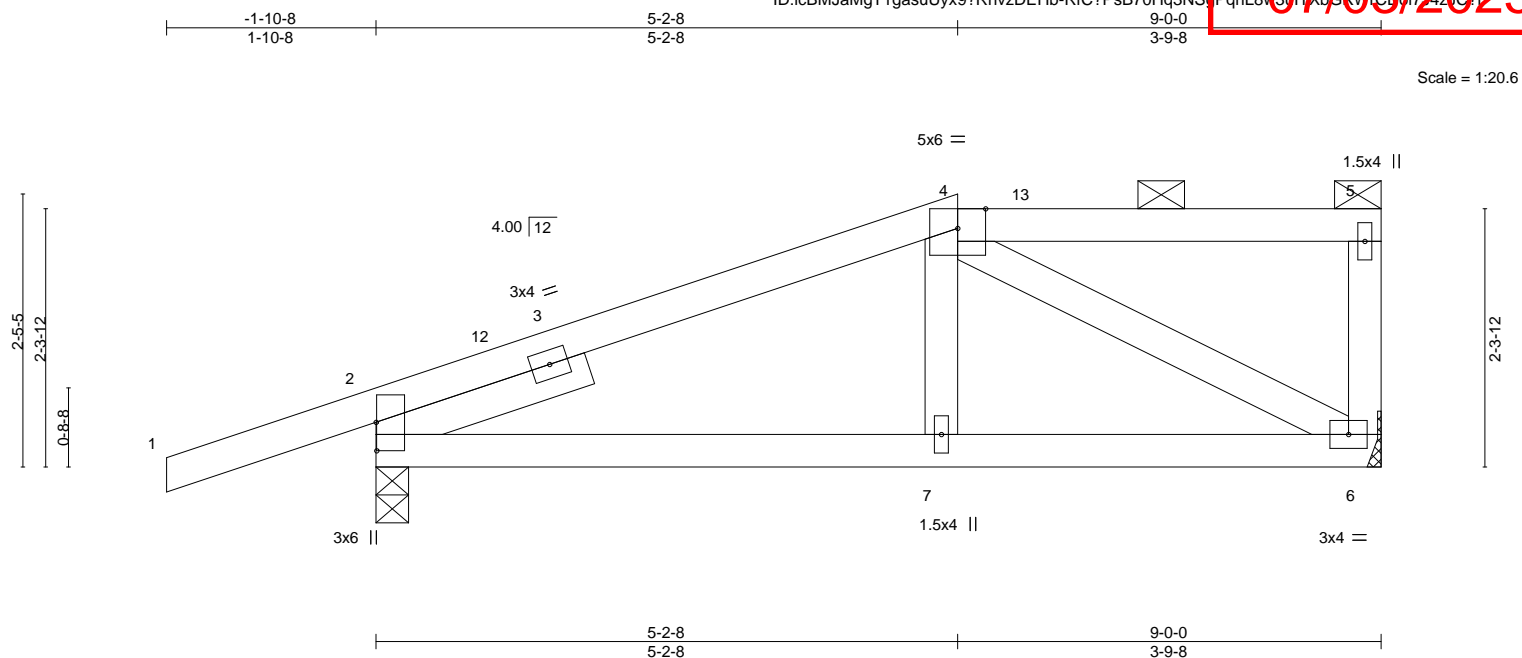

LUMBER-
TOP CHORD 2x4 SPF No.2
BOT CHORD 2x4 SPF No.2
WEBS 2x4 SPF No.2
SLIDER Left 2x4 SPF No.2 2-0-0

BRACING-	
TOP CHORD	Structural wood sheathing directly applied, except end verticals, and 2-0-0 oc purlins (6-0-0 max.): 4-5.
BOT CHORD	Rigid ceiling directly applied.

REACTIONS. (size) 2=0-3-8, 6=Mechanical
Max Horz 2=87(LC 11)
Max Uplift 2=144(LC 8), 6=69(LC 8)
Max Grav 2=544(LC 1), 6=385(LC 1)

FORCES. (lb) - Max. Comp./Max. Ten. - All forces 250 (lb) or less except when shown.

TOP CHORD 2-4=-434/153
BOT CHORD 2-7=-226/414, 6-7=-227/406
WEBS 4-6=-467/233

NOTES-

- 1) Unbalanced roof live loads have been considered for this design.
- 2) Wind: ASCE 7-16; Valt=115mph (3-second gust) Vasd=91mph; TCDL=6.0psf; BCDL=4.2psf; h=15ft; Cat. II; Exp C; Enclosed; MWFRS (envelope) gable end zone and C-C Exterior(2E) -1-10-8 to 1-1-8, Interior(1) 1-1-8 to 5-2-8, Exterior(2E) 5-2-8 to 8-10-4 zone; cantilever left and right exposed ; end vertical left and right exposed; C-C for members and forces & MWFRS for reactions shown; Lumber DOL=1.60 plate grip DOL=1.60
- 3) Provide adequate drainage to prevent water ponding.
- 4) This truss has been designed for a 10.0 psf bottom chord live load nonconcurrent with any other live loads.
- 5) Refer to girder(s) for truss to truss connections.
- 6) Provide mechanical connection (by others) of truss to bearing plate capable of withstanding 144 lb uplift at joint 2 and 69 lb uplift at joint 6.
- 7) This truss is designed in accordance with the 2018 International Residential Code sections R502.11.1 and R802.10.2 and referenced standard ANSI/TPI 1.
- 8) This truss design requires that a minimum of 7/16" structural wood sheathing be applied directly to the top chord and 1/2" gypsum sheetrock be applied directly to the bottom chord.
- 9) Graphical purlin representation does not depict the size or the orientation of the purlin along the top and/or bottom chord.



June 12.2023



Design valid for use only with MiTEK® connectors. This design is based only upon parameters shown, and is for an individual building component, not a truss system. Before use, the building designer must verify the applicability of design parameters and properly incorporate this design into the overall building design. Bracing indicated is to prevent buckling of individual truss web and/or chord members only. Additional temporary and permanent bracing is always required for stability and to prevent collapse with possible personnel injury and property damage. For general guidance regarding the fabrication, storage, delivery, erection and bracing of trusses and truss systems, see **ANSI/TPI1 Quality Criteria, DSB-89 and BCSI Building Code**

Safety Information available from Truss Plate Institute, 2670 Crain Highway, Suite 203 Waldorf, MD 20601



16023 Swingley Ridge Rd
Chesterfield, MO 63017

Job	Truss	Truss Type	Qty	Ply	Summit/161 Highland Meadows	RELEASE FOR CONSTRUCTION AS NOTED FOR PLAN REVIEW DEVELOPMENT SERVICES LEE'S SUMMIT, MISSOURI
3564895	F3	Half Hip	1	1	Job Reference (optional)	158827549

Builders FirstSource (Valley Center), Valley Center, KS - 67147,

8.630 s Nov 19 2022 MiTek Industries, Inc. Thu Jun 8 7 41 21 2023 Page 1

ID:icBMJaMgT1gasuUyx9?RhvzDEHb-RfC?PsB70Hq3NSqPqnL8v3uITxb65KvrcCm7J4ZICP?

07/06/2023

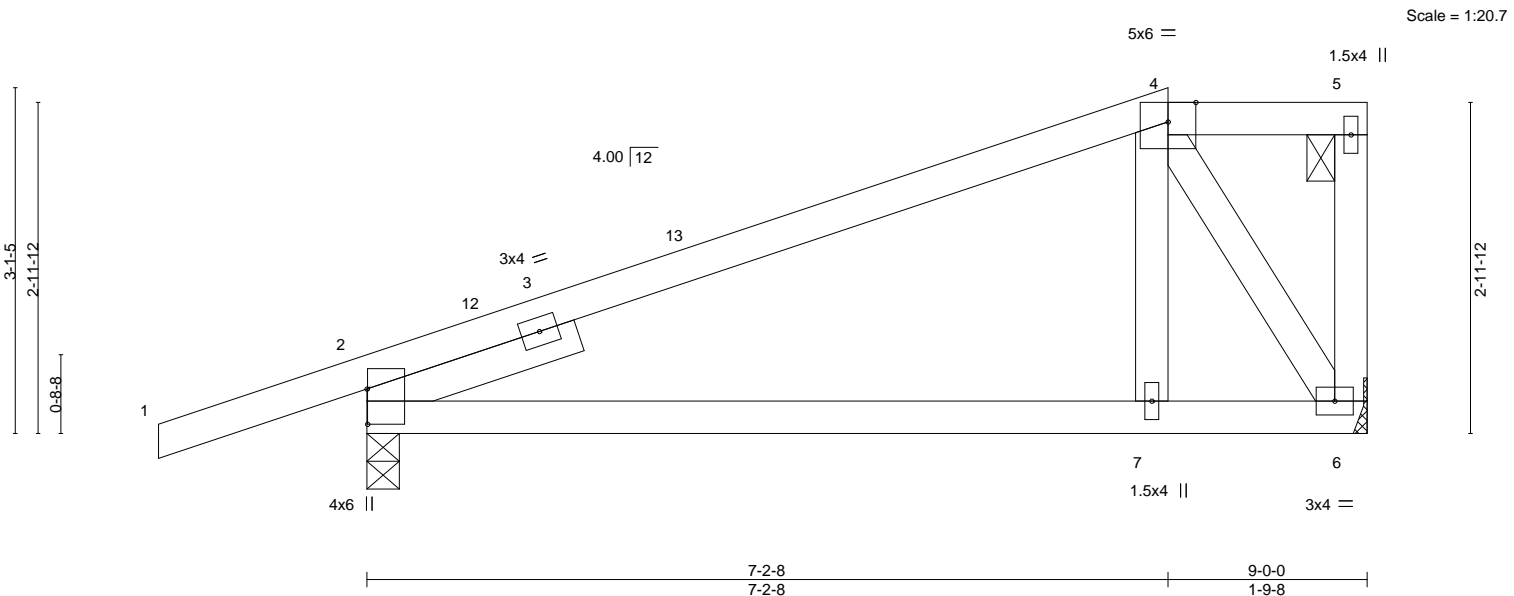


Plate Offsets (X,Y)--	[2:0-3-13,0-0-1]								
LOADING (psf)	SPACING-	2-0-0	CSI.	DEFL.	in (loc)	l/defl	L/d	PLATES	GRIP
TCLL 25.0	Plate Grip DOL	1.15	TC 0.57	Vert(LL)	0.07 7-10	>999	240	MT20	197/144
TCDL 10.0	Lumber DOL	1.15	BC 0.41	Vert(CT)	-0.13 7-10	>842	180		
BCLL 0.0	Rep Stress Incr	YES	WB 0.09	Horz(CT)	0.03 2	n/a	n/a		
BCDL 10.0	Code IRC2018/TPI2014		Matrix-AS					Weight: 34 lb	FT = 20%

LUMBER-
TOP CHORD 2x4 SPF No.2
BOT CHORD 2x4 SPF No.2
WEBS 2x4 SPF No.2
SLIDER Left 2x4 SPF No.2 2-0-0

BRACING-
TOP CHORD Structural wood sheathing directly applied, except end verticals, and 2-0-0 oc purlins: 4-5.
BOT CHORD Rigid ceiling directly applied.

REACTIONS. (size) 2=0-3-8, 6=Mechanical
Max Horz 2=113(LC 11)
Max Uplift 2=141(LC 8), 6=72(LC 8)
Max Grav 2=544(LC 1), 6=385(LC 1)

FORCES. (lb) - Max. Comp./Max. Ten. - All forces 250 (lb) or less except when shown.
TOP CHORD 2-4=-294/156
BOT CHORD 2-7=-155/252
WEBS 4-7=-34/284, 4-6=-468/236

NOTES-

- 1) Unbalanced roof live loads have been considered for this design.
- 2) Wind: ASCE 7-16; Vult=115mph (3-second gust) Vasd=91mph; TCDL=6.0psf; BCDL=4.2psf; h=15ft; Cat. II; Exp C; Enclosed; MWFRS (envelope) gable end zone and C-C Exterior(2E) -1-10-8 to 1-1-8, Interior(1) 1-1-8 to 7-2-8, Exterior(2E) 7-2-8 to 8-10-4 zone; cantilever left and right exposed ; end vertical left and right exposed;C-C for members and forces & MWFRS for reactions shown; Lumber DOL=1.60 plate grip DOL=1.60
- 3) Provide adequate drainage to prevent water ponding.
- 4) This truss has been designed for a 10.0 psf bottom chord live load nonconcurrent with any other live loads.
- 5) Refer to girder(s) for truss to truss connections.
- 6) Provide mechanical connection (by others) of truss to bearing plate capable of withstanding 141 lb uplift at joint 2 and 72 lb uplift at joint 6.
- 7) This truss is designed in accordance with the 2018 International Residential Code sections R502.11.1 and R802.10.2 and referenced standard ANSI/TPI 1.
- 8) This truss design requires that a minimum of 7/16" structural wood sheathing be applied directly to the top chord and 1/2" gypsum sheetrock be applied directly to the bottom chord.
- 9) Graphical purlin representation does not depict the size or the orientation of the purlin along the top and/or bottom chord.



June 12, 2023

WARNING - Verify design parameters and READ NOTES ON THIS AND INCLUDED MITEK REFERENCE PAGE MII-7473 rev. 5/19/2020 BEFORE USE.

Design valid for use only with MiTek® connectors. This design is based only upon parameters shown, and is for an individual building component, not a truss system. Before use, the building designer must verify the applicability of design parameters and properly incorporate this design into the overall building design. Bracing indicated is to prevent buckling of individual truss web and/or chord members only. Additional temporary and permanent bracing is always required for stability and to prevent collapse with possible personal injury and property damage. For general guidance regarding the fabrication, storage, delivery, erection and bracing of trusses and truss systems, see

ANSI/TPI1 Quality Criteria, DSB-89 and BCSI Building Component

Safety Information available from Truss Plate Institute, 2670 Crain Highway, Suite 203 Waldorf, MD 20601



16023 Swingley Ridge Rd
Chesterfield, MO 63017

Job	Truss	Truss Type	Qty	Ply	Summit/161 Highland Meadows	RELEASE FOR CONSTRUCTION
3564895	F4	Jack-Partial	11	1	Job Reference (optional)	AS NOTED FOR PLAN REVIEW DEVELOPMENT SERVICES LEE'S SUMMIT, MISSOURI

Builders FirstSource (Valley Center), Valley Center, KS - 67147,


8.630 s Nov 19 2022 MiTek Industries, Inc. Thu Jun 8 7 47 18 22 2023 Page 1

ID:icBMJaMgT1gasuUyx9?RhvzDEHb-RfC?PsB70Hq3NSqPqnL8v3uITxb6KVrCm7J4ZICP

07/03/2023

-1-10-8 4-6-0 9-0-0
1-10-8 4-6-0 4-6-0

Scale = 1:22.7

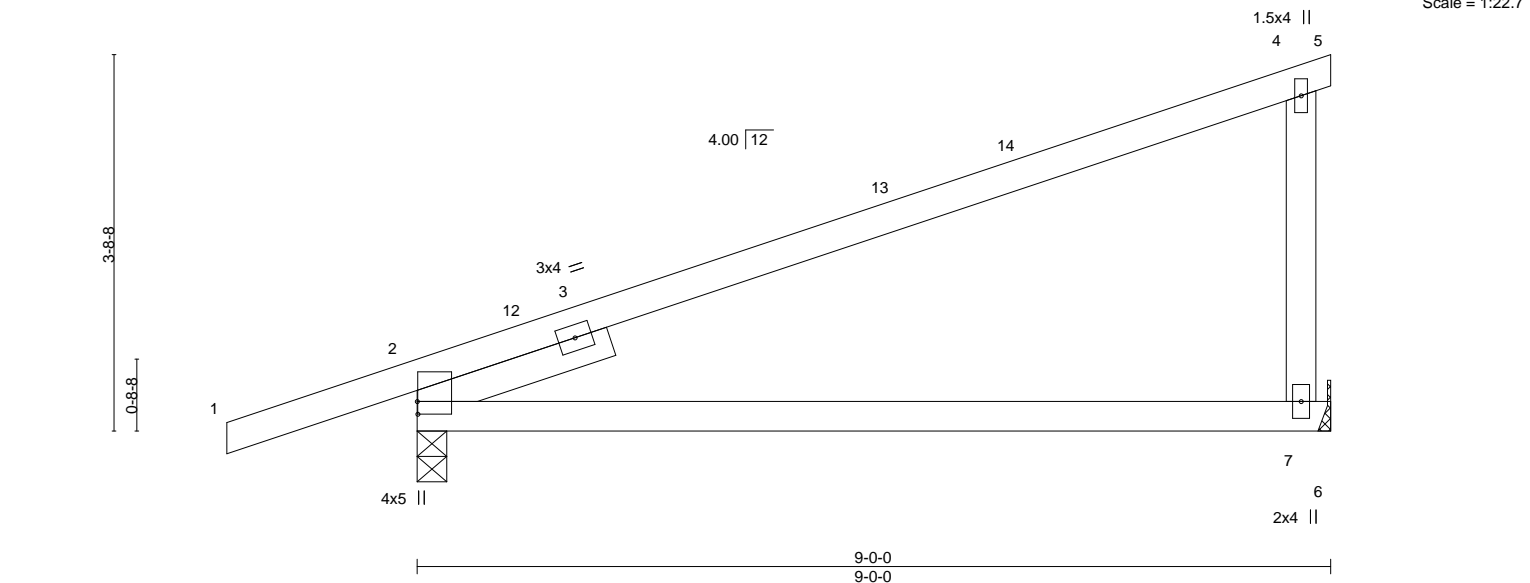

LOADING (psf)		SPACING-		CSI.		DEFL.		PLATES		GRIP	
TCLL	25.0	Plate Grip DOL	1.15	TC	1.00	Vert(LL)	-0.23 7-10 >455 240	MT20		197/144	
TCDL	10.0	Lumber DOL	1.15	BC	0.68	Vert(CT)	-0.51 7-10 >203 180				
BCLL	0.0	Rep Stress Incr	YES	WB	0.06	Horz(CT)	0.09 2 n/a n/a				
BCDL	10.0	Code IRC2018/TPI2014		Matrix-AS				Weight: 29 lb		FT = 20%	

LUMBER-

TOP CHORD 2x4 SPF No.2
BOT CHORD 2x4 SPF No.2
WEBS 2x4 SPF No.2
SLIDER Left 2x4 SPF No.2 2-0-0

BRACING-

TOP CHORD Structural wood sheathing directly applied.
BOT CHORD Rigid ceiling directly applied.

REACTIONS.

(size) 2=0-3-8, 7=Mechanical
Max Horz 2=140(LC 8)
Max Uplift 2=123(LC 8), 7=91(LC 8)
Max Grav 2=537(LC 1), 7=390(LC 1)

FORCES. (lb) - Max. Comp./Max. Ten. - All forces 250 (lb) or less except when shown.

TOP CHORD 2-4=-563/68
WEBS 4-7=-279/215

NOTES-

- 1) Wind: ASCE 7-16; Vult=115mph (3-second gust) Vasd=91mph; TCDL=6.0psf; BCDL=4.2psf; h=15ft; Cat. II; Exp C; Enclosed; MWFRS (envelope) gable end zone and C-C Exterior(2E) -1-10-8 to 1-1-8, Interior(1) 1-1-8 to 9-0-0 zone; cantilever left and right exposed; end vertical left and right exposed; C-C for members and forces & MWFRS for reactions shown; Lumber DOL=1.60 plate grip DOL=1.60
- 2) This truss has been designed for a 10.0 psf bottom chord live load nonconcurrent with any other live loads.
- 3) Refer to girder(s) for truss to truss connections.
- 4) Provide mechanical connection (by others) of truss to bearing plate capable of withstanding 123 lb uplift at joint 2 and 91 lb uplift at joint 7.
- 5) This truss is designed in accordance with the 2018 International Residential Code sections R502.11.1 and R802.10.2 and referenced standard ANSI/TPI 1.
- 6) This truss design requires that a minimum of 7/16" structural wood sheathing be applied directly to the top chord and 1/2" gypsum sheetrock be applied directly to the bottom chord.



June 12, 2023

WARNING - Verify design parameters and READ NOTES ON THIS AND INCLUDED MITEK REFERENCE PAGE MII-7473 rev. 5/19/2020 BEFORE USE.


Design valid for use only with MiTek® connectors. This design is based only upon parameters shown, and is for an individual building component, not a truss system. Before use, the building designer must verify the applicability of design parameters and properly incorporate this design into the overall building design. Bracing indicated is to prevent buckling of individual truss web and/or chord members only. Additional temporary and permanent bracing is always required for stability and to prevent collapse with possible personal injury and property damage. For general guidance regarding the fabrication, storage, delivery, erection and bracing of trusses and truss systems, see **ANSI/TPI1 Quality Criteria, DSB-89 and BCSI Building Component Safety Information** available from Truss Plate Institute, 2670 Crain Highway, Suite 203 Waldorf, MD 20601



16023 Swingley Ridge Rd
Chesterfield, MO 63017

Job	Truss	Truss Type	Qty	Ply	Summit/161 Highland Meadows	RELEASE FOR CONSTRUCTION
3564895	J1	Jack-Open	3	1	Job Reference (optional)	AS NOTED FOR PLAN REVIEW
Builders FirstSource (Valley Center), Valley Center, KS - 67147,					8.630 s Nov 19 2022 MiTek Industries, Inc. Thu Jun 01 16:23 2023 Page 1	DEVELOPMENT SERVICES
ID:icBMJaMgT1gasuUyx9?RhvzDEHb-RfC?PsB70Hq3NSqPqnL8v3uITxb6KVrCm7J4ZICP						LEE'S SUMMIT, MISSOURI

07/03/2023

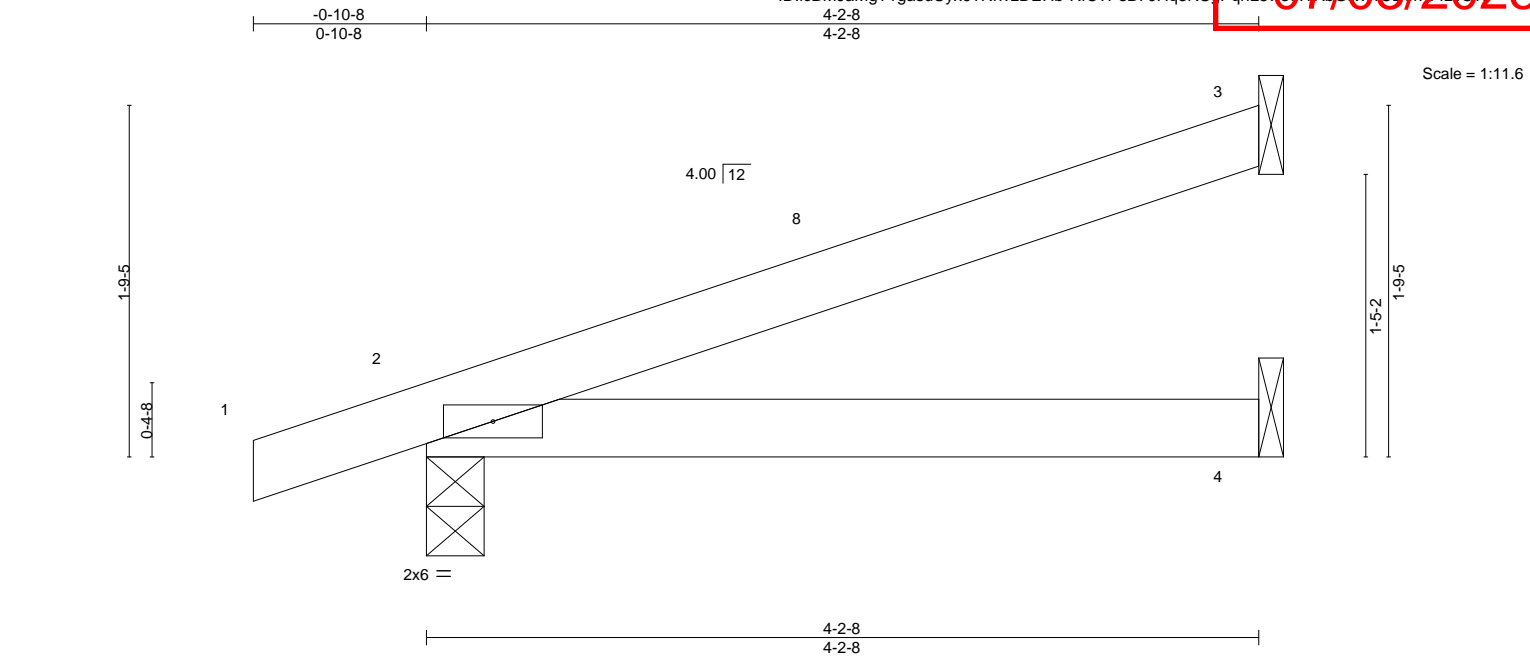

LOADING (psf)	SPACING-	2-0-0	CSI.	DEFL.	in	(loc)	l/defl	L/d	PLATES	GRIP
TCLL 25.0	Plate Grip DOL	1.15	TC 0.21	Vert(LL)	-0.02	4-7	>999	240	MT20	197/144
TCDL 10.0	Lumber DOL	1.15	BC 0.17	Vert(CT)	-0.03	4-7	>999	180		
BCLL 0.0	Rep Stress Incr	YES	WB 0.00	Horz(CT)	0.00	2	n/a	n/a		
BCDL 10.0	Code IRC2018/TPI2014		Matrix-AS						Weight: 11 lb	FT = 20%

LUMBER-	BRACING-
TOP CHORD 2x4 SPF No.2	TOP CHORD Structural wood sheathing directly applied.
BOT CHORD 2x4 SPF No.2	BOT CHORD Rigid ceiling directly applied.

REACTIONS.	(size) 3=Mechanical, 2=0-3-8, 4=Mechanical
	Max Horz 2=65(LC 8)
	Max Uplift 3=45(LC 12), 2=60(LC 8)
	Max Grav 3=124(LC 1), 2=254(LC 1), 4=74(LC 3)

FORCES. (lb) - Max. Comp./Max. Ten. - All forces 250 (lb) or less except when shown.

- NOTES-**
- 1) Wind: ASCE 7-16; Vult=115mph (3-second gust) Vasd=91mph; TCDL=6.0psf; BCDL=4.2psf; h=15ft; Cat. II; Exp C; Enclosed; MWFRS (envelope) gable end zone and C-C Exterior(2E) -0-10-8 to 2-1-8, Interior(1) 2-1-8 to 4-1-12 zone; cantilever left and right exposed; end vertical left and right exposed; C-C for members and forces & MWFRS for reactions shown; Lumber DOL=1.60 plate grip DOL=1.60
 - 2) This truss has been designed for a 10.0 psf bottom chord live load nonconcurrent with any other live loads.
 - 3) Refer to girder(s) for truss to truss connections.
 - 4) Provide mechanical connection (by others) of truss to bearing plate capable of withstanding 45 lb uplift at joint 3 and 60 lb uplift at joint 2.
 - 5) This truss is designed in accordance with the 2018 International Residential Code sections R502.11.1 and R802.10.2 and referenced standard ANSI/TPI 1.
 - 6) This truss design requires that a minimum of 7/16" structural wood sheathing be applied directly to the top chord and 1/2" gypsum sheetrock be applied directly to the bottom chord.




June 12, 2023

Builders FirstSource (Valley Center),	Valley Center, KS - 67147,
---------------------------------------	----------------------------

8.630 s Nov 19 2022 MiTek Industries, Inc. Thu Jun 8 14:13:34 2023 Page 1
ID:icBMJaMaT1gasuUvx9?RhvzDEHb-RfC?PsB70Hg3NSIPanL8y3vTxbG5VwC3d7V4zJC?fb

07/03/2023

 Weight: 6 lb FT = 20%

TOP CHORD	Structural wood sheathing directly applied or 2-1-7 oc purlins.
BOT CHORD	Rigid ceiling directly applied or 10-0-0 oc bracing.

(size) 3=Mechanical, 2=0-3-8, 4=Mechanical
Max Horz 2=39(LC 8)
Max Uplift 3=-19(LC 12), 2=-51(LC 8)
Max Grav 3=53(LC 1), 2=167(LC 1), 4=35(LC 3)

FORCES. (lb) - Max. Comp./Max. Ten. - All forces 250 (lb) or less except when shown.

- 1) Wind: ASCE 7-16; Vult=115mph (3-second gust) Vasd=91mph; TCdL=6.0psf; BCDL=4.2psf; h=15ft; Cat. II; Exp C; Enclosed; MWFRS (envelope) gable end zone and C-C Exterior(2E) zone; cantilever left and right exposed ; end vertical left and right exposed; C-C for members and forces & MWFRS for reactions shown; Lumber DOL=1.60 plate grip DOL=1.60
- 2) This truss has been designed for a 10.0 psf bottom chord live load nonconcurrent with any other live loads.
- 3) Refer to girder(s) for truss to truss connections.
- 4) Provide mechanical connection (by others) of truss to bearing plate capable of withstanding 19 lb uplift at joint 3 and 51 lb uplift at joint 2.
- 5) This truss is designed in accordance with the 2018 International Residential Code sections R502.11.1 and R802.10.2 and referenced standard ANSI/TPI 1.



June 12.2023



Design valid for use only with MiTEK® connectors. This design is based only upon parameters shown, and is for an individual building component, not a truss system. Before use, the building designer must verify the applicability of design parameters and properly incorporate this design into the overall building design. Bracing indicated is to prevent buckling of individual truss web and/or chord members only. Additional temporary and permanent bracing is always required for stability and to prevent collapse with possible personnel injury and property damage. For general guidance regarding the fabrication, storage, delivery, erection and bracing of trusses and truss systems, see **ANSI/TPI1 Quality Criteria, DSB-89 and BCSI Building Code**

Safety Information available from Truss Plate Institute, 2670 Crain Highway, Suite 203 Waldorf, MD 20601

ANSI/TPI1 Quality Criteria, DSB-89 and BCSI Building Component



16023 Swingley Ridge Rd
Chesterfield, MO 63017

Job	Truss	Truss Type	Qty	Ply	Summit/161 Highland Meadows	RELEASE FOR CONSTRUCTION
3564895	J3	Jack-Open	1	1	Job Reference (optional)	AS NOTED FOR PLAN REVIEW DEVELOPMENT SERVICES LEE'S SUMMIT, MISSOURI


Builders FirstSource (Valley Center),

Valley Center, KS - 67147,

8.630 s Nov 19 2022 MiTek Industries, Inc. Thu Jun 01 10:45:25 2023 Page 1

ID:icBMJaMgT1gasuUyx9?RhvzDEHb-RfC?PsB70Hq3NSqPqnL8v3uITxb6KVrCm7J4ZICP

07/03/2023

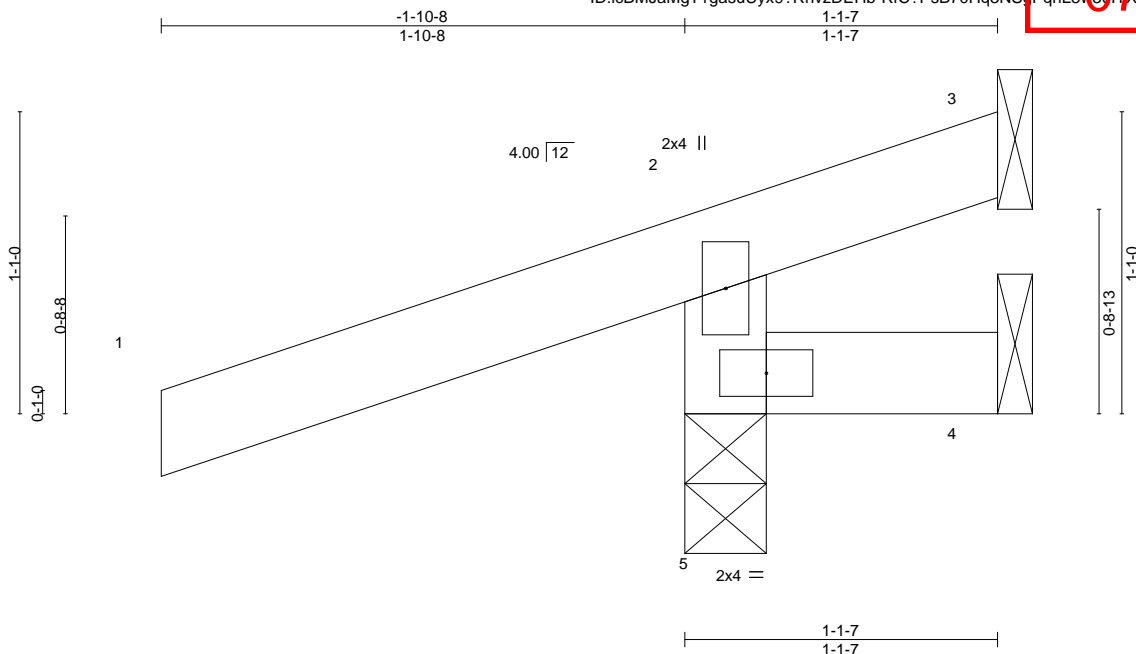

LOADING (psf)	SPACING-	2-0-0	CSI.	DEFL.	in	(loc)	l/defl	L/d	PLATES	GRIP
TCLL 25.0	Plate Grip DOL	1.15	TC 0.28	Vert(LL)	0.00	5	>999	240	MT20	197/144
TCDL 10.0	Lumber DOL	1.15	BC 0.08	Vert(CT)	0.00	5	>999	180		
BCLL 0.0	Rep Stress Incr	YES	WB 0.00	Horz(CT)	-0.00	3	n/a	n/a		
BCDL 10.0	Code IRC2018/TPI2014		Matrix-MR						Weight: 5 lb	FT = 20%

LUMBER-

TOP CHORD 2x4 SPF No.2
BOT CHORD 2x4 SPF No.2
WEBS 2x4 SPF No.2

BRACING-

TOP CHORD Structural wood sheathing directly applied or 1-1-7 oc purlins, except end verticals.
BOT CHORD Rigid ceiling directly applied or 10-0-0 oc bracing.

REACTIONS.

(size) 3=Mechanical, 4=Mechanical, 5=0-3-8
Max Horz 5=38(LC 8)
Max Uplift 3=71(LC 1), 4=34(LC 1), 5=150(LC 8)
Max Grav 3=40(LC 8), 4=20(LC 8), 5=333(LC 1)

FORCES. (lb) - Max. Comp./Max. Ten. - All forces 250 (lb) or less except when shown.

TOP CHORD 2-5=-280/212

NOTES-

- Wind: ASCE 7-16; Vult=115mph (3-second gust) Vasd=91mph; TCDL=6.0psf; BCDL=4.2psf; h=15ft; Cat. II; Exp C; Enclosed; MWFRS (envelope) gable end zone and C-C Exterior(2E) zone; cantilever left and right exposed; end vertical left and right exposed; C-C for members and forces & MWFRS for reactions shown; Lumber DOL=1.60 plate grip DOL=1.60
- This truss has been designed for a 10.0 psf bottom chord live load nonconcurrent with any other live loads.
- Refer to girder(s) for truss to truss connections.
- Bearing at joint(s) 5 considers parallel to grain value using ANSI/TPI 1 angle to grain formula. Building designer should verify capacity of bearing surface.
- Provide mechanical connection (by others) of truss to bearing plate capable of withstanding 71 lb uplift at joint 3, 34 lb uplift at joint 4 and 150 lb uplift at joint 5.
- This truss is designed in accordance with the 2018 International Residential Code sections R502.11.1 and R802.10.2 and referenced standard ANSI/TPI 1.



June 12, 2023

WARNING - Verify design parameters and READ NOTES ON THIS AND INCLUDED MITEK REFERENCE PAGE MII-7473 rev. 5/19/2020 BEFORE USE.

Design valid for use only with MiTek® connectors. This design is based only upon parameters shown, and is for an individual building component, not a truss system. Before use, the building designer must verify the applicability of design parameters and properly incorporate this design into the overall building design. Bracing indicated is to prevent buckling of individual truss web and/or chord members only. Additional temporary and permanent bracing is always required for stability and to prevent collapse with possible personal injury and property damage. For general guidance regarding the fabrication, storage, delivery, erection and bracing of trusses and truss systems, see

ANSI/TPI1 Quality Criteria, DSB-89 and BCSI Building Component

Safety Information available from Truss Plate Institute, 2670 Crain Highway, Suite 203 Waldorf, MD 20601



16023 Swingley Ridge Rd
Chesterfield, MO 63017

Job	Truss	Truss Type	Qty	Ply	Summit/161 Highland Meadows	RELEASE FOR CONSTRUCTION AS NOTED FOR PLAN REVIEW DEVELOPMENT SERVICES LEE'S SUMMIT, MISSOURI
3564895	J4	Jack-Closed	2	1	Job Reference (optional)	8.630 s Nov 21 2022 MITek Industries, Inc. File Jun 0 11:17:38 2023 Page 1

Builders First Source, Valley Center, KS 67147

ID:icBMJaMgT1gasuUyx9?RhvzDEHb-gQQdP1ub9F8ABnIOi64ChG5bA1WqjrnVardUz8 NP

07/03/2023

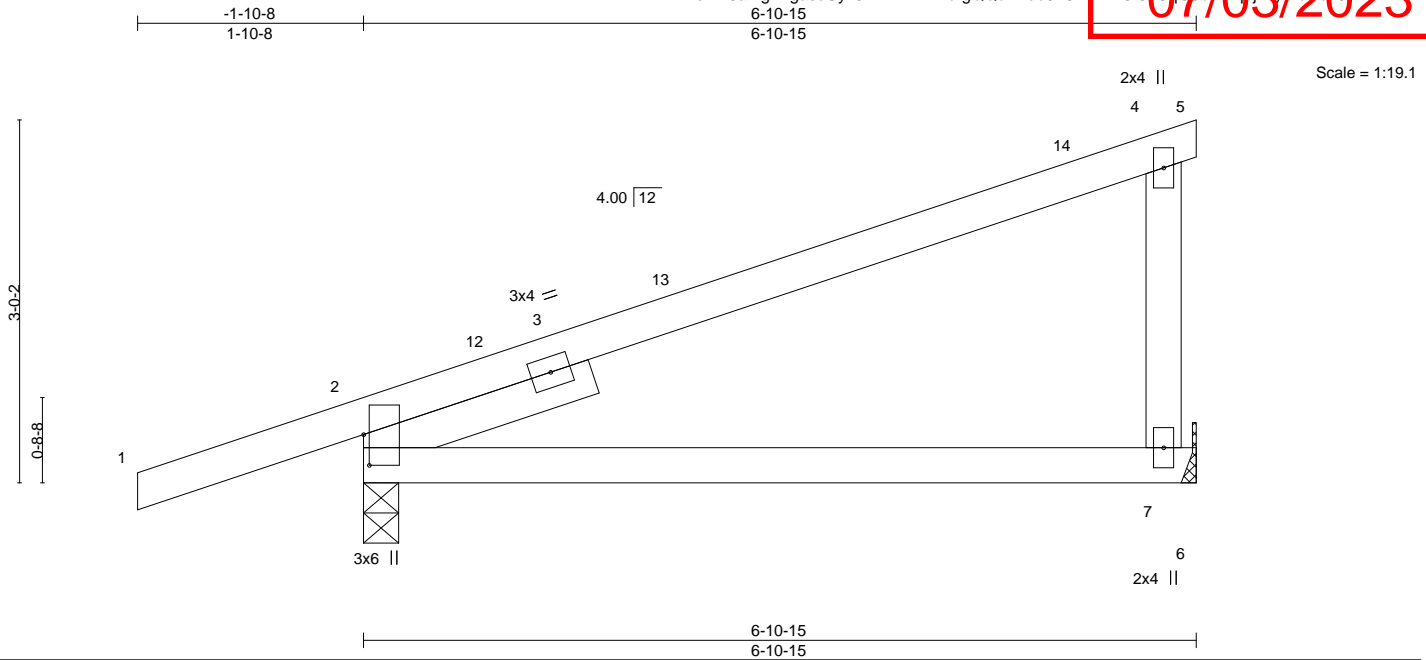


Plate Offsets (X,Y)-- [2:0-3-1,0-0-9]

LOADING (psf)	SPACING-	2-0-0	CSI.	DEFL.	in	(loc)	l/defl	L/d	PLATES	GRIP
TCLL 25.0	Plate Grip DOL	1.15	TC 0.58	Vert(LL)	0.09	7-10	>866	240	MT20	197/144
TCDL 10.0	Lumber DOL	1.15	BC 0.37	Vert(CT)	-0.17	7-10	>466	180		
BCLL 0.0	Rep Stress Incr	YES	WB 0.00	Horz(CT)	0.04	2	n/a	n/a		
BCDL 10.0	Code IRC2018/TPI2014		Matrix-AS						Weight: 24 lb	FT = 20%

LUMBER-
TOP CHORD 2x4 SPF No.2
BOT CHORD 2x4 SPF No.2
WEBS 2x4 SPF No.2
SLIDER Left 2x4 SPF No.2 2-0-0

BRACING-
TOP CHORD Sheathed, except end verticals.
BOT CHORD Rigid ceiling directly applied.

REACTIONS. (size) 7=Mechanical, 2=0-3-8
Max Horz 2=113(LC 11)
Max Uplift 7=-57(LC 8), 2=-123(LC 8)
Max Grav 7=291(LC 1), 2=448(LC 1)

FORCES. (lb) - Max. Comp./Max. Ten. - All forces 250 (lb) or less except when shown.
TOP CHORD 2-4=-334/78

- NOTES-**
- 1) Wind: ASCE 7-16; Vult=115mph (3-second gust) Vasd=91mph; TCDL=6.0psf; BCDL=4.2psf; h=15ft; Cat. II; Exp C; Enclosed; MWFRS (envelope) gable end zone and C-C Exterior(2E) -1-10-8 to 1-1-8, Interior(1) 1-1-8 to 6-10-15 zone; cantilever left and right exposed; end vertical left and right exposed; C-C for members and forces & MWFRS for reactions shown; Lumber DOL=1.60 plate grip DOL=1.60
 - 2) This truss has been designed for a 10.0 psf bottom chord live load nonconcurrent with any other live loads.
 - 3) Refer to girder(s) for truss to truss connections.
 - 4) Provide mechanical connection (by others) of truss to bearing plate capable of withstanding 100 lb uplift at joint(s) 7 except (jt=lb) 2=123.
 - 5) This truss is designed in accordance with the 2018 International Residential Code sections R502.11.1 and R802.10.2 and referenced standard ANSI/TPI 1.
 - 6) This truss design requires that a minimum of 7/16" structural wood sheathing be applied directly to the top chord and 1/2" gypsum sheetrock be applied directly to the bottom chord.



June 12, 2023

WARNING - Verify design parameters and READ NOTES ON THIS AND INCLUDED MITEK REFERENCE PAGE MII-7473 rev. 5/19/2020 BEFORE USE.

Design valid for use only with MITek® connectors. This design is based only upon parameters shown, and is for an individual building component, not a truss system. Before use, the building designer must verify the applicability of design parameters and properly incorporate this design into the overall building design. Bracing indicated is to prevent buckling of individual truss web and/or chord members only. Additional temporary and permanent bracing is always required for stability and to prevent collapse with possible personal injury and property damage. For general guidance regarding the fabrication, storage, delivery, erection and bracing of trusses and truss systems, see **ANSI/TPI1 Quality Criteria, DSB-89 and BCSI Building Component**

Safety Information available from Truss Plate Institute, 2670 Crain Highway, Suite 203 Waldorf, MD 20601



16023 Swingley Ridge Rd
Chesterfield, MO 63017

Job	Truss	Truss Type	Qty	Ply	Summit/161 Highland Meadows	RELEASE FOR CONSTRUCTION
3564895	J5	Jack-Open	2	1	Job Reference (optional)	AS NOTED FOR PLAN REVIEW DEVELOPMENT SERVICES LEE'S SUMMIT, MISSOURI

Builders FirstSource (Valley Center), Valley Center, KS - 67147,

8.630 s Nov 19 2022 MiTek Industries, Inc. Thu Jun 8 7 47 2023 Page 1

ID:icBMJaMgT1gasuUyx9?RhvzDEHb-RfC?PsB70Hq3NSqPqnL8v3uITxb6KVrCm7J4ZICP

07/03/2023

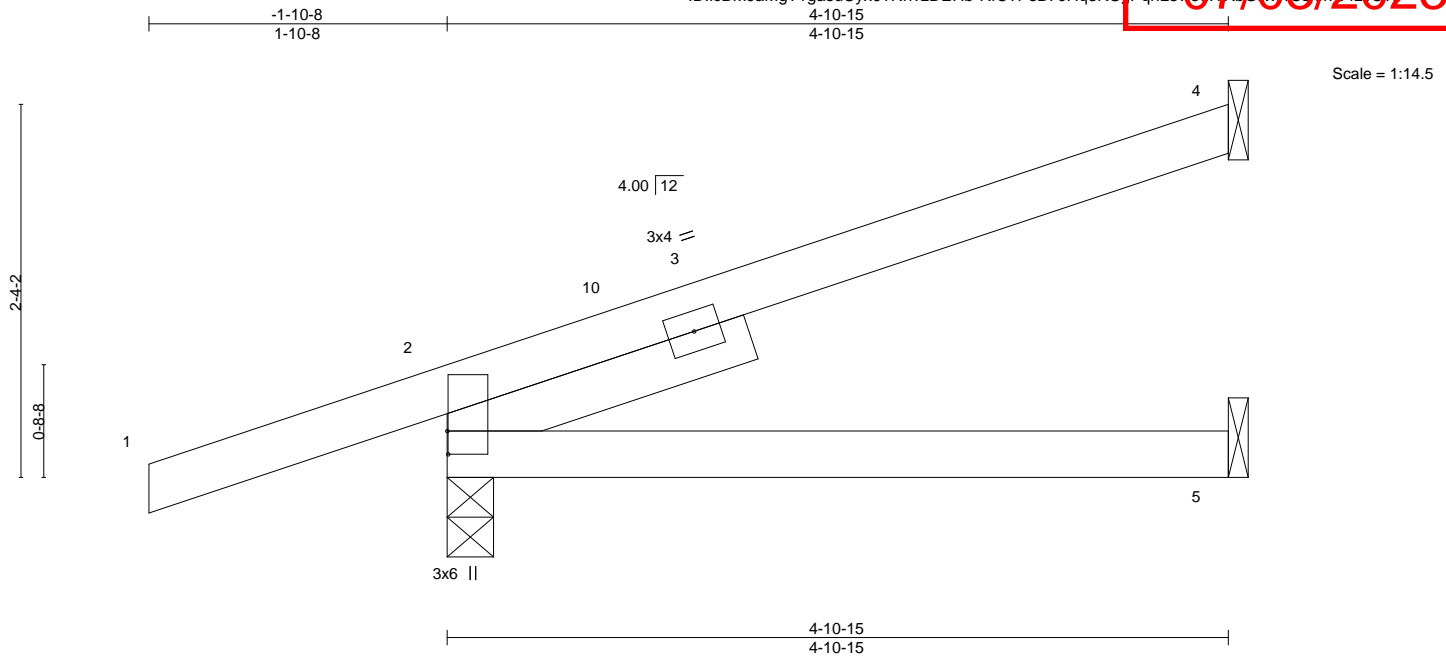


Plate Offsets (X,Y)-- [2:0-1-12,0-0-1]											
LOADING (psf)		SPACING- 2-0-0		CSI.		DEFL. in (loc) l/defl L/d			PLATES GRIP		
TCLL	25.0	Plate Grip DOL	1.15	TC	0.26	Vert(LL)	0.03	5-8	>999	240	MT20 197/144
TCDL	10.0	Lumber DOL	1.15	BC	0.19	Vert(CT)	-0.04	5-8	>999	180	
BCLL	0.0	Rep Stress Incr	YES	WB	0.00	Horz(CT)	0.01	4	n/a	n/a	
BCDL	10.0	Code IRC2018/TPI2014		Matrix-AS							Weight: 16 lb FT = 20%

LUMBER-

TOP CHORD 2x4 SPF No.2
BOT CHORD 2x4 SPF No.2
SLIDER Left 2x4 SPF No.2 2-0-0

BRACING-

TOP CHORD Structural wood sheathing directly applied.
BOT CHORD Rigid ceiling directly applied.

REACTIONS.

(size) 4=Mechanical, 2=0-3-8, 5=Mechanical
Max Horz 2=90(LC 8)
Max Uplift 4=54(LC 12), 2=106(LC 8)
Max Grav 4=138(LC 1), 2=375(LC 1), 5=83(LC 3)

FORCES. (lb) - Max. Comp./Max. Ten. - All forces 250 (lb) or less except when shown.

NOTES-

- 1) Wind: ASCE 7-16; Vult=115mph (3-second gust) Vasd=91mph; TCDL=6.0psf; BCDL=4.2psf; h=15ft; Cat. II; Exp C; Enclosed; MWFRS (envelope) gable end zone and C-C Exterior(2E) -1-10-8 to 1-1-8, Interior(1) 1-1-8 to 4-10-3 zone; cantilever left and right exposed; end vertical left and right exposed; C-C for members and forces & MWFRS for reactions shown; Lumber DOL=1.60 plate grip DOL=1.60
- 2) This truss has been designed for a 10.0 psf bottom chord live load nonconcurrent with any other live loads.
- 3) Refer to girder(s) for truss to truss connections.
- 4) Provide mechanical connection (by others) of truss to bearing plate capable of withstanding 54 lb uplift at joint 4 and 106 lb uplift at joint 2.
- 5) This truss is designed in accordance with the 2018 International Residential Code sections R502.11.1 and R802.10.2 and referenced standard ANSI/TPI 1.
- 6) This truss design requires that a minimum of 7/16" structural wood sheathing be applied directly to the top chord and 1/2" gypsum sheetrock be applied directly to the bottom chord.



June 12, 2023

WARNING - Verify design parameters and READ NOTES ON THIS AND INCLUDED MITEK REFERENCE PAGE MII-7473 rev. 5/19/2020 BEFORE USE.

Design valid for use only with MiTek® connectors. This design is based only upon parameters shown, and is for an individual building component, not a truss system. Before use, the building designer must verify the applicability of design parameters and properly incorporate this design into the overall building design. Bracing indicated is to prevent buckling of individual truss web and/or chord members only. Additional temporary and permanent bracing is always required for stability and to prevent collapse with possible personal injury and property damage. For general guidance regarding the fabrication, storage, delivery, erection and bracing of trusses and truss systems, see **ANSI/TPI1 Quality Criteria, DSB-89 and BCSI Building Component Safety Information** available from Truss Plate Institute, 2670 Crain Highway, Suite 203 Waldorf, MD 20601



16023 Swingley Ridge Rd
Chesterfield, MO 63017

Job	Truss	Truss Type	Qty	Ply	Summit/161 Highland Meadows	RELEASE FOR CONSTRUCTION
3564895	J6	Jack-Open	2	1		AS NOTED FOR PLAN REVIEW
					Job Reference (optional)	DEVELOPMENT SERVICES
						LEE'S SUMMIT, MISSOURI

Builders FirstSource (Valley Center), Valley Center, KS - 67147,

8.630 s Nov 19 2022 MiTek Industries, Inc. Thu Jun 8 7 47 15 AM 2023 Page 1

ID:icBMJaMgT1gasuUyx9?RhvzDEHb-RfC?PsB70Hq3NSqPqnL8v3uITxb6SVrCm7J4ZICP

07/03/2023

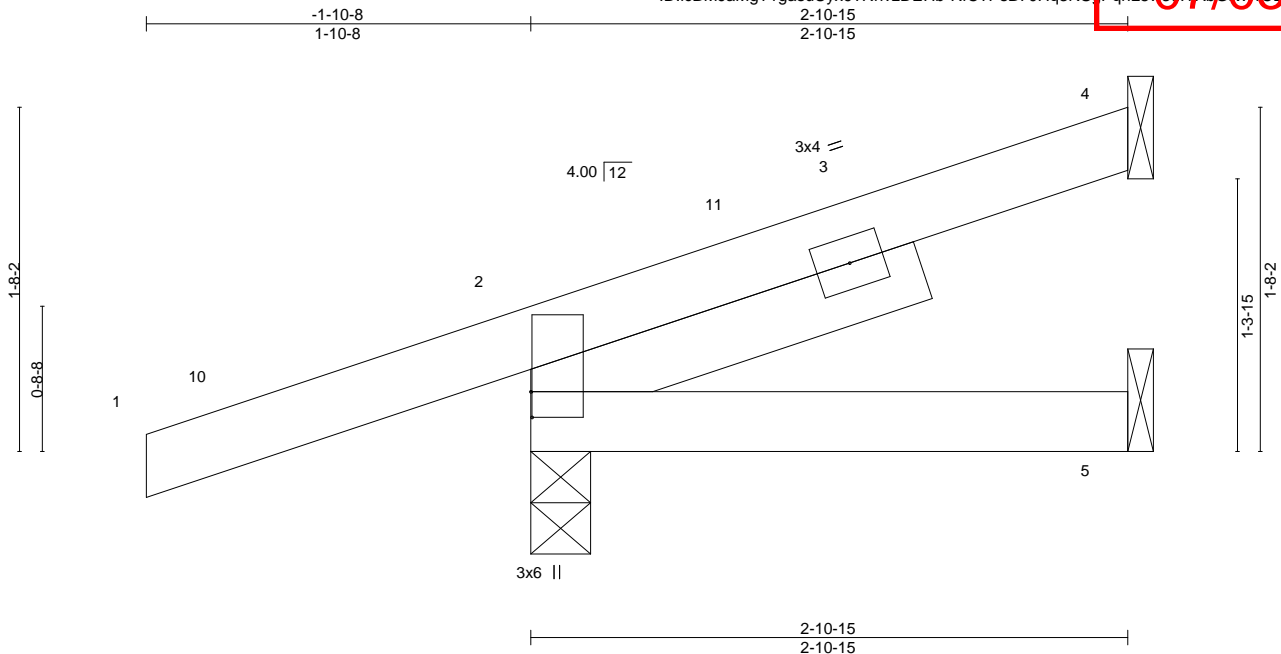


Plate Offsets (X,Y)-- [2:0-1-8,0-0-1]											
LOADING (psf)		SPACING- 2-0-0		CSI.		DEFL. in (loc) l/defl L/d			PLATES GRIP		
TCLL	25.0	Plate Grip DOL	1.15	TC	0.22	Vert(LL)	-0.00	8	>999	240	MT20 197/144
TCDL	10.0	Lumber DOL	1.15	BC	0.04	Vert(CT)	-0.00	5-8	>999	180	
BCLL	0.0	Rep Stress Incr	YES	WB	0.00	Horz(CT)	0.00	2	n/a	n/a	
BCDL	10.0	Code IRC2018/TPI2014		Matrix-MP							Weight: 11 lb FT = 20%

LUMBER-

TOP CHORD 2x4 SPF No.2
BOT CHORD 2x4 SPF No.2
SLIDER Left 2x4 SPF No.2 2-0-0

BRACING-

TOP CHORD Structural wood sheathing directly applied or 2-10-15 oc purlins.
BOT CHORD Rigid ceiling directly applied or 10-0-0 oc bracing.

REACTIONS.

(size) 4=Mechanical, 2=0-3-8, 5=Mechanical
Max Horz 2=65(LC 8)
Max Uplift 4=-28(LC 12), 2=-103(LC 8)
Max Grav 4=62(LC 1), 2=303(LC 1), 5=43(LC 3)

FORCES. (lb) - Max. Comp./Max. Ten. - All forces 250 (lb) or less except when shown.

NOTES-

- 1) Wind: ASCE 7-16; Vult=115mph (3-second gust) Vasd=91mph; TCDL=6.0psf; BCDL=4.2psf; h=15ft; Cat. II; Exp C; Enclosed; MWFRS (envelope) gable end zone and C-C Exterior(2E) -1-10-8 to 1-1-8, Interior(1) 1-1-8 to 2-10-3 zone; cantilever left and right exposed; end vertical left and right exposed; C-C for members and forces & MWFRS for reactions shown; Lumber DOL=1.60 plate grip DOL=1.60
- 2) This truss has been designed for a 10.0 psf bottom chord live load nonconcurrent with any other live loads.
- 3) Refer to girder(s) for truss to truss connections.
- 4) Provide mechanical connection (by others) of truss to bearing plate capable of withstanding 28 lb uplift at joint 4 and 103 lb uplift at joint 2.
- 5) This truss is designed in accordance with the 2018 International Residential Code sections R502.11.1 and R802.10.2 and referenced standard ANSI/TPI 1.



June 12, 2023

WARNING - Verify design parameters and READ NOTES ON THIS AND INCLUDED MITEK REFERENCE PAGE MII-7473 rev. 5/19/2020 BEFORE USE.

Design valid for use only with MiTek® connectors. This design is based only upon parameters shown, and is for an individual building component, not a truss system. Before use, the building designer must verify the applicability of design parameters and properly incorporate this design into the overall building design. Bracing indicated is to prevent buckling of individual truss web and/or chord members only. Additional temporary and permanent bracing is always required for stability and to prevent collapse with possible personal injury and property damage. For general guidance regarding the fabrication, storage, delivery, erection and bracing of trusses and truss systems, see

Safety Information available from Truss Plate Institute, 2670 Crain Highway, Suite 203 Waldorf, MD 20601



16023 Swingley Ridge Rd
Chesterfield, MO 63017

Job	Truss	Truss Type	Qty	Ply	Summit/161 Highland Meadows	RELEASE FOR CONSTRUCTION
3564895	J7	Jack-Open	1	1		AS NOTED FOR PLAN REVIEW
					Job Reference (optional)	DEVELOPMENT SERVICES
						LEE'S SUMMIT, MISSOURI


Builders FirstSource (Valley Center),

Valley Center, KS - 67147,

8.630 s Nov 19 2022 MiTek Industries, Inc. Thu Jun 8 7 41 18 AM 2023 Page 1

ID:icBMJaMgT1gasuUyx9?RhvzDEHb-RfC?PsB70Hq3NSpPqnL8v3uITxb6KVrCm7J4ZICP

07/03/2023

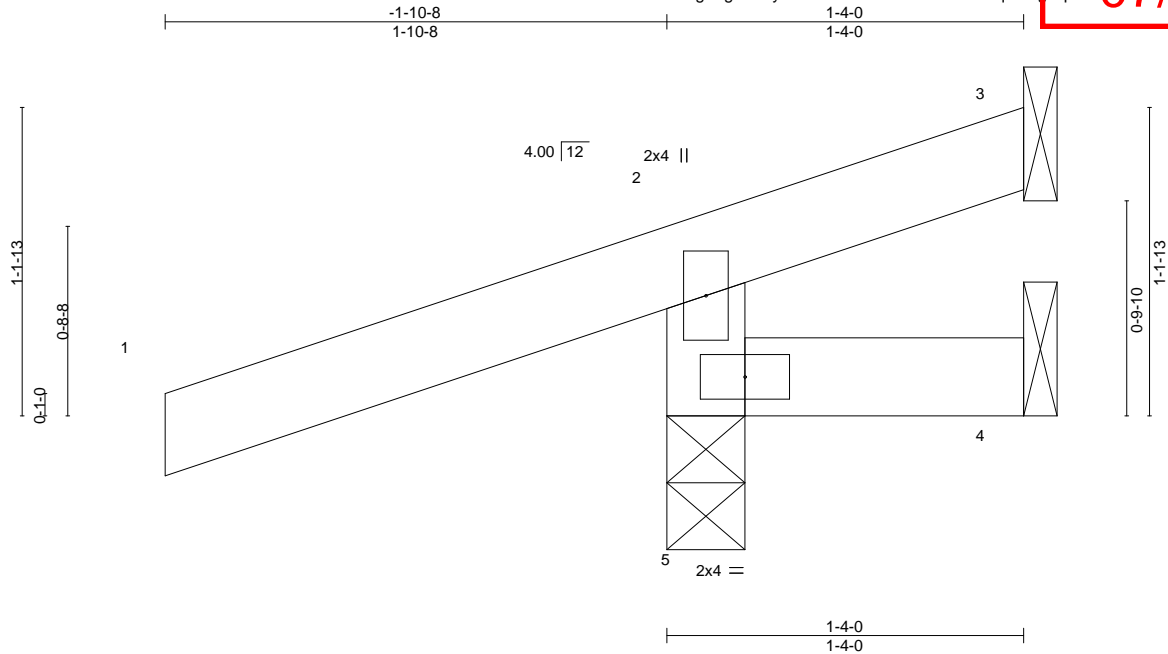

LOADING (psf)	SPACING-	2-0-0	CSI.	DEFL.	in	(loc)	l/defl	L/d	PLATES	GRIP
TCLL 25.0	Plate Grip DOL	1.15	TC 0.28	Vert(LL)	0.00	5	>999	240	MT20	197/144
TCDL 10.0	Lumber DOL	1.15	BC 0.08	Vert(CT)	0.00	5	>999	180		
BCLL 0.0	Rep Stress Incr	YES	WB 0.00	Horz(CT)	-0.00	3	n/a	n/a		
BCDL 10.0	Code IRC2018/TPI2014		Matrix-MR						Weight: 6 lb	FT = 20%

LUMBER-

TOP CHORD 2x4 SPF No.2
BOT CHORD 2x4 SPF No.2
WEBS 2x4 SPF No.2

BRACING-

TOP CHORD Structural wood sheathing directly applied or 1-4-0 oc purlins, except end verticals.
BOT CHORD Rigid ceiling directly applied or 10-0-0 oc bracing.

REACTIONS.

(size) 3=Mechanical, 4=Mechanical, 5=0-3-8
Max Horz 5=40(LC 8)
Max Uplift 3=43(LC 1), 4=26(LC 1), 5=138(LC 8)
Max Grav 3=26(LC 8), 4=19(LC 8), 5=316(LC 1)

FORCES. (lb) - Max. Comp./Max. Ten. - All forces 250 (lb) or less except when shown.

TOP CHORD 2-5=-266/199

NOTES-

- Wind: ASCE 7-16; Vult=115mph (3-second gust) Vasd=91mph; TCDL=6.0psf; BCDL=4.2psf; h=15ft; Cat. II; Exp C; Enclosed; MWFRS (envelope) gable end zone and C-C Exterior(2E) zone; cantilever left and right exposed; end vertical left and right exposed; C-C for members and forces & MWFRS for reactions shown; Lumber DOL=1.60 plate grip DOL=1.60
- This truss has been designed for a 10.0 psf bottom chord live load nonconcurrent with any other live loads.
- Refer to girder(s) for truss to truss connections.
- Bearing at joint(s) 5 considers parallel to grain value using ANSI/TPI 1 angle to grain formula. Building designer should verify capacity of bearing surface.
- Provide mechanical connection (by others) of truss to bearing plate capable of withstanding 43 lb uplift at joint 3, 26 lb uplift at joint 4 and 138 lb uplift at joint 5.
- This truss is designed in accordance with the 2018 International Residential Code sections R502.11.1 and R802.10.2 and referenced standard ANSI/TPI 1.



June 12, 2023

WARNING - Verify design parameters and READ NOTES ON THIS AND INCLUDED MITEK REFERENCE PAGE MII-7473 rev. 5/19/2020 BEFORE USE.

Design valid for use only with MiTek® connectors. This design is based only upon parameters shown, and is for an individual building component, not a truss system. Before use, the building designer must verify the applicability of design parameters and properly incorporate this design into the overall building design. Bracing indicated is to prevent buckling of individual truss web and/or chord members only. Additional temporary and permanent bracing is always required for stability and to prevent collapse with possible personal injury and property damage. For general guidance regarding the fabrication, storage, delivery, erection and bracing of trusses and truss systems, see **ANSI/TPI1 Quality Criteria, DSB-89 and BCSI Building Component Safety Information** available from Truss Plate Institute, 2670 Crain Highway, Suite 203 Waldorf, MD 20601



16023 Swingley Ridge Rd
Chesterfield, MO 63017

Job	Truss	Truss Type	Qty	Ply	Summit/161 Highland Meadows	RELEASE FOR CONSTRUCTION
3564895	J8	Jack-Open	4	1		AS NOTED FOR PLAN REVIEW
					Job Reference (optional)	DEVELOPMENT SERVICES
						LEE'S SUMMIT, MISSOURI

Builders FirstSource (Valley Center), Valley Center, KS - 67147,

8.630 s Nov 19 2022 MiTek Industries, Inc. Thu Jun 09 10:50:2022 Page 1

ID:icBMJaMgT1gasuUyx9?RhvzDEHb-RfC?PsB70Hq3NSqPqnL8v3uITxb6KVrCm7J4ZICP

07/03/2023

Scale: 1"=1'

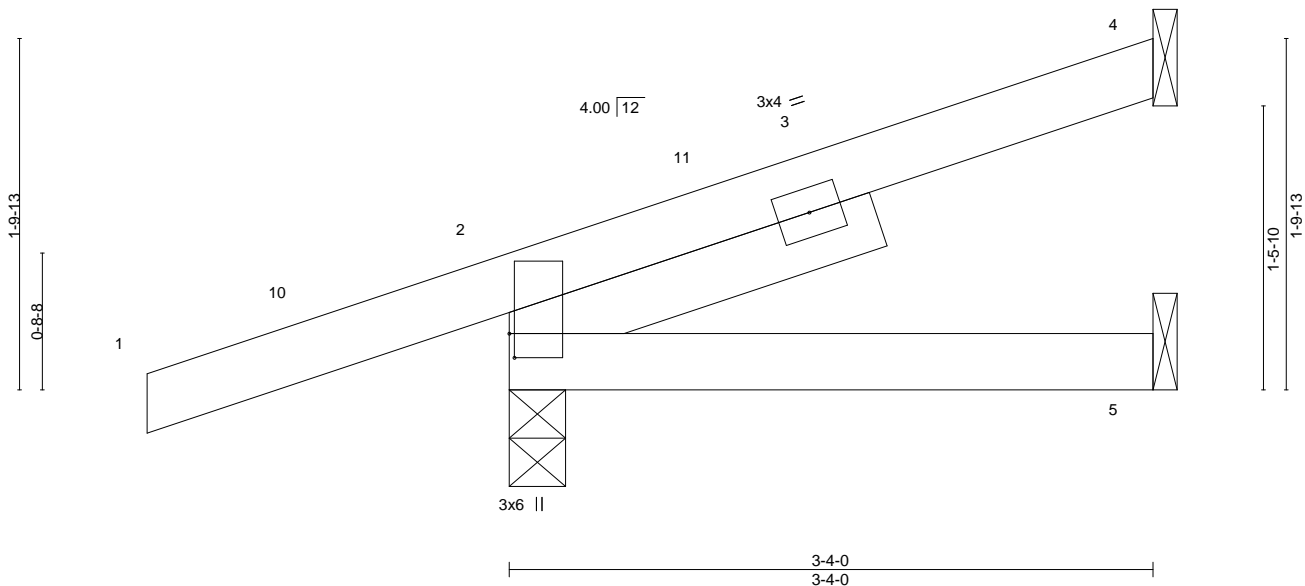


Plate Offsets (X,Y)-- [2:0-1-8,0-0-5]											
LOADING (psf)		SPACING- 2-0-0		CSI.		DEFL. in (loc) l/defl L/d			PLATES GRIP		
TCLL	25.0	Plate Grip DOL	1.15	TC	0.22	Vert(LL)	0.01	5-8	>999	240	MT20 197/144
TCDL	10.0	Lumber DOL	1.15	BC	0.07	Vert(CT)	-0.01	5-8	>999	180	
BCLL	0.0	Rep Stress Incr	YES	WB	0.00	Horz(CT)	0.00	2	n/a	n/a	
BCDL	10.0	Code IRC2018/TPI2014		Matrix-MP							Weight: 12 lb FT = 20%

LUMBER-

TOP CHORD 2x4 SPF No.2
BOT CHORD 2x4 SPF No.2
SLIDER Left 2x4 SPF No.2 2-0-0

BRACING-

TOP CHORD Structural wood sheathing directly applied or 3-4-0 oc purlins.
BOT CHORD Rigid ceiling directly applied or 10-0-0 oc bracing.

REACTIONS.

(size) 4=Mechanical, 2=0-3-8, 5=Mechanical
Max Horz 2=70(LC 8)
Max Uplift 4=33(LC 12), 2=103(LC 8)
Max Grav 4=79(LC 1), 2=316(LC 1), 5=52(LC 3)

FORCES. (lb) - Max. Comp./Max. Ten. - All forces 250 (lb) or less except when shown.

NOTES-

- 1) Wind: ASCE 7-16; Vult=115mph (3-second gust) Vasd=91mph; TCDL=6.0psf; BCDL=4.2psf; h=15ft; Cat. II; Exp C; Enclosed; MWFRS (envelope) gable end zone and C-C Exterior(2E) -1-10-8 to 1-1-8, Interior(1) 1-1-8 to 3-3-4 zone; cantilever left and right exposed; end vertical left and right exposed; C-C for members and forces & MWFRS for reactions shown; Lumber DOL=1.60 plate grip DOL=1.60
- 2) This truss has been designed for a 10.0 psf bottom chord live load nonconcurrent with any other live loads.
- 3) Refer to girder(s) for truss to truss connections.
- 4) Provide mechanical connection (by others) of truss to bearing plate capable of withstanding 33 lb uplift at joint 4 and 103 lb uplift at joint 2.
- 5) This truss is designed in accordance with the 2018 International Residential Code sections R502.11.1 and R802.10.2 and referenced standard ANSI/TPI 1.



June 12, 2023

WARNING - Verify design parameters and READ NOTES ON THIS AND INCLUDED MITEK REFERENCE PAGE MII-7473 rev. 5/19/2020 BEFORE USE.

Design valid for use only with MiTek® connectors. This design is based only upon parameters shown, and is for an individual building component, not a truss system. Before use, the building designer must verify the applicability of design parameters and properly incorporate this design into the overall building design. Bracing indicated is to prevent buckling of individual truss web and/or chord members only. Additional temporary and permanent bracing is always required for stability and to prevent collapse with possible personal injury and property damage. For general guidance regarding the fabrication, storage, delivery, erection and bracing of trusses and truss systems, see

ANSI/TPI1 Quality Criteria, DSB-89 and BCSI Building Component

Safety Information available from Truss Plate Institute, 2670 Crain Highway, Suite 203 Waldorf, MD 20601



16023 Swingley Ridge Rd
Chesterfield, MO 63017

Job	Truss	Truss Type	Qty	Ply	Summit/161 Highland Meadows	RELEASE FOR CONSTRUCTION
3564895	J9	Jack-Open	2	1		AS NOTED FOR PLAN REVIEW
					Job Reference (optional)	DEVELOPMENT SERVICES
						LEE'S SUMMIT, MISSOURI


Builders FirstSource (Valley Center),

Valley Center, KS - 67147,

8.630 s Nov 19 2022 MiTek Industries, Inc. Thu Jun 8 7 47 10 PM 2023 Page 1

ID:icBMJaMgT1gasuUyx9?RhvzDEHb-RfC?PsB70Hq3NSpPqnL8v3uITxb6KVrCm7J4ZICP

07/03/2023

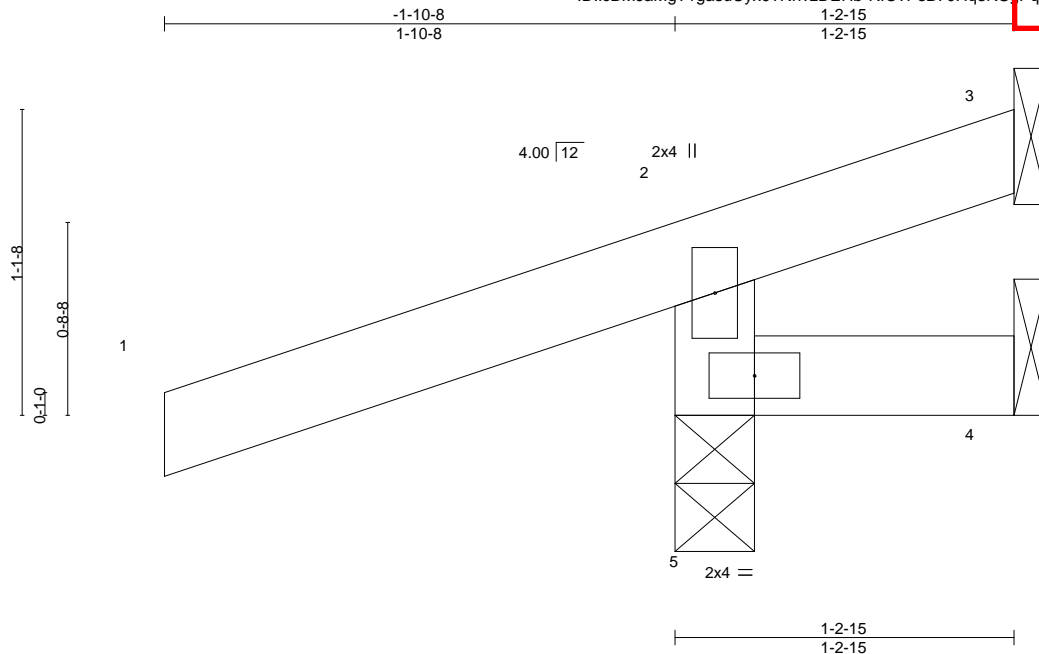

Scale = 1:8.5

LOADING (psf)	SPACING-	2-0-0	CSI.	DEFL.	in (loc)	l/defl	L/d	PLATES	GRIP
TCLL 25.0	Plate Grip DOL	1.15	TC 0.28	Vert(LL)	0.00	5	>999	240	MT20
TCDL 10.0	Lumber DOL	1.15	BC 0.08	Vert(CT)	0.00	5	>999	180	197/144
BCLL 0.0	Rep Stress Incr	YES	WB 0.00	Horz(CT)	-0.00	3	n/a	n/a	
BCDL 10.0	Code IRC2018/TPI2014		Matrix-MR						
								Weight: 6 lb	FT = 20%

LUMBER-

TOP CHORD 2x4 SPF No.2
BOT CHORD 2x4 SPF No.2
WEBS 2x4 SPF No.2

BRACING-

TOP CHORD Structural wood sheathing directly applied or 1-2-15 oc purlins, except end verticals.
BOT CHORD Rigid ceiling directly applied or 10-0-0 oc bracing.

REACTIONS.

(size) 3=Mechanical, 4=Mechanical, 5=0-3-8
Max Horz 5=39(LC 8)
Max Uplift 3=-53(LC 1), 4=-29(LC 1), 5=-142(LC 8)
Max Grav 3=31(LC 8), 4=19(LC 8), 5=322(LC 1)

FORCES. (lb) - Max. Comp./Max. Ten. - All forces 250 (lb) or less except when shown.

TOP CHORD 2-5=-271/204

NOTES-

- 1) Wind: ASCE 7-16; Vult=115mph (3-second gust) Vasd=91mph; TCDL=6.0psf; BCDL=4.2psf; h=15ft; Cat. II; Exp C; Enclosed; MWFRS (envelope) gable end zone and C-C Exterior(2E) zone; cantilever left and right exposed; end vertical left and right exposed; C-C for members and forces & MWFRS for reactions shown; Lumber DOL=1.60 plate grip DOL=1.60
- 2) This truss has been designed for a 10.0 psf bottom chord live load nonconcurrent with any other live loads.
- 3) Refer to girder(s) for truss to truss connections.
- 4) Bearing at joint(s) 5 considers parallel to grain value using ANSI/TPI 1 angle to grain formula. Building designer should verify capacity of bearing surface.
- 5) Provide mechanical connection (by others) of truss to bearing plate capable of withstanding 53 lb uplift at joint 3, 29 lb uplift at joint 4 and 142 lb uplift at joint 5.
- 6) This truss is designed in accordance with the 2018 International Residential Code sections R502.11.1 and R802.10.2 and referenced standard ANSI/TPI 1.



June 12, 2023

WARNING - Verify design parameters and READ NOTES ON THIS AND INCLUDED MITEK REFERENCE PAGE MII-7473 rev. 5/19/2020 BEFORE USE.

Design valid for use only with MiTek® connectors. This design is based only upon parameters shown, and is for an individual building component, not a truss system. Before use, the building designer must verify the applicability of design parameters and properly incorporate this design into the overall building design. Bracing indicated is to prevent buckling of individual truss web and/or chord members only. Additional temporary and permanent bracing is always required for stability and to prevent collapse with possible personal injury and property damage. For general guidance regarding the fabrication, storage, delivery, erection and bracing of trusses and truss systems, see

ANSI/TPI1 Quality Criteria, DSB-89 and BCSI Building Component

Safety Information available from Truss Plate Institute, 2670 Crain Highway, Suite 203 Waldorf, MD 20601



16023 Swingley Ridge Rd
Chesterfield, MO 63017

Job	Truss	Truss Type	Qty	Ply	Summit/161 Highland Meadows	RELEASE FOR CONSTRUCTION
3564895	J10	Jack-Partial	9	1	Job Reference (optional)	AS NOTED FOR PLAN REVIEW DEVELOPMENT SERVICES LEE'S SUMMIT, MISSOURI

Builders FirstSource (Valley Center), Valley Center, KS - 67147,

8.630 s Nov 19 2022 MiTek Industries, Inc. Thu Jun 9 7 41 18 24 2023 Page 1

ID:icBMJaMgT1gasuUyx9?RhvzDEHb-RfC?PsB70Hq3NSqPqnL8v3uITxb6KVrCm7J4ZICP

07/03/2023

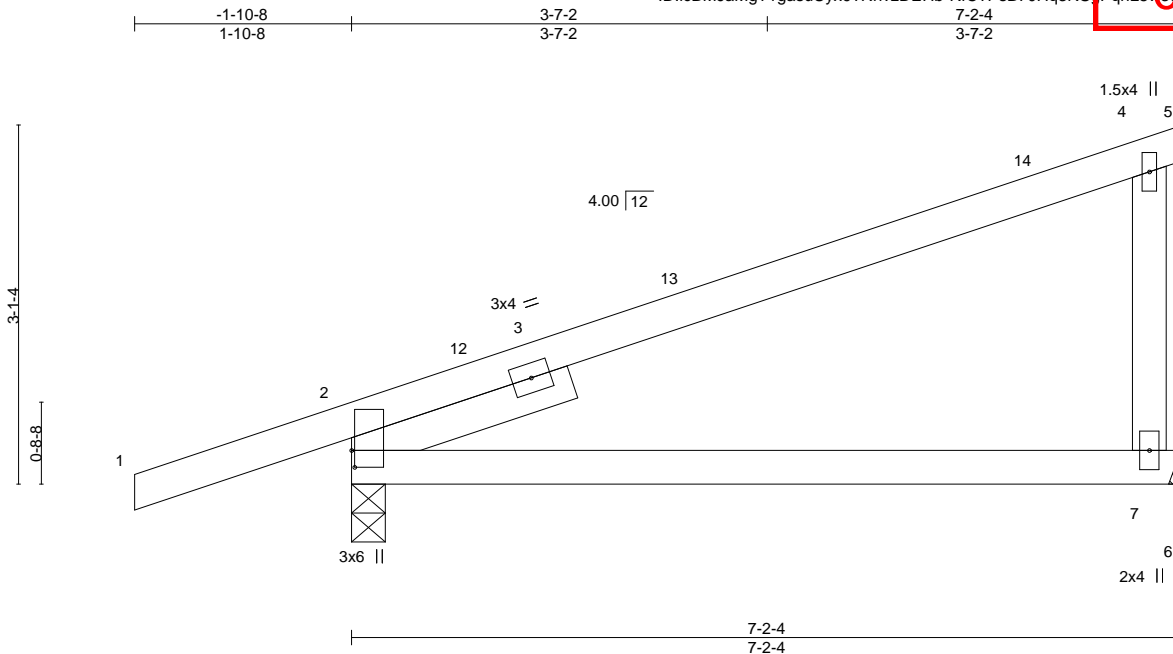


Plate Offsets (X,Y)--		[2:0-1-12,0-0-5]									
LOADING (psf)	SPACING-	2-0-0	CSI.	DEFL.	in	(loc)	l/defl	L/d	PLATES	GRIP	
TCLL 25.0	Plate Grip DOL	1.15	TC 0.60	Vert(LL)	0.10	7-10	>819	240	MT20	197/144	
TCDL 10.0	Lumber DOL	1.15	BC 0.40	Vert(CT)	-0.20	7-10	>414	180			
BCLL 0.0	Rep Stress Incr	YES	WB 0.04	Horz(CT)	0.04	2	n/a	n/a			
BCDL 10.0	Code IRC2018/TPI2014		Matrix-AS								
									Weight: 24 lb	FT = 20%	

LUMBER-

TOP CHORD 2x4 SPF No.2
BOT CHORD 2x4 SPF No.2
WEBS 2x4 SPF No.2
SLIDER Left 2x4 SPF No.2 2-0-0

BRACING-

TOP CHORD Structural wood sheathing directly applied.
BOT CHORD Rigid ceiling directly applied.

REACTIONS.

(size) 2=0-3-8, 7=Mechanical
Max Horz 2=118(LC 8)
Max Uplift 2=114(LC 8), 7=71(LC 8)
Max Grav 2=459(LC 1), 7=304(LC 1)

FORCES. (lb) - Max. Comp./Max. Ten. - All forces 250 (lb) or less except when shown.

TOP CHORD 2-4=-359/52

NOTES-

- 1) Wind: ASCE 7-16; Vult=115mph (3-second gust) Vasd=91mph; TCDL=6.0psf; BCDL=4.2psf; h=15ft; Cat. II; Exp C; Enclosed; MWFRS (envelope) gable end zone and C-C Exterior(2E) -1-10-8 to 1-1-8, Interior(1) 1-1-8 to 7-2-4 zone; cantilever left and right exposed; end vertical left and right exposed; C-C for members and forces & MWFRS for reactions shown; Lumber DOL=1.60 plate grip DOL=1.60
- 2) This truss has been designed for a 10.0 psf bottom chord live load nonconcurrent with any other live loads.
- 3) Refer to girder(s) for truss to truss connections.
- 4) Provide mechanical connection (by others) of truss to bearing plate capable of withstanding 114 lb uplift at joint 2 and 71 lb uplift at joint 7.
- 5) This truss is designed in accordance with the 2018 International Residential Code sections R502.11.1 and R802.10.2 and referenced standard ANSI/TPI 1.
- 6) This truss design requires that a minimum of 7/16" structural wood sheathing be applied directly to the top chord and 1/2" gypsum sheetrock be applied directly to the bottom chord.



June 12, 2023

WARNING - Verify design parameters and READ NOTES ON THIS AND INCLUDED MITEK REFERENCE PAGE MII-7473 rev. 5/19/2020 BEFORE USE.

Design valid for use only with MiTek® connectors. This design is based only upon parameters shown, and is for an individual building component, not a truss system. Before use, the building designer must verify the applicability of design parameters and properly incorporate this design into the overall building design. Bracing indicated is to prevent buckling of individual truss web and/or chord members only. Additional temporary and permanent bracing is always required for stability and to prevent collapse with possible personal injury and property damage. For general guidance regarding the fabrication, storage, delivery, erection and bracing of trusses and truss systems, see

Safety Information available from Truss Plate Institute, 2670 Crain Highway, Suite 203 Waldorf, MD 20601

ANSI/TPI1 Quality Criteria, DSB-89 and BCSI Building Component



16023 Swingley Ridge Rd
Chesterfield, MO 63017

Job	Truss	Truss Type	Qty	Ply	Summit/161 Highland Meadows	RELEASE FOR CONSTRUCTION
3564895	J11	Jack-Open	2	1		AS NOTED FOR PLAN REVIEW
Builders FirstSource (Valley Center), Valley Center, KS - 67147,					Job Reference (optional)	DEVELOPMENT SERVICES
					8.630 s Nov 19 2022 MiTek Industries, Inc. Thu Jun 07 10:25:30 2023 Page 1	LEE'S SUMMIT, MISSOURI

ID:icBMJaMgT1gasuUyx9?RhvzDEHb-RfC?PsB70Hq3NSpPqnL8v3uITxb6KVrCm7J4ZICP

07/03/2023

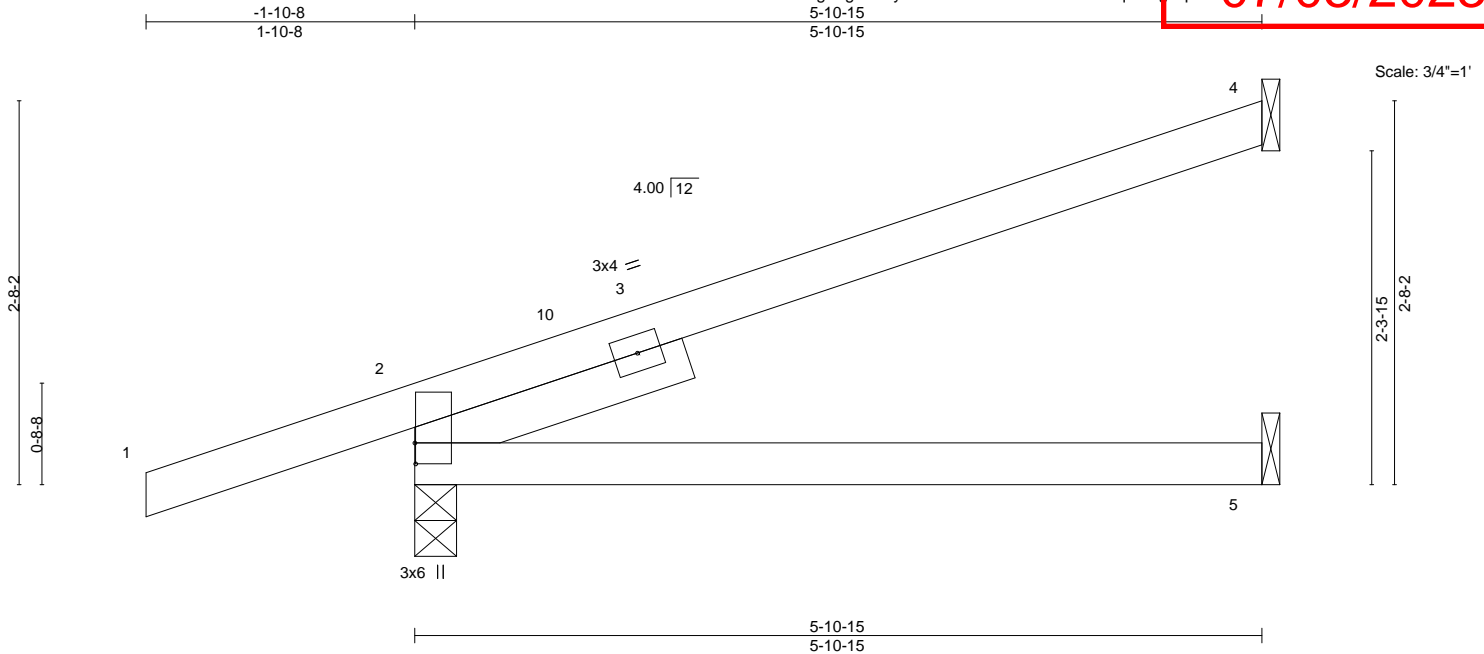


Plate Offsets (X,Y)--		[2:0-1-12,0-0-1]							
LOADING (psf)	SPACING-	2-0-0	CSI.	DEFL.	in	(loc)	l/defl	L/d	PLATES
TCLL 25.0	Plate Grip DOL	1.15	TC 0.42	Vert(LL)	0.06	5-8	>999	240	MT20
TCDL 10.0	Lumber DOL	1.15	BC 0.27	Vert(CT)	-0.10	5-8	>701	180	GRIP
BCLL 0.0	Rep Stress Incr	YES	WB 0.00	Horz(CT)	0.02	4	n/a	n/a	197/144
BCDL 10.0	Code IRC2018/TPI2014		Matrix-AS						Weight: 18 lb
									FT = 20%

LUMBER-

TOP CHORD 2x4 SPF No.2
BOT CHORD 2x4 SPF No.2
SLIDER Left 2x4 SPF No.2 2-0-0

BRACING-

TOP CHORD Structural wood sheathing directly applied.
BOT CHORD Rigid ceiling directly applied.

REACTIONS.

(size) 4=Mechanical, 2=0-3-8, 5=Mechanical
Max Horz 2=102(LC 8)
Max Uplift 4=67(LC 12), 2=110(LC 8)
Max Grav 4=173(LC 1), 2=415(LC 1), 5=101(LC 3)

FORCES.

(lb) - Max. Comp./Max. Ten. - All forces 250 (lb) or less except when shown.

TOP CHORD 2-4=-263/43

NOTES-

- 1) Wind: ASCE 7-16; Vult=115mph (3-second gust) Vasd=91mph; TCDL=6.0psf; BCDL=4.2psf; h=15ft; Cat. II; Exp C; Enclosed; MWFRS (envelope) gable end zone and C-C Exterior(2E) -1-10-8 to 1-1-8, Interior(1) 1-1-8 to 5-10-3 zone; cantilever left and right exposed; end vertical left and right exposed; C-C for members and forces & MWFRS for reactions shown; Lumber DOL=1.60 plate grip DOL=1.60
- 2) This truss has been designed for a 10.0 psf bottom chord live load nonconcurrent with any other live loads.
- 3) Refer to girder(s) for truss to truss connections.
- 4) Provide mechanical connection (by others) of truss to bearing plate capable of withstanding 67 lb uplift at joint 4 and 110 lb uplift at joint 2.
- 5) This truss is designed in accordance with the 2018 International Residential Code sections R502.11.1 and R802.10.2 and referenced standard ANSI/TPI 1.
- 6) This truss design requires that a minimum of 7/16" structural wood sheathing be applied directly to the top chord and 1/2" gypsum sheetrock be applied directly to the bottom chord.



June 12, 2023

WARNING - Verify design parameters and READ NOTES ON THIS AND INCLUDED MITEK REFERENCE PAGE MII-7473 rev. 5/19/2020 BEFORE USE.

Design valid for use only with MiTek® connectors. This design is based only upon parameters shown, and is for an individual building component, not a truss system. Before use, the building designer must verify the applicability of design parameters and properly incorporate this design into the overall building design. Bracing indicated is to prevent buckling of individual truss web and/or chord members only. Additional temporary and permanent bracing is always required for stability and to prevent collapse with possible personal injury and property damage. For general guidance regarding the fabrication, storage, delivery, erection and bracing of trusses and truss systems, see

ANSI/TPI1 Quality Criteria, DSB-89 and BCSI Building Component

Safety Information available from Truss Plate Institute, 2670 Crain Highway, Suite 203 Waldorf, MD 20601



16023 Swingley Ridge Rd
Chesterfield, MO 63017

Job	Truss	Truss Type	Qty	Ply	Summit/161 Highland Meadows	RELEASE FOR CONSTRUCTION
3564895	J12	Jack-Open	2	1	Job Reference (optional)	AS NOTED FOR PLAN REVIEW DEVELOPMENT SERVICES LEE'S SUMMIT, MISSOURI

Builders FirstSource (Valley Center), Valley Center, KS - 67147,

8.630 s Nov 19 2022 MiTek Industries, Inc. Thu Jun 8 7 47 16 2023 Page 1

ID:icBMJaMgT1gasuUyx9?RhvzDEHb-RfC?PsB70Hq3NSqPqnL8v3uITxb6KVrCm7J4ZICP

07/08/2023

-1-10-8
1-10-8

3-10-15
3-10-15

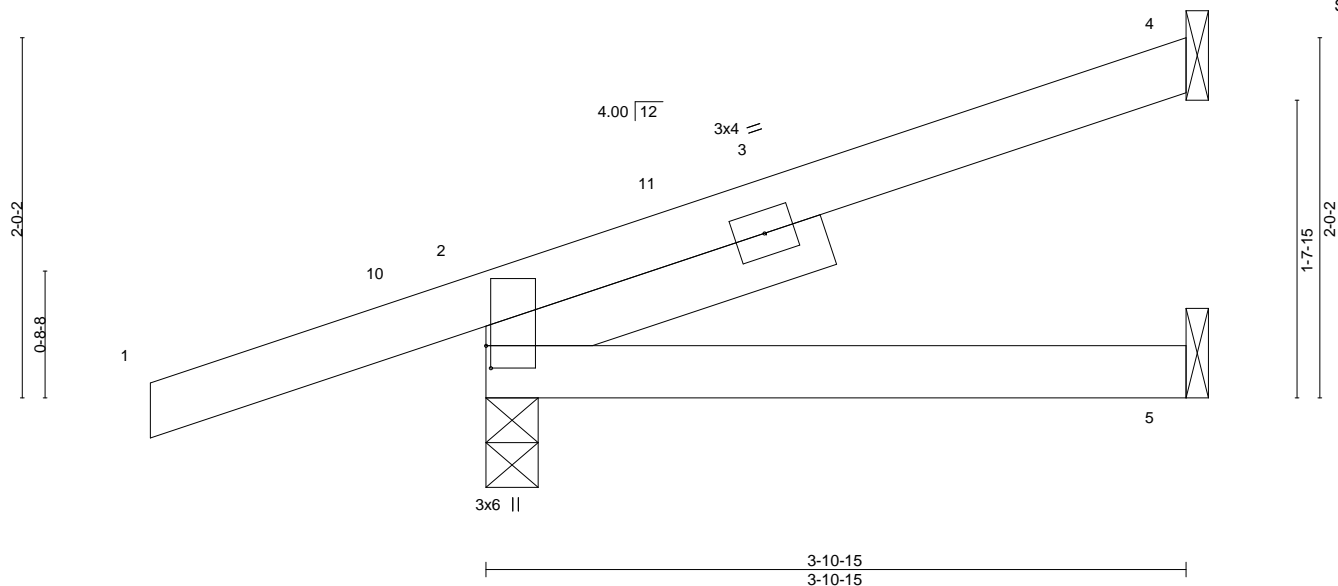


Plate Offsets (X,Y)--		[2:0-1-8,0-0-5]									
LOADING (psf)	SPACING-	2-0-0	CSI.	DEFL.	in	(loc)	l/defl	L/d	PLATES	GRIP	
TCLL 25.0	Plate Grip DOL	1.15	TC 0.22	Vert(LL)	-0.01	5-8	>999	240	MT20	197/144	
TCDL 10.0	Lumber DOL	1.15	BC 0.11	Vert(CT)	-0.02	5-8	>999	180			
BCLL 0.0	Rep Stress Incr	YES	WB 0.00	Horz(CT)	0.01	2	n/a	n/a			
BCDL 10.0	Code IRC2018/TPI2014		Matrix-MP								
									Weight: 14 lb	FT = 20%	

LUMBER-

TOP CHORD 2x4 SPF No.2
BOT CHORD 2x4 SPF No.2
SLIDER Left 2x4 SPF No.2 2-0-0

BRACING-

TOP CHORD Structural wood sheathing directly applied or 3-10-15 oc purlins.
BOT CHORD Rigid ceiling directly applied or 10-0-0 oc bracing.

REACTIONS.

(size) 4=Mechanical, 2=0-3-8, 5=Mechanical
Max Horz 2=78(LC 8)
Max Uplift 4=41(LC 12), 2=103(LC 8)
Max Grav 4=101(LC 1), 2=336(LC 1), 5=64(LC 3)

FORCES. (lb) - Max. Comp./Max. Ten. - All forces 250 (lb) or less except when shown.

NOTES-

- 1) Wind: ASCE 7-16; Vult=115mph (3-second gust) Vasd=91mph; TCDL=6.0psf; BCDL=4.2psf; h=15ft; Cat. II; Exp C; Enclosed; MWFRS (envelope) gable end zone and C-C Exterior(2E) -1-10-8 to 1-1-8, Interior(1) 1-1-8 to 3-10-3 zone; cantilever left and right exposed; end vertical left and right exposed; C-C for members and forces & MWFRS for reactions shown; Lumber DOL=1.60 plate grip DOL=1.60
- 2) This truss has been designed for a 10.0 psf bottom chord live load nonconcurrent with any other live loads.
- 3) Refer to girder(s) for truss to truss connections.
- 4) Provide mechanical connection (by others) of truss to bearing plate capable of withstanding 41 lb uplift at joint 4 and 103 lb uplift at joint 2.
- 5) This truss is designed in accordance with the 2018 International Residential Code sections R502.11.1 and R802.10.2 and referenced standard ANSI/TPI 1.



June 12, 2023

WARNING - Verify design parameters and READ NOTES ON THIS AND INCLUDED MITEK REFERENCE PAGE MII-7473 rev. 5/19/2020 BEFORE USE.

Design valid for use only with MiTek® connectors. This design is based only upon parameters shown, and is for an individual building component, not a truss system. Before use, the building designer must verify the applicability of design parameters and properly incorporate this design into the overall building design. Bracing indicated is to prevent buckling of individual truss web and/or chord members only. Additional temporary and permanent bracing is always required for stability and to prevent collapse with possible personal injury and property damage. For general guidance regarding the fabrication, storage, delivery, erection and bracing of trusses and truss systems, see **ANSI/TPI1 Quality Criteria, DSB-89 and BCSI Building Component Safety Information** available from Truss Plate Institute, 2670 Crain Highway, Suite 203 Waldorf, MD 20601



16023 Swingley Ridge Rd
Chesterfield, MO 63017

Job	Truss	Truss Type	Qty	Ply	Summit/161 Highland Meadows	AS NOTED FOR PLAN REVIEW DEVELOPMENT SERVICES LEE'S SUMMIT, MISSOURI
3564895	J13	Jack-Open	4	1	Job Reference (optional)	

Builders FirstSource (Valley Center), Valley Center, KS - 67147,

8.630 s Nov 19 2022 MiTek Industries, Inc. Thu Jun 8 7 41 18 27 2023 Page 1

ID:icBMJaMgT1gasuUyx9?RhvzDEHb-RfC?PsB70Hq3NSqPqnL8v3uITxb6KVrCm7J4ZICP

07/03/2023

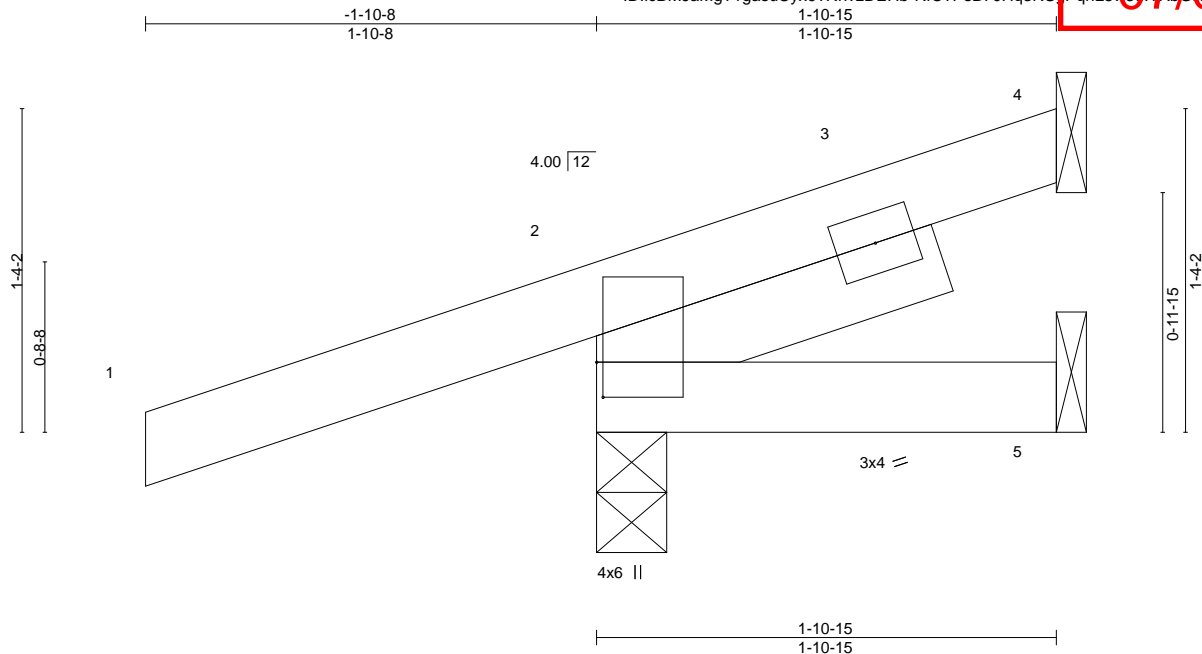


Plate Offsets (X,Y)-- [2:0-1-12,0-0-5]											
LOADING (psf)		SPACING- 2-0-0		CSI.		DEFL. in (loc) l/defl L/d			PLATES GRIP		
TCLL	25.0	Plate Grip DOL	1.15	TC	0.24	Vert(LL)	0.00	8	>999	240	MT20 197/144
TCDL	10.0	Lumber DOL	1.15	BC	0.02	Vert(CT)	0.00	8	>999	180	
BCLL	0.0	Rep Stress Incr	YES	WB	0.00	Horz(CT)	-0.00	2	n/a	n/a	
BCDL	10.0	Code IRC2018/TPI2014		Matrix-MP							Weight: 9 lb FT = 20%

LUMBER-

TOP CHORD 2x4 SPF No.2
BOT CHORD 2x4 SPF No.2
SLIDER Left 2x4 SPF No.2 1-6-0

BRACING-

TOP CHORD Structural wood sheathing directly applied or 1-10-15 oc purlins.
BOT CHORD Rigid ceiling directly applied or 10-0-0 oc bracing.

REACTIONS.

(size) 4=Mechanical, 2=0-3-8, 5=Mechanical
Max Horz 2=54(LC 8)
Max Uplift 4=13(LC 12), 2=108(LC 8)
Max Grav 4=18(LC 1), 2=282(LC 1), 5=24(LC 3)

FORCES. (lb) - Max. Comp./Max. Ten. - All forces 250 (lb) or less except when shown.

NOTES-

- 1) Wind: ASCE 7-16; Vult=115mph (3-second gust) Vasd=91mph; TCDL=6.0psf; BCDL=4.2psf; h=15ft; Cat. II; Exp C; Enclosed; MWFRS (envelope) gable end zone and C-C Exterior(2E) -1-10-8 to 1-1-8, Interior(1) 1-1-8 to 1-10-13 zone; cantilever left and right exposed; end vertical left and right exposed; C-C for members and forces & MWFRS for reactions shown; Lumber DOL=1.60 plate grip DOL=1.60
- 2) This truss has been designed for a 10.0 psf bottom chord live load nonconcurrent with any other live loads.
- 3) Refer to girder(s) for truss to truss connections.
- 4) Provide mechanical connection (by others) of truss to bearing plate capable of withstanding 13 lb uplift at joint 4 and 108 lb uplift at joint 2.
- 5) This truss is designed in accordance with the 2018 International Residential Code sections R502.11.1 and R802.10.2 and referenced standard ANSI/TPI 1.



June 12, 2023

WARNING - Verify design parameters and READ NOTES ON THIS AND INCLUDED MITEK REFERENCE PAGE MII-7473 rev. 5/19/2020 BEFORE USE.

Design valid for use only with MiTek® connectors. This design is based only upon parameters shown, and is for an individual building component, not a truss system. Before use, the building designer must verify the applicability of design parameters and properly incorporate this design into the overall building design. Bracing indicated is to prevent buckling of individual truss web and/or chord members only. Additional temporary and permanent bracing is always required for stability and to prevent collapse with possible personal injury and property damage. For general guidance regarding the fabrication, storage, delivery, erection and bracing of trusses and truss systems, see **ANSI/TPI1 Quality Criteria, DSB-89 and BCSI Building Component Safety Information** available from Truss Plate Institute, 2670 Crain Highway, Suite 203 Waldorf, MD 20601



16023 Swingley Ridge Rd
Chesterfield, MO 63017

Job	Truss	Truss Type	Qty	Ply	Summit/161 Highland Meadows	RELEASE FOR CONSTRUCTION
3564895	J14	Jack-Open	2	1	Job Reference (optional)	AS NOTED FOR PLAN REVIEW DEVELOPMENT SERVICES LEE'S SUMMIT, MISSOURI

Builders FirstSource (Valley Center), Valley Center, KS - 67147,

8.630 s Nov 19 2022 MiTek Industries, Inc. Thu Jun 8 7:41:28 2023 Page 1

ID:icBMJaMgT1gasuUyx9?RhvzDEHb-RfC?PsB70Hq3NSqPqnL8v3uITxb6KVrCm7J4ZICP

07/08/2023

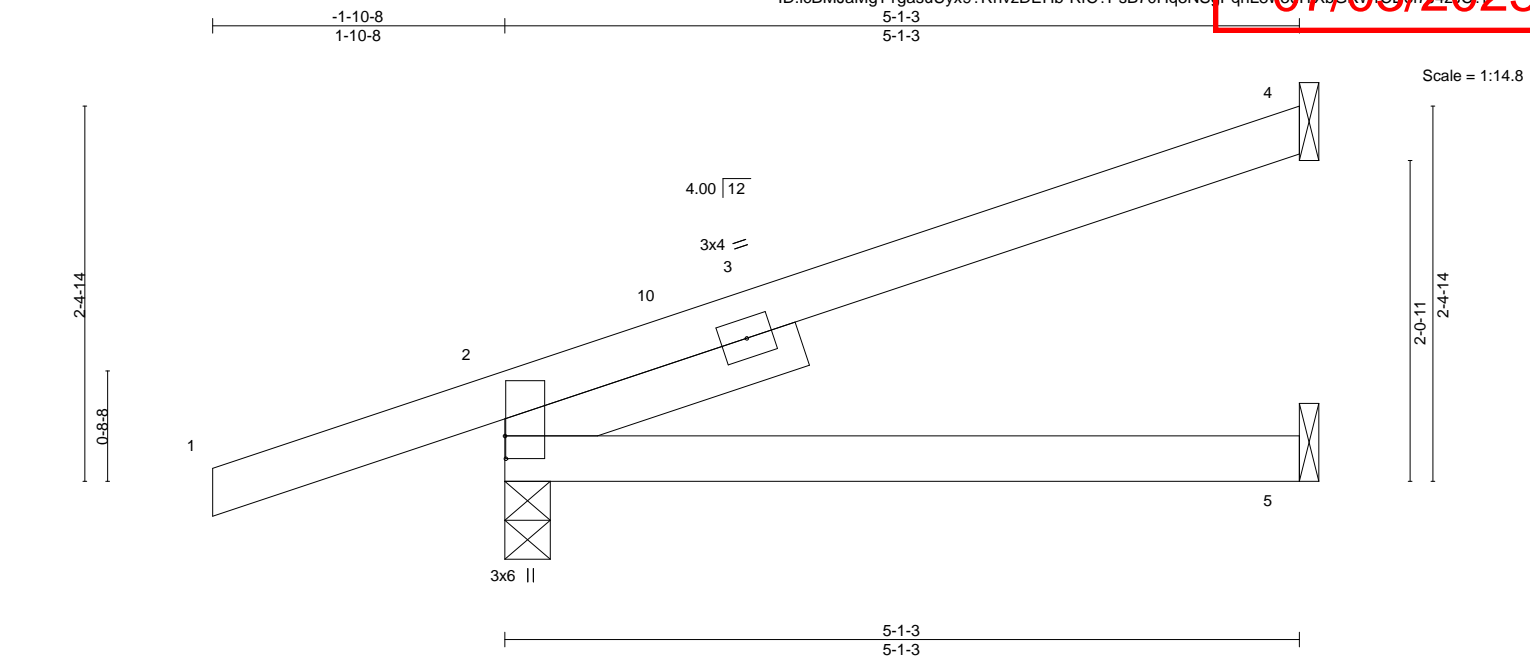


Plate Offsets (X,Y)--		[2:0-1-12,0-0-1]									
LOADING (psf)		SPACING-		2-0-0	CSI.		DEFL.	in	(loc)	l/defl	L/d
TCLL	25.0	Plate Grip DOL		1.15	TC	0.29	Vert(LL)	0.04	5-8	>999	240
TCDL	10.0	Lumber DOL		1.15	BC	0.20	Vert(CT)	-0.05	5-8	>999	180
BCLL	0.0	Rep Stress Incr	YES		WB	0.00	Horz(CT)	0.01	4	n/a	n/a
BCDL	10.0	Code	IRC2018/TPI2014		Matrix-AS						
								PLATES		GRIP	
								MT20		197/144	
								Weight: 17 lb		FT = 20%	

LUMBER-

TOP CHORD 2x4 SPF No.2
BOT CHORD 2x4 SPF No.2
SLIDER Left 2x4 SPF No.2 2-0-0

BRACING-

TOP CHORD Structural wood sheathing directly applied.
BOT CHORD Rigid ceiling directly applied.

REACTIONS.

(size) 4=Mechanical, 2=0-3-8, 5=Mechanical
Max Horz 2=92(LC 8)
Max Uplift 4=57(LC 12), 2=107(LC 8)
Max Grav 4=144(LC 1), 2=382(LC 1), 5=86(LC 3)

FORCES. (lb) - Max. Comp./Max. Ten. - All forces 250 (lb) or less except when shown.

NOTES-

- 1) Wind: ASCE 7-16; Vult=115mph (3-second gust) Vasd=91mph; TCDL=6.0psf; BCDL=4.2psf; h=15ft; Cat. II; Exp C; Enclosed; MWFRS (envelope) gable end zone and C-C Exterior(2E) -1-10-8 to 1-1-8, Interior(1) 1-1-8 to 5-0-7 zone; cantilever left and right exposed; end vertical left and right exposed; C-C for members and forces & MWFRS for reactions shown; Lumber DOL=1.60 plate grip DOL=1.60
- 2) This truss has been designed for a 10.0 psf bottom chord live load nonconcurrent with any other live loads.
- 3) Refer to girder(s) for truss to truss connections.
- 4) Provide mechanical connection (by others) of truss to bearing plate capable of withstanding 57 lb uplift at joint 4 and 107 lb uplift at joint 2.
- 5) This truss is designed in accordance with the 2018 International Residential Code sections R502.11.1 and R802.10.2 and referenced standard ANSI/TPI 1.
- 6) This truss design requires that a minimum of 7/16" structural wood sheathing be applied directly to the top chord and 1/2" gypsum sheetrock be applied directly to the bottom chord.



June 12, 2023

WARNING - Verify design parameters and READ NOTES ON THIS AND INCLUDED MITEK REFERENCE PAGE MII-7473 rev. 5/19/2020 BEFORE USE.

Design valid for use only with MiTek® connectors. This design is based only upon parameters shown, and is for an individual building component, not a truss system. Before use, the building designer must verify the applicability of design parameters and properly incorporate this design into the overall building design. Bracing indicated is to prevent buckling of individual truss web and/or chord members only. Additional temporary and permanent bracing is always required for stability and to prevent collapse with possible personal injury and property damage. For general guidance regarding the fabrication, storage, delivery, erection and bracing of trusses and truss systems, see

Safety Information available from Truss Plate Institute, 2670 Crain Highway, Suite 203 Waldorf, MD 20601



16023 Swingley Ridge Rd
Chesterfield, MO 63017

Job	Truss	Truss Type	Qty	Ply	Summit/161 Highland Meadows	RELEASE FOR CONSTRUCTION
3564895	J15	Jack-Open	2	1	Job Reference (optional)	AS NOTED FOR PLAN REVIEW
Builders FirstSource (Valley Center), Valley Center, KS - 67147,						DEVELOPMENT SERVICES
8.630 s Nov 19 2022 MiTek Industries, Inc. Thu Jun 8 7:41:29 2023 Page 1						LEE'S SUMMIT, MISSOURI
ID:icBMJaMgT1gasuUyx9?RhvzDEHb-RfC?PsB70Hq3NSpPqnL8v3uITxb6KVrCm7J4ZICP						158827535

07/03/2023

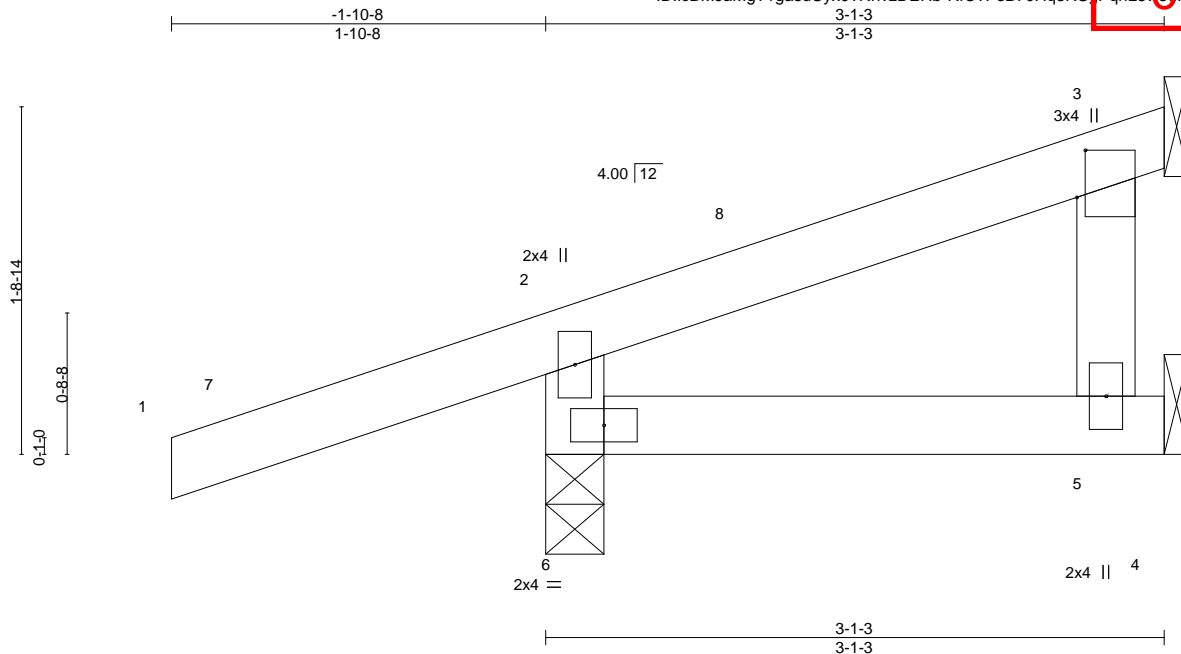


Plate Offsets (X,Y)--	[3:0-2-13,0-0-8]					
LOADING (psf)	SPACING-	2-0-0	CSI.	DEFL.	in (loc)	L/d
TCLL 25.0	Plate Grip DOL	1.15	TC 0.26	Vert(LL)	0.00 5-6	>999 240
TCDL 10.0	Lumber DOL	1.15	BC 0.07	Vert(CT)	-0.00 5-6	>999 180
BCLL 0.0	Rep Stress Incr	YES	WB 0.00	Horz(CT)	-0.00 3	n/a n/a
BCDL 10.0	Code	IRC2018/TPI2014	Matrix-MP			
Weight: 11 lb						FT = 20%

LUMBER-

TOP CHORD 2x4 SPF No.2
BOT CHORD 2x4 SPF No.2
WEBS 2x4 SPF No.2

BRACING-

TOP CHORD Structural wood sheathing directly applied or 3-1-3 oc purlins, except end verticals.
BOT CHORD Rigid ceiling directly applied or 10-0-0 oc bracing.

REACTIONS.

(size) 5=Mechanical, 3=Mechanical, 6=0-3-8
Max Horz 6=59(LC 8)
Max Uplift 3=-27(LC 12), 6=-112(LC 8)
Max Grav 5=57(LC 3), 3=55(LC 1), 6=315(LC 1)

FORCES.

(lb) - Max. Comp./Max. Ten. - All forces 250 (lb) or less except when shown.
TOP CHORD 2-6=-273/202

NOTES-

- 1) Unbalanced roof live loads have been considered for this design.
- 2) Wind: ASCE 7-16; Vult=115mph (3-second gust) Vasd=91mph; TCDL=6.0psf; BCDL=4.2psf; h=15ft; Cat. II; Exp C; Enclosed; MWFRS (envelope) gable end zone and C-C Exterior(2E) -1-10-8 to 1-1-8, Interior(1) 1-1-8 to 2-9-11 zone; cantilever left and right exposed; end vertical left and right exposed; C-C for members and forces & MWFRS for reactions shown; Lumber DOL=1.60 plate grip DOL=1.60
- 3) This truss has been designed for a 10.0 psf bottom chord live load nonconcurrent with any other live loads.
- 4) Refer to girder(s) for truss to truss connections.
- 5) Bearing at joint(s) 6 considers parallel to grain value using ANSI/TPI 1 angle to grain formula. Building designer should verify capacity of bearing surface.
- 6) Provide mechanical connection (by others) of truss to bearing plate capable of withstanding 27 lb uplift at joint 3 and 112 lb uplift at joint 6.
- 7) This truss is designed in accordance with the 2018 International Residential Code sections R502.11.1 and R802.10.2 and referenced standard ANSI/TPI 1.
- 8) Gap between inside of top chord bearing and first diagonal or vertical web shall not exceed 0.500in.



June 12, 2023

WARNING - Verify design parameters and READ NOTES ON THIS AND INCLUDED MITEK REFERENCE PAGE MII-7473 rev. 5/19/2020 BEFORE USE.

Design valid for use only with MiTek® connectors. This design is based only upon parameters shown, and is for an individual building component, not a truss system. Before use, the building designer must verify the applicability of design parameters and properly incorporate this design into the overall building design. Bracing indicated is to prevent buckling of individual truss web and/or chord members only. Additional temporary and permanent bracing is always required for stability and to prevent collapse with possible personal injury and property damage. For general guidance regarding the fabrication, storage, delivery, erection and bracing of trusses and truss systems, see

Safety Information available from Truss Plate Institute, 2670 Crain Highway, Suite 203 Waldorf, MD 20601

ANSI/TPI1 Quality Criteria, DSB-89 and BCSI Building Component



16023 Swingley Ridge Rd
Chesterfield, MO 63017

Job	Truss	Truss Type	Qty	Ply	Summit/161 Highland Meadows	AS NOTED FOR PLAN REVIEW DEVELOPMENT SERVICES LEE'S SUMMIT, MISSOURI
3564895	J16	Jack-Open	2	1	Job Reference (optional)	158827536


Builders FirstSource (Valley Center),

Valley Center, KS - 67147,

8.630 s Nov 19 2022 MiTek Industries, Inc. Thu Jun 8 7 18 30 2023 Page 1

ID:icBMJaMgT1gasuUyx9?RhvzDEHb-RfC?PsB70Hq3NSqPqnL8v3uITxb6KVrC0m7J4ZICP?

07/03/2023

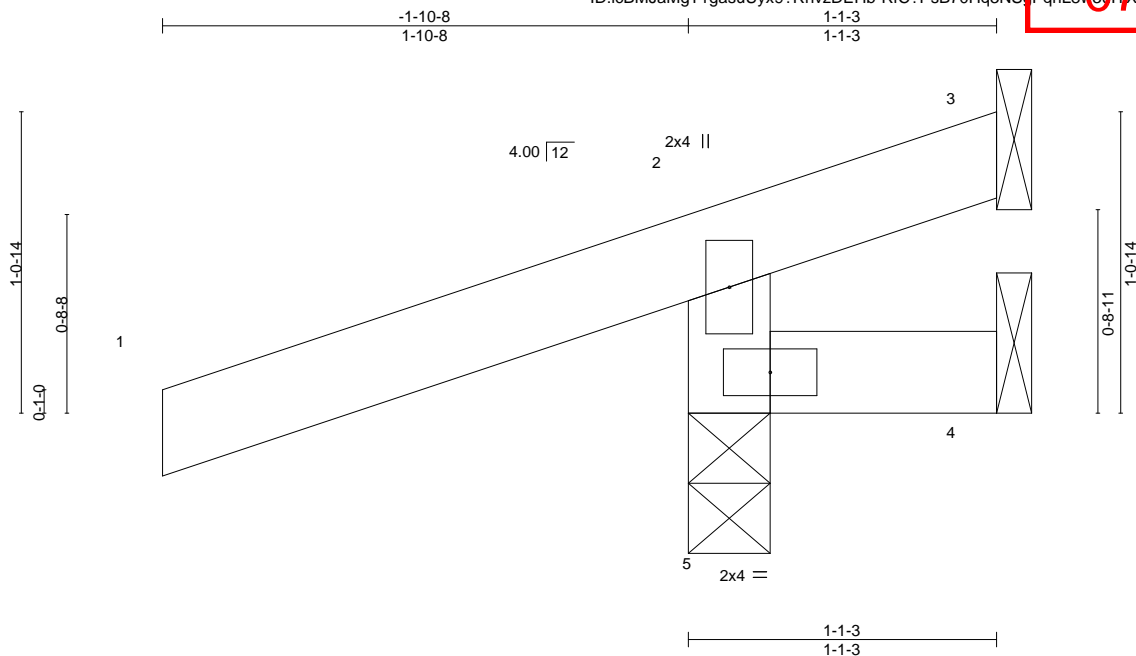

Scale = 1:8.2

LOADING (psf)	SPACING-	2-0-0	CSI.	DEFL.	in	(loc)	l/defl	L/d	PLATES	GRIP
TCLL 25.0	Plate Grip DOL	1.15	TC 0.28	Vert(LL)	0.00	5	>999	240	MT20	197/144
TCDL 10.0	Lumber DOL	1.15	BC 0.08	Vert(CT)	0.00	5	>999	180		
BCLL 0.0	Rep Stress Incr	YES	WB 0.00	Horz(CT)	-0.00	3	n/a	n/a		
BCDL 10.0	Code IRC2018/TPI2014		Matrix-MR						Weight: 5 lb	FT = 20%

LUMBER-

TOP CHORD 2x4 SPF No.2
BOT CHORD 2x4 SPF No.2
WEBS 2x4 SPF No.2

BRACING-

TOP CHORD Structural wood sheathing directly applied or 1-1-3 oc purlins, except end verticals.
BOT CHORD Rigid ceiling directly applied or 10-0-0 oc bracing.

REACTIONS.

(size) 3=Mechanical, 4=Mechanical, 5=0-3-8
Max Horz 5=38(LC 8)
Max Uplift 3=74(LC 1), 4=35(LC 1), 5=152(LC 8)
Max Grav 3=42(LC 8), 4=21(LC 8), 5=336(LC 1)

FORCES.

(lb) - Max. Comp./Max. Ten. - All forces 250 (lb) or less except when shown.
TOP CHORD 2-5=-282/213

NOTES-

- Wind: ASCE 7-16; Vult=115mph (3-second gust) Vasd=91mph; TCDL=6.0psf; BCDL=4.2psf; h=15ft; Cat. II; Exp C; Enclosed; MWFRS (envelope) gable end zone and C-C Exterior(2E) zone; cantilever left and right exposed; end vertical left and right exposed; C-C for members and forces & MWFRS for reactions shown; Lumber DOL=1.60 plate grip DOL=1.60
- This truss has been designed for a 10.0 psf bottom chord live load nonconcurrent with any other live loads.
- Refer to girder(s) for truss to truss connections.
- Bearing at joint(s) 5 considers parallel to grain value using ANSI/TPI 1 angle to grain formula. Building designer should verify capacity of bearing surface.
- Provide mechanical connection (by others) of truss to bearing plate capable of withstanding 74 lb uplift at joint 3, 35 lb uplift at joint 4 and 152 lb uplift at joint 5.
- This truss is designed in accordance with the 2018 International Residential Code sections R502.11.1 and R802.10.2 and referenced standard ANSI/TPI 1.



June 12, 2023

WARNING - Verify design parameters and READ NOTES ON THIS AND INCLUDED MITEK REFERENCE PAGE MII-7473 rev. 5/19/2020 BEFORE USE.

Design valid for use only with MiTek® connectors. This design is based only upon parameters shown, and is for an individual building component, not a truss system. Before use, the building designer must verify the applicability of design parameters and properly incorporate this design into the overall building design. Bracing indicated is to prevent buckling of individual truss web and/or chord members only. Additional temporary and permanent bracing is always required for stability and to prevent collapse with possible personal injury and property damage. For general guidance regarding the fabrication, storage, delivery, erection and bracing of trusses and truss systems, see

ANSI/TPI1 Quality Criteria, DSB-89 and BCSI Building Component

Safety Information available from Truss Plate Institute, 2670 Crain Highway, Suite 203 Waldorf, MD 20601



16023 Swingley Ridge Rd
Chesterfield, MO 63017

Job	Truss	Truss Type	Qty	Ply	Summit/161 Highland Meadows	RELEASE FOR CONSTRUCTION
3564895	J17	Roof Special Girder	1	1		AS NOTED FOR PLAN REVIEW
					Job Reference (optional)	DEVELOPMENT SERVICES
						LEE'S SUMMIT, MISSOURI

Builders FirstSource (Valley Center), Valley Center, KS - 67147,


8.630 s Nov 19 2022 MiTek Industries, Inc. Thu Jun 8 7 47 18 31 2023 Page 1

ID:icBMJaMgT1gasuUyx9?RhvzDEHb-RfC?PsB70Hq3NSqPqnL8v3uITxb6KVrCm7J4ZICP

07/03/2023

-1-10-8	2-0-0	5-6-0	8-0-0
1-10-8	2-0-0	3-6-0	2-6-0

Scale = 1:18.9

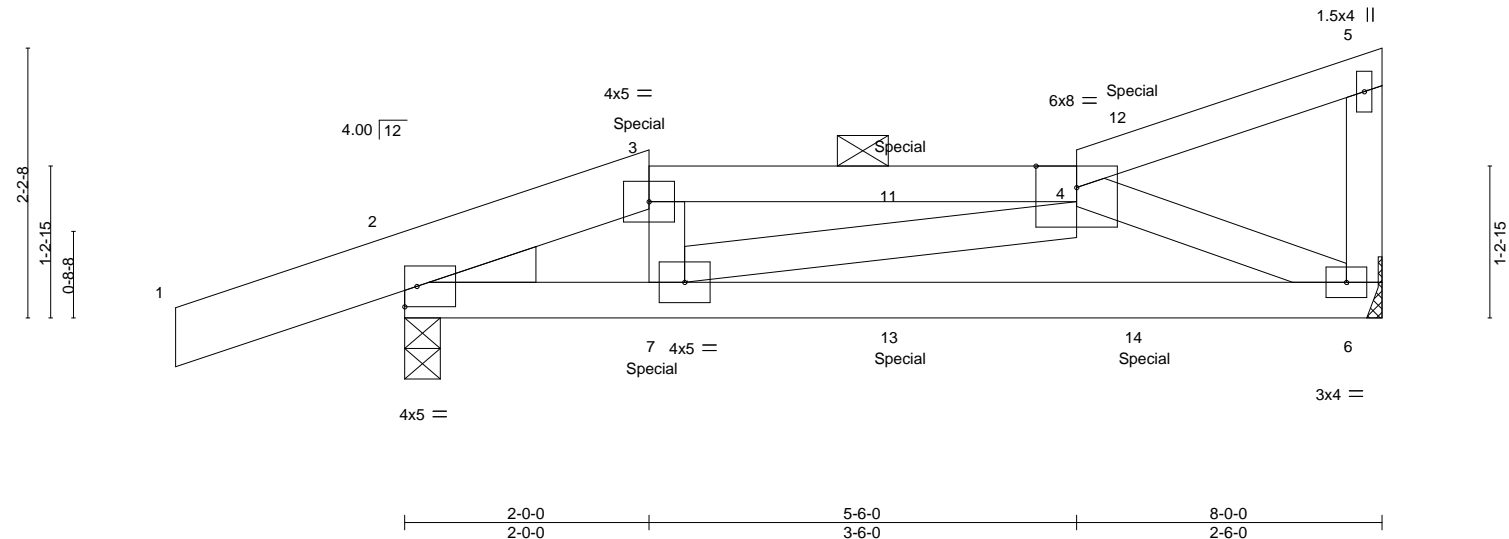

LOADING (psf)	SPACING-	2-0-0	CSL.	DEFL.	in (loc)	l/defl	L/d	PLATES	GRIP
TCLL 25.0	Plate Grip DOL	1.15	TC 0.31	Vert(LL)	-0.04	6-7	>999	240	MT20
TCDL 10.0	Lumber DOL	1.15	BC 0.39	Vert(CT)	-0.10	6-7	>950	180	197/144
BCLL 0.0	Rep Stress Incr	NO	WB 0.10	Horz(CT)	0.01	6	n/a	n/a	
BCDL 10.0	Code IRC2018/TPI2014		Matrix-MP						
								Weight: 34 lb	FT = 20%

LUMBER-

TOP CHORD 2x4 SPF No.2 *Except*
1-3: 2x6 SPF No.2
BOT CHORD 2x4 SPF No.2
WEBS 2x4 SPF No.2
WEDGE
Left: 2x4 SP No.3

BRACING-

TOP CHORD Structural wood sheathing directly applied or 6-0-0 oc purlins, except end verticals, and 2-0-0 oc purlins (6-0-0 max.): 3-4.
BOT CHORD Rigid ceiling directly applied or 10-0-0 oc bracing.

REACTIONS.

(size) 6=Mechanical, 2=0-3-8
Max Horz 2=82(LC 7)
Max Uplift 6=69(LC 8), 2=148(LC 4)
Max Grav 6=399(LC 1), 2=550(LC 1)

FORCES. (lb) - Max. Comp./Max. Ten. - All forces 250 (lb) or less except when shown.

TOP CHORD 2-3=-719/68, 3-4=-649/64
BOT CHORD 2-7=-78/629, 6-7=-126/565
WEBS 4-6=-614/155, 4-7=0/253

NOTES-

- 1) Wind: ASCE 7-16; Vult=115mph (3-second gust) Vasd=91mph; TCDL=6.0psf; BCDL=4.2psf; h=15ft; Cat. II; Exp C; Enclosed; MWFRS (envelope) gable end zone; cantilever left and right exposed; end vertical left and right exposed; Lumber DOL=1.60 plate grip DOL=1.60
- 2) Provide adequate drainage to prevent water ponding.
- 3) This truss has been designed for a 10.0 psf bottom chord live load nonconcurrent with any other live loads.
- 4) Refer to girder(s) for truss to truss connections.
- 5) Provide mechanical connection (by others) of truss to bearing plate capable of withstanding 69 lb uplift at joint 6 and 148 lb uplift at joint 2.
- 6) This truss is designed in accordance with the 2018 International Residential Code sections R502.11.1 and R802.10.2 and referenced standard ANSI/TPI 1.
- 7) Graphical purlin representation does not depict the size or the orientation of the purlin along the top and/or bottom chord.
- 8) Hanger(s) or other connection device(s) shall be provided sufficient to support concentrated load(s) 28 lb down and 36 lb up at 2-0-0, and 29 lb down and 37 lb up at 4-0-12, and 29 lb down and 38 lb up at 6-0-12 on top chord, and 65 lb down and 14 lb up at 2-0-0, and 25 lb down at 4-0-12, and 25 lb down at 6-0-12 on bottom chord. The design/selection of such connection device(s) is the responsibility of others.
- 9) In the LOAD CASE(S) section, loads applied to the face of the truss are noted as front (F) or back (B).

LOAD CASE(S) Standard

- 1) Dead + Roof Live (balanced): Lumber Increase=1.15, Plate Increase=1.15
Uniform Loads (plf)
Vert: 1-3=-70, 3-4=-70, 4-5=-70, 6-8=-20



June 12, 2023

Continued on page 2

WARNING - Verify design parameters and READ NOTES ON THIS AND INCLUDED MITEK REFERENCE PAGE MII-7473 rev. 5/19/2020 BEFORE USE.

Design valid for use only with MiTek® connectors. This design is based only upon parameters shown, and is for an individual building component, not a truss system. Before use, the building designer must verify the applicability of design parameters and properly incorporate this design into the overall building design. Bracing indicated is to prevent buckling of individual truss web and/or chord members only. Additional temporary and permanent bracing is always required for stability and to prevent collapse with possible personal injury and property damage. For general guidance regarding the fabrication, storage, delivery, erection and bracing of trusses and truss systems, see

ANSI/TPI1 Quality Criteria, DSB-89 and BCSI Building Component

Safety Information available from Truss Plate Institute, 2670 Crain Highway, Suite 203 Waldorf, MD 20601



16023 Swingley Ridge Rd
Chesterfield, MO 63017

Job	Truss	Truss Type	Qty	Ply	Summit/161 Highland Meadows	RELEASE FOR CONSTRUCTION
3564895	J17	Roof Special Girder	1	1	Job Reference (optional)	AS NOTED FOR PLAN REVIEW DEVELOPMENT SERVICES LEE'S SUMMIT, MISSOURI

Builders FirstSource (Valley Center), Valley Center, KS - 67147,

8.630 s Nov 19 2022 MiTek Industries, Inc. Thu Jun 07 16:31 2023 Page 2

ID:icBMJaMgT1gasuUyx9?RhvzDEHb-RfC?PsB70Hq3NSpPqnL8v3uITxbS KV rCm7 J4ZIC?1

07/03/2023

LOAD CASE(S) Standard
Concentrated Loads (lb)
Vert: 3=-13(B) 7=-15(B) 11=-17(B) 12=-17(B) 13=-25(B) 14=-25(B)




Job	Truss	Truss Type	Qty	Ply	Summit/161 Highland Meadows	RELEASE FOR CONSTRUCTION
3564895	J18	Half Hip	1	1		AS NOTED FOR PLAN REVIEW
					Job Reference (optional)	DEVELOPMENT SERVICES
						LEE'S SUMMIT, MISSOURI

Builders FirstSource (Valley Center), Valley Center, KS - 67147,

8.630 s Nov 19 2022 MiTek Industries, Inc. Thu Jun 9 7 47 18 32 2023 Page 1

ID:icBMJaMgT1gasuUyx9?RhvzDEHb-RfC?PsB70Hq3NSpPqnL8v3uITxb6SVrCm7J4ZICP

07/03/2023

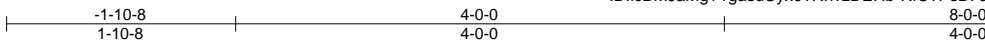

Scale = 1:18.9

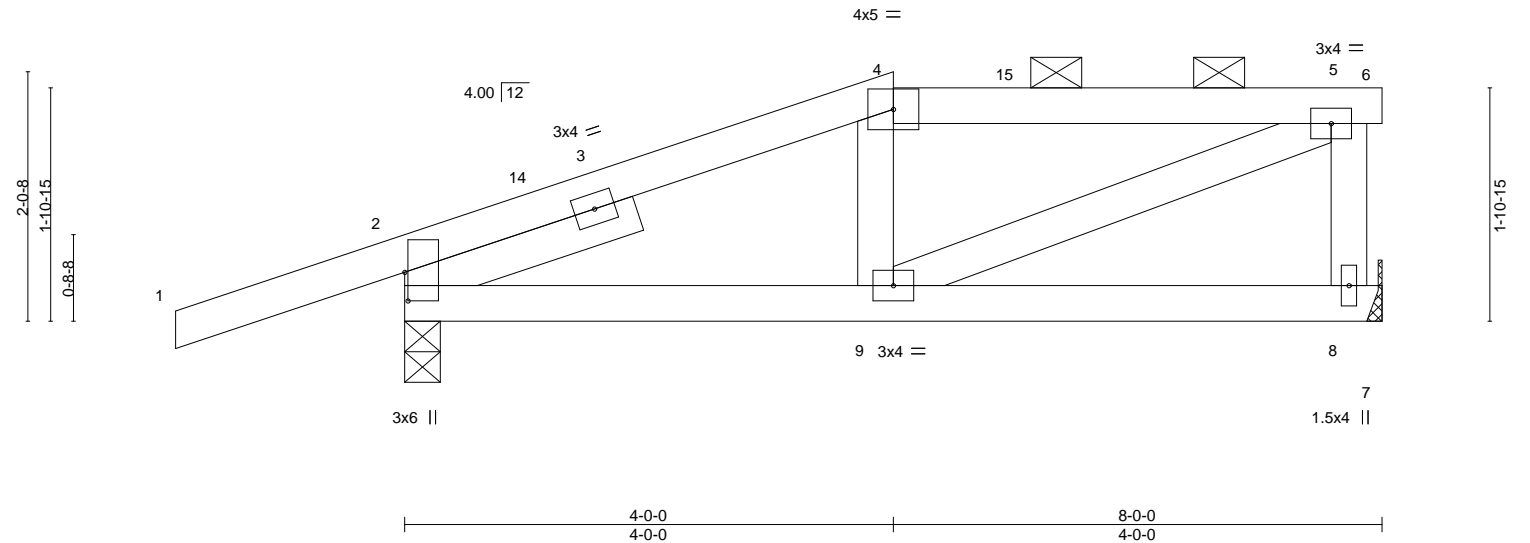


Plate Offsets (X,Y)--	[2:0-2-13,0-0-5]								
LOADING (psf)	SPACING-	2-0-0	CSI.	DEFL.	in (loc)	l/defl	L/d	PLATES	GRIP
TCLL 25.0	Plate Grip DOL	1.15	TC 0.27	Vert(LL)	-0.01	8-9	>999	MT20	197/144
TCDL 10.0	Lumber DOL	1.15	BC 0.13	Vert(CT)	-0.02	8-9	>999		
BCLL 0.0	Rep Stress Incr	YES	WB 0.10	Horz(CT)	-0.00	2	n/a		
BCDL 10.0	Code IRC2018/TPI2014		Matrix-AS					Weight: 31 lb	FT = 20%

LUMBER-

TOP CHORD 2x4 SPF No.2
BOT CHORD 2x4 SPF No.2
WEBS 2x4 SPF No.2
SLIDER Left 2x4 SPF No.2 2-0-0

BRACING-

TOP CHORD Structural wood sheathing directly applied, except
2-0-0 oc purlins (6-0-0 max.): 4-6.
BOT CHORD Rigid ceiling directly applied.

REACTIONS.

(size) 2=0-3-8, 8=Mechanical
Max Horz 2=75(LC 8)
Max Uplift 2=-134(LC 8), 8=-59(LC 8)
Max Grav 2=495(LC 1), 8=343(LC 1)

FORCES. (lb) - Max. Comp./Max. Ten. - All forces 250 (lb) or less except when shown.

TOP CHORD 2-4=-395/164, 4-5=-387/189
BOT CHORD 2-9=-179/378
WEBS 5-8=-303/153, 5-9=-203/418

NOTES-

- 1) Unbalanced roof live loads have been considered for this design.
- 2) Wind: ASCE 7-16; Vult=115mph (3-second gust) Vasd=91mph; TCDL=6.0psf; BCDL=4.2psf; h=15ft; Cat. II; Exp C; Enclosed; MWFRS (envelope) gable end zone and C-C Exterior(2E) -1-10-8 to 1-1-8, Interior(1) 1-1-8 to 4-0-0, Exterior(2E) 4-0-0 to 8-0-0 zone; cantilever left and right exposed ; end vertical left and right exposed;C-C for members and forces & MWFRS for reactions shown; Lumber DOL=1.60 plate grip DOL=1.60
- 3) Provide adequate drainage to prevent water ponding.
- 4) This truss has been designed for a 10.0 psf bottom chord live load nonconcurrent with any other live loads.
- 5) Refer to girder(s) for truss to truss connections.
- 6) Provide mechanical connection (by others) of truss to bearing plate capable of withstanding 134 lb uplift at joint 2 and 59 lb uplift at joint 8.
- 7) This truss is designed in accordance with the 2018 International Residential Code sections R502.11.1 and R802.10.2 and referenced standard ANSI/TPI 1.
- 8) This truss design requires that a minimum of 7/16" structural wood sheathing be applied directly to the top chord and 1/2" gypsum sheetrock be applied directly to the bottom chord.
- 9) Graphical purlin representation does not depict the size or the orientation of the purlin along the top and/or bottom chord.



June 12,2023

WARNING - Verify design parameters and READ NOTES ON THIS AND INCLUDED MITEK REFERENCE PAGE MII-7473 rev. 5/19/2020 BEFORE USE.

Design valid for use only with MiTek® connectors. This design is based only upon parameters shown, and is for an individual building component, not a truss system. Before use, the building designer must verify the applicability of design parameters and properly incorporate this design into the overall building design. Bracing indicated is to prevent buckling of individual truss web and/or chord members only. Additional temporary and permanent bracing is always required for stability and to prevent collapse with possible personal injury and property damage. For general guidance regarding the fabrication, storage, delivery, erection and bracing of trusses and truss systems, see

ANSI/TPI1 Quality Criteria, DSB-89 and BCSI Building Component

Safety Information available from Truss Plate Institute, 2670 Crain Highway, Suite 203 Waldorf, MD 20601



16023 Swingley Ridge Rd
Chesterfield, MO 63017

Job	Truss	Truss Type	Qty	Ply	Summit/161 Highland Meadows	AS NOTED FOR PLAN REVIEW DEVELOPMENT SERVICES LEE'S SUMMIT, MISSOURI
3564895	J19	Half Hip	1	1	Job Reference (optional)	

Builders FirstSource (Valley Center), Valley Center, KS - 67147,

8.630 s Nov 19 2022 MiTek Industries, Inc. Thu Jun 8 7 10 33 2023 Page 1

ID:icBMJaMgT1gasuUyx9?RhvzDEHb-RfC?PsB70Hq3NSpPqnL8v3uITxb6KVrCm7J4ZICP

07/08/2023

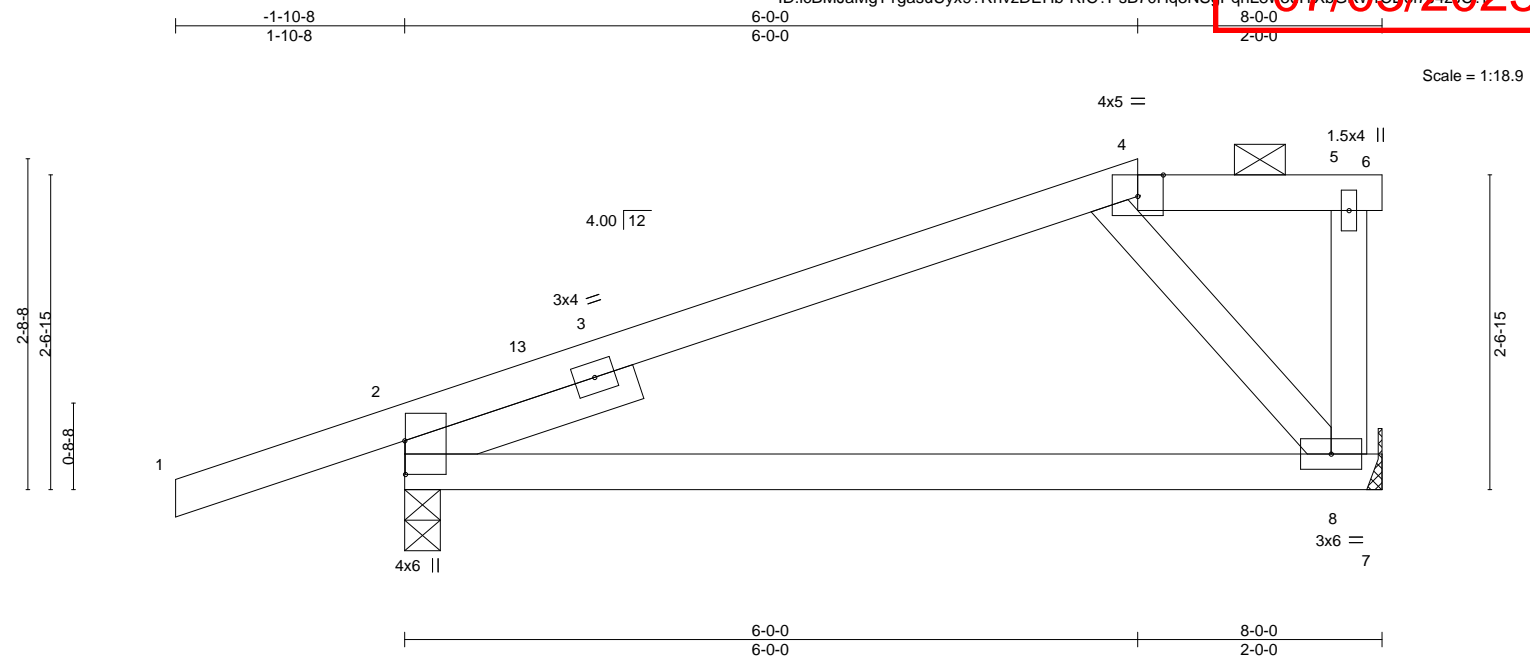


Plate Offsets (X,Y)-- [2:0-3-5,0-0-1], [4:0-2-8,Edge]											
LOADING (psf)		SPACING- 2-0-0		CSI.		DEFL. in (loc) l/defl L/d			PLATES GRIP		
TCLL	25.0	Plate Grip DOL	1.15	TC	0.48	Vert(LL)	-0.11	8-11	>828	240	MT20 197/144
TCDL	10.0	Lumber DOL	1.15	BC	0.45	Vert(CT)	-0.24	8-11	>379	180	
BCLL	0.0	Rep Stress Incr	YES	WB	0.05	Horz(CT)	0.03	2	n/a	n/a	
BCDL	10.0	Code IRC2018/TPI2014		Matrix-AS							Weight: 29 lb FT = 20%

LUMBER-
TOP CHORD 2x4 SPF No.2
BOT CHORD 2x4 SPF No.2
WEBS 2x4 SPF No.2
SLIDER Left 2x4 SPF No.2 2-0-0

BRACING-
TOP CHORD Structural wood sheathing directly applied, except end verticals, and 2-0-0 oc purlins (6-0-0 max.): 4-6.
BOT CHORD Rigid ceiling directly applied.

REACTIONS. (size) 2=0-3-8, 8=Mechanical
Max Horz 2=97(LC 11)
Max Uplift 2=134(LC 8), 8=59(LC 8)
Max Grav 2=495(LC 1), 8=343(LC 1)

FORCES. (lb) - Max. Comp./Max. Ten. - All forces 250 (lb) or less except when shown.
TOP CHORD 2-4=-562/82

NOTES-

- Unbalanced roof live loads have been considered for this design.
- Wind: ASCE 7-16; Vult=115mph (3-second gust) Vasd=91mph; TCDL=6.0psf; BCDL=4.2psf; h=15ft; Cat. II; Exp C; Enclosed; MWFRS (envelope) gable end zone and C-C Exterior(2E) -1-10-8 to 1-1-8, Interior(1) 1-1-8 to 6-0-0, Exterior(2E) 6-0-0 to 8-0-0 zone; cantilever left and right exposed; end vertical left and right exposed; C-C for members and forces & MWFRS for reactions shown; Lumber DOL=1.60 plate grip DOL=1.60
- Provide adequate drainage to prevent water ponding.
- This truss has been designed for a 10.0 psf bottom chord live load nonconcurrent with any other live loads.
- Refer to girder(s) for truss to truss connections.
- Provide mechanical connection (by others) of truss to bearing plate capable of withstanding 134 lb uplift at joint 2 and 59 lb uplift at joint 8.
- This truss is designed in accordance with the 2018 International Residential Code sections R502.11.1 and R802.10.2 and referenced standard ANSI/TPI 1.
- This truss design requires that a minimum of 7/16" structural wood sheathing be applied directly to the top chord and 1/2" gypsum sheetrock be applied directly to the bottom chord.
- Graphical purlin representation does not depict the size or the orientation of the purlin along the top and/or bottom chord.



June 12, 2023

WARNING - Verify design parameters and READ NOTES ON THIS AND INCLUDED MITEK REFERENCE PAGE MII-7473 rev. 5/19/2020 BEFORE USE.

Design valid for use only with MiTek® connectors. This design is based only upon parameters shown, and is for an individual building component, not a truss system. Before use, the building designer must verify the applicability of design parameters and properly incorporate this design into the overall building design. Bracing indicated is to prevent buckling of individual truss web and/or chord members only. Additional temporary and permanent bracing is always required for stability and to prevent collapse with possible personal injury and property damage. For general guidance regarding the fabrication, storage, delivery, erection and bracing of trusses and truss systems, see **ANSI/TPI1 Quality Criteria, DSB-89 and BCSI Building Component Safety Information** available from Truss Plate Institute, 2670 Crain Highway, Suite 203 Waldorf, MD 20601



16023 Swingley Ridge Rd
Chesterfield, MO 63017

Job	Truss	Truss Type	Qty	Ply	Summit/161 Highland Meadows	RELEASE FOR CONSTRUCTION
3564895	J20	Jack-Partial	6	1	Job Reference (optional)	AS NOTED FOR PLAN REVIEW DEVELOPMENT SERVICES LEE'S SUMMIT, MISSOURI

Builders FirstSource (Valley Center), Valley Center, KS - 67147,

8.630 s Nov 19 2022 MiTek Industries, Inc. Thu Jun 07 16:35:2023 Page 1

ID:icBMJaMgT1gasuUyx9?RhvzDEHb-RfC?PsB70Hq3NSqPqnL8v3uITxb6KVrCm7J4ZICP

07/03/2023

Scale = 1:20.9

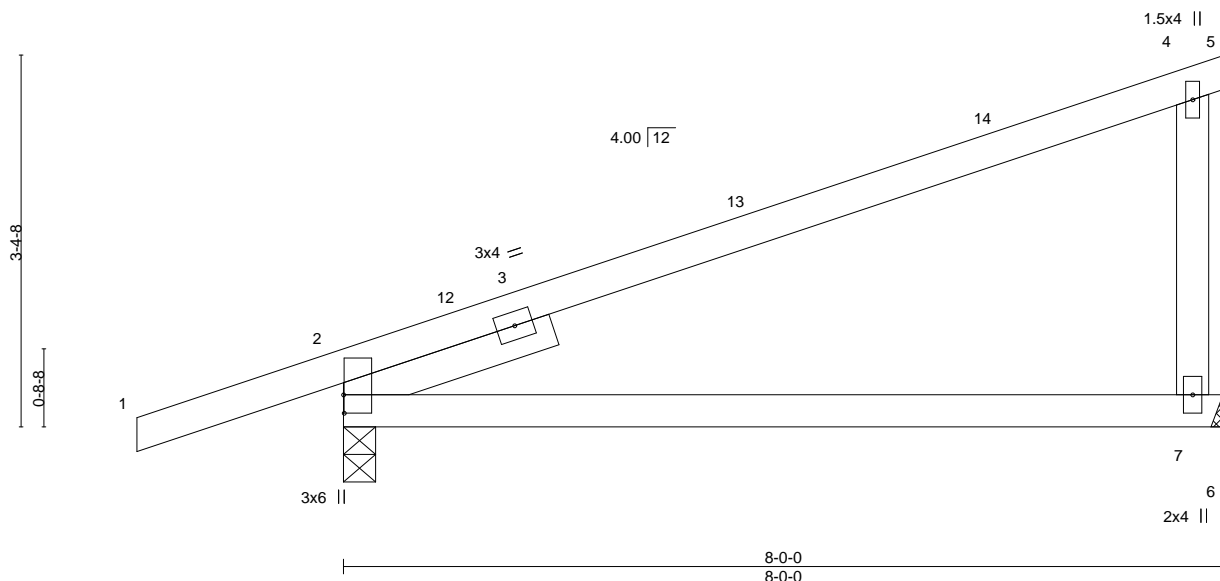


Plate Offsets (X,Y)--	[2:0-2-0,0-0-1]								
LOADING (psf)	SPACING-	2-0-0	CSI.	DEFL.	in (loc)	l/defl	L/d	PLATES	GRIP
TCLL 25.0	Plate Grip DOL	1.15	TC 0.77	Vert(LL)	0.14 7-10	>644	240	MT20	197/144
TCDL 10.0	Lumber DOL	1.15	BC 0.52	Vert(CT)	-0.32 7-10	>293	180		
BCLL 0.0	Rep Stress Incr	YES	WB 0.05	Horz(CT)	0.06 2	n/a	n/a		
BCDL 10.0	Code IRC2018/TPI2014		Matrix-AS					Weight: 26 lb	FT = 20%

LUMBER-

TOP CHORD 2x4 SPF No.2
BOT CHORD 2x4 SPF No.2
WEBS 2x4 SPF No.2
SLIDER Left 2x4 SPF No.2 2-0-0

BRACING-

TOP CHORD Structural wood sheathing directly applied.
BOT CHORD Rigid ceiling directly applied.

REACTIONS.

(size) 2=0-3-8, 7=Mechanical
Max Horz 2=128(LC 8)
Max Uplift 2=-118(LC 8), 7=-80(LC 8)
Max Grav 2=494(LC 1), 7=343(LC 1)

FORCES. (lb) - Max. Comp./Max. Ten. - All forces 250 (lb) or less except when shown.

TOP CHORD 2-4=-445/59

NOTES-

- 1) Wind: ASCE 7-16; Vult=115mph (3-second gust) Vasd=91mph; TCDL=6.0psf; BCDL=4.2psf; h=15ft; Cat. II; Exp C; Enclosed; MWFRS (envelope) gable end zone and C-C Exterior(2E) -1-10-8 to 1-1-8, Interior(1) 1-1-8 to 8-0-0 zone; cantilever left and right exposed ; end vertical left and right exposed;C-C for members and forces & MWFRS for reactions shown; Lumber DOL=1.60 plate grip DOL=1.60
- 2) This truss has been designed for a 10.0 psf bottom chord live load nonconcurrent with any other live loads.
- 3) Refer to girder(s) for truss to truss connections.
- 4) Provide mechanical connection (by others) of truss to bearing plate capable of withstanding 118 lb uplift at joint 2 and 80 lb uplift at joint 7.
- 5) This truss is designed in accordance with the 2018 International Residential Code sections R502.11.1 and R802.10.2 and referenced standard ANSI/TPI 1.
- 6) This truss design requires that a minimum of 7/16" structural wood sheathing be applied directly to the top chord and 1/2" gypsum sheetrock be applied directly to the bottom chord.



June 12,2023

WARNING - Verify design parameters and READ NOTES ON THIS AND INCLUDED MITEK REFERENCE PAGE MII-7473 rev. 5/19/2020 BEFORE USE.

Design valid for use only with MiTek® connectors. This design is based only upon parameters shown, and is for an individual building component, not a truss system. Before use, the building designer must verify the applicability of design parameters and properly incorporate this design into the overall building design. Bracing indicated is to prevent buckling of individual truss web and/or chord members only. Additional temporary and permanent bracing is always required for stability and to prevent collapse with possible personal injury and property damage. For general guidance regarding the fabrication, storage, delivery, erection and bracing of trusses and truss systems, see

ANSI/TPI1 Quality Criteria, DSB-89 and BCSI Building Component

Safety Information available from Truss Plate Institute, 2670 Crain Highway, Suite 203 Waldorf, MD 20601



16023 Swingley Ridge Rd
Chesterfield, MO 63017


Job	Truss	Truss Type	Qty	Ply	Summit/161 Highland Meadows	RELEASE FOR CONSTRUCTION
3564895	J21	Jack-Partial	3	1		AS NOTED FOR PLAN REVIEW
					Job Reference (optional)	DEVELOPMENT SERVICES
						LEE'S SUMMIT, MISSOURI

Builders FirstSource (Valley Center), Valley Center, KS - 67147,

8.630 s Nov 19 2022 MiTek Industries, Inc. Thu Jun 8 7 47 18 36 2023 Page 1

ID:icBMJaMgT1gasuUyx9?RhvzDEHb-RfC?PsB70Hq3NSpPqnL8v3uITxb6KVrCm7J4ZICP

07/03/2023

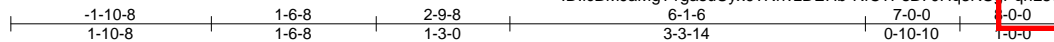

Scale = 1:21.5

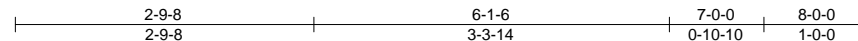
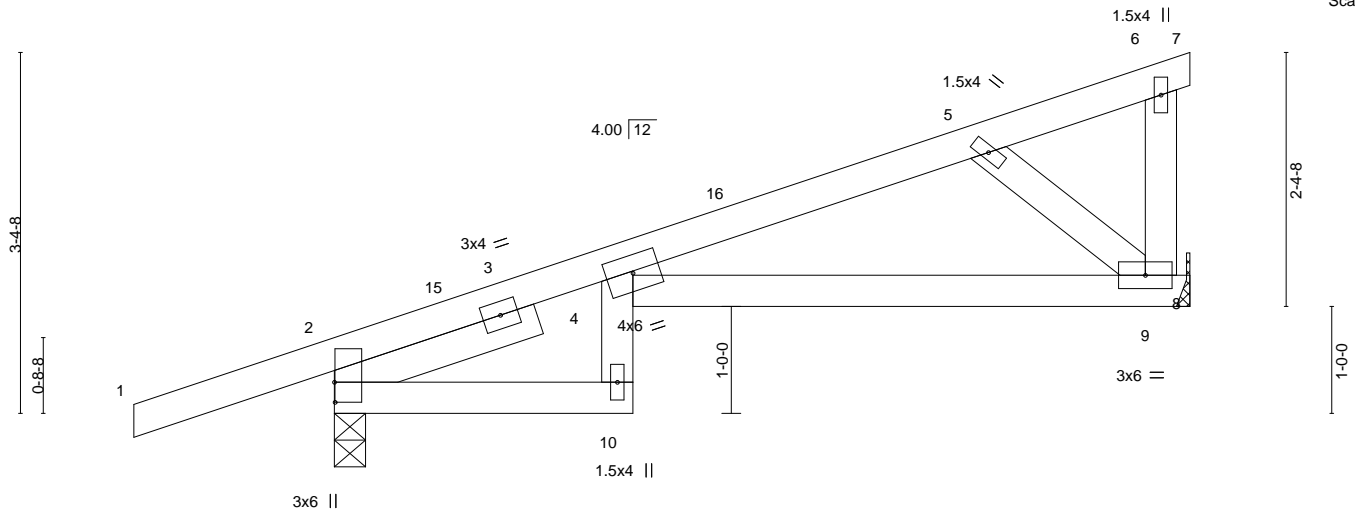


Plate Offsets (X,Y)-- [2:0-2-4,0-0-1]												
LOADING (psf)		SPACING- 2-0-0		CSI.		DEFL. in (loc) l/defl L/d			PLATES	GRIP		
TCLL	25.0	Plate Grip DOL	1.15	TC	1.00	Vert(LL)	-0.21	10	>446	240	MT20	197/144
TCDL	10.0	Lumber DOL	1.15	BC	0.32	Vert(CT)	-0.38	10	>242	180		
BCLL	0.0	Rep Stress Incr	YES	WB	0.09	Horz(CT)	0.21	9	n/a	n/a		
BCDL	10.0	Code IRC2018/TPI2014		Matrix-AS							Weight: 29 lb	FT = 20%

LUMBER-

TOP CHORD 2x4 SPF No.2
BOT CHORD 2x4 SPF No.2
WEBS 2x4 SPF No.2
SLIDER Left 2x4 SPF No.2 2-0-0

BRACING-

TOP CHORD Structural wood sheathing directly applied.
BOT CHORD Rigid ceiling directly applied.

REACTIONS.

(size) 2=0-3-8, 9=Mechanical
Max Horz 2=128(LC 8)
Max Uplift 2=117(LC 8), 9=79(LC 8)
Max Grav 2=496(LC 1), 9=343(LC 1)

FORCES. (lb) - Max. Comp./Max. Ten. - All forces 250 (lb) or less except when shown.

TOP CHORD 4-12=-250/52, 4-5=-458/209
BOT CHORD 4-9=-310/466
WEBS 5-9=-594/396

NOTES-

- 1) Wind: ASCE 7-16; Vult=115mph (3-second gust) Vasd=91mph; TCDL=6.0psf; BCDL=4.2psf; h=15ft; Cat. II; Exp C; Enclosed; MWFRS (envelope) gable end zone and C-C Exterior(2E) -1-10-8 to 1-1-8, Interior(1) 1-1-8 to 8-0-0 zone; cantilever left and right exposed; end vertical left and right exposed; C-C for members and forces & MWFRS for reactions shown; Lumber DOL=1.60 plate grip DOL=1.60
- 2) This truss has been designed for a 10.0 psf bottom chord live load nonconcurrent with any other live loads.
- 3) Refer to girder(s) for truss to truss connections.
- 4) Provide mechanical connection (by others) of truss to bearing plate capable of withstanding 117 lb uplift at joint 2 and 79 lb uplift at joint 9.
- 5) This truss is designed in accordance with the 2018 International Residential Code sections R502.11.1 and R802.10.2 and referenced standard ANSI/TPI 1.
- 6) This truss design requires that a minimum of 7/16" structural wood sheathing be applied directly to the top chord and 1/2" gypsum sheetrock be applied directly to the bottom chord.



June 12, 2023

WARNING - Verify design parameters and READ NOTES ON THIS AND INCLUDED MITEK REFERENCE PAGE MII-7473 rev. 5/19/2020 BEFORE USE.

Design valid for use only with MiTek® connectors. This design is based only upon parameters shown, and is for an individual building component, not a truss system. Before use, the building designer must verify the applicability of design parameters and properly incorporate this design into the overall building design. Bracing indicated is to prevent buckling of individual truss web and/or chord members only. Additional temporary and permanent bracing is always required for stability and to prevent collapse with possible personal injury and property damage. For general guidance regarding the fabrication, storage, delivery, erection and bracing of trusses and truss systems, see

ANSI/TPI1 Quality Criteria, DSB-89 and BCSI Building Component

Safety Information available from Truss Plate Institute, 2670 Crain Highway, Suite 203 Waldorf, MD 20601



16023 Swingley Ridge Rd
Chesterfield, MO 63017

Job	Truss	Truss Type	Qty	Ply	Summit/161 Highland Meadows	AS NOTED FOR PLAN REVIEW DEVELOPMENT SERVICES LEE'S SUMMIT, MISSOURI
3564895	J22	Jack-Open	2	1	Job Reference (optional)	

Builders FirstSource (Valley Center), Valley Center, KS - 67147,

8.630 s Nov 19 2022 MiTek Industries, Inc. Thu Jun 8 14:18:37 2023 Page 1

ID:icBMJaMgT1gasuUyx9?RhvzDEHb-RfC?PsB70Hq3NSqPqnL8v3uITxb6KVrCg7J4ZICP

07/03/2023

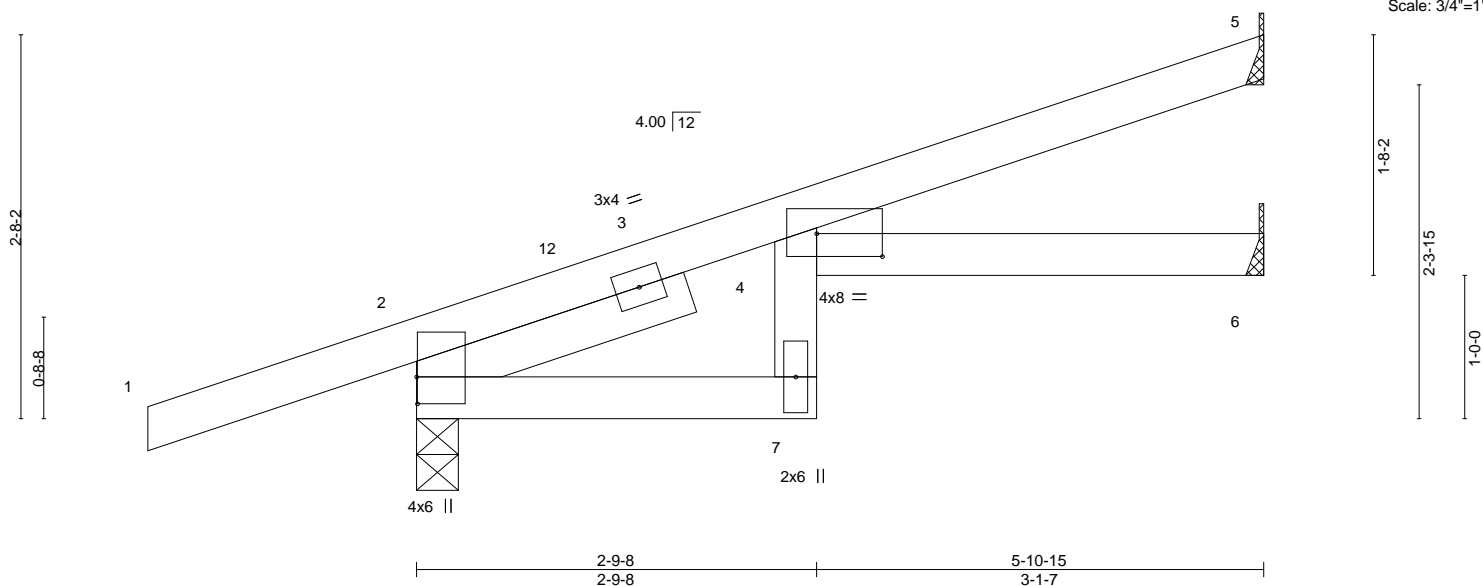


Plate Offsets (X,Y)-- [2:0-2-4,0-0-1], [4:0-5-8,0-1-15]												
LOADING (psf)		SPACING- 2-0-0		CSI.		DEFL. in (loc) l/defl L/d			PLATES	GRIP		
TCLL	25.0	Plate Grip DOL	1.15	TC	0.57	Vert(LL)	0.11	7	>661	240	MT20	197/144
TCDL	10.0	Lumber DOL	1.15	BC	0.39	Vert(CT)	-0.15	7	>465	180		
BCLL	0.0	Rep Stress Incr	YES	WB	0.00	Horz(CT)	0.09	6	n/a	n/a		
BCDL	10.0	Code IRC2018/TPI2014		Matrix-AS							Weight: 20 lb	FT = 20%

LUMBER-
TOP CHORD 2x4 SPF No.2
BOT CHORD 2x4 SPF No.2
SLIDER Left 2x4 SPF No.2 2-0-0

BRACING-
TOP CHORD Structural wood sheathing directly applied.
BOT CHORD Rigid ceiling directly applied.

REACTIONS. (size) 5=Mechanical, 2=0-3-8, 6=Mechanical
Max Horz 2=102(LC 8)
Max Uplift 5=52(LC 12), 2=110(LC 8), 6=6(LC 12)
Max Grav 5=153(LC 1), 2=416(LC 1), 6=97(LC 3)

FORCES. (lb) - Max. Comp./Max. Ten. - All forces 250 (lb) or less except when shown.

NOTES-

- 1) Wind: ASCE 7-16; Vult=115mph (3-second gust) Vasd=91mph; TCDL=6.0psf; BCDL=4.2psf; h=15ft; Cat. II; Exp C; Enclosed; MWFRS (envelope) gable end zone and C-C Exterior(2E) -1-10-8 to 1-1-8, Interior(1) 1-1-8 to 5-10-3 zone; cantilever left and right exposed; end vertical left and right exposed; C-C for members and forces & MWFRS for reactions shown; Lumber DOL=1.60 plate grip DOL=1.60
- 2) This truss has been designed for a 10.0 psf bottom chord live load nonconcurrent with any other live loads.
- 3) Refer to girder(s) for truss to truss connections.
- 4) Provide mechanical connection (by others) of truss to bearing plate capable of withstanding 52 lb uplift at joint 5, 110 lb uplift at joint 2 and 6 lb uplift at joint 6.
- 5) This truss is designed in accordance with the 2018 International Residential Code sections R502.11.1 and R802.10.2 and referenced standard ANSI/TPI 1.
- 6) This truss design requires that a minimum of 7/16" structural wood sheathing be applied directly to the top chord and 1/2" gypsum sheetrock be applied directly to the bottom chord.



June 12, 2023

WARNING - Verify design parameters and READ NOTES ON THIS AND INCLUDED MITEK REFERENCE PAGE MII-7473 rev. 5/19/2020 BEFORE USE.

Design valid for use only with MiTek® connectors. This design is based only upon parameters shown, and is for an individual building component, not a truss system. Before use, the building designer must verify the applicability of design parameters and properly incorporate this design into the overall building design. Bracing indicated is to prevent buckling of individual truss web and/or chord members only. Additional temporary and permanent bracing is always required for stability and to prevent collapse with possible personal injury and property damage. For general guidance regarding the fabrication, storage, delivery, erection and bracing of trusses and truss systems, see **ANSI/TPI1 Quality Criteria, DSB-89 and BCSI Building Component Safety Information** available from Truss Plate Institute, 2670 Crain Highway, Suite 203 Waldorf, MD 20601



16023 Swingley Ridge Rd
Chesterfield, MO 63017

Job	Truss	Truss Type	Qty	Ply	Summit/161 Highland Meadows	AS NOTED FOR PLAN REVIEW DEVELOPMENT SERVICES LEE'S SUMMIT, MISSOURI
3564895	J23	Jack-Open	2	1	Job Reference (optional)	158827543

Builders FirstSource (Valley Center), Valley Center, KS - 67147,

8.630 s Nov 19 2022 MiTek Industries, Inc. Thu Jun 8 7 10 39 2023 Page 1

ID:icBMJaMgT1gasuUyx9?RhvzDEHb-RfC?PsB70Hq3NSqPqnL8v3uITxb6KVrCm7J4ZICP

07/03/2023

-1-10-8
1-10-82-9-8
2-9-83-10-15
1-1-7

Scale = 1:12.9

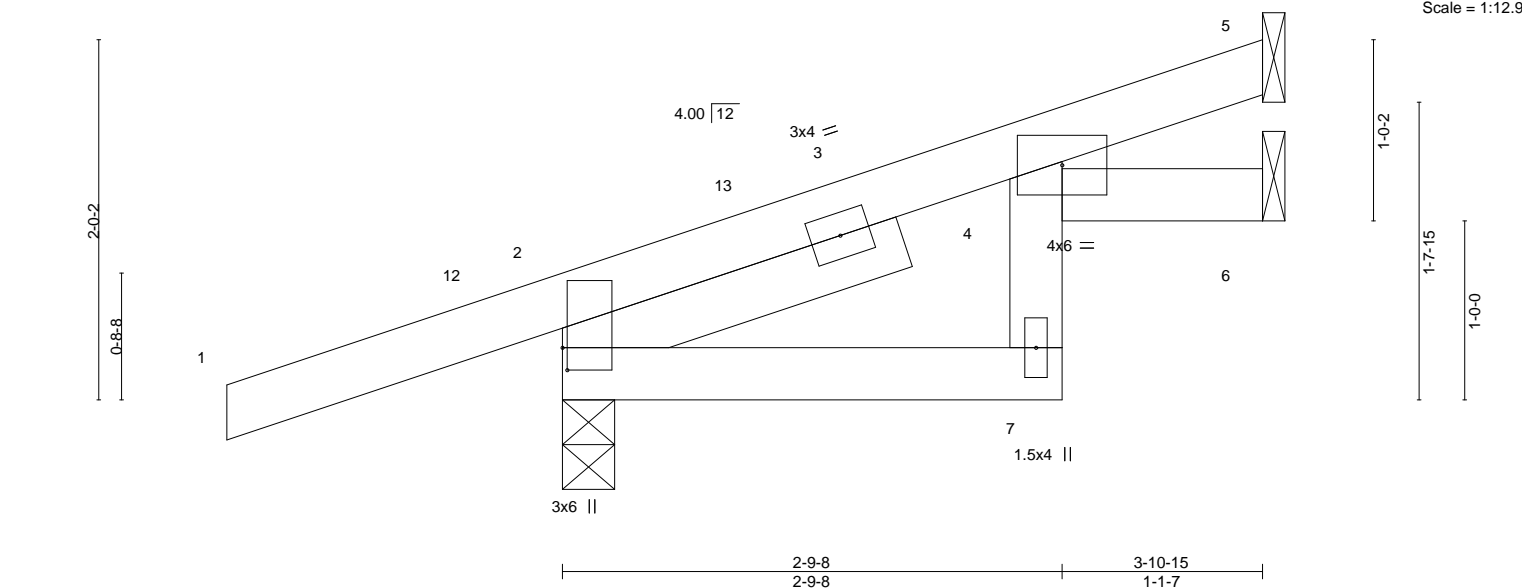


Plate Offsets (X,Y)-- [2:0-1-8,0-0-5]												
LOADING (psf)		SPACING- 2-0-0		CSI.		DEFL. in (loc) l/defl L/d				PLATES GRIP		
TCLL	25.0	Plate Grip DOL	1.15	TC	0.22	Vert(LL)	0.02	7	>999	240	MT20	197/144
TCDL	10.0	Lumber DOL	1.15	BC	0.11	Vert(CT)	-0.02	7	>999	180		
BCLL	0.0	Rep Stress Incr	YES	WB	0.00	Horz(CT)	0.02	6	n/a	n/a		
BCDL	10.0	Code IRC2018/TPI2014		Matrix-MR							Weight: 15 lb	FT = 20%

LUMBER-

TOP CHORD 2x4 SPF No.2
 BOT CHORD 2x4 SPF No.2
 SLIDER Left 2x4 SPF No.2 2-0-0

BRACING-

TOP CHORD Structural wood sheathing directly applied or 3-10-15 oc purlins.
 BOT CHORD Rigid ceiling directly applied or 6-0-0 oc bracing.

REACTIONS.

(size) 5=Mechanical, 2=0-3-8, 6=Mechanical
 Max Horz 2=78(LC 8)
 Max Uplift 5=-26(LC 12), 2=-103(LC 8), 6=-9(LC 12)
 Max Grav 5=82(LC 1), 2=337(LC 1), 6=60(LC 1)

FORCES. (lb) - Max. Comp./Max. Ten. - All forces 250 (lb) or less except when shown.

NOTES-

- 1) Wind: ASCE 7-16; Vult=115mph (3-second gust) Vasd=91mph; TCDL=6.0psf; BCDL=4.2psf; h=15ft; Cat. II; Exp C; Enclosed; MWFRS (envelope) gable end zone and C-C Exterior(2E) -1-10-8 to 1-1-8, Interior(1) 1-1-8 to 3-10-3 zone; cantilever left and right exposed; end vertical left and right exposed; C-C for members and forces & MWFRS for reactions shown; Lumber DOL=1.60 plate grip DOL=1.60
- 2) This truss has been designed for a 10.0 psf bottom chord live load nonconcurrent with any other live loads.
- 3) Refer to girder(s) for truss to truss connections.
- 4) Provide mechanical connection (by others) of truss to bearing plate capable of withstanding 26 lb uplift at joint 5, 103 lb uplift at joint 2 and 9 lb uplift at joint 6.
- 5) This truss is designed in accordance with the 2018 International Residential Code sections R502.11.1 and R802.10.2 and referenced standard ANSI/TPI 1.



June 12, 2023

WARNING - Verify design parameters and READ NOTES ON THIS AND INCLUDED MITEK REFERENCE PAGE MII-7473 rev. 5/19/2020 BEFORE USE.

Design valid for use only with MiTek® connectors. This design is based only upon parameters shown, and is for an individual building component, not a truss system. Before use, the building designer must verify the applicability of design parameters and properly incorporate this design into the overall building design. Bracing indicated is to prevent buckling of individual truss web and/or chord members only. Additional temporary and permanent bracing is always required for stability and to prevent collapse with possible personal injury and property damage. For general guidance regarding the fabrication, storage, delivery, erection and bracing of trusses and truss systems, see

ANSI/TPI1 Quality Criteria, DSB-89 and BCSI Building Component

Safety Information available from Truss Plate Institute, 2670 Crain Highway, Suite 203 Waldorf, MD 20601




16023 Swingley Ridge Rd
 Chesterfield, MO 63017

Builders FirstSource (Valley Center), Valley Center, KS - 67147,

8.630 s Nov 19 2022 MiTek Industries, Inc. Thu Jun 8 14:13:40 2023 Page 1
ID:icBMJaMgT1gasuYyx9?RhvzDEHb-RfC?PsB70Hq3NSqPqnL8v3uITXbGKVrCbi714zJC?f

07/03/2023

 

Weight: 8 lb FT = 20%

TOP CHORD 2x4 SPF No.2
BOT CHORD 2x4 SPF No.2

TOP CHORD	Structural wood sheathing directly applied or 3-0-0 oc purlins.
BOT CHORD	Rigid ceiling directly applied or 10-0-0 oc bracing.

(size) 3=Mechanical, 2=0-3-8, 4=Mechanical
 Max Horz 2=50(LC 8)
 Max Uplift 3=30(LC 12), 2=-54(LC 8)
 Max Grav 3=83(LC 1), 2=203(LC 1), 4=52(LC 3)

FORCES. (lb) - Max. Comp./Max. Ten. - All forces 250 (lb) or less except when shown.

- 1) Wind: ASCE 7-16; Vult=115mph (3-second gust) Vasd=91mph; TCDL=6.0psf; BCDL=4.2psf; h=15ft; Cat. II; Exp C; Enclosed; MWFRS (envelope) gable end zone and C-C Exterior(2E) -0-10-8 to 2-1-8, Interior(1) 2-1-8 to 2-11-4 zone; cantilever left and right exposed ; end vertical left and right exposed;C-C for members and forces & MWFRS for reactions shown; Lumber DOL=1.60 plate grip DOL=1.60
- 2) This truss has been designed for a 10.0 psf bottom chord live load nonconcurrent with any other live loads.
- 3) Refer to girder(s) for truss to truss connections.
- 4) Provide mechanical connection (by others) of truss to bearing plate capable of withstanding 30 lb uplift at joint 3 and 54 lb uplift at joint 2.
- 5) This truss is designed in accordance with the 2018 International Residential Code sections R502.11.1 and R802.10.2 and referenced standard ANSI/TPI 1.



June 12, 2023



Design valid for use only with MiTek® connectors. This design is based only upon parameters shown, and is for an individual building component, not a truss system. Before use, the building designer must verify the applicability of design parameters and properly incorporate this design into the overall building design. Bracing indicated is to prevent buckling of individual truss web and/or chord members only. Additional temporary and permanent bracing is always required for stability and to prevent collapse with possible personal injury and property damage. For general guidance regarding the fabrication, storage, delivery, erection and bracing of trusses and truss systems, see **ANSI/TPI1 Quality Criteria, DSB-89 and BCSI Building Code**.

Safety Information available from Truss Plate Institute, 2670 Crain Highway, Suite 203 Waldorf, MD 20601




16023 Swingley Ridge Rd
Chesterfield, MO 63017

Job	Truss	Truss Type	Qty	Ply	Summit/161 Highland Meadows	RELEASE FOR CONSTRUCTION
3564895	J25	Jack-Open	2	1	Job Reference (optional)	AS NOTED FOR PLAN REVIEW
Builders FirstSource (Valley Center), Valley Center, KS - 67147,						DEVELOPMENT SERVICES
8.630 s Nov 19 2022 MiTek Industries, Inc. Thu Jun 8 7 41 10 2023 Page 1						LEE'S SUMMIT, MISSOURI

ID:icBMJaMgT1gasuUyx9?RhvzDEHb-RfC?PsB70Hq3NSpPqnL8v3uITxb6KVrCm7J4ZICP

07/03/2023

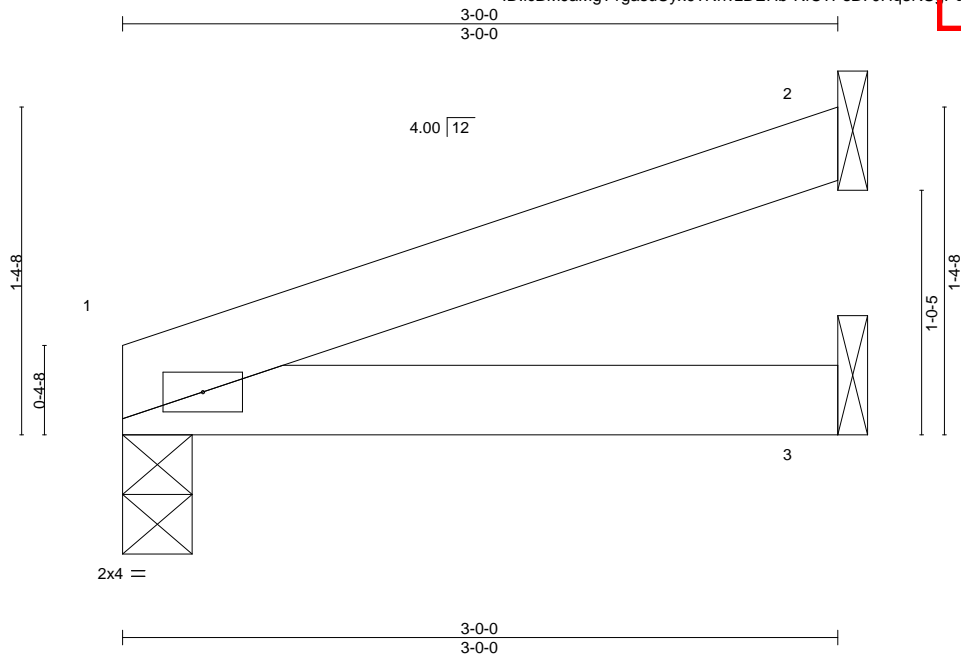

Scale = 1:9.7

LOADING (psf)	SPACING-	2-0-0	CSI.	DEFL.	in (loc)	l/defl	L/d	PLATES	GRIP
TCLL 25.0	Plate Grip DOL	1.15	TC 0.10	Vert(LL)	0.01	3-6	>999	240	MT20
TCDL 10.0	Lumber DOL	1.15	BC 0.10	Vert(CT)	-0.01	3-6	>999	180	197/144
BCLL 0.0	Rep Stress Incr	YES	WB 0.00	Horz(CT)	0.00	1	n/a	n/a	
BCDL 10.0	Code IRC2018/TPI2014		Matrix-MP						
									Weight: 7 lb FT = 20%

LUMBER-

TOP CHORD 2x4 SPF No.2
BOT CHORD 2x4 SPF No.2

BRACING-

TOP CHORD Structural wood sheathing directly applied or 3-0-0 oc purlins.
BOT CHORD Rigid ceiling directly applied or 10-0-0 oc bracing.

REACTIONS.

(size) 1=0-3-8, 2=Mechanical, 3=Mechanical
Max Horz 1=36(LC 8)
Max Uplift 1=-17(LC 8), 2=-31(LC 8)
Max Grav 1=132(LC 1), 2=87(LC 1), 3=53(LC 3)

FORCES. (lb) - Max. Comp./Max. Ten. - All forces 250 (lb) or less except when shown.

NOTES-

- 1) Wind: ASCE 7-16; Vult=115mph (3-second gust) Vasd=91mph; TCDL=6.0psf; BCDL=4.2psf; h=15ft; Cat. II; Exp C; Enclosed; MWFRS (envelope) gable end zone and C-C Exterior(2E) zone; cantilever left and right exposed; end vertical left and right exposed; C-C for members and forces & MWFRS for reactions shown; Lumber DOL=1.60 plate grip DOL=1.60
- 2) This truss has been designed for a 10.0 psf bottom chord live load nonconcurrent with any other live loads.
- 3) Refer to girder(s) for truss to truss connections.
- 4) Provide mechanical connection (by others) of truss to bearing plate capable of withstanding 17 lb uplift at joint 1 and 31 lb uplift at joint 2.
- 5) This truss is designed in accordance with the 2018 International Residential Code sections R502.11.1 and R802.10.2 and referenced standard ANSI/TPI 1.



June 12, 2023

WARNING - Verify design parameters and READ NOTES ON THIS AND INCLUDED MITEK REFERENCE PAGE MII-7473 rev. 5/19/2020 BEFORE USE.

Design valid for use only with MiTek® connectors. This design is based only upon parameters shown, and is for an individual building component, not a truss system. Before use, the building designer must verify the applicability of design parameters and properly incorporate this design into the overall building design. Bracing indicated is to prevent buckling of individual truss web and/or chord members only. Additional temporary and permanent bracing is always required for stability and to prevent collapse with possible personal injury and property damage. For general guidance regarding the fabrication, storage, delivery, erection and bracing of trusses and truss systems, see

ANSI/TPI1 Quality Criteria, DSB-89 and BCSI Building Component

Safety Information available from Truss Plate Institute, 2670 Crain Highway, Suite 203 Waldorf, MD 20601




16023 Swingley Ridge Rd
Chesterfield, MO 63017

8.630 s Nov 19 2022 MiTek Industries, Inc. Thu Jun 8 14:13:41 2023 Page 1

8.630 s Nov 19 2022 MiTek Industries, Inc. Thu Jan 04 13:41 2023 Page 1

ID:icBMJaMgT1gasuUyx9?RhvzDEHb-RfC?PsB70Hq3NSqPqnL8v3UitXbGKWrcldo7J4zJC2f
4-9-0
4-9-0

 


Weight: 16 lb FT = 20%

BRACING-	
TOP CHORD	Structural wood sheathing directly applied.
BOT CHORD	Rigid ceiling directly applied.

(size) 4=Mechanical, 2=0-3-8, 5=Mechanical
 Max Horz 2=88(LC 8)
 Max Uplift 4=52(LC 12), 2=-106(LC 8)
 Max Grav 4=132(LC 1), 2=368(LC 1), 5=80(LC 3)

FORCES. (lb) - Max. Comp./Max. Ten. - All forces 250 (lb) or less except when shown.


- 1) Wind: ASCE 7-16; Vult=115mph (3-second gust) Vasd=91mph; TCdL=6.0psf; BCDL=4.2psf; h=15ft; Cat. II; Exp C; Enclosed; MWFRS (envelope) gable end zone and C-C Exterior(2E) -1-10-8 to 1-1-8, Interior(1) 1-1-8 to 4-8-4 zone; cantilever left and right exposed ; end vertical left and right exposed; C-C for members and forces & MWFRS for reactions shown; Lumber DOL=1.60 plate grip DOL=1.60
- 2) This truss has been designed for a 10.0 psf bottom chord live load nonconcurrent with any other live loads.
- 3) Refer to girder(s) for truss to truss connections.
- 4) Provide mechanical connection (by others) of truss to bearing plate capable of withstanding 52 lb uplift at joint 4 and 106 lb uplift at joint 2.
- 5) This truss is designed in accordance with the 2018 International Residential Code sections R502.11.1 and R802.10.2 and referenced standard ANSI/TPI 1.
- 6) This truss design requires that a minimum of 7/16" structural wood sheathing be applied directly to the top chord and 1/2" gypsum sheetrock be applied directly to the bottom chord.

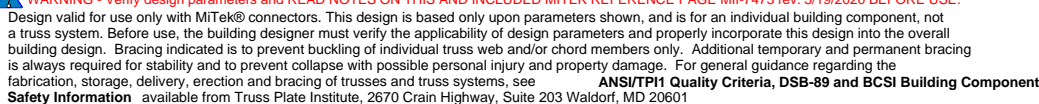

Job	Truss	Truss Type	Qty	Ply	Summit/161 Highland Meadows	RELEASE FOR CONSTRUCTION
3564895	J27	Jack-Open	4	1	Job Reference (optional)	AS NOTED FOR PLAN REVIEW
Builders FirstSource (Valley Center), Valley Center, KS - 67147,						DEVELOPMENT SERVICES
8.630 s Nov 19 2022 MiTek Industries, Inc. Thu Jun 8 7:41:12 2023 Page 1						LEE'S SUMMIT, MISSOURI

ID:icBMJaMgT1gasuUyx9?RhvhZDEHb-RfC?PsB70Hq3NSpPqnL8v3uITxb6KVrCm7J4ZICP

07/03/2023

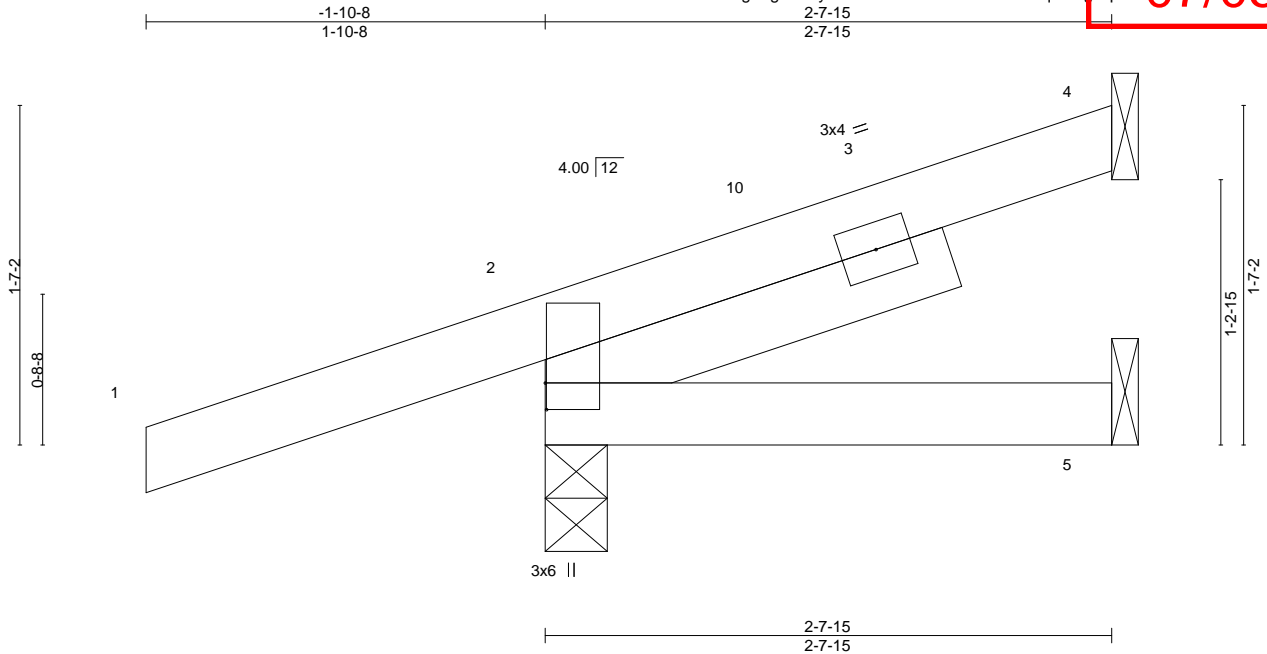

Scale = 1:10.8

Plate Offsets (X,Y)--		[2:0-1-8,0-0-1]									
LOADING (psf)		SPACING- 2-0-0		CSI.		DEFL. in (loc) l/defl L/d		PLATES GRIP			
TCLL	25.0	Plate Grip DOL	1.15	TC	0.24	Vert(LL)	-0.00 8	>999	240	MT20	197/144
TCDL	10.0	Lumber DOL	1.15	BC	0.03	Vert(CT)	-0.00 5-8	>999	180		
BCLL	0.0	Rep Stress Incr	YES	WB	0.00	Horz(CT)	0.00 2	n/a	n/a		
BCDL	10.0	Code IRC2018/TPI2014		Matrix-MP						Weight: 11 lb	FT = 20%

LUMBER-

TOP CHORD 2x4 SPF No.2
BOT CHORD 2x4 SPF No.2
SLIDER Left 2x4 SPF No.2 2-0-0

BRACING-

TOP CHORD Structural wood sheathing directly applied or 2-7-15 oc purlins.
BOT CHORD Rigid ceiling directly applied or 10-0-0 oc bracing.

REACTIONS.

(size) 4=Mechanical, 2=0-3-8, 5=Mechanical
Max Horz 2=62(LC 8)
Max Uplift 4=24(LC 12), 2=104(LC 8)
Max Grav 4=52(LC 1), 2=296(LC 1), 5=38(LC 3)

FORCES. (lb) - Max. Comp./Max. Ten. - All forces 250 (lb) or less except when shown.

NOTES-

- 1) Wind: ASCE 7-16; Vult=115mph (3-second gust) Vasd=91mph; TCDL=6.0psf; BCDL=4.2psf; h=15ft; Cat. II; Exp C; Enclosed; MWFRS (envelope) gable end zone and C-C Exterior(2E) -1-10-8 to 1-1-8, Interior(1) 1-1-8 to 2-7-3 zone; cantilever left and right exposed; end vertical left and right exposed; C-C for members and forces & MWFRS for reactions shown; Lumber DOL=1.60 plate grip DOL=1.60
- 2) This truss has been designed for a 10.0 psf bottom chord live load nonconcurrent with any other live loads.
- 3) Refer to girder(s) for truss to truss connections.
- 4) Provide mechanical connection (by others) of truss to bearing plate capable of withstanding 24 lb uplift at joint 4 and 104 lb uplift at joint 2.
- 5) This truss is designed in accordance with the 2018 International Residential Code sections R502.11.1 and R802.10.2 and referenced standard ANSI/TPI 1.



June 12, 2023

WARNING - Verify design parameters and READ NOTES ON THIS AND INCLUDED MITEK REFERENCE PAGE MII-7473 rev. 5/19/2020 BEFORE USE.

Design valid for use only with MiTek® connectors. This design is based only upon parameters shown, and is for an individual building component, not a truss system. Before use, the building designer must verify the applicability of design parameters and properly incorporate this design into the overall building design. Bracing indicated is to prevent buckling of individual truss web and/or chord members only. Additional temporary and permanent bracing is always required for stability and to prevent collapse with possible personal injury and property damage. For general guidance regarding the fabrication, storage, delivery, erection and bracing of trusses and truss systems, see

ANSI/TPI1 Quality Criteria, DSB-89 and BCSI Building Component

Safety Information available from Truss Plate Institute, 2670 Crain Highway, Suite 203 Waldorf, MD 20601




16023 Swingley Ridge Rd
Chesterfield, MO 63017

Builders FirstSource (Valley Center), Valley Center, KS - 67147,

8.630 s Nov 19 2022 MiTek Industries, Inc. Thu Jan 07 13:47:2023 Page 1
ID:icBMJaMgT1gasuYyx9?RhvzDEHb-RfC?PsB70Hq3NSqPqnL8v3uTxbGKvRrCp7fJ4zUC?f

07/03/2023

 

Weight: 8 lb FT = 20%

TOP CHORD	Structural wood sheathing directly applied or 1-10-4 oc purlins, except end verticals.
BOT CHORD	Rigid ceiling directly applied or 10-0-0 oc bracing.

(size) 7=0-3-8, 5=0-1-8
 Max Horz 7=41(LC 11)
 Max Uplift 7=-115(LC 8), 5=-21(LC 1)
 Max Grav 7=301(LC 1), 5=27(LC 3)

TOP CHORD $2-7=-273/197$

- 1) Wind: ASCE 7-16; Vult=115mph (3-second gust) Vasd=91mph; TC DL=6.0psf; BCDL=4.2psf; h=15ft; Cat. II; Exp C; Enclosed; MWFRS (envelope) gable end zone and C-C Exterior(2E) -1-10-8 to 1-1-8, Interior(1) 1-1-8 to 1-10-4 zone; cantilever left and right exposed ; end vertical left and right exposed;C-C for members and forces & MWFRS for reactions shown; Lumber DOL=1.60 plate grip DOL=1.60
- 2) This truss has been designed for a 10.0 psf bottom chord live load nonconcurrent with any other live loads.
- 3) Provide mechanical connection (by others) of truss to bearing plate at joint(s) 5.
- 4) Provide mechanical connection (by others) of truss to bearing plate capable of withstanding 115 lb uplift at joint 7 and 21 lb uplift at joint 5.
- 5) This truss is designed in accordance with the 2018 International Residential Code sections R502.11.1 and R802.10.2 and referenced standard ANSI/TPI 1.



June 12, 2023



WARNING – verify design parameters and READ NOTES ON THIS AND INCLUDED MITER REFERENCE PAGE MH-743.3 REV. 3/19/2020 BEFORE USE.

Design valid for use only with MiTEK® connectors. This design is based only upon parameters shown, and is for an individual building component, not a truss system. Before use, the building designer must verify the applicability of design parameters and properly incorporate this design into the overall building design. Bracing indicated is to prevent buckling of individual truss web and/or chord members only. Additional temporary and permanent bracing is always required for stability and to prevent collapse with possible personal injury and property damage. For general guidance regarding the fabrication, storage, delivery, erection and bracing of trusses and truss systems, see **ANSI/TPI1 Quality Criteria, DSB-89 and BCSI Building Code**

Safety Information available from Truss Plate Institute, 2670 Crain Highway, Suite 203 Waldorf, MD 20601



16023 Swingley Ridge Rd
Chesterfield, MO 63017

Job	Truss	Truss Type	Qty	Ply	Summit/161 Highland Meadows	AS NOTED FOR PLAN REVIEW DEVELOPMENT SERVICES LEE'S SUMMIT, MISSOURI
3564895	J29	Jack-Open	4	1	Job Reference (optional)	158827549


Builders FirstSource (Valley Center),

Valley Center, KS - 67147,

8.630 s Nov 19 2022 MiTek Industries, Inc. Thu Jun 07 10:44 2023 Page 1

ID:icBMJaMgT1gasuUyx9?RhvzDEHb-RfC?PsB70Hq3NSpPqnL8v3lITxb6KVrCm7J4ZICP

07/03/2023

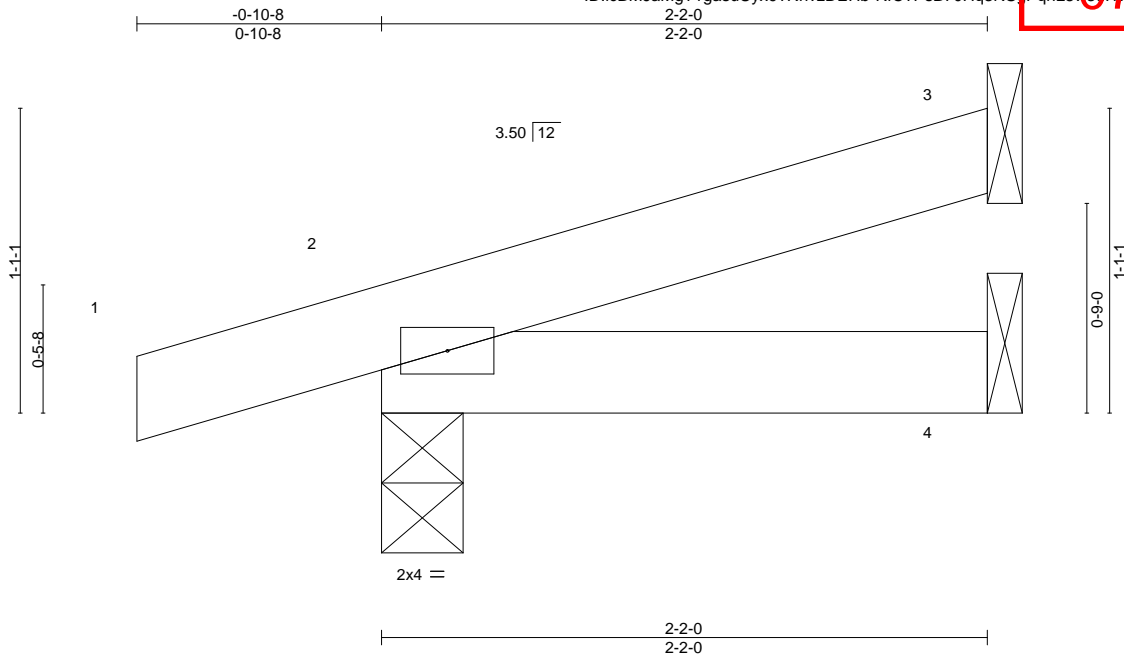

LOADING (psf)	SPACING-	2-0-0	CSI.	DEFL.	in	(loc)	l/defl	L/d	PLATES	GRIP
TCLL 25.0	Plate Grip DOL	1.15	TC 0.05	Vert(LL)	-0.00	7	>999	240	MT20	197/144
TCDL 10.0	Lumber DOL	1.15	BC 0.03	Vert(CT)	-0.00	7	>999	180		
BCLL 0.0	Rep Stress Incr	YES	WB 0.00	Horz(CT)	0.00	3	n/a	n/a		
BCDL 10.0	Code IRC2018/TPI2014		Matrix-MP						Weight: 6 lb	FT = 20%

LUMBER-

TOP CHORD 2x4 SPF No.2
BOT CHORD 2x4 SPF No.2

BRACING-

TOP CHORD Structural wood sheathing directly applied or 2-2-0 oc purlins.
BOT CHORD Rigid ceiling directly applied or 10-0-0 oc bracing.

REACTIONS.

(size) 3=Mechanical, 2=0-3-8, 4=Mechanical
Max Horz 2=35(LC 8)
Max Uplift 3=-21(LC 12), 2=-51(LC 8)
Max Grav 3=57(LC 1), 2=169(LC 1), 4=36(LC 3)

FORCES. (lb) - Max. Comp./Max. Ten. - All forces 250 (lb) or less except when shown.

NOTES-

- 1) Wind: ASCE 7-16; Vult=115mph (3-second gust) Vasd=91mph; TCDL=6.0psf; BCDL=4.2psf; h=15ft; Cat. II; Exp C; Enclosed; MWFRS (envelope) gable end zone and C-C Exterior(2E) zone; cantilever left and right exposed; end vertical left and right exposed; C-C for members and forces & MWFRS for reactions shown; Lumber DOL=1.60 plate grip DOL=1.60
- 2) This truss has been designed for a 10.0 psf bottom chord live load nonconcurrent with any other live loads.
- 3) Refer to girder(s) for truss to truss connections.
- 4) Provide mechanical connection (by others) of truss to bearing plate capable of withstanding 21 lb uplift at joint 3 and 51 lb uplift at joint 2.
- 5) This truss is designed in accordance with the 2018 International Residential Code sections R502.11.1 and R802.10.2 and referenced standard ANSI/TPI 1.



June 12, 2023

WARNING - Verify design parameters and READ NOTES ON THIS AND INCLUDED MITEK REFERENCE PAGE MII-7473 rev. 5/19/2020 BEFORE USE.

Design valid for use only with MiTek® connectors. This design is based only upon parameters shown, and is for an individual building component, not a truss system. Before use, the building designer must verify the applicability of design parameters and properly incorporate this design into the overall building design. Bracing indicated is to prevent buckling of individual truss web and/or chord members only. Additional temporary and permanent bracing is always required for stability and to prevent collapse with possible personal injury and property damage. For general guidance regarding the fabrication, storage, delivery, erection and bracing of trusses and truss systems, see

ANSI/TPI1 Quality Criteria, DSB-89 and BCSI Building Component


Safety Information available from Truss Plate Institute, 2670 Crain Highway, Suite 203 Waldorf, MD 20601



16023 Swingley Ridge Rd
Chesterfield, MO 63017

Job	Truss	Truss Type	Qty	Ply	Summit/161 Highland Meadows	RELEASE FOR CONSTRUCTION
3564895	L1	Monopitch	6	1	Job Reference (optional)	AS NOTED FOR PLAN REVIEW
Builders FirstSource (Valley Center), Valley Center, KS - 67147,						DEVELOPMENT SERVICES
8.630 s Nov 19 2022 MiTek Industries, Inc. Thu Jun 07 10:52:2023 Page 1						LEE'S SUMMIT, MISSOURI

ID:icBMJaMgT1gasuUyx9?RhvzDEHb-RfC?PsB70Hq3NSpPqnL8v3uITxb6KVrCm7J4ZIC? 07/03/2023

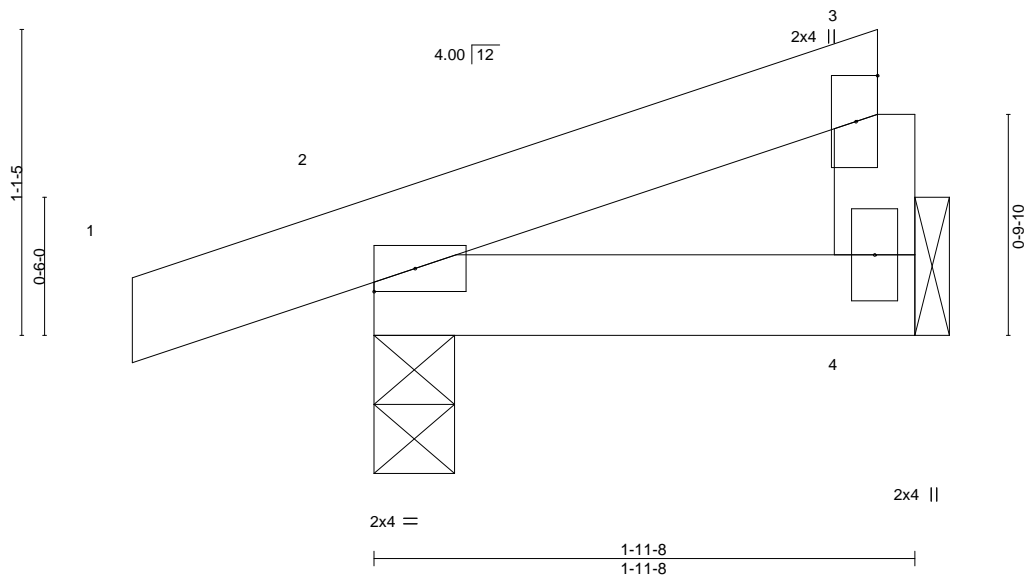

LOADING (psf)	SPACING-	2-0-0	CSI.	DEFL.	in (loc)	I/defl	L/d	PLATES	GRIP
TCLL 25.0	Plate Grip DOL	1.15	TC 0.05	Vert(LL)	-0.00	7	>999	MT20	197/144
TCDL 10.0	Lumber DOL	1.15	BC 0.02	Vert(CT)	-0.00	7	>999		
BCLL 0.0	Rep Stress Incr	YES	WB 0.00	Horz(CT)	0.00	2	n/a		
BCDL 10.0	Code IRC2018/TPI2014		Matrix-MP					Weight: 6 lb	FT = 20%

LUMBER-

TOP CHORD 2x4 SPF No.2
BOT CHORD 2x4 SPF No.2
WEBS 2x4 SPF No.2

BRACING-

TOP CHORD Structural wood sheathing directly applied or 1-11-8 oc purlins, except end verticals.
BOT CHORD Rigid ceiling directly applied or 10-0-0 oc bracing.

REACTIONS.

(size) 4=Mechanical, 2=0-3-8
Max Horz 2=35(LC 11)
Max Uplift 4=14(LC 12), 2=-52(LC 8)
Max Grav 4=67(LC 1), 2=158(LC 1)

FORCES. (lb) - Max. Comp./Max. Ten. - All forces 250 (lb) or less except when shown.

NOTES-

- 1) Wind: ASCE 7-16; Vult=115mph (3-second gust) Vasd=91mph; TCDL=6.0psf; BCDL=4.2psf; h=15ft; Cat. II; Exp C; Enclosed; MWFRS (envelope) gable end zone and C-C Exterior(2E) zone; cantilever left and right exposed; end vertical left and right exposed; C-C for members and forces & MWFRS for reactions shown; Lumber DOL=1.60 plate grip DOL=1.60
- 2) This truss has been designed for a 10.0 psf bottom chord live load nonconcurrent with any other live loads.
- 3) Refer to girder(s) for truss to truss connections.
- 4) Provide mechanical connection (by others) of truss to bearing plate capable of withstanding 14 lb uplift at joint 4 and 52 lb uplift at joint 2.
- 5) This truss is designed in accordance with the 2018 International Residential Code sections R502.11.1 and R802.10.2 and referenced standard ANSI/TPI 1.



June 12, 2023

WARNING - Verify design parameters and READ NOTES ON THIS AND INCLUDED MITEK REFERENCE PAGE MII-7473 rev. 5/19/2020 BEFORE USE.

Design valid for use only with MiTek® connectors. This design is based only upon parameters shown, and is for an individual building component, not a truss system. Before use, the building designer must verify the applicability of design parameters and properly incorporate this design into the overall building design. Bracing indicated is to prevent buckling of individual truss web and/or chord members only. Additional temporary and permanent bracing is always required for stability and to prevent collapse with possible personal injury and property damage. For general guidance regarding the fabrication, storage, delivery, erection and bracing of trusses and truss systems, see **ANSI/TPI1 Quality Criteria, DSB-89 and BCSI Building Component Safety Information** available from Truss Plate Institute, 2670 Crain Highway, Suite 203 Waldorf, MD 20601



16023 Swingley Ridge Rd
Chesterfield, MO 63017

Job	Truss	Truss Type	Qty	Ply	Summit/161 Highland Meadows	RELEASE FOR CONSTRUCTION
3564895	LG1	GABLE	1	1	Job Reference (optional)	AS NOTED FOR PLAN REVIEW
						DEVELOPMENT SERVICES
						LEE'S SUMMIT, MISSOURI


Builders FirstSource (Valley Center),

Valley Center, KS - 67147,

8.630 s Nov 19 2022 MiTek Industries, Inc. Thu Jun 8 7 41 10 PM 2023 Page 1


ID:icBMJaMgT1gasuUyx9?RhvzDEHb-RfC?PsB70Hq3NSqPqnL8v3uITxb6KVrCm7J4ZICP

07/03/2023

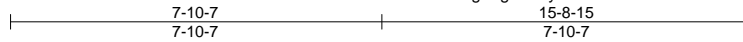

4x5 =

Scale = 1:48.8

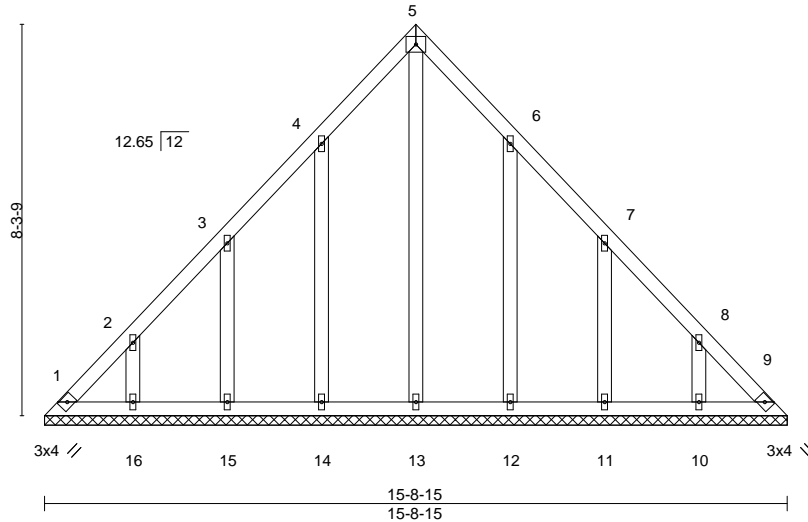

LOADING (psf)	SPACING-	2-0-0	CSI.	DEFL.	in (loc)	l/defl	L/d	PLATES	GRIP
TCLL 25.0	Plate Grip DOL	1.15	TC 0.06	Vert(LL)	n/a	-	n/a	MT20	197/144
TCDL 10.0	Lumber DOL	1.15	BC 0.03	Vert(CT)	n/a	-	n/a		
BCLL 0.0	Rep Stress Incr	YES	WB 0.16	Horz(CT)	0.00	9	n/a		
BCDL 10.0	Code IRC2018/TPI2014		Matrix-S					Weight: 76 lb	FT = 20%

LUMBER-

TOP CHORD 2x4 SPF No.2
BOT CHORD 2x4 SPF No.2
OTHERS 2x4 SPF No.2

BRACING-

TOP CHORD Structural wood sheathing directly applied or 6-0-0 oc purlins.
BOT CHORD Rigid ceiling directly applied or 10-0-0 oc bracing.

REACTIONS.

All bearings 15-8-15.
(lb) - Max Horz 1=-189(LC 10)
Max Uplift All uplift 100 lb or less at joint(s) 1, 9 except 14=-116(LC 12), 15=-116(LC 12), 16=-111(LC 12), 12=-115(LC 13), 11=-117(LC 13), 10=-111(LC 13)
Max Grav All reactions 250 lb or less at joint(s) 1, 9, 13, 14, 15, 16, 12, 11, 10

FORCES.

(lb) - Max. Comp./Max. Ten. - All forces 250 (lb) or less except when shown.
TOP CHORD 1-2=-251/161

NOTES-

- 1) Unbalanced roof live loads have been considered for this design.
- 2) Wind: ASCE 7-16; Vult=115mph (3-second gust) Vasd=91mph; TCDL=6.0psf; BCDL=4.2psf; h=15ft; Cat. II; Exp C; Enclosed; MWFRS (envelope) gable end zone and C-C Exterior(2E) 0-4-1 to 3-4-1, Interior(1) 3-4-1 to 7-10-7, Exterior(2R) 7-10-7 to 10-10-7, Interior(1) 10-10-7 to 15-4-14 zone; cantilever left and right exposed ; end vertical left and right exposed;C-C for members and forces & MWFRS for reactions shown; Lumber DOL=1.60 plate grip DOL=1.60
- 3) All plates are 1.5x4 MT20 unless otherwise indicated.
- 4) Gable requires continuous bottom chord bearing.
- 5) This truss has been designed for a 10.0 psf bottom chord live load nonconcurrent with any other live loads.
- 6) Provide mechanical connection (by others) of truss to bearing plate capable of withstanding 100 lb uplift at joint(s) 1, 9 except (jt=lb) 14=116, 15=116, 16=111, 12=115, 11=117, 10=111.
- 7) This truss is designed in accordance with the 2018 International Residential Code sections R502.11.1 and R802.10.2 and referenced standard ANSI/TPI 1.



June 12, 2023

WARNING - Verify design parameters and READ NOTES ON THIS AND INCLUDED MITEK REFERENCE PAGE MII-7473 rev. 5/19/2020 BEFORE USE.

Design valid for use only with MiTek® connectors. This design is based only upon parameters shown, and is for an individual building component, not a truss system. Before use, the building designer must verify the applicability of design parameters and properly incorporate this design into the overall building design. Bracing indicated is to prevent buckling of individual truss web and/or chord members only. Additional temporary and permanent bracing is always required for stability and to prevent collapse with possible personal injury and property damage. For general guidance regarding the fabrication, storage, delivery, erection and bracing of trusses and truss systems, see

ANSI/TPI1 Quality Criteria, DSB-89 and BCSI Building Component

Safety Information available from Truss Plate Institute, 2670 Crain Highway, Suite 203 Waldorf, MD 20601



16023 Swingley Ridge Rd
Chesterfield, MO 63017

Job	Truss	Truss Type	Qty	Ply	Summit/161 Highland Meadows	RELEASE FOR CONSTRUCTION
3564895	LG2	GABLE	1	1		AS NOTED FOR PLAN REVIEW
					Job Reference (optional)	DEVELOPMENT SERVICES
						LEE'S SUMMIT, MISSOURI


Builders FirstSource (Valley Center),

Valley Center, KS - 67147,

8.630 s Nov 19 2022 MiTek Industries, Inc. Thu Jun 8 7 41 18 PM 2023 Page 1

ID:icBMJaMgT1gasuUyx9?RhvzDEHb-RfC?PsB70Hq3NSqPqnL8v3uITxb6KVrCm7J4ZICP

07/03/2023

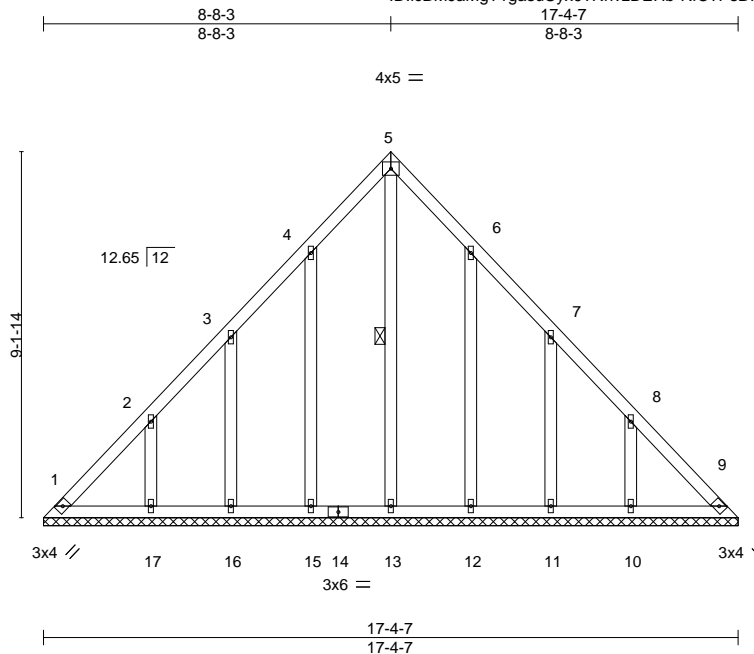

Scale = 1:57.6

LOADING (psf)	SPACING-	2-0-0	CSI.	DEFL.	in (loc)	l/defl	L/d	PLATES	GRIP
TCLL 25.0	Plate Grip DOL	1.15	TC 0.08	Vert(LL)	n/a	-	n/a	MT20	197/144
TCDL 10.0	Lumber DOL	1.15	BC 0.05	Vert(CT)	n/a	-	n/a		
BCLL 0.0	Rep Stress Incr	YES	WB 0.13	Horz(CT)	0.01	9	n/a		
BCDL 10.0	Code IRC2018/TPI2014		Matrix-S					Weight: 87 lb	FT = 20%

LUMBER-

TOP CHORD 2x4 SPF No.2
BOT CHORD 2x4 SPF No.2
OTHERS 2x4 SPF No.2

BRACING-

TOP CHORD Structural wood sheathing directly applied or 6-0-0 oc purlins.
BOT CHORD Rigid ceiling directly applied or 10-0-0 oc bracing.
WEBS 1 Row at midpt 5-13

REACTIONS.

All bearings 17-4-7.
(lb) - Max Horz 1=-209(LC 8)
Max Uplift All uplift 100 lb or less at joint(s) 1, 9 except 15=-117(LC 12), 16=-107(LC 12), 17=-143(LC 12), 12=-115(LC 13), 11=-108(LC 13), 10=-143(LC 13)
Max Grav All reactions 250 lb or less at joint(s) 1, 9, 13, 15, 16, 12, 11, 10 except 17=250(LC 19)

FORCES.

(lb) - Max. Comp./Max. Ten. - All forces 250 (lb) or less except when shown.
TOP CHORD 1-2=-264/176

NOTES-

- Unbalanced roof live loads have been considered for this design.
- Wind: ASCE 7-16; Vult=115mph (3-second gust) Vasd=91mph; TCDL=6.0psf; BCDL=4.2psf; h=15ft; Cat. II; Exp C; Enclosed; MWFRS (envelope) gable end zone and C-C Exterior(2E) 0-4-1 to 3-4-1, Interior(1) 3-4-1 to 8-8-3, Exterior(2R) 8-8-3 to 11-8-3, Interior(1) 11-8-3 to 17-0-6 zone; cantilever left and right exposed; end vertical left and right exposed; C-C for members and forces & MWFRS for reactions shown; Lumber DOL=1.60 plate grip DOL=1.60
- All plates are 1.5x4 MT20 unless otherwise indicated.
- Gable requires continuous bottom chord bearing.
- This truss has been designed for a 10.0 psf bottom chord live load nonconcurrent with any other live loads.
- Provide mechanical connection (by others) of truss to bearing plate capable of withstanding 100 lb uplift at joint(s) 1, 9 except (jt=lb) 15=117, 16=107, 17=143, 12=115, 11=108, 10=143.
- This truss is designed in accordance with the 2018 International Residential Code sections R502.11.1 and R802.10.2 and referenced standard ANSI/TPI 1.



June 12, 2023

WARNING - Verify design parameters and READ NOTES ON THIS AND INCLUDED MITEK REFERENCE PAGE MII-7473 rev. 5/19/2020 BEFORE USE.

Design valid for use only with MiTek® connectors. This design is based only upon parameters shown, and is for an individual building component, not a truss system. Before use, the building designer must verify the applicability of design parameters and properly incorporate this design into the overall building design. Bracing indicated is to prevent buckling of individual truss web and/or chord members only. Additional temporary and permanent bracing is always required for stability and to prevent collapse with possible personal injury and property damage. For general guidance regarding the fabrication, storage, delivery, erection and bracing of trusses and truss systems, see

ANSI/TPI1 Quality Criteria, DSB-89 and BCSI Building Component

Safety Information available from Truss Plate Institute, 2670 Crain Highway, Suite 203 Waldorf, MD 20601



16023 Swingley Ridge Rd
Chesterfield, MO 63017

Job	Truss	Truss Type	Qty	Ply	Summit/161 Highland Meadows	RELEASE FOR CONSTRUCTION
3564895	LG3	GABLE	2	1		AS NOTED FOR PLAN REVIEW
					Job Reference (optional)	DEVELOPMENT SERVICES
						LEE'S SUMMIT, MISSOURI

Builders FirstSource (Valley Center), Valley Center, KS - 67147,

8.630 s Nov 19 2022 MiTek Industries, Inc. Thu Jun 8 7:41:55 2023 Page 1

ID:icBMJaMgT1gasuUyx9?RhvzDEHb-RfC?PsB70Hq3NSqPqnL8v3uITxb6SVrC0g17J4ZICP

07/06/2023

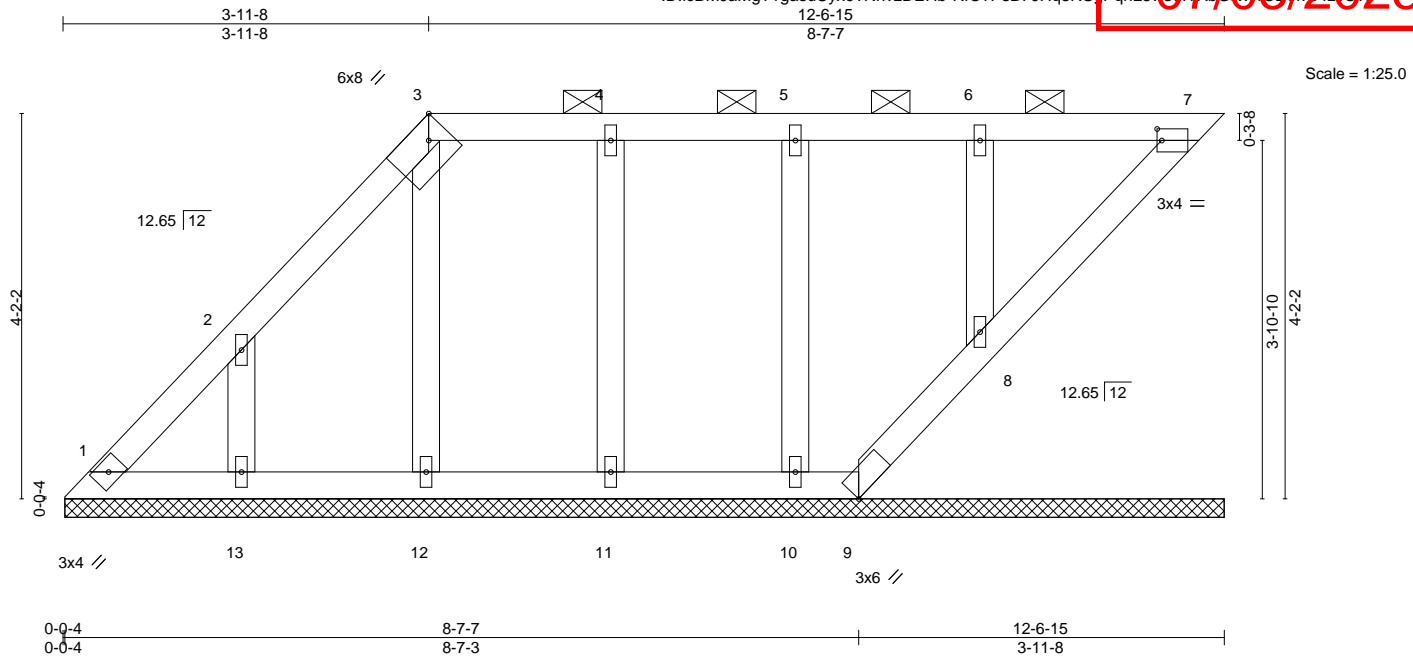


Plate Offsets (X,Y)-- [3:0-2-9,Edge], [7:0-0-10,0-1-8]		CSI.		DEFL.		PLATES		GRIP	
LOADING (psf)	SPACING-	2-0-0	TC	0.07	in (loc)	l/defl	L/d	MT20	197/144
TCLL 25.0	Plate Grip DOL	1.15	BC	0.04	n/a	-	n/a		
TCDL 10.0	Lumber DOL	1.15	WB	0.04	n/a	-	n/a		
BCLL 0.0	Rep Stress Incr	YES	Matrix-S		-0.00	7	n/a		
BCDL 10.0	Code IRC2018/TPI2014							Weight: 48 lb	FT = 20%

LUMBER-

TOP CHORD 2x4 SPF No.2
BOT CHORD 2x4 SPF No.2
OTHERS 2x4 SPF No.2

BRACING-

TOP CHORD Structural wood sheathing directly applied or 6-0-0 oc purlins, except 2-0-0 oc purlins (6-0-0 max.): 3-7.
BOT CHORD Rigid ceiling directly applied or 10-0-0 oc bracing.

REACTIONS.

All bearings 12-6-11.
(lb) - Max Horz 1=143(LC 12)
Max Uplift All uplift 100 lb or less at joint(s) 1, 7, 9, 12, 11, 10, 8 except 13=-126(LC 12)
Max Grav All reactions 250 lb or less at joint(s) 1, 7, 9, 13, 12, 11, 10, 8

FORCES. (lb) - Max. Comp./Max. Ten. - All forces 250 (lb) or less except when shown.

NOTES-

- Unbalanced roof live loads have been considered for this design.
- Wind: ASCE 7-16; Vult=115mph (3-second gust) Vasd=91mph; TCDL=6.0psf; BCDL=4.2psf; h=15ft; Cat. II; Exp C; Enclosed; MWFRS (envelope) gable end zone and C-C Exterior(2E) 0-4-1 to 3-4-1, Interior(1) 3-4-1 to 3-11-8, Exterior(2R) 3-11-8 to 6-11-8, Interior(1) 6-11-8 to 12-3-10 zone; cantilever left and right exposed; end vertical left and right exposed; C-C for members and forces & MWFRS for reactions shown; Lumber DOL=1.60 plate grip DOL=1.60
- Provide adequate drainage to prevent water ponding.
- All plates are 1.5x4 MT20 unless otherwise indicated.
- Gable requires continuous bottom chord bearing.
- This truss has been designed for a 10.0 psf bottom chord live load nonconcurrent with any other live loads.
- Provide mechanical connection (by others) of truss to bearing plate capable of withstanding 100 lb uplift at joint(s) 1, 7, 9, 12, 11, 10, 8 except (jt=lb) 13=126.
- Beveled plate or shim required to provide full bearing surface with truss chord at joint(s) 7, 8.
- This truss is designed in accordance with the 2018 International Residential Code sections R502.11.1 and R802.10.2 and referenced standard ANSI/TPI 1.
- Graphical purlin representation does not depict the size or the orientation of the purlin along the top and/or bottom chord.



June 12, 2023

WARNING - Verify design parameters and READ NOTES ON THIS AND INCLUDED MITEK REFERENCE PAGE MII-7473 rev. 5/19/2020 BEFORE USE.

Design valid for use only with MiTek® connectors. This design is based only upon parameters shown, and is for an individual building component, not a truss system. Before use, the building designer must verify the applicability of design parameters and properly incorporate this design into the overall building design. Bracing indicated is to prevent buckling of individual truss web and/or chord members only. Additional temporary and permanent bracing is always required for stability and to prevent collapse with possible personal injury and property damage. For general guidance regarding the fabrication, storage, delivery, erection and bracing of trusses and truss systems, see

Safety Information available from Truss Plate Institute, 2670 Crain Highway, Suite 203 Waldorf, MD 20601



16023 Swingley Ridge Rd
Chesterfield, MO 63017

Job	Truss	Truss Type	Qty	Ply	Summit/161 Highland Meadows	RELEASE FOR CONSTRUCTION
3564895	P1	Roof Special	1	1	Job Reference (optional)	AS NOTED FOR PLAN REVIEW
Builders FirstSource (Valley Center), Valley Center, KS - 67147,						DEVELOPMENT SERVICES
8.630 s Nov 19 2022 MiTek Industries, Inc. Thu Jun 9 10:57:30 2023 Page 1						LEE'S SUMMIT, MISSOURI
ID:icBMJaMgT1gasuUyx9?RhvzDEHb-RfC?PsB70Hq3NSuPqnL8v3uITxb6KVrCg17J4zJICP						58827554

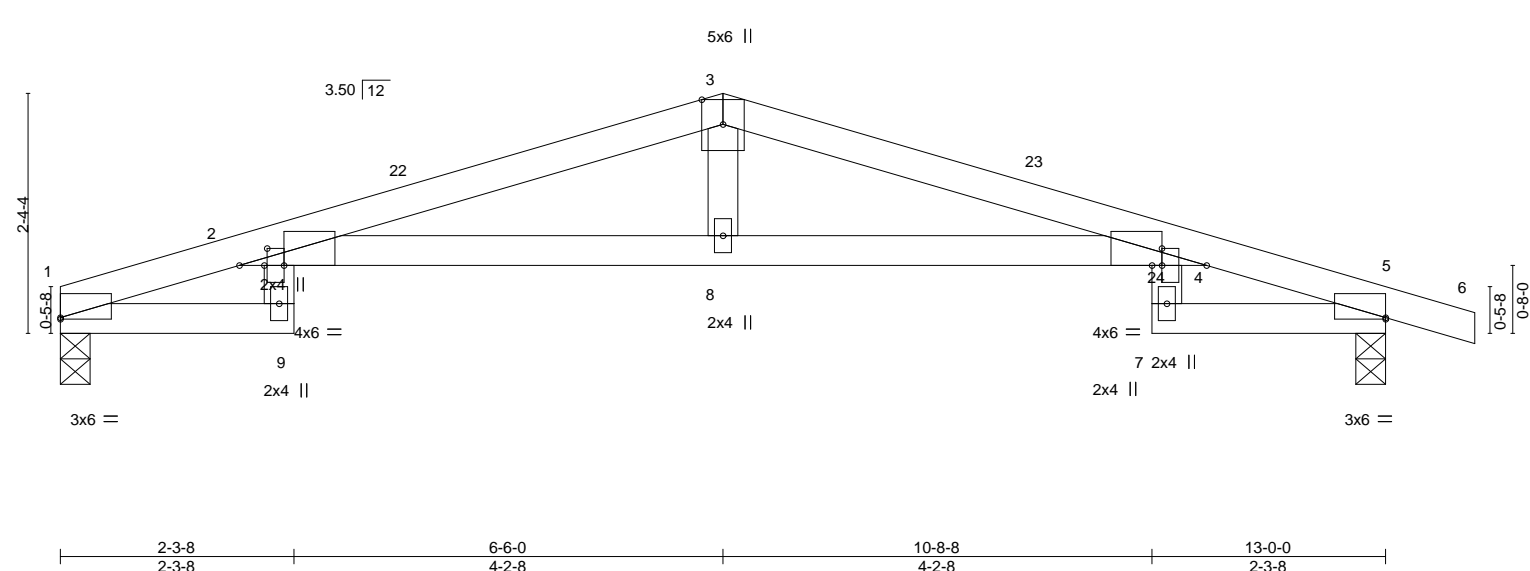
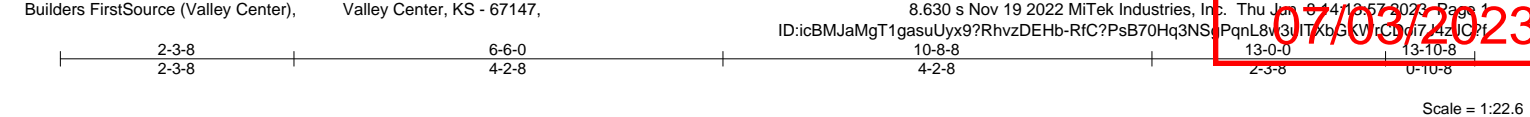


Plate Offsets (X,Y)--		[1:0-0-0,0-0-3], [2:0-5-4,Edge], [2:0-2-0,0-0-5], [4:0-5-4,Edge], [4:0-2-0,0-1-3], [5:Edge,0-0-3]	
LOADING (psf)	SPACING-	CSI.	DEFL.
TCLL 25.0	Plate Grip DOL 1.15	TC 0.85	in (loc) l/defl L/d
TCDL 10.0	Lumber DOL 1.15	BC 0.95	Vert(LL) -0.30 9 >515 240
BCLL 0.0	Rep Stress Incr YES	WB 0.10	Vert(CT) -0.57 9 >273 180
BCDL 10.0	Code IRC2018/TPI2014	Matrix-AS	Horz(CT) 0.27 5 n/a n/a
		PLATES MT20	
		GRIP 197/144	
		Weight: 40 lb FT = 20%	

LUMBER-	BRACING-
TOP CHORD 2x4 SP 2400F 2.0E	TOP CHORD Structural wood sheathing directly applied.
BOT CHORD 2x4 SPF No.2 *Except*	BOT CHORD Rigid ceiling directly applied.
2-4: 2x4 SPF 1650F 1.5E	
WEBS 2x4 SPF No.2	

REACTIONS.	(size) 1=0-3-8, 5=0-3-8
	Max Horz 1=-38(LC 17)
	Max Uplift 1=-79(LC 8), 5=-112(LC 9)
	Max Grav 1=594(LC 1), 5=659(LC 1)

FORCES.	(lb) - Max. Comp./Max. Ten. - All forces 250 (lb) or less except when shown.
TOP CHORD	2-3=-1784/508, 3-4=-1784/501
BOT CHORD	2-8=-414/1724, 4-8=-414/1724
WEBS	3-8=-55/397

- NOTES-**
- 1) Unbalanced roof live loads have been considered for this design.
 - 2) Wind: ASCE 7-16; Vult=115mph (3-second gust) Vasd=91mph; TCDL=6.0psf; BCDL=4.2psf; h=15ft; Cat. II; Exp C; Enclosed; MWFRS (envelope) gable end zone and C-C Exterior(2E) 0-0-0 to 2-9-1, Interior(1) 2-9-1 to 6-6-0, Exterior(2R) 6-6-0 to 9-6-0, Interior(1) 9-6-0 to 13-10-8 zone; cantilever left and right exposed ; end vertical left and right exposed;C-C for members and forces & MWFRS for reactions shown; Lumber DOL=1.60 plate grip DOL=1.60
 - 3) This truss has been designed for a 10.0 psf bottom chord live load nonconcurrent with any other live loads.
 - 4) Provide mechanical connection (by others) of truss to bearing plate capable of withstanding 100 lb uplift at joint(s) 1 except (jt=lb) 5=112.
 - 5) This truss is designed in accordance with the 2018 International Residential Code sections R502.11.1 and R802.10.2 and referenced standard ANSI/TPI 1.
 - 6) This truss design requires that a minimum of 7/16" structural wood sheathing be applied directly to the top chord and 1/2" gypsum sheetrock be applied directly to the bottom chord.




June 12,2023

Job	Truss	Truss Type	Qty	Ply	Summit/161 Highland Meadows	RELEASE FOR CONSTRUCTION
3564895	P2	ROOF SPECIAL	2	1		AS NOTED FOR PLAN REVIEW
					Job Reference (optional)	DEVELOPMENT SERVICES
						LEE'S SUMMIT, MISSOURI


Builders FirstSource (Valley Center), Valley Center, KS - 67147,

8.630 s Nov 19 2022 MiTek Industries, Inc. Thu Jun 9 10:58:30 2023 Page 1

ID:icBMJaMgT1gasuUyx9?RhvzDEHb-RfC?PsB70Hq3NSqPqnL8v3uITxb6KVrCg7J4ZICP

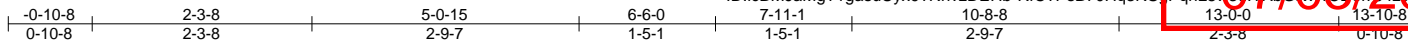

Scale: 1/2"=1'

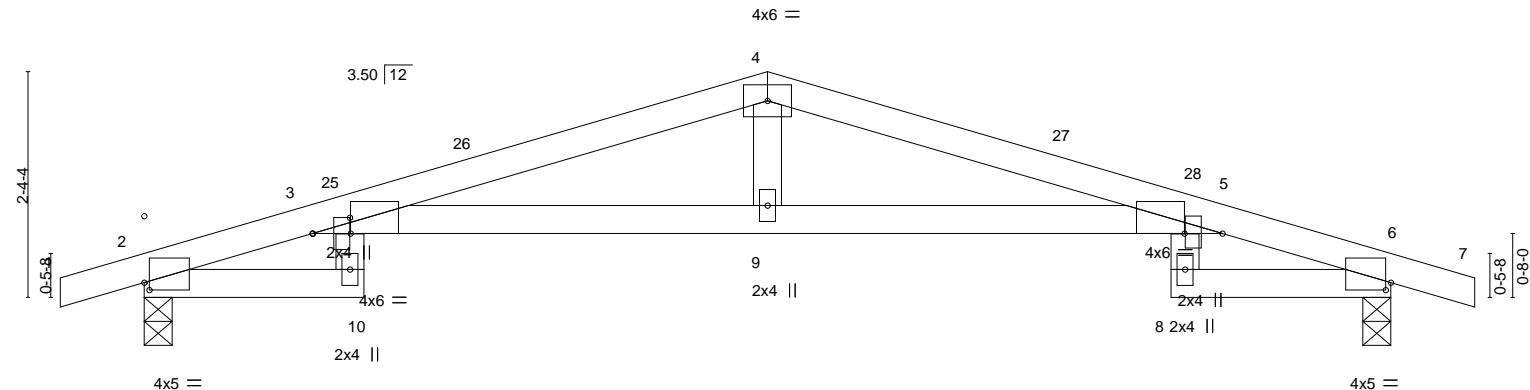

	2-3-8	6-6-0	10-8-8	13-0-0
	2-3-8	4-2-8	4-2-8	2-3-8
Plate Offsets (X,Y)--	[2:0-0-10,0-0-15], [3:0-4-12,Edge], [3:0-2-0,0-4-10], [3:0-2-3,1-9-1], [5:0-4-12,Edge], [6:0-0-10,0-0-15]			

LOADING (psf)	SPACING-	2-0-0	CSI.	DEFL.	in (loc)	l/defl	L/d	PLATES	GRIP
TCLL 25.0	Plate Grip DOL	1.15	TC 0.84	Vert(LL)	-0.28	10	>549	240	MT20
TCDL 10.0	Lumber DOL	1.15	BC 0.74	Vert(CT)	-0.54	10	>288	180	197/144
BCLL 0.0	Rep Stress Incr	YES	WB 0.12	Horz(CT)	0.25	6	n/a	n/a	
BCDL 10.0	Code IRC2018/TPI2014		Matrix-MS						
								Weight: 45 lb	FT = 20%

LUMBER-

TOP CHORD 2x4 SP 2400F 2.0E

BOT CHORD 2x4 SPF No.2 *Except*

3-5: 2x4 SP 2400F 2.0E

WEBS 2x4 SPF No.2

REACTIONS.

(size) 2=0-3-8, 6=0-3-8

Max Horz 2=34(LC 12)

Max Uplift 2=-112(LC 8), 6=-112(LC 9)

Max Grav 2=657(LC 1), 6=657(LC 1)

FORCES. (lb) - Max. Comp./Max. Ten. - All forces 250 (lb) or less except when shown.

TOP CHORD 3-4=-1762/488, 4-5=-1762/492

BOT CHORD 3-9=-402/1691, 5-9=-402/1691

WEBS 4-9=-74/473

NOTES-

- 1) Unbalanced roof live loads have been considered for this design.
- 2) Wind: ASCE 7-16; Vult=115mph (3-second gust) Vasd=91mph; TCDL=6.0psf; BCDL=4.2psf; h=15ft; Cat. II; Exp C; Enclosed; MWFRS (envelope) gable end zone and C-C Exterior(2E) -0-10-8 to 2-1-8, Interior(1) 2-1-8 to 6-6-0, Exterior(2R) 6-6-0 to 9-6-0, Interior(1) 9-6-0 to 13-0-8 zone; cantilever left and right exposed; end vertical left and right exposed; C-C for members and forces & MWFRS for reactions shown; Lumber DOL=1.60 plate grip DOL=1.60
- 3) This truss has been designed for a 10.0 psf bottom chord live load nonconcurrent with any other live loads.
- 4) Provide mechanical connection (by others) of truss to bearing plate capable of withstanding 100 lb uplift at joint(s) except (jt=lb) 2=112, 6=112.
- 5) This truss is designed in accordance with the 2018 International Residential Code sections R502.11.1 and R802.10.2 and referenced standard ANSI/TPI 1.



June 12, 2023

WARNING - Verify design parameters and READ NOTES ON THIS AND INCLUDED MITEK REFERENCE PAGE MII-7473 rev. 5/19/2020 BEFORE USE.


Design valid for use only with MiTek® connectors. This design is based only upon parameters shown, and is for an individual building component, not a truss system. Before use, the building designer must verify the applicability of design parameters and properly incorporate this design into the overall building design. Bracing indicated is to prevent buckling of individual truss web and/or chord members only. Additional temporary and permanent bracing is always required for stability and to prevent collapse with possible personal injury and property damage. For general guidance regarding the fabrication, storage, delivery, erection and bracing of trusses and truss systems, see


ANSI/TPI1 Quality Criteria, DSB-89 and BCSI Building Component

Safety Information available from Truss Plate Institute, 2670 Crain Highway, Suite 203 Waldorf, MD 20601



16023 Swingley Ridge Rd
Chesterfield, MO 63017

 **WARNING - Verify design parameters and READ NOTES ON THIS AND INCLUDED MITEK REFERENCE PAGE MII-7473 rev. 5/19/2020 BEFORE USE.**
 Design valid for use only with MiTek® connectors. This design is based only upon parameters shown, and is for an individual building component, not a truss system. Before use, the building designer must verify the applicability of design parameters and properly incorporate this design into the overall building design. Bracing indicated is to prevent buckling of individual truss web and/or chord members only. Additional temporary and permanent bracing is always required for stability and to prevent collapse with possible personal injury and property damage. For general guidance regarding the erection, storage, and bracing of trusses and truss systems and truss systems and truss systems, see **ANSI/APRI Quality Criteria, DSB-89 and BCSI Building Component Safety Information** available from Truss Plate Institute, 2670 Crain Highway, Suite 203 Waldorf, MD 20601

 **16023 Swingley Ridge Rd**
Chesterfield, MO 63017

Job	Truss	Truss Type	Qty	Ply	Summit/161 Highland Meadows	RELEASE FOR CONSTRUCTION
3564895	P3	ROOF SPECIAL GIRDER	1	2	Job Reference (optional)	AS NOTED FOR PLAN REVIEW DEVELOPMENT SERVICES LEE'S SUMMIT, MISSOURI

Builders FirstSource (Valley Center), Valley Center, KS - 67147,

8.630 s Nov 19 2022 MiTek Industries, Inc. Thu Jun 8 7 47 14 00 2023 Page 2

ID:icBMJaMgT1gasuUyx9?RhvzDEHb-RfC?PsB70Hq3NSqPqnL8v3uITxbS KV rCm7 J4ZIC?

LOAD CASE(S) Standard

- 1) Dead + Roof Live (balanced): Lumber Increase=1.15, Plate Increase=1.15
Uniform Loads (plf)
Vert: 1-4=-70, 4-7=-70, 10-11=-20, 17-20=-20, 8-14=-20
Concentrated Loads (lb)
Vert: 10=-225(B) 9=-421(B) 20=-225(B) 23=-219(B) 24=-219(B)

07/03/2023

 WARNING - Verify design parameters and READ NOTES ON THIS AND INCLUDED MITEK REFERENCE PAGE MII-7473 rev. 5/19/2020 BEFORE USE.

Design valid for use only with MiTek® connectors. This design is based only upon parameters shown, and is for an individual building component, not a truss system. Before use, the building designer must verify the applicability of design parameters and properly incorporate this design into the overall building design. Bracing indicated is to prevent buckling of individual truss web and/or chord members only. Additional temporary and permanent bracing is always required for stability and to prevent collapse with possible personal injury and property damage. For general guidance regarding the fabrication, storage, delivery, erection and bracing of trusses and truss systems, see **ANSI/TPI1 Quality Criteria, DSB-89 and BCSI Building Component Safety Information** available from Truss Plate Institute, 2670 Crain Highway, Suite 203 Waldorf, MD 20601



16023 Swingley Ridge Rd
Chesterfield, MO 63017

Job	Truss	Truss Type	Qty	Ply	Summit/161 Highland Meadows	AS NOTED FOR PLAN REVIEW DEVELOPMENT SERVICES LEE'S SUMMIT, MISSOURI
3564895	P4	Half Hip Girder	2	1	Job Reference (optional)	

Builders FirstSource (Valley Center), Valley Center, KS - 67147,

8.630 s Nov 19 2022 MiTek Industries, Inc. Thu Jun 8 7 47 14 01 2023 Page 1

ID:icBMJaMgT1gasuUyx9?RhvzDEHb-RfC?PsB70Hq3NSqPqnL8v3uITxb65KvrcCm7J4ZICP

07/03/2023



Scale = 1:12.5

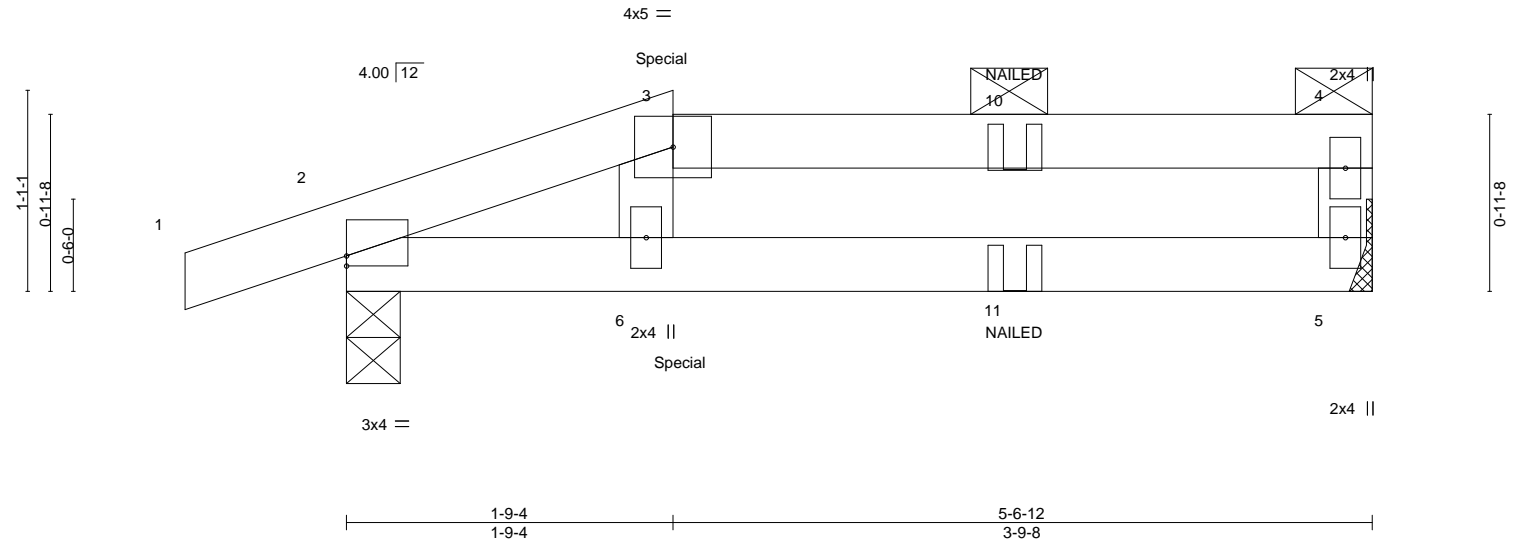


Plate Offsets (X,Y)--		[2:0-0-0,0-0-10]									
LOADING (psf)	SPACING-	2-0-0	CSI.	DEFL.	in	(loc)	l/defl	L/d	PLATES	GRIP	
TCLL 25.0	Plate Grip DOL	1.15	TC 0.28	Vert(LL)	-0.09	5-6	>727	240	MT20	197/144	
TCDL 10.0	Lumber DOL	1.15	BC 0.69	Vert(CT)	-0.17	5-6	>379	180			
BCLL 0.0	Rep Stress Incr	NO	WB 0.03	Horz(CT)	0.02	2	n/a	n/a			
BCDL 10.0	Code IRC2018/TPI2014		Matrix-MP						Weight: 15 lb	FT = 20%	

LUMBER-

TOP CHORD 2x4 SPF No.2
 BOT CHORD 2x4 SPF No.2
 WEBS 2x4 SPF No.2

BRACING-

TOP CHORD Structural wood sheathing directly applied or 5-6-12 oc purlins, except end verticals, and 2-0-0 oc purlins: 3-4.
 BOT CHORD Rigid ceiling directly applied or 6-0-0 oc bracing.

REACTIONS.

(size) 5=Mechanical, 2=0-3-8
 Max Horz 2=29(LC 7)
 Max Uplift 5=42(LC 4), 2=-78(LC 4)
 Max Grav 5=245(LC 1), 2=318(LC 1)

FORCES. (lb) - Max. Comp./Max. Ten. - All forces 250 (lb) or less except when shown.

WEBS 3-6=-251/74

NOTES-

- Unbalanced roof live loads have been considered for this design.
- Wind: ASCE 7-16; Vult=115mph (3-second gust) Vasd=91mph; TCDL=6.0psf; BCDL=4.2psf; h=15ft; Cat. II; Exp C; Enclosed; MWFRS (envelope) gable end zone; cantilever left and right exposed; end vertical left and right exposed; Lumber DOL=1.60 plate grip DOL=1.60
- Provide adequate drainage to prevent water ponding.
- This truss has been designed for a 10.0 psf bottom chord live load nonconcurrent with any other live loads.
- Refer to girder(s) for truss to truss connections.
- Provide mechanical connection (by others) of truss to bearing plate capable of withstanding 100 lb uplift at joint(s) 5, 2.
- This truss is designed in accordance with the 2018 International Residential Code sections R502.11.1 and R802.10.2 and referenced standard ANSI/TPI 1.
- Graphical purlin representation does not depict the size or the orientation of the purlin along the top and/or bottom chord.
- "NAILED" indicates 3-10d (0.148"x3") or 3-12d (0.148"x3.25") toe-nails per NDS guidelines.
- Hanger(s) or other connection device(s) shall be provided sufficient to support concentrated load(s) 36 lb down and 58 lb up at 1-9-4 on top chord, and 23 lb down at 1-9-4 on bottom chord. The design/selection of such connection device(s) is the responsibility of others.
- In the LOAD CASE(S) section, loads applied to the face of the truss are noted as front (F) or back (B).

LOAD CASE(S) Standard

- Dead + Roof Live (balanced): Lumber Increase=1.15, Plate Increase=1.15
- Uniform Loads (plf)
Vert: 1-3=-70, 3-4=-70, 5-7=-20
- Concentrated Loads (lb)
Vert: 6=-8(B) 11=-6(B)



June 12, 2023

WARNING - Verify design parameters and READ NOTES ON THIS AND INCLUDED MITEK REFERENCE PAGE MII-7473 rev. 5/19/2020 BEFORE USE.

Design valid for use only with MiTek® connectors. This design is based only upon parameters shown, and is for an individual building component, not a truss system. Before use, the building designer must verify the applicability of design parameters and properly incorporate this design into the overall building design. Bracing indicated is to prevent buckling of individual truss web and/or chord members only. Additional temporary and permanent bracing is always required for stability and to prevent collapse with possible personal injury and property damage. For general guidance regarding the fabrication, storage, delivery, erection and bracing of trusses and truss systems, see

ANSI/TPI1 Quality Criteria, DSB-89 and BCSI Building Component

Safety Information available from Truss Plate Institute, 2670 Crain Highway, Suite 203 Waldorf, MD 20601

16023 Swingley Ridge Rd
Chesterfield, MO 63017

Job	Truss	Truss Type	Qty	Ply	Summit/161 Highland Meadows	AS NOTED FOR PLAN REVIEW DEVELOPMENT SERVICES LEE'S SUMMIT, MISSOURI
3564895	P5	Half Hip	2	1	Job Reference (optional)	

Builders FirstSource (Valley Center), Valley Center, KS - 67147,


8.630 s Nov 19 2022 MiTek Industries, Inc. Thu Jun 8 7 47 14 03 2023 Page 1

ID:icBMJaMgT1gasuUyx9?RhvzDEHb-RfC?PsB70Hq3NSpPqnL8v3uITxb6KVrCm7J4ZICP

07/03/2023

-0-10-8	2-3-8	3-6-4	5-6-12
0-10-8	2-3-8	1-2-12	2-0-8

Scale = 1:12.9

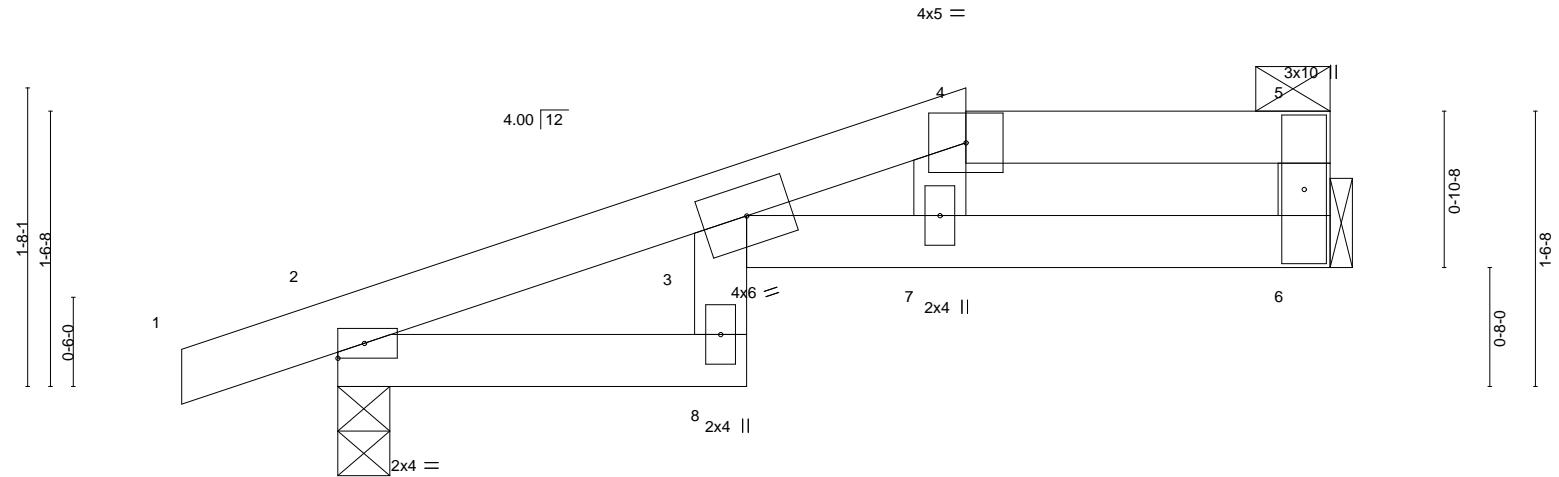

		2-3-8		3-6-4		5-6-12					
		2-3-8		1-2-12		2-0-8					
LOADING	(psf)	SPACING-	2-0-0	CSI.		DEFL.	in (loc)	l/defl	L/d	PLATES	GRIP
TCLL	25.0	Plate Grip DOL	1.15	TC	0.55	Vert(LL)	0.11 3-7	>603	240	MT20	197/144
TCDL	10.0	Lumber DOL	1.15	BC	0.61	Vert(CT)	-0.18 3-7	>370	180		
BCLL	0.0	Rep Stress Incr	YES	WB	0.05	Horz(CT)	0.08 6	n/a	n/a		
BCDL	10.0	Code IRC2018/TPI2014		Matrix-AS						Weight: 16 lb	FT = 20%

LUMBER-

TOP CHORD 2x4 SPF No.2
 BOT CHORD 2x4 SPF No.2
 WEBS 2x4 SPF No.2

BRACING-

TOP CHORD Structural wood sheathing directly applied, except end verticals, and 2-0-0 oc purlins: 4-5.
 BOT CHORD Rigid ceiling directly applied.

REACTIONS.

(size) 6=Mechanical, 2=0-3-8
 Max Horz 2=41(LC 8)
 Max Uplift 6=45(LC 8), 2=75(LC 8)
 Max Grav 6=239(LC 1), 2=310(LC 1)

FORCES. (lb) - Max. Comp./Max. Ten. - All forces 250 (lb) or less except when shown.

WEBS 4-7=-365/262

NOTES-

- 1) Unbalanced roof live loads have been considered for this design.
- 2) Wind: ASCE 7-16; Vult=115mph (3-second gust) Vasd=91mph; TCDL=6.0psf; BCDL=4.2psf; h=15ft; Cat. II; Exp C; Enclosed; MWFRS (envelope) gable end zone and C-C Exterior(2E) -0-10-8 to 2-1-12, Interior(1) 2-1-12 to 3-6-4, Exterior(2E) 3-6-4 to 5-5-0 zone; cantilever left and right exposed; end vertical left and right exposed; C-C for members and forces & MWFRS for reactions shown; Lumber DOL=1.60 plate grip DOL=1.60
- 3) Provide adequate drainage to prevent water ponding.
- 4) This truss has been designed for a 10.0 psf bottom chord live load nonconcurrent with any other live loads.
- 5) Refer to girder(s) for truss to truss connections.
- 6) Provide mechanical connection (by others) of truss to bearing plate capable of withstanding 100 lb uplift at joint(s) 6, 2.
- 7) This truss is designed in accordance with the 2018 International Residential Code sections R502.11.1 and R802.10.2 and referenced standard ANSI/TPI 1.
- 8) This truss design requires that a minimum of 7/16" structural wood sheathing be applied directly to the top chord and 1/2" gypsum sheetrock be applied directly to the bottom chord.
- 9) Graphical purlin representation does not depict the size or the orientation of the purlin along the top and/or bottom chord.



June 12, 2023

WARNING - Verify design parameters and READ NOTES ON THIS AND INCLUDED MITEK REFERENCE PAGE MII-7473 rev. 5/19/2020 BEFORE USE.

Design valid for use only with MiTek® connectors. This design is based only upon parameters shown, and is for an individual building component, not a truss system. Before use, the building designer must verify the applicability of design parameters and properly incorporate this design into the overall building design. Bracing indicated is to prevent buckling of individual truss web and/or chord members only. Additional temporary and permanent bracing is always required for stability and to prevent collapse with possible personal injury and property damage. For general guidance regarding the fabrication, storage, delivery, erection and bracing of trusses and truss systems, see

ANSI/TPI1 Quality Criteria, DSB-89 and BCSI Building Component

Safety Information available from Truss Plate Institute, 2670 Crain Highway, Suite 203 Waldorf, MD 20601



16023 Swingley Ridge Rd
 Chesterfield, MO 63017

Job	Truss	Truss Type	Qty	Ply	Summit/161 Highland Meadows	RELEASE FOR CONSTRUCTION
3564895	P6	HALF HIP	2	1		AS NOTED FOR PLAN REVIEW
					Job Reference (optional)	DEVELOPMENT SERVICES
						LEE'S SUMMIT, MISSOURI

Builders FirstSource (Valley Center), Valley Center, KS - 67147,

8.630 s Nov 19 2022 MiTek Industries, Inc. Thu Jun 8 7:47:14 PM 2023 Page 1

ID:icBMJaMgT1gasuUyx9?RhvzDEHb-RfC?PsB70Hq3NSaPqnL8v3uITxb6KVrCm7J4ZICP

07/08/2023

-0-10-8 2-3-8 5-3-4 5-6-12
0-10-8 2-3-8 2-11-12 0-3-8

Scale = 1:15.0

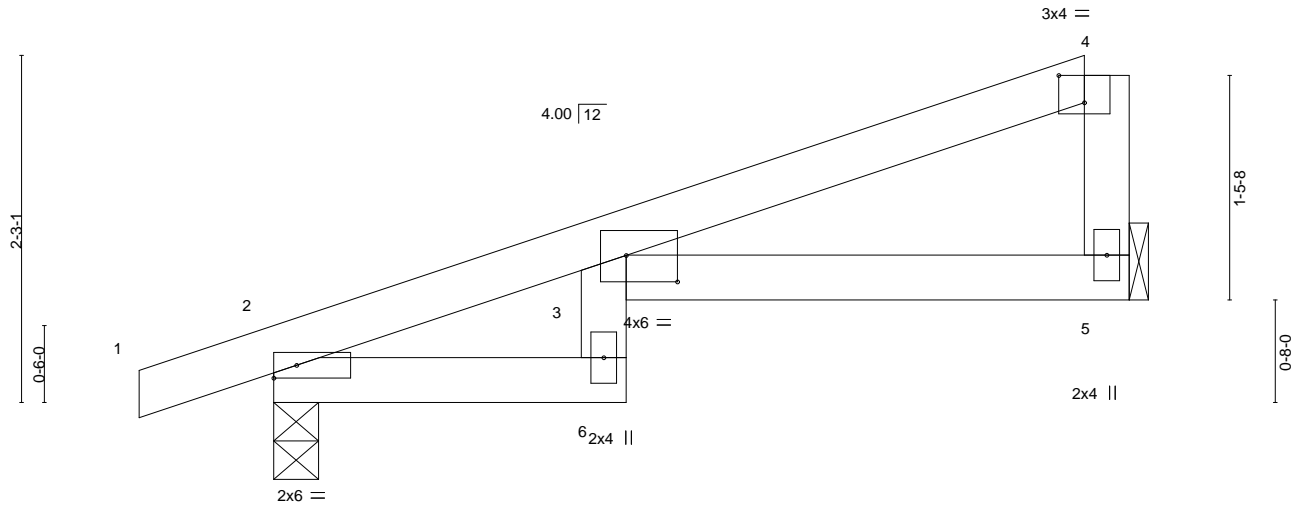


Plate Offsets (X,Y)--	[3:0-4-0,0-2-1], [4:0-2-0,0-2-2]								
LOADING (psf)	SPACING-	2-0-0	CSI.	DEFL.	in (loc)	l/defl	L/d	PLATES	GRIP
TCLL 25.0	Plate Grip DOL	1.15	TC 0.51	Vert(LL)	-0.07	6	>918	MT20	197/144
TCDL 10.0	Lumber DOL	1.15	BC 0.28	Vert(CT)	-0.12	6	>511		
BCLL 0.0	Rep Stress Incr	YES	WB 0.00	Horz(CT)	0.07	5	n/a		
BCDL 10.0	Code IRC2018/TPI2014		Matrix-R					Weight: 16 lb	FT = 20%

LUMBER-

TOP CHORD 2x4 SPF No.2
BOT CHORD 2x4 SPF No.2
WEBS 2x4 SPF No.2

BRACING-

TOP CHORD Structural wood sheathing directly applied or 5-6-12 oc purlins, except end verticals.
BOT CHORD Rigid ceiling directly applied or 10-0-0 oc bracing.

REACTIONS.

(size) 5=Mechanical, 2=0-3-8
Max Horz 2=78(LC 8)
Max Uplift 5=55(LC 12), 2=70(LC 8)
Max Grav 5=230(LC 1), 2=316(LC 1)

FORCES. (lb) - Max. Comp./Max. Ten. - All forces 250 (lb) or less except when shown.

NOTES-

- 1) Wind: ASCE 7-16; Vult=115mph (3-second gust) Vasd=91mph; TCDL=6.0psf; BCDL=4.2psf; h=15ft; Cat. II; Exp C; Enclosed; MWFRS (envelope) gable end zone and C-C Exterior(2E) -0-10-8 to 2-1-12, Interior(1) 2-1-12 to 5-5-0 zone; cantilever left and right exposed; end vertical left exposed; C-C for members and forces & MWFRS for reactions shown; Lumber DOL=1.60 plate grip DOL=1.60
- 2) This truss has been designed for a 10.0 psf bottom chord live load nonconcurrent with any other live loads.
- 3) Refer to girder(s) for truss to truss connections.
- 4) Provide mechanical connection (by others) of truss to bearing plate capable of withstanding 100 lb uplift at joint(s) 5, 2.
- 5) This truss is designed in accordance with the 2018 International Residential Code sections R502.11.1 and R802.10.2 and referenced standard ANSI/TPI 1.



June 12, 2023

WARNING - Verify design parameters and READ NOTES ON THIS AND INCLUDED MITEK REFERENCE PAGE MII-7473 rev. 5/19/2020 BEFORE USE.

Design valid for use only with MiTek® connectors. This design is based only upon parameters shown, and is for an individual building component, not a truss system. Before use, the building designer must verify the applicability of design parameters and properly incorporate this design into the overall building design. Bracing indicated is to prevent buckling of individual truss web and/or chord members only. Additional temporary and permanent bracing is always required for stability and to prevent collapse with possible personal injury and property damage. For general guidance regarding the fabrication, storage, delivery, erection and bracing of trusses and truss systems, see

ANSI/TPI1 Quality Criteria, DSB-89 and BCSI Building Component

Safety Information available from Truss Plate Institute, 2670 Crain Highway, Suite 203 Waldorf, MD 20601



16023 Swingley Ridge Rd
Chesterfield, MO 63017


Job	Truss	Truss Type	Qty	Ply	Summit/161 Highland Meadows	RELEASE FOR CONSTRUCTION
3564895	V2	Valley	1	1		AS NOTED FOR PLAN REVIEW
					Job Reference (optional)	DEVELOPMENT SERVICES
						LEE'S SUMMIT, MISSOURI

Builders FirstSource (Valley Center), Valley Center, KS - 67147,

8.630 s Nov 19 2022 MiTek Industries, Inc. Thu Jun 02 14:05:2023 Page 1

ID:icBMJaMgT1gasuUyx9?RhvzDEHb-RfC?PsB70Hq3NSpPqnL8v3uITxb6KVrCm7J4ZICP

07/03/2023

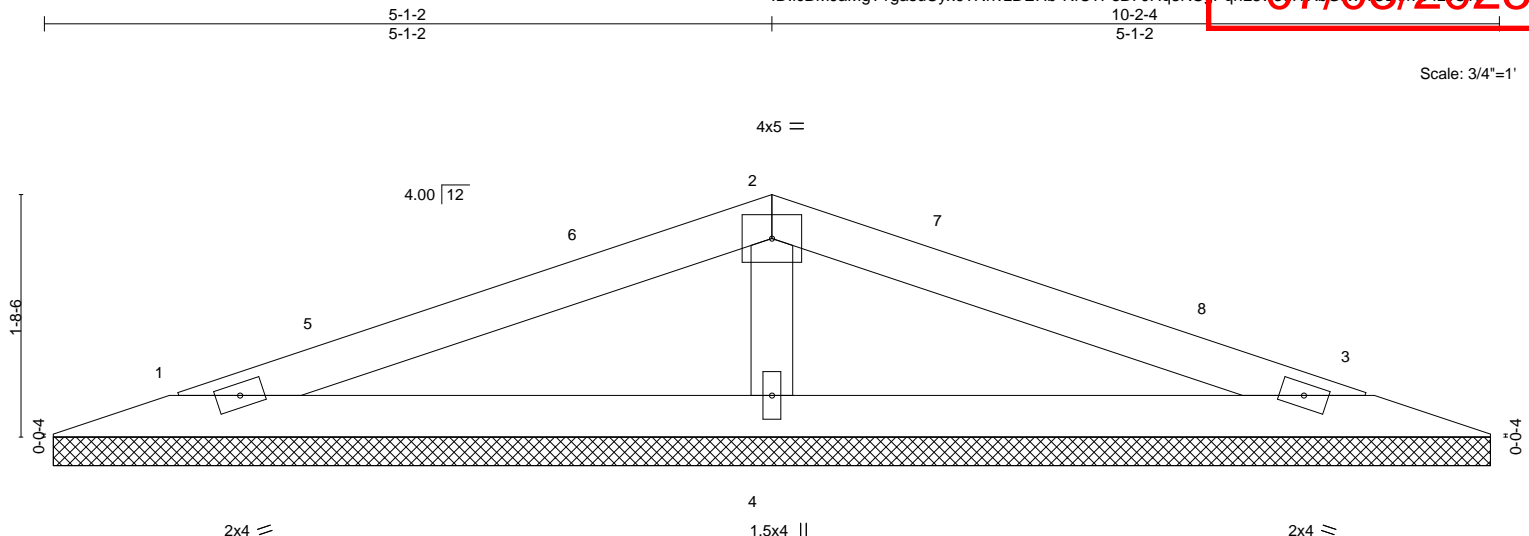

Scale: 3/4"=1'

		10-1-8		10-2-4	
		10-1-8		0-0-12	
LOADING (psf)	SPACING-	2-0-0	CSI.	DEFL.	PLATES
TCLL 25.0	Plate Grip DOL	1.15	TC 0.23	in (loc) l/defl L/d	GRIP
TCDL 10.0	Lumber DOL	1.15	BC 0.14	Vert(LL) n/a - n/a 999	MT20 197/144
BCLL 0.0	Rep Stress Incr	YES	WB 0.04	Vert(CT) n/a - n/a 999	
BCDL 10.0	Code IRC2018/TPI2014		Matrix-S	Horz(CT) 0.00 3 n/a n/a	Weight: 23 lb FT = 20%

LUMBER-

TOP CHORD 2x4 SPF No.2
BOT CHORD 2x4 SPF No.2
OTHERS 2x4 SPF No.2

BRACING-

TOP CHORD Structural wood sheathing directly applied or 6-0-0 oc purlins.
BOT CHORD Rigid ceiling directly applied or 10-0-0 oc bracing.

REACTIONS.

(size) 1=10-0-12, 3=10-0-12, 4=10-0-12
Max Horz 1=22(LC 17)
Max Uplift 1=33(LC 8), 3=36(LC 13), 4=42(LC 8)
Max Grav 1=166(LC 25), 3=166(LC 26), 4=427(LC 1)

FORCES. (lb) - Max. Comp./Max. Ten. - All forces 250 (lb) or less except when shown.

WEBS 2-4=-302/195

NOTES-

- Unbalanced roof live loads have been considered for this design.
- Wind: ASCE 7-16; Vult=115mph (3-second gust) Vasd=91mph; TCDL=6.0psf; BCDL=4.2psf; h=15ft; Cat. II; Exp C; Enclosed; MWFRS (envelope) gable end zone and C-C Exterior(2E) 0-11-5 to 3-11-5, Interior(1) 3-11-5 to 5-1-2, Exterior(2R) 5-1-2 to 8-1-2, Interior(1) 8-1-2 to 9-2-15 zone; cantilever left and right exposed; end vertical left and right exposed; C-C for members and forces & MWFRS for reactions shown; Lumber DOL=1.60 plate grip DOL=1.60
- Gable requires continuous bottom chord bearing.
- This truss has been designed for a 10.0 psf bottom chord live load nonconcurrent with any other live loads.
- Provide mechanical connection (by others) of truss to bearing plate capable of withstanding 100 lb uplift at joint(s) 1, 3, 4.
- This truss is designed in accordance with the 2018 International Residential Code sections R502.11.1 and R802.10.2 and referenced standard ANSI/TPI 1.



June 12, 2023

WARNING - Verify design parameters and READ NOTES ON THIS AND INCLUDED MITEK REFERENCE PAGE MII-7473 rev. 5/19/2020 BEFORE USE.

Design valid for use only with MiTek® connectors. This design is based only upon parameters shown, and is for an individual building component, not a truss system. Before use, the building designer must verify the applicability of design parameters and properly incorporate this design into the overall building design. Bracing indicated is to prevent buckling of individual truss web and/or chord members only. Additional temporary and permanent bracing is always required for stability and to prevent collapse with possible personal injury and property damage. For general guidance regarding the fabrication, storage, delivery, erection and bracing of trusses and truss systems, see

ANSI/TPI1 Quality Criteria, DSB-89 and BCSI Building Component

Safety Information available from Truss Plate Institute, 2670 Crain Highway, Suite 203 Waldorf, MD 20601



16023 Swingley Ridge Rd
Chesterfield, MO 63017



Job	Truss	Truss Type	Qty	Ply	Summit/161 Highland Meadows	RELEASE FOR CONSTRUCTION
3564895	V3	Valley	1	1	Job Reference (optional)	AS NOTED FOR PLAN REVIEW DEVELOPMENT SERVICES LEE'S SUMMIT, MISSOURI

Builders FirstSource (Valley Center), Valley Center, KS - 67147,

8.630 s Nov 19 2022 MiTek Industries, Inc. Thu Jun 8 7 47 14 06 2023 Page 1

ID:icBMJaMgT1gasuUyx9?RhvzDEHb-RfC?PsB70Hq3NSqPqnL8v3uITxb6KVrCm7J4ZICP

07/03/2023

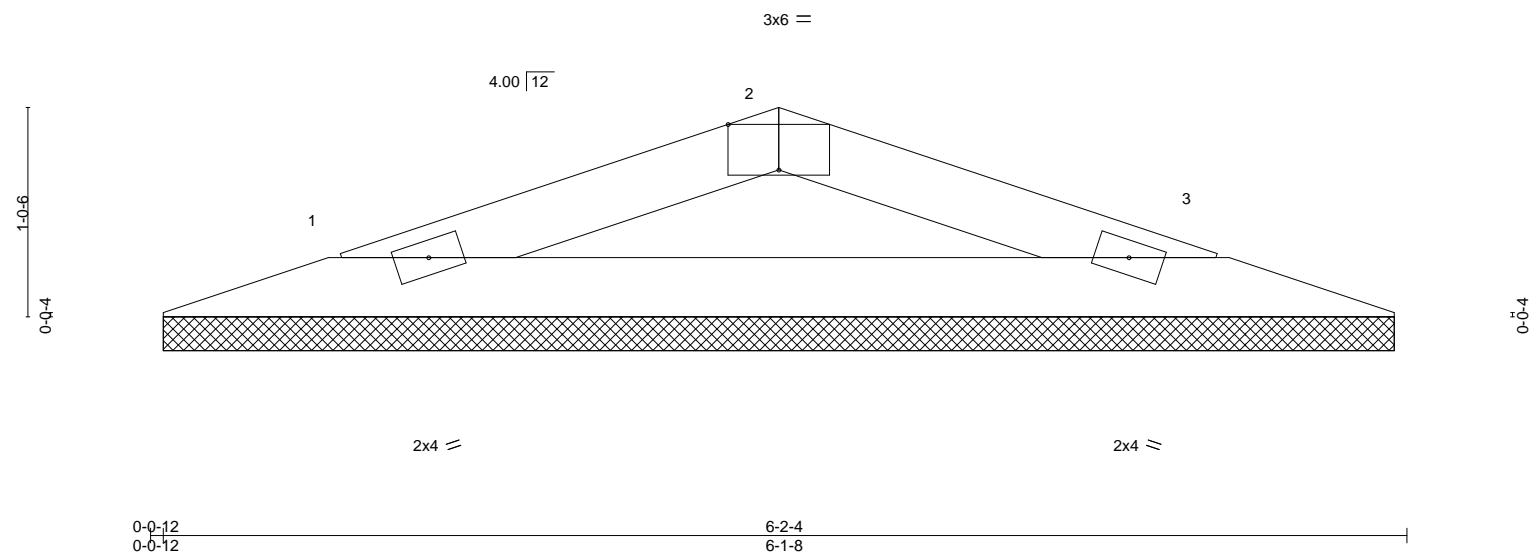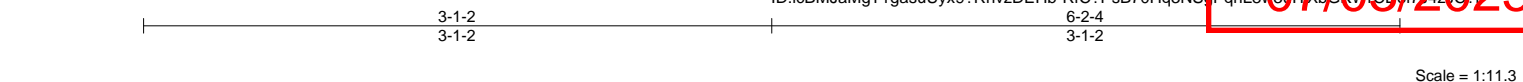

LOADING (psf)		SPACING-		CSI.		DEFL.		PLATES		GRIP	
TCLL	25.0	Plate Grip DOL	1.15	TC	0.10	Vert(LL)	n/a	MT20	197/144		
TCDL	10.0	Lumber DOL	1.15	BC	0.20	Vert(CT)	n/a				
BCLL	0.0	Rep Stress Incr	YES	WB	0.00	Horz(CT)	0.00				
BCDL	10.0	Code IRC2018/TPI2014		Matrix-P							

LUMBER-		BRACING-	
TOP CHORD	2x4 SPF No.2	TOP CHORD	Structural wood sheathing directly applied or 6-0-0 oc purlins.
BOT CHORD	2x4 SPF No.2	BOT CHORD	Rigid ceiling directly applied or 10-0-0 oc bracing.

REACTIONS.	
(size)	1=6-0-12, 3=6-0-12
Max Horz	1=12(LC 12)
Max Uplift	1=28(LC 8), 3=28(LC 9)
Max Grav	1=194(LC 1), 3=194(LC 1)

FORCES.	
(lb) - Max. Comp./Max. Ten. - All forces 250 (lb) or less except when shown.	
TOP CHORD	1-2=-253/215, 2-3=-253/225

- NOTES-**
- 1) Unbalanced roof live loads have been considered for this design.
 - 2) Wind: ASCE 7-16; Vult=115mph (3-second gust) Vasd=91mph; TCDL=6.0psf; BCDL=4.2psf; h=15ft; Cat. II; Exp C; Enclosed; MWFRS (envelope) gable end zone and C-C Exterior(2E) zone; cantilever left and right exposed; end vertical left and right exposed; C-C for members and forces & MWFRS for reactions shown; Lumber DOL=1.60 plate grip DOL=1.60
 - 3) Gable requires continuous bottom chord bearing.
 - 4) This truss has been designed for a 10.0 psf bottom chord live load nonconcurrent with any other live loads.
 - 5) Provide mechanical connection (by others) of truss to bearing plate capable of withstanding 100 lb uplift at joint(s) 1, 3.
 - 6) This truss is designed in accordance with the 2018 International Residential Code sections R502.11.1 and R802.10.2 and referenced standard ANSI/TPI 1.




June 12, 2023

07/03/2023

Symbols

PLATE LOCATION AND ORIENTATION

Center plate on joint unless x, y offsets are indicated.
Dimensions are in ft-in-sixteenths. Apply plates to both sides of truss and fully embed teeth.

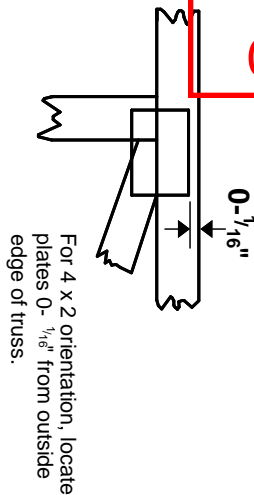

This symbol indicates the required direction of slots in connector plates.

* Plate location details available in **MiTek 20/20** software or upon request.

PLATE SIZE

4 X 4


The first dimension is the plate width measured perpendicular to slots. Second dimension is the length parallel to slots.

LATERAL BRACING LOCATION



Indicated by symbol shown and/or by text in the bracing section of the output. Use T or I bracing if indicated.

BEARING

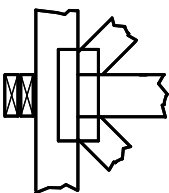


Indicates location where bearings (supports) occur. Icons vary but reaction section indicates joint number where bearings occur. Min size shown is for crushing only.

Industry Standards:

ANSI/TPI 1: National Design Specification for Metal Plate Connected Wood Truss Construction.
DSB-89: Design Standard for Bracing.
BCSI: Building Component Safety Information, Guide to Good Practice for Handling, Installing & Bracing of Metal Plate Connected Wood Trusses.

Numbering System

6-4-8 dimensions shown in ft-in-sixteenths
(Drawings not to scale)

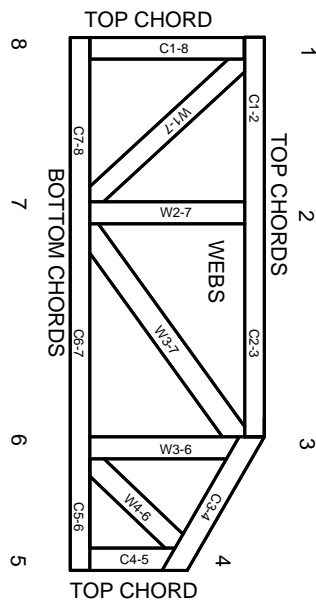

JOINTS ARE GENERALLY NUMBERED/LETTERED CLOCKWISE AROUND THE TRUSS STARTING AT THE JOINT FARTHEST TO THE LEFT.

CHORDS AND WEBS ARE IDENTIFIED BY END JOINT NUMBERS/LETTERS.

PRODUCT CODE APPROVALS

ICC-ES Reports:

ESR-1311, ESR-1352, ESR1988
ER-3907, ESR-2362, ESR-1397, ESR-3282

Trusses are designed for wind loads in the plane of the truss unless otherwise shown.

Lumber design values are in accordance with ANSI/TPI 1 section 6.3 These truss designs rely on lumber values established by others.

© 2012 MiTek® All Rights Reserved



MiTek Engineering Reference Sheet: MII-7473 rev. 5/19/2020



General Safety Notes

Failure to Follow Could Cause Property Damage or Personal Injury

1. Additional stability bracing for truss system, e.g. diagonal or X-bracing, is always required. See BCSI.
2. Truss bracing must be designed by an engineer. For wide truss spacing, individual lateral braces themselves may require bracing, or alternative Tor I bracing should be considered.
3. Never exceed the design loading shown and never stack materials on inadequately braced trusses.
4. Provide copies of this truss design to the building designer, erection supervisor, property owner and all other interested parties.
5. Cut members to bear tightly against each other.
6. Place plates on each face of truss at each joint and embed fully. Knots and wane at joint locations are regulated by ANSI/TPI 1.
7. Design assumes trusses will be suitably protected from the environment in accord with ANSI/TPI 1.
8. Unless otherwise noted, moisture content of lumber shall not exceed 19% at time of fabrication.
9. Unless expressly noted, this design is not applicable for use with fire retardant, preservative treated, or green lumber.
10. Camber is a non-structural consideration and is the responsibility of truss fabricator. General practice is to camber for dead load deflection.
11. Plate type, size, orientation and location dimensions indicated are minimum plating requirements.
12. Lumber used shall be of the species and size, and in all respects, equal to or better than that specified.
13. Top chords must be sheathed or purlins provided at spacing indicated on design.
14. Bottom chords require lateral bracing at 10 ft. spacing, or less, if no ceiling is installed, unless otherwise noted.
15. Connections not shown are the responsibility of others.
16. Do not cut or alter truss member or plate without prior approval of an engineer.
17. Install and load vertically unless indicated otherwise.
18. Use of green or treated lumber may pose unacceptable environmental, health or performance risks. Consult with project engineer before use.
19. Review all portions of this design (front, back, words and pictures) before use. Reviewing pictures alone is not sufficient.
20. Design assumes manufacture in accordance with ANSI/TPI 1 Quality Criteria.
21. The design does not take into account any dynamic or other loads other than those expressly stated.