

RE: 3664536
Summit/185 Highland Meadows

MiTek, Inc.
16023 Swingley Ridge Rd.
Chesterfield, MO 63017
314.434.1200

Site Information:

Customer: Project Name: 3664536
Lot/Block:
Address:
City:

Model:
Subdivision:
State:

General Truss Engineering Criteria & Design Loads (Individual Truss Design Drawings Show Special Loading Conditions):

Design Code: IRC2018/TPI2014
Wind Code: ASCE 7-16
Roof Load: 45.0 psf

Design Program: MiTek 20/20 8.6
Wind Speed: 115 mph
Floor Load: N/A psf

This package includes 75 individual, dated Truss Design Drawings and 0 Additional Drawings.

No.	Seal#	Truss Name	Date	No.	Seal#	Truss Name	Date
1	I58837488	A1	6/12/2023	21	I58837508	CJ8	6/12/2023
2	I58837489	A2	6/12/2023	22	I58837509	CJ9	6/12/2023
3	I58837490	A3	6/12/2023	23	I58837510	CJ10	6/12/2023
4	I58837491	A4	6/12/2023	24	I58837511	D1	6/12/2023
5	I58837492	A5	6/12/2023	25	I58837512	D2	6/12/2023
6	I58837493	A6	6/12/2023	26	I58837513	E1	6/12/2023
7	I58837494	A7	6/12/2023	27	I58837514	E2	6/12/2023
8	I58837495	A8	6/12/2023	28	I58837515	E3	6/12/2023
9	I58837496	A9	6/12/2023	29	I58837516	E4	6/12/2023
10	I58837497	B1	6/12/2023	30	I58837517	F1	6/12/2023
11	I58837498	B1A	6/12/2023	31	I58837518	F2	6/12/2023
12	I58837499	B2	6/12/2023	32	I58837519	F3	6/12/2023
13	I58837500	B3	6/12/2023	33	I58837520	F4	6/12/2023
14	I58837501	CJ1	6/12/2023	34	I58837521	J1	6/12/2023
15	I58837502	CJ2	6/12/2023	35	I58837522	J2	6/12/2023
16	I58837503	CJ3	6/12/2023	36	I58837523	J3	6/12/2023
17	I58837504	CJ4	6/12/2023	37	I58837524	J4	6/12/2023
18	I58837505	CJ5	6/12/2023	38	I58837525	J5	6/12/2023
19	I58837506	CJ6	6/12/2023	39	I58837526	J6	6/12/2023
20	I58837507	CJ7	6/12/2023	40	I58837527	J7	6/12/2023

The truss drawing(s) referenced above have been prepared by MiTek USA, Inc under my direct supervision based on the parameters provided by Builders FirstSource (Valley Center).
Truss Design Engineer's Name: Sevier, Scott
My license renewal date for the state of Missouri is December 31, 2023.
Missouri COA: 001193

IMPORTANT NOTE: The seal on these truss component designs is a certification that the engineer named is licensed in the jurisdiction(s) identified and that the designs comply with ANSI/TPI 1. These designs are based upon parameters shown (e.g., loads, supports, dimensions, shapes and design codes), which were given to MiTek. Any project specific information included is for MiTek customers file reference purpose only, and was not taken into account in the preparation of these designs. MiTek has not independently verified the applicability of the design parameters or the designs for any particular building. Before use, the building designer should verify applicability of design parameters and properly incorporate these designs into the overall building design per ANSI/TPI 1, Chapter 2.





RE: 3664536 - Summit/185 Highland Meadows

MiTek, Inc.
16023 Swingley Ridge Rd.
Chesterfield, MO 63017
314.434.1200

Site Information:

Project Customer: Project Name: 3664536

Lot/Block:

Subdivision:

Address:

City, County:

State:

No.	Seal#	Truss Name	Date
41	I58837528	J8	6/12/2023
42	I58837529	J9	6/12/2023
43	I58837530	J10	6/12/2023
44	I58837531	J11	6/12/2023
45	I58837532	J12	6/12/2023
46	I58837533	J13	6/12/2023
47	I58837534	J14	6/12/2023
48	I58837535	J15	6/12/2023
49	I58837536	J16	6/12/2023
50	I58837537	J17	6/12/2023
51	I58837538	J18	6/12/2023
52	I58837539	J19	6/12/2023
53	I58837540	J20	6/12/2023
54	I58837541	J21	6/12/2023
55	I58837542	J22	6/12/2023
56	I58837543	J23	6/12/2023
57	I58837544	J24	6/12/2023
58	I58837545	J25	6/12/2023
59	I58837546	J26	6/12/2023
60	I58837547	J27	6/12/2023
61	I58837548	J28	6/12/2023
62	I58837549	J29	6/12/2023
63	I58837550	L1	6/12/2023
64	I58837551	LG1	6/12/2023
65	I58837552	LG2	6/12/2023
66	I58837553	LG3	6/12/2023
67	I58837554	P1	6/12/2023
68	I58837555	P2	6/12/2023
69	I58837556	P3	6/12/2023
70	I58837557	P4	6/12/2023
71	I58837558	P5	6/12/2023
72	I58837559	P6	6/12/2023
73	I58837560	V1	6/12/2023
74	I58837561	V2	6/12/2023
75	I58837562	V3	6/12/2023

Job	Truss	Truss Type	Qty	Ply	Summit/185 Highland Meadows
3664536	A1	Hip Girder	1	1	

FOR CONSTRUCTION

AS NOTED FOR PLAN REVIEW

DEVELOPMENT SERVICES


LEE'S SUMMIT, MISSOURI

10/10/2023

Builders FirstSource (Valley Center), Valley Center, KS - 67147, 8.630 s Nov 19 2022 MiTek Industries, Inc. Thu Jun 21 14:12:37 2023 Page 1

ID:icBMJaMgT1gasuUyx9?RhvzDEhb-RfC?PsB70Hq3NSuPqnL8wGulTXbGKVICd7f7JzIC?P

Scale = 1:60.2

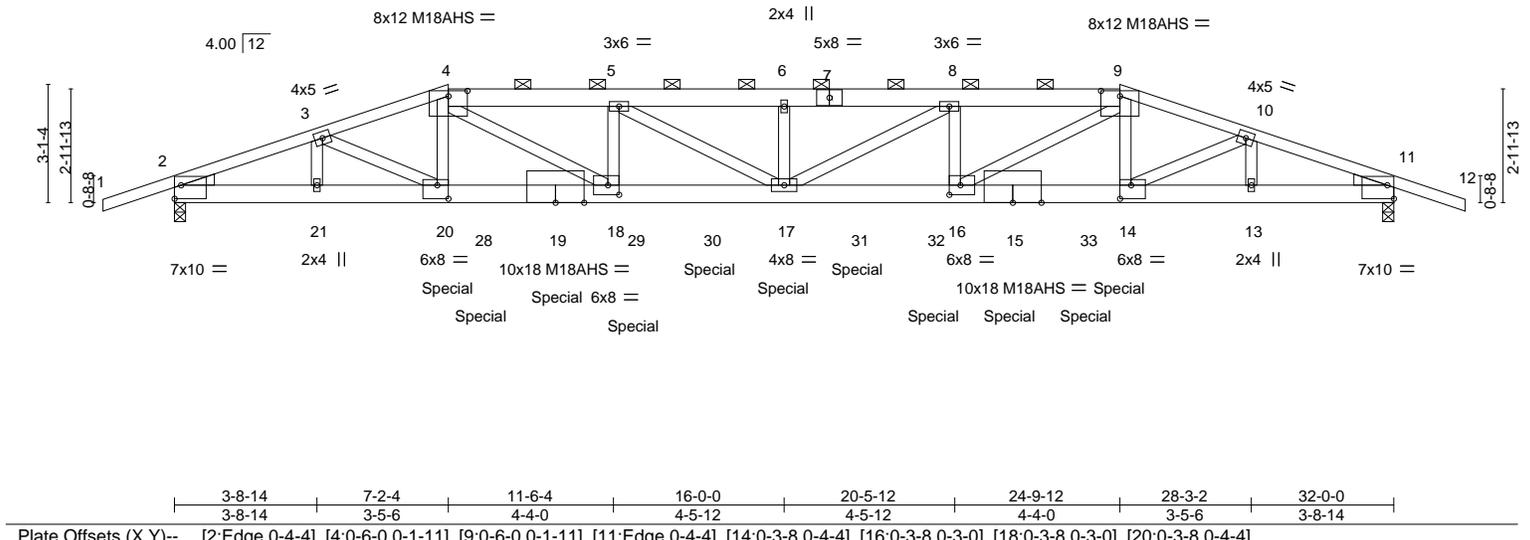

LOADING (psf)	SPACING-	CSI.	DEFL.	PLATES	GRIP
TCLL 25.0	Plate Grip DOL 1.15	TC 0.83	in (loc) l/defl L/d	MT20	197/144
TCDL 10.0	Lumber DOL 1.15	TC 0.96	Vert(LL) -0.59 17 >654 240	M18AHS	142/136
BCLL 0.0	Rep Stress Incr NO	WB 0.86	Vert(CT) -1.05 17 >365 180		
BCDL 10.0	Code IRC2018/TPI2014	Matrix-MS	Horz(CT) 0.17 11 n/a n/a		
				Weight: 174 lb	FT = 20%

LUMBER-
TOP CHORD 2x4 SP 2400F 2.0E *Except*
4-7,7-9: 2x6 SPF 2100F 1.8E
BOT CHORD 2x6 SP 2400F 2.0E *Except*
15-19: 2x6 SPF 2100F 1.8E
WEBS 2x4 SPF No.2
WEDGE
Left: 2x4 SPF No.2 , Right: 2x4 SPF No.2

BRACING-
TOP CHORD Structural wood sheathing directly applied or 2-0-13 oc purlins, except
2-0-0 oc purlins (2-4-1 max.): 4-9.
BOT CHORD Rigid ceiling directly applied or 6-3-10 oc bracing.

REACTIONS. (size) 2=0-3-8, 11=0-3-8
Max Horz 2=45(LC 25)
Max Uplift 2=790(LC 4), 11=790(LC 5)
Max Grav 2=3398(LC 1), 11=3398(LC 1)

FORCES. (lb) - Max. Comp./Max. Ten. - All forces 250 (lb) or less except when shown.
TOP CHORD 2-3=-7148/1577, 3-4=-8415/1909, 4-5=-10926/2522, 5-6=-11885/2732, 6-8=-11885/2732,
8-9=-10926/2522, 9-10=-8415/1910, 10-11=-7148/1578
BOT CHORD 2-21=-1466/6701, 20-21=-1466/6701, 18-20=-1762/7978, 17-18=-2452/10919,
16-17=-2421/10919, 14-16=-1717/7978, 13-14=-1422/6702, 11-13=-1422/6702
WEBS 3-21=-902/250, 3-20=-362/1573, 4-20=-122/682, 4-18=-847/3525, 5-18=-1162/314,
5-17=-325/1180, 6-17=-343/115, 8-17=-326/1179, 8-16=-1162/314, 9-16=-847/3524,
9-14=-122/682, 10-14=-363/1573, 10-13=-902/250

- NOTES-**
- Unbalanced roof live loads have been considered for this design.
 - Wind: ASCE 7-16; Vult=115mph (3-second gust) Vasd=91mph; TCDL=6.0psf; BCDL=4.2psf; h=15ft; Cat. II; Exp C; Enclosed; MWFRS (envelope) gable end zone; cantilever left and right exposed ; end vertical left and right exposed; Lumber DOL=1.60 plate grip DOL=1.60
 - Provide adequate drainage to prevent water ponding.
 - All plates are MT20 plates unless otherwise indicated.
 - This truss has been designed for a 10.0 psf bottom chord live load nonconcurrent with any other live loads.
 - Provide mechanical connection (by others) of truss to bearing plate capable of withstanding 790 lb uplift at joint 2 and 790 lb uplift at joint 11.
 - This truss is designed in accordance with the 2018 International Residential Code sections R502.11.1 and R802.10.2 and referenced standard ANSI/TPI 1.
 - Graphical purlin representation does not depict the size or the orientation of the purlin along the top and/or bottom chord.
 - Hanger(s) or other connection device(s) shall be provided sufficient to support concentrated load(s) 547 lb down and 132 lb up at 7-2-4, 284 lb down and 91 lb up at 8-0-12, 284 lb down and 91 lb up at 10-0-12, 284 lb down and 91 lb up at 12-0-12, 284 lb down and 91 lb up at 14-0-12, 284 lb down and 91 lb up at 16-0-0, 284 lb down and 91 lb up at 17-11-4, 284 lb down and 91 lb up at 19-11-4, 284 lb down and 91 lb up at 21-11-4, and 284 lb down and 91 lb up at 23-11-4, and 547 lb down and 132 lb up at 24-9-12 on bottom chord. The design/selection of such connection device(s) is the responsibility of others.
- On the CASE(S) section, loads applied to the face of the truss are noted as front (F) or back (B).



WARNING - Verify design parameters and READ NOTES ON THIS AND INCLUDED MITEK REFERENCE PAGE MII-7473 rev. 1/2/2023 BEFORE USE.

Design valid for use only with MiTek® connectors. This design is based only upon parameters shown, and is for an individual building component, not a truss system. Before use, the building designer must verify the applicability of design parameters and properly incorporate this design into the overall building design. Bracing indicated is to prevent buckling of individual truss web and/or chord members only. Additional temporary and permanent bracing is always required for stability and to prevent collapse with possible personal injury and property damage. For general guidance regarding the fabrication, storage, delivery, erection and bracing of trusses and truss systems, see **ANSI/TPI1 Quality Criteria, and DSB-22** available from Truss Plate Institute (www.tpinst.org) and **BCSI Building Component Safety Information** available from the Structural Building Component Association (www.sbcsccomponents.com)

MiTek®
16023 Swingley Ridge Rd.
Chesterfield, MO 63017
314.434.1200 / MiTek-US.com

Job	Truss	Truss Type	Qty	Ply	Summit/185 Highland Meadows	AS NOTED FOR PLAN REVIEW DEVELOPMENT SERVICES LEE'S SUMMIT, MISSOURI
3664536	A1	Hip Girder	1	1	Job Reference (optional)	15887488

Builders FirstSource (Valley Center), Valley Center, KS - 67147,

8.630 s Nov 19 2022 MiTek Industries, Inc. Thu Jun 23 14:12:37 2023 Page 2

ID:icBMJaMgT1gasuUyx9?RhvzDEHb-RfC?PsB70Hq3NSuPqnL8w3uITXbGKVICU7J4ZIC?10/10/2023

LOAD CASE(S) Standard

1) Dead + Roof Live (balanced): Lumber Increase=1.15, Plate Increase=1.15

Uniform Loads (plf)

Vert: 1-4=-70, 4-9=-70, 9-12=-70, 22-25=-20

Concentrated Loads (lb)

Vert: 19=-284(B) 20=-547(B) 17=-284(B) 14=-547(B) 15=-284(B) 28=-284(B) 29=-284(B) 30=-284(B) 31=-284(B) 32=-284(B) 33=-284(B)

WARNING - Verify design parameters and READ NOTES ON THIS AND INCLUDED MITEK REFERENCE PAGE MII-7473 rev. 1/2/2023 BEFORE USE.

Design valid for use only with MiTek® connectors. This design is based only upon parameters shown, and is for an individual building component, not a truss system. Before use, the building designer must verify the applicability of design parameters and properly incorporate this design into the overall building design. Bracing indicated is to prevent buckling of individual truss web and/or chord members only. Additional temporary and permanent bracing is always required for stability and to prevent collapse with possible personal injury and property damage. For general guidance regarding the fabrication, storage, delivery, erection and bracing of trusses and truss systems, see **ANSI/TPI1 Quality Criteria, and DSB-22** available from Truss Plate Institute (www.tpinst.org) and **BCSI Building Component Safety Information** available from the Structural Building Component Association (www.sbcsccomponents.com)

MiTek®


16023 Swingley Ridge Rd.
Chesterfield, MO 63017
314.434.1200 / MiTek-US.com

Job	Truss	Truss Type	Qty	Ply	Summit/185 Highland Meadows	AS NOTED FOR PLAN REVIEW DEVELOPMENT SERVICES LEE'S SUMMIT, MISSOURI
3664536	A2	Hip	1	1	Job Reference (optional)	58827489

Builders FirstSource (Valley Center), Valley Center, KS - 67147, 8.630 s Nov 19 2022 MiTek Industries, Inc. Thu Jun 21 14:12:38 2023 Page 1
 ID:icBMJaMgT1gasuUyx9?RhvzDEHb-RfC?PsB70Hq3NSpPqnL8wJlXbGKVICDg17JzICP PqnL8wJlXbGKVICDg17JzICP
 -1-10-8 | 5-7-6 | 9-2-4 | 16-0-0 | 22-9-12 | 26-4-10 | 32-0-0 | 33-10-8
 1-10-8 | 5-7-6 | 3-6-15 | 6-9-12 | 6-9-12 | 3-6-15 | 5-7-6 | 1-10-8

10/10/2023

Scale = 1:59.2

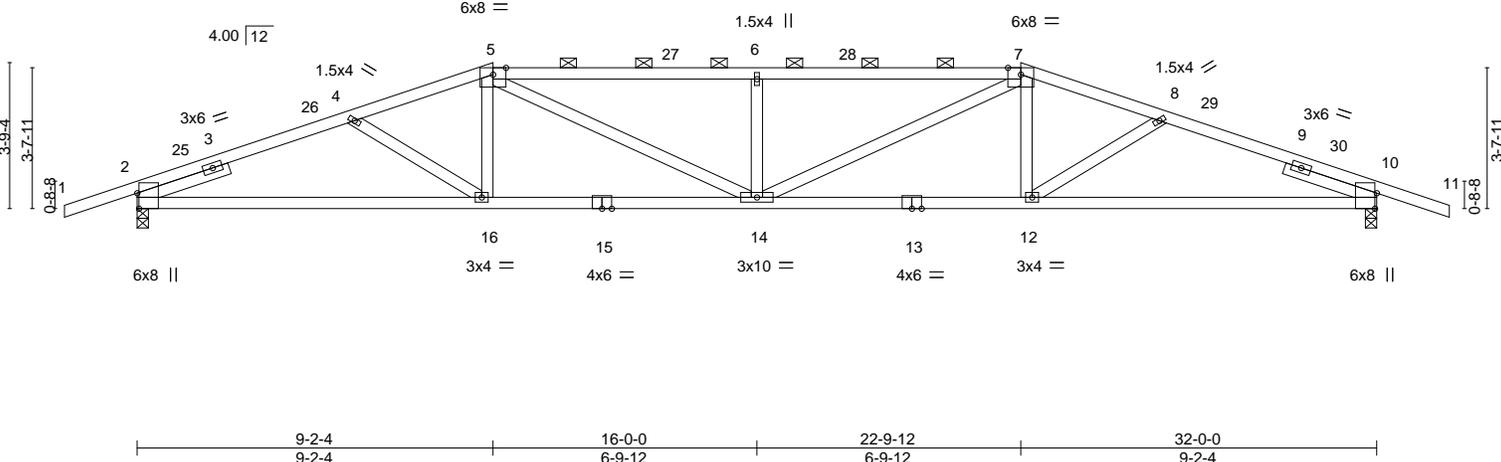

LOADING (psf)	SPACING-	2-0-0	CSI.	DEFL.	in (loc)	l/defl	L/d	PLATES	GRIP
TCLL 25.0	Plate Grip DOL	1.15	TC 0.76	Vert(LL)	-0.31	14	>999	MT20	197/144
TCDL 10.0	Lumber DOL	1.15	BC 0.97	Vert(CT)	-0.56	12-14	>692		
BCLL 0.0	Rep Stress Incr	YES	WB 0.23	Horz(CT)	0.14	10	n/a		
BCDL 10.0	Code IRC2018/TPI2014		Matrix-AS						
								Weight: 121 lb	FT = 20%

LUMBER-	BRACING-
TOP CHORD 2x4 SPF No.2 *Except* 5-7: 2x4 SPF 1650F 1.5E	TOP CHORD Structural wood sheathing directly applied, except 2-0-0 oc purlins (3-2-8 max.): 5-7.
BOT CHORD 2x4 SPF No.2	BOT CHORD Rigid ceiling directly applied.
WEBS 2x4 SPF No.2	
SLIDER Left 2x4 SPF No.2 2-6-0, Right 2x4 SPF No.2 2-6-0	

REACTIONS. (size) 2=0-3-8, 10=0-3-8
 Max Horz 2=-56(LC 13)
 Max Uplift 2=-313(LC 8), 10=-313(LC 9)
 Max Grav 2=1571(LC 1), 10=1571(LC 1)

FORCES. (lb) - Max. Comp./Max. Ten. - All forces 250 (lb) or less except when shown.
 TOP CHORD 2-4=-3016/623, 4-5=-2941/587, 5-6=-3516/725, 6-7=-3516/724, 7-8=-2941/587,
 8-10=-3016/623
 BOT CHORD 2-16=-508/2789, 14-16=-442/2792, 12-14=-450/2792, 10-12=-517/2789
 WEBS 5-16=0/261, 5-14=-197/947, 6-14=-574/195, 7-14=-197/947, 7-12=0/261

- NOTES-**
- 1) Unbalanced roof live loads have been considered for this design.
 - 2) Wind: ASCE 7-16; Vult=115mph (3-second gust) Vasd=91mph; TCDL=6.0psf; BCDL=4.2psf; h=15ft; Cat. II; Exp C; Enclosed; MWFRS (envelope) gable end zone and C-C Exterior(2E) -1-10-8 to 1-3-14, Interior(1) 1-3-14 to 9-2-4, Exterior(2R) 9-2-4 to 13-8-9, Interior(1) 13-8-9 to 22-9-12, Exterior(2R) 22-9-12 to 27-4-1, Interior(1) 27-4-1 to 33-10-8 zone; cantilever left and right exposed; end vertical left and right exposed; C-C for members and forces & MWFRS for reactions shown; Lumber DOL=1.60 plate grip DOL=1.60
 - 3) Provide adequate drainage to prevent water ponding.
 - 4) This truss has been designed for a 10.0 psf bottom chord live load nonconcurrent with any other live loads.
 - 5) Provide mechanical connection (by others) of truss to bearing plate capable of withstanding 313 lb uplift at joint 2 and 313 lb uplift at joint 10.
 - 6) This truss is designed in accordance with the 2018 International Residential Code sections R502.11.1 and R802.10.2 and referenced standard ANSI/TPI 1.
 - 7) This truss design requires that a minimum of 7/16" structural wood sheathing be applied directly to the top chord and 1/2" gypsum sheetrock be applied directly to the bottom chord.
 - 8) Graphical purlin representation does not depict the size or the orientation of the purlin along the top and/or bottom chord.



June 12, 2023

<p>WARNING - Verify design parameters and READ NOTES ON THIS AND INCLUDED MITEK REFERENCE PAGE MII-7473 rev. 1/2/2023 BEFORE USE.</p> <p>Design valid for use only with MiTek® connectors. This design is based only upon parameters shown, and is for an individual building component, not a truss system. Before use, the building designer must verify the applicability of design parameters and properly incorporate this design into the overall building design. Bracing indicated is to prevent buckling of individual truss web and/or chord members only. Additional temporary and permanent bracing is always required for stability and to prevent collapse with possible personal injury and property damage. For general guidance regarding the fabrication, storage, delivery, erection and bracing of trusses and truss systems, see ANSI/TPI1 Quality Criteria, and DSB-22 available from Truss Plate Institute (www.tpinst.org) and BCSI Building Component Safety Information available from the Structural Building Component Association (www.sbcsccomponents.com)</p>	 <p>16023 Swingley Ridge Rd. Chesterfield, MO 63017 314.434.1200 / MiTek-US.com</p>
---	--


Job	Truss	Truss Type	Qty	Ply	Summit/185 Highland Meadows	AS NOTED FOR PLAN REVIEW DEVELOPMENT SERVICES LEE'S SUMMIT, MISSOURI
3664536	A3	Hip	1	1	Job Reference (optional)	58827490

Builders FirstSource (Valley Center), Valley Center, KS - 67147,

8.630 s Nov 19 2022 MiTek Industries, Inc. Thu Jun 21 14:12:40 2023 Page 1

ID:icBMJaMgT1gasuUyx9?RhvzDEHb-RfC?PsB70Hq3NSpPqnL8wGulTxbGKwCtGf74ZICP2

10/10/2023

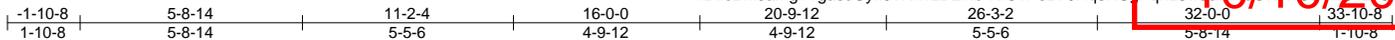

Scale = 1:59.2

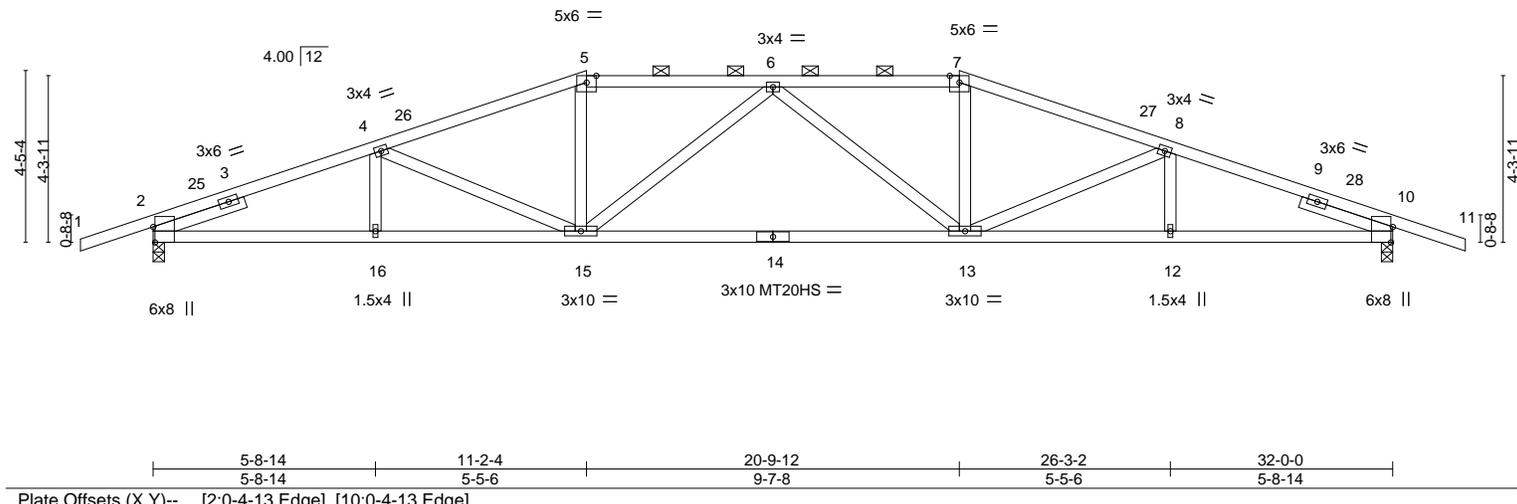


Plate Offsets (X,Y)--	[2:0-4-13,Edge], [10:0-4-13,Edge]				
LOADING (psf)	SPACING- 2-0-0	CSI.	DEFL. in (loc) l/defl L/d	PLATES	GRIP
TCLL 25.0	Plate Grip DOL 1.15	TC 0.76	Vert(LL) -0.27 13-15 >999 240	MT20	197/144
TCDL 10.0	Lumber DOL 1.15	BC 0.92	Vert(CT) -0.64 13-15 >605 180	MT20HS	148/108
BCLL 0.0	Rep Stress Incr YES	WB 0.34	Horz(CT) 0.14 10 n/a n/a		
BCDL 10.0	Code IRC2018/TPI2014	Matrix-AS		Weight: 125 lb	FT = 20%

LUMBER-	BRACING-
TOP CHORD 2x4 SPF No.2	TOP CHORD Structural wood sheathing directly applied, except
BOT CHORD 2x4 SPF 1650F 1.5E	2-0-0 oc purlins (3-5-3 max.): 5-7.
WEBS 2x4 SPF No.2	BOT CHORD Rigid ceiling directly applied.
SLIDER Left 2x4 SPF No.2 2-6-0, Right 2x4 SPF No.2 2-6-0	

REACTIONS. (size) 2=0-3-8, 10=0-3-8
 Max Horz 2=-67(LC 17)
 Max Uplift 2=-305(LC 8), 10=-305(LC 9)
 Max Grav 2=1571(LC 1), 10=1571(LC 1)

FORCES. (lb) - Max. Comp./Max. Ten. - All forces 250 (lb) or less except when shown.
 TOP CHORD 2-4=-3035/617, 4-5=-2789/576, 5-6=-2605/575, 6-7=-2605/575, 7-8=-2789/576, 8-10=-3035/617
 BOT CHORD 2-16=-506/2817, 15-16=-506/2817, 13-15=-496/2841, 12-13=-515/2817, 10-12=-515/2817
 WEBS 4-15=-258/131, 5-15=-37/478, 6-15=-471/148, 6-13=-471/148, 7-13=-37/478, 8-13=-258/132

- NOTES-**
- Unbalanced roof live loads have been considered for this design.
 - Wind: ASCE 7-16; Vult=115mph (3-second gust) Vasd=91mph; TCDL=6.0psf; BCDL=4.2psf; h=15ft; Cat. II; Exp C; Enclosed; MWFRS (envelope) gable end zone and C-C Exterior(2E) -1-10-8 to 1-3-14, Interior(1) 1-3-14 to 11-2-4, Exterior(2R) 11-2-4 to 16-0-0, Interior(1) 16-0-0 to 20-9-12, Exterior(2R) 20-9-12 to 25-4-1, Interior(1) 25-4-1 to 33-10-8 zone; cantilever left and right exposed; end vertical left and right exposed; C-C for members and forces & MWFRS for reactions shown; Lumber DOL=1.60 plate grip DOL=1.60
 - Provide adequate drainage to prevent water ponding.
 - All plates are MT20 plates unless otherwise indicated.
 - This truss has been designed for a 10.0 psf bottom chord live load nonconcurrent with any other live loads.
 - Provide mechanical connection (by others) of truss to bearing plate capable of withstanding 305 lb uplift at joint 2 and 305 lb uplift at joint 10.
 - This truss is designed in accordance with the 2018 International Residential Code sections R502.11.1 and R802.10.2 and referenced standard ANSI/TPI 1.
 - This truss design requires that a minimum of 7/16" structural wood sheathing be applied directly to the top chord and 1/2" gypsum sheetrock be applied directly to the bottom chord.
 - Graphical purlin representation does not depict the size or the orientation of the purlin along the top and/or bottom chord.



June 12, 2023


<p>WARNING - Verify design parameters and READ NOTES ON THIS AND INCLUDED MITEK REFERENCE PAGE MII-7473 rev. 1/2/2023 BEFORE USE.</p> <p>Design valid for use only with MiTek® connectors. This design is based only upon parameters shown, and is for an individual building component, not a truss system. Before use, the building designer must verify the applicability of design parameters and properly incorporate this design into the overall building design. Bracing indicated is to prevent buckling of individual truss web and/or chord members only. Additional temporary and permanent bracing is always required for stability and to prevent collapse with possible personal injury and property damage. For general guidance regarding the fabrication, storage, delivery, erection and bracing of trusses and truss systems, see ANSI/TPI1 Quality Criteria, and DSB-22 available from Truss Plate Institute (www.tpinst.org) and BCSI Building Component Safety Information available from the Structural Building Component Association (www.sbcsccomponents.com)</p>	<p>16023 Swingley Ridge Rd. Chesterfield, MO 63017 314.434.1200 / MiTek-US.com</p>
---	--

Job	Truss	Truss Type	Qty	Ply	Summit/185 Highland Meadows	AS NOTED FOR PLAN REVIEW DEVELOPMENT SERVICES LEE'S SUMMIT, MISSOURI
3664536	A4	Hip	1	1	Job Reference (optional)	5887491

Builders FirstSource (Valley Center), Valley Center, KS - 67147, 8.630 s Nov 19 2022 MiTek Industries, Inc. Thu Jun 14 12:41:2023 Page 1
 ID:icBMJaMgT1gasuUyx9?RhvzDEHb-RIC?PsB70Hq3NSpPqnL8WgUlTXbGKVCdGf74ZICP2 PqnL8WgUlTXbGKVCdGf74ZICP2
 -1-10-8 | 6-8-14 | 13-2-4 | 18-9-12 | 25-3-2 | 32-0-0 | 33-10-8
 1-10-8 | 6-8-14 | 6-5-6 | 5-7-8 | 6-5-6 | 6-8-14 | 1-10-8

10/10/2023

Scale = 1:59.2

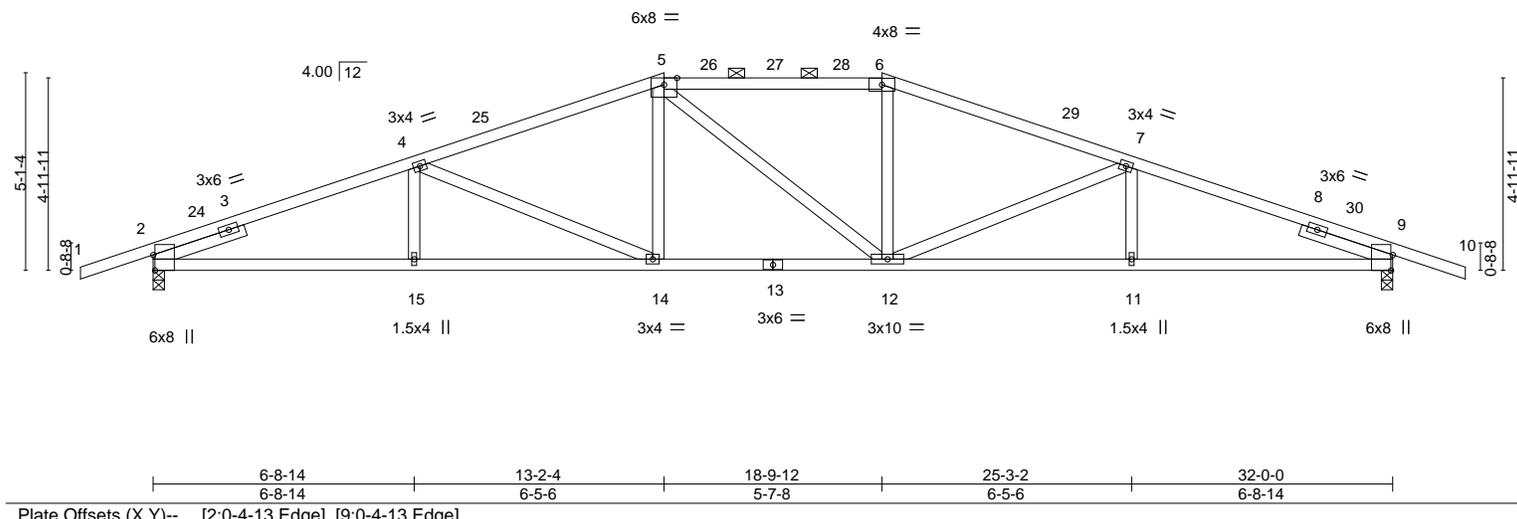

LOADING (psf)	SPACING-	2-0-0	CSI.	DEFL.	in (loc)	l/defl	L/d	PLATES	GRIP
TCLL 25.0	Plate Grip DOL	1.15	TC 0.87	Vert(LL)	-0.25 14-15	>999	240	MT20	197/144
TCDL 10.0	Lumber DOL	1.15	BC 0.80	Vert(CT)	-0.47 14-15	>816	180		
BCLL 0.0	Rep Stress Incr	YES	WB 0.44	Horz(CT)	0.14 9	n/a	n/a		
BCDL 10.0	Code IRC2018/TPI2014		Matrix-AS					Weight: 124 lb	FT = 20%

LUMBER-	BRACING-
TOP CHORD 2x4 SPF No.2	TOP CHORD Structural wood sheathing directly applied, except
BOT CHORD 2x4 SPF 1650F 1.5E	2-0-0 oc purlins (3-6-2 max.): 5-6.
WEBS 2x4 SPF No.2	BOT CHORD Rigid ceiling directly applied.
SLIDER Left 2x4 SPF No.2 2-6-0, Right 2x4 SPF No.2 2-6-0	

REACTIONS. (size) 2=0-3-8, 9=0-3-8
 Max Horz 2=78(LC 16)
 Max Uplift 2=-295(LC 8), 9=-295(LC 9)
 Max Grav 2=1571(LC 1), 9=1571(LC 1)

FORCES. (lb) - Max. Comp./Max. Ten. - All forces 250 (lb) or less except when shown.
 TOP CHORD 2-4=-3067/618, 4-5=-2579/563, 5-6=-2383/570, 6-7=-2579/563, 7-9=-3067/618
 BOT CHORD 2-15=-501/2846, 14-15=-501/2846, 12-14=-380/2382, 11-12=-510/2846, 9-11=-510/2846
 WEBS 4-14=-542/169, 5-14=-17/384, 6-12=-14/384, 7-12=-541/170

- NOTES-**
- 1) Unbalanced roof live loads have been considered for this design.
 - 2) Wind: ASCE 7-16; Vult=115mph (3-second gust) Vasd=91mph; TCDL=6.0psf; BCDL=4.2psf; h=15ft; Cat. II; Exp C; Enclosed; MWFRS (envelope) gable end zone and C-C Exterior(2E) -1-10-8 to 1-3-14, Interior(1) 1-3-14 to 13-2-4, Exterior(2R) 13-2-4 to 17-8-9, Interior(1) 17-8-9 to 18-9-12, Exterior(2R) 18-9-12 to 23-4-1, Interior(1) 23-4-1 to 33-10-8 zone; cantilever left and right exposed ; end vertical left and right exposed; C-C for members and forces & MWFRS for reactions shown; Lumber DOL=1.60 plate grip DOL=1.60
 - 3) Provide adequate drainage to prevent water ponding.
 - 4) This truss has been designed for a 10.0 psf bottom chord live load nonconcurrent with any other live loads.
 - 5) Provide mechanical connection (by others) of truss to bearing plate capable of withstanding 295 lb uplift at joint 2 and 295 lb uplift at joint 9.
 - 6) This truss is designed in accordance with the 2018 International Residential Code sections R502.11.1 and R802.10.2 and referenced standard ANSI/TPI 1.
 - 7) This truss design requires that a minimum of 7/16" structural wood sheathing be applied directly to the top chord and 1/2" gypsum sheetrock be applied directly to the bottom chord.
 - 8) Graphical purlin representation does not depict the size or the orientation of the purlin along the top and/or bottom chord.



June 12, 2023

Job 3664536	Truss A6	Truss Type Hip	Qty 1	Ply 1	Summit/185 Highland Meadows
----------------	-------------	-------------------	----------	----------	-----------------------------

RELEASE FOR CONSTRUCTION

AS NOTED FOR PLAN REVIEW

DEVELOPMENT SERVICES

LEE'S SUMMIT, MISSOURI

10/10/2023

Builders FirstSource (Valley Center), Valley Center, KS - 67147, 8.630 s Nov 19 2022 MiTek Industries, Inc. Thu Jun 21 14:12:44 2023 Page 1

ID:icBMJaMgT1gasuUyx9?RhvzDEHb-RIC?PsB70Hq3NSyPqnL8WgUlTxbGKVICd7f7JzJICP2

Scale = 1:58.2

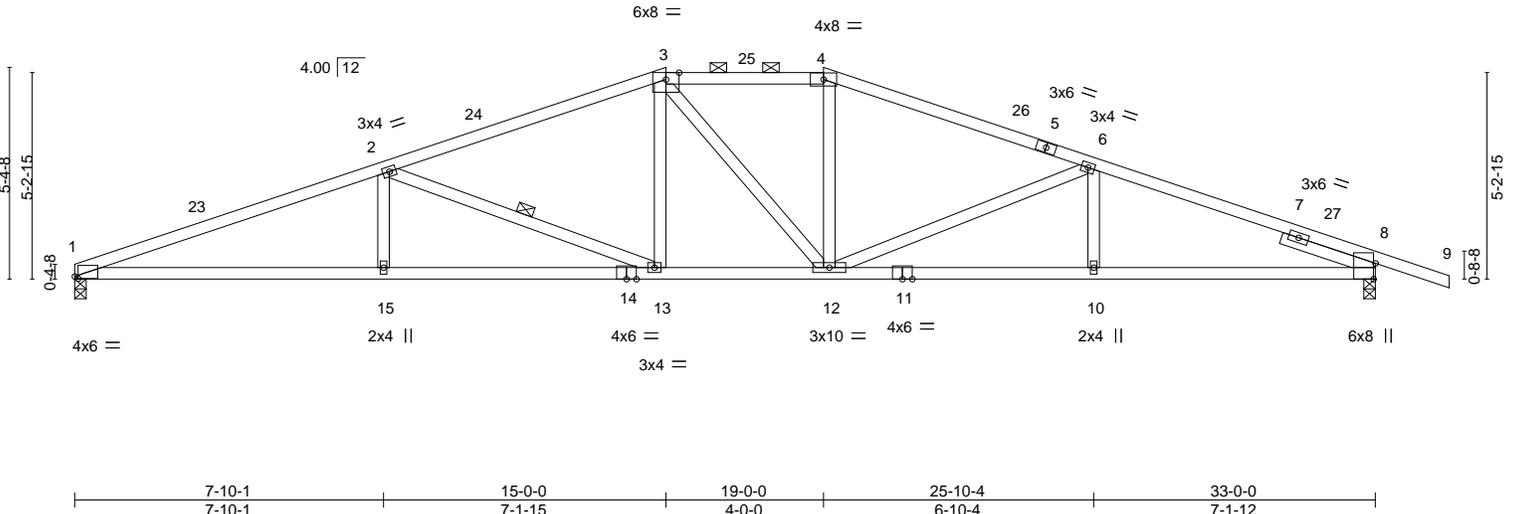


Plate Offsets (X,Y)--	[1:0-1-1,0-0-10], [8:0-4-13,Edge]
-----------------------	-----------------------------------

LOADING (psf)	SPACING-	CSI.	DEFL.	PLATES	GRIP
TCLL 25.0	2-0-0	TC 0.96	in (loc) l/defl L/d	MT20	197/144
TCDL 10.0	Plate Grip DOL 1.15	BC 0.99	Vert(LL) -0.28 10-12 >999 240		
BCLL 0.0	Lumber DOL 1.15	WB 0.59	Vert(CT) -0.53 10-12 >745 180		
BCDL 10.0	Rep Stress Incr YES	Matrix-AS	Horz(CT) 0.17 8 n/a n/a		
	Code IRC2018/TPI2014			Weight: 122 lb	FT = 20%

LUMBER-	BRACING-
TOP CHORD 2x4 SPF No.2	TOP CHORD Structural wood sheathing directly applied, except
BOT CHORD 2x4 SPF No.2 *Except* 8-11: 2x4 SPF 1650F 1.5E	2-0-0 oc purlins (3-5-11 max.): 3-4.
WEBS 2x4 SPF No.2	BOT CHORD Rigid ceiling directly applied.
SLIDER Right 2x4 SPF No.2 2-6-0	WEBS 1 Row at midpt 2-13

REACTIONS. (size) 1=0-3-8, 8=0-3-8
 Max Horz 1=-89(LC 17)
 Max Uplift 1=-229(LC 8), 8=-295(LC 9)
 Max Grav 1=1481(LC 1), 8=1620(LC 1)

FORCES. (lb) - Max. Comp./Max. Ten. - All forces 250 (lb) or less except when shown.
 TOP CHORD 1-2=-3705/723, 2-3=-2674/581, 3-4=-2422/561, 4-6=-2630/564, 6-8=-3195/613
 BOT CHORD 1-15=-612/3449, 13-15=-612/3449, 12-13=-386/2448, 10-12=-503/2965, 8-10=-503/2965
 WEBS 2-15=0/310, 2-13=-1073/259, 3-13=-44/482, 3-12=-266/205, 4-12=-35/399,
 6-12=-641/189

- NOTES-**
- 1) Unbalanced roof live loads have been considered for this design.
 - 2) Wind: ASCE 7-16; Vult=115mph (3-second gust) Vasd=91mph; TCDL=6.0psf; BCDL=4.2psf; h=15ft; Cat. II; Exp C; Enclosed; MWFRS (envelope) gable end zone and C-C Exterior(2E) 0-0-0 to 3-3-10, Interior(1) 3-3-10 to 15-0-0, Exterior(2E) 15-0-0 to 19-0-0, Exterior(2R) 19-0-0 to 23-8-0, Interior(1) 23-8-0 to 34-10-8 zone; cantilever left and right exposed; end vertical left and right exposed; C-C for members and forces & MWFRS for reactions shown; Lumber DOL=1.60 plate grip DOL=1.60
 - 3) Provide adequate drainage to prevent water ponding.
 - 4) This truss has been designed for a 10.0 psf bottom chord live load nonconcurrent with any other live loads.
 - 5) Provide mechanical connection (by others) of truss to bearing plate capable of withstanding 229 lb uplift at joint 1 and 295 lb uplift at joint 8.
 - 6) This truss is designed in accordance with the 2018 International Residential Code sections R502.11.1 and R802.10.2 and referenced standard ANSI/TPI 1.
 - 7) This truss design requires that a minimum of 7/16" structural wood sheathing be applied directly to the top chord and 1/2" gypsum sheetrock be applied directly to the bottom chord.
 - 8) Graphical purlin representation does not depict the size or the orientation of the purlin along the top and/or bottom chord.



June 12, 2023


WARNING - Verify design parameters and READ NOTES ON THIS AND INCLUDED MITEK REFERENCE PAGE MII-7473 rev. 1/2/2023 BEFORE USE.

Design valid for use only with MiTek® connectors. This design is based only upon parameters shown, and is for an individual building component, not a truss system. Before use, the building designer must verify the applicability of design parameters and properly incorporate this design into the overall building design. Bracing indicated is to prevent buckling of individual truss web and/or chord members only. Additional temporary and permanent bracing is always required for stability and to prevent collapse with possible personal injury and property damage. For general guidance regarding the fabrication, storage, delivery, erection and bracing of trusses and truss systems, see **ANSI/TPI1 Quality Criteria, and DSB-22** available from Truss Plate Institute (www.tpinst.org) and **BCSI Building Component Safety Information** available from the Structural Building Component Association (www.sbcsccomponents.com)


MiTek®
 16023 Swingley Ridge Rd.
 Chesterfield, MO 63017
 314.434.1200 / MiTek-US.com

Job 3664536	Truss A7	Truss Type Hip	Qty 1	Ply 1	Summit/185 Highland Meadows	AS NOTED FOR PLAN REVIEW DEVELOPMENT SERVICES LEE'S SUMMIT, MISSOURI
----------------	-------------	-------------------	----------	----------	-----------------------------	--

58827494
10/10/2023

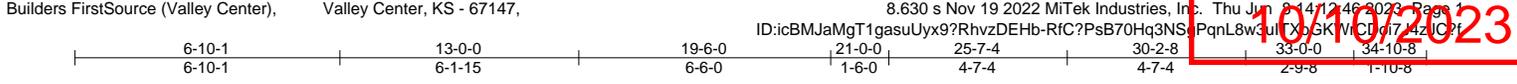

Scale = 1:59.2

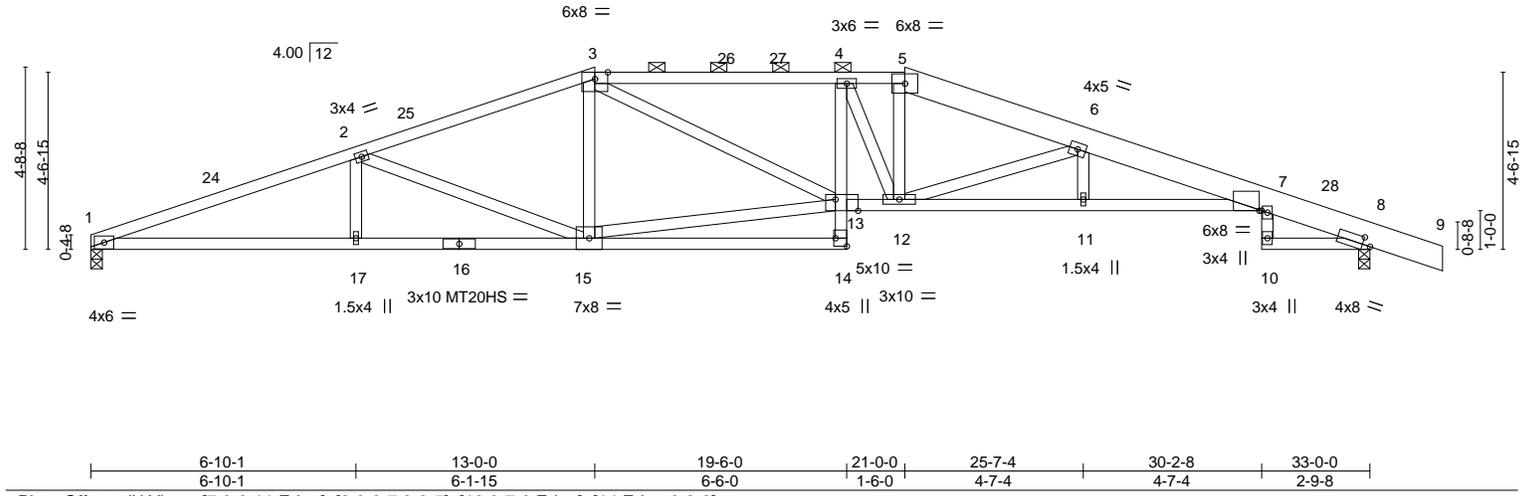

LOADING (psf)	SPACING- 2-0-0	CSI.	DEFL.	in (loc)	l/defl	L/d	PLATES	GRIP
TCLL 25.0	Plate Grip DOL 1.15	TC 0.84	Vert(LL)	-0.44	12-13	>903	240	240
TCDL 10.0	Lumber DOL 1.15	BC 0.93	Vert(CT)	-0.79	12-13	>501	180	180
BCLL 0.0	Rep Stress Incr YES	WB 0.73	Horz(CT)	0.35	8	n/a	n/a	n/a
BCDL 10.0	Code IRC2018/TPI2014	Matrix-AS						
							Weight: 160 lb	FT = 20%

LUMBER-	BRACING-
TOP CHORD 2x4 SPF No.2 *Except* 5-9: 2x8 SP 2400F 2.0E	TOP CHORD Structural wood sheathing directly applied, except 2-0-0 oc purlins (2-2-0 max.): 3-5.
BOT CHORD 2x4 SPF No.2 *Except* 7-13: 2x4 SP 2400F 2.0E	BOT CHORD Rigid ceiling directly applied.
WEBS 2x4 SPF No.2	

REACTIONS. (size) 1=0-3-8, 8=0-3-8
 Max Horz 1=-82(LC 17)
 Max Uplift 1=-239(LC 8), 8=-306(LC 9)
 Max Grav 1=1481(LC 1), 8=1620(LC 1)

FORCES. (lb) - Max. Comp./Max. Ten. - All forces 250 (lb) or less except when shown.
 TOP CHORD 1-2=-3763/742, 2-3=-2975/627, 3-4=-3587/788, 4-5=-3468/741, 5-6=-3675/749,
 6-7=-5115/1003, 7-8=-570/154
 BOT CHORD 1-17=-631/3511, 15-17=-631/3511, 14-15=-30/375, 12-13=-607/3586, 11-12=-905/5010,
 7-11=-906/5011
 WEBS 2-15=-820/224, 13-15=-423/2414, 3-13=-189/1038, 4-12=-429/124, 5-12=-200/1053,
 6-12=-1688/366

- NOTES-**
- 1) Unbalanced roof live loads have been considered for this design.
 - 2) Wind: ASCE 7-16; Vult=115mph (3-second gust) Vasd=91mph; TCDL=6.0psf; BCDL=4.2psf; h=15ft; Cat. II; Exp C; Enclosed; MWFRS (envelope) gable end zone and C-C Exterior(2E) 0-0-0 to 3-3-10, Interior(1) 3-3-10 to 13-0-0, Exterior(2R) 13-0-0 to 17-8-0, Interior(1) 17-8-0 to 21-0-0, Exterior(2R) 21-0-0 to 25-7-4, Interior(1) 25-7-4 to 34-10-8 zone; cantilever left and right exposed ; end vertical left and right exposed;C-C for members and forces & MWFRS for reactions shown; Lumber DOL=1.60 plate grip DOL=1.60
 - 3) Provide adequate drainage to prevent water ponding.
 - 4) All plates are MT20 plates unless otherwise indicated.
 - 5) This truss has been designed for a 10.0 psf bottom chord live load nonconcurrent with any other live loads.
 - 6) Provide mechanical connection (by others) of truss to bearing plate capable of withstanding 239 lb uplift at joint 1 and 306 lb uplift at joint 8.
 - 7) This truss is designed in accordance with the 2018 International Residential Code sections R502.11.1 and R802.10.2 and referenced standard ANSI/TPI 1.
 - 8) This truss design requires that a minimum of 7/16" structural wood sheathing be applied directly to the top chord and 1/2" gypsum sheetrock be applied directly to the bottom chord.
 - 9) Graphical purlin representation does not depict the size or the orientation of the purlin along the top and/or bottom chord.




June 12, 2023

Job 3664536	Truss A9	Truss Type HIP GIRDER	Qty 1	Ply 3	Summit/185 Highland Meadows	AS NOTED FOR PLAN REVIEW DEVELOPMENT SERVICES LEE'S SUMMIT, MISSOURI
----------------	-------------	--------------------------	----------	----------	-----------------------------	--

AS NOTED FOR PLAN REVIEW
DEVELOPMENT SERVICES
LEE'S SUMMIT, MISSOURI

10/10/2023

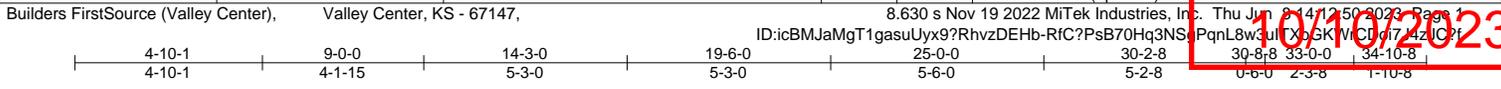

Scale = 1:59.2

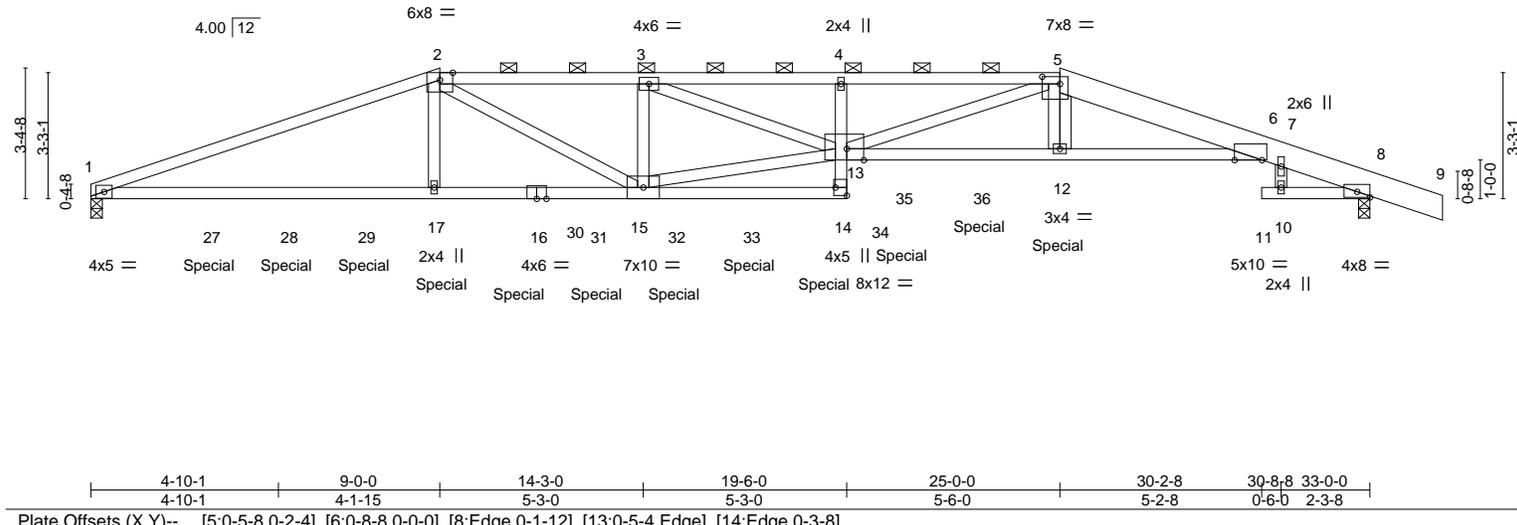


Plate Offsets (X, Y)-- [5:0-5-8,0-2-4], [6:0-8-8,0-0-0], [8:Edge,0-1-12], [13:0-5-4,Edge], [14:Edge,0-3-8]

LOADING (psf)	SPACING-	CSI.	DEFL.	PLATES	GRIP
TCLL 25.0	2-0-0	TC 0.82	in (loc) l/defl L/d	MT20	197/144
TCDL 10.0	Plate Grip DOL 1.15	BC 0.95	Vert(LL) -0.58 12-13 >677 240		
BCLL 0.0	Lumber DOL 1.15	WB 0.86	Vert(CT) -1.05 12-13 >377 180		
BCDL 10.0	Rep Stress Incr NO	Matrix-MS	Horz(CT) 0.33 8 n/a n/a		
	Code IRC2018/TPI2014			Weight: 445 lb	FT = 20%

LUMBER-	BRACING-
TOP CHORD 2x4 SP 2400F 2.0E *Except*	TOP CHORD Structural wood sheathing directly applied or 6-0-0 oc purlins, except
2-5: 2x4 SPF 1650F 1.5E, 5-9: 2x8 SP 2400F 2.0E	2-0-0 oc purlins (5-10-8 max.): 2-5.
BOT CHORD 2x4 SPF No.2 *Except*	BOT CHORD Rigid ceiling directly applied or 10-0-0 oc bracing.
1-16,6-13: 2x4 SP 2400F 2.0E	
WEBS 2x4 SPF No.2	

REACTIONS.
(size) 1=0-3-8, 8=0-3-8
Max Horz 1=61(LC 34)
Max Uplift 1=860(LC 4), 8=888(LC 5)
Max Grav 1=3925(LC 1), 8=3775(LC 1)

FORCES.
(lb) - Max. Comp./Max. Ten. - All forces 250 (lb) or less except when shown.
TOP CHORD 1-2=-10084/2273, 2-3=-11591/2700, 3-4=-16697/3842, 4-5=-17203/3957,
5-6=-14118/3202, 6-7=-1082/306, 7-8=-1211/319
BOT CHORD 1-17=-2114/9530, 15-17=-2102/9461, 14-15=-315/1398, 13-14=-129/614, 4-13=-289/166,
12-13=-3003/13692, 6-12=-3003/13692
WEBS 2-17=-252/1433, 2-15=-677/2682, 3-15=-2455/606, 13-15=-2376/10505, 3-13=-1211/5336,
5-13=-932/3887, 5-12=-390/1845, 7-10=-47/298

- NOTES-**
- 1) 3-ply truss to be connected together with 10d (0.131"x3") nails as follows:
Top chords connected as follows: 2x4 - 1 row at 0-7-0 oc, 2x8 - 2 rows staggered at 0-9-0 oc.
Bottom chords connected as follows: 2x4 - 2 rows staggered at 0-7-0 oc.
Webs connected as follows: 2x4 - 1 row at 0-9-0 oc.
 - 2) All loads are considered equally applied to all plies, except if noted as front (F) or back (B) face in the LOAD CASE(S) section. Ply to ply connections have been provided to distribute only loads noted as (F) or (B), unless otherwise indicated.
 - 3) Unbalanced roof live loads have been considered for this design.
 - 4) Wind: ASCE 7-16; Vult=115mph (3-second gust) Vasd=91mph; TCDL=6.0psf; BCDL=4.2psf; h=15ft; Cat. II; Exp C; Enclosed; MWFRS (envelope) gable end zone; cantilever left and right exposed; end vertical left and right exposed; Lumber DOL=1.60 plate grip DOL=1.60
 - 5) Provide adequate drainage to prevent water ponding.
 - 6) This truss has been designed for a 10.0 psf bottom chord live load nonconcurrent with any other live loads.
 - 7) Provide mechanical connection (by others) of truss to bearing plate capable of withstanding 860 lb uplift at joint 1 and 888 lb uplift at joint 8.
 - 8) This truss is designed in accordance with the 2018 International Residential Code sections R502.11.1 and R802.10.2 and referenced standard ANSI/TPI 1.
 - 9) Graphical purlin representation does not depict the size or the orientation of the purlin along the top and/or bottom chord.



June 12, 2023

Continued on page 2

<p>WARNING - Verify design parameters and READ NOTES ON THIS AND INCLUDED MITEK REFERENCE PAGE MII-7473 rev. 1/2/2023 BEFORE USE.</p> <p>Design valid for use only with MiTek® connectors. This design is based only upon parameters shown, and is for an individual building component, not a truss system. Before use, the building designer must verify the applicability of design parameters and properly incorporate this design into the overall building design. Bracing indicated is to prevent buckling of individual truss web and/or chord members only. Additional temporary and permanent bracing is always required for stability and to prevent collapse with possible personal injury and property damage. For general guidance regarding the fabrication, storage, delivery, erection and bracing of trusses and truss systems, see ANSI/TPI1 Quality Criteria, and DSB-22 available from Truss Plate Institute (www.tpinst.org) and BCSI Building Component Safety Information available from the Structural Building Component Association (www.sbcsccomponents.com)</p>	 <p>16023 Swingley Ridge Rd. Chesterfield, MO 63017 314.434.1200 / MiTek-US.com</p>
---	--

Job	Truss	Truss Type	Qty	Ply	Summit/185 Highland Meadows
3664536	A9	HIP GIRDER	1	3	Job Reference (optional)

RELEASE FOR CONSTRUCTION
AS NOTED FOR PLAN REVIEW
DEVELOPMENT SERVICES
LEE'S SUMMIT, MISSOURI

Builders FirstSource (Valley Center), Valley Center, KS - 67147,

8.630 s Nov 19 2022 MiTek Industries, Inc. Thu Jun 23 14:12:50 2023 Page 2

ID:icBMJaMgT1gasuUyx9?RhvzDEHb-RfC?PsB70Hq3NSpPqnL8w3ulTxbGKVICDm7JzZIC?10/10/2023

NOTES-

10) Hanger(s) or other connection device(s) shall be provided sufficient to support concentrated load(s) 379 lb down and 89 lb up at 3-0-12, 323 lb down and 79 lb up at 5-0-12, 323 lb down and 79 lb up at 7-0-12, 323 lb down and 100 lb up at 9-0-12, 323 lb down and 100 lb up at 11-0-12, 323 lb down and 100 lb up at 13-0-12, 323 lb down and 100 lb up at 15-0-12, 323 lb down and 100 lb up at 17-0-0, 323 lb down and 100 lb up at 18-11-4, 323 lb down and 99 lb up at 20-11-4, and 323 lb down and 99 lb up at 22-11-4, and 989 lb down and 281 lb up at 24-11-4 on bottom chord. The design/selection of such connection device(s) is the responsibility of others.

LOAD CASE(S) Standard

1) Dead + Roof Live (balanced): Lumber Increase=1.15, Plate Increase=1.15

Uniform Loads (plf)

Vert: 1-2=-70, 2-5=-70, 5-9=-70, 14-18=-20, 13-21=-20, 11-24=-20

Concentrated Loads (lb)

Vert: 17=-323(F) 12=-989(F) 27=-379(F) 28=-323(F) 29=-323(F) 30=-323(F) 31=-323(F) 32=-323(F) 33=-323(F) 34=-323(F) 35=-323(F) 36=-323(F)

WARNING - Verify design parameters and READ NOTES ON THIS AND INCLUDED MITEK REFERENCE PAGE MII-7473 rev. 1/2/2023 BEFORE USE.

Design valid for use only with MiTek® connectors. This design is based only upon parameters shown, and is for an individual building component, not a truss system. Before use, the building designer must verify the applicability of design parameters and properly incorporate this design into the overall building design. Bracing indicated is to prevent buckling of individual truss web and/or chord members only. Additional temporary and permanent bracing is always required for stability and to prevent collapse with possible personal injury and property damage. For general guidance regarding the fabrication, storage, delivery, erection and bracing of trusses and truss systems, see **ANSI/TPI1 Quality Criteria, and DSB-22** available from Truss Plate Institute (www.tpinst.org) and **BCSI Building Component Safety Information** available from the Structural Building Component Association (www.sbcsccomponents.com)

MiTek®

16023 Swingley Ridge Rd.
Chesterfield, MO 63017
314.434.1200 / MiTek-US.com

Job 3664536	Truss B1	Truss Type Roof Special	Qty 1	Ply 1	Summit/185 Highland Meadows	AS NOTED FOR PLAN REVIEW DEVELOPMENT SERVICES LEE'S SUMMIT, MISSOURI
----------------	-------------	----------------------------	----------	----------	-----------------------------	--

Builders FirstSource (Valley Center), Valley Center, KS - 67147,

8.630 s Nov 19 2022 MiTek Industries, Inc. Thu Jun 1 14 12 52 2023 Page 1

Job Reference (optional)



10/10/2023

Scale: 3/16"=1'

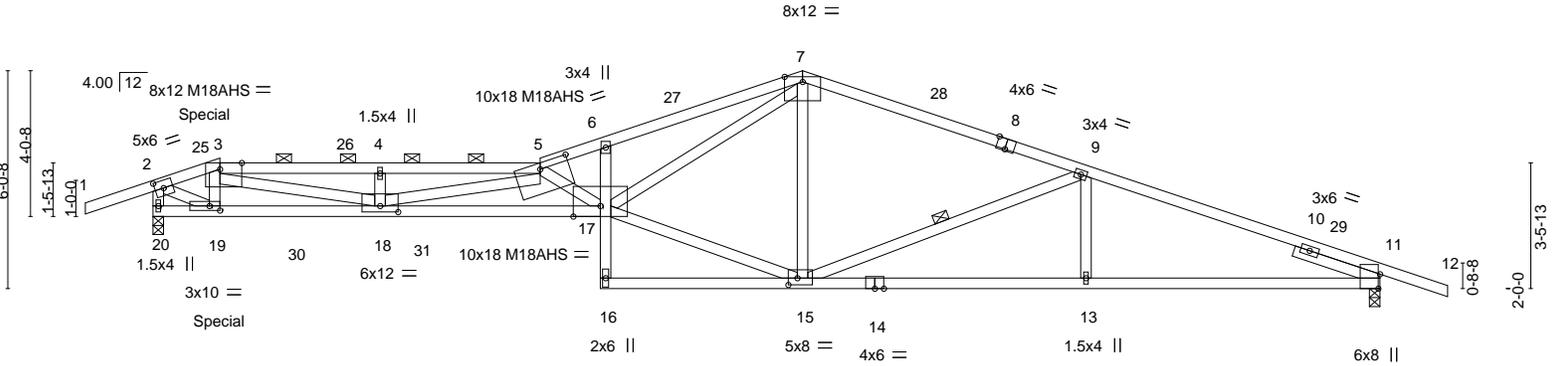


Plate Offsets (X, Y)--	[2:0-2-14,0-2-8], [3:0-7-4,Edge], [5:0-9-8,0-2-0], [8:0-3-0,Edge], [11:0-4-13,Edge], [15:0-3-0,0-2-4], [18:0-6-0,0-2-0], [19:0-3-8,0-1-8]
------------------------	---

LOADING (psf)	SPACING-	2-0-0	CSI.	DEFL.	in (loc)	l/defl	L/d	PLATES	GRIP
TCLL 25.0	Plate Grip DOL	1.15	TC 0.82	Vert(LL)	-0.80 17	>511	240	MT20	197/144
TCDL 10.0	Lumber DOL	1.15	BC 0.89	Vert(CT)	-1.43 17-18	>284	180	M18AHS	142/136
BCLL 0.0	Rep Stress Incr	YES	WB 0.72	Horz(CT)	0.26 11	n/a	n/a		
BCDL 10.0	Code IRC2018/TPI2014		Matrix-AS						
								Weight: 144 lb	FT = 20%

LUMBER-	BRACING-
TOP CHORD 2x4 SPF 1650F 1.5E *Except* 1-3: 2x4 SPF No.2	TOP CHORD Structural wood sheathing directly applied, except end verticals, and 2-0-0 oc purlins (2-2-0 max.): 3-5.
BOT CHORD 2x4 SPF No.2 *Except* 17-20: 2x4 SP 2400F 2.0E, 11-14: 2x4 SPF 1650F 1.5E	BOT CHORD Rigid ceiling directly applied.
WEBS 2x4 SPF No.2 *Except* 7-17,5-18,3-18: 2x4 SPF 1650F 1.5E	WEBS 1 Row at midpt 9-15
SLIDER Right 2x4 SPF No.2 2-6-0	
REACTIONS. (size) 20=0-3-8, 11=0-3-8 Max Horz 20=-129(LC 45) Max Uplift 20=-306(LC 8), 11=-288(LC 9) Max Grav 20=1634(LC 1), 11=1652(LC 1)	

FORCES. (lb) - Max. Comp./Max. Ten. - All forces 250 (lb) or less except when shown.
TOP CHORD 2-3=-1960/352, 3-4=-6205/1091, 4-5=-6205/1091, 5-6=-6524/1139, 6-7=-6304/1175, 7-9=-2485/508, 9-11=-3274/597, 2-20=-1659/387
BOT CHORD 18-19=-259/1956, 17-18=-1381/8544, 13-15=-481/3036, 11-13=-481/3036
WEBS 3-19=-779/152, 5-17=-2949/550, 15-17=-290/2233, 7-17=-770/4454, 7-15=-309/112, 9-15=-912/244, 9-13=0/281, 2-19=-380/2120, 4-18=-474/142, 5-18=-2519/510, 3-18=-783/4412

- NOTES-**
- Unbalanced roof live loads have been considered for this design.
 - Wind: ASCE 7-16; Vult=115mph (3-second gust) Vasd=91mph; TCDL=6.0psf; BCDL=4.2psf; h=15ft; Cat. II; Exp C; Enclosed; MWFRS (envelope) gable end zone and C-C Exterior(2E) -1-10-8 to 1-6-5, Interior(1) 1-6-5 to 1-10-4, Exterior(2E) 1-10-4 to 5-3-1, Interior(1) 5-3-1 to 18-0-0, Exterior(2R) 18-0-0 to 21-4-13, Interior(1) 21-4-13 to 35-10-8 zone; cantilever left and right exposed ; end vertical left and right exposed;C-C for members and forces & MWFRS for reactions shown; Lumber DOL=1.60 plate grip DOL=1.60
 - Provide adequate drainage to prevent water ponding.
 - All plates are MT20 plates unless otherwise indicated.
 - This truss has been designed for a 10.0 psf bottom chord live load nonconcurrent with any other live loads.
 - Provide mechanical connection (by others) of truss to bearing plate capable of withstanding 306 lb uplift at joint 20 and 288 lb uplift at joint 11.
 - This truss is designed in accordance with the 2018 International Residential Code sections R502.11.1 and R802.10.2 and referenced standard ANSI/TPI 1.
 - This truss design requires that a minimum of 7/16" structural wood sheathing be applied directly to the top chord and 1/2" gypsum sheetrock be applied directly to the bottom chord.
 - Graphical purlin representation does not depict the size or the orientation of the purlin along the top and/or bottom chord.
 - Hanger(s) or other connection device(s) shall be provided sufficient to support concentrated load(s) 64 lb down and 167 lb up at 1-10-4 on top chord, and 25 lb down and 32 lb up at 1-10-4, 22 lb down and 31 lb up at 1-11-0, and 22 lb down and 31 lb up at 3-11-0, and 22 lb down and 31 lb up at 5-11-0 on bottom chord. The design/selection of such connection device(s) is the responsibility of others.



June 12, 2023

WARNING - Verify design parameters and READ NOTES ON THIS AND INCLUDED MITEK REFERENCE PAGE MII-7473 rev. 1/2/2023 BEFORE USE.

Design valid for use only with MiTek® connectors. This design is based only upon parameters shown, and is for an individual building component, not a truss system. Before use, the building designer must verify the applicability of design parameters and properly incorporate this design into the overall building design. Bracing indicated is to prevent buckling of individual truss web and/or chord members only. Additional temporary and permanent bracing is always required for stability and to prevent collapse with possible personal injury and property damage. For general guidance regarding the fabrication, storage, delivery, erection and bracing of trusses and truss systems, see **ANSI/TPI1 Quality Criteria, and DSB-22** available from Truss Plate Institute (www.tpinst.org) and **BCSI Building Component Safety Information** available from the Structural Building Component Association (www.sbcsccomponents.com)

MiTek®
16023 Swingley Ridge Rd.
Chesterfield, MO 63017
314.434.1200 / MiTek-US.com

Job	Truss	Truss Type	Qty	Ply	Summit/185 Highland Meadows	RELEASE FOR CONSTRUCTION
3664536	B1	Roof Special	1	1	Job Reference (optional)	AS NOTED FOR PLAN REVIEW DEVELOPMENT SERVICES LEE'S SUMMIT, MISSOURI

Builders FirstSource (Valley Center), Valley Center, KS - 67147,

8.630 s Nov 19 2022 MiTek Industries, Inc. Thu Jun 23 14:12:52 2023 Page 2

ID:icBMJaMgT1gasuUyx9?RhvzDEHb-RfC?PsB70Hq3NSuPqnL8w3uITXbGKVICd7JzZIC?10/10/2023

NOTES-

11) In the LOAD CASE(S) section, loads applied to the face of the truss are noted as front (F) or back (B).

LOAD CASE(S) Standard

1) Dead + Roof Live (balanced): Lumber Increase=1.15, Plate Increase=1.15

Uniform Loads (plf)

Vert: 1-2=-70, 2-3=-70, 3-5=-70, 5-7=-70, 7-12=-70, 17-20=-20, 16-21=-20

Concentrated Loads (lb)

Vert: 3=33(F)

WARNING - Verify design parameters and READ NOTES ON THIS AND INCLUDED MITEK REFERENCE PAGE MII-7473 rev. 1/2/2023 BEFORE USE.

Design valid for use only with MiTek® connectors. This design is based only upon parameters shown, and is for an individual building component, not a truss system. Before use, the building designer must verify the applicability of design parameters and properly incorporate this design into the overall building design. Bracing indicated is to prevent buckling of individual truss web and/or chord members only. Additional temporary and permanent bracing is always required for stability and to prevent collapse with possible personal injury and property damage. For general guidance regarding the fabrication, storage, delivery, erection and bracing of trusses and truss systems, see **ANSI/TPI1 Quality Criteria, and DSB-22** available from Truss Plate Institute (www.tpinst.org) and **BCSI Building Component Safety Information** available from the Structural Building Component Association (www.sbcsccomponents.com)


MiTek®

16023 Swingley Ridge Rd.
Chesterfield, MO 63017
314.434.1200 / MiTek-US.com

Job 3664536	Truss B1A	Truss Type Roof Special	Qty 1	Ply 1	Summit/185 Highland Meadows	AS NOTED FOR PLAN REVIEW DEVELOPMENT SERVICES LEE'S SUMMIT, MISSOURI
----------------	--------------	----------------------------	----------	----------	-----------------------------	--

Builders FirstSource (Valley Center), Valley Center, KS - 67147, 8.630 s Nov 19 2022 MiTek Industries, Inc. Thu Jun 12 12:55:2023 Page 1
 ID:icBMJaMgT1gasuUyx9?RhvzDEHb-RIC?PsB70Hq3NSPqnl8WgJLTXbGKVICDg174ZICP2 PqnL8WgJLTXbGKVICDg174ZICP2
 1-10-8 | 1-10-4 | 6-1-12 | 10-8-12 | 12-4-12 | 17-2-4 | 18-9-12 | 26-3-2 | 34-0-0 | 35-10-8
 1-10-8 | 1-10-4 | 4-3-8 | 4-7-0 | 1-8-0 | 4-9-8 | 1-7-8 | 7-5-6 | 7-8-14 | 1-10-8
 Scale = 1:65.7

10/10/2023

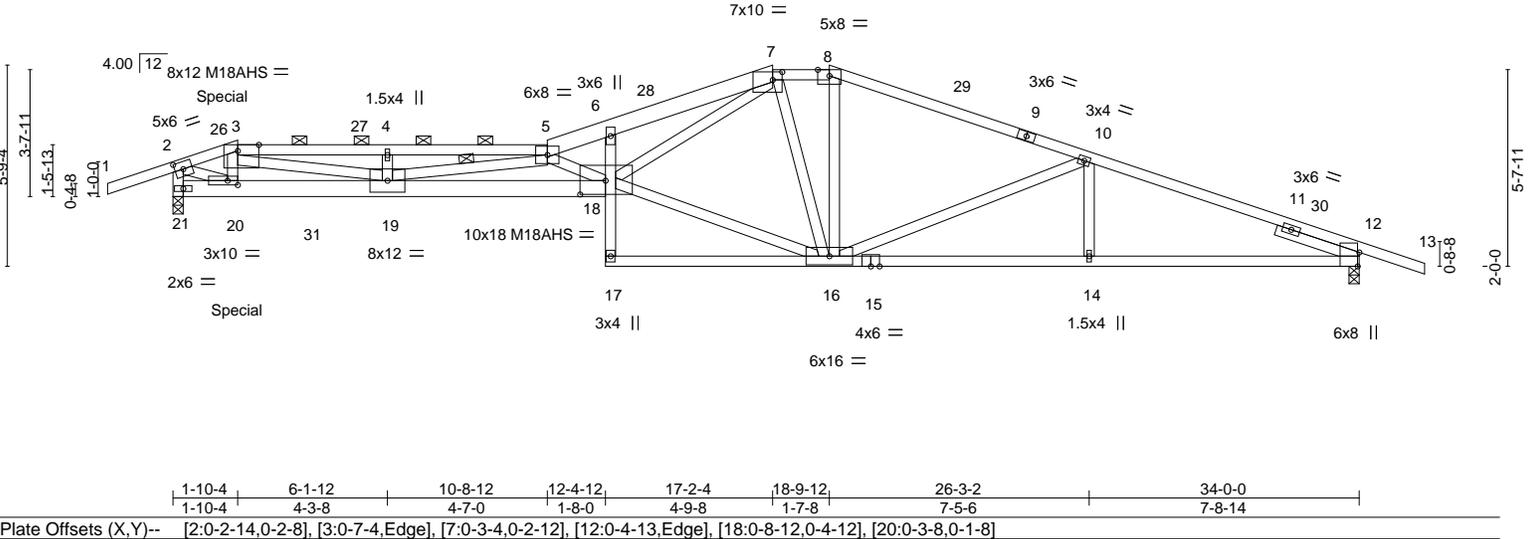

LOADING (psf)	SPACING-	2-0-0	CSI.	DEFL.	in (loc)	l/defl	L/d	PLATES	GRIP
TCLL 25.0	Plate Grip DOL	1.15	TC 0.90	Vert(LL)	-0.76	17	>537	MT20	197/144
TCDL 10.0	Lumber DOL	1.15	BC 0.86	Vert(CT)	-1.36	17	>299	M18AHS	142/136
BCLL 0.0	Rep Stress Incr	YES	WB 1.00	Horz(CT)	0.24	12	n/a		
BCDL 10.0	Code IRC2018/TPI2014		Matrix-AS						
								Weight: 156 lb	FT = 20%

LUMBER-
 TOP CHORD 2x4 SPF No.2 *Except*
 3-5,9-13: 2x4 SPF 1650F 1.5E, 5-7: 2x6 SPF No.2
 BOT CHORD 2x4 SPF No.2 *Except*
 18-21: 2x6 SPF 2100F 1.8E, 12-15: 2x4 SPF 1650F 1.5E
 WEBS 2x4 SPF No.2 *Except*
 7-18: 2x4 SPF 1650F 1.5E
 SLIDER Right 2x4 SPF No.2 2-6-0

BRACING-
 TOP CHORD Structural wood sheathing directly applied, except end verticals, and 2-0-0 oc purlins (2-2-0 max.): 3-5, 7-8.
 BOT CHORD Rigid ceiling directly applied.
 WEBS 1 Row at midpt 5-19

REACTIONS. (size) 12=0-3-8, 21=0-3-8
 Max Horz 21=-125(LC 13)
 Max Uplift 12=-293(LC 9), 21=-311(LC 8)
 Max Grav 12=1652(LC 1), 21=1634(LC 1)

FORCES. (lb) - Max. Comp./Max. Ten. - All forces 250 (lb) or less except when shown.
 TOP CHORD 2-3=-2275/418, 3-4=-6176/1118, 4-5=-6174/1116, 5-6=-6932/1266, 6-7=-6721/1294,
 7-8=-2391/539, 8-10=-2592/540, 10-12=-3277/606, 2-21=-1753/409
 BOT CHORD 19-20=-292/2232, 18-19=-1608/9407, 14-16=-492/3040, 12-14=-492/3040
 WEBS 3-20=-541/110, 5-18=-3411/650, 8-16=-43/488, 10-16=-787/223, 10-14=0/258,
 2-20=-434/2323, 4-19=-404/130, 3-19=-727/4085, 7-16=-919/174, 5-19=-3379/674,
 16-18=-367/2559, 7-18=-818/4563

NOTES-
 1) Unbalanced roof live loads have been considered for this design.
 2) Wind: ASCE 7-16; Vult=115mph (3-second gust) Vasd=91mph; TCDL=6.0psf; BCDL=4.2psf; h=15ft; Cat. II; Exp C; Enclosed; MWFRS (envelope) gable end zone and C-C Exterior(2E) -1-10-8 to 1-6-5, Interior(1) 1-6-5 to 1-10-4, Exterior(2E) 1-10-4 to 5-3-1, Interior(1) 5-3-1 to 17-2-4, Exterior(2E) 17-2-4 to 18-9-12, Exterior(2R) 18-9-12 to 22-2-9, Interior(1) 22-2-9 to 35-10-8 zone; cantilever left and right exposed; end vertical left and right exposed; C-C for members and forces & MWFRS for reactions shown; Lumber DOL=1.60 plate grip DOL=1.60
 3) Provide adequate drainage to prevent water ponding.
 4) All plates are MT20 plates unless otherwise indicated.
 5) The Fabrication Tolerance at joint 18 = 16%
 6) This truss has been designed for a 10.0 psf bottom chord live load nonconcurrent with any other live loads.
 7) Bearing at joint(s) 21 considers parallel to grain value using ANSI/TPI 1 angle to grain formula. Building designer should verify capacity of bearing surface.
 8) Provide mechanical connection (by others) of truss to bearing plate capable of withstanding 293 lb uplift at joint 12 and 311 lb uplift at joint 21.
 9) This truss is designed in accordance with the 2018 International Residential Code sections R502.11.1 and R802.10.2 and referenced standard ANSI/TPI 1.
 10) This truss design requires that a minimum of 7/16" structural wood sheathing be applied directly to the top chord and 1/2" gypsum sheetrock be applied directly to the bottom chord.
 On the graphic representation does not depict the size or the orientation of the purlin along the top and/or bottom chord.



June 12, 2023

Job	Truss	Truss Type	Qty	Ply	Summit/185 Highland Meadows
3664536	B1A	Roof Special	1	1	

RELEASE FOR CONSTRUCTION

AS NOTED FOR PLAN REVIEW
DEVELOPMENT SERVICES

LEE'S SUMMIT, MISSOURI

Builders FirstSource (Valley Center), Valley Center, KS - 67147,

8.630 s Nov 19 2022 MiTek Industries, Inc. Thu Jun 8 14:12:55 2023 Page 2

ID:icBMJaMgT1gasuUyx9?RhvzDEHb-RfC?PsB70Hq3NSpPqnL8w3ulTXbGKVICDm7JzJIC?P

10/10/2023

NOTES-

- Hanger(s) or other connection device(s) shall be provided sufficient to support concentrated load(s) 64 lb down and 167 lb up at 1-10-4 on top chord, and 25 lb down and 32 lb up at 1-10-4, 22 lb down and 31 lb up at 1-11-0, and 22 lb down and 31 lb up at 3-11-0, and 22 lb down and 31 lb up at 5-11-0 on bottom chord. The design/selection of such connection device(s) is the responsibility of others.
- In the LOAD CASE(S) section, loads applied to the face of the truss are noted as front (F) or back (B).

LOAD CASE(S) Standard

- Dead + Roof Live (balanced): Lumber Increase=1.15, Plate Increase=1.15
Uniform Loads (plf)
Vert: 1-2=-70, 2-3=-70, 3-5=-70, 5-7=-70, 7-8=-70, 8-13=-70, 18-21=-20, 17-22=-20
Concentrated Loads (lb)
Vert: 3=33(B)

WARNING - Verify design parameters and READ NOTES ON THIS AND INCLUDED MITEK REFERENCE PAGE MII-7473 rev. 1/2/2023 BEFORE USE.


Design valid for use only with MiTek® connectors. This design is based only upon parameters shown, and is for an individual building component, not a truss system. Before use, the building designer must verify the applicability of design parameters and properly incorporate this design into the overall building design. Bracing indicated is to prevent buckling of individual truss web and/or chord members only. Additional temporary and permanent bracing is always required for stability and to prevent collapse with possible personal injury and property damage. For general guidance regarding the fabrication, storage, delivery, erection and bracing of trusses and truss systems, see **ANSI/TPI1 Quality Criteria, and DSB-22** available from Truss Plate Institute (www.tpinst.org) and **BCSI Building Component Safety Information** available from the Structural Building Component Association (www.sbcsccomponents.com)

MiTek®

16023 Swingley Ridge Rd.
Chesterfield, MO 63017
314.434.1200 / MiTek-US.com

Job 3664536	Truss B2	Truss Type Roof Special	Qty 2	Ply 1	Summit/185 Highland Meadows	AS NOTED FOR PLAN REVIEW DEVELOPMENT SERVICES LEE'S SUMMIT, MISSOURI
----------------	-------------	----------------------------	----------	----------	-----------------------------	--

Builders FirstSource (Valley Center), Valley Center, KS - 67147, 8.630 s Nov 19 2022 MiTek Industries, Inc. Thu Jun 21 12:56:2023 Page 1
 ID:icBMJaMgT1gasuUyx9?RhvzDEHb-RfC?PsB70Hq3NS... PqnL8w3ulTxbGKVICdgr74ZICP? 10/10/2023
 -1-10-8 | 3-10-4 | 8-1-8 | 8-3-8 | 12-4-12 | 12-8-12 | 18-0-0 | 25-10-4 | 34-0-0 | 35-10-8
 1-10-8 | 3-10-4 | 4-3-4 | 0-2-0 | 4-1-4 | 0-4-0 | 5-3-4 | 7-10-4 | 8-1-12 | 1-10-8
 Scale: 3/16"=1'

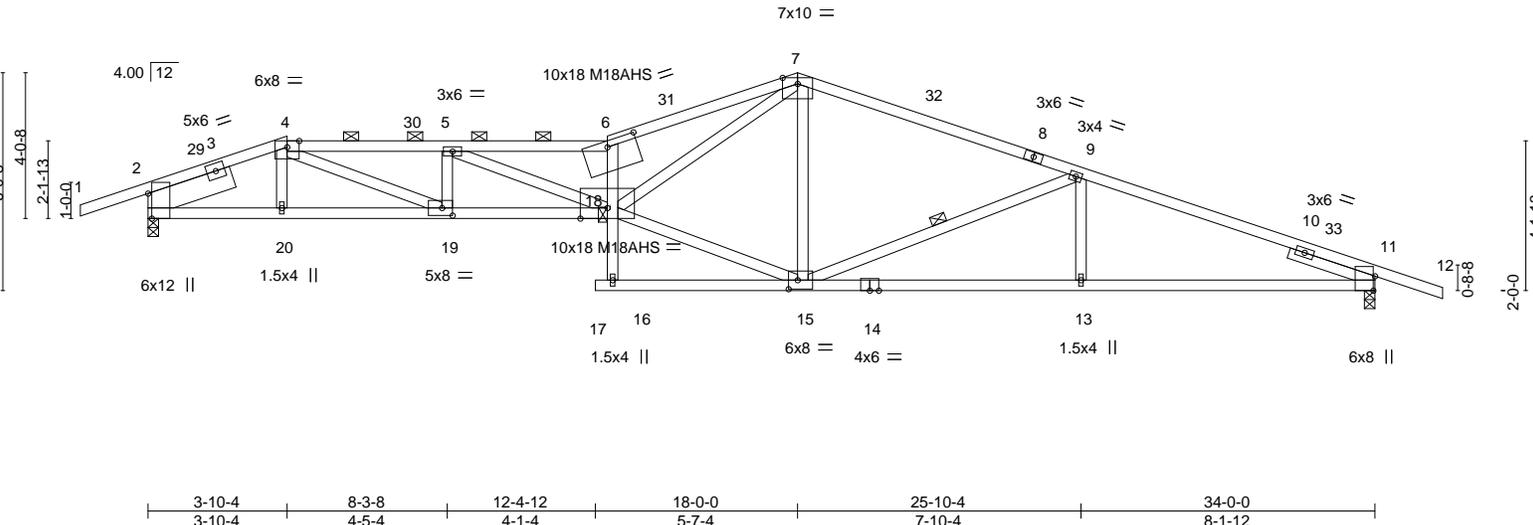

LOADING (psf)	SPACING-	2-0-0	CSI.	DEFL.	in (loc)	l/defl	L/d	PLATES	GRIP
TCLL 25.0	Plate Grip DOL	1.15	TC 0.90	Vert(LL)	-0.65	17	>632	MT20	197/144
TCDL 10.0	Lumber DOL	1.15	BC 0.96	Vert(CT)	-1.16	17	>351	M18AHS	142/136
BCLL 0.0	Rep Stress Incr	YES	WB 0.77	Horz(CT)	0.23	11	n/a		
BCDL 10.0	Code IRC2018/TPI2014		Matrix-AS						
								Weight: 145 lb	FT = 20%

LUMBER-
 TOP CHORD 2x4 SPF 1650F 1.5E
 BOT CHORD 2x4 SPF 1650F 1.5E *Except*
 14-17: 2x4 SPF No.2
 WEBS 2x4 SPF No.2 *Except*
 7-18: 2x4 SPF 1650F 1.5E
 SLIDER Left 2x8 SP 2400F 2.0E 2-6-0, Right 2x4 SPF No.2 2-6-0

BRACING-
 TOP CHORD Structural wood sheathing directly applied, except
 2-0-0 oc purlins (2-2-14 max.): 4-6.
 BOT CHORD Rigid ceiling directly applied.
 WEBS 1 Row at midpt 6-16, 9-15

REACTIONS. (size) 2=0-3-8, 11=0-3-8
 Max Horz 2=-142(LC 13)
 Max Uplift 2=-297(LC 8), 11=-282(LC 9)
 Max Grav 2=1665(LC 1), 11=1664(LC 1)

FORCES. (lb) - Max. Comp./Max. Ten. - All forces 250 (lb) or less except when shown.
 TOP CHORD 2-4=-2763/501, 4-5=-5191/936, 5-6=-6300/1124, 6-7=-6559/1205, 7-9=-2529/510,
 9-11=-3303/603
 BOT CHORD 2-20=-326/2531, 19-20=-330/2540, 18-19=-787/5188, 13-15=-487/3063, 11-13=-487/3063
 WEBS 6-18=-2298/472, 7-15=-344/113, 9-15=-894/240, 9-13=0/275, 15-18=-312/2349,
 7-18=-786/4713, 5-19=-1025/241, 4-19=-504/2885, 5-18=-217/1203

- NOTES-**
- 1) Unbalanced roof live loads have been considered for this design.
 - 2) Wind: ASCE 7-16; Vult=115mph (3-second gust) Vasd=91mph; TCDL=6.0psf; BCDL=4.2psf; h=15ft; Cat. II; Exp C; Enclosed; MWFRS (envelope) gable end zone and C-C Exterior(2E) -1-10-8 to 1-6-5, Interior(1) 1-6-5 to 3-10-4, Exterior(2R) 3-10-4 to 7-3-1, Interior(1) 7-3-1 to 18-0-0, Exterior(2R) 18-0-0 to 21-4-13, Interior(1) 21-4-13 to 35-10-8 zone; cantilever left and right exposed ; end vertical left and right exposed;C-C for members and forces & MWFRS for reactions shown; Lumber DOL=1.60 plate grip DOL=1.60
 - 3) Provide adequate drainage to prevent water ponding.
 - 4) All plates are MT20 plates unless otherwise indicated.
 - 5) This truss has been designed for a 10.0 psf bottom chord live load nonconcurrent with any other live loads.
 - 6) Provide mechanical connection (by others) of truss to bearing plate capable of withstanding 297 lb uplift at joint 2 and 282 lb uplift at joint 11.
 - 7) This truss is designed in accordance with the 2018 International Residential Code sections R502.11.1 and R802.10.2 and referenced standard ANSI/TPI 1.
 - 8) This truss design requires that a minimum of 7/16" structural wood sheathing be applied directly to the top chord and 1/2" gypsum sheetrock be applied directly to the bottom chord.
 - 9) Graphical purlin representation does not depict the size or the orientation of the purlin along the top and/or bottom chord.



June 12, 2023

Job 3664536	Truss B3	Truss Type Roof Special	Qty 1	Ply 1	Summit/185 Highland Meadows	AS NOTED FOR PLAN REVIEW DEVELOPMENT SERVICES LEE'S SUMMIT, MISSOURI
----------------	-------------	----------------------------	----------	----------	-----------------------------	--

Builders FirstSource (Valley Center), Valley Center, KS - 67147, 8.630 s Nov 19 2022 MiTek Industries, Inc. Thu Jun 21 14:12:58 2023 Page 1

10/10/2023

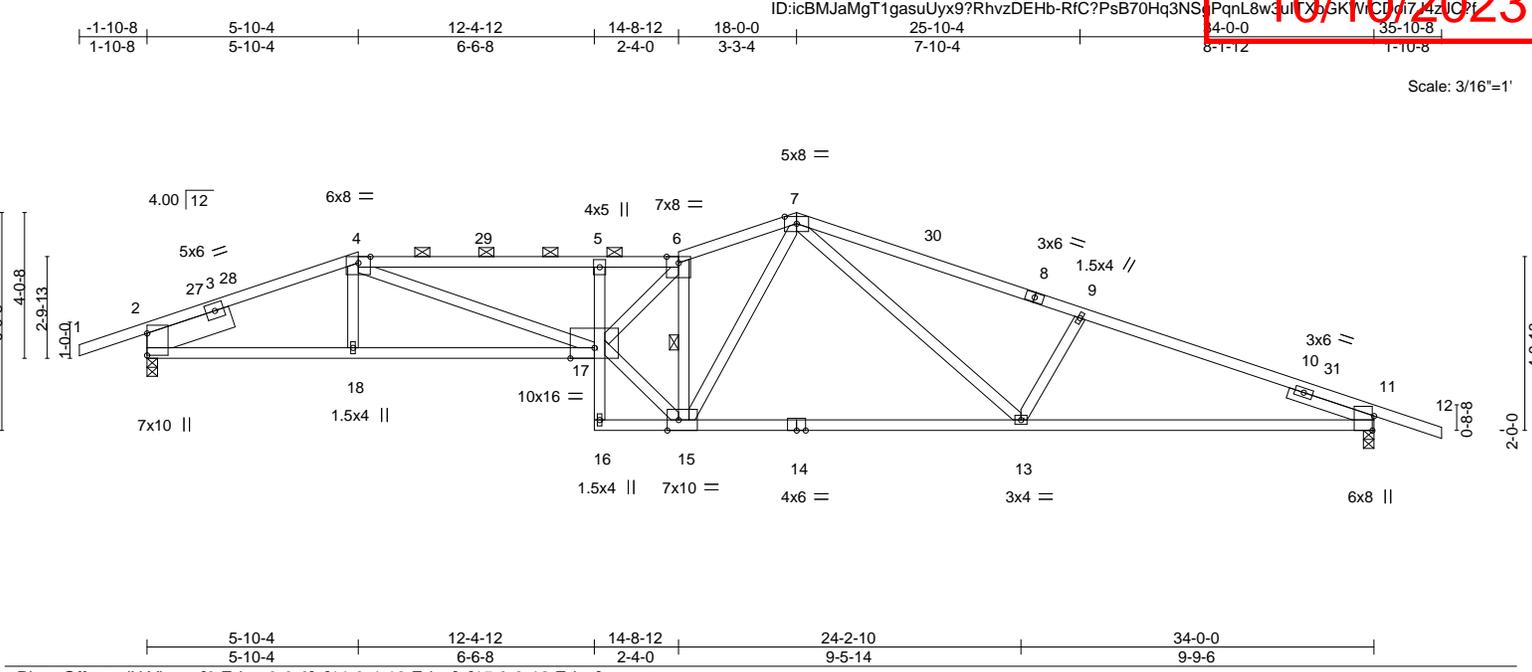


Plate Offsets (X,Y)--	[2:Edge,0-0-0], [11:0-4-13,Edge], [15:0-3-12,Edge]				
LOADING (psf)	SPACING - 2-0-0	CSI	DEFL. in (loc) l/defl L/d	PLATES	GRIP
TCLL 25.0	Plate Grip DOL 1.15	TC 0.87	Vert(LL) -0.41 5 >999 240	MT20	197/144
TCDL 10.0	Lumber DOL 1.15	BC 0.84	Lumber(CT) -0.82 13-15 >495 180		
BCLL 0.0	Rep Stress Incr YES	WB 0.89	Horz(CT) 0.17 11 n/a n/a		
BCDL 10.0	Code IRC2018/TPI2014	Matrix-AS		Weight: 152 lb	FT = 20%

LUMBER-	BRACING-
TOP CHORD 2x4 SP 2400F 2.0E *Except* 6-7: 2x4 SPF No.2, 7-8,8-12: 2x4 SPF 1650F 1.5E	TOP CHORD Structural wood sheathing directly applied, except 2-0-0 oc purlins (2-7-15 max.): 4-6.
BOT CHORD 2x4 SPF No.2 *Except* 2-17: 2x4 SP 2400F 2.0E, 11-14: 2x4 SPF 1650F 1.5E	BOT CHORD Rigid ceiling directly applied.
WEBS 2x4 SPF No.2	WEBS 1 Row at midpt 6-15
SLIDER Left 2x8 SP 2400F 2.0E 2-6-0, Right 2x4 SPF No.2 2-6-0	

REACTIONS. (size) 2=0-3-8, 11=0-3-8
 Max Horz 2=-142(LC 13)
 Max Uplift 2=-299(LC 8), 11=-281(LC 9)
 Max Grav 2=1661(LC 1), 11=1661(LC 1)

FORCES. (lb) - Max. Comp./Max. Ten. - All forces 250 (lb) or less except when shown.
 TOP CHORD 2-4=-2987/552, 4-5=-4870/919, 5-6=-4746/897, 6-7=-2916/623, 7-9=-3088/620,
 9-11=-3299/625
 BOT CHORD 2-18=-367/2755, 17-18=-371/2756, 5-17=-615/187, 13-15=-325/2265, 11-13=-508/3061
 WEBS 4-17=-410/2264, 15-17=-507/3645, 6-17=-475/2930, 6-15=-3093/549, 7-15=-179/1045,
 7-13=-160/864, 9-13=-479/219

- NOTES-**
- 1) Unbalanced roof live loads have been considered for this design.
 - 2) Wind: ASCE 7-16; Vult=115mph (3-second gust) Vasd=91mph; TCDL=6.0psf; BCDL=4.2psf; h=15ft; Cat. II; Exp C; Enclosed; MWFRS (envelope) gable end zone and C-C Exterior(2E) -1-10-8 to 1-6-5, Interior(1) 1-6-5 to 5-10-4, Exterior(2R) 5-10-4 to 9-3-1, Interior(1) 9-3-1 to 18-0-0, Exterior(2R) 18-0-0 to 21-4-13, Interior(1) 21-4-13 to 35-10-8 zone; cantilever left and right exposed ; end vertical left and right exposed;C-C for members and forces & MWFRS for reactions shown; Lumber DOL=1.60 plate grip DOL=1.60
 - 3) Provide adequate drainage to prevent water ponding.
 - 4) This truss has been designed for a 10.0 psf bottom chord live load nonconcurrent with any other live loads.
 - 5) Provide mechanical connection (by others) of truss to bearing plate capable of withstanding 299 lb uplift at joint 2 and 281 lb uplift at joint 11.
 - 6) This truss is designed in accordance with the 2018 International Residential Code sections R502.11.1 and R802.10.2 and referenced standard ANSI/TPI 1.
 - 7) This truss design requires that a minimum of 7/16" structural wood sheathing be applied directly to the top chord and 1/2" gypsum sheetrock be applied directly to the bottom chord.
 - 8) Graphical purlin representation does not depict the size or the orientation of the purlin along the top and/or bottom chord.



June 12, 2023

Job	Truss	Truss Type	Qty	Ply	Summit/185 Highland Meadows
3664536	CJ1	Diagonal Hip Girder	2	1	


AS NOTED FOR PLAN REVIEW
DEVELOPMENT SERVICES
LEE'S SUMMIT, MISSOURI

Builders FirstSource (Valley Center), Valley Center, KS - 67147,

8.630 s Nov 19 2022 MiTek Industries, Inc. Thu Jun 21 14:12:59 2023 Page 1

ID:icBMJaMgT1gasuUyx9?RhvzDEHb-RfC?PsB70Hq3NSuPqnL8w3ulTXbGKVCd7f7JzJICP?

10/10/2023

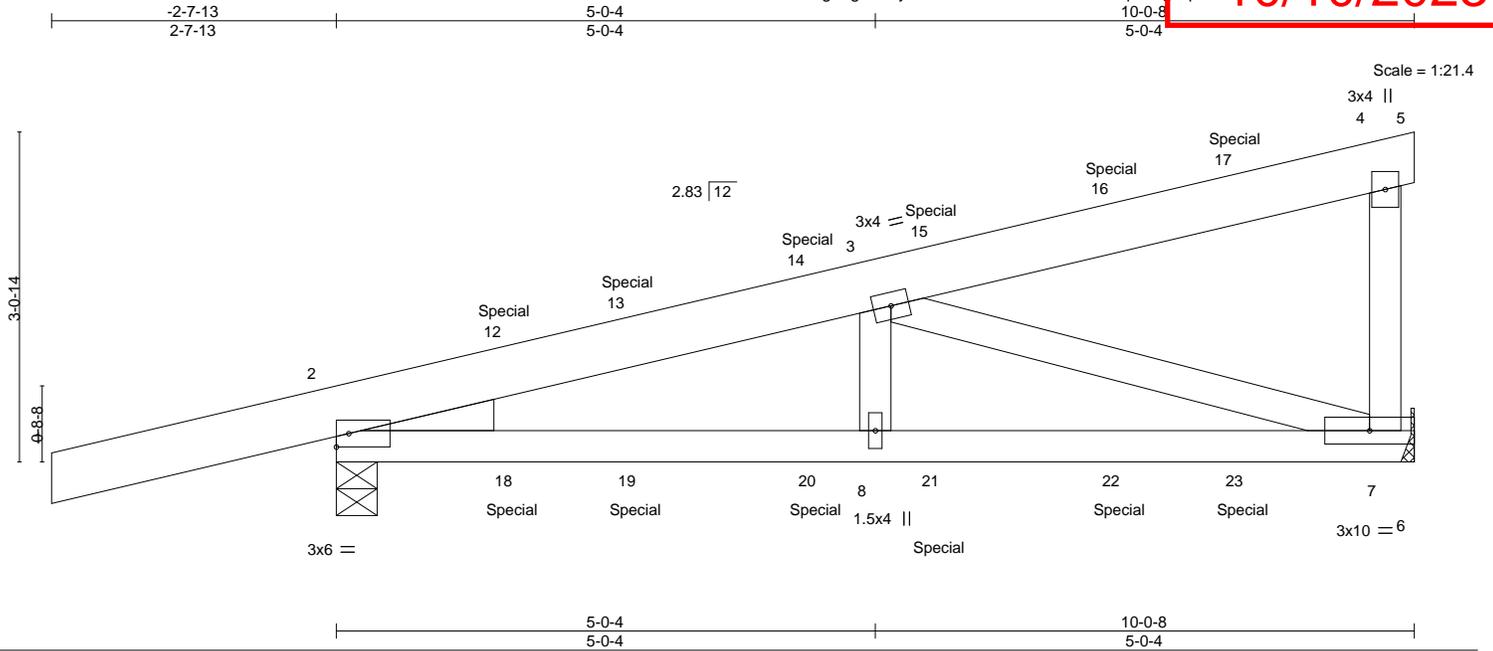

LOADING (psf)	SPACING-	2-0-0	CSI.	DEFL.	in (loc)	l/defl	L/d	PLATES	GRIP
TCLL 25.0	Plate Grip DOL	1.15	TC 0.33	Vert(LL)	-0.03	7-8	>999	MT20	197/144
TCDL 10.0	Lumber DOL	1.15	BC 0.38	Vert(CT)	-0.06	7-8	>999		
BCLL 0.0	Rep Stress Incr	NO	WB 0.30	Horz(CT)	0.01	7	n/a		
BCDL 10.0	Code IRC2018/TPI2014		Matrix-MS					Weight: 46 lb	FT = 20%

LUMBER-	BRACING-
TOP CHORD 2x6 SPF No.2	TOP CHORD Structural wood sheathing directly applied or 6-0-0 oc purlins, except end verticals.
BOT CHORD 2x4 SPF No.2	BOT CHORD Rigid ceiling directly applied or 10-0-0 oc bracing.
WEBS 2x4 SPF No.2	
WEDGE	
Left: 2x4 SP No.3	

REACTIONS. (size) 2=0-4-9, 7=Mechanical
 Max Horz 2=97(LC 27)
 Max Uplift 2=-191(LC 4), 7=-103(LC 8)
 Max Grav 2=617(LC 1), 7=575(LC 1)

FORCES. (lb) - Max. Comp./Max. Ten. - All forces 250 (lb) or less except when shown.
 TOP CHORD 2-3=-797/136
 BOT CHORD 2-8=-154/731, 7-8=-154/731
 WEBS 3-7=-704/168

- NOTES-**
- 1) Wind: ASCE 7-16; Vult=115mph (3-second gust) Vasd=91mph; TCDL=6.0psf; BCDL=4.2psf; h=15ft; Cat. II; Exp C; Enclosed; MWFRS (envelope) gable end zone; cantilever left and right exposed; end vertical left and right exposed; Lumber DOL=1.60 plate grip DOL=1.60
 - 2) This truss has been designed for a 10.0 psf bottom chord live load nonconcurrent with any other live loads.
 - 3) Refer to girder(s) for truss to truss connections.
 - 4) Provide mechanical connection (by others) of truss to bearing plate capable of withstanding 191 lb uplift at joint 2 and 103 lb uplift at joint 7.
 - 5) This truss is designed in accordance with the 2018 International Residential Code sections R502.11.1 and R802.10.2 and referenced standard ANSI/TPI 1.
 - 6) Hanger(s) or other connection device(s) shall be provided sufficient to support concentrated load(s) 83 lb down and 173 lb up at 1-7-11, 12 lb down and 15 lb up at 2-9-8, 15 lb down and 32 lb up at 4-5-10, 35 lb down and 52 lb up at 5-7-7, and 52 lb down and 76 lb up at 7-3-10, and 76 lb down and 87 lb up at 8-5-6 on top chord, and 11 lb down and 64 lb up at 1-7-11, 10 lb down and 6 lb up at 2-9-8, 24 lb down and 7 lb up at 4-5-10, 22 lb down at 5-7-7, and 33 lb down at 7-3-10, and 45 lb down at 8-5-6 on bottom chord. The design/selection of such connection device(s) is the responsibility of others.
 - 7) In the LOAD CASE(S) section, loads applied to the face of the truss are noted as front (F) or back (B).

LOAD CASE(S) Standard

- 1) Dead + Roof Live (balanced): Lumber Increase=1.15, Plate Increase=1.15
 Uniform Loads (plf)
 Vert: 1-4=-70, 4-5=-20, 6-9=-20
 Concentrated Loads (lb)
 Vert: 12=49(F) 15=-6(B) 16=-45(F) 17=-76(B) 18=32(F) 19=6(B) 20=7(F) 21=-12(B) 22=-29(F) 23=-41(B)



Job	Truss	Truss Type	Qty	Ply	Summit/185 Highland Meadows
3664536	CJ2	Diagonal Hip Girder	1	1	

AS NOTED FOR PLAN REVIEW
DEVELOPMENT SERVICES
LEE'S SUMMIT, MISSOURI

Builders FirstSource (Valley Center), Valley Center, KS - 67147, 8.630 s Nov 19 2022 MiTek Industries, Inc. Thu Jun 21 14:12:02 2023 Page 1
ID:icBMJaMgT1gasuUyx9?RhvzDEHb-RIC?PsB70Hq3NSpPqnL8WgULTx5GKVICDm7JzUCP2 PqnL8WgULTx5GKVICDm7JzUCP2
11-2-4 3-9-9 10/10/2023

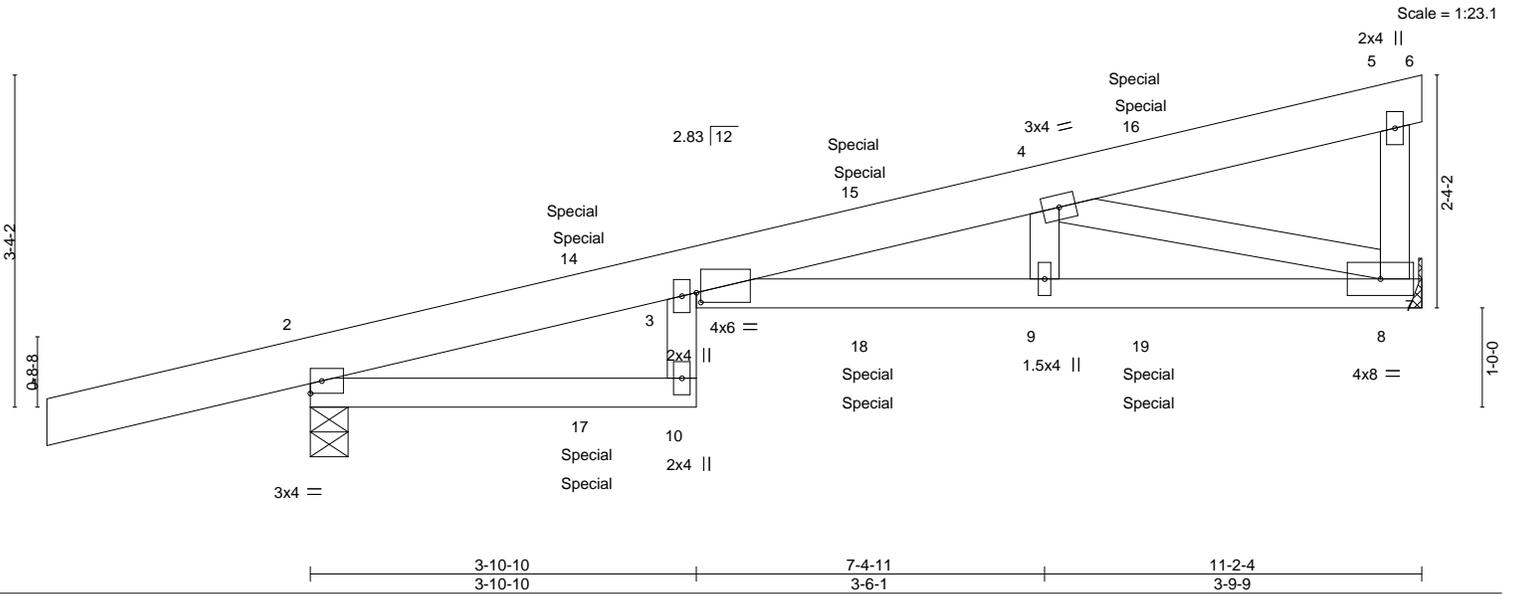


Plate Offsets (X,Y)--	[3:0-0-8,0-1-3]				
LOADING (psf)	SPACING- 2-0-0	CSI.	DEFL. in (loc) l/defl L/d	PLATES	GRIP
TCLL 25.0	Plate Grip DOL 1.15	TC 0.75	Vert(LL) -0.22 3-9 >595 240	MT20	197/144
TCDL 10.0	Lumber DOL 1.15	BC 0.91	Vert(CT) -0.41 3-9 >320 180		
BCLL 0.0	Rep Stress Incr NO	WB 0.42	Horz(CT) 0.17 8 n/a n/a		
BCDL 10.0	Code IRC2018/TPI2014	Matrix-MS		Weight: 46 lb	FT = 20%

LUMBER-	BRACING-
TOP CHORD 2x6 SPF 2100F 1.8E	TOP CHORD Structural wood sheathing directly applied or 5-10-8 oc purlins, except end verticals.
BOT CHORD 2x4 SPF No.2	BOT CHORD Rigid ceiling directly applied or 8-10-14 oc bracing.
WEBS 2x4 SPF No.2	

REACTIONS. (size) 8=Mechanical, 2=0-4-9
 Max Horz 2=90(LC 5)
 Max Uplift 8=-154(LC 8), 2=-227(LC 4)
 Max Grav 8=694(LC 1), 2=779(LC 1)

FORCES. (lb) - Max. Comp./Max. Ten. - All forces 250 (lb) or less except when shown.
 TOP CHORD 3-4=-1695/407
 BOT CHORD 3-9=-427/1701, 8-9=-426/1699
 WEBS 4-8=-1726/450

- NOTES-**
- 1) Wind: ASCE 7-16; Vult=115mph (3-second gust) Vasd=91mph; TCDL=6.0psf; BCDL=4.2psf; h=15ft; Cat. II; Exp C; Enclosed; MWFRS (envelope) gable end zone; cantilever left and right exposed; end vertical left and right exposed; Lumber DOL=1.60 plate grip DOL=1.60
 - 2) This truss has been designed for a 10.0 psf bottom chord live load nonconcurrent with any other live loads.
 - 3) Refer to girder(s) for truss to truss connections.
 - 4) Provide mechanical connection (by others) of truss to bearing plate capable of withstanding 154 lb uplift at joint 8 and 227 lb uplift at joint 2.
 - 5) This truss is designed in accordance with the 2018 International Residential Code sections R502.11.1 and R802.10.2 and referenced standard ANSI/TPI 1.
 - 6) Hanger(s) or other connection device(s) shall be provided sufficient to support concentrated load(s) 12 lb down and 15 lb up at 2-9-8, 12 lb down and 15 lb up at 2-9-8, 32 lb down and 39 lb up at 5-7-7, 32 lb down and 39 lb up at 5-7-7, and 59 lb down and 73 lb up at 8-5-6, and 59 lb down and 73 lb up at 8-5-6 on top chord, and 10 lb down and 6 lb up at 2-9-8, 10 lb down and 6 lb up at 2-9-8, 32 lb down and 25 lb up at 5-7-7, 32 lb down and 25 lb up at 5-7-7, and 61 lb down and 32 lb up at 8-5-6, and 61 lb down and 32 lb up at 8-5-6 on bottom chord. The design/selection of such connection device(s) is the responsibility of others.
 - 7) In the LOAD CASE(S) section, loads applied to the face of the truss are noted as front (F) or back (B).

LOAD CASE(S) Standard
 1) Dead + Roof Live (balanced): Lumber Increase=1.15, Plate Increase=1.15
 Uniform Loads (plf)
 Vert: 1-3=-70, 3-5=-70, 5-6=-20, 10-11=-20, 3-7=-20
 Concentrated Loads (lb)
 Vert: 15=-12(F=-6, B=-6) 16=-109(F=-54, B=-54) 17=12(F=6, B=6) 18=-63(F=-32, B=-32) 19=-123(F=-61, B=-61)



June 12, 2023

Job 3664536	Truss CJ3	Truss Type Diagonal Hip Girder	Qty 1	Ply 1	Summit/185 Highland Meadows Job Reference (optional)	AS NOTED FOR PLAN REVIEW DEVELOPMENT SERVICES LEE'S SUMMIT, MISSOURI
----------------	--------------	-----------------------------------	----------	----------	---	--

Builders FirstSource (Valley Center), Valley Center, KS - 67147,

8.630 s Nov 19 2022 MiTek Industries, Inc. Thu Jun 21 14:12:03 2023 Page 1

ID:icBMJaMgT1gasuUyx9?RhvzDEHb-RfC?PsB70Hq3NSuPqnL8wGulTxbGKVICd7f7JzICP

10/10/2023

-2-7-13
2-7-13

2-8-7
2-8-7

Scale = 1:10.3

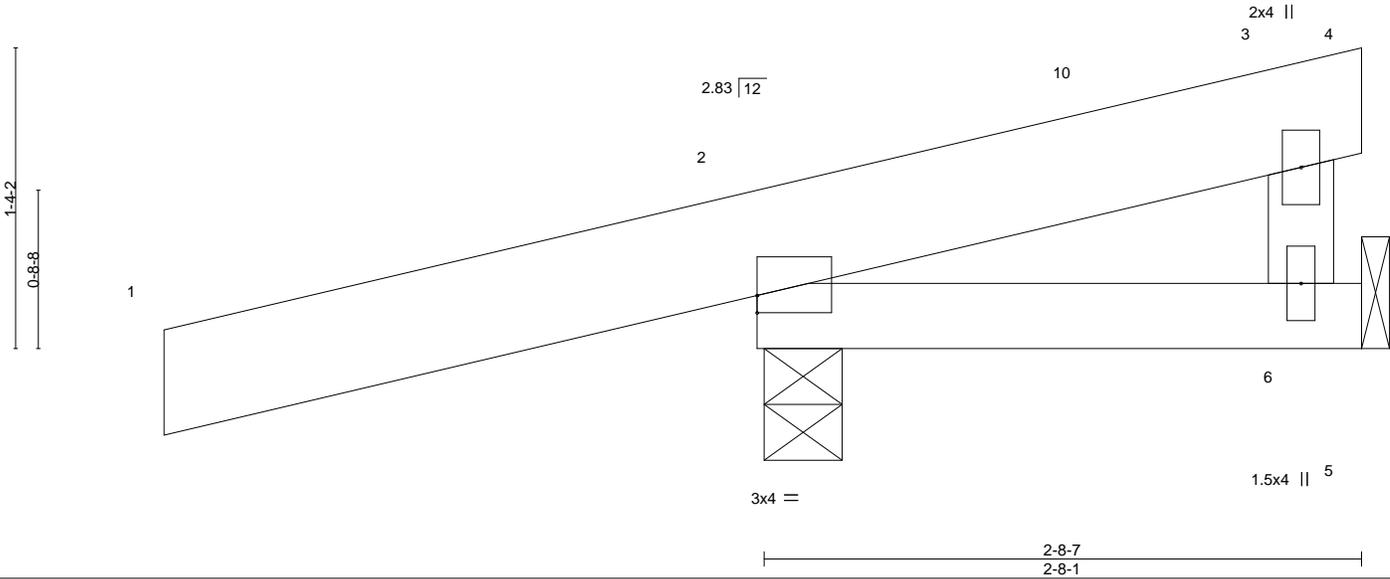


Plate Offsets (X,Y)-- [2:0-0-0,0-0-15]

LOADING (psf)	SPACING-	2-0-0	CSI.	DEFL.	in (loc)	l/defl	L/d	PLATES	GRIP
TCLL 25.0	Plate Grip DOL	1.15	TC 0.25	Vert(LL)	0.00	6-9	>999	MT20	197/144
TCDL 10.0	Lumber DOL	1.15	BC 0.08	Vert(CT)	0.00	6-9	>999		
BCLL 0.0	Rep Stress Incr	NO	WB 0.00	Horz(CT)	-0.00	2	n/a		
BCDL 10.0	Code IRC2018/TPI2014		Matrix-MP						
								Weight: 14 lb	FT = 20%

LUMBER-
 TOP CHORD 2x6 SPF No.2
 BOT CHORD 2x4 SPF No.2
 WEBS 2x4 SPF No.2

BRACING-
 TOP CHORD Structural wood sheathing directly applied or 2-8-7 oc purlins, except end verticals.
 BOT CHORD Rigid ceiling directly applied or 10-0-0 oc bracing.

REACTIONS. (size) 6=Mechanical, 2=0-4-3
 Max Horz 2=43(LC 11)
 Max Uplift 6=-1(LC 9), 2=-167(LC 8)
 Max Grav 6=61(LC 3), 2=396(LC 1)

FORCES. (lb) - Max. Comp./Max. Ten. - All forces 250 (lb) or less except when shown.

NOTES-

- 1) Wind: ASCE 7-16; Vult=115mph (3-second gust) Vasd=91mph; TCDL=6.0psf; BCDL=4.2psf; h=15ft; Cat. II; Exp C; Enclosed; MWFRS (envelope) gable end zone and C-C Corner(3) -2-7-13 to 1-7-1, Exterior(2R) 1-7-1 to 2-8-7 zone; cantilever left and right exposed; end vertical left and right exposed; C-C for members and forces & MWFRS for reactions shown; Lumber DOL=1.60 plate grip DOL=1.60
- 2) This truss has been designed for a 10.0 psf bottom chord live load nonconcurrent with any other live loads.
- 3) Refer to girder(s) for truss to truss connections.
- 4) Provide mechanical connection (by others) of truss to bearing plate capable of withstanding 1 lb uplift at joint 6 and 167 lb uplift at joint 2.
- 5) This truss is designed in accordance with the 2018 International Residential Code sections R502.11.1 and R802.10.2 and referenced standard ANSI/TPI 1.



June 12, 2023

WARNING - Verify design parameters and READ NOTES ON THIS AND INCLUDED MITEK REFERENCE PAGE MII-7473 rev. 1/2/2023 BEFORE USE.

Design valid for use only with MiTek® connectors. This design is based only upon parameters shown, and is for an individual building component, not a truss system. Before use, the building designer must verify the applicability of design parameters and properly incorporate this design into the overall building design. Bracing indicated is to prevent buckling of individual truss web and/or chord members only. Additional temporary and permanent bracing is always required for stability and to prevent collapse with possible personal injury and property damage. For general guidance regarding the fabrication, storage, delivery, erection and bracing of trusses and truss systems, see **ANSI/TPI1 Quality Criteria, and DSB-22** available from Truss Plate Institute (www.tpinst.org) and **BCSI Building Component Safety Information** available from the Structural Building Component Association (www.sbcsccomponents.com)

MiTek®

16023 Swingley Ridge Rd.
 Chesterfield, MO 63017
 314.434.1200 / MiTek-US.com

Job 3664536	Truss CJ4	Truss Type Diagonal Hip Girder	Qty 2	Ply 1	Summit/185 Highland Meadows
----------------	--------------	-----------------------------------	----------	----------	-----------------------------


AS NOTED FOR PLAN REVIEW
DEVELOPMENT SERVICES
LEE'S SUMMIT, MISSOURI

Builders FirstSource (Valley Center), Valley Center, KS - 67147,


8.630 s Nov 19 2022 MiTek Industries, Inc. Thu Jun 21 14:12:04 2023 Page 1

ID:icBMJaMgT1gasuUyx9?RhvzDEHb-RIC?PsB70Hq3NSpPqnL8w3ulTXbGKVICDg7JzJICP

10/10/2023

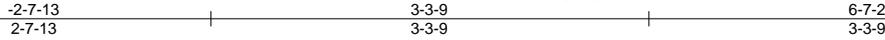

Scale = 1:17.3

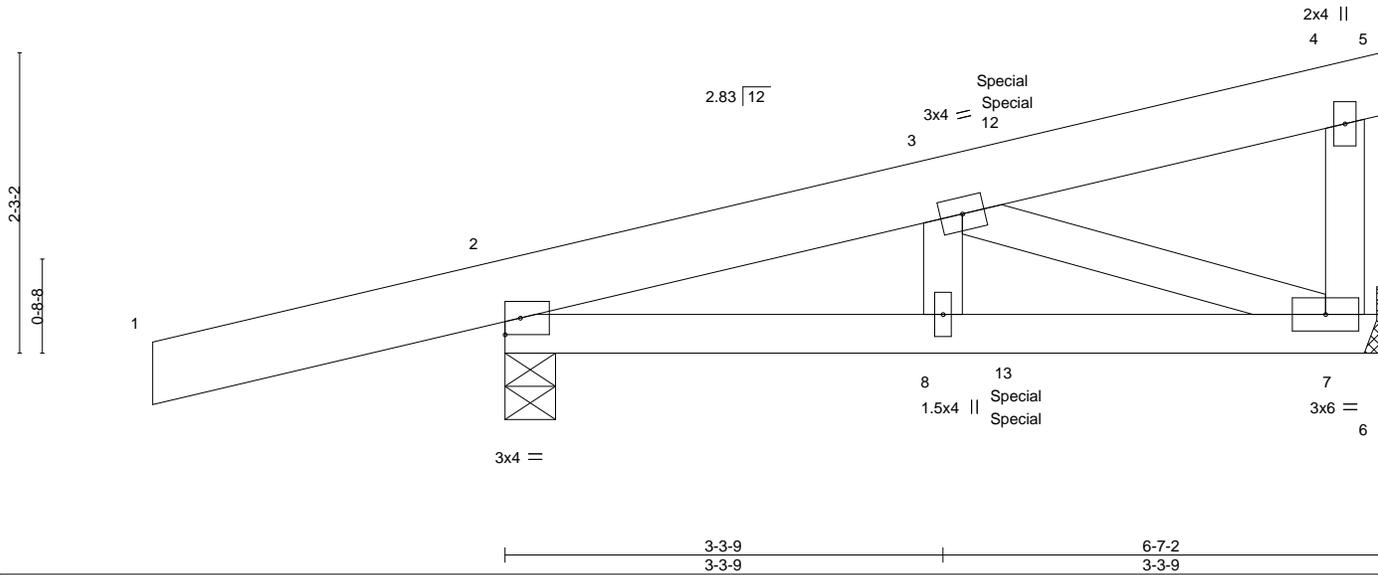

LOADING (psf)	SPACING-	CSI.	DEFL.	in (loc)	l/defl	L/d	PLATES	GRIP
TCLL 25.0	2-0-0	TC 0.25	Vert(LL)	-0.01	8	>999	MT20	197/144
TCDL 10.0	Plate Grip DOL 1.15	BC 0.18	Vert(CT)	-0.01	7-8	>999		
BCLL 0.0	Lumber DOL 1.15	WB 0.06	Horz(CT)	0.00	7	n/a		
BCDL 10.0	Rep Stress Incr NO	Matrix-MP						
	Code IRC2018/TPI2014						Weight: 31 lb	FT = 20%

LUMBER-
 TOP CHORD 2x6 SPF No.2
 BOT CHORD 2x4 SPF No.2
 WEBS 2x4 SPF No.2

BRACING-
 TOP CHORD Structural wood sheathing directly applied or 6-0-0 oc purlins, except end verticals.
 BOT CHORD Rigid ceiling directly applied or 10-0-0 oc bracing.

REACTIONS. (size) 2=0-4-9, 7=Mechanical
 Max Horz 2=78(LC 7)
 Max Uplift 2=-164(LC 4), 7=-49(LC 8)
 Max Grav 2=508(LC 1), 7=256(LC 1)

FORCES. (lb) - Max. Comp./Max. Ten. - All forces 250 (lb) or less except when shown.
 TOP CHORD 2-3=-311/36
 BOT CHORD 2-8=-36/261, 7-8=-36/261
 WEBS 3-7=-278/55

- NOTES-**
- 1) Wind: ASCE 7-16; Vult=115mph (3-second gust) Vasd=91mph; TCDL=6.0psf; BCDL=4.2psf; h=15ft; Cat. II; Exp C; Enclosed; MWFRS (envelope) gable end zone; cantilever left and right exposed; end vertical left and right exposed; Lumber DOL=1.60 plate grip DOL=1.60
 - 2) This truss has been designed for a 10.0 psf bottom chord live load nonconcurrent with any other live loads.
 - 3) Refer to girder(s) for truss to truss connections.
 - 4) Provide mechanical connection (by others) of truss to bearing plate capable of withstanding 164 lb uplift at joint 2 and 49 lb uplift at joint 7.
 - 5) This truss is designed in accordance with the 2018 International Residential Code sections R502.11.1 and R802.10.2 and referenced standard ANSI/TPI 1.
 - 6) Hanger(s) or other connection device(s) shall be provided sufficient to support concentrated load(s) 17 lb down and 30 lb up at 3-10-4, and 17 lb down and 30 lb up at 3-10-4 on top chord, and 11 lb down and 1 lb up at 3-10-4, and 11 lb down and 1 lb up at 3-10-4 on bottom chord. The design/selection of such connection device(s) is the responsibility of others.
 - 7) In the LOAD CASE(S) section, loads applied to the face of the truss are noted as front (F) or back (B).

LOAD CASE(S) Standard
 1) Dead + Roof Live (balanced): Lumber Increase=1.15, Plate Increase=1.15
 Uniform Loads (plf)
 Vert: 1-4=-70, 4-5=-20, 6-9=-20
 Concentrated Loads (lb)
 Vert: 13=2(F=1, B=1)



June 12, 2023

WARNING - Verify design parameters and READ NOTES ON THIS AND INCLUDED MITEK REFERENCE PAGE MII-7473 rev. 1/2/2023 BEFORE USE.

Design valid for use only with MiTek® connectors. This design is based only upon parameters shown, and is for an individual building component, not a truss system. Before use, the building designer must verify the applicability of design parameters and properly incorporate this design into the overall building design. Bracing indicated is to prevent buckling of individual truss web and/or chord members only. Additional temporary and permanent bracing is always required for stability and to prevent collapse with possible personal injury and property damage. For general guidance regarding the fabrication, storage, delivery, erection and bracing of trusses and truss systems, see **ANSI/TPI1 Quality Criteria, and DSB-22** available from Truss Plate Institute (www.tpinst.org) and **BCSI Building Component Safety Information** available from the Structural Building Component Association (www.sbcsccomponents.com)

MiTek®

16023 Swingley Ridge Rd.
 Chesterfield, MO 63017
 314.434.1200 / MiTek-US.com

Job 3664536	Truss CJ5	Truss Type Diagonal Hip Girder	Qty 1	Ply 1	Summit/185 Highland Meadows Job Reference (optional)	AS NOTED FOR PLAN REVIEW DEVELOPMENT SERVICES LEE'S SUMMIT, MISSOURI
----------------	--------------	-----------------------------------	----------	----------	---	--

Builders FirstSource (Valley Center), Valley Center, KS - 67147,

8.630 s Nov 19 2022 MiTek Industries, Inc. Thu Jun 21 14:12:05 2023 Page 1

ID:icBMJaMgT1gasuUyx9?RhvzDEHb-RfC?PsB70Hq3NSuPqnL8w3ulTXbGKVICDm7JzJICP

10/10/2023

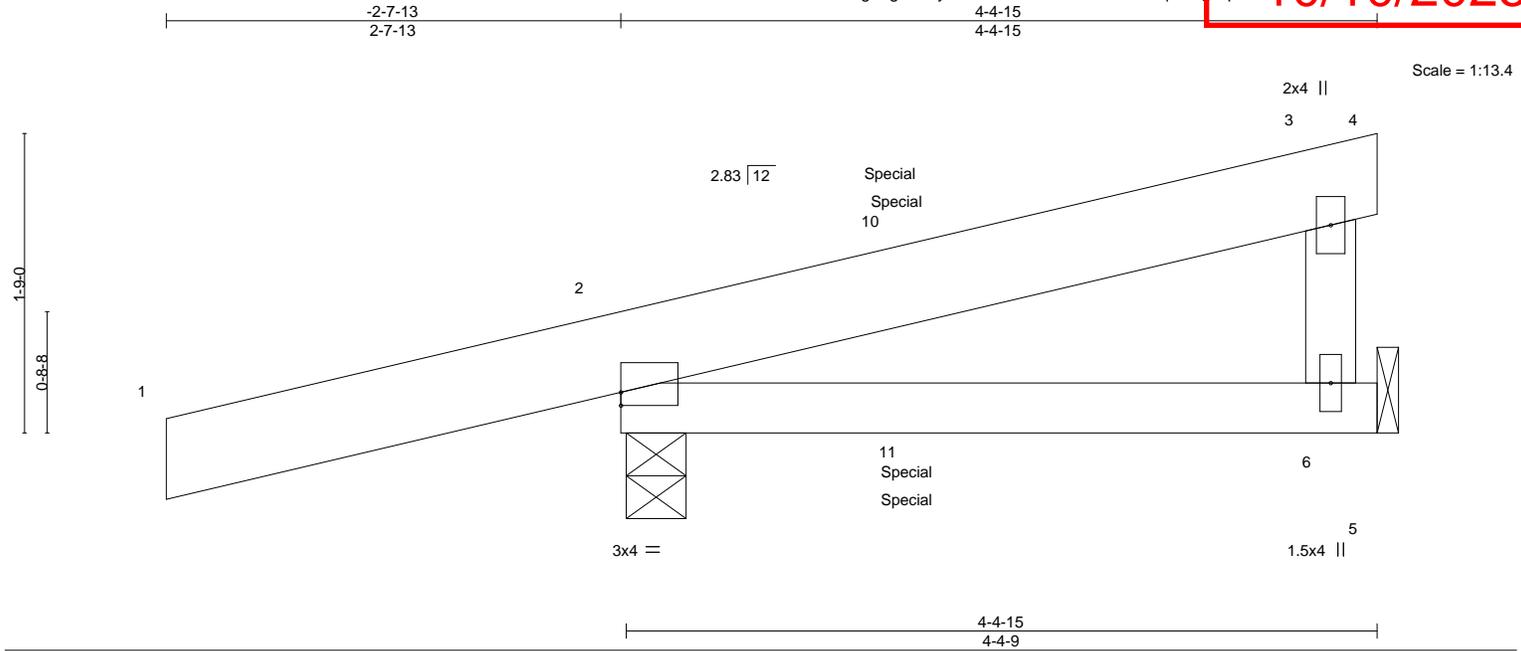


Plate Offsets (X,Y)--	[2:0-0-0,0-0-15]						
LOADING (psf)	SPACING-	2-0-0	CSI.	DEFL.	in (loc)	l/defl	L/d
TCLL 25.0	Plate Grip DOL	1.15	TC 0.25	Vert(LL)	0.01 6-9	>999	240
TCDL 10.0	Lumber DOL	1.15	BC 0.11	Vert(CT)	0.01 6-9	>999	180
BCLL 0.0	Rep Stress Incr	NO	WB 0.00	Horz(CT)	-0.00 2	n/a	n/a
BCDL 10.0	Code IRC2018/TPI2014		Matrix-MP				
							PLATES MT20
							GRIP 197/144
							Weight: 19 lb FT = 20%

LUMBER-		BRACING-	
TOP CHORD	2x6 SPF No.2	TOP CHORD	Structural wood sheathing directly applied or 4-4-15 oc purlins, except end verticals.
BOT CHORD	2x4 SPF No.2	BOT CHORD	Rigid ceiling directly applied or 10-0-0 oc bracing.
WEBS	2x4 SPF No.2		

REACTIONS. (size) 6=Mechanical, 2=0-4-3
 Max Horz 2=58(LC 7)
 Max Uplift 6=-24(LC 8), 2=-158(LC 4)
 Max Grav 6=117(LC 37), 2=388(LC 1)

FORCES. (lb) - Max. Comp./Max. Ten. - All forces 250 (lb) or less except when shown.

NOTES-

- 1) Wind: ASCE 7-16; Vult=115mph (3-second gust) Vasd=91mph; TCDL=6.0psf; BCDL=4.2psf; h=15ft; Cat. II; Exp C; Enclosed; MWFRS (envelope) gable end zone; cantilever left and right exposed; end vertical left and right exposed; Lumber DOL=1.60 plate grip DOL=1.60
- 2) This truss has been designed for a 10.0 psf bottom chord live load nonconcurrent with any other live loads.
- 3) Refer to girder(s) for truss to truss connections.
- 4) Provide mechanical connection (by others) of truss to bearing plate capable of withstanding 24 lb uplift at joint 6 and 158 lb uplift at joint 2.
- 5) This truss is designed in accordance with the 2018 International Residential Code sections R502.11.1 and R802.10.2 and referenced standard ANSI/TPI 1.
- 6) Hanger(s) or other connection device(s) shall be provided sufficient to support concentrated load(s) 81 lb down and 170 lb up at 1-8-1, and 14 lb down and 27 lb up at 1-8-1 on top chord, and 11 lb down and 63 lb up at 1-8-1, and 8 lb down and 0 lb up at 1-8-1 on bottom chord. The design/selection of such connection device(s) is the responsibility of others.
- 7) In the LOAD CASE(S) section, loads applied to the face of the truss are noted as front (F) or back (B).

LOAD CASE(S) Standard

- 1) Dead + Roof Live (balanced): Lumber Increase=1.15, Plate Increase=1.15
 Uniform Loads (plf)
 Vert: 1-3=-70, 3-4=-20, 5-7=-20
 Concentrated Loads (lb)
 Vert: 10=48(B) 11=24(F=-8, B=32)



June 12, 2023


Job	Truss	Truss Type	Qty	Ply	Summit/185 Highland Meadows
3664536	CJ6	Diagonal Hip Girder	1	1	

AS NOTED FOR PLAN REVIEW
DEVELOPMENT SERVICES
LEE'S SUMMIT, MISSOURI

Builders FirstSource (Valley Center), Valley Center, KS - 67147,

8.630 s Nov 19 2022 MiTek Industries, Inc. Thu Jun 21 14:12:06 2023 Page 1

10/10/2023

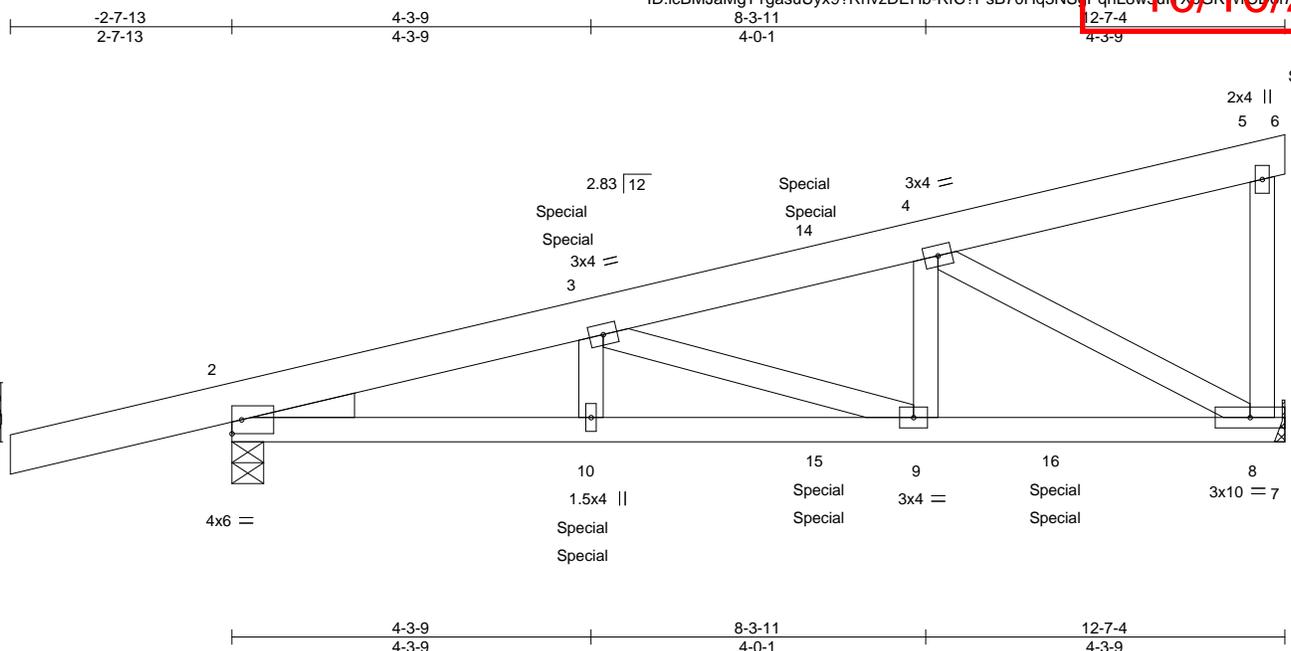

Scale = 1:27.4

LOADING (psf)	SPACING-	2-0-0	CSI.	DEFL.	in (loc)	l/defl	L/d	PLATES	GRIP
TCLL 25.0	Plate Grip DOL	1.15	TC 0.49	Vert(LL)	-0.06 8-9	>999	240	MT20	197/144
TCDL 10.0	Lumber DOL	1.15	BC 0.88	Vert(CT)	-0.12 8-9	>999	180		
BCLL 0.0	Rep Stress Incr	NO	WB 0.52	Horz(CT)	0.03 8	n/a	n/a		
BCDL 10.0	Code IRC2018/TPI2014		Matrix-MS					Weight: 60 lb	FT = 20%

LUMBER-	BRACING-
TOP CHORD 2x6 SPF No.2	TOP CHORD Structural wood sheathing directly applied or 5-4-8 oc purlins, except end verticals.
BOT CHORD 2x4 SPF 1650F 1.5E	BOT CHORD Rigid ceiling directly applied or 10-0-0 oc bracing.
WEBS 2x4 SPF No.2	
WEDGE	
Left: 2x4 SP No.3	

REACTIONS. (size) 2=0-4-9, 8=Mechanical
 Max Horz 2=114(LC 7)
 Max Uplift 2=-232(LC 4), 8=-189(LC 8)
 Max Grav 2=923(LC 1), 8=1042(LC 1)

FORCES. (lb) - Max. Comp./Max. Ten. - All forces 250 (lb) or less except when shown.
 TOP CHORD 2-3=-1501/243, 3-4=-1348/243
 BOT CHORD 2-10=-260/1397, 9-10=-260/1397, 8-9=-236/1296
 WEBS 4-9=-71/579, 4-8=-1429/281

- NOTES-**
- 1) Wind: ASCE 7-16; Vult=115mph (3-second gust) Vasd=91mph; TCDL=6.0psf; BCDL=4.2psf; h=15ft; Cat. II; Exp C; Enclosed; MWFRS (envelope) gable end zone; cantilever left and right exposed; end vertical left and right exposed; Lumber DOL=1.60 plate grip DOL=1.60
 - 2) This truss has been designed for a 10.0 psf bottom chord live load nonconcurrent with any other live loads.
 - 3) Refer to girder(s) for truss to truss connections.
 - 4) Provide mechanical connection (by others) of truss to bearing plate capable of withstanding 232 lb uplift at joint 2 and 189 lb uplift at joint 8.
 - 5) This truss is designed in accordance with the 2018 International Residential Code sections R502.11.1 and R802.10.2 and referenced standard ANSI/TPI 1.
 - 6) Hanger(s) or other connection device(s) shall be provided sufficient to support concentrated load(s) 21 lb down and 35 lb up at 4-2-8, 21 lb down and 35 lb up at 4-2-8, and 49 lb down and 72 lb up at 7-0-7, and 49 lb down and 72 lb up at 7-0-7 on top chord, and 12 lb down at 4-2-8, 12 lb down at 4-2-8, 32 lb down at 7-0-7, 32 lb down at 7-0-7, and 263 lb down and 86 lb up at 9-10-6, and 263 lb down and 86 lb up at 9-10-6 on bottom chord. The design/selection of such connection device(s) is the responsibility of others.
 - 7) In the LOAD CASE(S) section, loads applied to the face of the truss are noted as front (F) or back (B).

LOAD CASE(S) Standard

- 1) Dead + Roof Live (balanced): Lumber Increase=1.15, Plate Increase=1.15
 Uniform Loads (plf)
 Vert: 1-5=-70, 5-6=-20, 7-11=-20
 Concentrated Loads (lb)
 Vert: 10=-1(F=-1, B=-1) 14=-78(F=-39, B=-39) 15=-54(F=-27, B=-27) 16=-526(F=-263, B=-263)



June 12, 2023

Job 3664536	Truss CJ7	Truss Type Jack-Open	Qty 1	Ply 1	Summit/185 Highland Meadows Job Reference (optional)	AS NOTED FOR PLAN REVIEW DEVELOPMENT SERVICES LEE'S SUMMIT, MISSOURI
----------------	--------------	-------------------------	----------	----------	---	--

Builders FirstSource (Valley Center), Valley Center, KS - 67147,

8.630 s Nov 19 2022 MiTek Industries, Inc. Thu Jun 21 14:12:07 2023 Page 1

ID:icBMJaMgT1gasuUyx9?RhvzDEHb-RfC?PsB70Hq3NSuPqnL8wGulTXbGKVICd7f7JzICP

10/10/2023

-2-7-13
2-7-13

1-9-2
1-9-2

Scale = 1:8.5

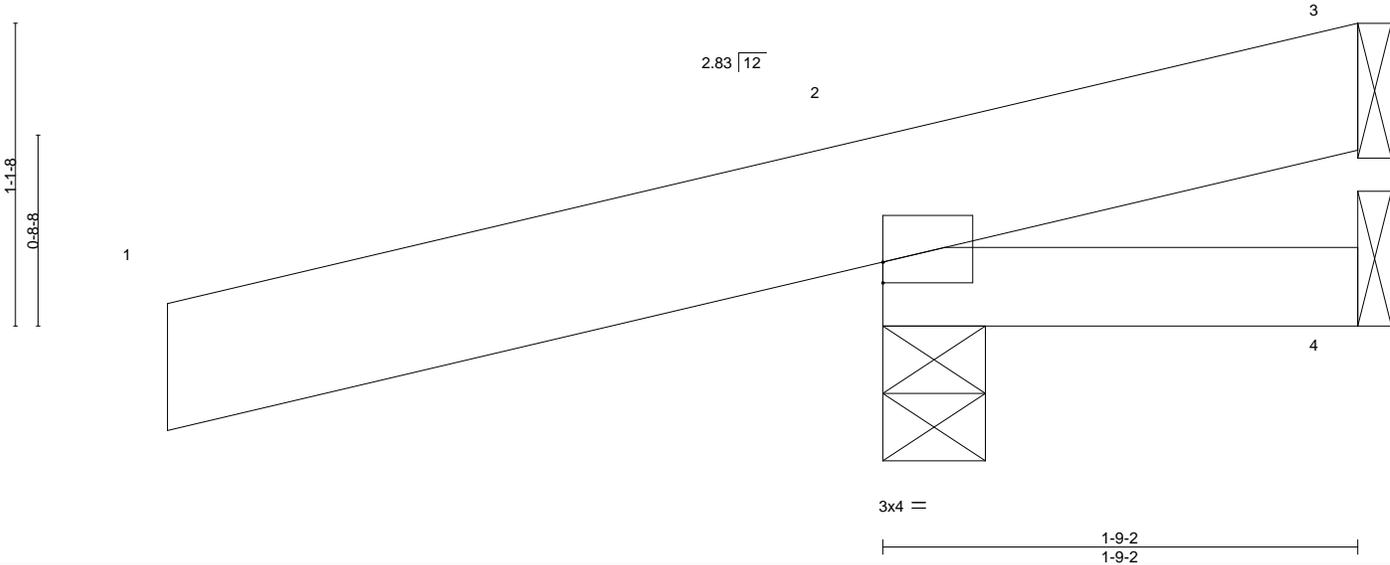


Plate Offsets (X,Y)-- [2:0-0-0,0-0-15]

LOADING (psf)	SPACING-	2-0-0	CSI.	DEFL.	in	(loc)	l/defl	L/d	PLATES	GRIP
TCLL 25.0	Plate Grip DOL	1.15	TC 0.22	Vert(LL)	0.00	7	>999	240	MT20	197/144
TCDL 10.0	Lumber DOL	1.15	BC 0.08	Vert(CT)	0.00	7	>999	180		
BCLL 0.0	Rep Stress Incr	YES	WB 0.00	Horz(CT)	-0.00	3	n/a	n/a		
BCDL 10.0	Code	IRC2018/TPI2014	Matrix-MP						Weight: 10 lb	FT = 20%

LUMBER-
TOP CHORD 2x6 SPF No.2
BOT CHORD 2x4 SPF No.2

BRACING-
TOP CHORD Structural wood sheathing directly applied or 1-9-2 oc purlins.
BOT CHORD Rigid ceiling directly applied or 10-0-0 oc bracing.

REACTIONS. (size) 3=Mechanical, 2=0-4-9, 4=Mechanical
Max Horz 2=46(LC 8)
Max Uplift 3=50(LC 1), 2=181(LC 8), 4=12(LC 1)
Max Grav 3=36(LC 8), 2=405(LC 1), 4=19(LC 3)

FORCES. (lb) - Max. Comp./Max. Ten. - All forces 250 (lb) or less except when shown.

NOTES-

- 1) Wind: ASCE 7-16; Vult=115mph (3-second gust) Vasd=91mph; TCDL=6.0psf; BCDL=4.2psf; h=15ft; Cat. II; Exp C; Enclosed; MWFRS (envelope) gable end zone and C-C Corner(3) zone; cantilever left and right exposed; end vertical left and right exposed; C-C for members and forces & MWFRS for reactions shown; Lumber DOL=1.60 plate grip DOL=1.60
- 2) This truss has been designed for a 10.0 psf bottom chord live load nonconcurrent with any other live loads.
- 3) Refer to girder(s) for truss to truss connections.
- 4) Provide mechanical connection (by others) of truss to bearing plate capable of withstanding 50 lb uplift at joint 3, 181 lb uplift at joint 2 and 12 lb uplift at joint 4.
- 5) This truss is designed in accordance with the 2018 International Residential Code sections R502.11.1 and R802.10.2 and referenced standard ANSI/TPI 1.



June 12, 2023

WARNING - Verify design parameters and READ NOTES ON THIS AND INCLUDED MITEK REFERENCE PAGE MII-7473 rev. 1/2/2023 BEFORE USE.

Design valid for use only with MiTek® connectors. This design is based only upon parameters shown, and is for an individual building component, not a truss system. Before use, the building designer must verify the applicability of design parameters and properly incorporate this design into the overall building design. Bracing indicated is to prevent buckling of individual truss web and/or chord members only. Additional temporary and permanent bracing is always required for stability and to prevent collapse with possible personal injury and property damage. For general guidance regarding the fabrication, storage, delivery, erection and bracing of trusses and truss systems, see **ANSI/TPI1 Quality Criteria, and DSB-22** available from Truss Plate Institute (www.tpinst.org) and **BCSI Building Component Safety Information** available from the Structural Building Component Association (www.sbcsccomponents.com)

MiTek®

16023 Swingley Ridge Rd.
Chesterfield, MO 63017
314.434.1200 / MiTek-US.com

Job 3664536	Truss CJ8	Truss Type Diagonal Hip Girder	Qty 1	Ply 1	Summit/185 Highland Meadows Job Reference (optional)
----------------	--------------	-----------------------------------	----------	----------	---


AS NOTED FOR PLAN REVIEW
DEVELOPMENT SERVICES
LEE'S SUMMIT, MISSOURI

Builders FirstSource (Valley Center), Valley Center, KS - 67147,

8.630 s Nov 19 2022 MiTek Industries, Inc. Thu Jun 21 14:12:08 2023 Page 1

ID:icBMJaMgT1gasuUyx9?RhvzDEHb-RIC?PsB70Hq3NSpPqnL8w3ulTXbGKVICDm7JzICP

10/10/2023

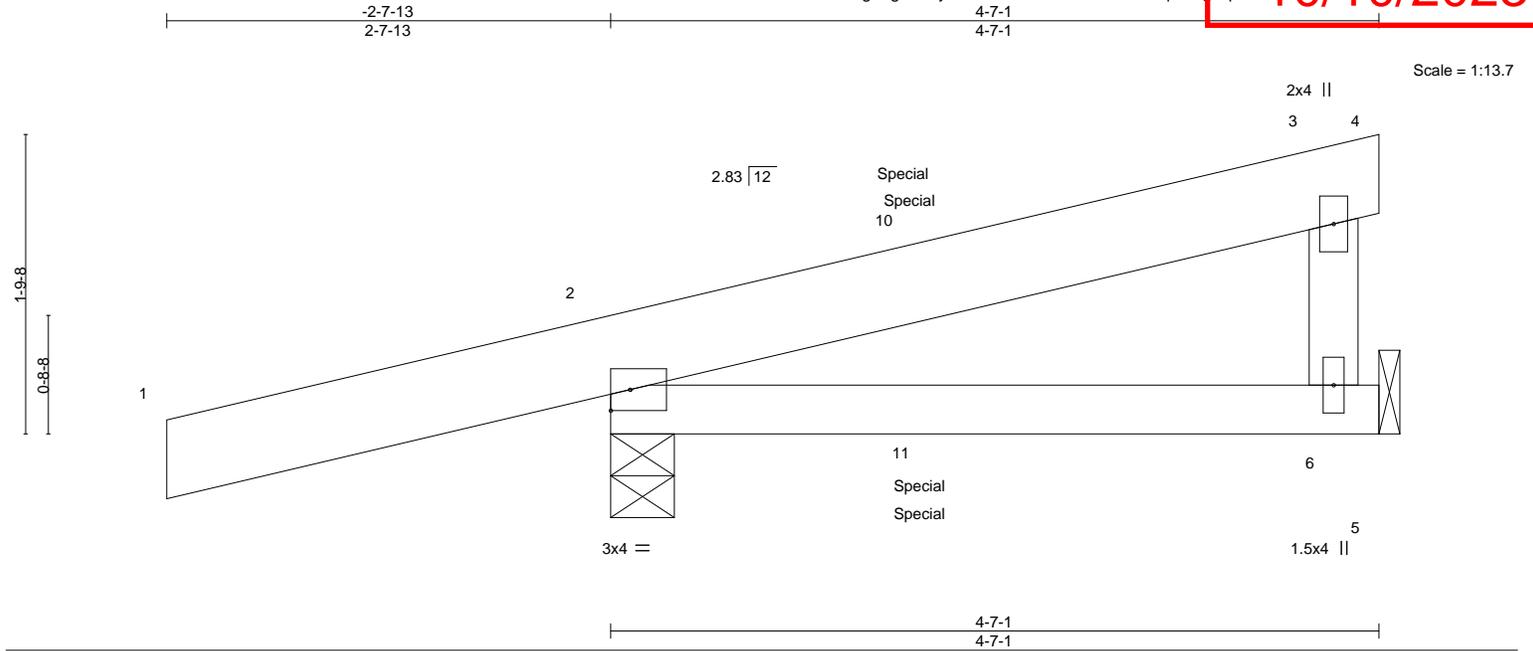

LOADING (psf)	SPACING-	2-0-0	CSI.	DEFL.	in (loc)	l/defl	L/d	PLATES	GRIP
TCLL 25.0	Plate Grip DOL	1.15	TC 0.31	Vert(LL)	0.02 6-9	>999	240	MT20	197/144
BCDL 10.0	Lumber DOL	1.15	BC 0.23	Vert(CT)	0.03 6-9	>999	180		
BCLL 0.0	Rep Stress Incr	NO	WB 0.00	Horz(CT)	-0.01 2	n/a	n/a		
BCDL 10.0	Code IRC2018/TPI2014		Matrix-MP					Weight: 20 lb	FT = 20%

LUMBER-	BRACING-
TOP CHORD 2x6 SPF No.2	TOP CHORD Structural wood sheathing directly applied or 4-7-1 oc purlins, except end verticals.
BOT CHORD 2x4 SPF No.2	BOT CHORD Rigid ceiling directly applied or 10-0-0 oc bracing.
WEBS 2x4 SPF No.2	

REACTIONS. (size) 6=Mechanical, 2=0-4-9
 Max Horz 2=60(LC 7)
 Max Uplift 6=31(LC 21), 2=151(LC 4)
 Max Grav 6=119(LC 37), 2=354(LC 1)

FORCES. (lb) - Max. Comp./Max. Ten. - All forces 250 (lb) or less except when shown.

NOTES-

- 1) Wind: ASCE 7-16; Vult=115mph (3-second gust) Vasd=91mph; TCDL=6.0psf; BCDL=4.2psf; h=15ft; Cat. II; Exp C; Enclosed; MWFRS (envelope) gable end zone; cantilever left and right exposed ; end vertical left and right exposed; Lumber DOL=1.60 plate grip DOL=1.60
- 2) This truss has been designed for a 10.0 psf bottom chord live load nonconcurrent with any other live loads.
- 3) Refer to girder(s) for truss to truss connections.
- 4) Provide mechanical connection (by others) of truss to bearing plate capable of withstanding 31 lb uplift at joint 6 and 151 lb uplift at joint 2.
- 5) This truss is designed in accordance with the 2018 International Residential Code sections R502.11.1 and R802.10.2 and referenced standard ANSI/TPI 1.
- 6) Hanger(s) or other connection device(s) shall be provided sufficient to support concentrated load(s) 73 lb down and 152 lb up at 1-10-3, and 73 lb down and 152 lb up at 1-10-3 on top chord, and 11 lb down and 58 lb up at 1-10-3, and 11 lb down and 58 lb up at 1-10-3 on bottom chord. The design/selection of such connection device(s) is the responsibility of others.
- 7) In the LOAD CASE(S) section, loads applied to the face of the truss are noted as front (F) or back (B).

LOAD CASE(S) Standard

- 1) Dead + Roof Live (balanced): Lumber Increase=1.15, Plate Increase=1.15
 Uniform Loads (plf)
 Vert: 1-3=-70, 3-4=-20, 5-7=-20
 Concentrated Loads (lb)
 Vert: 10=86(F=43, B=43) 11=59(F=30, B=30)



June 12, 2023

Job 3664536	Truss CJ9	Truss Type Jack-Open	Qty 2	Ply 1	Summit/185 Highland Meadows Job Reference (optional)
----------------	--------------	-------------------------	----------	----------	---

AS NOTED FOR PLAN REVIEW
DEVELOPMENT SERVICES
LEE'S SUMMIT, MISSOURI

Builders FirstSource (Valley Center), Valley Center, KS - 67147,

8.630 s Nov 19 2022 MiTek Industries, Inc. Thu Jun 21 14:13:09 2023 Page 1

ID:icBMJaMgT1gasuUyx9?RhvzDEHb-RfC?PsB70Hq3NSyPqnL8w3ulTXbGKVICDm7JzJICP?

10/10/2023

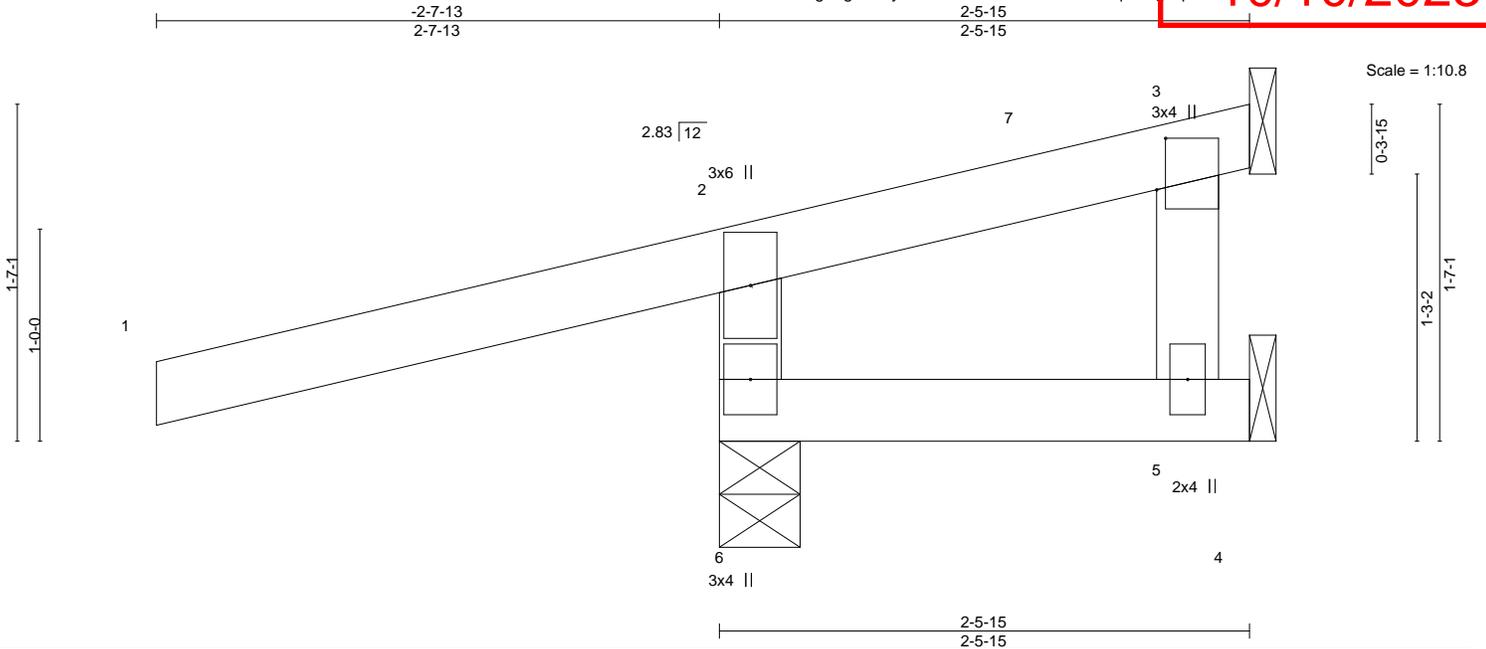


Plate Offsets (X,Y)--	[3:0-2-15,0-0-8]				
LOADING (psf)	SPACING- 2-0-0	CSI.	DEFL. in (loc) l/defl L/d	PLATES	GRIP
TCLL 25.0	Plate Grip DOL 1.15	TC 0.55	Vert(LL) 0.00 5-6 >999 240	MT20	197/144
TCDL 10.0	Lumber DOL 1.15	BC 0.18	Vert(CT) 0.00 5-6 >999 180		
BCLL 0.0	Rep Stress Incr YES	WB 0.00	Horz(CT) -0.02 3 n/a n/a		
BCDL 10.0	Code IRC2018/TPI2014	Matrix-MP		Weight: 11 lb	FT = 20%

LUMBER-	BRACING-
TOP CHORD 2x4 SPF No.2	TOP CHORD Structural wood sheathing directly applied or 2-5-15 oc purlins, except end verticals.
BOT CHORD 2x4 SPF No.2	BOT CHORD Rigid ceiling directly applied or 10-0-0 oc bracing.
WEBS 2x4 SPF No.2	

REACTIONS. (size) 6=0-4-9, 5=Mechanical, 3=Mechanical
 Max Horz 6=37(LC 11)
 Max Uplift 6=-177(LC 8), 5=-17(LC 25), 3=-68(LC 25)
 Max Grav 6=421(LC 1), 5=40(LC 3), 3=18(LC 8)

FORCES. (lb) - Max. Comp./Max. Ten. - All forces 250 (lb) or less except when shown.
 TOP CHORD 2-6=-361/340

- NOTES-**
- 1) Unbalanced roof live loads have been considered for this design.
 - 2) Wind: ASCE 7-16; Vult=115mph (3-second gust) Vasd=91mph; TCDL=6.0psf; BCDL=4.2psf; h=15ft; Cat. II; Exp C; Enclosed; MWFRS (envelope) gable end zone and C-C Corner(3) -2-7-13 to 1-7-1, Exterior(2R) 1-7-1 to 2-2-7 zone; cantilever left and right exposed ; end vertical left and right exposed;C-C for members and forces & MWFRS for reactions shown; Lumber DOL=1.60 plate grip DOL=1.60
 - 3) This truss has been designed for a 10.0 psf bottom chord live load nonconcurrent with any other live loads.
 - 4) Refer to girder(s) for truss to truss connections.
 - 5) Provide mechanical connection (by others) of truss to bearing plate capable of withstanding 177 lb uplift at joint 6, 17 lb uplift at joint 5 and 68 lb uplift at joint 3.
 - 6) This truss is designed in accordance with the 2018 International Residential Code sections R502.11.1 and R802.10.2 and referenced standard ANSI/TPI 1.
 - 7) Gap between inside of top chord bearing and first diagonal or vertical web shall not exceed 0.500in.



June 12, 2023

WARNING - Verify design parameters and READ NOTES ON THIS AND INCLUDED MITEK REFERENCE PAGE MII-7473 rev. 1/2/2023 BEFORE USE.

Design valid for use only with MiTek® connectors. This design is based only upon parameters shown, and is for an individual building component, not a truss system. Before use, the building designer must verify the applicability of design parameters and properly incorporate this design into the overall building design. Bracing indicated is to prevent buckling of individual truss web and/or chord members only. Additional temporary and permanent bracing is always required for stability and to prevent collapse with possible personal injury and property damage. For general guidance regarding the fabrication, storage, delivery, erection and bracing of trusses and truss systems, see **ANSI/TPI1 Quality Criteria, and DSB-22** available from Truss Plate Institute (www.tpinst.org) and **BCSI Building Component Safety Information** available from the Structural Building Component Association (www.sbcsccomponents.com)

MiTek®


16023 Swingley Ridge Rd.
 Chesterfield, MO 63017
 314.434.1200 / MiTek-US.com

Job 3664536	Truss CJ10	Truss Type Jack-Open	Qty 2	Ply 1	Summit/185 Highland Meadows Job Reference (optional)
----------------	---------------	-------------------------	----------	----------	---

AS NOTED FOR PLAN REVIEW
DEVELOPMENT SERVICES
LEE'S SUMMIT, MISSOURI

Builders FirstSource (Valley Center), Valley Center, KS - 67147, 8.630 s Nov 19 2022 MiTek Industries, Inc. Thu Jun 21 14:12:00 2023 Page 1
ID:icBMJaMgT1gasuUyx9?RhvzDEHb-RfC?PsB70Hq3NSpPqnL8wGulTXbGKVICDgr7JzICP?

10/10/2023

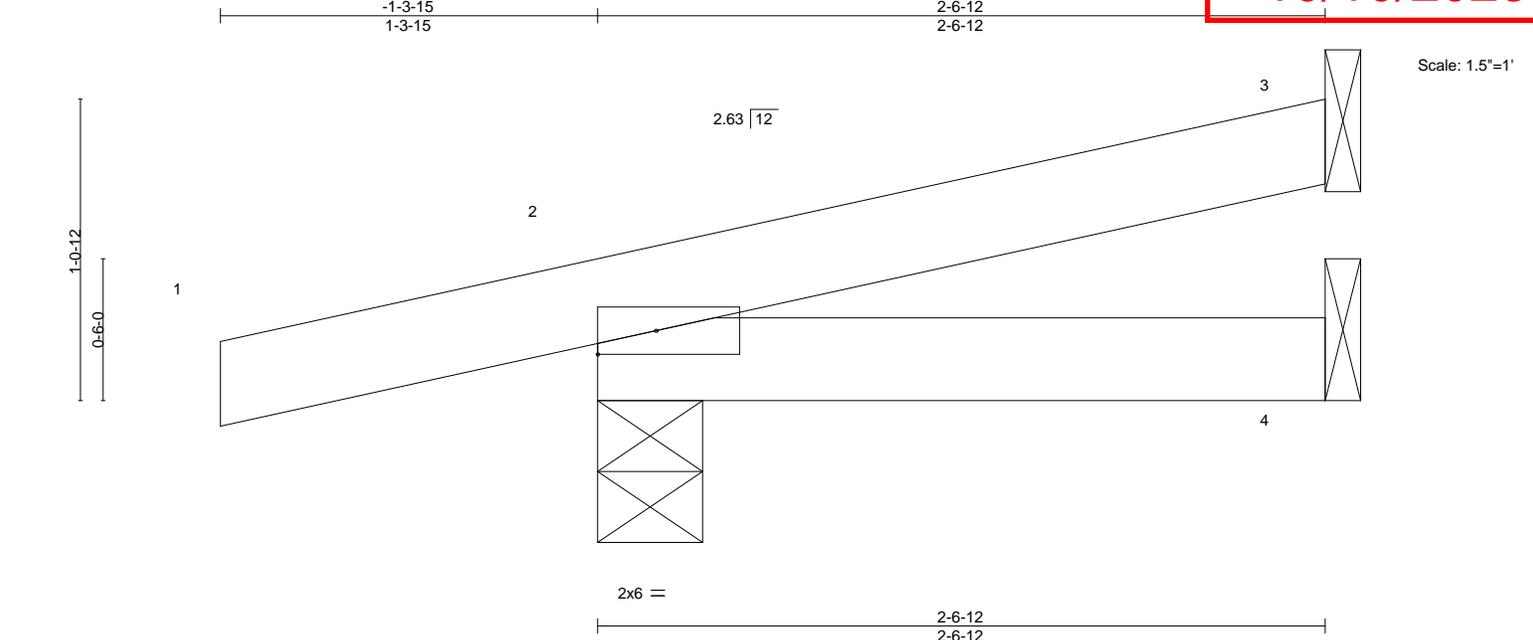

LOADING (psf)	SPACING-	CSI.	DEFL.	PLATES	GRIP
TCLL 25.0	2-0-0	TC 0.11	in (loc) l/defl L/d	MT20	197/144
TCDL 10.0	Plate Grip DOL 1.15	BC 0.04	Vert(LL) -0.00 7 >999 240		
BCLL 0.0	Lumber DOL 1.15	WB 0.00	Vert(CT) -0.00 4-7 >999 180		
BCDL 10.0	Rep Stress Incr YES	Matrix-MP	Horz(CT) 0.00 3 n/a n/a		
	Code IRC2018/TPI2014			Weight: 8 lb	FT = 20%

LUMBER-
TOP CHORD 2x4 SPF No.2
BOT CHORD 2x4 SPF No.2

BRACING-
TOP CHORD Structural wood sheathing directly applied or 2-6-12 oc purlins.
BOT CHORD Rigid ceiling directly applied or 10-0-0 oc bracing.

REACTIONS. (size) 3=Mechanical, 2=0-4-7, 4=Mechanical
Max Horz 2=34(LC 8)
Max Uplift 3=-23(LC 12), 2=-78(LC 8)
Max Grav 3=64(LC 1), 2=230(LC 1), 4=42(LC 3)

FORCES. (lb) - Max. Comp./Max. Ten. - All forces 250 (lb) or less except when shown.

- NOTES-**
- 1) Wind: ASCE 7-16; Vult=115mph (3-second gust) Vasd=91mph; TCDL=6.0psf; BCDL=4.2psf; h=15ft; Cat. II; Exp C; Enclosed; MWFRS (envelope) gable end zone and C-C Corner(3) zone; cantilever left and right exposed ; end vertical left and right exposed;C-C for members and forces & MWFRS for reactions shown; Lumber DOL=1.60 plate grip DOL=1.60
 - 2) This truss has been designed for a 10.0 psf bottom chord live load nonconcurrent with any other live loads.
 - 3) Refer to girder(s) for truss to truss connections.
 - 4) Provide mechanical connection (by others) of truss to bearing plate capable of withstanding 23 lb uplift at joint 3 and 78 lb uplift at joint 2.
 - 5) This truss is designed in accordance with the 2018 International Residential Code sections R502.11.1 and R802.10.2 and referenced standard ANSI/TPI 1.




June 12, 2023

Job 3664536	Truss D1	Truss Type Hip Girder	Qty 1	Ply 1	Summit/185 Highland Meadows	AS NOTED FOR PLAN REVIEW DEVELOPMENT SERVICES LEE'S SUMMIT, MISSOURI
----------------	-------------	--------------------------	----------	----------	-----------------------------	--

RELEASE FOR CONSTRUCTION
10/10/2023

Builders FirstSource (Valley Center), Valley Center, KS - 67147, 8.630 s Nov 19 2022 MiTek Industries, Inc. Thu Jun 8 14:12:10 2023 Page 1
 ID:icBMJaMgT1gasuUyx9?RhvzDEHb-RIC?PsB70Hq3NSpPqnL8w3ulTXbGKVICd7JzZIC?P

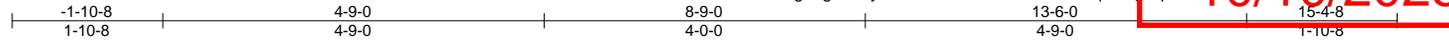

Scale = 1:28.6

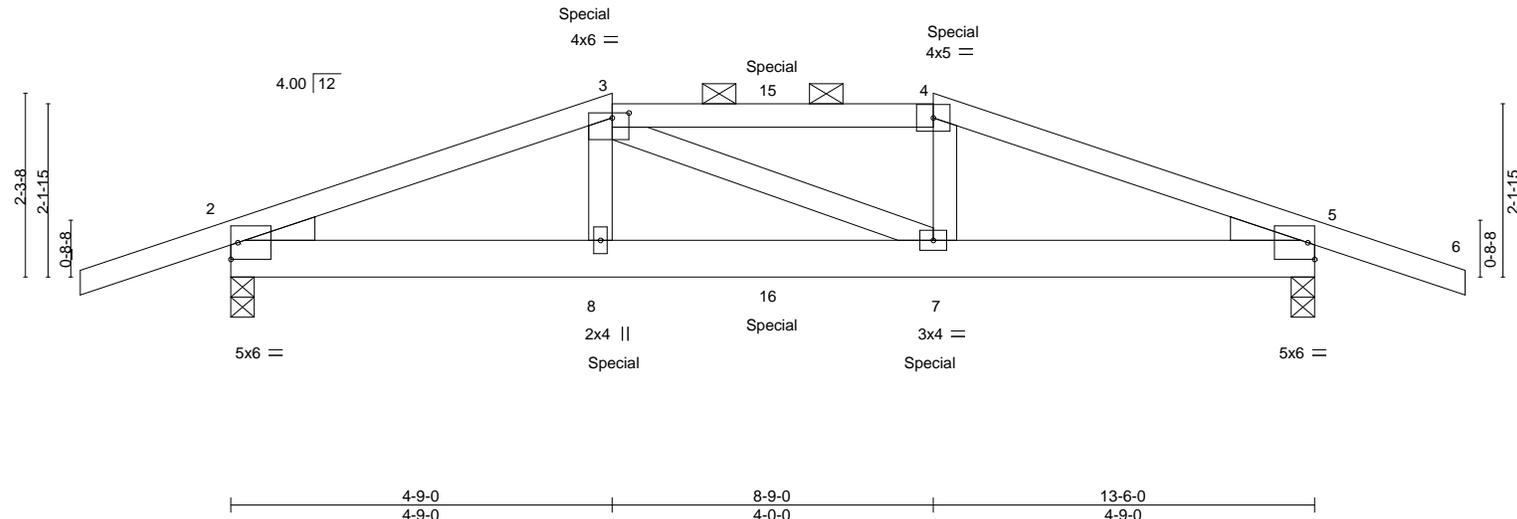


Plate Offsets (X, Y)--	[3:0-2-8, 0-0-12]
------------------------	-------------------

LOADING (psf)	SPACING-	2-0-0	CSI.	DEFL.	in (loc)	l/defl	L/d	PLATES	GRIP
TCLL 25.0	Plate Grip DOL	1.15	TC 0.55	Vert(LL)	-0.08	7-8	>999	MT20	197/144
TCDL 10.0	Lumber DOL	1.15	BC 0.78	Vert(CT)	-0.14	7-8	>999		
BCLL 0.0	Rep Stress Incr	NO	WB 0.07	Horz(CT)	0.03	5	n/a		
BCDL 10.0	Code IRC2018/TPI2014		Matrix-MS						
								Weight: 56 lb	FT = 20%

LUMBER-	BRACING-
TOP CHORD 2x4 SPF No.2	TOP CHORD Structural wood sheathing directly applied or 3-8-12 oc purlins, except
BOT CHORD 2x6 SPF No.2	2-0-0 oc purlins (3-9-5 max.): 3-4.
WEBS 2x4 SPF No.2	BOT CHORD Rigid ceiling directly applied or 10-0-0 oc bracing.
WEDGE	
Left: 2x4 SP No.3 , Right: 2x4 SP No.3	

REACTIONS. (size) 2=0-3-8, 5=0-3-8
 Max Horz 2=-36(LC 26)
 Max Uplift 2=-260(LC 4), 5=-260(LC 5)
 Max Grav 2=1108(LC 1), 5=1108(LC 1)

FORCES. (lb) - Max. Comp./Max. Ten. - All forces 250 (lb) or less except when shown.
 TOP CHORD 2-3=-1988/371, 3-4=-1810/369, 4-5=-1980/369
 BOT CHORD 2-8=-319/1836, 7-8=-320/1817, 5-7=-305/1828
 WEBS 3-8=0/300, 4-7=0/297

- NOTES-**
- Unbalanced roof live loads have been considered for this design.
 - Wind: ASCE 7-16; Vult=115mph (3-second gust) Vasd=91mph; TCDL=6.0psf; BCDL=4.2psf; h=15ft; Cat. II; Exp C; Enclosed; MWFRS (envelope) gable end zone; cantilever left and right exposed ; end vertical left and right exposed; Lumber DOL=1.60 plate grip DOL=1.60
 - Provide adequate drainage to prevent water ponding.
 - This truss has been designed for a 10.0 psf bottom chord live load nonconcurrent with any other live loads.
 - Provide mechanical connection (by others) of truss to bearing plate capable of withstanding 260 lb uplift at joint 2 and 260 lb uplift at joint 5.
 - This truss is designed in accordance with the 2018 International Residential Code sections R502.11.1 and R802.10.2 and referenced standard ANSI/TPI 1.
 - Graphical purlin representation does not depict the size or the orientation of the purlin along the top and/or bottom chord.
 - Hanger(s) or other connection device(s) shall be provided sufficient to support concentrated load(s) 85 lb down and 62 lb up at 4-9-0, and 62 lb down and 54 lb up at 6-9-0, and 85 lb down and 62 lb up at 8-9-0 on top chord, and 260 lb down and 77 lb up at 4-9-0, and 40 lb down at 6-9-0, and 260 lb down and 77 lb up at 8-8-4 on bottom chord. The design/selection of such connection device(s) is the responsibility of others.
 - In the LOAD CASE(S) section, loads applied to the face of the truss are noted as front (F) or back (B).

LOAD CASE(S) Standard
 1) Dead + Roof Live (balanced): Lumber Increase=1.15, Plate Increase=1.15
 Uniform Loads (plf)
 Vert: 1-3=-70, 3-4=-70, 4-6=-70, 9-12=-20



June 12, 2023

Continued on page 2

<p>WARNING - Verify design parameters and READ NOTES ON THIS AND INCLUDED MITEK REFERENCE PAGE MII-7473 rev. 1/2/2023 BEFORE USE.</p> <p>Design valid for use only with MiTek® connectors. This design is based only upon parameters shown, and is for an individual building component, not a truss system. Before use, the building designer must verify the applicability of design parameters and properly incorporate this design into the overall building design. Bracing indicated is to prevent buckling of individual truss web and/or chord members only. Additional temporary and permanent bracing is always required for stability and to prevent collapse with possible personal injury and property damage. For general guidance regarding the fabrication, storage, delivery, erection and bracing of trusses and truss systems, see ANSI/TPI1 Quality Criteria, and DSB-22 available from Truss Plate Institute (www.tpinst.org) and BCSI Building Component Safety Information available from the Structural Building Component Association (www.sbcsccomponents.com)</p>	 <p>16023 Swingley Ridge Rd. Chesterfield, MO 63017 314.434.1200 / MiTek-US.com</p>
---	--

Job	Truss	Truss Type	Qty	Ply	Summit/185 Highland Meadows
3664536	D1	Hip Girder	1	1	Job Reference (optional)

RELEASE FOR CONSTRUCTION

AS NOTED FOR PLAN REVIEW

DEVELOPMENT SERVICES

LEE'S SUMMIT, MISSOURI

10/10/2023

Builders FirstSource (Valley Center), Valley Center, KS - 67147,

8.630 s Nov 19 2022 MiTek Industries, Inc. Thu Jun 14 12:11:2023 Page 2
 ID:icBMJaMgT1gasuUyx9?RhvzDEHb-RfC?PsB70Hq3NSpPqnL8w3ulTXbGKVICU7J4ZIC?

LOAD CASE(S) Standard

Concentrated Loads (lb)

Vert: 3=-62(F) 4=-62(F) 8=-260(F) 7=-260(F) 15=-62(F) 16=-33(F)

WARNING - Verify design parameters and READ NOTES ON THIS AND INCLUDED MITEK REFERENCE PAGE MII-7473 rev. 1/2/2023 BEFORE USE.

Design valid for use only with MiTek® connectors. This design is based only upon parameters shown, and is for an individual building component, not a truss system. Before use, the building designer must verify the applicability of design parameters and properly incorporate this design into the overall building design. Bracing indicated is to prevent buckling of individual truss web and/or chord members only. Additional temporary and permanent bracing is always required for stability and to prevent collapse with possible personal injury and property damage. For general guidance regarding the fabrication, storage, delivery, erection and bracing of trusses and truss systems, see **ANSI/TPI1 Quality Criteria, and DSB-22** available from Truss Plate Institute (www.tpinst.org) and **BCSI Building Component Safety Information** available from the Structural Building Component Association (www.sbcsccomponents.com)

MiTek®

16023 Swingley Ridge Rd.
 Chesterfield, MO 63017
 314.434.1200 / MiTek-US.com

Job	Truss	Truss Type	Qty	Ply	Summit/185 Highland Meadows
3664536	D2	Common	2	1	

RELEASE FOR CONSTRUCTION

AS NOTED FOR PLAN REVIEW

DEVELOPMENT SERVICES

LEE'S SUMMIT, MISSOURI

10/10/2023

Builders FirstSource (Valley Center), Valley Center, KS - 67147, 8.630 s Nov 19 2022 MiTek Industries, Inc. Thu Jun 21 14:12:12 2023 Page 1

ID:icBMJaMgT1gasuUyx9?RhvzDEHb-RfC?PsB70Hq3NSpPqnL8w3ulTXbGKVICd7i7JzUIC? 13-6-0 15-4-8 1-10-8

Scale = 1:27.7

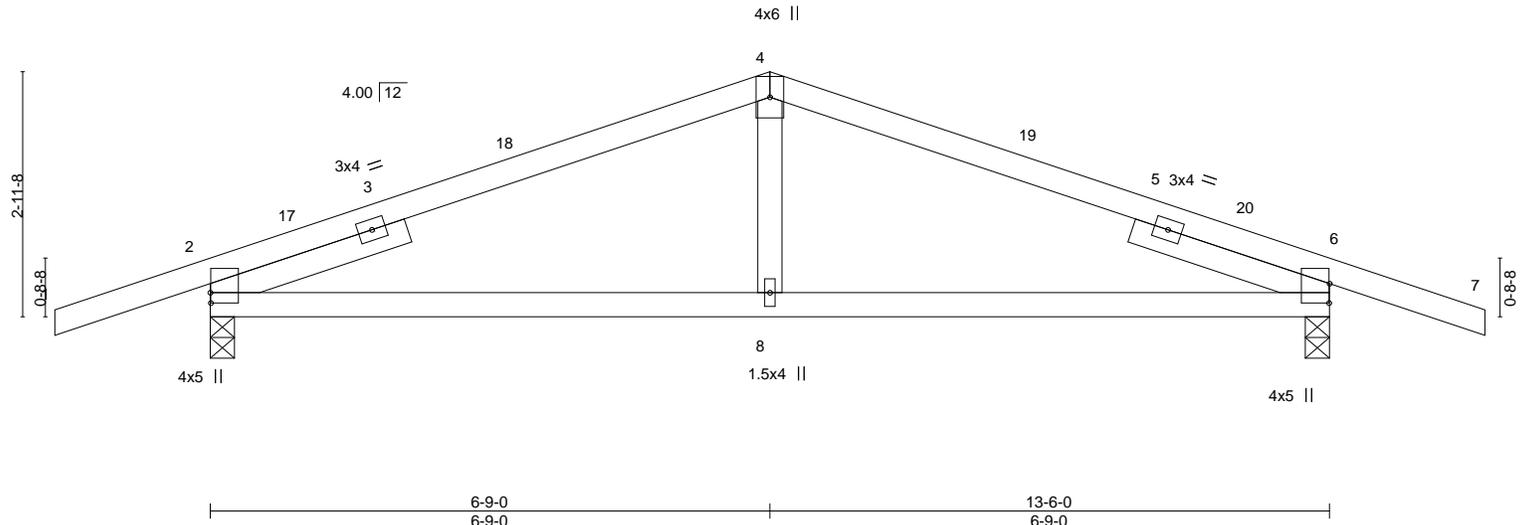


Plate Offsets (X,Y)--	[2:0-1-8,0-0-1], [6:0-2-13,0-0-1]
-----------------------	-----------------------------------

LOADING (psf)	SPACING-	2-0-0	CSI.	DEFL.	in (loc)	l/defl	L/d	PLATES	GRIP
TCLL 25.0	Plate Grip DOL	1.15	TC 0.37	Vert(LL)	-0.05	8-15	>999	MT20	197/144
TCDL 10.0	Lumber DOL	1.15	BC 0.34	Vert(CT)	-0.08	8-15	>999		
BCLL 0.0	Rep Stress Incr	YES	WB 0.06	Horz(CT)	0.02	2	n/a		
BCDL 10.0	Code IRC2018/TPI2014		Matrix-AS						
								Weight: 45 lb	FT = 20%

LUMBER-
TOP CHORD 2x4 SPF No.2
BOT CHORD 2x4 SPF No.2
WEBS 2x4 SPF No.2
SLIDER Left 2x4 SPF No.2 2-6-0, Right 2x4 SPF No.2 2-6-0

BRACING-
TOP CHORD Structural wood sheathing directly applied.
BOT CHORD Rigid ceiling directly applied.

REACTIONS. (size) 2=0-3-8, 6=0-3-8
Max Horz 2=-46(LC 13)
Max Uplift 2=-160(LC 8), 6=-160(LC 9)
Max Grav 2=739(LC 1), 6=739(LC 1)

FORCES. (lb) - Max. Comp./Max. Ten. - All forces 250 (lb) or less except when shown.
TOP CHORD 2-4=-862/264, 4-6=-862/264
BOT CHORD 2-8=-148/813, 6-8=-148/813
WEBS 4-8=0/264

- NOTES-**
- 1) Unbalanced roof live loads have been considered for this design.
 - 2) Wind: ASCE 7-16; Vult=115mph (3-second gust) Vasd=91mph; TCDL=6.0psf; BCDL=4.2psf; h=15ft; Cat. II; Exp C; Enclosed; MWFRS (envelope) gable end zone and C-C Exterior(2E) -1-10-8 to 1-1-8, Interior(1) 1-1-8 to 6-9-0, Exterior(2R) 6-9-0 to 9-9-0, Interior(1) 9-9-0 to 15-4-8 zone; cantilever left and right exposed ; end vertical left and right exposed;C-C for members and forces & MWFRS for reactions shown; Lumber DOL=1.60 plate grip DOL=1.60
 - 3) This truss has been designed for a 10.0 psf bottom chord live load nonconcurrent with any other live loads.
 - 4) Provide mechanical connection (by others) of truss to bearing plate capable of withstanding 160 lb uplift at joint 2 and 160 lb uplift at joint 6.
 - 5) This truss is designed in accordance with the 2018 International Residential Code sections R502.11.1 and R802.10.2 and referenced standard ANSI/TPI 1.
 - 6) This truss design requires that a minimum of 7/16" structural wood sheathing be applied directly to the top chord and 1/2" gypsum sheetrock be applied directly to the bottom chord.



June 12, 2023

Job	Truss	Truss Type	Qty	Ply	Summit/185 Highland Meadows	RELEASE FOR CONSTRUCTION AS NOTED FOR PLAN REVIEW DEVELOPMENT SERVICES LEE'S SUMMIT, MISSOURI
3664536	E1	Hip Girder	1	2	Job Reference (optional)	158877543

Builders FirstSource (Valley Center), Valley Center, KS - 67147,

8.630 s Nov 19 2022 MiTek Industries, Inc. Thu Jun 23 14:12:14 2023 Page 2

ID:icBMJaMgT1gasuUyx9?RhvzDEHb-RfC?PsB70Hq3NSpPqnL8wGulTxbGKVICDg7J4ZIC?10/10/2023

NOTES-

10) Hanger(s) or other connection device(s) shall be provided sufficient to support concentrated load(s) 1383 lb down and 328 lb up at 9-0-0, 370 lb down and 111 lb up at 11-0-12, 370 lb down and 111 lb up at 13-0-12, 370 lb down and 111 lb up at 15-0-12, 370 lb down and 111 lb up at 17-0-12, 370 lb down and 111 lb up at 19-0-12, 370 lb down and 111 lb up at 21-0-12, 370 lb down and 111 lb up at 23-0-12, 370 lb down and 111 lb up at 25-0-12, 370 lb down and 111 lb up at 27-0-12, 370 lb down and 111 lb up at 29-0-12, 365 lb down and 92 lb up at 31-0-12, and 365 lb down and 89 lb up at 33-0-12, and 552 lb down and 122 lb up at 35-0-12 on bottom chord. The design/selection of such connection device(s) is the responsibility of others.

LOAD CASE(S) Standard

1) Dead + Roof Live (balanced): Lumber Increase=1.15, Plate Increase=1.15

Uniform Loads (plf)

Vert: 1-3=-70, 3-8=-70, 8-11=-70, 21-25=-20

Concentrated Loads (lb)

Vert: 19=-1383(F) 14=-370(F) 15=-370(F) 29=-370(F) 30=-370(F) 31=-370(F) 32=-370(F) 33=-370(F) 34=-370(F) 35=-370(F) 36=-370(F) 37=-365(F) 38=-365(F) 39=-552(F)

WARNING - Verify design parameters and READ NOTES ON THIS AND INCLUDED MITEK REFERENCE PAGE MII-7473 rev. 1/2/2023 BEFORE USE.

Design valid for use only with MiTek® connectors. This design is based only upon parameters shown, and is for an individual building component, not a truss system. Before use, the building designer must verify the applicability of design parameters and properly incorporate this design into the overall building design. Bracing indicated is to prevent buckling of individual truss web and/or chord members only. Additional temporary and permanent bracing is always required for stability and to prevent collapse with possible personal injury and property damage. For general guidance regarding the fabrication, storage, delivery, erection and bracing of trusses and truss systems, see **ANSI/TPI1 Quality Criteria, and DSB-22** available from Truss Plate Institute (www.tpinst.org) and **BCSI Building Component Safety Information** available from the Structural Building Component Association (www.sbcsccomponents.com)

MiTek®

16023 Swingley Ridge Rd.
Chesterfield, MO 63017
314.434.1200 / MiTek-US.com


Job 3664536	Truss E2	Truss Type Roof Special Girder	Qty 1	Ply 1	Summit/185 Highland Meadows	AS NOTED FOR PLAN REVIEW DEVELOPMENT SERVICES LEE'S SUMMIT, MISSOURI
----------------	-------------	-----------------------------------	----------	----------	-----------------------------	--

Builders FirstSource (Valley Center), Valley Center, KS - 67147,


8.630 s Nov 19 2022 MiTek Industries, Inc. Thu Jun 14 12:15:2023 Page 1

ID:icBMJaMgT1gasuUyx9?RhvzDEHb-RIC?PsB70Hq3NSuPqnL8wGulTXbGKVICDm7JzJICP

10/10/2023

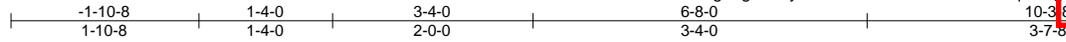

Scale = 1:22.9

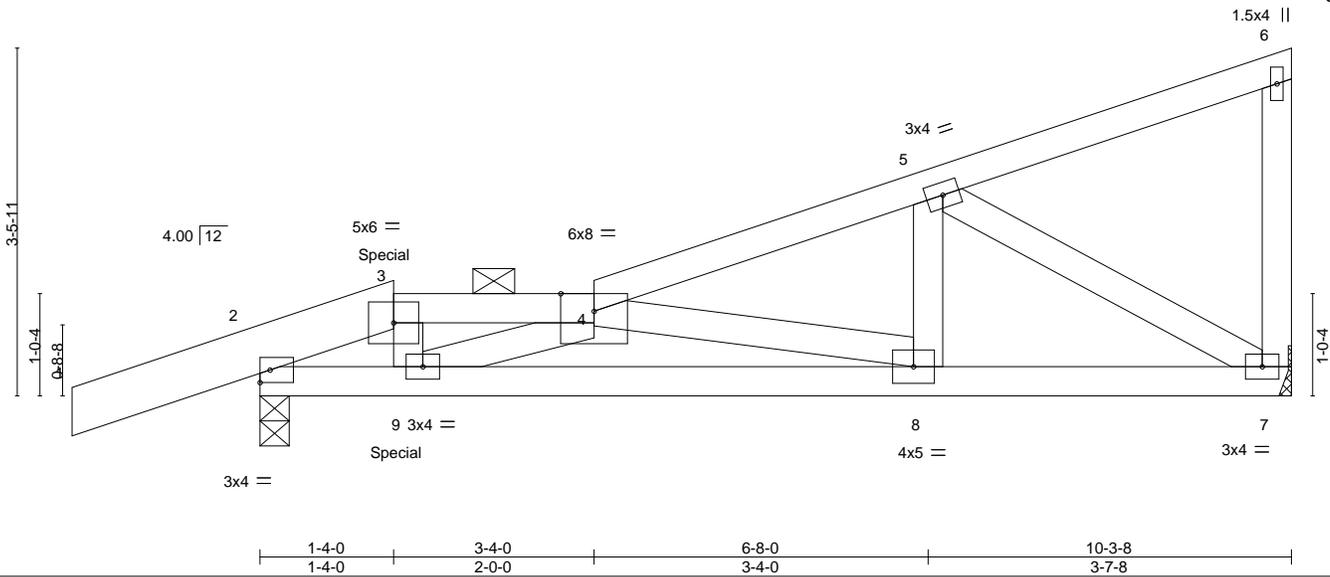

LOADING (psf)	SPACING-	2-0-0	CSI.	DEFL.	in (loc)	l/defl	L/d	PLATES	GRIP
TCLL 25.0	Plate Grip DOL	1.15	TC 0.18	Vert(LL)	-0.03 8-9	>999	240	MT20	197/144
TCDL 10.0	Lumber DOL	1.15	BC 0.38	Vert(CT)	-0.06 8-9	>999	180		
BCLL 0.0	Rep Stress Incr	NO	WB 0.18	Horz(CT)	0.01 7	n/a	n/a		
BCDL 10.0	Code IRC2018/TPI2014		Matrix-MS					Weight: 44 lb	FT = 20%

LUMBER-
 TOP CHORD 2x4 SPF No.2 *Except*
 1-3: 2x6 SPF No.2
 BOT CHORD 2x4 SPF No.2
 WEBS 2x4 SPF No.2

BRACING-
 TOP CHORD Structural wood sheathing directly applied or 6-0-0 oc purlins, except end verticals, and 2-0-0 oc purlins (6-0-0 max.): 3-4.
 BOT CHORD Rigid ceiling directly applied or 10-0-0 oc bracing.

REACTIONS. (size) 7=Mechanical, 2=0-3-8
 Max Horz 2=132(LC 7)
 Max Uplift 7=84(LC 8), 2=123(LC 4)
 Max Grav 7=435(LC 1), 2=538(LC 1)

FORCES. (lb) - Max. Comp./Max. Ten. - All forces 250 (lb) or less except when shown.
 TOP CHORD 2-3=-642/22, 3-4=-603/26, 4-5=-611/84
 BOT CHORD 2-9=-78/494, 8-9=-192/1056, 7-8=-84/555
 WEBS 3-9=-13/282, 4-8=-514/110, 5-8=0/264, 5-7=-626/126, 4-9=-658/212

- NOTES-**
- 1) Wind: ASCE 7-16; Vult=115mph (3-second gust) Vasd=91mph; TCDL=6.0psf; BCDL=4.2psf; h=15ft; Cat. II; Exp C; Enclosed; MWFRS (envelope) gable end zone; cantilever left and right exposed ; end vertical left and right exposed; Lumber DOL=1.60 plate grip DOL=1.60
 - 2) Provide adequate drainage to prevent water ponding.
 - 3) This truss has been designed for a 10.0 psf bottom chord live load nonconcurrent with any other live loads.
 - 4) Refer to girder(s) for truss to truss connections.
 - 5) Provide mechanical connection (by others) of truss to bearing plate capable of withstanding 84 lb uplift at joint 7 and 123 lb uplift at joint 2.
 - 6) This truss is designed in accordance with the 2018 International Residential Code sections R502.11.1 and R802.10.2 and referenced standard ANSI/TPI 1.
 - 7) Graphical purlin representation does not depict the size or the orientation of the purlin along the top and/or bottom chord.
 - 8) Hanger(s) or other connection device(s) shall be provided sufficient to support concentrated load(s) 139 lb down and 262 lb up at 1-4-0 on top chord, and 41 lb down and 44 lb up at 1-4-0 on bottom chord. The design/selection of such connection device(s) is the responsibility of others.
 - 9) In the LOAD CASE(S) section, loads applied to the face of the truss are noted as front (F) or back (B).

LOAD CASE(S) Standard
 1) Dead + Roof Live (balanced): Lumber Increase=1.15, Plate Increase=1.15
 Uniform Loads (plf)
 Vert: 1-3=-70, 3-4=-70, 4-6=-70, 7-10=-20
 Concentrated Loads (lb)
 Vert: 3=71(F)



June 12, 2023

WARNING - Verify design parameters and READ NOTES ON THIS AND INCLUDED MITEK REFERENCE PAGE MII-7473 rev. 1/2/2023 BEFORE USE.

Design valid for use only with MiTek® connectors. This design is based only upon parameters shown, and is for an individual building component, not a truss system. Before use, the building designer must verify the applicability of design parameters and properly incorporate this design into the overall building design. Bracing indicated is to prevent buckling of individual truss web and/or chord members only. Additional temporary and permanent bracing is always required for stability and to prevent collapse with possible personal injury and property damage. For general guidance regarding the fabrication, storage, delivery, erection and bracing of trusses and truss systems, see **ANSI/TPI1 Quality Criteria, and DSB-22** available from Truss Plate Institute (www.tpinst.org) and **BCSI Building Component Safety Information** available from the Structural Building Component Association (www.sbcsccomponents.com)

MiTek®


16023 Swingley Ridge Rd.
 Chesterfield, MO 63017
 314.434.1200 / MiTek-US.com

Job 3664536	Truss E3	Truss Type Roof Special	Qty 1	Ply 1	Summit/185 Highland Meadows
----------------	-------------	----------------------------	----------	----------	-----------------------------

AS NOTED FOR PLAN REVIEW
DEVELOPMENT SERVICES
LEE'S SUMMIT, MISSOURI

Builders FirstSource (Valley Center), Valley Center, KS - 67147,

8.630 s Nov 19 2022 MiTek Industries, Inc. Thu Jun 21 14:12:16 2023 Page 1

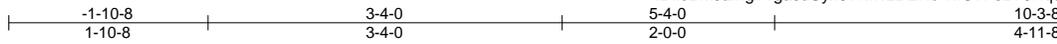

10/10/2023

3x4 || Scale = 1:21.6

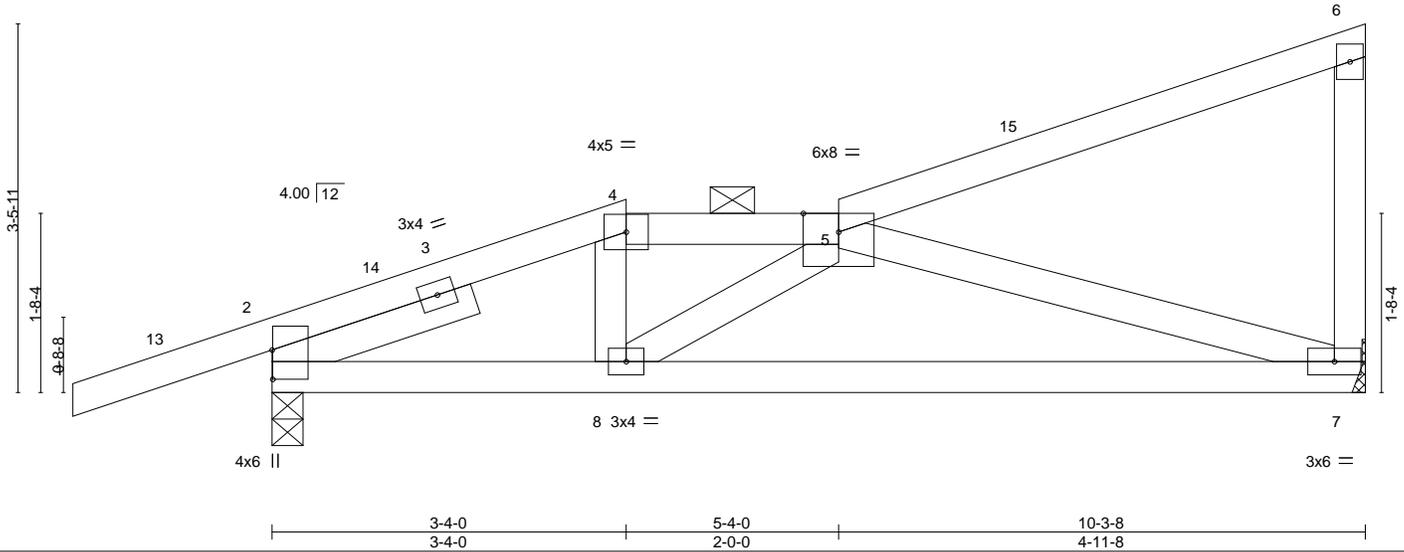


Plate Offsets (X,Y)--	[2:0-3-5,0-0-1]						
LOADING (psf)	SPACING-	2-0-0	CSI.	DEFL.	in (loc)	l/defl	L/d
TCLL 25.0	Plate Grip DOL	1.15	TC 0.24	Vert(LL)	-0.07	7-8	>999
TCDL 10.0	Lumber DOL	1.15	BC 0.37	Vert(CT)	-0.14	7-8	>883
BCLL 0.0	Rep Stress Incr	YES	WB 0.35	Horz(CT)	0.01	7	n/a
BCDL 10.0	Code IRC2018/TPI2014		Matrix-AS				
							PLATES
							MT20
							GRIP
							197/144
							Weight: 42 lb
							FT = 20%

LUMBER-	BRACING-
TOP CHORD 2x4 SPF No.2	TOP CHORD Structural wood sheathing directly applied, except end verticals, and
BOT CHORD 2x4 SPF No.2	2-0-0 oc purlins (6-0-0 max.): 4-5.
WEBS 2x4 SPF No.2	BOT CHORD Rigid ceiling directly applied.
SLIDER Left 2x4 SPF No.2 2-0-0	

REACTIONS. (size) 7=Mechanical, 2=0-3-8
 Max Horz 2=131(LC 11)
 Max Uplift 7=88(LC 12), 2=-149(LC 8)
 Max Grav 7=444(LC 1), 2=600(LC 1)

FORCES. (lb) - Max. Comp./Max. Ten. - All forces 250 (lb) or less except when shown.
 TOP CHORD 2-4=-713/135, 4-5=-635/145
 BOT CHORD 2-8=-293/653, 7-8=-320/768
 WEBS 5-7=-754/286

- NOTES-**
- 1) Wind: ASCE 7-16; Vult=115mph (3-second gust) Vasd=91mph; TCDL=6.0psf; BCDL=4.2psf; h=15ft; Cat. II; Exp C; Enclosed; MWFRS (envelope) gable end zone and C-C Exterior(2E) -1-10-8 to 1-1-8, Interior(1) 1-1-8 to 3-4-0, Exterior(2E) 3-4-0 to 5-4-0, Interior(1) 5-4-0 to 10-1-12 zone; cantilever left and right exposed ; end vertical left and right exposed;C-C for members and forces & MWFRS for reactions shown; Lumber DOL=1.60 plate grip DOL=1.60
 - 2) Provide adequate drainage to prevent water ponding.
 - 3) This truss has been designed for a 10.0 psf bottom chord live load nonconcurrent with any other live loads.
 - 4) Refer to girder(s) for truss to truss connections.
 - 5) Provide mechanical connection (by others) of truss to bearing plate capable of withstanding 88 lb uplift at joint 7 and 149 lb uplift at joint 2.
 - 6) This truss is designed in accordance with the 2018 International Residential Code sections R502.11.1 and R802.10.2 and referenced standard ANSI/TPI 1.
 - 7) This truss design requires that a minimum of 7/16" structural wood sheathing be applied directly to the top chord and 1/2" gypsum sheetrock be applied directly to the bottom chord.
 - 8) Graphical purlin representation does not depict the size or the orientation of the purlin along the top and/or bottom chord.



June 12, 2023

Job 3664536	Truss E4	Truss Type Half Hip Girder	Qty 1	Ply 1	Summit/185 Highland Meadows	AS NOTED FOR PLAN REVIEW DEVELOPMENT SERVICES LEE'S SUMMIT, MISSOURI
----------------	-------------	-------------------------------	----------	----------	-----------------------------	--

Builders FirstSource (Valley Center), Valley Center, KS - 67147,


8.630 s Nov 19 2022 MiTek Industries, Inc. Thu Jun 21 14:12:18 2023 Page 1

ID:icBMJaMgT1gasuUyx9?RhvzDEHb-RIC?PsB70Hq3NSQ PqnL8W3ulTXbGKVICDm7JzUCP

10/10/2023



Scale = 1:20.5

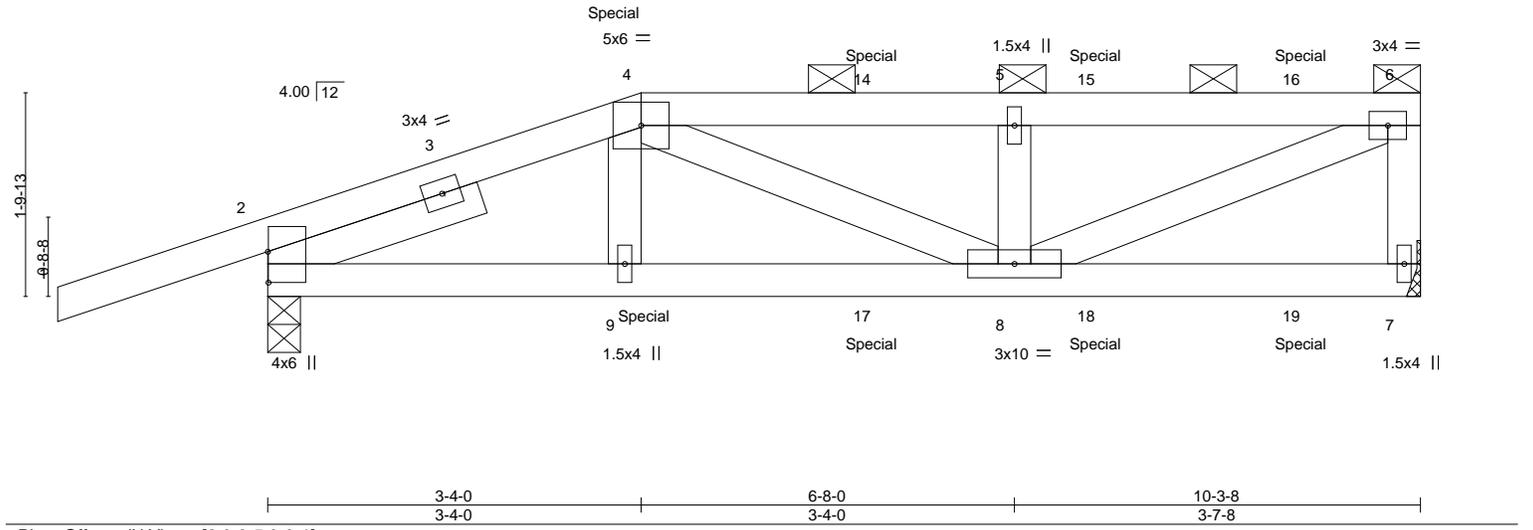

LOADING (psf)	SPACING-	2-0-0	CSI.	DEFL.	in (loc)	l/defl	L/d	PLATES	GRIP
TCLL 25.0	Plate Grip DOL	1.15	TC 0.27	Vert(LL)	-0.02	8-9	>999	MT20	197/144
TCDL 10.0	Lumber DOL	1.15	BC 0.36	Vert(CT)	-0.04	8-9	>999		
BCLL 0.0	Rep Stress Incr	NO	WB 0.21	Horz(CT)	0.01	7	n/a		
BCDL 10.0	Code IRC2018/TPI2014		Matrix-MS					Weight: 40 lb	FT = 20%

LUMBER-	BRACING-
TOP CHORD 2x4 SPF No.2	TOP CHORD Structural wood sheathing directly applied or 6-0-0 oc purlins, except end verticals, and 2-0-0 oc purlins (6-0-0 max.): 4-6.
BOT CHORD 2x4 SPF No.2	BOT CHORD Rigid ceiling directly applied or 10-0-0 oc bracing.
WEBS 2x4 SPF No.2	
SLIDER Left 2x4 SPF No.2 2-0-0	

REACTIONS. (size) 7=Mechanical, 2=0-3-8
 Max Horz 2=67(LC 7)
 Max Uplift 7=-102(LC 5), 2=-179(LC 4)
 Max Grav 7=518(LC 1), 2=676(LC 1)

FORCES. (lb) - Max. Comp./Max. Ten. - All forces 250 (lb) or less except when shown.
 TOP CHORD 2-4=-841/165, 4-5=-837/175, 5-6=-837/175, 6-7=-471/115
 BOT CHORD 2-9=-168/769, 8-9=-170/760
 WEBS 5-8=-293/114, 6-8=-175/871

- NOTES-**
- 1) Unbalanced roof live loads have been considered for this design.
 - 2) Wind: ASCE 7-16; Vult=115mph (3-second gust) Vasd=91mph; TCDL=6.0psf; BCDL=4.2psf; h=15ft; Cat. II; Exp C; Enclosed; MWFRS (envelope) gable end zone; cantilever left and right exposed ; end vertical left and right exposed; Lumber DOL=1.60 plate grip DOL=1.60
 - 3) Provide adequate drainage to prevent water ponding.
 - 4) This truss has been designed for a 10.0 psf bottom chord live load nonconcurrent with any other live loads.
 - 5) Refer to girder(s) for truss to truss connections.
 - 6) Provide mechanical connection (by others) of truss to bearing plate capable of withstanding 102 lb uplift at joint 7 and 179 lb uplift at joint 2.
 - 7) This truss is designed in accordance with the 2018 International Residential Code sections R502.11.1 and R802.10.2 and referenced standard ANSI/TPI 1.
 - 8) Graphical purlin representation does not depict the size or the orientation of the purlin along the top and/or bottom chord.
 - 9) Hanger(s) or other connection device(s) shall be provided sufficient to support concentrated load(s) 33 lb down and 38 lb up at 3-4-0, 30 lb down and 38 lb up at 5-4-12, and 30 lb down and 37 lb up at 7-4-12, and 30 lb down and 39 lb up at 9-2-12 on top chord, and 103 lb down and 44 lb up at 3-4-0, 19 lb down at 5-4-12, and 19 lb down at 7-4-12, and 19 lb down at 9-2-12 on bottom chord. The design/selection of such connection device(s) is the responsibility of others.
 - 10) In the LOAD CASE(S) section, loads applied to the face of the truss are noted as front (F) or back (B).

LOAD CASE(S) Standard
 1) Dead + Roof Live (balanced): Lumber Increase=1.15, Plate Increase=1.15
 Uniform Loads (plf)
 Vert: 1-4=-70, 4-6=-70, 7-10=-20



June 12, 2023

Continued on page 2

<p>WARNING - Verify design parameters and READ NOTES ON THIS AND INCLUDED MITEK REFERENCE PAGE MII-7473 rev. 1/2/2023 BEFORE USE.</p> <p>Design valid for use only with MiTek® connectors. This design is based only upon parameters shown, and is for an individual building component, not a truss system. Before use, the building designer must verify the applicability of design parameters and properly incorporate this design into the overall building design. Bracing indicated is to prevent buckling of individual truss web and/or chord members only. Additional temporary and permanent bracing is always required for stability and to prevent collapse with possible personal injury and property damage. For general guidance regarding the fabrication, storage, delivery, erection and bracing of trusses and truss systems, see ANSI/TPI1 Quality Criteria, and DSB-22 available from Truss Plate Institute (www.tpinst.org) and BCSI Building Component Safety Information available from the Structural Building Component Association (www.sbcsccomponents.com)</p>	<p>16023 Swingley Ridge Rd. Chesterfield, MO 63017 314.434.1200 / MiTek-US.com</p>
---	--

Job	Truss	Truss Type	Qty	Ply	Summit/185 Highland Meadows
3664536	E4	Half Hip Girder	1	1	

RELEASE FOR CONSTRUCTION

AS NOTED FOR PLAN REVIEW
DEVELOPMENT SERVICES
LEE'S SUMMIT, MISSOURI

10/10/2023

Builders FirstSource (Valley Center), Valley Center, KS - 67147,

8.630 s Nov 19 2022 MiTek Industries, Inc. Thu Jun 21 14:12:18 2023 Page 2

ID:icBMJaMgT1gasuUyx9?RhvzDEHb-RfC?PsB70Hq3NSpPqnL8w3ulTXbGKVICU7J4ZIC?

LOAD CASE(S) Standard

Concentrated Loads (lb)

Vert: 9=-78(B) 4=-9(B) 14=-9(B) 15=-9(B) 16=-12(B) 17=-10(B) 18=-10(B) 19=-11(B)

WARNING - Verify design parameters and READ NOTES ON THIS AND INCLUDED MITEK REFERENCE PAGE MII-7473 rev. 1/2/2023 BEFORE USE.

Design valid for use only with MiTek® connectors. This design is based only upon parameters shown, and is for an individual building component, not a truss system. Before use, the building designer must verify the applicability of design parameters and properly incorporate this design into the overall building design. Bracing indicated is to prevent buckling of individual truss web and/or chord members only. Additional temporary and permanent bracing is always required for stability and to prevent collapse with possible personal injury and property damage. For general guidance regarding the fabrication, storage, delivery, erection and bracing of trusses and truss systems, see **ANSI/TPI1 Quality Criteria, and DSB-22** available from Truss Plate Institute (www.tpinst.org) and **BCSI Building Component Safety Information** available from the Structural Building Component Association (www.sbcsccomponents.com)

MiTek®

16023 Swingley Ridge Rd.
Chesterfield, MO 63017
314.434.1200 / MiTek-US.com

Job 3664536	Truss F1	Truss Type Half Hip Girder	Qty 1	Ply 1	Summit/185 Highland Meadows	AS NOTED FOR PLAN REVIEW DEVELOPMENT SERVICES LEE'S SUMMIT, MISSOURI
----------------	-------------	-------------------------------	----------	----------	-----------------------------	--

Builders FirstSource (Valley Center), Valley Center, KS - 67147,


8.630 s Nov 19 2022 MiTek Industries, Inc. Thu Jun 21 14:12:19 2023 Page 1

ID:icBMJaMgT1gasuUyx9?RhvzDEHb-RfC?PsB70Hq3NSuPqnL8wGulTxbGKVICdgr7JzZICP?

10/10/2023



Scale = 1:20.6

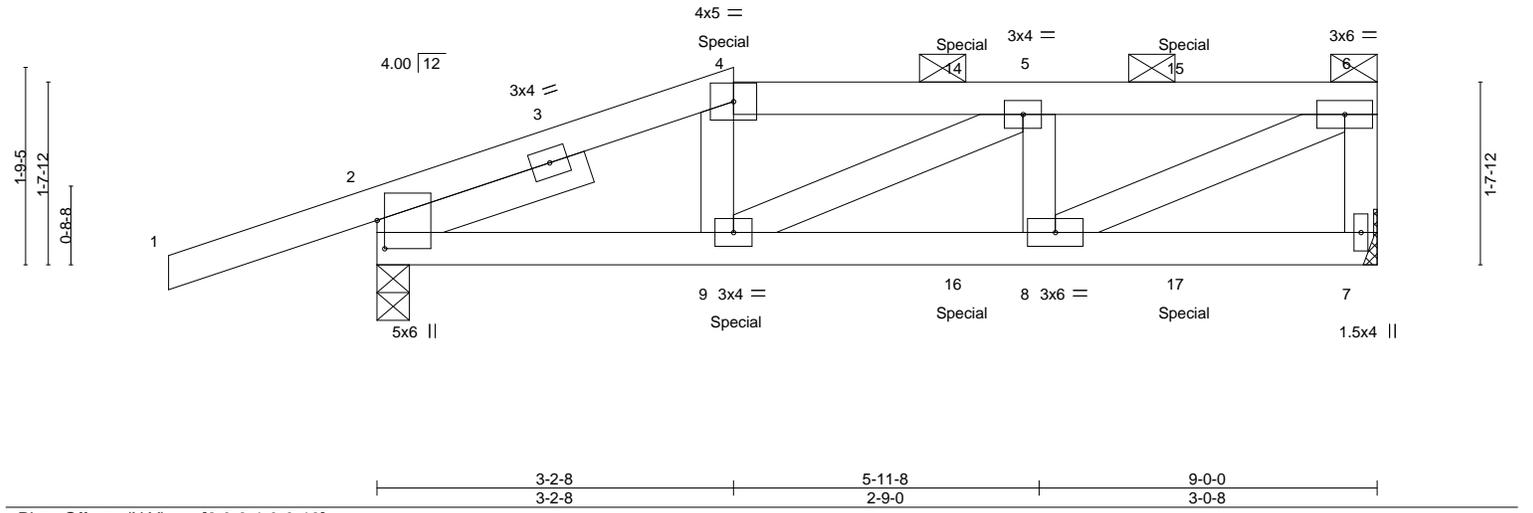

LOADING (psf)	SPACING-	2-0-0	CSI.	DEFL.	in (loc)	l/defl	L/d	PLATES	GRIP
TCLL 25.0	Plate Grip DOL	1.15	TC 0.27	Vert(LL)	-0.02	8-9	>999	MT20	197/144
TCDL 10.0	Lumber DOL	1.15	BC 0.45	Vert(CT)	-0.04	8-9	>999		
BCLL 0.0	Rep Stress Incr	NO	WB 0.25	Horz(CT)	0.01	7	n/a		
BCDL 10.0	Code IRC2018/TPI2014		Matrix-MS						
								Weight: 36 lb	FT = 20%

LUMBER-	BRACING-
TOP CHORD 2x4 SPF No.2	TOP CHORD Structural wood sheathing directly applied or 5-9-14 oc purlins, except end verticals, and 2-0-0 oc purlins (5-10-10 max.): 4-6.
BOT CHORD 2x4 SPF No.2	BOT CHORD Rigid ceiling directly applied or 10-0-0 oc bracing.
WEBS 2x4 SPF No.2	
SLIDER Left 2x4 SPF No.2 2-0-0	

REACTIONS. (size) 7=Mechanical, 2=0-3-8
 Max Horz 2=60(LC 7)
 Max Uplift 7=-101(LC 5), 2=-183(LC 4)
 Max Grav 7=572(LC 1), 2=707(LC 1)

FORCES. (lb) - Max. Comp./Max. Ten. - All forces 250 (lb) or less except when shown.
 TOP CHORD 2-4=-927/168, 4-5=-850/166, 5-6=-927/175, 6-7=-535/113
 BOT CHORD 2-9=-176/860, 8-9=-178/927
 WEBS 5-8=-297/121, 6-8=-185/1024

- NOTES-**
- 1) Unbalanced roof live loads have been considered for this design.
 - 2) Wind: ASCE 7-16; Vult=115mph (3-second gust) Vasd=91mph; TCDL=6.0psf; BCDL=4.2psf; h=15ft; Cat. II; Exp C; Enclosed; MWFRS (envelope) gable end zone; cantilever left and right exposed ; end vertical left and right exposed; Lumber DOL=1.60 plate grip DOL=1.60
 - 3) Provide adequate drainage to prevent water ponding.
 - 4) This truss has been designed for a 10.0 psf bottom chord live load nonconcurrent with any other live loads.
 - 5) Refer to girder(s) for truss to truss connections.
 - 6) Provide mechanical connection (by others) of truss to bearing plate capable of withstanding 101 lb uplift at joint 7 and 183 lb uplift at joint 2.
 - 7) This truss is designed in accordance with the 2018 International Residential Code sections R502.11.1 and R802.10.2 and referenced standard ANSI/TPI 1.
 - 8) Graphical purlin representation does not depict the size or the orientation of the purlin along the top and/or bottom chord.
 - 9) Hanger(s) or other connection device(s) shall be provided sufficient to support concentrated load(s) 77 lb down and 55 lb up at 3-2-8, and 54 lb down and 55 lb up at 5-3-4, and 54 lb down and 55 lb up at 7-3-4 on top chord, and 117 lb down and 40 lb up at 3-2-8, and 36 lb down at 5-3-4, and 36 lb down at 7-3-4 on bottom chord. The design/selection of such connection device(s) is the responsibility of others.
 - 10) In the LOAD CASE(S) section, loads applied to the face of the truss are noted as front (F) or back (B).

LOAD CASE(S) Standard
 1) Dead + Roof Live (balanced): Lumber Increase=1.15, Plate Increase=1.15
 Uniform Loads (plf)
 Vert: 1-4=-70, 4-6=-70, 7-10=-20



June 12, 2023

Continued on page 2

<p>WARNING - Verify design parameters and READ NOTES ON THIS AND INCLUDED MITEK REFERENCE PAGE MII-7473 rev. 1/2/2023 BEFORE USE.</p> <p>Design valid for use only with MiTek® connectors. This design is based only upon parameters shown, and is for an individual building component, not a truss system. Before use, the building designer must verify the applicability of design parameters and properly incorporate this design into the overall building design. Bracing indicated is to prevent buckling of individual truss web and/or chord members only. Additional temporary and permanent bracing is always required for stability and to prevent collapse with possible personal injury and property damage. For general guidance regarding the fabrication, storage, delivery, erection and bracing of trusses and truss systems, see ANSI/TPI1 Quality Criteria, and DSB-22 available from Truss Plate Institute (www.tpinst.org) and BCSI Building Component Safety Information available from the Structural Building Component Association (www.sbcsccomponents.com)</p>	 <p>16023 Swingley Ridge Rd. Chesterfield, MO 63017 314.434.1200 / MiTek-US.com</p>
---	--

Job	Truss	Truss Type	Qty	Ply	Summit/185 Highland Meadows
3664536	F1	Half Hip Girder	1	1	

RELEASE FOR CONSTRUCTION

AS NOTED FOR PLAN REVIEW

DEVELOPMENT SERVICES

LEE'S SUMMIT, MISSOURI

10/10/2023

Builders FirstSource (Valley Center), Valley Center, KS - 67147,

8.630 s Nov 19 2022 MiTek Industries, Inc. Thu Jun 21 14:12:19 2023 Page 2
 ID:icBMJaMgT1gasuUyx9?RhvzDEHb-RfC?PsB70Hq3NSpPqnL8w3ulTXbGKVICU7J4ZICP?

LOAD CASE(S) Standard

Concentrated Loads (lb)

Vert: 4=-54(F) 9=-117(F) 14=-54(F) 15=-54(F) 16=-36(F) 17=-36(F)

WARNING - Verify design parameters and READ NOTES ON THIS AND INCLUDED MITEK REFERENCE PAGE MII-7473 rev. 1/2/2023 BEFORE USE.

Design valid for use only with MiTek® connectors. This design is based only upon parameters shown, and is for an individual building component, not a truss system. Before use, the building designer must verify the applicability of design parameters and properly incorporate this design into the overall building design. Bracing indicated is to prevent buckling of individual truss web and/or chord members only. Additional temporary and permanent bracing is always required for stability and to prevent collapse with possible personal injury and property damage. For general guidance regarding the fabrication, storage, delivery, erection and bracing of trusses and truss systems, see **ANSI/TPI1 Quality Criteria, and DSB-22** available from Truss Plate Institute (www.tpinst.org) and **BCSI Building Component Safety Information** available from the Structural Building Component Association (www.sbcsccomponents.com)

MiTek®

16023 Swingley Ridge Rd.
 Chesterfield, MO 63017
 314.434.1200 / MiTek-US.com

Job	Truss	Truss Type	Qty	Ply	Summit/185 Highland Meadows	AS NOTED FOR PLAN REVIEW DEVELOPMENT SERVICES LEE'S SUMMIT, MISSOURI
3664536	F2	Half Hip	1	1	Job Reference (optional)	58827548

Builders FirstSource (Valley Center), Valley Center, KS - 67147,

8.630 s Nov 19 2022 MiTek Industries, Inc. Thu Jun 21 14:12:20 2023 Page 1

ID:icBMJaMgT1gasuUyx9?RhvzDEHb-RfC?PsB70Hq3NSpPqnL8w3ulTXbGKwCtgr7JzJICP

10/10/2023



Scale = 1:20.6

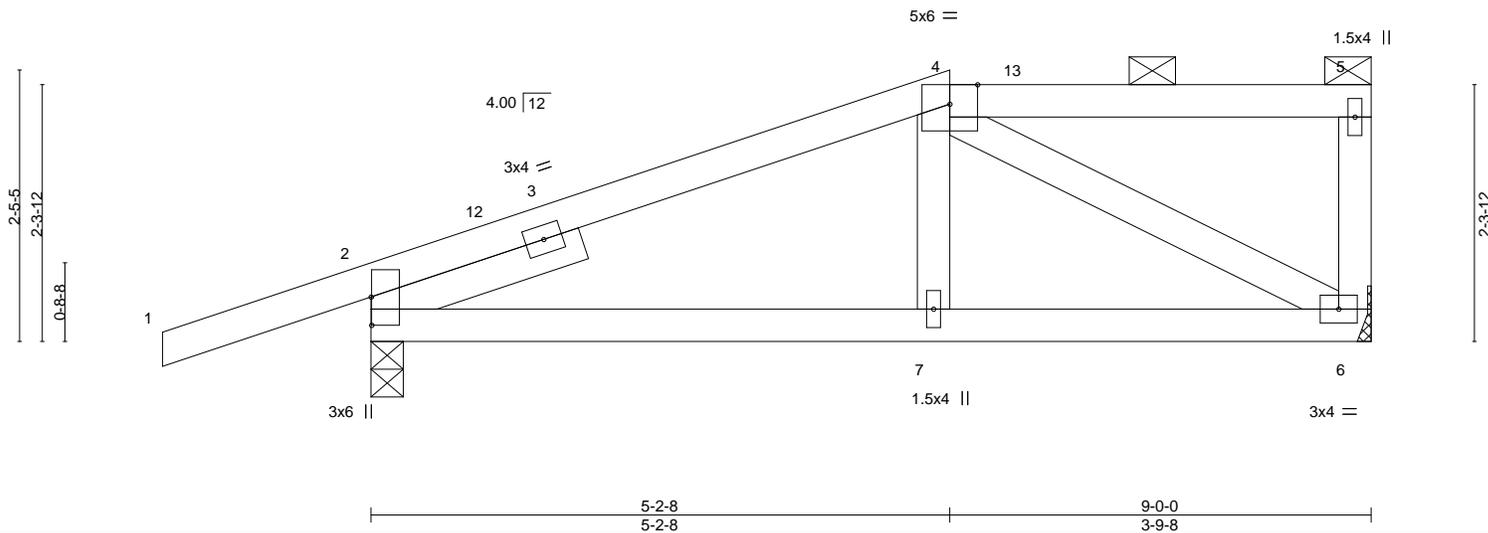


Plate Offsets (X,Y)--	[2:0-3-1,0-0-1]								
LOADING (psf)	SPACING-	2-0-0	CSI.	DEFL.	in (loc)	l/defl	L/d	PLATES	GRIP
TCLL 25.0	Plate Grip DOL 1.15		TC 0.25	Vert(LL) 0.02	7-10	>999	240	MT20	197/144
TCDL 10.0	Lumber DOL 1.15		BC 0.18	Vert(CT) -0.02	7-10	>999	180		
BCLL 0.0	Rep Stress Incr YES		WB 0.15	Horz(CT) -0.01	2	n/a	n/a		
BCDL 10.0	Code IRC2018/TPI2014		Matrix-AS						
								Weight: 34 lb	FT = 20%

LUMBER-
 TOP CHORD 2x4 SPF No.2
 BOT CHORD 2x4 SPF No.2
 WEBS 2x4 SPF No.2
 SLIDER Left 2x4 SPF No.2 2-0-0

BRACING-
 TOP CHORD Structural wood sheathing directly applied, except end verticals, and 2-0-0 oc purlins (6-0-0 max.): 4-5.
 BOT CHORD Rigid ceiling directly applied.

REACTIONS. (size) 2=0-3-8, 6=Mechanical
 Max Horz 2=87(LC 11)
 Max Uplift 2=-144(LC 8), 6=-69(LC 8)
 Max Grav 2=544(LC 1), 6=385(LC 1)

FORCES. (lb) - Max. Comp./Max. Ten. - All forces 250 (lb) or less except when shown.
 TOP CHORD 2-4=-434/153
 BOT CHORD 2-7=-226/414, 6-7=-227/406
 WEBS 4-6=-467/233

- NOTES-**
- 1) Unbalanced roof live loads have been considered for this design.
 - 2) Wind: ASCE 7-16; Vult=115mph (3-second gust) Vasd=91mph; TCDL=6.0psf; BCDL=4.2psf; h=15ft; Cat. II; Exp C; Enclosed; MWFRS (envelope) gable end zone and C-C Exterior(2E) -1-10-8 to 1-1-8, Interior(1) 1-1-8 to 5-2-8, Exterior(2E) 5-2-8 to 8-10-4 zone; cantilever left and right exposed ; end vertical left and right exposed;C-C for members and forces & MWFRS for reactions shown; Lumber DOL=1.60 plate grip DOL=1.60
 - 3) Provide adequate drainage to prevent water ponding.
 - 4) This truss has been designed for a 10.0 psf bottom chord live load nonconcurrent with any other live loads.
 - 5) Refer to girder(s) for truss to truss connections.
 - 6) Provide mechanical connection (by others) of truss to bearing plate capable of withstanding 144 lb uplift at joint 2 and 69 lb uplift at joint 6.
 - 7) This truss is designed in accordance with the 2018 International Residential Code sections R502.11.1 and R802.10.2 and referenced standard ANSI/TPI 1.
 - 8) This truss design requires that a minimum of 7/16" structural wood sheathing be applied directly to the top chord and 1/2" gypsum sheetrock be applied directly to the bottom chord.
 - 9) Graphical purlin representation does not depict the size or the orientation of the purlin along the top and/or bottom chord.



June 12, 2023

WARNING - Verify design parameters and READ NOTES ON THIS AND INCLUDED MITEK REFERENCE PAGE MII-7473 rev. 1/2/2023 BEFORE USE.

Design valid for use only with MiTek® connectors. This design is based only upon parameters shown, and is for an individual building component, not a truss system. Before use, the building designer must verify the applicability of design parameters and properly incorporate this design into the overall building design. Bracing indicated is to prevent buckling of individual truss web and/or chord members only. Additional temporary and permanent bracing is always required for stability and to prevent collapse with possible personal injury and property damage. For general guidance regarding the fabrication, storage, delivery, erection and bracing of trusses and truss systems, see **ANSI/TPI1 Quality Criteria, and DSB-22** available from Truss Plate Institute (www.tpinst.org) and **BCSI Building Component Safety Information** available from the Structural Building Component Association (www.sbcsccomponents.com)

MiTek®

16023 Swingley Ridge Rd.
 Chesterfield, MO 63017
 314.434.1200 / MiTek-US.com


Job	Truss	Truss Type	Qty	Ply	Summit/185 Highland Meadows	AS NOTED FOR PLAN REVIEW DEVELOPMENT SERVICES LEE'S SUMMIT, MISSOURI
3664536	F3	Half Hip	1	1	Job Reference (optional)	58827549

Builders FirstSource (Valley Center), Valley Center, KS - 67147,

8.630 s Nov 19 2022 MiTek Industries, Inc. Thu Jun 21 14:12:21 2023 Page 1


ID:icBMJaMgT1gasuUyx9?RhvhzDEHb-RIC?PsB70Hq3NSyPqnL8wGulTXbGKVICd7f7JzZIC?2

10/10/2023

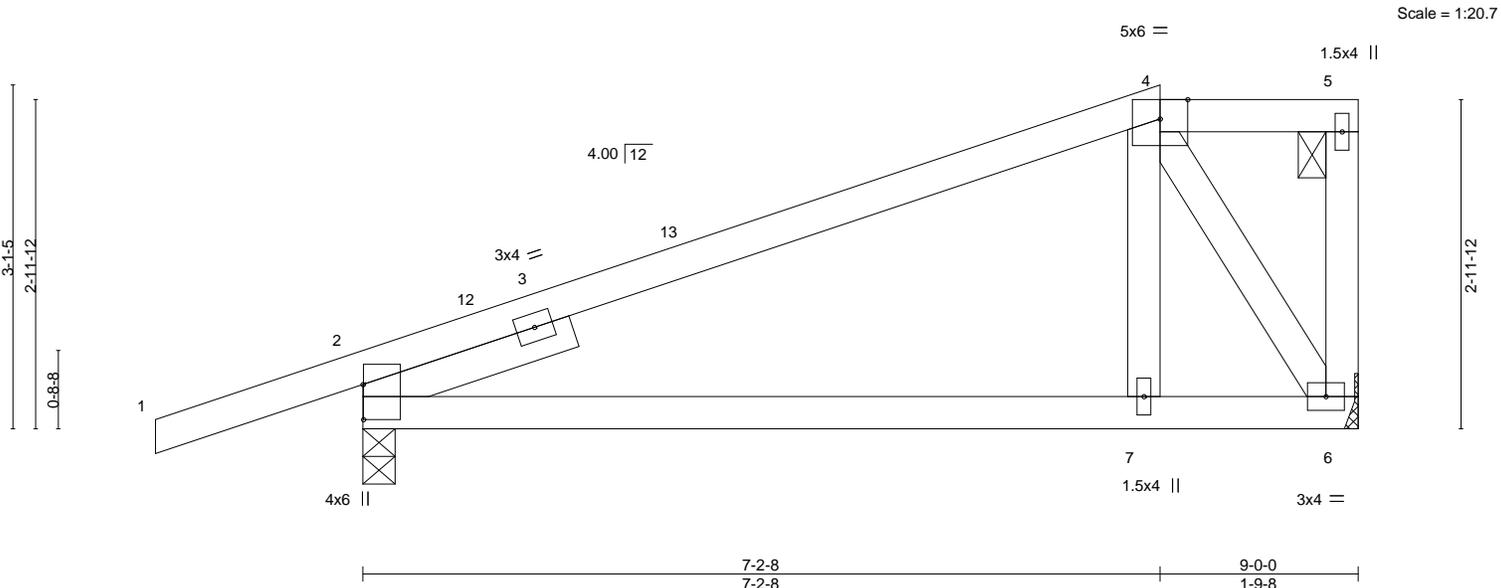

Job 3664536	Truss F4	Truss Type Jack-Partial	Qty 11	Ply 1	Summit/185 Highland Meadows Job Reference (optional)	AS NOTED FOR PLAN REVIEW DEVELOPMENT SERVICES LEE'S SUMMIT, MISSOURI
----------------	-------------	----------------------------	-----------	----------	---	--

Builders FirstSource (Valley Center), Valley Center, KS - 67147, 8.630 s Nov 19 2022 MiTek Industries, Inc. Thu Jun 21 14:12:22 2023 Page 1

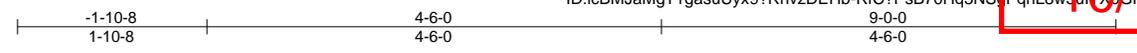

10/10/2023

Scale = 1:22.7

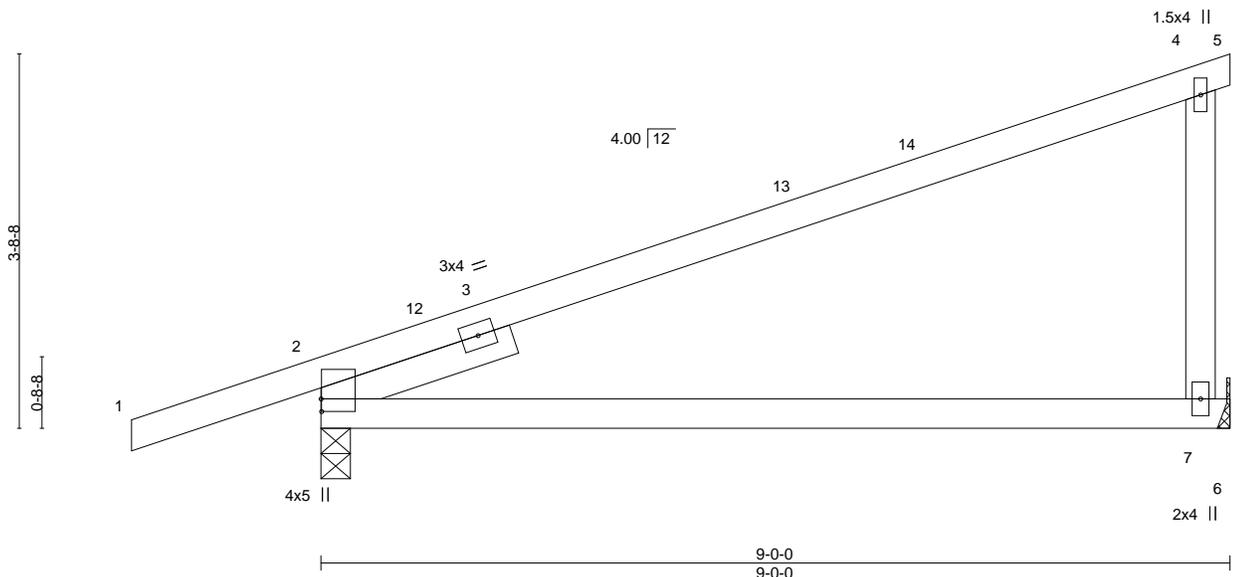


Plate Offsets (X,Y)--	[2:0-1-8,0-0-1]
-----------------------	-----------------

LOADING (psf)	SPACING-	2-0-0	CSI.	DEFL.	in (loc)	l/defl	L/d	PLATES	GRIP
TCLL 25.0	Plate Grip DOL	1.15	TC 1.00	Vert(LL)	-0.23	7-10	>455	MT20	197/144
TCDL 10.0	Lumber DOL	1.15	BC 0.68	Vert(CT)	-0.51	7-10	>203		
BCLL 0.0	Rep Stress Incr	YES	WB 0.06	Horz(CT)	0.09	2	n/a		
BCDL 10.0	Code IRC2018/TPI2014		Matrix-AS						
								Weight: 29 lb	FT = 20%

LUMBER-	BRACING-
TOP CHORD 2x4 SPF No.2	TOP CHORD Structural wood sheathing directly applied.
BOT CHORD 2x4 SPF No.2	BOT CHORD Rigid ceiling directly applied.
WEBS 2x4 SPF No.2	
SLIDER Left 2x4 SPF No.2 2-0-0	

REACTIONS. (size) 2=0-3-8, 7=Mechanical
 Max Horz 2=140(LC 8)
 Max Uplift 2=-123(LC 8), 7=-91(LC 8)
 Max Grav 2=537(LC 1), 7=390(LC 1)

FORCES. (lb) - Max. Comp./Max. Ten. - All forces 250 (lb) or less except when shown.
 TOP CHORD 2-4=-563/68
 WEBS 4-7=-279/215

- NOTES-**
- 1) Wind: ASCE 7-16; Vult=115mph (3-second gust) Vasd=91mph; TCDL=6.0psf; BCDL=4.2psf; h=15ft; Cat. II; Exp C; Enclosed; MWFRS (envelope) gable end zone and C-C Exterior(2E) -1-10-8 to 1-1-8, Interior(1) 1-1-8 to 9-0-0 zone; cantilever left and right exposed; end vertical left and right exposed; C-C for members and forces & MWFRS for reactions shown; Lumber DOL=1.60 plate grip DOL=1.60
 - 2) This truss has been designed for a 10.0 psf bottom chord live load nonconcurrent with any other live loads.
 - 3) Refer to girder(s) for truss to truss connections.
 - 4) Provide mechanical connection (by others) of truss to bearing plate capable of withstanding 123 lb uplift at joint 2 and 91 lb uplift at joint 7.
 - 5) This truss is designed in accordance with the 2018 International Residential Code sections R502.11.1 and R802.10.2 and referenced standard ANSI/TPI 1.
 - 6) This truss design requires that a minimum of 7/16" structural wood sheathing be applied directly to the top chord and 1/2" gypsum sheetrock be applied directly to the bottom chord.



June 12, 2023

<p>WARNING - Verify design parameters and READ NOTES ON THIS AND INCLUDED MITEK REFERENCE PAGE MII-7473 rev. 1/2/2023 BEFORE USE.</p> <p>Design valid for use only with MiTek® connectors. This design is based only upon parameters shown, and is for an individual building component, not a truss system. Before use, the building designer must verify the applicability of design parameters and properly incorporate this design into the overall building design. Bracing indicated is to prevent buckling of individual truss web and/or chord members only. Additional temporary and permanent bracing is always required for stability and to prevent collapse with possible personal injury and property damage. For general guidance regarding the fabrication, storage, delivery, erection and bracing of trusses and truss systems, see ANSI/TPI1 Quality Criteria, and DSB-22 available from Truss Plate Institute (www.tpinst.org) and BCSI Building Component Safety Information available from the Structural Building Component Association (www.sbcsccomponents.com)</p>	<p>16023 Swingley Ridge Rd. Chesterfield, MO 63017 314.434.1200 / MiTek-US.com</p>
---	--

Job 3664536	Truss J1	Truss Type Jack-Open	Qty 3	Ply 1	Summit/185 Highland Meadows Job Reference (optional)
----------------	-------------	-------------------------	----------	----------	---

AS NOTED FOR PLAN REVIEW
DEVELOPMENT SERVICES
LEE'S SUMMIT, MISSOURI

Builders FirstSource (Valley Center), Valley Center, KS - 67147,

8.630 s Nov 19 2022 MiTek Industries, Inc. Thu Jun 14 12:23:2023 Page 1


ID:icBMJaMgT1gasuUyx9?RhvzDEHb-RfC?PsB70Hq3NSyPqnL8w3LTXbGKVCf7f7JzICP?

10/10/2023

-0-10-8
0-10-8

4-2-8
4-2-8

Scale = 1:11.6

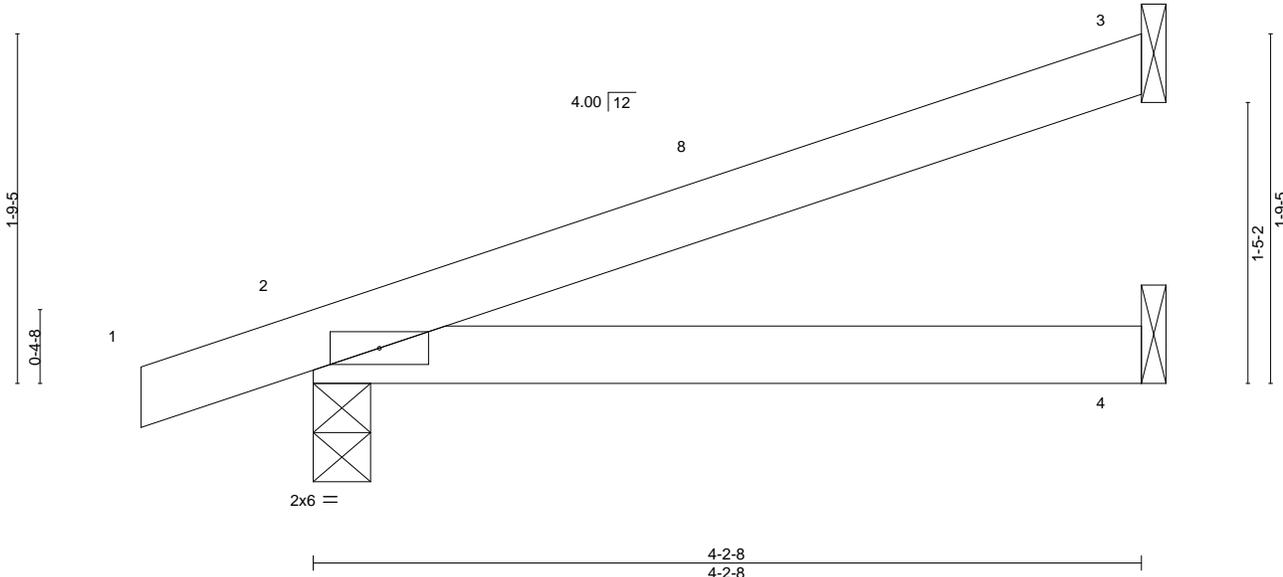

LOADING (psf)	SPACING-	2-0-0	CSI.	DEFL.	in (loc)	l/defl	L/d	PLATES	GRIP
TCLL 25.0	Plate Grip DOL	1.15	TC 0.21	Vert(LL)	-0.02 4-7	>999	240	MT20	197/144
TCDL 10.0	Lumber DOL	1.15	BC 0.17	Vert(CT)	-0.03 4-7	>999	180		
BCLL 0.0	Rep Stress Incr	YES	WB 0.00	Horz(CT)	0.00 2	n/a	n/a		
BCDL 10.0	Code IRC2018/TPI2014		Matrix-AS					Weight: 11 lb	FT = 20%

LUMBER-
TOP CHORD 2x4 SPF No.2
BOT CHORD 2x4 SPF No.2

BRACING-
TOP CHORD Structural wood sheathing directly applied.
BOT CHORD Rigid ceiling directly applied.

REACTIONS. (size) 3=Mechanical, 2=0-3-8, 4=Mechanical
Max Horz 2=65(LC 8)
Max Uplift 3=45(LC 12), 2=60(LC 8)
Max Grav 3=124(LC 1), 2=254(LC 1), 4=74(LC 3)

FORCES. (lb) - Max. Comp./Max. Ten. - All forces 250 (lb) or less except when shown.

- NOTES-**
- 1) Wind: ASCE 7-16; Vult=115mph (3-second gust) Vasd=91mph; TCDL=6.0psf; BCDL=4.2psf; h=15ft; Cat. II; Exp C; Enclosed; MWFRS (envelope) gable end zone and C-C Exterior(2E) -0-10-8 to 2-1-8, Interior(1) 2-1-8 to 4-1-12 zone; cantilever left and right exposed; end vertical left and right exposed; C-C for members and forces & MWFRS for reactions shown; Lumber DOL=1.60 plate grip DOL=1.60
 - 2) This truss has been designed for a 10.0 psf bottom chord live load nonconcurrent with any other live loads.
 - 3) Refer to girder(s) for truss to truss connections.
 - 4) Provide mechanical connection (by others) of truss to bearing plate capable of withstanding 45 lb uplift at joint 3 and 60 lb uplift at joint 2.
 - 5) This truss is designed in accordance with the 2018 International Residential Code sections R502.11.1 and R802.10.2 and referenced standard ANSI/TPI 1.
 - 6) This truss design requires that a minimum of 7/16" structural wood sheathing be applied directly to the top chord and 1/2" gypsum sheetrock be applied directly to the bottom chord.



June 12, 2023

Job 3664536	Truss J2	Truss Type Jack-Open	Qty 1	Ply 1	Summit/185 Highland Meadows Job Reference (optional)
----------------	-------------	-------------------------	----------	----------	---


AS NOTED FOR PLAN REVIEW
DEVELOPMENT SERVICES
LEE'S SUMMIT, MISSOURI

Builders FirstSource (Valley Center), Valley Center, KS - 67147,

8.630 s Nov 19 2022 MiTek Industries, Inc. Thu Jun 21 14:12:34 2023 Page 1

ID:icBMJaMgT1gasuUyx9?RhvzDEHb-RfC?PsB70Hq3NSuPqnL8wGulTxbGKVICDm7JzICP

10/10/2023

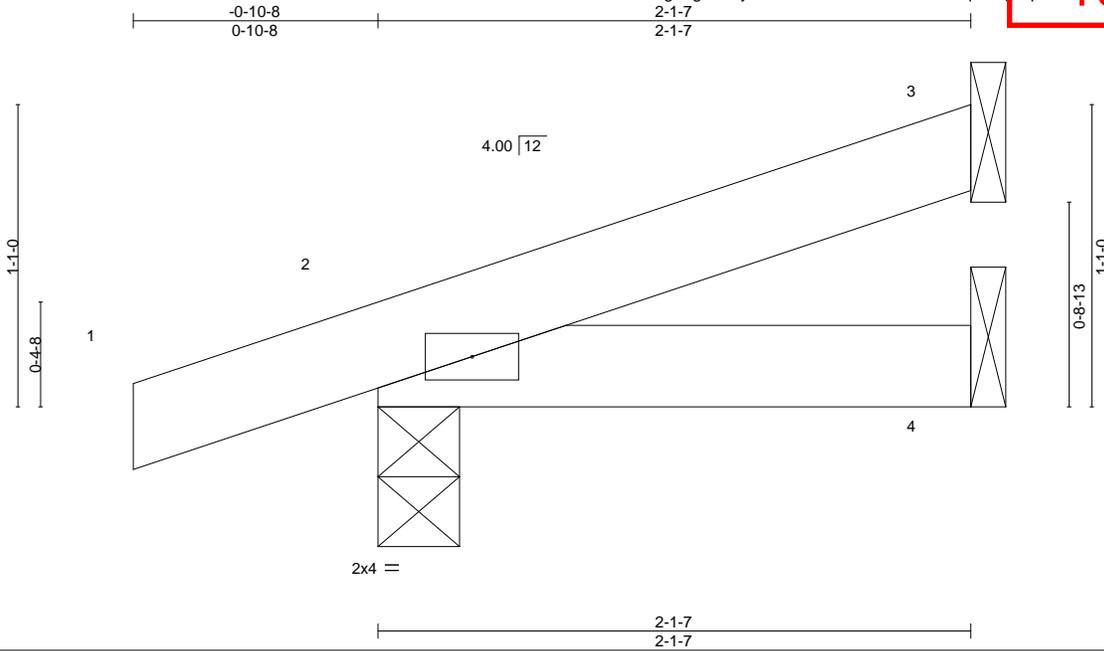

Scale = 1:8.2

LOADING (psf)	SPACING-	CSI.	DEFL.	in (loc)	l/defl	L/d	PLATES	GRIP
TCLL 25.0	2-0-0	TC 0.05	Vert(LL)	-0.00	7	>999	MT20	197/144
TCDL 10.0	Plate Grip DOL 1.15	BC 0.03	Vert(CT)	-0.00	7	>999		
BCLL 0.0	Lumber DOL 1.15	WB 0.00	Horz(CT)	0.00	2	n/a		
BCDL 10.0	Rep Stress Incr YES	Matrix-MP					Weight: 6 lb	FT = 20%
	Code IRC2018/TPI2014							

LUMBER-
TOP CHORD 2x4 SPF No.2
BOT CHORD 2x4 SPF No.2

BRACING-
TOP CHORD Structural wood sheathing directly applied or 2-1-7 oc purlins.
BOT CHORD Rigid ceiling directly applied or 10-0-0 oc bracing.

REACTIONS. (size) 3=Mechanical, 2=0-3-8, 4=Mechanical
Max Horz 2=39(LC 8)
Max Uplift 3=-19(LC 12), 2=-51(LC 8)
Max Grav 3=53(LC 1), 2=167(LC 1), 4=35(LC 3)

FORCES. (lb) - Max. Comp./Max. Ten. - All forces 250 (lb) or less except when shown.

NOTES-

- 1) Wind: ASCE 7-16; Vult=115mph (3-second gust) Vasd=91mph; TCDL=6.0psf; BCDL=4.2psf; h=15ft; Cat. II; Exp C; Enclosed; MWFRS (envelope) gable end zone and C-C Exterior(2E) zone; cantilever left and right exposed; end vertical left and right exposed; C-C for members and forces & MWFRS for reactions shown; Lumber DOL=1.60 plate grip DOL=1.60
- 2) This truss has been designed for a 10.0 psf bottom chord live load nonconcurrent with any other live loads.
- 3) Refer to girder(s) for truss to truss connections.
- 4) Provide mechanical connection (by others) of truss to bearing plate capable of withstanding 19 lb uplift at joint 3 and 51 lb uplift at joint 2.
- 5) This truss is designed in accordance with the 2018 International Residential Code sections R502.11.1 and R802.10.2 and referenced standard ANSI/TPI 1.



June 12, 2023

WARNING - Verify design parameters and READ NOTES ON THIS AND INCLUDED MITEK REFERENCE PAGE MII-7473 rev. 1/2/2023 BEFORE USE.

Design valid for use only with MiTek® connectors. This design is based only upon parameters shown, and is for an individual building component, not a truss system. Before use, the building designer must verify the applicability of design parameters and properly incorporate this design into the overall building design. Bracing indicated is to prevent buckling of individual truss web and/or chord members only. Additional temporary and permanent bracing is always required for stability and to prevent collapse with possible personal injury and property damage. For general guidance regarding the fabrication, storage, delivery, erection and bracing of trusses and truss systems, see **ANSI/TPI1 Quality Criteria, and DSB-22** available from Truss Plate Institute (www.tpinst.org) and **BCSI Building Component Safety Information** available from the Structural Building Component Association (www.sbcsccomponents.com)

MiTek®

16023 Swingley Ridge Rd.
Chesterfield, MO 63017
314.434.1200 / MiTek-US.com

Job 3664536	Truss J3	Truss Type Jack-Open	Qty 1	Ply 1	Summit/185 Highland Meadows Job Reference (optional)
----------------	-------------	-------------------------	----------	----------	---

RELEASE FOR CONSTRUCTION

AS NOTED FOR PLAN REVIEW

DEVELOPMENT SERVICES


LEE'S SUMMIT, MISSOURI

10/10/2023

Builders FirstSource (Valley Center), Valley Center, KS - 67147, 8.630 s Nov 19 2022 MiTek Industries, Inc. Thu Jun 14 12:45:2023 Page 1



Scale = 1:8.3

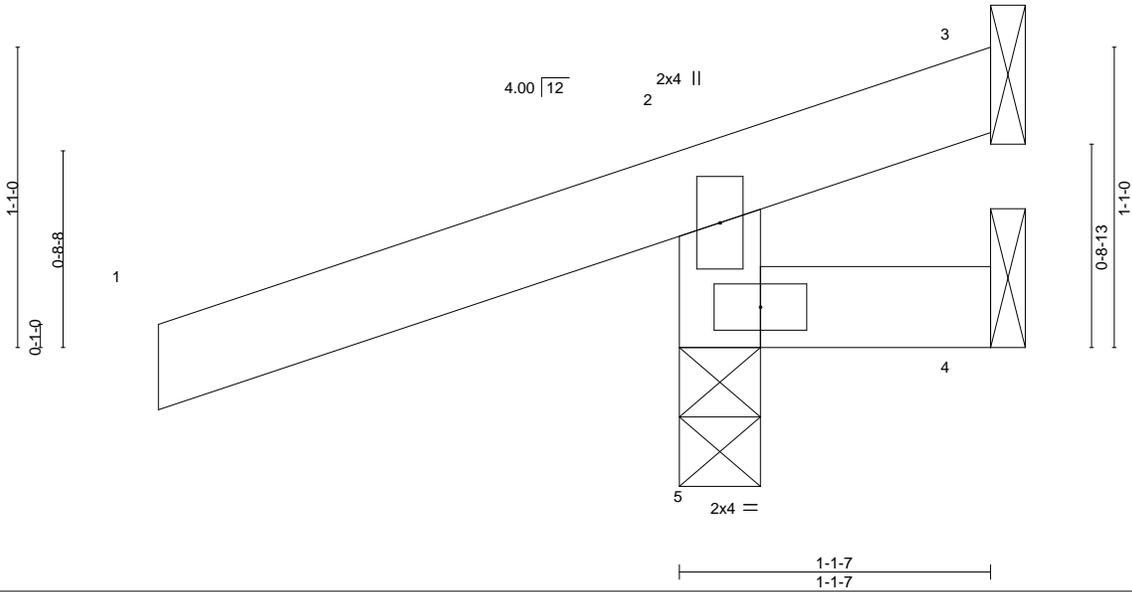

LOADING (psf)	SPACING-	CSI.	DEFL.	in (loc)	l/defl	L/d	PLATES	GRIP
TCLL 25.0	2-0-0	TC 0.28	Vert(LL)	0.00	5	>999	MT20	197/144
TCDL 10.0	Plate Grip DOL 1.15	BC 0.08	Vert(CT)	0.00	5	>999		
BCLL 0.0	Lumber DOL 1.15	WB 0.00	Horz(CT)	-0.00	3	n/a		
BCDL 10.0	Rep Stress Incr YES	Matrix-MR					Weight: 5 lb	FT = 20%
	Code IRC2018/TPI2014							

LUMBER-	BRACING-
TOP CHORD 2x4 SPF No.2	TOP CHORD Structural wood sheathing directly applied or 1-1-7 oc purlins, except end verticals.
BOT CHORD 2x4 SPF No.2	BOT CHORD Rigid ceiling directly applied or 10-0-0 oc bracing.
WEBS 2x4 SPF No.2	

REACTIONS. (size) 3=Mechanical, 4=Mechanical, 5=0-3-8
 Max Horz 5=38(LC 8)
 Max Uplift 3=-71(LC 1), 4=-34(LC 1), 5=-150(LC 8)
 Max Grav 3=40(LC 8), 4=20(LC 8), 5=333(LC 1)

FORCES. (lb) - Max. Comp./Max. Ten. - All forces 250 (lb) or less except when shown.
 TOP CHORD 2-5=-280/212

NOTES-

- 1) Wind: ASCE 7-16; Vult=115mph (3-second gust) Vasd=91mph; TCDL=6.0psf; BCDL=4.2psf; h=15ft; Cat. II; Exp C; Enclosed; MWFRS (envelope) gable end zone and C-C Exterior(2E) zone; cantilever left and right exposed ; end vertical left and right exposed;C-C for members and forces & MWFRS for reactions shown; Lumber DOL=1.60 plate grip DOL=1.60
- 2) This truss has been designed for a 10.0 psf bottom chord live load nonconcurrent with any other live loads.
- 3) Refer to girder(s) for truss to truss connections.
- 4) Bearing at joint(s) 5 considers parallel to grain value using ANSI/TPI 1 angle to grain formula. Building designer should verify capacity of bearing surface.
- 5) Provide mechanical connection (by others) of truss to bearing plate capable of withstanding 71 lb uplift at joint 3, 34 lb uplift at joint 4 and 150 lb uplift at joint 5.
- 6) This truss is designed in accordance with the 2018 International Residential Code sections R502.11.1 and R802.10.2 and referenced standard ANSI/TPI 1.



June 12, 2023

Job 3664536	Truss J4	Truss Type Jack-Closed	Qty 2	Ply 1	Summit/185 Highland Meadows	RELEASE FOR CONSTRUCTION AS NOTED FOR PLAN REVIEW DEVELOPMENT SERVICES LEE'S SUMMIT, MISSOURI
----------------	-------------	---------------------------	----------	----------	-----------------------------	--

Builders First Source, Valley Center, KS 67147

ID:icBMJaMgT1gasuUyx9?RhzvDEHb-gQQdP1ub9F8A8BEnIOi63Cq55bAWp1fNv3rdUz8NF
 8.630 s Nov 21 2022 MITek Industries, Inc. Fri Jun 9 11:17:38 2023 Page 1
 10/10/2023

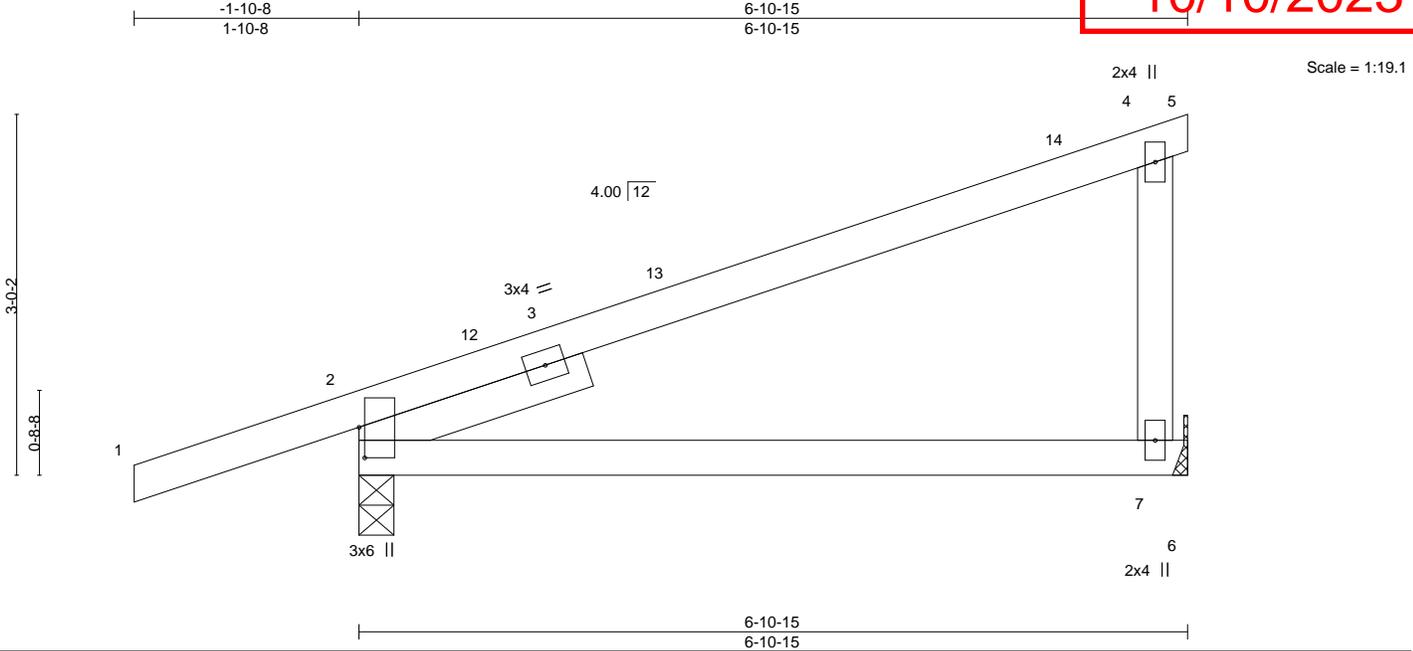


Plate Offsets (X,Y)--	[2:0-3-1,0-0-9]				
LOADING (psf)	SPACING- 2-0-0	CSI.	DEFL. in (loc) l/defl L/d	PLATES	GRIP
TCLL 25.0	Plate Grip DOL 1.15	TC 0.58	Vert(LL) 0.09 7-10 >866 240	MT20	197/144
TCDL 10.0	Lumber DOL 1.15	BC 0.37	Vert(CT) -0.17 7-10 >466 180		
BCLL 0.0	Rep Stress Incr YES	WB 0.00	Horz(CT) 0.04 2 n/a n/a		
BCDL 10.0	Code IRC2018/TPI2014	Matrix-AS		Weight: 24 lb	FT = 20%

LUMBER-
 TOP CHORD 2x4 SPF No.2
 BOT CHORD 2x4 SPF No.2
 WEBS 2x4 SPF No.2
 SLIDER Left 2x4 SPF No.2 2-0-0

BRACING-
 TOP CHORD Sheathed, except end verticals.
 BOT CHORD Rigid ceiling directly applied.

REACTIONS. (size) 7=Mechanical, 2=0-3-8
 Max Horz 2=113(LC 11)
 Max Uplift 7=-57(LC 8), 2=-123(LC 8)
 Max Grav 7=291(LC 1), 2=448(LC 1)

FORCES. (lb) - Max. Comp./Max. Ten. - All forces 250 (lb) or less except when shown.
 TOP CHORD 2-4=-334/78

- NOTES-**
- 1) Wind: ASCE 7-16; Vult=115mph (3-second gust) Vasd=91mph; TCDL=6.0psf; BCDL=4.2psf; h=15ft; Cat. II; Exp C; Enclosed; MWFRS (envelope) gable end zone and C-C Exterior(2E) -1-10-8 to 1-1-8, Interior(1) 1-1-8 to 6-10-15 zone; cantilever left and right exposed; end vertical left and right exposed; C-C for members and forces & MWFRS for reactions shown; Lumber DOL=1.60 plate grip DOL=1.60
 - 2) This truss has been designed for a 10.0 psf bottom chord live load nonconcurrent with any other live loads.
 - 3) Refer to girder(s) for truss to truss connections.
 - 4) Provide mechanical connection (by others) of truss to bearing plate capable of withstanding 100 lb uplift at joint(s) 7 except (jt=lb) 2=123.
 - 5) This truss is designed in accordance with the 2018 International Residential Code sections R502.11.1 and R802.10.2 and referenced standard ANSI/TPI 1.
 - 6) This truss design requires that a minimum of 7/16" structural wood sheathing be applied directly to the top chord and 1/2" gypsum sheetrock be applied directly to the bottom chord.



June 12, 2023

Job 3664536	Truss J5	Truss Type Jack-Open	Qty 2	Ply 1	Summit/185 Highland Meadows Job Reference (optional)	AS NOTED FOR PLAN REVIEW DEVELOPMENT SERVICES LEE'S SUMMIT, MISSOURI
----------------	-------------	-------------------------	----------	----------	---	--

Builders FirstSource (Valley Center), Valley Center, KS - 67147, 8.630 s Nov 19 2022 MiTek Industries, Inc. Thu Jun 21 14:12:47 2023 Page 1
 ID:icBMJaMgT1gasuUyx9?RhvzDEHb-RfC?PsB70Hq3NSpPqnL8w3ulTXbGKVICDm7JzJICP

10/10/2023

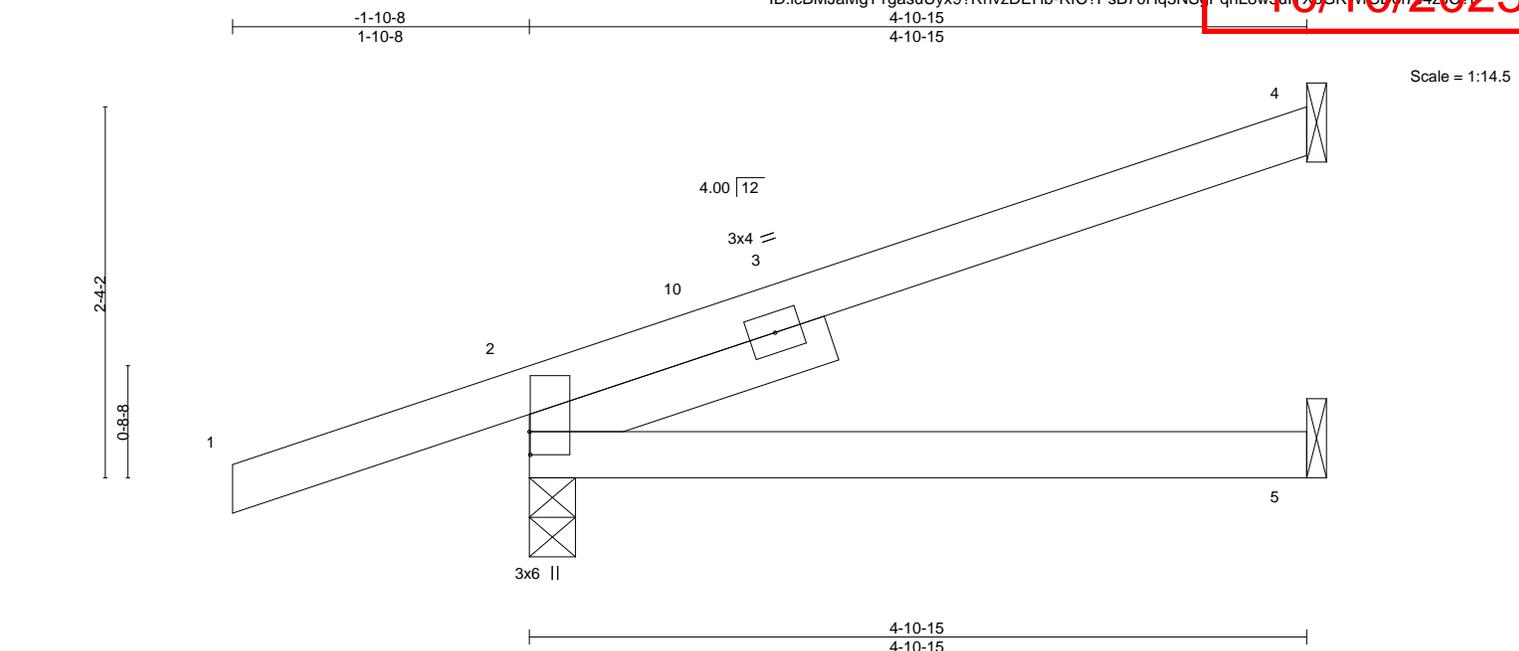


Plate Offsets (X,Y)--	[2:0-1-12,0-0-1]
-----------------------	------------------

LOADING (psf)	SPACING-	CSI.	DEFL.	PLATES	GRIP
TCLL 25.0	2-0-0	TC 0.26	in (loc) l/defl L/d	MT20	197/144
TCDL 10.0	Plate Grip DOL 1.15	BC 0.19	Vert(LL) 0.03 5-8 >999 240		
BCLL 0.0	Lumber DOL 1.15	WB 0.00	Vert(CT) -0.04 5-8 >999 180		
BCDL 10.0	Rep Stress Incr YES	Matrix-AS	Horz(CT) 0.01 4 n/a n/a		
	Code IRC2018/TPI2014			Weight: 16 lb	FT = 20%

LUMBER-	BRACING-
TOP CHORD 2x4 SPF No.2	TOP CHORD Structural wood sheathing directly applied.
BOT CHORD 2x4 SPF No.2	BOT CHORD Rigid ceiling directly applied.
SLIDER Left 2x4 SPF No.2 2-0-0	

REACTIONS. (size) 4=Mechanical, 2=0-3-8, 5=Mechanical
 Max Horz 2=90(LC 8)
 Max Uplift 4=54(LC 12), 2=106(LC 8)
 Max Grav 4=138(LC 1), 2=375(LC 1), 5=83(LC 3)

FORCES. (lb) - Max. Comp./Max. Ten. - All forces 250 (lb) or less except when shown.

- NOTES-**
- 1) Wind: ASCE 7-16; Vult=115mph (3-second gust) Vasd=91mph; TCDL=6.0psf; BCDL=4.2psf; h=15ft; Cat. II; Exp C; Enclosed; MWFRS (envelope) gable end zone and C-C Exterior(2E) -1-10-8 to 1-1-8, Interior(1) 1-1-8 to 4-10-3 zone; cantilever left and right exposed; end vertical left and right exposed; C-C for members and forces & MWFRS for reactions shown; Lumber DOL=1.60 plate grip DOL=1.60
 - 2) This truss has been designed for a 10.0 psf bottom chord live load nonconcurrent with any other live loads.
 - 3) Refer to girder(s) for truss to truss connections.
 - 4) Provide mechanical connection (by others) of truss to bearing plate capable of withstanding 54 lb uplift at joint 4 and 106 lb uplift at joint 2.
 - 5) This truss is designed in accordance with the 2018 International Residential Code sections R502.11.1 and R802.10.2 and referenced standard ANSI/TPI 1.
 - 6) This truss design requires that a minimum of 7/16" structural wood sheathing be applied directly to the top chord and 1/2" gypsum sheetrock be applied directly to the bottom chord.



June 12, 2023

Job 3664536	Truss J6	Truss Type Jack-Open	Qty 2	Ply 1	Summit/185 Highland Meadows Job Reference (optional)
----------------	-------------	-------------------------	----------	----------	---

AS NOTED FOR PLAN REVIEW
DEVELOPMENT SERVICES
LEE'S SUMMIT, MISSOURI

Builders FirstSource (Valley Center), Valley Center, KS - 67147,

8.630 s Nov 19 2022 MiTek Industries, Inc. Thu Jun 21 14:12:48 2023 Page 1

ID:icBMJaMgT1gasuUyx9?RhvzDEHb-RfC?PsB70Hq3NSpPqnL8w3ulTXbGKVICDm7JzICP

10/10/2023

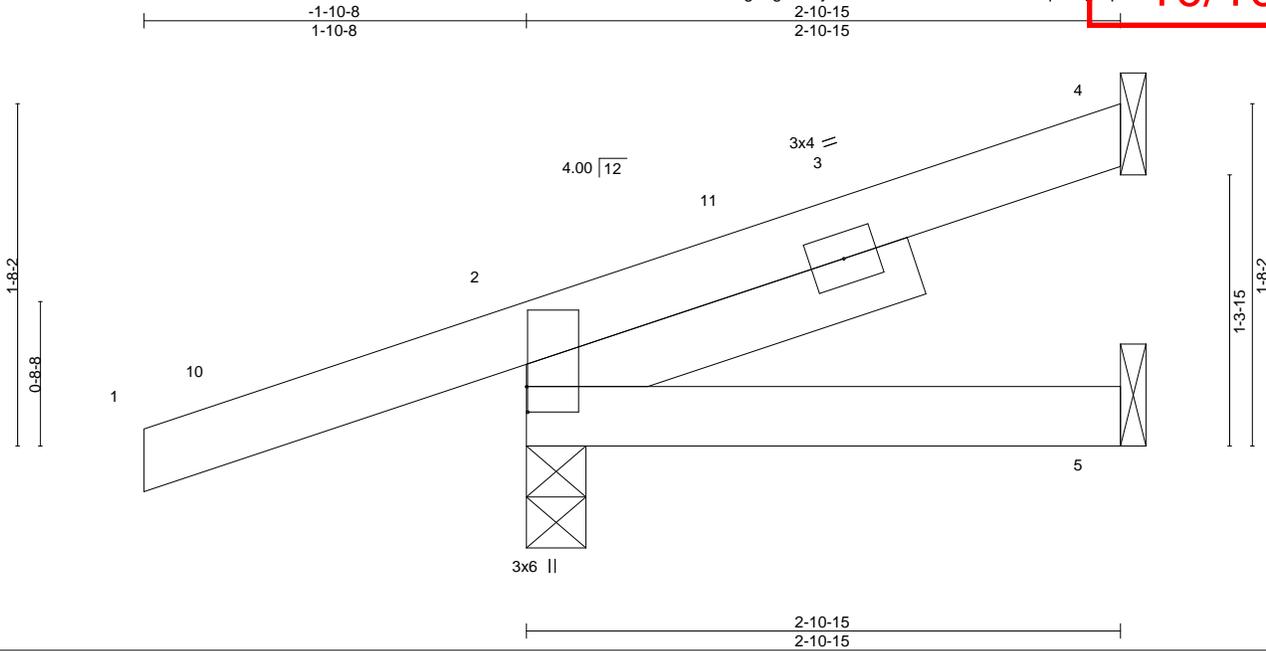


Plate Offsets (X,Y)--	[2:0-1-8,0-0-1]					PLATES	GRIP		
LOADING (psf)	SPACING-	2-0-0	CSI.	DEFL.	in (loc)	l/defl	L/d		
TCLL 25.0	Plate Grip DOL	1.15	TC 0.22	Vert(LL)	-0.00	8	>999	240	
TCDL 10.0	Lumber DOL	1.15	BC 0.04	Vert(CT)	-0.00	5-8	>999	180	
BCLL 0.0	Rep Stress Incr	YES	WB 0.00	Horz(CT)	0.00	2	n/a	n/a	
BCDL 10.0	Code	IRC2018/TPI2014	Matrix-MP					Weight: 11 lb	FT = 20%

LUMBER-		BRACING-	
TOP CHORD	2x4 SPF No.2	TOP CHORD	Structural wood sheathing directly applied or 2-10-15 oc purlins.
BOT CHORD	2x4 SPF No.2	BOT CHORD	Rigid ceiling directly applied or 10-0-0 oc bracing.
SLIDER	Left 2x4 SPF No.2 2-0-0		

REACTIONS. (size) 4=Mechanical, 2=0-3-8, 5=Mechanical
 Max Horz 2=65(LC 8)
 Max Uplift 4=-28(LC 12), 2=-103(LC 8)
 Max Grav 4=62(LC 1), 2=303(LC 1), 5=43(LC 3)

FORCES. (lb) - Max. Comp./Max. Ten. - All forces 250 (lb) or less except when shown.

- NOTES-**
- 1) Wind: ASCE 7-16; Vult=115mph (3-second gust) Vasd=91mph; TCDL=6.0psf; BCDL=4.2psf; h=15ft; Cat. II; Exp C; Enclosed; MWFRS (envelope) gable end zone and C-C Exterior(2E) -1-10-8 to 1-1-8, Interior(1) 1-1-8 to 2-10-3 zone; cantilever left and right exposed; end vertical left and right exposed; C-C for members and forces & MWFRS for reactions shown; Lumber DOL=1.60 plate grip DOL=1.60
 - 2) This truss has been designed for a 10.0 psf bottom chord live load nonconcurrent with any other live loads.
 - 3) Refer to girder(s) for truss to truss connections.
 - 4) Provide mechanical connection (by others) of truss to bearing plate capable of withstanding 28 lb uplift at joint 4 and 103 lb uplift at joint 2.
 - 5) This truss is designed in accordance with the 2018 International Residential Code sections R502.11.1 and R802.10.2 and referenced standard ANSI/TPI 1.




June 12, 2023

Job 3664536	Truss J7	Truss Type Jack-Open	Qty 1	Ply 1	Summit/185 Highland Meadows Job Reference (optional)
----------------	-------------	-------------------------	----------	----------	---

AS NOTED FOR PLAN REVIEW
DEVELOPMENT SERVICES
LEE'S SUMMIT, MISSOURI

Builders FirstSource (Valley Center), Valley Center, KS - 67147, 8.630 s Nov 19 2022 MiTek Industries, Inc. Thu Jun 27 14:12:49 2023 Page 1
ID:icBMJaMgT1gasuUyx9?RhvzDEHb-RfC?PsB70Hq3NSuPqnL8wGulTXbGKVICU7f7JzJICP?

10/10/2023

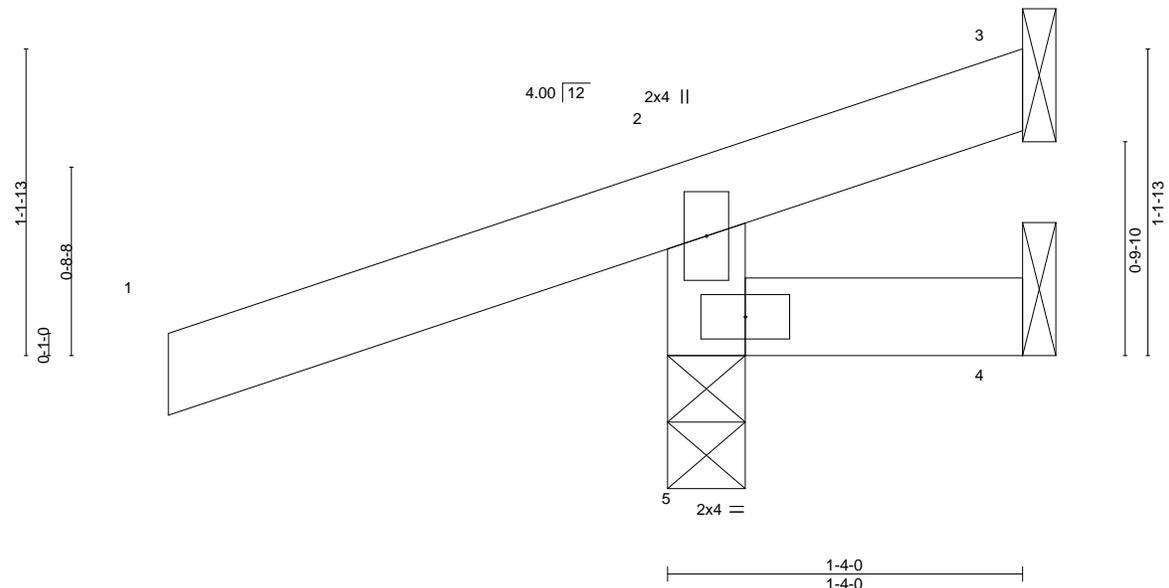

LOADING (psf)	SPACING-	2-0-0	CSI.	DEFL.	in (loc)	l/defl	L/d	PLATES	GRIP
TCLL 25.0	Plate Grip DOL	1.15	TC 0.28	Vert(LL)	0.00	5	>999	MT20	197/144
TCDL 10.0	Lumber DOL	1.15	BC 0.08	Vert(CT)	0.00	5	>999		
BCLL 0.0	Rep Stress Incr	YES	WB 0.00	Horz(CT)	-0.00	3	n/a		
BCDL 10.0	Code IRC2018/TPI2014		Matrix-MR					Weight: 6 lb	FT = 20%

LUMBER-	BRACING-
TOP CHORD 2x4 SPF No.2	TOP CHORD Structural wood sheathing directly applied or 1-4-0 oc purlins, except end verticals.
BOT CHORD 2x4 SPF No.2	BOT CHORD Rigid ceiling directly applied or 10-0-0 oc bracing.
WEBS 2x4 SPF No.2	

REACTIONS. (size) 3=Mechanical, 4=Mechanical, 5=0-3-8
 Max Horz 5=40(LC 8)
 Max Uplift 3=-43(LC 1), 4=-26(LC 1), 5=-138(LC 8)
 Max Grav 3=26(LC 8), 4=19(LC 8), 5=316(LC 1)

FORCES. (lb) - Max. Comp./Max. Ten. - All forces 250 (lb) or less except when shown.
 TOP CHORD 2-5=-266/199

- NOTES-**
- 1) Wind: ASCE 7-16; Vult=115mph (3-second gust) Vasd=91mph; TCDL=6.0psf; BCDL=4.2psf; h=15ft; Cat. II; Exp C; Enclosed; MWFRS (envelope) gable end zone and C-C Exterior(2E) zone; cantilever left and right exposed ; end vertical left and right exposed;C-C for members and forces & MWFRS for reactions shown; Lumber DOL=1.60 plate grip DOL=1.60
 - 2) This truss has been designed for a 10.0 psf bottom chord live load nonconcurrent with any other live loads.
 - 3) Refer to girder(s) for truss to truss connections.
 - 4) Bearing at joint(s) 5 considers parallel to grain value using ANSI/TPI 1 angle to grain formula. Building designer should verify capacity of bearing surface.
 - 5) Provide mechanical connection (by others) of truss to bearing plate capable of withstanding 43 lb uplift at joint 3, 26 lb uplift at joint 4 and 138 lb uplift at joint 5.
 - 6) This truss is designed in accordance with the 2018 International Residential Code sections R502.11.1 and R802.10.2 and referenced standard ANSI/TPI 1.



June 12, 2023

Job 3664536	Truss J8	Truss Type Jack-Open	Qty 4	Ply 1	Summit/185 Highland Meadows Job Reference (optional)
----------------	-------------	-------------------------	----------	----------	---

RELEASE FOR CONSTRUCTION

AS NOTED FOR PLAN REVIEW
DEVELOPMENT SERVICES

LEE'S SUMMIT, MISSOURI

10/10/2023

Builders FirstSource (Valley Center), Valley Center, KS - 67147,

8.630 s Nov 19 2022 MiTek Industries, Inc. Thu Jun 21 14:12:50 2023 Page 1

ID:icBMJaMgT1gasuUyx9?RhvzDEHb-RfC?PsB70Hq3NSpPqnL8wGulTXbGKvICDm7JzJICP

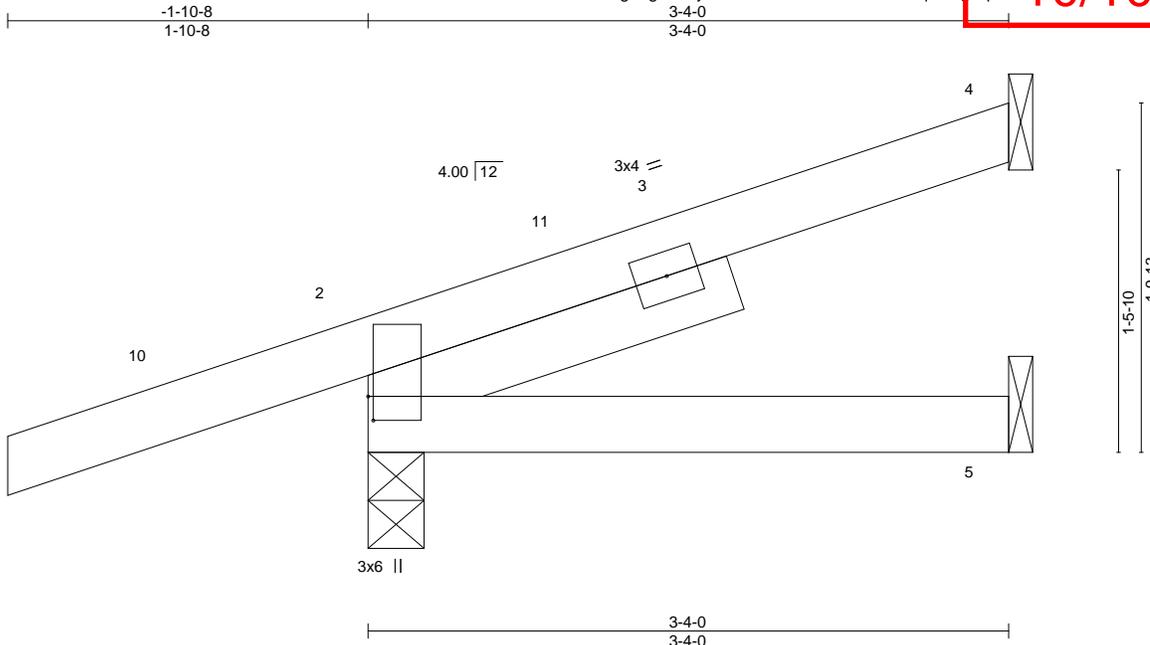


Plate Offsets (X,Y)--	[2:0-1-8,0-0-5]					Weight: 12 lb	FT = 20%
LOADING (psf)	SPACING-	2-0-0	CSI.	DEFL.	in (loc)	l/defl	L/d
TCLL 25.0	Plate Grip DOL	1.15	TC 0.22	Vert(LL)	0.01 5-8	>999	240
TCDL 10.0	Lumber DOL	1.15	BC 0.07	Vert(CT)	-0.01 5-8	>999	180
BCLL 0.0	Rep Stress Incr	YES	WB 0.00	Horz(CT)	0.00 2	n/a	n/a
BCDL 10.0	Code	IRC2018/TPI2014	Matrix-MP				

LUMBER-		BRACING-	
TOP CHORD	2x4 SPF No.2	TOP CHORD	Structural wood sheathing directly applied or 3-4-0 oc purlins.
BOT CHORD	2x4 SPF No.2	BOT CHORD	Rigid ceiling directly applied or 10-0-0 oc bracing.
SLIDER	Left 2x4 SPF No.2 2-0-0		

REACTIONS. (size) 4=Mechanical, 2=0-3-8, 5=Mechanical
 Max Horz 2=70(LC 8)
 Max Uplift 4=-33(LC 12), 2=-103(LC 8)
 Max Grav 4=79(LC 1), 2=316(LC 1), 5=52(LC 3)

FORCES. (lb) - Max. Comp./Max. Ten. - All forces 250 (lb) or less except when shown.

NOTES-

- 1) Wind: ASCE 7-16; Vult=115mph (3-second gust) Vasd=91mph; TCDL=6.0psf; BCDL=4.2psf; h=15ft; Cat. II; Exp C; Enclosed; MWFRS (envelope) gable end zone and C-C Exterior(2E) -1-10-8 to 1-1-8, Interior(1) 1-1-8 to 3-3-4 zone; cantilever left and right exposed; end vertical left and right exposed; C-C for members and forces & MWFRS for reactions shown; Lumber DOL=1.60 plate grip DOL=1.60
- 2) This truss has been designed for a 10.0 psf bottom chord live load nonconcurrent with any other live loads.
- 3) Refer to girder(s) for truss to truss connections.
- 4) Provide mechanical connection (by others) of truss to bearing plate capable of withstanding 33 lb uplift at joint 4 and 103 lb uplift at joint 2.
- 5) This truss is designed in accordance with the 2018 International Residential Code sections R502.11.1 and R802.10.2 and referenced standard ANSI/TPI 1.



June 12, 2023

<p>WARNING - Verify design parameters and READ NOTES ON THIS AND INCLUDED MITEK REFERENCE PAGE MII-7473 rev. 1/2/2023 BEFORE USE.</p> <p>Design valid for use only with MiTek® connectors. This design is based only upon parameters shown, and is for an individual building component, not a truss system. Before use, the building designer must verify the applicability of design parameters and properly incorporate this design into the overall building design. Bracing indicated is to prevent buckling of individual truss web and/or chord members only. Additional temporary and permanent bracing is always required for stability and to prevent collapse with possible personal injury and property damage. For general guidance regarding the fabrication, storage, delivery, erection and bracing of trusses and truss systems, see ANSI/TPI1 Quality Criteria, and DSB-22 available from Truss Plate Institute (www.tpinst.org) and BCSI Building Component Safety Information available from the Structural Building Component Association (www.sbcsccomponents.com)</p>	 <p>16023 Swingley Ridge Rd. Chesterfield, MO 63017 314.434.1200 / MiTek-US.com</p>
---	--

Job 3664536	Truss J9	Truss Type Jack-Open	Qty 2	Ply 1	Summit/185 Highland Meadows Job Reference (optional)
----------------	-------------	-------------------------	----------	----------	---


AS NOTED FOR PLAN REVIEW
DEVELOPMENT SERVICES
LEE'S SUMMIT, MISSOURI

Builders FirstSource (Valley Center), Valley Center, KS - 67147,

8.630 s Nov 19 2022 MiTek Industries, Inc. Thu Jun 15 14:12:51 2023 Page 1

ID:icBMJaMgT1gasuUyx9?RhvzDEHb-RfC?PsB70Hq3NSyPqnL8wGulTXbGKVICU7f7JzICP?

10/10/2023

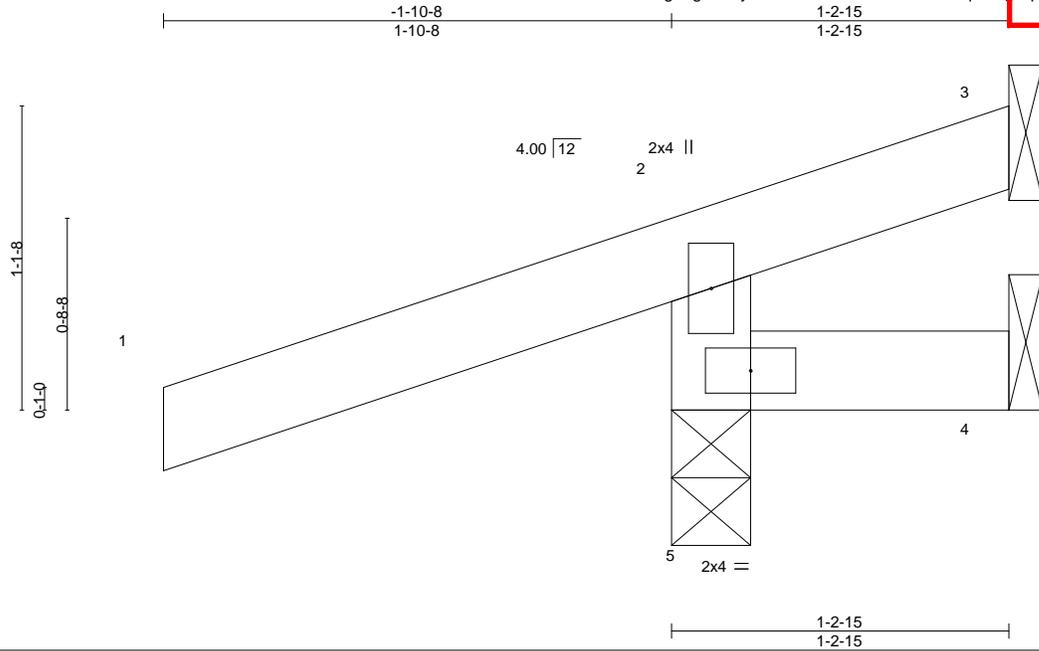

Scale = 1:8.5

LOADING (psf)	SPACING-	CSI.	DEFL.	in (loc)	l/defl	L/d	PLATES	GRIP
TCLL 25.0	2-0-0	TC 0.28	Vert(LL)	0.00	5	>999	MT20	197/144
TCDL 10.0	Plate Grip DOL 1.15	BC 0.08	Vert(CT)	0.00	5	>999		
BCLL 0.0	Lumber DOL 1.15	WB 0.00	Horz(CT)	-0.00	3	n/a		
BCDL 10.0	Rep Stress Incr YES	Matrix-MR						
	Code IRC2018/TPI2014						Weight: 6 lb	FT = 20%

LUMBER-
TOP CHORD 2x4 SPF No.2
BOT CHORD 2x4 SPF No.2
WEBS 2x4 SPF No.2

BRACING-
TOP CHORD Structural wood sheathing directly applied or 1-2-15 oc purlins, except end verticals.
BOT CHORD Rigid ceiling directly applied or 10-0-0 oc bracing.

REACTIONS. (size) 3=Mechanical, 4=Mechanical, 5=0-3-8
Max Horz 5=39(LC 8)
Max Uplift 3=-53(LC 1), 4=-29(LC 1), 5=-142(LC 8)
Max Grav 3=31(LC 8), 4=19(LC 8), 5=322(LC 1)

FORCES. (lb) - Max. Comp./Max. Ten. - All forces 250 (lb) or less except when shown.
TOP CHORD 2-5=-271/204

NOTES-

- 1) Wind: ASCE 7-16; Vult=115mph (3-second gust) Vasd=91mph; TCDL=6.0psf; BCDL=4.2psf; h=15ft; Cat. II; Exp C; Enclosed; MWFRS (envelope) gable end zone and C-C Exterior(2E) zone; cantilever left and right exposed ; end vertical left and right exposed;C-C for members and forces & MWFRS for reactions shown; Lumber DOL=1.60 plate grip DOL=1.60
- 2) This truss has been designed for a 10.0 psf bottom chord live load nonconcurrent with any other live loads.
- 3) Refer to girder(s) for truss to truss connections.
- 4) Bearing at joint(s) 5 considers parallel to grain value using ANSI/TPI 1 angle to grain formula. Building designer should verify capacity of bearing surface.
- 5) Provide mechanical connection (by others) of truss to bearing plate capable of withstanding 53 lb uplift at joint 3, 29 lb uplift at joint 4 and 142 lb uplift at joint 5.
- 6) This truss is designed in accordance with the 2018 International Residential Code sections R502.11.1 and R802.10.2 and referenced standard ANSI/TPI 1.



June 12, 2023

WARNING - Verify design parameters and READ NOTES ON THIS AND INCLUDED MITEK REFERENCE PAGE MII-7473 rev. 1/2/2023 BEFORE USE.
Design valid for use only with MiTek® connectors. This design is based only upon parameters shown, and is for an individual building component, not a truss system. Before use, the building designer must verify the applicability of design parameters and properly incorporate this design into the overall building design. Bracing indicated is to prevent buckling of individual truss web and/or chord members only. Additional temporary and permanent bracing is always required for stability and to prevent collapse with possible personal injury and property damage. For general guidance regarding the fabrication, storage, delivery, erection and bracing of trusses and truss systems, see **ANSI/TPI1 Quality Criteria, and DSB-22** available from Truss Plate Institute (www.tpinst.org) and **BCSI Building Component Safety Information** available from the Structural Building Component Association (www.sbcsccomponents.com)


MiTek®
16023 Swingley Ridge Rd.
Chesterfield, MO 63017
314.434.1200 / MiTek-US.com

Job 3664536	Truss J10	Truss Type Jack-Partial	Qty 9	Ply 1	Summit/185 Highland Meadows
----------------	--------------	----------------------------	----------	----------	-----------------------------

AS NOTED FOR PLAN REVIEW
DEVELOPMENT SERVICES
LEE'S SUMMIT, MISSOURI

Builders FirstSource (Valley Center), Valley Center, KS - 67147, 8.630 s Nov 19 2022 MiTek Industries, Inc. Thu Jun 21 14:12:24 2023 Page 1

10/10/2023

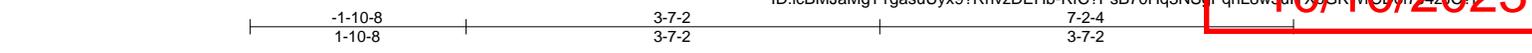

Scale = 1:19.9

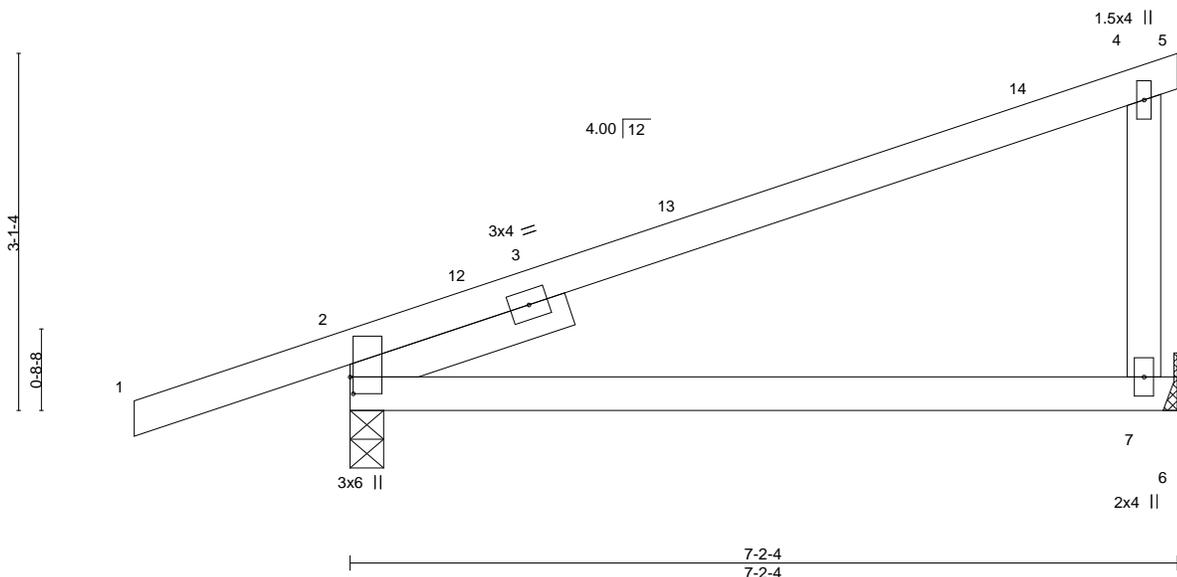


Plate Offsets (X, Y)--	[2:0-1-12,0-0-5]
------------------------	------------------

LOADING (psf)	SPACING-	2-0-0	CSI.	DEFL.	in (loc)	l/defl	L/d	PLATES	GRIP
TCLL 25.0	Plate Grip DOL	1.15	TC 0.60	Vert(LL)	0.10	7-10	>819	MT20	197/144
TCDL 10.0	Lumber DOL	1.15	BC 0.40	Vert(CT)	-0.20	7-10	>414		
BCLL 0.0	Rep Stress Incr	YES	WB 0.04	Horz(CT)	0.04	2	n/a		
BCDL 10.0	Code	IRC2018/TPI2014	Matrix-AS						
								Weight: 24 lb	FT = 20%

LUMBER-	BRACING-
TOP CHORD 2x4 SPF No.2	TOP CHORD Structural wood sheathing directly applied.
BOT CHORD 2x4 SPF No.2	BOT CHORD Rigid ceiling directly applied.
WEBS 2x4 SPF No.2	
SLIDER Left 2x4 SPF No.2 2-0-0	

REACTIONS. (size) 2=0-3-8, 7=Mechanical
 Max Horz 2=118(LC 8)
 Max Uplift 2=-114(LC 8), 7=-71(LC 8)
 Max Grav 2=459(LC 1), 7=304(LC 1)

FORCES. (lb) - Max. Comp./Max. Ten. - All forces 250 (lb) or less except when shown.
 TOP CHORD 2-4=-359/52

- NOTES-**
- 1) Wind: ASCE 7-16; Vult=115mph (3-second gust) Vasd=91mph; TCDL=6.0psf; BCDL=4.2psf; h=15ft; Cat. II; Exp C; Enclosed; MWFRS (envelope) gable end zone and C-C Exterior(2E) -1-10-8 to 1-1-8, Interior(1) 1-1-8 to 7-2-4 zone; cantilever left and right exposed ; end vertical left and right exposed;C-C for members and forces & MWFRS for reactions shown; Lumber DOL=1.60 plate grip DOL=1.60
 - 2) This truss has been designed for a 10.0 psf bottom chord live load nonconcurrent with any other live loads.
 - 3) Refer to girder(s) for truss to truss connections.
 - 4) Provide mechanical connection (by others) of truss to bearing plate capable of withstanding 114 lb uplift at joint 2 and 71 lb uplift at joint 7.
 - 5) This truss is designed in accordance with the 2018 International Residential Code sections R502.11.1 and R802.10.2 and referenced standard ANSI/TPI 1.
 - 6) This truss design requires that a minimum of 7/16" structural wood sheathing be applied directly to the top chord and 1/2" gypsum sheetrock be applied directly to the bottom chord.



June 12, 2023

Job 3664536	Truss J12	Truss Type Jack-Open	Qty 2	Ply 1	Summit/185 Highland Meadows Job Reference (optional)
----------------	--------------	-------------------------	----------	----------	---

AS NOTED FOR PLAN REVIEW
DEVELOPMENT SERVICES
LEE'S SUMMIT, MISSOURI

Builders FirstSource (Valley Center), Valley Center, KS - 67147,

8.630 s Nov 19 2022 MiTek Industries, Inc. Thu Jun 21 14:12:26 2023 Page 1

ID:icBMJaMgT1gasuUyx9?RhvzDEHb-RfC?PsB70Hq3NSyPqnL8w3ulTXbGKVICDm7JzZICP?

10/10/2023

-1-10-8
1-10-8

3-10-15
3-10-15

Scale = 1:12.9

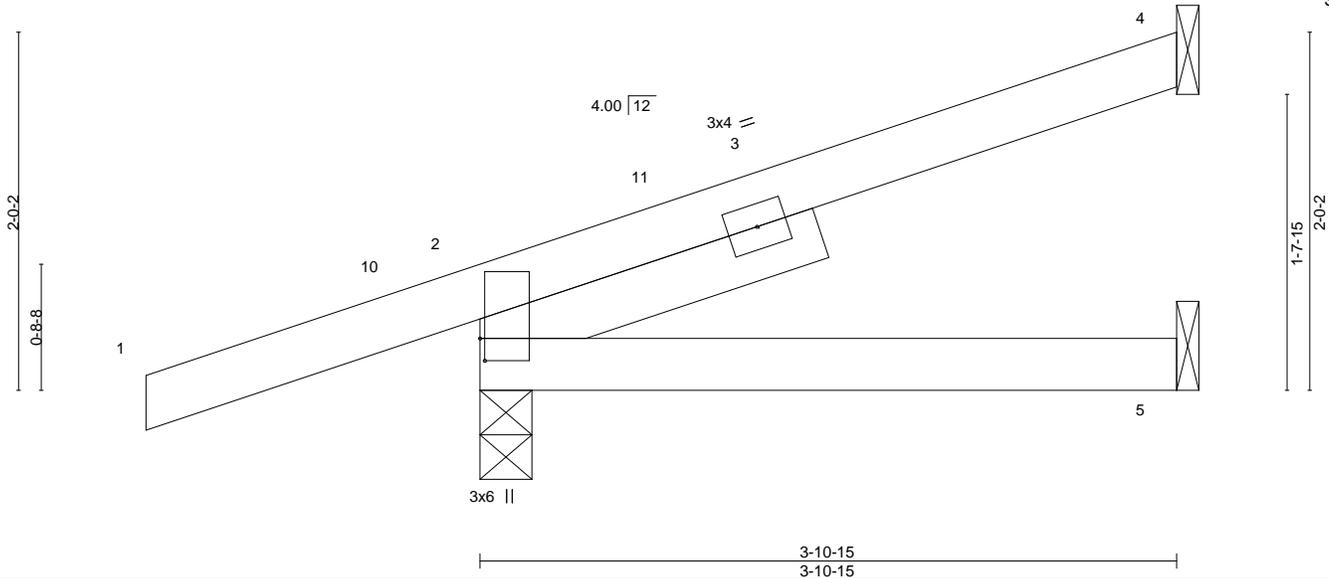


Plate Offsets (X,Y)--	[2:0-1-8,0-0-5]				
LOADING (psf)	SPACING- 2-0-0	CSI.	DEFL. in (loc) l/defl L/d	PLATES	GRIP
TCLL 25.0	Plate Grip DOL 1.15	TC 0.22	Vert(LL) -0.01 5-8 >999 240	MT20	197/144
TCDL 10.0	Lumber DOL 1.15	BC 0.11	Vert(CT) -0.02 5-8 >999 180		
BCLL 0.0	Rep Stress Incr YES	WB 0.00	Horz(CT) 0.01 2 n/a n/a		
BCDL 10.0	Code IRC2018/TPI2014	Matrix-MP		Weight: 14 lb	FT = 20%

LUMBER-	BRACING-
TOP CHORD 2x4 SPF No.2	TOP CHORD Structural wood sheathing directly applied or 3-10-15 oc purlins.
BOT CHORD 2x4 SPF No.2	BOT CHORD Rigid ceiling directly applied or 10-0-0 oc bracing.
SLIDER Left 2x4 SPF No.2 2-0-0	

REACTIONS. (size) 4=Mechanical, 2=0-3-8, 5=Mechanical
 Max Horz 2=78(LC 8)
 Max Uplift 4=-41(LC 12), 2=-103(LC 8)
 Max Grav 4=101(LC 1), 2=336(LC 1), 5=64(LC 3)

FORCES. (lb) - Max. Comp./Max. Ten. - All forces 250 (lb) or less except when shown.

NOTES-

- 1) Wind: ASCE 7-16; Vult=115mph (3-second gust) Vasd=91mph; TCDL=6.0psf; BCDL=4.2psf; h=15ft; Cat. II; Exp C; Enclosed; MWFRS (envelope) gable end zone and C-C Exterior(2E) -1-10-8 to 1-1-8, Interior(1) 1-1-8 to 3-10-3 zone; cantilever left and right exposed; end vertical left and right exposed; C-C for members and forces & MWFRS for reactions shown; Lumber DOL=1.60 plate grip DOL=1.60
- 2) This truss has been designed for a 10.0 psf bottom chord live load nonconcurrent with any other live loads.
- 3) Refer to girder(s) for truss to truss connections.
- 4) Provide mechanical connection (by others) of truss to bearing plate capable of withstanding 41 lb uplift at joint 4 and 103 lb uplift at joint 2.
- 5) This truss is designed in accordance with the 2018 International Residential Code sections R502.11.1 and R802.10.2 and referenced standard ANSI/TPI 1.



June 12, 2023

Job 3664536	Truss J13	Truss Type Jack-Open	Qty 4	Ply 1	Summit/185 Highland Meadows Job Reference (optional)
----------------	--------------	-------------------------	----------	----------	---

AS NOTED FOR PLAN REVIEW
DEVELOPMENT SERVICES
LEE'S SUMMIT, MISSOURI

Builders FirstSource (Valley Center), Valley Center, KS - 67147,

8.630 s Nov 19 2022 MiTek Industries, Inc. Thu Jun 21 14:12:27 2023 Page 1

ID:icBMJaMgT1gasuUyx9?RhvzDEHb-RfC?PsB70Hq3NSuPqnL8wGulTxbGKVICd7f7JzICP

10/10/2023

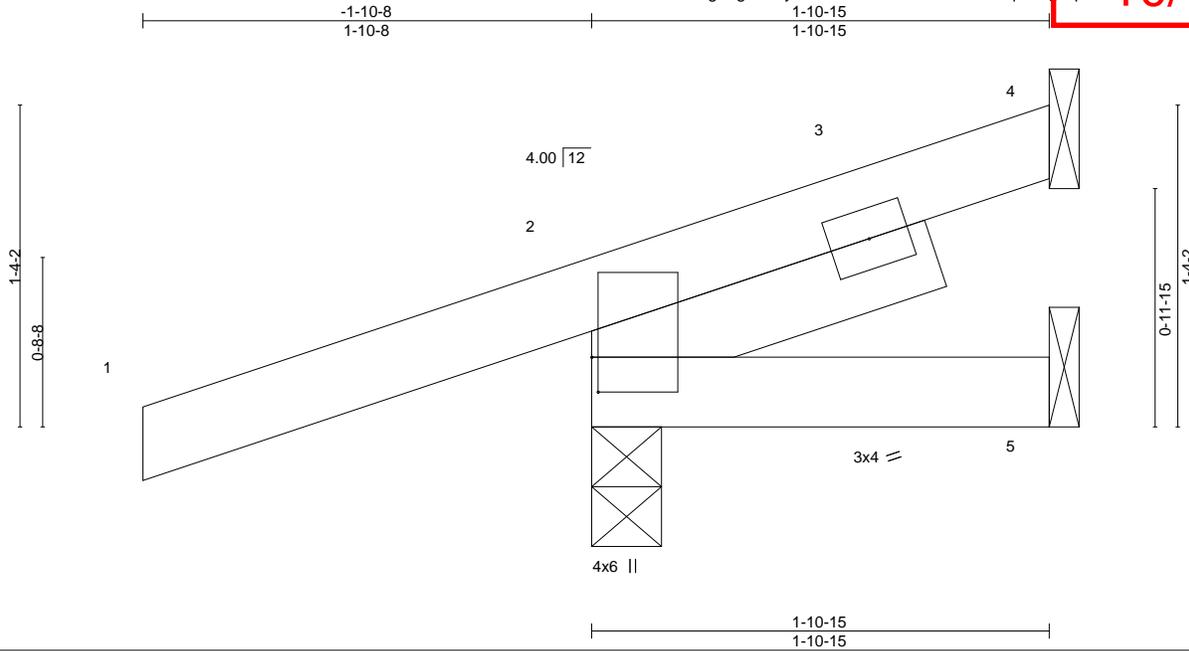


Plate Offsets (X,Y)--	[2:0-1-12,0-0-5]				
LOADING (psf)	SPACING- 2-0-0	CSI.	DEFL. in (loc) l/defl L/d	PLATES	GRIP
TCLL 25.0	Plate Grip DOL 1.15	TC 0.24	Vert(LL) 0.00 8 >999 240	MT20	197/144
TCDL 10.0	Lumber DOL 1.15	BC 0.02	Vert(CT) 0.00 8 >999 180		
BCLL 0.0	Rep Stress Incr YES	WB 0.00	Horz(CT) -0.00 2 n/a n/a		
BCDL 10.0	Code IRC2018/TPI2014	Matrix-MP		Weight: 9 lb	FT = 20%

LUMBER-	BRACING-
TOP CHORD 2x4 SPF No.2	TOP CHORD Structural wood sheathing directly applied or 1-10-15 oc purlins.
BOT CHORD 2x4 SPF No.2	BOT CHORD Rigid ceiling directly applied or 10-0-0 oc bracing.
SLIDER Left 2x4 SPF No.2 1-6-0	

REACTIONS. (size) 4=Mechanical, 2=0-3-8, 5=Mechanical
 Max Horz 2=54(LC 8)
 Max Uplift 4=-13(LC 12), 2=-108(LC 8)
 Max Grav 4=18(LC 1), 2=282(LC 1), 5=24(LC 3)

FORCES. (lb) - Max. Comp./Max. Ten. - All forces 250 (lb) or less except when shown.

- NOTES-**
- 1) Wind: ASCE 7-16; Vult=115mph (3-second gust) Vasd=91mph; TCDL=6.0psf; BCDL=4.2psf; h=15ft; Cat. II; Exp C; Enclosed; MWFRS (envelope) gable end zone and C-C Exterior(2E) -1-10-8 to 1-1-8, Interior(1) 1-1-8 to 1-10-13 zone; cantilever left and right exposed; end vertical left and right exposed; C-C for members and forces & MWFRS for reactions shown; Lumber DOL=1.60 plate grip DOL=1.60
 - 2) This truss has been designed for a 10.0 psf bottom chord live load nonconcurrent with any other live loads.
 - 3) Refer to girder(s) for truss to truss connections.
 - 4) Provide mechanical connection (by others) of truss to bearing plate capable of withstanding 13 lb uplift at joint 4 and 108 lb uplift at joint 2.
 - 5) This truss is designed in accordance with the 2018 International Residential Code sections R502.11.1 and R802.10.2 and referenced standard ANSI/TPI 1.



June 12, 2023

Job 3664536	Truss J14	Truss Type Jack-Open	Qty 2	Ply 1	Summit/185 Highland Meadows Job Reference (optional)	AS NOTED FOR PLAN REVIEW DEVELOPMENT SERVICES LEE'S SUMMIT, MISSOURI
----------------	--------------	-------------------------	----------	----------	---	--

Builders FirstSource (Valley Center), Valley Center, KS - 67147,

8.630 s Nov 19 2022 MiTek Industries, Inc. Thu Jun 21 14:12:28 2023 Page 1

ID:icBMJaMgT1gasuUyx9?RhvzDEHb-RfC?PsB70Hq3NSpPqnL8w3ulTXbGKVICDm7JzZICP?

10/10/2023

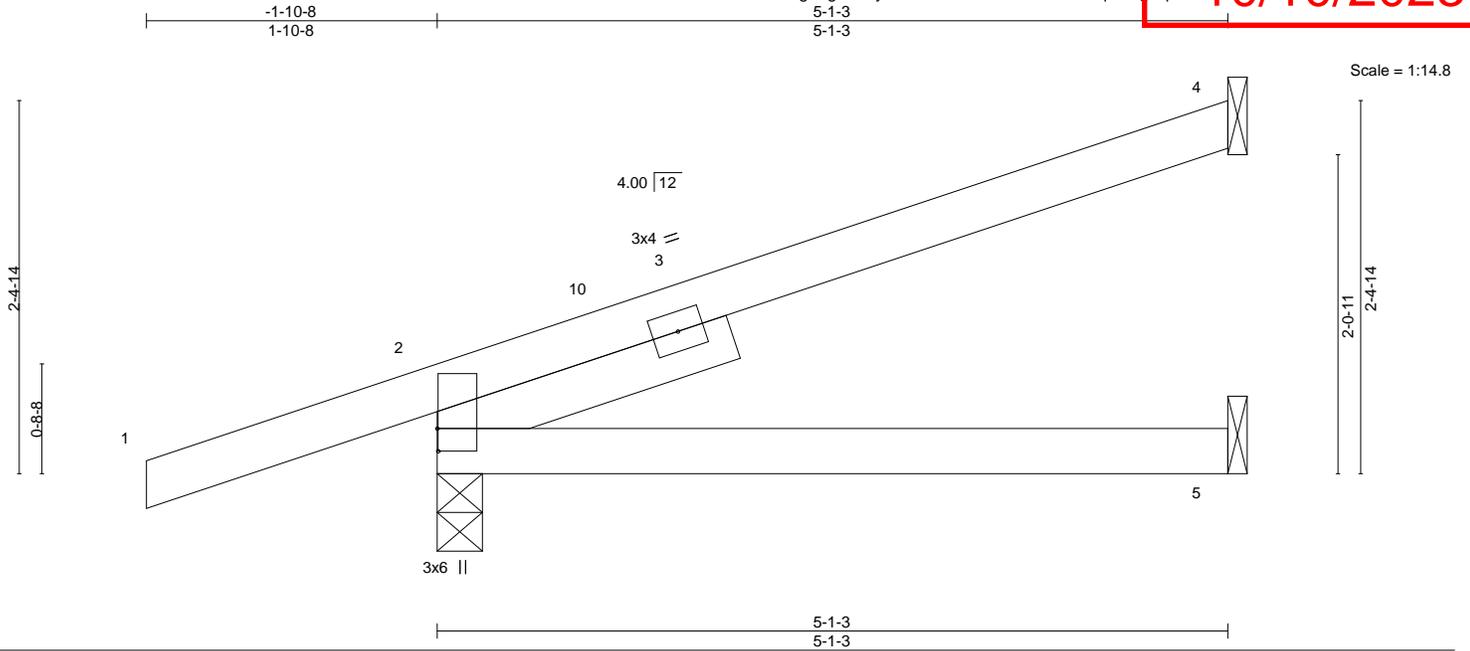


Plate Offsets (X,Y)--	[2:0-1-12,0-0-1]				
LOADING (psf)	SPACING- 2-0-0	CSI.	DEFL. in (loc) l/defl L/d	PLATES	GRIP
TCLL 25.0	Plate Grip DOL 1.15	TC 0.29	Vert(LL) 0.04 5-8 >999 240	MT20	197/144
TCDL 10.0	Lumber DOL 1.15	BC 0.20	Vert(CT) -0.05 5-8 >999 180		
BCLL 0.0	Rep Stress Incr YES	WB 0.00	Horz(CT) 0.01 4 n/a n/a		
BCDL 10.0	Code IRC2018/TPI2014	Matrix-AS		Weight: 17 lb	FT = 20%

LUMBER-	BRACING-
TOP CHORD 2x4 SPF No.2	TOP CHORD Structural wood sheathing directly applied.
BOT CHORD 2x4 SPF No.2	BOT CHORD Rigid ceiling directly applied.
SLIDER Left 2x4 SPF No.2 2-0-0	

REACTIONS. (size) 4=Mechanical, 2=0-3-8, 5=Mechanical
 Max Horz 2=92(LC 8)
 Max Uplift 4=57(LC 12), 2=107(LC 8)
 Max Grav 4=144(LC 1), 2=382(LC 1), 5=86(LC 3)

FORCES. (lb) - Max. Comp./Max. Ten. - All forces 250 (lb) or less except when shown.

NOTES-

- 1) Wind: ASCE 7-16; Vult=115mph (3-second gust) Vasd=91mph; TCDL=6.0psf; BCDL=4.2psf; h=15ft; Cat. II; Exp C; Enclosed; MWFRS (envelope) gable end zone and C-C Exterior(2E) -1-10-8 to 1-1-8, Interior(1) 1-1-8 to 5-0-7 zone; cantilever left and right exposed; end vertical left and right exposed; C-C for members and forces & MWFRS for reactions shown; Lumber DOL=1.60 plate grip DOL=1.60
- 2) This truss has been designed for a 10.0 psf bottom chord live load nonconcurrent with any other live loads.
- 3) Refer to girder(s) for truss to truss connections.
- 4) Provide mechanical connection (by others) of truss to bearing plate capable of withstanding 57 lb uplift at joint 4 and 107 lb uplift at joint 2.
- 5) This truss is designed in accordance with the 2018 International Residential Code sections R502.11.1 and R802.10.2 and referenced standard ANSI/TPI 1.
- 6) This truss design requires that a minimum of 7/16" structural wood sheathing be applied directly to the top chord and 1/2" gypsum sheetrock be applied directly to the bottom chord.



June 12, 2023


Job 3664536	Truss J15	Truss Type Jack-Open	Qty 2	Ply 1	Summit/185 Highland Meadows Job Reference (optional)	AS NOTED FOR PLAN REVIEW DEVELOPMENT SERVICES LEE'S SUMMIT, MISSOURI
----------------	--------------	-------------------------	----------	----------	---	--

Builders FirstSource (Valley Center), Valley Center, KS - 67147,

8.630 s Nov 19 2022 MiTek Industries, Inc. Thu Jun 21 14:12:29 2023 Page 1

ID:icBMJaMgT1gasuUyx9?RhvzDEHb-RfC?PsB70Hq3NSyPqnL8wGulTXbGKVICDm7JzJICP

10/10/2023

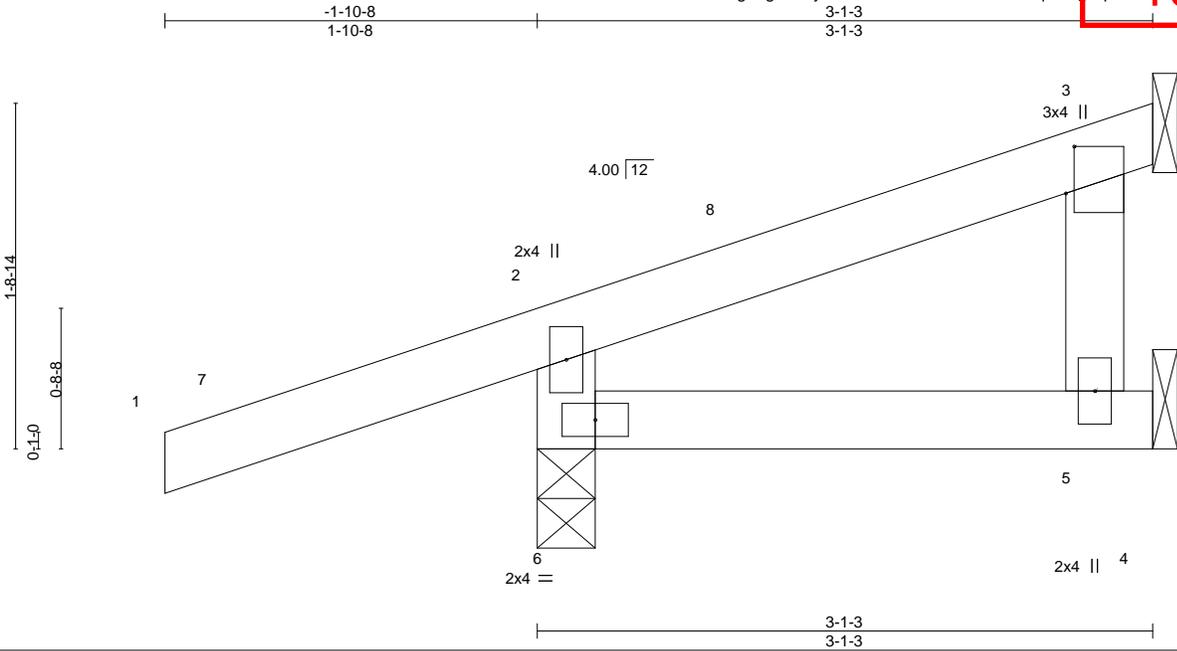

Scale = 1:11.5

Plate Offsets (X,Y)--	[3:0-2-13,0-0-8]				
LOADING (psf)	SPACING- 2-0-0	CSI.	DEFL. in (loc) l/defl L/d	PLATES	GRIP
TCLL 25.0	Plate Grip DOL 1.15	TC 0.26	Vert(LL) 0.00 5-6 >999 240	MT20	197/144
TCDL 10.0	Lumber DOL 1.15	BC 0.07	Vert(CT) -0.00 5-6 >999 180		
BCLL 0.0	Rep Stress Incr YES	WB 0.00	Horz(CT) -0.00 3 n/a n/a		
BCDL 10.0	Code IRC2018/TPI2014	Matrix-MP		Weight: 11 lb	FT = 20%

LUMBER-	BRACING-
TOP CHORD 2x4 SPF No.2	TOP CHORD Structural wood sheathing directly applied or 3-1-3 oc purlins, except end verticals.
BOT CHORD 2x4 SPF No.2	BOT CHORD Rigid ceiling directly applied or 10-0-0 oc bracing.
WEBS 2x4 SPF No.2	

REACTIONS. (size) 5=Mechanical, 3=Mechanical, 6=0-3-8
 Max Horz 6=59(LC 8)
 Max Uplift 3=-27(LC 12), 6=-112(LC 8)
 Max Grav 5=57(LC 3), 3=55(LC 1), 6=315(LC 1)

FORCES. (lb) - Max. Comp./Max. Ten. - All forces 250 (lb) or less except when shown.
 TOP CHORD 2-6=-273/202

NOTES-

- 1) Unbalanced roof live loads have been considered for this design.
- 2) Wind: ASCE 7-16; Vult=115mph (3-second gust) Vasd=91mph; TCDL=6.0psf; BCDL=4.2psf; h=15ft; Cat. II; Exp C; Enclosed; MWFRS (envelope) gable end zone and C-C Exterior(2E) -1-10-8 to 1-1-8, Interior(1) 1-1-8 to 2-9-11 zone; cantilever left and right exposed ; end vertical left and right exposed;C-C for members and forces & MWFRS for reactions shown; Lumber DOL=1.60 plate grip DOL=1.60
- 3) This truss has been designed for a 10.0 psf bottom chord live load nonconcurrent with any other live loads.
- 4) Refer to girder(s) for truss to truss connections.
- 5) Bearing at joint(s) 6 considers parallel to grain value using ANSI/TPI 1 angle to grain formula. Building designer should verify capacity of bearing surface.
- 6) Provide mechanical connection (by others) of truss to bearing plate capable of withstanding 27 lb uplift at joint 3 and 112 lb uplift at joint 6.
- 7) This truss is designed in accordance with the 2018 International Residential Code sections R502.11.1 and R802.10.2 and referenced standard ANSI/TPI 1.
- 8) Gap between inside of top chord bearing and first diagonal or vertical web shall not exceed 0.500in.



June 12, 2023

Job 3664536	Truss J16	Truss Type Jack-Open	Qty 2	Ply 1	Summit/185 Highland Meadows
----------------	--------------	-------------------------	----------	----------	-----------------------------

RELEASE FOR CONSTRUCTION

AS NOTED FOR PLAN REVIEW


DEVELOPMENT SERVICES

LEE'S SUMMIT, MISSOURI

10/10/2023

Builders FirstSource (Valley Center), Valley Center, KS - 67147, 8.630 s Nov 19 2022 MiTek Industries, Inc. Thu Jun 14 12:30:2023 Page 1

ID:icBMJaMgT1gasUyx9?RhvzDEHb-RfC?PsB70Hq3NSuPqnL8w3UjTxbGKvICDm7JzJICP

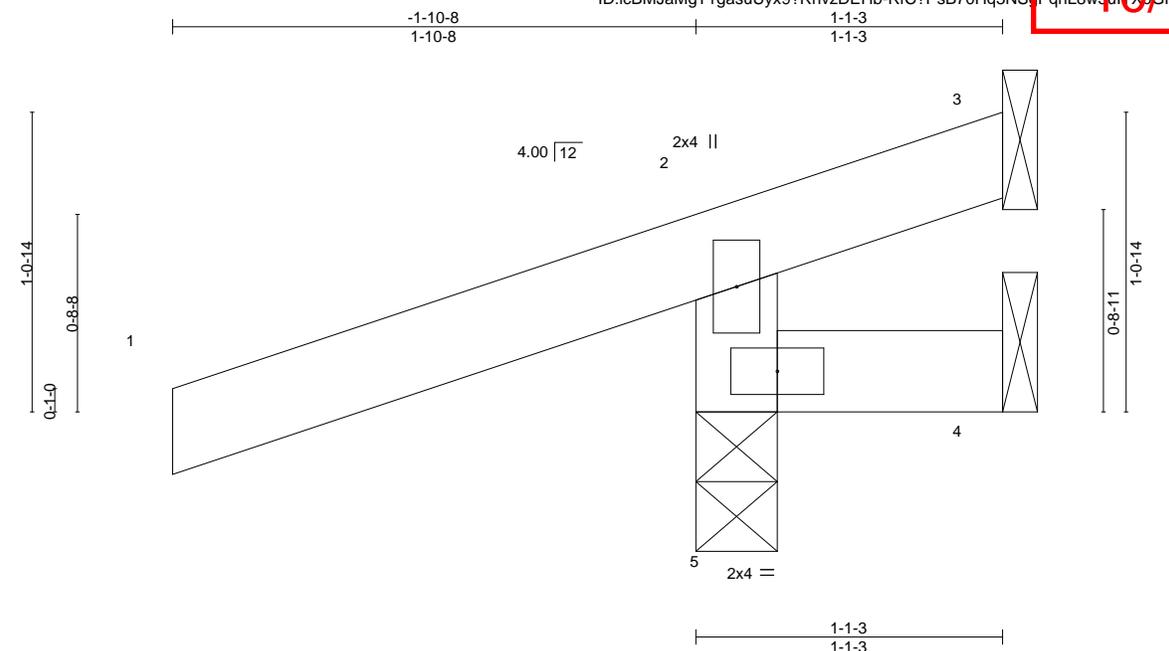

Scale = 1:8.2

LOADING (psf)	SPACING-	CSI.	DEFL.	in (loc)	l/defl	L/d	PLATES	GRIP
TCLL 25.0	2-0-0	TC 0.28	Vert(LL)	0.00	5	>999	MT20	197/144
TCDL 10.0	Plate Grip DOL 1.15	BC 0.08	Vert(CT)	0.00	5	>999		
BCLL 0.0	Lumber DOL 1.15	WB 0.00	Horz(CT)	-0.00	3	n/a		
BCDL 10.0	Rep Stress Incr YES	Matrix-MR					Weight: 5 lb	FT = 20%
	Code IRC2018/TPI2014							

LUMBER-
TOP CHORD 2x4 SPF No.2
BOT CHORD 2x4 SPF No.2
WEBS 2x4 SPF No.2

BRACING-
TOP CHORD Structural wood sheathing directly applied or 1-1-3 oc purlins, except end verticals.
BOT CHORD Rigid ceiling directly applied or 10-0-0 oc bracing.

REACTIONS. (size) 3=Mechanical, 4=Mechanical, 5=0-3-8
Max Horz 5=38(LC 8)
Max Uplift 3=-74(LC 1), 4=-35(LC 1), 5=-152(LC 8)
Max Grav 3=42(LC 8), 4=21(LC 8), 5=336(LC 1)

FORCES. (lb) - Max. Comp./Max. Ten. - All forces 250 (lb) or less except when shown.
TOP CHORD 2-5=-282/213

NOTES-


- 1) Wind: ASCE 7-16; Vult=115mph (3-second gust) Vasd=91mph; TCDL=6.0psf; BCDL=4.2psf; h=15ft; Cat. II; Exp C; Enclosed; MWFRS (envelope) gable end zone and C-C Exterior(2E) zone; cantilever left and right exposed ; end vertical left and right exposed;C-C for members and forces & MWFRS for reactions shown; Lumber DOL=1.60 plate grip DOL=1.60
- 2) This truss has been designed for a 10.0 psf bottom chord live load nonconcurrent with any other live loads.
- 3) Refer to girder(s) for truss to truss connections.
- 4) Bearing at joint(s) 5 considers parallel to grain value using ANSI/TPI 1 angle to grain formula. Building designer should verify capacity of bearing surface.
- 5) Provide mechanical connection (by others) of truss to bearing plate capable of withstanding 74 lb uplift at joint 3, 35 lb uplift at joint 4 and 152 lb uplift at joint 5.
- 6) This truss is designed in accordance with the 2018 International Residential Code sections R502.11.1 and R802.10.2 and referenced standard ANSI/TPI 1.



June 12, 2023

Job 3664536	Truss J17	Truss Type Roof Special Girder	Qty 1	Ply 1	Summit/185 Highland Meadows	AS NOTED FOR PLAN REVIEW DEVELOPMENT SERVICES LEE'S SUMMIT, MISSOURI
----------------	--------------	-----------------------------------	----------	----------	-----------------------------	--

Builders FirstSource (Valley Center), Valley Center, KS - 67147, 8.630 s Nov 19 2022 MiTek Industries, Inc. Thu Jun 21 14:12:31 2023 Page 1
 ID:icBMJaMgT1gasuUyx9?RhvzDEHb-RfC?PsB70Hq3NSuPqnL8w3ulTXbGKVICDm7JzJICP? 10/10/2023

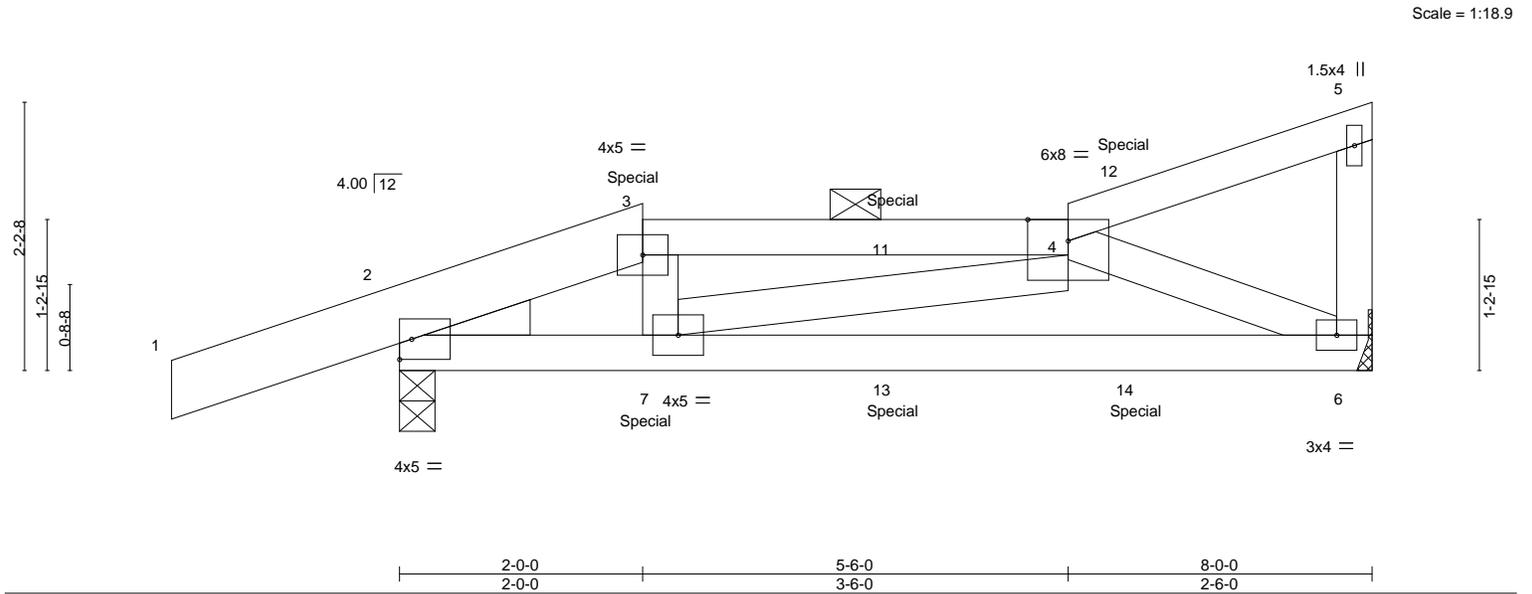

LOADING (psf)	SPACING-	2-0-0	CSI.	DEFL.	in (loc)	l/defl	L/d	PLATES	GRIP
TCLL 25.0	Plate Grip DOL	1.15	TC 0.31	Vert(LL)	-0.04 6-7	>999	240	MT20	197/144
TCDL 10.0	Lumber DOL	1.15	BC 0.39	Vert(CT)	-0.10 6-7	>950	180		
BCLL 0.0	Rep Stress Incr	NO	WB 0.10	Horz(CT)	0.01 6	n/a	n/a		
BCDL 10.0	Code IRC2018/TPI2014		Matrix-MP					Weight: 34 lb	FT = 20%

LUMBER-	BRACING-
TOP CHORD 2x4 SPF No.2 *Except* 1-3: 2x6 SPF No.2	TOP CHORD Structural wood sheathing directly applied or 6-0-0 oc purlins, except end verticals, and 2-0-0 oc purlins (6-0-0 max.): 3-4.
BOT CHORD 2x4 SPF No.2	BOT CHORD Rigid ceiling directly applied or 10-0-0 oc bracing.
WEBS 2x4 SPF No.2	
WEDGE	
Left: 2x4 SP No.3	

REACTIONS. (size) 6=Mechanical, 2=0-3-8
 Max Horz 2=82(LC 7)
 Max Uplift 6=69(LC 8), 2=148(LC 4)
 Max Grav 6=399(LC 1), 2=550(LC 1)

FORCES. (lb) - Max. Comp./Max. Ten. - All forces 250 (lb) or less except when shown.
 TOP CHORD 2-3=-719/68, 3-4=-649/64
 BOT CHORD 2-7=-78/629, 6-7=-126/565
 WEBS 4-6=-614/155, 4-7=0/253

- NOTES-**
- 1) Wind: ASCE 7-16; Vult=115mph (3-second gust) Vasd=91mph; TCDL=6.0psf; BCDL=4.2psf; h=15ft; Cat. II; Exp C; Enclosed; MWFRS (envelope) gable end zone; cantilever left and right exposed ; end vertical left and right exposed; Lumber DOL=1.60 plate grip DOL=1.60
 - 2) Provide adequate drainage to prevent water ponding.
 - 3) This truss has been designed for a 10.0 psf bottom chord live load nonconcurrent with any other live loads.
 - 4) Refer to girder(s) for truss to truss connections.
 - 5) Provide mechanical connection (by others) of truss to bearing plate capable of withstanding 69 lb uplift at joint 6 and 148 lb uplift at joint 2.
 - 6) This truss is designed in accordance with the 2018 International Residential Code sections R502.11.1 and R802.10.2 and referenced standard ANSI/TPI 1.
 - 7) Graphical purlin representation does not depict the size or the orientation of the purlin along the top and/or bottom chord.
 - 8) Hanger(s) or other connection device(s) shall be provided sufficient to support concentrated load(s) 28 lb down and 36 lb up at 2-0-0, and 29 lb down and 37 lb up at 4-0-12, and 29 lb down and 38 lb up at 6-0-12 on top chord, and 65 lb down and 14 lb up at 2-0-0, and 25 lb down at 4-0-12, and 25 lb down at 6-0-12 on bottom chord. The design/selection of such connection device(s) is the responsibility of others.
 - 9) In the LOAD CASE(S) section, loads applied to the face of the truss are noted as front (F) or back (B).

LOAD CASE(S) Standard
 1) Dead + Roof Live (balanced): Lumber Increase=1.15, Plate Increase=1.15
 Uniform Loads (plf)
 Vert: 1-3=-70, 3-4=-70, 4-5=-70, 6-8=-20



June 12, 2023

Continued on page 2

<p>WARNING - Verify design parameters and READ NOTES ON THIS AND INCLUDED MITEK REFERENCE PAGE MII-7473 rev. 1/2/2023 BEFORE USE.</p> <p>Design valid for use only with MiTek® connectors. This design is based only upon parameters shown, and is for an individual building component, not a truss system. Before use, the building designer must verify the applicability of design parameters and properly incorporate this design into the overall building design. Bracing indicated is to prevent buckling of individual truss web and/or chord members only. Additional temporary and permanent bracing is always required for stability and to prevent collapse with possible personal injury and property damage. For general guidance regarding the fabrication, storage, delivery, erection and bracing of trusses and truss systems, see ANSI/TPI1 Quality Criteria, and DSB-22 available from Truss Plate Institute (www.tpinst.org) and BCSI Building Component Safety Information available from the Structural Building Component Association (www.sbcsccomponents.com)</p>	<p>16023 Swingley Ridge Rd. Chesterfield, MO 63017 314.434.1200 / MiTek-US.com</p>
---	--

Job	Truss	Truss Type	Qty	Ply	Summit/185 Highland Meadows	RELEASE FOR CONSTRUCTION
3664536	J17	Roof Special Girder	1	1	Job Reference (optional)	AS NOTED FOR PLAN REVIEW DEVELOPMENT SERVICES LEE'S SUMMIT, MISSOURI

Builders FirstSource (Valley Center), Valley Center, KS - 67147,

8.630 s Nov 19 2022 MiTek Industries, Inc. Thu Jun 21 14:12:31 2023 Page 2

ID:icBMJaMgT1gasuUyx9?RhvzDEHb-RfC?PsB70Hq3NSpPqnL8w3ulTXbGKVICU7J4ZIC?1

10/10/2023

LOAD CASE(S) Standard

Concentrated Loads (lb)

Vert: 3=-13(B) 7=-15(B) 11=-17(B) 12=-17(B) 13=-25(B) 14=-25(B)

WARNING - Verify design parameters and READ NOTES ON THIS AND INCLUDED MITEK REFERENCE PAGE MII-7473 rev. 1/2/2023 BEFORE USE.

Design valid for use only with MiTek® connectors. This design is based only upon parameters shown, and is for an individual building component, not a truss system. Before use, the building designer must verify the applicability of design parameters and properly incorporate this design into the overall building design. Bracing indicated is to prevent buckling of individual truss web and/or chord members only. Additional temporary and permanent bracing is always required for stability and to prevent collapse with possible personal injury and property damage. For general guidance regarding the fabrication, storage, delivery, erection and bracing of trusses and truss systems, see **ANSI/TPI1 Quality Criteria, and DSB-22** available from Truss Plate Institute (www.tpinst.org) and **BCSI Building Component Safety Information** available from the Structural Building Component Association (www.sbcsccomponents.com)

MiTek®

16023 Swingley Ridge Rd.
Chesterfield, MO 63017
314.434.1200 / MiTek-US.com

Job 3664536	Truss J18	Truss Type Half Hip	Qty 1	Ply 1	Summit/185 Highland Meadows Job Reference (optional)	RELEASE FOR CONSTRUCTION AS NOTED FOR PLAN REVIEW DEVELOPMENT SERVICES LEE'S SUMMIT, MISSOURI
----------------	--------------	------------------------	----------	----------	---	--

Builders FirstSource (Valley Center), Valley Center, KS - 67147,

8.630 s Nov 19 2022 MiTek Industries, Inc. Thu Jun 21 14:12:32 2023 Page 1

ID:icBMJaMgT1gasuUyx9?RhvzDEHb-RIC?PsB70Hq3NSuPqnL8w3uITXbGKVICDm7JzUICP

10/10/2023



Scale = 1:18.9

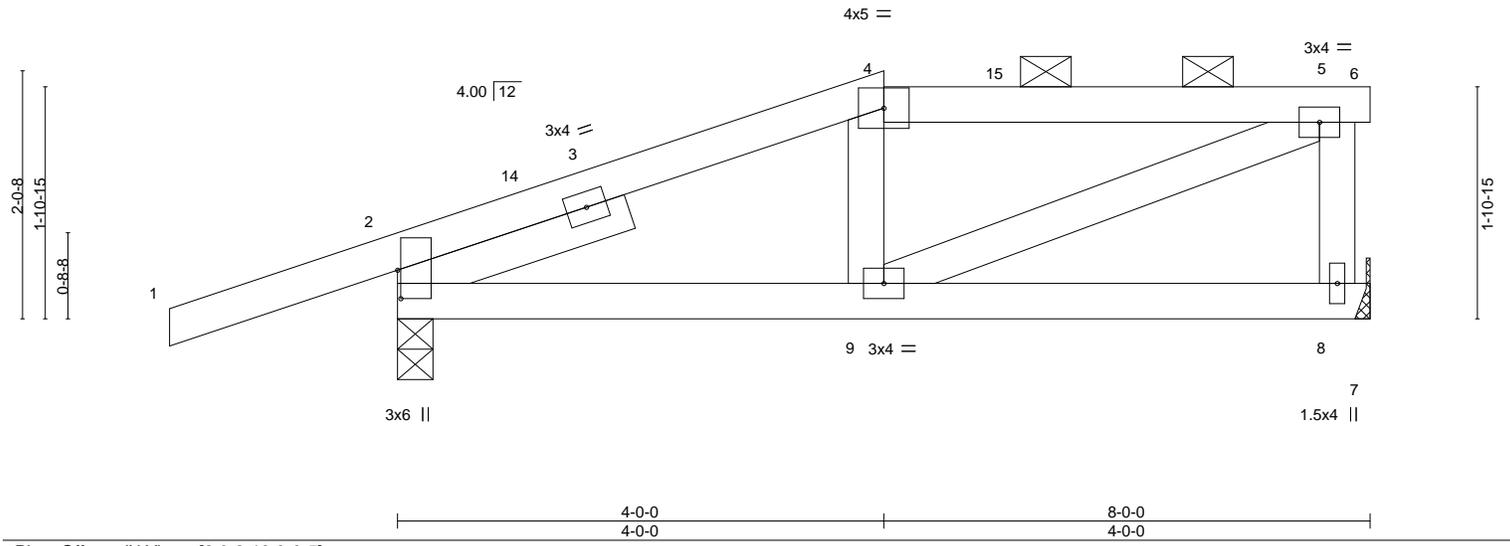


Plate Offsets (X,Y)--	[2:0-2-13,0-0-5]
-----------------------	------------------

LOADING (psf)	SPACING-	2-0-0	CSI.	DEFL.	in (loc)	l/defl	L/d	PLATES	GRIP
TCLL 25.0	Plate Grip DOL	1.15	TC 0.27	Vert(LL)	-0.01	8-9	>999	MT20	197/144
TCDL 10.0	Lumber DOL	1.15	BC 0.13	Vert(CT)	-0.02	8-9	>999		
BCLL 0.0	Rep Stress Incr	YES	WB 0.10	Horz(CT)	-0.00	2	n/a		
BCDL 10.0	Code IRC2018/TPI2014		Matrix-AS						
								Weight: 31 lb	FT = 20%

LUMBER-	BRACING-
TOP CHORD 2x4 SPF No.2	TOP CHORD Structural wood sheathing directly applied, except
BOT CHORD 2x4 SPF No.2	2-0-0 oc purlins (6-0-0 max.): 4-6.
WEBS 2x4 SPF No.2	BOT CHORD Rigid ceiling directly applied.
SLIDER Left 2x4 SPF No.2 2-0-0	

REACTIONS. (size) 2=0-3-8, 8=Mechanical
 Max Horz 2=75(LC 8)
 Max Uplift 2=-134(LC 8), 8=-59(LC 8)
 Max Grav 2=495(LC 1), 8=343(LC 1)

FORCES. (lb) - Max. Comp./Max. Ten. - All forces 250 (lb) or less except when shown.
 TOP CHORD 2-4=-395/164, 4-5=-387/189
 BOT CHORD 2-9=-179/378
 WEBS 5-8=-303/153, 5-9=-203/418

- NOTES-**
- 1) Unbalanced roof live loads have been considered for this design.
 - 2) Wind: ASCE 7-16; Vult=115mph (3-second gust) Vasd=91mph; TCDL=6.0psf; BCDL=4.2psf; h=15ft; Cat. II; Exp C; Enclosed; MWFRS (envelope) gable end zone and C-C Exterior(2E) -1-10-8 to 1-1-8, Interior(1) 1-1-8 to 4-0-0, Exterior(2E) 4-0-0 to 8-0-0 zone; cantilever left and right exposed ; end vertical left and right exposed;C-C for members and forces & MWFRS for reactions shown; Lumber DOL=1.60 plate grip DOL=1.60
 - 3) Provide adequate drainage to prevent water ponding.
 - 4) This truss has been designed for a 10.0 psf bottom chord live load nonconcurrent with any other live loads.
 - 5) Refer to girder(s) for truss to truss connections.
 - 6) Provide mechanical connection (by others) of truss to bearing plate capable of withstanding 134 lb uplift at joint 2 and 59 lb uplift at joint 8.
 - 7) This truss is designed in accordance with the 2018 International Residential Code sections R502.11.1 and R802.10.2 and referenced standard ANSI/TPI 1.
 - 8) This truss design requires that a minimum of 7/16" structural wood sheathing be applied directly to the top chord and 1/2" gypsum sheetrock be applied directly to the bottom chord.
 - 9) Graphical purlin representation does not depict the size or the orientation of the purlin along the top and/or bottom chord.



June 12, 2023

Job 3664536	Truss J19	Truss Type Half Hip	Qty 1	Ply 1	Summit/185 Highland Meadows	AS NOTED FOR PLAN REVIEW DEVELOPMENT SERVICES LEE'S SUMMIT, MISSOURI
----------------	--------------	------------------------	----------	----------	-----------------------------	--

Builders FirstSource (Valley Center), Valley Center, KS - 67147,

8.630 s Nov 19 2022 MiTek Industries, Inc. Thu Jun 14 12:33:2023 Page 1

ID:icBMJaMgT1gasUyx9?RhvzDEHb-RfC?PsB70Hq3NSyPqnL8w3ulTXbGKVICd7f7JzJICP2

10/10/2023



Scale = 1:18.9

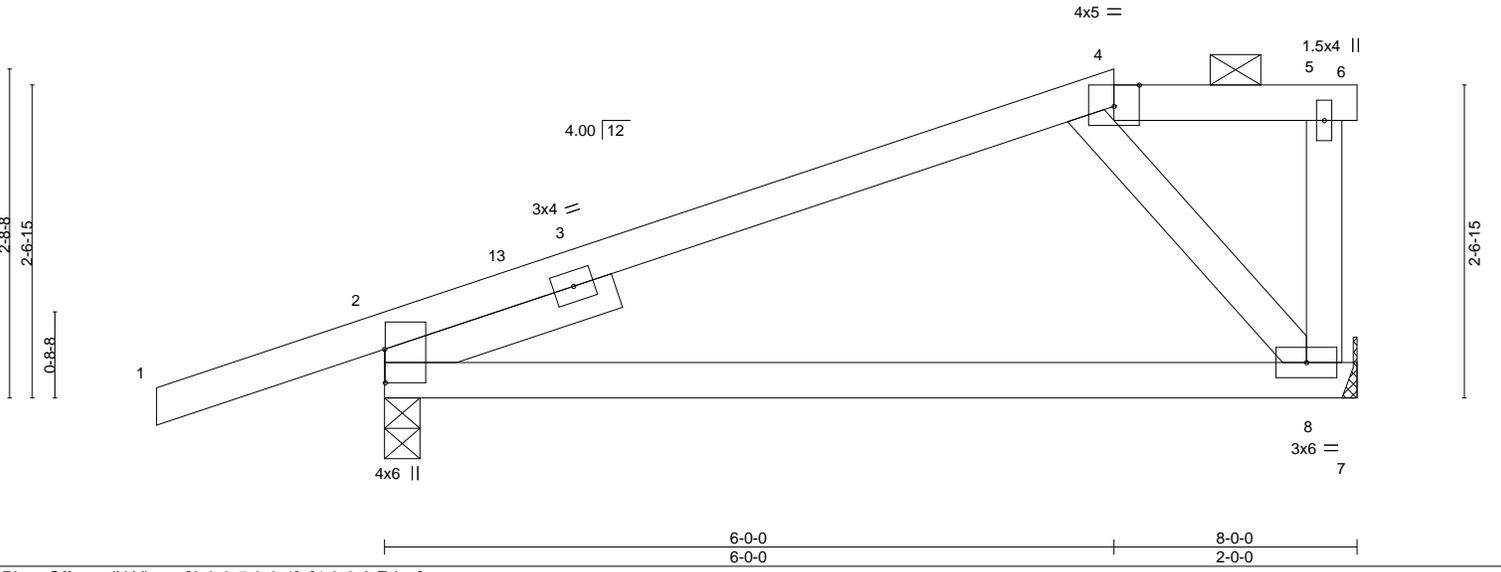


Plate Offsets (X, Y)--	[2:0-3-5,0-0-1], [4:0-2-8,Edge]				
LOADING (psf)	SPACING- 2-0-0	CSI.	DEFL. in (loc) l/defl L/d	PLATES	GRIP
TCLL 25.0	Plate Grip DOL 1.15	TC 0.48	Vert(LL) -0.11 8-11 >828 240	MT20	197/144
TCDL 10.0	Lumber DOL 1.15	BC 0.45	Vert(CT) -0.24 8-11 >379 180		
BCLL 0.0	Rep Stress Incr YES	WB 0.05	Horz(CT) 0.03 2 n/a n/a		
BCDL 10.0	Code IRC2018/TPI2014	Matrix-AS		Weight: 29 lb	FT = 20%

LUMBER-	BRACING-
TOP CHORD 2x4 SPF No.2	TOP CHORD Structural wood sheathing directly applied, except end verticals, and 2-0-0 oc purlins (6-0-0 max.): 4-6.
BOT CHORD 2x4 SPF No.2	BOT CHORD Rigid ceiling directly applied.
WEBS 2x4 SPF No.2	
SLIDER Left 2x4 SPF No.2 2-0-0	

REACTIONS. (size) 2=0-3-8, 8=Mechanical
 Max Horz 2=97(LC 11)
 Max Uplift 2=-134(LC 8), 8=-59(LC 8)
 Max Grav 2=495(LC 1), 8=343(LC 1)

FORCES. (lb) - Max. Comp./Max. Ten. - All forces 250 (lb) or less except when shown.
 TOP CHORD 2-4=-562/82

NOTES-

- 1) Unbalanced roof live loads have been considered for this design.
- 2) Wind: ASCE 7-16; Vult=115mph (3-second gust) Vasd=91mph; TCDL=6.0psf; BCDL=4.2psf; h=15ft; Cat. II; Exp C; Enclosed; MWFRS (envelope) gable end zone and C-C Exterior(2E) -1-10-8 to 1-1-8, Interior(1) 1-1-8 to 6-0-0, Exterior(2E) 6-0-0 to 8-0-0 zone; cantilever left and right exposed; end vertical left and right exposed; C-C for members and forces & MWFRS for reactions shown; Lumber DOL=1.60 plate grip DOL=1.60
- 3) Provide adequate drainage to prevent water ponding.
- 4) This truss has been designed for a 10.0 psf bottom chord live load nonconcurrent with any other live loads.
- 5) Refer to girder(s) for truss to truss connections.
- 6) Provide mechanical connection (by others) of truss to bearing plate capable of withstanding 134 lb uplift at joint 2 and 59 lb uplift at joint 8.
- 7) This truss is designed in accordance with the 2018 International Residential Code sections R502.11.1 and R802.10.2 and referenced standard ANSI/TPI 1.
- 8) This truss design requires that a minimum of 7/16" structural wood sheathing be applied directly to the top chord and 1/2" gypsum sheetrock be applied directly to the bottom chord.
- 9) Graphical purlin representation does not depict the size or the orientation of the purlin along the top and/or bottom chord.



June 12, 2023

Job 3664536	Truss J20	Truss Type Jack-Partial	Qty 6	Ply 1	Summit/185 Highland Meadows Job Reference (optional)	AS NOTED FOR PLAN REVIEW DEVELOPMENT SERVICES LEE'S SUMMIT, MISSOURI
----------------	--------------	----------------------------	----------	----------	---	--


Builders FirstSource (Valley Center), Valley Center, KS - 67147,

8.630 s Nov 19 2022 MiTek Industries, Inc. Thu Jun 21 14:12:35 2023 Page 1

ID:icBMJaMgT1gasuUyx9?RhvzDEHb-RfC?PsB70Hq3NSyPqnL8w3UlTXbGKVICDm7JzUCIP

10/10/2023

Scale = 1:20.9

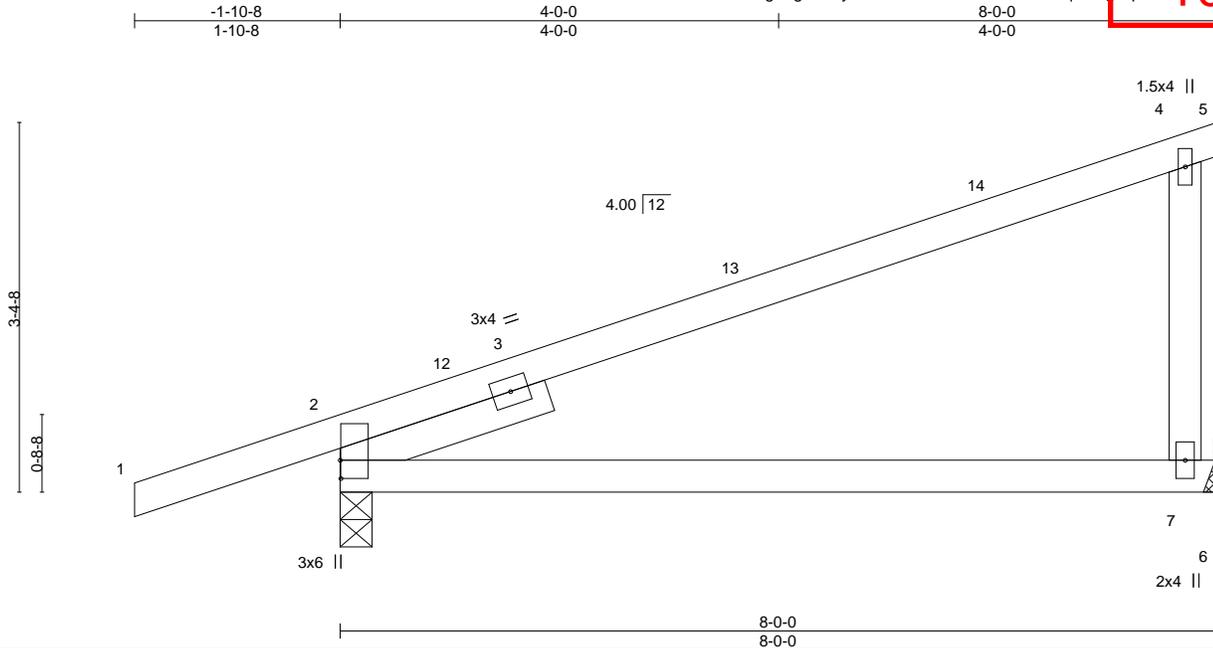

LOADING (psf)		SPACING-		CSI.		DEFL.				PLATES	GRIP	
TCLL	25.0	Plate Grip DOL	1.15	TC	0.77	Vert(LL)	0.14	7-10	>644	240	MT20	197/144
TCDL	10.0	Lumber DOL	1.15	BC	0.52	Vert(CT)	-0.32	7-10	>293	180		
BCLL	0.0	Rep Stress Incr	YES	WB	0.05	Horz(CT)	0.06	2	n/a	n/a		
BCDL	10.0	Code	IRC2018/TPI2014	Matrix-AS							Weight: 26 lb	FT = 20%

LUMBER-
 TOP CHORD 2x4 SPF No.2
 BOT CHORD 2x4 SPF No.2
 WEBS 2x4 SPF No.2
 SLIDER Left 2x4 SPF No.2 2-0-0

BRACING-
 TOP CHORD Structural wood sheathing directly applied.
 BOT CHORD Rigid ceiling directly applied.

REACTIONS. (size) 2=0-3-8, 7=Mechanical
 Max Horz 2=128(LC 8)
 Max Uplift 2=-118(LC 8), 7=-80(LC 8)
 Max Grav 2=494(LC 1), 7=343(LC 1)

FORCES. (lb) - Max. Comp./Max. Ten. - All forces 250 (lb) or less except when shown.
 TOP CHORD 2-4=-445/59

- NOTES-**
- 1) Wind: ASCE 7-16; Vult=115mph (3-second gust) Vasd=91mph; TCDL=6.0psf; BCDL=4.2psf; h=15ft; Cat. II; Exp C; Enclosed; MWFRS (envelope) gable end zone and C-C Exterior(2E) -1-10-8 to 1-1-8, Interior(1) 1-1-8 to 8-0-0 zone; cantilever left and right exposed ; end vertical left and right exposed;C-C for members and forces & MWFRS for reactions shown; Lumber DOL=1.60 plate grip DOL=1.60
 - 2) This truss has been designed for a 10.0 psf bottom chord live load nonconcurrent with any other live loads.
 - 3) Refer to girder(s) for truss to truss connections.
 - 4) Provide mechanical connection (by others) of truss to bearing plate capable of withstanding 118 lb uplift at joint 2 and 80 lb uplift at joint 7.
 - 5) This truss is designed in accordance with the 2018 International Residential Code sections R502.11.1 and R802.10.2 and referenced standard ANSI/TPI 1.
 - 6) This truss design requires that a minimum of 7/16" structural wood sheathing be applied directly to the top chord and 1/2" gypsum sheetrock be applied directly to the bottom chord.



June 12, 2023

WARNING - Verify design parameters and READ NOTES ON THIS AND INCLUDED MITEK REFERENCE PAGE MII-7473 rev. 1/2/2023 BEFORE USE.

Design valid for use only with MiTek® connectors. This design is based only upon parameters shown, and is for an individual building component, not a truss system. Before use, the building designer must verify the applicability of design parameters and properly incorporate this design into the overall building design. Bracing indicated is to prevent buckling of individual truss web and/or chord members only. Additional temporary and permanent bracing is always required for stability and to prevent collapse with possible personal injury and property damage. For general guidance regarding the fabrication, storage, delivery, erection and bracing of trusses and truss systems, see **ANSI/TPI1 Quality Criteria, and DSB-22** available from Truss Plate Institute (www.tpinst.org) and **BCSI Building Component Safety Information** available from the Structural Building Component Association (www.sbcsccomponents.com)

MiTek®

16023 Swingley Ridge Rd.
 Chesterfield, MO 63017
 314.434.1200 / MiTek-US.com

Job 3664536	Truss J21	Truss Type Jack-Partial	Qty 3	Ply 1	Summit/185 Highland Meadows	AS NOTED FOR PLAN REVIEW DEVELOPMENT SERVICES LEE'S SUMMIT, MISSOURI
----------------	--------------	----------------------------	----------	----------	-----------------------------	--

Builders FirstSource (Valley Center), Valley Center, KS - 67147,

8.630 s Nov 19 2022 MiTek Industries, Inc. Thu Jun 27 14:12:36 2023 Page 1

ID:icBMJaMgT1gasuUyx9?RhvzDEHb-RIC?PsB70Hq3NSjPqnL8wGulTXbGKVICDm7JzJICP?

10/10/2023



Scale = 1:21.5

Plate Offsets (X,Y)--	[2:0-2-4,0-0-1]						
LOADING (psf)	SPACING-	2-0-0	CSI.	DEFL.	in (loc)	l/defl	L/d
TCLL 25.0	Plate Grip DOL	1.15	TC 1.00	Vert(LL)	-0.21	10	>446
TCDL 10.0	Lumber DOL	1.15	BC 0.32	Vert(CT)	-0.38	10	>242
BCLL 0.0	Rep Stress Incr	YES	WB 0.09	Horz(CT)	0.21	9	n/a
BCDL 10.0	Code IRC2018/TPI2014		Matrix-AS				
							PLATES
							MT20
							GRIP
							197/144
							Weight: 29 lb
							FT = 20%

LUMBER-	BRACING-
TOP CHORD 2x4 SPF No.2	TOP CHORD Structural wood sheathing directly applied.
BOT CHORD 2x4 SPF No.2	BOT CHORD Rigid ceiling directly applied.
WEBS 2x4 SPF No.2	
SLIDER Left 2x4 SPF No.2 2-0-0	

REACTIONS. (size) 2=0-3-8, 9=Mechanical
 Max Horz 2=128(LC 8)
 Max Uplift 2=-117(LC 8), 9=-79(LC 8)
 Max Grav 2=496(LC 1), 9=343(LC 1)

FORCES. (lb) - Max. Comp./Max. Ten. - All forces 250 (lb) or less except when shown.
 TOP CHORD 4-12=-250/52, 4-5=-458/209
 BOT CHORD 4-9=-310/466
 WEBS 5-9=-594/396

- NOTES-**
- 1) Wind: ASCE 7-16; Vult=115mph (3-second gust) Vasd=91mph; TCDL=6.0psf; BCDL=4.2psf; h=15ft; Cat. II; Exp C; Enclosed; MWFRS (envelope) gable end zone and C-C Exterior(2E) -1-10-8 to 1-1-8, Interior(1) 1-1-8 to 8-0-0 zone; cantilever left and right exposed; end vertical left and right exposed; C-C for members and forces & MWFRS for reactions shown; Lumber DOL=1.60 plate grip DOL=1.60
 - 2) This truss has been designed for a 10.0 psf bottom chord live load nonconcurrent with any other live loads.
 - 3) Refer to girder(s) for truss to truss connections.
 - 4) Provide mechanical connection (by others) of truss to bearing plate capable of withstanding 117 lb uplift at joint 2 and 79 lb uplift at joint 9.
 - 5) This truss is designed in accordance with the 2018 International Residential Code sections R502.11.1 and R802.10.2 and referenced standard ANSI/TPI 1.
 - 6) This truss design requires that a minimum of 7/16" structural wood sheathing be applied directly to the top chord and 1/2" gypsum sheetrock be applied directly to the bottom chord.



June 12, 2023

<p>WARNING - Verify design parameters and READ NOTES ON THIS AND INCLUDED MITEK REFERENCE PAGE MII-7473 rev. 1/2/2023 BEFORE USE.</p> <p>Design valid for use only with MiTek® connectors. This design is based only upon parameters shown, and is for an individual building component, not a truss system. Before use, the building designer must verify the applicability of design parameters and properly incorporate this design into the overall building design. Bracing indicated is to prevent buckling of individual truss web and/or chord members only. Additional temporary and permanent bracing is always required for stability and to prevent collapse with possible personal injury and property damage. For general guidance regarding the fabrication, storage, delivery, erection and bracing of trusses and truss systems, see ANSI/TPI1 Quality Criteria, and DSB-22 available from Truss Plate Institute (www.tpinst.org) and BCSI Building Component Safety Information available from the Structural Building Component Association (www.sbcsccomponents.com)</p>	<p>16023 Swingley Ridge Rd. Chesterfield, MO 63017 314.434.1200 / MiTek-US.com</p>
---	--


Job 3664536	Truss J22	Truss Type Jack-Open	Qty 2	Ply 1	Summit/185 Highland Meadows Job Reference (optional)	AS NOTED FOR PLAN REVIEW DEVELOPMENT SERVICES LEE'S SUMMIT, MISSOURI
----------------	--------------	-------------------------	----------	----------	---	--

Builders FirstSource (Valley Center), Valley Center, KS - 67147,

8.630 s Nov 19 2022 MiTek Industries, Inc. Thu Jun 21 12:37:2023 Page 1

ID:icBMJaMgT1gasuUyx9?RhvzDEHb-RfC?PsB70Hq3NSuPqnL8wGulTXbGKVICd7f7JzJICP?

10/10/2023

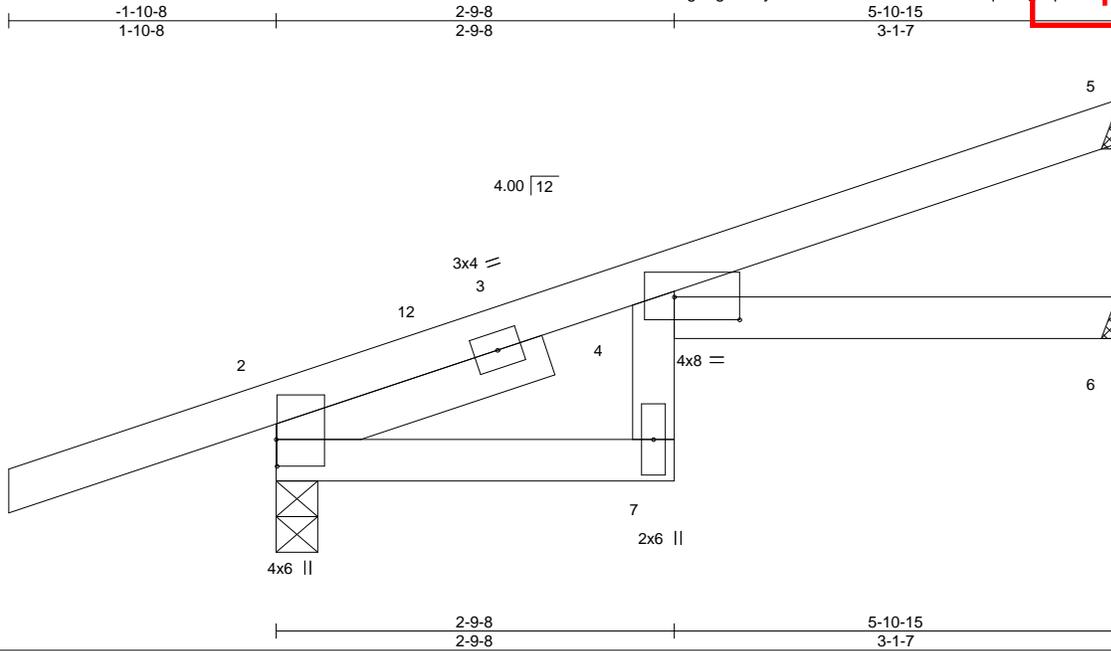

Scale: 3/4"=1'

Plate Offsets (X,Y)--	[2:0-2-4,0-0-1], [4:0-5-8,0-1-15]				
LOADING (psf)	SPACING- 2-0-0	CSI.	DEFL. in (loc) l/defl L/d	PLATES	GRIP
TCLL 25.0	Plate Grip DOL 1.15	TC 0.57	Vert(LL) 0.11 7 >661 240	MT20	197/144
TCDL 10.0	Lumber DOL 1.15	BC 0.39	Vert(CT) -0.15 7 >465 180		
BCLL 0.0	Rep Stress Incr YES	WB 0.00	Horz(CT) 0.09 6 n/a n/a		
BCDL 10.0	Code IRC2018/TPI2014	Matrix-AS		Weight: 20 lb	FT = 20%

LUMBER-	BRACING-
TOP CHORD 2x4 SPF No.2	TOP CHORD Structural wood sheathing directly applied.
BOT CHORD 2x4 SPF No.2	BOT CHORD Rigid ceiling directly applied.
SLIDER Left 2x4 SPF No.2 2-0-0	

REACTIONS. (size) 5=Mechanical, 2=0-3-8, 6=Mechanical
 Max Horz 2=102(LC 8)
 Max Uplift 5=-52(LC 12), 2=-110(LC 8), 6=-6(LC 12)
 Max Grav 5=153(LC 1), 2=416(LC 1), 6=97(LC 3)

FORCES. (lb) - Max. Comp./Max. Ten. - All forces 250 (lb) or less except when shown.

NOTES-

- 1) Wind: ASCE 7-16; Vult=115mph (3-second gust) Vasd=91mph; TCDL=6.0psf; BCDL=4.2psf; h=15ft; Cat. II; Exp C; Enclosed; MWFRS (envelope) gable end zone and C-C Exterior(2E) -1-10-8 to 1-1-8, Interior(1) 1-1-8 to 5-10-3 zone; cantilever left and right exposed; end vertical left and right exposed; C-C for members and forces & MWFRS for reactions shown; Lumber DOL=1.60 plate grip DOL=1.60
- 2) This truss has been designed for a 10.0 psf bottom chord live load nonconcurrent with any other live loads.
- 3) Refer to girder(s) for truss to truss connections.
- 4) Provide mechanical connection (by others) of truss to bearing plate capable of withstanding 52 lb uplift at joint 5, 110 lb uplift at joint 2 and 6 lb uplift at joint 6.
- 5) This truss is designed in accordance with the 2018 International Residential Code sections R502.11.1 and R802.10.2 and referenced standard ANSI/TPI 1.
- 6) This truss design requires that a minimum of 7/16" structural wood sheathing be applied directly to the top chord and 1/2" gypsum sheetrock be applied directly to the bottom chord.



June 12, 2023

<p>WARNING - Verify design parameters and READ NOTES ON THIS AND INCLUDED MITEK REFERENCE PAGE MII-7473 rev. 1/2/2023 BEFORE USE.</p> <p>Design valid for use only with MiTek® connectors. This design is based only upon parameters shown, and is for an individual building component, not a truss system. Before use, the building designer must verify the applicability of design parameters and properly incorporate this design into the overall building design. Bracing indicated is to prevent buckling of individual truss web and/or chord members only. Additional temporary and permanent bracing is always required for stability and to prevent collapse with possible personal injury and property damage. For general guidance regarding the fabrication, storage, delivery, erection and bracing of trusses and truss systems, see ANSI/TPI1 Quality Criteria, and DSB-22 available from Truss Plate Institute (www.tpinst.org) and BCSI Building Component Safety Information available from the Structural Building Component Association (www.sbcsccomponents.com)</p>	<p>16023 Swingley Ridge Rd. Chesterfield, MO 63017 314.434.1200 / MiTek-US.com</p>
---	--

Job 3664536	Truss J23	Truss Type Jack-Open	Qty 2	Ply 1	Summit/185 Highland Meadows
----------------	--------------	-------------------------	----------	----------	-----------------------------

AS NOTED FOR PLAN REVIEW
DEVELOPMENT SERVICES
LEE'S SUMMIT, MISSOURI

Builders FirstSource (Valley Center), Valley Center, KS - 67147, 8.630 s Nov 19 2022 MiTek Industries, Inc. Thu Jun 21 4:12:39 2023 Page 1

10/10/2023

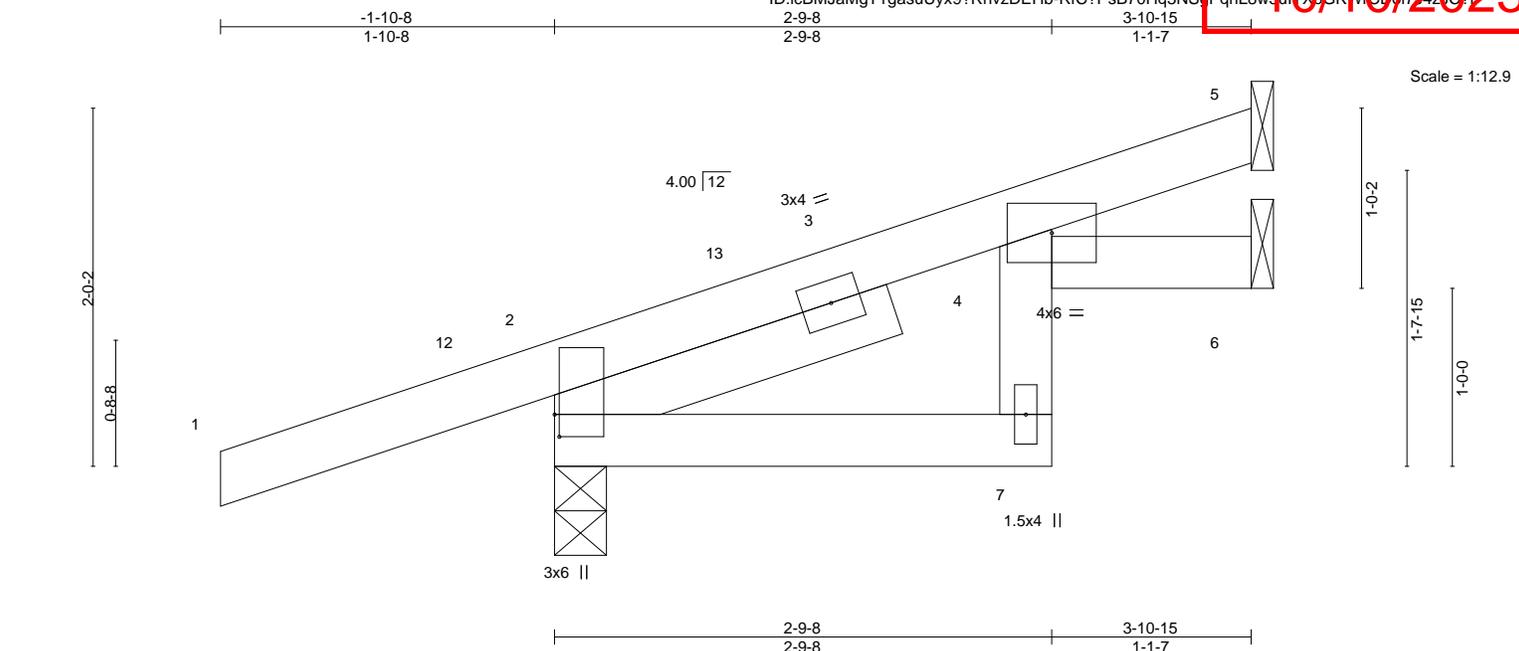


Plate Offsets (X,Y)--	[2:0-1-8,0-0-5]
-----------------------	-----------------

LOADING (psf)	SPACING-	2-0-0	CSI.	DEFL.	in (loc)	l/defl	L/d	PLATES	GRIP
TCLL 25.0	Plate Grip DOL	1.15	TC 0.22	Vert(LL)	0.02	7	>999	MT20	197/144
TCDL 10.0	Lumber DOL	1.15	BC 0.11	Vert(CT)	-0.02	7	>999		
BCLL 0.0	Rep Stress Incr	YES	WB 0.00	Horz(CT)	0.02	6	n/a		
BCDL 10.0	Code	IRC2018/TPI2014	Matrix-MR						
								Weight: 15 lb	FT = 20%

LUMBER-	BRACING-
TOP CHORD 2x4 SPF No.2	TOP CHORD Structural wood sheathing directly applied or 3-10-15 oc purlins.
BOT CHORD 2x4 SPF No.2	BOT CHORD Rigid ceiling directly applied or 6-0-0 oc bracing.
SLIDER Left 2x4 SPF No.2 2-0-0	

REACTIONS. (size) 5=Mechanical, 2=0-3-8, 6=Mechanical
 Max Horz 2=78(LC 8)
 Max Uplift 5=-26(LC 12), 2=-103(LC 8), 6=-9(LC 12)
 Max Grav 5=82(LC 1), 2=337(LC 1), 6=60(LC 1)

FORCES. (lb) - Max. Comp./Max. Ten. - All forces 250 (lb) or less except when shown.

- NOTES-**
- 1) Wind: ASCE 7-16; Vult=115mph (3-second gust) Vasd=91mph; TCDL=6.0psf; BCDL=4.2psf; h=15ft; Cat. II; Exp C; Enclosed; MWFRS (envelope) gable end zone and C-C Exterior(2E) -1-10-8 to 1-1-8, Interior(1) 1-1-8 to 3-10-3 zone; cantilever left and right exposed; end vertical left and right exposed; C-C for members and forces & MWFRS for reactions shown; Lumber DOL=1.60 plate grip DOL=1.60
 - 2) This truss has been designed for a 10.0 psf bottom chord live load nonconcurrent with any other live loads.
 - 3) Refer to girder(s) for truss to truss connections.
 - 4) Provide mechanical connection (by others) of truss to bearing plate capable of withstanding 26 lb uplift at joint 5, 103 lb uplift at joint 2 and 9 lb uplift at joint 6.
 - 5) This truss is designed in accordance with the 2018 International Residential Code sections R502.11.1 and R802.10.2 and referenced standard ANSI/TPI 1.



June 12, 2023

Job 3664536	Truss J24	Truss Type Jack-Open	Qty 1	Ply 1	Summit/185 Highland Meadows Job Reference (optional)
----------------	--------------	-------------------------	----------	----------	---


AS NOTED FOR PLAN REVIEW
DEVELOPMENT SERVICES
LEE'S SUMMIT, MISSOURI

Builders FirstSource (Valley Center), Valley Center, KS - 67147,

8.630 s Nov 19 2022 MiTek Industries, Inc. Thu Jun 21 14:12:40 2023 Page 1

ID:icBMJaMgT1gasuUyx9?RhvzDEHb-RfC?PsB70Hq3NSyPqnL8wGulTxbGKVICDm7JzJICP?

10/10/2023

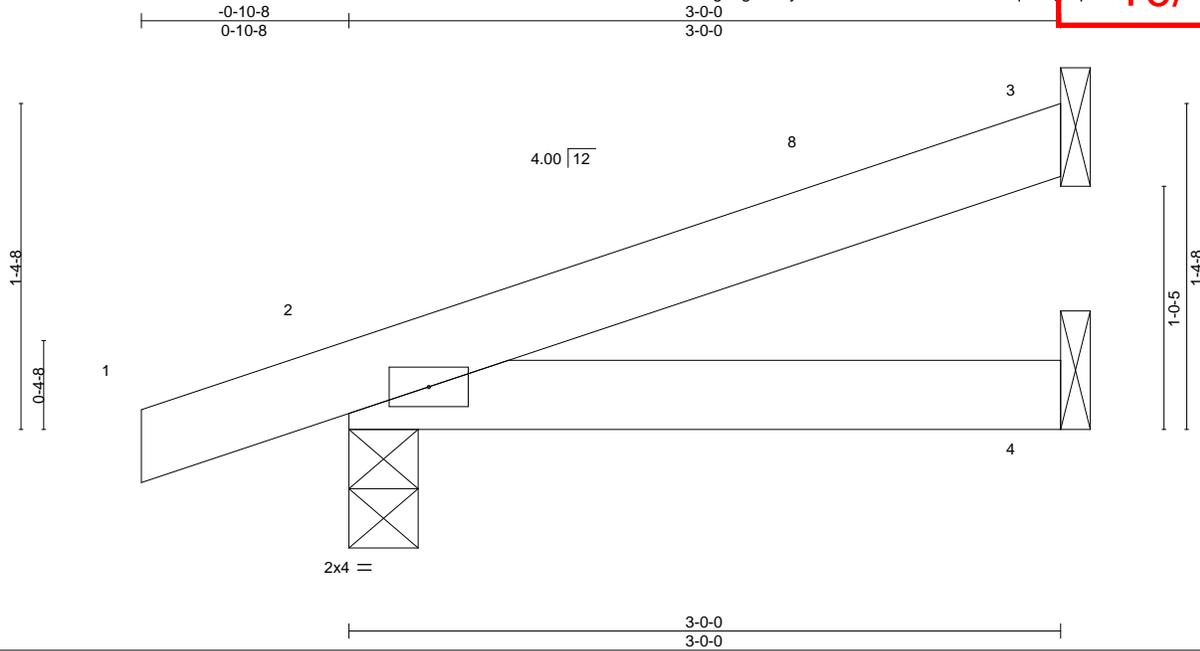

LOADING (psf)	SPACING-	2-0-0	CSI.	DEFL.	in (loc)	l/defl	L/d	PLATES	GRIP
TCLL 25.0	Plate Grip DOL	1.15	TC 0.09	Vert(LL)	-0.00	4-7	>999	MT20	197/144
TCDL 10.0	Lumber DOL	1.15	BC 0.08	Vert(CT)	-0.01	4-7	>999		
BCLL 0.0	Rep Stress Incr	YES	WB 0.00	Horz(CT)	0.00	2	n/a		
BCDL 10.0	Code IRC2018/TPI2014		Matrix-MP					Weight: 8 lb	FT = 20%

LUMBER-
TOP CHORD 2x4 SPF No.2
BOT CHORD 2x4 SPF No.2

BRACING-
TOP CHORD Structural wood sheathing directly applied or 3-0-0 oc purlins.
BOT CHORD Rigid ceiling directly applied or 10-0-0 oc bracing.

REACTIONS. (size) 3=Mechanical, 2=0-3-8, 4=Mechanical
Max Horz 2=50(LC 8)
Max Uplift 3=-30(LC 12), 2=-54(LC 8)
Max Grav 3=83(LC 1), 2=203(LC 1), 4=52(LC 3)

FORCES. (lb) - Max. Comp./Max. Ten. - All forces 250 (lb) or less except when shown.

NOTES-

- 1) Wind: ASCE 7-16; Vult=115mph (3-second gust) Vasd=91mph; TCDL=6.0psf; BCDL=4.2psf; h=15ft; Cat. II; Exp C; Enclosed; MWFRS (envelope) gable end zone and C-C Exterior(2E) -0-10-8 to 2-1-8, Interior(1) 2-1-8 to 2-11-4 zone; cantilever left and right exposed; end vertical left and right exposed; C-C for members and forces & MWFRS for reactions shown; Lumber DOL=1.60 plate grip DOL=1.60
- 2) This truss has been designed for a 10.0 psf bottom chord live load nonconcurrent with any other live loads.
- 3) Refer to girder(s) for truss to truss connections.
- 4) Provide mechanical connection (by others) of truss to bearing plate capable of withstanding 30 lb uplift at joint 3 and 54 lb uplift at joint 2.
- 5) This truss is designed in accordance with the 2018 International Residential Code sections R502.11.1 and R802.10.2 and referenced standard ANSI/TPI 1.



June 12, 2023

WARNING - Verify design parameters and READ NOTES ON THIS AND INCLUDED MITEK REFERENCE PAGE MII-7473 rev. 1/2/2023 BEFORE USE.

Design valid for use only with MiTek® connectors. This design is based only upon parameters shown, and is for an individual building component, not a truss system. Before use, the building designer must verify the applicability of design parameters and properly incorporate this design into the overall building design. Bracing indicated is to prevent buckling of individual truss web and/or chord members only. Additional temporary and permanent bracing is always required for stability and to prevent collapse with possible personal injury and property damage. For general guidance regarding the fabrication, storage, delivery, erection and bracing of trusses and truss systems, see **ANSI/TPI1 Quality Criteria, and DSB-22** available from Truss Plate Institute (www.tpinst.org) and **BCSI Building Component Safety Information** available from the Structural Building Component Association (www.sbcsccomponents.com)

MiTek®

16023 Swingley Ridge Rd.
Chesterfield, MO 63017
314.434.1200 / MiTek-US.com


Job	Truss	Truss Type	Qty	Ply	Summit/185 Highland Meadows
3664536	J25	Jack-Open	2	1	Job Reference (optional)

RELEASE FOR CONSTRUCTION
AS NOTED FOR PLAN REVIEW
DEVELOPMENT SERVICES
LEE'S SUMMIT, MISSOURI
10/10/2023

Builders FirstSource (Valley Center), Valley Center, KS - 67147,

8.630 s Nov 19 2022 MiTek Industries, Inc. Thu Jun 21 14:12:40 2023 Page 1

ID:icBMJaMgT1gasuUyx9?RhvzDEHb-RfC?PsB70Hq3NSuPqnL8wGulTxbGKvICDm7JzICP?

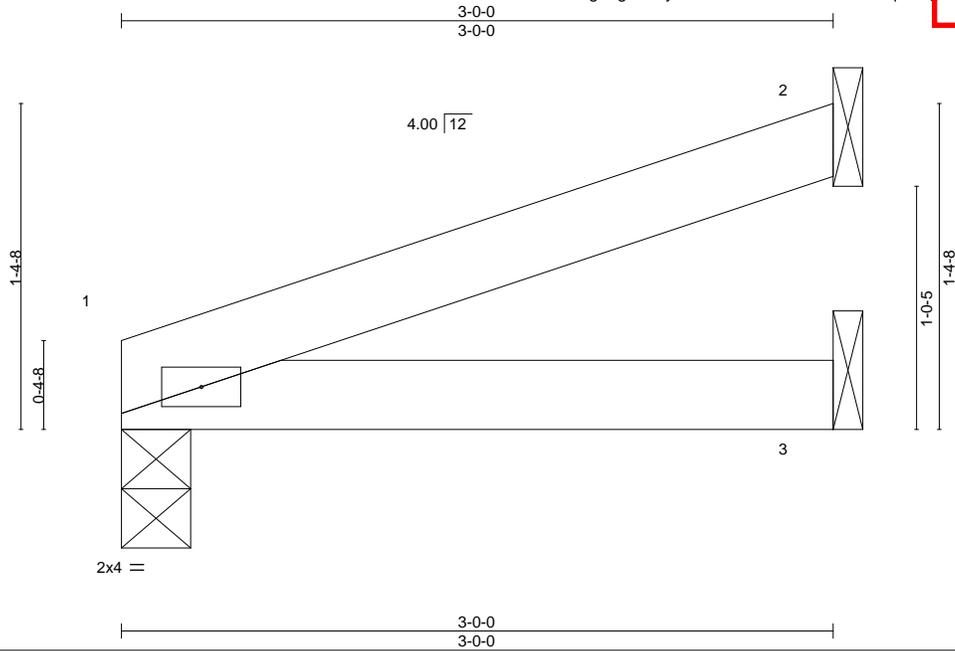

Scale = 1:9.7

LOADING (psf)	SPACING-	CSI.	DEFL.	in (loc)	l/defl	L/d	PLATES	GRIP
TCLL 25.0	2-0-0	TC 0.10	Vert(LL)	0.01	3-6	>999	MT20	197/144
TCDL 10.0	Plate Grip DOL 1.15	BC 0.10	Vert(CT)	-0.01	3-6	>999		
BCLL 0.0	Lumber DOL 1.15	WB 0.00	Horz(CT)	0.00	1	n/a		
BCDL 10.0	Rep Stress Incr YES	Matrix-MP					Weight: 7 lb	FT = 20%
	Code IRC2018/TPI2014							

LUMBER-
TOP CHORD 2x4 SPF No.2
BOT CHORD 2x4 SPF No.2

BRACING-
TOP CHORD Structural wood sheathing directly applied or 3-0-0 oc purlins.
BOT CHORD Rigid ceiling directly applied or 10-0-0 oc bracing.

REACTIONS. (size) 1=0-3-8, 2=Mechanical, 3=Mechanical
Max Horz 1=36(LC 8)
Max Uplift 1=-17(LC 8), 2=-31(LC 8)
Max Grav 1=132(LC 1), 2=87(LC 1), 3=53(LC 3)

FORCES. (lb) - Max. Comp./Max. Ten. - All forces 250 (lb) or less except when shown.

NOTES-

- 1) Wind: ASCE 7-16; Vult=115mph (3-second gust) Vasd=91mph; TCDL=6.0psf; BCDL=4.2psf; h=15ft; Cat. II; Exp C; Enclosed; MWFRS (envelope) gable end zone and C-C Exterior(2E) zone; cantilever left and right exposed; end vertical left and right exposed; C-C for members and forces & MWFRS for reactions shown; Lumber DOL=1.60 plate grip DOL=1.60
- 2) This truss has been designed for a 10.0 psf bottom chord live load nonconcurrent with any other live loads.
- 3) Refer to girder(s) for truss to truss connections.
- 4) Provide mechanical connection (by others) of truss to bearing plate capable of withstanding 17 lb uplift at joint 1 and 31 lb uplift at joint 2.
- 5) This truss is designed in accordance with the 2018 International Residential Code sections R502.11.1 and R802.10.2 and referenced standard ANSI/TPI 1.



June 12, 2023

WARNING - Verify design parameters and READ NOTES ON THIS AND INCLUDED MITEK REFERENCE PAGE MII-7473 rev. 1/2/2023 BEFORE USE.

Design valid for use only with MiTek® connectors. This design is based only upon parameters shown, and is for an individual building component, not a truss system. Before use, the building designer must verify the applicability of design parameters and properly incorporate this design into the overall building design. Bracing indicated is to prevent buckling of individual truss web and/or chord members only. Additional temporary and permanent bracing is always required for stability and to prevent collapse with possible personal injury and property damage. For general guidance regarding the fabrication, storage, delivery, erection and bracing of trusses and truss systems, see **ANSI/TPI1 Quality Criteria, and DSB-22** available from Truss Plate Institute (www.tpinst.org) and **BCSI Building Component Safety Information** available from the Structural Building Component Association (www.sbcsccomponents.com)

MiTek®

16023 Swingley Ridge Rd.
Chesterfield, MO 63017
314.434.1200 / MiTek-US.com

Job 3664536	Truss J26	Truss Type Jack-Open	Qty 3	Ply 1	Summit/185 Highland Meadows Job Reference (optional)	AS NOTED FOR PLAN REVIEW DEVELOPMENT SERVICES LEE'S SUMMIT, MISSOURI
----------------	--------------	-------------------------	----------	----------	---	--

Builders FirstSource (Valley Center), Valley Center, KS - 67147,

8.630 s Nov 19 2022 MiTek Industries, Inc. Thu Jun 21 14:12:41 2023 Page 1

ID:icBMJaMgT1gasuUyx9?RhvzDEHb-RfC?PsB70Hq3NSpPqnL8w3ulTXbGKVICDm7JZUC?10/10/2023

-1-10-8
1-10-8

4-9-0
4-9-0

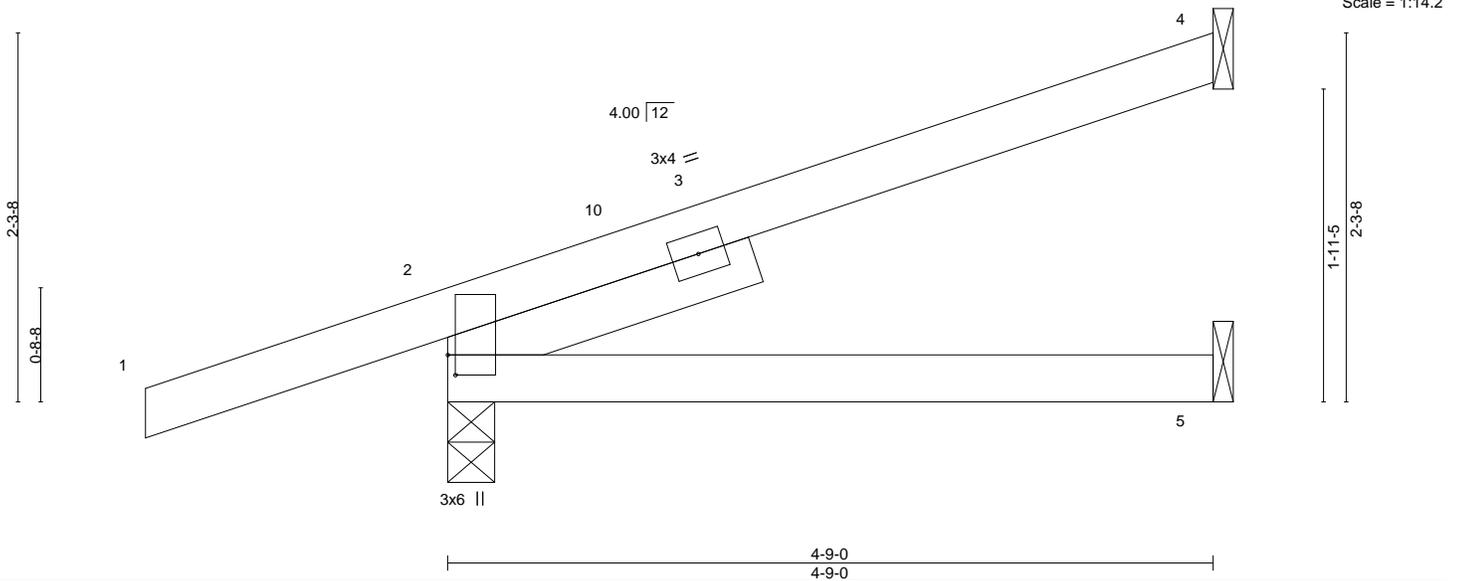


Plate Offsets (X,Y)--	[2:0-1-8,0-0-9]								
LOADING (psf)	SPACING-	2-0-0	CSI.	DEFL.	in (loc)	l/defl	L/d	PLATES	GRIP
TCLL 25.0	Plate Grip DOL	1.15	TC 0.24	Vert(LL)	0.03 5-8	>999	240	MT20	197/144
TCDL 10.0	Lumber DOL	1.15	BC 0.17	Vert(CT)	-0.04 5-8	>999	180		
BCLL 0.0	Rep Stress Incr	YES	WB 0.00	Horz(CT)	0.01 4	n/a	n/a		
BCDL 10.0	Code	IRC2018/TPI2014	Matrix-AS					Weight: 16 lb	FT = 20%

LUMBER-		BRACING-	
TOP CHORD	2x4 SPF No.2	TOP CHORD	Structural wood sheathing directly applied.
BOT CHORD	2x4 SPF No.2	BOT CHORD	Rigid ceiling directly applied.
SLIDER	Left 2x4 SPF No.2 2-0-0		

REACTIONS. (size) 4=Mechanical, 2=0-3-8, 5=Mechanical
 Max Horz 2=88(LC 8)
 Max Uplift 4=52(LC 12), 2=106(LC 8)
 Max Grav 4=132(LC 1), 2=368(LC 1), 5=80(LC 3)

FORCES. (lb) - Max. Comp./Max. Ten. - All forces 250 (lb) or less except when shown.

- NOTES-**
- 1) Wind: ASCE 7-16; Vult=115mph (3-second gust) Vasd=91mph; TCDL=6.0psf; BCDL=4.2psf; h=15ft; Cat. II; Exp C; Enclosed; MWFRS (envelope) gable end zone and C-C Exterior(2E) -1-10-8 to 1-1-8, Interior(1) 1-1-8 to 4-8-4 zone; cantilever left and right exposed; end vertical left and right exposed; C-C for members and forces & MWFRS for reactions shown; Lumber DOL=1.60 plate grip DOL=1.60
 - 2) This truss has been designed for a 10.0 psf bottom chord live load nonconcurrent with any other live loads.
 - 3) Refer to girder(s) for truss to truss connections.
 - 4) Provide mechanical connection (by others) of truss to bearing plate capable of withstanding 52 lb uplift at joint 4 and 106 lb uplift at joint 2.
 - 5) This truss is designed in accordance with the 2018 International Residential Code sections R502.11.1 and R802.10.2 and referenced standard ANSI/TPI 1.
 - 6) This truss design requires that a minimum of 7/16" structural wood sheathing be applied directly to the top chord and 1/2" gypsum sheetrock be applied directly to the bottom chord.



June 12, 2023

Job 3664536	Truss J27	Truss Type Jack-Open	Qty 4	Ply 1	Summit/185 Highland Meadows Job Reference (optional)
----------------	--------------	-------------------------	----------	----------	---


AS NOTED FOR PLAN REVIEW
DEVELOPMENT SERVICES
LEE'S SUMMIT, MISSOURI

Builders FirstSource (Valley Center), Valley Center, KS - 67147,

8.630 s Nov 19 2022 MiTek Industries, Inc. Thu Jun 21 14:12:42 2023 Page 1

ID:icBMJaMgT1gasuUyx9?RhvhzDEHb-RfC?PsB70Hq3NSpPqnL8wGulTXbGKVICd7f7JzICP

10/10/2023

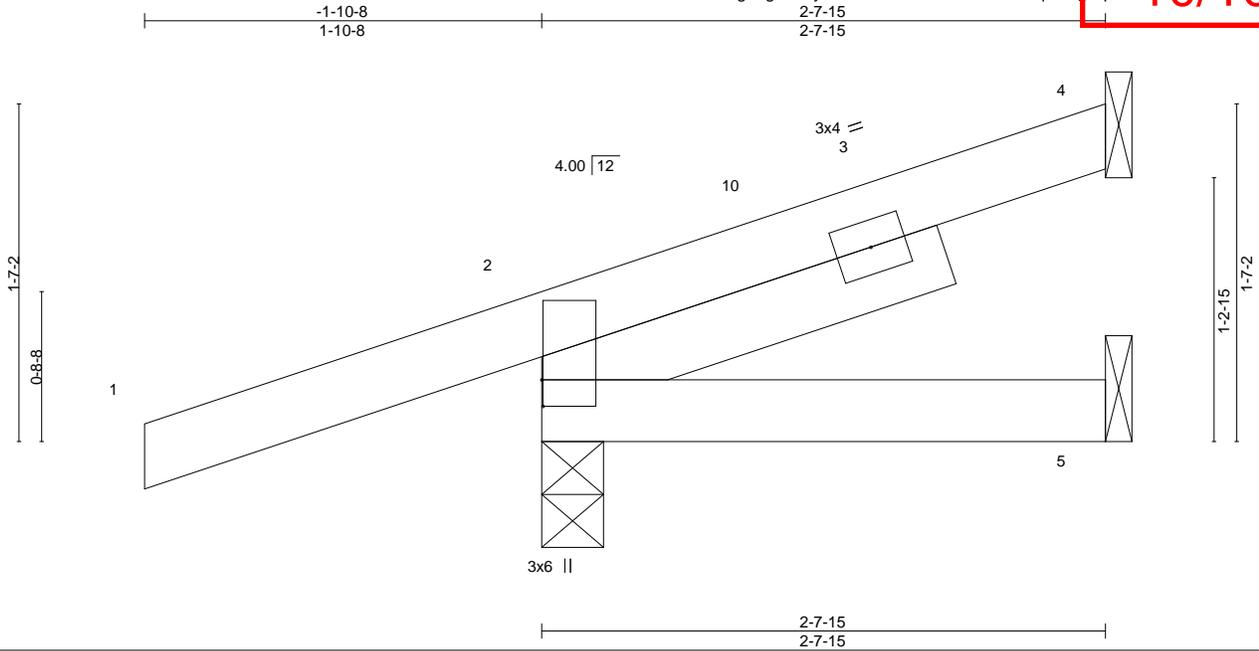

Scale = 1:10.8

Plate Offsets (X,Y)--	[2:0-1-8,0-0-1]						
LOADING (psf)	SPACING-	2-0-0	CSI.	DEFL.	in (loc)	l/defl	L/d
TCLL 25.0	Plate Grip DOL	1.15	TC 0.24	Vert(LL)	-0.00	8	>999
TCDL 10.0	Lumber DOL	1.15	BC 0.03	Vert(CT)	-0.00	5-8	>999
BCLL 0.0	Rep Stress Incr	YES	WB 0.00	Horz(CT)	0.00	2	n/a
BCDL 10.0	Code	IRC2018/TPI2014	Matrix-MP				
							PLATES
							MT20
							GRIP
							197/144
							Weight: 11 lb
							FT = 20%

LUMBER-		BRACING-	
TOP CHORD	2x4 SPF No.2	TOP CHORD	Structural wood sheathing directly applied or 2-7-15 oc purlins.
BOT CHORD	2x4 SPF No.2	BOT CHORD	Rigid ceiling directly applied or 10-0-0 oc bracing.
SLIDER	Left 2x4 SPF No.2 2-0-0		

REACTIONS. (size) 4=Mechanical, 2=0-3-8, 5=Mechanical
 Max Horz 2=62(LC 8)
 Max Uplift 4=-24(LC 12), 2=-104(LC 8)
 Max Grav 4=52(LC 1), 2=296(LC 1), 5=38(LC 3)

FORCES. (lb) - Max. Comp./Max. Ten. - All forces 250 (lb) or less except when shown.

- NOTES-**
- 1) Wind: ASCE 7-16; Vult=115mph (3-second gust) Vasd=91mph; TCDL=6.0psf; BCDL=4.2psf; h=15ft; Cat. II; Exp C; Enclosed; MWFRS (envelope) gable end zone and C-C Exterior(2E) -1-10-8 to 1-1-8, Interior(1) 1-1-8 to 2-7-3 zone; cantilever left and right exposed; end vertical left and right exposed; C-C for members and forces & MWFRS for reactions shown; Lumber DOL=1.60 plate grip DOL=1.60
 - 2) This truss has been designed for a 10.0 psf bottom chord live load nonconcurrent with any other live loads.
 - 3) Refer to girder(s) for truss to truss connections.
 - 4) Provide mechanical connection (by others) of truss to bearing plate capable of withstanding 24 lb uplift at joint 4 and 104 lb uplift at joint 2.
 - 5) This truss is designed in accordance with the 2018 International Residential Code sections R502.11.1 and R802.10.2 and referenced standard ANSI/TPI 1.




June 12, 2023

Job 3664536	Truss J28	Truss Type MONO TRUSS	Qty 6	Ply 1	Summit/185 Highland Meadows
----------------	--------------	--------------------------	----------	----------	-----------------------------


AS NOTED FOR PLAN REVIEW
DEVELOPMENT SERVICES
LEE'S SUMMIT, MISSOURI

Builders FirstSource (Valley Center), Valley Center, KS - 67147, 8.630 s Nov 19 2022 MiTek Industries, Inc. Thu Jun 21 14:12:43 2023 Page 1

10/10/2023

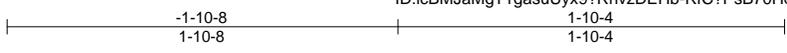

Scale = 1:11.0

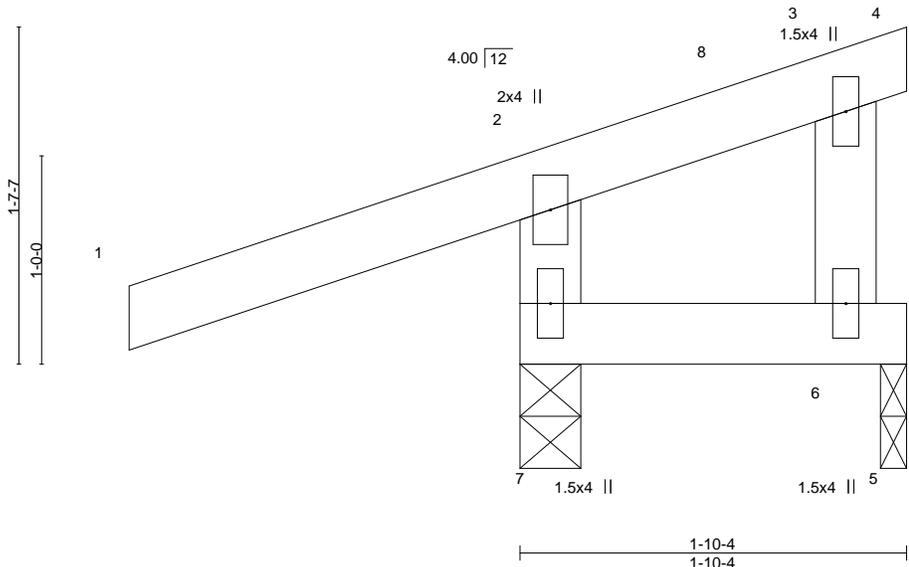

LOADING (psf)	SPACING-	CSI.	DEFL.	PLATES	GRIP
TCLL 25.0	2-0-0	TC 0.28	in (loc) l/defl L/d	MT20	197/144
TCDL 10.0	Plate Grip DOL 1.15	BC 0.05	Vert(LL) 0.00 6 >999 240		
BCLL 0.0	Lumber DOL 1.15	WB 0.01	Vert(CT) 0.00 7 >999 180		
BCDL 10.0	Rep Stress Incr YES	Matrix-MS	Horz(CT) 0.00 n/a n/a		
	Code IRC2018/TPI2014			Weight: 8 lb	FT = 20%

LUMBER-	BRACING-
TOP CHORD 2x4 SPF No.2	TOP CHORD Structural wood sheathing directly applied or 1-10-4 oc purlins, except end verticals.
BOT CHORD 2x4 SPF No.2	BOT CHORD Rigid ceiling directly applied or 10-0-0 oc bracing.
WEBS 2x4 SPF No.2	

REACTIONS. (size) 7=0-3-8, 5=0-1-8
 Max Horz 7=41(LC 11)
 Max Uplift 7=-115(LC 8), 5=-21(LC 1)
 Max Grav 7=301(LC 1), 5=27(LC 3)

FORCES. (lb) - Max. Comp./Max. Ten. - All forces 250 (lb) or less except when shown.
 TOP CHORD 2-7=-273/197

NOTES-

- 1) Wind: ASCE 7-16; Vult=115mph (3-second gust) Vasd=91mph; TCDL=6.0psf; BCDL=4.2psf; h=15ft; Cat. II; Exp C; Enclosed; MWFRS (envelope) gable end zone and C-C Exterior(2E) -1-10-8 to 1-1-8, Interior(1) 1-1-8 to 1-10-4 zone; cantilever left and right exposed; end vertical left and right exposed; C-C for members and forces & MWFRS for reactions shown; Lumber DOL=1.60 plate grip DOL=1.60
- 2) This truss has been designed for a 10.0 psf bottom chord live load nonconcurrent with any other live loads.
- 3) Provide mechanical connection (by others) of truss to bearing plate at joint(s) 4.
- 4) Provide mechanical connection (by others) of truss to bearing plate capable of withstanding 115 lb uplift at joint 7 and 21 lb uplift at joint 5.
- 5) This truss is designed in accordance with the 2018 International Residential Code sections R502.11.1 and R802.10.2 and referenced standard ANSI/TPI 1.



June 12, 2023

Job 3664536	Truss J29	Truss Type Jack-Open	Qty 4	Ply 1	Summit/185 Highland Meadows Job Reference (optional)
----------------	--------------	-------------------------	----------	----------	---

AS NOTED FOR PLAN REVIEW
DEVELOPMENT SERVICES
LEE'S SUMMIT, MISSOURI


Builders FirstSource (Valley Center),

Valley Center, KS - 67147,

8.630 s Nov 19 2022 MiTek Industries, Inc. Thu Jun 21 14:12:44 2023 Page 1

ID:icBMJaMgT1gasuUyx9?RhvzDEHb-RfC?PsB70Hq3NSuPqnL8w3ulTxbGKVICDm7JzICP

10/10/2023

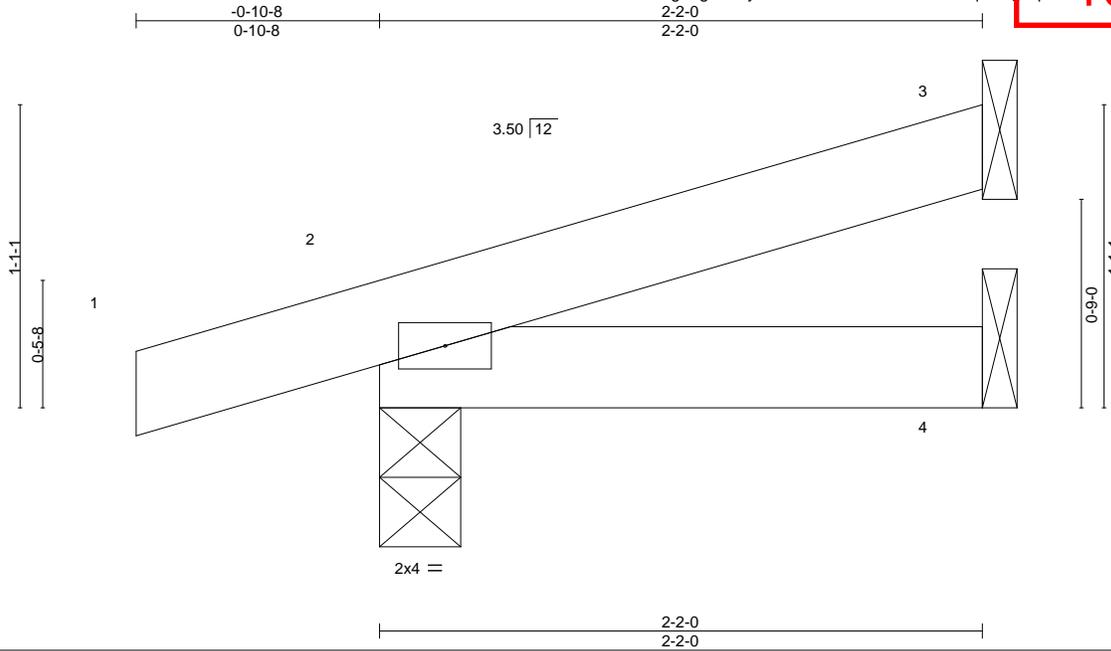

LOADING (psf)	SPACING-	2-0-0	CSI.	DEFL.	in (loc)	l/defl	L/d	PLATES	GRIP
TCLL 25.0	Plate Grip DOL	1.15	TC 0.05	Vert(LL)	-0.00	7	>999	MT20	197/144
TCDL 10.0	Lumber DOL	1.15	BC 0.03	Vert(CT)	-0.00	7	>999		
BCLL 0.0	Rep Stress Incr	YES	WB 0.00	Horz(CT)	0.00	3	n/a		
BCDL 10.0	Code	IRC2018/TPI2014	Matrix-MP					Weight: 6 lb	FT = 20%

LUMBER-
TOP CHORD 2x4 SPF No.2
BOT CHORD 2x4 SPF No.2

BRACING-
TOP CHORD Structural wood sheathing directly applied or 2-2-0 oc purlins.
BOT CHORD Rigid ceiling directly applied or 10-0-0 oc bracing.

REACTIONS. (size) 3=Mechanical, 2=0-3-8, 4=Mechanical
Max Horz 2=35(LC 8)
Max Uplift 3=-21(LC 12), 2=-51(LC 8)
Max Grav 3=57(LC 1), 2=169(LC 1), 4=36(LC 3)

FORCES. (lb) - Max. Comp./Max. Ten. - All forces 250 (lb) or less except when shown.

NOTES-

- 1) Wind: ASCE 7-16; Vult=115mph (3-second gust) Vasd=91mph; TCDL=6.0psf; BCDL=4.2psf; h=15ft; Cat. II; Exp C; Enclosed; MWFRS (envelope) gable end zone and C-C Exterior(2E) zone; cantilever left and right exposed; end vertical left and right exposed; C-C for members and forces & MWFRS for reactions shown; Lumber DOL=1.60 plate grip DOL=1.60
- 2) This truss has been designed for a 10.0 psf bottom chord live load nonconcurrent with any other live loads.
- 3) Refer to girder(s) for truss to truss connections.
- 4) Provide mechanical connection (by others) of truss to bearing plate capable of withstanding 21 lb uplift at joint 3 and 51 lb uplift at joint 2.
- 5) This truss is designed in accordance with the 2018 International Residential Code sections R502.11.1 and R802.10.2 and referenced standard ANSI/TPI 1.



June 12, 2023

WARNING - Verify design parameters and READ NOTES ON THIS AND INCLUDED MITEK REFERENCE PAGE MII-7473 rev. 1/2/2023 BEFORE USE.

Design valid for use only with MiTek® connectors. This design is based only upon parameters shown, and is for an individual building component, not a truss system. Before use, the building designer must verify the applicability of design parameters and properly incorporate this design into the overall building design. Bracing indicated is to prevent buckling of individual truss web and/or chord members only. Additional temporary and permanent bracing is always required for stability and to prevent collapse with possible personal injury and property damage. For general guidance regarding the fabrication, storage, delivery, erection and bracing of trusses and truss systems, see **ANSI/TPI1 Quality Criteria, and DSB-22** available from Truss Plate Institute (www.tpinst.org) and **BCSI Building Component Safety Information** available from the Structural Building Component Association (www.sbcsccomponents.com)

MiTek®

16023 Swingley Ridge Rd.
Chesterfield, MO 63017
314.434.1200 / MiTek-US.com

Job 3664536	Truss L1	Truss Type Monopitch	Qty 6	Ply 1	Summit/185 Highland Meadows
----------------	-------------	-------------------------	----------	----------	-----------------------------


RELEASE FOR CONSTRUCTION
AS NOTED FOR PLAN REVIEW
DEVELOPMENT SERVICES
LEE'S SUMMIT, MISSOURI
10/10/2023

Builders FirstSource (Valley Center),

Valley Center, KS - 67147,

8.630 s Nov 19 2022 MiTek Industries, Inc. Thu Jun 21 14:12:52 2023 Page 1

ID:icBMJaMgT1gasuUyx9?RhvzDEHb-RfC?PsB70Hq3NSyPqnL8wgulTxbGKVICDm7JzICP?

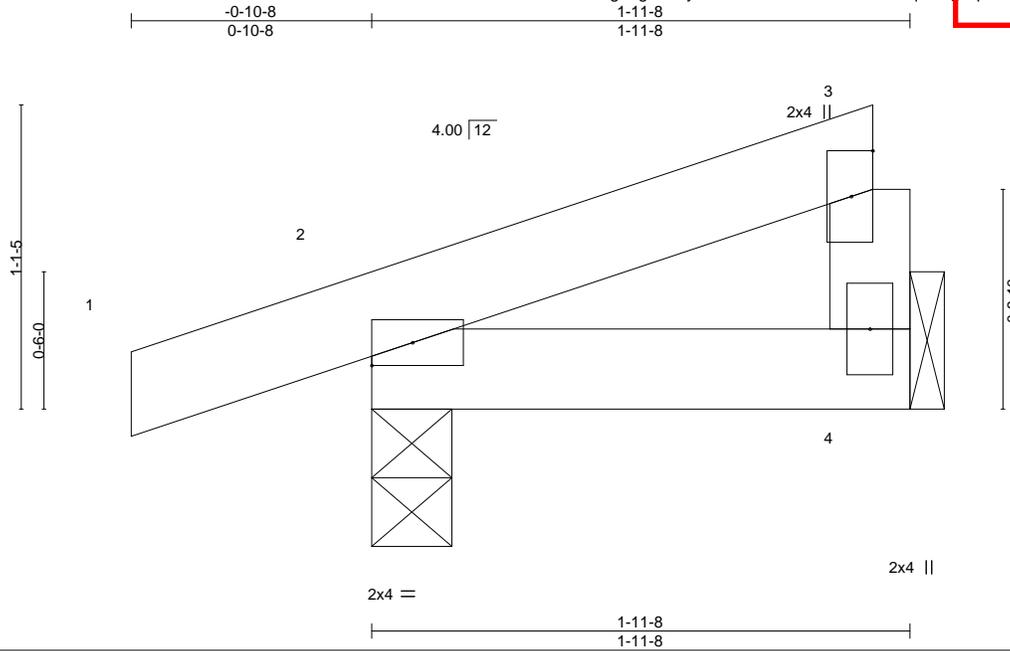

Scale = 1:8.3

LOADING (psf)	SPACING-	2-0-0	CSI.	DEFL. in (loc)	l/defl	L/d	PLATES	GRIP
TCLL 25.0	Plate Grip DOL	1.15	TC 0.05	Vert(LL) -0.00	7 >999	240	MT20	197/144
TCDL 10.0	Lumber DOL	1.15	BC 0.02	Vert(CT) -0.00	7 >999	180		
BCLL 0.0	Rep Stress Incr	YES	WB 0.00	Horz(CT) 0.00	2 n/a	n/a		
BCDL 10.0	Code IRC2018/TPI2014		Matrix-MP				Weight: 6 lb	FT = 20%

LUMBER-
TOP CHORD 2x4 SPF No.2
BOT CHORD 2x4 SPF No.2
WEBS 2x4 SPF No.2

BRACING-
TOP CHORD Structural wood sheathing directly applied or 1-11-8 oc purlins, except end verticals.
BOT CHORD Rigid ceiling directly applied or 10-0-0 oc bracing.

REACTIONS. (size) 4=Mechanical, 2=0-3-8
Max Horz 2=35(LC 11)
Max Uplift 4=14(LC 12), 2=-52(LC 8)
Max Grav 4=67(LC 1), 2=158(LC 1)

FORCES. (lb) - Max. Comp./Max. Ten. - All forces 250 (lb) or less except when shown.

- NOTES-**
- 1) Wind: ASCE 7-16; Vult=115mph (3-second gust) Vasd=91mph; TCDL=6.0psf; BCDL=4.2psf; h=15ft; Cat. II; Exp C; Enclosed; MWFRS (envelope) gable end zone and C-C Exterior(2E) zone; cantilever left and right exposed ; end vertical left and right exposed;C-C for members and forces & MWFRS for reactions shown; Lumber DOL=1.60 plate grip DOL=1.60
 - 2) This truss has been designed for a 10.0 psf bottom chord live load nonconcurrent with any other live loads.
 - 3) Refer to girder(s) for truss to truss connections.
 - 4) Provide mechanical connection (by others) of truss to bearing plate capable of withstanding 14 lb uplift at joint 4 and 52 lb uplift at joint 2.
 - 5) This truss is designed in accordance with the 2018 International Residential Code sections R502.11.1 and R802.10.2 and referenced standard ANSI/TPI 1.



June 12, 2023

Job 3664536	Truss LG1	Truss Type GABLE	Qty 1	Ply 1	Summit/185 Highland Meadows Job Reference (optional)	AS NOTED FOR PLAN REVIEW DEVELOPMENT SERVICES LEE'S SUMMIT, MISSOURI
----------------	--------------	---------------------	----------	----------	---	--


Builders FirstSource (Valley Center),

Valley Center, KS - 67147,

8.630 s Nov 19 2022 MiTek Industries, Inc. Thu Jun 15 14:12:53 2023 Page 1

ID:icBMJaMgT1gasUyx9?RhvzDEHb-RIC?PsB70Hq3NSyPqnL8wGulTXbGKVICDm7JzJICP

10/10/2023

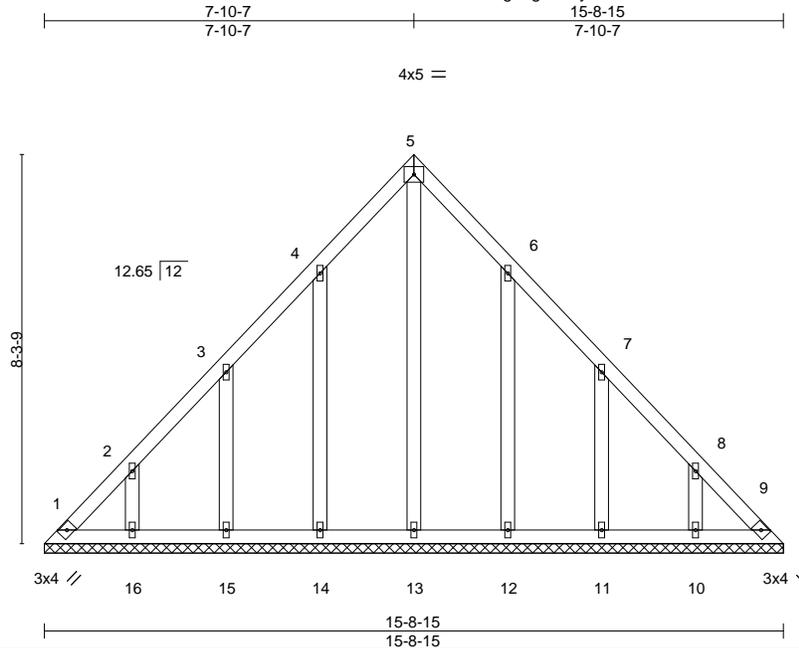

LOADING (psf)	SPACING-	2-0-0	CSI.	DEFL.	in (loc)	l/defl	L/d	PLATES	GRIP	
TCLL 25.0	Plate Grip DOL	1.15	TC 0.06	Vert(LL)	n/a	-	n/a	999	MT20	197/144
TCDL 10.0	Lumber DOL	1.15	BC 0.03	Vert(CT)	n/a	-	n/a	999		
BCLL 0.0	Rep Stress Incr	YES	WB 0.16	Horz(CT)	0.00	9	n/a	n/a		
BCDL 10.0	Code IRC2018/TPI2014		Matrix-S						Weight: 76 lb	FT = 20%

LUMBER-	BRACING-
TOP CHORD 2x4 SPF No.2	TOP CHORD Structural wood sheathing directly applied or 6-0-0 oc purlins.
BOT CHORD 2x4 SPF No.2	BOT CHORD Rigid ceiling directly applied or 10-0-0 oc bracing.
OTHERS 2x4 SPF No.2	

REACTIONS. All bearings 15-8-15.
 (lb) - Max Horz 1=-189(LC 10)
 Max Uplift All uplift 100 lb or less at joint(s) 1, 9 except 14=-116(LC 12), 15=-116(LC 12), 16=-111(LC 12), 12=-115(LC 13), 11=-117(LC 13), 10=-111(LC 13)
 Max Grav All reactions 250 lb or less at joint(s) 1, 9, 13, 14, 15, 16, 12, 11, 10

FORCES. (lb) - Max. Comp./Max. Ten. - All forces 250 (lb) or less except when shown.
 TOP CHORD 1-2=-251/161

NOTES-

- 1) Unbalanced roof live loads have been considered for this design.
- 2) Wind: ASCE 7-16; Vult=115mph (3-second gust) Vasd=91mph; TCDL=6.0psf; BCDL=4.2psf; h=15ft; Cat. II; Exp C; Enclosed; MWFRS (envelope) gable end zone and C-C Exterior(2E) 0-4-1 to 3-4-1, Interior(1) 3-4-1 to 7-10-7, Exterior(2R) 7-10-7 to 10-10-7, Interior(1) 10-10-7 to 15-4-14 zone; cantilever left and right exposed ; end vertical left and right exposed;C-C for members and forces & MWFRS for reactions shown; Lumber DOL=1.60 plate grip DOL=1.60
- 3) All plates are 1.5x4 MT20 unless otherwise indicated.
- 4) Gable requires continuous bottom chord bearing.
- 5) This truss has been designed for a 10.0 psf bottom chord live load nonconcurrent with any other live loads.
- 6) Provide mechanical connection (by others) of truss to bearing plate capable of withstanding 100 lb uplift at joint(s) 1, 9 except (jt=lb) 14=116, 15=116, 16=111, 12=115, 11=117, 10=111.
- 7) This truss is designed in accordance with the 2018 International Residential Code sections R502.11.1 and R802.10.2 and referenced standard ANSI/TPI 1.



June 12, 2023

WARNING - Verify design parameters and READ NOTES ON THIS AND INCLUDED MITEK REFERENCE PAGE MII-7473 rev. 1/2/2023 BEFORE USE.

Design valid for use only with MiTek® connectors. This design is based only upon parameters shown, and is for an individual building component, not a truss system. Before use, the building designer must verify the applicability of design parameters and properly incorporate this design into the overall building design. Bracing indicated is to prevent buckling of individual truss web and/or chord members only. Additional temporary and permanent bracing is always required for stability and to prevent collapse with possible personal injury and property damage. For general guidance regarding the fabrication, storage, delivery, erection and bracing of trusses and truss systems, see **ANSI/TPI1 Quality Criteria, and DSB-22** available from Truss Plate Institute (www.tpinst.org) and **BCSI Building Component Safety Information** available from the Structural Building Component Association (www.sbcsccomponents.com)

MiTek®


16023 Swingley Ridge Rd.
 Chesterfield, MO 63017
 314.434.1200 / MiTek-US.com

Job 3664536	Truss LG2	Truss Type GABLE	Qty 1	Ply 1	Summit/185 Highland Meadows
----------------	--------------	---------------------	----------	----------	-----------------------------

AS NOTED FOR PLAN REVIEW
DEVELOPMENT SERVICES
LEE'S SUMMIT, MISSOURI

Builders FirstSource (Valley Center), Valley Center, KS - 67147, 8.630 s Nov 19 2022 MiTek Industries, Inc. Thu Jun 15 12:54:2023 Page 1

10/10/2023

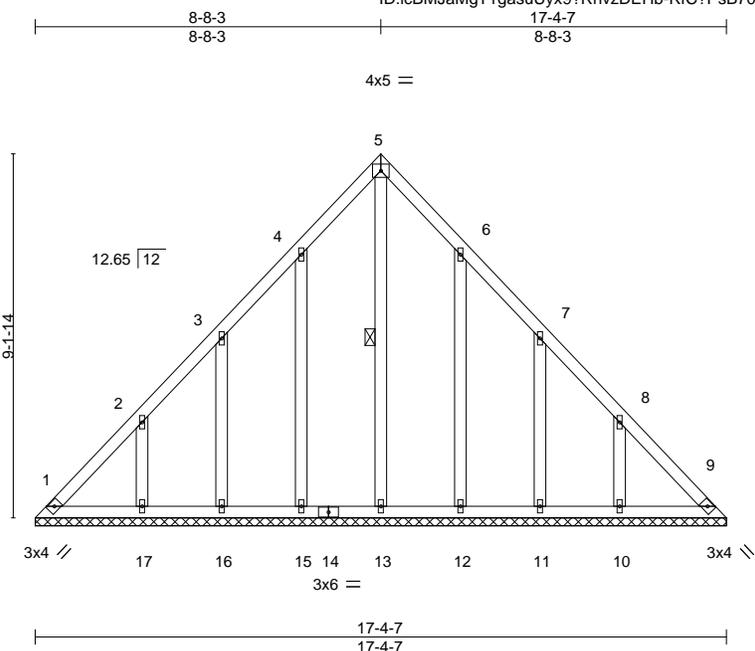

Scale = 1:57.6

LOADING (psf)	SPACING-	2-0-0	CSI.	DEFL.	in (loc)	l/defl	L/d	PLATES	GRIP	
TCLL 25.0	Plate Grip DOL	1.15	TC 0.08	Vert(LL)	n/a	-	n/a	999	MT20	197/144
TCDL 10.0	Lumber DOL	1.15	BC 0.05	Vert(CT)	n/a	-	n/a	999		
BCLL 0.0	Rep Stress Incr	YES	WB 0.13	Horz(CT)	0.01	9	n/a	n/a		
BCDL 10.0	Code IRC2018/TPI2014		Matrix-S						Weight: 87 lb	FT = 20%

LUMBER-	BRACING-
TOP CHORD 2x4 SPF No.2	TOP CHORD Structural wood sheathing directly applied or 6-0-0 oc purlins.
BOT CHORD 2x4 SPF No.2	BOT CHORD Rigid ceiling directly applied or 10-0-0 oc bracing.
OTHERS 2x4 SPF No.2	WEBS 1 Row at midpt 5-13

REACTIONS. All bearings 17-4-7.
 (lb) - Max Horz 1=-209(LC 8)
 Max Uplift All uplift 100 lb or less at joint(s) 1, 9 except 15=-117(LC 12), 16=-107(LC 12), 17=-143(LC 12), 12=-115(LC 13), 11=-108(LC 13), 10=-143(LC 13)
 Max Grav All reactions 250 lb or less at joint(s) 1, 9, 13, 15, 16, 12, 11, 10 except 17=250(LC 19)

FORCES. (lb) - Max. Comp./Max. Ten. - All forces 250 (lb) or less except when shown.
 TOP CHORD 1-2=-264/176

- NOTES-**
- 1) Unbalanced roof live loads have been considered for this design.
 - 2) Wind: ASCE 7-16; Vult=115mph (3-second gust) Vasd=91mph; TCDL=6.0psf; BCDL=4.2psf; h=15ft; Cat. II; Exp C; Enclosed; MWFRS (envelope) gable end zone and C-C Exterior(2E) 0-4-1 to 3-4-1, Interior(1) 3-4-1 to 8-8-3, Exterior(2R) 8-8-3 to 11-8-3, Interior(1) 11-8-3 to 17-0-6 zone; cantilever left and right exposed ; end vertical left and right exposed;C-C for members and forces & MWFRS for reactions shown; Lumber DOL=1.60 plate grip DOL=1.60
 - 3) All plates are 1.5x4 MT20 unless otherwise indicated.
 - 4) Gable requires continuous bottom chord bearing.
 - 5) This truss has been designed for a 10.0 psf bottom chord live load nonconcurrent with any other live loads.
 - 6) Provide mechanical connection (by others) of truss to bearing plate capable of withstanding 100 lb uplift at joint(s) 1, 9 except (jt=lb) 15=117, 16=107, 17=143, 12=115, 11=108, 10=143.
 - 7) This truss is designed in accordance with the 2018 International Residential Code sections R502.11.1 and R802.10.2 and referenced standard ANSI/TPI 1.




June 12, 2023

Job 3664536	Truss LG3	Truss Type GABLE	Qty 2	Ply 1	Summit/185 Highland Meadows Job Reference (optional)	AS NOTED FOR PLAN REVIEW DEVELOPMENT SERVICES LEE'S SUMMIT, MISSOURI
----------------	--------------	---------------------	----------	----------	---	--

Builders FirstSource (Valley Center), Valley Center, KS - 67147, 8.630 s Nov 19 2022 MiTek Industries, Inc. Thu Jun 21 14:12:55 2023 Page 1

ID:icBMJaMgT1gasuUyx9?RhvzDEHb-RfC?PsB70Hq3NSyPqnL8w3ulTxbGKVCd7f7JzJICP? 10/10/2023

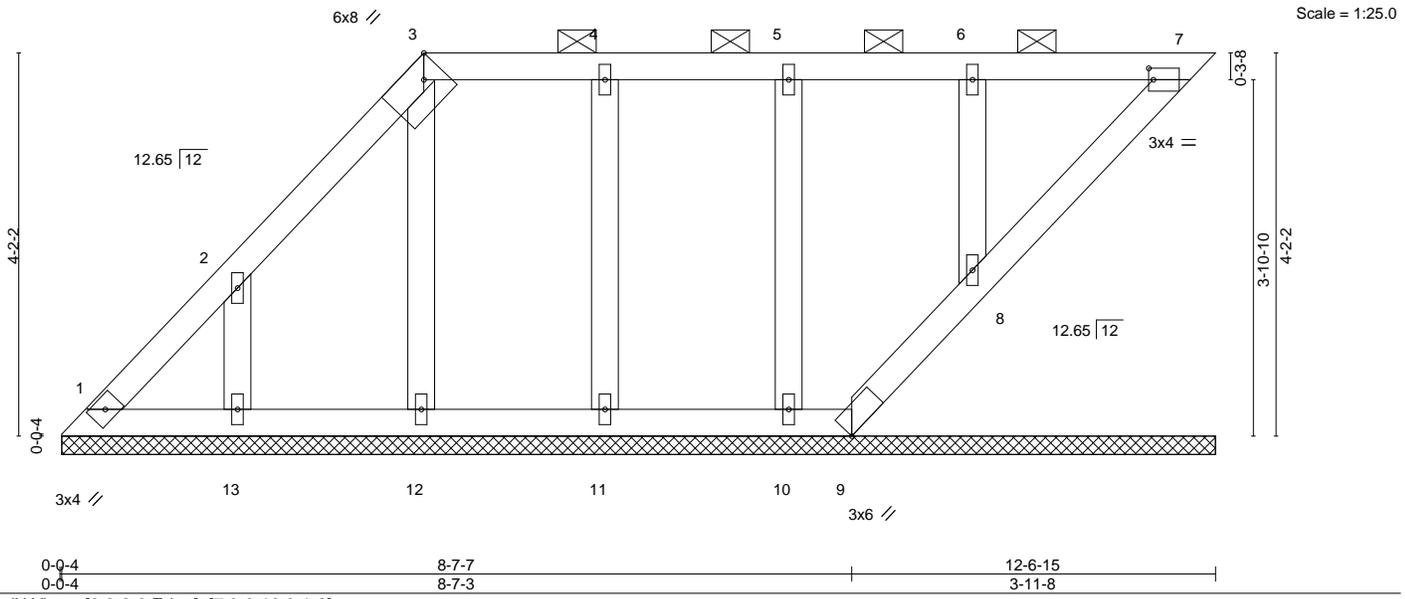

LOADING (psf)	SPACING- 2-0-0	CSI.	DEFL.	PLATES	GRIP
TCLL 25.0	Plate Grip DOL 1.15	TC 0.07	in (loc) l/defl L/d	MT20	197/144
TCDL 10.0	Lumber DOL 1.15	BC 0.04	Vert(LL) n/a - n/a 999		
BCLL 0.0	Rep Stress Incr YES	WB 0.04	Vert(CT) n/a - n/a 999		
BCDL 10.0	Code IRC2018/TPI2014	Matrix-S	Horz(CT) -0.00 7 n/a n/a		
				Weight: 48 lb	FT = 20%

LUMBER-	BRACING-
TOP CHORD 2x4 SPF No.2	TOP CHORD Structural wood sheathing directly applied or 6-0-0 oc purlins, except
BOT CHORD 2x4 SPF No.2	2-0-0 oc purlins (6-0-0 max.): 3-7.
OTHERS 2x4 SPF No.2	BOT CHORD Rigid ceiling directly applied or 10-0-0 oc bracing.

REACTIONS. All bearings 12-6-11.
 (lb) - Max Horz 1=143(LC 12)
 Max Uplift All uplift 100 lb or less at joint(s) 1, 7, 9, 12, 11, 10, 8 except 13=-126(LC 12)
 Max Grav All reactions 250 lb or less at joint(s) 1, 7, 9, 13, 12, 11, 10, 8

FORCES. (lb) - Max. Comp./Max. Ten. - All forces 250 (lb) or less except when shown.

- NOTES-**
- Unbalanced roof live loads have been considered for this design.
 - Wind: ASCE 7-16; Vult=115mph (3-second gust) Vasd=91mph; TCDL=6.0psf; BCDL=4.2psf; h=15ft; Cat. II; Exp C; Enclosed; MWFRS (envelope) gable end zone and C-C Exterior(2E) 0-4-1 to 3-4-1, Interior(1) 3-4-1 to 3-11-8, Exterior(2R) 3-11-8 to 6-11-8, Interior(1) 6-11-8 to 12-3-10 zone; cantilever left and right exposed; end vertical left and right exposed; C-C for members and forces & MWFRS for reactions shown; Lumber DOL=1.60 plate grip DOL=1.60
 - Provide adequate drainage to prevent water ponding.
 - All plates are 1.5x4 MT20 unless otherwise indicated.
 - Gable requires continuous bottom chord bearing.
 - This truss has been designed for a 10.0 psf bottom chord live load nonconcurrent with any other live loads.
 - Provide mechanical connection (by others) of truss to bearing plate capable of withstanding 100 lb uplift at joint(s) 1, 7, 9, 12, 11, 10, 8 except (jt=lb) 13=126.
 - Beveled plate or shim required to provide full bearing surface with truss chord at joint(s) 7, 8.
 - This truss is designed in accordance with the 2018 International Residential Code sections R502.11.1 and R802.10.2 and referenced standard ANSI/TPI 1.
 - Graphical purlin representation does not depict the size or the orientation of the purlin along the top and/or bottom chord.



June 12, 2023

Job 3664536	Truss P1	Truss Type Roof Special	Qty 1	Ply 1	Summit/185 Highland Meadows Job Reference (optional)	AS NOTED FOR PLAN REVIEW DEVELOPMENT SERVICES LEE'S SUMMIT, MISSOURI
----------------	-------------	----------------------------	----------	----------	---	--

Builders FirstSource (Valley Center), Valley Center, KS - 67147, 8.630 s Nov 19 2022 MiTek Industries, Inc. Thu Jun 15 14:12:57 2023 Page 1
 ID:icBMJaMgT1gasuUyx9?RhvzDEHb-RIC?PsB70Hq3NSpPqnL8WgUlTXbGKVICd714ZICP2 PqnL8WgUlTXbGKVICd714ZICP2
 2-3-8 2-3-8 6-6-0 4-2-8 10-8-8 4-2-8 13-0-0 2-3-8 13-10-8 0-10-8

10/10/2023

Scale = 1:22.6

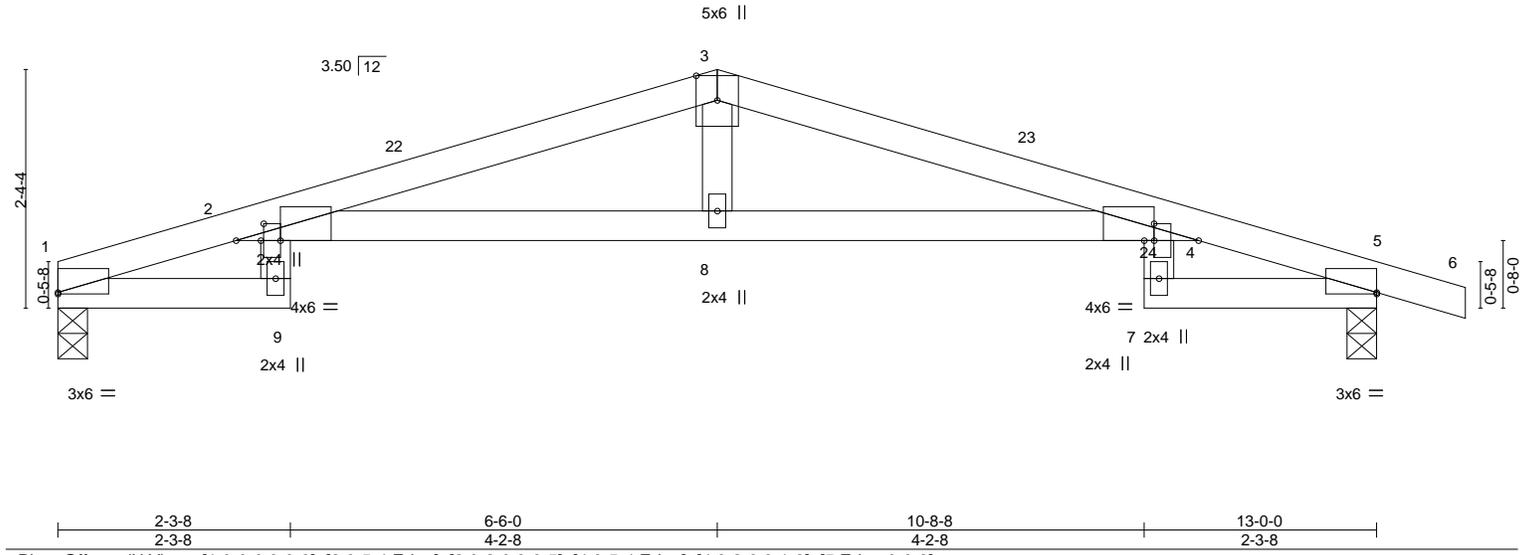


Plate Offsets (X, Y)-- [1:0-0-0,0-0-3], [2:0-5-4,Edge], [2:0-2-0,0-0-5], [4:0-5-4,Edge], [4:0-2-0,0-1-3], [5:Edge,0-0-3]

LOADING (psf)	SPACING-	2-0-0	CSI.	DEFL.	in (loc)	l/defl	L/d	PLATES	GRIP
TCLL 25.0	Plate Grip DOL	1.15	TC 0.85	Vert(LL)	-0.30	9	>515	MT20	197/144
TCDL 10.0	Lumber DOL	1.15	BC 0.95	Vert(CT)	-0.57	9	>273		
BCLL 0.0	Rep Stress Incr	YES	WB 0.10	Horz(CT)	0.27	5	n/a		
BCDL 10.0	Code IRC2018/TPI2014		Matrix-AS					Weight: 40 lb	FT = 20%

LUMBER-
 TOP CHORD 2x4 SP 2400F 2.0E
 BOT CHORD 2x4 SPF No.2 *Except*
 2-4: 2x4 SPF 1650F 1.5E
 WEBS 2x4 SPF No.2

BRACING-
 TOP CHORD Structural wood sheathing directly applied.
 BOT CHORD Rigid ceiling directly applied.

REACTIONS. (size) 1=0-3-8, 5=0-3-8
 Max Horz 1=-38(LC 17)
 Max Uplift 1=-79(LC 8), 5=-112(LC 9)
 Max Grav 1=594(LC 1), 5=659(LC 1)

FORCES. (lb) - Max. Comp./Max. Ten. - All forces 250 (lb) or less except when shown.
 TOP CHORD 2-3=-1784/508, 3-4=-1784/501
 BOT CHORD 2-8=-414/1724, 4-8=-414/1724
 WEBS 3-8=-55/397

- NOTES-**
- 1) Unbalanced roof live loads have been considered for this design.
 - 2) Wind: ASCE 7-16; Vult=115mph (3-second gust) Vasd=91mph; TCDL=6.0psf; BCDL=4.2psf; h=15ft; Cat. II; Exp C; Enclosed; MWFRS (envelope) gable end zone and C-C Exterior(2E) 0-0-0 to 2-9-1, Interior(1) 2-9-1 to 6-6-0, Exterior(2R) 6-6-0 to 9-6-0, Interior(1) 9-6-0 to 13-10-8 zone; cantilever left and right exposed ; end vertical left and right exposed;C-C for members and forces & MWFRS for reactions shown; Lumber DOL=1.60 plate grip DOL=1.60
 - 3) This truss has been designed for a 10.0 psf bottom chord live load nonconcurrent with any other live loads.
 - 4) Provide mechanical connection (by others) of truss to bearing plate capable of withstanding 100 lb uplift at joint(s) 1 except (jt=lb) 5=112.
 - 5) This truss is designed in accordance with the 2018 International Residential Code sections R502.11.1 and R802.10.2 and referenced standard ANSI/TPI 1.
 - 6) This truss design requires that a minimum of 7/16" structural wood sheathing be applied directly to the top chord and 1/2" gypsum sheetrock be applied directly to the bottom chord.



June 12, 2023


Job 3664536	Truss P2	Truss Type ROOF SPECIAL	Qty 2	Ply 1	Summit/185 Highland Meadows	AS NOTED FOR PLAN REVIEW DEVELOPMENT SERVICES LEE'S SUMMIT, MISSOURI
----------------	-------------	----------------------------	----------	----------	-----------------------------	--

Builders FirstSource (Valley Center), Valley Center, KS - 67147,

8.630 s Nov 19 2022 MiTek Industries, Inc. Thu Jun 15 14:58:2023 Page 1



Scale: 1/2"=1'

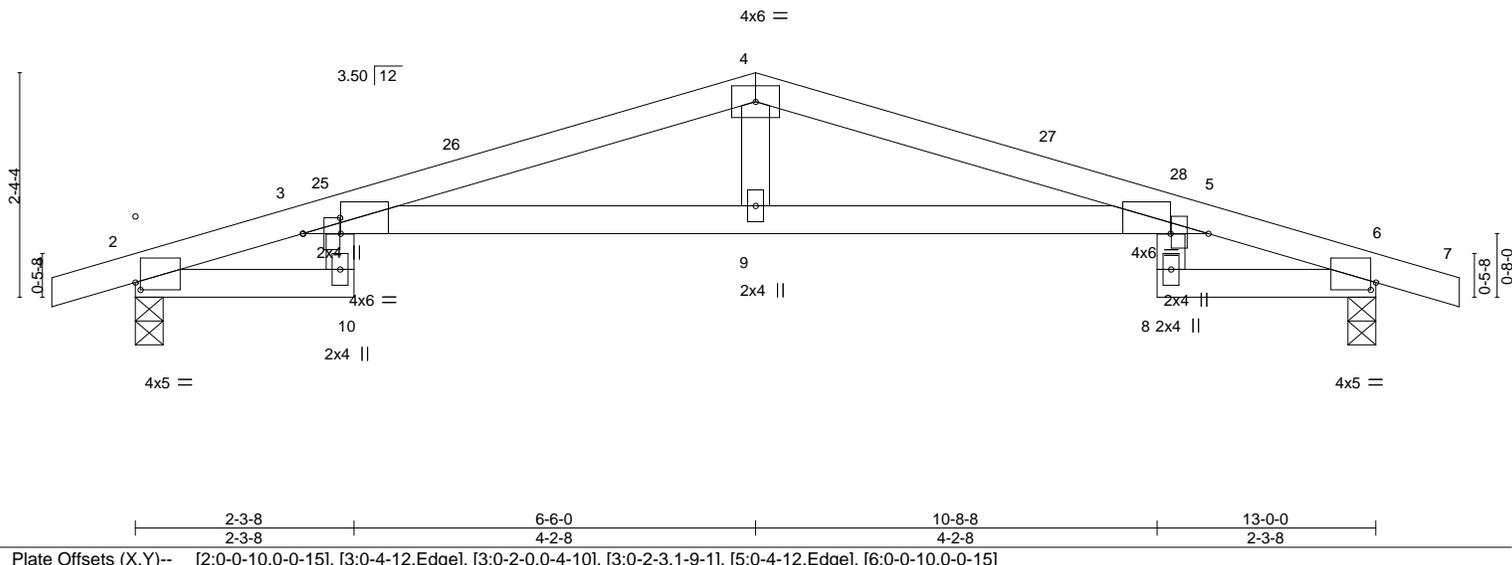

LOADING (psf)	SPACING-	CSI.	DEFL.	PLATES	GRIP
TCLL 25.0	2-0-0	TC 0.84	in (loc) l/defl L/d	MT20	197/144
TCDL 10.0	Plate Grip DOL 1.15	BC 0.74	Vert(LL) -0.28 10 >549 240		
BCLL 0.0	Lumber DOL 1.15	WB 0.12	Vert(CT) -0.54 10 >288 180		
BCDL 10.0	Rep Stress Incr YES	Matrix-MS	Horz(CT) 0.25 6 n/a n/a		
	Code IRC2018/TPI2014			Weight: 45 lb	FT = 20%

LUMBER-	BRACING-
TOP CHORD 2x4 SP 2400F 2.0E	TOP CHORD Structural wood sheathing directly applied or 5-6-0 oc purlins.
BOT CHORD 2x4 SPF No.2 *Except*	BOT CHORD Rigid ceiling directly applied or 10-0-0 oc bracing.
WEBS 2x4 SPF No.2	

REACTIONS. (size) 2=0-3-8, 6=0-3-8
 Max Horz 2=34(LC 12)
 Max Uplift 2=-112(LC 8), 6=-112(LC 9)
 Max Grav 2=657(LC 1), 6=657(LC 1)

FORCES. (lb) - Max. Comp./Max. Ten. - All forces 250 (lb) or less except when shown.
 TOP CHORD 3-4=-1762/488, 4-5=-1762/492
 BOT CHORD 3-9=-402/1691, 5-9=-402/1691
 WEBS 4-9=-74/473

- NOTES-**
- 1) Unbalanced roof live loads have been considered for this design.
 - 2) Wind: ASCE 7-16; Vult=115mph (3-second gust) Vasd=91mph; TCDL=6.0psf; BCDL=4.2psf; h=15ft; Cat. II; Exp C; Enclosed; MWFRS (envelope) gable end zone and C-C Exterior(2E) -0-10-8 to 2-1-8, Interior(1) 2-1-8 to 6-6-0, Exterior(2R) 6-6-0 to 9-6-0, Interior(1) 9-6-0 to 13-10-8 zone; cantilever left and right exposed ; end vertical left and right exposed;C-C for members and forces & MWFRS for reactions shown; Lumber DOL=1.60 plate grip DOL=1.60
 - 3) This truss has been designed for a 10.0 psf bottom chord live load nonconcurrent with any other live loads.
 - 4) Provide mechanical connection (by others) of truss to bearing plate capable of withstanding 100 lb uplift at joint(s) except (jt=lb) 2=112, 6=112.
 - 5) This truss is designed in accordance with the 2018 International Residential Code sections R502.11.1 and R802.10.2 and referenced standard ANSI/TPI 1.



June 12, 2023

WARNING - Verify design parameters and READ NOTES ON THIS AND INCLUDED MITEK REFERENCE PAGE MII-7473 rev. 1/2/2023 BEFORE USE.

Design valid for use only with MiTek® connectors. This design is based only upon parameters shown, and is for an individual building component, not a truss system. Before use, the building designer must verify the applicability of design parameters and properly incorporate this design into the overall building design. Bracing indicated is to prevent buckling of individual truss web and/or chord members only. Additional temporary and permanent bracing is always required for stability and to prevent collapse with possible personal injury and property damage. For general guidance regarding the fabrication, storage, delivery, erection and bracing of trusses and truss systems, see **ANSI/TPI1 Quality Criteria, and DSB-22** available from Truss Plate Institute (www.tpinst.org) and **BCSI Building Component Safety Information** available from the Structural Building Component Association (www.sbcsccomponents.com)

MiTek®
 16023 Swingley Ridge Rd.
 Chesterfield, MO 63017
 314.434.1200 / MiTek-US.com

Job 3664536	Truss P3	Truss Type ROOF SPECIAL GIRDER	Qty 1	Ply 2	Summit/185 Highland Meadows
----------------	-------------	-----------------------------------	----------	----------	-----------------------------


RELEASE FOR CONSTRUCTION

AS NOTED FOR PLAN REVIEW
DEVELOPMENT SERVICES
LEE'S SUMMIT, MISSOURI

10/10/2023

Builders FirstSource (Valley Center), Valley Center, KS - 67147, 8.630 s Nov 19 2022 MiTek Industries, Inc. Thu Jun 21 14:14:00 2023 Page 1 of 1
 ID:icBMJaMgT1gasuUyx9?RhvzDEHb-RfC?PsB70Hq3NSpPqnL8w3ulTXbGKVICd7f7JzJICP? 10-8-8 10-8-8 13-0-0 13-10-8
 0-10-8 2-3-8 6-6-0 10-8-8 13-0-0 13-10-8
 0-10-8 2-3-8 4-2-8 4-2-8 2-3-8 0-10-8

Scale = 1:21.2

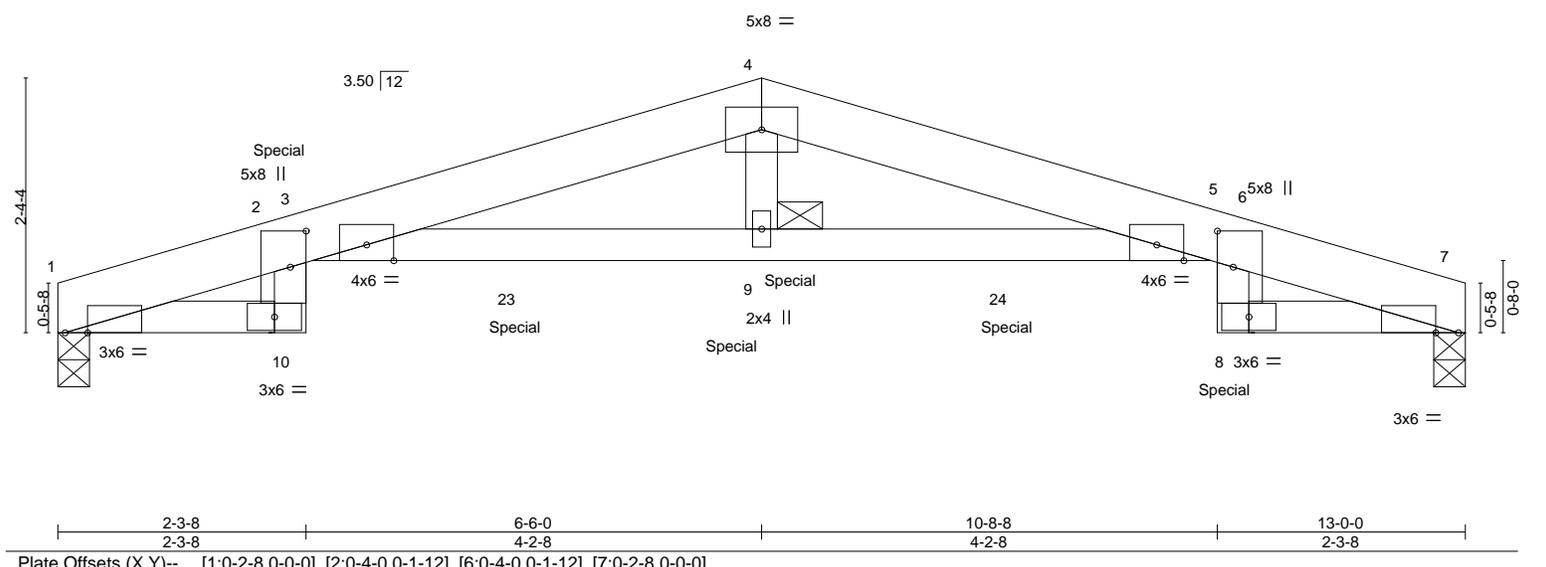

LOADING (psf)	SPACING- 2-0-0	CSI.	DEFL. in (loc) l/defl L/d	PLATES	GRIP
TCLL 25.0	Plate Grip DOL 1.15	TC 0.65	Vert(LL) -0.18 9-22 >844 240	MT20	197/144
TCDL 10.0	Lumber DOL 1.15	BC 0.86	Vert(CT) -0.31 9-22 >494 180		
BCLL 0.0	Rep Stress Incr NO	WB 0.12	Horz(CT) 0.16 7 n/a n/a		
BCDL 10.0	Code IRC2018/TPI2014	Matrix-MS		Weight: 82 lb	FT = 20%

LUMBER-	BRACING-
TOP CHORD 2x6 SPF 2100F 1.8E	TOP CHORD Structural wood sheathing directly applied or 6-0-0 oc purlins.
BOT CHORD 2x4 SPF No.2	BOT CHORD Rigid ceiling directly applied or 10-0-0 oc bracing.
WEBS 2x4 SPF No.2	JOINTS 1 Brace at Jt(s): 9

REACTIONS. (size) 1=0-3-8, 7=0-3-8
 Max Horz 1=30(LC 8)
 Max Uplift 1=-253(LC 4), 7=-252(LC 5)
 Max Grav 1=1233(LC 1), 7=1226(LC 1)

FORCES. (lb) - Max. Comp./Max. Ten. - All forces 250 (lb) or less except when shown.
 TOP CHORD 1-2=-1301/268, 3-4=-4113/844, 4-5=-4112/854, 5-6=-292/83, 6-7=-1306/284
 BOT CHORD 1-10=-193/910, 2-10=-115/549, 3-9=-810/4079, 5-9=-810/4079, 6-8=-60/321, 7-8=-187/918
 WEBS 4-9=-198/966

- NOTES-**
- 2-ply truss to be connected together with 10d (0.131"x3") nails as follows:
 Top chords connected as follows: 2x6 - 2 rows staggered at 0-9-0 oc.
 Bottom chords connected as follows: 2x4 - 1 row at 0-4-0 oc.
 Webs connected as follows: 2x4 - 1 row at 0-9-0 oc.
 - All loads are considered equally applied to all plies, except if noted as front (F) or back (B) face in the LOAD CASE(S) section. Ply to ply connections have been provided to distribute only loads noted as (F) or (B), unless otherwise indicated.
 - Unbalanced roof live loads have been considered for this design.
 - Wind: ASCE 7-16; Vult=115mph (3-second gust) Vasd=91mph; TCDL=6.0psf; BCDL=4.2psf; h=15ft; Cat. II; Exp C; Enclosed; MWFRS (envelope) gable end zone; cantilever left and right exposed; end vertical left and right exposed; Lumber DOL=1.60 plate grip DOL=1.60
 - This truss has been designed for a 10.0 psf bottom chord live load nonconcurrent with any other live loads.
 - Bearing at joint(s) 1, 7 considers parallel to grain value using ANSI/TPI 1 angle to grain formula. Building designer should verify capacity of bearing surface.
 - Provide mechanical connection (by others) of truss to bearing plate capable of withstanding 100 lb uplift at joint(s) except (jt=lb) 1=253, 7=252.
 - This truss is designed in accordance with the 2018 International Residential Code sections R502.11.1 and R802.10.2 and referenced standard ANSI/TPI 1.
 - Hanger(s) or other connection device(s) shall be provided sufficient to support concentrated load(s) 225 lb down and 63 lb up at 2-4-3, 219 lb down and 65 lb up at 4-2-12, 210 lb down and 75 lb up at 6-2-12, 210 lb down and 75 lb up at 6-9-4, and 219 lb down and 65 lb up at 8-9-4, and 225 lb down and 63 lb up at 10-10-4 on bottom chord. The design/selection of such connection device(s) is the responsibility of others.

LOAD CASE(S) Standard
 Continued on page 2



June 12, 2023

WARNING - Verify design parameters and READ NOTES ON THIS AND INCLUDED MITEK REFERENCE PAGE MII-7473 rev. 1/2/2023 BEFORE USE.

Design valid for use only with MiTek® connectors. This design is based only upon parameters shown, and is for an individual building component, not a truss system. Before use, the building designer must verify the applicability of design parameters and properly incorporate this design into the overall building design. Bracing indicated is to prevent buckling of individual truss web and/or chord members only. Additional temporary and permanent bracing is always required for stability and to prevent collapse with possible personal injury and property damage. For general guidance regarding the fabrication, storage, delivery, erection and bracing of trusses and truss systems, see **ANSI/TPI1 Quality Criteria, and DSB-22** available from Truss Plate Institute (www.tpinst.org) and **BCSI Building Component Safety Information** available from the Structural Building Component Association (www.sbcsccomponents.com)

MiTek®
 16023 Swingley Ridge Rd.
 Chesterfield, MO 63017
 314.434.1200 / MiTek-US.com

Job	Truss	Truss Type	Qty	Ply	Summit/185 Highland Meadows	RELEASE FOR CONSTRUCTION
3664536	P3	ROOF SPECIAL GIRDER	1	2	Job Reference (optional)	AS NOTED FOR PLAN REVIEW DEVELOPMENT SERVICES LEE'S SUMMIT, MISSOURI

Builders FirstSource (Valley Center), Valley Center, KS - 67147,

8.630 s Nov 19 2022 MiTek Industries, Inc. Thu Jun 23 14:14:00 2023 Page 2

ID:icBMJaMgT1gasuUyx9?RhvzDEHb-RfC?PsB70Hq3NSuPqnL8w3uTxbGKVICUg7J4ZIC? 10/10/2023

LOAD CASE(S) Standard

- 1) Dead + Roof Live (balanced): Lumber Increase=1.15, Plate Increase=1.15
- Uniform Loads (plf)
 - Vert: 1-4=-70, 4-7=-70, 10-11=-20, 17-20=-20, 8-14=-20
- Concentrated Loads (lb)
 - Vert: 10=-225(B) 9=-421(B) 20=-225(B) 23=-219(B) 24=-219(B)

WARNING - Verify design parameters and READ NOTES ON THIS AND INCLUDED MITEK REFERENCE PAGE MII-7473 rev. 1/2/2023 BEFORE USE.

Design valid for use only with MiTek® connectors. This design is based only upon parameters shown, and is for an individual building component, not a truss system. Before use, the building designer must verify the applicability of design parameters and properly incorporate this design into the overall building design. Bracing indicated is to prevent buckling of individual truss web and/or chord members only. Additional temporary and permanent bracing is always required for stability and to prevent collapse with possible personal injury and property damage. For general guidance regarding the fabrication, storage, delivery, erection and bracing of trusses and truss systems, see **ANSI/TPI1 Quality Criteria, and DSB-22** available from Truss Plate Institute (www.tpinst.org) and **BCSI Building Component Safety Information** available from the Structural Building Component Association (www.sbcsccomponents.com)

MiTek®

16023 Swingley Ridge Rd.
Chesterfield, MO 63017
314.434.1200 / MiTek-US.com

Job 3664536	Truss P4	Truss Type Half Hip Girder	Qty 2	Ply 1	Summit/185 Highland Meadows
----------------	-------------	-------------------------------	----------	----------	-----------------------------

AS NOTED FOR PLAN REVIEW
DEVELOPMENT SERVICES
LEE'S SUMMIT, MISSOURI

Builders FirstSource (Valley Center), Valley Center, KS - 67147,


8.630 s Nov 19 2022 MiTek Industries, Inc. Thu Jun 21 14:14:01 2023 Page 1

ID:icBMJaMgT1gasuUyx9?RhvzDEHb-RfC?PsB70Hq3NSuPqnL8wGulTXbGKVCf0r7JzZICP?

10/10/2023



Scale = 1:12.5

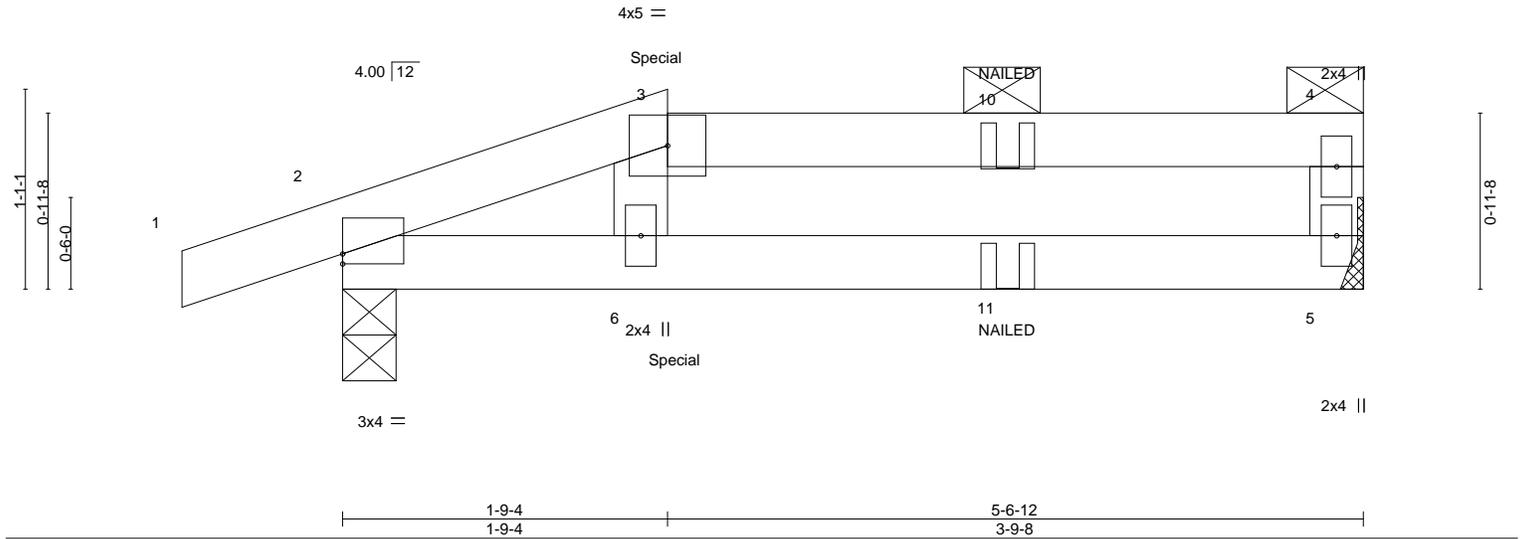

LOADING (psf)	SPACING-	2-0-0	CSI.	DEFL.	in (loc)	l/defl	L/d	PLATES	GRIP
TCLL 25.0	Plate Grip DOL	1.15	TC 0.28	Vert(LL)	-0.09	5-6	>727	MT20	197/144
TCDL 10.0	Lumber DOL	1.15	BC 0.69	Vert(CT)	-0.17	5-6	>379		
BCLL 0.0	Rep Stress Incr	NO	WB 0.03	Horz(CT)	0.02	2	n/a		
BCDL 10.0	Code IRC2018/TPI2014		Matrix-MP					Weight: 15 lb	FT = 20%

LUMBER-	BRACING-
TOP CHORD 2x4 SPF No.2	TOP CHORD Structural wood sheathing directly applied or 5-6-12 oc purlins, except end verticals, and 2-0-0 oc purlins: 3-4.
BOT CHORD 2x4 SPF No.2	BOT CHORD Rigid ceiling directly applied or 6-0-0 oc bracing.
WEBS 2x4 SPF No.2	

REACTIONS. (size) 5=Mechanical, 2=0-3-8
 Max Horz 2=29(LC 7)
 Max Uplift 5=-42(LC 4), 2=-78(LC 4)
 Max Grav 5=245(LC 1), 2=318(LC 1)

FORCES. (lb) - Max. Comp./Max. Ten. - All forces 250 (lb) or less except when shown.
 WEBS 3-6=-251/74

- NOTES-**
- 1) Unbalanced roof live loads have been considered for this design.
 - 2) Wind: ASCE 7-16; Vult=115mph (3-second gust) Vasd=91mph; TCDL=6.0psf; BCDL=4.2psf; h=15ft; Cat. II; Exp C; Enclosed; MWFRS (envelope) gable end zone; cantilever left and right exposed; end vertical left and right exposed; Lumber DOL=1.60 plate grip DOL=1.60
 - 3) Provide adequate drainage to prevent water ponding.
 - 4) This truss has been designed for a 10.0 psf bottom chord live load nonconcurrent with any other live loads.
 - 5) Refer to girder(s) for truss to truss connections.
 - 6) Provide mechanical connection (by others) of truss to bearing plate capable of withstanding 100 lb uplift at joint(s) 5, 2.
 - 7) This truss is designed in accordance with the 2018 International Residential Code sections R502.11.1 and R802.10.2 and referenced standard ANSI/TPI 1.
 - 8) Graphical purlin representation does not depict the size or the orientation of the purlin along the top and/or bottom chord.
 - 9) "NAILED" indicates 3-10d (0.148"x3") or 3-12d (0.148"x3.25") toe-nails per NDS guidelines.
 - 10) Hanger(s) or other connection device(s) shall be provided sufficient to support concentrated load(s) 36 lb down and 58 lb up at 1-9-4 on top chord, and 23 lb down at 1-9-4 on bottom chord. The design/selection of such connection device(s) is the responsibility of others.
 - 11) In the LOAD CASE(S) section, loads applied to the face of the truss are noted as front (F) or back (B).

LOAD CASE(S) Standard

1) Dead + Roof Live (balanced): Lumber Increase=1.15, Plate Increase=1.15
Uniform Loads (plf)
Vert: 1-3=-70, 3-4=-70, 5-7=-20
Concentrated Loads (lb)
Vert: 6=-8(B) 11=-6(B)



June 12, 2023

Job 3664536	Truss P5	Truss Type Half Hip	Qty 2	Ply 1	Summit/185 Highland Meadows Job Reference (optional)	AS NOTED FOR PLAN REVIEW DEVELOPMENT SERVICES LEE'S SUMMIT, MISSOURI
----------------	-------------	------------------------	----------	----------	---	--

Builders FirstSource (Valley Center), Valley Center, KS - 67147,


8.630 s Nov 19 2022 MiTek Industries, Inc. Thu Jun 21 14:14:03 2023 Page 1

ID:icBMJaMgT1gasuUyx9?RhvzDEHb-RfC?PsB70Hq3NSyPqnL8wGulTxbGKVICd7f7JzUICP

10/10/2023



Scale = 1:12.9

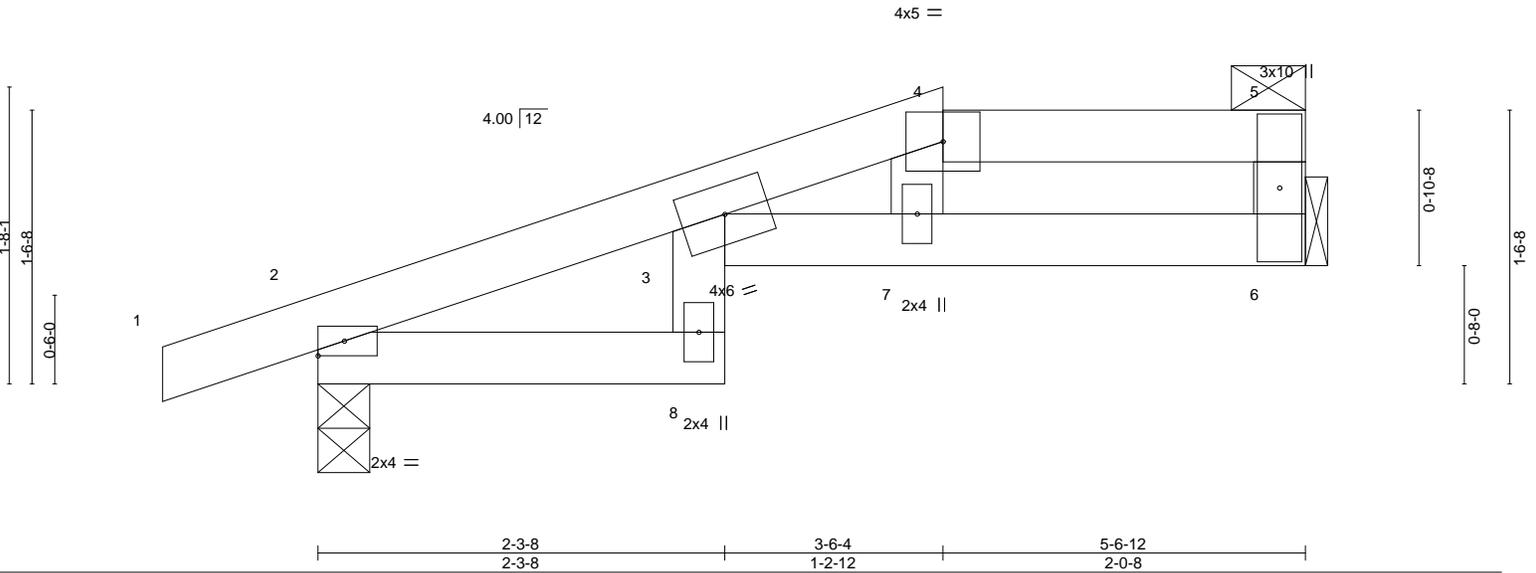

LOADING (psf)	SPACING-	2-0-0	CSI.	DEFL.	in (loc)	l/defl	L/d	PLATES	GRIP
TCLL 25.0	Plate Grip DOL	1.15	TC 0.55	Vert(LL)	0.11 3-7	>603	240	MT20	197/144
TCDL 10.0	Lumber DOL	1.15	BC 0.61	Vert(CT)	-0.18 3-7	>370	180		
BCLL 0.0	Rep Stress Incr	YES	WB 0.05	Horz(CT)	0.08 6	n/a	n/a		
BCDL 10.0	Code IRC2018/TPI2014		Matrix-AS					Weight: 16 lb	FT = 20%

LUMBER-
 TOP CHORD 2x4 SPF No.2
 BOT CHORD 2x4 SPF No.2
 WEBS 2x4 SPF No.2

BRACING-
 TOP CHORD Structural wood sheathing directly applied, except end verticals, and 2-0-0 oc purlins: 4-5.
 BOT CHORD Rigid ceiling directly applied.

REACTIONS. (size) 6=Mechanical, 2=0-3-8
 Max Horz 2=41(LC 8)
 Max Uplift 6=45(LC 8), 2=75(LC 8)
 Max Grav 6=239(LC 1), 2=310(LC 1)

FORCES. (lb) - Max. Comp./Max. Ten. - All forces 250 (lb) or less except when shown.
 WEBS 4-7=-365/262

NOTES-

- Unbalanced roof live loads have been considered for this design.
- Wind: ASCE 7-16; Vult=115mph (3-second gust) Vasd=91mph; TCDL=6.0psf; BCDL=4.2psf; h=15ft; Cat. II; Exp C; Enclosed; MWFRS (envelope) gable end zone and C-C Exterior(2E) -0-10-8 to 2-1-12, Interior(1) 2-1-12 to 3-6-4, Exterior(2E) 3-6-4 to 5-5-0 zone; cantilever left and right exposed; end vertical left and right exposed; C-C for members and forces & MWFRS for reactions shown; Lumber DOL=1.60 plate grip DOL=1.60
- Provide adequate drainage to prevent water ponding.
- This truss has been designed for a 10.0 psf bottom chord live load nonconcurrent with any other live loads.
- Refer to girder(s) for truss to truss connections.
- Provide mechanical connection (by others) of truss to bearing plate capable of withstanding 100 lb uplift at joint(s) 6, 2.
- This truss is designed in accordance with the 2018 International Residential Code sections R502.11.1 and R802.10.2 and referenced standard ANSI/TPI 1.
- This truss design requires that a minimum of 7/16" structural wood sheathing be applied directly to the top chord and 1/2" gypsum sheetrock be applied directly to the bottom chord.
- Graphical purlin representation does not depict the size or the orientation of the purlin along the top and/or bottom chord.



June 12, 2023

WARNING - Verify design parameters and READ NOTES ON THIS AND INCLUDED MITEK REFERENCE PAGE MII-7473 rev. 1/2/2023 BEFORE USE.

Design valid for use only with MiTek® connectors. This design is based only upon parameters shown, and is for an individual building component, not a truss system. Before use, the building designer must verify the applicability of design parameters and properly incorporate this design into the overall building design. Bracing indicated is to prevent buckling of individual truss web and/or chord members only. Additional temporary and permanent bracing is always required for stability and to prevent collapse with possible personal injury and property damage. For general guidance regarding the fabrication, storage, delivery, erection and bracing of trusses and truss systems, see **ANSI/TPI1 Quality Criteria, and DSB-22** available from Truss Plate Institute (www.tpinst.org) and **BCSI Building Component Safety Information** available from the Structural Building Component Association (www.sbcsccomponents.com)

MiTek®

16023 Swingley Ridge Rd.
 Chesterfield, MO 63017
 314.434.1200 / MiTek-US.com

Job 3664536	Truss P6	Truss Type HALF HIP	Qty 2	Ply 1	Summit/185 Highland Meadows Job Reference (optional)	RELEASE FOR CONSTRUCTION AS NOTED FOR PLAN REVIEW DEVELOPMENT SERVICES LEE'S SUMMIT, MISSOURI
----------------	-------------	------------------------	----------	----------	---	--

Builders FirstSource (Valley Center), Valley Center, KS - 67147,

8.630 s Nov 19 2022 MiTek Industries, Inc. Thu Jun 21 14:03:2023 Page 1

ID:icBMJaMgT1gasuUyx9?RhvzDEHb-RfC?PsB70Hq3NSuPqnL8wGulTXbGKVICd7f7JzICP?

10/10/2023



Scale = 1:15.0

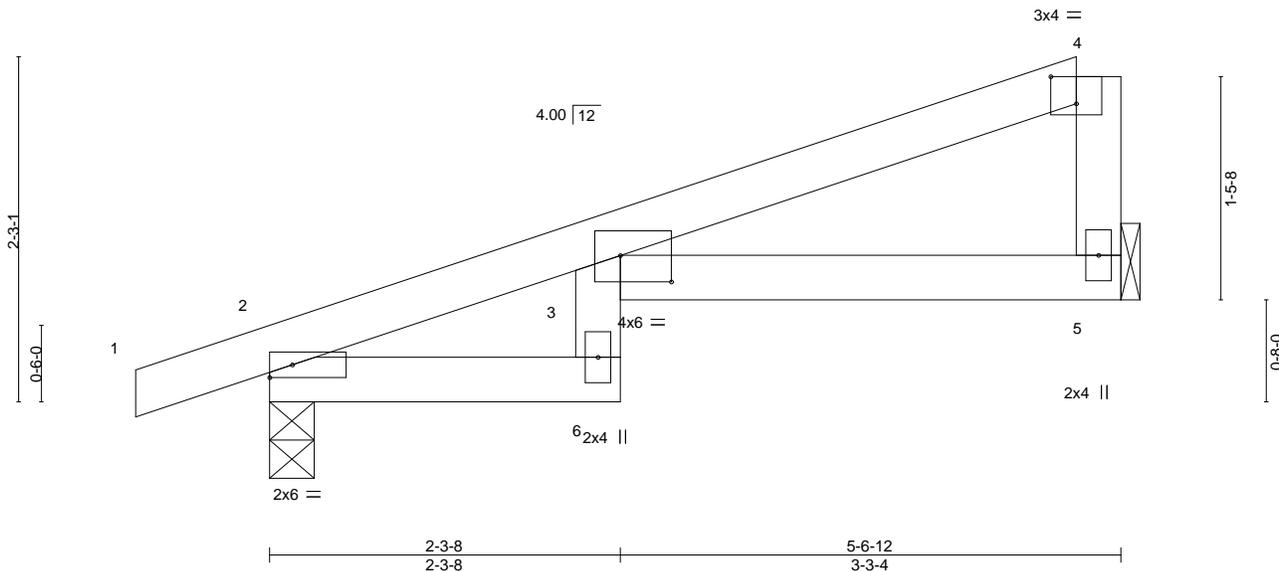


Plate Offsets (X,Y)--	[3:0-4-0,0-2-1], [4:0-2-0,0-2-2]				
LOADING (psf)	SPACING- 2-0-0	CSI.	DEFL. in (loc) l/defl L/d	PLATES	GRIP
TCLL 25.0	Plate Grip DOL 1.15	TC 0.51	Vert(LL) -0.07 6 >918 240	MT20	197/144
TCDL 10.0	Lumber DOL 1.15	BC 0.28	Vert(CT) -0.12 6 >511 180		
BCLL 0.0	Rep Stress Incr YES	WB 0.00	Horz(CT) 0.07 5 n/a n/a		
BCDL 10.0	Code IRC2018/TPI2014	Matrix-R		Weight: 16 lb	FT = 20%

LUMBER-	BRACING-
TOP CHORD 2x4 SPF No.2	TOP CHORD Structural wood sheathing directly applied or 5-6-12 oc purlins, except end verticals.
BOT CHORD 2x4 SPF No.2	BOT CHORD Rigid ceiling directly applied or 10-0-0 oc bracing.
WEBS 2x4 SPF No.2	

REACTIONS. (size) 5=Mechanical, 2=0-3-8
 Max Horz 2=78(LC 8)
 Max Uplift 5=-55(LC 12), 2=-70(LC 8)
 Max Grav 5=230(LC 1), 2=316(LC 1)

FORCES. (lb) - Max. Comp./Max. Ten. - All forces 250 (lb) or less except when shown.

NOTES-

- 1) Wind: ASCE 7-16; Vult=115mph (3-second gust) Vasd=91mph; TCDL=6.0psf; BCDL=4.2psf; h=15ft; Cat. II; Exp C; Enclosed; MWFRS (envelope) gable end zone and C-C Exterior(2E) -0-10-8 to 2-1-12, Interior(1) 2-1-12 to 5-5-0 zone; cantilever left and right exposed; end vertical left exposed; C-C for members and forces & MWFRS for reactions shown; Lumber DOL=1.60 plate grip DOL=1.60
- 2) This truss has been designed for a 10.0 psf bottom chord live load nonconcurrent with any other live loads.
- 3) Refer to girder(s) for truss to truss connections.
- 4) Provide mechanical connection (by others) of truss to bearing plate capable of withstanding 100 lb uplift at joint(s) 5, 2.
- 5) This truss is designed in accordance with the 2018 International Residential Code sections R502.11.1 and R802.10.2 and referenced standard ANSI/TPI 1.



June 12, 2023

Job 3664536	Truss V1	Truss Type Valley	Qty 1	Ply 1	Summit/185 Highland Meadows
----------------	-------------	----------------------	----------	----------	-----------------------------

RELEASE FOR CONSTRUCTION

AS NOTED FOR PLAN REVIEW

DEVELOPMENT SERVICES

LEE'S SUMMIT, MISSOURI

10/10/2023


Builders FirstSource (Valley Center), Valley Center, KS - 67147,

8.630 s Nov 19 2022 MiTek Industries, Inc. Thu Jun 21 14:14:04 2023 Page 1

ID:icBMJaMgT1gasuUyx9?RhvzDEHb-RIC?PsB70Hq3NSpPqnL8w3uITXbGKVICDm7JzZICP



Scale = 1:22.5

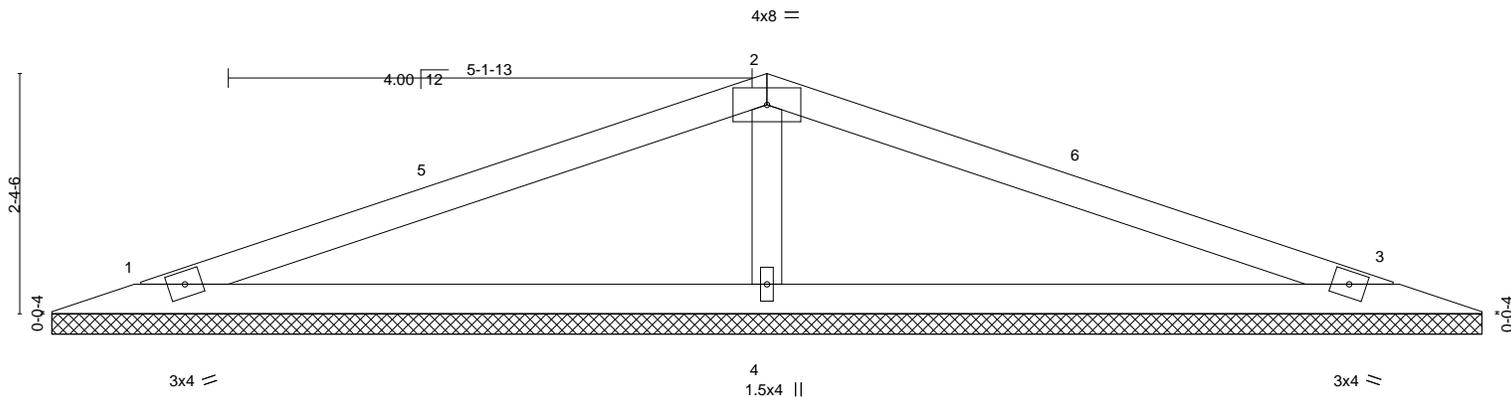

0-0-12 0-0-12				14-2-4 14-1-8					
LOADING (psf)	SPACING-	2-0-0	CSI.	DEFL.	in (loc)	l/defl	L/d	PLATES	GRIP
TCLL 25.0	Plate Grip DOL	1.15	TC 0.55	Vert(LL)	n/a	-	n/a	MT20	197/144
TCDL 10.0	Lumber DOL	1.15	BC 0.31	Vert(CT)	n/a	-	n/a		
BCLL 0.0	Rep Stress Incr	YES	WB 0.06	Horz(CT)	0.00	3	n/a		
BCDL 10.0	Code IRC2018/TPI2014		Matrix-S					Weight: 33 lb	FT = 20%

LUMBER-
 TOP CHORD 2x4 SPF No.2
 BOT CHORD 2x4 SPF No.2
 OTHERS 2x4 SPF No.2

BRACING-
 TOP CHORD Structural wood sheathing directly applied or 6-0-0 oc purlins.
 BOT CHORD Rigid ceiling directly applied or 10-0-0 oc bracing.

REACTIONS. (size) 1=14-0-12, 3=14-0-12, 4=14-0-12
 Max Horz 1=33(LC 12)
 Max Uplift 1=49(LC 8), 3=53(LC 13), 4=63(LC 8)
 Max Grav 1=246(LC 25), 3=246(LC 26), 4=633(LC 1)

FORCES. (lb) - Max. Comp./Max. Ten. - All forces 250 (lb) or less except when shown.
WEBS 2-4=-448/206

- NOTES-**
- Unbalanced roof live loads have been considered for this design.
 - Wind: ASCE 7-16; Vult=115mph (3-second gust) Vasd=91mph; TCDL=6.0psf; BCDL=4.2psf; h=15ft; Cat. II; Exp C; Enclosed; MWFRS (envelope) gable end zone and C-C Exterior(2E) 0-11-5 to 3-11-5, Interior(1) 3-11-5 to 7-1-2, Exterior(2R) 7-1-2 to 10-1-2, Interior(1) 10-1-2 to 13-2-15 zone; cantilever left and right exposed; end vertical left and right exposed; C-C for members and forces & MWFRS for reactions shown; Lumber DOL=1.60 plate grip DOL=1.60
 - Gable requires continuous bottom chord bearing.
 - This truss has been designed for a 10.0 psf bottom chord live load nonconcurrent with any other live loads.
 - Provide mechanical connection (by others) of truss to bearing plate capable of withstanding 100 lb uplift at joint(s) 1, 3, 4.
 - This truss is designed in accordance with the 2018 International Residential Code sections R502.11.1 and R802.10.2 and referenced standard ANSI/TPI 1.



June 12, 2023

WARNING - Verify design parameters and READ NOTES ON THIS AND INCLUDED MITEK REFERENCE PAGE MII-7473 rev. 1/2/2023 BEFORE USE.

Design valid for use only with MiTek® connectors. This design is based only upon parameters shown, and is for an individual building component, not a truss system. Before use, the building designer must verify the applicability of design parameters and properly incorporate this design into the overall building design. Bracing indicated is to prevent buckling of individual truss web and/or chord members only. Additional temporary and permanent bracing is always required for stability and to prevent collapse with possible personal injury and property damage. For general guidance regarding the fabrication, storage, delivery, erection and bracing of trusses and truss systems, see **ANSI/TPI1 Quality Criteria, and DSB-22** available from Truss Plate Institute (www.tpinst.org) and **BCSI Building Component Safety Information** available from the Structural Building Component Association (www.sbcsccomponents.com)

MiTek®

16023 Swingley Ridge Rd.
 Chesterfield, MO 63017
 314.434.1200 / MiTek-US.com


Job 3664536	Truss V2	Truss Type Valley	Qty 1	Ply 1	Summit/185 Highland Meadows
----------------	-------------	----------------------	----------	----------	-----------------------------

RELEASE FOR CONSTRUCTION
AS NOTED FOR PLAN REVIEW
DEVELOPMENT SERVICES
LEE'S SUMMIT, MISSOURI
10/10/2023


Builders FirstSource (Valley Center), Valley Center, KS - 67147,

8.630 s Nov 19 2022 MiTek Industries, Inc. Thu Jun 21 14:14:05 2023 Page 1

ID:icBMJaMgT1gasuUyx9?RhvzDEHb-RfC?PsB70Hq3NSpPqnL8w3ulTx5GKVICDm7J4ZICP

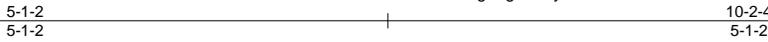

Scale: 3/4"=1'

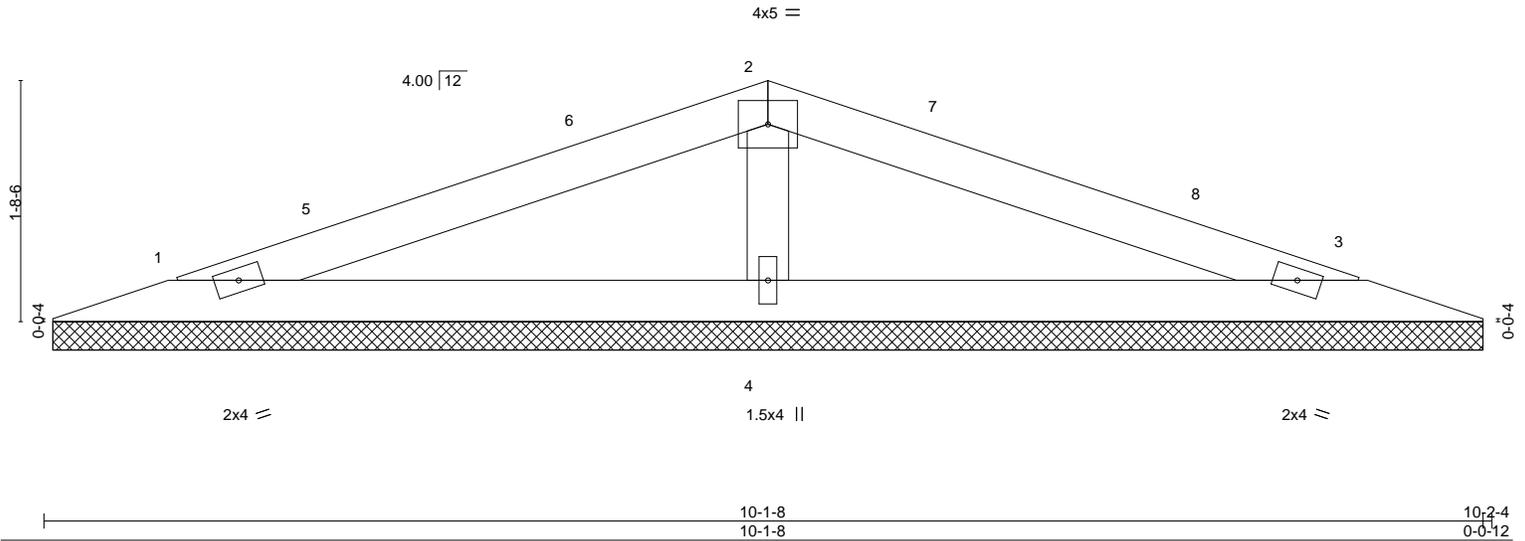

LOADING (psf)	SPACING-	CSI.	DEFL.	PLATES	GRIP
TCLL 25.0	2-0-0	TC 0.23	in (loc) l/defl L/d	MT20	197/144
TCDL 10.0	Plate Grip DOL 1.15	BC 0.14	Vert(LL) n/a - n/a 999		
BCLL 0.0	Lumber DOL 1.15	WB 0.04	Vert(CT) n/a - n/a 999		
BCDL 10.0	Rep Stress Incr YES	Matrix-S	Horz(CT) 0.00 3 n/a n/a		
	Code IRC2018/TPI2014			Weight: 23 lb	FT = 20%

LUMBER-	BRACING-
TOP CHORD 2x4 SPF No.2	TOP CHORD Structural wood sheathing directly applied or 6-0-0 oc purlins.
BOT CHORD 2x4 SPF No.2	BOT CHORD Rigid ceiling directly applied or 10-0-0 oc bracing.
OTHERS 2x4 SPF No.2	

REACTIONS. (size) 1=10-0-12, 3=10-0-12, 4=10-0-12
 Max Horz 1=22(LC 17)
 Max Uplift 1=33(LC 8), 3=36(LC 13), 4=42(LC 8)
 Max Grav 1=166(LC 25), 3=166(LC 26), 4=427(LC 1)

FORCES. (lb) - Max. Comp./Max. Ten. - All forces 250 (lb) or less except when shown.
WEBS 2-4=302/195

NOTES-

- Unbalanced roof live loads have been considered for this design.
- Wind: ASCE 7-16; Vult=115mph (3-second gust) Vasd=91mph; TCDL=6.0psf; BCDL=4.2psf; h=15ft; Cat. II; Exp C; Enclosed; MWFRS (envelope) gable end zone and C-C Exterior(2E) 0-11-5 to 3-11-5, Interior(1) 3-11-5 to 5-1-2, Exterior(2R) 5-1-2 to 8-1-2, Interior(1) 8-1-2 to 9-2-15 zone; cantilever left and right exposed; end vertical left and right exposed; C-C for members and forces & MWFRS for reactions shown; Lumber DOL=1.60 plate grip DOL=1.60
- Gable requires continuous bottom chord bearing.
- This truss has been designed for a 10.0 psf bottom chord live load nonconcurrent with any other live loads.
- Provide mechanical connection (by others) of truss to bearing plate capable of withstanding 100 lb uplift at joint(s) 1, 3, 4.
- This truss is designed in accordance with the 2018 International Residential Code sections R502.11.1 and R802.10.2 and referenced standard ANSI/TPI 1.



June 12, 2023

Job 3664536	Truss V3	Truss Type Valley	Qty 1	Ply 1	Summit/185 Highland Meadows Job Reference (optional)	RELEASE FOR CONSTRUCTION AS NOTED FOR PLAN REVIEW DEVELOPMENT SERVICES LEE'S SUMMIT, MISSOURI
----------------	-------------	----------------------	----------	----------	---	--

Builders FirstSource (Valley Center), Valley Center, KS - 67147,


8.630 s Nov 19 2022 MiTek Industries, Inc. Thu Jun 14 14:06:2023 Page 1

ID:icBMJaMgT1gasuUyx9?RhvhDEHb-RfC?PsB70Hq3NSuPqnL8wGulTXbGKVICDm7JzZICP

10/10/2023



Scale = 1:11.3

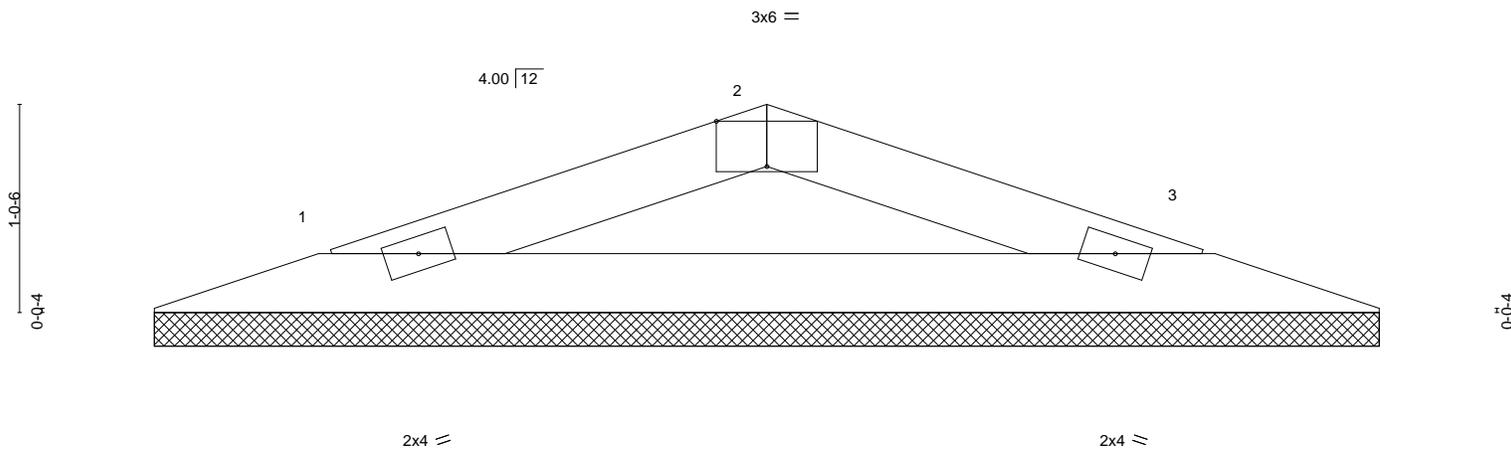

0-0-12	6-2-4
0-0-12	6-1-8

Plate Offsets (X,Y)-- [2:0-3-0,Edge]									
LOADING (psf)	SPACING-	2-0-0	CSI.	DEFL.	in (loc)	l/defl	L/d	PLATES	GRIP
TCLL 25.0	Plate Grip DOL	1.15	TC 0.10	Vert(LL)	n/a	-	n/a	MT20	197/144
TCDL 10.0	Lumber DOL	1.15	BC 0.20	Vert(CT)	n/a	-	n/a		
BCLL 0.0	Rep Stress Incr	YES	WB 0.00	Horz(CT)	0.00	3	n/a		
BCDL 10.0	Code IRC2018/TPI2014		Matrix-P					Weight: 12 lb	FT = 20%

LUMBER-
TOP CHORD 2x4 SPF No.2
BOT CHORD 2x4 SPF No.2

BRACING-
TOP CHORD Structural wood sheathing directly applied or 6-0-0 oc purlins.
BOT CHORD Rigid ceiling directly applied or 10-0-0 oc bracing.

REACTIONS. (size) 1=6-0-12, 3=6-0-12
Max Horz 1=12(LC 12)
Max Uplift 1=28(LC 8), 3=28(LC 9)
Max Grav 1=194(LC 1), 3=194(LC 1)

FORCES. (lb) - Max. Comp./Max. Ten. - All forces 250 (lb) or less except when shown.
TOP CHORD 1-2=-253/215, 2-3=-253/225

- NOTES-**
- Unbalanced roof live loads have been considered for this design.
 - Wind: ASCE 7-16; Vult=115mph (3-second gust) Vasd=91mph; TCDL=6.0psf; BCDL=4.2psf; h=15ft; Cat. II; Exp C; Enclosed; MWFRS (envelope) gable end zone and C-C Exterior(2E) zone; cantilever left and right exposed; end vertical left and right exposed; C-C for members and forces & MWFRS for reactions shown; Lumber DOL=1.60 plate grip DOL=1.60
 - Gable requires continuous bottom chord bearing.
 - This truss has been designed for a 10.0 psf bottom chord live load nonconcurrent with any other live loads.
 - Provide mechanical connection (by others) of truss to bearing plate capable of withstanding 100 lb uplift at joint(s) 1, 3.
 - This truss is designed in accordance with the 2018 International Residential Code sections R502.11.1 and R802.10.2 and referenced standard ANSI/TPI 1.



June 12, 2023

WARNING - Verify design parameters and READ NOTES ON THIS AND INCLUDED MITEK REFERENCE PAGE MII-7473 rev. 1/2/2023 BEFORE USE.

Design valid for use only with MiTek® connectors. This design is based only upon parameters shown, and is for an individual building component, not a truss system. Before use, the building designer must verify the applicability of design parameters and properly incorporate this design into the overall building design. Bracing indicated is to prevent buckling of individual truss web and/or chord members only. Additional temporary and permanent bracing is always required for stability and to prevent collapse with possible personal injury and property damage. For general guidance regarding the fabrication, storage, delivery, erection and bracing of trusses and truss systems, see **ANSI/TPI1 Quality Criteria, and DSB-22** available from Truss Plate Institute (www.tpinst.org) and **BCSI Building Component Safety Information** available from the Structural Building Component Association (www.sbcsccomponents.com)


MiTek®

16023 Swingley Ridge Rd.
Chesterfield, MO 63017
314.434.1200 / MiTek-US.com

Symbols

PLATE LOCATION AND ORIENTATION

Center plate on joint unless x, y offsets are indicated. Dimensions are in ft-in-sixteenths. Apply plates to both sides of truss and fully embed teeth.

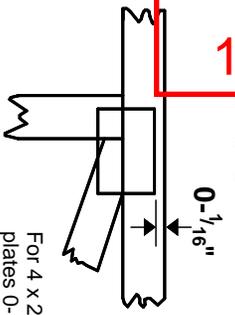

For 4 x 2 orientation, locate plates 0- 1/16" from outside edge of truss.



This symbol indicates the required direction of slots in connector plates.

* Plate location details available in MITek software or upon request.

PLATE SIZE

4 X 4


The first dimension is the plate width measured perpendicular to slots. Second dimension is the length parallel to slots.

LATERAL BRACING LOCATION



Indicated by symbol shown and/or by text in the bracing section of the output. Use T or I bracing if indicated.

BEARING

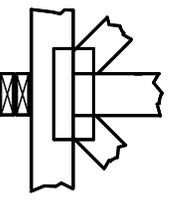


Indicates location where bearings (supports) occur. Icons vary but reaction section indicates joint number/letter where bearings occur. Min size shown is for crushing only.

Industry Standards:
 ANSI/TPI 1: National Design Specification for Metal Plate Connected Wood Truss Construction.
 DSB-22: Design Standard for Bracing.
 BCSI: Building Component Safety Information, Guide to Good Practice for Handling, Installing, Restraining & Bracing of Metal Plate Connected Wood Trusses.

Numbering System

6-4-8 dimensions shown in ft-in-sixteenths (Drawings not to scale)

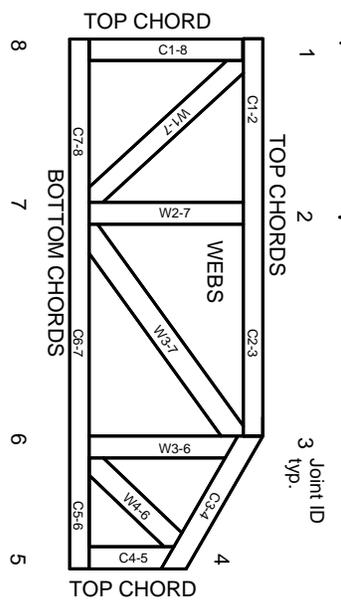

JOINTS ARE GENERALLY NUMBERED/LETTERED CLOCKWISE AROUND THE TRUSS STARTING AT THE JOINT FARTHEST TO THE LEFT.

CHORDS AND WEBS ARE IDENTIFIED BY END JOINT NUMBERS/LETTERS.

Product Code Approvals

ICC-ES Reports:
 ESR-1-1988, ESR-2362, ESR-2685, ESR-3282
 ESR-4722, ESL-1388

Design General Notes

Trusses are designed for wind loads in the plane of the truss unless otherwise shown.
 Lumber design values are in accordance with ANSI/TPI 1 section 6.3. These truss designs rely on Lumber values established by others.

© 2023 MITek® All Rights Reserved

General Safety Notes

Failure to Follow Could Cause Property Damage or Personal Injury

1. Additional stability/bracing for truss system, e.g. diagonal or X-bracing, is always required. See BCSI.
2. Truss bracing must be designed by an engineer. For wide truss spacing, individual lateral braces themselves may require bracing, or alternative Tor I bracing should be considered.
3. Never exceed the design loading shown and never stack materials on inadequately braced trusses.
4. Provide copies of this truss design to the building designer, erection supervisor, property owner and all other interested parties.
5. Cut members to bear tightly against each other.
6. Place plates on each face of truss at each joint and embed fully. Knots and wane at joint locations are regulated by ANSI/TPI 1.
7. Design assumes trusses will be suitably protected from the environment in accord with ANSI/TPI 1.
8. Unless otherwise noted, moisture content of lumber shall not exceed 19% at time of fabrication.
9. Unless expressly noted, this design is not applicable for use with fire retardant, preservative treated, or green lumber.
10. Camber is a non-structural consideration and is the responsibility of truss fabricator. General practice is to camber for dead load deflection.
11. Plate type, size, orientation and location dimensions indicated are minimum plating requirements.
12. Lumber used shall be of the species and size, and in all respects, equal to or better than that specified.
13. Top chords must be sheathed or purlins provided at spacing indicated on design.
14. Bottom chords require lateral bracing at 10 ft. spacing, or less, if no ceiling is installed, unless otherwise noted.
15. Connections not shown are the responsibility of others.
16. Do not cut or alter truss member or plate without prior approval of an engineer.
17. Install and load vertically unless indicated otherwise.
18. Use of green or treated lumber may pose unacceptable environmental, health or performance risks. Consult with project engineer before use.
19. Review all portions of this design (front, back, words and pictures) before use. Reviewing pictures alone is not sufficient.
20. Design assumes manufacture in accordance with ANSI/TPI 1 Quality Criteria.
21. The design does not take into account any dynamic or other loads other than those expressly stated.

