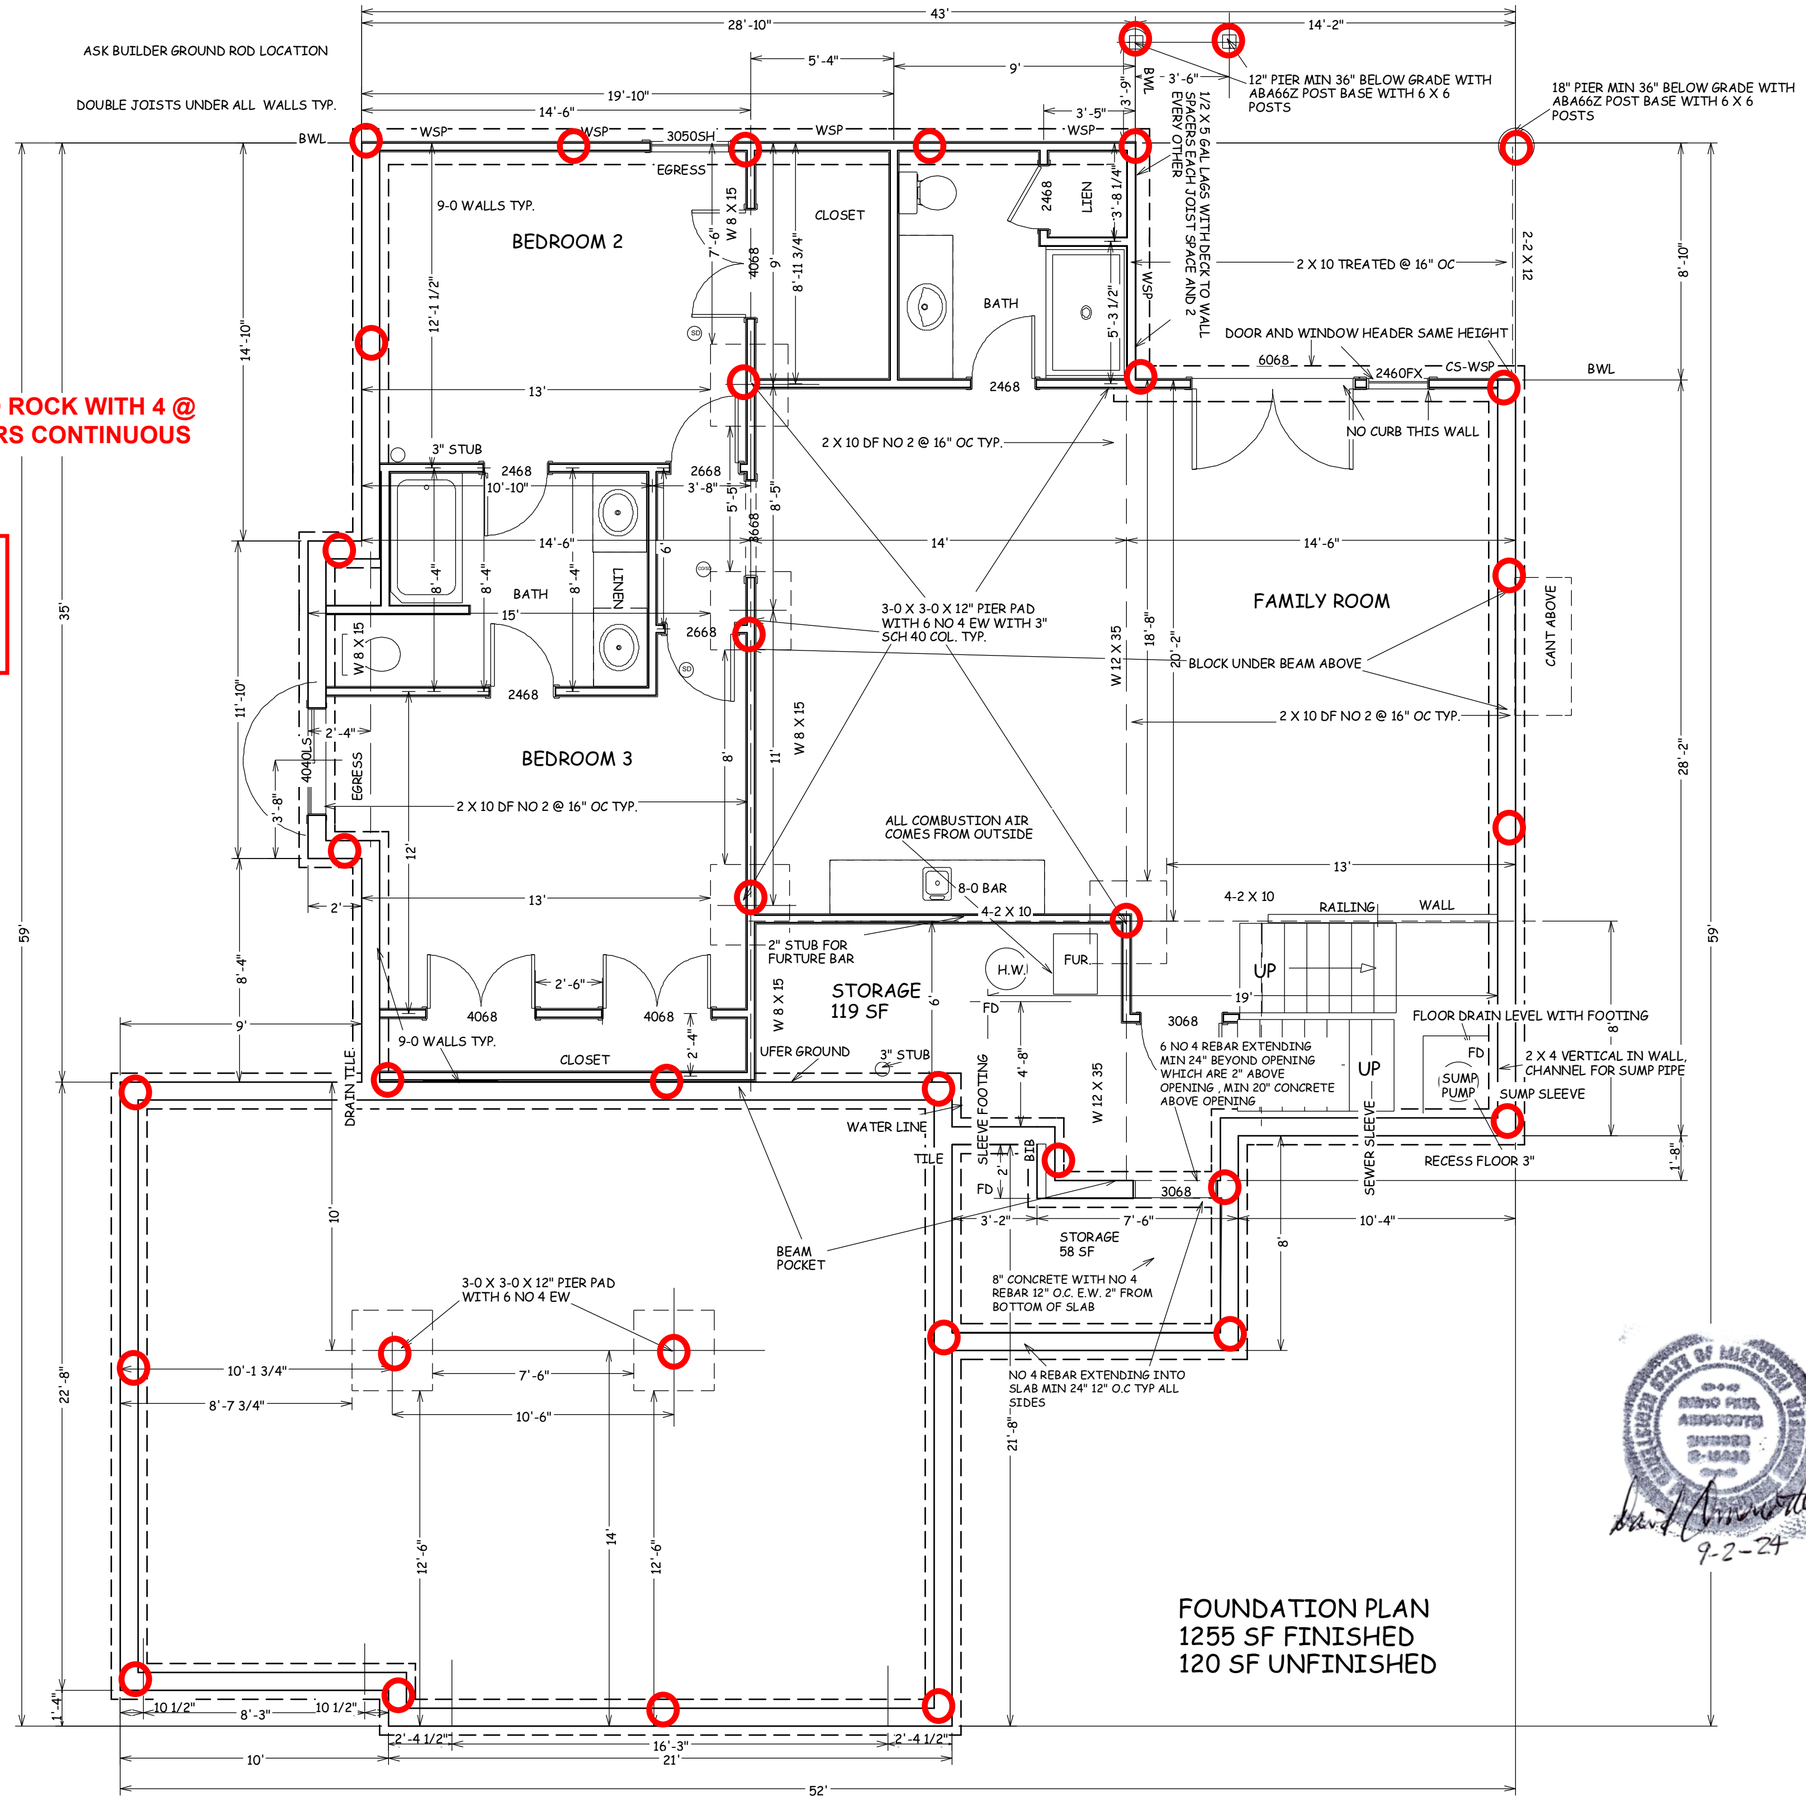


**18" DIA PIERS TO ROCK WITH 4 @ #4 VERTICAL BARS CONTINUOUS**

RELEASE FOR CONSTRUCTION
AS NOTED FOR PLAN REVIEW
DEVELOPMENT SERVICES
LEE'S SUMMIT, MISSOURI
09/17/2024

Brandon Kalwei
Digitally signed by Brandon Kalwei
DN: CN=Brandon Kalwei, OU=Development, OU=LS Users, DC=COLS, DC=LOC
Date: 2024.09.17 13:02:25-05'00'

BUILD IN ACCORDANCE WITH 2018 INTERNATIONAL RESIDENTIAL CODE AND LOCAL CODES.

TRUMARK HOMES
LOT 206 HIGHLAND MEADOWS
1105 SW FIORD DR
LEE SUMMIT MO

| | |
|---|---|
| SCALE | 1/4" = 1-0 |
| DATE | 8-21-24 |
| PLAN NO. | 4280 |
| SHEET NO. | 2 OF 6 |

9-2-24