

MiTek, Inc.
16023 Swingley Ridge Rd.
Chesterfield, MO 63017
314.434.1200

Re: 242042
GENE BOSLEY RES. / ROOF

The truss drawing(s) referenced below have been prepared by MiTek USA, Inc. under my direct supervision based on the parameters provided by Heartland Truss, Inc..

Pages or sheets covered by this seal: I69875878 thru I69875976

My license renewal date for the state of Missouri is December 31, 2025.

Missouri COA: Engineering 001193



November 27, 2024

Johnson, Andrew ,Engineer

IMPORTANT NOTE: The seal on these truss component designs is a certification that the engineer named is licensed in the jurisdiction(s) identified and that the designs comply with ANSI/TPI 1. These designs are based upon parameters shown (e.g., loads, supports, dimensions, shapes and design codes), which were given to MiTek or TRENCO. Any project specific information included is for MiTek's or TRENCO's customers file reference purpose only, and was not taken into account in the preparation of these designs. MiTek or TRENCO has not independently verified the applicability of the design parameters or the designs for any particular building. Before use, the building designer should verify applicability of design parameters and properly incorporate these designs into the overall building design per ANSI/TPI 1, Chapter 2.

Job	Truss	Truss Type	Qty	Ply	GENE BOSLEY RES. / ROOF
242042	01	Piggyback Base	1	1	

RELEASE FOR CONSTRUCTION
 AS NOTED FOR PLAN REVIEW
 DEVELOPMENT SERVICES
 LEE'S SUMMIT, MISSOURI

Heartland Truss, Inc, Plattsburg, MO - 64477, 8.730 s Oct 31 2024 MiTek Industries, Inc. Wed Nov 27 09:17:2024 Page 1
 ID: mrcY1X_2FQFIxm9hhpx4TmyPVL_n6TdPpKFNfUVRtXHS XhbKjertmDMGgDU Gcs/uhVF2U2
 1-4-4 3-1-0 4-1-0 9-0-0 13-11-0 18-2-9 24-2-8 30-2-8 34-5-8 38-8-8 41-8-8 49-0-12 50-5-0
 1-4-4 1-8-12 1-0-0 4-1-0 4-11-0 4-11-0 4-3-9 6-0-0 6-0-0 4-3-0 4-3-0 4-3-0 3-0-0 7-4-4 49-2-8
 0-6-8 2-7-3 6-4-3 12-0-3 0-6-8 2-0-0 12-0-3

12/02/2024

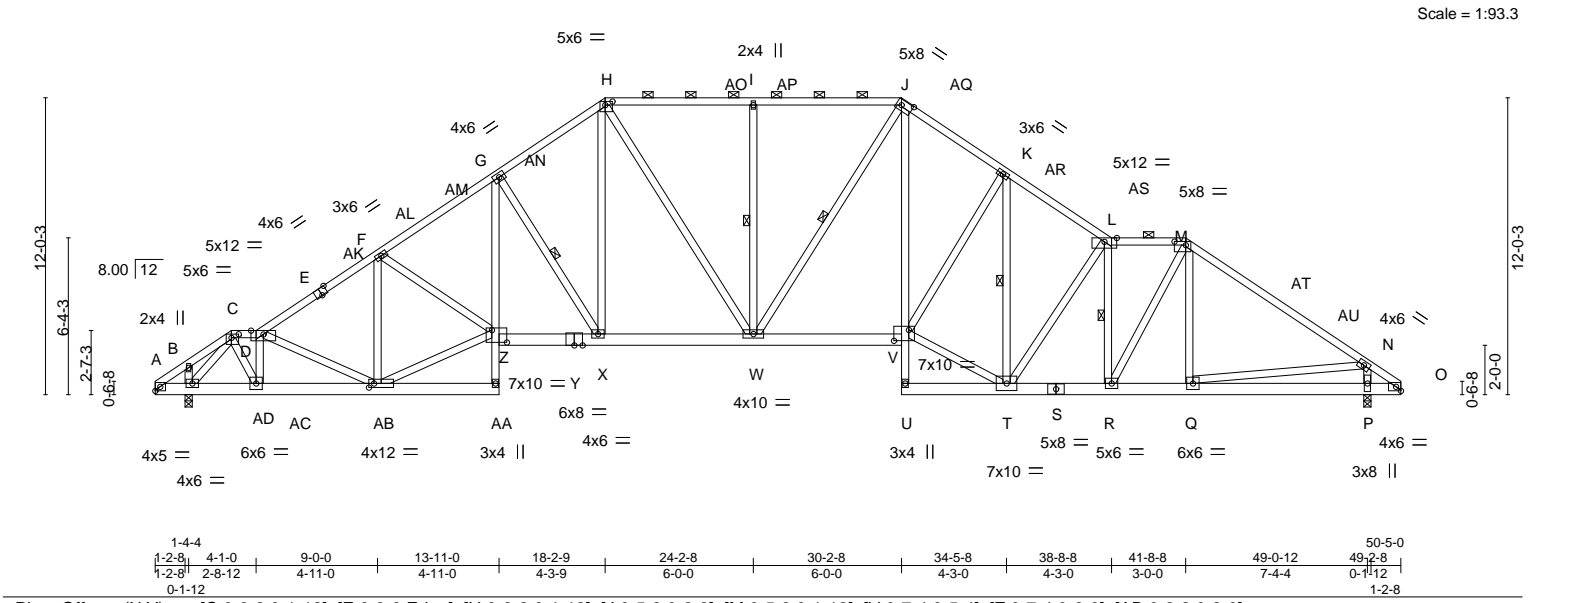


Plate Offsets (X, Y)-- [C:0-3-8,0-1-12], [E:0-3-0,Edge], [H:0-3-8,0-1-12], [J:0-5-8,0-2-8], [M:0-5-8,0-1-12], [V:0-7-4,0-5-4], [Z:0-7-4,0-6-0], [AB:0-2-8,0-2-0]

LOADING (psf)	SPACING-	CSI.	DEFL.	PLATES	GRIP
TCLL 25.0 (Roof Snow=25.0) TCDL 10.0 BCLL 0.0 BCDL 10.0	2-0-0 Plate Grip DOL 1.15 Lumber DOL 1.15 Rep Stress Incr YES Code IRC2018/TPI2014	TC 0.87 BC 0.81 WB 0.88 Matrix-MS	in (loc) l/def L/d Vert(LL) -0.32 V-W >999 240 Vert(CT) -0.52 V-W >999 180 Horz(CT) 0.25 P n/a n/a	MT20	244/190
				Weight: 424 lb	FT = 20%

LUMBER-	BRACING-
TOP CHORD 2x4 SP No.2 *Except* E-H,H-J,D-E: 2x4 SP 1650F 1.5E, M-O: 2x4 SP 2400F 2.0E	TOP CHORD Structural wood sheathing directly applied or 2-2-0 oc purlins, except 2-0-0 oc purlins (2-4-15 max.): C-D, H-J, L-M.
BOT CHORD 2x6 SP No.1 *Except* A-AA: 2x6 SP 2400F 2.0E, G-AA,J-U: 2x4 SP No.3	BOT CHORD Rigid ceiling directly applied or 10-0-0 oc bracing.
WEBS 2x4 SP No.3 *Except* C-AC,Z-AB,T-V: 2x4 SP No.2	WEBS 1 Row at midpt G-X, I-W, J-W, K-T, L-R

REACTIONS. (size) AD=0-3-8, P=0-3-8
 Max Horz AD=-287(LC 10)
 Max Uplift AD=-185(LC 12), P=-205(LC 13)
 Max Grav AD=2981(LC 40), P=2935(LC 40)

FORCES. (lb) - Max. Comp./Max. Ten. - All forces 250 (lb) or less except when shown.
 TOP CHORD A-B=-375/20, B-C=-475/76, C-D=-3262/301, D-F=-4013/393, F-G=-4728/498, G-H=-3613/495, H-I=-3008/482, I-J=-3008/482, J-K=-3838/531, K-L=-3641/486, L-M=-3504/451, M-N=-3560/377, N-O=-511/15
 BOT CHORD A-AD=0/323, AC-AD=-268/2026, AB-AC=-327/3095, G-Z=-129/1454, X-Z=-209/3797, W-X=-148/2834, V-W=-87/3013, J-V=-168/1787, R-T=-253/3468, Q-R=-180/2715, P-Q=-122/753, O-P=-122/753
 WEBS B-AD=-286/78, C-AD=-2774/220, C-AC=-232/2697, D-AC=-2558/275, F-AB=-1439/148, Z-AB=-270/3452, F-Z=-30/797, G-X=-1722/286, H-X=-163/1299, H-W=-193/764, I-W=-890/193, J-W=-233/321, T-V=-179/3329, K-V=-147/490, K-T=-831/87, L-T=-872/185, L-R=-1460/183, M-R=-167/1692, N-Q=-92/1978, N-P=-2961/471

- NOTES-**
- Wind: ASCE 7-16; Vult=115mph (3-second gust) Vasd=91mph; TCDL=6.0psf; BCDL=6.0psf; h=20ft; Cat. II; Exp C; Enclosed; MWFRS (envelope) gable end zone and C-C Exterior(2E) 0-0-0 to 4-1-0, Interior(1) 4-1-0 to 13-2-0, Exterior(2R) 13-2-0 to 23-3-1, Interior(1) 23-3-1 to 25-3-12, Exterior(2R) 25-3-12 to 35-4-12, Interior(1) 35-4-12 to 38-8-8, Exterior(2R) 38-8-8 to 45-4-8, Exterior(2E) 45-4-8 to 50-5-0 zone; cantilever left and right exposed ; end vertical left and right exposed;C-C for members and forces & MWFRS for reactions shown; Lumber DOL=1.33 plate grip DOL=1.33
 - TCLL: ASCE 7-16; Pf=25.0 psf (Lum DOL=1.15 Plate DOL=1.15); Is=1.0; Rough Cat C; Fully Exp.; Ce=0.9; Cs=1.00; Ct=1.10
 - Unbalanced snow loads have been considered for this design.
 - Provide adequate drainage to prevent water ponding.
 - This truss has been designed for a 10.0 psf bottom chord live load nonconcurrent with any other live loads.
 - Provide mechanical connection (by others) of truss to bearing plate capable of withstanding 100 lb uplift at joint(s) except (jt=lb) AD=185, P=205.
 - This truss is designed in accordance with the 2018 International Residential Code sections R502.11.1 and R802.10.2 and referenced standard ANSI/TPI 1.
 - Graphical purlin representation does not depict the size or the orientation of the purlin along the top and/or bottom chord.



November 27, 2024

Job	Truss	Truss Type	Qty	Ply	GENE BOSLEY RES. / ROOF
242042	02	Piggyback Base	1	1	

RELEASE FOR CONSTRUCTION

AS NOTED FOR PLAN REVIEW

DEVELOPMENT SERVICES

12/02/2024

LEE'S SUMMIT, MISSOURI

Heartland Truss, Inc. Plattsburg, MO - 64477, 8.730 s Oct 31 2024 MiTek Industries, Inc. Wed Nov 27 08:08 2024 Page 1

ID:mrcY1X_2FQFIXm9hpx4TmyPVL_FJ00d9L8ZcM2d6T7FDqHw_9Xx416CdeLucaQvF2U

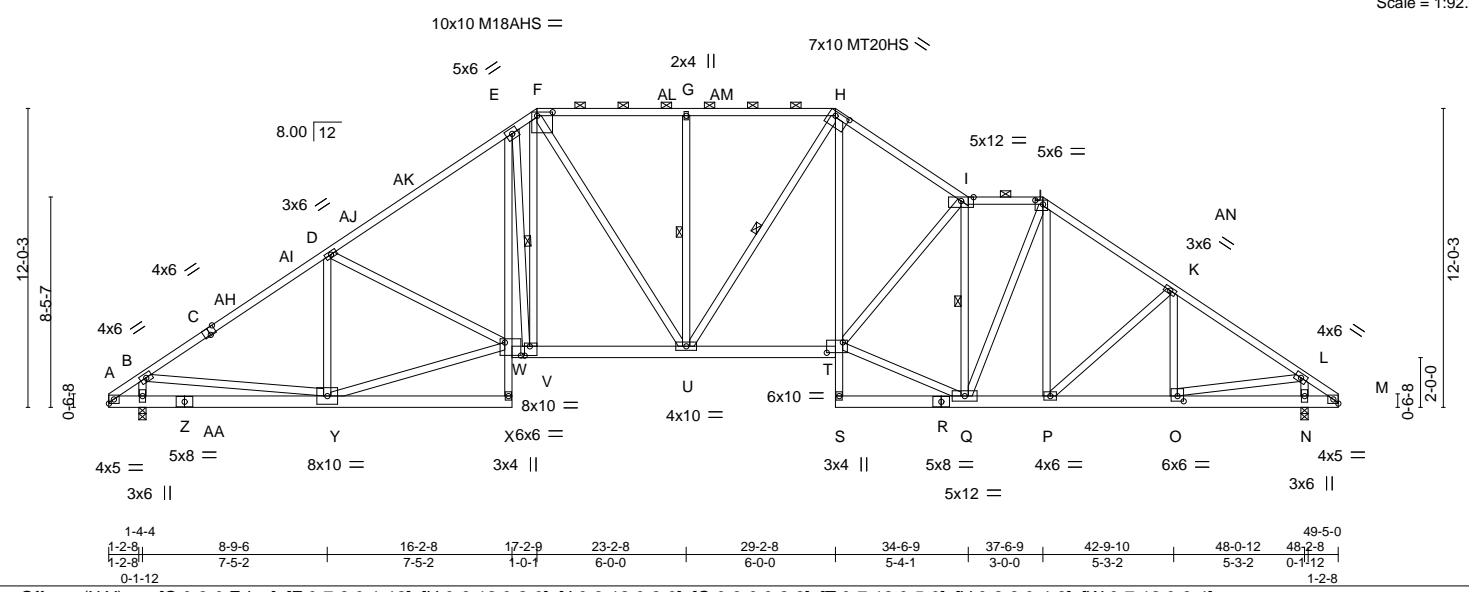


Plate Offsets (X,Y)-- [C:0-3-0,Edge], [F:0-7-8,0-1-12], [H:0-6-12,0-2-0], [J:0-3-12,0-2-0], [O:0-3-0,0-2-8], [T:0-7-12,0-5-0], [V:0-2-8,0-4-8], [W:0-7-12,0-6-4]

LOADING (psf)	SPACING-	CSL	DEFL.	PLATES	GRIP
TCLL 25.0	Plate Grip DOL 1.15	TC 1.00	Vert(LL) -0.29 in (loc) l/defl >999 L/d 240	MT20	244/190
(Roof Snow=25.0)	Lumber DOL 1.15	BC 0.92	Vert(CT) -0.47 T-U >999 180	MT20HS	187/143
TCDL 10.0	Rep Stress Incr YES	WB 0.97	Horz(CT) 0.21 N n/a n/a	M18AHS	186/179
BCLL 0.0	Code IRC2018/TPI2014	Matrix-MS			Weight: 427 lb FT = 20%
BCDL 10.0					

LUMBER-	BRACING-
TOP CHORD 2x4 SP 1650F 1.5E *Except* I-J,J-M,A-C: 2x4 SP No.2	TOP CHORD Structural wood sheathing directly applied, except 2-0-0 oc purlins (3-1-4 max.): F-H, I-J.
BOT CHORD 2x6 SP No.1 *Except* E-X: 2x4 SP No.2, H-S: 2x4 SP No.3	BOT CHORD Rigid ceiling directly applied or 10-0-0 oc bracing, Except: 2-2-0 oc bracing: W-X.
WEBS 2x4 SP No.3 *Except* W-Y,Q-T: 2x4 SP No.2	WEBS 1 Row at midpt E-V, G-U, H-U, I-Q

REACTIONS. (size) AA=0-3-8, N=0-3-8
 Max Horz AA=-287(LC 8)
 Max Uplift AA=174(LC 12), N=-204(LC 13)
 Max Grav AA=2683(LC 36), N=2890(LC 36)

FORCES. (lb) - Max. Comp./Max. Ten. - All forces 250 (lb) or less except when shown.

TOP CHORD A-B=-464/0, B-D=-3499/341, D-E=-3695/437, E-F=-3437/551, F-G=-2925/448, G-H=-2925/448, H-I=-3612/480, I-J=-2907/427, J-K=-3234/412, K-L=-3403/335, L-M=-355/15

BOT CHORD A-AA=-69/549, Y-AA=-282/699, E-W=-48/782, V-W=-184/2671, U-V=-169/2639, T-U=-67/2832, H-T=-124/1555, P-Q=-123/2505, O-P=-187/2684, N-O=-33/391, M-N=-33/391

WEBS B-AA=-2485/389, B-Y=-125/2252, D-Y=-1038/168, W-Y=-215/2642, D-W=-70/524, E-V=-1487/310, F-V=-338/1677, F-U=-199/764, G-U=-874/192, H-U=-235/264, Q-T=-169/3083, I-T=-170/302, I-Q=-2309/237, J-Q=-111/1248, J-P=-57/340, K-P=-331/198, K-O=-465/114, L-O=-182/2337, L-N=-2617/311

- NOTES-**
- Wind: ASCE 7-16; Vult=115mph (3-second gust) Vasd=91mph; TCDL=6.0psf; BCDL=6.0psf; h=20ft; Cat. II; Exp C; Enclosed; MWFRS (envelope) gable end zone and C-C Exterior(2E) 0-0-0 to 4-11-5, Interior(1) 4-11-5 to 12-3-4, Exterior(2R) 12-3-4 to 22-1-13, Interior(1) 22-1-13 to 24-4-15, Exterior(2R) 24-4-15 to 29-4-4, Exterior(2E) 29-4-4 to 34-6-9, Exterior(2R) 34-6-9 to 42-5-14, Interior(1) 42-5-14 to 44-5-11, Exterior(2E) 44-5-11 to 49-5-0 zone; cantilever left and right exposed; end vertical left and right exposed; C-C for members and forces & MWFRS for reactions shown; Lumber DOL=1.33 plate grip DOL=1.33
 - TCLL: ASCE 7-16; Pf=25.0 psf (Lum DOL=1.15 Plate DOL=1.15); Is=1.0; Rough Cat C; Fully Exp.; Ce=0.9; Cs=1.00; Ct=1.10
 - Unbalanced snow loads have been considered for this design.
 - Provide adequate drainage to prevent water ponding.
 - All plates are MT20 plates unless otherwise indicated.
 - This truss has been designed for a 10.0 psf bottom chord live load nonconcurrent with any other live loads.
 - Provide mechanical connection (by others) of truss to bearing plate capable of withstanding 100 lb uplift at joint(s) except (jt=lb) AA=174, N=204.
 - This truss is designed in accordance with the 2018 International Residential Code sections R502.11.1 and R802.10.2 and referenced standard ANSI/TPI 1.
 - Graphical purlin representation does not depict the size or the orientation of the purlin along the top and/or bottom chord.



November 27, 2024

Job	Truss	Truss Type	Qty	Ply	GENE BOSLEY RES. / ROOF
242042	03	Piggyback Base	1	1	

AS NOTED FOR PLAN REVIEW
DEVELOPMENT SERVICES

LEE'S SUMMIT, MISSOURI

Heartland Truss, Inc. Plattsburg, MO - 64477,

8.730 s Oct 31 2024 MiTek Industries, Inc. Wed Nov 27 09:20:24 Page 1

ID: mrcY1X_2FQFIxm9hpx4TmyPVL_jVaOqVMVvskDgnhfZyk38j9Z71CY Pp1U7z2Vt2U

12/02/2024



10x10 M18AHS =

Scale = 1:91.0

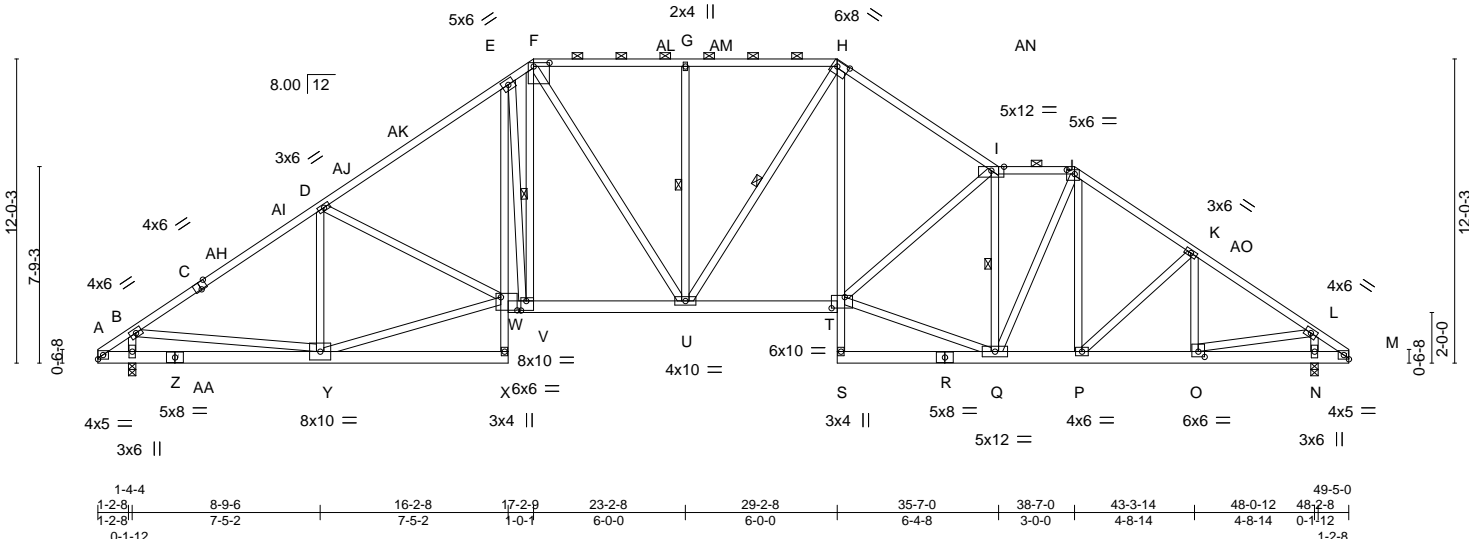


Plate Offsets (X, Y)-- [C:0-3-0,Edge], [F:0-7-8,0-1-12], [H:0-5-8,0-2-8], [J:0-3-12,0-2-0], [O:0-3-0,0-2-8], [T:0-6-4,0-5-4], [V:0-2-8,0-4-8], [W:0-7-12,0-6-4]

LOADING (psf)	SPACING-	CSI.	DEFL.	PLATES	GRIP
TCLL 25.0	Plate Grip DOL 1.15	TC 1.00	in (loc) l/defl L/d	MT20 244/190	M18AHS 186/179
(Roof Snow=25.0)	Lumber DOL 1.15	BC 0.92	Vert(LL) -0.29 X >999 240		
TCDL 10.0	Rep Stress Incr YES	WB 0.97	Vert(CT) -0.46 T-U >999 180		
BCLL 0.0	Code IRC2018/TPI2014	Matrix-MS	Horz(CT) 0.21 N n/a n/a		
BCDL 10.0				Weight: 423 lb	FT = 20%

LUMBER-	BRACING-
TOP CHORD 2x4 SP No.2 *Except* C-F,F-H: 2x4 SP 1650F 1.5E, H-I: 2x4 SP 2400F 2.0E	TOP CHORD Structural wood sheathing directly applied, except 2-0-0 oc purlins (2-10-15 max.): F-H, I-J.
BOT CHORD 2x6 SP No.1 *Except* E-X: 2x4 SP No.2, H-S: 2x4 SP No.3	BOT CHORD Rigid ceiling directly applied or 10-0-0 oc bracing, Except: 2-2-0 oc bracing: W-X.
WEBS 2x4 SP No.3 *Except* W-Y,Q-T: 2x4 SP No.2	WEBS 1 Row at midpt E-V, G-U, H-U, I-Q

REACTIONS. (size) AA=0-3-8, N=0-3-8
 Max Horz AA=-287(LC 8)
 Max Uplift AA=-174(LC 12), N=-204(LC 13)
 Max Grav AA=2689(LC 36), N=2884(LC 36)

FORCES. (lb) - Max. Comp./Max. Ten. - All forces 250 (lb) or less except when shown.
 TOP CHORD A-B=-465/0, B-D=-3508/361, D-E=-3708/459, E-F=-3448/573, F-G=-2911/474,
 G-H=-2911/474, H-I=-3670/501, I-J=-3069/452, J-K=-3274/429, K-L=-3329/346,
 L-M=-336/17
 BOT CHORD A-AA=-69/549, Y-AA=-282/699, E-W=-46/785, V-W=-179/2681, U-V=-164/2649,
 T-U=-84/2850, H-T=-119/1498, P-Q=-154/2556, O-P=-203/2637, N-O=-25/347,
 M-N=-25/347
 WEBS B-AA=-2490/401, B-Y=-139/2259, D-Y=-1042/169, W-Y=-215/2649, D-W=-70/521,
 E-V=-1487/310, F-V=-337/1676, F-U=-198/757, G-U=-871/193, H-U=-252/267,
 Q-T=-215/3163, I-T=-299/254, I-Q=-2266/285, J-Q=-144/1344, J-P=-55/270,
 K-O=-544/119, L-O=-201/2344, L-N=-2573/309

- NOTES-**
- Wind: ASCE 7-16; Vult=115mph (3-second gust) Vasd=91mph; TCDL=6.0psf; BCDL=6.0psf; h=20ft; Cat. II; Exp C; Enclosed; MWFRS (envelope) gable end zone and C-C Exterior(2E) 0-0-0 to 4-11-5, Interior(1) 4-11-5 to 12-3-4, Exterior(2R) 12-3-4 to 22-1-13, Interior(1) 22-1-13 to 24-4-15, Exterior(2R) 24-4-15 to 34-3-9, Interior(1) 34-3-9 to 35-7-0, Exterior(2R) 35-7-0 to 43-3-14, Interior(1) 43-3-14 to 44-5-11, Exterior(2E) 44-5-11 to 49-5-0 zone; cantilever left and right exposed; end vertical left and right exposed; C-C for members and MWFRS for reactions shown; Lumber DOL=1.33 plate grip DOL=1.33
 - TCLL: ASCE 7-16; Pf=25.0 psf (Lum DOL=1.15 Plate DOL=1.15); Is=1.0; Rough Cat C; Fully Exp.; Ce=0.9; Cs=1.00; Ct=1.10
 - Unbalanced snow loads have been considered for this design.
 - Provide adequate drainage to prevent water ponding.
 - All plates are MT20 plates unless otherwise indicated.
 - This truss has been designed for a 10.0 psf bottom chord live load nonconcurrent with any other live loads.
 - Provide mechanical connection (by others) of truss to bearing plate capable of withstanding 100 lb uplift at joint(s) except (jt=lb) AA=174, N=204.
 - This truss is designed in accordance with the 2018 International Residential Code sections R502.11.1 and R802.10.2 and referenced standard ANSI/TPI 1.
 - Graphical purlin representation does not depict the size or the orientation of the purlin along the top and/or bottom chord.



November 27, 2024

WARNING - Verify design parameters and READ NOTES ON THIS AND INCLUDED MITEK REFERENCE PAGE MII-7473 rev. 1/2/2023 BEFORE USE.

Design valid for use only with MiTek® connectors. This design is based only upon parameters shown, and is for an individual building component, not a truss system. Before use, the building designer must verify the applicability of the design parameters and properly incorporate this design into the overall building design. Bracing indicated is to prevent buckling of individual truss web and/or chord members only. Additional temporary and permanent bracing is always required for stability and to prevent collapse with possible personal injury and property damage. For general guidance regarding the fabrication, storage, delivery, erection and bracing of trusses and truss systems, see **ANSI/TPI1 Quality Criteria, and DSB-22** available from Truss Plate Institute (www.tpinst.org) and **BCSI Building Component Safety Information** available from the Structural Building Component Association (www.sbcsccomponents.com)

MiTek®
 16023 Swingley Ridge Rd.
 Chesterfield, MO 63017
 314.434.1200 / MiTek-US.com

AS NOTED FOR PLAN REVIEW
DEVELOPMENT SERVICES
LEE'S SUMMIT, MISSOURI

Job	Truss	Truss Type	Qty	Ply	GENE BOSLEY RES. / ROOF
242042	04	Piggyback Base	1	1	

Heartland Truss, Inc, Plattsburg, MO - 64477,

8.730 s Oct 31 2024 MiTek Industries, Inc. Wed Nov 27 07:39:11 2024 Page 1

ID: mrcY1X_2FQFIxm9hpx4TmyPVL_fui8FANIRU_xv5r2NmXvZcVVWbCIB4BrgE12Yf21

12/02/2024



Scale = 1:91.3

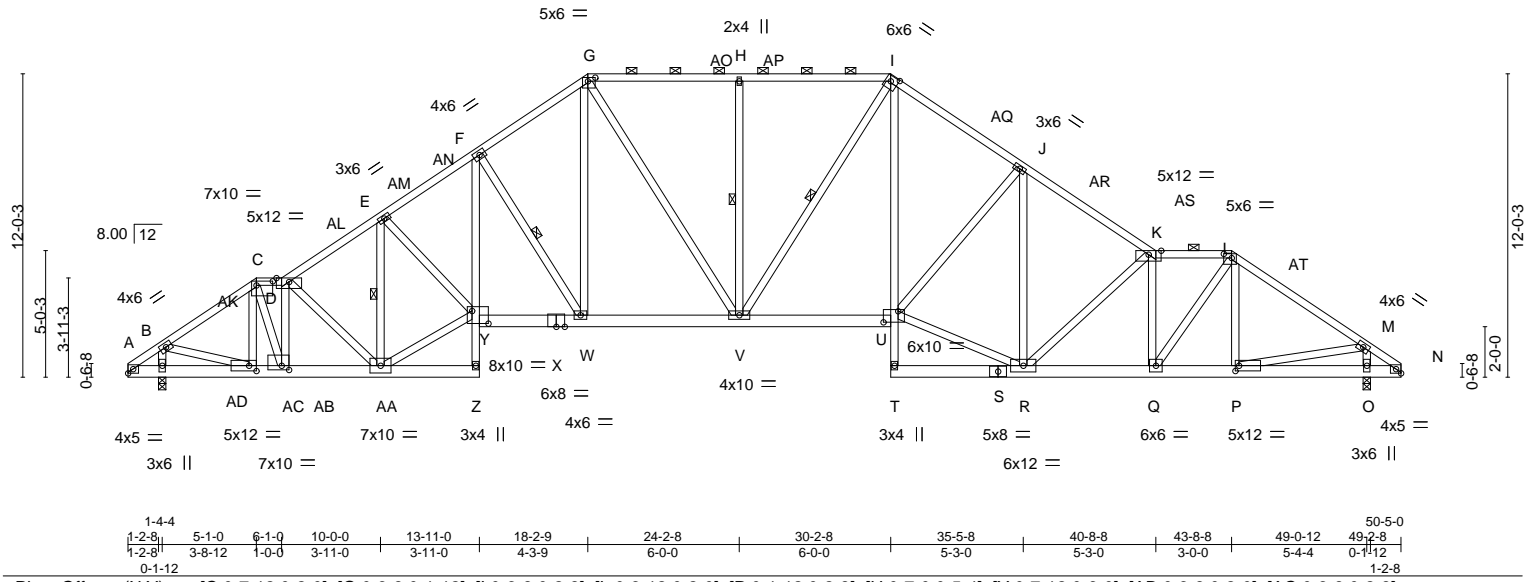


Plate Offsets (X, Y)-- [C:0-7-12,0-2-0], [G:0-3-8,0-1-12], [I:0-3-8,0-2-8], [L:0-3-12,0-2-0], [P:0-1-12,0-2-8], [U:0-7-0,0-5-4], [Y:0-7-12,0-6-0], [AB:0-3-8,0-2-0], [AC:0-3-8,0-2-8]

LOADING (psf)	SPACING-	CSI.	DEFL.	PLATES	GRIP
TCLL 25.0	Plate Grip DOL 1.15	TC 0.99	in (loc) l/def L/d	MT20	244/190
(Roof Snow=25.0)	Lumber DOL 1.15	BC 0.81	Vert(LL) -0.34 U-V >999 240		
TCDL 10.0	Rep Stress Incr YES	WB 0.98	Vert(CT) -0.55 U-V >999 180		
BCLL 0.0	Code IRC2018/TPI2014	Matrix-MS	Horz(CT) 0.25 O n/a n/a		
BCDL 10.0				Weight: 424 lb	FT = 20%

LUMBER-	BRACING-
TOP CHORD 2x4 SP No.2 *Except* G-I,I-K: 2x4 SP 1650F 1.5E	TOP CHORD Structural wood sheathing directly applied, except 2-0-0 oc purlins (2-7-13 max.): C-D, G-I, K-L.
BOT CHORD 2x6 SP No.1 *Except* A-Z: 2x6 SP 2400F 2.0E, F-Z,I-T: 2x4 SP No.3	BOT CHORD Rigid ceiling directly applied or 10-0-0 oc bracing.
WEBS 2x4 SP No.3 *Except* Y-AA,R-U: 2x4 SP No.2	WEBS 1 Row at midpt E-AA, F-W, H-V, I-V

REACTIONS. (size) AD=0-3-8, O=0-3-8
 Max Horz AD=-287(LC 8)
 Max Uplift AD=-185(LC 12), O=-205(LC 13)
 Max Grav AD=2997(LC 40), O=2919(LC 40)

FORCES. (lb) - Max. Comp./Max. Ten. - All forces 250 (lb) or less except when shown.
 TOP CHORD A-B=-330/15, B-C=-3267/291, C-D=-3280/328, D-E=-3826/403, E-F=-4689/499,
 F-G=-3618/489, G-H=-3018/476, H-I=-3018/476, I-J=-3902/511, J-K=-3928/465,
 K-L=-3913/444, L-M=-3415/342, M-N=-354/14
 BOT CHORD A-AD=-12/313, AC-AD=-272/470, AB-AC=-273/2616, AA-AB=-297/3191, F-Y=-144/1504,
 W-Y=-198/3807, V-W=-139/2842, U-V=-87/3037, I-U=-140/1744, Q-R=-293/3858,
 P-Q=-183/2668, O-P=-57/449, N-O=-57/449
 WEBS B-AD=-2646/281, B-AC=-164/2372, C-AC=-610/70, C-AB=-190/2165, D-AB=-2164/224,
 E-AA=-1673/129, Y-AA=-252/3526, E-Y=-41/988, F-W=-1724/285, G-W=-160/1281,
 G-V=-191/747, H-V=-890/192, I-V=-237/335, R-U=-194/3382, J-U=-289/330, J-R=-647/80,
 K-R=-945/182, K-Q=-1774/220, L-Q=-207/2219, L-P=-409/83, M-P=-153/2250,
 M-O=-2767/362

- NOTES-**
- Wind: ASCE 7-16; Vult=115mph (3-second gust) Vasd=91mph; TCDL=6.0psf; BCDL=6.0psf; h=20ft; Cat. II; Exp C; Enclosed; MWFRS (envelope) gable end zone and C-C Exterior(2E) 0-0-0 to 6-1-0, Interior(1) 6-1-0 to 13-2-0, Exterior(2R) 13-2-0 to 23-3-1, Interior(1) 23-3-1 to 25-3-12, Exterior(2R) 25-3-12 to 35-5-8, Interior(1) 35-5-8 to 40-8-8, Exterior(2R) 40-8-8 to 45-4-8, Exterior(2E) 45-4-8 to 50-5-0 zone; cantilever left and right exposed; end vertical left and right exposed; C-C for members and forces & MWFRS for reactions shown; Lumber DOL=1.33 plate grip DOL=1.33
 - TCLL: ASCE 7-16; Pf=25.0 psf (Lum DOL=1.15 Plate DOL=1.15); Is=1.0; Rough Cat C; Fully Exp.; Ce=0.9; Cs=1.00; Ct=1-10
 - Unbalanced snow loads have been considered for this design.
 - Provide adequate drainage to prevent water ponding.
 - This truss has been designed for a 10.0 psf bottom chord live load nonconcurrent with any other live loads.
 - Provide mechanical connection (by others) of truss to bearing plate capable of withstanding 100 lb uplift at joint(s) except (jt=lb) AD=185, O=205.
 - This truss is designed in accordance with the 2018 International Residential Code sections R502.11.1 and R802.10.2 and referenced standard ANSI/TPI 1.
 - Graphical purlin representation does not depict the size or the orientation of the purlin along the top and/or bottom chord.



November 27, 2024

WARNING - Verify design parameters and READ NOTES ON THIS AND INCLUDED MITEK REFERENCE PAGE MII-7473 rev. 12/2023 BEFORE USE.

Design valid for use only with MiTek® connectors. This design is based only upon parameters shown, and is for an individual building component, not a truss system. Before use, the building designer must verify the applicability of design parameters and properly incorporate this design into the overall building design. Bracing indicated is to prevent buckling of individual truss web and/or chord members only. Additional temporary and permanent bracing is always required for stability and to prevent collapse with possible personal injury and property damage. For general guidance regarding the fabrication, storage, delivery, erection and bracing of trusses and truss systems, see ANSI/TPI1 Quality Criteria, and DSB-22 available from Truss Plate Institute (www.tpinst.org) and BCSI Building Component Safety Information available from the Structural Building Component Association (www.sbcscomponents.com)



Job	Truss	Truss Type	Qty	Ply	GENE BOSLEY RES. / ROOF
242042	05	Piggyback Base	1	1	

AS NOTED FOR PLAN REVIEW
DEVELOPMENT SERVICES
LEE'S SUMMIT, MISSOURI

Heartland Truss, Inc. Plattsburg, MO - 64477,

8.730 s Oct 31 2024 MiTek Industries, Inc. Wed Nov 27 07:39:12 2024 Page 5

ID: mrcY1X_2FQFIXm9hhpx4TmyPVL_74GWSWONCn6nXFQEE5HmRmLnpxkVQDPxarYLWf21z

12/02/2024

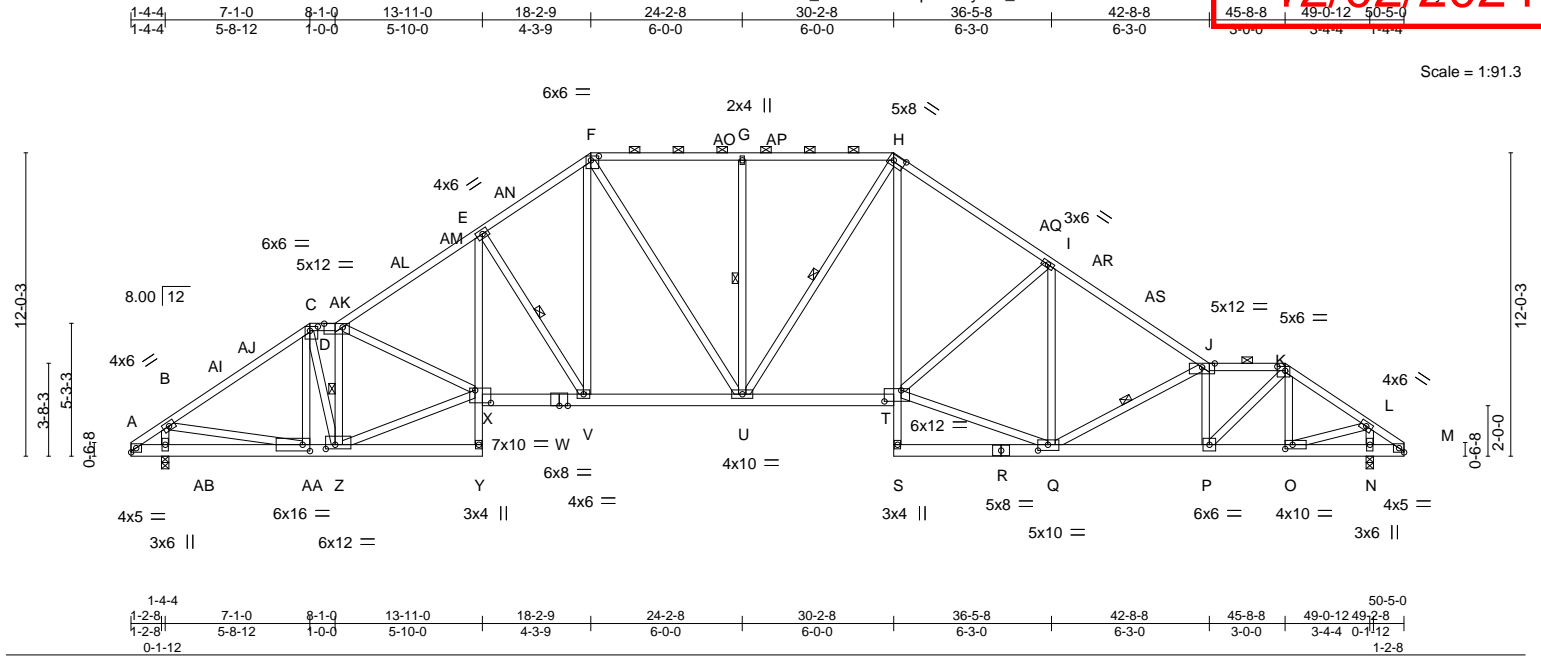


Plate Offsets (X, Y)-- [C:0-3-12,0-2-0], [D:0-8-12,0-1-12], [F:0-3-12,0-2-0], [H:0-5-8,0-2-8], [K:0-3-12,0-2-0], [O:0-3-8,0-2-0], [Q:0-4-12,0-2-12], [T:0-8-0,0-5-4], [X:0-7-8,0-6-0], [Z:0-4-8,0-2-0], [AA:0-3-8,0-3-0]

LOADING (psf)	SPACING-	CSI.	DEFL.	PLATES	GRIP
TCLL 25.0	Plate Grip DOL 1.15	TC 0.79	Vert(LL) -0.33 T-U >999 240	MT20	244/190
(Roof Snow=25.0)	Lumber DOL 1.15	BC 0.86	Vert(CT) -0.53 T-U >999 180		
TCDL 10.0	Rep Stress Incr YES	WB 0.95	Horz(CT) 0.25 N n/a n/a		
BCLL 0.0	Code IRC2018/TPI2014	Matrix-MS		Weight: 413 lb	FT = 20%
BCDL 10.0					

LUMBER-	BRACING-
TOP CHORD 2x4 SP No.2 *Except* A-C,F-H: 2x4 SP 1650F 1.5E, D-F,H-J: 2x4 SP 2400F 2.0E	TOP CHORD Structural wood sheathing directly applied or 2-2-0 oc purlins, except 2-0-0 oc purlins (2-5-8 max.): C-D, F-H, J-K.
BOT CHORD 2x6 SP No.1 *Except* A-Y: 2x6 SP 2400F 2.0E, E-Y,H-S: 2x4 SP No.3	BOT CHORD Rigid ceiling directly applied or 10-0-0 oc bracing.
WEBS 2x4 SP No.3 *Except* X-Z,Q-T,K-P: 2x4 SP No.2	WEBS 1 Row at midpt D-Z, E-V, G-U, H-U, J-Q

REACTIONS. (size) AB=0-3-8, N=0-3-8
Max Horz AB=287(LC 9)
Max Uplift AB=185(LC 12), N=205(LC 13)
Max Grav AB=3012(LC 40), N=2904(LC 40)

FORCES. (lb) - Max. Comp./Max. Ten. - All forces 250 (lb) or less except when shown.
TOP CHORD A-B=-432/4, B-C=-3588/339, C-D=-3210/360, D-E=-4697/495, E-F=-3648/498, F-G=-3035/477, G-H=-3035/477, H-I=-3971/500, I-J=-4213/451, J-K=-4479/449, K-L=-3056/291, L-M=-252/18
BOT CHORD A-AB=-55/529, AA-AB=-281/663, Z-AA=-251/2804, E-X=-93/1277, V-X=-199/3808, U-V=-130/2849, T-U=-93/3063, H-T=-122/1712, P-Q=-341/4387, O-P=-171/2451
WEBS B-AB=-2832/368, B-AA=-137/2304, C-AA=-320/46, C-Z=-142/1779, D-Z=-3042/293, X-Z=-267/3243, D-X=-27/773, E-V=-1717/296, F-V=-172/1310, F-U=-187/723, G-U=-886/192, H-U=-235/357, Q-T=-217/3517, I-T=-466/279, I-Q=-539/88, J-Q=-1159/193, J-P=-2089/254, K-P=-263/2941, K-O=-709/92, L-O=-177/2292, L-N=-2598/282

- NOTES-
- Wind: ASCE 7-16; Vult=115mph (3-second gust) Vasd=91mph; TCDL=6.0psf; BCDL=6.0psf; h=20ft; Cat. II; Exp C; Enclosed; MWFRS (envelope) gable end zone and C-C Exterior(2E) 0-0-0 to 5-0-8, Exterior(2R) 5-0-8 to 7-1-0, Exterior(2E) 7-1-0 to 8-1-0, Interior(1) 8-1-0 to 13-2-0, Exterior(2R) 13-2-0 to 23-3-1, Interior(1) 23-3-1 to 25-3-12, Exterior(2R) 25-3-12 to 35-4-12, Interior(1) 35-4-12 to 42-8-8, Exterior(2R) 42-8-8 to 45-8-8, Exterior(2E) 45-8-8 to 50-5-0 zone; cantilever left and right exposed ; end vertical left and right exposed; C-C for members and forces & MWFRS for reactions shown; Lumber DOL=1.33 plate grip DOL=1.33
 - TCLL: ASCE 7-16; Pf=25.0 psf (Lum DOL=1.15 Plate DOL=1.15); Is=1.0; Rough Cat C; Fully Exp.; Ce=0.9; Cs=1.00; Ct=1.10
 - Unbalanced snow loads have been considered for this design.
 - Provide adequate drainage to prevent water ponding.
 - This truss has been designed for a 10.0 psf bottom chord live load nonconcurrent with any other live loads.
 - Provide mechanical connection (by others) of truss to bearing plate capable of withstanding 100 lb uplift at joint(s) except (jt=lb) AB=185, N=205.
 - This truss is designed in accordance with the 2018 International Residential Code sections R502.11.1 and R802.10.2 and referenced standard ANSI/TPI 1.
 - Graphical purlin representation does not depict the size or the orientation of the purlin along the top and/or bottom chord.



November 27, 2024

Job 242042	Truss 06	Truss Type Roof Special Girder	Qty 1	Ply 1	GENE BOSLEY RES. / ROOF	AS NOTED FOR PLAN REVIEW DEVELOPMENT SERVICES LEE'S SUMMIT, MISSOURI
---------------	-------------	-----------------------------------	----------	----------	-------------------------	--

Heartland Truss, Inc, Plattsburg, MO - 64477, 8.730 s Oct 31 2024 MiTek Industries, Inc. Wed Nov 27 17:39:15 2024 Page 1
 ID:mrcY1X_2FQfIXm9hpx4TmyPVI_-Yfyf5YQGUiUMOI8pwDrt3PzCHzW08G_g5TtG99yL2Tjw

12/02/2024

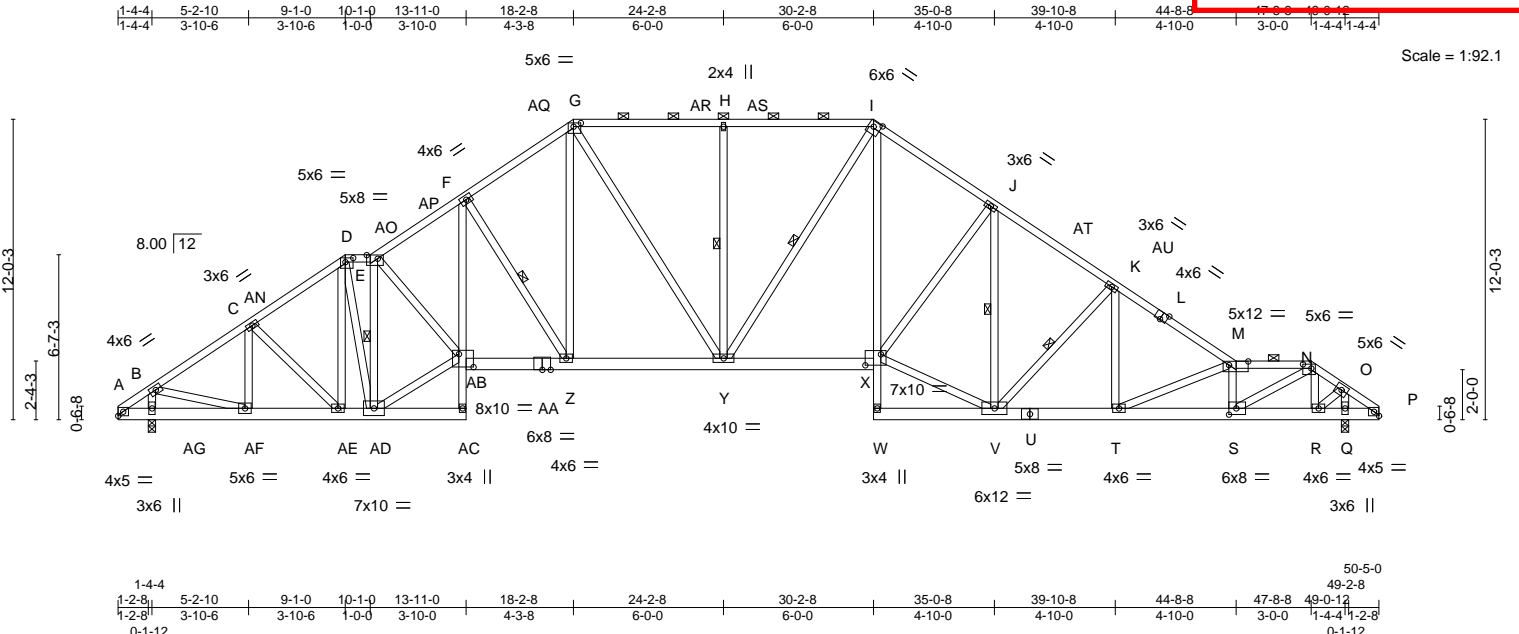


Plate Offsets (X, Y)-- [D:0-3-12,0-2-0], [E:0-5-4,0-1-12], [G:0-3-8,0-1-12], [I:0-3-8,0-2-8], [L:0-3-0,Edge], [M:0-9-4,0-1-12], [N:0-4-0,0-2-0], [S:0-3-8,0-3-0], [X:0-7-8,0-5-4], [AB:0-7-0,0-6-4]

LOADING (psf)	SPACING-	2-0-0	CSI.	DEFL.	in	(loc)	l/defl	L/d	PLATES	GRIP
TCLL 25.0	Plate Grip DOL	1.15	TC 0.94	Vert(LL)	-0.39	X	>999	240	MT20	244/190
(Roof Snow=25.0)	Lumber DOL	1.15	BC 0.92	Vert(CT)	-0.61	X-Y	>933	180		
TCDL 10.0	Rep Stress Incr	NO	WB 0.90	Horz(CT)	0.28	Q	n/a	n/a		
BCLL 0.0	Code IRC2018/TPI2014		Matrix-MS						Weight: 430 lb	FT = 20%
BCDL 10.0										

LUMBER-	BRACING-
TOP CHORD 2x4 SP No.2 *Except* G-I,I-L: 2x4 SP 1650F 1.5E, L-M: 2x4 SP 2400F 2.0E	TOP CHORD Structural wood sheathing directly applied, except 2-0-0 oc purlins (2-3-12 max.): D-E, G-I, M-N.
BOT CHORD 2x6 SP No.1 *Except* A-AC: 2x6 SP 2400F 2.0E, F-AC,I-W: 2x4 SP No.3	BOT CHORD Rigid ceiling directly applied or 10-0-0 oc bracing.
WEBS 2x4 SP No.3 *Except* B-AF,AB-AD,V-X: 2x4 SP No.2, N-S: 2x4 SP 1650F 1.5E	WEBS 1 Row at midpt E-AD, F-Z, H-Y, I-Y, J-V, K-V

REACTIONS. (size) AG=0-3-8, Q=0-3-8
 Max Horz AG=-287(LC 8)
 Max Uplift AG=-186(LC 12), Q=-244(LC 13)
 Max Grav AG=3031(LC 40), Q=2839(LC 40)

FORCES. (lb) - Max. Comp./Max. Ten. - All forces 250 (lb) or less except when shown.
TOP CHORD A-B=-379/17, B-C=-3343/315, C-D=-3560/402, D-E=-3068/388, E-F=-4625/518, F-G=-3650/502, G-H=-3061/481, H-I=-3061/481, I-J=-3963/514, J-K=-3980/468, K-M=-4853/470, M-N=-5386/512, N-O=-2061/218
BOT CHORD A-AG=-9/348, AF-AG=-266/496, AE-AF=-281/2667, AD-AE=-213/2835, F-AB=-130/1388, Z-AB=-210/3822, Y-Z=-119/2864, X-Y=-98/3113, I-X=-145/1790, T-V=-278/3961, S-T=-436/5208, R-S=-146/1753
WEBS B-AG=-2597/278, B-AF=-191/2402, C-AF=-789/121, C-AE=-57/374, D-AD=-114/1287, E-AD=-3358/293, AB-AD=-243/3427, E-AB=-42/1198, F-Z=-1714/287, G-Z=-162/1270, G-Y=-186/701, H-Y=-873/190, I-Y=-250/359, V-X=-188/3457, J-X=-200/458, J-V=-631/110, K-V=-1163/211, K-T=-23/683, M-T=-1346/193, M-S=-2424/267, N-S=-367/4289, N-R=-1265/139, O-R=-189/1982, O-Q=-2424/255

- NOTES-**
- 1) Wind: ASCE 7-16; Vult=115mph (3-second gust) Vasd=91mph; TCDL=6.0psf; BCDL=6.0psf; h=20ft; Cat. II; Exp C; Enclosed; MWFRS (envelope) gable end zone and C-C Exterior(2E) 0-0-0 to 5-2-10, Exterior(2R) 5-2-10 to 9-1-0, Exterior(2E) 9-1-0 to 10-1-0, Interior(1) 10-1-0 to 13-2-0, Exterior(2R) 13-2-0 to 23-3-0, Interior(1) 23-3-0 to 25-2-0, Exterior(2R) 25-2-0 to 35-0-8, Interior(1) 35-0-8 to 44-8-8, Exterior(2R) 44-8-8 to 47-8-8, Exterior(2E) 47-8-8 to 50-5-0 zone; cantilever left and right exposed ; end vertical left and right exposed; C-C for members and forces & MWFRS for reactions shown; Lumber DOL=1.33 plate grip DOL=1.33
 - 2) TCLL: ASCE 7-16; Pf=25.0 psf (Lum DOL=1.15 Plate DOL=1.15); Is=1.0; Rough Cat C; Fully Exp.; Ce=0.9; Cs=1.00; Ct=1.10
 - 3) Unbalanced snow loads have been considered for this design.
 - 4) Provide adequate drainage to prevent water ponding.
 - 5) This truss has been designed for a 10.0 psf bottom chord live load nonconcurrent with any other live loads.
 - 6) Provide mechanical connection (by others) of truss to bearing plate capable of withstanding 100 lb uplift at joint(s) except (jt=lb) AG=186, Q=244.
 - 7) This truss is designed in accordance with the 2018 International Residential Code sections R502.11.1 and R802.10.2 and referenced standard ANSI/TPI 1.
- (3) Graphical representation does not depict the size or the orientation of the purlin along the top and/or bottom chord.



November 27, 2024

WARNING - Verify design parameters and READ NOTES ON THIS AND INCLUDED MITEK REFERENCE PAGE MII-7473 rev. 1/2/2023 BEFORE USE.

Design valid for use only with MiTek® connectors. This design is based only upon parameters shown, and is for an individual building component, not a truss system. Before use, the building designer must verify the applicability of the design parameters and properly incorporate this design into the overall building design. Bracing indicated is to prevent buckling of individual truss web and/or chord members only. Additional temporary and permanent bracing is always required for stability and to prevent collapse with possible personal injury and property damage. For general guidance regarding the fabrication, storage, delivery, erection and bracing of trusses and truss systems, see **ANSI/TPI1 Quality Criteria, and DSB-22** available from Truss Plate Institute (www.tpinst.org) and **BCSI Building Component Safety Information** available from the Structural Building Component Association (www.sbcsccomponents.com)

16023 Swingley Ridge Rd.
Chesterfield, MO 63017
314.434.1200 / MiTek-US.com

Job	Truss	Truss Type	Qty	Ply	Job Reference (optional)
242042	06	Roof Special Girder	1	1	GENE BOSLEY RES. / ROOF

RELEASE FOR CONSTRUCTION
AS NOTED FOR PLAN REVIEW
DEVELOPMENT SERVICES
LEE'S SUMMIT, MISSOURI

Heartland Truss, Inc, Plattsburg, MO - 64477,

8.730 s Oct 31 2024 MiTek Industries, Inc. Wed Nov 27 07:39:15 2024 Page 2

ID:mrCY1X_2FQFIXm9hhpx4TmyPVI_-Yfyf5YQGUiUMOi8pwDrT3PzCH_2W08G_g5TcS9yE2Jw

12/02/2024

NOTES-

- 9) Hanger(s) or other connection device(s) shall be provided sufficient to support concentrated load(s) 95 lb up at 47-8-8 on top chord, and 65 lb up at 47-8-8 on bottom chord. The design/selection of such connection device(s) is the responsibility of others.
- 10) In the LOAD CASE(S) section, loads applied to the face of the truss are noted as front (F) or back (B).

LOAD CASE(S) Standard

1) Dead + Snow (balanced): Lumber Increase=1.15, Plate Increase=1.15

Uniform Loads (plf)

Vert: A-D=-70, D-E=-70, E-G=-70, G-I=-70, I-M=-70, M-N=-70, N-P=-70, AC-AH=-20, X-AB=-20, W-AK=-20

Concentrated Loads (lb)

Vert: N=29(B) R=31(B)

WARNING - Verify design parameters and READ NOTES ON THIS AND INCLUDED MITEK REFERENCE PAGE MII-7473 rev. 1/2/2023 BEFORE USE.

Design valid for use only with MiTek® connectors. This design is based only upon parameters shown, and is for an individual building component, not a truss system. Before use, the building designer must verify the applicability of design parameters and properly incorporate this design into the overall building design. Bracing indicated is to prevent buckling of individual truss web and/or chord members only. Additional temporary and permanent bracing is always required for stability and to prevent collapse with possible personal injury and property damage. For general guidance regarding the fabrication, storage, delivery, erection and bracing of trusses and truss systems, see **ANSI/TPI1 Quality Criteria, and DSB-22** available from Truss Plate Institute (www.tpinst.org) and **BCSI Building Component Safety Information** available from the Structural Building Component Association (www.sbcsccomponents.com)

MiTek®

16023 Swingley Ridge Rd.
 Chesterfield, MO 63017
 314.434.1200 / MiTek-US.com

Job	Truss	Truss Type	Qty	Ply	GENE BOSLEY RES. / ROOF
242042	07	Roof Special	1	1	

RELEASED FOR CONSTRUCTION
 AS NOTED FOR PLAN REVIEW
 DEVELOPMENT SERVICES
 LEE'S SUMMIT, MISSOURI

Heartland Truss, Inc, Plattsburg, MO - 64477,

8.730 s Oct 31 2024 MiTek Industries, Inc. Wed Nov 27 07:39:16 2024 Page 1

ID: mrcY1X_2FQF1Xm9hhpx4TmyPVL_OrV1luRuF0cD0s?TwmiccWNGOHftipk7y7b7yF2

12/02/2024

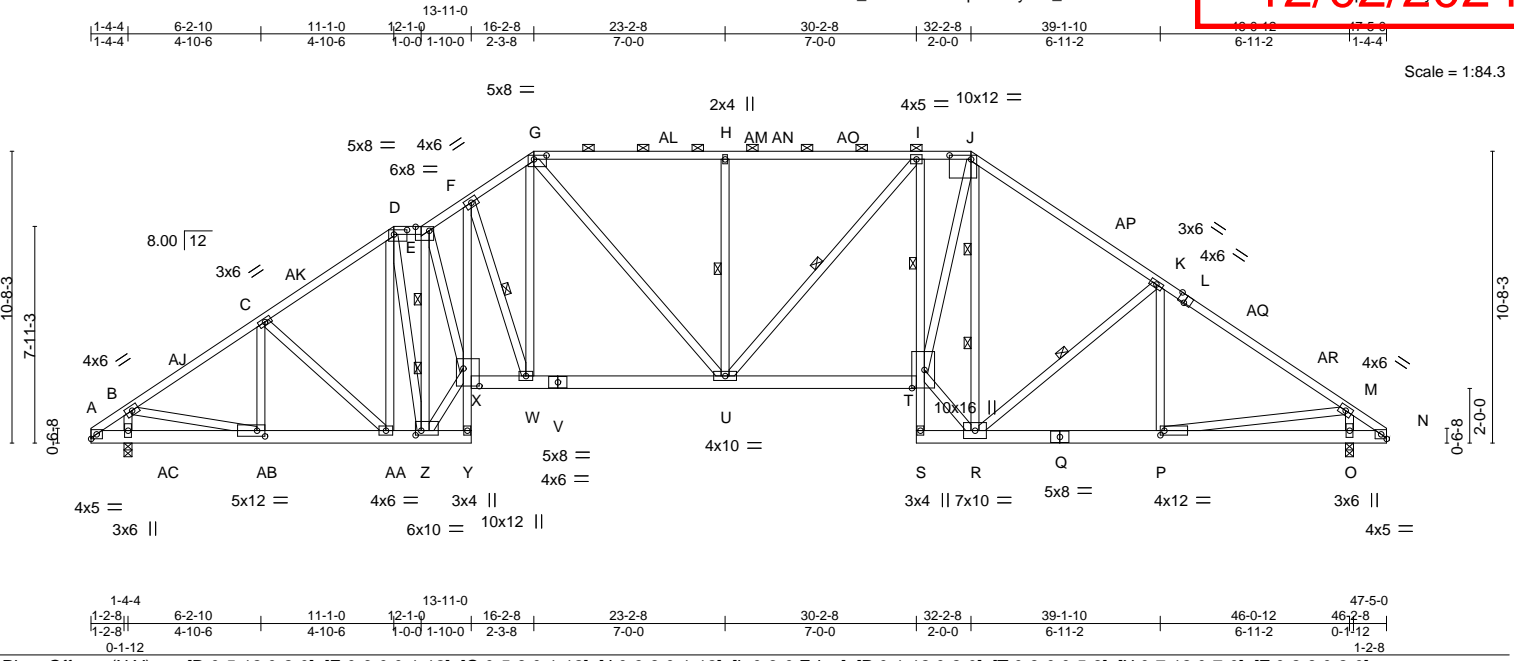


Plate Offsets (X, Y)-- [D:0-5-12,0-2-0], [E:0-6-0,0-1-12], [G:0-5-8,0-1-12], [J:0-9-8,0-1-12], [L:0-3-0,Edge], [P:0-1-12,0-2-0], [T:0-8-0,0-5-8], [X:0-7-12,0-7-0], [Z:0-2-8,0-2-0], [AB:0-3-8,0-2-8]


LOADING (psf)	SPACING-	2-0-0	CSI.	DEFL.	in (loc)	l/defl	L/d	PLATES	GRIP
TCLL 25.0	Plate Grip DOL	1.15	TC 0.94	Vert(LL)	-0.38	T-U	>999	MT20	244/190
(Roof Snow=25.0)	Lumber DOL	1.15	BC 0.88	Vert(CT)	-0.60	T-U	>889		
TCDL 10.0	Rep Stress Incr	YES	WB 1.00	Horz(CT)	0.42	O	n/a		
BCLL 0.0	Code IRC2018/TPI2014		Matrix-MS					Weight: 412 lb	FT = 20%
BCDL 10.0									

LUMBER-	BRACING-
TOP CHORD 2x4 SP No.2 *Except* G-J: 2x4 SP 2400F 2.0E, J-L-L-N: 2x4 SP 1650F 1.5E	TOP CHORD Structural wood sheathing directly applied, except 2-0-0 oc purlins (3-2-7 max.): D-E, G-J.
BOT CHORD 2x6 SP No.1 *Except* F-Y: 2x4 SP No.2, I-S: 2x4 SP No.3	BOT CHORD Rigid ceiling directly applied or 10-0-0 oc bracing, Except: 6-0-0 oc bracing: X-Y,S-T.
WEBS 2x4 SP No.3 *Except* E-Z,X-Z,E-X,R-T,J-T: 2x4 SP No.2	WEBS 1 Row at midpt I-T 1 Row at midpt F-W, H-U, I-U, K-R 2 Rows at 1/3 pts E-Z, J-R

REACTIONS. (size) AC=0-3-8, O=0-3-8
 Max Horz AC=-253(LC 8)
 Max Uplift AC=-167(LC 12), O=-155(LC 13)
 Max Grav AC=2689(LC 36), O=2533(LC 36)

FORCES. (lb) - Max. Comp./Max. Ten. - All forces 250 (lb) or less except when shown.
 TOP CHORD A-B=-314/6, B-C=-3080/317, C-D=-2965/393, D-E=-2457/381, E-F=-3841/495,
 F-G=-3442/483, G-H=-3407/452, H-I=-3407/452, I-J=-3102/429, J-K=-2739/404,
 K-M=-3192/331, M-N=-445/0
 BOT CHORD A-AC=-16/343, AB-AC=-245/469, AA-AB=-232/2423, Z-AA=-195/2311, F-X=-178/1451,
 W-X=-265/3279, U-W=-216/2861, T-U=-108/3129, I-T=-959/287, P-R=-162/2506,
 O-P=-58/547, N-O=-58/547
 WEBS B-AC=-2420/295, B-AB=-176/2127, C-AB=-472/110, C-AA=-250/257, D-Z=-79/1163,
 E-Z=-4433/292, X-Z=-336/4094, E-X=-205/2814, F-W=-1648/250, G-W=-160/1254,
 G-U=-205/847, H-U=-1004/213, I-U=-155/436, R-T=-85/3361, J-T=-293/3748,
 J-R=-2292/203, K-R=-614/226, K-P=-264/114, M-P=-138/1981, M-O=-2375/354

- NOTES-**
- 1) Wind: ASCE 7-16; Vult=115mph (3-second gust) Vasd=91mph; TCDL=6.0psf; BCDL=6.0psf; h=20ft; Cat. II; Exp C; Enclosed; MWFRS (envelope) gable end zone and C-C Exterior(2E) 0-0-0 to 4-8-14, Interior(1) 4-8-14 to 6-2-10, Exterior(2R) 6-2-10 to 11-1-0, Exterior(2E) 11-1-0 to 12-1-0, Exterior(2R) 12-1-0 to 20-11-6, Interior(1) 20-11-6 to 27-5-10, Exterior(2R) 27-5-10 to 36-11-6, Interior(1) 36-11-6 to 42-8-2, Exterior(2E) 42-8-2 to 47-5-0 zone; cantilever left and right exposed ; end vertical left and right exposed;C-C for members and forces & MWFRS for reactions shown; Lumber DOL=1.33 plate grip DOL=1.33
 - 2) TCLL: ASCE 7-16; Pf=25.0 psf (Lum DOL=1.15 Plate DOL=1.15); Is=1.0; Rough Cat C; Fully Exp.; Ce=0.9; Cs=1.00; Ct=1.0
 - 3) Unbalanced snow loads have been considered for this design.
 - 4) Provide adequate drainage to prevent water ponding.
 - 5) This truss has been designed for a 10.0 psf bottom chord live load nonconcurrent with any other live loads.
 - 6) Provide mechanical connection (by others) of truss to bearing plate capable of withstanding 100 lb uplift at joint(s) except (jt=lb) AC=167, O=155.
 - 7) This truss is designed in accordance with the 2018 International Residential Code sections R502.11.1 and R802.10.2 and referenced standard ANSI/TPI 1.
 - 8) Graphical purlin representation does not depict the size or the orientation of the purlin along the top and/or bottom chord.

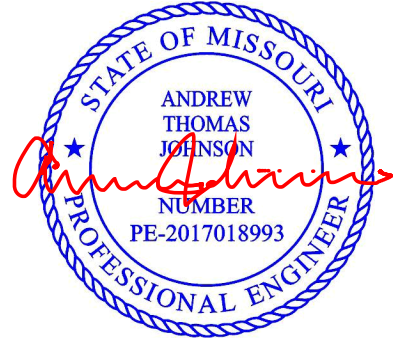

November 27, 2024

Job	Truss	Truss Type	Qty	Ply	GENE BOSLEY RES. / ROOF
242042	08	Roof Special	1	1	

AS NOTED FOR PLAN REVIEW
DEVELOPMENT SERVICES
LEE'S SUMMIT, MISSOURI


6887585

Heartland Truss, Inc, Plattsburg, MO - 64477,

8.730 s Oct 31 2024 MiTek Industries, Inc. Wed Nov 27 07:39:17 2024 Page 1

ID: mrcY1X_2FQFIXm9hhpx4TmyPVL_U23PWESW0K14d IC1etx8c2YEdogM9zZnhVElyE2j 47-5-0

12/02/2024

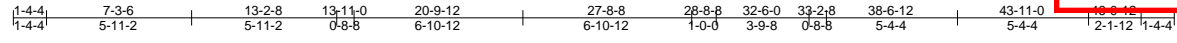

Scale = 1:94.1

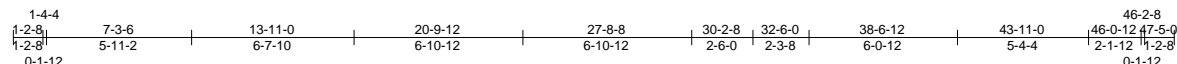
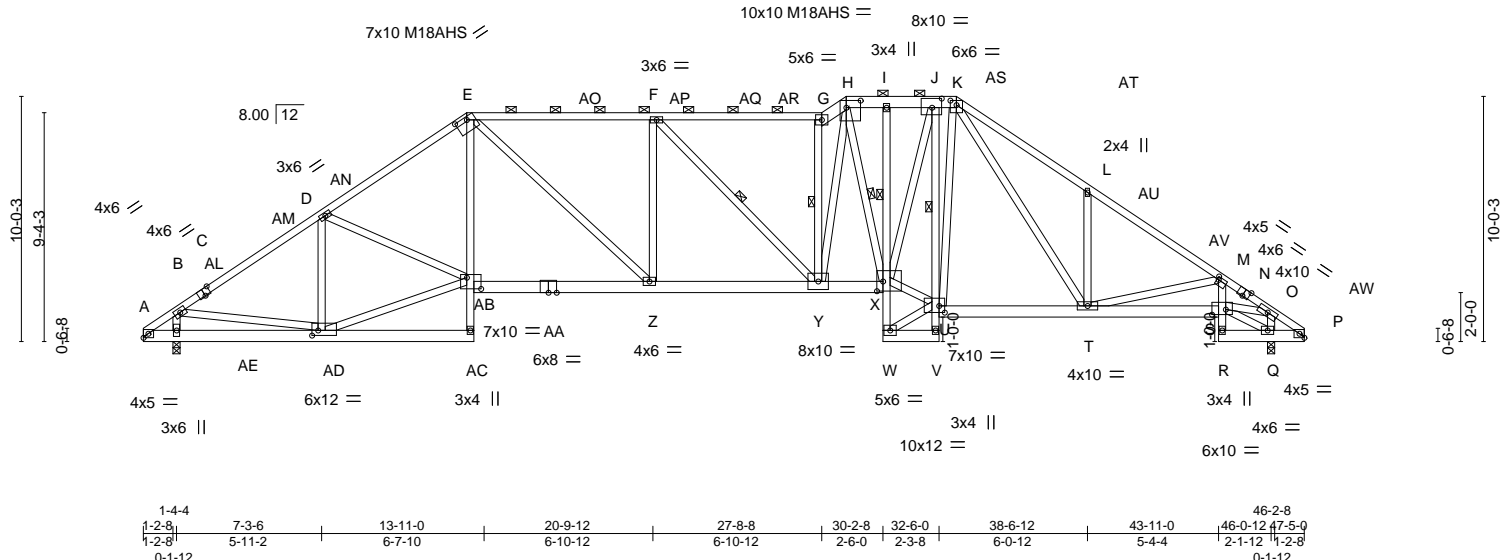


Plate Offsets (X, Y)-- [C:0-3-0,Edge], [E:0-6-0-0-1-8], [H:0-7-0-0-3-8], [J:0-4-12,0-4-8], [K:0-3-0,0-2-3], [M:0-0-12,0-1-8], [N:0-3-0,Edge], [S:0-6-12,0-2-8], [U:0-2-12,0-3-4], [X:0-3-0,0-4-12], [AB:0-7-0,0-5-8], [AD:0-3-0,0-2-8]

LOADING (psf)	SPACING-	CSI.	DEFL.	PLATES	GRIP
TCLL 25.0	2-0-0	TC 0.91	in (loc) l/defl L/d	MT20	244/190
(Roof Snow=25.0)	Plate Grip DOL 1.15	BC 0.92	Vert(LL) -0.38 Y-Z >999 240	M18AHS	186/179
TCDL 10.0	Lumber DOL 1.15	WB 0.99	Vert(CT) -0.60 Y-Z >893 180		
BCLL 0.0	Rep Stress Incr YES	Matrix-MS	Horz(CT) 0.33 Q n/a n/a		
BCDL 10.0	Code IRC2018/TPI2014			Weight: 408 lb	FT = 20%

LUMBER-	BRACING-
TOP CHORD 2x4 SP No.2 *Except* C-E: 2x4 SP 1650F 1.5E, E-G: 2x4 SP 2850F 2.3E G-H,H-K: 2x6 SP No.1 BOT CHORD 2x6 SP No.1 *Except* E-AC,I-W,J-V: 2x4 SP No.3, M-R: 2x4 SP No.2 WEBS 2x4 SP No.3 *Except* H-Y,U-X,J-X,O-S: 2x4 SP No.2	TOP CHORD Structural wood sheathing directly applied, except 2-0-0 oc purlins (2-2-0 max.): E-G, H-K. BOT CHORD Rigid ceiling directly applied or 10-0-0 oc bracing, Except: 6-0-0 oc bracing: W-X,V-W,U-V,R-S. 1 Row at midpt I-X, J-U WEBS 1 Row at midpt G-Y, F-Y, H-X

REACTIONS. (size) AE=0-3-8, Q=0-3-8
 Max Horz AE=-233(LC 8)
 Max Uplift AE=-136(LC 12), Q=-146(LC 13)
 Max Grav AE=2500(LC 36), Q=2519(LC 36)

FORCES. (lb) - Max. Comp./Max. Ten. - All forces 250 (lb) or less except when shown.
TOP CHORD A-B=-370/0, B-D=-3055/313, D-E=-3876/416, E-F=-4164/455, F-G=-3932/442,
 G-H=-4343/505, H-I=-3335/419, I-J=-3327/418, J-K=-2601/383, K-L=-3637/516,
 L-M=-3613/364, M-O=-4564/365
BOT CHORD A-AE=-29/455, AD-AE=-224/548, E-AB=-51/965, Z-AB=-271/3215, Y-Z=-279/4163,
 X-Y=-145/3601, J-U=-1797/174, T-U=-80/2576, S-T=-294/4046, M-S=0/454, Q-R=-26/274
WEBS B-AE=-2343/315, B-AD=-150/2048, D-AD=-1150/172, F-Z=-841/248, E-Z=-238/1290,
 G-Y=-2143/272, F-Y=-332/153, H-Y=-217/2507, H-X=-1249/157, U-W=0/273, U-X=90/2887,
 J-X=-226/2629, L-T=-741/260, M-T=-1220/189, O-Q=-2111/190, O-S=-276/3602,
 AB-AD=-229/2401, D-AB=-76/971, K-T=-251/1152, K-U=-103/696

- NOTES-**
- 1) Wind: ASCE 7-16; Vult=115mph (3-second gust) Vasd=91mph; TCDL=6.0psf; BCDL=6.0psf; h=20ft; Cat. II; Exp C; Enclosed; MWFRS (envelope) gable end zone and C-C Exterior(2E) 0-0-0 to 4-8-14, Interior(1) 4-8-14 to 8-5-10, Exterior(2R) 8-5-10 to 17-11-6, Interior(1) 17-11-6 to 27-8-8, Exterior(2R) 27-8-8 to 37-11-6, Interior(1) 37-11-6 to 42-8-2, Exterior(2E) 42-8-2 to 47-5-0 zone; cantilever left and right exposed ; end vertical left and right exposed;C-C for members and forces & MWFRS for reactions shown; Lumber DOL=1.33 plate grip DOL=1.33
 - 2) TCLL: ASCE 7-16; Pf=25.0 psf (Lum DOL=1.15 Plate DOL=1.15); Is=1.0; Rough Cat C; Fully Exp.; Ce=0.9; Cs=1.00; Ct=1.10
 - 3) Unbalanced snow loads have been considered for this design.
 - 4) Provide adequate drainage to prevent water ponding.
 - 5) All plates are MT20 plates unless otherwise indicated.
 - 6) This truss has been designed for a 10.0 psf bottom chord live load nonconcurrent with any other live loads.
 - 7) Provide mechanical connection (by others) of truss to bearing plate capable of withstanding 100 lb uplift at joint(s) except (jt=lb) AE=136, Q=146.
 - 8) This truss is designed in accordance with the 2018 International Residential Code sections R502.11.1 and R802.10.2 and referenced standard ANSI/TPI 1.
 - 9) Graphical purlin representation does not depict the size or the orientation of the purlin along the top and/or bottom chord.



November 27, 2024


WARNING - Verify design parameters and READ NOTES ON THIS AND INCLUDED MITEK REFERENCE PAGE MII-7473 rev. 1/2/2023 BEFORE USE.

Design valid for use only with MiTek® connectors. This design is based only upon parameters shown, and is for an individual building component, not a truss system. Before use, the building designer must verify the applicability of the design parameters and properly incorporate this design into the overall building design. Bracing indicated is to prevent buckling of individual truss web and/or chord members only. Additional temporary and permanent bracing is always required for stability and to prevent collapse with possible personal injury and property damage. For general guidance regarding the fabrication, storage, delivery, erection and bracing of trusses and truss systems, see **ANSI/TPI1 Quality Criteria, and DSB-22** available from Truss Plate Institute (www.tpinst.org) and **BCSI Building Component Safety Information** available from the Structural Building Component Association (www.sbcsccomponents.com)

MiTek®
 16023 Swingley Ridge Rd.
 Chesterfield, MO 63017
 314.434.1200 / MiTek-US.com

Job	Truss	Truss Type	Qty	Ply	GENE BOSLEY RES. / ROOF	RELEASE FOR CONSTRUCTION
242042	10	Roof Special	1	1		AS NOTED FOR PLAN REVIEW DEVELOPMENT SERVICES LEE'S SUMMIT, MISSOURI

Heartland Truss, Inc, Plattsburg, MO - 64477, 8.730 s Oct 31 2024 MiTek Industries, Inc. Wed Nov 27 17:36:20 2024 Page 1
 ID: mrcY1X_2FQFXm9hpx4TmyPVL_udIY8FUPJF7IUT11imQemSj29dFKJPLWDr1VZ21
 12/02/2024

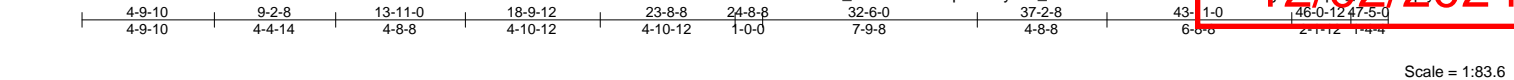

Scale = 1:83.6

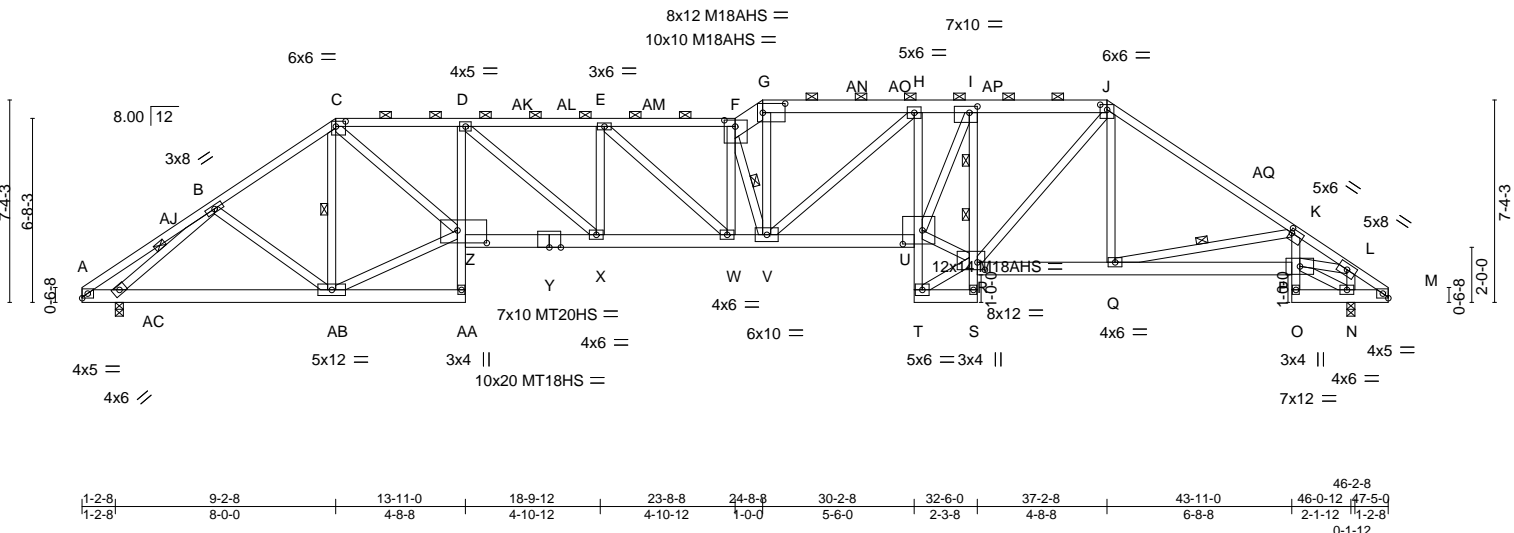


Plate Offsets (X,Y)--	[C:0-4-4,0-2-4], [F:0-4-12,0-2-12], [G:0-9-12,0-4-0], [I:0-3-8,0-2-12], [J:0-3-0,0-2-3], [K:0-0-12,0-2-0], [R:0-3-4,0-3-4], [U:0-8-8,0-6-0], [Z:1-0-12,0-5-8]
-----------------------	---

LOADING (psf)	SPACING-	CSI.	DEFL.	PLATES	GRIP
TCLL 25.0	Plate Grip DOL 1.15	TC 1.00	in (loc) l/def L/d	MT20 244/190	
(Roof Snow=25.0)	Lumber DOL 1.15	BC 0.94	Vert(LL) -0.71 W-X >757 240	MT20HS 187/143	
TCDL 10.0	Rep Stress Incr YES	WB 0.92	Vert(CT) -1.03 W-X >522 180	M18AHS 186/179	
BCLL 0.0	Code IRC2018/TPI2014	Matrix-MS	Horz(CT) 0.53 N n/a n/a	Weight 372 lb	244/190%
BCDL 10.0					

LUMBER-	BRACING-
TOP CHORD 2x4 SP No.2 *Except* C-F: 2x4 SP 2400F 2.0E, F-G: 2x8 SP 2400F 2.0E, G-J: 2x6 SP No.1 J-M: 2x4 SP 1650F 1.5E	TOP CHORD Structural wood sheathing directly applied, except 2-0-0 oc purlins (2-2-0 max.): C-F, G-J.
BOT CHORD 2x6 SP No.1 *Except* D-AA: 2x4 SP No.3, Y-Z,U-Y: 2x6 SP 2400F 2.0E H-T,I-S,K-O: 2x4 SP No.2	BOT CHORD Rigid ceiling directly applied or 2-2-0 oc bracing. Except: 2 Rows at 1/3 pts I-R
WEBS 2x4 SP No.3 *Except* Z-AB,G-V,L-P: 2x4 SP No.2, C-Z,R-U,I-U: 2x4 SP 1650F 1.5E	WEBS 1 Row at midpt B-AC, C-AB, F-V, K-Q

REACTIONS. (size) N=0-3-8, AC=0-3-8
 Max Horz AC=170(LC 9)
 Max Uplift N=-134(LC 8), AC=-258(LC 12)
 Max Grav N=2525(LC 35), AC=2559(LC 35)

FORCES. (lb) - Max. Comp./Max. Ten. - All forces 250 (lb) or less except when shown.
 TOP CHORD A-B=-539/47, B-C=-3549/371, C-D=-6523/588, D-E=-7277/600, E-F=-7523/629,
 F-G=-7499/639, G-H=-6780/588, H-I=-6361/569, I-J=-4671/471, J-K=-4052/392,
 K-L=-4752/417, L-M=-270/24
 BOT CHORD A-AC=0/400, AB-AC=-325/2633, D-Z=-1260/241, X-Z=-463/6545, W-X=-444/7277,
 V-W=-427/7539, U-V=-348/6399, H-U=-618/131, I-R=-4470/302, Q-R=-158/3316,
 P-Q=-399/4150, K-P=0/467, N-O=-46/261
 WEBS B-AC=-3017/352, B-AB=-221/357, C-AB=-1529/137, Z-AB=-236/3130, C-Z=-315/4759,
 E-X=-931/179, D-X=-152/980, F-W=-520/73, E-W=-58/587, G-V=-196/2930, F-V=-3291/333,
 H-V=-147/624, R-T=-14/287, R-U=-279/5417, I-U=-247/4209, J-R=-180/2136, J-Q=0/331,
 K-Q=-1480/290, L-N=-2156/173, L-P=-342/3730

- NOTES-**
- 1) Wind: ASCE 7-16; Vult=115mph (3-second gust) Vasd=91mph; TCDL=6.0psf; BCDL=6.0psf; h=20ft; Cat. II; Exp C; Enclosed; MWFRS (envelope) gable end zone and C-C Exterior(2E) 0-0-0 to 4-9-10, Exterior(2R) 4-9-10 to 13-9-4, Interior(1) 13-9-4 to 23-8-8, Exterior(2R) 23-8-8 to 29-5-6, Interior(1) 29-5-6 to 32-4-4, Exterior(2R) 32-4-4 to 41-11-6, Interior(1) 41-11-6 to 42-8-2, Exterior(2E) 42-8-2 to 47-5-0 zone; cantilever left and right exposed; end vertical left and right exposed; C-C for members and forces & MWFRS for reactions shown; Lumber DOL=1.33 plate grip DOL=1.33
 - 2) TCLL: ASCE 7-16; Pf=25.0 psf (Lum DOL=1.15 Plate DOL=1.15); Is=1.0; Rough Cat C; Fully Exp.; Ce=0.9; Cs=1.00; Ct=1.10
 - 3) Unbalanced snow loads have been considered for this design.
 - 4) Provide adequate drainage to prevent water ponding.
 - 5) All plates are MT20 plates unless otherwise indicated.
 - 6) This truss has been designed for a 10.0 psf bottom chord live load nonconcurrent with any other live loads.
 - 7) Provide mechanical connection (by others) of truss to bearing plate capable of withstanding 100 lb uplift at joint(s) except (jt=lb) N=134, AC=258.
 - 8) This truss is designed in accordance with the 2018 International Residential Code sections R502.11.1 and R802.10.2 and Conference Standard ANSI/TPI 1.



November 27, 2024

WARNING - Verify design parameters and READ NOTES ON THIS AND INCLUDED MITEK REFERENCE PAGE MII-7473 rev. 1/2/2023 BEFORE USE.

Design valid for use only with MiTek® connectors. This design is based only upon parameters shown, and is for an individual building component, not a truss system. Before use, the building designer must verify the applicability of design parameters and properly incorporate this design into the overall building design. Bracing indicated is to prevent buckling of individual truss web and/or chord members only. Additional temporary and permanent bracing is always required for stability and to prevent collapse with possible personal injury and property damage. For general guidance regarding the fabrication, storage, delivery, erection and bracing of trusses and truss systems, see **ANSI/TPI1 Quality Criteria, and DSB-22** available from Truss Plate Institute (www.tpinst.org) and **BCSI Building Component Safety Information** available from the Structural Building Component Association (www.sbcscomponents.com)

MiTek®
 16023 Swingley Ridge Rd.
 Chesterfield, MO 63017
 314.434.1200 / MiTek-US.com

Job 242042	Truss 10	Truss Type Roof Special	Qty 1	Ply 1	GENE BOSLEY RES. / ROOF Job Reference (optional)
---------------	-------------	----------------------------	----------	----------	---

Heartland Truss, Inc, Plattsburg, MO - 64477,

8.730 s Oct 31 2024 MiTek Industries, Inc. Wed Nov 27 17:36:20 2024 Page 2

ID: mrcY1X_2FQFIXm9hhpx4TmyPVL_udIY8FUPJF7fUT1mQemSj2ZdEpX_PPLWDr1Vf2T

RELEASE FOR CONSTRUCTION

AS NOTED FOR PLAN REVIEW
DEVELOPMENT SERVICES
LEE'S SUMMIT, MISSOURI

12/02/2024

NOTES-

9) Graphical purlin representation does not depict the size or the orientation of the purlin along the top and/or bottom chord.

WARNING - Verify design parameters and READ NOTES ON THIS AND INCLUDED MITEK REFERENCE PAGE MII-7473 rev. 1/2/2023 BEFORE USE.

Design valid for use only with MiTek® connectors. This design is based only upon parameters shown, and is for an individual building component, not a truss system. Before use, the building designer must verify the applicability of design parameters and properly incorporate this design into the overall building design. Bracing indicated is to prevent buckling of individual truss web and/or chord members only. Additional temporary and permanent bracing is always required for stability and to prevent collapse with possible personal injury and property damage. For general guidance regarding the fabrication, storage, delivery, erection and bracing of trusses and truss systems, see **ANSI/TPI1 Quality Criteria, and DSB-22** available from Truss Plate Institute (www.tpinst.org) and **BCSI Building Component Safety Information** available from the Structural Building Component Association (www.sbcsccomponents.com)

MiTek®

16023 Swingley Ridge Rd.
Chesterfield, MO 63017
314.434.1200 / MiTek-US.com

Job	Truss	Truss Type	Qty	Ply	GENE BOSLEY RES. / ROOF
242042	11	Roof Special	1	1	

FOR CONSTRUCTION

AS NOTED FOR PLAN REVIEW

DEVELOPMENT SERVICES

LEE'S SUMMIT, MISSOURI

12/02/2024

Heartland Truss, Inc, Plattsburg, MO - 64477, 8.730 s Oct 31 2024 MiTek Industries, Inc. Wed Nov 27 07:39:22 2024 Page 1

ID: mrcY1X_2FQFIXm9hpx4TmyPVL_q?tlZxWfrsNNkr39qBT6rtnP3okHQULM3rJyJvL2f

Scale = 1:84.0

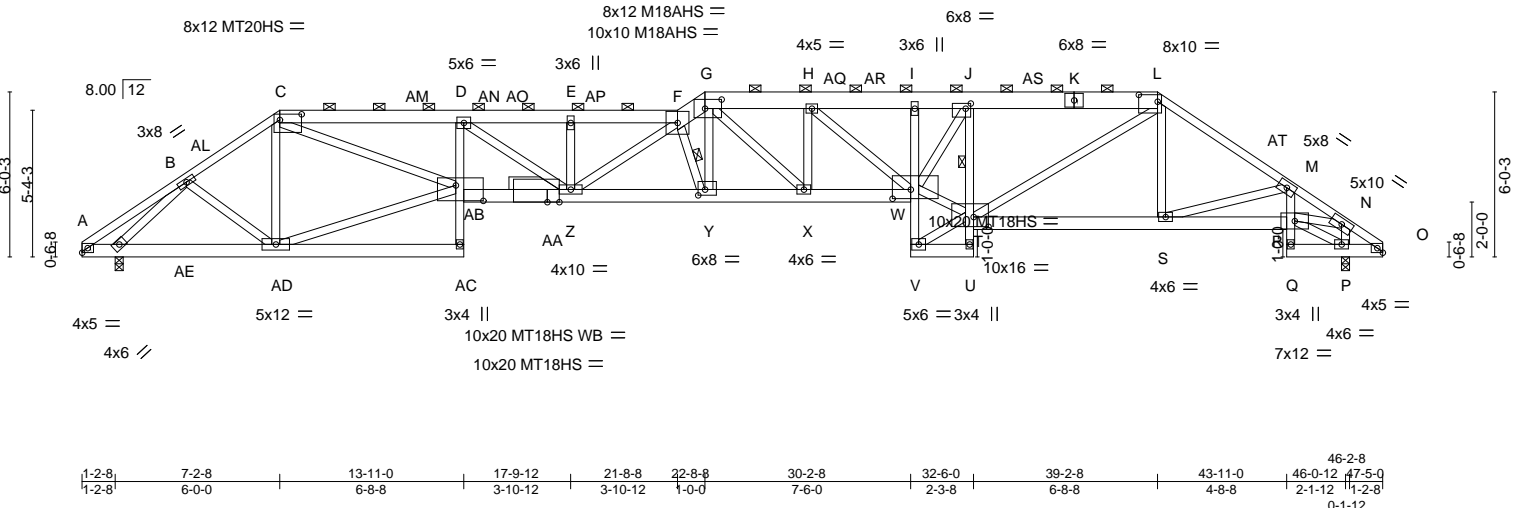


Plate Offsets (X, Y)-- [C:0-9-8,0-2-8], [G:0-7-4,0-4-0], [J:0-2-4,0-2-4], [L:0-8-4,0-3-0], [T:0-6-8,0-4-4], [W:0-8-0,0-4-0], [Y:0-3-0,0-2-8], [AA:0-5-4,0-0-0], [AB:1-0-0,0-6-12]

LOADING (psf)	SPACING-	CSL	DEFL.	PLATES	GRIP
TCLL 25.0	Plate Grip DOL 1.15	TC 0.75	in (loc) l/defl L/d	MT20 244/190	
(Roof Snow=25.0)	Lumber DOL 1.15	BC 0.86	Vert(LL) -1.03 Y-Z >521 240	MT20HS 187/143	
TCDL 10.0	Rep Stress Incr YES	WB 0.98	Vert(CT) -1.47 Y-Z >367 180	M18AHS 186/179	
BCLL 0.0	Code IRC2018/TPI2014	Matrix-MS	Horz(CT) 0.66 P n/a n/a	Weight 380 lb	244/190%
BCDL 10.0					

LUMBER-	BRACING-
TOP CHORD 2x8 SP 2400F 2.0E *Except* A-C,L-O: 2x4 SP No.2, C-F: 2x6 SP 2400F 2.0E	TOP CHORD Structural wood sheathing directly applied or 2-2-0 oc purlins, except 2-0-0 oc purlins (2-5-6 max.): C-F, G-L.
BOT CHORD 2x4 SP No.2 *Except* A-AC,U-V,R-T,O-Q: 2x6 SP No.1, AA-AB,W-AA: 2x6 SP 2400F 2.0E	BOT CHORD Rigid ceiling directly applied or 10-0-0 oc bracing, Except: 6-0-0 oc bracing: V-W,U-V,T-U,Q-R.
WEBS 2x4 SP No.3 *Except* AB-AD,L-T,N-R: 2x4 SP No.2, C-AB,T-W: 2x4 SP 2400F 2.0E	WEBS 1 Row at midpt J-T 1 Row at midpt F-Y
OTHERS J-W,G-Y,H-X: 2x4 SP 1650F 1.5E 2x6 SP No.2	

REACTIONS. (size) P=0-3-8, AE=0-3-8
 Max Horz AE=138(LC 9)
 Max Uplift P=-181(LC 8), AE=-245(LC 12)
 Max Grav P=2709(LC 36), AE=2742(LC 36)

FORCES. (lb) - Max. Comp./Max. Ten. - All forces 250 (lb) or less except when shown.

TOP CHORD A-B=-454/53, B-C=-3712/335, C-D=-10398/757, D-E=-10954/813, E-F=-10954/813, F-G=-10678/825, G-H=-9586/771, H-I=-8742/722, I-J=-8701/719, J-L=-6517/579, L-M=-4442/369, M-N=-5073/385, N-O=-288/30

BOT CHORD A-AE=-2/329, AD-AE=272/2595, D-AB=-1120/219, Z-AB=-657/10449, Y-Z=-763/11424, X-Y=-645/9942, W-X=-655/9586, J-T=-4946/448, S-T=-210/3673, R-S=-322/4349, M-R=0/511, P-Q=-28/294

WEBS B-AE=-3210/293, B-AD=-94/634, C-AD=-1333/169, AB-AD=-221/3080, C-AB=-617/7849, E-Z=-699/109, D-Z=-80/674, T-V=0/278, T-W=-502/7120, J-W=-281/4356, L-S=0/314, L-T=-303/3427, M-S=-979/177, N-P=-2336/194, N-R=-295/3959, G-Y=-279/4275, H-X=-57/591, H-W=-1132/124, G-X=-678/145, F-Y=-4505/356, F-Z=-744/111

- NOTES-**
- 1) Wind: ASCE 7-16; Vult=115mph (3-second gust) Vasd=91mph; TCDL=6.0psf; BCDL=6.0psf; h=20ft; Cat. II; Exp C; Enclosed; MWFRS (envelope) gable end zone and C-C Exterior(2E) 0-0-0 to 4-8-14, Exterior(2R) 4-8-14 to 11-11-6, Interior(1) 11-11-6 to 21-8-8, Exterior(2R) 21-8-8 to 27-5-6, Interior(1) 27-5-6 to 34-5-10, Exterior(2R) 34-5-10 to 42-8-2, Exterior(2E) 42-8-2 to 47-5-0 zone; cantilever left and right exposed ; end vertical left and right exposed;C-C for members and forces & MWFRS for reactions shown; Lumber DOL=1.33 plate grip DOL=1.33
 - 2) TCLL: ASCE 7-16; Pf=25.0 psf (Lum DOL=1.15 Plate DOL=1.15); Is=1.0; Rough Cat C; Fully Exp.; Ce=0.9; Cs=1.00; Ct=1.10
 - 3) Unbalanced snow loads have been considered for this design.
 - 4) Provide adequate drainage to prevent water ponding.
 - 5) All plates are MT20 plates unless otherwise indicated.
 - 6) The Fabrication Tolerance at joint AB = 16%
 - 7) This truss has been designed for a 10.0 psf bottom chord live load nonconcurrent with any other live loads.
 - 8) Provide mechanical connection (by others) of truss to bearing plate capable of withstanding 100 lb uplift at joint(s) except (jt=lb) P=181, AE=245.



November 27, 2024

Continued on page 2

WARNING - Verify design parameters and READ NOTES ON THIS AND INCLUDED MITEK REFERENCE PAGE MII-7473 rev. 1/2/2023 BEFORE USE.

Design valid for use only with MiTek® connectors. This design is based only upon parameters shown, and is for an individual building component, not a truss system. Before use, the building designer must verify the applicability of design parameters and properly incorporate this design into the overall building design. Bracing indicated is to prevent buckling of individual truss web and/or chord members only. Additional temporary and permanent bracing is always required for stability and to prevent collapse with possible personal injury and property damage. For general guidance regarding the fabrication, storage, delivery, erection and bracing of trusses and truss systems, see **ANSI/TPI1 Quality Criteria, and DSB-22** available from Truss Plate Institute (www.tpinst.org) and **BCSI Building Component Safety Information** available from the Structural Building Component Association (www.sbcsccomponents.com)

MiTek®
 16023 Swingley Ridge Rd.
 Chesterfield, MO 63017
 314.434.1200 / MiTek-US.com

Job 242042	Truss 11	Truss Type Roof Special	Qty 1	Ply 1	GENE BOSLEY RES. / ROOF Job Reference (optional)
---------------	-------------	----------------------------	----------	----------	---

RELEASE FOR CONSTRUCTION

AS NOTED FOR PLAN REVIEW
DEVELOPMENT SERVICES
LEE'S SUMMIT, MISSOURI

12/02/2024

Heartland Truss, Inc, Plattsburg, MO - 64477,

8.730 s Oct 31 2024 MiTek Industries, Inc. Wed Nov 27 07:36:22 2024 Page 2
ID: mrcY1X_2FQFIXm9hpx4TmyPVI_-q?tlZxWfrsNNkn39qBT6rtmRspk1HQLM37JwylE2p

NOTES-

- 9) This truss is designed in accordance with the 2018 International Residential Code sections R502.11.1 and R802.10.2 and referenced standard ANSI/TPI 1.
- 10) Graphical purlin representation does not depict the size or the orientation of the purlin along the top and/or bottom chord.

WARNING - Verify design parameters and READ NOTES ON THIS AND INCLUDED MITEK REFERENCE PAGE MII-7473 rev. 1/2/2023 BEFORE USE.



Design valid for use only with MiTek® connectors. This design is based only upon parameters shown, and is for an individual building component, not a truss system. Before use, the building designer must verify the applicability of design parameters and properly incorporate this design into the overall building design. Bracing indicated is to prevent buckling of individual truss web and/or chord members only. Additional temporary and permanent bracing is always required for stability and to prevent collapse with possible personal injury and property damage. For general guidance regarding the fabrication, storage, delivery, erection and bracing of trusses and truss systems, see **ANSI/TPI1 Quality Criteria, and DSB-22** available from Truss Plate Institute (www.tpinst.org) and **BCSI Building Component Safety Information** available from the Structural Building Component Association (www.sbcsccomponents.com)

MiTek®

16023 Swingley Ridge Rd.
Chesterfield, MO 63017
314.434.1200 / MiTek-US.com

Job	Truss	Truss Type	Qty	Ply	GENE BOSLEY RES. / ROOF	AS NOTED FOR PLAN REVIEW DEVELOPMENT SERVICES LEE'S SUMMIT, MISSOURI
242042	12	Roof Special Girder	1	1		169875899

Heartland Truss, Inc. Plattsburg, MO - 64477, 8.730 s Oct 31 2024 MiTek Industries, Inc. Wed Nov 27 17:36:24 2024 Page 1
 ID: mrcY1X_2FQFIXm9hhpx4TmyPVI_nO_3_dXvNTd4z5LYxcVaxlKc_11_1_ANUQzoyF2p

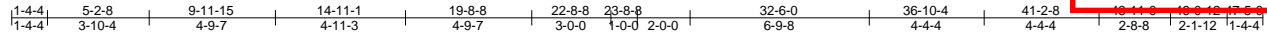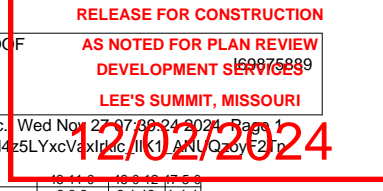

Scale = 1:87.3

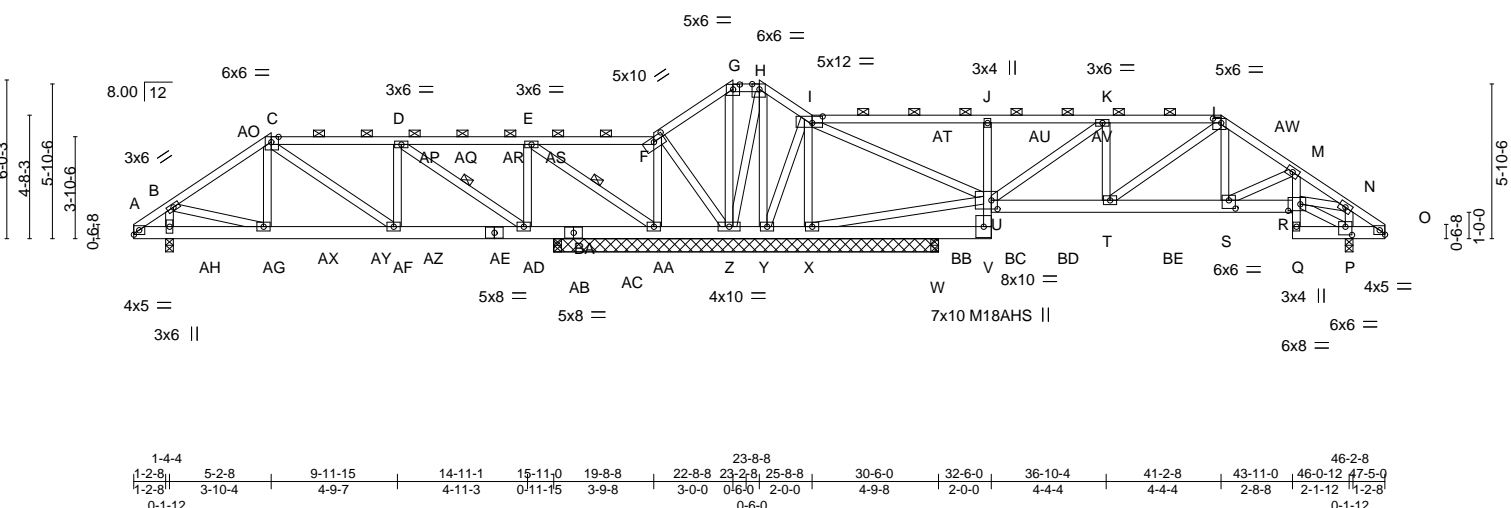


Plate Offsets (X, Y)-- [C:0-3-5,Edge], [F:0-5-0,0-2-0], [G:0-3-0,0-2-3], [H:0-3-5,Edge], [I:0-4-12,0-3-0], [L:0-3-12,0-2-0], [P:0-3-0,0-3-12], [R:0-5-8,0-3-0], [S:0-3-0,0-3-12], [U:0-2-12,0-4-0]

LOADING (psf)	SPACING-	2-0-0	CSI.	DEFL.	in (loc)	l/defl	L/d	PLATES	GRIP
TCLL 25.0	Plate Grip DOL	1.15	TC 0.96	Vert(LL)	-0.15	T-U	>999	MT20	244/190
(Roof Snow=25.0)	Lumber DOL	1.15	BC 1.00	Vert(CT)	-0.20	T-U	>944	M18AHS	186/179
TCDL 10.0	Rep Stress Incr	NO	WB 0.98	Horz(CT)	0.11	P	n/a		
BCLL 0.0	Code IRC2018/TPI2014		Matrix-MS						
BCDL 10.0								Weight: 343 lb	FT = 20%

LUMBER-	BRACING-
TOP CHORD 2x4 SP No.2 *Except* C-F,I-L: 2x4 SP 1650F 1.5E	TOP CHORD Structural wood sheathing directly applied or 2-11-8 oc purlins, except
BOT CHORD 2x6 SP No.1 *Except* J-V: 2x4 SP No.2, M-Q: 2x4 SP No.3	BOT CHORD 2-0-0 oc purlins (3-8-14 max.): C-F, G-H, I-L. Rigid ceiling directly applied.
WEBS 2x4 SP No.3 *Except* I-U,N-R: 2x4 SP No.2	WEBS 1 Row at midpt D-AD, E-AA

REACTIONS. All bearings 0-3-8 except (jt=length) AA=14-7-0, Z=14-7-0, Y=14-7-0, X=14-7-0.
 (lb) - Max Horz AH=-134(LC 68)
 Max Uplift All uplift 100 lb or less at joint(s) except AH=-373(LC 12), AA=-101(LC 12), Z=-230(LC 9), Y=-195(LC 13), X=-227(LC 13), P=-488(LC 13), AC=-211(LC 12), W=-223(LC 13)
 Max Grav All reactions 250 lb or less at joint(s) except AH=1578(LC 41), AA=513(LC 18), Z=1276(LC 40), Y=745(LC 40), X=1201(LC 40), P=1971(LC 41), AC=1091(LC 40), W=1157(LC 40)

FORCES. (lb) - Max. Comp./Max. Ten. - All forces 250 (lb) or less except when shown.
 TOP CHORD B-C=-1738/458, C-D=-1880/485, D-E=-420/139, E-F=-298/1410, F-G=-370/1730, G-H=-273/1411, H-I=-322/1624, I-J=-1492/387, J-K=-1459/380, K-L=-2806/718, L-M=-2945/805, M-N=-3349/874
 BOT CHORD AF-AG=-374/1423, AD-AF=-444/1877, AC-AD=-84/420, AA-AC=-84/420, Z-AA=-1380/388, Y-Z=-1400/435, X-Y=-1559/459, W-X=-588/148, V-W=-588/148, U-V=-532/124, J-U=-787/167, T-U=-640/2806, S-T=-547/2396, R-S=-684/2809, M-R=-54/392
 WEBS B-AH=-1480/410, B-AG=-319/1370, C-AG=-199/401, C-AF=-168/565, D-AF=-191/613, D-AD=-1892/441, E-AD=-169/665, E-AA=-2132/479, F-AA=-198/760, G-Z=-1037/237, H-Y=-799/167, I-Y=-98/386, I-X=-1477/357, U-X=-931/302, I-U=-750/3351, K-U=-1672/419, K-T=-264/722, L-T=-117/515, L-S=-323/1090, M-S=-645/162, N-R=-638/2608, N-P=-1641/439

NOTES-
 1) Wind: ASCE 7-16; Vult=115mph (3-second gust) Vasd=91mph; TCDL=6.0psf; BCDL=6.0psf; h=20ft; Cat. II; Exp C; Enclosed; MWFRS (envelope) gable end zone and C-C Exterior(2E) 0-0-0 to 4-8-14, Exterior(2R) 4-8-14 to 9-11-15, Interior(1) 9-11-15 to 19-8-8, Exterior(2R) 19-8-8 to 23-8-8, Exterior(2E) 23-8-8 to 25-8-8, Interior(1) 25-8-8 to 36-5-10, Exterior(2R) 36-5-10 to 42-8-2, Exterior(2E) 42-8-2 to 47-5-0 zone; cantilever left and right exposed ; end vertical left and right exposed; C-C for members and forces & MWFRS for reactions shown; Lumber DOL=1.33 plate grip DOL=1.33
 2) TCLL: ASCE 7-16; Pf=25.0 psf (Lum DOL=1.15 Plate DOL=1.15); Is=1.0; Rough Cat C; Fully Exp.; Ce=0.9; Cs=1.00; Ct=1.10
 3) Unbalanced snow loads have been considered for this design.
 4) Provide adequate drainage to prevent water ponding.
 5) All plates are MT20 plates unless otherwise indicated.
 6) All plates are MT20 unless otherwise indicated.



November 27, 2024

Job	Truss	Truss Type	Qty	Ply	GENE BOSLEY RES. / ROOF	AS NOTED FOR PLAN REVIEW DEVELOPMENT SERVICES LEE'S SUMMIT, MISSOURI
242042	12	Roof Special Girder	1	1	Job Reference (optional)	169875889

Heartland Truss, Inc, Plattsburg, MO - 64477,

8.730 s Oct 31 2024 MiTek Industries, Inc. Wed Nov 27 17:39:24 2024 Page 2

ID:mrCY1X_2FQFIxm9hpx4TmyPVI_nO_3_dXvNTd4z5LYxcVaxlKc_II(1)_ANUQzoyF2p

12/02/2024

NOTES-

- 7) This truss has been designed for a 10.0 psf bottom chord live load nonconcurrent with any other live loads.
- 8) Provide mechanical connection (by others) of truss to bearing plate capable of withstanding 373 lb uplift at joint AH, 101 lb uplift at joint AA, 230 lb uplift at joint Z, 195 lb uplift at joint Y, 227 lb uplift at joint X, 488 lb uplift at joint P, 211 lb uplift at joint AC and 223 lb uplift at joint W.
- 9) This truss is designed in accordance with the 2018 International Residential Code sections R502.11.1 and R802.10.2 and referenced standard ANSI/TPI 1.
- 10) Graphical purlin representation does not depict the size or the orientation of the purlin along the top and/or bottom chord.
- 11) Hanger(s) or other connection device(s) shall be provided sufficient to support concentrated load(s) 495 lb down and 197 lb up at 5-2-8, 200 lb down and 83 lb up at 7-1-12, 200 lb down and 83 lb up at 9-1-12, 200 lb down and 83 lb up at 11-1-12, 200 lb down and 83 lb up at 13-1-12, 200 lb down and 83 lb up at 15-1-12, 285 lb down and 99 lb up at 31-1-12, 285 lb down and 100 lb up at 33-1-12, 285 lb down and 100 lb up at 35-1-12, 285 lb down and 100 lb up at 37-1-12, and 285 lb down and 100 lb up at 39-1-12, and 764 lb down and 317 lb up at 41-1-12 on bottom chord. The design/selection of such connection device(s) is the responsibility of others.
- 12) In the LOAD CASE(S) section, loads applied to the face of the truss are noted as front (F) or back (B).

LOAD CASE(S) Standard

- 1) Dead + Snow (balanced): Lumber Increase=1.15, Plate Increase=1.15

Uniform Loads (plf)

Vert: A-C=-70, C-F=-70, F-G=-70, G-H=-70, H-I=-70, I-L=-70, L-O=-70, V-AI=-20, R-U=-20, Q-AL=-20

Concentrated Loads (lb)

Vert: AG=-495(B) AD=-200(B) T=-285(B) S=-764(B) AX=-200(B) AY=-200(B) AZ=-200(B) BA=-200(B) BB=-285(B) BC=-285(B) BD=-285(B) BE=-285(B)

WARNING - Verify design parameters and READ NOTES ON THIS AND INCLUDED MITEK REFERENCE PAGE MII-7473 rev. 1/2/2023 BEFORE USE.

Design valid for use only with MiTek® connectors. This design is based only upon parameters shown, and is for an individual building component, not a truss system. Before use, the building designer must verify the applicability of design parameters and properly incorporate this design into the overall building design. Bracing indicated is to prevent buckling of individual truss web and/or chord members only. Additional temporary and permanent bracing is always required for stability and to prevent collapse with possible personal injury and property damage. For general guidance regarding the fabrication, storage, delivery, erection and bracing of trusses and truss systems, see **ANSI/TPI1 Quality Criteria, and DSB-22** available from Truss Plate Institute (www.tpinst.org) and **BCSI Building Component Safety Information** available from the Structural Building Component Association (www.sbcsccomponents.com)

MiTek®16023 Swingley Ridge Rd.
Chesterfield, MO 63017
314.434.1200 / MiTek-US.com

Job	Truss	Truss Type	Qty	Ply	GENE BOSLEY RES. / ROOF
242042	13	Diagonal Hip Girder	1	1	


AS NOTED FOR PLAN REVIEW
DEVELOPMENT SERVICES
LEE'S SUMMIT, MISSOURI

Heartland Truss, Inc, Plattsburg, MO - 64477,

8.730 s Oct 31 2024 MiTek Industries, Inc. Wed No 27-07-86-24-2024 Page 1

ID:mrcY1X_2FQFXm9hhpx4TmyPVI_nO_3_dXvNTd4z5L YxcVaxIrsDagWIP ANUozoyE2n

12/02/2024

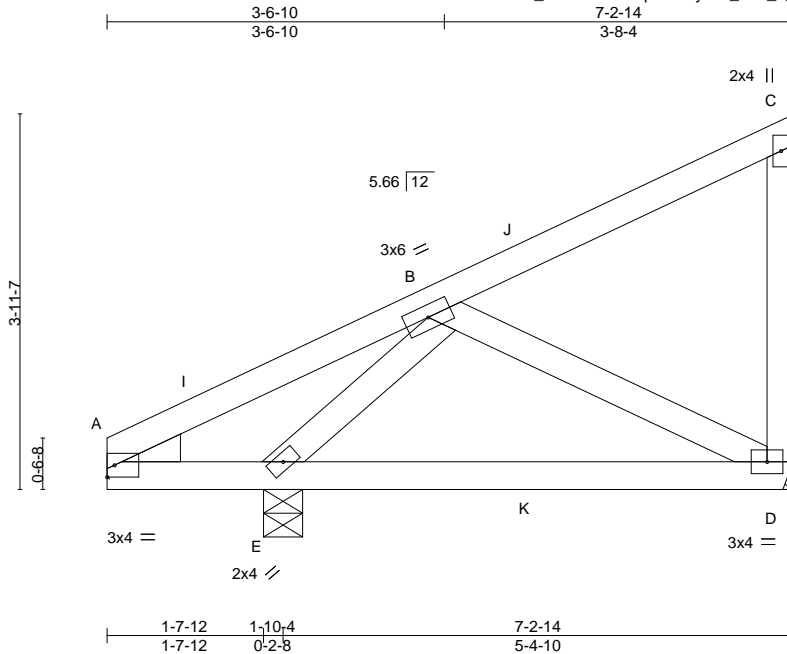

Scale = 1:24.3

LOADING (psf)	SPACING-	CSI.	DEFL.	PLATES	GRIP
TCLL 25.0 (Roof Snow=25.0)	2-0-0 Plate Grip DOL 1.15 Lumber DOL 1.15 Rep Stress Incr NO Code IRC2018/TPI2014	TC 0.42 BC 0.28 WB 0.12 Matrix-MP	in (loc) l/defl L/d Vert(LL) -0.03 D-E >999 240 Vert(CT) -0.05 D-E >999 180 Horz(CT) 0.00 D n/a n/a	MT20	244/190
TCDL 10.0				Weight: 38 lb	FT = 20%
BCLL 0.0					
BCDL 10.0					

LUMBER-
TOP CHORD 2x4 SP No.2
BOT CHORD 2x4 SP No.2
WEBS 2x4 SP No.3
WEDGE
Left: 2x4 SP No.3

BRACING-
TOP CHORD Structural wood sheathing directly applied or 6-0-0 oc purlins, except end verticals.
BOT CHORD Rigid ceiling directly applied or 6-0-0 oc bracing.

REACTIONS. (size) D=Mechanical, E=0-4-15
Max Horz E=141(LC 11)
Max Uplift D=-86(LC 9), E=-62(LC 12)
Max Grav D=323(LC 18), E=547(LC 18)

FORCES. (lb) - Max. Comp./Max. Ten. - All forces 250 (lb) or less except when shown.
WEBS B-D=-276/191, B-E=-535/253

NOTES-

- 1) Wind: ASCE 7-16; Vult=115mph (3-second gust) Vasd=91mph; TCDL=6.0psf; BCDL=6.0psf; h=20ft; Cat. II; Exp C; Enclosed; MWFRS (envelope) gable end zone and C-C Corner(3) 0-0-0 to 4-2-15, Exterior(2R) 4-2-15 to 7-1-2 zone; cantilever left and right exposed ; end vertical left and right exposed;C-C for members and forces & MWFRS for reactions shown; Lumber DOL=1.33 plate grip DOL=1.33
- 2) TCLL: ASCE 7-16; Pf=25.0 psf (Lum DOL=1.15 Plate DOL=1.15); Is=1.0; Rough Cat C; Fully Exp.; Ce=0.9; Cs=1.00; Ct=1.10
- 3) Unbalanced snow loads have been considered for this design.
- 4) This truss has been designed for a 10.0 psf bottom chord live load nonconcurrent with any other live loads.
- 5) Refer to girder(s) for truss to truss connections.
- 6) Provide mechanical connection (by others) of truss to bearing plate capable of withstanding 86 lb uplift at joint D and 62 lb uplift at joint E.
- 7) This truss is designed in accordance with the 2018 International Residential Code sections R502.11.1 and R802.10.2 and referenced standard ANSI/TPI 1.
- 8) Hanger(s) or other connection device(s) shall be provided sufficient to support concentrated load(s) 111 lb down and 88 lb up at 4-6-0, and 111 lb down and 88 lb up at 4-6-0 on top chord, and 12 lb down and 19 lb up at 4-6-0, and 12 lb down and 19 lb up at 4-6-0 on bottom chord. The design/selection of such connection device(s) is the responsibility of others.
- 9) In the LOAD CASE(S) section, loads applied to the face of the truss are noted as front (F) or back (B).

LOAD CASE(S) Standard

- 1) Dead + Snow (balanced): Lumber Increase=1.15, Plate Increase=1.15
Uniform Loads (plf)
Vert: A-C=-70, D-F=-20
Concentrated Loads (lb)
Vert: K=5(F=2, B=2)



November 27, 2024

WARNING - Verify design parameters and READ NOTES ON THIS AND INCLUDED MITEK REFERENCE PAGE MII-7473 rev. 1/2/2023 BEFORE USE.

Design valid for use only with MiTek® connectors. This design is based only upon parameters shown, and is for an individual building component, not a truss system. Before use, the building designer must verify the applicability of design parameters and properly incorporate this design into the overall building design. Bracing indicated is to prevent buckling of individual truss web and/or chord members only. Additional temporary and permanent bracing is always required for stability and to prevent collapse with possible personal injury and property damage. For general guidance regarding the fabrication, storage, delivery, erection and bracing of trusses and truss systems, see **ANSI/TPI1 Quality Criteria, and DSB-22** available from Truss Plate Institute (www.tpinst.org) and **BCSI Building Component Safety Information** available from the Structural Building Component Association (www.sbcsccomponents.com)

MiTek®

16023 Swingley Ridge Rd.
Chesterfield, MO 63017
314.434.1200 / MiTek-US.com

Job 242042	Truss 14	Truss Type Diagonal Hip Girder	Qty 1	Ply 1	GENE BOSLEY RES. / ROOF
---------------	-------------	-----------------------------------	----------	----------	-------------------------


AS NOTED FOR PLAN REVIEW
DEVELOPMENT SERVICES
LEE'S SUMMIT, MISSOURI

Heartland Truss, Inc, Plattsburg, MO - 64477,


8.730 s Oct 31 2024 MiTek Industries, Inc. Wed No 27-17-86-25-2024 Page 1

ID:mrcY1X_2FQFIXm9hhpx4TmyPVI_-FaYRBzYX8nixbEvkVJ0pTVN10NkU118P12_WFV2Tm

12/02/2024

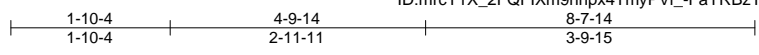

Scale = 1:26.8

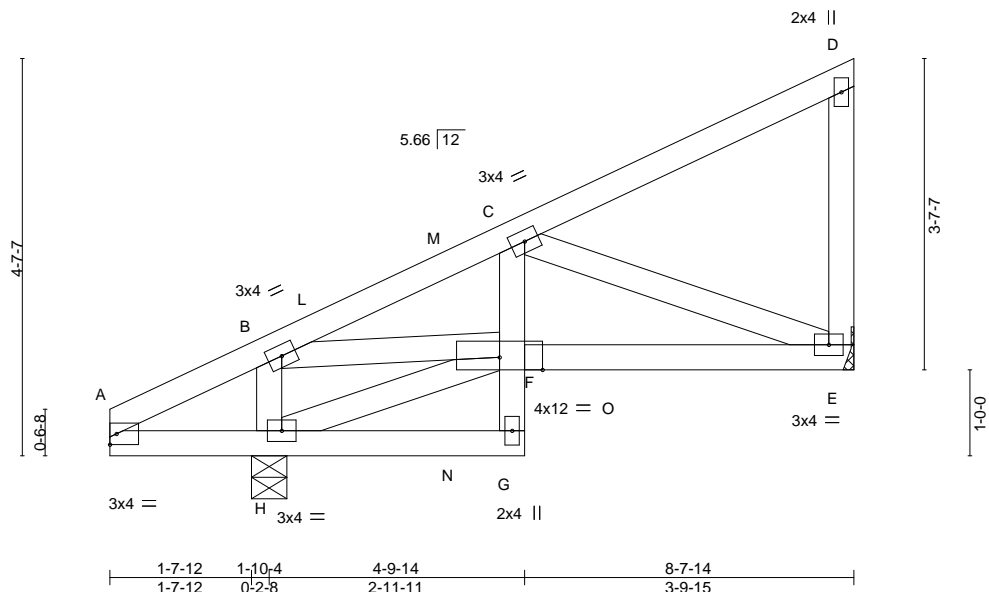

LOADING (psf)	SPACING-	CSI.	DEFL.	PLATES	GRIP
TCLL 25.0 (Roof Snow=25.0)	2-0-0 Plate Grip DOL 1.15 Lumber DOL 1.15	TC 0.41 BC 0.73 WB 0.31 Matrix-MP	in (loc) l/defl L/d Vert(LL) -0.05 E-F >999 240 Vert(CT) -0.07 E-F >999 180 Horz(CT) 0.01 E n/a n/a	MT20	244/190
TCDL 10.0	Rep Stress Incr NO Code IRC2018/TPI2014			Weight: 50 lb	FT = 20%
BCLL 0.0					
BCDL 10.0					

LUMBER-	BRACING-
TOP CHORD 2x4 SP No.2	TOP CHORD Structural wood sheathing directly applied or 6-0-0 oc purlins, except end verticals.
BOT CHORD 2x4 SP No.2 *Except* C-G: 2x4 SP No.3	BOT CHORD Rigid ceiling directly applied or 6-0-0 oc bracing.
WEBS 2x4 SP No.3	

REACTIONS. (size) H=0-4-15, E=Mechanical
Max Horz H=137(LC 9)
Max Uplift H=-147(LC 12), E=-189(LC 12)
Max Grav H=633(LC 18), E=508(LC 18)

FORCES. (lb) - Max. Comp./Max. Ten. - All forces 250 (lb) or less except when shown.
TOP CHORD B-C=-774/371
BOT CHORD E-F=-366/690
WEBS B-H=-527/287, B-F=-324/740, C-E=-730/456

- NOTES-**
- 1) Wind: ASCE 7-16; Vult=115mph (3-second gust) Vasd=91mph; TCDL=6.0psf; BCDL=6.0psf; h=20ft; Cat. II; Exp C; Enclosed; MWFRS (envelope) gable end zone and C-C Corner(3) 0-0-0 to 4-2-15, Exterior(2R) 4-2-15 to 8-6-2 zone; cantilever left and right exposed; end vertical left and right exposed; C-C for members and forces & MWFRS for reactions shown; Lumber DOL=1.33 plate grip DOL=1.33
 - 2) TCLL: ASCE 7-16; Pf=25.0 psf (Lum DOL=1.15 Plate DOL=1.15); Is=1.0; Rough Cat C; Fully Exp.; Ce=0.9; Cs=1.00; Ct=1.10
 - 3) Unbalanced snow loads have been considered for this design.
 - 4) This truss has been designed for a 10.0 psf bottom chord live load nonconcurrent with any other live loads.
 - 5) Refer to girder(s) for truss to truss connections.
 - 6) Provide mechanical connection (by others) of truss to bearing plate capable of withstanding 147 lb uplift at joint H and 189 lb uplift at joint E.
 - 7) This truss is designed in accordance with the 2018 International Residential Code sections R502.11.1 and R802.10.2 and referenced standard ANSI/TPI 1.
 - 8) Hanger(s) or other connection device(s) shall be provided sufficient to support concentrated load(s) 104 lb down and 76 lb up at 4-0-6, and 104 lb down and 76 lb up at 4-0-6 on top chord, and 55 lb up at 4-0-6, 55 lb up at 4-0-6, and 99 lb down and 78 lb up at 5-11-0, and 99 lb down and 78 lb up at 5-11-0 on bottom chord. The design/selection of such connection device(s) is the responsibility of others.
 - 9) In the LOAD CASE(S) section, loads applied to the face of the truss are noted as front (F) or back (B).

LOAD CASE(S) Standard
1) Dead + Snow (balanced): Lumber Increase=1.15, Plate Increase=1.15
Uniform Loads (plf)
Vert: A-D=-70, G-I=-20, E-F=-20
Concentrated Loads (lb)
Vert: N=59(F=29, B=29) O=-197(F=-99, B=-99)



November 27, 2024

WARNING - Verify design parameters and READ NOTES ON THIS AND INCLUDED MITEK REFERENCE PAGE MII-7473 rev. 1/2/2023 BEFORE USE.
Design valid for use only with MiTek® connectors. This design is based only upon parameters shown, and is for an individual building component, not a truss system. Before use, the building designer must verify the applicability of design parameters and properly incorporate this design into the overall building design. Bracing indicated is to prevent buckling of individual truss web and/or chord members only. Additional temporary and permanent bracing is always required for stability and to prevent collapse with possible personal injury and property damage. For general guidance regarding the fabrication, storage, delivery, erection and bracing of trusses and truss systems, see **ANSI/TPI1 Quality Criteria, and DSB-22** available from Truss Plate Institute (www.tpinst.org) and **BCSI Building Component Safety Information** available from the Structural Building Component Association (www.sbcsccomponents.com)

MiTek®
16023 Swingley Ridge Rd.
Chesterfield, MO 63017
314.434.1200 / MiTek-US.com

Job 242042	Truss 15	Truss Type Jack-Closed	Qty 2	Ply 1	GENE BOSLEY RES. / ROOF
---------------	-------------	---------------------------	----------	----------	-------------------------

AS NOTED FOR PLAN REVIEW
DEVELOPMENT SERVICES
LEE'S SUMMIT, MISSOURI


Heartland Truss, Inc, Plattsburg, MO - 64477,

8.730 s Oct 31 2024 MiTek Industries, Inc.

Wed Nov 27 07:36:25 2024 Page 1

ID:mrcY1X_2FQFIxm9hhpx4TmyPVL_-FaYRBzYX8nlxbEvkV0pTVN5Y0X2U078P12_VF0F2Tm

12/02/2024

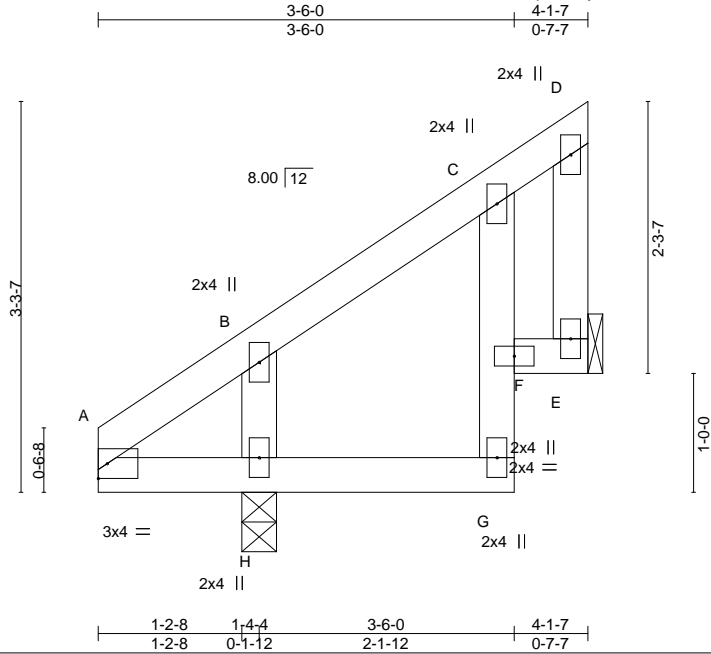

Scale = 1:19.4

LOADING (psf)	SPACING-	CSI.	DEFL.	in (loc)	l/defl	L/d	PLATES	GRIP
TCLL 25.0 (Roof Snow=25.0)	2-0-0 Plate Grip DOL 1.15 Lumber DOL 1.15	TC 0.19 BC 0.13 WB 0.06 Matrix-MP	Vert(LL) -0.01 Vert(CT) -0.01 Horz(CT) 0.01	G	>999	240	MT20	244/190
TCDL 10.0	Rep Stress Incr YES			E	n/a	n/a		
BCLL 0.0	Code IRC2018/TPI2014							
BCDL 10.0							Weight: 21 lb	FT = 20%

LUMBER-
TOP CHORD 2x4 SP No.2
BOT CHORD 2x4 SP No.2 *Except*
C-G: 2x4 SP No.3
WEBS 2x4 SP No.3

BRACING-
TOP CHORD Structural wood sheathing directly applied or 4-1-7 oc purlins, except end verticals.
BOT CHORD Rigid ceiling directly applied or 6-0-0 oc bracing.

REACTIONS. (size) E=Mechanical, H=0-3-8
Max Horz H=88(LC 9)
Max Uplift E=-55(LC 9), H=-10(LC 12)
Max Grav E=127(LC 18), H=399(LC 18)

FORCES. (lb) - Max. Comp./Max. Ten. - All forces 250 (lb) or less except when shown.
WEBS B-H=-316/151

- NOTES-**
- 1) Wind: ASCE 7-16; Vult=115mph (3-second gust) Vasd=91mph; TCDL=6.0psf; BCDL=6.0psf; h=20ft; Cat. II; Exp C; Enclosed; MWFRS (envelope) gable end zone and C-C Exterior(2E) zone; cantilever left and right exposed; end vertical left and right exposed; C-C for members and forces & MWFRS for reactions shown; Lumber DOL=1.33 plate grip DOL=1.33
 - 2) TCLL: ASCE 7-16; Pf=25.0 psf (Lum DOL=1.15 Plate DOL=1.15); Is=1.0; Rough Cat C; Fully Exp.; Ce=0.9; Cs=1.00; Ct=1.10
 - 3) Unbalanced snow loads have been considered for this design.
 - 4) This truss has been designed for a 10.0 psf bottom chord live load nonconcurrent with any other live loads.
 - 5) Refer to girder(s) for truss to truss connections.
 - 6) Provide mechanical connection (by others) of truss to bearing plate capable of withstanding 55 lb uplift at joint E and 10 lb uplift at joint H.
 - 7) This truss is designed in accordance with the 2018 International Residential Code sections R502.11.1 and R802.10.2 and referenced standard ANSI/TPI 1.



November 27, 2024

WARNING - Verify design parameters and READ NOTES ON THIS AND INCLUDED MITEK REFERENCE PAGE MII-7473 rev. 1/2/2023 BEFORE USE.

Design valid for use only with MiTek® connectors. This design is based only upon parameters shown, and is for an individual building component, not a truss system. Before use, the building designer must verify the applicability of design parameters and properly incorporate this design into the overall building design. Bracing indicated is to prevent buckling of individual truss web and/or chord members only. Additional temporary and permanent bracing is always required for stability and to prevent collapse with possible personal injury and property damage. For general guidance regarding the fabrication, storage, delivery, erection and bracing of trusses and truss systems, see **ANSI/TPI1 Quality Criteria, and DSB-22** available from Truss Plate Institute (www.tpinst.org) and **BCSI Building Component Safety Information** available from the Structural Building Component Association (www.sbcsccomponents.com)

MiTek®

16023 Swingley Ridge Rd.
Chesterfield, MO 63017
314.434.1200 / MiTek-US.com

Job 242042	Truss 16	Truss Type Jack-Open	Qty 3	Ply 1	GENE BOSLEY RES. / ROOF
---------------	-------------	-------------------------	----------	----------	-------------------------


AS NOTED FOR PLAN REVIEW
DEVELOPMENT SERVICES
LEE'S SUMMIT, MISSOURI

Heartland Truss, Inc, Plattsburg, MO - 64477,

8.730 s Oct 31 2024 MiTek Industries, Inc. Wed Nov 27 17:36:26 2024 Page 1

ID:mrcY1X_2FQFIXm9hhpx4TmyPVL_-jm6pOJZ9v5toCOUw31X20jwG5QWDT5hdhx29vF2T

12/02/2024

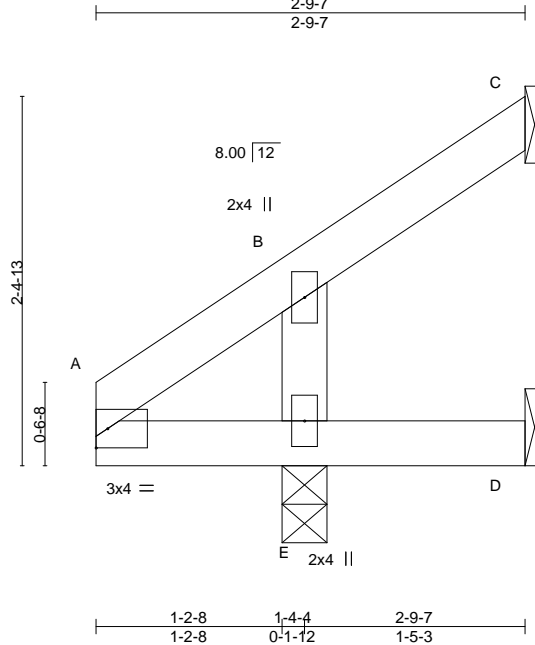

Scale = 1:15.0

LOADING (psf)	SPACING-	CSI.	DEFL.	PLATES	GRIP
TCLL 25.0 (Roof Snow=25.0)	2-0-0 Plate Grip DOL 1.15 Lumber DOL 1.15	TC 0.14 BC 0.12 WB 0.04 Matrix-MP	in (loc) l/defl L/d Vert(LL) 0.00 E >999 240 Vert(CT) 0.00 D-E >999 180 Horz(CT) -0.01 C n/a n/a	MT20	244/190
TCDL 10.0	Rep Stress Incr YES				
BCLL 0.0	Code IRC2018/TPI2014				
BCDL 10.0				Weight: 11 lb	FT = 20%

LUMBER-
TOP CHORD 2x4 SP No.2
BOT CHORD 2x4 SP No.2
WEBS 2x4 SP No.3

BRACING-
TOP CHORD Structural wood sheathing directly applied or 2-9-7 oc purlins.
BOT CHORD Rigid ceiling directly applied or 10-0-0 oc bracing.

REACTIONS. (size) C=Mechanical, D=Mechanical, E=0-3-8
Max Horz E=71(LC 12)
Max Uplift C=-43(LC 12), D=-27(LC 18)
Max Grav C=29(LC 21), D=11(LC 10), E=339(LC 18)

FORCES. (lb) - Max. Comp./Max. Ten. - All forces 250 (lb) or less except when shown.

NOTES-

- 1) Wind: ASCE 7-16; Vult=115mph (3-second gust) Vasd=91mph; TCDL=6.0psf; BCDL=6.0psf; h=20ft; Cat. II; Exp C; Enclosed; MWFRS (envelope) gable end zone and C-C Exterior(2E) zone; cantilever left and right exposed; end vertical left and right exposed; C-C for members and forces & MWFRS for reactions shown; Lumber DOL=1.33 plate grip DOL=1.33
- 2) TCLL: ASCE 7-16; Pf=25.0 psf (Lum DOL=1.15 Plate DOL=1.15); Is=1.0; Rough Cat C; Fully Exp.; Ce=0.9; Cs=1.00; Ct=1.10
- 3) Unbalanced snow loads have been considered for this design.
- 4) This truss has been designed for a 10.0 psf bottom chord live load nonconcurrent with any other live loads.
- 5) Refer to girder(s) for truss to truss connections.
- 6) Provide mechanical connection (by others) of truss to bearing plate capable of withstanding 43 lb uplift at joint C and 27 lb uplift at joint D.
- 7) This truss is designed in accordance with the 2018 International Residential Code sections R502.11.1 and R802.10.2 and referenced standard ANSI/TPI 1.



November 27, 2024

WARNING - Verify design parameters and READ NOTES ON THIS AND INCLUDED MITEK REFERENCE PAGE MII-7473 rev. 1/2/2023 BEFORE USE.

Design valid for use only with MiTek® connectors. This design is based only upon parameters shown, and is for an individual building component, not a truss system. Before use, the building designer must verify the applicability of design parameters and properly incorporate this design into the overall building design. Bracing indicated is to prevent buckling of individual truss web and/or chord members only. Additional temporary and permanent bracing is always required for stability and to prevent collapse with possible personal injury and property damage. For general guidance regarding the fabrication, storage, delivery, erection and bracing of trusses and truss systems, see **ANSI/TPI1 Quality Criteria, and DSB-22** available from Truss Plate Institute (www.tpinst.org) and **BCSI Building Component Safety Information** available from the Structural Building Component Association (www.sbcsccomponents.com)

MiTek®

16023 Swingley Ridge Rd.
Chesterfield, MO 63017
314.434.1200 / MiTek-US.com

Job 242042	Truss 17	Truss Type Jack-Open	Qty 2	Ply 1	GENE BOSLEY RES. / ROOF
---------------	-------------	-------------------------	----------	----------	-------------------------


AS NOTED FOR PLAN REVIEW
DEVELOPMENT SERVICES
LEE'S SUMMIT, MISSOURI

Heartland Truss, Inc, Plattsburg, MO - 64477,

8.730 s Oct 31 2024 MiTek Industries, Inc. Wed Nov 27 07:36:26 2024 Page 1

ID:mrcY1X_2FQFIXm9hpx4TmyPVL_-jm6pOJZ9v5toCOUw31X20jvGkQIZDTDhdhX29vF3T

12/02/2024

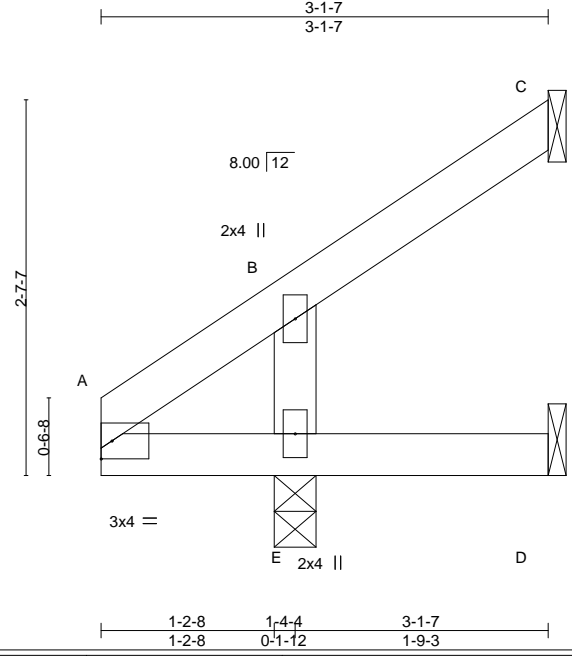

Scale: 3/4"=1'

LOADING (psf)	SPACING-	CSI.	DEFL.	PLATES	GRIP
TCLL 25.0 (Roof Snow=25.0)	2-0-0 Plate Grip DOL 1.15 Lumber DOL 1.15	TC 0.15 BC 0.12 WB 0.05 Matrix-MP	in (loc) l/defl L/d Vert(LL) 0.00 D-E >999 240 Vert(CT) 0.00 D-E >999 180 Horz(CT) -0.01 C n/a n/a	MT20	244/190
TCDL 10.0	Rep Stress Incr YES				
BCLL 0.0	Code IRC2018/TPI2014				
BCDL 10.0				Weight: 12 lb	FT = 20%

LUMBER-	BRACING-
TOP CHORD 2x4 SP No.2	TOP CHORD Structural wood sheathing directly applied or 3-1-7 oc purlins.
BOT CHORD 2x4 SP No.2	BOT CHORD Rigid ceiling directly applied or 10-0-0 oc bracing.
WEBS 2x4 SP No.3	

REACTIONS. (size) C=Mechanical, D=Mechanical, E=0-3-8
 Max Horz E=79(LC 12)
 Max Uplift C=-49(LC 12), D=-13(LC 12)
 Max Grav C=53(LC 18), D=17(LC 10), E=349(LC 18)

FORCES. (lb) - Max. Comp./Max. Ten. - All forces 250 (lb) or less except when shown.

NOTES-

- 1) Wind: ASCE 7-16; Vult=115mph (3-second gust) Vasd=91mph; TCDL=6.0psf; BCDL=6.0psf; h=20ft; Cat. II; Exp C; Enclosed; MWFRS (envelope) gable end zone and C-C Exterior(2E) zone; cantilever left and right exposed; end vertical left and right exposed; C-C for members and forces & MWFRS for reactions shown; Lumber DOL=1.33 plate grip DOL=1.33
- 2) TCLL: ASCE 7-16; Pf=25.0 psf (Lum DOL=1.15 Plate DOL=1.15); Is=1.0; Rough Cat C; Fully Exp.; Ce=0.9; Cs=1.00; Ct=1.10
- 3) Unbalanced snow loads have been considered for this design.
- 4) This truss has been designed for a 10.0 psf bottom chord live load nonconcurrent with any other live loads.
- 5) Refer to girder(s) for truss to truss connections.
- 6) Provide mechanical connection (by others) of truss to bearing plate capable of withstanding 49 lb uplift at joint C and 13 lb uplift at joint D.
- 7) This truss is designed in accordance with the 2018 International Residential Code sections R502.11.1 and R802.10.2 and referenced standard ANSI/TPI 1.



November 27, 2024

Job 242042	Truss 18	Truss Type Jack-Closed	Qty 6	Ply 1	GENE BOSLEY RES. / ROOF
---------------	-------------	---------------------------	----------	----------	-------------------------


AS NOTED FOR PLAN REVIEW
DEVELOPMENT SERVICES
LEE'S SUMMIT, MISSOURI

Heartland Truss, Inc, Plattsburg, MO - 64477,

8.730 s Oct 31 2024 MiTek Industries, Inc. Wed No 27-07-30-26-2024 Page 1

ID: mrcY1X_2FQFIXm9hhpx4TmyPVL_jm6pOJZ9v5toCOLw31X20jvDd2r1tSOHdhzX2gF2T

12/02/2024

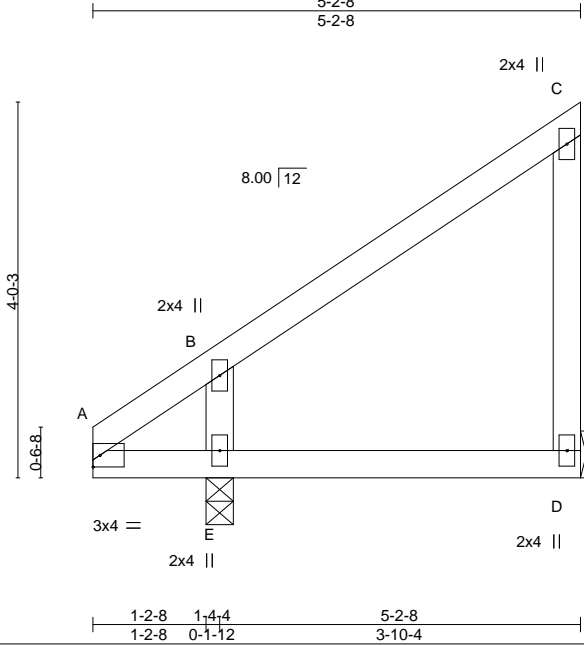

Scale = 1:24.6

LOADING (psf)	SPACING-	CSI.	DEFL.	in (loc)	l/defl	L/d	PLATES	GRIP
TCLL 25.0 (Roof Snow=25.0)	2-0-0 Plate Grip DOL 1.15	TC 0.36	Vert(LL) -0.02	D-E	>999	240	MT20	244/190
TCDL 10.0	Lumber DOL 1.15	BC 0.22	Vert(CT) -0.02	D-E	>999	180		
BCLL 0.0	Rep Stress Incr YES	WB 0.09	Horz(CT) 0.00	D	n/a	n/a		
BCDL 10.0	Code IRC2018/TPI2014	Matrix-MP					Weight: 24 lb	FT = 20%

LUMBER-
TOP CHORD 2x4 SP No.2
BOT CHORD 2x4 SP No.2
WEBS 2x4 SP No.3

BRACING-
TOP CHORD Structural wood sheathing directly applied or 5-2-8 oc purlins, except end verticals.
BOT CHORD Rigid ceiling directly applied or 10-0-0 oc bracing.

REACTIONS. (size) D=Mechanical, E=0-3-8
Max Horz E=134(LC 11)
Max Uplift D=-63(LC 9), E=-17(LC 12)
Max Grav D=220(LC 18), E=474(LC 18)

FORCES. (lb) - Max. Comp./Max. Ten. - All forces 250 (lb) or less except when shown.
WEBS B-E=-449/228

NOTES-

- 1) Wind: ASCE 7-16; Vult=115mph (3-second gust) Vasd=91mph; TCDL=6.0psf; BCDL=6.0psf; h=20ft; Cat. II; Exp C; Enclosed; MWFRS (envelope) gable end zone and C-C Exterior(2E) zone; cantilever left and right exposed ; end vertical left and right exposed;C-C for members and forces & MWFRS for reactions shown; Lumber DOL=1.33 plate grip DOL=1.33
- 2) TCLL: ASCE 7-16; Pf=25.0 psf (Lum DOL=1.15 Plate DOL=1.15); Is=1.0; Rough Cat C; Fully Exp.; Ce=0.9; Cs=1.00; Ct=1.10
- 3) Unbalanced snow loads have been considered for this design.
- 4) This truss has been designed for a 10.0 psf bottom chord live load nonconcurrent with any other live loads.
- 5) Refer to girder(s) for truss to truss connections.
- 6) Provide mechanical connection (by others) of truss to bearing plate capable of withstanding 63 lb uplift at joint D and 17 lb uplift at joint E.
- 7) This truss is designed in accordance with the 2018 International Residential Code sections R502.11.1 and R802.10.2 and referenced standard ANSI/TPI 1.



November 27, 2024

WARNING - Verify design parameters and READ NOTES ON THIS AND INCLUDED MITEK REFERENCE PAGE MII-7473 rev. 1/2/2023 BEFORE USE.

Design valid for use only with MiTek® connectors. This design is based only upon parameters shown, and is for an individual building component, not a truss system. Before use, the building designer must verify the applicability of design parameters and properly incorporate this design into the overall building design. Bracing indicated is to prevent buckling of individual truss web and/or chord members only. Additional temporary and permanent bracing is always required for stability and to prevent collapse with possible personal injury and property damage. For general guidance regarding the fabrication, storage, delivery, erection and bracing of trusses and truss systems, see **ANSI/TPI1 Quality Criteria, and DSB-22** available from Truss Plate Institute (www.tpinst.org) and **BCSI Building Component Safety Information** available from the Structural Building Component Association (www.sbcsccomponents.com)

MiTek®

16023 Swingley Ridge Rd.
Chesterfield, MO 63017
314.434.1200 / MiTek-US.com

Job 242042	Truss 19	Truss Type Jack-Closed	Qty 5	Ply 1	GENE BOSLEY RES. / ROOF
---------------	-------------	---------------------------	----------	----------	-------------------------


AS NOTED FOR PLAN REVIEW
DEVELOPMENT SERVICES
LEE'S SUMMIT, MISSOURI

Heartland Truss, Inc, Plattsburg, MO - 64477,

8.730 s Oct 31 2024 MiTek Industries, Inc. Wed No 27-07-89-27-2024 Page 1

ID:mrcY1X_2FQFIxM9hpx4TmyPVI_-BzgbceaogO7fqY37dk2HYWTPyq6rww1RSL4z7YF217

12/02/2024

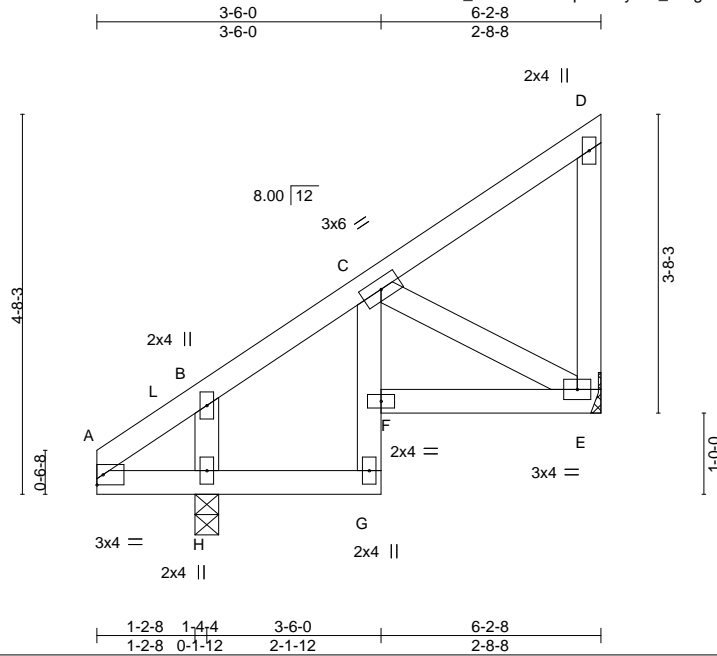

Scale = 1:28.4

LOADING (psf)	SPACING-	CSI.	DEFL.	in (loc)	l/defl	L/d	PLATES	GRIP
TCLL 25.0 (Roof Snow=25.0)	2-0-0 Plate Grip DOL 1.15 Lumber DOL 1.15	TC 0.26 BC 0.57 WB 0.06 Matrix-MP	Vert(LL) -0.02 Vert(CT) -0.03 Horz(CT) 0.02	F >999 F >999 E n/a	240 180 n/a		MT20	244/190
TCDL 10.0	Rep Stress Incr YES Code IRC2018/TPI2014						Weight: 34 lb	FT = 20%
BCLL 0.0								
BCDL 10.0								

LUMBER-
TOP CHORD 2x4 SP No.2
BOT CHORD 2x4 SP No.2 *Except*
C-G: 2x4 SP No.3
WEBS 2x4 SP No.3

BRACING-
TOP CHORD Structural wood sheathing directly applied or 6-0-0 oc purlins, except end verticals.
BOT CHORD Rigid ceiling directly applied or 10-0-0 oc bracing. Except: 6-0-0 oc bracing: F-G.

REACTIONS. (size) H=0-3-8, E=Mechanical
Max Horz H=141(LC 9)
Max Uplift H=-10(LC 12), E=-80(LC 12)
Max Grav H=478(LC 18), E=305(LC 18)

FORCES. (lb) - Max. Comp./Max. Ten. - All forces 250 (lb) or less except when shown.
TOP CHORD B-C=-257/49
BOT CHORD E-F=-113/261
WEBS B-H=-321/114, C-E=-252/141

NOTES-

- 1) Wind: ASCE 7-16; Vult=115mph (3-second gust) Vasd=91mph; TCDL=6.0psf; BCDL=6.0psf; h=20ft; Cat. II; Exp C; Enclosed; MWFRS (envelope) gable end zone and C-C Exterior(2E) zone; cantilever left and right exposed ; end vertical left and right exposed;C-C for members and forces & MWFRS for reactions shown; Lumber DOL=1.33 plate grip DOL=1.33
- 2) TCLL: ASCE 7-16; Pf=25.0 psf (Lum DOL=1.15 Plate DOL=1.15); Is=1.0; Rough Cat C; Fully Exp.; Ce=0.9; Cs=1.00; Ct=1.10
- 3) Unbalanced snow loads have been considered for this design.
- 4) This truss has been designed for a 10.0 psf bottom chord live load nonconcurrent with any other live loads.
- 5) Refer to girder(s) for truss to truss connections.
- 6) Provide mechanical connection (by others) of truss to bearing plate capable of withstanding 10 lb uplift at joint H and 80 lb uplift at joint E.
- 7) This truss is designed in accordance with the 2018 International Residential Code sections R502.11.1 and R802.10.2 and referenced standard ANSI/TPI 1.



November 27, 2024

WARNING - Verify design parameters and READ NOTES ON THIS AND INCLUDED MITEK REFERENCE PAGE MII-7473 rev. 1/2/2023 BEFORE USE.

Design valid for use only with MiTek® connectors. This design is based only upon parameters shown, and is for an individual building component, not a truss system. Before use, the building designer must verify the applicability of design parameters and properly incorporate this design into the overall building design. Bracing indicated is to prevent buckling of individual truss web and/or chord members only. Additional temporary and permanent bracing is always required for stability and to prevent collapse with possible personal injury and property damage. For general guidance regarding the fabrication, storage, delivery, erection and bracing of trusses and truss systems, see **ANSI/TPI1 Quality Criteria, and DSB-22** available from Truss Plate Institute (www.tpinst.org) and **BCSI Building Component Safety Information** available from the Structural Building Component Association (www.sbcsccomponents.com)

MiTek®

16023 Swingley Ridge Rd.
Chesterfield, MO 63017
314.434.1200 / MiTek-US.com

Job	Truss	Truss Type	Qty	Ply	GENE BOSLEY RES. / ROOF
242042	20	Jack-Closed	4	1	

RELEASE FOR CONSTRUCTION

AS NOTED FOR PLAN REVIEW

DEVELOPMENT SERVICES


LEE'S SUMMIT, MISSOURI

12/02/2024

Heartland Truss, Inc, Plattsburg, MO - 64477,

8.730 s Oct 31 2024 MiTek Industries, Inc. Wed Nov 27 07:36:27 2024 Page 1

ID: mrcY1X_2FQFIXm9hhpx4TmyPVL_-BzgBceaogO?fq37dk2HYwTdq9avMRSU4zTYE21

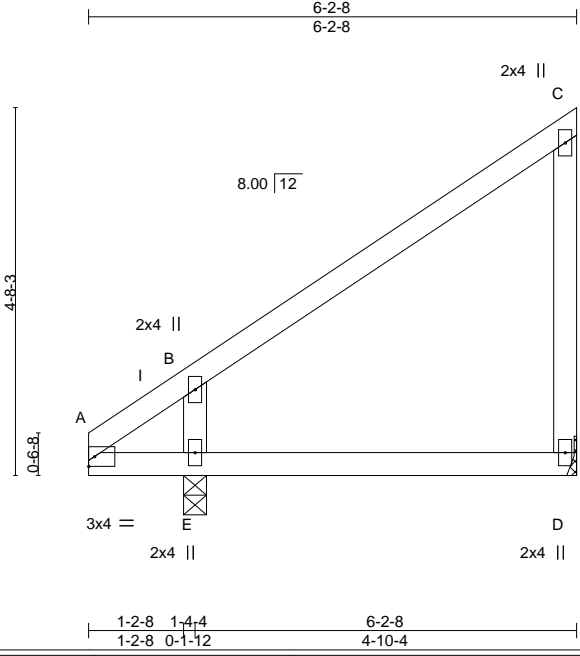

Scale = 1:29.3

LOADING (psf)	SPACING-	CSI.	DEFL.	in (loc)	l/defl	L/d	PLATES	GRIP
TCLL 25.0 (Roof Snow=25.0)	2-0-0 Plate Grip DOL 1.15	TC 0.65	Vert(LL) 0.04	D-E	>999	240	MT20	244/190
TCDL 10.0	Lumber DOL 1.15	BC 0.32	Vert(CT) -0.06	D-E	>999	180		
BCLL 0.0	Rep Stress Incr YES	WB 0.11	Horz(CT) 0.00	D	n/a	n/a		
BCDL 10.0	Code IRC2018/TPI2014	Matrix-MP					Weight: 28 lb	FT = 20%

LUMBER-	BRACING-
TOP CHORD 2x4 SP No.2	TOP CHORD Structural wood sheathing directly applied or 6-0-0 oc purlins, except end verticals.
BOT CHORD 2x4 SP No.2	BOT CHORD Rigid ceiling directly applied or 10-0-0 oc bracing.
WEBS 2x4 SP No.3	

REACTIONS. (size) D=Mechanical, E=0-3-8
 Max Horz E=160(LC 11)
 Max Uplift D=-79(LC 12), E=-12(LC 12)
 Max Grav D=305(LC 18), E=478(LC 18)

FORCES. (lb) - Max. Comp./Max. Ten. - All forces 250 (lb) or less except when shown.
 WEBS B-E=-540/291

NOTES-

- 1) Wind: ASCE 7-16; Vult=115mph (3-second gust) Vasd=91mph; TCDL=6.0psf; BCDL=6.0psf; h=20ft; Cat. II; Exp C; Enclosed; MWFRS (envelope) gable end zone and C-C Exterior(2E) zone; cantilever left and right exposed ; end vertical left and right exposed;C-C for members and forces & MWFRS for reactions shown; Lumber DOL=1.33 plate grip DOL=1.33
- 2) TCLL: ASCE 7-16; Pf=25.0 psf (Lum DOL=1.15 Plate DOL=1.15); Is=1.0; Rough Cat C; Fully Exp.; Ce=0.9; Cs=1.00; Ct=1.10
- 3) Unbalanced snow loads have been considered for this design.
- 4) This truss has been designed for a 10.0 psf bottom chord live load nonconcurrent with any other live loads.
- 5) Refer to girder(s) for truss to truss connections.
- 6) Provide mechanical connection (by others) of truss to bearing plate capable of withstanding 79 lb uplift at joint D and 12 lb uplift at joint E.
- 7) This truss is designed in accordance with the 2018 International Residential Code sections R502.11.1 and R802.10.2 and referenced standard ANSI/TPI 1.




November 27, 2024

Job 242042	Truss 21	Truss Type Hip Girder	Qty 1	Ply 1	GENE BOSLEY RES. / ROOF	AS NOTED FOR PLAN REVIEW DEVELOPMENT SERVICES LEE'S SUMMIT, MISSOURI
---------------	-------------	--------------------------	----------	----------	-------------------------	--

RELEASE FOR CONSTRUCTION
12/02/2024

Heartland Truss, Inc, Plattsburg, MO - 64477, 8.730 s Oct 31 2024 MiTek Industries, Inc. Wed Nov 27 17:36:28 2024 Page 1
 ID:mrCY1X_2FQIFXm9hhpx4TmyPVI_-f9EZp_aQQi7WSieJASaW587RGETE C a079ef2V F21

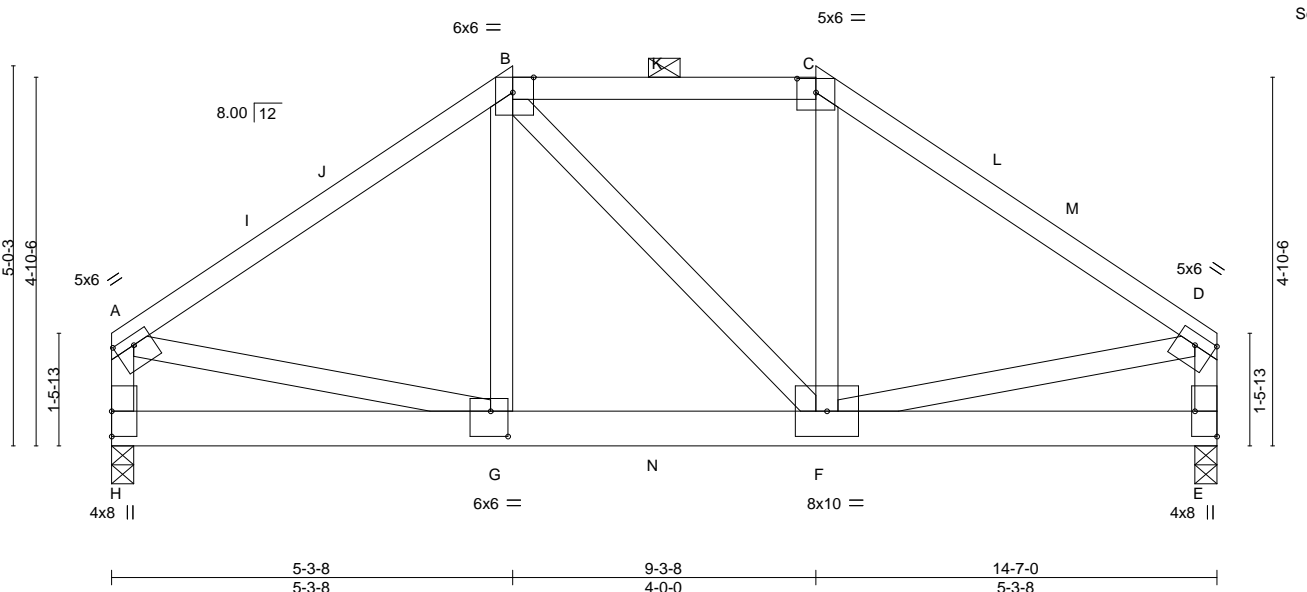

Scale = 1:30.4

Plate Offsets (X, Y)-- [A:0-3-0,0-1-8], [B:0-3-5,Edge], [C:0-3-0,0-2-3], [D:Edge,0-1-12], [E:Edge,0-3-8], [G:0-2-12,0-4-0]

LOADING (psf)	SPACING-	CSI.	DEFL.	PLATES	GRIP
TCLL 25.0 (Roof Snow=25.0)	Plate Grip DOL 1.15 Lumber DOL 1.15	TC 0.86 BC 0.49 WB 0.66	in (loc) l/defl L/d Vert(LL) -0.06 F-G >999 240 Vert(CT) -0.08 F-G >999 180 Horz(CT) 0.01 E n/a n/a	MT20	244/190
TCDL 10.0	Rep Stress Incr NO Code IRC2018/TPI2014	Matrix-MS			
BCLL 0.0					
BCDL 10.0					
				Weight: 97 lb	FT = 20%

LUMBER-	BRACING-
TOP CHORD 2x4 SP 1650F 1.5E *Except* B-C: 2x4 SP No.2	TOP CHORD Structural wood sheathing directly applied or 3-8-4 oc purlins, except end verticals, and 2-0-0 oc purlins (3-9-1 max.): B-C.
BOT CHORD 2x6 SP No.1	BOT CHORD Rigid ceiling directly applied or 10-0-0 oc bracing.
WEBS 2x4 SP No.3	

REACTIONS. (size) H=0-3-8, E=0-3-8
 Max Horz H=-127(LC 8)
 Max Uplift H=-405(LC 12), E=-405(LC 13)
 Max Grav H=1839(LC 32), E=1836(LC 32)

FORCES. (lb) - Max. Comp./Max. Ten. - All forces 250 (lb) or less except when shown.
 TOP CHORD A-B=-2199/587, B-C=-1672/537, C-D=-2198/590, A-H=-1786/462, D-E=-1786/457
 BOT CHORD G-H=-137/268, F-G=-436/1670
 WEBS B-G=-220/749, C-F=-237/825, A-G=-415/1581, D-F=-418/1582


- NOTES-**
- 1) Wind: ASCE 7-16; Vult=115mph (3-second gust) Vasd=91mph; TCDL=6.0psf; BCDL=6.0psf; h=20ft; Cat. II; Exp C; Enclosed; MWFRS (envelope) gable end zone and C-C Exterior(2E) 0-1-12 to 3-1-12, Exterior(2R) 3-1-12 to 11-5-4, Exterior(2E) 11-5-4 to 14-5-4 zone; cantilever left and right exposed; end vertical left and right exposed; C-C for members and forces & MWFRS for reactions shown; Lumber DOL=1.33 plate grip DOL=1.33
 - 2) TCLL: ASCE 7-16; Pf=25.0 psf (Lum DOL=1.15 Plate DOL=1.15); Is=1.0; Rough Cat C; Fully Exp.; Ce=0.9; Cs=1.00; Ct=1.10
 - 3) Unbalanced snow loads have been considered for this design.
 - 4) Provide adequate drainage to prevent water ponding.
 - 5) This truss has been designed for a 10.0 psf bottom chord live load nonconcurrent with any other live loads.
 - 6) Provide mechanical connection (by others) of truss to bearing plate capable of withstanding 405 lb uplift at joint H and 405 lb uplift at joint E.
 - 7) This truss is designed in accordance with the 2018 International Residential Code sections R502.11.1 and R802.10.2 and referenced standard ANSI/TPI 1.
 - 8) Graphical purlin representation does not depict the size or the orientation of the purlin along the top and/or bottom chord.
 - 9) Hanger(s) or other connection device(s) shall be provided sufficient to support concentrated load(s) 812 lb down and 314 lb up at 5-3-8, and 321 lb down and 95 lb up at 7-2-12, and 812 lb down and 314 lb up at 9-2-12 on bottom chord. The design/selection of such connection device(s) is the responsibility of others.
 - 10) In the LOAD CASE(S) section, loads applied to the face of the truss are noted as front (F) or back (B).

LOAD CASE(S) Standard
 1) Dead + Snow (balanced): Lumber Increase=1.15, Plate Increase=1.15
 Uniform Loads (plf)
 Vert: A-B=-70, B-C=-70, C-D=-70, E-H=-20



November 27, 2024

Continued on page 2

<p>WARNING - Verify design parameters and READ NOTES ON THIS AND INCLUDED MITEK REFERENCE PAGE MII-7473 rev. 1/2/2023 BEFORE USE.</p> <p>Design valid for use only with MiTek® connectors. This design is based only upon parameters shown, and is for an individual building component, not a truss system. Before use, the building designer must verify the applicability of design parameters and properly incorporate this design into the overall building design. Bracing indicated is to prevent buckling of individual truss web and/or chord members only. Additional temporary and permanent bracing is always required for stability and to prevent collapse with possible personal injury and property damage. For general guidance regarding the fabrication, storage, delivery, erection and bracing of trusses and truss systems, see ANSI/TPI1 Quality Criteria, and DSB-22 available from Truss Plate Institute (www.tpinst.org) and BCSI Building Component Safety Information available from the Structural Building Component Association (www.sbcsccomponents.com)</p>	 16023 Swingley Ridge Rd. Chesterfield, MO 63017 314.434.1200 / MiTek-US.com
---	--

Job	Truss	Truss Type	Qty	Ply	GENE BOSLEY RES. / ROOF
242042	21	Hip Girder	1	1	

RELEASE FOR CONSTRUCTION

AS NOTED FOR PLAN REVIEW

DEVELOPMENT SERVICES

LEE'S SUMMIT, MISSOURI

12/02/2024

Heartland Truss, Inc, Plattsburg, MO - 64477,

8.730 s Oct 31 2024 MiTek Industries, Inc. Wed Nov 27 17:36:28 2024 Page 2
 ID: mrcY1X_2FQFIXm9hhpx4TmyPVI_-f9EZp_aQQi7WSieJASaW58?RGETA=C&ab?9ef2Vf2T

LOAD CASE(S) Standard
 Concentrated Loads (lb)
 Vert: G=-812(B) F=-812(B) N=-321(B)

WARNING - Verify design parameters and READ NOTES ON THIS AND INCLUDED MITEK REFERENCE PAGE MII-7473 rev. 1/2/2023 BEFORE USE.

Design valid for use only with MiTek® connectors. This design is based only upon parameters shown, and is for an individual building component, not a truss system. Before use, the building designer must verify the applicability of design parameters and properly incorporate this design into the overall building design. Bracing indicated is to prevent buckling of individual truss web and/or chord members only. Additional temporary and permanent bracing is always required for stability and to prevent collapse with possible personal injury and property damage. For general guidance regarding the fabrication, storage, delivery, erection and bracing of trusses and truss systems, see **ANSI/TPI1 Quality Criteria, and DSB-22** available from Truss Plate Institute (www.tpinst.org) and **BCSI Building Component Safety Information** available from the Structural Building Component Association (www.sbcsccomponents.com)

MiTek®

16023 Swingley Ridge Rd.
 Chesterfield, MO 63017
 314.434.1200 / MiTek-US.com


Job	Truss	Truss Type	Qty	Ply	GENE BOSLEY RES. / ROOF
242042	22	Diagonal Hip Girder	2	1	

AS NOTED FOR PLAN REVIEW
DEVELOPMENT SERVICES
LEE'S SUMMIT, MISSOURI

Heartland Truss, Inc, Plattsburg, MO - 64477,


8.730 s Oct 31 2024 MiTek Industries, Inc.

Wed No 27-07-30-28 2024 Page 1

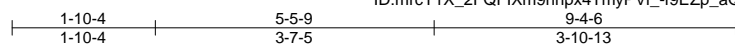

12/02/2024

Scale = 1:29.8

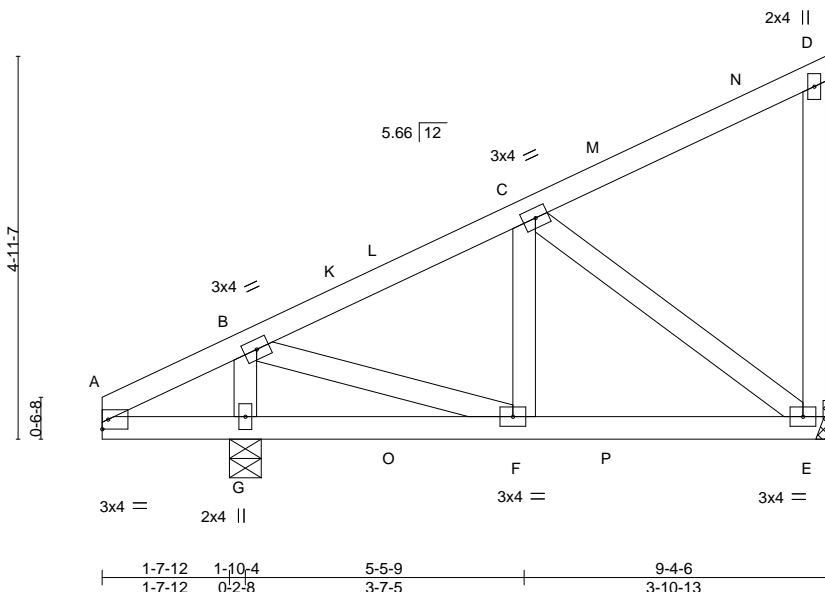

LOADING (psf)	SPACING-	CSI.	DEFL.	PLATES	GRIP
TCLL 25.0 (Roof Snow=25.0)	2-0-0 Plate Grip DOL 1.15 Lumber DOL 1.15	TC 0.33 BC 0.40 WB 0.20 Matrix-MS	in (loc) l/defl L/d Vert(LL) -0.02 E-F >999 240 Vert(CT) -0.03 E-F >999 180 Horz(CT) -0.00 E n/a n/a	MT20	244/190
TCDL 10.0	Rep Stress Incr NO				
BCLL 0.0	Code IRC2018/TPI2014				
BCDL 10.0				Weight: 53 lb	FT = 20%

LUMBER-	BRACING-
TOP CHORD 2x4 SP No.2	TOP CHORD Structural wood sheathing directly applied or 6-0-0 oc purlins, except end verticals.
BOT CHORD 2x4 SP No.2	BOT CHORD Rigid ceiling directly applied or 6-0-0 oc bracing.
WEBS 2x4 SP No.3	

REACTIONS. (size) G=0-4-15, E=Mechanical
Max Horz G=162(LC 11)
Max Uplift G=-180(LC 12), E=-190(LC 12)
Max Grav G=578(LC 18), E=519(LC 18)

FORCES. (lb) - Max. Comp./Max. Ten. - All forces 250 (lb) or less except when shown.
TOP CHORD B-C=-451/232
BOT CHORD E-F=-210/367
WEBS B-G=-568/316, B-F=-148/484, C-E=-440/301

- NOTES-**
- 1) Wind: ASCE 7-16; Vult=115mph (3-second gust) Vasd=91mph; TCDL=6.0psf; BCDL=6.0psf; h=20ft; Cat. II; Exp C; Enclosed; MWFRS (envelope) gable end zone and C-C Corner(3) 0-0-0 to 4-2-15, Exterior(2R) 4-2-15 to 9-2-9 zone; cantilever left and right exposed ; end vertical left and right exposed;C-C for members and forces & MWFRS for reactions shown; Lumber DOL=1.33 plate grip DOL=1.33
 - 2) TCLL: ASCE 7-16; Pf=25.0 psf (Lum DOL=1.15 Plate DOL=1.15); Is=1.0; Rough Cat C; Fully Exp.; Ce=0.9; Cs=1.00; Ct=1.10
 - 3) Unbalanced snow loads have been considered for this design.
 - 4) This truss has been designed for a 10.0 psf bottom chord live load nonconcurrent with any other live loads.
 - 5) Refer to girder(s) for truss to truss connections.
 - 6) Provide mechanical connection (by others) of truss to bearing plate capable of withstanding 180 lb uplift at joint G and 190 lb uplift at joint E.
 - 7) This truss is designed in accordance with the 2018 International Residential Code sections R502.11.1 and R802.10.2 and referenced standard ANSI/TPI 1.
 - 8) Hanger(s) or other connection device(s) shall be provided sufficient to support concentrated load(s) 82 lb down and 100 lb up at 3-9-8, and 82 lb down and 100 lb up at 3-9-8, and 129 lb down and 122 lb up at 6-7-7 on top chord, and 64 lb up at 3-9-8, 64 lb up at 3-9-8, and 142 lb down and 88 lb up at 6-7-7, and 26 lb down and 22 lb up at 6-7-7 on bottom chord. The design/selection of such connection device(s) is the responsibility of others.
 - 9) In the LOAD CASE(S) section, loads applied to the face of the truss are noted as front (F) or back (B).

LOAD CASE(S) Standard

- 1) Dead + Snow (balanced): Lumber Increase=1.15, Plate Increase=1.15
Uniform Loads (plf)
Vert: A-D=-70, E-H=-20
Concentrated Loads (lb)
Vert: L=60(F=30, B=30) M=-49(B) O=66(F=33, B=33) P=-155(F=-142, B=-13)



November 27, 2024

WARNING - Verify design parameters and READ NOTES ON THIS AND INCLUDED MITEK REFERENCE PAGE MII-7473 rev. 1/2/2023 BEFORE USE.
Design valid for use only with MiTek® connectors. This design is based only upon parameters shown, and is for an individual building component, not a truss system. Before use, the building designer must verify the applicability of design parameters and properly incorporate this design into the overall building design. Bracing indicated is to prevent buckling of individual truss web and/or chord members only. Additional temporary and permanent bracing is always required for stability and to prevent collapse with possible personal injury and property damage. For general guidance regarding the fabrication, storage, delivery, erection and bracing of trusses and truss systems, see **ANSI/TPI1 Quality Criteria, and DSB-22** available from Truss Plate Institute (www.tpinst.org) and **BCSI Building Component Safety Information** available from the Structural Building Component Association (www.sbcsccomponents.com)

MiTek®
16023 Swingley Ridge Rd.
Chesterfield, MO 63017
314.434.1200 / MiTek-US.com

Job 242042	Truss 23	Truss Type Jack-Open	Qty 2	Ply 1	GENE BOSLEY RES. / ROOF
---------------	-------------	-------------------------	----------	----------	-------------------------

AS NOTED FOR PLAN REVIEW
DEVELOPMENT SERVICES
LEE'S SUMMIT, MISSOURI

Heartland Truss, Inc, Plattsburg, MO - 64477,


8.730 s Oct 31 2024 MiTek Industries, Inc.

Wed Nov 27 07:39:29 2024 Page 1

ID:mrcY1X_2FQFIXm9hhpx4TmyPVL_7Loy1Kb2B0FN4sDVk95eLVYAtQWkUJBPZNF37

12/02/2024

Scale = 1:21.2

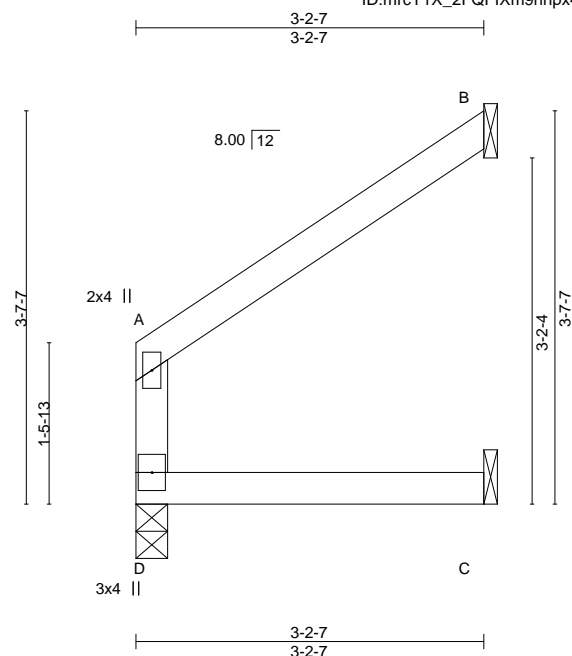

LOADING (psf)	SPACING-	CSI.	DEFL.	in (loc)	l/defl	L/d	PLATES	GRIP
TCLL 25.0 (Roof Snow=25.0)	2-0-0 Plate Grip DOL 1.15 Lumber DOL 1.15	TC 0.31 BC 0.21 WB 0.00 Matrix-MR	Vert(LL) 0.01 Vert(CT) -0.01 Horz(CT) -0.03	C-D C-D B	>999 >999 n/a	240 180 n/a	MT20	244/190
TCDL 10.0	Rep Stress Incr YES Code IRC2018/TPI2014						Weight: 12 lb	FT = 20%
BCLL 0.0								
BCDL 10.0								

LUMBER-	BRACING-
TOP CHORD 2x4 SP No.2	TOP CHORD Structural wood sheathing directly applied or 3-2-7 oc purlins, except end verticals.
BOT CHORD 2x4 SP No.2	BOT CHORD Rigid ceiling directly applied or 10-0-0 oc bracing.
WEBS 2x4 SP No.3	

REACTIONS. (size) D=0-3-8, B=Mechanical, C=Mechanical
 Max Horz D=70(LC 9)
 Max Uplift B=-73(LC 12), C=-4(LC 12)
 Max Grav D=190(LC 18), B=148(LC 18), C=58(LC 5)

FORCES. (lb) - Max. Comp./Max. Ten. - All forces 250 (lb) or less except when shown.

NOTES-

- 1) Wind: ASCE 7-16; Vult=115mph (3-second gust) Vasd=91mph; TCDL=6.0psf; BCDL=6.0psf; h=20ft; Cat. II; Exp C; Enclosed; MWFRS (envelope) gable end zone and C-C Exterior(2E) zone; cantilever left and right exposed; end vertical left and right exposed; C-C for members and forces & MWFRS for reactions shown; Lumber DOL=1.33 plate grip DOL=1.33
- 2) TCLL: ASCE 7-16; Pf=25.0 psf (Lum DOL=1.15 Plate DOL=1.15); Is=1.0; Rough Cat C; Fully Exp.; Ce=0.9; Cs=1.00; Ct=1.10
- 3) Unbalanced snow loads have been considered for this design.
- 4) This truss has been designed for a 10.0 psf bottom chord live load nonconcurrent with any other live loads.
- 5) Refer to girder(s) for truss to truss connections.
- 6) Provide mechanical connection (by others) of truss to bearing plate capable of withstanding 73 lb uplift at joint B and 4 lb uplift at joint C.
- 7) This truss is designed in accordance with the 2018 International Residential Code sections R502.11.1 and R802.10.2 and referenced standard ANSI/TPI 1.



November 27, 2024

Job 242042	Truss 24	Truss Type Jack-Open	Qty 8	Ply 1	GENE BOSLEY RES. / ROOF
---------------	-------------	-------------------------	----------	----------	-------------------------

RELEASE FOR CONSTRUCTION


AS NOTED FOR PLAN REVIEW

DEVELOPMENT SERVICES

LEE'S SUMMIT, MISSOURI

12/02/2024

Heartland Truss, Inc, Plattsburg, MO - 64477, 8.730 s Oct 31 2024 MiTek Industries, Inc. Wed Nov 27 17:36:39 2024 Page 1

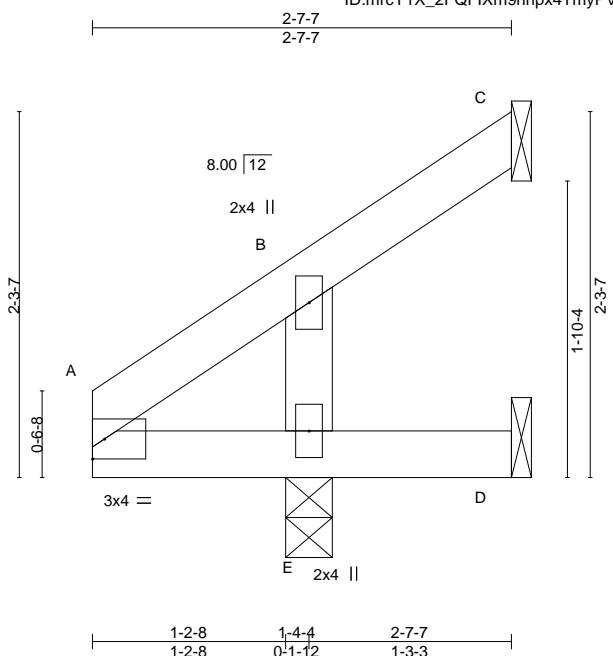

Scale = 1:14.4

LOADING (psf)	SPACING-	CSI.	DEFL.	PLATES	GRIP
TCLL 25.0 (Roof Snow=25.0)	2-0-0 Plate Grip DOL 1.15 Lumber DOL 1.15 Rep Stress Incr YES Code IRC2018/TPI2014	TC 0.13 BC 0.12 WB 0.04 Matrix-MP	in (loc) l/defl L/d Vert(LL) 0.00 E >999 240 Vert(CT) 0.00 D-E >999 180 Horz(CT) -0.01 C n/a n/a	MT20	244/190
TCDL 10.0				Weight: 10 lb	FT = 20%
BCLL 0.0					
BCDL 10.0					

LUMBER-	BRACING-
TOP CHORD 2x4 SP No.2	TOP CHORD Structural wood sheathing directly applied or 2-7-7 oc purlins.
BOT CHORD 2x4 SP No.2	BOT CHORD Rigid ceiling directly applied or 10-0-0 oc bracing.
WEBS 2x4 SP No.3	

REACTIONS. (size) C=Mechanical, D=Mechanical, E=0-3-8
 Max Horz E=66(LC 12)
 Max Uplift C=-40(LC 12), D=-35(LC 18)
 Max Grav C=21(LC 21), D=8(LC 10), E=337(LC 18)

FORCES. (lb) - Max. Comp./Max. Ten. - All forces 250 (lb) or less except when shown.

- NOTES-**
- 1) Wind: ASCE 7-16; Vult=115mph (3-second gust) Vasd=91mph; TCDL=6.0psf; BCDL=6.0psf; h=20ft; Cat. II; Exp C; Enclosed; MWFRS (envelope) gable end zone and C-C Exterior(2E) zone; cantilever left and right exposed; end vertical left and right exposed; C-C for members and forces & MWFRS for reactions shown; Lumber DOL=1.33 plate grip DOL=1.33
 - 2) TCLL: ASCE 7-16; Pf=25.0 psf (Lum DOL=1.15 Plate DOL=1.15); Is=1.0; Rough Cat C; Fully Exp.; Ce=0.9; Cs=1.00; Ct=1.10
 - 3) Unbalanced snow loads have been considered for this design.
 - 4) This truss has been designed for a 10.0 psf bottom chord live load nonconcurrent with any other live loads.
 - 5) Refer to girder(s) for truss to truss connections.
 - 6) Provide mechanical connection (by others) of truss to bearing plate capable of withstanding 40 lb uplift at joint C and 35 lb uplift at joint D.
 - 7) This truss is designed in accordance with the 2018 International Residential Code sections R502.11.1 and R802.10.2 and referenced standard ANSI/TPI 1.



November 27, 2024

Job 242042	Truss 25	Truss Type Jack-Closed	Qty 3	Ply 1	GENE BOSLEY RES. / ROOF
---------------	-------------	---------------------------	----------	----------	-------------------------


AS NOTED FOR PLAN REVIEW
DEVELOPMENT SERVICES
LEE'S SUMMIT, MISSOURI

Heartland Truss, Inc, Plattsburg, MO - 64477,

8.730 s Oct 31 2024 MiTek Industries, Inc.

Wed Nov 27 17:39:29 2024 Page 1
ID:mrcY1X_2FQFIxm9hpx4TmyPVI_-7Loy1Kb2B0FN4sDVk95l5Lyd0r18C0bkJBPZNF3Tj

12/02/2024

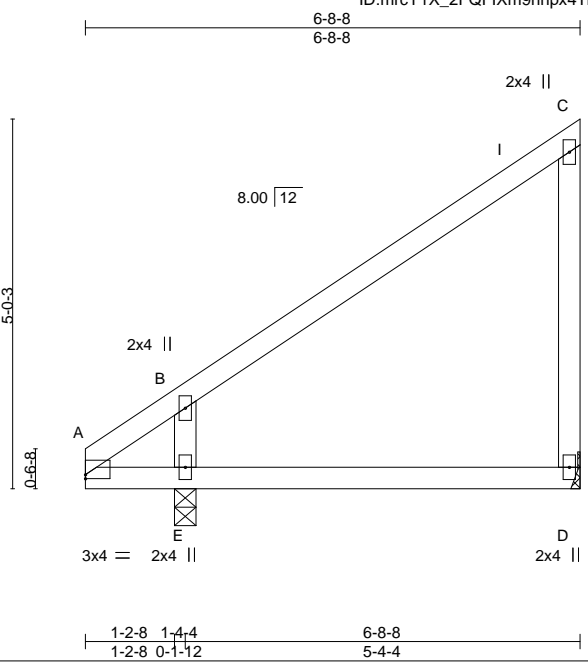

Scale = 1:31.2

Plate Offsets (X,Y)-- [A:0-0-0,0-0-10]

LOADING (psf)	SPACING-	CSI.	DEFL.	PLATES	GRIP
TCLL 25.0 (Roof Snow=25.0)	2-0-0 Plate Grip DOL 1.15 Lumber DOL 1.15	TC 0.82 BC 0.38 WB 0.12 Matrix-MP	in (loc) l/defl L/d Vert(LL) 0.06 D-E >999 240 Vert(CT) -0.09 D-E >709 180 Horz(CT) 0.00 D n/a n/a	MT20	244/190
TCDL 10.0	Rep Stress Incr YES				
BCLL 0.0	Code IRC2018/TPI2014				
BCDL 10.0				Weight: 30 lb	FT = 20%

LUMBER-	BRACING-
TOP CHORD 2x4 SP No.2	TOP CHORD Structural wood sheathing directly applied, except end verticals.
BOT CHORD 2x4 SP No.2	BOT CHORD Rigid ceiling directly applied or 10-0-0 oc bracing.
WEBS 2x4 SP No.3	

REACTIONS. (size) D=Mechanical, E=0-3-8
 Max Horz E=172(LC 11)
 Max Uplift D=-75(LC 12), E=-16(LC 12)
 Max Grav D=341(LC 18), E=495(LC 18)

FORCES. (lb) - Max. Comp./Max. Ten. - All forces 250 (lb) or less except when shown.
 TOP CHORD C-D=-268/81
 WEBS B-E=-594/321

NOTES-

- 1) Wind: ASCE 7-16; Vult=115mph (3-second gust) Vasd=91mph; TCDL=6.0psf; BCDL=6.0psf; h=20ft; Cat. II; Exp C; Enclosed; MWFRS (envelope) gable end zone and C-C Exterior(2E) zone; cantilever left and right exposed; end vertical left and right exposed; C-C for members and forces & MWFRS for reactions shown; Lumber DOL=1.33 plate grip DOL=1.33
- 2) TCLL: ASCE 7-16; Pf=25.0 psf (Lum DOL=1.15 Plate DOL=1.15); Is=1.0; Rough Cat C; Fully Exp.; Ce=0.9; Cs=1.00; Ct=1.10
- 3) Unbalanced snow loads have been considered for this design.
- 4) This truss has been designed for a 10.0 psf bottom chord live load nonconcurrent with any other live loads.
- 5) Refer to girder(s) for truss to truss connections.
- 6) Provide mechanical connection (by others) of truss to bearing plate capable of withstanding 75 lb uplift at joint D and 16 lb uplift at joint E.
- 7) This truss is designed in accordance with the 2018 International Residential Code sections R502.11.1 and R802.10.2 and referenced standard ANSI/TPI 1.



November 27, 2024

Job 242042	Truss 26	Truss Type Jack-Closed	Qty 2	Ply 1	GENE BOSLEY RES. / ROOF
---------------	-------------	---------------------------	----------	----------	-------------------------


AS NOTED FOR PLAN REVIEW
DEVELOPMENT SERVICES
LEE'S SUMMIT, MISSOURI

Heartland Truss, Inc, Plattsburg, MO - 64477,

8.730 s Oct 31 2024 MiTek Industries, Inc. Wed No 27-07-30-2024 Page 1

ID: mrcY1X_2FQFIXm9hhpx4TmyPVI_-bYMKEGcgjJNEh0oilsc_AZ5xN1E9fctJyKByE2Tp

12/02/2024

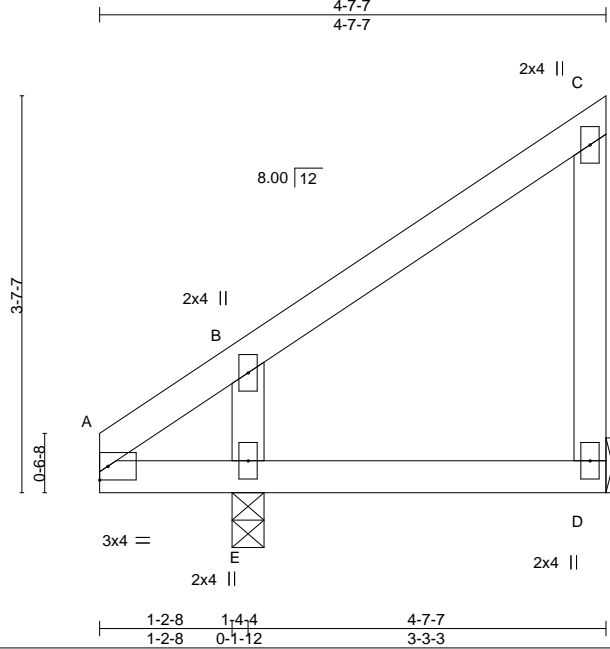

Scale = 1:21.0

LOADING (psf)	SPACING-	CSI.	DEFL.	PLATES	GRIP
TCLL 25.0 (Roof Snow=25.0)	2-0-0 Plate Grip DOL 1.15 Lumber DOL 1.15	TC 0.24 BC 0.17 WB 0.07 Matrix-MP	in (loc) l/defl L/d Vert(LL) 0.01 D-E >999 240 Vert(CT) -0.01 D-E >999 180 Horz(CT) 0.00 D n/a n/a	MT20	244/190
TCDL 10.0	Rep Stress Incr YES				
BCLL 0.0	Code IRC2018/TPI2014				
BCDL 10.0				Weight: 21 lb	FT = 20%

LUMBER-
TOP CHORD 2x4 SP No.2
BOT CHORD 2x4 SP No.2
WEBS 2x4 SP No.3

BRACING-
TOP CHORD Structural wood sheathing directly applied or 4-7-7 oc purlins, except end verticals.
BOT CHORD Rigid ceiling directly applied or 10-0-0 oc bracing.

REACTIONS. (size) D=Mechanical, E=0-3-8
Max Horz E=119(LC 11)
Max Uplift D=-60(LC 9), E=-15(LC 12)
Max Grav D=171(LC 18), E=433(LC 18)

FORCES. (lb) - Max. Comp./Max. Ten. - All forces 250 (lb) or less except when shown.
WEBS B-E=-379/194

- NOTES-**
- 1) Wind: ASCE 7-16; Vult=115mph (3-second gust) Vasd=91mph; TCDL=6.0psf; BCDL=6.0psf; h=20ft; Cat. II; Exp C; Enclosed; MWFRS (envelope) gable end zone and C-C Exterior(2E) zone; cantilever left and right exposed ; end vertical left and right exposed;C-C for members and forces & MWFRS for reactions shown; Lumber DOL=1.33 plate grip DOL=1.33
 - 2) TCLL: ASCE 7-16; Pf=25.0 psf (Lum DOL=1.15 Plate DOL=1.15); Is=1.0; Rough Cat C; Fully Exp.; Ce=0.9; Cs=1.00; Ct=1.10
 - 3) Unbalanced snow loads have been considered for this design.
 - 4) This truss has been designed for a 10.0 psf bottom chord live load nonconcurrent with any other live loads.
 - 5) Refer to girder(s) for truss to truss connections.
 - 6) Provide mechanical connection (by others) of truss to bearing plate capable of withstanding 60 lb uplift at joint D and 15 lb uplift at joint E.
 - 7) This truss is designed in accordance with the 2018 International Residential Code sections R502.11.1 and R802.10.2 and referenced standard ANSI/TPI 1.



November 27, 2024

WARNING - Verify design parameters and READ NOTES ON THIS AND INCLUDED MITEK REFERENCE PAGE MII-7473 rev. 1/2/2023 BEFORE USE.

Design valid for use only with MiTek® connectors. This design is based only upon parameters shown, and is for an individual building component, not a truss system. Before use, the building designer must verify the applicability of design parameters and properly incorporate this design into the overall building design. Bracing indicated is to prevent buckling of individual truss web and/or chord members only. Additional temporary and permanent bracing is always required for stability and to prevent collapse with possible personal injury and property damage. For general guidance regarding the fabrication, storage, delivery, erection and bracing of trusses and truss systems, see **ANSI/TPI1 Quality Criteria, and DSB-22** available from Truss Plate Institute (www.tpinst.org) and **BCSI Building Component Safety Information** available from the Structural Building Component Association (www.sbcsccomponents.com)

MiTek®

16023 Swingley Ridge Rd.
Chesterfield, MO 63017
314.434.1200 / MiTek-US.com

Job	Truss	Truss Type	Qty	Ply	GENE BOSLEY RES. / ROOF
242042	27	Half Hip Girder	1	2	

RELEASE FOR CONSTRUCTION


AS NOTED FOR PLAN REVIEW

DEVELOPMENT SERVICES

LEE'S SUMMIT, MISSOURI

12/02/2024

Heartland Truss, Inc, Plattsburg, MO - 64477, 8.730 s Oct 31 2024 MiTek Industries, Inc. Wed Nov 27 17:36:30 2024 Page 1

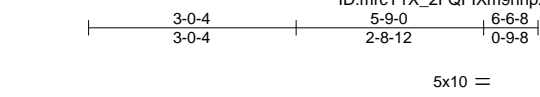

Scale = 1:33.5

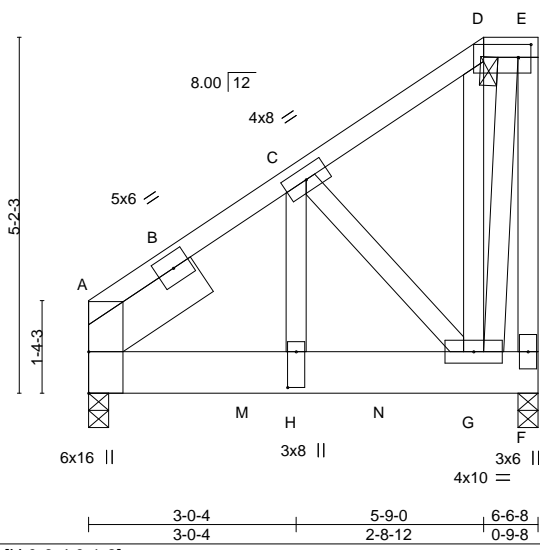


Plate Offsets (X, Y)-- [A:Edge,0-0-0], [D:0-2-4,0-2-4], [H:0-6-4,0-1-8]

LOADING (psf)	SPACING-	CSI.	DEFL.	in (loc)	l/defl	L/d	PLATES	GRIP
TCLL 25.0 (Roof Snow=25.0)	Plate Grip DOL 1.15	TC 0.33	Vert(LL) -0.03	G-H	>999	240	MT20	244/190
TCDL 10.0	Lumber DOL 1.15	BC 0.33	Vert(CT) -0.05	G-H	>999	180		
BCLL 0.0	Rep Stress Incr NO	WB 0.78	Horz(CT) 0.00	F	n/a	n/a		
BCDL 10.0	Code IRC2018/TPI2014	Matrix-MP					Weight: 132 lb	FT = 20%

LUMBER-	BRACING-
TOP CHORD 2x4 SP No.2	TOP CHORD Structural wood sheathing directly applied or 6-0-0 oc purlins, except end verticals, and 2-0-0 oc purlins (6-0-0 max.): D-E.
BOT CHORD 2x8 SP 2400F 2.0E	BOT CHORD Rigid ceiling directly applied or 10-0-0 oc bracing.
WEBS 2x4 SP No.3	
SLIDER Left 2x8 SP 2400F 2.0E 2-0-0	

REACTIONS. (size) A=0-3-8, F=0-3-8
 Max Horz A=139(LC 11)
 Max Uplift A=-405(LC 12), F=-538(LC 9)
 Max Grav A=5518(LC 29), F=4144(LC 29)

FORCES. (lb) - Max. Comp./Max. Ten. - All forces 250 (lb) or less except when shown.
 TOP CHORD A-C=-3295/364, C-D=-603/146, D-E=-436/149, E-F=-2616/340
 BOT CHORD A-H=-285/2640, G-H=-285/2640
 WEBS C-H=-335/3754, C-G=-3299/423, E-G=-332/2641

- NOTES-**
- 2-ply truss to be connected together with 10d (0.131"x3") nails as follows:
 Top chords connected as follows: 2x4 - 1 row at 0-9-0 oc.
 Bottom chords connected as follows: 2x8 - 2 rows staggered at 0-4-0 oc.
 Webs connected as follows: 2x4 - 1 row at 0-9-0 oc.
 - All loads are considered equally applied to all plies, except if noted as front (F) or back (B) face in the LOAD CASE(S) section. Ply to ply connections have been provided to distribute only loads noted as (F) or (B), unless otherwise indicated.
 - Wind: ASCE 7-16; Vult=115mph (3-second gust) Vasd=91mph; TCDL=6.0psf; BCDL=6.0psf; h=20ft; Cat. II; Exp C; Enclosed; Hip Roof; Hip Truss; MWFRS (envelope) and C-C Exterior(2E) 0-0-0 to 3-0-4, Exterior(2R) 3-0-4 to 5-9-0, Exterior(2E) 5-9-0 to 6-4-12 zone; cantilever left and right exposed; end vertical left and right exposed; C-C for members and forces & MWFRS for reactions shown; Lumber DOL=1.33 plate grip DOL=1.33
 - TCLL: ASCE 7-16; Pf=25.0 psf (Lum DOL=1.15 Plate DOL=1.15); Is=1.0; Rough Cat C; Fully Exp.; Ce=0.9; Cs=1.00; Ct=1.10
 - Unbalanced snow loads have been considered for this design.
 - Provide adequate drainage to prevent water ponding.
 - This truss has been designed for a 10.0 psf bottom chord live load nonconcurrent with any other live loads.
 - Provide mechanical connection (by others) of truss to bearing plate capable of withstanding 405 lb uplift at joint A and 538 lb uplift at joint F.
 - This truss is designed in accordance with the 2018 International Residential Code sections R502.11.1 and R802.10.2 and referenced standard ANSI/TPI 1.
 - Graphical purlin representation does not depict the size or the orientation of the purlin along the top and/or bottom chord.
 - Hanger(s) or other connection device(s) shall be provided sufficient to support concentrated load(s) 2666 lb down and 197 lb up at 0-3-11, 2573 lb down and 204 lb up at 2-3-11, and 2520 lb down and 248 lb up at 4-3-11, and 1025 lb down and 298 lb up at 5-9-0 on bottom chord. The design/selection of such connection device(s) is the responsibility of others.




November 27, 2024

LOAD CASE(S) Standard
 Continued on page 2

WARNING - Verify design parameters and READ NOTES ON THIS AND INCLUDED MITEK REFERENCE PAGE MII-7473 rev. 1/2/2023 BEFORE USE.

Design valid for use only with MiTek® connectors. This design is based only upon parameters shown, and is for an individual building component, not a truss system. Before use, the building designer must verify the applicability of design parameters and properly incorporate this design into the overall building design. Bracing indicated is to prevent buckling of individual truss web and/or chord members only. Additional temporary and permanent bracing is always required for stability and to prevent collapse with possible personal injury and property damage. For general guidance regarding the fabrication, storage, delivery, erection and bracing of trusses and truss systems, see **ANSI/TPI1 Quality Criteria, and DSB-22** available from Truss Plate Institute (www.tpinst.org) and **BCSI Building Component Safety Information** available from the Structural Building Component Association (www.sbcsccomponents.com)



16023 Swingley Ridge Rd.
 Chesterfield, MO 63017
 314.434.1200 / MiTek-US.com

Job	Truss	Truss Type	Qty	Ply	GENE BOSLEY RES. / ROOF
242042	27	Half Hip Girder	1	2	

RELEASE FOR CONSTRUCTION

AS NOTED FOR PLAN REVIEW
DEVELOPMENT SERVICES
LEE'S SUMMIT, MISSOURI

12/02/2024

Heartland Truss, Inc, Plattsburg, MO - 64477,

8.730 s Oct 31 2024 MiTek Industries, Inc. Wed Nov 27 17:36:31 2024 Page 2
ID: mrcY1X_2FQF1Xm9hpx4TmyPVL_4kviS0dljdV5J9Nusa7Djnd4kRWRuXl0ngjly1f2jg

LOAD CASE(S) Standard

- 1) Dead + Snow (balanced): Lumber Increase=1.15, Plate Increase=1.15
- Uniform Loads (plf)
 - Vert: A-D=-70, D-E=-70, F-I=-20
- Concentrated Loads (lb)
 - Vert: G=-1025(B) K=-2666(F) M=-2573(F) N=-2520(F)

WARNING - Verify design parameters and READ NOTES ON THIS AND INCLUDED MITEK REFERENCE PAGE MII-7473 rev. 1/2/2023 BEFORE USE.

Design valid for use only with MiTek® connectors. This design is based only upon parameters shown, and is for an individual building component, not a truss system. Before use, the building designer must verify the applicability of design parameters and properly incorporate this design into the overall building design. Bracing indicated is to prevent buckling of individual truss web and/or chord members only. Additional temporary and permanent bracing is always required for stability and to prevent collapse with possible personal injury and property damage. For general guidance regarding the fabrication, storage, delivery, erection and bracing of trusses and truss systems, see **ANSI/TPI1 Quality Criteria, and DSB-22** available from Truss Plate Institute (www.tpinst.org) and **BCSI Building Component Safety Information** available from the Structural Building Component Association (www.sbcsccomponents.com)

MiTek®

16023 Swingley Ridge Rd.
Chesterfield, MO 63017
314.434.1200 / MiTek-US.com

Job: 242042, Truss: 28, Truss Type: Piggyback Base, Qty: 1, Ply: 1, GENE BOSLEY RES. / ROOF

AS NOTED FOR PLAN REVIEW DEVELOPMENT SERVICES LEE'S SUMMIT, MISSOURI

12/02/2024

Heartland Truss, Inc., Plattsburg, MO - 64477, 8.730 s Oct 31 2024 MiTek Industries, Inc. Wed Nov 27 09:32 2024 Page 1

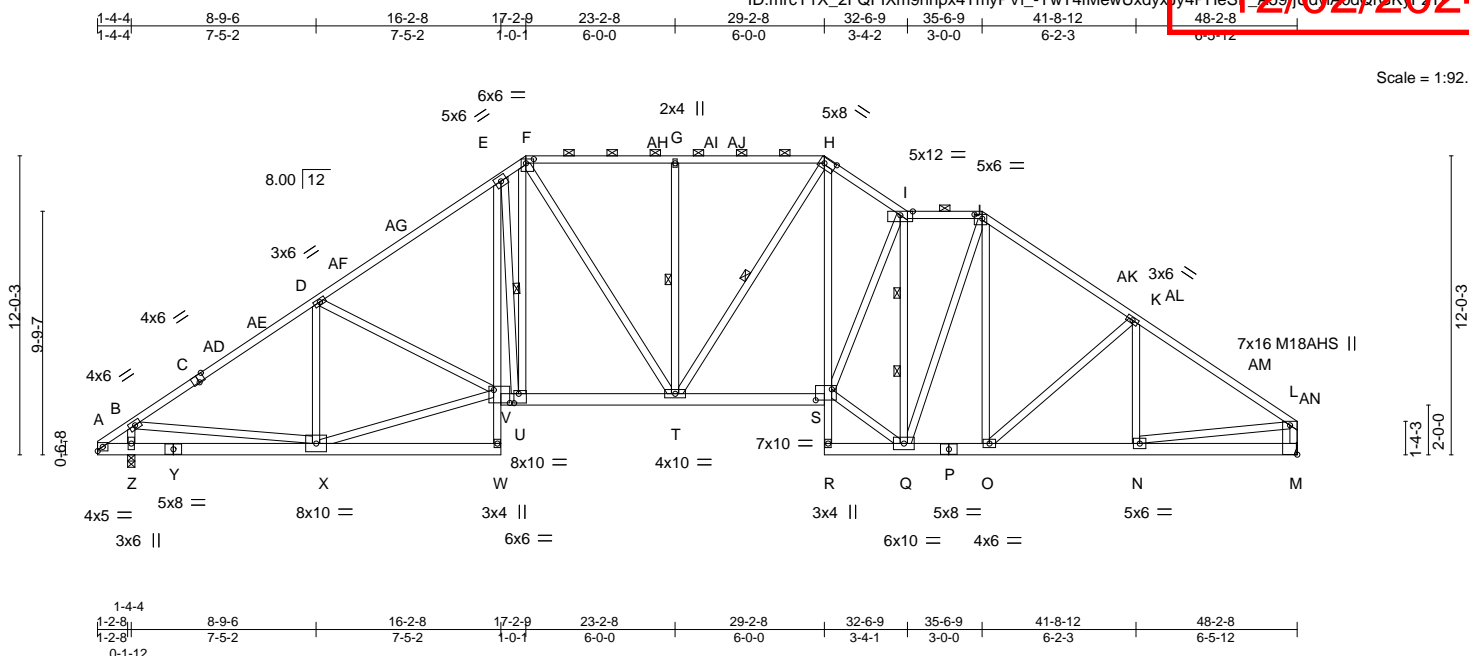


Plate Offsets (X, Y)-- [C:0-3-0,Edge], [F:0-3-12,0-2-0], [H:0-5-8,0-2-8], [J:0-3-12,0-2-0], [L:Edge,0-3-8], [S:0-7-12,0-5-4], [U:0-2-4,0-4-8], [V:0-7-12,0-6-4]



REACTIONS. (size) Z=0-3-8, M=Mechanical. Max Horz Z=302(LC 11), Max Uplift Z=-173(LC 12), M=-184(LC 13), Max Grav Z=2674(LC 36), M=2679(LC 36)

FORCES. (lb) - Max. Comp./Max. Ten. - All forces 250 (lb) or less except when shown. TOP CHORD, BOT CHORD, WEBS force values.

- NOTES- 1) Wind: ASCE 7-16; Vult=115mph... 2) TCDL: ASCE 7-16; Pf=25.0 psf... 3) Unbalanced snow loads... 4) Provide adequate drainage... 5) All plates are MT20 plates... 6) This truss has been designed for a 10.0 psf bottom chord live load... 7) Refer to girder(s) for truss to truss connections... 8) Provide mechanical connection... 9) This truss is designed in accordance with the 2018 International Residential Code... 10) Graphical purlin representation does not depict the size or the orientation of the purlin...



November 27, 2024

Job	Truss	Truss Type	Qty	Ply	GENE BOSLEY RES. / ROOF
242042	29	Piggyback Base	1	1	

AS NOTED FOR PLAN REVIEW
DEVELOPMENT SERVICES
LEE'S SUMMIT, MISSOURI

12/02/2024

Heartland Truss, Inc, Plattsburg, MO - 64477, 8.730 s Oct 31 2024 MiTek Industries, Inc. Wed No 27-17-86-33-2024 Page 1
 ID:mrcY1X_2FQfIXm9hpx4TmyPVL_071SsieYEmpYTXHz?9hoBjKWF2cM(Cx_E69PorVLT) 29hoBjKWF2cM(Cx_E69PorVLT) 48-2-8 7-5-12

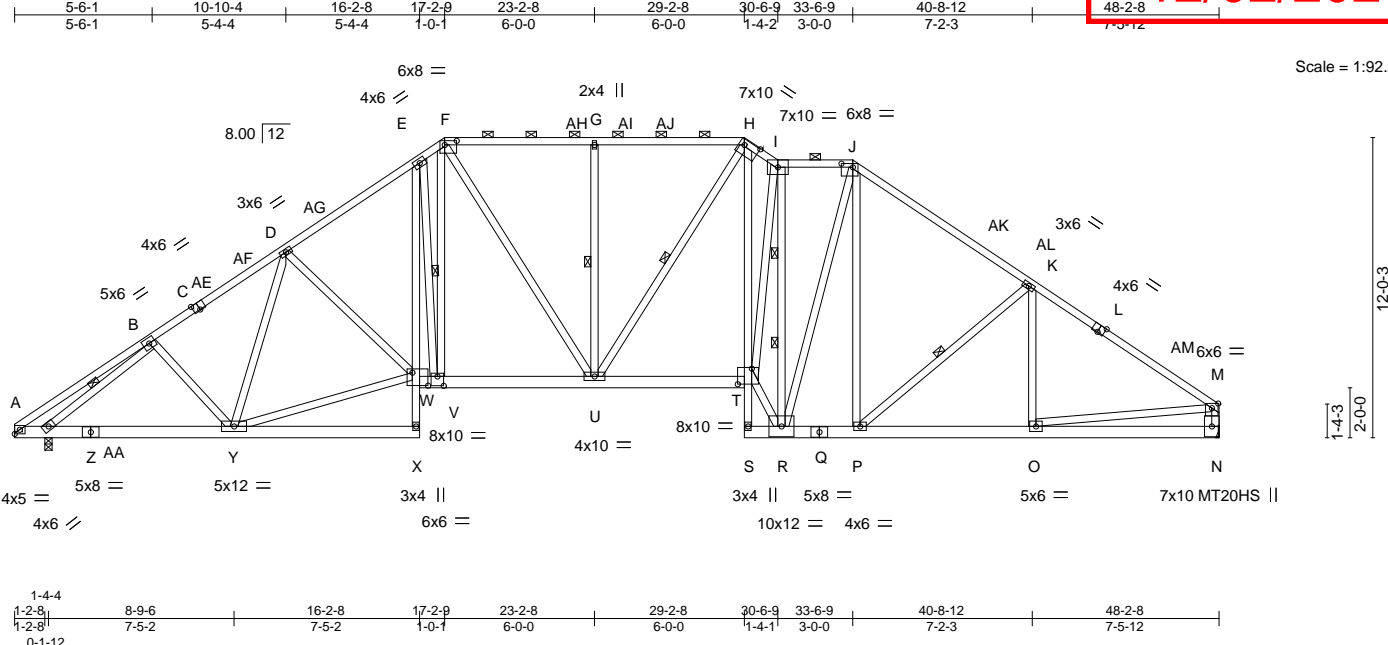


Plate Offsets (X, Y)-- [C:0-3-0,Edge], [F:0-5-12,0-2-0], [H:0-7-8,0-2-8], [J:0-5-8,0-1-12], [L:0-3-0,Edge], [T:0-6-12,0-7-8], [V:0-3-0,0-4-8], [W:0-7-8,0-6-4]

LOADING (psf)	SPACING-	CSL	DEFL.	PLATES	GRIP
TCLL 25.0 (Roof Snow=25.0)	Plate Grip DOL 1.15 Lumber DOL 1.15	TC 0.76 BC 0.92 WB 0.87	in (loc) l/def L/d Vert(LL) -0.31 T-U >999 240 Vert(CT) -0.52 T-U >999 180 Horz(CT) 0.30 N n/a n/a	MT20 MT20HS	244/190 187/143
TCDL 10.0	Rep Stress Incr YES	Matrix-MS			
BCLL 0.0	Code IRC2018/TPI2014				
BCDL 10.0				Weight: 444 lb	FT = 20%

LUMBER-	BRACING-
TOP CHORD 2x4 SP 2400F 2.0E *Except* F-H: 2x4 SP 1650F 1.5E, H-I,I-J,A-C: 2x4 SP No.2	TOP CHORD Structural wood sheathing directly applied or 2-2-0 oc purlins, except end verticals, and 2-0-0 oc purlins (3-1-7 max.): F-H, I-J.
BOT CHORD 2x6 SP No.1 *Except* E-X,H-S: 2x4 SP No.2	BOT CHORD Rigid ceiling directly applied or 10-0-0 oc bracing, Except: 2-2-0 oc bracing: W-X 6-0-0 oc bracing: S-T.
WEBS 2x4 SP No.3 *Except* W-Y,M-N,M-O: 2x4 SP No.2, R-T: 2x4 SP 1650F 1.5E I-R: 2x4 SP 2400F 2.0E	WEBS 1 Row at midpt E-V, G-U, H-U, K-P, B-AA 2 Rows at 1/3 pts I-R

REACTIONS. (size) N=Mechanical, AA=0-3-8
 Max Horz AA=302(LC 11)
 Max Uplift N=-184(LC 13), AA=-173(LC 12)
 Max Grav N=2593(LC 36), AA=2630(LC 36)

FORCES. (lb) - Max. Comp./Max. Ten. - All forces 250 (lb) or less except when shown.
 TOP CHORD A-B=-624/75, B-D=-3416/383, D-E=-3600/462, E-F=-3274/526, F-G=-3010/462,
 G-H=-3010/462, H-I=-3411/524, I-J=-2463/436, J-K=-3009/435, K-M=-3524/359,
 M-N=-2503/260
 BOT CHORD A-AA=0/439, Y-AA=-299/2707, E-W=-98/977, V-W=-216/2650, U-V=-203/2638,
 T-U=-95/2798, S-T=-292/15, H-T=-214/1577, P-R=-62/2254, O-P=-171/2797, N-O=-81/359
 WEBS D-Y=-780/113, W-Y=-235/2816, D-W=-199/347, E-V=-1267/243, F-V=-262/1434,
 F-U=-200/784, G-U=-866/188, H-U=-158/434, R-T=-127/4193, I-T=-198/1974,
 I-R=-4073/268, J-R=-192/1133, J-P=-95/440, K-P=-704/228, B-AA=-3013/304,
 M-O=-143/2463

NOTES-

- Wind: ASCE 7-16; Vult=115mph (3-second gust) Vasd=91mph; TCDL=6.0psf; BCDL=6.0psf; h=20ft; Cat. II; Exp C; Enclosed; MWFRS (envelope) gable end zone and C-C Exterior(2E) 0-0-0 to 4-9-14, Interior(1) 4-9-14 to 12-4-11, Exterior(2R) 12-4-11 to 22-0-6, Interior(1) 22-0-6 to 24-6-6, Exterior(2R) 24-6-6 to 29-4-4, Exterior(2E) 29-4-4 to 30-6-9, Exterior(2R) 30-6-9 to 38-4-7, Interior(1) 38-4-7 to 43-2-14, Exterior(2E) 43-2-14 to 48-0-12 zone; cantilever left and right exposed ; end vertical left and right exposed;C-C for members and forces & MWFRS for reactions shown; Lumber DOL=1.33 plate grip DOL=1.33
- TCLL: ASCE 7-16; Pf=25.0 psf (Lum DOL=1.15 Plate DOL=1.15); Is=1.0; Rough Cat C; Fully Exp.; Ce=0.9; Cs=1.00; Ct=1.10
- Unbalanced snow loads have been considered for this design.
- Provide adequate drainage to prevent water ponding.
- All plates are MT20 plates unless otherwise indicated.
- This truss has been designed for a 10.0 psf bottom chord live load nonconcurrent with any other live loads.
- Refer to girder(s) for truss to truss connections.
- Provide mechanical connection (by others) of truss to bearing plate capable of withstanding 184 lb uplift at joint N and 173 lb uplift at joint AA.
- This truss is designed in accordance with the 2018 International Residential Code sections R502.11.1 and R802.10.2 and referenced standard ANSI/TPI 1.
- Graphical purlin representation does not depict the size or the orientation of the purlin along the top and/or bottom chord.



November 27, 2024

WARNING - Verify design parameters and READ NOTES ON THIS AND INCLUDED MITEK REFERENCE PAGE MII-7473 rev. 1/2/2023 BEFORE USE.

Design valid for use only with MiTek® connectors. This design is based only upon parameters shown, and is for an individual building component, not a truss system. Before use, the building designer must verify the applicability of the design parameters and properly incorporate this design into the overall building design. Bracing indicated is to prevent buckling of individual truss web and/or chord members only. Additional temporary and permanent bracing is always required for stability and to prevent collapse with possible personal injury and property damage. For general guidance regarding the fabrication, storage, delivery, erection and bracing of trusses and truss systems, see **ANSI/TPI1 Quality Criteria, and DSB-22** available from Truss Plate Institute (www.tpinst.org) and **BCSI Building Component Safety Information** available from the Structural Building Component Association (www.sbcsccomponents.com)

MiTek®
 16023 Swingley Ridge Rd.
 Chesterfield, MO 63017
 314.434.1200 / MiTek-US.com

Job	Truss	Truss Type	Qty	Ply	GENE BOSLEY RES. / ROOF
242042	30	Hip	1	1	

RELEASE FOR CONSTRUCTION

AS NOTED FOR PLAN REVIEW


DEVELOPMENT SERVICES

LEE'S SUMMIT, MISSOURI

12/02/2024

Heartland Truss, Inc, Plattsburg, MO - 64477,

8.730 s Oct 31 2024 MiTek Industries, Inc. Wed Nov 27 07:30:34 2024 Page 1

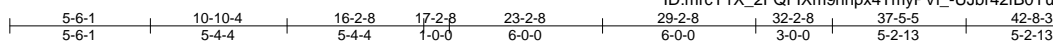

Scale = 1:90.2

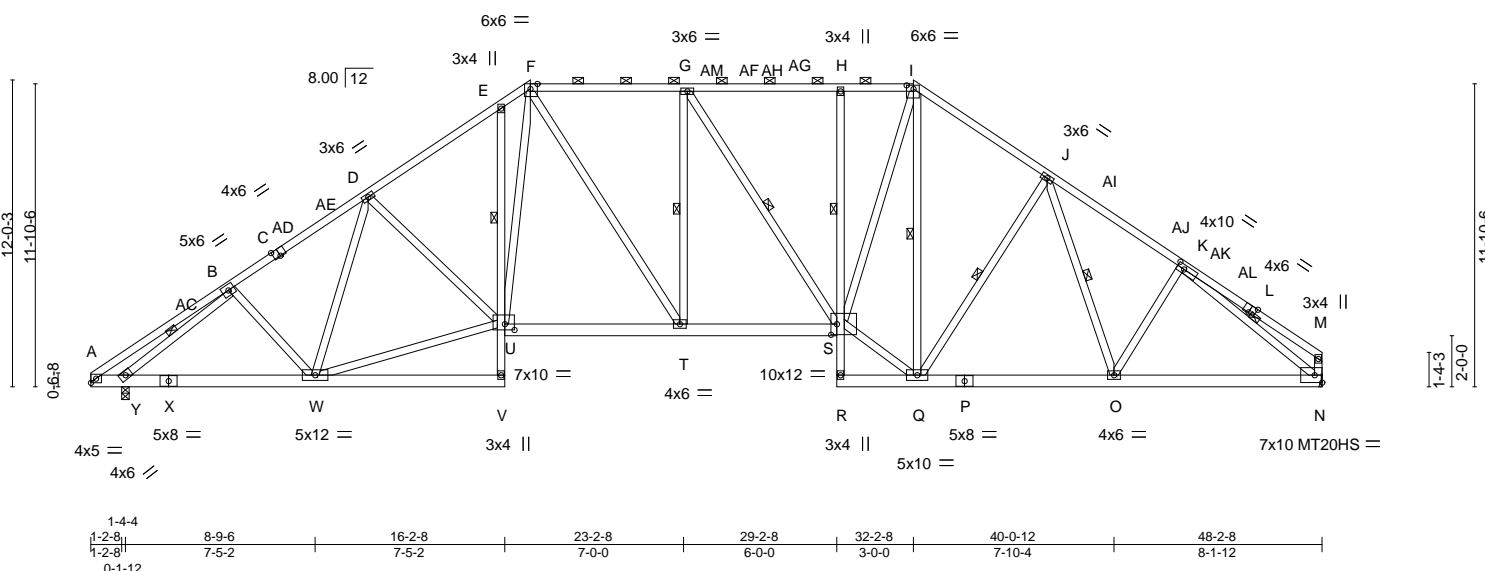


Plate Offsets (X, Y)-- [C:0-3-0,Edge], [F:0-3-5,Edge], [I:0-3-4,0-1-12], [K:0-3-7,0-2-1], [L:0-3-0,Edge], [S:0-2-12,0-5-0], [U:0-4-8,0-2-12]

LOADING (psf)	SPACING-	CSI.	DEFL.	PLATES	GRIP
TCLL 25.0	Plate Grip DOL 1.15	TC 0.85	in (loc) l/defl L/d	MT20 244/190	
(Roof Snow=25.0)	Lumber DOL 1.15	BC 0.56	Vert(LL) -0.24 T-U >999 240	MT20HS 187/143	
TCDL 10.0	Rep Stress Incr YES	WB 0.95	Vert(CT) -0.40 T-U >999 180		
BCLL 0.0	Code IRC2018/TPI2014	Matrix-MS	Horz(CT) 0.21 N n/a n/a		
BCDL 10.0				Weight: 413 lb	FT = 20%

LUMBER-	BRACING-
TOP CHORD 2x4 SP No.2 *Except* F-I: 2x4 SP 1650F 1.5E	TOP CHORD Structural wood sheathing directly applied or 2-2-0 oc purlins, except end verticals, and 2-0-0 oc purlins (3-2-6 max.): F-I.
BOT CHORD 2x6 SP No.1 *Except* E-V, H-R: 2x4 SP No.3	BOT CHORD Rigid ceiling directly applied or 10-0-0 oc bracing, Except: 6-0-0 oc bracing: R-S.
WEBS 2x4 SP No.3 *Except* U-W, Q-S, I-S: 2x4 SP No.2	WEBS 1 Row at midpt E-U, H-S 1 Row at midpt G-T, G-S, I-Q, J-Q, J-O, B-Y, K-N

REACTIONS. (size) N=Mechanical, Y=0-3-8
 Max Horz Y=299(LC 11)
 Max Uplift N=-228(LC 13), Y=-246(LC 12)
 Max Grav N=2540(LC 32), Y=2651(LC 32)

FORCES. (lb) - Max. Comp./Max. Ten. - All forces 250 (lb) or less except when shown.
 TOP CHORD A-B=-621/88, B-D=-3430/372, D-E=-3532/434, E-F=-3301/505, F-G=-3073/448,
 G-H=-2872/437, H-I=-2868/437, I-J=-2811/432, J-K=-3335/389, K-M=-452/136,
 M-N=-376/126
 BOT CHORD A-Y=0/438, W-Y=-382/2736, E-U=-263/191, T-U=-205/2615, S-T=-183/3070, H-S=-645/140,
 O-Q=-116/2564, N-O=-207/2683
 WEBS D-W=-700/103, U-W=-298/2908, D-U=-236/299, F-U=-233/1276, F-T=-197/896,
 G-T=-573/266, G-S=-386/149, Q-S=-35/2554, I-S=-251/2454, I-Q=-1105/231,
 J-Q=-720/231, J-O=-54/279, B-Y=-3052/273, K-N=-3157/214

- NOTES-**
- 1) Wind: ASCE 7-16; Vult=115mph (3-second gust) Vasd=91mph; TCDL=6.0psf; BCDL=6.0psf; h=20ft; Cat. II; Exp C; Enclosed; MWFRS (envelope) gable end zone and C-C Exterior(2E) 0-0-0 to 4-9-14, Interior(1) 4-9-14 to 10-4-11, Exterior(2R) 10-4-11 to 24-0-5, Interior(1) 24-0-5 to 25-4-11, Exterior(2R) 25-4-11 to 39-0-5, Interior(1) 39-0-5 to 43-2-14, Exterior(2E) 43-2-14 to 48-0-12 zone; cantilever left and right exposed; end vertical left and right exposed; C-C for members and forces & MWFRS for reactions shown; Lumber DOL=1.33 plate grip DOL=1.33
 - 2) TCLL: ASCE 7-16; Pf=25.0 psf (Lum DOL=1.15 Plate DOL=1.15); Is=1.0; Rough Cat C; Fully Exp.; Ce=0.9; Cs=1.00; Ct=1.10
 - 3) Unbalanced snow loads have been considered for this design.
 - 4) Provide adequate drainage to prevent water ponding.
 - 5) All plates are MT20 plates unless otherwise indicated.
 - 6) This truss has been designed for a 10.0 psf bottom chord live load nonconcurrent with any other live loads.
 - 7) Refer to girder(s) for truss to truss connections.
 - 8) Provide mechanical connection (by others) of truss to bearing plate capable of withstanding 228 lb uplift at joint N and 246 lb uplift at joint Y.
 - 9) This truss is designed in accordance with the 2018 International Residential Code sections R502.11.1 and R802.10.2 and referenced standard ANSI/TPI 1.
 - 10) Graphical purlin representation does not depict the size or the orientation of the purlin along the top and/or bottom chord.



November 27, 2024

WARNING - Verify design parameters and READ NOTES ON THIS AND INCLUDED MITEK REFERENCE PAGE MII-7473 rev. 1/2/2023 BEFORE USE.

Design valid for use only with MiTek® connectors. This design is based only upon parameters shown, and is for an individual building component, not a truss system. Before use, the building designer must verify the applicability of design parameters and properly incorporate this design into the overall building design. Bracing indicated is to prevent buckling of individual truss web and/or chord members only. Additional temporary and permanent bracing is always required for stability and to prevent collapse with possible personal injury and property damage. For general guidance regarding the fabrication, storage, delivery, erection and bracing of trusses and truss systems, see **ANSI/TPI1 Quality Criteria, and DSB-22** available from Truss Plate Institute (www.tpinst.org) and **BCSI Building Component Safety Information** available from the Structural Building Component Association (www.sbcsccomponents.com)

MiTek®
 16023 Swingley Ridge Rd.
 Chesterfield, MO 63017
 314.434.1200 / MiTek-US.com

Job	Truss	Truss Type	Qty	Ply	GENE BOSLEY RES. / ROOF
242042	31	Diagonal Hip Girder	1	1	

RELEASE FOR CONSTRUCTION


AS NOTED FOR PLAN REVIEW

DEVELOPMENT SERVICES

LEE'S SUMMIT, MISSOURI

12/02/2024

Heartland Truss, Inc, Plattsburg, MO - 64477, 8.730 s Oct 31 2024 MiTek Industries, Inc. Wed No 27-07-30-25-2024 Page 1
 ID:mrcY1X_2FQFIXm9hhpx4TmyPVI_yV9DHNgnps02 longf5QCbtcm42oicTIdasVevyF2r

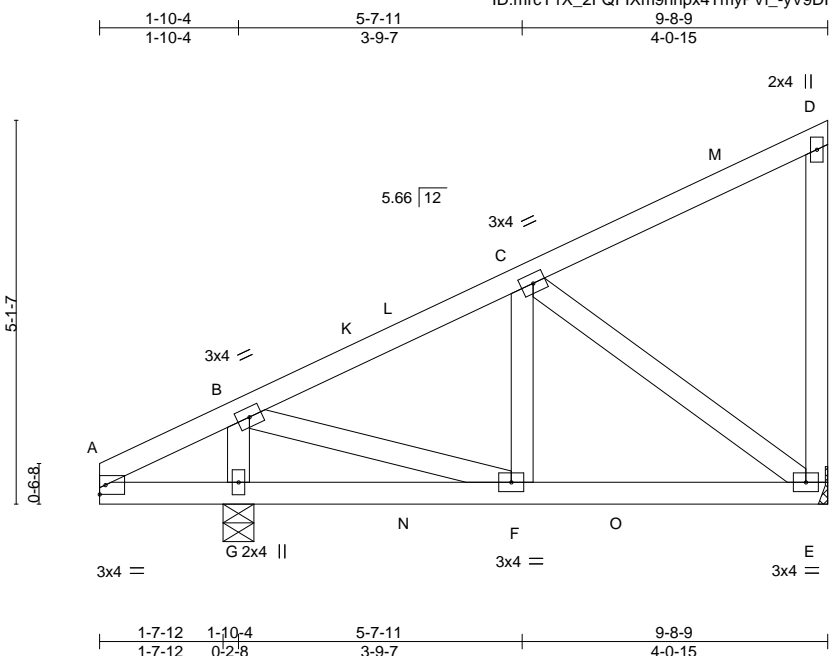

Scale = 1:30.7

LOADING (psf)	SPACING-	CSI.	DEFL.	PLATES	GRIP
TCLL 25.0 (Roof Snow=25.0)	2-0-0 Plate Grip DOL 1.15 Lumber DOL 1.15 Rep Stress Incr NO Code IRC2018/TPI2014	TC 0.38 BC 0.76 WB 0.30 Matrix-MS	in (loc) l/defl L/d Vert(LL) -0.05 E-F >999 240 Vert(CT) -0.06 E-F >999 180 Horz(CT) 0.00 E n/a n/a	MT20	244/190
TCDL 10.0				Weight: 55 lb	FT = 20%
BCLL 0.0					
BCDL 10.0					

LUMBER-	BRACING-
TOP CHORD 2x4 SP No.2	TOP CHORD Structural wood sheathing directly applied or 6-0-0 oc purlins, except end verticals.
BOT CHORD 2x4 SP No.2	BOT CHORD Rigid ceiling directly applied or 6-0-0 oc bracing.
WEBS 2x4 SP No.3	

REACTIONS. (size) G=0-4-15, E=Mechanical
 Max Horz G=167(LC 11)
 Max Uplift G=-130(LC 12), E=-187(LC 12)
 Max Grav G=736(LC 18), E=690(LC 18)

FORCES. (lb) - Max. Comp./Max. Ten. - All forces 250 (lb) or less except when shown.
 TOP CHORD B-C=-654/214
 BOT CHORD E-F=-186/539
 WEBS B-G=-718/318, B-F=-169/636, C-E=-645/296

- NOTES-**
- 1) Wind: ASCE 7-16; Vult=115mph (3-second gust) Vasd=91mph; TCDL=6.0psf; BCDL=6.0psf; h=20ft; Cat. II; Exp C; Enclosed; MWFRS (envelope) gable end zone and C-C Corner(3) 0-0-0 to 4-2-15, Exterior(2R) 4-2-15 to 9-6-13 zone; cantilever left and right exposed ; end vertical left and right exposed;C-C for members and forces & MWFRS for reactions shown; Lumber DOL=1.33 plate grip DOL=1.33
 - 2) TCLL: ASCE 7-16; Pf=25.0 psf (Lum DOL=1.15 Plate DOL=1.15); Is=1.0; Rough Cat C; Fully Exp.; Ce=0.9; Cs=1.00; Ct=1.10
 - 3) Unbalanced snow loads have been considered for this design.
 - 4) This truss has been designed for a 10.0 psf bottom chord live load nonconcurrent with any other live loads.
 - 5) Refer to girder(s) for truss to truss connections.
 - 6) Provide mechanical connection (by others) of truss to bearing plate capable of withstanding 130 lb uplift at joint G and 187 lb uplift at joint E.
 - 7) This truss is designed in accordance with the 2018 International Residential Code sections R502.11.1 and R802.10.2 and referenced standard ANSI/TPI 1.
 - 8) Hanger(s) or other connection device(s) shall be provided sufficient to support concentrated load(s) 101 lb down and 76 lb up at 4-1-12, and 101 lb down and 76 lb up at 4-1-12 on top chord, and 12 lb down and 24 lb up at 4-1-12, 12 lb down and 24 lb up at 4-1-12, and 164 lb down and 89 lb up at 6-11-11, and 164 lb down and 89 lb up at 6-11-11 on bottom chord. The design/selection of such connection device(s) is the responsibility of others.
 - 9) In the LOAD CASE(S) section, loads applied to the face of the truss are noted as front (F) or back (B).

LOAD CASE(S) Standard
 1) Dead + Snow (balanced): Lumber Increase=1.15, Plate Increase=1.15
 Uniform Loads (plf)
 Vert: A-D=-70, E-H=-20
 Concentrated Loads (lb)
 Vert: O=-328(F=-164, B=-164)



November 27, 2024

WARNING - Verify design parameters and READ NOTES ON THIS AND INCLUDED MITEK REFERENCE PAGE MII-7473 rev. 1/2/2023 BEFORE USE.

Design valid for use only with MiTek® connectors. This design is based only upon parameters shown, and is for an individual building component, not a truss system. Before use, the building designer must verify the applicability of design parameters and properly incorporate this design into the overall building design. Bracing indicated is to prevent buckling of individual truss web and/or chord members only. Additional temporary and permanent bracing is always required for stability and to prevent collapse with possible personal injury and property damage. For general guidance regarding the fabrication, storage, delivery, erection and bracing of trusses and truss systems, see **ANSI/TPI1 Quality Criteria, and DSB-22** available from Truss Plate Institute (www.tpinst.org) and **BCSI Building Component Safety Information** available from the Structural Building Component Association (www.sbcscomponents.com)

MiTek®
 16023 Swingley Ridge Rd.
 Chesterfield, MO 63017
 314.434.1200 / MiTek-US.com


Job 242042	Truss 32	Truss Type Jack-Closed	Qty 1	Ply 1	GENE BOSLEY RES. / ROOF
---------------	-------------	---------------------------	----------	----------	-------------------------

AS NOTED FOR PLAN REVIEW
DEVELOPMENT SERVICES
LEE'S SUMMIT, MISSOURI

Heartland Truss, Inc, Plattsburg, MO - 64477,

8.730 s Oct 31 2024 MiTek Industries, Inc. Wed No 27-17-35-2024 Page 1
ID:mrcY1X_2FQFIXm9hhpx4TmyPVI_yV9DHNgnps0Xongf5QC9t9ok12/6v/KdasVdyE2

12/02/2024

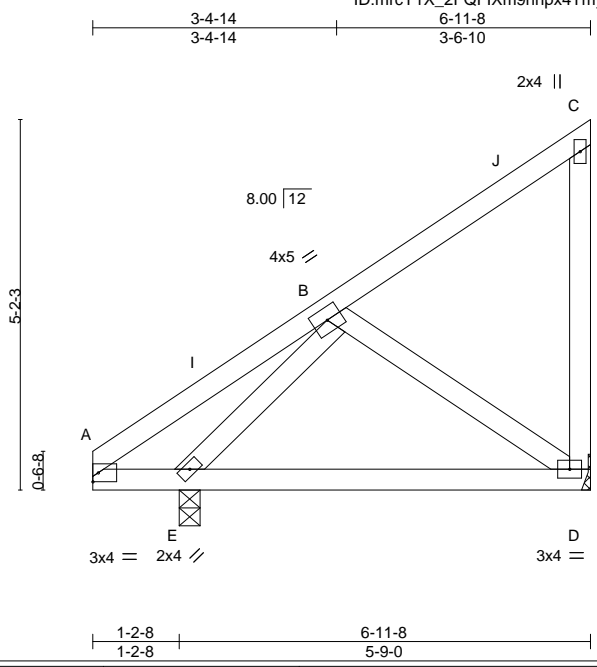

Scale: 3/8"=1'

LOADING (psf)	SPACING-	CSI.	DEFL.	PLATES	GRIP
TCLL 25.0 (Roof Snow=25.0)	2-0-0 Plate Grip DOL 1.15 Lumber DOL 1.15	TC 0.49 BC 0.28 WB 0.11 Matrix-MP	in (loc) l/defl L/d Vert(LL) -0.03 D-E >999 240 Vert(CT) -0.06 D-E >999 180 Horz(CT) 0.00 D n/a n/a	MT20	244/190
TCDL 10.0	Rep Stress Incr YES				
BCLL 0.0	Code IRC2018/TP12014				
BCDL 10.0				Weight: 40 lb	FT = 20%

LUMBER-	BRACING-
TOP CHORD 2x4 SP No.2	TOP CHORD Structural wood sheathing directly applied or 6-0-0 oc purlins, except end verticals.
BOT CHORD 2x4 SP No.2	BOT CHORD Rigid ceiling directly applied or 6-0-0 oc bracing.
WEBS 2x4 SP No.3	

REACTIONS. (size) D=Mechanical, E=0-3-8
Max Horz E=179(LC 11)
Max Uplift D=-75(LC 12), E=-17(LC 12)
Max Grav D=371(LC 18), E=479(LC 18)

FORCES. (lb) - Max. Comp./Max. Ten. - All forces 250 (lb) or less except when shown.
WEBS B-D=-286/163, B-E=-379/174

NOTES-

- 1) Wind: ASCE 7-16; Vult=115mph (3-second gust) Vasd=91mph; TCDL=6.0psf; BCDL=6.0psf; h=20ft; Cat. II; Exp C; Enclosed; MWFRS (envelope) gable end zone and C-C Exterior(2E) zone; cantilever left and right exposed ; end vertical left and right exposed;C-C for members and forces & MWFRS for reactions shown; Lumber DOL=1.33 plate grip DOL=1.33
- 2) TCLL: ASCE 7-16; Pf=25.0 psf (Lum DOL=1.15 Plate DOL=1.15); Is=1.0; Rough Cat C; Fully Exp.; Ce=0.9; Cs=1.00; Ct=1.10
- 3) Unbalanced snow loads have been considered for this design.
- 4) This truss has been designed for a 10.0 psf bottom chord live load nonconcurrent with any other live loads.
- 5) Refer to girder(s) for truss to truss connections.
- 6) Provide mechanical connection (by others) of truss to bearing plate capable of withstanding 75 lb uplift at joint D and 17 lb uplift at joint E.
- 7) This truss is designed in accordance with the 2018 International Residential Code sections R502.11.1 and R802.10.2 and referenced standard ANSI/TP1 1.



November 27, 2024

Job	Truss	Truss Type	Qty	Ply	GENE BOSLEY RES. / ROOF
242042	33	Jack-Closed	2	1	

RELEASE FOR CONSTRUCTION


AS NOTED FOR PLAN REVIEW
DEVELOPMENT SERVICES
LEE'S SUMMIT, MISSOURI

12/02/2024

Heartland Truss, Inc, Plattsburg, MO - 64477,

8.730 s Oct 31 2024 MiTek Industries, Inc. Wed Nov 27 07:36:35 2024 Page 1

ID:mrcY1X_2FQFIXm9hpx4TmyPVI_-yV9DHNgnps0Xongf5QCStcnc/x/Yc/MdasVdy/F2/c

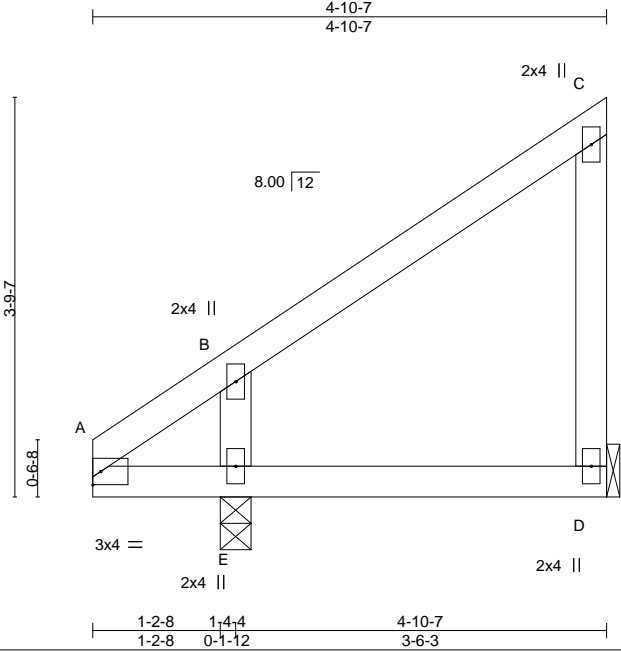

Scale = 1:21.8

LOADING (psf)	SPACING-	CSI.	DEFL.	PLATES	GRIP
TCLL 25.0 (Roof Snow=25.0)	2-0-0 Plate Grip DOL 1.15 Lumber DOL 1.15	TC 0.28 BC 0.19 WB 0.08 Matrix-MP	in (loc) l/defl L/d Vert(LL) 0.01 D-E >999 240 Vert(CT) -0.02 D-E >999 180 Horz(CT) 0.00 D n/a n/a	MT20	244/190
TCDL 10.0	Rep Stress Incr YES				
BCLL 0.0	Code IRC2018/TPI2014				
BCDL 10.0				Weight: 22 lb	FT = 20%

LUMBER-
TOP CHORD 2x4 SP No.2
BOT CHORD 2x4 SP No.2
WEBS 2x4 SP No.3

BRACING-
TOP CHORD Structural wood sheathing directly applied or 4-10-7 oc purlins, except end verticals.
BOT CHORD Rigid ceiling directly applied or 10-0-0 oc bracing.

REACTIONS. (size) D=Mechanical, E=0-3-8
Max Horz E=126(LC 11)
Max Uplift D=61(LC 9), E=-16(LC 12)
Max Grav D=192(LC 18), E=451(LC 18)


FORCES. (lb) - Max. Comp./Max. Ten. - All forces 250 (lb) or less except when shown.
WEBS B-E=-409/208

NOTES-

- 1) Wind: ASCE 7-16; Vult=115mph (3-second gust) Vasd=91mph; TCDL=6.0psf; BCDL=6.0psf; h=20ft; Cat. II; Exp C; Enclosed; MWFRS (envelope) gable end zone and C-C Exterior(2E) zone; cantilever left and right exposed ; end vertical left and right exposed;C-C for members and forces & MWFRS for reactions shown; Lumber DOL=1.33 plate grip DOL=1.33
- 2) TCLL: ASCE 7-16; Pf=25.0 psf (Lum DOL=1.15 Plate DOL=1.15); Is=1.0; Rough Cat C; Fully Exp.; Ce=0.9; Cs=1.00; Ct=1.10
- 3) Unbalanced snow loads have been considered for this design.
- 4) This truss has been designed for a 10.0 psf bottom chord live load nonconcurrent with any other live loads.
- 5) Refer to girder(s) for truss to truss connections.
- 6) Provide mechanical connection (by others) of truss to bearing plate capable of withstanding 61 lb uplift at joint D and 16 lb uplift at joint E.
- 7) This truss is designed in accordance with the 2018 International Residential Code sections R502.11.1 and R802.10.2 and referenced standard ANSI/TPI 1.



November 27, 2024

<p>WARNING - Verify design parameters and READ NOTES ON THIS AND INCLUDED MITEK REFERENCE PAGE MII-7473 rev. 1/2/2023 BEFORE USE.</p> <p>Design valid for use only with MiTek® connectors. This design is based only upon parameters shown, and is for an individual building component, not a truss system. Before use, the building designer must verify the applicability of design parameters and properly incorporate this design into the overall building design. Bracing indicated is to prevent buckling of individual truss web and/or chord members only. Additional temporary and permanent bracing is always required for stability and to prevent collapse with possible personal injury and property damage. For general guidance regarding the fabrication, storage, delivery, erection and bracing of trusses and truss systems, see ANSI/TPI1 Quality Criteria, and DSB-22 available from Truss Plate Institute (www.tpinst.org) and BCSI Building Component Safety Information available from the Structural Building Component Association (www.sbcsccomponents.com)</p>	 <p>16023 Swingley Ridge Rd. Chesterfield, MO 63017 314.434.1200 / MiTek-US.com</p>
--	--

Job 242042	Truss 34	Truss Type Jack-Open	Qty 2	Ply 1	GENE BOSLEY RES. / ROOF
---------------	-------------	-------------------------	----------	----------	-------------------------


AS NOTED FOR PLAN REVIEW
DEVELOPMENT SERVICES
LEE'S SUMMIT, MISSOURI

Heartland Truss, Inc, Plattsburg, MO - 64477,

8.730 s Oct 31 2024 MiTek Industries, Inc. Wed Nov 27 17:36:36 2024 Page 1

ID:mrcY1X_2FQFIXm9hhpx4TmyPVL_QjibVjhRY98NPxFrs7jOQqLWSsZrww208PBYk2b

12/02/2024

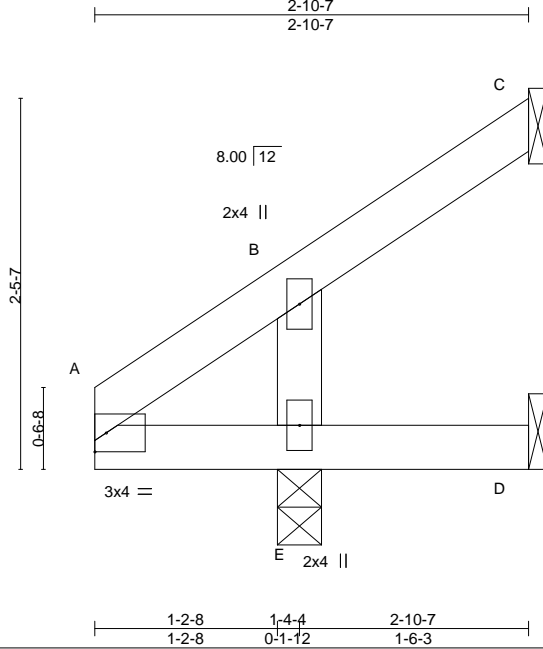

Scale = 1:15.2

LOADING (psf)	SPACING-	CSI.	DEFL.	PLATES	GRIP
TCLL 25.0 (Roof Snow=25.0)	2-0-0 Plate Grip DOL 1.15 Lumber DOL 1.15 Rep Stress Incr YES Code IRC2018/TPI2014	TC 0.14 BC 0.12 WB 0.04 Matrix-MP	in (loc) l/defl L/d Vert(LL) 0.00 D-E >999 240 Vert(CT) 0.00 D-E >999 180 Horz(CT) -0.01 C n/a n/a	MT20	244/190
TCDL 10.0					
BCLL 0.0					
BCDL 10.0				Weight: 11 lb	FT = 20%

LUMBER-
TOP CHORD 2x4 SP No.2
BOT CHORD 2x4 SP No.2
WEBS 2x4 SP No.3

BRACING-
TOP CHORD Structural wood sheathing directly applied or 2-10-7 oc purlins.
BOT CHORD Rigid ceiling directly applied or 10-0-0 oc bracing.

REACTIONS. (size) C=Mechanical, D=Mechanical, E=0-3-8
Max Horz E=73(LC 12)
Max Uplift C=-45(LC 12), D=-23(LC 18)
Max Grav C=35(LC 18), D=13(LC 10), E=340(LC 18)

FORCES. (lb) - Max. Comp./Max. Ten. - All forces 250 (lb) or less except when shown.

NOTES-

- 1) Wind: ASCE 7-16; Vult=115mph (3-second gust) Vasd=91mph; TCDL=6.0psf; BCDL=6.0psf; h=20ft; Cat. II; Exp C; Enclosed; MWFRS (envelope) gable end zone and C-C Exterior(2E) zone; cantilever left and right exposed; end vertical left and right exposed; C-C for members and forces & MWFRS for reactions shown; Lumber DOL=1.33 plate grip DOL=1.33
- 2) TCLL: ASCE 7-16; Pf=25.0 psf (Lum DOL=1.15 Plate DOL=1.15); Is=1.0; Rough Cat C; Fully Exp.; Ce=0.9; Cs=1.00; Ct=1.10
- 3) Unbalanced snow loads have been considered for this design.
- 4) This truss has been designed for a 10.0 psf bottom chord live load nonconcurrent with any other live loads.
- 5) Refer to girder(s) for truss to truss connections.
- 6) Provide mechanical connection (by others) of truss to bearing plate capable of withstanding 45 lb uplift at joint C and 23 lb uplift at joint D.
- 7) This truss is designed in accordance with the 2018 International Residential Code sections R502.11.1 and R802.10.2 and referenced standard ANSI/TPI 1.



November 27, 2024

WARNING - Verify design parameters and READ NOTES ON THIS AND INCLUDED MITEK REFERENCE PAGE MII-7473 rev. 1/2/2023 BEFORE USE.

Design valid for use only with MiTek® connectors. This design is based only upon parameters shown, and is for an individual building component, not a truss system. Before use, the building designer must verify the applicability of design parameters and properly incorporate this design into the overall building design. Bracing indicated is to prevent buckling of individual truss web and/or chord members only. Additional temporary and permanent bracing is always required for stability and to prevent collapse with possible personal injury and property damage. For general guidance regarding the fabrication, storage, delivery, erection and bracing of trusses and truss systems, see **ANSI/TPI1 Quality Criteria, and DSB-22** available from Truss Plate Institute (www.tpinst.org) and **BCSI Building Component Safety Information** available from the Structural Building Component Association (www.sbcsccomponents.com)

MiTek®

16023 Swingley Ridge Rd.
Chesterfield, MO 63017
314.434.1200 / MiTek-US.com

Job	Truss	Truss Type	Qty	Ply	GENE BOSLEY RES. / ROOF
242042	35	Hip	1	1	


RELEASE FOR CONSTRUCTION

AS NOTED FOR PLAN REVIEW
DEVELOPMENT SERVICES

LEE'S SUMMIT, MISSOURI

12/02/2024

Heartland Truss, Inc, Plattsburg, MO - 64477, 8.730 s Oct 31 2024 MiTek Industries, Inc. Wed Nov 27 17:36:37 2024 Page 1

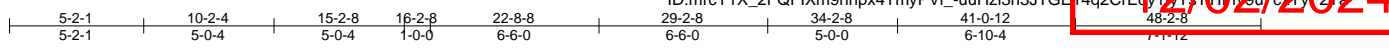

Scale = 1:88.8

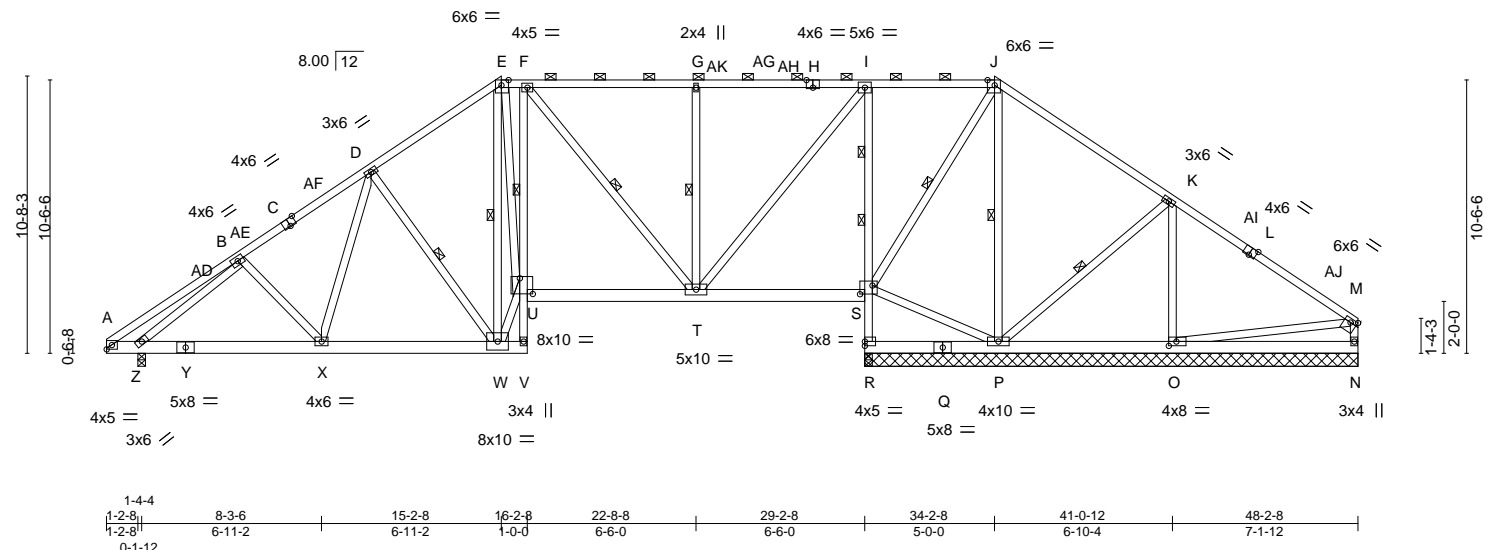


Plate Offsets (X, Y)-- [C:0-3-0,Edge], [E:0-3-5,Edge], [H:0-3-0,Edge], [J:0-3-5,Edge], [L:0-3-0,Edge], [M:Edge,0-1-12], [O:0-3-8,0-2-0], [S:0-5-12,0-4-0], [U:0-6-0,0-7-4]

LOADING (psf)	SPACING-	CSL	DEFL.	PLATES	GRIP
TCLL 25.0 (Roof Snow=25.0)	Plate Grip DOL 1.15	TC 0.96	in (loc) l/def L/d	MT20	244/190
TCDL 10.0	Lumber DOL 1.15	BC 0.74	Vert(LL) -0.10 T-U >999 240		
BCLL 0.0	Rep Stress Incr YES	WB 0.82	Vert(CT) -0.17 T-U >999 180		
BCDL 10.0	Code IRC2018/TPI2014	Matrix-MS	Horz(CT) 0.08 R n/a n/a		
				Weight: 398 lb	FT = 20%

LUMBER-	BRACING-
TOP CHORD 2x4 SP No.2 *Except* E-H,J-L,H-J: 2x4 SP 1650F 1.5E	TOP CHORD Structural wood sheathing directly applied, except end verticals, and 2-0-0 oc purlins (6-0-0 max.): E-J.
BOT CHORD 2x6 SP No.1 *Except* F-V,I-R: 2x4 SP No.3	BOT CHORD Rigid ceiling directly applied or 3-1-8 oc bracing. Except: 1 Row at midpt F-U 2 Rows at 1/3 pts I-S
WEBS 2x4 SP No.3	WEBS 1 Row at midpt D-W, E-W, F-T, G-T, J-S, J-P, K-P

REACTIONS. All bearings 19-0-0 except (jt=length) Z=0-3-8.
 (lb) - Max Horz Z=266(LC 11)
 Max Uplift All uplift 100 lb or less at joint(s) P, N except R=-315(LC 9), O=-119(LC 13), Z=-174(LC 12)
 Max Grav All reactions 250 lb or less at joint(s) except R=2565(LC 31), R=1864(LC 1), P=952(LC 32), O=620(LC 42), N=328(LC 42), Z=1553(LC 32)

FORCES. (lb) - Max. Comp./Max. Ten. - All forces 250 (lb) or less except when shown.
 TOP CHORD A-B=-417/65, B-D=-1680/259, D-E=-1102/274, E-F=-885/286, F-G=-499/219, G-I=-499/219, I-J=-110/754, J-K=-121/689, K-M=-183/345, M-N=-266/130
 BOT CHORD A-Z=0/265, X-Z=-279/1430, W-X=-170/1189, F-U=-317/663, T-U=-142/880, S-T=-748/199, R-S=-2530/338, I-S=-2299/349
 WEBS B-X=-260/154, D-X=-16/277, D-W=-749/209, E-W=-721/170, U-W=-203/1562, E-U=-222/1390, F-T=-907/160, G-T=-876/187, I-T=-252/1969, P-S=-520/182, J-S=-495/60, J-P=-320/41, K-P=-507/130, K-O=-451/228, B-Z=-1561/187, M-O=-305/90

- NOTES-**
- 1) Wind: ASCE 7-16; Vult=115mph (3-second gust) Vasd=91mph; TCDL=6.0psf; BCDL=6.0psf; h=20ft; Cat. II; Exp C; Enclosed; MWFRS (envelope) gable end zone and C-C Exterior(2E) 0-0-0 to 5-0-8, Interior(1) 5-0-8 to 8-4-11, Exterior(2R) 8-4-11 to 22-0-5, Interior(1) 22-0-5 to 27-4-11, Exterior(2R) 27-4-11 to 41-0-12, Interior(1) 41-0-12 to 43-2-14, Exterior(2E) 43-2-14 to 48-0-12 zone; cantilever left and right exposed ; end vertical left and right exposed;C-C for members and forces & MWFRS for reactions shown; Lumber DOL=1.33 plate grip DOL=1.33
 - 2) TCLL: ASCE 7-16; Pf=25.0 psf (Lum DOL=1.15 Plate DOL=1.15); Is=1.0; Rough Cat C; Fully Exp.; Ce=0.9; Cs=1.00; Ct=1.10
 - 3) Unbalanced snow loads have been considered for this design.
 - 4) Provide adequate drainage to prevent water ponding.
 - 5) This truss has been designed for a 10.0 psf bottom chord live load nonconcurrent with any other live loads.
 - 6) Provide mechanical connection (by others) of truss to bearing plate capable of withstanding 100 lb uplift at joint(s) P, N except (jt=lb) R=315, O=119, Z=174.
 - 7) This truss is designed in accordance with the 2018 International Residential Code sections R502.11.1 and R802.10.2 and referenced standard ANSI/TPI 1.
 - 8) Graphical purlin representation does not depict the size or the orientation of the purlin along the top and/or bottom chord.

November 27, 2024

WARNING - Verify design parameters and READ NOTES ON THIS AND INCLUDED MITEK REFERENCE PAGE MII-7473 rev. 1/2/2023 BEFORE USE.

Design valid for use only with MiTek® connectors. This design is based only upon parameters shown, and is for an individual building component, not a truss system. Before use, the building designer must verify the applicability of the design parameters and properly incorporate this design into the overall building design. Bracing indicated is to prevent buckling of individual truss web and/or chord members only. Additional temporary and permanent bracing is always required for stability and to prevent collapse with possible personal injury and property damage. For general guidance regarding the fabrication, storage, delivery, erection and bracing of trusses and truss systems, see **ANSI/TPI1 Quality Criteria, and DSB-22** available from Truss Plate Institute (www.tpinst.org) and **BCSI Building Component Safety Information** available from the Structural Building Component Association (www.sbccomponents.com)


16023 Swingley Ridge Rd.
Chesterfield, MO 63017
314.434.1200 / MiTek-US.com

Job	Truss	Truss Type	Qty	Ply	GENE BOSLEY RES. / ROOF
242042	36	Half Hip	1	1	


AS NOTED FOR PLAN REVIEW
DEVELOPMENT SERVICES
LEE'S SUMMIT, MISSOURI

Heartland Truss, Inc, Plattsburg, MO - 64477,

8.730 s Oct 31 2024 MiTek Industries, Inc. Wed Nov 27 07:36:37 2024 Page 1

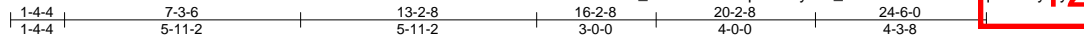

12/02/2024

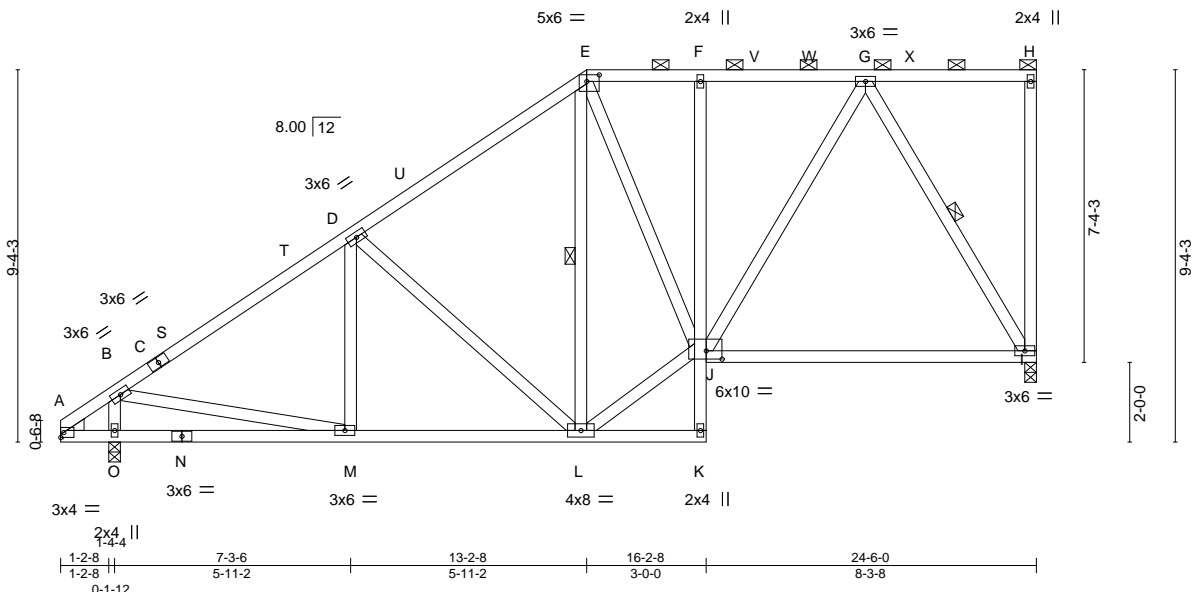

Scale = 1:57.9

Plate Offsets (X,Y)-- [E:0-3-12,0-2-0], [J:0-4-12,0-2-8]

LOADING (psf)	SPACING-	CSI.	DEFL.	PLATES	GRIP
TCLL 25.0 (Roof Snow=25.0)	Plate Grip DOL 1.15 Lumber DOL 1.15 Rep Stress Incr YES Code IRC2018/TPI2014	TC 0.94 BC 0.68 WB 0.73 Matrix-MS	in (loc) l/defl L/d Vert(LL) -0.17 I-J >999 240 Vert(CT) -0.35 I-J >785 180 Horz(CT) 0.03 I n/a n/a	MT20	244/190
TCDL 10.0					
BCLL 0.0					
BCDL 10.0					
				Weight: 181 lb	FT = 20%

LUMBER-
 TOP CHORD 2x4 SP No.2
 BOT CHORD 2x4 SP No.2 *Except*
 F-K: 2x4 SP No.3
 WEBS 2x4 SP No.3
 WEDGE
 Left: 2x4 SP No.3

BRACING-
 TOP CHORD Structural wood sheathing directly applied or 2-2-0 oc purlins, except end verticals, and 2-0-0 oc purlins (5-6-10 max.): E-H.
 BOT CHORD Rigid ceiling directly applied or 10-0-0 oc bracing, Except:
 WEBS 6-0-0 oc bracing: K-L.
 1 Row at midpt E-L, G-I

REACTIONS. (size) I=0-3-8, O=0-3-8
 Max Horz O=307(LC 9)
 Max Uplift I=187(LC 9), O=144(LC 12)
 Max Grav I=1405(LC 28), O=1565(LC 29)

FORCES. (lb) - Max. Comp./Max. Ten. - All forces 250 (lb) or less except when shown.
 TOP CHORD B-D=-1705/177, D-E=-1165/208, E-F=-956/214, F-G=-963/213
 BOT CHORD M-O=-304/417, L-M=-233/1257, F-J=-437/112, I-J=-167/663
 WEBS B-O=-1512/239, B-M=-39/1042, D-L=-648/189, E-L=-292/127, J-L=-177/952, E-J=-70/573,
 G-J=-116/693, G-I=-1282/227

- NOTES-**
- Wind: ASCE 7-16; Vult=115mph (3-second gust) Vasd=91mph; TCDL=6.0psf; BCDL=6.0psf; h=20ft; Cat. II; Exp C; Enclosed; MWFRS (envelope) gable end zone and C-C Exterior(2E) 0-0-0 to 3-0-0, Interior(1) 3-0-0 to 8-11-9, Exterior(2R) 8-11-9 to 17-5-7, Interior(1) 17-5-7 to 21-4-4, Exterior(2E) 21-4-4 to 24-4-4 zone; cantilever left and right exposed; end vertical left and right exposed; C-C for members and forces & MWFRS for reactions shown; Lumber DOL=1.33 plate grip DOL=1.33
 - TCLL: ASCE 7-16; Pf=25.0 psf (Lum DOL=1.15 Plate DOL=1.15); Is=1.0; Rough Cat C; Fully Exp.; Ce=0.9; Cs=1.00; Ct=1.10
 - Unbalanced snow loads have been considered for this design.
 - Provide adequate drainage to prevent water ponding.
 - This truss has been designed for a 10.0 psf bottom chord live load nonconcurrent with any other live loads.
 - Provide mechanical connection (by others) of truss to bearing plate capable of withstanding 100 lb uplift at joint(s) except (jt=lb) I=187, O=144.
 - This truss is designed in accordance with the 2018 International Residential Code sections R502.11.1 and R802.10.2 and referenced standard ANSI/TPI 1.
 - Graphical purlin representation does not depict the size or the orientation of the purlin along the top and/or bottom chord.



November 27, 2024

Job 242042	Truss 37	Truss Type Half Hip	Qty 1	Ply 1	GENE BOSLEY RES. / ROOF
---------------	-------------	------------------------	----------	----------	-------------------------

RELEASE FOR CONSTRUCTION
AS NOTED FOR PLAN REVIEW
DEVELOPMENT SERVICES
LEE'S SUMMIT, MISSOURI
 12/02/2024

Heartland Truss, Inc, Plattsburg, MO - 64477, 8.730 s Oct 31 2024 MiTek Industries, Inc. Wed Nov 27 17:38:38 2024 Page 1
 ID: mrcY1X_2FQFIxm9hpx4TmyPVL_N4rLwPih4nO5fEPmYisVFCpDgVn2QYATvE2

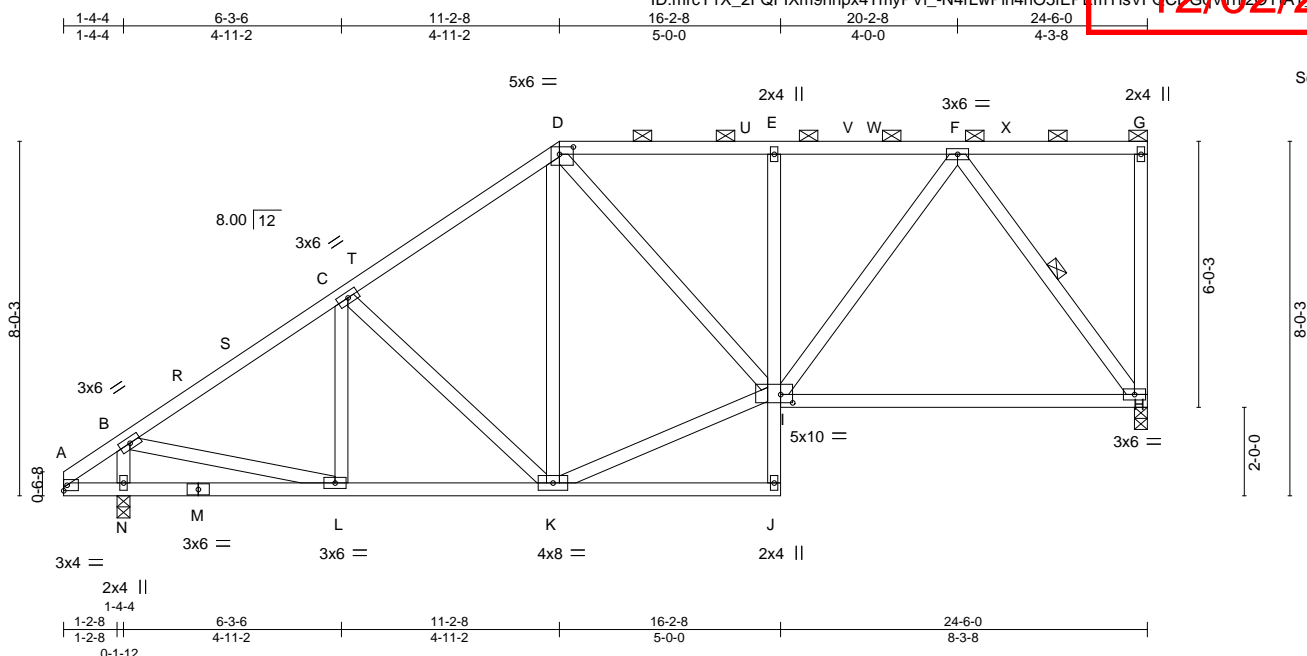


Plate Offsets (X, Y)-- [D:0-3-12,0-2-0], [I:0-3-4,0-2-4]

LOADING (psf)	SPACING-	CSI.	DEFL.	PLATES	GRIP
TCLL 25.0 (Roof Snow=25.0)	2-0-0 Plate Grip DOL 1.15 Lumber DOL 1.15	TC 0.64 BC 0.69 WB 0.45	in (loc) l/defl L/d Vert(LL) -0.17 H-I >999 240 Vert(CT) -0.35 H-I >790 180 Horz(CT) 0.03 H n/a n/a	MT20	244/190
TCDL 10.0	Rep Stress Incr YES	Matrix-MS			
BCLL 0.0	Code IRC2018/TPI2014				
BCDL 10.0				Weight: 169 lb	FT = 20%

LUMBER-	BRACING-
TOP CHORD 2x4 SP No.2	TOP CHORD Structural wood sheathing directly applied or 4-4-9 oc purlins, except end verticals, and 2-0-0 oc purlins (4-0-14 max.): D-G.
BOT CHORD 2x4 SP No.2 *Except* E-J: 2x4 SP No.3	BOT CHORD Rigid ceiling directly applied or 10-0-0 oc bracing, Except:
WEBS 2x4 SP No.3	WEBS 6-0-0 oc bracing: J-K. 1 Row at midpt F-H

REACTIONS. (size) H=0-3-8, N=0-3-8
 Max Horz N=257(LC 9)
 Max Uplift H=-184(LC 9), N=-149(LC 12)
 Max Grav H=1491(LC 28), N=1547(LC 29)

FORCES. (lb) - Max. Comp./Max. Ten. - All forces 250 (lb) or less except when shown.
 TOP CHORD B-C=-1538/181, C-D=-1169/214, D-E=-1330/215, E-F=-1330/211
 BOT CHORD L-N=-252/334, K-L=-225/1145, E-I=-611/137, H-I=-178/875
 WEBS B-N=-1463/219, B-L=-52/1065, C-K=-461/151, I-K=-178/1002, D-I=-90/632, F-I=-113/777, F-H=-1459/233

- NOTES-**
- 1) Wind: ASCE 7-16; Vult=115mph (3-second gust) Vasd=91mph; TCDL=6.0psf; BCDL=6.0psf; h=20ft; Cat. II; Exp C; Enclosed; MWFRS (envelope) gable end zone and C-C Exterior(2E) 0-0-0 to 3-0-0, Interior(1) 3-0-0 to 6-11-9, Exterior(2R) 6-11-9 to 15-5-7, Interior(1) 15-5-7 to 21-4-4, Exterior(2E) 21-4-4 to 24-4-4 zone; cantilever left and right exposed ; end vertical left and right exposed; C-C for members and forces & MWFRS for reactions shown; Lumber DOL=1.33 plate grip DOL=1.33
 - 2) TCLL: ASCE 7-16; Pf=25.0 psf (Lum DOL=1.15 Plate DOL=1.15); ls=1.0; Rough Cat C; Fully Exp.; Ce=0.9; Cs=1.00; Ct=1.10
 - 3) Unbalanced snow loads have been considered for this design.
 - 4) Provide adequate drainage to prevent water ponding.
 - 5) This truss has been designed for a 10.0 psf bottom chord live load nonconcurrent with any other live loads.
 - 6) Provide mechanical connection (by others) of truss to bearing plate capable of withstanding 100 lb uplift at joint(s) except (jt=lb) H=184, N=149.
 - 7) This truss is designed in accordance with the 2018 International Residential Code sections R502.11.1 and R802.10.2 and referenced standard ANSI/TPI 1.
 - 8) Graphical purlin representation does not depict the size or the orientation of the purlin along the top and/or bottom chord.




November 27, 2024

Job 242042	Truss 38	Truss Type Half Hip	Qty 1	Ply 1	GENE BOSLEY RES. / ROOF
---------------	-------------	------------------------	----------	----------	-------------------------

AS NOTED FOR PLAN REVIEW
DEVELOPMENT SERVICES
LEE'S SUMMIT, MISSOURI

Heartland Truss, Inc, Plattsburg, MO - 64477, 8.730 s Oct 31 2024 MiTek Industries, Inc. Wed Nov 27 17:39:39 2024 Page 1
ID:mrcY1X_2FQfIXm9hhpx4TmyPVL_rGOk7IjJr4WYGO QKFG51szl990mB CaCg?QV(2)

12/02/2024

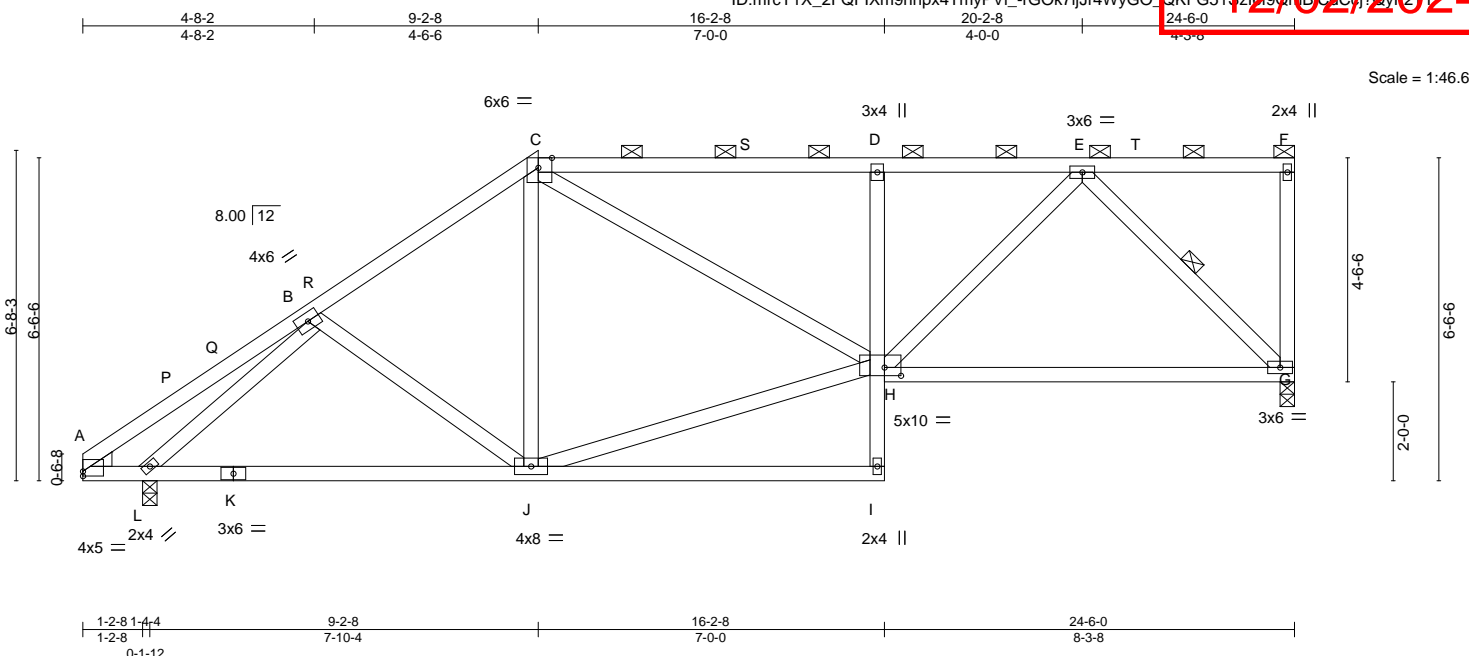

Scale = 1:46.6

Plate Offsets (X, Y)-- [A:0-0-0,0-1-2], [C:0-3-5,Edge], [H:0-4-0,0-2-0]

LOADING (psf)	SPACING-	CSI.	DEFL.	in (loc)	l/defl	L/d	PLATES	GRIP
TCLL 25.0 (Roof Snow=25.0)	Plate Grip DOL 1.15	TC 0.95	Vert(LL) -0.17	G-H	>999	240	MT20	244/190
TCDL 10.0	Lumber DOL 1.15	BC 0.70	Vert(CT) -0.35	G-H	>792	180		
BCLL 0.0	Rep Stress Incr YES	WB 0.66	Horz(CT) 0.06	G	n/a	n/a		
BCDL 10.0	Code IRC2018/TPI2014	Matrix-MS					Weight: 154 lb	FT = 20%

LUMBER-	BRACING-
TOP CHORD 2x4 SP No.2 *Except* C-F: 2x4 SP 1650F 1.5E	TOP CHORD Structural wood sheathing directly applied or 4-6-1 oc purlins, except end verticals, and 2-0-0 oc purlins (2-2-0 max.): C-F.
BOT CHORD 2x4 SP No.2 *Except* D-I: 2x4 SP No.3	BOT CHORD Rigid ceiling directly applied or 10-0-0 oc bracing, Except: 6-0-0 oc bracing: I-J.
WEBS 2x4 SP No.3	WEBS 1 Row at midpt E-G
WEDGE Left: 2x4 SP No.3	

REACTIONS. (size) G=0-3-8, L=0-3-8
 Max Horz L=200(LC 9)
 Max Uplift G=-180(LC 9), L=-89(LC 12)
 Max Grav G=1570(LC 28), L=1424(LC 29)

FORCES. (lb) - Max. Comp./Max. Ten. - All forces 250 (lb) or less except when shown.
 TOP CHORD B-C=-1398/156, C-D=-2010/218, D-E=-1987/204
 BOT CHORD J-L=-225/1069, D-H=-818/176, G-H=-204/1246
 WEBS B-J=-281/221, C-J=-272/130, H-J=-183/1199, C-H=-145/1003, E-H=-97/1060, E-G=-1739/252, B-L=-1478/208

- NOTES-**
- 1) Wind: ASCE 7-16; Vult=115mph (3-second gust) Vasd=91mph; TCDL=6.0psf; BCDL=6.0psf; h=20ft; Cat. II; Exp C; Enclosed; MWFRS (envelope) gable end zone and C-C Exterior(2E) 0-0-0 to 3-0-0, Interior(1) 3-0-0 to 4-11-9, Exterior(2R) 4-11-9 to 13-5-7, Interior(1) 13-5-7 to 21-4-4, Exterior(2E) 21-4-4 to 24-4-4 zone; cantilever left and right exposed ; end vertical left and right exposed; C-C for members and forces & MWFRS for reactions shown; Lumber DOL=1.33 plate grip DOL=1.33
 - 2) TCLL: ASCE 7-16; Pf=25.0 psf (Lum DOL=1.15 Plate DOL=1.15); Is=1.0; Rough Cat C; Fully Exp.; Ce=0.9; Cs=1.00; Ct=1.10
 - 3) Unbalanced snow loads have been considered for this design.
 - 4) Provide adequate drainage to prevent water ponding.
 - 5) This truss has been designed for a 10.0 psf bottom chord live load nonconcurrent with any other live loads.
 - 6) Provide mechanical connection (by others) of truss to bearing plate capable of withstanding 100 lb uplift at joint(s) L except (jt=lb) G=180.
 - 7) This truss is designed in accordance with the 2018 International Residential Code sections R502.11.1 and R802.10.2 and referenced standard ANSI/TPI 1.
 - 8) Graphical purlin representation does not depict the size or the orientation of the purlin along the top and/or bottom chord.



November 27, 2024

Job	Truss	Truss Type	Qty	Ply	GENE BOSLEY RES. / ROOF
242042	39	Common	3	1	

RELEASE FOR CONSTRUCTION


AS NOTED FOR PLAN REVIEW

DEVELOPMENT SERVICES

LEE'S SUMMIT, MISSOURI

12/02/2024

Heartland Truss, Inc, Plattsburg, MO - 64477, 8.730 s Oct 31 2024 MiTek Industries, Inc. Wed Nov 27 17:36:39 2024 Page 1

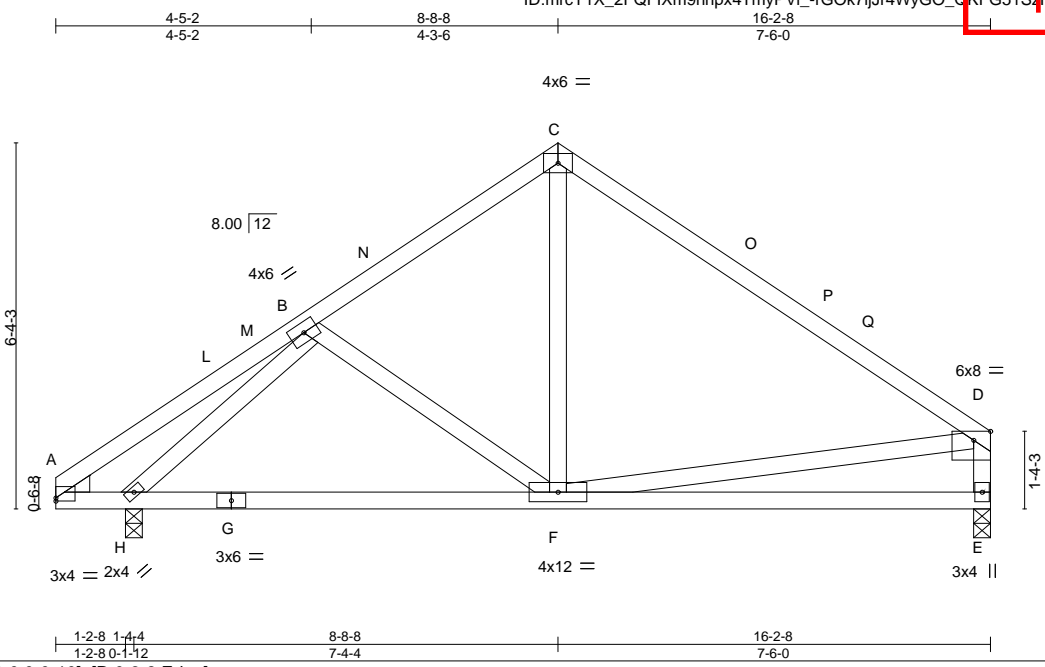

LOADING (psf)	SPACING-	CSI.	DEFL.	PLATES	GRIP
TCLL 25.0 (Roof Snow=25.0)	2-0-0 Plate Grip DOL 1.15 Lumber DOL 1.15 Rep Stress Incr YES Code IRC2018/TPI2014	TC 0.99 BC 0.49 WB 0.35 Matrix-MS	in (loc) l/defl L/d Vert(LL) -0.06 E-F >999 240 Vert(CT) -0.13 E-F >999 180 Horz(CT) 0.01 E n/a n/a	MT20	244/190
TCDL 10.0					
BCLL 0.0					
BCDL 10.0				Weight: 89 lb	FT = 20%

LUMBER-
TOP CHORD 2x4 SP No.2 *Except*
C-D: 2x4 SP 1650F 1.5E
BOT CHORD 2x4 SP No.2
WEBS 2x4 SP No.3 *Except*
D-E: 2x4 SP No.2

BRACING-
TOP CHORD Structural wood sheathing directly applied, except end verticals.
BOT CHORD Rigid ceiling directly applied or 10-0-0 oc bracing.

WEDGE
Left: 2x4 SP No.3

REACTIONS. (size) E=0-3-8, H=0-3-8
Max Horz H=162(LC 11)
Max Uplift E=-61(LC 13), H=-78(LC 12)
Max Grav E=760(LC 19), H=874(LC 18)

FORCES. (lb) - Max. Comp./Max. Ten. - All forces 250 (lb) or less except when shown.
TOP CHORD B-C=-703/141, C-D=-768/115, D-E=-693/116
BOT CHORD F-H=-114/650, E-F=-99/312
WEBS C-F=0/298, B-H=-888/184, D-F=-36/336

NOTES-
1) Wind: ASCE 7-16; Vult=115mph (3-second gust) Vasd=91mph; TCDL=6.0psf; BCDL=6.0psf; h=20ft; Cat. II; Exp C; Enclosed; MWFRS (envelope) gable end zone and C-C Exterior(2E) 0-0-0 to 3-0-0, Interior(1) 3-0-0 to 5-8-8, Exterior(2R) 5-8-8 to 11-8-8, Interior(1) 11-8-8 to 13-0-12, Exterior(2E) 13-0-12 to 16-0-12 zone; cantilever left and right exposed ; end vertical left and right exposed; C-C for members and forces & MWFRS for reactions shown; Lumber DOL=1.33 plate grip DOL=1.33
2) TCLL: ASCE 7-16; Pf=25.0 psf (Lum DOL=1.15 Plate DOL=1.15); Is=1.0; Rough Cat C; Fully Exp.; Ce=0.9; Cs=1.00; Ct=1.10
3) Unbalanced snow loads have been considered for this design.
4) This truss has been designed for a 10.0 psf bottom chord live load nonconcurrent with any other live loads.
5) Provide mechanical connection (by others) of truss to bearing plate capable of withstanding 100 lb uplift at joint(s) E, H.
6) This truss is designed in accordance with the 2018 International Residential Code sections R502.11.1 and R802.10.2 and referenced standard ANSI/TPI 1.



November 27, 2024

WARNING - Verify design parameters and READ NOTES ON THIS AND INCLUDED MITEK REFERENCE PAGE MII-7473 rev. 1/2/2023 BEFORE USE.

Design valid for use only with MiTek® connectors. This design is based only upon parameters shown, and is for an individual building component, not a truss system. Before use, the building designer must verify the applicability of design parameters and properly incorporate this design into the overall building design. Bracing indicated is to prevent buckling of individual truss web and/or chord members only. Additional temporary and permanent bracing is always required for stability and to prevent collapse with possible personal injury and property damage. For general guidance regarding the fabrication, storage, delivery, erection and bracing of trusses and truss systems, see **ANSI/TPI1 Quality Criteria, and DSB-22** available from Truss Plate Institute (www.tpinst.org) and **BCSI Building Component Safety Information** available from the Structural Building Component Association (www.sbcsccomponents.com)


MiTek®
16023 Swingley Ridge Rd.
Chesterfield, MO 63017
314.434.1200 / MiTek-US.com

Job	Truss	Truss Type	Qty	Ply	GENE BOSLEY RES. / ROOF
242042	40	Hip	1	1	

RELEASE FOR CONSTRUCTION
AS NOTED FOR PLAN REVIEW
DEVELOPMENT SERVICES
LEE'S SUMMIT, MISSOURI
12/02/2024

Heartland Truss, Inc, Plattsburg, MO - 64477, 8.730 s Oct 31 2024 MiTek Industries, Inc. Wed Nov 27 09:39:2024 Page 1

ID:mrcY1X_2FQFIXm9hhpx4TmyPVI_rGOk7ljr4WYGO_QKFG51SzK0fZmHRCaCg?QVF2T

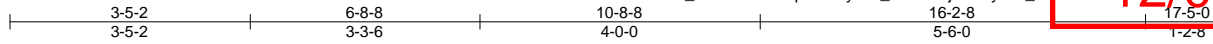

Scale = 1:32.9

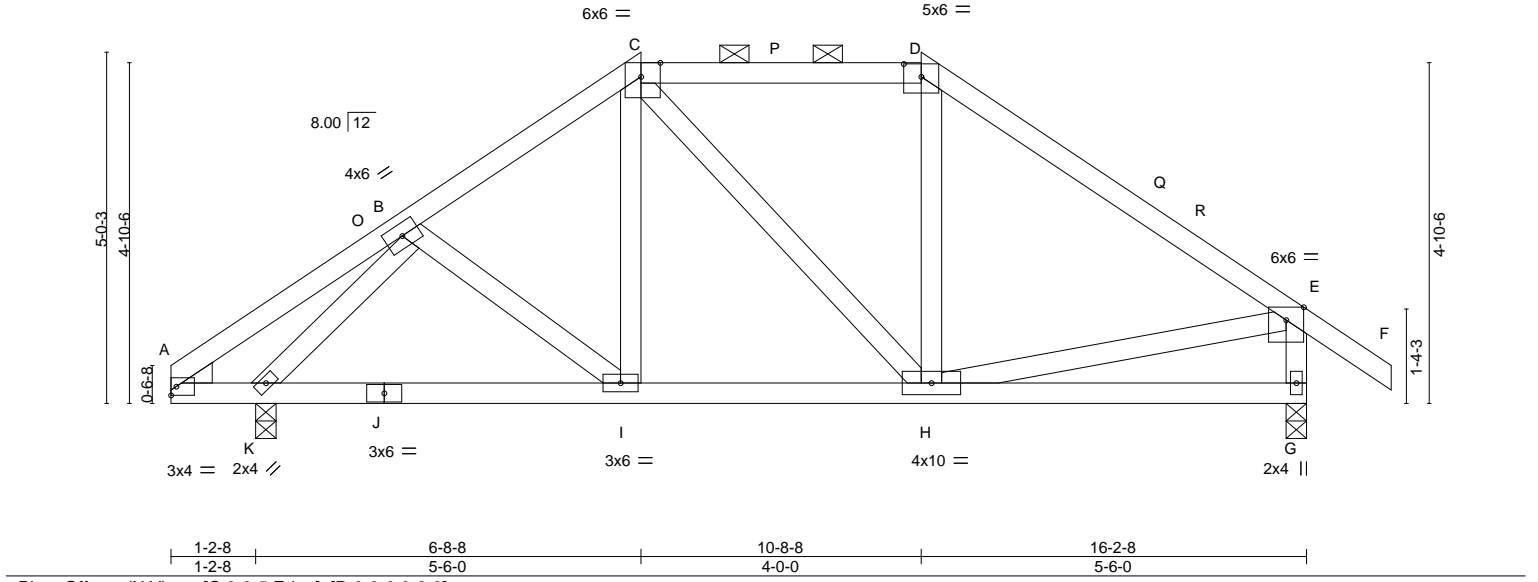


Plate Offsets (X, Y)-- [C:0-3-5,Edge], [D:0-3-0,0-2-3]

LOADING (psf)	SPACING-	CSI.	DEFL.	PLATES	GRIP
TCLL 25.0 (Roof Snow=25.0)	2-0-0 Plate Grip DOL 1.15 Lumber DOL 1.15	TC 0.83 BC 0.31 WB 0.29	in (loc) l/defl L/d Vert(LL) -0.02 G-H >999 240 Vert(CT) -0.04 G-H >999 180 Horz(CT) 0.01 G n/a n/a	MT20	244/190
TCDL 10.0	Rep Stress Incr YES Code IRC2018/TPI2014	Matrix-MS		Weight: 96 lb	FT = 20%
BCLL 0.0					
BCDL 10.0					

LUMBER-	BRACING-
TOP CHORD 2x4 SP No.2	TOP CHORD Structural wood sheathing directly applied or 5-3-8 oc purlins, except end verticals, and 2-0-0 oc purlins (6-0-0 max.): C-D.
BOT CHORD 2x4 SP No.2	BOT CHORD Rigid ceiling directly applied or 6-0-0 oc bracing.
WEBS 2x4 SP No.3	
WEDGE	
Left: 2x4 SP No.3	

REACTIONS. (size) G=0-3-8, K=0-3-8
Max Horz K=135(LC 11)
Max Uplift G=-98(LC 13), K=-87(LC 12)
Max Grav G=1077(LC 33), K=1084(LC 33)

FORCES. (lb) - Max. Comp./Max. Ten. - All forces 250 (lb) or less except when shown.
TOP CHORD B-C=-839/150, C-D=-608/162, D-E=-925/137, E-G=-1025/176
BOT CHORD I-K=-91/659, H-I=-49/609
WEBS B-K=-1106/192, E-H=-49/487

- NOTES-**
- 1) Wind: ASCE 7-16; Vult=115mph (3-second gust) Vasd=91mph; TCDL=6.0psf; BCDL=6.0psf; h=20ft; Cat. II; Exp C; Enclosed; MWFRS (envelope) gable end zone and C-C Exterior(2E) 0-0-0 to 3-0-0, Exterior(2R) 3-0-0 to 14-5-0, Exterior(2E) 14-5-0 to 17-5-0 zone; cantilever left and right exposed ; end vertical left and right exposed;C-C for members and forces & MWFRS for reactions shown; Lumber DOL=1.33 plate grip DOL=1.33
 - 2) TCLL: ASCE 7-16; Pf=25.0 psf (Lum DOL=1.15 Plate DOL=1.15); Is=1.0; Rough Cat C; Fully Exp.; Ce=0.9; Cs=1.00; Ct=1.10
 - 3) Unbalanced snow loads have been considered for this design.
 - 4) This truss has been designed for greater of min roof live load of 16.0 psf or 2.00 times flat roof load of 25.0 psf on overhangs non-concurrent with other live loads.
 - 5) Provide adequate drainage to prevent water ponding.
 - 6) This truss has been designed for a 10.0 psf bottom chord live load nonconcurrent with any other live loads.
 - 7) Provide mechanical connection (by others) of truss to bearing plate capable of withstanding 100 lb uplift at joint(s) G, K.
 - 8) This truss is designed in accordance with the 2018 International Residential Code sections R502.11.1 and R802.10.2 and referenced standard ANSI/TPI 1.
 - 9) Graphical purlin representation does not depict the size or the orientation of the purlin along the top and/or bottom chord.



November 27, 2024

Job 242042	Truss 41	Truss Type Hip Girder	Qty 1	Ply 1	GENE BOSLEY RES. / ROOF
---------------	-------------	--------------------------	----------	----------	-------------------------

AS NOTED FOR PLAN REVIEW
DEVELOPMENT SERVICES

169875948


LEE'S SUMMIT, MISSOURI

Heartland Truss, Inc, Plattsburg, MO - 64477,


8.730 s Oct 31 2024 MiTek Industries, Inc. Wed Nov 27 17:36:10 2024 Page 1

ID:mrcY1X_2FQFXm9hhpx4TmyPVI_-JTy6K5kxcOepuYzdtznKagVZapbVgALrAmGySv(2)

12/02/2024

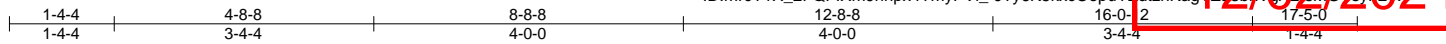

Scale = 1:29.8

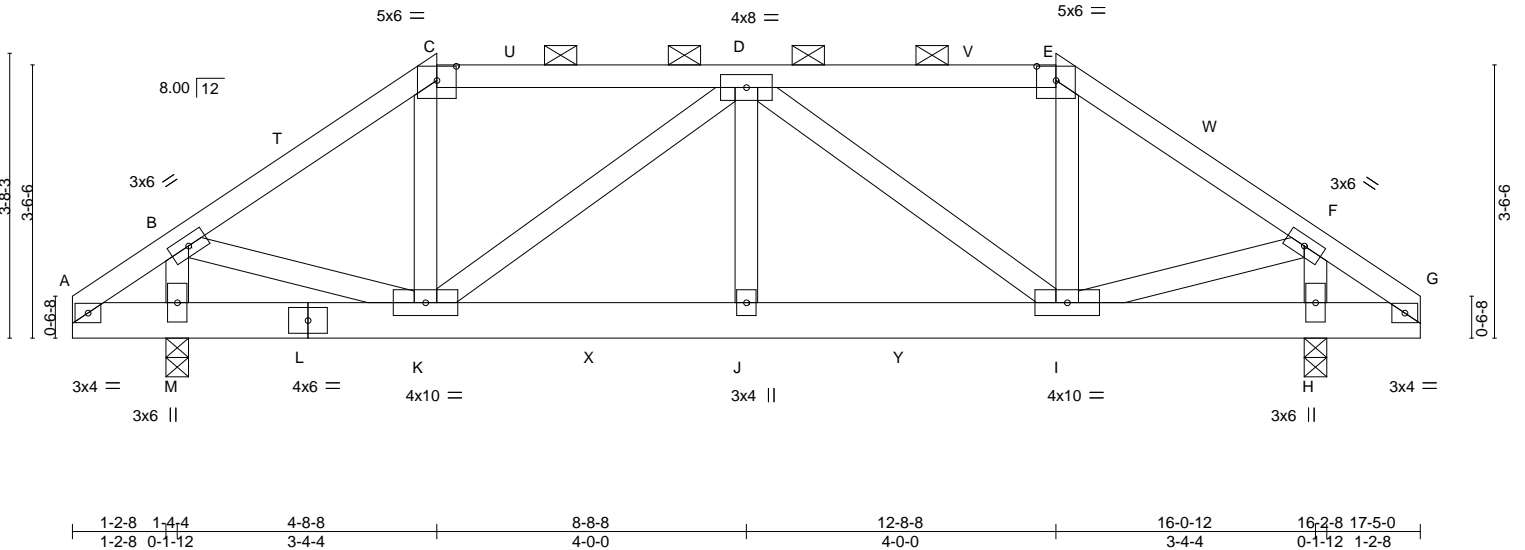

LOADING (psf)	SPACING-	CSI.	DEFL.	PLATES	GRIP
TCLL 25.0 (Roof Snow=25.0)	Plate Grip DOL 1.15 Lumber DOL 1.15 Rep Stress Incr NO Code IRC2018/TPI2014	TC 0.52 BC 0.38 WB 0.52 Matrix-MS	in (loc) l/defl L/d Vert(LL) -0.05 J >999 240 Vert(CT) -0.07 J-K >999 180 Horz(CT) 0.02 H n/a n/a	MT20	244/190
TCDL 10.0				Weight: 108 lb	FT = 20%
BCLL 0.0					
BCDL 10.0					

LUMBER-	BRACING-
TOP CHORD 2x4 SP No.2	TOP CHORD Structural wood sheathing directly applied or 4-8-10 oc purlins, except
BOT CHORD 2x6 SP No.1	2-0-0 oc purlins (4-9-2 max.); C-E.
WEBS 2x4 SP No.3	BOT CHORD Rigid ceiling directly applied or 10-0-0 oc bracing.

REACTIONS. (size) M=0-3-8, H=0-3-8
 Max Horz M=76(LC 9)
 Max Uplift M=-385(LC 12), H=-387(LC 13)
 Max Grav M=1477(LC 32), H=1479(LC 32)

FORCES. (lb) - Max. Comp./Max. Ten. - All forces 250 (lb) or less except when shown.
 TOP CHORD B-C=-1558/463, C-D=-1265/408, D-E=-1268/409, E-F=-1562/465
 BOT CHORD J-K=-514/1958, I-J=-514/1958
 WEBS B-M=-1336/405, B-K=-334/1245, C-K=-192/563, D-K=-876/235, D-J=-117/457,
 D-I=-872/232, E-I=-193/565, F-I=-339/1248, F-H=-1339/406

- NOTES-**
- 1) Wind: ASCE 7-16; Vult=115mph (3-second gust) Vasd=91mph; TCDL=6.0psf; BCDL=6.0psf; h=20ft; Cat. II; Exp C; Enclosed; MWFRS (envelope) gable end zone and C-C Exterior(2E) 0-0-0 to 3-0-0, Exterior(2R) 3-0-0 to 14-5-0, Exterior(2E) 14-5-0 to 17-5-0 zone; cantilever left and right exposed ; end vertical left and right exposed;C-C for members and forces & MWFRS for reactions shown; Lumber DOL=1.33 plate grip DOL=1.33
 - 2) TCLL: ASCE 7-16; Pf=25.0 psf (Lum DOL=1.15 Plate DOL=1.15); Is=1.0; Rough Cat C; Fully Exp.; Ce=0.9; Cs=1.00; Ct=1.10
 - 3) Unbalanced snow loads have been considered for this design.
 - 4) Provide adequate drainage to prevent water ponding.
 - 5) This truss has been designed for a 10.0 psf bottom chord live load nonconcurrent with any other live loads.
 - 6) Provide mechanical connection (by others) of truss to bearing plate capable of withstanding 100 lb uplift at joint(s) except (jt=lb) M=385, H=387.
 - 7) This truss is designed in accordance with the 2018 International Residential Code sections R502.11.1 and R802.10.2 and referenced standard ANSI/TPI 1.
 - 8) Graphical purlin representation does not depict the size or the orientation of the purlin along the top and/or bottom chord.
 - 9) Hanger(s) or other connection device(s) shall be provided sufficient to support concentrated load(s) 330 lb down and 191 lb up at 4-8-8, 158 lb down and 80 lb up at 6-9-4, 158 lb down and 80 lb up at 8-9-4, and 158 lb down and 80 lb up at 10-9-4, and 330 lb down and 191 lb up at 12-7-12 on bottom chord. The design/selection of such connection device(s) is the responsibility of others.
 - 10) In the LOAD CASE(S) section, loads applied to the face of the truss are noted as front (F) or back (B).

LOAD CASE(S) Standard
 1) Dead + Snow (balanced): Lumber Increase=1.15, Plate Increase=1.15
 Uniform Loads (plf)
 Vert: A-C=-70, C-E=-70, E-G=-70, N-Q=-20



November 27, 2024

Continued on page 2

<p>WARNING - Verify design parameters and READ NOTES ON THIS AND INCLUDED MITEK REFERENCE PAGE MII-7473 rev. 1/2/2023 BEFORE USE.</p> <p>Design valid for use only with MiTek® connectors. This design is based only upon parameters shown, and is for an individual building component, not a truss system. Before use, the building designer must verify the applicability of design parameters and properly incorporate this design into the overall building design. Bracing indicated is to prevent buckling of individual truss web and/or chord members only. Additional temporary and permanent bracing is always required for stability and to prevent collapse with possible personal injury and property damage. For general guidance regarding the fabrication, storage, delivery, erection and bracing of trusses and truss systems, see ANSI/TPI1 Quality Criteria, and DSB-22 available from Truss Plate Institute (www.tpinst.org) and BCSI Building Component Safety Information available from the Structural Building Component Association (www.sbcsccomponents.com)</p>	<p>16023 Swingley Ridge Rd. Chesterfield, MO 63017 314.434.1200 / MiTek-US.com</p>
---	--

Job	Truss	Truss Type	Qty	Ply	Job Reference (optional)
242042	41	Hip Girder	1	1	GENE BOSLEY RES. / ROOF

RELEASE FOR CONSTRUCTION

AS NOTED FOR PLAN REVIEW
DEVELOPMENT SERVICES
LEE'S SUMMIT, MISSOURI

12/02/2024

Heartland Truss, Inc, Plattsburg, MO - 64477,

8.730 s Oct 31 2024 MiTek Industries, Inc. Wed No 27:17:36 10/30/24 Page 2
ID:mrcY1X_2FQFIXm9hhpx4TmyPVI_-JTy6K5kxcOepuY2dtznKag\Za2bVgALrM6Ys1E27

LOAD CASE(S) Standard

Concentrated Loads (lb)

Vert: K=-330(F) J=-158(F) I=-330(F) X=-158(F) Y=-158(F)

WARNING - Verify design parameters and READ NOTES ON THIS AND INCLUDED MITEK REFERENCE PAGE MII-7473 rev. 1/2/2023 BEFORE USE.

Design valid for use only with MiTek® connectors. This design is based only upon parameters shown, and is for an individual building component, not a truss system. Before use, the building designer must verify the applicability of design parameters and properly incorporate this design into the overall building design. Bracing indicated is to prevent buckling of individual truss web and/or chord members only. Additional temporary and permanent bracing is always required for stability and to prevent collapse with possible personal injury and property damage. For general guidance regarding the fabrication, storage, delivery, erection and bracing of trusses and truss systems, see **ANSI/TPI1 Quality Criteria, and DSB-22** available from Truss Plate Institute (www.tpinst.org) and **BCSI Building Component Safety Information** available from the Structural Building Component Association (www.sbccomponents.com)

MiTek®

16023 Swingley Ridge Rd.
Chesterfield, MO 63017
314.434.1200 / MiTek-US.com

Job	Truss	Truss Type	Qty	Ply	GENE BOSLEY RES. / ROOF
242042	42	Diagonal Hip Girder	2	1	


AS NOTED FOR PLAN REVIEW
DEVELOPMENT SERVICES
LEE'S SUMMIT, MISSOURI

Heartland Truss, Inc, Plattsburg, MO - 64477,

8.730 s Oct 31 2024 MiTek Industries, Inc. Wed No 27-17-89-11-2024 Page 1

ID: mrcY1X_2FQFIxm9hpx4TmyPVI_nfWUYRlaNimgW3pRgJa72IS7zfEtV4W5p4JVF2TJ

12/02/2024

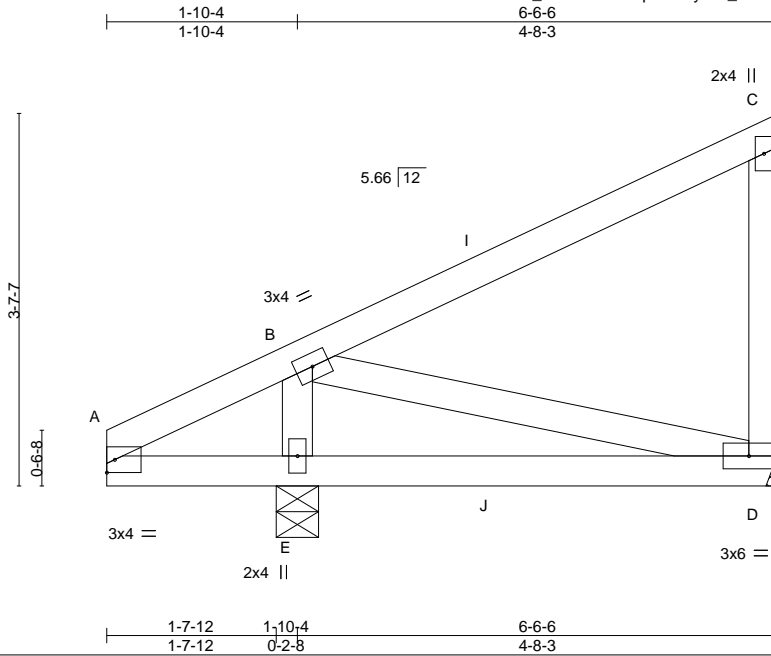

Scale = 1:22.4

LOADING (psf)	SPACING-	CSI.	DEFL.	PLATES	GRIP
TCLL 25.0 (Roof Snow=25.0)	2-0-0 Plate Grip DOL 1.15 Lumber DOL 1.15 Rep Stress Incr NO Code IRC2018/TPI2014	TC 0.51 BC 0.21 WB 0.10 Matrix-MP	in (loc) l/defl L/d Vert(LL) 0.02 D-E >999 240 Vert(CT) 0.02 D-E >999 180 Horz(CT) -0.00 D n/a n/a	MT20	244/190
TCDL 10.0				Weight: 33 lb	FT = 20%
BCLL 0.0					
BCDL 10.0					

LUMBER-
TOP CHORD 2x4 SP No.2
BOT CHORD 2x4 SP No.2
WEBS 2x4 SP No.3

BRACING-
TOP CHORD Structural wood sheathing directly applied or 6-0-0 oc purlins, except end verticals.
BOT CHORD Rigid ceiling directly applied or 6-0-0 oc bracing.

REACTIONS. (size) E=0-4-15, D=Mechanical
Max Horz E=128(LC 11)
Max Uplift E=-106(LC 12), D=-100(LC 9)
Max Grav E=502(LC 18), D=193(LC 18)

FORCES. (lb) - Max. Comp./Max. Ten. - All forces 250 (lb) or less except when shown.
WEBS B-E=-526/258

NOTES-

- 1) Wind: ASCE 7-16; Vult=115mph (3-second gust) Vasd=91mph; TCDL=6.0psf; BCDL=6.0psf; h=20ft; Cat. II; Exp C; Enclosed; MWFRS (envelope) gable end zone and C-C Corner(3) 0-0-0 to 4-2-15, Exterior(2R) 4-2-15 to 6-4-10 zone; cantilever left and right exposed; end vertical left and right exposed; C-C for members and forces & MWFRS for reactions shown; Lumber DOL=1.33 plate grip DOL=1.33
- 2) TCLL: ASCE 7-16; Pf=25.0 psf (Lum DOL=1.15 Plate DOL=1.15); Is=1.0; Rough Cat C; Fully Exp.; Ce=0.9; Cs=1.00; Ct=1.10
- 3) Unbalanced snow loads have been considered for this design.
- 4) This truss has been designed for a 10.0 psf bottom chord live load nonconcurrent with any other live loads.
- 5) Refer to girder(s) for truss to truss connections.
- 6) Provide mechanical connection (by others) of truss to bearing plate capable of withstanding 100 lb uplift at joint(s) D except (jt=lb) E=106.
- 7) This truss is designed in accordance with the 2018 International Residential Code sections R502.11.1 and R802.10.2 and referenced standard ANSI/TPI 1.
- 8) Hanger(s) or other connection device(s) shall be provided sufficient to support concentrated load(s) 93 lb down and 105 lb up at 3-9-8, and 93 lb down and 105 lb up at 3-9-8 on top chord, and 64 lb up at 3-9-8, and 64 lb up at 3-9-8 on bottom chord. The design/selection of such connection device(s) is the responsibility of others.
- 9) In the LOAD CASE(S) section, loads applied to the face of the truss are noted as front (F) or back (B).

LOAD CASE(S) Standard

- 1) Dead + Snow (balanced): Lumber Increase=1.15, Plate Increase=1.15
Uniform Loads (plf)
Vert: A-C=-70, D-F=-20
Concentrated Loads (lb)
Vert: I=60(F=30, B=30) J=66(F=33, B=33)



November 27, 2024

WARNING - Verify design parameters and READ NOTES ON THIS AND INCLUDED MITEK REFERENCE PAGE MII-7473 rev. 1/2/2023 BEFORE USE.

Design valid for use only with MiTek® connectors. This design is based only upon parameters shown, and is for an individual building component, not a truss system. Before use, the building designer must verify the applicability of design parameters and properly incorporate this design into the overall building design. Bracing indicated is to prevent buckling of individual truss web and/or chord members only. Additional temporary and permanent bracing is always required for stability and to prevent collapse with possible personal injury and property damage. For general guidance regarding the fabrication, storage, delivery, erection and bracing of trusses and truss systems, see **ANSI/TPI1 Quality Criteria, and DSB-22** available from Truss Plate Institute (www.tpinst.org) and **BCSI Building Component Safety Information** available from the Structural Building Component Association (www.sbcsccomponents.com)

MiTek®

16023 Swingley Ridge Rd.
Chesterfield, MO 63017
314.434.1200 / MiTek-US.com


Job	Truss	Truss Type	Qty	Ply	GENE BOSLEY RES. / ROOF
242042	43	Jack-Closed	5	1	

RELEASE FOR CONSTRUCTION

AS NOTED FOR PLAN REVIEW
DEVELOPMENT SERVICES
LEE'S SUMMIT, MISSOURI

12/02/2024

Heartland Truss, Inc, Plattsburg, MO - 64477, 8.730 s Oct 31 2024 MiTek Industries, Inc. Wed No 27-07-30-11-2024 Page 1
 ID: mrcY1X_2FQFIxm9hpx4TmyPVI_-nfWUYRlaNimgWi8 RgJa7i2zUT_8E8IV4W5q4JVF2T

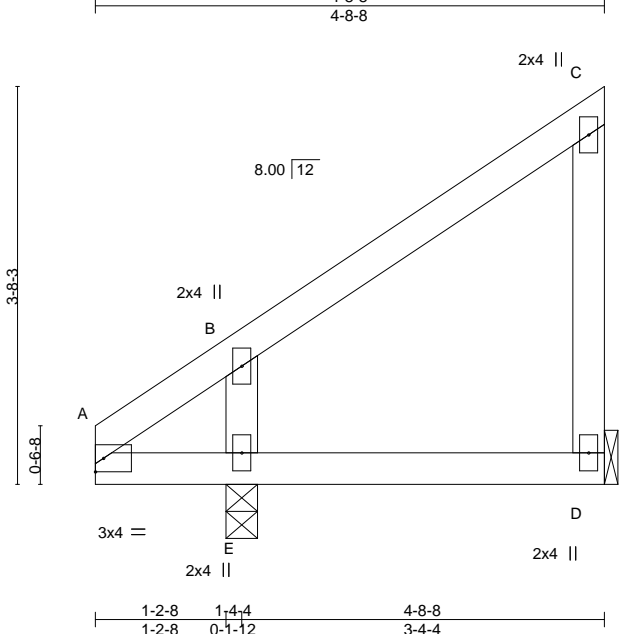

Scale = 1:21.3

LOADING (psf)	SPACING-	CSI.	DEFL.	PLATES	GRIP
TCLL 25.0 (Roof Snow=25.0)	2-0-0 Plate Grip DOL 1.15 Lumber DOL 1.15	TC 0.25 BC 0.18 WB 0.08 Matrix-MP	in (loc) l/defl L/d Vert(LL) 0.01 D-E >999 240 Vert(CT) -0.01 D-E >999 180 Horz(CT) 0.00 D n/a n/a	MT20	244/190
TCDL 10.0	Rep Stress Incr YES				
BCLL 0.0	Code IRC2018/TPI2014				
BCDL 10.0				Weight: 22 lb	FT = 20%

LUMBER-	BRACING-
TOP CHORD 2x4 SP No.2	TOP CHORD Structural wood sheathing directly applied or 4-8-8 oc purlins, except end verticals.
BOT CHORD 2x4 SP No.2	BOT CHORD Rigid ceiling directly applied or 10-0-0 oc bracing.
WEBS 2x4 SP No.3	

REACTIONS. (size) D=Mechanical, E=0-3-8
 Max Horz E=122(LC 11)
 Max Uplift D=-60(LC 9), E=-16(LC 12)
 Max Grav D=178(LC 18), E=439(LC 18)

FORCES. (lb) - Max. Comp./Max. Ten. - All forces 250 (lb) or less except when shown.
 WEBS B-E=-389/199

- NOTES-**
- 1) Wind: ASCE 7-16; Vult=115mph (3-second gust) Vasd=91mph; TCDL=6.0psf; BCDL=6.0psf; h=20ft; Cat. II; Exp C; Enclosed; MWFRS (envelope) gable end zone and C-C Exterior(2E) zone; cantilever left and right exposed ; end vertical left and right exposed;C-C for members and forces & MWFRS for reactions shown; Lumber DOL=1.33 plate grip DOL=1.33
 - 2) TCLL: ASCE 7-16; Pf=25.0 psf (Lum DOL=1.15 Plate DOL=1.15); Is=1.0; Rough Cat C; Fully Exp.; Ce=0.9; Cs=1.00; Ct=1.10
 - 3) Unbalanced snow loads have been considered for this design.
 - 4) This truss has been designed for a 10.0 psf bottom chord live load nonconcurrent with any other live loads.
 - 5) Refer to girder(s) for truss to truss connections.
 - 6) Provide mechanical connection (by others) of truss to bearing plate capable of withstanding 100 lb uplift at joint(s) D, E.
 - 7) This truss is designed in accordance with the 2018 International Residential Code sections R502.11.1 and R802.10.2 and referenced standard ANSI/TPI 1.




November 27, 2024

Job 242042	Truss 44	Truss Type Roof Special Girder	Qty 1	Ply 1	GENE BOSLEY RES. / ROOF
---------------	-------------	-----------------------------------	----------	----------	-------------------------

AS NOTED FOR PLAN REVIEW
DEVELOPMENT SERVICES
LEE'S SUMMIT, MISSOURI

Heartland Truss, Inc, Plattsburg, MO - 64477, 8.730 s Oct 31 2024 MiTek Industries, Inc. Wed Nov 27 07:39:42 2024 Page 1

ID: mrcY1X_2FQFIXm9hpx4TmyPVL_-Fr4slnlC7?uK7sj??OqM5nsMnzLzAaNdVf2V 12/02/2024

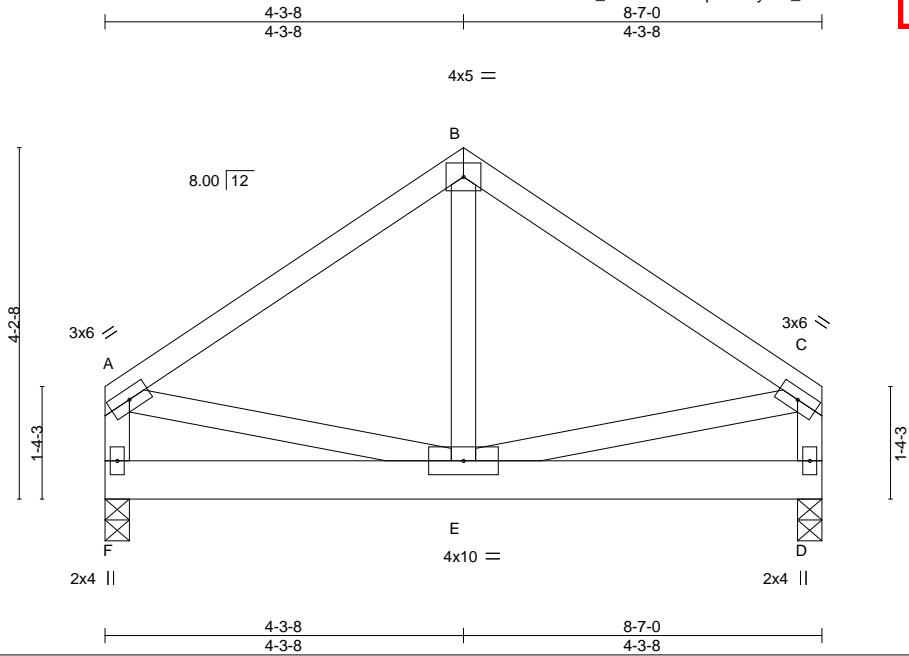

LOADING (psf)	SPACING-	CSI.	DEFL.	PLATES	GRIP
TCLL 25.0 (Roof Snow=25.0)	2-0-0 Plate Grip DOL 1.15	TC 0.79	in (loc) l/defl L/d	MT20	244/190
TCDL 10.0	Lumber DOL 1.15	BC 0.05	Vert(LL) -0.01 E >999 240		
BCLL 0.0	Rep Stress Incr NO	WB 0.22	Vert(CT) -0.01 E >999 180		
BCDL 10.0	Code IRC2018/TPI2014	Matrix-MP	Horz(CT) -0.00 D n/a n/a	Weight: 55 lb	FT = 20%

LUMBER-	BRACING-
TOP CHORD 2x4 SP No.2	TOP CHORD Structural wood sheathing directly applied or 4-7-5 oc purlins, except end verticals.
BOT CHORD 2x6 SP No.1	BOT CHORD Rigid ceiling directly applied or 10-0-0 oc bracing.
WEBS 2x4 SP No.3	

REACTIONS. (size) F=0-3-8, D=0-3-8
 Max Horz F=107(LC 9)
 Max Uplift F=-168(LC 12), D=-168(LC 13)
 Max Grav F=743(LC 18), D=743(LC 19)

FORCES. (lb) - Max. Comp./Max. Ten. - All forces 250 (lb) or less except when shown.
 TOP CHORD A-B=-715/268, B-C=-715/268, A-F=-701/260, C-D=-701/251
 WEBS B-E=-169/375, A-E=-163/524, C-E=-143/524

- NOTES-**
- 1) Wind: ASCE 7-16; Vult=115mph (3-second gust) Vasd=91mph; TCDL=6.0psf; BCDL=6.0psf; h=20ft; Cat. II; Exp C; Enclosed; MWFRS (envelope) gable end zone and C-C Exterior(2E) 0-1-12 to 3-1-12, Exterior(2R) 3-1-12 to 5-5-4, Exterior(2E) 5-5-4 to 8-5-4 zone; cantilever left and right exposed; end vertical left and right exposed; C-C for members and forces & MWFRS for reactions shown; Lumber DOL=1.33 plate grip DOL=1.33
 - 2) TCLL: ASCE 7-16; Pf=25.0 psf (Lum DOL=1.15 Plate DOL=1.15); Is=1.0; Rough Cat C; Fully Exp.; Ce=0.9; Cs=1.00; Ct=1.10
 - 3) Unbalanced snow loads have been considered for this design.
 - 4) This truss has been designed for a 10.0 psf bottom chord live load nonconcurrent with any other live loads.
 - 5) Provide mechanical connection (by others) of truss to bearing plate capable of withstanding 100 lb uplift at joint(s) except (jt=lb) F=168, D=168.
 - 6) This truss is designed in accordance with the 2018 International Residential Code sections R502.11.1 and R802.10.2 and referenced standard ANSI/TPI 1.
 - 7) Hanger(s) or other connection device(s) shall be provided sufficient to support concentrated load(s) 544 lb down and 282 lb up at 4-3-8 on bottom chord. The design/selection of such connection device(s) is the responsibility of others.
 - 8) In the LOAD CASE(S) section, loads applied to the face of the truss are noted as front (F) or back (B).

LOAD CASE(S) Standard
 1) Dead + Snow (balanced): Lumber Increase=1.15, Plate Increase=1.15
 Uniform Loads (plf)
 Vert: A-B=-70, B-C=-70, D-F=-20
 Concentrated Loads (lb)
 Vert: E=-544(F)




November 27, 2024

Job 242042	Truss 45	Truss Type Common	Qty 1	Ply 1	GENE BOSLEY RES. / ROOF
---------------	-------------	----------------------	----------	----------	-------------------------

RELEASE FOR CONSTRUCTION
AS NOTED FOR PLAN REVIEW
DEVELOPMENT SERVICES
LEE'S SUMMIT, MISSOURI
12/02/2024

Heartland Truss, Inc, Plattsburg, MO - 64477, 8.730 s Oct 31 2024 MiTek Industries, Inc. Wed No 27-07-86-12-2024 Page 1
 ID: mrcY1X_2FQFIXm9hpx4TmyPVL_-Fr4slnC7?uX7sj??Oqpf5b1t1KzHcJArNdyE21Y

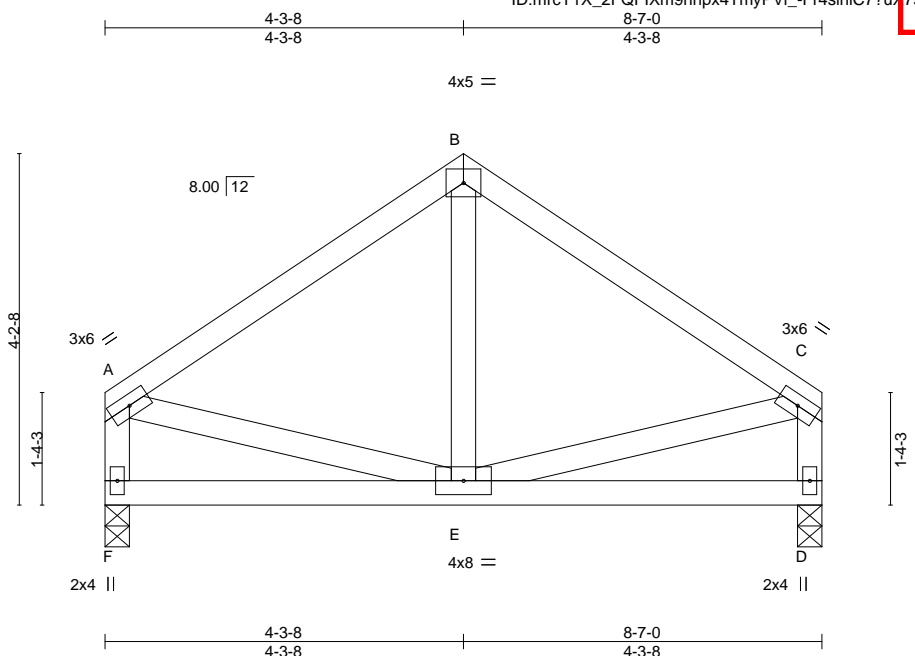

Scale = 1:27.6

LOADING (psf)	SPACING-	CSI.	DEFL.	PLATES	GRIP
TCLL 25.0 (Roof Snow=25.0)	2-0-0 Plate Grip DOL 1.15 Lumber DOL 1.15 Rep Stress Incr YES Code IRC2018/TPI2014	TC 0.65 BC 0.16 WB 0.09 Matrix-MP	in (loc) l/defl L/d Vert(LL) -0.01 E-F >999 240 Vert(CT) -0.02 E-F >999 180 Horz(CT) -0.00 D n/a n/a	MT20	244/190
TCDL 10.0				Weight: 48 lb	FT = 20%
BCLL 0.0					
BCDL 10.0					

LUMBER-
 TOP CHORD 2x4 SP No.2
 BOT CHORD 2x4 SP No.2
 WEBS 2x4 SP No.3

BRACING-
 TOP CHORD Structural wood sheathing directly applied or 6-0-0 oc purlins, except end verticals.
 BOT CHORD Rigid ceiling directly applied or 10-0-0 oc bracing.

REACTIONS. (size) F=0-3-8, D=0-3-8
 Max Horz F=110(LC 11)
 Max Uplift F=-33(LC 12), D=-33(LC 13)
 Max Grav F=471(LC 18), D=471(LC 19)

FORCES. (lb) - Max. Comp./Max. Ten. - All forces 250 (lb) or less except when shown.
 TOP CHORD A-B=-366/96, B-C=-366/96, A-F=-439/129, C-D=-439/119

NOTES-

- 1) Wind: ASCE 7-16; Vult=115mph (3-second gust) Vasd=91mph; TCDL=6.0psf; BCDL=6.0psf; h=20ft; Cat. II; Exp C; Enclosed; MWFRS (envelope) gable end zone and C-C Exterior(2E) 0-1-12 to 3-1-12, Exterior(2R) 3-1-12 to 5-5-4, Exterior(2E) 5-5-4 to 8-5-4 zone; cantilever left and right exposed; end vertical left and right exposed; C-C for members and forces & MWFRS for reactions shown; Lumber DOL=1.33 plate grip DOL=1.33
- 2) TCLL: ASCE 7-16; Pf=25.0 psf (Lum DOL=1.15 Plate DOL=1.15); Is=1.0; Rough Cat C; Fully Exp.; Ce=0.9; Cs=1.00; Ct=1.10
- 3) Unbalanced snow loads have been considered for this design.
- 4) This truss has been designed for a 10.0 psf bottom chord live load nonconcurrent with any other live loads.
- 5) Provide mechanical connection (by others) of truss to bearing plate capable of withstanding 100 lb uplift at joint(s) F, D.
- 6) This truss is designed in accordance with the 2018 International Residential Code sections R502.11.1 and R802.10.2 and referenced standard ANSI/TPI 1.



November 27, 2024

Job 242042	Truss 46	Truss Type Diagonal Hip Girder	Qty 1	Ply 1	GENE BOSLEY RES. / ROOF
---------------	-------------	-----------------------------------	----------	----------	-------------------------

AS NOTED FOR PLAN REVIEW
DEVELOPMENT SERVICES
LEE'S SUMMIT, MISSOURI

Heartland Truss, Inc, Plattsburg, MO - 64477,


8.730 s Oct 31 2024 MiTek Industries, Inc.

Wed Nov 27 07:39:13 2024 Page 1

ID:mrCY1X_2FQFIXm9hhpx4TmyPVL-j2eEz7mqJ0OI?

HCZ5L2C175xHeliikXday8Eyl2JL

12/02/2024

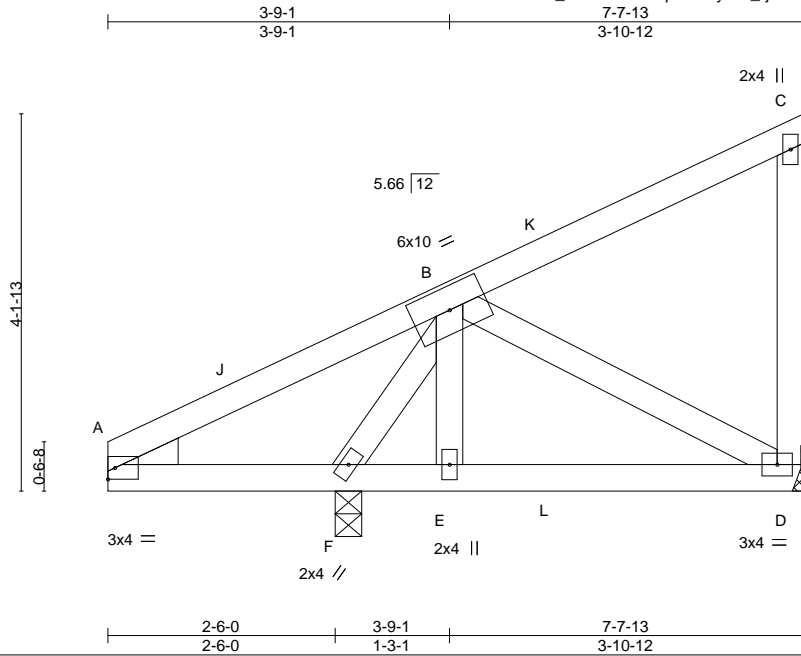

Scale = 1:25.3

LOADING (psf)	SPACING-	CSI.	DEFL.	PLATES	GRIP
TCLL 25.0 (Roof Snow=25.0)	2-0-0 Plate Grip DOL 1.15 Lumber DOL 1.15 Rep Stress Incr NO Code IRC2018/TPI2014	TC 0.45 BC 0.30 WB 0.11 Matrix-MP	in (loc) l/defl L/d Vert(LL) 0.01 D-E >999 240 Vert(CT) -0.01 D-E >999 180 Horz(CT) -0.00 F n/a n/a	MT20	244/190
TCDL 10.0				Weight: 42 lb	FT = 20%
BCLL 0.0					
BCDL 10.0					

LUMBER-
TOP CHORD 2x4 SP No.2
BOT CHORD 2x4 SP No.2
WEBS 2x4 SP No.3
WEDGE
Left: 2x4 SP No.3

BRACING-
TOP CHORD Structural wood sheathing directly applied or 6-0-0 oc purlins, except end verticals.
BOT CHORD Rigid ceiling directly applied or 6-0-0 oc bracing.

REACTIONS. (size) D=Mechanical, F=0-3-8
Max Horz D=149(LC 11)
Max Uplift D=-112(LC 9), F=-104(LC 12)
Max Grav D=215(LC 18), F=606(LC 18)

FORCES. (lb) - Max. Comp./Max. Ten. - All forces 250 (lb) or less except when shown.
TOP CHORD A-B=-150/311
WEBS B-F=-507/266

NOTES-

- Wind: ASCE 7-16; Vult=115mph (3-second gust) Vasd=91mph; TCDL=6.0psf; BCDL=6.0psf; h=20ft; Cat. II; Exp C; Enclosed; MWFRS (envelope) gable end zone and C-C Corner(3) 0-0-0 to 4-2-15, Exterior(2R) 4-2-15 to 7-6-1 zone; cantilever left and right exposed; end vertical left and right exposed; C-C for members and forces & MWFRS for reactions shown; Lumber DOL=1.33 plate grip DOL=1.33
- TCLL: ASCE 7-16; Pf=25.0 psf (Lum DOL=1.15 Plate DOL=1.15); Is=1.0; Rough Cat C; Fully Exp.; Ce=0.9; Cs=1.00; Ct=1.10
- Unbalanced snow loads have been considered for this design.
- This truss has been designed for a 10.0 psf bottom chord live load nonconcurrent with any other live loads.
- Refer to girder(s) for truss to truss connections.
- Provide mechanical connection (by others) of truss to bearing plate capable of withstanding 100 lb uplift at joint(s) except (jt=lb) D=112, F=104.
- This truss is designed in accordance with the 2018 International Residential Code sections R502.11.1 and R802.10.2 and referenced standard ANSI/TPI 1.
- Hanger(s) or other connection device(s) shall be provided sufficient to support concentrated load(s) 112 lb down and 95 lb up at 4-10-15, and 124 lb down and 176 lb up at 4-10-15 on top chord, and 11 lb down and 18 lb up at 4-10-15, and 12 lb down and 111 lb up at 4-10-15 on bottom chord. The design/selection of such connection device(s) is the responsibility of others.
- In the LOAD CASE(S) section, loads applied to the face of the truss are noted as front (F) or back (B).

LOAD CASE(S) Standard

- Dead + Snow (balanced): Lumber Increase=1.15, Plate Increase=1.15
Uniform Loads (plf)
Vert: A-C=-70, D-G=-20
Concentrated Loads (lb)
Vert: K=42(F) L=49(F=47, B=2)



November 27, 2024

WARNING - Verify design parameters and READ NOTES ON THIS AND INCLUDED MITEK REFERENCE PAGE MII-7473 rev. 1/2/2023 BEFORE USE.

Design valid for use only with MiTek® connectors. This design is based only upon parameters shown, and is for an individual building component, not a truss system. Before use, the building designer must verify the applicability of design parameters and properly incorporate this design into the overall building design. Bracing indicated is to prevent buckling of individual truss web and/or chord members only. Additional temporary and permanent bracing is always required for stability and to prevent collapse with possible personal injury and property damage. For general guidance regarding the fabrication, storage, delivery, erection and bracing of trusses and truss systems, see **ANSI/TPI1 Quality Criteria, and DSB-22** available from Truss Plate Institute (www.tpinst.org) and **BCSI Building Component Safety Information** available from the Structural Building Component Association (www.sbcsccomponents.com)

MiTek®

16023 Swingley Ridge Rd.
Chesterfield, MO 63017
314.434.1200 / MiTek-US.com

Job 242042	Truss 47	Truss Type Diagonal Hip Girder	Qty 1	Ply 1	GENE BOSLEY RES. / ROOF
---------------	-------------	-----------------------------------	----------	----------	-------------------------


AS NOTED FOR PLAN REVIEW
DEVELOPMENT SERVICES
LEE'S SUMMIT, MISSOURI

Heartland Truss, Inc, Plattsburg, MO - 64477,

8.730 s Oct 31 2024 MiTek Industries, Inc. Wed Nov 27 17:36:13 2024 Page 1

ID:mrcY1X_2FQFIxm9hpx4TmyPVL_j2eEz7mqJ00I?HCZ5L2C75%Hatire%Jay%8BY%2%L

12/02/2024

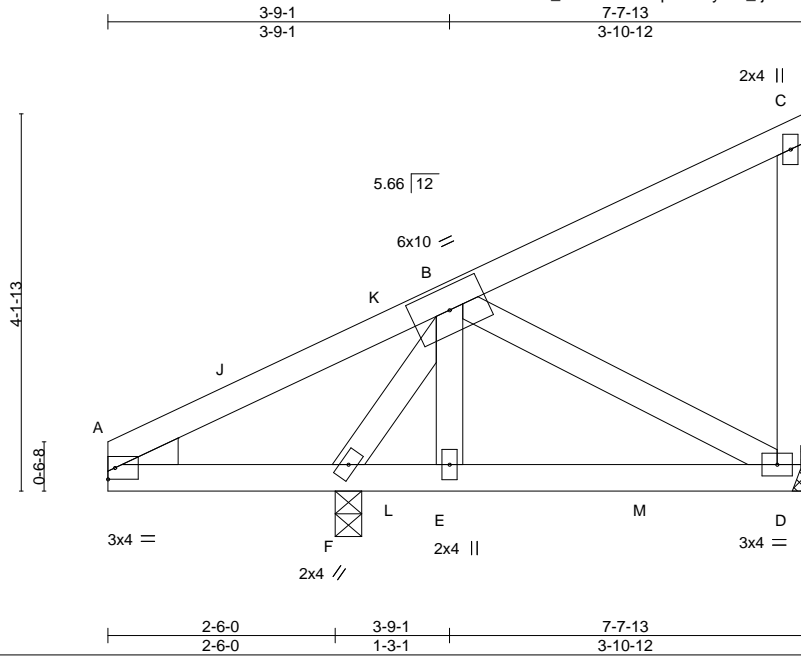

Scale = 1:25.3

LOADING (psf)	SPACING-	CSI.	DEFL.	PLATES	GRIP
TCLL 25.0 (Roof Snow=25.0)	2-0-0 Plate Grip DOL 1.15 Lumber DOL 1.15 Rep Stress Incr NO Code IRC2018/TPI2014	TC 0.46 BC 0.54 WB 0.15 Matrix-MP	in (loc) l/defl L/d Vert(LL) -0.03 D-E >999 240 Vert(CT) -0.04 D-E >999 180 Horz(CT) -0.00 F n/a n/a	MT20	244/190
TCDL 10.0				Weight: 42 lb	FT = 20%
BCLL 0.0					
BCDL 10.0					

LUMBER-	BRACING-
TOP CHORD 2x4 SP No.2	TOP CHORD Structural wood sheathing directly applied or 6-0-0 oc purlins, except end verticals.
BOT CHORD 2x4 SP No.2	BOT CHORD Rigid ceiling directly applied or 6-0-0 oc bracing.
WEBS 2x4 SP No.3	
WEDGE	
Left: 2x4 SP No.3	

REACTIONS. (size) D=Mechanical, F=0-3-8
 Max Horz D=149(LC 11)
 Max Uplift D=-129(LC 9), F=-161(LC 12)
 Max Grav D=386(LC 18), F=639(LC 18)

FORCES. (lb) - Max. Comp./Max. Ten. - All forces 250 (lb) or less except when shown.
 TOP CHORD A-B=-138/296
 WEBS B-F=-719/290

NOTES-

- 1) Wind: ASCE 7-16; Vult=115mph (3-second gust) Vasd=91mph; TCDL=6.0psf; BCDL=6.0psf; h=20ft; Cat. II; Exp C; Enclosed; MWFRS (envelope) gable end zone and C-C Corner(3) 0-0-0 to 4-2-15, Exterior(2R) 4-2-15 to 7-6-1 zone; cantilever left and right exposed; end vertical left and right exposed; C-C for members and forces & MWFRS for reactions shown; Lumber DOL=1.33 plate grip DOL=1.33
- 2) TCLL: ASCE 7-16; Pf=25.0 psf (Lum DOL=1.15 Plate DOL=1.15); Is=1.0; Rough Cat C; Fully Exp.; Ce=0.9; Cs=1.00; Ct=1.10
- 3) Unbalanced snow loads have been considered for this design.
- 4) This truss has been designed for a 10.0 psf bottom chord live load nonconcurrent with any other live loads.
- 5) Refer to girder(s) for truss to truss connections.
- 6) Provide mechanical connection (by others) of truss to bearing plate capable of withstanding 100 lb uplift at joint(s) except (jt=lb) D=129, F=161.
- 7) This truss is designed in accordance with the 2018 International Residential Code sections R502.11.1 and R802.10.2 and referenced standard ANSI/TPI 1.
- 8) Hanger(s) or other connection device(s) shall be provided sufficient to support concentrated load(s) 112 lb down and 95 lb up at 3-2-7, and 124 lb down and 176 lb up at 3-2-7 on top chord, and 23 lb down and 18 lb up at 3-2-7, and 24 lb down and 111 lb up at 3-2-7, and 203 lb down and 92 lb up at 5-11-5 on bottom chord. The design/selection of such connection device(s) is the responsibility of others.
- 9) In the LOAD CASE(S) section, loads applied to the face of the truss are noted as front (F) or back (B).

LOAD CASE(S) Standard

- 1) Dead + Snow (balanced): Lumber Increase=1.15, Plate Increase=1.15
 Uniform Loads (plf)
 Vert: A-C=-70, D-G=-20
 Concentrated Loads (lb)
 Vert: K=42(B) L=49(F=2, B=47) M=-203(F)



November 27, 2024

Job 242042	Truss 48	Truss Type Jack-Closed	Qty 1	Ply 1	GENE BOSLEY RES. / ROOF
---------------	-------------	---------------------------	----------	----------	-------------------------

AS NOTED FOR PLAN REVIEW
DEVELOPMENT SERVICES
LEE'S SUMMIT, MISSOURI


Heartland Truss, Inc, Plattsburg, MO - 64477,

8.730 s Oct 31 2024 MiTek Industries, Inc. Wed No 27-07-30-14-2024 Page 1

ID:mrCY1X_2FQFIXm9hhpx4TmyPVI_-BECdASnSfd8FN9sO6psHkWgYcLrRtoxmKJhgyF2T
5-4-3
5-4-3

12/02/2024

Scale = 1:25.1

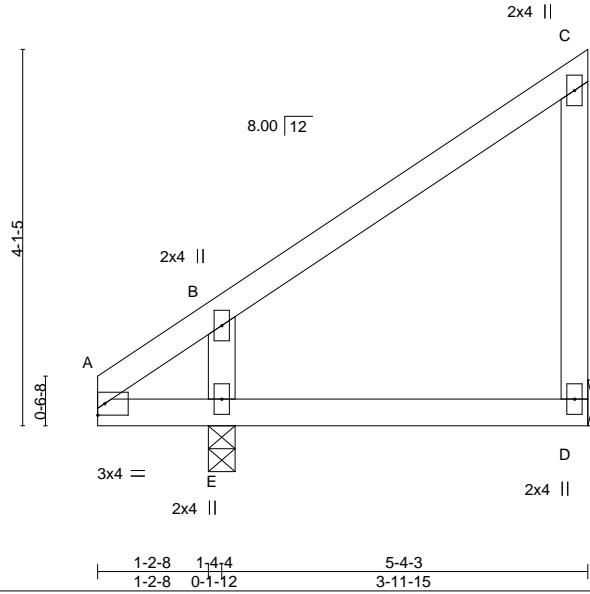

LOADING (psf)	SPACING-	CSI.	DEFL.	in (loc)	l/defl	L/d	PLATES	GRIP
TCLL 25.0 (Roof Snow=25.0)	2-0-0 Plate Grip DOL 1.15 Lumber DOL 1.15	TC 0.39 BC 0.23 WB 0.09 Matrix-MP	Vert(LL) 0.02 Vert(CT) -0.03 Horz(CT) 0.00	D-E D-E D	>999 >999 n/a	240 180 n/a	MT20	244/190
TCDL 10.0	Rep Stress Incr YES Code IRC2018/TPI2014						Weight: 24 lb	FT = 20%
BCLL 0.0								
BCDL 10.0								

LUMBER-
TOP CHORD 2x4 SP No.2
BOT CHORD 2x4 SP No.2
WEBS 2x4 SP No.3

BRACING-
TOP CHORD Structural wood sheathing directly applied or 5-4-3 oc purlins, except end verticals.
BOT CHORD Rigid ceiling directly applied or 10-0-0 oc bracing.

REACTIONS. (size) D=Mechanical, E=0-3-8
Max Horz E=138(LC 11)
Max Uplift D=-64(LC 9), E=-18(LC 12)
Max Grav D=231(LC 18), E=482(LC 18)

FORCES. (lb) - Max. Comp./Max. Ten. - All forces 250 (lb) or less except when shown.
WEBS B-E=-465/236

- NOTES-**
- 1) Wind: ASCE 7-16; Vult=115mph (3-second gust) Vasd=91mph; TCDL=6.0psf; BCDL=6.0psf; h=20ft; Cat. II; Exp C; Enclosed; MWFRS (envelope) gable end zone and C-C Exterior(2E) zone; cantilever left and right exposed ; end vertical left and right exposed;C-C for members and forces & MWFRS for reactions shown; Lumber DOL=1.33 plate grip DOL=1.33
 - 2) TCLL: ASCE 7-16; Pf=25.0 psf (Lum DOL=1.15 Plate DOL=1.15); Is=1.0; Rough Cat C; Fully Exp.; Ce=0.9; Cs=1.00; Ct=1.10
 - 3) Unbalanced snow loads have been considered for this design.
 - 4) This truss has been designed for a 10.0 psf bottom chord live load nonconcurrent with any other live loads.
 - 5) Refer to girder(s) for truss to truss connections.
 - 6) Provide mechanical connection (by others) of truss to bearing plate capable of withstanding 100 lb uplift at joint(s) D, E.
 - 7) This truss is designed in accordance with the 2018 International Residential Code sections R502.11.1 and R802.10.2 and referenced standard ANSI/TPI 1.



November 27, 2024

WARNING - Verify design parameters and READ NOTES ON THIS AND INCLUDED MITEK REFERENCE PAGE MII-7473 rev. 1/2/2023 BEFORE USE.

Design valid for use only with MiTek® connectors. This design is based only upon parameters shown, and is for an individual building component, not a truss system. Before use, the building designer must verify the applicability of design parameters and properly incorporate this design into the overall building design. Bracing indicated is to prevent buckling of individual truss web and/or chord members only. Additional temporary and permanent bracing is always required for stability and to prevent collapse with possible personal injury and property damage. For general guidance regarding the fabrication, storage, delivery, erection and bracing of trusses and truss systems, see **ANSI/TPI1 Quality Criteria, and DSB-22** available from Truss Plate Institute (www.tpinst.org) and **BCSI Building Component Safety Information** available from the Structural Building Component Association (www.sbcsccomponents.com)

MiTek®

16023 Swingley Ridge Rd.
Chesterfield, MO 63017
314.434.1200 / MiTek-US.com

Job	Truss	Truss Type	Qty	Ply	GENE BOSLEY RES. / ROOF
242042	49	Jack-Open	2	1	

RELEASE FOR CONSTRUCTION


AS NOTED FOR PLAN REVIEW

DEVELOPMENT SERVICES

LEE'S SUMMIT, MISSOURI

12/02/2024

Heartland Truss, Inc, Plattsburg, MO - 64477, 8.730 s Oct 31 2024 MiTek Industries, Inc. Wed Nov 27 17:36:14 2024 Page 1

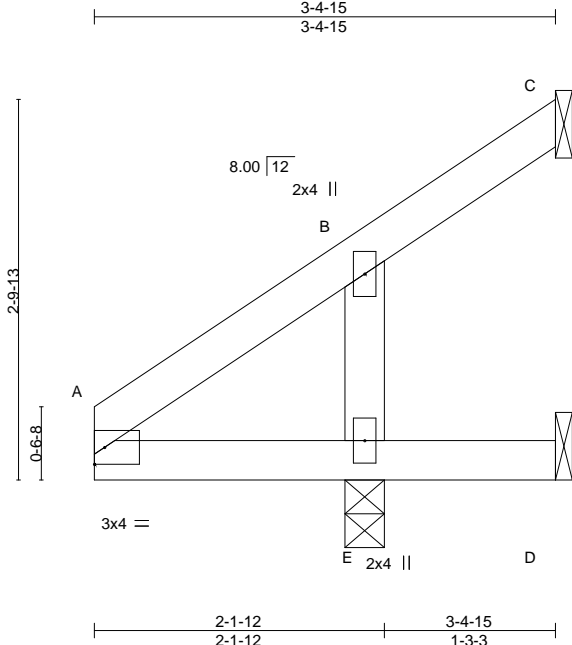

Scale = 1:17.0

LOADING (psf)	SPACING-	CSI.	DEFL.	PLATES	GRIP
TCLL 25.0 (Roof Snow=25.0)	2-0-0 Plate Grip DOL 1.15 Lumber DOL 1.15	TC 0.28 BC 0.30 WB 0.08 Matrix-MP	in (loc) l/defl L/d Vert(LL) 0.00 D-E >999 240 Vert(CT) 0.00 D-E >999 180 Horz(CT) 0.05 D n/a n/a	MT20	244/190
TCDL 10.0	Rep Stress Incr YES				
BCLL 0.0	Code IRC2018/TPI2014				
BCDL 10.0				Weight: 13 lb	FT = 20%

LUMBER-	BRACING-
TOP CHORD 2x4 SP No.2	TOP CHORD Structural wood sheathing directly applied or 3-4-15 oc purlins.
BOT CHORD 2x4 SP No.2	BOT CHORD Rigid ceiling directly applied or 10-0-0 oc bracing.
WEBS 2x4 SP No.3	

REACTIONS. (size) C=Mechanical, D=Mechanical, E=0-3-8
 Max Horz C=87(LC 12)
 Max Uplift C=-25(LC 21), D=-83(LC 18), E=-134(LC 12)
 Max Grav C=55(LC 12), D=29(LC 12), E=535(LC 18)

FORCES. (lb) - Max. Comp./Max. Ten. - All forces 250 (lb) or less except when shown.
 WEBS B-E=-328/224

- NOTES-**
- 1) Wind: ASCE 7-16; Vult=115mph (3-second gust) Vasd=91mph; TCDL=6.0psf; BCDL=6.0psf; h=20ft; Cat. II; Exp C; Enclosed; MWFRS (envelope) gable end zone and C-C Exterior(2E) zone; cantilever left and right exposed ; end vertical left and right exposed;C-C for members and forces & MWFRS for reactions shown; Lumber DOL=1.33 plate grip DOL=1.33
 - 2) TCLL: ASCE 7-16; Pf=25.0 psf (Lum DOL=1.15 Plate DOL=1.15); Is=1.0; Rough Cat C; Fully Exp.; Ce=0.9; Cs=1.00; Ct=1.10
 - 3) Unbalanced snow loads have been considered for this design.
 - 4) This truss has been designed for a 10.0 psf bottom chord live load nonconcurrent with any other live loads.
 - 5) Refer to girder(s) for truss to truss connections.
 - 6) Provide mechanical connection (by others) of truss to bearing plate capable of withstanding 100 lb uplift at joint(s) C, D except (jt=lb) E=134.
 - 7) This truss is designed in accordance with the 2018 International Residential Code sections R502.11.1 and R802.10.2 and referenced standard ANSI/TPI 1.




November 27, 2024

Job	Truss	Truss Type	Qty	Ply	GENE BOSLEY RES. / ROOF
242042	50	Jack-Open	2	1	

RELEASE FOR CONSTRUCTION
AS NOTED FOR PLAN REVIEW
DEVELOPMENT SERVICES
LEE'S SUMMIT, MISSOURI

169875927
12/02/2024

Heartland Truss, Inc, Plattsburg, MO - 64477, 8.730 s Oct 31 2024 MiTek Industries, Inc. Wed Nov 27 07:39:14 2024 Page 1
 ID: mrcY1X_2FQFIXm9hpx4TmyPVL_BECdASnSfd8FN9sO SpsHkWg_80dJFcDxmLkUjhsyF2T

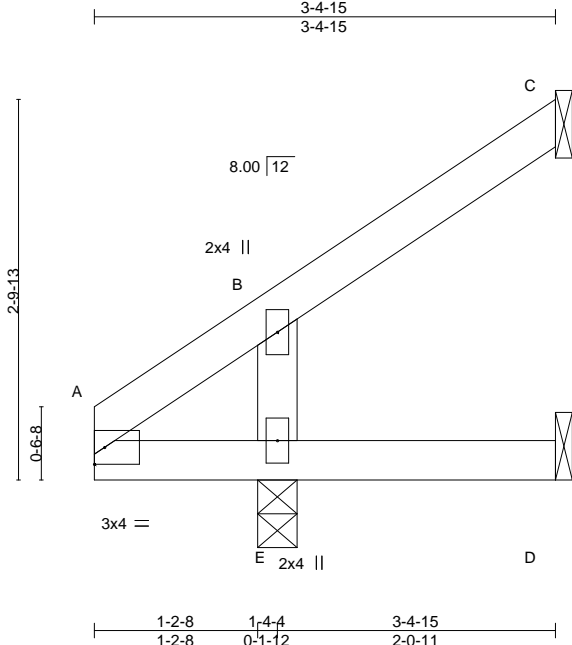

Scale = 1:17.0

LOADING (psf)	SPACING-	CSI.	DEFL.	in (loc)	l/defl	L/d	PLATES	GRIP
TCLL 25.0 (Roof Snow=25.0)	2-0-0 Plate Grip DOL 1.15 Lumber DOL 1.15	TC 0.16 BC 0.12 WB 0.05 Matrix-MP	Vert(LL) 0.00 Vert(CT) 0.00 Horz(CT) -0.01	D-E D-E C	>999 >999 n/a	240 180 n/a	MT20	244/190
TCDL 10.0	Rep Stress Incr YES Code IRC2018/TPI2014						Weight: 13 lb	FT = 20%
BCLL 0.0								
BCDL 10.0								

LUMBER-	BRACING-
TOP CHORD 2x4 SP No.2	TOP CHORD Structural wood sheathing directly applied or 3-4-15 oc purlins.
BOT CHORD 2x4 SP No.2	BOT CHORD Rigid ceiling directly applied or 10-0-0 oc bracing.
WEBS 2x4 SP No.3	

REACTIONS. (size) C=Mechanical, D=Mechanical, E=0-3-8
 Max Horz E=87(LC 12)
 Max Uplift C=-54(LC 12), D=-12(LC 12)
 Max Grav C=73(LC 18), D=23(LC 5), E=362(LC 18)

FORCES. (lb) - Max. Comp./Max. Ten. - All forces 250 (lb) or less except when shown.
 WEBS B-E=-266/113

- NOTES-**
- 1) Wind: ASCE 7-16; Vult=115mph (3-second gust) Vasd=91mph; TCDL=6.0psf; BCDL=6.0psf; h=20ft; Cat. II; Exp C; Enclosed; MWFRS (envelope) gable end zone and C-C Exterior(2E) zone; cantilever left and right exposed ; end vertical left and right exposed;C-C for members and forces & MWFRS for reactions shown; Lumber DOL=1.33 plate grip DOL=1.33
 - 2) TCLL: ASCE 7-16; Pf=25.0 psf (Lum DOL=1.15 Plate DOL=1.15); Is=1.0; Rough Cat C; Fully Exp.; Ce=0.9; Cs=1.00; Ct=1.10
 - 3) Unbalanced snow loads have been considered for this design.
 - 4) This truss has been designed for a 10.0 psf bottom chord live load nonconcurrent with any other live loads.
 - 5) Refer to girder(s) for truss to truss connections.
 - 6) Provide mechanical connection (by others) of truss to bearing plate capable of withstanding 100 lb uplift at joint(s) C, D.
 - 7) This truss is designed in accordance with the 2018 International Residential Code sections R502.11.1 and R802.10.2 and referenced standard ANSI/TPI 1.



November 27, 2024

Job 242042	Truss 51	Truss Type Common	Qty 4	Ply 1	GENE BOSLEY RES. / ROOF
---------------	-------------	----------------------	----------	----------	-------------------------

RELEASE FOR CONSTRUCTION
AS NOTED FOR PLAN REVIEW
DEVELOPMENT SERVICES
LEE'S SUMMIT, MISSOURI
 12/02/2024

Heartland Truss, Inc, Plattsburg, MO - 64477, 8.730 s Oct 31 2024 MiTek Industries, Inc. Wed Nov 27 17:39:15 2024 Page 1
 ID:mrcY1X_2FQFIXm9hhpx4TmyPVI_-fQm?Ooo4QwG6_JRagWNNWHjDL24E4/vt12831D4/F2TS

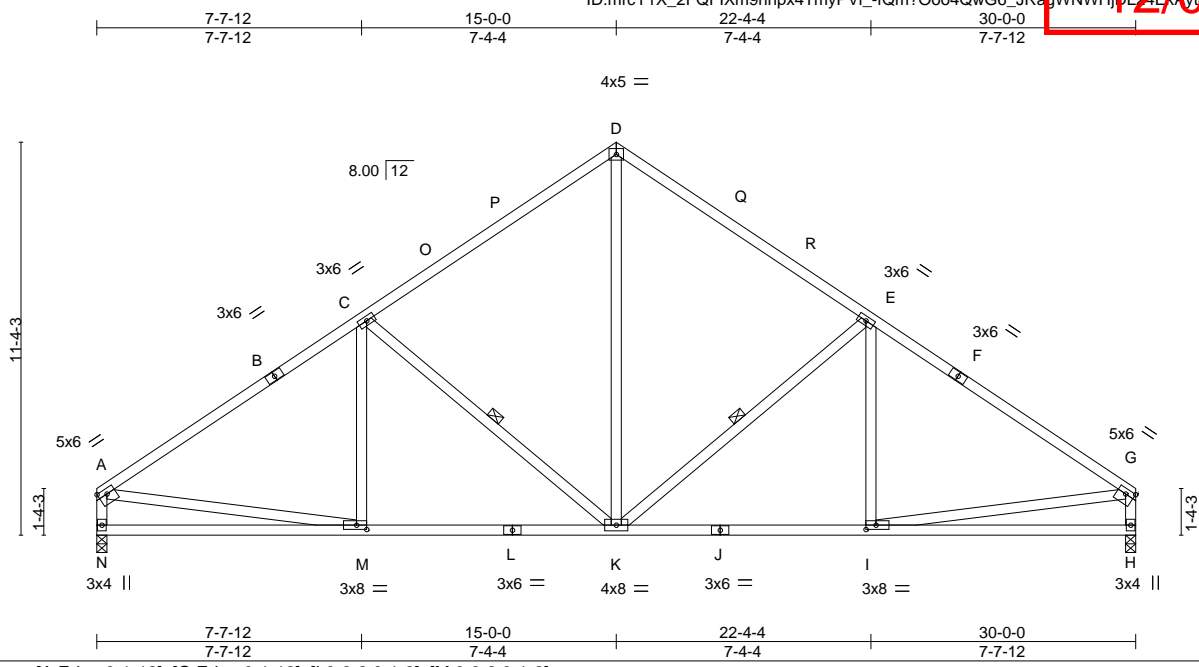


Plate Offsets (X, Y)-- [A:Edge,0-1-12], [G:Edge,0-1-12], [I:0-3-8,0-1-8], [M:0-3-8,0-1-8]

LOADING (psf)	SPACING-	CSI.	DEFL.	PLATES	GRIP
TCLL 25.0 (Roof Snow=25.0)	2-0-0 Plate Grip DOL 1.15 Lumber DOL 1.15	TC 0.86 BC 0.58 WB 0.49	in (loc) l/defl L/d Vert(LL) -0.08 M-N >999 240 Vert(CT) -0.17 M-N >999 180 Horz(CT) 0.04 H n/a n/a	MT20	244/190
TCDL 10.0	Rep Stress Incr YES	Matrix-MS			
BCLL 0.0	Code IRC2018/TPI2014				
BCDL 10.0				Weight: 184 lb	FT = 20%

LUMBER-	BRACING-
TOP CHORD 2x4 SP 1650F 1.5E *Except* A-B,F-G: 2x4 SP No.2	TOP CHORD Structural wood sheathing directly applied, except end verticals.
BOT CHORD 2x4 SP No.2	BOT CHORD Rigid ceiling directly applied or 10-0-0 oc bracing.
WEBS 2x4 SP No.3	WEBS 1 Row at midpt E-K, C-K

REACTIONS. (size) N=0-3-8, H=0-3-8
 Max Horz N=288(LC 9)
 Max Uplift N=-126(LC 12), H=-126(LC 13)
 Max Grav N=1345(LC 18), H=1345(LC 19)

FORCES. (lb) - Max. Comp./Max. Ten. - All forces 250 (lb) or less except when shown.
 TOP CHORD A-C=-1719/190, C-D=-1273/255, D-E=-1273/255, E-G=-1719/194, A-N=-1274/165, G-H=-1274/165
 BOT CHORD M-N=-278/396, K-M=-183/1333, I-K=-53/1333
 WEBS D-K=-110/781, E-K=-586/246, C-K=-586/246, A-M=-46/1174, G-I=-29/1174

- NOTES-**
- 1) Wind: ASCE 7-16; Vult=115mph (3-second gust) Vasd=91mph; TCDL=6.0psf; BCDL=6.0psf; h=20ft; Cat. II; Exp C; Enclosed; MWFRS (envelope) gable end zone and C-C Exterior(2E) 0-1-12 to 3-1-12, Interior(1) 3-1-12 to 12-0-0, Exterior(2R) 12-0-0 to 18-0-0, Interior(1) 18-0-0 to 26-10-4, Exterior(2E) 26-10-4 to 29-10-4 zone; cantilever left and right exposed; end vertical left and right exposed; C-C for members and forces & MWFRS for reactions shown; Lumber DOL=1.33 plate grip DOL=1.33
 - 2) TCLL: ASCE 7-16; Pf=25.0 psf (Lum DOL=1.15 Plate DOL=1.15); ls=1.0; Rough Cat C; Fully Exp.; Ce=0.9; Cs=1.00; Ct=1.10
 - 3) Unbalanced snow loads have been considered for this design.
 - 4) This truss has been designed for a 10.0 psf bottom chord live load nonconcurrent with any other live loads.
 - 5) Provide mechanical connection (by others) of truss to bearing plate capable of withstanding 100 lb uplift at joint(s) except (jt=lb) N=126, H=126.
 - 6) This truss is designed in accordance with the 2018 International Residential Code sections R502.11.1 and R802.10.2 and referenced standard ANSI/TPI 1.



November 27, 2024

Job 242042	Truss 52	Truss Type Hip	Qty 1	Ply 1	GENE BOSLEY RES. / ROOF
---------------	-------------	-------------------	----------	----------	-------------------------

AS NOTED FOR PLAN REVIEW
DEVELOPMENT SERVICES
LEE'S SUMMIT, MISSOURI

Heartland Truss, Inc, Plattsburg, MO - 64477, 8.730 s Oct 31 2024 MiTek Industries, Inc. Wed No 27-17-89-15-2024 Page 1
 ID:mrcY1X_2FQFIXm9hhpx4TmyPVL_fQm?Ooo4QwG6_JRag WNWHD.8473AR.12831047F2TS
 1-4-4 7-9-6 14-2-8 18-2-8 24-6-12 31-2-8
 1-4-4 6-5-2 6-5-2 4-0-0 6-4-4 6-7-12
 12/02/2024

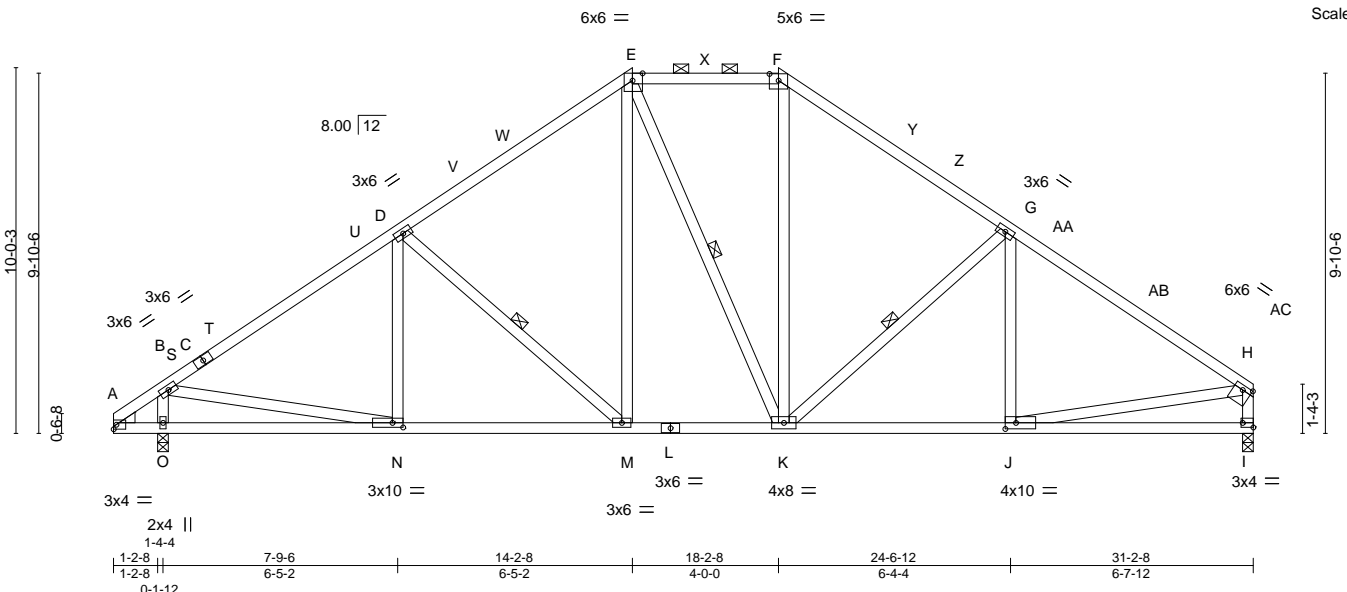


Plate Offsets (X, Y)-- [E:0-3-5,Edge], [F:0-3-0,0-2-3], [H:0-3-0,0-1-8], [I:Edge,0-1-8], [J:0-3-8,0-2-0], [N:0-3-8,0-1-8]

LOADING (psf)	SPACING-	CSI.	DEFL.	PLATES	GRIP
TCLL 25.0	2-0-0	TC 0.85	in (loc) l/defl L/d	MT20	244/190
(Roof Snow=25.0)	Plate Grip DOL 1.15	BC 0.56	Vert(LL) -0.10 M-N >999 240		
TCDL 10.0	Lumber DOL 1.15	WB 0.71	Vert(CT) -0.17 M-N >999 180		
BCLL 0.0	Rep Stress Incr YES	Matrix-MS	Horz(CT) 0.05 l n/a n/a		
BCDL 10.0	Code IRC2018/TPI2014			Weight: 205 lb	FT = 20%

LUMBER-
 TOP CHORD 2x4 SP 1650F 1.5E *Except*
 E-F,A-C: 2x4 SP No.2
 BOT CHORD 2x4 SP No.2
 WEBS 2x4 SP No.3
 WEDGE
 Left: 2x4 SP No.3

BRACING-
 TOP CHORD Structural wood sheathing directly applied or 3-2-8 oc purlins, except end verticals, and 2-0-0 oc purlins (4-5-13 max.): E-F.
 BOT CHORD Rigid ceiling directly applied or 10-0-0 oc bracing.
 WEBS 1 Row at midpt D-M, E-K, G-K

REACTIONS. (size) O=0-3-8, I=0-3-8
 Max Horz O=252(LC 11)
 Max Uplift O=-154(LC 12), I=-134(LC 13)
 Max Grav O=2080(LC 32), I=1952(LC 32)

FORCES. (lb) - Max. Comp./Max. Ten. - All forces 250 (lb) or less except when shown.
 TOP CHORD B-D=-2474/191, D-E=-1961/227, E-F=-1420/243, F-G=-1964/231, G-H=-2479/184, H-I=-1886/168
 BOT CHORD A-O=-37/287, N-O=-247/433, M-N=-185/1903, K-M=-30/1420, J-K=-75/1915
 WEBS B-O=-2013/261, B-N=-55/1640, D-M=-627/203, E-M=-70/513, F-K=-60/531, G-K=-648/202, H-J=-28/1706

- NOTES-**
- 1) Wind: ASCE 7-16; Vult=115mph (3-second gust) Vasd=91mph; TCDL=6.0psf; BCDL=6.0psf; h=20ft; Cat. II; Exp C; Enclosed; MWFRS (envelope) gable end zone and C-C Exterior(2E) 0-0-0 to 3-1-7, Interior(1) 3-1-7 to 9-9-9, Exterior(2R) 9-9-9 to 22-7-7, Interior(1) 22-7-7 to 27-11-5, Exterior(2E) 27-11-5 to 31-0-12 zone; cantilever left and right exposed ; end vertical left and right exposed;C-C for members and forces & MWFRS for reactions shown; Lumber DOL=1.33 plate grip DOL=1.33
 - 2) TCLL: ASCE 7-16; Pf=25.0 psf (Lum DOL=1.15 Plate DOL=1.15); Is=1.0; Rough Cat C; Fully Exp.; Ce=0.9; Cs=1.00; Ct=1.10
 - 3) Unbalanced snow loads have been considered for this design.
 - 4) Provide adequate drainage to prevent water ponding.
 - 5) This truss has been designed for a 10.0 psf bottom chord live load nonconcurrent with any other live loads.
 - 6) Provide mechanical connection (by others) of truss to bearing plate capable of withstanding 100 lb uplift at joint(s) except (jt=lb) O=154, I=134.
 - 7) This truss is designed in accordance with the 2018 International Residential Code sections R502.11.1 and R802.10.2 and referenced standard ANSI/TPI 1.
 - 8) Graphical purlin representation does not depict the size or the orientation of the purlin along the top and/or bottom chord.



November 27, 2024

Job	Truss	Truss Type	Qty	Ply	GENE BOSLEY RES. / ROOF
242042	53	Hip	1	1	

AS NOTED FOR PLAN REVIEW
DEVELOPMENT SERVICES
LEE'S SUMMIT, MISSOURI

Heartland Truss, Inc, Plattsburg, MO - 64477,

8.730 s Oct 31 2024 MiTek Industries, Inc. Wed Nov 27 07:36:16 2024 Page 1

ID:mrcY1X_2FQFIXm9hhpx4TmyPVL_-8dJNb8oiBEOzcT0mEEuqlxI W2LamLiEFopWYF2TR

12/02/2024



Scale = 1:58.3

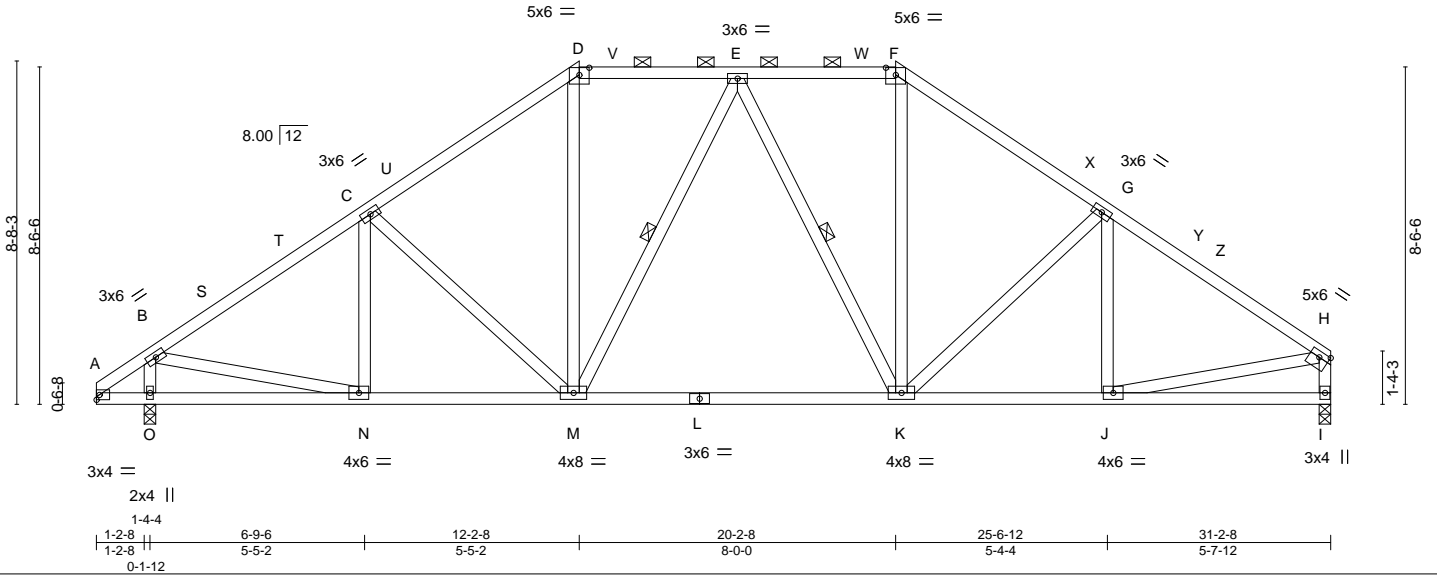


Plate Offsets (X, Y)-- [D:0-3-0,0-2-3], [F:0-3-0,0-2-3], [H:Edge,0-1-12]

LOADING (psf)	SPACING-	CSI.	DEFL.	PLATES	GRIP
TCLL 25.0 (Roof Snow=25.0)	2-0-0 Plate Grip DOL 1.15 Lumber DOL 1.15 Rep Stress Incr YES Code IRC2018/TPI2014	TC 0.84 BC 0.60 WB 0.64 Matrix-MS	in (loc) l/defl L/d Vert(LL) -0.12 K-M >999 240 Vert(CT) -0.26 K-M >999 180 Horz(CT) 0.05 I n/a n/a	MT20	244/190
TCDL 10.0				Weight: 202 lb	FT = 20%
BCLL 0.0					
BCDL 10.0					

LUMBER-	BRACING-
TOP CHORD 2x4 SP No.2	TOP CHORD Structural wood sheathing directly applied or 2-4-4 oc purlins, except end verticals, and 2-0-0 oc purlins (4-10-0 max.): D-F.
BOT CHORD 2x4 SP No.2	BOT CHORD Rigid ceiling directly applied or 10-0-0 oc bracing.
WEBS 2x4 SP No.3	WEBS 1 Row at midpt E-M, E-K

REACTIONS. (size) O=0-3-8, I=0-3-8
Max Horz O=219(LC 11)
Max Uplift O=-161(LC 12), I=-141(LC 13)
Max Grav O=2015(LC 32), I=1808(LC 32)

FORCES. (lb) - Max. Comp./Max. Ten. - All forces 250 (lb) or less except when shown.
TOP CHORD B-C=-2192/200, C-D=-1828/247, D-E=-1345/251, E-F=-1348/254, F-G=-1834/252, G-H=-2209/198, H-I=-1747/171
BOT CHORD N-O=-211/305, M-N=-184/1674, K-M=-80/1375, J-K=-97/1697
WEBS B-O=-1919/247, B-N=-97/1537, C-M=-443/171, D-M=-47/501, E-M=-340/163, E-K=-337/162, F-K=-50/518, G-K=-470/170, H-J=-69/1548

- NOTES-**
- 1) Wind: ASCE 7-16; Vult=115mph (3-second gust) Vasd=91mph; TCDL=6.0psf; BCDL=6.0psf; h=20ft; Cat. II; Exp C; Enclosed; MWFRS (envelope) gable end zone and C-C Exterior(2E) 0-0-0 to 3-1-7, Interior(1) 3-1-7 to 7-9-9, Exterior(2R) 7-9-9 to 24-7-7, Interior(1) 24-7-7 to 27-11-5, Exterior(2E) 27-11-5 to 31-0-12 zone; cantilever left and right exposed ; end vertical left and right exposed; C-C for members and forces & MWFRS for reactions shown; Lumber DOL=1.33 plate grip DOL=1.33
 - 2) TCLL: ASCE 7-16; Pf=25.0 psf (Lum DOL=1.15 Plate DOL=1.15); Is=1.0; Rough Cat C; Fully Exp.; Ce=0.9; Cs=1.00; Ct=1.10
 - 3) Unbalanced snow loads have been considered for this design.
 - 4) Provide adequate drainage to prevent water ponding.
 - 5) This truss has been designed for a 10.0 psf bottom chord live load nonconcurrent with any other live loads.
 - 6) Provide mechanical connection (by others) of truss to bearing plate capable of withstanding 100 lb uplift at joint(s) except (jt=lb) O=161, I=141.
 - 7) This truss is designed in accordance with the 2018 International Residential Code sections R502.11.1 and R802.10.2 and referenced standard ANSI/TPI 1.
 - 8) Graphical purlin representation does not depict the size or the orientation of the purlin along the top and/or bottom chord.



November 27, 2024

WARNING - Verify design parameters and READ NOTES ON THIS AND INCLUDED MITEK REFERENCE PAGE MII-7473 rev. 1/2/2023 BEFORE USE.
Design valid for use only with MiTek® connectors. This design is based only upon parameters shown, and is for an individual building component, not a truss system. Before use, the building designer must verify the applicability of design parameters and properly incorporate this design into the overall building design. Bracing indicated is to prevent buckling of individual truss web and/or chord members only. Additional temporary and permanent bracing is always required for stability and to prevent collapse with possible personal injury and property damage. For general guidance regarding the fabrication, storage, delivery, erection and bracing of trusses and truss systems, see **ANSI/TPI1 Quality Criteria, and DSB-22** available from Truss Plate Institute (www.tpinst.org) and **BCSI Building Component Safety Information** available from the Structural Building Component Association (www.sbcsccomponents.com)

MiTek®
16023 Swingley Ridge Rd.
Chesterfield, MO 63017
314.434.1200 / MiTek-US.com

Job 242042	Truss 54	Truss Type Roof Special	Qty 1	Ply 1	GENE BOSLEY RES. / ROOF
---------------	-------------	----------------------------	----------	----------	-------------------------


AS NOTED FOR PLAN REVIEW
DEVELOPMENT SERVICES
LEE'S SUMMIT, MISSOURI

Heartland Truss, Inc. Plattsburg, MO - 64477,

8.730 s Oct 31 2024 MiTek Industries, Inc. Wed No 27-7-86-17-2024 Page 1

ID: mrcY1X_2FQFXm9hhpx4TmyPVI_-cptUpKyYWqEdzoxP_M8iMvserntNSyBHVW1210

12/02/2024

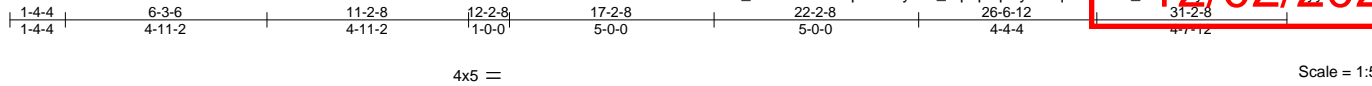

Scale = 1:56.3

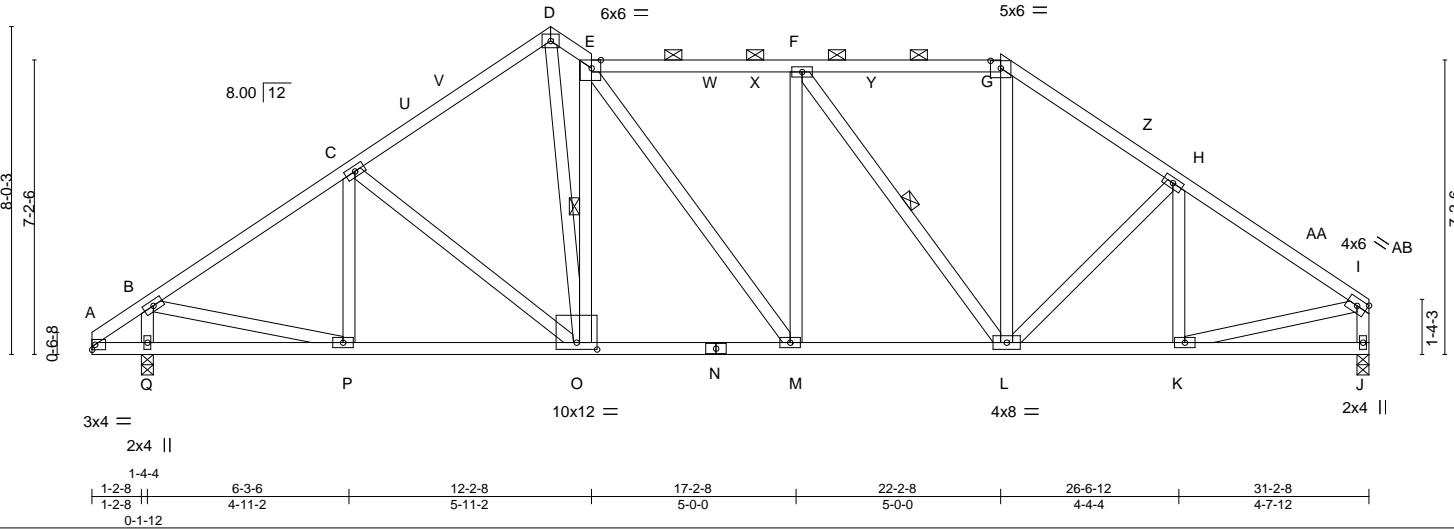


Plate Offsets (X, Y)-- [E:0-2-11,Edge], [G:0-3-0,0-2-3], [O:0-6-0,0-2-0]

LOADING (psf)	SPACING-	CSI.	DEFL.	in (loc)	l/defl	L/d	PLATES	GRIP
TCLL 25.0 (Roof Snow=25.0)	Plate Grip DOL 1.15 Lumber DOL 1.15	TC 0.80 BC 0.48	Vert(LL) -0.10 Vert(CT) -0.18 Horz(CT) 0.05	M	>999	240	MT20	244/190
TCDL 10.0	Rep Stress Incr YES	WB 0.72		M-O	>999	180		
BCLL 0.0	Code IRC2018/TPI2014	Matrix-MS		J	n/a	n/a		
BCDL 10.0							Weight: 212 lb	FT = 20%

LUMBER-	BRACING-
TOP CHORD 2x4 SP No.2	TOP CHORD Structural wood sheathing directly applied or 3-11-13 oc purlins, except end verticals, and 2-0-0 oc purlins (3-6-0 max.): E-G.
BOT CHORD 2x4 SP No.2	BOT CHORD Rigid ceiling directly applied or 10-0-0 oc bracing.
WEBS 2x4 SP No.3	WEBS 1 Row at midpt E-O, F-L

REACTIONS. (size) Q=0-3-8, J=0-3-8
 Max Horz Q=204(LC 11)
 Max Uplift Q=-114(LC 12), J=-179(LC 13)
 Max Grav Q=1525(LC 35), J=1538(LC 34)

FORCES. (lb) - Max. Comp./Max. Ten. - All forces 250 (lb) or less except when shown.
 TOP CHORD B-C=-1707/182, C-D=-1573/245, D-E=-1731/285, E-F=-1746/288, F-G=-1360/275, G-H=-1669/286, H-I=-1802/234, I-J=-1488/202
 BOT CHORD O-P=-141/1343, M-O=-111/1483, L-M=-107/1743, K-L=-145/1383
 WEBS B-Q=-1426/209, B-P=-75/1287, C-O=-288/155, D-O=-251/1731, E-O=-1615/304, E-M=-96/445, F-M=-261/142, F-L=-646/127, G-L=-42/557, H-L=-345/133, I-K=-117/1298

NOTES-

- 1) Wind: ASCE 7-16; Vult=115mph (3-second gust) Vasd=91mph; TCDL=6.0psf; BCDL=6.0psf; h=20ft; Cat. II; Exp C; Enclosed; MWFRS (envelope) gable end zone and C-C Exterior(2E) 0-0-0 to 3-1-7, Interior(1) 3-1-7 to 8-1-1, Exterior(2R) 8-1-1 to 11-2-8, Exterior(2E) 11-2-8 to 12-2-8, Interior(1) 12-2-8 to 19-1-1, Exterior(2R) 19-1-1 to 25-3-15, Interior(1) 25-3-15 to 27-11-5, Exterior(2E) 27-11-5 to 31-0-12 zone; cantilever left and right exposed ; end vertical left and right exposed; C-C for members and forces & MWFRS for reactions shown; Lumber DOL=1.33 plate grip DOL=1.33
- 2) TCLL: ASCE 7-16; Pf=25.0 psf (Lum DOL=1.15 Plate DOL=1.15); Is=1.0; Rough Cat C; Fully Exp.; Ce=0.9; Cs=1.00; Ct=1.10
- 3) Unbalanced snow loads have been considered for this design.
- 4) Provide adequate drainage to prevent water ponding.
- 5) All plates are 3x6 MT20 unless otherwise indicated.
- 6) This truss has been designed for a 10.0 psf bottom chord live load nonconcurrent with any other live loads.
- 7) Provide mechanical connection (by others) of truss to bearing plate capable of withstanding 100 lb uplift at joint(s) except (jt=lb) Q=114, J=179.
- 8) This truss is designed in accordance with the 2018 International Residential Code sections R502.11.1 and R802.10.2 and referenced standard ANSI/TPI 1.
- 9) Graphical purlin representation does not depict the size or the orientation of the purlin along the top and/or bottom chord.



November 27, 2024

Job	Truss	Truss Type	Qty	Ply	GENE BOSLEY RES. / ROOF
242042	55	Roof Special	1	1	

RELEASE FOR CONSTRUCTION

AS NOTED FOR PLAN REVIEW

DEVELOPMENT SERVICES

LEE'S SUMMIT, MISSOURI

12/02/2024

Heartland Truss, Inc, Plattsburg, MO - 64477, 8.730 s Oct 31 2024 MiTek Industries, Inc. Wed Nov 27 17:36:18 2024 Page 1
 ID:mrcY1X_2FQFIXm9hhpx4TmyPVL_4?R70qqzjrehmAbLexDvMtGf_NbVXh6hngFVh27P 31-2-8 1-0-0

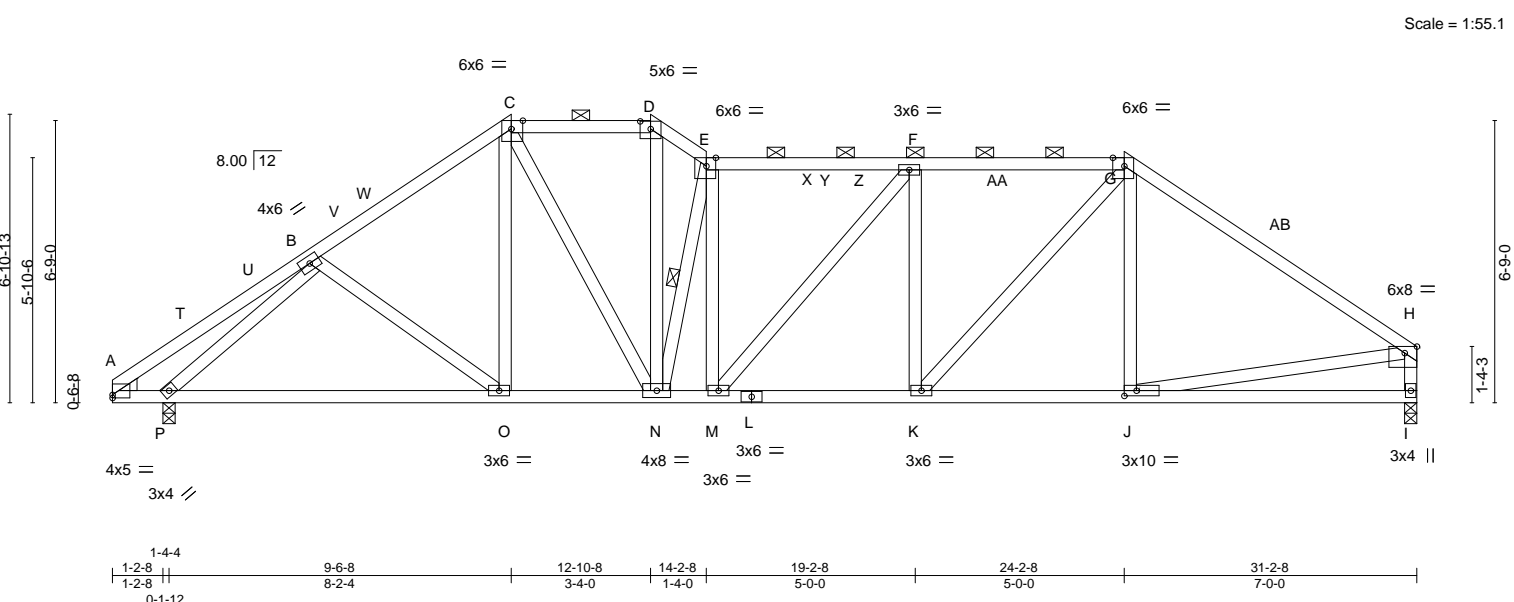


Plate Offsets (X, Y)-- [A:0-0-0,0-0-14], [C:0-3-5,Edge], [D:0-3-0,0-2-3], [E:0-2-11,Edge], [G:0-3-5,Edge], [H:0-3-8,Edge], [J:0-3-8,0-1-8]

LOADING (psf)	SPACING-	CSI.	DEFL.	PLATES	GRIP
TCLL 25.0 (Roof Snow=25.0)	2-0-0 Plate Grip DOL 1.15 Lumber DOL 1.15	TC 0.79 BC 0.68 WB 0.94	in (loc) l/def L/d Vert(LL) -0.14 K-M >999 240 Vert(CT) -0.22 K-M >999 180 Horz(CT) 0.06 l n/a n/a	MT20	244/190
TCDL 10.0	Rep Stress Incr YES	Matrix-MS			
BCLL 0.0	Code IRC2018/TPI2014				
BCDL 10.0				Weight: 208 lb	FT = 20%

LUMBER-	BRACING-
TOP CHORD 2x4 SP No.2 *Except* G-H: 2x4 SP 2400F 2.0E	TOP CHORD Structural wood sheathing directly applied or 2-2-0 oc purlins, except end verticals, and 2-0-0 oc purlins (3-0-3 max.): C-D, E-G.
BOT CHORD 2x4 SP No.2	BOT CHORD Rigid ceiling directly applied or 10-0-0 oc bracing.
WEBS 2x4 SP No.3 *Except* H-I: 2x4 SP No.2	WEBS 1 Row at midpt E-N
WEDGE Left: 2x4 SP No.3	

REACTIONS. (size) I=0-3-8, P=0-3-8
 Max Horz P=174(LC 11)
 Max Uplift I=-174(LC 13), P=-99(LC 12)
 Max Grav I=1533(LC 36), P=1802(LC 36)

FORCES. (lb) - Max. Comp./Max. Ten. - All forces 250 (lb) or less except when shown.
 TOP CHORD A-B=-269/108, B-C=-1838/236, C-D=-1865/266, D-E=-2274/312, E-F=-2239/274,
 F-G=-2312/292, G-H=-1974/228, H-I=-1465/210
 BOT CHORD O-P=-188/1472, N-O=-134/1502, M-N=-162/2232, K-M=-159/2308, J-K=-100/1600,
 I-J=-83/336
 WEBS C-O=-10/253, C-N=-126/769, D-N=-125/1002, E-N=-1665/225, F-K=-692/170,
 G-K=-153/1065, B-P=-1963/294, H-J=-105/1486

- NOTES-**
- 1) Wind: ASCE 7-16; Vult=115mph (3-second gust) Vasd=91mph; TCDL=6.0psf; BCDL=6.0psf; h=20ft; Cat. II; Exp C; Enclosed; MWFRS (envelope) gable end zone and C-C Exterior(2E) 0-0-0 to 3-1-7, Interior(1) 3-1-7 to 6-5-1, Exterior(2R) 6-5-1 to 12-10-8, Exterior(2E) 12-10-8 to 14-2-8, Interior(1) 14-2-8 to 21-1-1, Exterior(2R) 21-1-1 to 27-3-15, Interior(1) 27-3-15 to 27-11-5, Exterior(2E) 27-11-5 to 31-0-12 zone; cantilever left and right exposed ; end vertical left and right exposed;C-C for members and forces & MWFRS for reactions shown; Lumber DOL=1.33 plate grip DOL=1.33
 - 2) TCLL: ASCE 7-16; Pf=25.0 psf (Lum DOL=1.15 Plate DOL=1.15); Is=1.0; Rough Cat C; Fully Exp.; Ce=0.9; Cs=1.00; Ct=1.10
 - 3) Unbalanced snow loads have been considered for this design.
 - 4) Provide adequate drainage to prevent water ponding.
 - 5) This truss has been designed for a 10.0 psf bottom chord live load nonconcurrent with any other live loads.
 - 6) Provide mechanical connection (by others) of truss to bearing plate capable of withstanding 100 lb uplift at joint(s) P except (jt=lb) I=174.
 - 7) This truss is designed in accordance with the 2018 International Residential Code sections R502.11.1 and R802.10.2 and referenced standard ANSI/TPI 1.
 - 8) Graphical purlin representation does not depict the size or the orientation of the purlin along the top and/or bottom chord.



November 27, 2024

WARNING - Verify design parameters and READ NOTES ON THIS AND INCLUDED MITEK REFERENCE PAGE MII-7473 rev. 1/2/2023 BEFORE USE.

Design valid for use only with MiTek® connectors. This design is based only upon parameters shown, and is for an individual building component, not a truss system. Before use, the building designer must verify the applicability of design parameters and properly incorporate this design into the overall building design. Bracing indicated is to prevent buckling of individual truss web and/or chord members only. Additional temporary and permanent bracing is always required for stability and to prevent collapse with possible personal injury and property damage. For general guidance regarding the fabrication, storage, delivery, erection and bracing of trusses and truss systems, see **ANSI/TPI1 Quality Criteria, and DSB-22** available from Truss Plate Institute (www.tpinst.org) and **BCSI Building Component Safety Information** available from the Structural Building Component Association (www.sbcsccomponents.com)

MiTek®
 16023 Swingley Ridge Rd.
 Chesterfield, MO 63017
 314.434.1200 / MiTek-US.com

Job	Truss	Truss Type	Qty	Ply	GENE BOSLEY RES. / ROOF
242042	56	Roof Special Girder	1	2	

RELEASE FOR CONSTRUCTION

AS NOTED FOR PLAN REVIEW

DEVELOPMENT SERVICES

LEE'S SUMMIT, MISSOURI

12/02/2024

Heartland Truss, Inc, Plattsburg, MO - 64477, 8.730 s Oct 31 2024 MiTek Industries, Inc. Wed Nov 27 07:39:19 2024 Page 1

ID:mrcY1X_2FQFIXm9hpx4TmyPVL_-YC?WDArbU9nXTwLVLVSSRZNSUhpP6Rcwm1fMwYF2TC

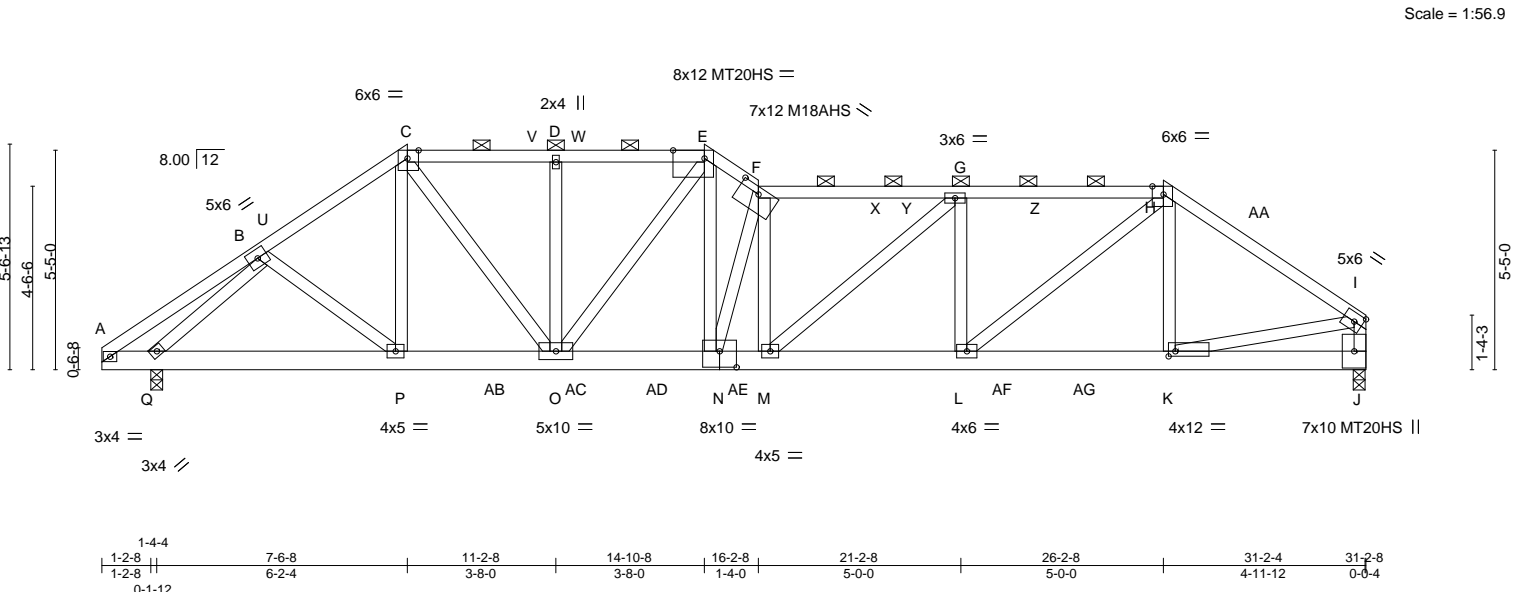


Plate Offsets (X, Y)-- [C:0-3-5,Edge], [E:0-9-5,Edge], [F:0-6-0,0-2-0], [H:0-3-5,Edge], [K:0-2-0,0-1-8], [N:0-5-0,0-4-12]

LOADING (psf)	SPACING-	CSL	DEFL.	PLATES	GRIP
TCLL 25.0	Plate Grip DOL 1.15	TC 0.63	Vert(LL) -0.28 in (loc) M >999 L/d 240	MT20 244/190	
(Roof Snow=25.0)	Lumber DOL 1.15	BC 0.73	Vert(CT) -0.39 L-M >927 180	MT20HS 187/143	
TCDL 10.0	Rep Stress Incr NO	WB 0.96	Horz(CT) 0.07 J n/a n/a	M18AHS 186/179	
BCLL 0.0	Code IRC2018/TPI2014	Matrix-MS		Weight: 446 lb	FT = 20%
BCDL 10.0					

LUMBER-	BRACING-
TOP CHORD 2x4 SP No.2 *Except* F-H: 2x4 SP 1650F 1.5E	TOP CHORD Structural wood sheathing directly applied or 3-7-11 oc purlins, except end verticals, and 2-0-0 oc purlins (4-4-12 max.): C-E, F-H.
BOT CHORD 2x6 SP No.1	BOT CHORD Rigid ceiling directly applied or 10-0-0 oc bracing.
WEBS 2x4 SP No.3 *Except* C-P,E-N: 2x4 SP No.2	

REACTIONS. (size) J=0-3-8, Q=0-3-8
 Max Horz Q=139(LC 63)
 Max Uplift J=-943(LC 13), Q=-815(LC 12)
 Max Grav J=4243(LC 36), Q=4365(LC 36)

FORCES. (lb) - Max. Comp./Max. Ten. - All forces 250 (lb) or less except when shown.
 TOP CHORD A-B=-731/129, B-C=-6159/1329, C-D=-7026/1492, D-E=-7026/1492, E-F=-9675/2023, F-G=-8932/1836, G-H=-8043/1668, H-I=-5717/1283, I-J=-4182/963
 BOT CHORD A-Q=-64/551, P-Q=-949/4262, O-P=-1091/5147, N-O=-1546/7657, M-N=-1790/8983, L-M=-1609/8040, K-L=-1009/4751, J-K=-90/318
 WEBS B-P=-276/1131, C-P=-242/730, C-O=-602/3208, D-O=-643/137, E-O=-1086/285, E-N=-1277/5993, F-N=-3980/802, F-M=-1587/388, G-M=-223/1329, G-L=-1674/341, H-L=-808/4295, H-K=-319/261, B-Q=-5232/1159, I-K=-1004/4650

- NOTES-**
- 2-ply truss to be connected together with 10d (0.131"x3") nails as follows:
 Top chords connected as follows: 2x4 - 1 row at 0-7-0 oc.
 Bottom chords connected as follows: 2x6 - 2 rows staggered at 0-9-0 oc.
 Webs connected as follows: 2x4 - 1 row at 0-9-0 oc.
 - All loads are considered equally applied to all plies, except if noted as front (F) or back (B) face in the LOAD CASE(S) section. Ply to ply connections have been provided to distribute only loads noted as (F) or (B), unless otherwise indicated.
 - Wind: ASCE 7-16; Vult=115mph (3-second gust) Vasd=91mph; TCDL=6.0psf; BCDL=6.0psf; h=20ft; Cat. II; Exp C; Enclosed; MWFRS (envelope) gable end zone and C-C Exterior(2E) 0-0-0 to 3-1-7, Interior(1) 3-1-7 to 4-5-1, Exterior(2R) 4-5-1 to 10-7-15, Interior(1) 10-7-15 to 11-9-1, Exterior(2R) 11-9-1 to 14-10-8, Exterior(2E) 14-10-8 to 16-2-8, Interior(1) 16-2-8 to 23-1-1, Exterior(2R) 23-1-1 to 27-11-5, Exterior(2E) 27-11-5 to 31-0-12 zone; cantilever left and right exposed; end vertical left and right exposed; C-C for members and forces & MWFRS for reactions shown; Lumber DOL=1.33 plate grip DOL=1.33
 - TCLL: ASCE 7-16; Pf=25.0 psf (Lum DOL=1.15 Plate DOL=1.15); Is=1.0; Rough Cat C; Fully Exp.; Ce=0.9; Cs=1.00; Ct=1.10
 - Unbalanced snow loads have been considered for this design.
 - Provide adequate drainage to prevent water ponding.
 - All plates are MT20 plates unless otherwise indicated.
 - This truss has been designed for a 10.0 psf bottom chord live load nonconcurrent with any other live loads.
 - Provide mechanical connection (by others) of truss to bearing plate capable of withstanding 100 lb uplift at joint(s) except (jt=lb) J=943, Q=815.
 - This truss is designed in accordance with the 2018 International Residential Code sections R502.11.1 and R802.10.2 and conform to standard ANSI/TPI 1.



November 27, 2024

WARNING - Verify design parameters and READ NOTES ON THIS AND INCLUDED MITEK REFERENCE PAGE MII-7473 rev. 1/2/2023 BEFORE USE.

Design valid for use only with MiTek® connectors. This design is based only upon parameters shown, and is for an individual building component, not a truss system. Before use, the building designer must verify the applicability of design parameters and properly incorporate this design into the overall building design. Bracing indicated is to prevent buckling of individual truss web and/or chord members only. Additional temporary and permanent bracing is always required for stability and to prevent collapse with possible personal injury and property damage. For general guidance regarding the fabrication, storage, delivery, erection and bracing of trusses and truss systems, see **ANSI/TPI1 Quality Criteria, and DSB-22** available from Truss Plate Institute (www.tpinst.org) and **BCSI Building Component Safety Information** available from the Structural Building Component Association (www.sbcsccomponents.com)

MiTek®
 16023 Swingley Ridge Rd.
 Chesterfield, MO 63017
 314.434.1200 / MiTek-US.com

Job	Truss	Truss Type	Qty	Ply	Job Reference (optional)
242042	56	Roof Special Girder	1	2	

AS NOTED FOR PLAN REVIEW
DEVELOPMENT SERVICES
LEE'S SUMMIT, MISSOURI

Heartland Truss, Inc, Plattsburg, MO - 64477,

8.730 s Oct 31 2024 MiTek Industries, Inc. Wed Nov 27 07:36:49 2024 Page 2

ID: mrcY1X_2FQFIXm9hhpx4TmyPVL_YC?WDArbU9nXTwLVlMSSRZNSUhaPfdRgw11FMvF2TJ

12/02/2024

NOTES-

- 11) Graphical purlin representation does not depict the size or the orientation of the purlin along the top and/or bottom chord.
- 12) Hanger(s) or other connection device(s) shall be provided sufficient to support concentrated load(s) 1145 lb down and 353 lb up at 7-6-8, 389 lb down and 96 lb up at 9-7-4, 389 lb down and 96 lb up at 11-7-4, 389 lb down and 96 lb up at 13-7-4, 1177 lb down and 341 lb up at 14-9-12, 470 lb down and 95 lb up at 21-3-4, 285 lb down and 99 lb up at 22-1-12, and 285 lb down and 99 lb up at 24-1-12, and 783 lb down and 350 lb up at 26-1-12 on bottom chord. The design/selection of such connection device(s) is the responsibility of others.

LOAD CASE(S) Standard

1) Dead + Snow (balanced): Lumber Increase=1.15, Plate Increase=1.15

Uniform Loads (plf)

Vert: A-C=-70, C-E=-70, E-F=-70, F-H=-70, H-I=-70, J-R=-20

Concentrated Loads (lb)

Vert: P=-1145(F) L=-470(F) K=-783(F) AB=-389(F) AC=-389(F) AD=-389(F) AE=-1177(F) AF=-285(F) AG=-285(F)

WARNING - Verify design parameters and READ NOTES ON THIS AND INCLUDED MITEK REFERENCE PAGE MII-7473 rev. 1/2/2023 BEFORE USE.

Design valid for use only with MiTek® connectors. This design is based only upon parameters shown, and is for an individual building component, not a truss system. Before use, the building designer must verify the applicability of design parameters and properly incorporate this design into the overall building design. Bracing indicated is to prevent buckling of individual truss web and/or chord members only. Additional temporary and permanent bracing is always required for stability and to prevent collapse with possible personal injury and property damage. For general guidance regarding the fabrication, storage, delivery, erection and bracing of trusses and truss systems, see **ANSI/TPI1 Quality Criteria, and DSB-22** available from Truss Plate Institute (www.tpinst.org) and **BCSI Building Component Safety Information** available from the Structural Building Component Association (www.sbccomponents.com)

MiTek®

16023 Swingley Ridge Rd.
Chesterfield, MO 63017
314.434.1200 / MiTek-US.com

Job	Truss	Truss Type	Qty	Ply	GENE BOSLEY RES. / ROOF
242042	57	Diagonal Hip Girder	1	1	

RELEASE FOR CONSTRUCTION


AS NOTED FOR PLAN REVIEW

DEVELOPMENT SERVICES

LEE'S SUMMIT, MISSOURI

12/02/2024

Heartland Truss, Inc, Plattsburg, MO - 64477, 8.730 s Oct 31 2024 MiTek Industries, Inc. Wed Nov 27 17:39:50 2024 Page 1
 ID: mrcY1X_2FQFIXm9hhpx4TmyPVL_0OZuRWsDFtvO54KYT3zh_nwJ96uy rfv92npuhlyF2TJ

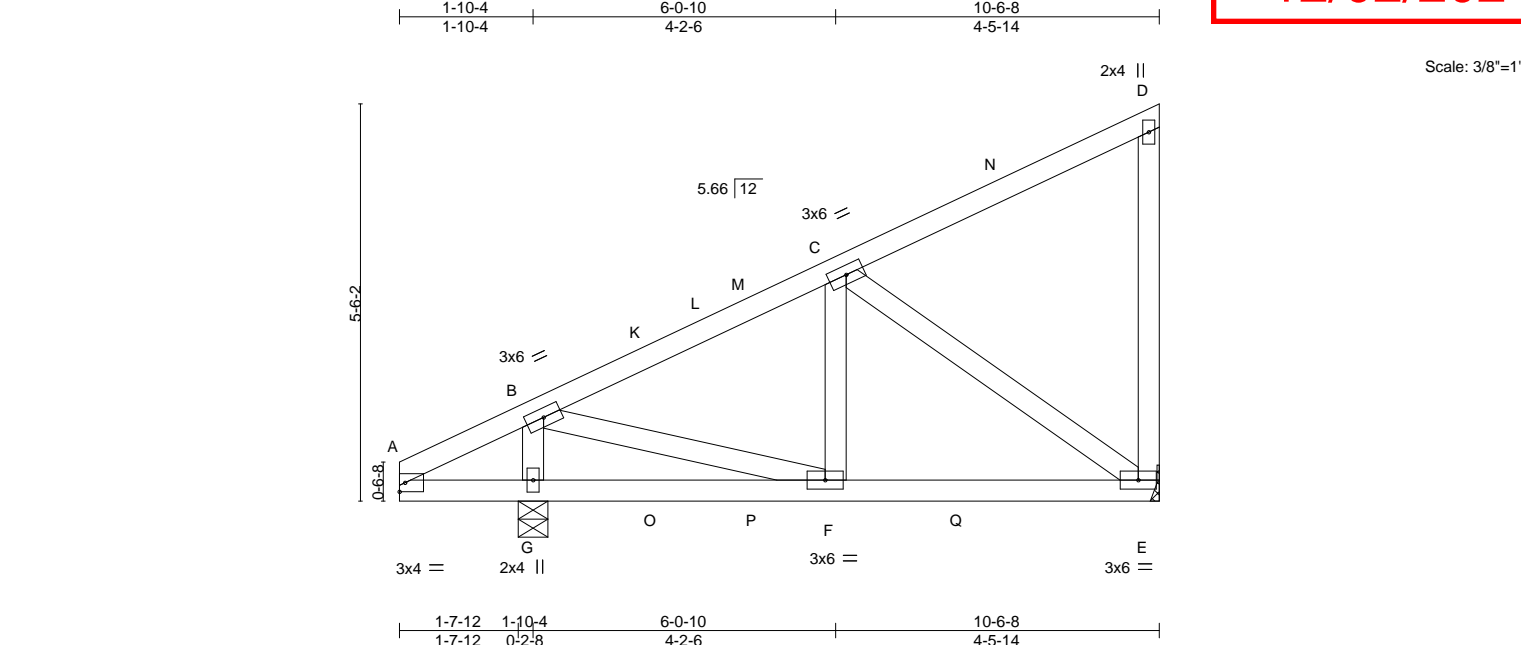

LOADING (psf)	SPACING-	CSI.	DEFL.	PLATES	GRIP
TCLL 25.0 (Roof Snow=25.0)	2-0-0 Plate Grip DOL 1.15 Lumber DOL 1.15	TC 0.45 BC 0.77 WB 0.37 Matrix-MS	in (loc) l/defl L/d Vert(LL) -0.08 E-F >999 240 Vert(CT) -0.11 E-F >917 180 Horz(CT) -0.00 E n/a n/a	MT20	244/190
TCDL 10.0	Rep Stress Incr NO				
BCLL 0.0	Code IRC2018/TPI2014				
BCDL 10.0				Weight: 59 lb	FT = 20%

LUMBER-
 TOP CHORD 2x4 SP No.2
 BOT CHORD 2x4 SP 1650F 1.5E
 WEBS 2x4 SP No.3

BRACING-
 TOP CHORD Structural wood sheathing directly applied or 6-0-0 oc purlins, except end verticals.
 BOT CHORD Rigid ceiling directly applied or 6-0-0 oc bracing.

REACTIONS. (size) G=0-4-15, E=Mechanical
 Max Horz G=179(LC 11)
 Max Uplift G=-240(LC 12), E=-229(LC 12)
 Max Grav G=664(LC 18), E=784(LC 18)

FORCES. (lb) - Max. Comp./Max. Ten. - All forces 250 (lb) or less except when shown.
 TOP CHORD B-C=-680/322
 BOT CHORD F-G=-269/180, E-F=-263/578
 WEBS B-G=-729/367, B-F=-179/737, C-F=-140/256, C-E=-677/375

- NOTES-**
- 1) Wind: ASCE 7-16; Vult=115mph (3-second gust) Vasd=91mph; TCDL=6.0psf; BCDL=6.0psf; h=20ft; Cat. II; Exp C; Enclosed; MWFRS (envelope) gable end zone and C-C Corner(3) 0-0-0 to 4-2-15, Exterior(2R) 4-2-15 to 10-4-12 zone; cantilever left and right exposed ; end vertical left and right exposed;C-C for members and forces & MWFRS for reactions shown; Lumber DOL=1.33 plate grip DOL=1.33
 - 2) TCLL: ASCE 7-16; Pf=25.0 psf (Lum DOL=1.15 Plate DOL=1.15); Is=1.0; Rough Cat C; Fully Exp.; Ce=0.9; Cs=1.00; Ct=1.10
 - 3) Unbalanced snow loads have been considered for this design.
 - 4) This truss has been designed for a 10.0 psf bottom chord live load nonconcurrent with any other live loads.
 - 5) Refer to girder(s) for truss to truss connections.
 - 6) Provide mechanical connection (by others) of truss to bearing plate capable of withstanding 100 lb uplift at joint(s) except (jt=lb) G=240, E=229.
 - 7) This truss is designed in accordance with the 2018 International Residential Code sections R502.11.1 and R802.10.2 and referenced standard ANSI/TPI 1.
 - 8) Hanger(s) or other connection device(s) shall be provided sufficient to support concentrated load(s) 76 lb down and 96 lb up at 3-6-11, 76 lb down and 96 lb up at 3-6-11, and 103 lb down and 91 lb up at 4-11-11, and 103 lb down and 91 lb up at 4-11-11 on top chord, and 74 lb up at 3-6-11, 74 lb up at 3-6-11, 11 lb down and 18 lb up at 4-11-11, 11 lb down and 18 lb up at 4-11-11, and 211 lb down and 93 lb up at 7-9-10, and 211 lb down and 93 lb up at 7-9-10 on bottom chord. The design/selection of such connection device(s) is the responsibility of others.
 - 9) In the LOAD CASE(S) section, loads applied to the face of the truss are noted as front (F) or back (B).

LOAD CASE(S) Standard

- 1) Dead + Snow (balanced): Lumber Increase=1.15, Plate Increase=1.15
 Uniform Loads (plf)
 Vert: A-D=-70, E-H=-20
 Concentrated Loads (lb)
 Vert: K=67(F=34, B=34) O=75(F=38, B=38) P=3(F=2, B=2) Q=-422(F=-211, B=-211)



November 27, 2024

WARNING - Verify design parameters and READ NOTES ON THIS AND INCLUDED MITEK REFERENCE PAGE MII-7473 rev. 1/2/2023 BEFORE USE.

Design valid for use only with MiTek® connectors. This design is based only upon parameters shown, and is for an individual building component, not a truss system. Before use, the building designer must verify the applicability of design parameters and properly incorporate this design into the overall building design. Bracing indicated is to prevent buckling of individual truss web and/or chord members only. Additional temporary and permanent bracing is always required for stability and to prevent collapse with possible personal injury and property damage. For general guidance regarding the fabrication, storage, delivery, erection and bracing of trusses and truss systems, see **ANSI/TPI1 Quality Criteria, and DSB-22** available from Truss Plate Institute (www.tpinst.org) and **BCSI Building Component Safety Information** available from the Structural Building Component Association (www.sbcsccomponents.com)

MiTek®
 16023 Swingley Ridge Rd.
 Chesterfield, MO 63017
 314.434.1200 / MiTek-US.com

Job	Truss	Truss Type	Qty	Ply	GENE BOSLEY RES. / ROOF
242042	58	Diagonal Hip Girder	1	1	

AS NOTED FOR PLAN REVIEW
DEVELOPMENT SERVICES
LEE'S SUMMIT, MISSOURI

Heartland Truss, Inc, Plattsburg, MO - 64477,

8.730 s Oct 31 2024 MiTek Industries, Inc.


Wed Nov 27 07:39:51 2024 Page 1

ID: mrcY1X_2FQFIXm9hhpx4TmyPVL_Ua7Gessr0m1FiEvk1UwX_STjVEmagzH4MMRkVf2Tj

12/02/2024



Scale: 3/8"=1'

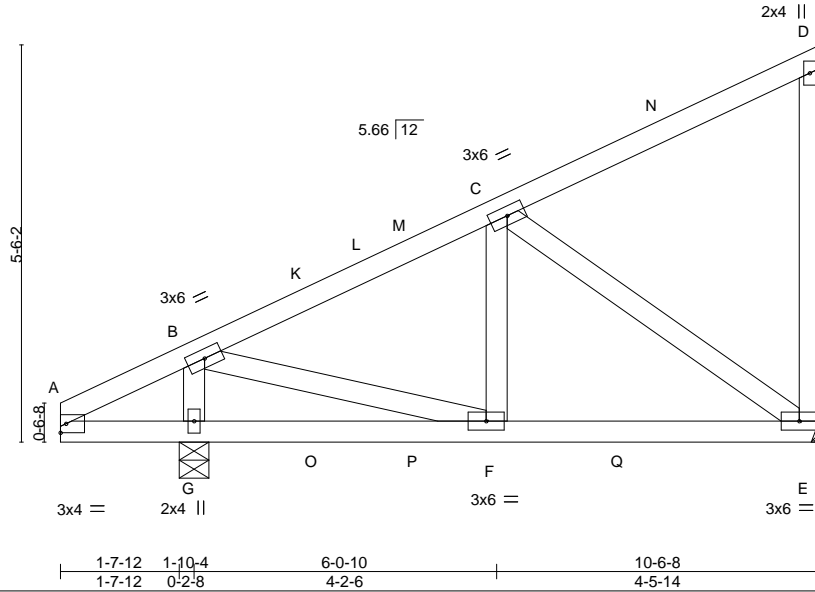

LOADING (psf)	SPACING-	CSI.	DEFL.	PLATES	GRIP
TCLL 25.0 (Roof Snow=25.0)	2-0-0 Plate Grip DOL 1.15 Lumber DOL 1.15	TC 0.45 BC 0.80 WB 0.40 Matrix-MS	in (loc) l/defl L/d Vert(LL) -0.08 E-F >999 240 Vert(CT) -0.11 E-F >895 180 Horz(CT) 0.00 E n/a n/a	MT20	244/190
TCDL 10.0	Rep Stress Incr NO Code IRC2018/TPI2014			Weight: 59 lb	FT = 20%
BCLL 0.0					
BCDL 10.0					

LUMBER-	BRACING-
TOP CHORD 2x4 SP No.2	TOP CHORD Structural wood sheathing directly applied or 6-0-0 oc purlins, except end verticals.
BOT CHORD 2x4 SP 1650F 1.5E	BOT CHORD Rigid ceiling directly applied or 6-0-0 oc bracing.
WEBS 2x4 SP No.3	

REACTIONS. (size) G=0-4-15, E=Mechanical
Max Horz G=179(LC 11)
Max Uplift G=-192(LC 12), E=-217(LC 12)
Max Grav G=733(LC 18), E=816(LC 18)

FORCES. (lb) - Max. Comp./Max. Ten. - All forces 250 (lb) or less except when shown.
TOP CHORD B-C=-736/256
BOT CHORD E-F=-241/621
WEBS B-G=-768/352, B-F=-180/753, C-F=-109/291, C-E=-729/348

- NOTES-**
- 1) Wind: ASCE 7-16; Vult=115mph (3-second gust) Vasd=91mph; TCDL=6.0psf; BCDL=6.0psf; h=20ft; Cat. II; Exp C; Enclosed; MWFRS (envelope) gable end zone and C-C Corner(3) 0-0-0 to 4-2-15, Exterior(2R) 4-2-15 to 10-4-12 zone; cantilever left and right exposed ; end vertical left and right exposed;C-C for members and forces & MWFRS for reactions shown; Lumber DOL=1.33 plate grip DOL=1.33
 - 2) TCLL: ASCE 7-16; Pf=25.0 psf (Lum DOL=1.15 Plate DOL=1.15); Is=1.0; Rough Cat C; Fully Exp.; Ce=0.9; Cs=1.00; Ct=1.10
 - 3) Unbalanced snow loads have been considered for this design.
 - 4) This truss has been designed for a 10.0 psf bottom chord live load nonconcurrent with any other live loads.
 - 5) Refer to girder(s) for truss to truss connections.
 - 6) Provide mechanical connection (by others) of truss to bearing plate capable of withstanding 100 lb uplift at joint(s) except (jt=lb) G=192, E=217.
 - 7) This truss is designed in accordance with the 2018 International Residential Code sections R502.11.1 and R802.10.2 and referenced standard ANSI/TPI 1.
 - 8) Hanger(s) or other connection device(s) shall be provided sufficient to support concentrated load(s) 76 lb down and 96 lb up at 3-6-11, and 107 lb down and 94 lb up at 4-11-11, and 103 lb down and 91 lb up at 4-11-11 on top chord, and 74 lb up at 3-6-11, 16 lb down and 17 lb up at 4-11-11, 11 lb down and 18 lb up at 4-11-11, and 233 lb down and 92 lb up at 7-9-10, and 211 lb down and 93 lb up at 7-9-10 on bottom chord. The design/selection of such connection device(s) is the responsibility of others.
 - 9) In the LOAD CASE(S) section, loads applied to the face of the truss are noted as front (F) or back (B).

LOAD CASE(S) Standard

- 1) Dead + Snow (balanced): Lumber Increase=1.15, Plate Increase=1.15
Uniform Loads (plf)
Vert: A-D=-70, E-H=-20
Concentrated Loads (lb)
Vert: K=34(B) M=-5(F) O=38(B) P=-4(F=-6, B=2) Q=-444(F=-233, B=-211)



November 27, 2024

Job	Truss	Truss Type	Qty	Ply	GENE BOSLEY RES. / ROOF
242042	59	Diagonal Hip Girder	1	1	

RELEASE FOR CONSTRUCTION


AS NOTED FOR PLAN REVIEW

DEVELOPMENT SERVICES

LEE'S SUMMIT, MISSOURI

12/02/2024

Heartland Truss, Inc, Plattsburg, MO - 64477, 8.730 s Oct 31 2024 MiTek Industries, Inc. Wed No 27-07-89-51-2024 Page 1
 ID:mrCY1X_2FQFIXm9hhpx4TmyPVL_-Ua7Gessr0m1FiEvktnUwX_SorV27AkzI4MWRk4F2T

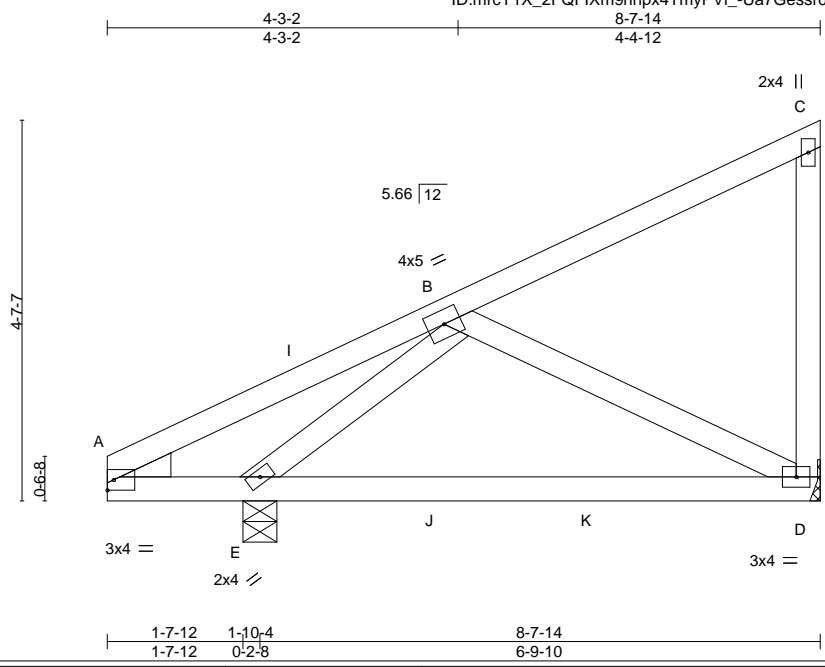

Scale = 1:28.0

LOADING (psf)	SPACING-	CSI.	DEFL.	PLATES	GRIP
TCLL 25.0 (Roof Snow=25.0)	2-0-0 Plate Grip DOL 1.15 Lumber DOL 1.15	TC 0.64 BC 0.84 WB 0.17 Matrix-MP	in (loc) l/defl L/d Vert(LL) -0.20 D-E >411 240 Vert(CT) -0.22 D-E >372 180 Horz(CT) 0.00 D n/a n/a	MT20	244/190
TCDL 10.0	Rep Stress Incr NO Code IRC2018/TPI2014			Weight: 46 lb	FT = 20%
BCLL 0.0					
BCDL 10.0					

LUMBER-	BRACING-
TOP CHORD 2x4 SP No.2	TOP CHORD Structural wood sheathing directly applied or 6-0-0 oc purlins, except end verticals.
BOT CHORD 2x4 SP 1650F 1.5E	BOT CHORD Rigid ceiling directly applied or 6-0-0 oc bracing.
WEBS 2x4 SP No.3	
WEDGE	
Left: 2x4 SP No.3	

REACTIONS. (size) D=Mechanical, E=0-4-15
 Max Horz E=151(LC 11)
 Max Uplift D=-222(LC 12), E=-203(LC 12)
 Max Grav D=526(LC 18), E=545(LC 18)

FORCES. (lb) - Max. Comp./Max. Ten. - All forces 250 (lb) or less except when shown.
 TOP CHORD A-B=-263/489
 BOT CHORD A-E=-349/278, D-E=-213/320
 WEBS B-D=-359/302, B-E=-508/364

- NOTES-**
- 1) Wind: ASCE 7-16; Vult=115mph (3-second gust) Vasd=91mph; TCDL=6.0psf; BCDL=6.0psf; h=20ft; Cat. II; Exp C; Enclosed; MWFRS (envelope) gable end zone and C-C Corner(3) 0-0-0 to 4-2-0, Exterior(2R) 4-2-0 to 8-6-2 zone; cantilever left and right exposed; end vertical left and right exposed; C-C for members and forces & MWFRS for reactions shown; Lumber DOL=1.33 plate grip DOL=1.33
 - 2) TCLL: ASCE 7-16; Pf=25.0 psf (Lum DOL=1.15 Plate DOL=1.15); Is=1.0; Rough Cat C; Fully Exp.; Ce=0.9; Cs=1.00; Ct=1.10
 - 3) Unbalanced snow loads have been considered for this design.
 - 4) This truss has been designed for a 10.0 psf bottom chord live load nonconcurrent with any other live loads.
 - 5) Refer to girder(s) for truss to truss connections.
 - 6) Provide mechanical connection (by others) of truss to bearing plate capable of withstanding 100 lb uplift at joint(s) except (jt=lb) D=222, E=203.
 - 7) This truss is designed in accordance with the 2018 International Residential Code sections R502.11.1 and R802.10.2 and referenced standard ANSI/TPI 1.
 - 8) Hanger(s) or other connection device(s) shall be provided sufficient to support concentrated load(s) 344 lb up at 4-0-6, and 104 lb down and 76 lb up at 4-0-6 on top chord, and 273 lb up at 4-0-6, 55 lb up at 4-0-6, and 99 lb down and 81 lb up at 5-11-0, and 195 lb down and 77 lb up at 5-11-0 on bottom chord. The design/selection of such connection device(s) is the responsibility of others.
 - 9) In the LOAD CASE(S) section, loads applied to the face of the truss are noted as front (F) or back (B).

LOAD CASE(S) Standard

- 1) Dead + Snow (balanced): Lumber Increase=1.15, Plate Increase=1.15

Uniform Loads (plf)
 Vert: A-C=-70, D-F=-20

Concentrated Loads (lb)
 Vert: B=88(F) J=137(F=108, B=29) K=-294(F=-195, B=-99)



November 27, 2024


Job 242042	Truss 60	Truss Type Jack-Closed	Qty 3	Ply 1	GENE BOSLEY RES. / ROOF
---------------	-------------	---------------------------	----------	----------	-------------------------

AS NOTED FOR PLAN REVIEW
DEVELOPMENT SERVICES
LEE'S SUMMIT, MISSOURI

Heartland Truss, Inc, Plattsburg, MO - 64477,

8.730 s Oct 31 2024 MiTek Industries, Inc. Wed No 27-07-30-51-2024 Page 1

ID:mrcY1X_2FQFIXm9hpx4TmyPVI_-Ua7Gessr0m1FiEvk1nJwX_SUNVN_Ralluz14WIMRk7F2T
5-5-7 5-5-7
12/02/2024

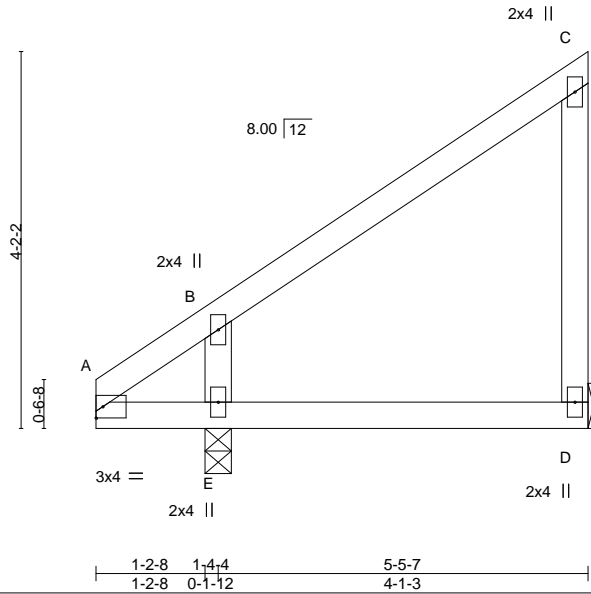

Scale = 1:25.5

LOADING (psf)	SPACING-	CSI.	DEFL.	in (loc)	l/defl	L/d	PLATES	GRIP
TCLL 25.0 (Roof Snow=25.0)	2-0-0 Plate Grip DOL 1.15	TC 0.42	Vert(LL) 0.02	D-E	>999	240	MT20	244/190
TCDL 10.0	Lumber DOL 1.15	BC 0.24	Vert(CT) -0.03	D-E	>999	180		
BCLL 0.0	Rep Stress Incr YES	WB 0.09	Horz(CT) 0.00	D	n/a	n/a		
BCDL 10.0	Code IRC2018/TPI2014	Matrix-MP					Weight: 25 lb	FT = 20%

LUMBER-
TOP CHORD 2x4 SP No.2
BOT CHORD 2x4 SP No.2
WEBS 2x4 SP No.3

BRACING-
TOP CHORD Structural wood sheathing directly applied or 5-5-7 oc purlins, except end verticals.
BOT CHORD Rigid ceiling directly applied or 10-0-0 oc bracing.

REACTIONS. (size) D=Mechanical, E=0-3-8
Max Horz E=140(LC 11)
Max Uplift D=-64(LC 9), E=-18(LC 12)
Max Grav D=239(LC 18), E=488(LC 18)

FORCES. (lb) - Max. Comp./Max. Ten. - All forces 250 (lb) or less except when shown.
WEBS B-E=-478/243

- NOTES-**
- 1) Wind: ASCE 7-16; Vult=115mph (3-second gust) Vasd=91mph; TCDL=6.0psf; BCDL=6.0psf; h=20ft; Cat. II; Exp C; Enclosed; MWFRS (envelope) gable end zone and C-C Exterior(2E) zone; cantilever left and right exposed ; end vertical left and right exposed;C-C for members and forces & MWFRS for reactions shown; Lumber DOL=1.33 plate grip DOL=1.33
 - 2) TCLL: ASCE 7-16; Pf=25.0 psf (Lum DOL=1.15 Plate DOL=1.15); Is=1.0; Rough Cat C; Fully Exp.; Ce=0.9; Cs=1.00; Ct=1.10
 - 3) Unbalanced snow loads have been considered for this design.
 - 4) This truss has been designed for a 10.0 psf bottom chord live load nonconcurrent with any other live loads.
 - 5) Refer to girder(s) for truss to truss connections.
 - 6) Provide mechanical connection (by others) of truss to bearing plate capable of withstanding 100 lb uplift at joint(s) D, E.
 - 7) This truss is designed in accordance with the 2018 International Residential Code sections R502.11.1 and R802.10.2 and referenced standard ANSI/TPI 1.



November 27, 2024

WARNING - Verify design parameters and READ NOTES ON THIS AND INCLUDED MITEK REFERENCE PAGE MII-7473 rev. 1/2/2023 BEFORE USE.

Design valid for use only with MiTek® connectors. This design is based only upon parameters shown, and is for an individual building component, not a truss system. Before use, the building designer must verify the applicability of design parameters and properly incorporate this design into the overall building design. Bracing indicated is to prevent buckling of individual truss web and/or chord members only. Additional temporary and permanent bracing is always required for stability and to prevent collapse with possible personal injury and property damage. For general guidance regarding the fabrication, storage, delivery, erection and bracing of trusses and truss systems, see **ANSI/TPI1 Quality Criteria, and DSB-22** available from Truss Plate Institute (www.tpinst.org) and **BCSI Building Component Safety Information** available from the Structural Building Component Association (www.sbcsccomponents.com)

MiTek®

16023 Swingley Ridge Rd.
Chesterfield, MO 63017
314.434.1200 / MiTek-US.com

Job	Truss	Truss Type	Qty	Ply	GENE BOSLEY RES. / ROOF
242042	61	Jack-Open	3	1	

RELEASE FOR CONSTRUCTION

AS NOTED FOR PLAN REVIEW

DEVELOPMENT SERVICES


LEE'S SUMMIT, MISSOURI

12/02/2024

Heartland Truss, Inc, Plattsburg, MO - 64477,

8.730 s Oct 31 2024 MiTek Industries, Inc. Wed Nov 27 17:39:52 2024 Page 1

3-5-7
3-5-7

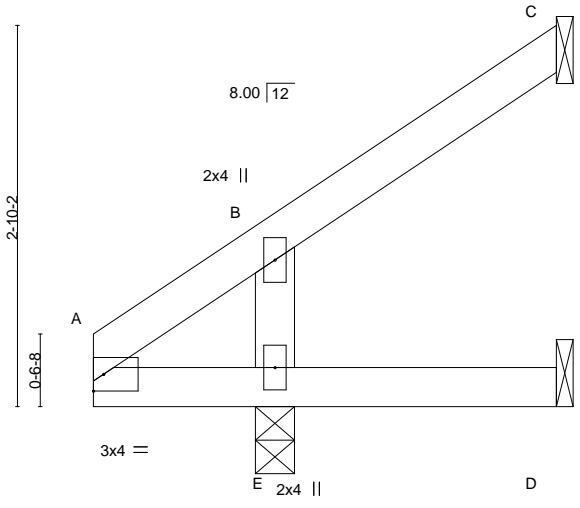

Scale = 1:17.2

1-2-8 1-4-4 3-5-7
1-2-8 0-1-12 2-1-3

LOADING (psf)	SPACING-	CSI.	DEFL.	in (loc)	I/defl	L/d	PLATES	GRIP
TCLL 25.0 (Roof Snow=25.0)	2-0-0 Plate Grip DOL 1.15	TC 0.16	Vert(LL) 0.00	D-E	>999	240	MT20	244/190
TCDL 10.0	Lumber DOL 1.15	BC 0.12	Vert(CT) 0.00	D-E	>999	180		
BCLL 0.0	Rep Stress Incr YES	WB 0.05	Horz(CT) -0.01	C	n/a	n/a		
BCDL 10.0	Code IRC2018/TPI2014	Matrix-MP					Weight: 13 lb	FT = 20%

LUMBER-	BRACING-
TOP CHORD 2x4 SP No.2	TOP CHORD Structural wood sheathing directly applied or 3-5-7 oc purlins.
BOT CHORD 2x4 SP No.2	BOT CHORD Rigid ceiling directly applied or 10-0-0 oc bracing.
WEBS 2x4 SP No.3	

REACTIONS. (size) C=Mechanical, D=Mechanical, E=0-3-8
 Max Horz E=88(LC 12)
 Max Uplift C=-55(LC 12), D=-12(LC 12)
 Max Grav C=76(LC 18), D=24(LC 5), E=364(LC 18)

FORCES. (lb) - Max. Comp./Max. Ten. - All forces 250 (lb) or less except when shown.
 WEBS B-E=-269/114

- NOTES-**
- 1) Wind: ASCE 7-16; Vult=115mph (3-second gust) Vasd=91mph; TCDL=6.0psf; BCDL=6.0psf; h=20ft; Cat. II; Exp C; Enclosed; MWFRS (envelope) gable end zone and C-C Exterior(2E) zone; cantilever left and right exposed ; end vertical left and right exposed;C-C for members and forces & MWFRS for reactions shown; Lumber DOL=1.33 plate grip DOL=1.33
 - 2) TCLL: ASCE 7-16; Pf=25.0 psf (Lum DOL=1.15 Plate DOL=1.15); Is=1.0; Rough Cat C; Fully Exp.; Ce=0.9; Cs=1.00; Ct=1.10
 - 3) Unbalanced snow loads have been considered for this design.
 - 4) This truss has been designed for a 10.0 psf bottom chord live load nonconcurrent with any other live loads.
 - 5) Refer to girder(s) for truss to truss connections.
 - 6) Provide mechanical connection (by others) of truss to bearing plate capable of withstanding 100 lb uplift at joint(s) C, D.
 - 7) This truss is designed in accordance with the 2018 International Residential Code sections R502.11.1 and R802.10.2 and referenced standard ANSI/TPI 1.



November 27, 2024

Job	Truss	Truss Type	Qty	Ply	GENE BOSLEY RES. / ROOF
242042	62	Jack-Open	3	1	

RELEASE FOR CONSTRUCTION

AS NOTED FOR PLAN REVIEW

DEVELOPMENT SERVICES


LEE'S SUMMIT, MISSOURI

12/02/2024

Heartland Truss, Inc, Plattsburg, MO - 64477,

8.730 s Oct 31 2024 MiTek Industries, Inc. Wed Nov 27 07:36:52 2024 Page 1

ID: mrcY1X_2FQFIxm9hpx4TmyPVL_ynhesCtTn496KOUwaU?93C?k?W?Da6kGvz?K?2?

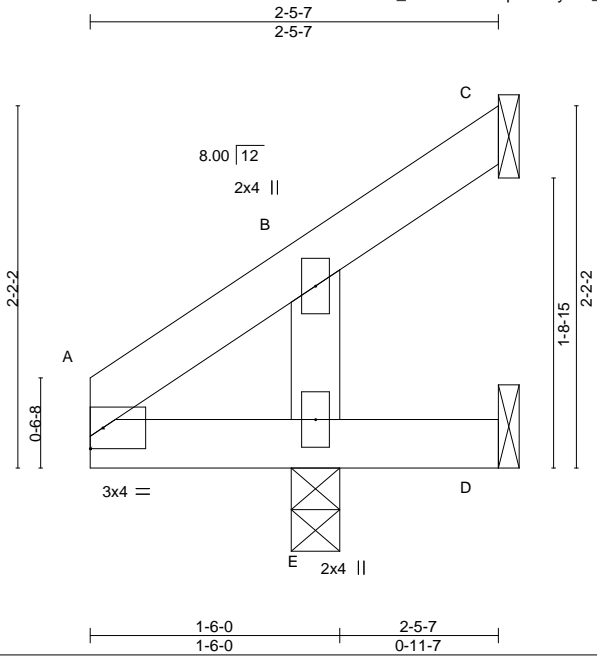

Scale = 1:13.8

LOADING (psf)	SPACING-	CSI.	DEFL.	PLATES	GRIP
TCLL 25.0 (Roof Snow=25.0)	2-0-0 Plate Grip DOL 1.15 Lumber DOL 1.15 Rep Stress Incr YES Code IRC2018/TP12014	TC 0.13 BC 0.13 WB 0.04 Matrix-MP	in (loc) l/defl L/d Vert(LL) 0.00 E >999 240 Vert(CT) 0.00 E >999 180 Horz(CT) -0.01 C n/a n/a	MT20	244/190
TCDL 10.0				Weight: 10 lb	FT = 20%
BCLL 0.0					
BCDL 10.0					

LUMBER-
TOP CHORD 2x4 SP No.2
BOT CHORD 2x4 SP No.2
WEBS 2x4 SP No.3

BRACING-
TOP CHORD Structural wood sheathing directly applied or 2-5-7 oc purlins.
BOT CHORD Rigid ceiling directly applied or 10-0-0 oc bracing.

REACTIONS. (size) C=Mechanical, D=Mechanical, E=0-3-8
Max Horz E=62(LC 12)
Max Uplift C=-37(LC 12), D=-46(LC 18)
Max Grav C=14(LC 10), D=5(LC 8), E=339(LC 18)

FORCES. (lb) - Max. Comp./Max. Ten. - All forces 250 (lb) or less except when shown.

- NOTES-**
- 1) Wind: ASCE 7-16; Vult=115mph (3-second gust) Vasd=91mph; TCDL=6.0psf; BCDL=6.0psf; h=20ft; Cat. II; Exp C; Enclosed; MWFRS (envelope) gable end zone and C-C Exterior(2E) zone; cantilever left and right exposed; end vertical left and right exposed; C-C for members and forces & MWFRS for reactions shown; Lumber DOL=1.33 plate grip DOL=1.33
 - 2) TCLL: ASCE 7-16; Pf=25.0 psf (Lum DOL=1.15 Plate DOL=1.15); Is=1.0; Rough Cat C; Fully Exp.; Ce=0.9; Cs=1.00; Ct=1.10
 - 3) Unbalanced snow loads have been considered for this design.
 - 4) This truss has been designed for a 10.0 psf bottom chord live load nonconcurrent with any other live loads.
 - 5) Refer to girder(s) for truss to truss connections.
 - 6) Provide mechanical connection (by others) of truss to bearing plate capable of withstanding 100 lb uplift at joint(s) C, D.
 - 7) This truss is designed in accordance with the 2018 International Residential Code sections R502.11.1 and R802.10.2 and referenced standard ANSI/TP1 1.



November 27, 2024

WARNING - Verify design parameters and READ NOTES ON THIS AND INCLUDED MITEK REFERENCE PAGE MII-7473 rev. 1/2/2023 BEFORE USE.

Design valid for use only with MiTek® connectors. This design is based only upon parameters shown, and is for an individual building component, not a truss system. Before use, the building designer must verify the applicability of design parameters and properly incorporate this design into the overall building design. Bracing indicated is to prevent buckling of individual truss web and/or chord members only. Additional temporary and permanent bracing is always required for stability and to prevent collapse with possible personal injury and property damage. For general guidance regarding the fabrication, storage, delivery, erection and bracing of trusses and truss systems, see **ANSI/TP1 Quality Criteria, and DSB-22** available from Truss Plate Institute (www.tpinst.org) and **BCSI Building Component Safety Information** available from the Structural Building Component Association (www.sbcsccomponents.com)

MiTek®

16023 Swingley Ridge Rd.
Chesterfield, MO 63017
314.434.1200 / MiTek-US.com

Job	Truss	Truss Type	Qty	Ply	GENE BOSLEY RES. / ROOF
242042	63	Jack-Closed	1	1	

RELEASE FOR CONSTRUCTION


AS NOTED FOR PLAN REVIEW

DEVELOPMENT SERVICES

LEE'S SUMMIT, MISSOURI

12/02/2024

Heartland Truss, Inc, Plattsburg, MO - 64477, 8.730 s Oct 31 2024 MiTek Industries, Inc. Wed No 27-07-30-53-2024 Page 1

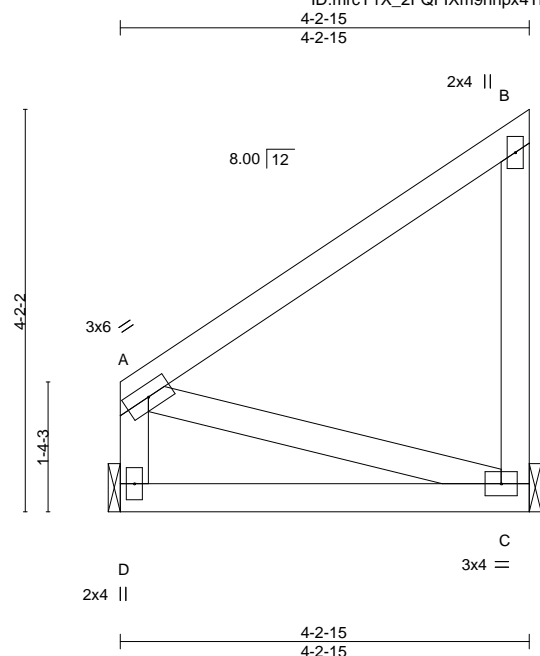

Scale: 1/2"=1'

LOADING (psf)	SPACING-	CSI.	DEFL.	in (loc)	l/defl	L/d	PLATES	GRIP
TCLL 25.0 (Roof Snow=25.0)	2-0-0 Plate Grip DOL 1.15 Lumber DOL 1.15	TC 0.56 BC 0.19 WB 0.05 Matrix-MP	Vert(LL) -0.01 Vert(CT) -0.03 Horz(CT) 0.00	C-D C-D C	>999 >999 n/a	240 180 n/a	MT20	244/190
TCDL 10.0	Rep Stress Incr YES						Weight: 26 lb	FT = 20%
BCLL 0.0	Code IRC2018/TP12014							
BCDL 10.0								

LUMBER-	BRACING-
TOP CHORD 2x4 SP No.2	TOP CHORD Structural wood sheathing directly applied or 4-2-15 oc purlins, except end verticals.
BOT CHORD 2x4 SP No.2	BOT CHORD Rigid ceiling directly applied or 10-0-0 oc bracing.
WEBS 2x4 SP No.3	

REACTIONS. (size) D=Mechanical, C=Mechanical
 Max Horz D=141(LC 11)
 Max Uplift D=-2(LC 12), C=-64(LC 9)
 Max Grav D=261(LC 18), C=261(LC 18)

FORCES. (lb) - Max. Comp./Max. Ten. - All forces 250 (lb) or less except when shown.

- NOTES-**
- 1) Wind: ASCE 7-16; Vult=115mph (3-second gust) Vasd=91mph; TCDL=6.0psf; BCDL=6.0psf; h=20ft; Cat. II; Exp C; Enclosed; MWFRS (envelope) gable end zone and C-C Exterior(2E) zone; cantilever left and right exposed; end vertical left and right exposed; C-C for members and forces & MWFRS for reactions shown; Lumber DOL=1.33 plate grip DOL=1.33
 - 2) TCLL: ASCE 7-16; Pf=25.0 psf (Lum DOL=1.15 Plate DOL=1.15); Is=1.0; Rough Cat C; Fully Exp.; Ce=0.9; Cs=1.00; Ct=1.10
 - 3) Unbalanced snow loads have been considered for this design.
 - 4) This truss has been designed for a 10.0 psf bottom chord live load nonconcurrent with any other live loads.
 - 5) Refer to girder(s) for truss to truss connections.
 - 6) Provide mechanical connection (by others) of truss to bearing plate capable of withstanding 100 lb uplift at joint(s) D, C.
 - 7) This truss is designed in accordance with the 2018 International Residential Code sections R502.11.1 and R802.10.2 and referenced standard ANSI/TP1 1.



November 27, 2024

Job 242042	Truss 64	Truss Type Jack-Open	Qty 1	Ply 1	GENE BOSLEY RES. / ROOF
---------------	-------------	-------------------------	----------	----------	-------------------------

AS NOTED FOR PLAN REVIEW
DEVELOPMENT SERVICES
LEE'S SUMMIT, MISSOURI


Heartland Truss, Inc, Plattsburg, MO - 64477,

8.730 s Oct 31 2024 MiTek Industries, Inc. Wed Nov 27 07:39:53 2024 Page 1

ID: mrcY1X_2FQFIXm9hpx4TmyPVL_-QzF03Xu5YOHzyY273CWocP 1502 |ISB: 02SVYK21K

12/02/2024

Scale = 1:17.3

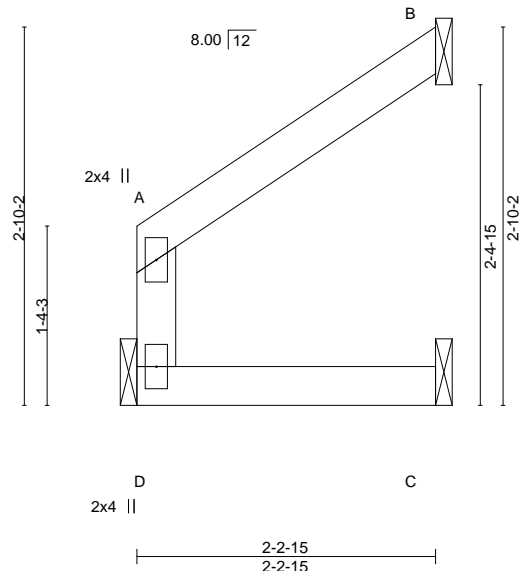

LOADING (psf)	SPACING-	CSI.	DEFL.	in (loc)	l/defl	L/d	PLATES	GRIP
TCLL 25.0 (Roof Snow=25.0)	2-0-0 Plate Grip DOL 1.15 Lumber DOL 1.15	TC 0.17 BC 0.11 WB 0.00 Matrix-MR	Vert(LL) -0.00 Vert(CT) -0.00 Horz(CT) -0.01	C-D C-D B	>999 >999 n/a	240 180 n/a	MT20	244/190
TCDL 10.0	Rep Stress Incr YES Code IRC2018/TPI2014						Weight: 9 lb	FT = 20%
BCLL 0.0								
BCDL 10.0								

LUMBER-
TOP CHORD 2x4 SP No.2
BOT CHORD 2x4 SP No.2
WEBS 2x4 SP No.3

BRACING-
TOP CHORD Structural wood sheathing directly applied or 2-2-15 oc purlins, except end verticals.
BOT CHORD Rigid ceiling directly applied or 10-0-0 oc bracing.

REACTIONS. (size) D=Mechanical, B=Mechanical, C=Mechanical
Max Horz D=53(LC 9)
Max Uplift B=-53(LC 12), C=-5(LC 12)
Max Grav D=122(LC 18), B=96(LC 18), C=40(LC 5)

FORCES. (lb) - Max. Comp./Max. Ten. - All forces 250 (lb) or less except when shown.

NOTES-

- 1) Wind: ASCE 7-16; Vult=115mph (3-second gust) Vasd=91mph; TCDL=6.0psf; BCDL=6.0psf; h=20ft; Cat. II; Exp C; Enclosed; MWFRS (envelope) gable end zone and C-C Exterior(2E) zone; cantilever left and right exposed; end vertical left and right exposed; C-C for members and forces & MWFRS for reactions shown; Lumber DOL=1.33 plate grip DOL=1.33
- 2) TCLL: ASCE 7-16; Pf=25.0 psf (Lum DOL=1.15 Plate DOL=1.15); Is=1.0; Rough Cat C; Fully Exp.; Ce=0.9; Cs=1.00; Ct=1.10
- 3) Unbalanced snow loads have been considered for this design.
- 4) This truss has been designed for a 10.0 psf bottom chord live load nonconcurrent with any other live loads.
- 5) Refer to girder(s) for truss to truss connections.
- 6) Provide mechanical connection (by others) of truss to bearing plate capable of withstanding 100 lb uplift at joint(s) B, C.
- 7) This truss is designed in accordance with the 2018 International Residential Code sections R502.11.1 and R802.10.2 and referenced standard ANSI/TPI 1.



November 27, 2024

WARNING - Verify design parameters and READ NOTES ON THIS AND INCLUDED MITEK REFERENCE PAGE MII-7473 rev. 1/2/2023 BEFORE USE.
Design valid for use only with MiTek® connectors. This design is based only upon parameters shown, and is for an individual building component, not a truss system. Before use, the building designer must verify the applicability of design parameters and properly incorporate this design into the overall building design. Bracing indicated is to prevent buckling of individual truss web and/or chord members only. Additional temporary and permanent bracing is always required for stability and to prevent collapse with possible personal injury and property damage. For general guidance regarding the fabrication, storage, delivery, erection and bracing of trusses and truss systems, see **ANSI/TPI1 Quality Criteria, and DSB-22** available from Truss Plate Institute (www.tpinst.org) and **BCSI Building Component Safety Information** available from the Structural Building Component Association (www.sbcsccomponents.com)

MiTek®
16023 Swingley Ridge Rd.
Chesterfield, MO 63017
314.434.1200 / MiTek-US.com

Job	Truss	Truss Type	Qty	Ply	GENE BOSLEY RES. / ROOF
242042	65	Jack-Closed	1	1	

AS NOTED FOR PLAN REVIEW
DEVELOPMENT SERVICES
LEE'S SUMMIT, MISSOURI

Heartland Truss, Inc, Plattsburg, MO - 64477,

8.730 s Oct 31 2024 MiTek Industries, Inc. Wed No 27-07-30-53-2024 Page 1

ID: mrcY1X_2FQFIxm9hpx4TmyPVI_-QzF03Xu5YOHzyY273CW0cPymsh2ISBr27SVyR21K
4-1-7
4-1-7
12/02/2024

Scale = 1:19.4

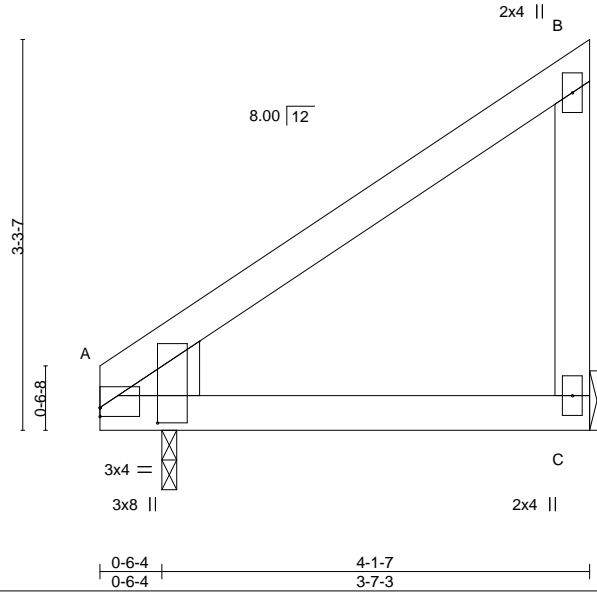


Plate Offsets (X, Y)--	[A:0-0-0,0-0-14], [A:0-1-9,0-5-13]				
LOADING (psf)	SPACING-	CSI.	DEFL.	PLATES	GRIP
TCLL 25.0 (Roof Snow=25.0)	2-0-0 Plate Grip DOL 1.15 Lumber DOL 1.15	TC 0.30 BC 0.22 WB 0.00	in (loc) l/defl L/d Vert(LL) -0.01 C-H >999 240 Vert(CT) -0.02 C-H >999 180 Horz(CT) 0.01 A n/a n/a	MT20	244/190
TCDL 10.0	Rep Stress Incr YES	Matrix-MP			
BCLL 0.0	Code IRC2018/TPI2014				
BCDL 10.0				Weight: 19 lb	FT = 20%

LUMBER-
TOP CHORD 2x4 SP No.2
BOT CHORD 2x4 SP No.2
WEBS 2x4 SP No.3
WEDGE
Left: 2x6 SP No.1

BRACING-
TOP CHORD Structural wood sheathing directly applied or 4-1-7 oc purlins, except end verticals.
BOT CHORD Rigid ceiling directly applied or 10-0-0 oc bracing.

REACTIONS. (size) C=Mechanical, A=0-1-8
Max Horz A=107(LC 11)
Max Uplift C=-49(LC 12), A=-11(LC 12)
Max Grav C=223(LC 18), A=302(LC 18)

FORCES. (lb) - Max. Comp./Max. Ten. - All forces 250 (lb) or less except when shown.

- NOTES-**
- 1) Wind: ASCE 7-16; Vult=115mph (3-second gust) Vasd=91mph; TCDL=6.0psf; BCDL=6.0psf; h=20ft; Cat. II; Exp C; Enclosed; MWFRS (envelope) gable end zone and C-C Exterior(2E) zone; cantilever left and right exposed; end vertical left and right exposed; C-C for members and forces & MWFRS for reactions shown; Lumber DOL=1.33 plate grip DOL=1.33
 - 2) TCLL: ASCE 7-16; Pf=25.0 psf (Lum DOL=1.15 Plate DOL=1.15); Is=1.0; Rough Cat C; Fully Exp.; Ce=0.9; Cs=1.00; Ct=1.10
 - 3) Unbalanced snow loads have been considered for this design.
 - 4) This truss has been designed for a 10.0 psf bottom chord live load nonconcurrent with any other live loads.
 - 5) Refer to girder(s) for truss to truss connections.
 - 6) Provide mechanical connection (by others) of truss to bearing plate at joint(s) A.
 - 7) Provide mechanical connection (by others) of truss to bearing plate capable of withstanding 100 lb uplift at joint(s) C, A.
 - 8) This truss is designed in accordance with the 2018 International Residential Code sections R502.11.1 and R802.10.2 and referenced standard ANSI/TPI 1.



November 27, 2024

Job	Truss	Truss Type	Qty	Ply	GENE BOSLEY RES. / ROOF
242042	66	Jack-Open	1	1	

RELEASE FOR CONSTRUCTION


AS NOTED FOR PLAN REVIEW

DEVELOPMENT SERVICES

LEE'S SUMMIT, MISSOURI

12/02/2024

Heartland Truss, Inc, Plattsburg, MO - 64477, 8.730 s Oct 31 2024 MiTek Industries, Inc. Wed Nov 27 17:39:54 2024 Page 1

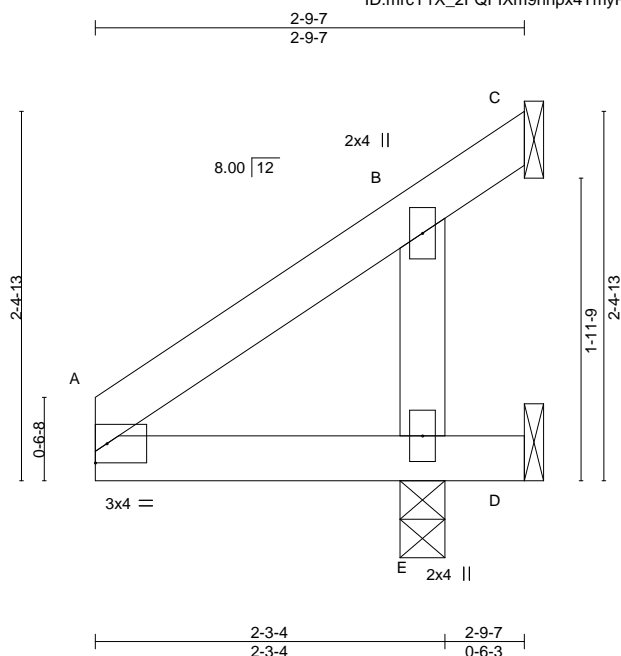

Scale = 1:15.0

LOADING (psf)	SPACING-	CSI.	DEFL.	PLATES	GRIP
TCLL 25.0 (Roof Snow=25.0)	2-0-0 Plate Grip DOL 1.15 Lumber DOL 1.15	TC 0.29 BC 0.35 WB 0.08 Matrix-MP	in (loc) l/defl L/d Vert(LL) 0.00 E >999 240 Vert(CT) 0.00 E >999 180 Horz(CT) -0.05 C n/a n/a	MT20	244/190
TCDL 10.0	Rep Stress Incr YES				
BCLL 0.0	Code IRC2018/TPI2014				
BCDL 10.0				Weight: 12 lb	FT = 20%

LUMBER-	BRACING-
TOP CHORD 2x4 SP No.2	TOP CHORD Structural wood sheathing directly applied or 2-9-7 oc purlins.
BOT CHORD 2x4 SP No.2	BOT CHORD Rigid ceiling directly applied or 10-0-0 oc bracing.
WEBS 2x4 SP No.3	

REACTIONS. (size) C=Mechanical, D=Mechanical, E=0-3-8
 Max Horz D=71(LC 12)
 Max Uplift C=-189(LC 18), D=-244(LC 18)
 Max Grav E=774(LC 18)

FORCES. (lb) - Max. Comp./Max. Ten. - All forces 250 (lb) or less except when shown.
 WEBS B-E=-412/141

- NOTES-**
- 1) Wind: ASCE 7-16; Vult=115mph (3-second gust) Vasd=91mph; TCDL=6.0psf; BCDL=6.0psf; h=20ft; Cat. II; Exp C; Enclosed; MWFRS (envelope) gable end zone and C-C Exterior(2E) zone; cantilever left and right exposed ; end vertical left and right exposed;C-C for members and forces & MWFRS for reactions shown; Lumber DOL=1.33 plate grip DOL=1.33
 - 2) TCLL: ASCE 7-16; Pf=25.0 psf (Lum DOL=1.15 Plate DOL=1.15); Is=1.0; Rough Cat C; Fully Exp.; Ce=0.9; Cs=1.00; Ct=1.10
 - 3) Unbalanced snow loads have been considered for this design.
 - 4) This truss has been designed for a 10.0 psf bottom chord live load nonconcurrent with any other live loads.
 - 5) Refer to girder(s) for truss to truss connections.
 - 6) Provide mechanical connection (by others) of truss to bearing plate capable of withstanding 100 lb uplift at joint(s) except (jt=lb) C=189, D=244.
 - 7) This truss is designed in accordance with the 2018 International Residential Code sections R502.11.1 and R802.10.2 and referenced standard ANSI/TPI 1.



November 27, 2024


Job 242042	Truss 67	Truss Type Jack-Closed Girder	Qty 1	Ply 1	GENE BOSLEY RES. / ROOF
---------------	-------------	----------------------------------	----------	----------	-------------------------

AS NOTED FOR PLAN REVIEW
DEVELOPMENT SERVICES
LEE'S SUMMIT, MISSOURI

Heartland Truss, Inc, Plattsburg, MO - 64477,

8.730 s Oct 31 2024 MiTek Industries, Inc. Wed No 27-17-39-54 2024 Page 1
ID: mrcY1X_2FQFIXm9hhpx4TmyPVI_-v9oOhtvjJhf qZidJiv1c8drti016 VP32012VF21

12/02/2024

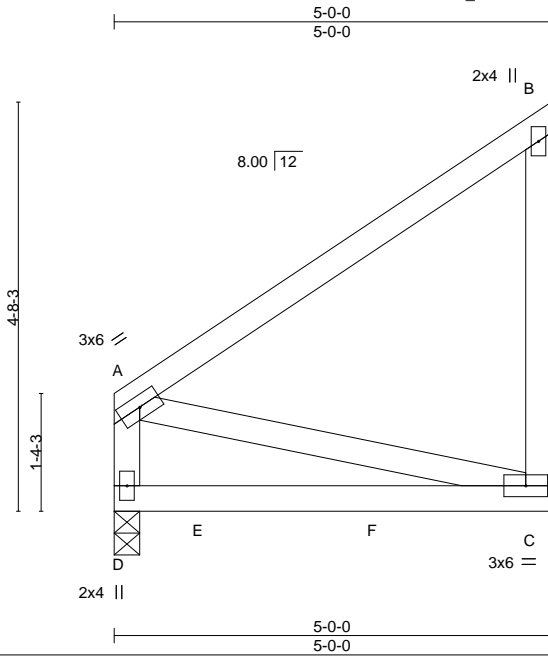

Scale = 1:26.4

LOADING (psf)	SPACING-	CSI.	DEFL.	in (loc)	l/defl	L/d	PLATES	GRIP
TCLL 25.0 (Roof Snow=25.0)	2-0-0 Plate Grip DOL 1.15	TC 0.98	Vert(LL) -0.10	C-D	>567	240	MT20	244/190
TCDL 10.0	Lumber DOL 1.15	BC 0.70	Vert(CT) -0.16	C-D	>357	180		
BCLL 0.0	Rep Stress Incr NO	WB 0.08	Horz(CT) 0.00	C	n/a	n/a		
BCDL 10.0	Code IRC2018/TPI2014	Matrix-MP						
							Weight: 31 lb	FT = 20%

LUMBER-
TOP CHORD 2x4 SP No.2
BOT CHORD 2x4 SP 1650F 1.5E
WEBS 2x4 SP No.3

BRACING-
TOP CHORD Structural wood sheathing directly applied or 5-0-0 oc purlins, except end verticals.
BOT CHORD Rigid ceiling directly applied or 10-0-0 oc bracing.

REACTIONS. (size) D=0-3-8, C=Mechanical
Max Horz D=160(LC 9)
Max Uplift C=-75(LC 9)
Max Grav D=495(LC 18), C=490(LC 18)

FORCES. (lb) - Max. Comp./Max. Ten. - All forces 250 (lb) or less except when shown.
TOP CHORD A-D=-273/82, B-C=-273/99

- NOTES-**
- 1) Wind: ASCE 7-16; Vult=115mph (3-second gust) Vasd=91mph; TCDL=6.0psf; BCDL=6.0psf; h=20ft; Cat. II; Exp C; Enclosed; MWFRS (envelope) gable end zone and C-C Exterior(2E) zone; cantilever left and right exposed ; end vertical left and right exposed;C-C for members and forces & MWFRS for reactions shown; Lumber DOL=1.33 plate grip DOL=1.33
 - 2) TCLL: ASCE 7-16; Pf=25.0 psf (Lum DOL=1.15 Plate DOL=1.15); Is=1.0; Rough Cat C; Fully Exp.; Ce=0.9; Cs=1.00; Ct=1.10
 - 3) Unbalanced snow loads have been considered for this design.
 - 4) This truss has been designed for a 10.0 psf bottom chord live load nonconcurrent with any other live loads.
 - 5) Refer to girder(s) for truss to truss connections.
 - 6) Provide mechanical connection (by others) of truss to bearing plate capable of withstanding 100 lb uplift at joint(s) C.
 - 7) This truss is designed in accordance with the 2018 International Residential Code sections R502.11.1 and R802.10.2 and referenced standard ANSI/TPI 1.
 - 8) Hanger(s) or other connection device(s) shall be provided sufficient to support concentrated load(s) 103 lb down at 1-0-12, and 241 lb down and 22 lb up at 3-0-12 on bottom chord. The design/selection of such connection device(s) is the responsibility of others.
 - 9) In the LOAD CASE(S) section, loads applied to the face of the truss are noted as front (F) or back (B).

LOAD CASE(S) Standard
1) Dead + Snow (balanced): Lumber Increase=1.15, Plate Increase=1.15
Uniform Loads (plf)
Vert: A-B=-70, C-D=-20
Concentrated Loads (lb)
Vert: E=-103(B) F=-241(B)



November 27, 2024

WARNING - Verify design parameters and READ NOTES ON THIS AND INCLUDED MITEK REFERENCE PAGE MII-7473 rev. 1/2/2023 BEFORE USE.

Design valid for use only with MiTek® connectors. This design is based only upon parameters shown, and is for an individual building component, not a truss system. Before use, the building designer must verify the applicability of design parameters and properly incorporate this design into the overall building design. Bracing indicated is to prevent buckling of individual truss web and/or chord members only. Additional temporary and permanent bracing is always required for stability and to prevent collapse with possible personal injury and property damage. For general guidance regarding the fabrication, storage, delivery, erection and bracing of trusses and truss systems, see **ANSI/TPI1 Quality Criteria, and DSB-22** available from Truss Plate Institute (www.tpinst.org) and **BCSI Building Component Safety Information** available from the Structural Building Component Association (www.sbcsccomponents.com)

MiTek®

16023 Swingley Ridge Rd.
Chesterfield, MO 63017
314.434.1200 / MiTek-US.com

Job	Truss	Truss Type	Qty	Ply	GENE BOSLEY RES. / ROOF
242042	68	Jack-Closed	1	1	

RELEASE FOR CONSTRUCTION


AS NOTED FOR PLAN REVIEW

DEVELOPMENT SERVICES

LEE'S SUMMIT, MISSOURI

12/02/2024

Heartland Truss, Inc, Plattsburg, MO - 64477, 8.730 s Oct 31 2024 MiTek Industries, Inc. Wed Nov 27 07:39:54 2024 Page 1

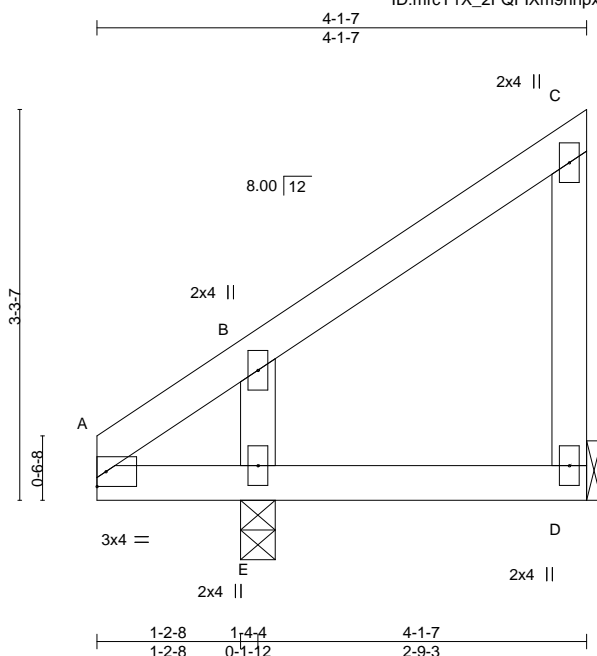

Scale = 1:19.4

LOADING (psf)	SPACING-	CSI.	DEFL.	in (loc)	l/defl	L/d	PLATES	GRIP
TCLL 25.0 (Roof Snow=25.0)	2-0-0 Plate Grip DOL 1.15	TC 0.20	Vert(LL) -0.01	D-E	>999	240	MT20	244/190
TCDL 10.0	Lumber DOL 1.15	BC 0.13	Vert(CT) -0.01	D-E	>999	180		
BCLL 0.0	Rep Stress Incr YES	WB 0.06	Horz(CT) 0.00	D	n/a	n/a		
BCDL 10.0	Code IRC2018/TPI2014	Matrix-MP					Weight: 19 lb	FT = 20%

LUMBER-	BRACING-
TOP CHORD 2x4 SP No.2	TOP CHORD Structural wood sheathing directly applied or 4-1-7 oc purlins, except end verticals.
BOT CHORD 2x4 SP No.2	BOT CHORD Rigid ceiling directly applied or 10-0-0 oc bracing.
WEBS 2x4 SP No.3	


REACTIONS. (size) D=Mechanical, E=0-3-8
 Max Horz E=107(LC 11)
 Max Uplift D=-58(LC 9), E=-14(LC 12)
 Max Grav D=127(LC 18), E=399(LC 18)

FORCES. (lb) - Max. Comp./Max. Ten. - All forces 250 (lb) or less except when shown.
 WEBS B-E=-324/168

- NOTES-**
- 1) Wind: ASCE 7-16; Vult=115mph (3-second gust) Vasd=91mph; TCDL=6.0psf; BCDL=6.0psf; h=20ft; Cat. II; Exp C; Enclosed; MWFRS (envelope) gable end zone and C-C Exterior(2E) zone; cantilever left and right exposed ; end vertical left and right exposed;C-C for members and forces & MWFRS for reactions shown; Lumber DOL=1.33 plate grip DOL=1.33
 - 2) TCLL: ASCE 7-16; Pf=25.0 psf (Lum DOL=1.15 Plate DOL=1.15); Is=1.0; Rough Cat C; Fully Exp.; Ce=0.9; Cs=1.00; Ct=1.10
 - 3) Unbalanced snow loads have been considered for this design.
 - 4) This truss has been designed for a 10.0 psf bottom chord live load nonconcurrent with any other live loads.
 - 5) Refer to girder(s) for truss to truss connections.
 - 6) Provide mechanical connection (by others) of truss to bearing plate capable of withstanding 100 lb uplift at joint(s) D, E.
 - 7) This truss is designed in accordance with the 2018 International Residential Code sections R502.11.1 and R802.10.2 and referenced standard ANSI/TPI 1.



November 27, 2024

<p>WARNING - Verify design parameters and READ NOTES ON THIS AND INCLUDED MITEK REFERENCE PAGE MII-7473 rev. 1/2/2023 BEFORE USE.</p> <p>Design valid for use only with MiTek® connectors. This design is based only upon parameters shown, and is for an individual building component, not a truss system. Before use, the building designer must verify the applicability of design parameters and properly incorporate this design into the overall building design. Bracing indicated is to prevent buckling of individual truss web and/or chord members only. Additional temporary and permanent bracing is always required for stability and to prevent collapse with possible personal injury and property damage. For general guidance regarding the fabrication, storage, delivery, erection and bracing of trusses and truss systems, see ANSI/TPI1 Quality Criteria, and DSB-22 available from Truss Plate Institute (www.tpinst.org) and BCSI Building Component Safety Information available from the Structural Building Component Association (www.sbcsccomponents.com)</p>	 <p>16023 Swingley Ridge Rd. Chesterfield, MO 63017 314.434.1200 / MiTek-US.com</p>
---	--

Job	Truss	Truss Type	Qty	Ply	GENE BOSLEY RES. / ROOF
242042	69	Jack-Closed	5	1	

RELEASE FOR CONSTRUCTION

AS NOTED FOR PLAN REVIEW


DEVELOPMENT SERVICES

LEE'S SUMMIT, MISSOURI

12/02/2024

Heartland Truss, Inc, Plattsburg, MO - 64477,

8.730 s Oct 31 2024 MiTek Industries, Inc. Wed Nov 27 17:39:55 2024 Page 1

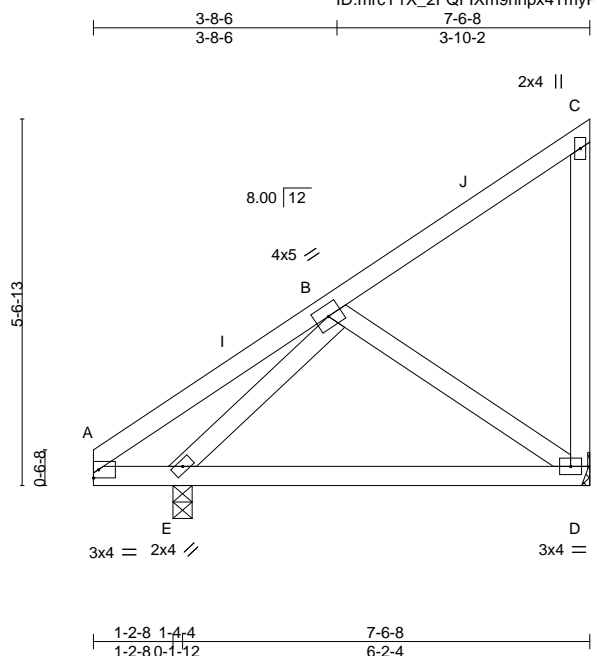

Scale = 1:35.0

LOADING (psf)	SPACING-	CSI.	DEFL.	PLATES	GRIP
TCLL 25.0 (Roof Snow=25.0)	2-0-0 Plate Grip DOL 1.15 Lumber DOL 1.15	TC 0.58 BC 0.35 WB 0.14 Matrix-MP	in (loc) l/defl L/d Vert(LL) -0.05 D-E >999 240 Vert(CT) -0.09 D-E >810 180 Horz(CT) 0.00 D n/a n/a	MT20	244/190
TCDL 10.0	Rep Stress Incr YES				
BCLL 0.0	Code IRC2018/TP12014				
BCDL 10.0				Weight: 44 lb	FT = 20%

LUMBER-	BRACING-
TOP CHORD 2x4 SP No.2	TOP CHORD Structural wood sheathing directly applied or 6-0-0 oc purlins, except end verticals.
BOT CHORD 2x4 SP No.2	BOT CHORD Rigid ceiling directly applied or 10-0-0 oc bracing.
WEBS 2x4 SP No.3	

REACTIONS. (size) D=Mechanical, E=0-3-8
 Max Horz E=193(LC 11)
 Max Uplift D=-76(LC 9), E=-21(LC 12)
 Max Grav D=409(LC 18), E=493(LC 18)

FORCES. (lb) - Max. Comp./Max. Ten. - All forces 250 (lb) or less except when shown.
 BOT CHORD D-E=-112/263
 WEBS B-D=-318/174, B-E=-383/187

- NOTES-**
- 1) Wind: ASCE 7-16; Vult=115mph (3-second gust) Vasd=91mph; TCDL=6.0psf; BCDL=6.0psf; h=20ft; Cat. II; Exp C; Enclosed; MWFRS (envelope) gable end zone and C-C Exterior(2E) zone; cantilever left and right exposed; end vertical left and right exposed; C-C for members and forces & MWFRS for reactions shown; Lumber DOL=1.33 plate grip DOL=1.33
 - 2) TCLL: ASCE 7-16; Pf=25.0 psf (Lum DOL=1.15 Plate DOL=1.15); Is=1.0; Rough Cat C; Fully Exp.; Ce=0.9; Cs=1.00; Ct=1.10
 - 3) Unbalanced snow loads have been considered for this design.
 - 4) This truss has been designed for a 10.0 psf bottom chord live load nonconcurrent with any other live loads.
 - 5) Refer to girder(s) for truss to truss connections.
 - 6) Provide mechanical connection (by others) of truss to bearing plate capable of withstanding 100 lb uplift at joint(s) D, E.
 - 7) This truss is designed in accordance with the 2018 International Residential Code sections R502.11.1 and R802.10.2 and referenced standard ANSI/TP1 1.



November 27, 2024

Job 242042	Truss 70	Truss Type Roof Special	Qty 1	Ply 1	GENE BOSLEY RES. / ROOF
---------------	-------------	----------------------------	----------	----------	-------------------------


AS NOTED FOR PLAN REVIEW
DEVELOPMENT SERVICES
LEE'S SUMMIT, MISSOURI

Heartland Truss, Inc, Plattsburg, MO - 64477,

8.730 s Oct 31 2024 MiTek Industries, Inc. Wed Nov 27 07:39:55 2024 Page 1

ID:mrcY1X_2FQFIxm9hhpx4TmyPVL_NLMnUDvM4?XhBrCVGcZshd166j1VC8ZllZaMYE21

12/02/2024

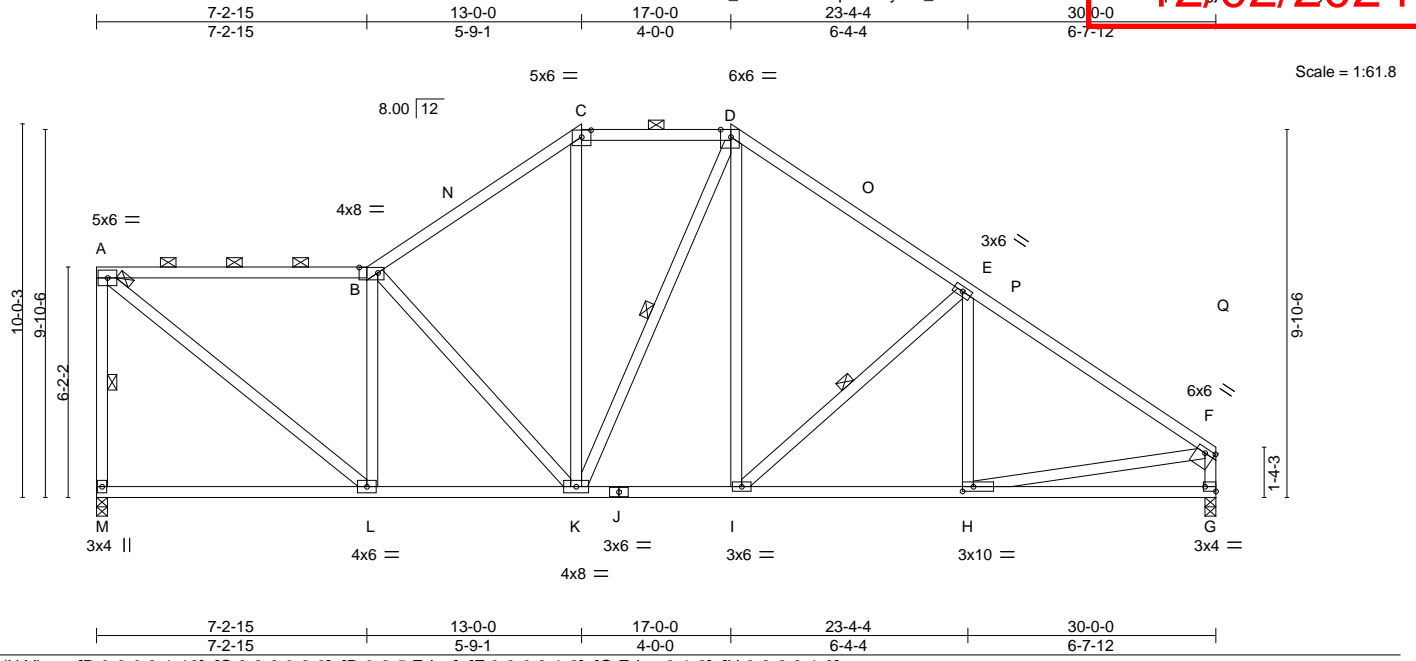

LOADING (psf)	SPACING-	CSI.	DEFL.	PLATES	GRIP
TCLL 25.0 (Roof Snow=25.0)	Plate Grip DOL 1.15 Lumber DOL 1.15 Rep Stress Incr YES Code IRC2018/TPI2014	TC 0.95 BC 0.54 WB 0.82 Matrix-MS	in (loc) l/defl L/d Vert(LL) -0.10 H-I >999 240 Vert(CT) -0.18 L-M >999 180 Horz(CT) 0.04 G n/a n/a	MT20	244/190
TCDL 10.0				Weight: 210 lb	FT = 20%
BCLL 0.0					
BCDL 10.0					

LUMBER-	BRACING-
TOP CHORD 2x4 SP 1650F 1.5E *Except* A-B: 2x4 SP 2400F 2.0E, C-D: 2x4 SP No.2	TOP CHORD Structural wood sheathing directly applied or 2-2-0 oc purlins, except end verticals, and 2-0-0 oc purlins (2-2-0 max.): A-B, C-D.
BOT CHORD 2x4 SP No.2	BOT CHORD Rigid ceiling directly applied or 10-0-0 oc bracing.
WEBS 2x4 SP No.3 *Except* A-M: 2x4 SP No.2	WEBS 1 Row at midpt A-M, D-K, E-I

REACTIONS. (size) M=0-3-8, G=0-3-8
 Max Horz M=-315(LC 8)
 Max Uplift M=-146(LC 12), G=-114(LC 13)
 Max Grav M=1574(LC 33), G=1878(LC 34)

FORCES. (lb) - Max. Comp./Max. Ten. - All forces 250 (lb) or less except when shown.
 TOP CHORD A-M=-1503/194, A-B=-1553/118, B-C=-1743/201, C-D=-1287/218, D-E=-1845/218, E-F=-2372/164, F-G=-1812/148
 BOT CHORD L-M=-209/264, K-L=-66/1525, I-K=0/1320, H-I=-52/1827
 WEBS A-L=-221/1982, B-L=-1109/236, B-K=-438/83, C-K=-48/415, D-L=-75/546, E-L=-664/207, F-H=-11/1619

- NOTES-**
- Wind: ASCE 7-16; Vult=115mph (3-second gust) Vasd=91mph; TCDL=6.0psf; BCDL=6.0psf; h=20ft; Cat. II; Exp C; Enclosed; MWFRS (envelope) gable end zone and C-C Exterior(2E) 0-1-12 to 3-1-12, Interior(1) 3-1-12 to 10-0-0, Exterior(2R) 10-0-0 to 20-0-0, Interior(1) 20-0-0 to 26-10-4, Exterior(2E) 26-10-4 to 29-10-4 zone; cantilever left and right exposed; end vertical left and right exposed; C-C for members and forces & MWFRS for reactions shown; Lumber DOL=1.33 plate grip DOL=1.33
 - TCLL: ASCE 7-16; Pf=25.0 psf (Lum DOL=1.15 Plate DOL=1.15); Is=1.0; Rough Cat C; Fully Exp.; Ce=0.9; Cs=1.00; Ct=1.10
 - Unbalanced snow loads have been considered for this design.
 - Provide adequate drainage to prevent water ponding.
 - This truss has been designed for a 10.0 psf bottom chord live load nonconcurrent with any other live loads.
 - Provide mechanical connection (by others) of truss to bearing plate capable of withstanding 100 lb uplift at joint(s) except (jt=lb) M=146, G=114.
 - This truss is designed in accordance with the 2018 International Residential Code sections R502.11.1 and R802.10.2 and referenced standard ANSI/TPI 1.
 - Graphical purlin representation does not depict the size or the orientation of the purlin along the top and/or bottom chord.



November 27, 2024

Job	Truss	Truss Type	Qty	Ply	GENE BOSLEY RES. / ROOF
242042	71	Roof Special	1	1	

FOR CONSTRUCTION

AS NOTED FOR PLAN REVIEW

DEVELOPMENT SERVICES

LEE'S SUMMIT, MISSOURI

12/02/2024

Heartland Truss, Inc., Plattsburg, MO - 64477, 8.730 s Oct 31 2024 MiTek Industries, Inc. Wed Nov 27 17:39:56 2024 Page 1

ID:mrcY1X_2FQFIXm9hhpx4TmyPVL_rYw9hZw_qJfYp?npK45E24C2N/FromXME763V127H

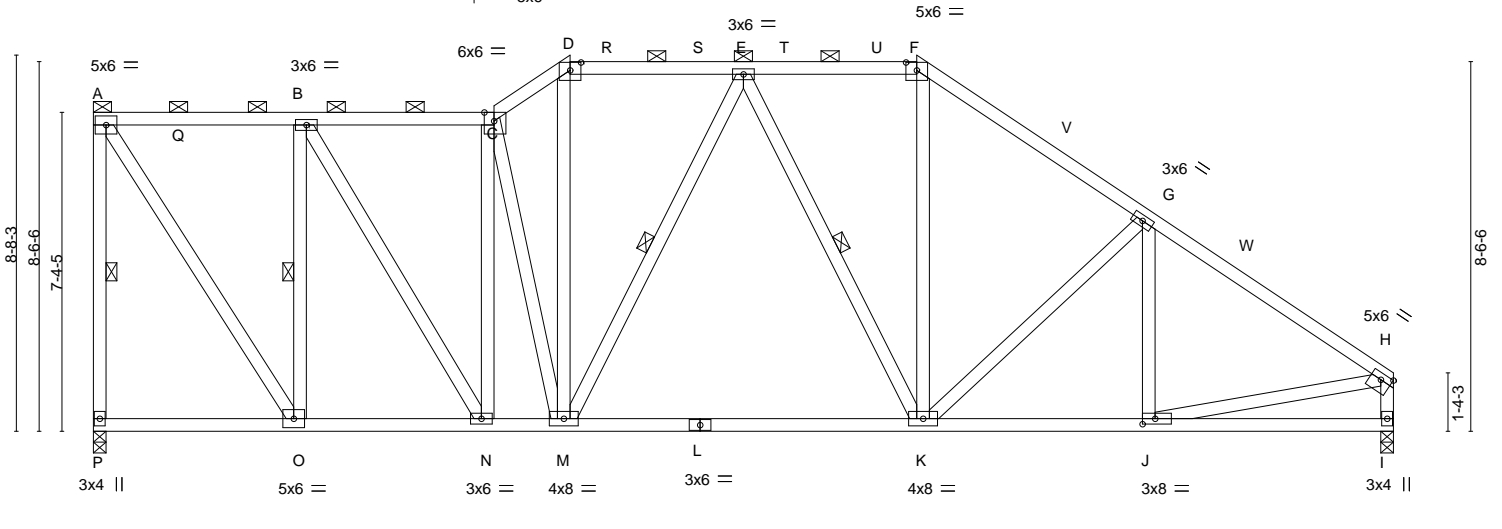


Plate Offsets (X,Y)--	[C:0-2-11,Edge], [D:0-3-0,0-2-3], [F:0-3-0,0-2-3], [H:Edge,0-1-12], [J:0-3-8,0-1-8]
-----------------------	---

LOADING (psf)	SPACING-	CSI.	DEFL.	PLATES	GRIP
TCLL 25.0 (Roof Snow=25.0)	Plate Grip DOL 1.15 Lumber DOL 1.15	TC 0.94 BC 0.61 WB 0.79	in (loc) l/defl L/d Vert(LL) -0.12 K-M >999 240 Vert(CT) -0.26 K-M >999 180 Horz(CT) 0.05 I n/a n/a	MT20	244/190
TCDL 10.0	Rep Stress Incr YES	Matrix-MS			
BCLL 0.0	Code IRC2018/TPI2014				
BCDL 10.0				Weight: 234 lb	FT = 20%

LUMBER-	BRACING-
TOP CHORD 2x4 SP No.2	TOP CHORD Structural wood sheathing directly applied or 2-9-3 oc purlins, except end verticals, and 2-0-0 oc purlins (4-1-3 max.): A-C, D-F.
BOT CHORD 2x4 SP No.2	BOT CHORD Rigid ceiling directly applied or 10-0-0 oc bracing.
WEBS 2x4 SP No.3	WEBS 1 Row at midpt A-P, B-O, E-M, E-K

REACTIONS. (size) P=0-3-8, I=0-3-8
 Max Horz P=-295(LC 8)
 Max Uplift P=-179(LC 8), I=-100(LC 13)
 Max Grav P=1890(LC 34), I=1685(LC 35)

FORCES. (lb) - Max. Comp./Max. Ten. - All forces 250 (lb) or less except when shown.

TOP CHORD A-P=-1847/192, A-B=-1061/87, B-C=-1557/111, C-D=-1785/151, D-E=-1469/144, E-F=-1341/197, F-G=-1663/187, G-H=-2040/145, H-I=-1624/130

BOT CHORD O-P=-175/316, N-O=-115/1061, M-N=-99/1570, K-M=-77/1554, J-K=-50/1557

WEBS A-O=-195/1919, B-O=-1504/246, B-N=-151/942, C-N=-811/118, C-M=-411/85, D-M=-45/736, E-M=-337/113, E-K=-483/165, F-K=0/587, G-K=-491/180, H-J=-17/1407

- NOTES-**
- 1) Wind: ASCE 7-16; Vult=115mph (3-second gust) Vasd=91mph; TCDL=6.0psf; BCDL=6.0psf; h=20ft; Cat. II; Exp C; Enclosed; MWFRS (envelope) gable end zone and C-C Exterior(2E) 0-1-12 to 3-1-12, Interior(1) 3-1-12 to 9-2-15, Exterior(2R) 9-2-15 to 14-0-0, Interior(1) 14-0-0 to 16-0-0, Exterior(2R) 16-0-0 to 22-0-0, Interior(1) 22-0-0 to 26-10-4, Exterior(2E) 26-10-4 to 29-10-4 zone; cantilever left and right exposed ; end vertical left and right exposed; C-C for members and forces & MWFRS for reactions shown; Lumber DOL=1.33 plate grip DOL=1.33
 - 2) TCLL: ASCE 7-16; Pf=25.0 psf (Lum DOL=1.15 Plate DOL=1.15); Is=1.0; Rough Cat C; Fully Exp.; Ce=0.9; Cs=1.00; Ct=1.10
 - 3) Unbalanced snow loads have been considered for this design.
 - 4) Provide adequate drainage to prevent water ponding.
 - 5) This truss has been designed for a 10.0 psf bottom chord live load nonconcurrent with any other live loads.
 - 6) Provide mechanical connection (by others) of truss to bearing plate capable of withstanding 100 lb uplift at joint(s) except (jt=lb) P=179, I=100.
 - 7) This truss is designed in accordance with the 2018 International Residential Code sections R502.11.1 and R802.10.2 and referenced standard ANSI/TPI 1.
 - 8) Graphical purlin representation does not depict the size or the orientation of the purlin along the top and/or bottom chord.




November 27, 2024

Job 242042	Truss 72	Truss Type Roof Special	Qty 1	Ply 1	GENE BOSLEY RES. / ROOF
---------------	-------------	----------------------------	----------	----------	-------------------------

AS NOTED FOR PLAN REVIEW
DEVELOPMENT SERVICES
LEE'S SUMMIT, MISSOURI

Heartland Truss, Inc, Plattsburg, MO - 64477, 8.730 s Oct 31 2024 MiTek Industries, Inc. Wed Nov 27 07:39:57 2024 Page 1
ID: mrcY1X_2FQFIXm9hpx4TmyPVL_-JkUXvvcxpcnQP9MUN1bKbFmrvWUzJcmzgeMYF2TG

12/02/2024

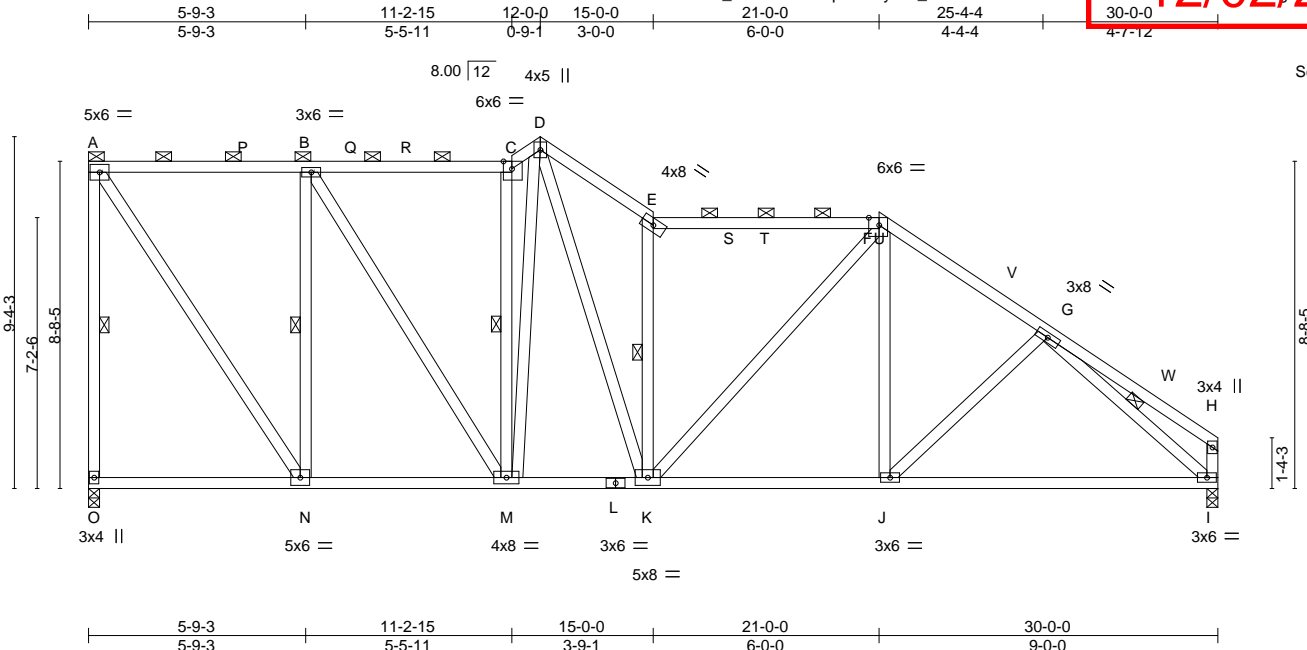

Scale = 1:61.2


Plate Offsets (X, Y)--	[C:0-2-11, Edge], [F:0-3-5, Edge]				
LOADING (psf)	SPACING	CSI	DEFL.	PLATES	GRIP
TCLL 25.0 (Roof Snow=25.0)	2-0-0 Plate Grip DOL 1.15 Lumber DOL 1.15 Rep Stress Incr YES Code IRC2018/TPI2014	TC 1.00 BC 0.71 WB 0.76 Matrix-MS	in (loc) l/defl L/d Vert(LL) -0.15 I-J >999 240 Vert(CT) -0.31 I-J >999 180 Horz(CT) 0.05 I n/a n/a	MT20	244/190
TCDL 10.0					
BCLL 0.0					
BCDL 10.0				Weight: 237 lb	FT = 20%

LUMBER-	BRACING-
TOP CHORD 2x4 SP No.2 *Except* E-F: 2x4 SP 1650F 1.5E	TOP CHORD Structural wood sheathing directly applied or 3-7-1 oc purlins, except end verticals, and 2-0-0 oc purlins (2-2-0 max.): A-C, E-F.
BOT CHORD 2x4 SP No.2	BOT CHORD Rigid ceiling directly applied or 10-0-0 oc bracing.
WEBS 2x4 SP No.3 *Except* A-O: 2x4 SP No.2	WEBS 1 Row at midpt A-O, B-N, C-M, E-K, G-I

REACTIONS. (size) O=0-3-8, I=0-3-8
Max Horz O=-331(LC 8)
Max Uplift O=-171(LC 12), I=-156(LC 13)
Max Grav O=1864(LC 36), I=1658(LC 37)

FORCES. (lb) - Max. Comp./Max. Ten. - All forces 250 (lb) or less except when shown.
TOP CHORD A-O=-1812/190, A-B=-1031/142, B-C=-1384/205, C-D=-1748/257, D-E=-2161/334,
E-F=-1778/231, F-G=-1747/241, G-H=-346/68, H-I=-365/76
BOT CHORD N-O=-185/373, M-N=-80/1031, K-M=-22/1318, J-K=-31/1434, I-J=-141/1485
WEBS A-N=-195/1832, B-N=-1403/256, B-M=-137/752, C-M=-1309/164, D-M=-73/850,
D-K=-282/1411, E-K=-1654/306, F-K=-63/520, F-J=0/343, G-J=-252/220, G-I=-1785/189

- NOTES-**
- 1) Wind: ASCE 7-16; Vult=115mph (3-second gust) Vasd=91mph; TCDL=6.0psf; BCDL=6.0psf; h=20ft; Cat. II; Exp C; Enclosed; MWFRS (envelope) gable end zone and C-C Exterior(2E) 0-1-12 to 3-1-12, Interior(1) 3-1-12 to 11-2-15, Exterior(2R) 11-2-15 to 12-0-0, Exterior(2E) 12-0-0 to 15-0-0, Interior(1) 15-0-0 to 18-0-0, Exterior(2R) 18-0-0 to 24-0-0, Interior(1) 24-0-0 to 26-10-4, Exterior(2E) 26-10-4 to 29-10-4 zone; cantilever left and right exposed ; end vertical left and right exposed; C-C for members and forces & MWFRS for reactions shown; Lumber DOL=1.33 plate grip DOL=1.33
 - 2) TCLL: ASCE 7-16; Pf=25.0 psf (Lum DOL=1.15 Plate DOL=1.15); Is=1.0; Rough Cat C; Fully Exp.; Ce=0.9; Cs=1.00; Ct=1.10
 - 3) Unbalanced snow loads have been considered for this design.
 - 4) Provide adequate drainage to prevent water ponding.
 - 5) This truss has been designed for a 10.0 psf bottom chord live load nonconcurrent with any other live loads.
 - 6) Provide mechanical connection (by others) of truss to bearing plate capable of withstanding 100 lb uplift at joint(s) except (jt=lb) O=171, I=156.
 - 7) This truss is designed in accordance with the 2018 International Residential Code sections R502.11.1 and R802.10.2 and referenced standard ANSI/TPI 1.
 - 8) Graphical purlin representation does not depict the size or the orientation of the purlin along the top and/or bottom chord.

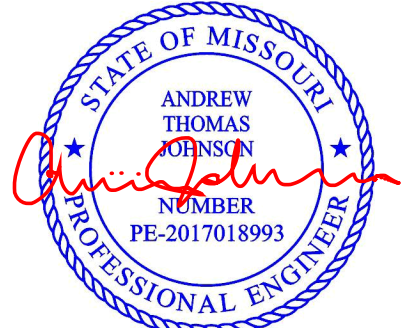

November 27, 2024

Job 242042	Truss 73	Truss Type Roof Special	Qty 1	Ply 1	GENE BOSLEY RES. / ROOF	AS NOTED FOR PLAN REVIEW DEVELOPMENT SERVICES LEE'S SUMMIT, MISSOURI
---------------	-------------	----------------------------	----------	----------	-------------------------	--

Heartland Truss, Inc, Plattsburg, MO - 64477, 8.730 s Oct 31 2024 MiTek Industries, Inc. Wed Nov 27 17:39:58 2024 Page 1
 ID: mrcY1X_2FQFIXm9hpx4TmyPVI_-nw2v6FyEMwvG2Jx4xl6ZITEX5K1Ljnr2JDAyF2F

12/02/2024

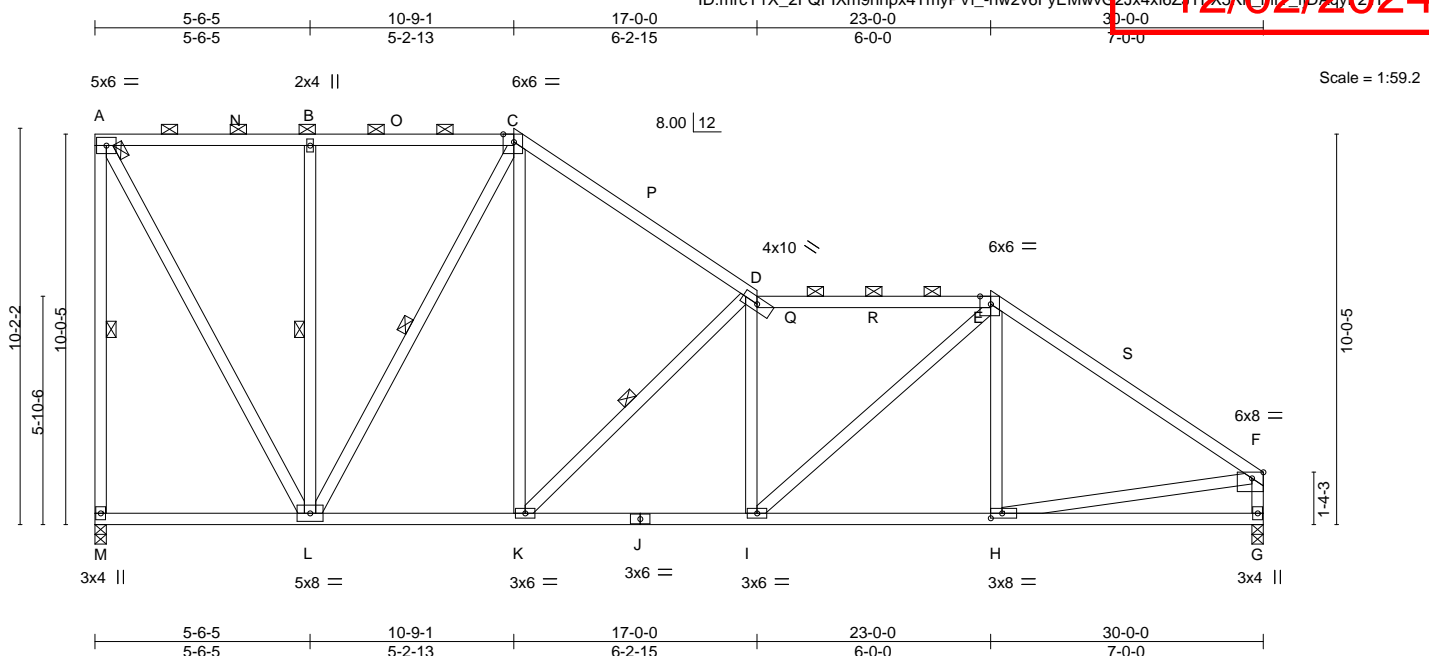


Plate Offsets (X,Y)-- [C:0-3-5,Edge], [E:0-3-5,Edge], [F:0-3-8,Edge], [H:0-3-8,0-1-8]

LOADING (psf)	SPACING-	CSI.	DEFL.	PLATES	GRIP
TCLL 25.0 (Roof Snow=25.0)	2-0-0 Plate Grip DOL 1.15 Lumber DOL 1.15 Rep Stress Incr YES Code IRC2018/TPI2014	TC 0.96 BC 0.57 WB 0.69 Matrix-MS	in (loc) l/defl L/d Vert(LL) -0.11 I >999 240 Vert(CT) -0.19 I-K >999 180 Horz(CT) 0.05 G n/a n/a	MT20	244/190
TCDL 10.0					
BCLL 0.0					
BCDL 10.0					
				Weight: 219 lb	FT = 20%

LUMBER-	BRACING-
TOP CHORD 2x4 SP 2400F 2.0E *Except* A-C: 2x4 SP No.2, C-D: 2x4 SP 1650F 1.5E	TOP CHORD Structural wood sheathing directly applied, except end verticals, and 2-0-0 oc purlins (4-2-11 max.): A-C, D-E.
BOT CHORD 2x4 SP No.2	BOT CHORD Rigid ceiling directly applied or 10-0-0 oc bracing.
WEBS 2x4 SP No.3 *Except* A-M: 2x4 SP 1650F 1.5E, F-G: 2x4 SP No.2	WEBS 1 Row at midpt A-M, B-L, C-L, D-K

REACTIONS. (size) M=0-3-8, G=0-3-8
 Max Horz M=-367(LC 8)
 Max Uplift M=-179(LC 8), G=-159(LC 13)
 Max Grav M=1799(LC 34), G=1638(LC 35)

FORCES. (lb) - Max. Comp./Max. Ten. - All forces 250 (lb) or less except when shown.
 TOP CHORD A-M=-1748/227, A-B=-821/152, B-C=-824/153, C-D=-1445/194, D-E=-2051/257,
 E-F=-1958/206, F-G=-1572/194
 BOT CHORD L-M=-197/442, K-L=-65/1121, I-K=-95/2040, H-I=-83/1470, G-H=-81/335
 WEBS A-L=-234/1677, B-L=-798/180, C-L=-878/189, C-K=-106/953, D-K=-1243/262,
 D-I=-413/98, E-I=-39/787, F-H=-38/1374

- NOTES-**
- 1) Wind: ASCE 7-16; Vult=115mph (3-second gust) Vasd=91mph; TCDL=6.0psf; BCDL=6.0psf; h=20ft; Cat. II; Exp C; Enclosed; MWFRS (envelope) gable end zone and C-C Exterior(2E) 0-1-12 to 3-1-12, Interior(1) 3-1-12 to 7-9-1, Exterior(2R) 7-9-1 to 13-9-1, Interior(1) 13-9-1 to 20-0-0, Exterior(2R) 20-0-0 to 26-0-0, Interior(1) 26-0-0 to 26-10-4, Exterior(2E) 26-10-4 to 29-10-4 zone; cantilever left and right exposed ; end vertical left and right exposed;C-C for members and forces & MWFRS for reactions shown; Lumber DOL=1.33 plate grip DOL=1.33
 - 2) TCLL: ASCE 7-16; Pf=25.0 psf (Lum DOL=1.15 Plate DOL=1.15); Is=1.0; Rough Cat C; Fully Exp.; Ce=0.9; Cs=1.00; Ct=1.10
 - 3) Unbalanced snow loads have been considered for this design.
 - 4) Provide adequate drainage to prevent water ponding.
 - 5) This truss has been designed for a 10.0 psf bottom chord live load nonconcurrent with any other live loads.
 - 6) Provide mechanical connection (by others) of truss to bearing plate capable of withstanding 100 lb uplift at joint(s) except (jt=lb) M=179, G=159.
 - 7) This truss is designed in accordance with the 2018 International Residential Code sections R502.11.1 and R802.10.2 and referenced standard ANSI/TPI 1.
 - 8) Graphical purlin representation does not depict the size or the orientation of the purlin along the top and/or bottom chord.



November 27, 2024

Job 242042	Truss 74	Truss Type Roof Special Girder	Qty 1	Ply 1	GENE BOSLEY RES. / ROOF
---------------	-------------	-----------------------------------	----------	----------	-------------------------


AS NOTED FOR PLAN REVIEW
DEVELOPMENT SERVICES
LEE'S SUMMIT, MISSOURI

Heartland Truss, Inc, Plattsburg, MO - 64477,

8.730 s Oct 31 2024 MiTek Industries, Inc. Wed No 27-17-39-58 2024 Page 1

ID:mrcY1X_2FQFIXm9hhpx4TmyPVL_-nw2v6FyEMwvG2Jx4xl6ZjTFzvkgtidL2jDA4yE2F

12/02/2024

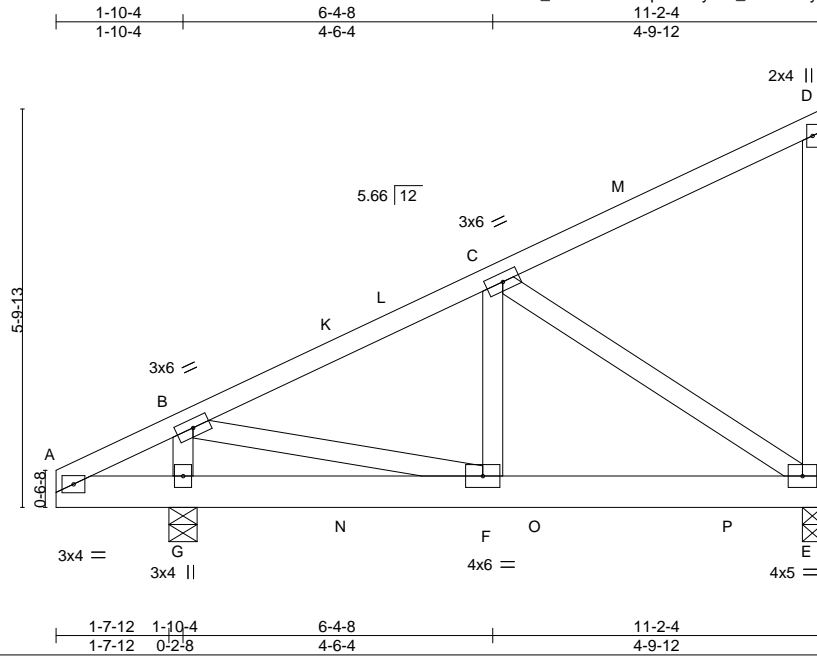

Scale = 1:33.6

LOADING (psf)	SPACING-	CSI.	DEFL.	PLATES	GRIP
TCLL 25.0 (Roof Snow=25.0)	2-0-0 Plate Grip DOL 1.15 Lumber DOL 1.15 Rep Stress Incr NO Code IRC2018/TPI2014	TC 0.53 BC 0.63 WB 0.60 Matrix-MS	in (loc) l/defl L/d Vert(LL) -0.05 E-F >999 240 Vert(CT) -0.06 E-F >999 180 Horz(CT) 0.00 E n/a n/a	MT20	244/190
TCDL 10.0				Weight: 72 lb	FT = 20%
BCLL 0.0					
BCDL 10.0					

LUMBER-
TOP CHORD 2x4 SP No.2
BOT CHORD 2x6 SP No.1
WEBS 2x4 SP No.3

BRACING-
TOP CHORD Structural wood sheathing directly applied or 5-9-0 oc purlins, except end verticals.
BOT CHORD Rigid ceiling directly applied or 6-0-0 oc bracing.

REACTIONS. (size) G=0-4-15, E=0-3-8
Max Horz G=187(LC 11)
Max Uplift G=-178(LC 12), E=-325(LC 12)
Max Grav G=907(LC 18), E=1350(LC 18)

FORCES. (lb) - Max. Comp./Max. Ten. - All forces 250 (lb) or less except when shown.
TOP CHORD B-C=-999/309
BOT CHORD F-G=-202/252, E-F=-258/849
WEBS B-G=-878/369, B-F=-227/904, C-F=-156/508, C-E=-995/404

- NOTES-**
- 1) Wind: ASCE 7-16; Vult=115mph (3-second gust) Vasd=91mph; TCDL=6.0psf; BCDL=6.0psf; h=20ft; Cat. II; Exp C; Enclosed; MWFRS (envelope) gable end zone and C-C Corner(3) 0-0-0 to 4-2-15, Exterior(2R) 4-2-15 to 11-0-8 zone; cantilever left and right exposed ; end vertical left and right exposed;C-C for members and forces & MWFRS for reactions shown; Lumber DOL=1.33 plate grip DOL=1.33
 - 2) TCLL: ASCE 7-16; Pf=25.0 psf (Lum DOL=1.15 Plate DOL=1.15); Is=1.0; Rough Cat C; Fully Exp.; Ce=0.9; Cs=1.00; Ct=1.10
 - 3) Unbalanced snow loads have been considered for this design.
 - 4) This truss has been designed for a 10.0 psf bottom chord live load nonconcurrent with any other live loads.
 - 5) Provide mechanical connection (by others) of truss to bearing plate capable of withstanding 100 lb uplift at joint(s) except (jt=lb) G=178, E=325.
 - 6) This truss is designed in accordance with the 2018 International Residential Code sections R502.11.1 and R802.10.2 and referenced standard ANSI/TPI 1.
 - 7) Hanger(s) or other connection device(s) shall be provided sufficient to support concentrated load(s) 97 lb down and 76 lb up at 4-2-13, and 97 lb down and 76 lb up at 4-2-13 on top chord, and 12 lb down and 22 lb up at 4-2-13, 12 lb down and 22 lb up at 4-2-13, 169 lb down and 90 lb up at 7-0-12, 169 lb down and 90 lb up at 7-0-12, and 344 lb down and 101 lb up at 9-10-11, and 344 lb down and 101 lb up at 9-10-11 on bottom chord. The design/selection of such connection device(s) is the responsibility of others.
 - 8) In the LOAD CASE(S) section, loads applied to the face of the truss are noted as front (F) or back (B).

LOAD CASE(S) Standard
1) Dead + Snow (balanced): Lumber Increase=1.15, Plate Increase=1.15
Uniform Loads (plf)
Vert: A-D=-70, E-H=-20
Concentrated Loads (lb)
Vert: O=-339(F=-169, B=-169) P=-688(F=-344, B=-344)



November 27, 2024

Job	Truss	Truss Type	Qty	Ply	GENE BOSLEY RES. / ROOF
242042	75	Roof Special Girder	1	1	

AS NOTED FOR PLAN REVIEW
DEVELOPMENT SERVICES
LEE'S SUMMIT, MISSOURI


Heartland Truss, Inc, Plattsburg, MO - 64477,

8.730 s Oct 31 2024 MiTek Industries, Inc.

Wed Nov 27 17:39:59 2024 Page 1

ID:mrcY1X_2FQFIXm9hhpx4TmyPVL_-F7cHKbz7E17gTVGVSDorjopj0RFB3DjShjQVf21E

12/02/2024

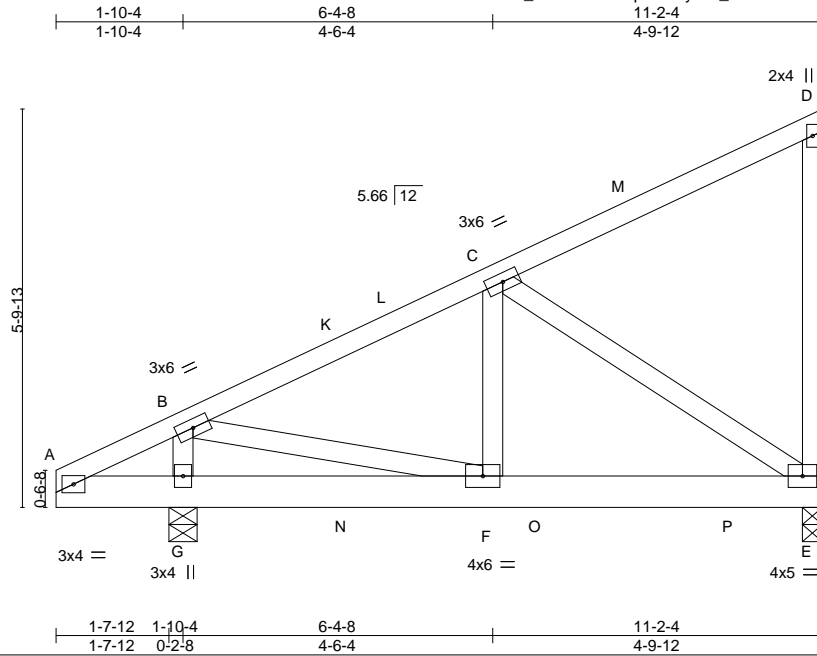

Scale = 1:33.6

LOADING (psf)	SPACING-	CSI.	DEFL.	PLATES	GRIP
TCLL 25.0 (Roof Snow=25.0)	2-0-0 Plate Grip DOL 1.15 Lumber DOL 1.15 Rep Stress Incr NO Code IRC2018/TPI2014	TC 0.53 BC 0.63 WB 0.60 Matrix-MS	in (loc) l/defl L/d Vert(LL) -0.05 E-F >999 240 Vert(CT) -0.06 E-F >999 180 Horz(CT) 0.00 E n/a n/a	MT20	244/190
TCDL 10.0				Weight: 72 lb	FT = 20%
BCLL 0.0					
BCDL 10.0					

LUMBER-
TOP CHORD 2x4 SP No.2
BOT CHORD 2x6 SP No.1
WEBS 2x4 SP No.3

BRACING-
TOP CHORD Structural wood sheathing directly applied or 5-9-0 oc purlins, except end verticals.
BOT CHORD Rigid ceiling directly applied or 6-0-0 oc bracing.

REACTIONS. (size) G=0-4-15, E=0-3-8
Max Horz G=187(LC 11)
Max Uplift G=-178(LC 12), E=-325(LC 12)
Max Grav G=907(LC 18), E=1350(LC 18)

FORCES. (lb) - Max. Comp./Max. Ten. - All forces 250 (lb) or less except when shown.
TOP CHORD B-C=-999/309
BOT CHORD F-G=-202/252, E-F=-258/849
WEBS B-G=-878/369, B-F=-227/904, C-F=-156/508, C-E=-995/404

NOTES-

- 1) Wind: ASCE 7-16; Vult=115mph (3-second gust) Vasd=91mph; TCDL=6.0psf; BCDL=6.0psf; h=20ft; Cat. II; Exp C; Enclosed; MWFRS (envelope) gable end zone and C-C Corner(3) 0-0-0 to 4-2-15, Exterior(2R) 4-2-15 to 11-0-8 zone; cantilever left and right exposed ; end vertical left and right exposed;C-C for members and forces & MWFRS for reactions shown; Lumber DOL=1.33 plate grip DOL=1.33
- 2) TCLL: ASCE 7-16; Pf=25.0 psf (Lum DOL=1.15 Plate DOL=1.15); Is=1.0; Rough Cat C; Fully Exp.; Ce=0.9; Cs=1.00; Ct=1.10
- 3) Unbalanced snow loads have been considered for this design.
- 4) This truss has been designed for a 10.0 psf bottom chord live load nonconcurrent with any other live loads.
- 5) Provide mechanical connection (by others) of truss to bearing plate capable of withstanding 100 lb uplift at joint(s) except (jt=lb) G=178, E=325.
- 6) This truss is designed in accordance with the 2018 International Residential Code sections R502.11.1 and R802.10.2 and referenced standard ANSI/TPI 1.
- 7) Hanger(s) or other connection device(s) shall be provided sufficient to support concentrated load(s) 97 lb down and 76 lb up at 4-2-13, and 97 lb down and 76 lb up at 4-2-13 on top chord, and 12 lb down and 22 lb up at 4-2-13, 12 lb down and 22 lb up at 4-2-13, 169 lb down and 90 lb up at 7-0-12, 169 lb down and 90 lb up at 7-0-12, and 344 lb down and 101 lb up at 9-10-11, and 344 lb down and 101 lb up at 9-10-11 on bottom chord. The design/selection of such connection device(s) is the responsibility of others.
- 8) In the LOAD CASE(S) section, loads applied to the face of the truss are noted as front (F) or back (B).

LOAD CASE(S) Standard
1) Dead + Snow (balanced): Lumber Increase=1.15, Plate Increase=1.15
Uniform Loads (plf)
Vert: A-D=-70, E-H=-20
Concentrated Loads (lb)
Vert: O=-339(F=-169, B=-169) P=-688(F=-344, B=-344)



November 27, 2024

Job	Truss	Truss Type	Qty	Ply	GENE BOSLEY RES. / ROOF
242042	76	Monopitch	7	1	

RELEASE FOR CONSTRUCTION

AS NOTED FOR PLAN REVIEW

DEVELOPMENT SERVICES

LEE'S SUMMIT, MISSOURI

12/02/2024


Heartland Truss, Inc, Plattsburg, MO - 64477,

8.730 s Oct 31 2024 MiTek Industries, Inc.

Wed Nov 27 07:39:59 2024 Page 1

ID:mrcY1X_2FQFIXm9hhpx4TmyPVI_-F7cHKbzs7E17gTW

3V5dorgonejshR1MF8DUSnjCYF2E

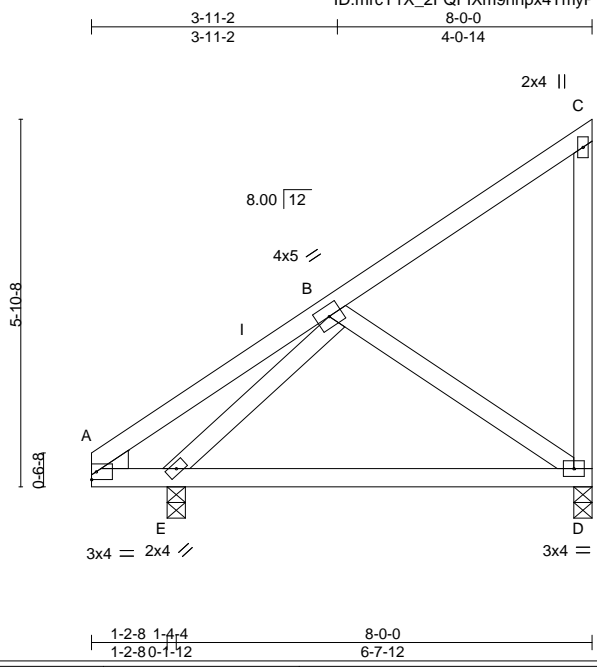

Scale = 1:36.8

LOADING (psf)	SPACING-	CSI.	DEFL.	PLATES	GRIP
TCLL 25.0 (Roof Snow=25.0)	2-0-0 Plate Grip DOL 1.15 Lumber DOL 1.15	TC 0.66 BC 0.41 WB 0.16 Matrix-MP	in (loc) l/defl L/d Vert(LL) -0.06 D-E >999 240 Vert(CT) -0.12 D-E >657 180 Horz(CT) 0.00 D n/a n/a	MT20	244/190
TCDL 10.0	Rep Stress Incr YES				
BCLL 0.0	Code IRC2018/TPI2014				
BCDL 10.0				Weight: 47 lb	FT = 20%

LUMBER-	BRACING-
TOP CHORD 2x4 SP No.2	TOP CHORD Structural wood sheathing directly applied or 6-0-0 oc purlins, except end verticals.
BOT CHORD 2x4 SP No.2	BOT CHORD Rigid ceiling directly applied or 10-0-0 oc bracing.
WEBS 2x4 SP No.3	
WEDGE	
Left: 2x4 SP No.3	

REACTIONS. (size) D=0-3-8, E=0-3-8
 Max Horz E=205(LC 11)
 Max Uplift D=93(LC 12), E=25(LC 12)
 Max Grav D=437(LC 18), E=506(LC 18)

FORCES. (lb) - Max. Comp./Max. Ten. - All forces 250 (lb) or less except when shown.
 BOT CHORD D-E=-117/299
 WEBS B-D=-342/208, B-E=-385/204

NOTES-

- 1) Wind: ASCE 7-16; Vult=115mph (3-second gust) Vasd=91mph; TCDL=6.0psf; BCDL=6.0psf; h=20ft; Cat. II; Exp C; Enclosed; MWFRS (envelope) gable end zone and C-C Exterior(2E) 0-0-0 to 3-0-0, Interior(1) 3-0-0 to 4-10-4, Exterior(2E) 4-10-4 to 7-10-4 zone; cantilever left and right exposed; end vertical left and right exposed; C-C for members and forces & MWFRS for reactions shown; Lumber DOL=1.33 plate grip DOL=1.33
- 2) TCLL: ASCE 7-16; Pf=25.0 psf (Lum DOL=1.15 Plate DOL=1.15); Is=1.0; Rough Cat C; Fully Exp.; Ce=0.9; Cs=1.00; Ct=1.10
- 3) Unbalanced snow loads have been considered for this design.
- 4) This truss has been designed for a 10.0 psf bottom chord live load nonconcurrent with any other live loads.
- 5) Provide mechanical connection (by others) of truss to bearing plate capable of withstanding 100 lb uplift at joint(s) D, E.
- 6) This truss is designed in accordance with the 2018 International Residential Code sections R502.11.1 and R802.10.2 and referenced standard ANSI/TPI 1.



November 27, 2024

Job	Truss	Truss Type	Qty	Ply	GENE BOSLEY RES. / ROOF
242042	77	Jack-Closed	4	1	

RELEASE FOR CONSTRUCTION

AS NOTED FOR PLAN REVIEW

DEVELOPMENT SERVICES

LEE'S SUMMIT, MISSOURI

12/02/2024


Heartland Truss, Inc, Plattsburg, MO - 64477,

8.730 s Oct 31 2024 MiTek Industries, Inc.

Wed Nov 27 09:59:20 2024 Page 1

ID:mrcY1X_2FQFIXm9hhpx4TmyPVL_F7cHKbzs7E17gTW

GVSDorgbajcoRUH8PUSnjCYF21E

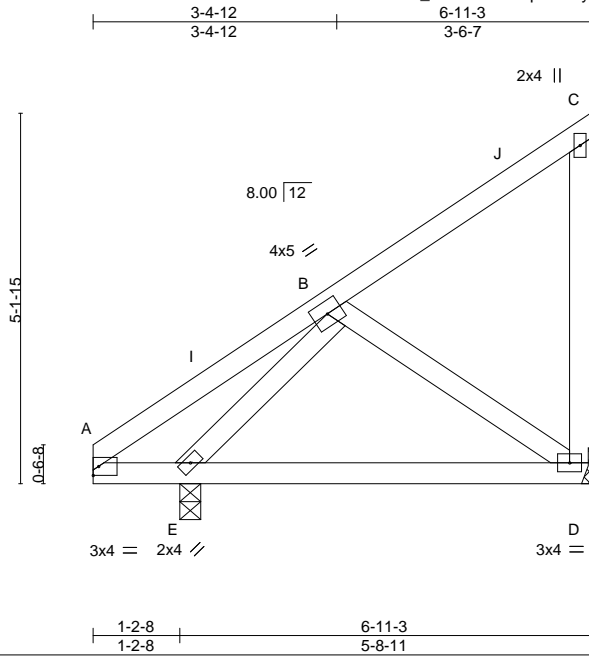

LOADING (psf)	SPACING-	CSI.	DEFL.	PLATES	GRIP
TCLL 25.0 (Roof Snow=25.0)	2-0-0 Plate Grip DOL 1.15	TC 0.49	in (loc) l/defl L/d	MT20	244/190
TCDL 10.0	Lumber DOL 1.15	BC 0.28	Vert(LL) -0.03 D-E >999 240		
BCLL 0.0	Rep Stress Incr YES	WB 0.11	Vert(CT) -0.06 D-E >999 180		
BCDL 10.0	Code IRC2018/TP12014	Matrix-MP	Horz(CT) 0.00 D n/a n/a	Weight: 40 lb	FT = 20%

LUMBER-
 TOP CHORD 2x4 SP No.2
 BOT CHORD 2x4 SP No.2
 WEBS 2x4 SP No.3

BRACING-
 TOP CHORD Structural wood sheathing directly applied or 6-0-0 oc purlins, except end verticals.
 BOT CHORD Rigid ceiling directly applied or 6-0-0 oc bracing.

REACTIONS. (size) D=Mechanical, E=0-3-8
 Max Horz E=178(LC 11)
 Max Uplift D=-75(LC 12), E=-17(LC 12)
 Max Grav D=369(LC 18), E=478(LC 18)

FORCES. (lb) - Max. Comp./Max. Ten. - All forces 250 (lb) or less except when shown.
 WEBS B-D=-284/163, B-E=-378/174

- NOTES-**
- 1) Wind: ASCE 7-16; Vult=115mph (3-second gust) Vasd=91mph; TCDL=6.0psf; BCDL=6.0psf; h=20ft; Cat. II; Exp C; Enclosed; MWFRS (envelope) gable end zone and C-C Exterior(2E) zone; cantilever left and right exposed ; end vertical left and right exposed;C-C for members and forces & MWFRS for reactions shown; Lumber DOL=1.33 plate grip DOL=1.33
 - 2) TCLL: ASCE 7-16; Pf=25.0 psf (Lum DOL=1.15 Plate DOL=1.15); Is=1.0; Rough Cat C; Fully Exp.; Ce=0.9; Cs=1.00; Ct=1.10
 - 3) Unbalanced snow loads have been considered for this design.
 - 4) This truss has been designed for a 10.0 psf bottom chord live load nonconcurrent with any other live loads.
 - 5) Refer to girder(s) for truss to truss connections.
 - 6) Provide mechanical connection (by others) of truss to bearing plate capable of withstanding 100 lb uplift at joint(s) D, E.
 - 7) This truss is designed in accordance with the 2018 International Residential Code sections R502.11.1 and R802.10.2 and referenced standard ANSI/TPI 1.



November 27, 2024

Job	Truss	Truss Type	Qty	Ply	GENE BOSLEY RES. / ROOF
242042	78	Jack-Closed	4	1	


AS NOTED FOR PLAN REVIEW
DEVELOPMENT SERVICES
LEE'S SUMMIT, MISSOURI

Heartland Truss, Inc, Plattsburg, MO - 64477,

8.730 s Oct 31 2024 MiTek Industries, Inc. Wed Nov 27 17:46:00 2024 Page 1

ID: mrcY1X_2FQFIxm9hhpx4TmyPVL_jJAqXxzUuX9_Id5T2A81OjK23751AgV5zGKfM2D

12/02/2024

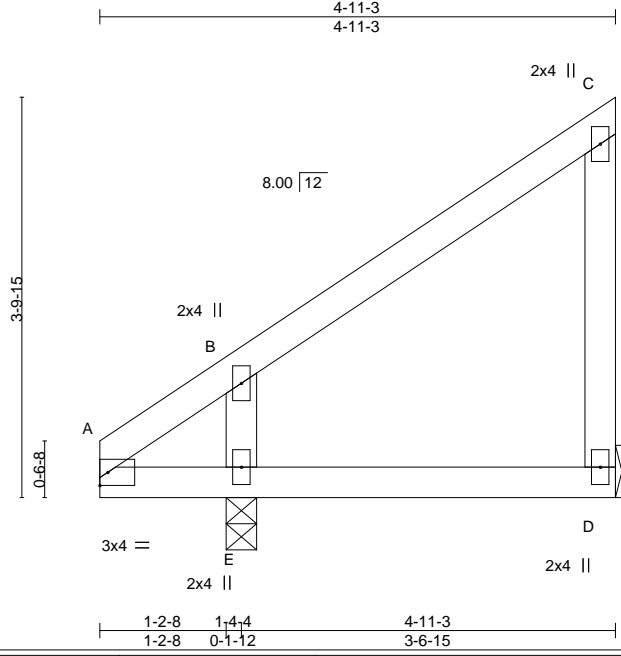

Scale = 1:22.0

LOADING (psf)	SPACING-	CSI.	DEFL.	PLATES	GRIP
TCLL 25.0 (Roof Snow=25.0)	2-0-0 Plate Grip DOL 1.15 Lumber DOL 1.15	TC 0.29 BC 0.20 WB 0.08 Matrix-MP	in (loc) l/defl L/d Vert(LL) 0.01 D-E >999 240 Vert(CT) -0.02 D-E >999 180 Horz(CT) 0.00 D n/a n/a	MT20	244/190
TCDL 10.0	Rep Stress Incr YES				
BCLL 0.0	Code IRC2018/TPI2014				
BCDL 10.0				Weight: 23 lb	FT = 20%

LUMBER-
TOP CHORD 2x4 SP No.2
BOT CHORD 2x4 SP No.2
WEBS 2x4 SP No.3

BRACING-
TOP CHORD Structural wood sheathing directly applied or 4-11-3 oc purlins, except end verticals.
BOT CHORD Rigid ceiling directly applied or 10-0-0 oc bracing.

REACTIONS. (size) D=Mechanical, E=0-3-8
Max Horz E=127(LC 11)
Max Uplift D=-62(LC 9), E=-16(LC 12)
Max Grav D=198(LC 18), E=455(LC 18)

FORCES. (lb) - Max. Comp./Max. Ten. - All forces 250 (lb) or less except when shown.
WEBS B-E=-417/211

- NOTES-**
- 1) Wind: ASCE 7-16; Vult=115mph (3-second gust) Vasd=91mph; TCDL=6.0psf; BCDL=6.0psf; h=20ft; Cat. II; Exp C; Enclosed; MWFRS (envelope) gable end zone and C-C Exterior(2E) zone; cantilever left and right exposed ; end vertical left and right exposed;C-C for members and forces & MWFRS for reactions shown; Lumber DOL=1.33 plate grip DOL=1.33
 - 2) TCLL: ASCE 7-16; Pf=25.0 psf (Lum DOL=1.15 Plate DOL=1.15); Is=1.0; Rough Cat C; Fully Exp.; Ce=0.9; Cs=1.00; Ct=1.10
 - 3) Unbalanced snow loads have been considered for this design.
 - 4) This truss has been designed for a 10.0 psf bottom chord live load nonconcurrent with any other live loads.
 - 5) Refer to girder(s) for truss to truss connections.
 - 6) Provide mechanical connection (by others) of truss to bearing plate capable of withstanding 100 lb uplift at joint(s) D, E.
 - 7) This truss is designed in accordance with the 2018 International Residential Code sections R502.11.1 and R802.10.2 and referenced standard ANSI/TPI 1.




November 27, 2024

Job	Truss	Truss Type	Qty	Ply	GENE BOSLEY RES. / ROOF
242042	79	Jack-Open	4	1	

RELEASE FOR CONSTRUCTION
AS NOTED FOR PLAN REVIEW
DEVELOPMENT SERVICES
LEE'S SUMMIT, MISSOURI
12/02/2024

Heartland Truss, Inc, Plattsburg, MO - 64477, 8.730 s Oct 31 2024 MiTek Industries, Inc. Wed Nov 27 17:46:00 2024 Page 1
 ID: mrcY1X_2FQFIXm9hpx4TmyPVI_-jAgXxzUuX9_Id572A81Ouk4R7UUAarJISZGKFKM2D

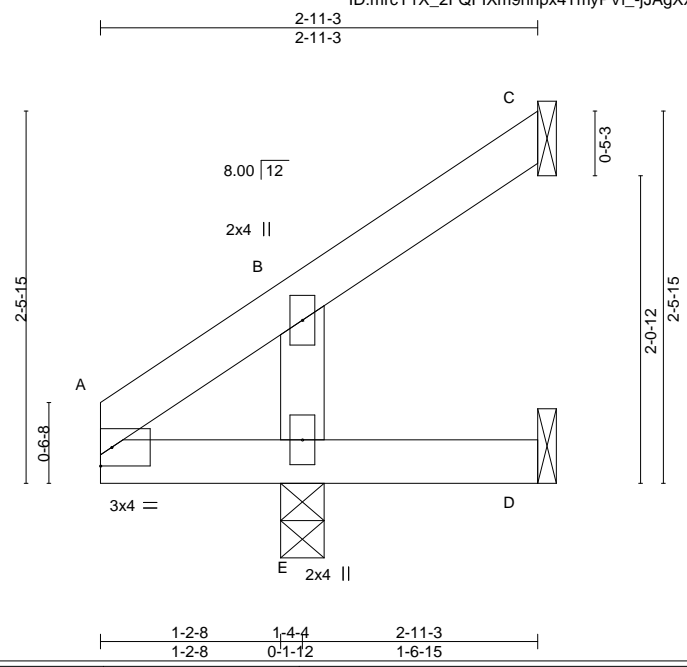

Scale = 1:15.5

LOADING (psf)	SPACING-	CSI.	DEFL.	in (loc)	l/defl	L/d	PLATES	GRIP
TCLL 25.0 (Roof Snow=25.0)	2-0-0 Plate Grip DOL 1.15 Lumber DOL 1.15	TC 0.14 BC 0.12 WB 0.05 Matrix-MP	Vert(LL) 0.00 Vert(CT) 0.00 Horz(CT) -0.01	D-E D-E C	>999 >999 n/a	240 180 n/a	MT20	244/190
TCDL 10.0	Rep Stress Incr YES Code IRC2018/TPI2014						Weight: 11 lb	FT = 20%
BCLL 0.0								
BCDL 10.0								

LUMBER-	BRACING-
TOP CHORD 2x4 SP No.2	TOP CHORD Structural wood sheathing directly applied or 2-11-3 oc purlins.
BOT CHORD 2x4 SP No.2	BOT CHORD Rigid ceiling directly applied or 10-0-0 oc bracing.
WEBS 2x4 SP No.3	

REACTIONS. (size) C=Mechanical, D=Mechanical, E=0-3-8
 Max Horz E=74(LC 12)
 Max Uplift C=-46(LC 12), D=-21(LC 18)
 Max Grav C=40(LC 18), D=14(LC 10), E=342(LC 18)

FORCES. (lb) - Max. Comp./Max. Ten. - All forces 250 (lb) or less except when shown.

- NOTES-**
- 1) Wind: ASCE 7-16; Vult=115mph (3-second gust) Vasd=91mph; TCDL=6.0psf; BCDL=6.0psf; h=20ft; Cat. II; Exp C; Enclosed; MWFRS (envelope) gable end zone and C-C Exterior(2E) zone; cantilever left and right exposed; end vertical left and right exposed; C-C for members and forces & MWFRS for reactions shown; Lumber DOL=1.33 plate grip DOL=1.33
 - 2) TCLL: ASCE 7-16; Pf=25.0 psf (Lum DOL=1.15 Plate DOL=1.15); Is=1.0; Rough Cat C; Fully Exp.; Ce=0.9; Cs=1.00; Ct=1.10
 - 3) Unbalanced snow loads have been considered for this design.
 - 4) This truss has been designed for a 10.0 psf bottom chord live load nonconcurrent with any other live loads.
 - 5) Refer to girder(s) for truss to truss connections.
 - 6) Provide mechanical connection (by others) of truss to bearing plate capable of withstanding 100 lb uplift at joint(s) C, D.
 - 7) This truss is designed in accordance with the 2018 International Residential Code sections R502.11.1 and R802.10.2 and referenced standard ANSI/TPI 1.



November 27, 2024

Job 242042	Truss 80	Truss Type Valley	Qty 1	Ply 1	GENE BOSLEY RES. / ROOF
---------------	-------------	----------------------	----------	----------	-------------------------

RELEASE FOR CONSTRUCTION

AS NOTED FOR PLAN REVIEW


DEVELOPMENT SERVICES

LEE'S SUMMIT, MISSOURI


12/02/2024

Heartland Truss, Inc, Plattsburg, MO - 64477,

8.730 s Oct 31 2024 MiTek Industries, Inc. Wed Nov 27 17:46:01 2024 Page 1
 ID: mrcY1X_2FQFIXm9hpx4TmyPVI_-BVj2IG_7frHqyngctfG_512bXqVhfrPgdktppvY2

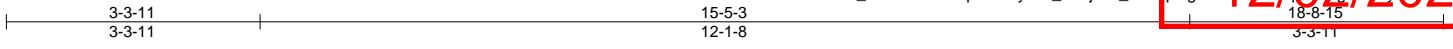

Scale = 1:30.0

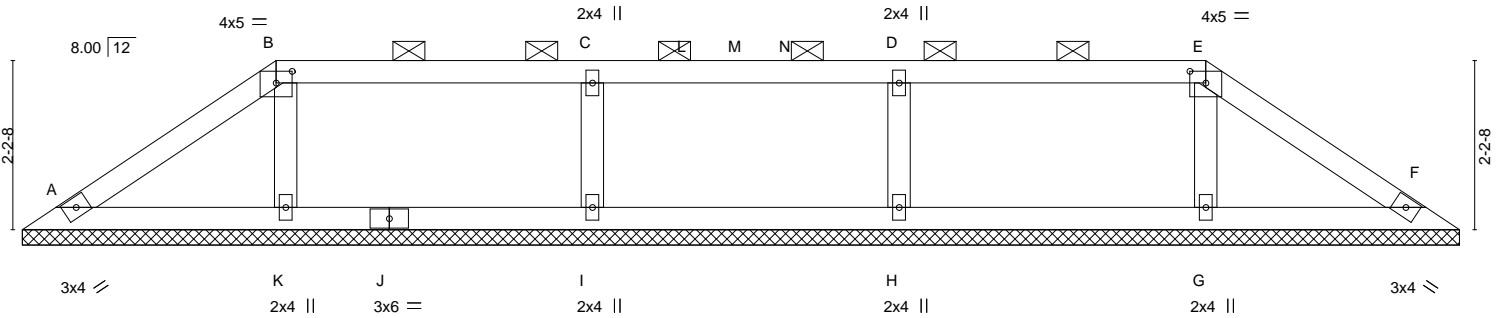

18-8-15
18-8-15

Plate Offsets (X, Y)-- [B:0-2-8,0-1-13], [E:0-2-8,0-1-13]

LOADING (psf)	SPACING-	CSI.	DEFL.	PLATES	GRIP
TCLL 25.0 (Roof Snow=25.0)	2-0-0 Plate Grip DOL 1.15 Lumber DOL 1.15 Rep Stress Incr YES Code IRC2018/TPI2014	TC 0.43 BC 0.11 WB 0.11 Matrix-S	in (loc) l/defl L/d Vert(LL) n/a - n/a 999 Vert(CT) n/a - n/a 999 Horz(CT) 0.00 F n/a n/a	MT20	244/190
TCDL 10.0				Weight: 66 lb	FT = 20%
BCLL 0.0					
BCDL 10.0					


LUMBER-
 TOP CHORD 2x4 SP No.2
 BOT CHORD 2x4 SP No.2
 OTHERS 2x4 SP No.3

BRACING-
 TOP CHORD Structural wood sheathing directly applied or 6-0-0 oc purlins, except 2-0-0 oc purlins (6-0-0 max.); B-E.
 BOT CHORD Rigid ceiling directly applied or 10-0-0 oc bracing.

REACTIONS. All bearings 18-8-15.
 (lb) - Max Horz A=-47(LC 8)
 Max Uplift All uplift 100 lb or less at joint(s) A, F, G, H, I, K
 Max Grav All reactions 250 lb or less at joint(s) A, F except G=355(LC 31), H=618(LC 31), I=631(LC 31), K=353(LC 31)

FORCES. (lb) - Max. Comp./Max. Ten. - All forces 250 (lb) or less except when shown.
WEBS E-G=-279/86, D-H=-537/117, C-I=-550/119, B-K=-276/95

- NOTES-**
- 1) Wind: ASCE 7-16; Vult=115mph (3-second gust) Vasd=91mph; TCDL=6.0psf; BCDL=6.0psf; h=20ft; Cat. II; Exp C; Enclosed; MWFRS (envelope) gable end zone and C-C Exterior(2E) 0-5-12 to 3-3-11, Exterior(2R) 3-3-11 to 7-5-3, Interior(1) 7-5-3 to 11-2-5, Exterior(2R) 11-2-5 to 15-5-3, Exterior(2E) 15-5-3 to 18-3-2 zone; cantilever left and right exposed ; end vertical left and right exposed; C-C for members and forces & MWFRS for reactions shown; Lumber DOL=1.33 plate grip DOL=1.33
 - 2) TCLL: ASCE 7-16; Pf=25.0 psf (Lum DOL=1.15 Plate DOL=1.15); Is=1.0; Rough Cat C; Fully Exp.; Ce=0.9; Cs=1.00; Ct=1.10
 - 3) Unbalanced snow loads have been considered for this design.
 - 4) Provide adequate drainage to prevent water ponding.
 - 5) Gable requires continuous bottom chord bearing.
 - 6) This truss has been designed for a 10.0 psf bottom chord live load nonconcurrent with any other live loads.
 - 7) Provide mechanical connection (by others) of truss to bearing plate capable of withstanding 100 lb uplift at joint(s) A, F, G, H, I, K.
 - 8) This truss is designed in accordance with the 2018 International Residential Code sections R502.11.1 and R802.10.2 and referenced standard ANSI/TPI 1.
 - 9) Graphical purlin representation does not depict the size or the orientation of the purlin along the top and/or bottom chord.

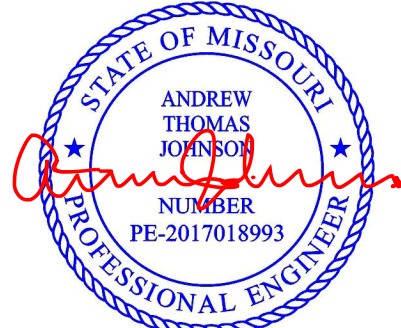

November 27, 2024

WARNING - Verify design parameters and READ NOTES ON THIS AND INCLUDED MITEK REFERENCE PAGE MII-7473 rev. 1/2/2023 BEFORE USE.
 Design valid for use only with MiTek® connectors. This design is based only upon parameters shown, and is for an individual building component, not a truss system. Before use, the building designer must verify the applicability of design parameters and properly incorporate this design into the overall building design. Bracing indicated is to prevent buckling of individual truss web and/or chord members only. Additional temporary and permanent bracing is always required for stability and to prevent collapse with possible personal injury and property damage. For general guidance regarding the fabrication, storage, delivery, erection and bracing of trusses and truss systems, see **ANSI/TPI1 Quality Criteria, and DSB-22** available from Truss Plate Institute (www.tpinst.org) and **BCSI Building Component Safety Information** available from the Structural Building Component Association (www.sbcsccomponents.com)

MiTek®
 16023 Swingley Ridge Rd.
 Chesterfield, MO 63017
 314.434.1200 / MiTek-US.com

Job 242042	Truss 81	Truss Type Valley	Qty 1	Ply 1	GENE BOSLEY RES. / ROOF
---------------	-------------	----------------------	----------	----------	-------------------------

RELEASE FOR CONSTRUCTION

AS NOTED FOR PLAN REVIEW


DEVELOPMENT SERVICES

LEE'S SUMMIT, MISSOURI

12/02/2024

Heartland Truss, Inc, Plattsburg, MO - 64477, 8.730 s Oct 31 2024 MiTek Industries, Inc. Wed Nov 27 17:46:01 2024 Page 1
 ID: mrcY1X_2FQFIXm9hpx4TmyPVI_-BVj2IG_7frHqngfctGx5APXgqHURgdtp9v1(2) 14-8-15 14-8-15

Scale = 1:23.6

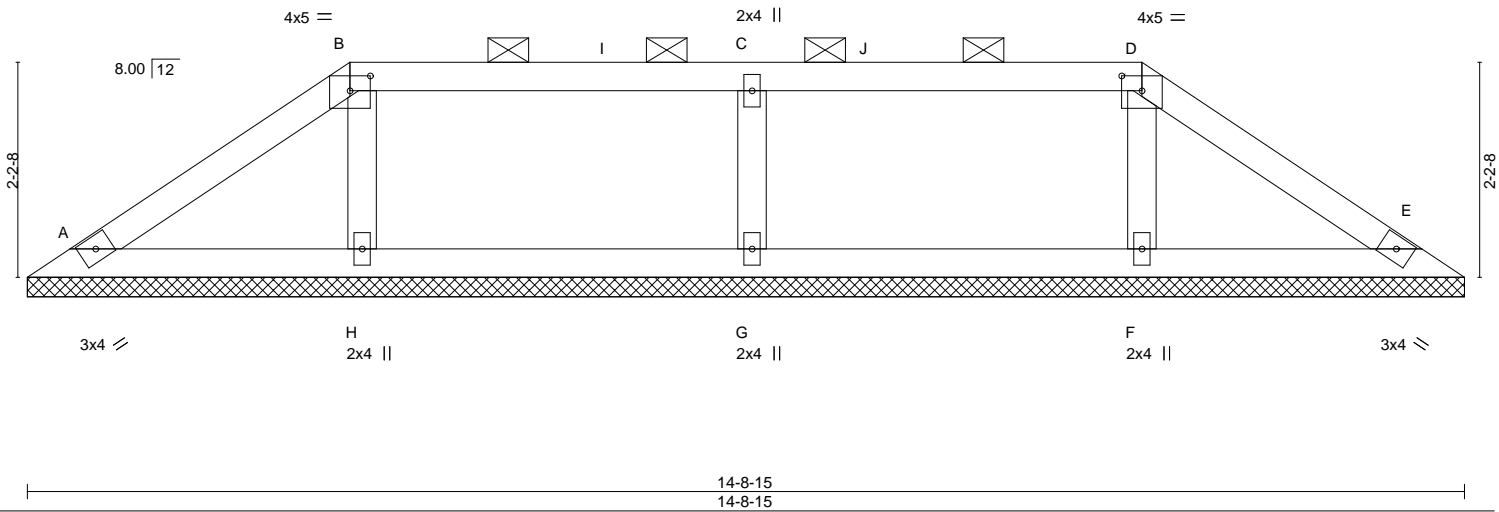

LOADING (psf)	SPACING-	CSI.	DEFL.	PLATES	GRIP
TCLL 25.0 (Roof Snow=25.0)	Plate Grip DOL 1.15 Lumber DOL 1.15	TC 0.51 BC 0.11 WB 0.13 Matrix-S	in (loc) l/defl L/d Vert(LL) n/a - n/a 999 Vert(CT) n/a - n/a 999 Horz(CT) 0.00 E n/a n/a	MT20	244/190
TCDL 10.0	Rep Stress Incr YES				
BCLL 0.0	Code IRC2018/TPI2014				
BCDL 10.0				Weight: 52 lb	FT = 20%

LUMBER-	BRACING-
TOP CHORD 2x4 SP No.2	TOP CHORD Structural wood sheathing directly applied or 6-0-0 oc purlins, except 2-0-0 oc purlins (6-0-0 max.); B-D.
BOT CHORD 2x4 SP No.2	BOT CHORD Rigid ceiling directly applied or 10-0-0 oc bracing.
OTHERS 2x4 SP No.3	


REACTIONS. All bearings 14-8-15.
 (lb) - Max Horz A=-47(LC 8)
 Max Uplift All uplift 100 lb or less at joint(s) A, E, F, G, H
 Max Grav All reactions 250 lb or less at joint(s) A, E except F=337(LC 31), G=685(LC 31), H=339(LC 31)

FORCES. (lb) - Max. Comp./Max. Ten. - All forces 250 (lb) or less except when shown.
 WEBS D-F=-261/88, C-G=-603/129, B-H=-263/96

- NOTES-**
- 1) Wind: ASCE 7-16; Vult=115mph (3-second gust) Vasd=91mph; TCDL=6.0psf; BCDL=6.0psf; h=20ft; Cat. II; Exp C; Enclosed; MWFRS (envelope) gable end zone and C-C Exterior(2E) 0-5-12 to 3-3-11, Exterior(2R) 3-3-11 to 11-5-3, Exterior(2E) 11-5-3 to 14-3-2 zone; cantilever left and right exposed; end vertical left and right exposed; C-C for members and forces & MWFRS for reactions shown; Lumber DOL=1.33 plate grip DOL=1.33
 - 2) TCLL: ASCE 7-16; Pf=25.0 psf (Lum DOL=1.15 Plate DOL=1.15); Is=1.0; Rough Cat C; Fully Exp.; Ce=0.9; Cs=1.00; Ct=1.10
 - 3) Unbalanced snow loads have been considered for this design.
 - 4) Provide adequate drainage to prevent water ponding.
 - 5) Gable requires continuous bottom chord bearing.
 - 6) This truss has been designed for a 10.0 psf bottom chord live load nonconcurrent with any other live loads.
 - 7) Provide mechanical connection (by others) of truss to bearing plate capable of withstanding 100 lb uplift at joint(s) A, E, F, G, H.
 - 8) This truss is designed in accordance with the 2018 International Residential Code sections R502.11.1 and R802.10.2 and referenced standard ANSI/TPI 1.
 - 9) Graphical purlin representation does not depict the size or the orientation of the purlin along the top and/or bottom chord.



November 27, 2024

<p>WARNING - Verify design parameters and READ NOTES ON THIS AND INCLUDED MITEK REFERENCE PAGE MII-7473 rev. 1/2/2023 BEFORE USE.</p> <p>Design valid for use only with MiTek® connectors. This design is based only upon parameters shown, and is for an individual building component, not a truss system. Before use, the building designer must verify the applicability of design parameters and properly incorporate this design into the overall building design. Bracing indicated is to prevent buckling of individual truss web and/or chord members only. Additional temporary and permanent bracing is always required for stability and to prevent collapse with possible personal injury and property damage. For general guidance regarding the fabrication, storage, delivery, erection and bracing of trusses and truss systems, see ANSI/TPI1 Quality Criteria, and DSB-22 available from Truss Plate Institute (www.tpinst.org) and BCSI Building Component Safety Information available from the Structural Building Component Association (www.sbcsccomponents.com)</p>	 <p>16023 Swingley Ridge Rd. Chesterfield, MO 63017 314.434.1200 / MiTek-US.com</p>
---	--

Job 242042	Truss 82	Truss Type Valley	Qty 1	Ply 1	GENE BOSLEY RES. / ROOF
---------------	-------------	----------------------	----------	----------	-------------------------

AS NOTED FOR PLAN REVIEW
DEVELOPMENT SERVICES
LEE'S SUMMIT, MISSOURI

Heartland Truss, Inc, Plattsburg, MO - 64477,

8.730 s Oct 31 2024 MiTek Industries, Inc.

Wed Nov 27 17:46:12 2024 Page 1

ID: mrcY1X_2FQFIXm9hpx4TmyPVL_giHQyc?IQ9PhXwEAbBVTJQLkAAdeksayHhRjLjYK2)E
10-8-15
3-3-11

12/02/2024

Scale = 1:17.2

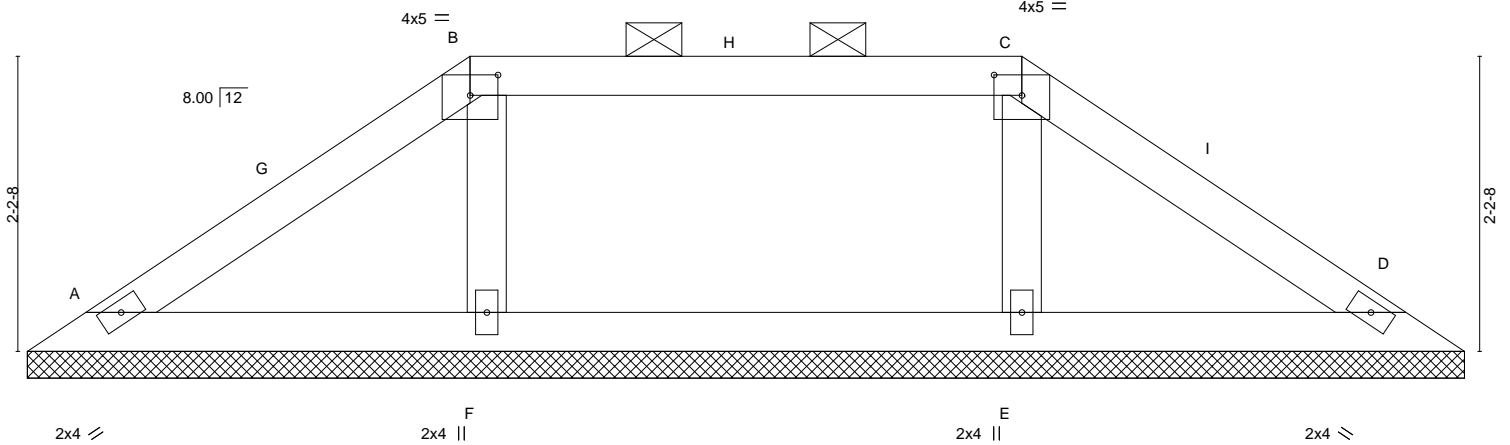


Plate Offsets (X, Y)-- [B:0-2-8,0-1-13], [C:0-2-8,0-1-13]

LOADING (psf)	SPACING-	CSI.	DEFL.	PLATES	GRIP
TCLL 25.0 (Roof Snow=25.0)	2-0-0 Plate Grip DOL 1.15 Lumber DOL 1.15	TC 0.50 BC 0.10 WB 0.07	in (loc) l/defl L/d Vert(LL) n/a - n/a 999 Vert(CT) n/a - n/a 999 Horz(CT) 0.00 D n/a n/a	MT20	244/190
TCDL 10.0	Rep Stress Incr YES	Matrix-S			
BCLL 0.0	Code IRC2018/TPI2014			Weight: 37 lb	FT = 20%
BCDL 10.0					

LUMBER-
TOP CHORD 2x4 SP No.2
BOT CHORD 2x4 SP No.2
OTHERS 2x4 SP No.3

BRACING-
TOP CHORD Structural wood sheathing directly applied or 6-0-0 oc purlins, except 2-0-0 oc purlins (6-0-0 max.); B-C.
BOT CHORD Rigid ceiling directly applied or 10-0-0 oc bracing.

REACTIONS. All bearings 10-8-15.
(lb) - Max Horz A=-47(LC 8)
Max Uplift All uplift 100 lb or less at joint(s) A, D, E, F
Max Grav All reactions 250 lb or less at joint(s) A, D except E=406(LC 19), F=395(LC 18)

FORCES. (lb) - Max. Comp./Max. Ten. - All forces 250 (lb) or less except when shown.
WEBS C-E=-324/100, B-F=-312/96

- NOTES-**
- 1) Wind: ASCE 7-16; Vult=115mph (3-second gust) Vasd=91mph; TCDL=6.0psf; BCDL=6.0psf; h=20ft; Cat. II; Exp C; Enclosed; MWFRS (envelope) gable end zone and C-C Exterior(2E) 0-5-12 to 3-3-11, Exterior(2R) 3-3-11 to 7-5-3, Exterior(2E) 7-5-3 to 10-3-2 zone; cantilever left and right exposed; end vertical left and right exposed; C-C for members and forces & MWFRS for reactions shown; Lumber DOL=1.33 plate grip DOL=1.33
 - 2) TCLL: ASCE 7-16; Pf=25.0 psf (Lum DOL=1.15 Plate DOL=1.15); Is=1.0; Rough Cat C; Fully Exp.; Ce=0.9; Cs=1.00; Ct=1.10
 - 3) Unbalanced snow loads have been considered for this design.
 - 4) Provide adequate drainage to prevent water ponding.
 - 5) Gable requires continuous bottom chord bearing.
 - 6) This truss has been designed for a 10.0 psf bottom chord live load nonconcurrent with any other live loads.
 - 7) Provide mechanical connection (by others) of truss to bearing plate capable of withstanding 100 lb uplift at joint(s) A, D, E, F.
 - 8) This truss is designed in accordance with the 2018 International Residential Code sections R502.11.1 and R802.10.2 and referenced standard ANSI/TPI 1.
 - 9) Graphical purlin representation does not depict the size or the orientation of the purlin along the top and/or bottom chord.



November 27, 2024

WARNING - Verify design parameters and READ NOTES ON THIS AND INCLUDED MITEK REFERENCE PAGE MII-7473 rev. 1/2/2023 BEFORE USE.

Design valid for use only with MiTek® connectors. This design is based only upon parameters shown, and is for an individual building component, not a truss system. Before use, the building designer must verify the applicability of design parameters and properly incorporate this design into the overall building design. Bracing indicated is to prevent buckling of individual truss web and/or chord members only. Additional temporary and permanent bracing is always required for stability and to prevent collapse with possible personal injury and property damage. For general guidance regarding the fabrication, storage, delivery, erection and bracing of trusses and truss systems, see **ANSI/TPI1 Quality Criteria, and DSB-22** available from Truss Plate Institute (www.tpinst.org) and **BCSI Building Component Safety Information** available from the Structural Building Component Association (www.sbcsccomponents.com)

MiTek®

16023 Swingley Ridge Rd.
Chesterfield, MO 63017
314.434.1200 / MiTek-US.com

Job 242042	Truss 83	Truss Type Valley	Qty 1	Ply 1	GENE BOSLEY RES. / ROOF
---------------	-------------	----------------------	----------	----------	-------------------------

RELEASE FOR CONSTRUCTION

AS NOTED FOR PLAN REVIEW

DEVELOPMENT SERVICES

LEE'S SUMMIT, MISSOURI

12/02/2024

Heartland Truss, Inc, Plattsburg, MO - 64477, 8.730 s Oct 31 2024 MiTek Industries, Inc. Wed Nov 27 17:46:12 2024 Page 1

ID:mrcY1X_2FQFIXm9hhpx4TmyPVL_giHQyc?lQ9PhXwtrAbBVtJJCZAUsjywhRjJyLZ7E

3-3-11 3-3-11 3-5-3 0-1-8 6-8-15 3-3-11

4x5 = Scale = 1:15.6

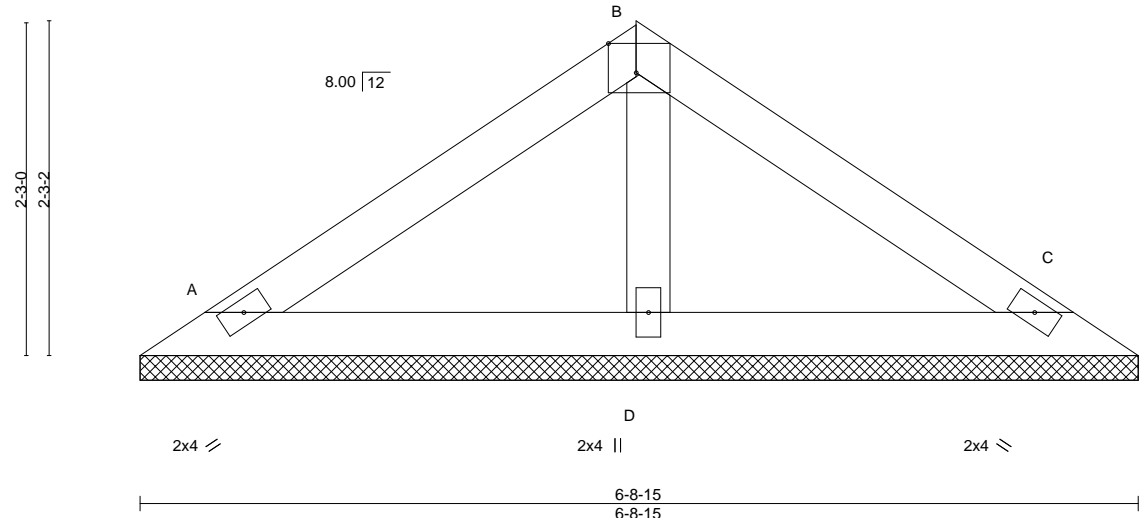


Plate Offsets (X,Y)-- [B:0-2-4,Edge]	
LOADING (psf)	SPACING- 2-0-0
TCLL 25.0 (Roof Snow=25.0)	Plate Grip DOL 1.15
TCDL 10.0	Lumber DOL 1.15
BCLL 0.0	Rep Stress Incr YES
BCDL 10.0	Code IRC2018/TPI2014
CSI.	DEFL. in (loc) l/defl L/d
TC 0.27	Vert(LL) n/a - n/a 999
BC 0.09	Vert(CT) n/a - n/a 999
WB 0.03	Horz(CT) 0.00 C n/a n/a
Matrix-P	PLATES MT20
	GRIP 244/190
	Weight: 23 lb FT = 20%

LUMBER-	BRACING-
TOP CHORD 2x4 SP No.2	TOP CHORD Structural wood sheathing directly applied or 6-0-0 oc purlins.
BOT CHORD 2x4 SP No.2	BOT CHORD Rigid ceiling directly applied or 10-0-0 oc bracing.
OTHERS 2x4 SP No.3	


REACTIONS. (size) A=6-8-15, C=6-8-15, D=6-8-15
 Max Horz A=-48(LC 8)
 Max Uplift A=-28(LC 12), C=-35(LC 13)
 Max Grav A=197(LC 18), C=192(LC 19), D=238(LC 19)

FORCES. (lb) - Max. Comp./Max. Ten. - All forces 250 (lb) or less except when shown.

- NOTES-**
- 1) Wind: ASCE 7-16; Vult=115mph (3-second gust) Vasd=91mph; TCDL=6.0psf; BCDL=6.0psf; h=20ft; Cat. II; Exp C; Enclosed; MWFRS (envelope) gable end zone and C-C Exterior(2E) zone; cantilever left and right exposed ; end vertical left and right exposed;C-C for members and forces & MWFRS for reactions shown; Lumber DOL=1.33 plate grip DOL=1.33
 - 2) TCLL: ASCE 7-16; Pf=25.0 psf (Lum DOL=1.15 Plate DOL=1.15); Is=1.0; Rough Cat C; Fully Exp.; Ce=0.9; Cs=1.00; Ct=1.10
 - 3) Unbalanced snow loads have been considered for this design.
 - 4) Gable requires continuous bottom chord bearing.
 - 5) This truss has been designed for a 10.0 psf bottom chord live load nonconcurrent with any other live loads.
 - 6) Provide mechanical connection (by others) of truss to bearing plate capable of withstanding 100 lb uplift at joint(s) A, C.
 - 7) This truss is designed in accordance with the 2018 International Residential Code sections R502.11.1 and R802.10.2 and referenced standard ANSI/TPI 1.



November 27, 2024

<p>WARNING - Verify design parameters and READ NOTES ON THIS AND INCLUDED MITEK REFERENCE PAGE MII-7473 rev. 1/2/2023 BEFORE USE.</p> <p>Design valid for use only with MiTek® connectors. This design is based only upon parameters shown, and is for an individual building component, not a truss system. Before use, the building designer must verify the applicability of design parameters and properly incorporate this design into the overall building design. Bracing indicated is to prevent buckling of individual truss web and/or chord members only. Additional temporary and permanent bracing is always required for stability and to prevent collapse with possible personal injury and property damage. For general guidance regarding the fabrication, storage, delivery, erection and bracing of trusses and truss systems, see ANSI/TPI1 Quality Criteria, and DSB-22 available from Truss Plate Institute (www.tpinst.org) and BCSI Building Component Safety Information available from the Structural Building Component Association (www.sbcsccomponents.com)</p>	 <p>16023 Swingley Ridge Rd. Chesterfield, MO 63017 314.434.1200 / MiTek-US.com</p>
---	--

Job 242042	Truss 84	Truss Type Jack-Open	Qty 1	Ply 1	GENE BOSLEY RES. / ROOF
---------------	-------------	-------------------------	----------	----------	-------------------------

RELEASE FOR CONSTRUCTION


AS NOTED FOR PLAN REVIEW

DEVELOPMENT SERVICES

LEE'S SUMMIT, MISSOURI

12/02/2024

Heartland Truss, Inc, Plattsburg, MO - 64477, 8.730 s Oct 31 2024 MiTek Industries, Inc. Wed Nov 27 17:46:02 2024 Page 1
 ID:mrcY1X_2FQFIXm9hhpx4TmyPVL_giHQyc?IQ9PhXwErAbBVTIQDBy8JelayHrJlyE2FB

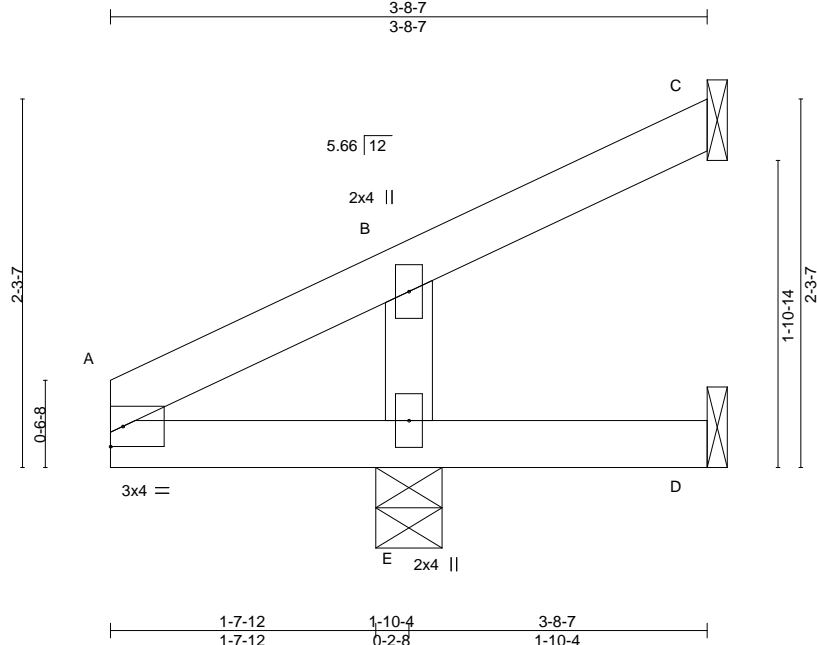

Scale = 1:14.3

LOADING (psf)	SPACING-	CSI.	DEFL.	PLATES	GRIP
TCLL 25.0 (Roof Snow=25.0)	2-0-0 Plate Grip DOL 1.15	TC 0.25	in (loc) l/defl L/d	MT20	244/190
TCDL 10.0	Lumber DOL 1.15	BC 0.22	Vert(LL) 0.00 D-E >999 240		
BCLL 0.0	Rep Stress Incr YES	WB 0.06	Vert(CT) 0.00 D-E >999 180		
BCDL 10.0	Code IRC2018/TPI2014	Matrix-MP	Horz(CT) -0.03 C n/a n/a	Weight: 13 lb	FT = 20%

LUMBER-	BRACING-
TOP CHORD 2x4 SP No.2	TOP CHORD Structural wood sheathing directly applied or 3-8-7 oc purlins.
BOT CHORD 2x4 SP No.2	BOT CHORD Rigid ceiling directly applied or 10-0-0 oc bracing.
WEBS 2x4 SP No.3	

REACTIONS. (size) C=Mechanical, D=Mechanical, E=0-4-15
 Max Horz E=67(LC 12)
 Max Uplift C=-36(LC 12), D=-37(LC 18), E=-15(LC 12)
 Max Grav C=29(LC 18), D=8(LC 8), E=460(LC 18)

FORCES. (lb) - Max. Comp./Max. Ten. - All forces 250 (lb) or less except when shown.
 WEBS B-E=-307/158

- NOTES-**
- 1) Wind: ASCE 7-16; Vult=115mph (3-second gust) Vasd=91mph; TCDL=6.0psf; BCDL=6.0psf; h=20ft; Cat. II; Exp C; Enclosed; MWFRS (envelope) gable end zone and C-C Corner(3) zone; cantilever left and right exposed ; end vertical left and right exposed;C-C for members and forces & MWFRS for reactions shown; Lumber DOL=1.33 plate grip DOL=1.33
 - 2) TCLL: ASCE 7-16; Pf=25.0 psf (Lum DOL=1.15 Plate DOL=1.15); Is=1.0; Rough Cat C; Fully Exp.; Ce=0.9; Cs=1.00; Ct=1.10
 - 3) Unbalanced snow loads have been considered for this design.
 - 4) This truss has been designed for a 10.0 psf bottom chord live load nonconcurrent with any other live loads.
 - 5) Refer to girder(s) for truss to truss connections.
 - 6) Provide mechanical connection (by others) of truss to bearing plate capable of withstanding 100 lb uplift at joint(s) C, D, E.
 - 7) This truss is designed in accordance with the 2018 International Residential Code sections R502.11.1 and R802.10.2 and referenced standard ANSI/TPI 1.



November 27, 2024

Job 242042	Truss 85	Truss Type Piggyback	Qty 3	Ply 1	GENE BOSLEY RES. / ROOF
---------------	-------------	-------------------------	----------	----------	-------------------------

RELEASE FOR CONSTRUCTION
AS NOTED FOR PLAN REVIEW
DEVELOPMENT SERVICES
LEE'S SUMMIT, MISSOURI

12/02/2024

Heartland Truss, Inc, Plattsburg, MO - 64477, 8.730 s Oct 31 2024 MiTek Industries, Inc. Wed Nov 27 17:46:33 2024 Page 1
 ID:mrcY1X_2FQFIXm9hhpx4TmyPVL_8uro9y0NBSXY94pklik0WysHLKGNBCk8ZG_sVFR21A

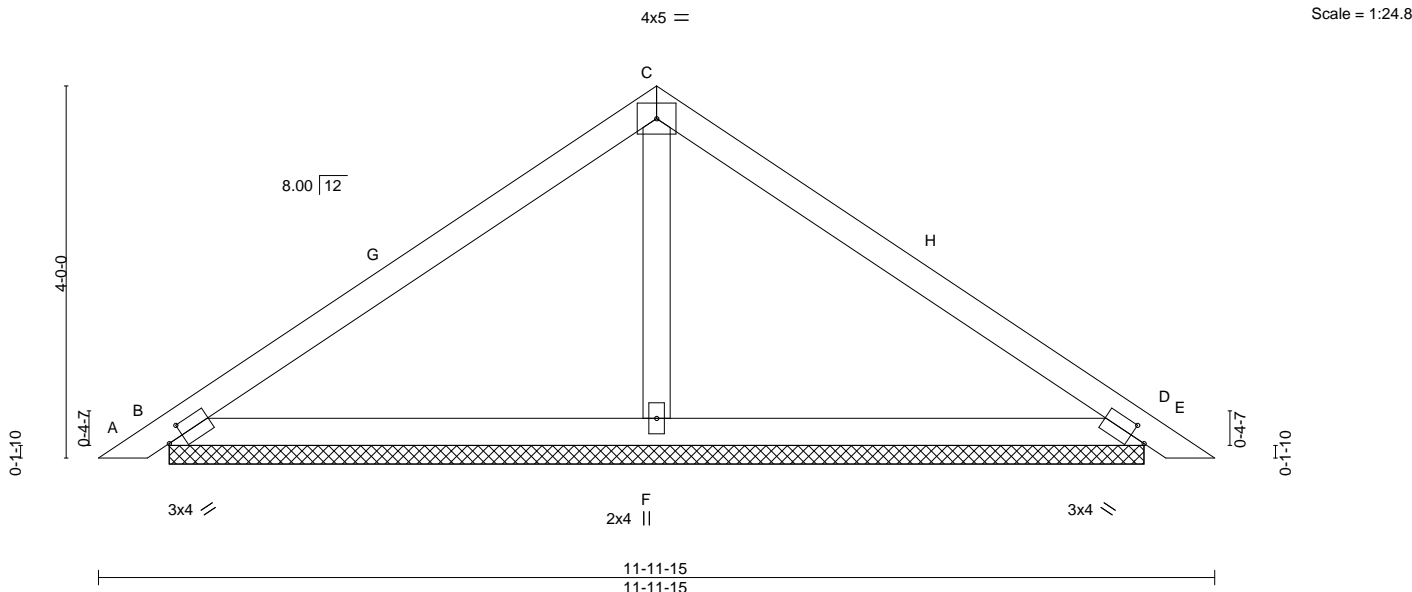


Plate Offsets (X, Y)-- [B:0-2-0,0-1-8], [D:0-2-0,0-1-8]

LOADING (psf)	SPACING-	CSI.	DEFL.	in (loc)	l/defl	L/d	PLATES	GRIP
TCLL 25.0 (Roof Snow=25.0)	Plate Grip DOL 1.15 Lumber DOL 1.15	TC 0.74 BC 0.37	Vert(LL) -0.01 Vert(CT) -0.00 Horz(CT) 0.00	E E D	n/r n/r n/a	120 90 n/a	MT20	244/190
TCDL 10.0	Rep Stress Incr YES Code IRC2018/TPI2014	WB 0.10 Matrix-S					Weight: 42 lb	FT = 20%
BCLL 0.0								
BCDL 10.0								

LUMBER-	BRACING-
TOP CHORD 2x4 SP No.2	TOP CHORD Structural wood sheathing directly applied or 6-0-0 oc purlins.
BOT CHORD 2x4 SP No.2	BOT CHORD Rigid ceiling directly applied or 10-0-0 oc bracing.
OTHERS 2x4 SP No.3	

REACTIONS. (size) B=10-5-11, D=10-5-11, F=10-5-11
 Max Horz B=-95(LC 10)
 Max Uplift B=-50(LC 12), D=-62(LC 13), F=-15(LC 12)
 Max Grav B=393(LC 19), D=393(LC 20), F=505(LC 20)

FORCES. (lb) - Max. Comp./Max. Ten. - All forces 250 (lb) or less except when shown.
WEBS C-F=-332/102

- NOTES-**
- 1) Wind: ASCE 7-16; Vult=115mph (3-second gust) Vasd=91mph; TC DL=6.0psf; BC DL=6.0psf; h=20ft; Cat. II; Exp C; Enclosed; MWFRS (envelope) gable end zone and C-C Exterior(2E) 0-3-2 to 3-3-2, Exterior(2R) 3-3-2 to 8-8-13, Exterior(2E) 8-8-13 to 11-8-13 zone; cantilever left and right exposed; end vertical left and right exposed; C-C for members and forces & MWFRS for reactions shown; Lumber DOL=1.33 plate grip DOL=1.33
 - 2) TCLL: ASCE 7-16; Pf=25.0 psf (Lum DOL=1.15 Plate DOL=1.15); Is=1.0; Rough Cat C; Fully Exp.; Ce=0.9; Cs=1.00; Ct=1.10
 - 3) Unbalanced snow loads have been considered for this design.
 - 4) This truss has been designed for greater of min roof live load of 16.0 psf or 2.00 times flat roof load of 25.0 psf on overhangs non-concurrent with other live loads.
 - 5) Gable requires continuous bottom chord bearing.
 - 6) This truss has been designed for a 10.0 psf bottom chord live load nonconcurrent with any other live loads.
 - 7) Provide mechanical connection (by others) of truss to bearing plate capable of withstanding 100 lb uplift at joint(s) B, D, F.
 - 8) This truss is designed in accordance with the 2018 International Residential Code sections R502.11.1 and R802.10.2 and referenced standard ANSI/TPI 1.
 - 9) See Standard Industry Piggyback Truss Connection Detail for Connection to base truss as applicable, or consult qualified building designer.



November 27, 2024

Job	Truss	Truss Type	Qty	Ply	GENE BOSLEY RES. / ROOF
242042	86	Piggyback	1	1	

RELEASE FOR CONSTRUCTION


AS NOTED FOR PLAN REVIEW

DEVELOPMENT SERVICES

LEE'S SUMMIT, MISSOURI

12/02/2024

Heartland Truss, Inc, Plattsburg, MO - 64477, 8.730 s Oct 31 2024 MiTek Industries, Inc. Wed Nov 27 17:46:03 2024 Page 1
 ID: mrcY1X_2FQFIXm9hhpx4TmyPVI_8uro9y0NBSXY94p2kik0WZ6LSnBk8XG s/V12) A 169875963

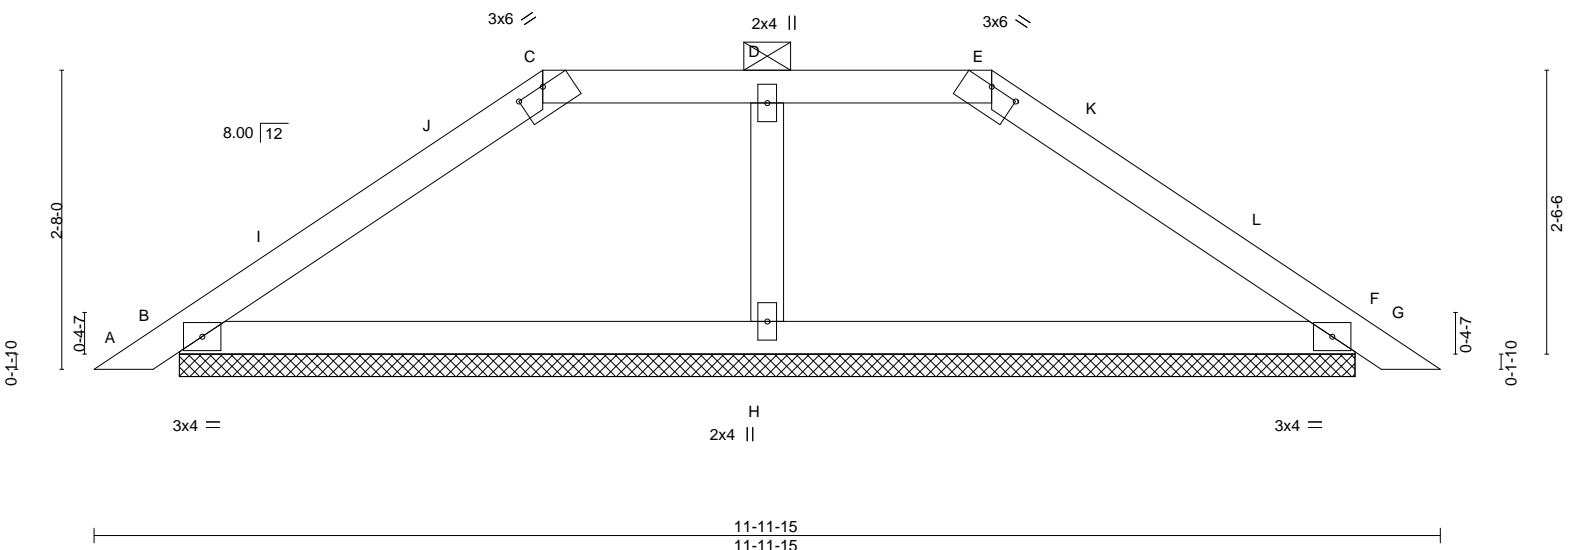

LOADING (psf)		SPACING-		CSI.		DEFL.				PLATES		GRIP	
TCLL	25.0	Plate Grip DOL	1.15	TC	0.30	Vert(LL)	-0.01	G	n/r	120	MT20	244/190	
(Roof Snow=25.0)		Lumber DOL	1.15	BC	0.27	Vert(CT)	-0.00	G	n/r	90	Weight: 39 lb FT = 20%		
TCDL	10.0	Rep Stress Incr	YES	WB	0.07	Horz(CT)	0.01	F	n/a	n/a			
BCLL	0.0	Code IRC2018/TPI2014		Matrix-S									
BCDL	10.0												

LUMBER-		BRACING-	
TOP CHORD	2x4 SP No.2	TOP CHORD	Structural wood sheathing directly applied or 6-0-0 oc purlins, except 2-0-0 oc purlins (6-0-0 max.): C-E.
BOT CHORD	2x4 SP No.2	BOT CHORD	Rigid ceiling directly applied or 10-0-0 oc bracing.
OTHERS	2x4 SP No.3		

REACTIONS. (size) B=10-5-11, F=10-5-11, H=10-5-11
 Max Horz B=-63(LC 10)
 Max Uplift B=-78(LC 12), F=-80(LC 13)
 Max Grav B=545(LC 33), F=545(LC 33), H=441(LC 32)

FORCES. (lb) - Max. Comp./Max. Ten. - All forces 250 (lb) or less except when shown.
 TOP CHORD B-C=-550/151, C-D=-356/160, D-E=-356/160, E-F=-550/151
 BOT CHORD B-H=-49/356, F-H=-49/356
 WEBS D-H=-312/70

- NOTES-**
- 1) Wind: ASCE 7-16; Vult=115mph (3-second gust) Vasd=91mph; TCDL=6.0psf; BCDL=6.0psf; h=20ft; Cat. II; Exp C; Enclosed; MWFRS (envelope) gable end zone and C-C Exterior(2E) 0-3-2 to 3-3-2, Exterior(2R) 3-3-2 to 8-8-13, Exterior(2E) 8-8-13 to 11-8-13 zone; cantilever left and right exposed; end vertical left and right exposed; C-C for members and forces & MWFRS for reactions shown; Lumber DOL=1.33 plate grip DOL=1.33
 - 2) TCLL: ASCE 7-16; Pf=25.0 psf (Lum DOL=1.15 Plate DOL=1.15); Is=1.0; Rough Cat C; Fully Exp.; Ce=0.9; Cs=1.00; Ct=1.10
 - 3) Unbalanced snow loads have been considered for this design.
 - 4) This truss has been designed for greater of min roof live load of 16.0 psf or 2.00 times flat roof load of 25.0 psf on overhangs non-concurrent with other live loads.
 - 5) Provide adequate drainage to prevent water ponding.
 - 6) Gable requires continuous bottom chord bearing.
 - 7) This truss has been designed for a 10.0 psf bottom chord live load nonconcurrent with any other live loads.
 - 8) Provide mechanical connection (by others) of truss to bearing plate capable of withstanding 100 lb uplift at joint(s) B, F.
 - 9) This truss is designed in accordance with the 2018 International Residential Code sections R502.11.1 and R802.10.2 and referenced standard ANSI/TPI 1.
 - 10) See Standard Industry Piggyback Truss Connection Detail for Connection to base truss as applicable, or consult qualified building designer.
 - 11) Graphical purlin representation does not depict the size or the orientation of the purlin along the top and/or bottom chord.



November 27, 2024

Job 242042	Truss 87	Truss Type Piggyback	Qty 1	Ply 1	GENE BOSLEY RES. / ROOF
---------------	-------------	-------------------------	----------	----------	-------------------------


AS NOTED FOR PLAN REVIEW
DEVELOPMENT SERVICES
LEE'S SUMMIT, MISSOURI

Heartland Truss, Inc, Plattsburg, MO - 64477,


8.730 s Oct 31 2024 MiTek Industries, Inc. Wed Nov 27 07:46:04 2024 Page 1

ID: mrcY1X_2FQFIXm9hhpx4TmyPVL_c4PANi0?ymgPmEOEH?DzYKvgT056IKNLAyQV129

12/02/2024

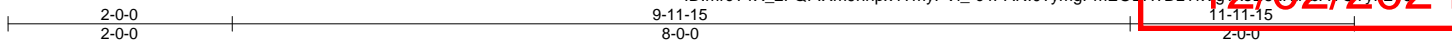

Scale = 1:20.5

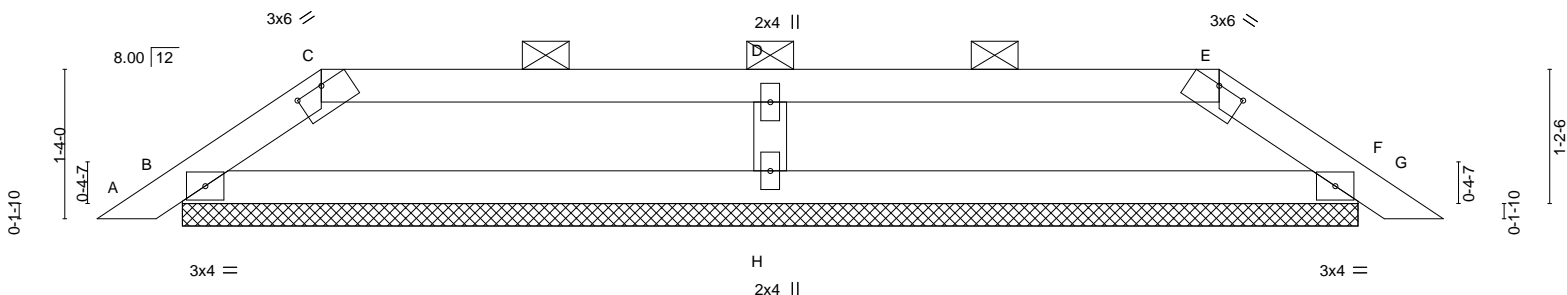

11-11-15
11-11-15

Plate Offsets (X, Y)-- [C:0-3-0,0-0-2], [E:0-3-0,0-0-2]

LOADING (psf)	SPACING-	CSI.	DEFL.	in (loc)	l/defl	L/d	PLATES	GRIP
TCLL 25.0 (Roof Snow=25.0)	Plate Grip DOL 1.15	TC 0.52	Vert(LL) -0.00	G	n/r	120	MT20	244/190
TCDL 10.0	Lumber DOL 1.15	BC 0.26	Vert(CT) -0.00	G	n/r	90		
BCLL 0.0	Rep Stress Incr YES	WB 0.12	Horz(CT) 0.01	F	n/a	n/a		
BCDL 10.0	Code IRC2018/TPI2014	Matrix-S					Weight: 36 lb	FT = 20%

LUMBER-
TOP CHORD 2x4 SP No.2
BOT CHORD 2x4 SP No.2
WEBS 2x4 SP No.3

BRACING-
TOP CHORD Structural wood sheathing directly applied or 6-0-0 oc purlins, except 2-0-0 oc purlins (6-0-0 max.); C-E.
BOT CHORD Rigid ceiling directly applied or 10-0-0 oc bracing.

REACTIONS. (size) B=10-5-11, F=10-5-11, H=10-5-11
Max Horz B=-30(LC 10)
Max Uplift B=-58(LC 12), F=-58(LC 13), H=-57(LC 9)
Max Grav B=319(LC 33), F=319(LC 33), H=727(LC 32)

FORCES. (lb) - Max. Comp./Max. Ten. - All forces 250 (lb) or less except when shown.
TOP CHORD B-C=-444/117, C-D=-369/106, D-E=-369/106, E-F=-444/117
BOT CHORD B-H=-57/369, F-H=-57/369
WEBS D-H=-603/156

- NOTES-**
- 1) Wind: ASCE 7-16; Vult=115mph (3-second gust) Vasd=91mph; TCDL=6.0psf; BCDL=6.0psf; h=20ft; Cat. II; Exp C; Enclosed; MWFRS (envelope) gable end zone and C-C Exterior(2E) 0-3-2 to 2-0-0, Exterior(2R) 2-0-0 to 9-11-15, Exterior(2E) 9-11-15 to 11-8-13 zone; cantilever left and right exposed; end vertical left and right exposed; C-C for members and forces & MWFRS for reactions shown; Lumber DOL=1.33 plate grip DOL=1.33
 - 2) TCLL: ASCE 7-16; Pf=25.0 psf (Lum DOL=1.15 Plate DOL=1.15); Is=1.0; Rough Cat C; Fully Exp.; Ce=0.9; Cs=1.00; Ct=1.10
 - 3) Unbalanced snow loads have been considered for this design.
 - 4) This truss has been designed for greater of min roof live load of 16.0 psf or 2.00 times flat roof load of 25.0 psf on overhangs non-concurrent with other live loads.
 - 5) Provide adequate drainage to prevent water ponding.
 - 6) Gable requires continuous bottom chord bearing.
 - 7) This truss has been designed for a 10.0 psf bottom chord live load nonconcurrent with any other live loads.
 - 8) Provide mechanical connection (by others) of truss to bearing plate capable of withstanding 100 lb uplift at joint(s) B, F, H.
 - 9) This truss is designed in accordance with the 2018 International Residential Code sections R502.11.1 and R802.10.2 and referenced standard ANSI/TPI 1.
 - 10) See Standard Industry Piggyback Truss Connection Detail for Connection to base truss as applicable, or consult qualified building designer.
 - 11) Graphical purlin representation does not depict the size or the orientation of the purlin along the top and/or bottom chord.



November 27, 2024

WARNING - Verify design parameters and READ NOTES ON THIS AND INCLUDED MITEK REFERENCE PAGE MII-7473 rev. 1/2/2023 BEFORE USE.

Design valid for use only with MiTek® connectors. This design is based only upon parameters shown, and is for an individual building component, not a truss system. Before use, the building designer must verify the applicability of design parameters and properly incorporate this design into the overall building design. Bracing indicated is to prevent buckling of individual truss web and/or chord members only. Additional temporary and permanent bracing is always required for stability and to prevent collapse with possible personal injury and property damage. For general guidance regarding the fabrication, storage, delivery, erection and bracing of trusses and truss systems, see **ANSI/TPI1 Quality Criteria, and DSB-22** available from Truss Plate Institute (www.tpinst.org) and **BCSI Building Component Safety Information** available from the Structural Building Component Association (www.sbcsccomponents.com)

MiTek®

16023 Swingley Ridge Rd.
Chesterfield, MO 63017
314.434.1200 / MiTek-US.com


Job	Truss	Truss Type	Qty	Ply	GENE BOSLEY RES. / ROOF
242042	88	Roof Special	1	1	

RELEASE FOR CONSTRUCTION
AS NOTED FOR PLAN REVIEW
DEVELOPMENT SERVICES
LEE'S SUMMIT, MISSOURI

12/02/2024

Heartland Truss, Inc, Plattsburg, MO - 64477, 8.730 s Oct 31 2024 MiTek Industries, Inc. Wed No: 27-17-16-14-2024 Page 1
 ID:mrcY1X_2FQFIXm9hhpx4TmyPVL_-c4PANI0?ymgPmEOEH?DzYk/ksk056j7NLAAYQV1(2)9

Scale = 1:20.5

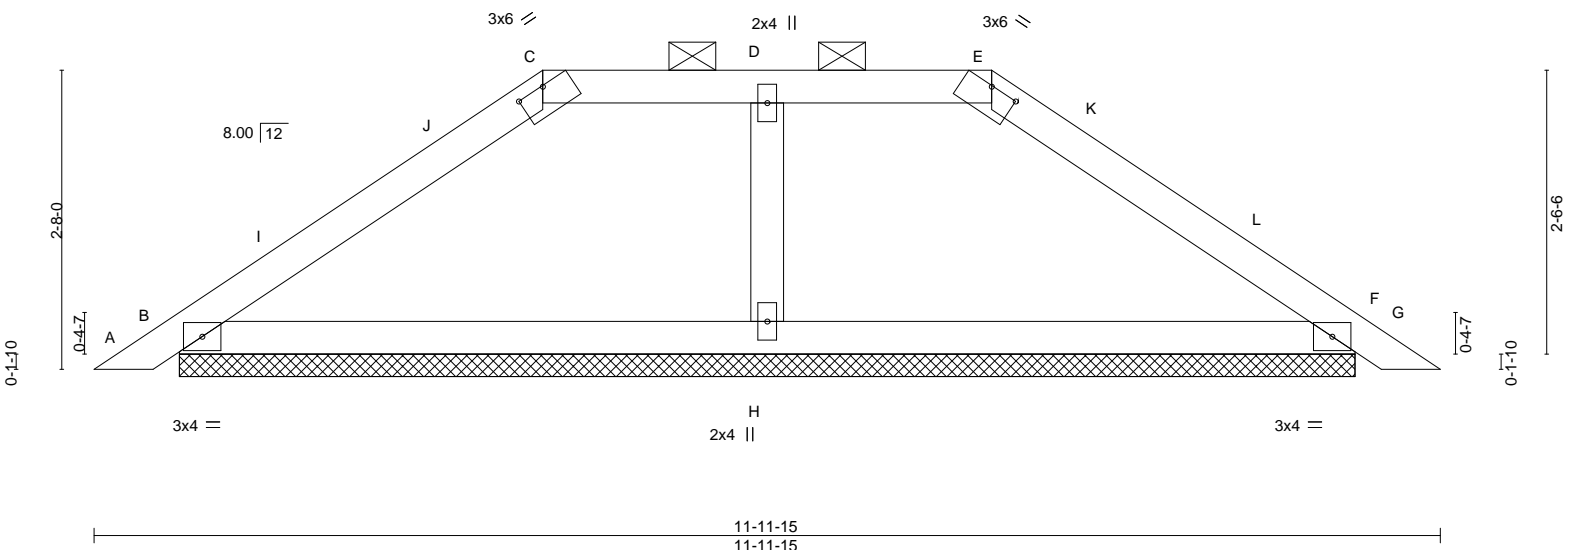

LOADING (psf)		SPACING-		CSI.		DEFL.				PLATES		GRIP	
TCLL	25.0	Plate Grip DOL	1.15	TC	0.30	Vert(LL)	-0.01	G	n/r	L/d	120	MT20	244/190
(Roof Snow=25.0)		Lumber DOL	1.15	BC	0.27	Vert(CT)	-0.00	G	n/r		90		
TCDL	10.0	Rep Stress Incr	YES	WB	0.07	Horz(CT)	0.01	F	n/a	n/a			
BCLL	0.0	Code IRC2018/TPI2014		Matrix-S								Weight: 39 lb	FT = 20%
BCDL	10.0												

LUMBER-		BRACING-	
TOP CHORD	2x4 SP No.2	TOP CHORD	Structural wood sheathing directly applied or 6-0-0 oc purlins, except 2-0-0 oc purlins (6-0-0 max.): C-E.
BOT CHORD	2x4 SP No.2	BOT CHORD	Rigid ceiling directly applied or 10-0-0 oc bracing.
OTHERS	2x4 SP No.3		

REACTIONS. (size) B=10-5-11, F=10-5-11, H=10-5-11
 Max Horz B=-63(LC 10)
 Max Uplift B=-78(LC 12), F=-80(LC 13)
 Max Grav B=545(LC 33), F=545(LC 33), H=441(LC 32)

FORCES. (lb) - Max. Comp./Max. Ten. - All forces 250 (lb) or less except when shown.
 TOP CHORD B-C=-550/151, C-D=-356/160, D-E=-356/160, E-F=-550/151
 BOT CHORD B-H=-49/356, F-H=-49/356
 WEBS D-H=-312/70

- NOTES-**
- 1) Wind: ASCE 7-16; Vult=115mph (3-second gust) Vasd=91mph; TCDL=6.0psf; BCDL=6.0psf; h=20ft; Cat. II; Exp C; Enclosed; MWFRS (envelope) gable end zone and C-C Exterior(2E) 0-3-2 to 3-3-2, Exterior(2R) 3-3-2 to 8-8-13, Exterior(2E) 8-8-13 to 11-8-13 zone; cantilever left and right exposed; end vertical left and right exposed; C-C for members and forces & MWFRS for reactions shown; Lumber DOL=1.33 plate grip DOL=1.33
 - 2) TCLL: ASCE 7-16; Pf=25.0 psf (Lum DOL=1.15 Plate DOL=1.15); Is=1.0; Rough Cat C; Fully Exp.; Ce=0.9; Cs=1.00; Ct=1.10
 - 3) Unbalanced snow loads have been considered for this design.
 - 4) This truss has been designed for greater of min roof live load of 16.0 psf or 2.00 times flat roof load of 25.0 psf on overhangs non-concurrent with other live loads.
 - 5) Provide adequate drainage to prevent water ponding.
 - 6) Gable requires continuous bottom chord bearing.
 - 7) This truss has been designed for a 10.0 psf bottom chord live load nonconcurrent with any other live loads.
 - 8) Provide mechanical connection (by others) of truss to bearing plate capable of withstanding 100 lb uplift at joint(s) B, F.
 - 9) This truss is designed in accordance with the 2018 International Residential Code sections R502.11.1 and R802.10.2 and referenced standard ANSI/TPI 1.
 - 10) See Standard Industry Piggyback Truss Connection Detail for Connection to base truss as applicable, or consult qualified building designer.
 - 11) Graphical purlin representation does not depict the size or the orientation of the purlin along the top and/or bottom chord.



November 27, 2024

Job	Truss	Truss Type	Qty	Ply	GENE BOSLEY RES. / ROOF
242042	89	Roof Special	1	1	

RELEASE FOR CONSTRUCTION

AS NOTED FOR PLAN REVIEW

DEVELOPMENT SERVICES


LEE'S SUMMIT, MISSOURI

12/02/2024


Heartland Truss, Inc, Plattsburg, MO - 64477,

8.730 s Oct 31 2024 MiTek Industries, Inc. Wed Nov 27 17:46:05 2024 Page 1

ID:mrcY1X_2FQFIXm9hhpx4TmyPVL_-4HzZae1dj4oGOozQrjkC5_2r28814a1hf-vpwwy1f273

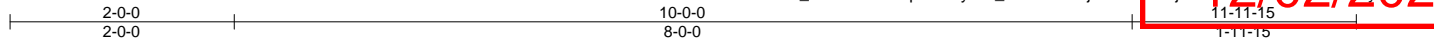

Scale = 1:20.5

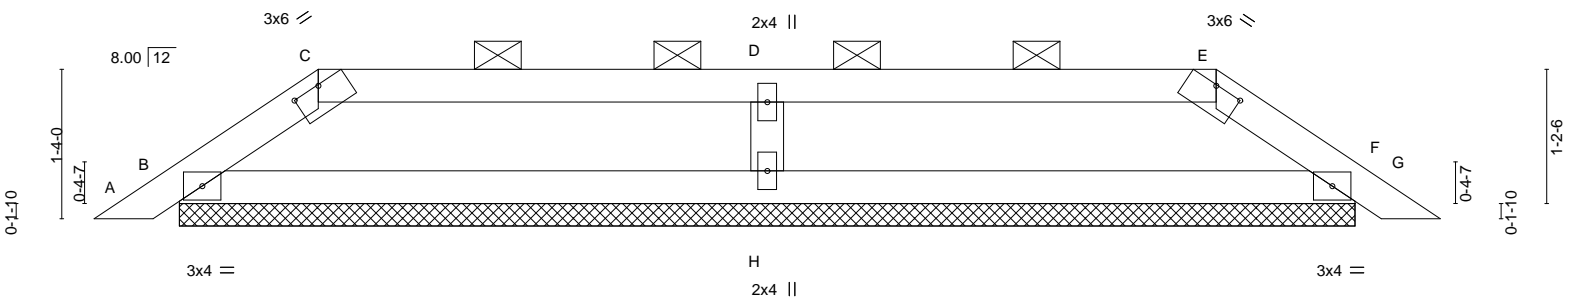

11-11-15
11-11-15

Plate Offsets (X, Y)-- [C:0-3-0,0-0-2], [E:0-3-0,0-0-2]

LOADING (psf)	SPACING-		CSI.	DEFL.	in (loc)	l/defl	L/d	PLATES	GRIP
TCLL 25.0	Plate Grip DOL 1.15	2-0-0	TC 0.52	Vert(LL) -0.00	G	n/r	120	MT20	244/190
(Roof Snow=25.0)	Lumber DOL 1.15		BC 0.26	Vert(CT) -0.00	G	n/r	90		
TCDL 10.0	Rep Stress Incr YES		WB 0.12	Horz(CT) 0.01	F	n/a	n/a		
BCLL 0.0	Code IRC2018/TPI2014		Matrix-S						
BCDL 10.0								Weight: 36 lb	FT = 20%

LUMBER-
TOP CHORD 2x4 SP No.2
BOT CHORD 2x4 SP No.2
WEBS 2x4 SP No.3

BRACING-
TOP CHORD Structural wood sheathing directly applied or 6-0-0 oc purlins, except 2-0-0 oc purlins (6-0-0 max.); C-E.
BOT CHORD Rigid ceiling directly applied or 10-0-0 oc bracing.

REACTIONS. (size) B=10-5-11, F=10-5-11, H=10-5-11
Max Horz B=-30(LC 10)
Max Uplift B=-58(LC 12), F=-58(LC 13), H=-57(LC 9)
Max Grav B=319(LC 33), F=319(LC 33), H=727(LC 32)

FORCES. (lb) - Max. Comp./Max. Ten. - All forces 250 (lb) or less except when shown.
TOP CHORD B-C=-444/117, C-D=-369/106, D-E=-369/106, E-F=-444/117
BOT CHORD B-H=-57/369, F-H=-57/369
WEBS D-H=-603/156

- NOTES-**
- 1) Wind: ASCE 7-16; Vult=115mph (3-second gust) Vasd=91mph; TCDL=6.0psf; BCDL=6.0psf; h=20ft; Cat. II; Exp C; Enclosed; MWFRS (envelope) gable end zone and C-C Exterior(2E) 0-3-2 to 2-0-0, Exterior(2R) 2-0-0 to 10-0-0, Exterior(2E) 10-0-0 to 11-8-13 zone; cantilever left and right exposed; end vertical left and right exposed; C-C for members and forces & MWFRS for reactions shown; Lumber DOL=1.33 plate grip DOL=1.33
 - 2) TCLL: ASCE 7-16; Pf=25.0 psf (Lum DOL=1.15 Plate DOL=1.15); Is=1.0; Rough Cat C; Fully Exp.; Ce=0.9; Cs=1.00; Ct=1.10
 - 3) Unbalanced snow loads have been considered for this design.
 - 4) This truss has been designed for greater of min roof live load of 16.0 psf or 2.00 times flat roof load of 25.0 psf on overhangs non-concurrent with other live loads.
 - 5) Provide adequate drainage to prevent water ponding.
 - 6) Gable requires continuous bottom chord bearing.
 - 7) This truss has been designed for a 10.0 psf bottom chord live load nonconcurrent with any other live loads.
 - 8) Provide mechanical connection (by others) of truss to bearing plate capable of withstanding 100 lb uplift at joint(s) B, F, H.
 - 9) This truss is designed in accordance with the 2018 International Residential Code sections R502.11.1 and R802.10.2 and referenced standard ANSI/TPI 1.
 - 10) See Standard Industry Piggyback Truss Connection Detail for Connection to base truss as applicable, or consult qualified building designer.
 - 11) Graphical purlin representation does not depict the size or the orientation of the purlin along the top and/or bottom chord.



November 27, 2024

WARNING - Verify design parameters and READ NOTES ON THIS AND INCLUDED MITEK REFERENCE PAGE MII-7473 rev. 1/2/2023 BEFORE USE.

Design valid for use only with MiTek® connectors. This design is based only upon parameters shown, and is for an individual building component, not a truss system. Before use, the building designer must verify the applicability of design parameters and properly incorporate this design into the overall building design. Bracing indicated is to prevent buckling of individual truss web and/or chord members only. Additional temporary and permanent bracing is always required for stability and to prevent collapse with possible personal injury and property damage. For general guidance regarding the fabrication, storage, delivery, erection and bracing of trusses and truss systems, see **ANSI/TPI1 Quality Criteria, and DSB-22** available from Truss Plate Institute (www.tpinst.org) and **BCSI Building Component Safety Information** available from the Structural Building Component Association (www.sbcsccomponents.com)

MiTek®
16023 Swingley Ridge Rd.
Chesterfield, MO 63017
314.434.1200 / MiTek-US.com

Job 242042	Truss LAY01	Truss Type GABLE	Qty 1	Ply 1	GENE BOSLEY RES. / ROOF
---------------	----------------	---------------------	----------	----------	-------------------------

RELEASE FOR CONSTRUCTION


AS NOTED FOR PLAN REVIEW

DEVELOPMENT SERVICES

LEE'S SUMMIT, MISSOURI

12/02/2024

Heartland Truss, Inc, Plattsburg, MO - 64477, 8.730 s Oct 31 2024 MiTek Industries, Inc. Wed No 27 07 46 05 2024 Page 1

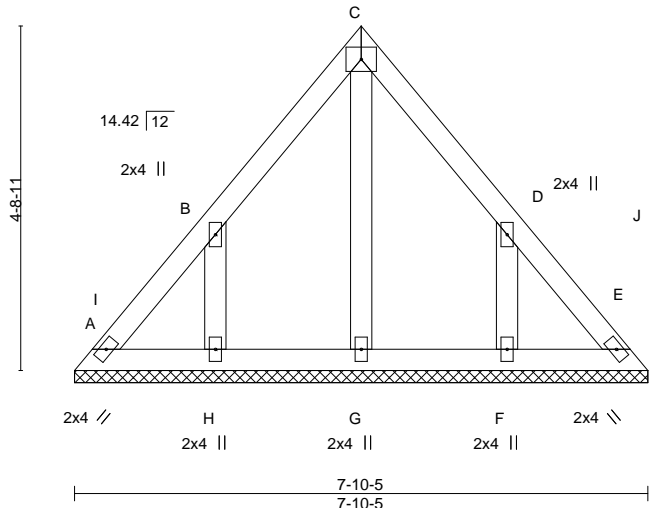

LOADING (psf)	SPACING-	CSI.	DEFL.	PLATES	GRIP
TCLL 25.0 (Roof Snow=25.0)	2-0-0 Plate Grip DOL 1.15 Lumber DOL 1.15	TC 0.12 BC 0.03 WB 0.07 Matrix-P	in (loc) l/defl L/d Vert(LL) n/a - n/a 999 Vert(CT) n/a - n/a 999 Horz(CT) 0.00 E n/a n/a	MT20	244/190
TCDL 10.0	Rep Stress Incr YES			Weight: 40 lb	FT = 20%
BCLL 0.0	Code IRC2018/TPI2014				
BCDL 10.0					

LUMBER-	BRACING-
TOP CHORD 2x4 SP No.2	TOP CHORD Structural wood sheathing directly applied or 6-0-0 oc purlins.
BOT CHORD 2x4 SP No.2	BOT CHORD Rigid ceiling directly applied or 10-0-0 oc bracing.
OTHERS 2x4 SP No.3	

REACTIONS. All bearings 7-10-5.
 (lb) - Max Horz A=-114(LC 10)
 Max Uplift All uplift 100 lb or less at joint(s) A, E except H=-163(LC 12), F=-162(LC 13)
 Max Grav All reactions 250 lb or less at joint(s) A, E, G except H=318(LC 18), F=318(LC 19)

FORCES. (lb) - Max. Comp./Max. Ten. - All forces 250 (lb) or less except when shown.
WEBS B-H=-277/187, D-F=-277/187

- NOTES-**
- 1) Wind: ASCE 7-16; Vult=115mph (3-second gust) Vasd=91mph; TCDL=6.0psf; BCDL=6.0psf; h=20ft; Cat. II; Exp C; Enclosed; MWFRS (envelope) gable end zone and C-C Exterior(2E) 0-3-12 to 3-3-12, Exterior(2R) 3-3-12 to 4-6-10, Exterior(2E) 4-6-10 to 7-6-10 zone; cantilever left and right exposed; end vertical left and right exposed; C-C for members and forces & MWFRS for reactions shown; Lumber DOL=1.33 plate grip DOL=1.33
 - 2) TCLL: ASCE 7-16; Pf=25.0 psf (Lum DOL=1.15 Plate DOL=1.15); Is=1.0; Rough Cat C; Fully Exp.; Ce=0.9; Cs=1.00; Ct=1.10
 - 3) Unbalanced snow loads have been considered for this design.
 - 4) Gable requires continuous bottom chord bearing.
 - 5) This truss has been designed for a 10.0 psf bottom chord live load nonconcurrent with any other live loads.
 - 6) Provide mechanical connection (by others) of truss to bearing plate capable of withstanding 100 lb uplift at joint(s) A, E except (jt=) H=163, F=162.
 - 7) This truss is designed in accordance with the 2018 International Residential Code sections R502.11.1 and R802.10.2 and referenced standard ANSI/TPI 1.




November 27, 2024

<p>WARNING - Verify design parameters and READ NOTES ON THIS AND INCLUDED MITEK REFERENCE PAGE MII-7473 rev. 1/2/2023 BEFORE USE.</p> <p>Design valid for use only with MiTek® connectors. This design is based only upon parameters shown, and is for an individual building component, not a truss system. Before use, the building designer must verify the applicability of design parameters and properly incorporate this design into the overall building design. Bracing indicated is to prevent buckling of individual truss web and/or chord members only. Additional temporary and permanent bracing is always required for stability and to prevent collapse with possible personal injury and property damage. For general guidance regarding the fabrication, storage, delivery, erection and bracing of trusses and truss systems, see ANSI/TPI1 Quality Criteria, and DSB-22 available from Truss Plate Institute (www.tpinst.org) and BCSI Building Component Safety Information available from the Structural Building Component Association (www.sbcsccomponents.com)</p>	<p>16023 Swingley Ridge Rd. Chesterfield, MO 63017 314.434.1200 / MiTek-US.com</p>
---	--

Job 242042	Truss LAY02	Truss Type Lay-In Gable	Qty 1	Ply 1	GENE BOSLEY RES. / ROOF
---------------	----------------	----------------------------	----------	----------	-------------------------

RELEASE FOR CONSTRUCTION
AS NOTED FOR PLAN REVIEW
DEVELOPMENT SERVICES
LEE'S SUMMIT, MISSOURI
12/02/2024

Heartland Truss, Inc, Plattsburg, MO - 64477, 8.730 s Oct 31 2024 MiTek Industries, Inc. Wed No 27-17-46-06-2024 Page 1

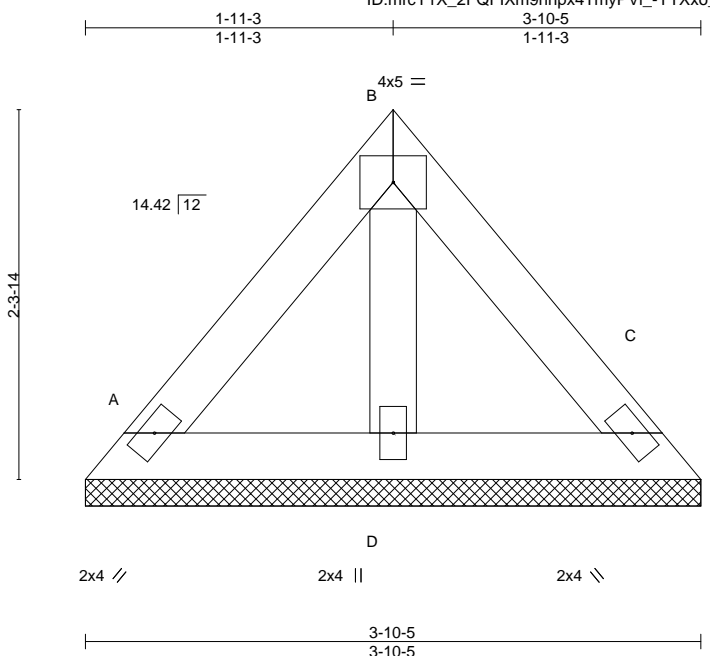

Scale = 1:14.5

LOADING (psf)	SPACING-	CSI.	DEFL.	PLATES	GRIP
TCLL 25.0 (Roof Snow=25.0)	2-0-0 Plate Grip DOL 1.15 Lumber DOL 1.15	TC 0.08 BC 0.03 WB 0.01 Matrix-P	in (loc) l/defl L/d Vert(LL) n/a - n/a 999 Vert(CT) n/a - n/a 999 Horz(CT) 0.00 C n/a n/a	MT20	244/190
TCDL 10.0	Rep Stress Incr YES				
BCLL 0.0	Code IRC2018/TP12014				
BCDL 10.0				Weight: 16 lb	FT = 20%

LUMBER-	BRACING-
TOP CHORD 2x4 SP No.2	TOP CHORD Structural wood sheathing directly applied or 3-10-5 oc purlins.
BOT CHORD 2x4 SP No.2	BOT CHORD Rigid ceiling directly applied or 10-0-0 oc bracing.
OTHERS 2x4 SP No.3	

REACTIONS. (size) A=3-10-5, C=3-10-5, D=3-10-5
 Max Horz A=-51(LC 8)
 Max Uplift A=-24(LC 13), C=-19(LC 12)
 Max Grav A=123(LC 18), C=123(LC 19), D=105(LC 19)

FORCES. (lb) - Max. Comp./Max. Ten. - All forces 250 (lb) or less except when shown.

- NOTES-**
- 1) Wind: ASCE 7-16; Vult=115mph (3-second gust) Vasd=91mph; TCDL=6.0psf; BCDL=6.0psf; h=20ft; Cat. II; Exp C; Enclosed; MWFRS (envelope) gable end zone and C-C Exterior(2E) zone; cantilever left and right exposed; end vertical left and right exposed; C-C for members and forces & MWFRS for reactions shown; Lumber DOL=1.33 plate grip DOL=1.33
 - 2) TCLL: ASCE 7-16; Pf=25.0 psf (Lum DOL=1.15 Plate DOL=1.15); Is=1.0; Rough Cat C; Fully Exp.; Ce=0.9; Cs=1.00; Ct=1.10
 - 3) Unbalanced snow loads have been considered for this design.
 - 4) Gable requires continuous bottom chord bearing.
 - 5) This truss has been designed for a 10.0 psf bottom chord live load nonconcurrent with any other live loads.
 - 6) Provide mechanical connection (by others) of truss to bearing plate capable of withstanding 100 lb uplift at joint(s) A, C.
 - 7) This truss is designed in accordance with the 2018 International Residential Code sections R502.11.1 and R802.10.2 and referenced standard ANSI/TP1 1.



November 27, 2024

Job 242042	Truss LAY03	Truss Type GABLE	Qty 1	Ply 1	GENE BOSLEY RES. / ROOF
---------------	----------------	---------------------	----------	----------	-------------------------

RELEASE FOR CONSTRUCTION


AS NOTED FOR PLAN REVIEW

DEVELOPMENT SERVICES

LEE'S SUMMIT, MISSOURI

12/02/2024

Heartland Truss, Inc, Plattsburg, MO - 64477, 8.730 s Oct 31 2024 MiTek Industries, Inc. Wed Nov 27 17:46:06 2024 Page 1

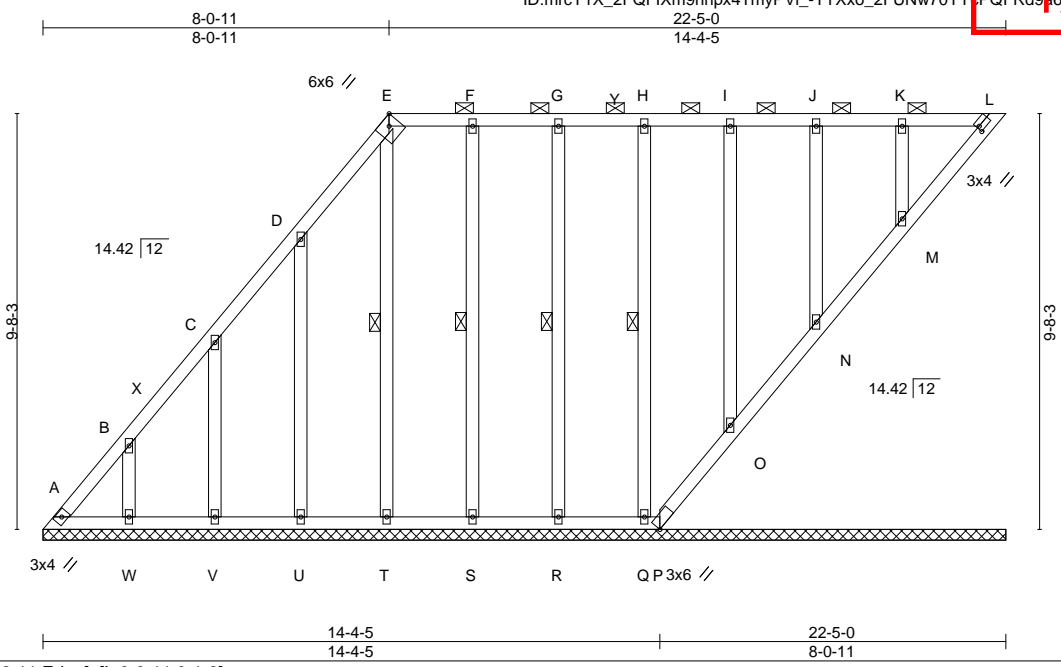

Scale = 1:53.6

Plate Offsets (X,Y)-- [E:0-2-11,Edge], [L:0-0-11,0-1-8]

LOADING (psf)	SPACING-	CSI.	DEFL.	PLATES	GRIP
TCLL 25.0 (Roof Snow=25.0)	2-0-0 Plate Grip DOL 1.15 Lumber DOL 1.15	TC 0.14 BC 0.04 WB 0.30 Matrix-S	in (loc) l/defl L/d Vert(LL) n/a - n/a 999 Vert(CT) n/a - n/a 999 Horz(CT) -0.00 L n/a n/a	MT20	244/190
TCDL 10.0	Rep Stress Incr YES				
BCLL 0.0	Code IRC2018/TPI2014				
BCDL 10.0				Weight: 173 lb	FT = 20%

LUMBER-	BRACING-
TOP CHORD 2x4 SP No.2	TOP CHORD Structural wood sheathing directly applied or 6-0-0 oc purlins, except 2-0-0 oc purlins (6-0-0 max.): E-L.
BOT CHORD 2x4 SP No.2	BOT CHORD Rigid ceiling directly applied or 10-0-0 oc bracing.
OTHERS 2x4 SP No.3	WEBS 1 Row at midpt E-T, F-S, G-R, H-Q

REACTIONS. All bearings 22-5-0.
 (lb) - Max Horz A=365(LC 12)
 Max Uplift All uplift 100 lb or less at joint(s) A, L, P, S, R, Q, O, N, M except W=-146(LC 12), V=-140(LC 12), U=-156(LC 12)
 Max Grav All reactions 250 lb or less at joint(s) L, P, T except A=315(LC 12), W=342(LC 29), V=326(LC 29), U=358(LC 29), S=346(LC 28), R=334(LC 28), Q=323(LC 28), O=336(LC 28), N=318(LC 28), M=388(LC 28)

FORCES. (lb) - Max. Comp./Max. Ten. - All forces 250 (lb) or less except when shown.
 TOP CHORD A-B=-424/326, B-C=-283/214
 WEBS B-W=-292/163, C-V=-288/165, D-U=-318/180, F-S=-306/59, G-R=-293/55, H-Q=-290/53, I-O=-295/54, J-N=-282/52, K-M=-333/60

- NOTES-**
- 1) Wind: ASCE 7-16; Vult=115mph (3-second gust) Vasd=91mph; TCDL=6.0psf; BCDL=6.0psf; h=20ft; Cat. II; Exp C; Enclosed; MWFRS (envelope) gable end zone and C-C Exterior(2E) 0-3-12 to 3-3-12, Interior(1) 3-3-12 to 5-0-11, Exterior(2R) 5-0-11 to 11-0-11, Interior(1) 11-0-11 to 19-1-4, Exterior(2E) 19-1-4 to 22-1-4 zone; cantilever left and right exposed ; end vertical left and right exposed;C-C for members and forces & MWFRS for reactions shown; Lumber DOL=1.33 plate grip DOL=1.33
 - 2) TCLL: ASCE 7-16; Pf=25.0 psf (Lum DOL=1.15 Plate DOL=1.15); Is=1.0; Rough Cat C; Fully Exp.; Ce=0.9; Cs=1.00; Ct=1.10
 - 3) Unbalanced snow loads have been considered for this design.
 - 4) Provide adequate drainage to prevent water ponding.
 - 5) All plates are 2x4 MT20 unless otherwise indicated.
 - 6) Gable requires continuous bottom chord bearing.
 - 7) This truss has been designed for a 10.0 psf bottom chord live load nonconcurrent with any other live loads.
 - 8) Provide mechanical connection (by others) of truss to bearing plate capable of withstanding 100 lb uplift at joint(s) A, L, P, S, R, Q, O, N, M except (jt=lb) W=146, V=140, U=156.
 - 9) Beveled plate or shim required to provide full bearing surface with truss chord at joint(s) L, O, N, M.
 - 10) This truss is designed in accordance with the 2018 International Residential Code sections R502.11.1 and R802.10.2 and referenced standard ANSI/TPI 1.
 - 11) Graphical purlin representation does not depict the size or the orientation of the purlin along the top and/or bottom chord.



November 27, 2024

Job 242042	Truss LAY04	Truss Type GABLE	Qty 1	Ply 1	GENE BOSLEY RES. / ROOF
---------------	----------------	---------------------	----------	----------	-------------------------

RELEASE FOR CONSTRUCTION
AS NOTED FOR PLAN REVIEW
DEVELOPMENT SERVICES
LEE'S SUMMIT, MISSOURI
12/02/2024

Heartland Truss, Inc, Plattsburg, MO - 64477, 8.730 s Oct 31 2024 MiTek Industries, Inc. Wed Nov 27 17:46:07 2024 Page 1
 ID: mrcY1X_2FQFXm9hhpx4TmyPVL_0f5J?K3tFh2_dj7bz8mgAM711uUjBk3ZQC2jyE276

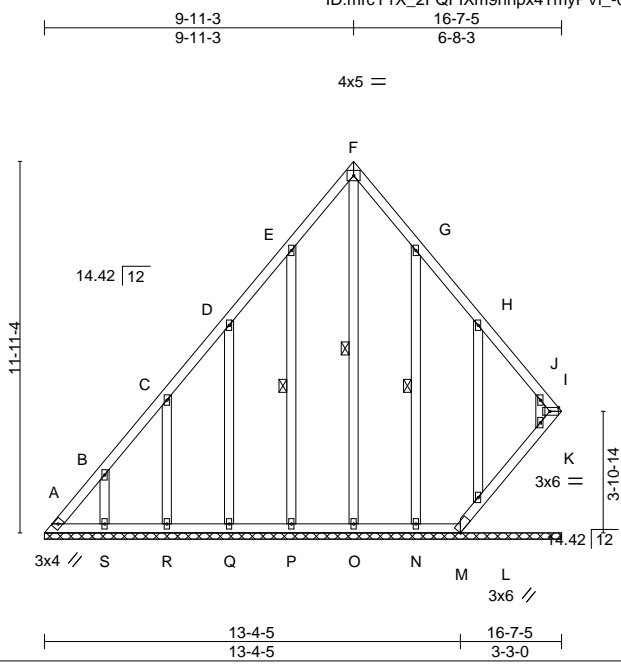


Plate Offsets (X,Y)--	[J:Edge,0-1-8]
-----------------------	----------------

LOADING (psf)	SPACING-	CSI.	DEFL.	in (loc)	l/defl	L/d	PLATES	GRIP
TCLL 25.0 (Roof Snow=25.0)	2-0-0 Plate Grip DOL 1.15 Lumber DOL 1.15	TC 0.12 BC 0.06 WB 0.18 Matrix-S	Vert(LL) n/a Vert(CT) n/a Horz(CT) 0.01	-	n/a	999	MT20	244/190
TCDL 10.0	Rep Stress Incr YES			J	n/a	n/a		
BCLL 0.0	Code IRC2018/TPI2014							
BCDL 10.0							Weight: 138 lb	FT = 20%

LUMBER-	BRACING-
TOP CHORD 2x4 SP No.2	TOP CHORD Structural wood sheathing directly applied or 6-0-0 oc purlins.
BOT CHORD 2x4 SP No.2	BOT CHORD Rigid ceiling directly applied or 10-0-0 oc bracing. Except:
OTHERS 2x4 SP No.3	WEBS 1 Row at midpt F-0, E-P, G-N

REACTIONS. All bearings 16-7-5.
 (lb) - Max Horz A=287(LC 9)
 Max Uplift All uplift 100 lb or less at joint(s) except A=-156(LC 10), J=-258(LC 11), M=-227(LC 13), P=-140(LC 12), Q=-146(LC 12), R=-142(LC 12), S=-143(LC 12), N=-142(LC 13), L=-133(LC 13), K=-121(LC 13)
 Max Grav All reactions 250 lb or less at joint(s) M, O, Q, R, S, L, K except A=356(LC 12), J=444(LC 13), P=329(LC 18), N=325(LC 19)

FORCES. (lb) - Max. Comp./Max. Ten. - All forces 250 (lb) or less except when shown.
 TOP CHORD A-B=-475/329, B-C=-338/214, I-J=-294/195
 BOT CHORD L-M=-175/299, K-L=-184/286, J-K=-183/273
 WEBS E-P=-289/164, G-N=-288/162

- NOTES-**
- 1) Wind: ASCE 7-16; Vult=115mph (3-second gust) Vasd=91mph; TCDL=6.0psf; BCDL=6.0psf; h=20ft; Cat. II; Exp C; Enclosed; MWFRS (envelope) gable end zone and C-C Exterior(2E) 0-3-12 to 3-3-12, Interior(1) 3-3-12 to 6-11-3, Exterior(2R) 6-11-3 to 12-11-3, Interior(1) 12-11-3 to 13-5-1, Exterior(2E) 13-5-1 to 16-5-1 zone; cantilever left and right exposed; end vertical left and right exposed; C-C for members and forces & MWFRS for reactions shown; Lumber DOL=1.33 plate grip DOL=1.33
 - 2) TCLL: ASCE 7-16; Pf=25.0 psf (Lum DOL=1.15 Plate DOL=1.15); Is=1.0; Rough Cat C; Fully Exp.; Ce=0.9; Cs=1.00; Ct=1.10
 - 3) Unbalanced snow loads have been considered for this design.
 - 4) All plates are 2x4 MT20 unless otherwise indicated.
 - 5) Gable requires continuous bottom chord bearing.
 - 6) This truss has been designed for a 10.0 psf bottom chord live load nonconcurrent with any other live loads.
 - 7) Provide mechanical connection (by others) of truss to bearing plate capable of withstanding 156 lb uplift at joint A, 258 lb uplift at joint J, 227 lb uplift at joint M, 140 lb uplift at joint P, 146 lb uplift at joint Q, 142 lb uplift at joint R, 143 lb uplift at joint S, 142 lb uplift at joint N, 133 lb uplift at joint L and 121 lb uplift at joint K.
 - 8) Beveled plate or shim required to provide full bearing surface with truss chord at joint(s) J, L, K.
 - 9) This truss is designed in accordance with the 2018 International Residential Code sections R502.11.1 and R802.10.2 and referenced standard ANSI/TPI 1.



November 27, 2024

<p>WARNING - Verify design parameters and READ NOTES ON THIS AND INCLUDED MITEK REFERENCE PAGE MII-7473 rev. 1/2/2023 BEFORE USE.</p> <p>Design valid for use only with MiTek® connectors. This design is based only upon parameters shown, and is for an individual building component, not a truss system. Before use, the building designer must verify the applicability of design parameters and properly incorporate this design into the overall building design. Bracing indicated is to prevent buckling of individual truss web and/or chord members only. Additional temporary and permanent bracing is always required for stability and to prevent collapse with possible personal injury and property damage. For general guidance regarding the fabrication, storage, delivery, erection and bracing of trusses and truss systems, see ANSI/TPI1 Quality Criteria, and DSB-22 available from Truss Plate Institute (www.tpinst.org) and BCSI Building Component Safety Information available from the Structural Building Component Association (www.sbcsccomponents.com)</p>	<p>16023 Swingley Ridge Rd. Chesterfield, MO 63017 314.434.1200 / MiTek-US.com</p>
---	--

Job 242042	Truss LAY05	Truss Type GABLE	Qty 1	Ply 1	GENE BOSLEY RES. / ROOF
---------------	----------------	---------------------	----------	----------	-------------------------

RELEASE FOR CONSTRUCTION

AS NOTED FOR PLAN REVIEW

DEVELOPMENT SERVICES

LEE'S SUMMIT, MISSOURI

12/02/2024

Heartland Truss, Inc, Plattsburg, MO - 64477, 8.730 s Oct 31 2024 MiTek Industries, Inc. Wed Nov 27 17:46:08 2024 Page 1

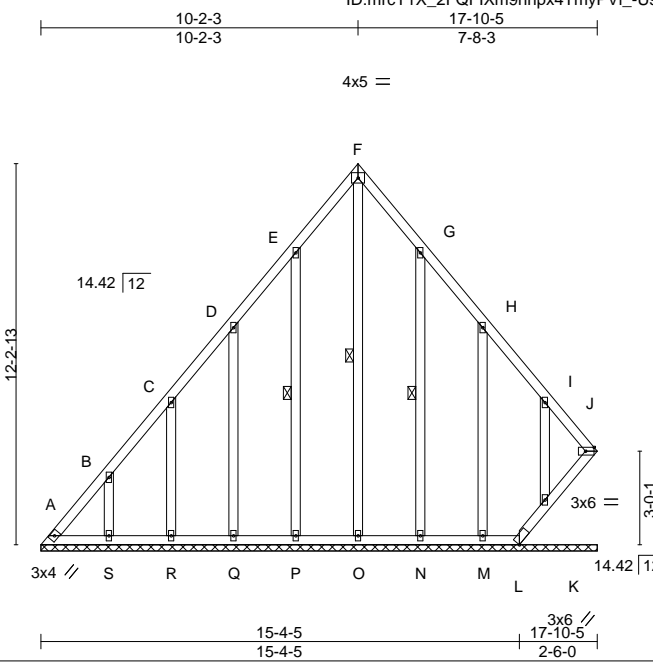


Plate Offsets (X,Y)-- [J:Edge,0-1-8]

LOADING (psf)	SPACING-	CSI.	DEFL.	in (loc)	l/defl	L/d	PLATES	GRIP
TCLL 25.0 (Roof Snow=25.0)	Plate Grip DOL 1.15	TC 0.12	Vert(LL) n/a	-	n/a	999	MT20	244/190
TCDL 10.0	Lumber DOL 1.15	BC 0.08	Vert(CT) n/a	-	n/a	999		
BCLL 0.0	Rep Stress Incr YES	WB 0.19	Horz(CT) 0.01	J	n/a	n/a		
BCDL 10.0	Code IRC2018/TPI2014	Matrix-S					Weight: 149 lb	FT = 20%

LUMBER-	BRACING-
TOP CHORD 2x4 SP No.2	TOP CHORD Structural wood sheathing directly applied or 6-0-0 oc purlins.
BOT CHORD 2x4 SP No.2	BOT CHORD Rigid ceiling directly applied or 10-0-0 oc bracing.
OTHERS 2x4 SP No.3	WEBS 1 Row at midpt F-O, E-P, G-N

REACTIONS. All bearings 17-10-5.
 (lb) - Max Horz A=299(LC 9)
 Max Uplift All uplift 100 lb or less at joint(s) except A=-156(LC 10), J=-226(LC 11), L=-262(LC 13), P=-139(LC 12), Q=-147(LC 12), R=-139(LC 12), S=-155(LC 12), N=-136(LC 13), M=-155(LC 13), K=-126(LC 13)
 Max Grav All reactions 250 lb or less at joint(s) L, O, Q, R, S, M, K except A=353(LC 12), J=474(LC 13), P=328(LC 18), N=329(LC 19)

FORCES. (lb) - Max. Comp./Max. Ten. - All forces 250 (lb) or less except when shown.
 TOP CHORD A-B=-475/320, B-C=-325/207, I-J=-294/191
 BOT CHORD K-L=-221/350, J-K=-227/342
 WEBS E-P=-289/163, G-N=-288/161

- NOTES-**
- 1) Wind: ASCE 7-16; Vult=115mph (3-second gust) Vasd=91mph; TCDL=6.0psf; BCDL=6.0psf; h=20ft; Cat. II; Exp C; Enclosed; MWFRS (envelope) gable end zone and C-C Exterior(2E) 0-3-12 to 3-3-12, Interior(1) 3-3-12 to 7-2-3, Exterior(2R) 7-2-3 to 13-2-3, Interior(1) 13-2-3 to 14-8-1, Exterior(2E) 14-8-1 to 17-8-1 zone; cantilever left and right exposed; end vertical left and right exposed; C-C for members and forces & MWFRS for reactions shown; Lumber DOL=1.33 plate grip DOL=1.33
 - 2) TCLL: ASCE 7-16; Pf=25.0 psf (Lum DOL=1.15 Plate DOL=1.15); Is=1.0; Rough Cat C; Fully Exp.; Ce=0.9; Cs=1.00; Ct=1.10
 - 3) Unbalanced snow loads have been considered for this design.
 - 4) All plates are 2x4 MT20 unless otherwise indicated.
 - 5) Gable requires continuous bottom chord bearing.
 - 6) This truss has been designed for a 10.0 psf bottom chord live load nonconcurrent with any other live loads.
 - 7) Provide mechanical connection (by others) of truss to bearing plate capable of withstanding 156 lb uplift at joint A, 226 lb uplift at joint J, 262 lb uplift at joint L, 139 lb uplift at joint P, 147 lb uplift at joint Q, 139 lb uplift at joint R, 155 lb uplift at joint S, 136 lb uplift at joint N, 155 lb uplift at joint M and 126 lb uplift at joint K.
 - 8) Beveled plate or shim required to provide full bearing surface with truss chord at joint(s) J, K.
 - 9) This truss is designed in accordance with the 2018 International Residential Code sections R502.11.1 and R802.10.2 and referenced standard ANSI/TPI 1.



November 27, 2024

WARNING - Verify design parameters and READ NOTES ON THIS AND INCLUDED MITEK REFERENCE PAGE MII-7473 rev. 1/2/2023 BEFORE USE.

Design valid for use only with MiTek® connectors. This design is based only upon parameters shown, and is for an individual building component, not a truss system. Before use, the building designer must verify the applicability of design parameters and properly incorporate this design into the overall building design. Bracing indicated is to prevent buckling of individual truss web and/or chord members only. Additional temporary and permanent bracing is always required for stability and to prevent collapse with possible personal injury and property damage. For general guidance regarding the fabrication, storage, delivery, erection and bracing of trusses and truss systems, see **ANSI/TPI1 Quality Criteria, and DSB-22** available from Truss Plate Institute (www.tpinst.org) and **BCSI Building Component Safety Information** available from the Structural Building Component Association (www.sbcsccomponents.com)

MiTek®
 16023 Swingley Ridge Rd.
 Chesterfield, MO 63017
 314.434.1200 / MiTek-US.com

Job	Truss	Truss Type	Qty	Ply	GENE BOSLEY RES. / ROOF
242042	LAY06	GABLE	1	1	

RELEASE FOR CONSTRUCTION


AS NOTED FOR PLAN REVIEW

DEVELOPMENT SERVICES

LEE'S SUMMIT, MISSOURI

12/02/2024

Heartland Truss, Inc, Plattsburg, MO - 64477, 8.730 s Oct 31 2024 MiTek Industries, Inc. Wed Nov 27 17:46:08 2024 Page 1

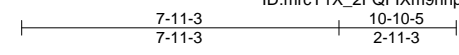

4x5 =

Scale = 1:57.6

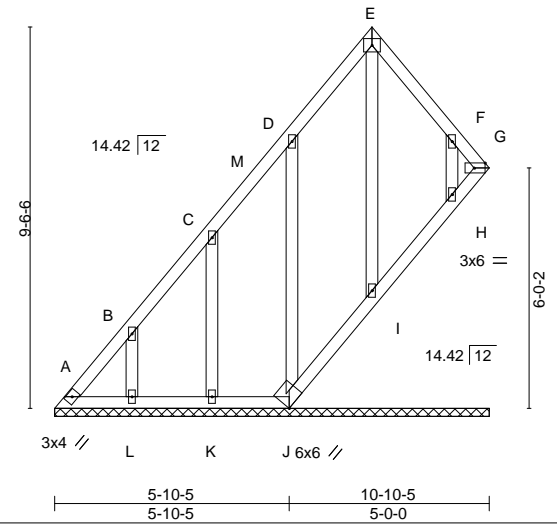


Plate Offsets (X,Y)-- [G:Edge,0-1-8]

LOADING (psf)	SPACING-	CSI.	DEFL.	PLATES	GRIP
TCLL 25.0 (Roof Snow=25.0)	2-0-0 Plate Grip DOL 1.15 Lumber DOL 1.15	TC 0.11 BC 0.04 WB 0.19 Matrix-S	in (loc) l/defl L/d Vert(LL) n/a - n/a 999 Vert(CT) n/a - n/a 999 Horz(CT) 0.00 G n/a n/a	MT20	244/190
TCDL 10.0	Rep Stress Incr YES				
BCLL 0.0	Code IRC2018/TPI2014				
BCDL 10.0				Weight: 75 lb	FT = 20%

LUMBER-	BRACING-
TOP CHORD 2x4 SP No.2	TOP CHORD Structural wood sheathing directly applied or 6-0-0 oc purlins.
BOT CHORD 2x4 SP No.2	BOT CHORD Rigid ceiling directly applied or 10-0-0 oc bracing. Except:
OTHERS 2x4 SP No.3	6-0-0 oc bracing: G-H.

REACTIONS. All bearings 10-10-5.
 (lb) - Max Horz A=284(LC 12)
 Max Uplift All uplift 100 lb or less at joint(s) except A=-103(LC 10), G=-104(LC 9), J=-129(LC 12), K=-143(LC 12), L=-143(LC 12), H=-127(LC 13)
 Max Grav All reactions 250 lb or less at joint(s) G, J, I, K, L except A=278(LC 12), H=284(LC 19)

FORCES. (lb) - Max. Comp./Max. Ten. - All forces 250 (lb) or less except when shown.
 TOP CHORD A-B=-374/288
 WEBS F-H=-251/145

- NOTES-**
- 1) Wind: ASCE 7-16; Vult=115mph (3-second gust) Vasd=91mph; TCDL=6.0psf; BCDL=6.0psf; h=20ft; Cat. II; Exp C; Enclosed; MWFRS (envelope) gable end zone and C-C Exterior(2E) 0-3-12 to 3-3-12, Interior(1) 3-3-12 to 4-11-3, Exterior(2R) 4-11-3 to 7-11-3, Exterior(2E) 7-11-3 to 10-8-1 zone; cantilever left and right exposed; end vertical left and right exposed; C-C for members and forces & MWFRS for reactions shown; Lumber DOL=1.33 plate grip DOL=1.33
 - 2) TCLL: ASCE 7-16; Pf=25.0 psf (Lum DOL=1.15 Plate DOL=1.15); Is=1.0; Rough Cat C; Fully Exp.; Ce=0.9; Cs=1.00; Ct=1.10
 - 3) Unbalanced snow loads have been considered for this design.
 - 4) All plates are 2x4 MT20 unless otherwise indicated.
 - 5) Gable requires continuous bottom chord bearing.
 - 6) This truss has been designed for a 10.0 psf bottom chord live load nonconcurrent with any other live loads.
 - 7) Provide mechanical connection (by others) of truss to bearing plate capable of withstanding 103 lb uplift at joint A, 104 lb uplift at joint G, 129 lb uplift at joint J, 143 lb uplift at joint K, 143 lb uplift at joint L and 127 lb uplift at joint H.
 - 8) Beveled plate or shim required to provide full bearing surface with truss chord at joint(s) G, I, H.
 - 9) This truss is designed in accordance with the 2018 International Residential Code sections R502.11.1 and R802.10.2 and referenced standard ANSI/TPI 1.




November 27, 2024

<p>WARNING - Verify design parameters and READ NOTES ON THIS AND INCLUDED MITEK REFERENCE PAGE MII-7473 rev. 1/2/2023 BEFORE USE.</p> <p>Design valid for use only with MiTek® connectors. This design is based only upon parameters shown, and is for an individual building component, not a truss system. Before use, the building designer must verify the applicability of design parameters and properly incorporate this design into the overall building design. Bracing indicated is to prevent buckling of individual truss web and/or chord members only. Additional temporary and permanent bracing is always required for stability and to prevent collapse with possible personal injury and property damage. For general guidance regarding the fabrication, storage, delivery, erection and bracing of trusses and truss systems, see ANSI/TPI1 Quality Criteria, and DSB-22 available from Truss Plate Institute (www.tpinst.org) and BCSI Building Component Safety Information available from the Structural Building Component Association (www.sbcsccomponents.com)</p>	<p>16023 Swingley Ridge Rd. Chesterfield, MO 63017 314.434.1200 / MiTek-US.com</p>
---	--

Job 242042	Truss LAY07	Truss Type GABLE	Qty 1	Ply 1	GENE BOSLEY RES. / ROOF
---------------	----------------	---------------------	----------	----------	-------------------------

RELEASE FOR CONSTRUCTION
AS NOTED FOR PLAN REVIEW
DEVELOPMENT SERVICES
LEE'S SUMMIT, MISSOURI
12/02/2024

Heartland Truss, Inc, Plattsburg, MO - 64477, 8.730 s Oct 31 2024 MiTek Industries, Inc. Wed Nov 27 07:46:09 2024 Page 1
 ID: mrcY1X_2FQFIXm9hpx4TmyPVL_y2C3Q048nllit7HB4Zp8FhCaRZmsn6WjU3nyE274

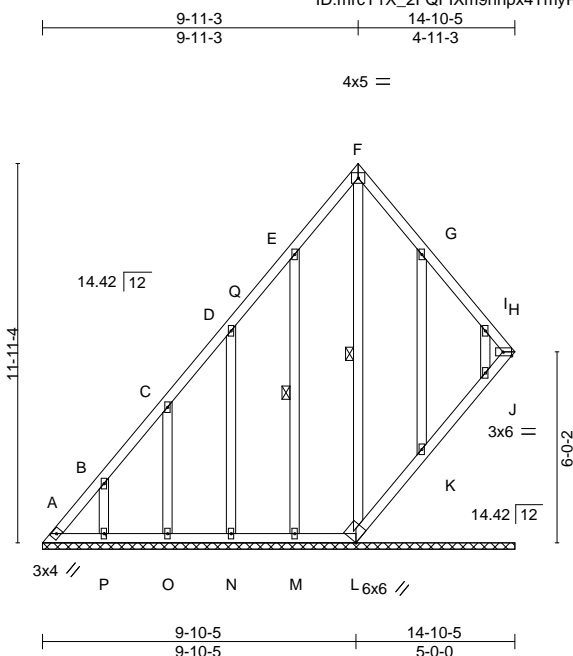

Scale = 1:72.5

Plate Offsets (X,Y)-- [I:Edge,0-1-8]

LOADING (psf)	SPACING-	CSI.	DEFL.	PLATES	GRIP
TCLL 25.0 (Roof Snow=25.0)	2-0-0 Plate Grip DOL 1.15 Lumber DOL 1.15	TC 0.12 BC 0.05 WB 0.23 Matrix-S	in (loc) l/defl L/d Vert(LL) n/a - n/a 999 Vert(CT) n/a - n/a 999 Horz(CT) 0.01 l n/a n/a	MT20	244/190
TCDL 10.0	Rep Stress Incr YES				
BCLL 0.0	Code IRC2018/TPI2014				
BCDL 10.0				Weight: 121 lb	FT = 20%

LUMBER-	BRACING-
TOP CHORD 2x4 SP No.2	TOP CHORD Structural wood sheathing directly applied or 6-0-0 oc purlins.
BOT CHORD 2x4 SP No.2	BOT CHORD Rigid ceiling directly applied or 10-0-0 oc bracing.
OTHERS 2x4 SP No.3	WEBS 1 Row at midpt F-L, E-M

REACTIONS. All bearings 14-10-5.
 (lb) - Max Horz A=324(LC 12)
 Max Uplift All uplift 100 lb or less at joint(s) L except A=-149(LC 10), I=-172(LC 11), M=-141(LC 12),
 N=-146(LC 12), O=-142(LC 12), P=-143(LC 12), K=-141(LC 13), J=-125(LC 13)
 Max Grav All reactions 250 lb or less at joint(s) L, N, O, P, J except A=366(LC 12), I=273(LC 13), M=325(LC 18), K=336(LC 19)

FORCES. (lb) - Max. Comp./Max. Ten. - All forces 250 (lb) or less except when shown.
 TOP CHORD A-B=-489/355, B-C=-351/239
 WEBS E-M=-284/165, G-K=-291/170

- NOTES-**
- 1) Wind: ASCE 7-16; Vult=115mph (3-second gust) Vasd=91mph; TCDL=6.0psf; BCDL=6.0psf; h=20ft; Cat. II; Exp C; Enclosed; MWFRS (envelope) gable end zone and C-C Exterior(2E) 0-3-12 to 3-3-12, Interior(1) 3-3-12 to 6-11-3, Exterior(2R) 6-11-3 to 11-11-3, Exterior(2E) 11-11-3 to 14-8-1 zone; cantilever left and right exposed; end vertical left and right exposed; C-C for members and forces & MWFRS for reactions shown; Lumber DOL=1.33 plate grip DOL=1.33
 - 2) TCLL: ASCE 7-16; Pf=25.0 psf (Lum DOL=1.15 Plate DOL=1.15); Is=1.0; Rough Cat C; Fully Exp.; Ce=0.9; Cs=1.00; Ct=1.10
 - 3) Unbalanced snow loads have been considered for this design.
 - 4) All plates are 2x4 MT20 unless otherwise indicated.
 - 5) Gable requires continuous bottom chord bearing.
 - 6) This truss has been designed for a 10.0 psf bottom chord live load nonconcurrent with any other live loads.
 - 7) Provide mechanical connection (by others) of truss to bearing plate capable of withstanding 100 lb uplift at joint(s) L except (jt=lb) A=149, I=172, M=141, N=146, O=142, P=143, K=141, J=125.
 - 8) Beveled plate or shim required to provide full bearing surface with truss chord at joint(s) I, K, J.
 - 9) This truss is designed in accordance with the 2018 International Residential Code sections R502.11.1 and R802.10.2 and referenced standard ANSI/TPI 1.



November 27, 2024

Job 242042	Truss LAY08	Truss Type GABLE	Qty 1	Ply 1	GENE BOSLEY RES. / ROOF
---------------	----------------	---------------------	----------	----------	-------------------------

RELEASE FOR CONSTRUCTION

AS NOTED FOR PLAN REVIEW


DEVELOPMENT SERVICES

LEE'S SUMMIT, MISSOURI


12/02/2024

Heartland Truss, Inc, Plattsburg, MO - 64477,

8.730 s Oct 31 2024 MiTek Industries, Inc. Wed Nov 27 07:46:09 2024 Page 1
 ID:mrcY1X_2FQFXm9hhpx4TmyPVL_y2C3Q048nllt7HB4Zp8fncr1ZnvSawWjU3nyE274

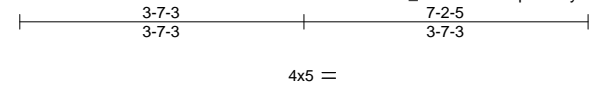

Scale = 1:29.2

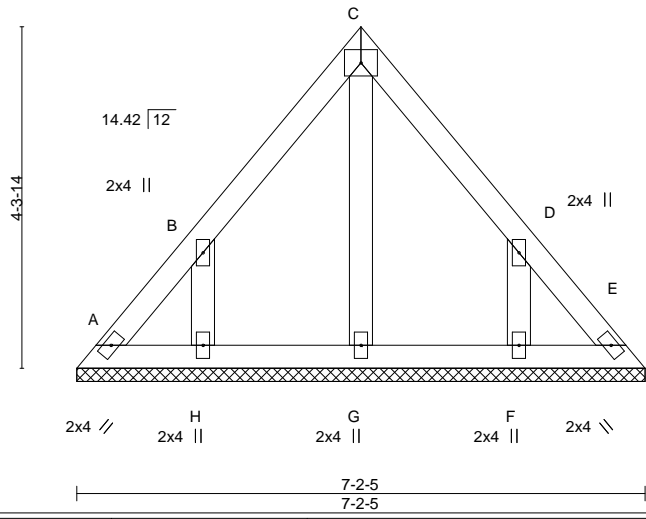

LOADING (psf)	SPACING-	CSI.	DEFL.	PLATES	GRIP
TCLL 25.0 (Roof Snow=25.0)	2-0-0 Plate Grip DOL 1.15 Lumber DOL 1.15	TC 0.10 BC 0.03 WB 0.06 Matrix-P	in (loc) l/defl L/d Vert(LL) n/a - n/a 999 Vert(CT) n/a - n/a 999 Horz(CT) 0.00 E n/a n/a	MT20	244/190
TCDL 10.0	Rep Stress Incr YES				
BCLL 0.0	Code IRC2018/TP12014			Weight: 36 lb	FT = 20%
BCDL 10.0					

LUMBER-	BRACING-
TOP CHORD 2x4 SP No.2	TOP CHORD Structural wood sheathing directly applied or 6-0-0 oc purlins.
BOT CHORD 2x4 SP No.2	BOT CHORD Rigid ceiling directly applied or 10-0-0 oc bracing.
OTHERS 2x4 SP No.3	

REACTIONS. All bearings 7-2-5.
 (lb) - Max Horz A=-104(LC 8)
 Max Uplift All uplift 100 lb or less at joint(s) A, E except H=-153(LC 12), F=-152(LC 13)
 Max Grav All reactions 250 lb or less at joint(s) A, E, G except H=294(LC 18), F=294(LC 19)

FORCES. (lb) - Max. Comp./Max. Ten. - All forces 250 (lb) or less except when shown.
WEBS B-H=-257/174, D-F=-257/174

- NOTES-**
- 1) Wind: ASCE 7-16; Vult=115mph (3-second gust) Vasd=91mph; TCDL=6.0psf; BCDL=6.0psf; h=20ft; Cat. II; Exp C; Enclosed; MWFRS (envelope) gable end zone and C-C Exterior(2E) zone; cantilever left and right exposed ; end vertical left and right exposed;C-C for members and forces & MWFRS for reactions shown; Lumber DOL=1.33 plate grip DOL=1.33
 - 2) TCLL: ASCE 7-16; Pf=25.0 psf (Lum DOL=1.15 Plate DOL=1.15); Is=1.0; Rough Cat C; Fully Exp.; Ce=0.9; Cs=1.00; Ct=1.10
 - 3) Unbalanced snow loads have been considered for this design.
 - 4) Gable requires continuous bottom chord bearing.
 - 5) This truss has been designed for a 10.0 psf bottom chord live load nonconcurrent with any other live loads.
 - 6) Provide mechanical connection (by others) of truss to bearing plate capable of withstanding 100 lb uplift at joint(s) A, E except (jt=lb) H=153, F=152.
 - 7) This truss is designed in accordance with the 2018 International Residential Code sections R502.11.1 and R802.10.2 and referenced standard ANSI/TPI 1.



November 27, 2024

Job 242042	Truss LAY09	Truss Type GABLE	Qty 1	Ply 1	GENE BOSLEY RES. / ROOF
---------------	----------------	---------------------	----------	----------	-------------------------


AS NOTED FOR PLAN REVIEW
DEVELOPMENT SERVICES
LEE'S SUMMIT, MISSOURI

Heartland Truss, Inc, Plattsburg, MO - 64477,

8.730 s Oct 31 2024 MiTek Industries, Inc. Wed No 27 17:46:10 2024 Page 3

ID:mrcY1X_2FQFXm9hhpx4TmyPVL_-REmSdL5mXcQZU9sCeGKNo?l=594MMHzmXcshZFR213

12/02/2024

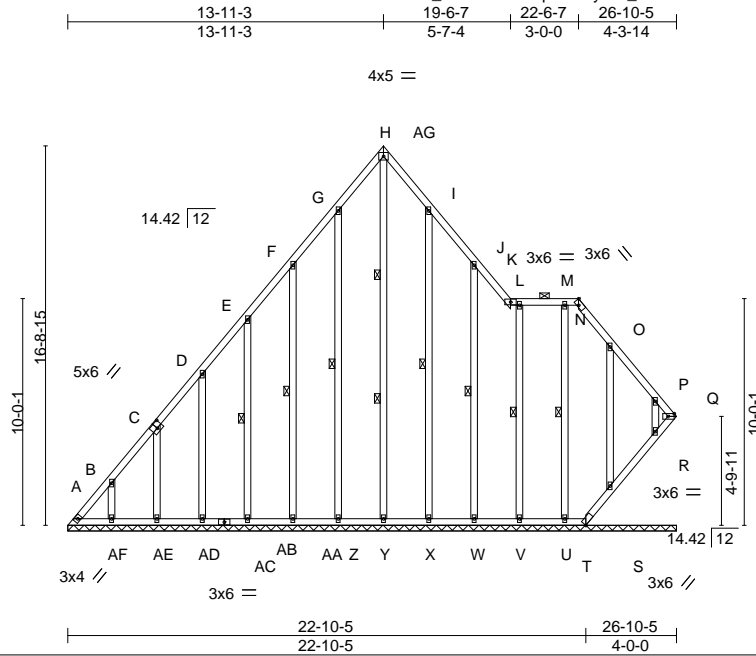

Scale = 1:101.7

Plate Offsets (X, Y)-- [C:0-3-0,0-3-0], [N:0-2-11,Edge], [Q:Edge,0-1-8]

LOADING (psf)	SPACING-	CSI.	DEFL.	in (loc)	l/defl	L/d	PLATES	GRIP
TCLL 25.0 (Roof Snow=25.0)	Plate Grip DOL 1.15	TC 0.13	Vert(LL) n/a	-	n/a	999	MT20	244/190
TCDL 10.0	Lumber DOL 1.15	BC 0.09	Vert(CT) n/a	-	n/a	999		
BCLL 0.0	Rep Stress Incr YES	WB 0.33	Horz(CT) 0.02	Q	n/a	n/a		
BCDL 10.0	Code IRC2018/TPI2014	Matrix-S					Weight: 274 lb	FT = 20%

LUMBER-
TOP CHORD 2x4 SP No.2
BOT CHORD 2x4 SP No.2
OTHERS 2x4 SP No.3

BRACING-
TOP CHORD Structural wood sheathing directly applied or 6-0-0 oc purlins, except 2-0-0 oc purlins (6-0-0 max.): K-N.
BOT CHORD Rigid ceiling directly applied or 10-0-0 oc bracing, Except: 6-0-0 oc bracing: Q-R.
WEBS 1 Row at midpt G-Z, F-AA, E-AB, I-X, J-W, L-V, M-U
2 Rows at 1/3 pts H-Y

REACTIONS. All bearings 26-10-5.
(lb) - Max Horz A=410(LC 9)
Max Uplift All uplift 100 lb or less at joint(s) Y, V except Q=-309(LC 11), A=-268(LC 10), T=-314(LC 13), Z=-129(LC 12), AA=-151(LC 12), AB=-140(LC 12), AD=-148(LC 12), AE=-140(LC 12), AF=-135(LC 12), X=-127(LC 13), W=-139(LC 13), U=-132(LC 13), S=-153(LC 13), R=-109(LC 13)
Max Grav All reactions 250 lb or less at joint(s) T, AA, AB, AD, AE, AF except Q=606(LC 13), A=524(LC 12), Y=355(LC 13), Z=326(LC 18), X=347(LC 34), W=340(LC 34), V=281(LC 33), U=272(LC 33), S=329(LC 46), R=288(LC 34)

FORCES. (lb) - Max. Comp./Max. Ten. - All forces 250 (lb) or less except when shown.
TOP CHORD A-B=-694/433, B-C=-563/353, C-D=-421/298, D-E=-270/237, G-H=-237/269, O-P=-287/183, P-Q=-394/258
BOT CHORD A-AF=-156/253, AE-AF=-156/253, AD-AE=-160/255, AB-AD=-160/255, AA-AB=-160/255, Z-AA=-160/255, Y-Z=-160/255, X-Y=-160/255, W-X=-160/255, V-W=-160/255, U-V=-160/255, T-U=-160/255, S-T=-261/419, R-S=-266/408, Q-R=-262/398
WEBS H-Y=-331/235, G-Z=-286/153, I-X=-307/151, J-W=-301/162, O-S=-298/191, P-R=-251/130

NOTES-

- 1) Wind: ASCE 7-16; Vult=115mph (3-second gust) Vasd=91mph; TCDL=6.0psf; BCDL=6.0psf; h=20ft; Cat. II; Exp C; Enclosed; MWFRS (envelope) gable end zone and C-C Exterior(2E) 0-3-12 to 3-3-12, Interior(1) 3-3-12 to 10-11-3, Exterior(2R) 10-11-3 to 16-11-3, Interior(1) 16-11-3 to 19-6-7, Exterior(2R) 19-6-7 to 23-11-3, Exterior(2E) 23-11-3 to 26-8-1 zone; cantilever left and right exposed; end vertical left and right exposed; C-C for members and forces & MWFRS for reactions shown; Lumber DOL=1.33 plate grip DOL=1.33
- 2) TCLL: ASCE 7-16; Pf=25.0 psf (Lum DOL=1.15 Plate DOL=1.15); Is=1.0; Rough Cat C; Fully Exp.; Ce=0.9; Cs=1.00; Ct=1.10
- 3) Unbalanced snow loads have been considered for this design.
- 4) Provide adequate drainage to prevent water ponding.
- 5) All plates are 2x4 MT20 unless otherwise indicated.
- 6) Gable requires continuous bottom chord bearing.
- 7) This truss has been designed for a 10.0 psf bottom chord live load nonconcurrent with any other live loads.
- 8) Provide mechanical connection (by others) of truss to bearing plate capable of withstanding 100 lb uplift at joint(s) Y, V except (jt=lb) Q=309, A=268, T=314, Z=129, AA=151, AB=140, AD=148, AE=140, AF=135, X=127, W=139, U=132, S=153, R=109.
- 9) Beveled plate or shim required to provide full bearing surface with truss chord at joint(s) Q, S, R.
- 10) This truss is designed in accordance with the 2018 International Residential Code sections R502.11.1 and R802.10.2 and conform to standard ANSI/TPI 1.



November 27, 2024

WARNING - Verify design parameters and READ NOTES ON THIS AND INCLUDED MITEK REFERENCE PAGE MII-7473 rev. 1/2/2023 BEFORE USE.

Design valid for use only with MiTek® connectors. This design is based only upon parameters shown, and is for an individual building component, not a truss system. Before use, the building designer must verify the applicability of design parameters and properly incorporate this design into the overall building design. Bracing indicated is to prevent buckling of individual truss web and/or chord members only. Additional temporary and permanent bracing is always required for stability and to prevent collapse with possible personal injury and property damage. For general guidance regarding the fabrication, storage, delivery, erection and bracing of trusses and truss systems, see **ANSI/TPI1 Quality Criteria, and DSB-22** available from Truss Plate Institute (www.tpinst.org) and **BCSI Building Component Safety Information** available from the Structural Building Component Association (www.sbcsccomponents.com)

MiTek®

16023 Swingley Ridge Rd.
Chesterfield, MO 63017
314.434.1200 / MiTek-US.com

Job 242042	Truss LAY09	Truss Type GABLE	Qty 1	Ply 1	GENE BOSLEY RES. / ROOF Job Reference (optional)
---------------	----------------	---------------------	----------	----------	---

RELEASE FOR CONSTRUCTION

AS NOTED FOR PLAN REVIEW
DEVELOPMENT SERVICES
LEE'S SUMMIT, MISSOURI

12/02/2024

Heartland Truss, Inc, Plattsburg, MO - 64477,

8.730 s Oct 31 2024 MiTek Industries, Inc. Wed No 27:17:46 10/2024 Page 2
ID:mrcY1X_2FQFIXm9hhpx4TmyPVL_-REmSdL5mXcQZU9sCeGKN0?l=59dMMHzmXcshZr213

NOTES-

11) Graphical purlin representation does not depict the size or the orientation of the purlin along the top and/or bottom chord.

 **WARNING - Verify design parameters and READ NOTES ON THIS AND INCLUDED MITEK REFERENCE PAGE MII-7473 rev. 1/2/2023 BEFORE USE.**

Design valid for use only with MiTek® connectors. This design is based only upon parameters shown, and is for an individual building component, not a truss system. Before use, the building designer must verify the applicability of design parameters and properly incorporate this design into the overall building design. Bracing indicated is to prevent buckling of individual truss web and/or chord members only. Additional temporary and permanent bracing is always required for stability and to prevent collapse with possible personal injury and property damage. For general guidance regarding the fabrication, storage, delivery, erection and bracing of trusses and truss systems, see **ANSI/TPI1 Quality Criteria, and DSB-22** available from Truss Plate Institute (www.tpinst.org) and **BCSI Building Component Safety Information** available from the Structural Building Component Association (www.sbcsccomponents.com)

MiTek®

16023 Swingley Ridge Rd.
Chesterfield, MO 63017
314.434.1200 / MiTek-US.com

Job 242042	Truss LAY10	Truss Type GABLE	Qty 1	Ply 1	GENE BOSLEY RES. / ROOF
---------------	----------------	---------------------	----------	----------	-------------------------

RELEASE FOR CONSTRUCTION

AS NOTED FOR PLAN REVIEW


DEVELOPMENT SERVICES

LEE'S SUMMIT, MISSOURI


12/02/2024

Heartland Truss, Inc, Plattsburg, MO - 64477, 8.730 s Oct 31 2024 MiTek Industries, Inc. Wed No 27-07-40-11-2024 Page 1

ID: mrcY1X_2FQFIXm9hhpx4TmyPVL_vQKqrh6OlwYQ6JQaC_rkKCHjBZrCF16_BMP82YK22

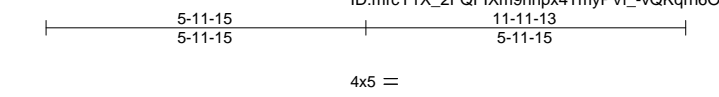

Scale = 1:43.2

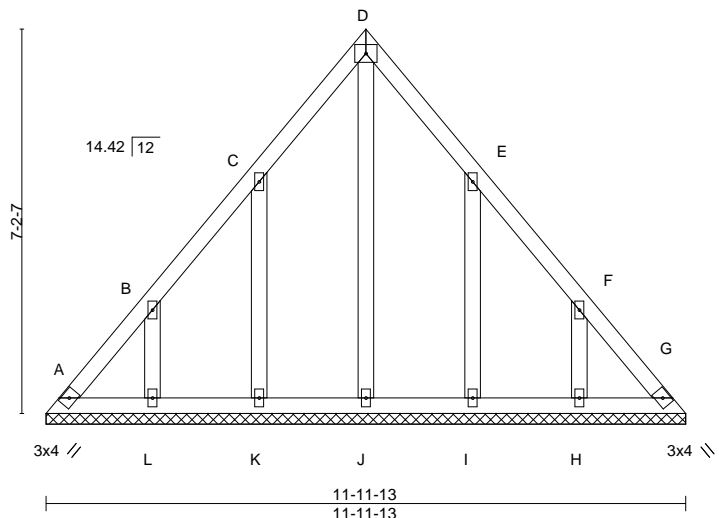

LOADING (psf)	SPACING-	CSI.	DEFL.	PLATES	GRIP
TCLL 25.0 (Roof Snow=25.0)	2-0-0 Plate Grip DOL 1.15 Lumber DOL 1.15 Rep Stress Incr YES Code IRC2018/TPI2014	TC 0.11 BC 0.05 WB 0.12 Matrix-S	in (loc) l/defl L/d Vert(LL) n/a - n/a 999 Vert(CT) n/a - n/a 999 Horz(CT) 0.00 G n/a n/a	MT20	244/190
TCDL 10.0				Weight: 72 lb	FT = 20%
BCLL 0.0					
BCDL 10.0					

LUMBER-	BRACING-
TOP CHORD 2x4 SP No.2	TOP CHORD Structural wood sheathing directly applied or 6-0-0 oc purlins.
BOT CHORD 2x4 SP No.2	BOT CHORD Rigid ceiling directly applied or 10-0-0 oc bracing.
OTHERS 2x4 SP No.3	

REACTIONS. All bearings 11-11-13.
 (lb) - Max Horz A=179(LC 9)
 Max Uplift All uplift 100 lb or less at joint(s) A, G except K=-147(LC 12), L=-146(LC 12), I=-146(LC 13), H=-146(LC 13)
 Max Grav All reactions 250 lb or less at joint(s) A, G, J, L, H except K=332(LC 18), I=332(LC 19)

FORCES. (lb) - Max. Comp./Max. Ten. - All forces 250 (lb) or less except when shown.
WEBS C-K=-293/173, E-I=-293/172


- NOTES-**
- 1) Wind: ASCE 7-16; Vult=115mph (3-second gust) Vasd=91mph; TCDL=6.0psf; BCDL=6.0psf; h=20ft; Cat. II; Exp C; Enclosed; MWFRS (envelope) gable end zone and C-C Exterior(2E) 0-3-12 to 3-3-12, Exterior(2R) 3-3-12 to 8-8-2, Exterior(2E) 8-8-2 to 11-8-2 zone; cantilever left and right exposed; end vertical left and right exposed; C-C for members and forces & MWFRS for reactions shown; Lumber DOL=1.33 plate grip DOL=1.33
 - 2) TCLL: ASCE 7-16; Pf=25.0 psf (Lum DOL=1.15 Plate DOL=1.15); Is=1.0; Rough Cat C; Fully Exp.; Ce=0.9; Cs=1.00; Ct=1.10
 - 3) Unbalanced snow loads have been considered for this design.
 - 4) All plates are 2x4 MT20 unless otherwise indicated.
 - 5) Gable requires continuous bottom chord bearing.
 - 6) This truss has been designed for a 10.0 psf bottom chord live load nonconcurrent with any other live loads.
 - 7) Provide mechanical connection (by others) of truss to bearing plate capable of withstanding 100 lb uplift at joint(s) A, G except (jt=lb) K=147, L=146, I=146, H=146.
 - 8) This truss is designed in accordance with the 2018 International Residential Code sections R502.11.1 and R802.10.2 and referenced standard ANSI/TPI 1.



November 27, 2024

PLATE LOCATION AND ORIENTATION

Center plate on joint unless x, y offsets are indicated. Dimensions are in ft-in-sixteenths. Apply plates to both sides of truss and fully embed teeth.

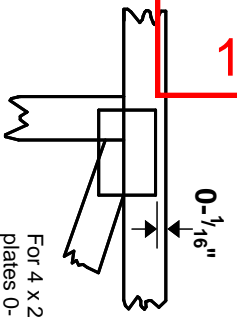

For 4 x 2 orientation, locate plates 0- 1/16" from outside edge of truss.

This symbol indicates the required direction of slots in connector plates.

* Plate location details available in MITek software or upon request.

PLATE SIZE

The first dimension is the plate width measured perpendicular to slots. Second dimension is the length parallel to slots.




LATERAL BRACING LOCATION



Indicated by symbol shown and/or by text in the bracing section of the output. Use T or I bracing if indicated.



BEARING

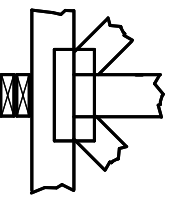

Indicates location where bearings (supports) occur. Icons vary but reaction section indicates joint number/letter where bearings occur. Min size shown is for crushing only.

Industry Standards:
ANSI/TPI 1: National Design Specification for Metal Plate Connected Wood Truss Construction.
DSB-22: Design Standard for Bracing.
BCSI: Building Component Safety Information, Guide to Good Practice for Handling, Installing, Restraining & Bracing of Metal Plate Connected Wood Trusses.

Numbering System

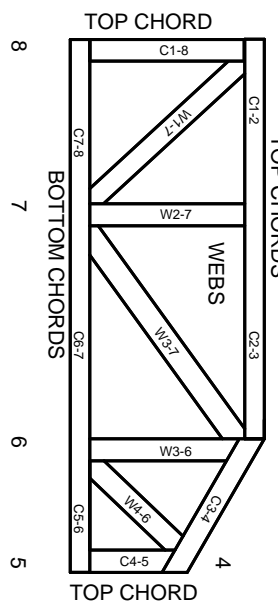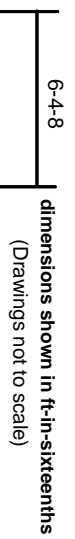

JOINTS ARE GENERALLY NUMBERED/LETTERED CLOCKWISE AROUND THE TRUSS STARTING AT THE JOINT FARTHEST TO THE LEFT.

CHORDS AND WEBS ARE IDENTIFIED BY END JOINT NUMBERS/LETTERS.

Product Code Approvals

ICC-ES Reports:
ESR-1-1988, ESR-2362, ESR-2685, ESR-3282
ESR-4722, ESL-1388

Design General Notes

Trusses are designed for wind loads in the plane of the truss unless otherwise shown.

Lumber design values are in accordance with ANSI/TPI 1 section 6.3. These truss designs rely on Lumber values established by others.

© 2023 MITek® All Rights Reserved

General Safety Notes

Failure to Follow Could Cause Property Damage or Personal Injury

1. Additional stability bracing for truss system, e.g. diagonal or X-bracing, is always required. See BCSI.
2. Truss bracing must be designed by an engineer. For wide truss spacing, individual lateral braces themselves may require bracing, or alternative Tor I bracing should be considered.
3. Never exceed the design loading shown and never stack materials on inadequately braced trusses.
4. Provide copies of this truss design to the building designer, erection supervisor, property owner and all other interested parties.
5. Cut members to bear tightly against each other.
6. Place plates on each face of truss at each joint and embed fully. Knots and wane at joint locations are regulated by ANSI/TPI 1.
7. Design assumes trusses will be suitably protected from the environment in accord with ANSI/TPI 1.
8. Unless otherwise noted, moisture content of lumber shall not exceed 19% at time of fabrication.
9. Unless expressly noted, this design is not applicable for use with fire retardant, preservative treated, or green lumber.
10. Camber is a non-structural consideration and is the responsibility of truss fabricator. General practice is to camber for dead load deflection.
11. Plate type, size, orientation and location dimensions indicated are minimum plating requirements.
12. Lumber used shall be of the species and size, and in all respects, equal to or better than that specified.
13. Top chords must be sheathed or purlins provided at spacing indicated on design.
14. Bottom chords require lateral bracing at 10 ft. spacing, or less, if no ceiling is installed, unless otherwise noted.
15. Connections not shown are the responsibility of others.
16. Do not cut or alter truss member or plate without prior approval of an engineer.
17. Install and load vertically unless indicated otherwise.
18. Use of green or treated lumber may pose unacceptable environmental, health or performance risks. Consult with project engineer before use.
19. Review all portions of this design (front, back, words and pictures) before use. Reviewing pictures alone is not sufficient.
20. Design assumes manufacture in accordance with ANSI/TPI 1 Quality Criteria.
21. The design does not take into account any dynamic or other loads other than those expressly stated.

