AS GRADED PLOT PLAN

Ordered by: Elevate Design and Build LLC
Description: Lot 141 Hook Farms, Second Plat, Lee's Summit, MO.
Address:2626 SW Firefly Ln.
Lot Area 10,818 sf

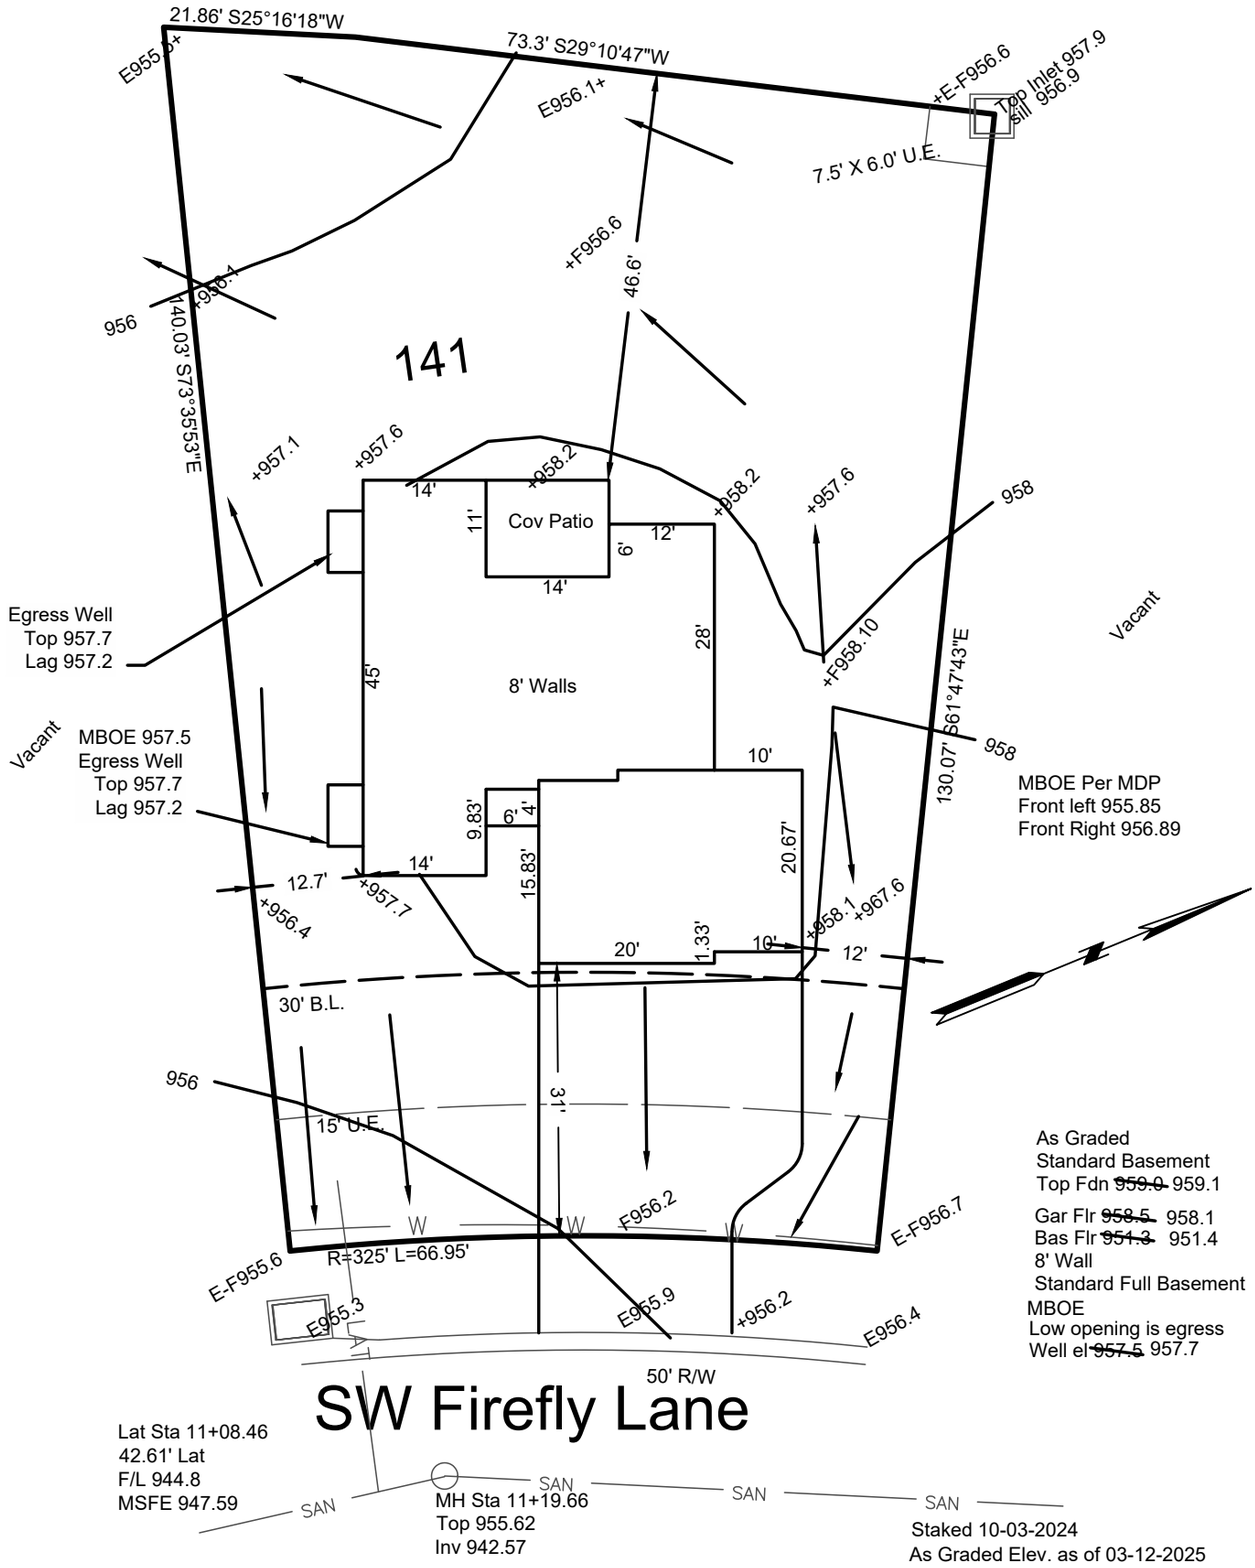

As Graded
Standard Basement
Top Fdn ~~959.9~~ 959.1
Gar Flr ~~958.5~~ 958.1
Bas Flr ~~951.3~~ 951.4
8' Wall
Standard Full Basement
MBOE
Low opening is egress
Well el ~~957.5~~ 957.7

→ = DRAINAGE PATTERN

STATE OF MISSOURI
LEE N. BODENHEIMER
NUMBER LS-2114
REGISTERED LAND SURVEYOR

CONSTRUCTION ENGINEERING SERVICES, INC.
16810-C East 40 Highway
Independence, MO 64055
(816)478-2323
lee@engineeringkc.com

SCALE: 1"=20'
DATE: 10-03-2024 & 02-12-2025
JOB NO: 19218 & 19361

LEE BODENHEIMER, L.S.
Land Surveyor