NOTE:
STRUCTURE SHALL BE PRECAST CONCRETE WITH MIN. 28-DAY COMPRESSIVE STRENGTH OF 4,000 PSI

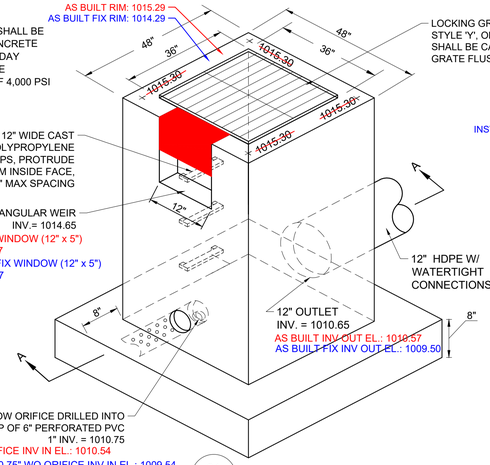

NOTE:
1. ITEMS IN RED AND CLOUDED IN RED INDICATE AS BUILT CONDITIONS.
2. ITEMS IN BLUE AND CLOUDED IN BLUE INDICATE AS BUILT FIX. ONCE FIX IS COMPLETED, PROVIDE TOPO SURVEY OF THE ENTIRE SITE INCLUDING PARKING, BUILDING FFE, AREA INLET TOP OF CASTING, POND, POND STRUCTURE INVERTS AND DIMENSIONS.

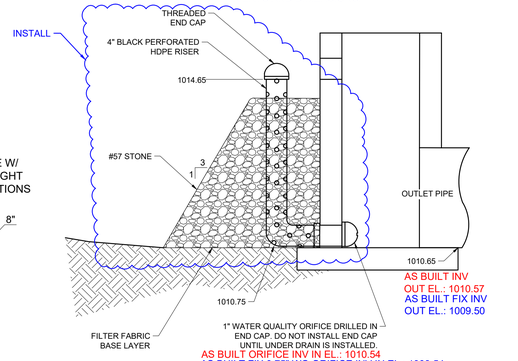

01 C903 — PRECAST OUTLET CONTROL STRUCTURE WITH PERFORATED PIPE
NOT TO SCALE

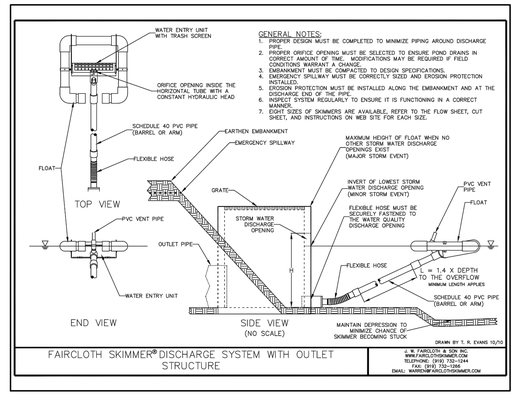

03 C903 — FAIRCLOTH SKIMMER
NOT TO SCALE

04 C903 — NOT USED
NOT TO SCALE

05 C903 — NOT USED
NOT TO SCALE

NOTE:
1. ITEMS IN RED AND CLOUDED IN RED INDICATE AS BUILT CONDITIONS.
2. ITEMS IN BLUE AND CLOUDED IN BLUE INDICATE AS BUILT FIX. ONCE FIX IS COMPLETED, PROVIDE TOPO SURVEY OF THE ENTIRE SITE INCLUDING PARKING, BUILDING FFE, AREA INLET TOP OF CASTING, POND, POND STRUCTURE INVERTS AND DIMENSIONS.

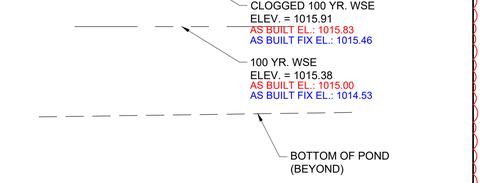

06 C903 — DETENTION POND EMERGENCY SPILLWAY
NOT TO SCALE

07 C903 — NOT USED
NOT TO SCALE

08 C903 — NOT USED
NOT TO SCALE

09 C903 — NOT USED
NOT TO SCALE

10 C903 — NOT USED
NOT TO SCALE

4

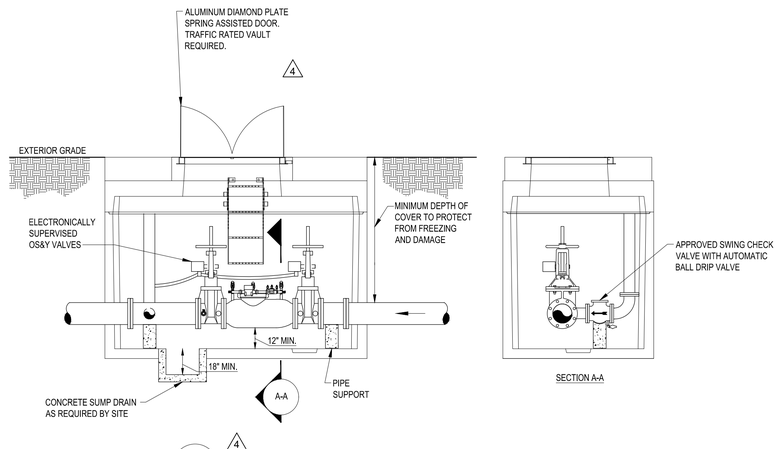

11 C903 — BACKFLOW PREVENTER VAULT
NOT TO SCALE

Gresham Smith
GreshamSmith.com
222 Second Avenue South
Suite 1400
Nashville, TN 37201
615.770.8100

Firestone COMPLETE AUTO CARE
3561 SW MARKET STREET
LEE'S SUMMIT, MISSOURI 64082

THIS DRAWING IS THE PROPERTY OF BRIDGESTONE RETAIL OPERATIONS, LLC AND IS LOANED SUBJECT TO AGREEMENT THAT IT WILL NOT BE REPRODUCED, COPIED OR DELETERIOUS TO THE INTERESTS OF BRIDGESTONE RETAIL OPERATIONS, LLC. THE ARCHITECTURAL OR ENGINEERING SERVICES FOR THIS PROJECT ARE NOT FOR ANY USE OTHER THAN THE FOREGOING CONDITION AND AS ADMISSION TO THE EXCLUSIVE OWNERSHIP IN AND TO THE DRAWING BY BRIDGESTONE RETAIL OPERATIONS, LLC.

STATE OF MISSOURI
MICHAEL DUANE HUNKLER NUMBER E-28843
REGISTERED PROFESSIONAL ENGINEER
2021.06.29 11:24:33 -05'00'

Revision

No.	Date	Description
1	02.07.2020	CITY COMMENTS
2	02.20.2020	CITY COMMENTS
3	03.27.2020	CITY COMMENTS
4	05.15.2020	CITY COMMENTS
5	04.12.2021	AS BUILT
6	04.15.2021	AS BUILT
7	06.29.2021	AS BUILT FIX

SITE DETAILS

C903

40831.45
JANUARY 8, 2020

This Line Is 3 Inches When Printed Full Size

\\NA-FS-04\ra_nf05\40831145\07CAMgmt\00RecordDwgs\Pond AsBuilt Check\40831145-C900_AsBuilt04.22.2021 - AsBuilt Fix.dwg - Ethan Kluding - 6/29/2021 10:50:27 AM