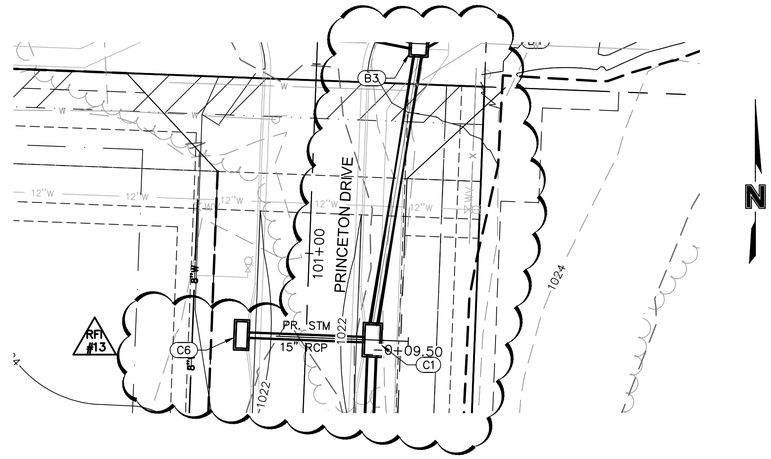

PUBLIC STORM LINE C6

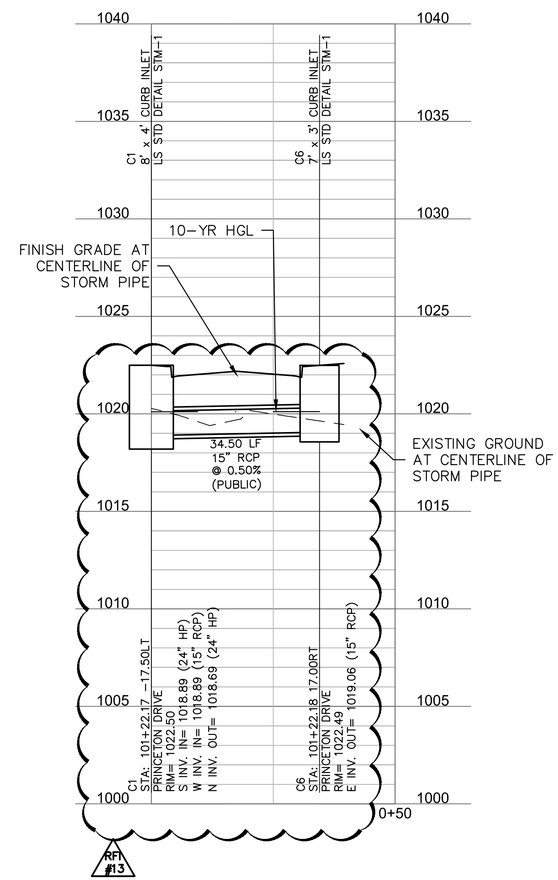

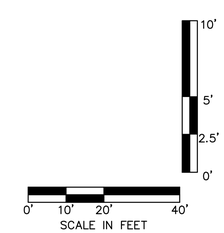

STORM PIPE NOTE:
HP = POLYPROPYLENE PIPE MEETING CITY OF LEE'S SUMMIT SPECIFICATIONS SECTION 2600; LATEST EDITION.

MISSOURI ONE-CALL SYSTEM
1-800-DIG-RITE OR 811
www.mo1call.com

olsson
Olsson Engineering MO State Certificate of Authority #001592
Olsson Landscape Architecture MO State Cert. of Authority #2005000285
550 St. Louis St.
Springfield, MO 65806
TEL 417.890.8802 www.olsson.com

AS-BUILT
11/01/2022

REV. NO.	DATE	REVISIONS DESCRIPTION
1	07/19/2019	ENGR. REVIEW COMMENTS
RFI #13	12/20/19	STORM REVISION DUE TO TCWA CONFLICT

REVISIONS

SE PRINCETON DRIVE
PUBLIC STORM LINE C6

THE PRINCETON SENIOR LIVING
SE OLDHAM PARKWAY

LEE'S SUMMIT, MISSOURI

2019

drawn by: RPJ
designed by: RVJ
checked by: JLR
project no.: 018-1450
drawing no.: C_STM_PROF_81450
date: 07.19.19

SHEET
ST1.3

DWG: F:\2018\1001-1500\018-1450\40-Design\AutoCAD\Final Plans\Sheets\GNCV\PUBLIC STORM\C_STM02_PROF_81450.DWG USER: rjeppson
DATE: Dec 19, 2019 3:30pm XREFS: V_XB0U_81450 V_TOPO_81450 C_PBASE_81450 T_PBASE_81450 C_TBLK_22x34_81450