



DWG: F:\2021\02501-03000\021-02987\40-Design\AutoCAD\Final Plans\Sheets\OSTU\Final Development Plans\L\_GEN01\_02102987.dwg USER: bmcbride  
DATE: Oct 14, 2021 4:09pm XREFS: L\_ITBLK\_02102987 C\_PBASE\_02102987 C\_PSAN\_02102987 C\_PSTM\_02102987 C\_PSURF\_02102987 C\_PLBASE\_02102987 L\_XBASE\_02102987 L\_PBASE\_02102987

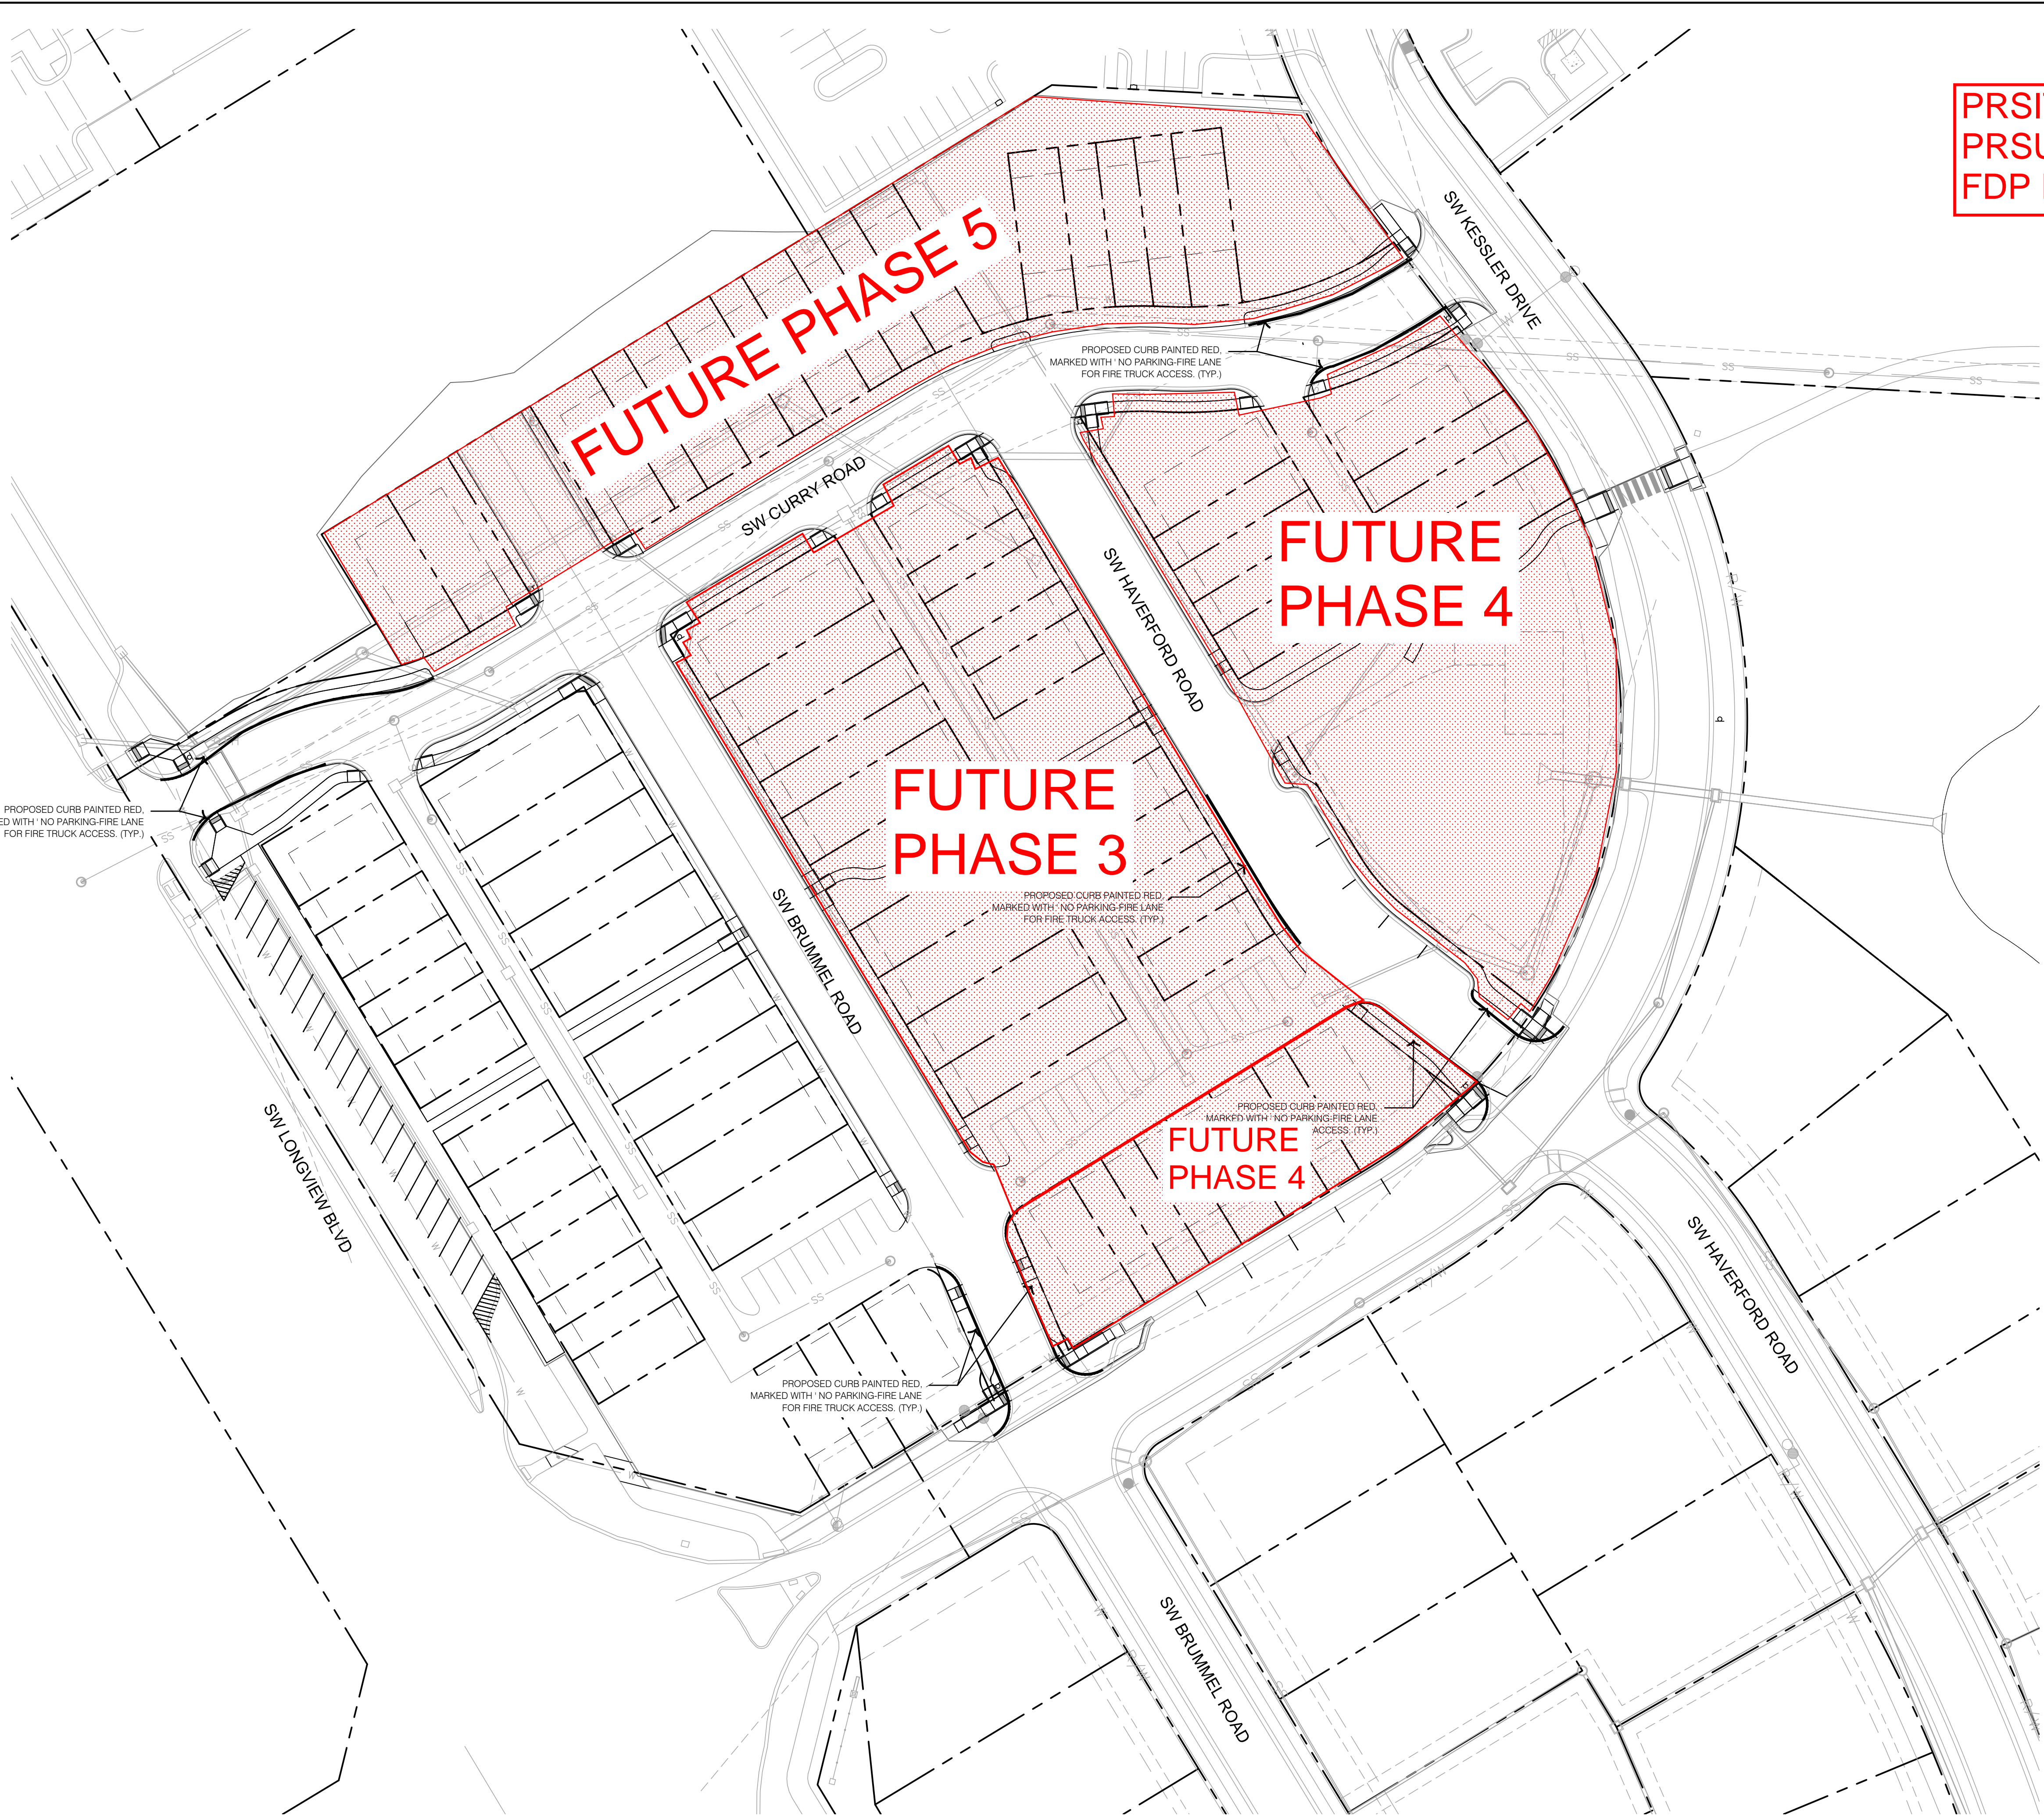

PRSITE20224130  
PRSUBD20215636  
FDP PL2021212

RELEASED FOR CONSTRUCTION  
As Noted on Plan Review  
Development Services Department  
Lee's Summit, Missouri  
08/22/2023

1 FIRE LANE STRIPING PLAN

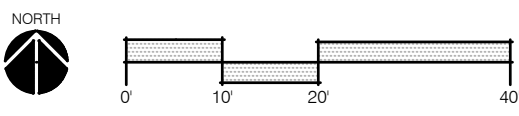

ochsner hare + hare

the olsson studio

OLSSON - LANDSCAPE ARCHITECTURE  
MISSOURI CERTIFICATE OF AUTHORITY #:2005000285  
1814 Main St.  
Kansas City, MO 64108 TEL 816.842.8844 www.olsson.com

STATE OF MISSOURI  
BRANDON D. MCBRIDE  
NUMBER  
K 2017000884  
LANDSCAPE ARCHITECT  
10/14/2021

BY  
REVISIONS DESCRIPTION  
DATE  
REV. NO.

REVISIONS

FIRE LANE STRIPING PLAN

NEW LONGVIEW  
FINAL DEVELOPMENT PLANS

LEE'S SUMMIT, MO

2021


drawn by: LS  
checked by: BM  
approved by: KPS  
QA/QC by: KPS  
project no.: 021-02987  
drawing no.: L\_GEN01\_02102987  
date: 10/14/2021

SHEET  
L103



STORM SEWER PLAN NOTES

1. PRIOR TO COMMENCEMENT OF WORK THE CONTRACTOR SHALL NOTIFY AND COORDINATE CONSTRUCTION WITH LEES SUMMIT, MISSOURI.
2. ALL PIPE LENGTHS AND ELEVATIONS ARE CALCULATED LINEARLY FROM CENTER OF STRUCTURE TO CENTER OF STRUCTURE.
3. COORDINATES ARE PROVIDED AT THE CENTER OF STRUCTURE. ADDITIONAL COORDINATES PROVIDED ARE PER LOCAL CODES AND ORDINANCES OR AS AN AID WHEN ORIENTING THE BOX DURING INSTALLATION.
4. THE CONTRACTOR SHALL EXPOSE EXISTING UTILITIES AT LOCATIONS OF POSSIBLE CONFLICT AND POINTS OF CONNECTION PRIOR TO ANY CONSTRUCTION OF STORM SEWER.
5. STORM SEWER TRENCHES SHALL BE CONSTRUCTED SUCH THAT UNDISTURBED EXISTING SOIL OR FILL COMPACTED TO 95% PROCTOR DENSITY IS AT A DEPTH THAT IS 18" ABOVE TOP OF PROPOSED PIPE.
6. STRUCTURE INVERT CHANNELS SHALL BE SMOOTH, CIRCULAR, AND CONFORMING TO 1/2 THE ADJACENT PIPE SECTION (INVERT TO CENTER). CHANGES IN DIRECTION OF FLOW SHALL BE MADE WITH A SMOOTH CURVE AND MAINTAIN SHAPE THROUGHOUT. CHANGES IN GRADE OF ADJACENT PIPES SHALL BE TRANSITIONED SMOOTHLY AND EVENLY THROUGH THE STRUCTURE.
7. PIPE PENETRATIONS SHALL BE GROUTED TO ENSURE WATERTIGHT SEALS.

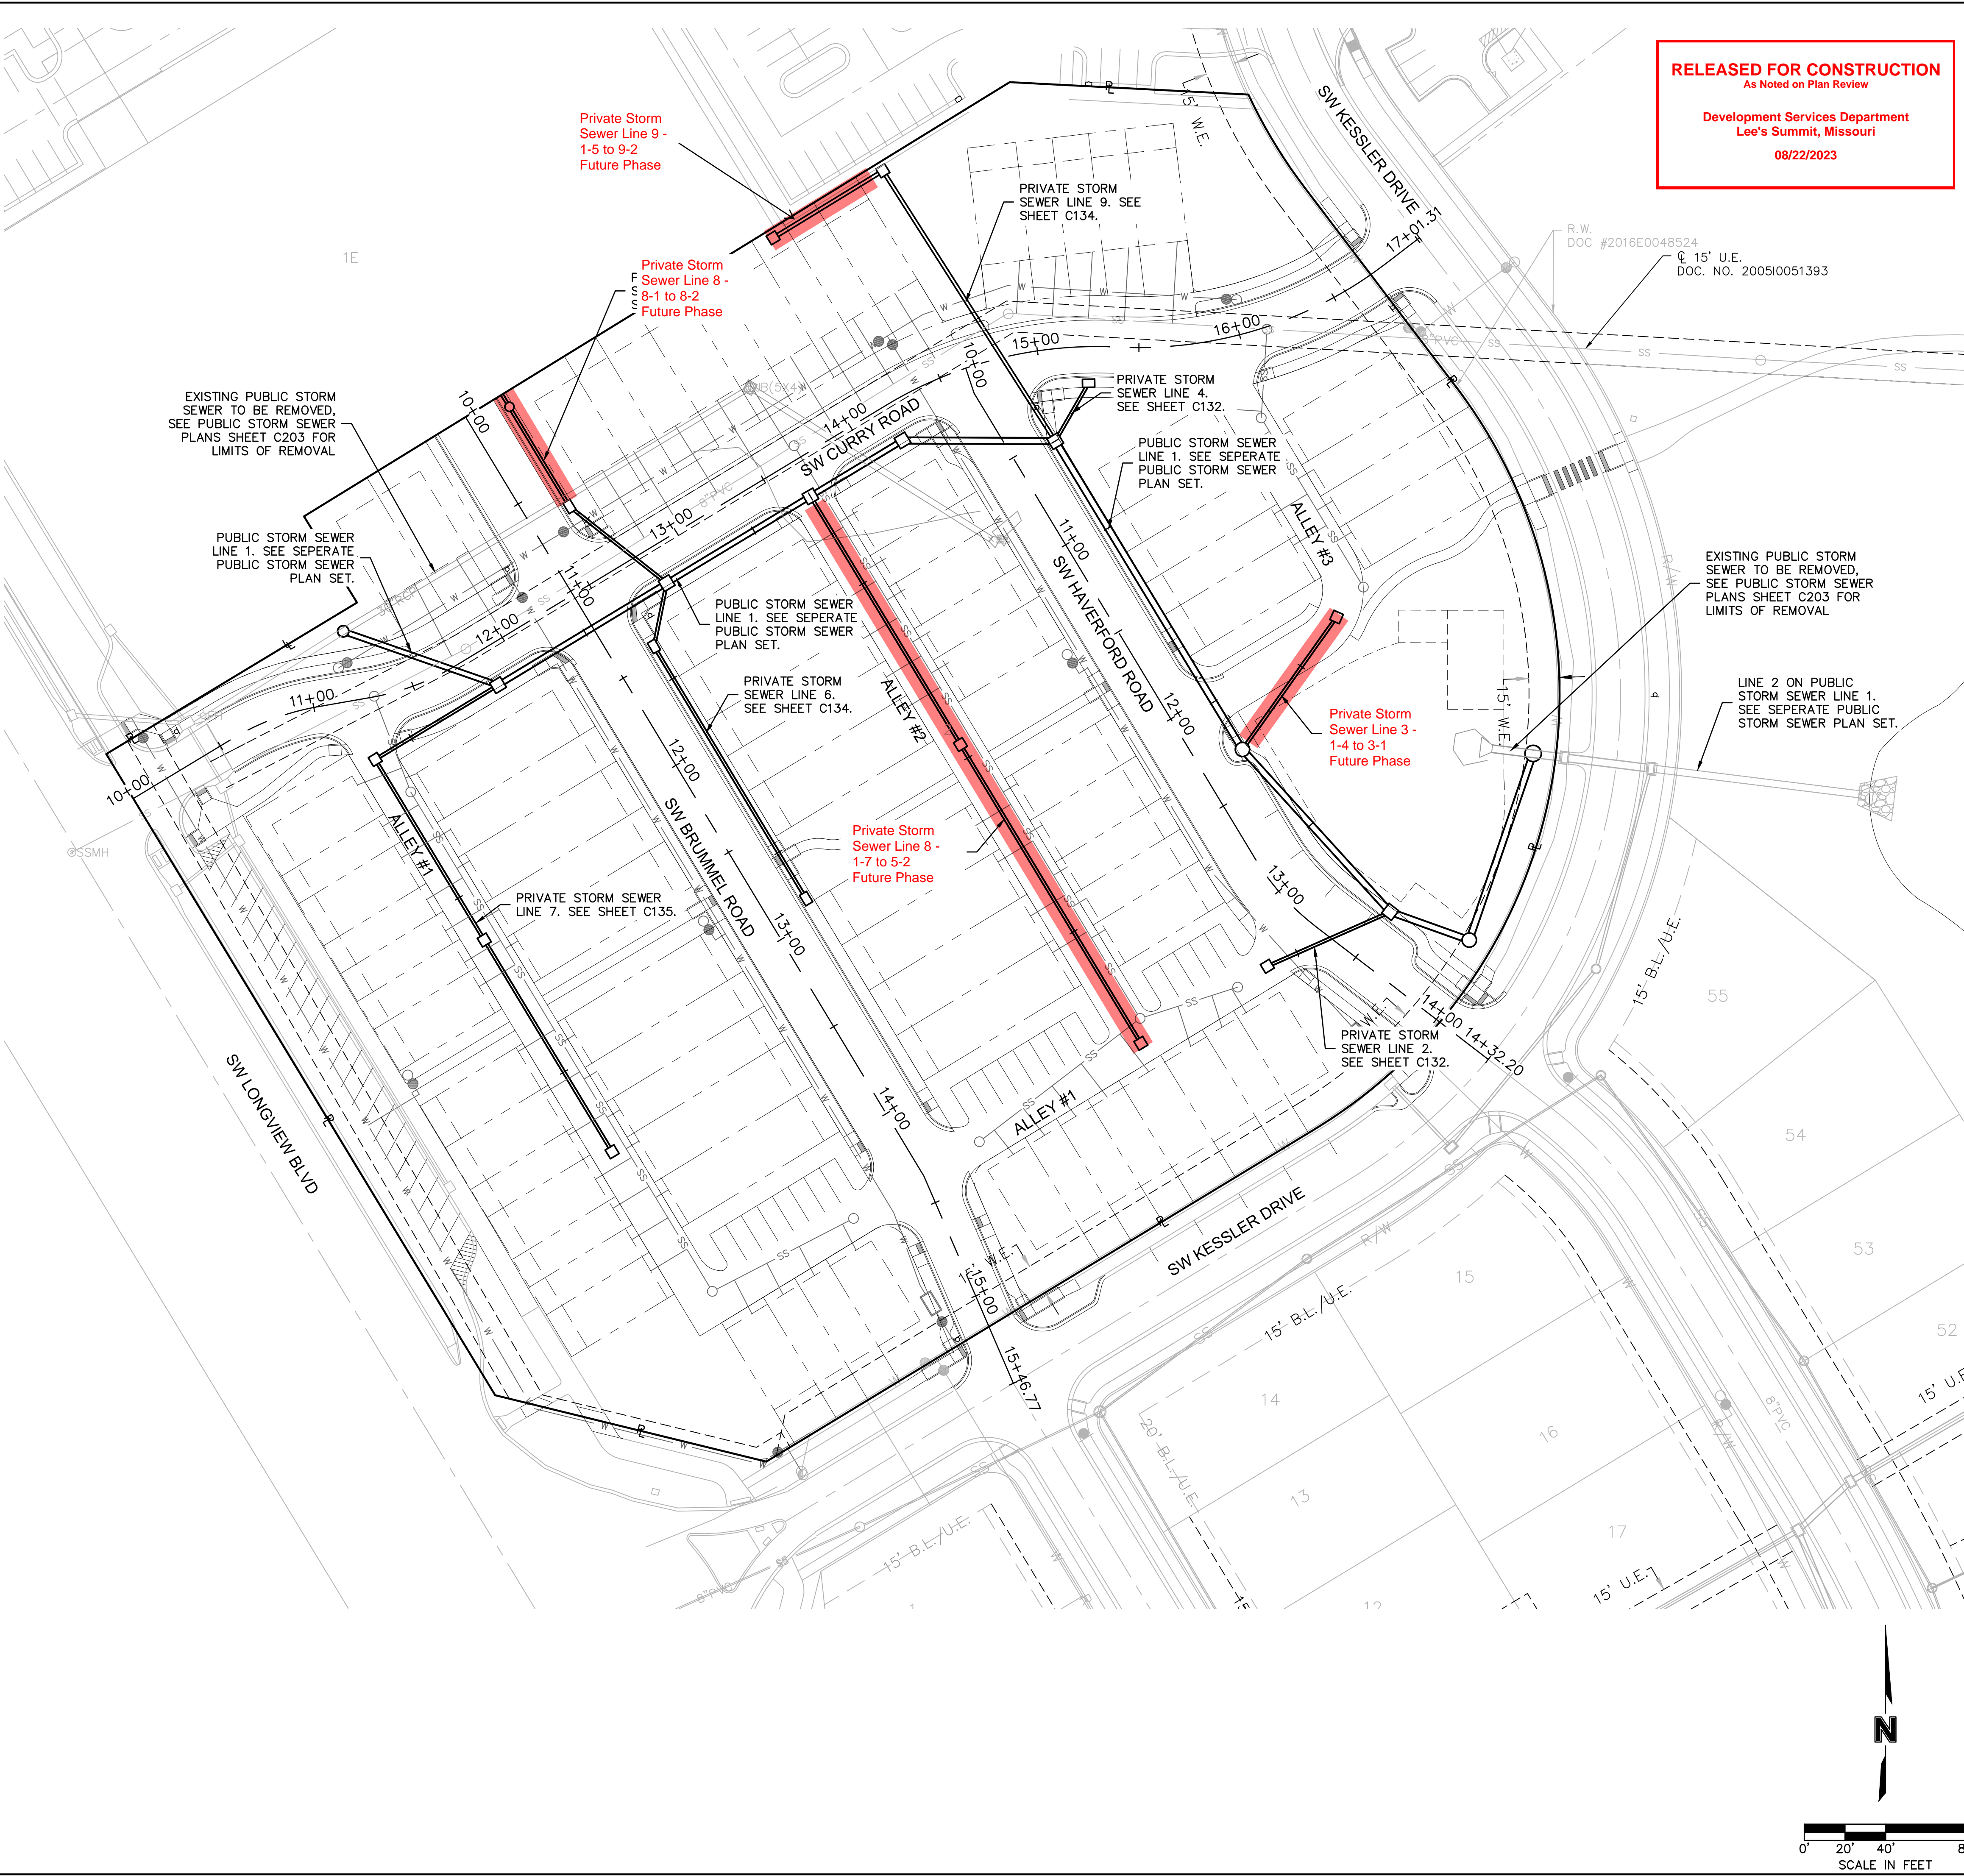

DWG: F:\2021\02501-03000\021-02987\40-Design\AutoCAD\Final Plans\Sheets\GNC\A\FINAL DEVELOPMENT PLANS\021-02987.dwg USER: cflowrey  
DATE: Sep 07, 2021 11:02am XREFS: C\_PBASE\_02102987 C\_PUTIL\_02102987 C\_XBASE\_02102987 C\_PBND\_02102987

olsson

Olsson - Civil Engineering  
Missouri Certificate of Authority #  
1301 Burlington Street  
North Kansas City, MO 64116  
TEL 816.361.1177 www.olsson.com

STATE OF MISSOURI  
JULIE ELAINE  
SELLERS  
10/14/21  
PROFESSIONAL ENGINEER

BY  
REVISIONS DESCRIPTION  
DATE  
REV. NO.

STORM SEWER GENERAL LAYOUT  
NEW LONGVIEW TOWNHOMES  
451 SW LONGVIEW BLVD  
LEE'S SUMMIT, MO  
2021

drawn by: OLJCM  
checked by: JES  
approved by: JES  
QA/QC by: JES  
project no.: 021-02987  
drawing no.:  
date: 08.25.2021

SHEET  
C131



