WILSHIRE HILLS III

Lee's Summit, MO

MHDC Project No. #22-057 MT

PRINTS ISSUED

10/30/23 PERMIT SUBMITTAL

REVISIONS:

1	12/15/23	Addendum 1 - Response to City Comments
2	03/14/24	Addendum 2
3	04/19/24	Addendum 3 - Response to City Comments #2

PROJECT CERTIFICATION

I, **David E. Hendrikse**, hereby specify pursuant to the governing requirements of the state, that the documents intended to be authenticated by my seal are limited to:

G-001	G-201	G-302	A-201	A-410
G-002	G-202	G-303	A-300	A-411
G-003	G-203	AS-101	A-301	A-500
G-004	G-204	A-101	A-302	A-501
G-005	G-205	A-102	A-303	A-502
G-006	G-206	A-103	A-304	A-503
G-007	G-207	A-104	A-400	A-600
G-100	G-208	A-120	A-401	A-700
G-101	G-209	A-121	A-402	
G-102	G-300	A-122	A-403	
G-200	G-301	A-200	A-404	

and I hereby disclaim any responsibility for all other plans, specifications, reports or other documents or instruments relating to or intended to be used for any part or parts of the architectural or engineering project or survey.

SEAL

STATE OF MISSOURI
DAVID EUGENE HENDRIKSE
NUMBER A-7365
REGISTERED ARCHITECT

04/19/24

DAVID E. HENDRIKSE, AIA

REGIONAL MAP

VICINITY MAP

WILSHIRE HILLS III
LEE'S SUMMIT, MISSOURI

N

SHEET INDEX

GENERAL

	Sheet Issue Date	Sheet Number	Sheet Name	Rev.	Current Revision Date
■	10/30/23	G-001	TITLE SHEET	3	04/19/24
■	10/30/23	G-002	GENERAL INFORMATION		
■	10/30/23	G-003	PLAN GENERAL NOTES		
■	10/30/23	G-004	GENERAL INFORMATION		
■	10/30/23	G-005	GENERAL INFORMATION		
■	10/30/23	G-006	GENERAL INFORMATION		
■	10/30/23	G-007	GENERAL INFORMATION		
■	10/30/23	G-100	CODE ANALYSIS	3	04/19/24
■	10/30/23	G-101	CODE PLANS	3	04/19/24
■	10/30/23	G-102	ASSEMBLIES - PARTITION, CEILING, ROOF	1	12/15/23
■	10/30/23	G-200	UL ASSEMBLIES		
■	10/30/23	G-201	UL ASSEMBLIES		
■	10/30/23	G-202	UL ASSEMBLIES		
■	10/30/23	G-203	UL ASSEMBLIES		
■	10/30/23	G-204	UL ASSEMBLIES		
■	10/30/23	G-205	UL ASSEMBLIES		
■	10/30/23	G-206	UL ASSEMBLIES		
■	10/30/23	G-207	UL ASSEMBLIES		
■	10/30/23	G-208	UL ASSEMBLIES		
■	12/15/23	G-209	UL ASSEMBLIES	1	12/15/23
■	10/30/23	G-300	ACCESSIBILITY STANDARDS		
■	10/30/23	G-301	ACCESSIBILITY STANDARDS		
■	10/30/23	G-302	ACCESSIBILITY STANDARDS		
■	10/30/23	G-303	ACCESSIBILITY STANDARDS		

CIVIL

	Sheet Issue Date	Sheet Number	Sheet Name	Rev.	Current Revision Date
■	06/30/23	C0.01	COVER	1	02/22/24
■	06/30/23	C0.02	GENERAL NOTES	1	02/22/24
■	06/30/23	C1.01	OVERALL PLAN	1	02/22/24
■	06/30/23	C2.01	SITE PLAN	1	02/22/24
■	06/30/23	C3.01	JOINT PLAN	1	02/22/24
■	06/30/23	C4.01	GRADING & DRAINAGE PLAN	1	02/22/24
■	06/30/23	C5.01	STORM SEWER PLAN	1	02/22/24
■	06/30/23	C6.01	STORM SEWER PROFILES	1	02/22/24
■	06/30/23	C7.01	UTILITY PLAN & PROFILE	1	02/06/24
■	06/30/23	C8.01	ACCESSIBILITY PLAN	1	02/22/24
■	06/30/23	C8.02	ACCESSIBILITY PLAN	1	02/22/24
■	06/30/23	C8.03	ACCESSIBILITY PLAN	1	02/22/24
■	06/30/23	C9.01	INITIAL EROSION CONTROL PLAN		
■	06/30/23	C9.02	FINAL EROSION CONTROL PLAN		
■	06/30/23	C10.01	SITE DETAILS		
■	06/30/23	C10.02	SITE DETAILS		
■	06/30/23	C10.03	SITE DETAILS		
■	06/30/23	C11.01	STORM SEWER DETAILS		
■	06/30/23	C11.02	STORM SEWER DETAILS		
■	06/30/23	C12.01	SANITARY SEWER DETAILS		
■	06/30/23	C13.01	WATER DETAILS	1	02/22/24
■	06/30/23	C14.01	EROSION CONTROL DETAILS		
■	06/30/23	C14.02	EROSION CONTROL DETAILS		
■	06/30/23	C14.03	EROSION CONTROL DETAILS		
■	06/30/23	C15.01	STORM SEWER DRAINAGE AREA MAP		
■	09/28/23	L1.01	LANDSCAPE PLAN	1	02/22/24
■	09/28/23	L1.02	LANDSCAPE PLAN	1	02/22/24
■	09/28/23	L1.03	LANDSCAPE PLAN	1	02/22/24
■	09/28/23	L1.04	LANDSCAPE PLAN		
■	09/28/23	L1.05	LANDSCAPE PLAN		
■	07/13/23	RW1.01	RETAINING WALL PLAN	1	02/22/24
■	07/13/23	RW2.01	RETAINING WALL DETAILS	1	02/23/24

STRUCTURAL

	Sheet Issue Date	Sheet Number	Sheet Name	Rev.	Current Revision Date
■	10/30/23	S-001	STRUCTURAL GENERAL NOTES	1	12/15/23
■	10/30/23	S-002	STRUCTURAL GENERAL NOTES		
■	10/30/23	S-003	SPECIAL INSPECTIONS		
■	10/30/23	S-100	SLAB DIMENSION PLAN		
■	10/30/23	S-101	FOUNDATION PLAN		
■	10/30/23	S-102	2ND FLOOR FRAMING PLAN		
■	10/30/23	S-103	3RD FLOOR FRAMING PLAN		
■	10/30/23	S-104	ROOF FRAMING PLAN		
■	10/30/23	S-500	STRUCTURAL DETAILS		
■	10/30/23	S-501	STRUCTURAL DETAILS		
■	10/30/23	S-502	STRUCTURAL DETAILS		
■	10/30/23	S-503	STRUCTURAL DETAILS		

ARCHITECTURAL

	Sheet Issue Date	Sheet Number	Sheet Name	Rev.	Current Revision Date
■	10/30/23	AS-101	ARCHITECTURAL SITE AMENITIES		
■	10/30/23	A-101	FIRST FLOOR PLAN		
■	10/30/23	A-102	SECOND FLOOR PLAN		
■	10/30/23	A-103	THIRD FLOOR PLAN		
■	10/30/23	A-104	ROOF PLAN		
■	10/30/23	A-120	FIRST FLOOR REFLECTED CEILING PLAN		
■	10/30/23	A-121	SECOND FLOOR REFLECTED CEILING PLAN		
■	10/30/23	A-122	THIRD FLOOR REFLECTED CEILING PLAN		
■	10/30/23	A-200	EXTERIOR ELEVATIONS		
■	10/30/23	A-201	EXTERIOR ELEVATIONS		
■	10/30/23	A-300	OVERALL BUILDING SECTION		
■	10/30/23	A-301	WALL SECTIONS		
■	10/30/23	A-302	ELEVATOR SECTION & DETAILS		
■	10/30/23	A-303	STAIR SECTION & DETAILS		
■	10/30/23	A-304	FRONT CANOPY PLAN / ELEV. / SECTION / & DETAILS		
■	10/30/23	A-400	ONE BEDROOM UNIT PLAN - TYPE A		
■	10/30/23	A-401	ONE BEDROOM UNIT PLAN - TYPE B		
■	10/30/23	A-402	TWO BEDROOM UNIT PLAN - TYPE A		
■	10/30/23	A-403	TWO BEDROOM UNIT PLAN - TYPE B		
■	10/30/23	A-404	TWO BEDROOM CORNER UNIT PLAN - TYPE B		
■	10/30/23	A-410	ENLARGED FLOOR PLANS - COMMON AREAS	1	12/15/23
■	10/30/23	A-411	ENLARGED FLOOR PLANS - COMMON AREAS	1	12/15/23
■	10/30/23	A-500	DETAILS		
■	10/30/23	A-501	DETAILS		
■	10/30/23	A-502	DETAILS		
■	10/30/23	A-503	SUSPENDED CEILING DETAILS		
■	10/30/23	A-600	WINDOW / DOOR / FINISH SCHEDULES	3	04/19/24
■	10/30/23	A-700	INTERIOR ELEVATIONS	1	12/15/23

MECHANICAL

	Sheet Issue Date	Sheet Number	Sheet Name	Rev.	Current Revision Date
■	10/30/23	MEP000	MEP COVER SHEET		
■	10/30/23	MEP101	MEP SITE PLAN	1	12/15/23
■	10/30/23	MEP200	MEP PENETRATION DETAILS		
■	10/30/23	MEP201	MEP PENETRATION DETAILS		
■	10/30/23	M101	FIRST FLOOR HVAC PLAN	1	12/15/23
■	10/30/23	M102	SECOND FLOOR HVAC PLAN		
■	10/30/23	M103	THIRD FLOOR HVAC PLAN		
■	10/30/23	M201	ENLARGED UNIT PLANS - HVAC	1	12/15/23
■	10/30/23	M301	MECHANICAL SCHEDULES	1	12/15/23
■	10/30/23	M401	MECHANICAL DETAILS		

PLUMBING

	Sheet Issue Date	Sheet Number	Sheet Name	Rev.	Current Revision Date
■	10/30/23	P101	FIRST FLOOR PLUMBING PLAN	1	12/15/23
■	10/30/23	P102	SECOND FLOOR PLUMBING PLAN		
■	10/30/23	P103	THIRD FLOOR PLUMBING PLAN		
■	10/30/23	P201	ENLARGED UNIT PLANS - PLUMBING		
■	10/30/23	P301	PLUMBING SCHEDULES		
■	10/30/23	P302	PLUMBING DETAILS	1	12/15/23

ELECTRICAL

	Sheet Issue Date	Sheet Number	Sheet Name	Rev.	Current Revision Date
■	10/30/23	E101	FIRST FLOOR LIGHTING PLAN		
■	10/30/23	E102	SECOND FLOOR LIGHTING PLAN		
■	10/30/23	E103	THIRD FLOOR LIGHTING PLAN		
■	10/30/23	E111	ENLARGED UNIT PLANS - LIGHTING		
■	10/30/23	E201	FIRST FLOOR POWER PLAN	1	12/15/23
■	10/30/23	E202	SECOND FLOOR POWER PLAN		
■	10/30/23	E203	THIRD FLOOR POWER PLAN		
■	10/30/23	E211	ENLARGED UNIT PLANS - POWER		
■	10/30/23	E301	ELECTRICAL RISER DIAGRAM	1	12/15/23
■	10/30/23	E302	ELECTRICAL SCHEDULES		
■	10/30/23	E303	ELECTRICAL SCHEDULES		
■	10/30/23	E401	ELECTRICAL SCHEDULES/DETAILS		
■	10/30/23	E402	ELECTRICAL DETAILS		
■	10/30/23	SL100	SITE PHOTOMETRICS		

SOLID FILL INDICATES INCLUSION IN ISSUE
SHEET ISSUE DATE

■ 10 / 10/ 2020 | A-000 SHEET NAME | - | 10 / 10/ 2020

SHEET NUMBER AND NAME
CURRENT REVISION NUMBER & REVISION DATE ON SHEET

SHEET INDEX LEGEND

PROJECT DATA

PROJECT DESIGN INFORMATION

NEW CONSTRUCTION: YES

ZONING: MU - MIXED USE ZONING

CODE:
2018 INTERNATIONAL BUILDING CODE
2018 INTERNATIONAL RESIDENTIAL CODE
2018 INTERNATIONAL MECHANICAL CODE
2018 INTERNATIONAL PLUMBING CODE
2018 INTERNATIONAL FIRE CODE
2017 NATIONAL ELECTRIC CODE
2009 ACCESSIBILITY CODE ICC/ANSI 117.1
2018 IECC ENERGY CODE

OCCUPANCY GROUP: R-2

TYPE OF CONSTRUCTION: TYPE V-A

NOTE: MHDC FORM 1200 FOR DESIGN/CONSTRUCTION COMPLIANCE GUIDELINES ARE UTILIZED IN THE DESIGN OF THE PROJECT

BUILDING SUMMARY:

ONE (1) TOTAL BUILDINGS
HEIGHT: 46' - 8"

SQUARE FOOTAGES:	GROSS	NET
3-STORY		
FIRST FLOOR	17,860 S.F.	17,437 S.F.
SECOND FLOOR	17,860 S.F.	17,437 S.F.
THIRD FLOOR	17,860 S.F.	17,437 S.F.
TOTAL	**53,580 S.F.**	**52,311 S.F.**

ENERGY CONSERVATION: SEE CODE ANALYSIS

UNIT SUMMARY: OVERALL UNIT TOTAL (3-STORY) = **50**

3-STORY (BLDG) UNITS

TYPE "A" UNITS (5% OF TOTAL)	(5) UNITS - TWO BEDROOM
	(3) UNITS - ONE BEDROOM
HI/VI UNITS (2% OF TOTAL)	(1) UNITS - TWO BEDROOM
	(1) UNITS - ONE BEDROOM
STANDARD UNITS	(26) UNITS - TWO BEDROOM
	(14) UNITS - ONE BEDROOM
TOTAL UNITS	**(50) UNITS**

SQUARE FOOTAGE:	GROSS	NET
TYPE "A" - 2 BEDROOM	880 S.F.	822 S.F.
TYPE "B" - 2 BEDROOM	880 S.F.	822 S.F.
TYPE "A" - 1 BEDROOM	711 S.F.	660 S.F.
TYPE "B" - 1 BEDROOM	711 S.F.	660 S.F.
TYPE "B" - 2 BEDROOM	1004 S.F.	935 S.F.

SITE SUMMARY: SEE CIVIL

NOTE: SQUARE FOOTAGE

-GROSS - COMMON SPACE CALCULATION: OUTSIDE PERIMETER OF STUD (ENTIRE BUILDING) LESS THE TOTAL OF THE GROSS UNIT SQUARE FOOTAGE PER FLOOR.
-GROSS - UNIT CALCULATION: CENTERLINE OF PARTY WALL TO OUTSIDE OF EXTERIOR STUD WALL AND/OR OUTSIDE OF CORRIDOR STUD WALL.
-NET - PAINT-TO-PAINT AT PERIMETER,TAKEN FROM INSIDE OF DEMISING, EXTERIOR, AND CORRIDOR WALLS.

PROJECT TEAM

OWNER
WILSHIRE HILLS III, L.P.
ADDRESS: 206 PEACH WAY
COLUMBIA, MO 65203
CONTACT: **BRIAN KIMES**
EMAIL: bkimes@jesmith.com
PHONE: 573.443.2021

ARCHITECT
ROSEMANN & ASSOCIATES, P.C.
ADDRESS: 1526 Grand Boulevard
Kansas City, MO 64108
CONTACT: **MICHAEL GAILLARD**
EMAIL: mgaillard@rosemann.com
PHONE: 816.472.1448

CONTRACTOR
FAIRWAY CONSTRUCTION CO., INC.
ADDRESS: 206 PEACH WAY
COLUMBIA, MO 65203
CONTACT: **DEVIN BROWN**
EMAIL: dbrown@fairwayconstruction.net
PHONE:

STRUCTURAL ENGINEER
ROSEMANN & ASSOCIATES, P.C.
ADDRESS: 1526 Grand Boulevard
Kansas City, MO 64108
CONTACT: **Scott Rosemann**
EMAIL: srosemann@rosemann.com
PHONE: 816.472.1448

MECHANICAL, ELECTRICAL, PLUMBING ENGINEER
PEARSON KENT MCKINLEY RAAF ENGINEERS LLC
ADDRESS: 13300 W. 98TH STREET
LENEXA, KS 66215
CONTACT: **MIKE RAAF**
EMAIL: mike.raaf@pkmreng.com
PHONE: 913.492.2400

CIVIL ENGINEER
ENGINEERING SURVEYS & SERVICES
ADDRESS: 802 EL DORADO DRIVE
JEFFERSON CITY, MO 65101
CONTACT: **SARAH THOMPSON**
EMAIL: sthompson@ess-inc.com
PHONE: 573.449.2646

BUILDING OFFICIAL
Company Name
ADDRESS: Address Line 1
Address Line 2
CONTACT: **Name**
EMAIL: Email
PHONE: Phone

SIGNATURE BLOCK

OWNER:
WILSHIRE HILLS III, L.P.
206 PEACH WAY
COLUMBIA, MO 65203

BY: _____ DATE: _____
NAME

CONTRACTOR:
FAIRWAY CONSTRUCTION CO., INC.
206 PEACH WAY
COLUMBIA, MO 65203

BY: _____ DATE: _____
NAME

ARCHITECT:
ROSEMANN & ASSOCIATES, P.C.
1526 GRAND BOULEVARD
KANSAS CITY, MO 64108-1404

BY: _____ DATE: _____
DAVID E. HENDRIKSE, AIA

BONDING COMPANY:
OWNER NAME
ADDRESS
CITY, ST ZIP

BY: _____ DATE: _____
NAME

MISSOURI HOUSING DEVELOPMENT COMMISSION
920 MAIN STREET, SUITE 1400
KANSAS CITY, MO 64105

BY: _____ DATE: _____
NAME

rosemann & ASSOCIATES P.C.
ARCHITECTURE
INTERIOR DESIGN
ENGINEERING
PLANNING
1526 Grand Boulevard
Kansas City, MO 64108-1404
p: 816.472.1448
w: www.rosemann.com

© 2023 Rosemann & Associates, P.C.

DENVER ▲ KANSAS CITY ▲ ST. LOUIS ▲ ATLANTA

WILSHIRE HILLS III
LEE'S SUMMIT, MISSOURI
MHDC Project No. #22-057 MT

SHEET TITLE
TITLE SHEET

PROJECT NUMBER: 23034

SHEET NUMBER:

G-001

ABBREVIATIONS

A	ABV	ABOVE
	ACC	ACCESSIBLE
	ACT	ACOUSTICAL CEILING TILE
	AD	AREA DRAIN
	ADA	AMERICANS WITH DISABILITIES ACT
	ADAAG	ADA ACCESSIBILITY GUIDELINES
	ADF	ACCESSIBLE DRINKING FOUNTAIN
	ADH	ADHESIVE
	ADJ	ADJUSTABLE/ADJACENT
	AEWC	ACCESSIBLE ELECTRIC WATER COOLER
	AFF	ABOVE FINISH FLOOR
	AHJ	AUTHORITY HAVING JURISDICTION
	AHU	AIR HANDLING UNIT
	AL	ASSISTED LIVING
	ALAV	ACCESSIBLE LAVATORY
	ALT	ALTERNATE
	ALUM	ALUMINUM
	AMI	ACCESSIBLE MIRROR
	ANN	FIRE ANNUNCIATOR PANEL
	ANO	ANNODIZED
	APPD	APPROVED
	APPROX	APPROXIMATE(LY)
	ASD	ACCESSIBLE SOAP DISPENSER
	ASH	ACCESSIBLE SHOWER HEAD
	ATTEN	ATTENUATION
	ATTN	ATTENTION
	AU	ACCESSIBLE URINAL
B	B.O.	BOTTOM OF
	BD	BOARD
	BLDG	BUILDING
	BLK	BLOCK
	BLKG	BLOCKING
	BM	BENCH MARK
	BO	BY OTHERS
	BOD	BOTTOM OF DECK(ING)
	BOH	BACK OF HOUSE
	BOT	BOTTOM (OF)
	BRG	BEARING
	BRKT	BRACKET
	BSMT	BASEMENT
	BTWN / BTW	BETWEEN
	BUR	BUILT UP ROOFING
	BUS	BUSINESS
C	C TO C	CENTER TO CENTER
	CAB	CABINET
	CB	CERAMIC BASE/CORNER BEAD/CHALKBOARD
	CEM / CEMT	CEMENT / CEMENTITIOUS
	CFM	CUBIC FEET PER MINUTE
	CI	CAST IRON
	CIP	CAST IN PLACE
	CJ	CONTROL JOINT
	CL	CENTERLINE
	CLG	CEILING
	CLO	CLOSET
	CLR	CLEAR
	CLRM	CLASSROOM
	CMP	CORRUGATE METAL PIPE
	CMU	CONCRETE MASONRY UNIT
	CNTR	COUNTERTOP
	CO	CLEANOUT
	COL	COLUMN
	COMB	COMBINATION
	CONC	CONCRETE
	CONN	CONNECTION
	CONST	CONSTRUCTION
	CONT	CONTINUOUS
	CONTR	CONTRACTOR
	COORD	COORDINATE / COORDINATOR
	CORR	CORRIDOR
	CPT	CARPET
	CSK	COUNTERSINK / COUNTER SUNK
	CT	CERAMIC TILE
	CTG	COATING
	CTR	CENTER
	CY	CUBIC YARD(S)

D	DBL	DOUBLE
	DEMO	DEMOLITION / DEMOLISH
	DIA	DIAMETER
	DIAG	DIAGONAL
	DIM	DIMENSION
	DIMS	DIMENSIONS
	DN	DOWN
	DP	DEEP
	DR	DOOR
	DS	DOWNSPOUT
	DTL	DETAIL
	DWG	DRAWING
E	E	EAST
	EA	EACH
	EF	EACH FACE
	EJ	EXPANSION JOINT
	EL	ELEVATION
	ELEC	ELECTRIC(AL)
	ELEV	ELEVATOR
	ENLG	ENLARGED
	EPDM	ETHLYENE PROPYLENE DIENE TERPOLYMER
	EQ	EQUAL
	ES	EACH SIDE
	EW	EACH WAY
	EWC	ELECTRIC WATER COOLER
	EXH	EXHAUST
	EXIST	EXISTING
	EXP	EXPANSION
	EXT	EXTERIOR
F	FA	FIRE ALARM
	FACP	FIRE ACCESS CONTROL PANEL
	FAWCM	FULLY ADHERED WATER CONTROL MEMBRANE
	FD	FLOOR DRAIN / FIRE DEPARTMENT
	FDN	FOUNDATION
	FE	FIRE EXTINGUISHER
	FEC	FIRE EXTINGUISHER CABINET
	FF	FINISH FLOOR
	FGL	FIBERGLASS
	FH	FIRE HOSE
	FHA	FAIR HOUSING ACT
	FHC	FIRE HOSE CABINET
	FIN	FINISH
	FIXT	FIXTURE
	FLASH	FLASHING
	FLEX	FLEXIBLE
	FLR	FLOOR
	FND	FOUNDATION
	FO	FACE OF
	FRP	FIBER-REINFORCED PLASTIC
	FT	FOOT
	FTG	FOOTING
G	GA	GAUGE
	GALV	GALVANIZED
	GB	GRAB BAR
	GC	GENERAL CONTRACTOR
	GEN	GENERAL
	GFRC	GLASS FIBER REINFORCED CONCRETE
	GL	GLASS
	GLZ	GLAZED TILE
	GPM	GALLONS/MINUTE
	GR	GRADE
	GWB	GYPSUM WALL BOARD
	GYP	GYPSUM
	GYP BD	GYPSUM BOARD
H	HB	HOSE BIBB
	HC	HOLLOW CORE
	HD	HEAVY DUTY OR HAND DRYER
	HDBD	HARD BOARD
	HDNR	HARDENER
	HDW	HARDWARE
	HDWD	HARDWOOD
	HM	HOLLOW METAL
	HORIZ	HORIZONTAL
	HR	HOUR
	HT	HEIGHT
	HTG	HEATING
	HTR	HEATER
	HYD	HYDRANT

I	IBC	INTERNATIONAL BUILDING CODE
	ID	INTERIOR DESIGNER
	ID	INSIDE DIAMETER
	IDF	INDIVIDUAL DISTRIBUTION FRAME
	IL	INDEPENDENT LIVING
	IN	INCHES
	INDIV	INDIVIDUAL
	INSUL	INSULATION / INSULATED
	INT	INTERIOR
	INV	INVERT
J	JAN	JANITOR
	JST	JOIST
	JT	JOINT
K	KD	KNOCKED DOWN
	KIT	KITCHEN
	KN	KNOX BOX
L	LA	LANDSCAPE / LANDSCAPE ARCHITECT
	LAM	LAMINATE
	LAV	LAVATORY
	LF	LINEAR FOOT/FEET
	LG	LONG
	LGTH	LENGTH
	LKR	LOCKER
	LSC	LIFE SAFETY CODE
	LT	LIGHT
M	MAS	MASONRY
	MATL	MATERIAL
	MATL	MATERIAL
	MAX	MAXIMUM
	MB	MARKER BOARD / MAIL BOX
	MC	MEMORY CARE
	MDF	MAIN DISTRIBUTION FRAME
	MECH	MECHANICAL
	MFR	MANUFACTURE(ER)
	MH	MANHOLE
	MI	MIRROR
	MIN	MINIMUM
	MO	MASONRY OPENING
	MTD	MOUNTED
	MTG HT	MOUNTING HEIGHT
	MTL	METAL
N	N	NORTH
	NIC	NOT IN COUNT / NOT IN CONTRACT
	NO	NUMBER
	NOM	NOMINAL
	NTS	NOT TO SCALE
O	OA	OVERALL
	OC	ON CENTER
	OD	OUTSIDE DIAMETER
	OFD	OVERFLOW ROOF DRAIN
	OFF	OFFICE
	OH	OPPOSITE HAND
	OPNG	OPENING
	OPP	OPPOSITE
	OSB	ORIENTED STRAND BOARD
P	PA	PUBLIC ADDRESS
	PAR	PARALLEL
	PCP / PLAS	PORTLAND CEMENT PLASTER
	PERP	PERPENDICULAR
	PH	PRE-HUNG
	PL	PROPERTY LINE
	PLAM	PLASTIC LAMINATE
	PLAS	PLASTER
	PLBG	PLUMBING
	PLBG	PLUMBING
	PLYWD	PLYWOOD
	PNL	PANEL
	PNLG	PANELING
	PR	PAIR
	PREFAB	PREFABRICATED
	PREFIN	PREFINISHED
	PT	PAINT
	PTD	PAINTED
	PTN	PARTITION
	PTR	PAPER TOWEL RECEPTACLE

R	R	RADIUS
	RA	RETURN AIR
	RC	RESILIENT CHANNEL
	RCP	REFLECTED CEILING PLAN / REINFORCED CONCRETE PIPE(ING)
	RD	ROOF DRAIN
	RE / REF	REFER TO
	RECPT	RECEPTACLE
	RECS	RECOMMENDATION(S)
	REF	REFRIGERATOR / REFER TO
	REINF	REINFORCING
	REQD	REQUIRED
	REV	REVISION
	RFG	ROOFING
	RO	ROUGH OPENING
	RR	RESTROOM
	RTU	ROOF TOP UNIT
S	S	SOUTH
	SAF	SELF ADHERED FLASHING
	SAFP	SPRAYED APPLIED FIRE-PROOFING
	SC	SOLID CORE
	SCHED	SCHEDULE
	SCR	SHOWER CURTAIN ROD
	SD	SOAP DISPENSER
	SECT	SECTION
	SF	SQUARE FEET
	SH	SINGLE HUNG
	SHR	SHOWER
	SHT	SHEET
	SIM	SIMILAR
	SND	SANITARY NAPKIN DISPENSER
	SOG	SLAB ON GRADE
	SP CTG	SPECIAL COATING
	SPEC	SPECIFICATION
	SPKR	SPEAKER
	SQ	SQUARE
	SQIN	SQUARE INCHES
	SST	STAINLESS STEEL
	STC	SOUND TRANSMISSION COEFFICIENT
	STD	STANDARD
	STL	STEEL
	STOR	STORAGE
	STOR	STORAGE
	STRUCT	STRUCTURAL
	SUBFLR	SUBFLOOR
	SUSP	SUSPEND(ED)
	SY	SQUARE YARD
	SYM	SYMMETRICAL
T	T	TREAD
	T&B	TOP AND BOTTOM
	T&G	TONGUE AND GROOVE
	T.O.	TOP OF
	TB	TOWEL BAR
	TBD	TO BE DETERMINED
	TEL / TELE	TELEPHONE
	TER / TRZ	TERRAZZO (TERRACE)
	TERM	TERMINATE / TERMINAL
	TOC	TOP OF CURB / TOP OF CONC
	TOM	TOP OF MASONRY
	TOW	TOP OF WALL
	TP / TPD	TOILET PAPER DISPENSER
	TPO	THERMOPLASTIC POLYOLEFIN
	TRANS	TRANSFORMER / TRANSPARENT / TRANSOM
	TS	TUBE STEEL
	TYP	TYPICAL
U	UNO	UNLESS NOTED OTHERWISE
	UON	UNLESS OTHERWISE NOTED
	UR	URINAL
	US	UTILITY SHELF

V	VCT	VINYL COMPOSITE TILE
	VENT	VENTILATE / VENTILATION
	VER	VERIFY
	VIF	VERIFY IN FIELD
	VP	VISION PANEL
	VTR	VENT THRU ROOF
W	W	WEST
	W/	WITH
	W/IN	WITHIN
	W/O	WITHOUT
	WC	WATER CLOSET
	WD	WOOD
	WDW	WINDOW
	WF	WIDE FLANGE / WATER FOUNTAIN
	WH	WALL HUNG / HYDRANT / WATER HEATER / WEEP HOLE
	WLD	WELD(ED)
	WRB	WEATHER-RESISTANT BARRIER
	WT	T SECTION
	WWF	WELDED WIRE FABRIC
X	X	BY (2X4)
Y	YD	YARD / YARD DRAIN

MATERIAL LEGEND AND SYMBOLS

- MASONRY BLOCK - PLAN 1/2" = 1'-0" AND BELOW
- BRICK - SECTION
- CONCRETE ABOVE 1-1/2" = 1'-0"
- STUD WALL
- GYPSUM BOARD
- PLYWOOD
- RIGID INSULATION
- BATT INSULATION
- STANDING SEAM METAL ROOF
- EARTH
- CRUSHED ROCK
- SAND
- CONTINUOUS LUMBER
- NON-CONTINUOUS LUMBER (SHIM)
- FINISH LUMBER
- STEEL OR METAL

- 1000 / Room Name — ROOM NUMBER
- 101 — DOOR NUMBER
- A1 — WINDOW TYPE
- P7 — WALL TYPE
- 01.00 — ELEVATION KEYNOTE
- 01.00 — PLAN KEYNOTE
- ELEVATION NUMBER / 1 / A101 / SHEET NUMBER — SIMILAR TO WALL SECTION INDICATED; WALL SECTION CUT LINE
- ELEVATION NUMBER / 1 / A101 / SHEET NUMBER — SIMILAR TO BUILDING SECTION INDICATED; BUILDING SECTION CUT LINE
- ELEVATION NUMBER / A-101 / 3 / SHEET NUMBER — EXTERIOR ELEVATION
- ELEVATION NUMBER / A-101 / 3 / SHEET NUMBER — INTERIOR ELEVATION
- ELEVATION NUMBER / 1 / A101 / SHEET NUMBER — SIMILAR TO BUILDING SECTION INDICATED; ENLARGED PLAN OR DETAIL CALLOUT
- Name / Elevation — ELEVATION MARK
- ARCHITECT TO VERIFY

GENERAL NOTES

STANDARDS AND REGULATIONS

1. CONTRACTOR SHALL PERFORM ALL WORK IN CONFORMANCE WITH APPLICABLE BUILDING CODES, REGULATIONS, ORDINANCES, UTILITY PROVIDER REQUIREMENTS, AND SIMILAR STANDARDS.
2. CONTRACTOR SHALL OBTAIN ALL REQUIRED PERMITS AND SIMILAR RELEASES REQUIRED FOR CONSTRUCTION AND OCCUPANCY. CONTRACTOR SHALL FURNISH ALL COPIES OF SUCH ITEMS TO OWNER AND ARCHITECT WITHIN 10 DAYS OF RECEIPT. IF PERMITS ARE ISSUED SUBJECT TO CERTAIN CONDITIONS OR REVISIONS TO THE WORK OR PERMITS ARE DELAYED FOR ANY REASON, CONTRACTOR SHALL NOTIFY CONTRACTING OFFICER IMMEDIATELY.
3. CONTRACTOR SHALL OBTAIN ALL REQUIRED INSPECTIONS OF THE WORK. CONTRACTOR SHALL REGULARLY UPDATE OWNER AND ARCHITECT REGARDING THE STATUS OF THE INSPECTIONS.
4. CONTRACTOR SHALL COORDINATE WORK WITH APPLICABLE UTILITY PROVIDERS.
5. CONTRACTOR SHALL BE FAMILIAR WITH AND WORK SHALL BE IN COMPLIANCE WITH REFERENCED FIRE-RATED ASSEMBLY TESTS AND STANDARDS.

ADMINISTRATION OF THE WORK

1. CONTRACTOR SHALL BE SOLELY RESPONSIBLE FOR THE MEANS, METHODS AND SEQUENCES OF CONSTRUCTION.
2. CONTRACTOR SHALL BE SOLELY RESPONSIBLE FOR THE SAFETY OF ALL CONSTRUCTION PERSONNEL AND AUTHORIZED VISITORS.
3. CONTRACTOR SHALL BECOME FULLY ACQUAINTED WITH THE CONDITIONS RELATED TO THE WORK. ANY KNOWN DISCREPANCIES BETWEEN THE DOCUMENTS AND ACTUAL CONDITIONS SHALL BE REPORTED TO THE OWNER FOR RESOLUTION PRIOR TO PROCEEDING WITH WORK RELATED TO THE DISCREPANCY.
4. CONTRACTOR SHALL REMOVE AND PROPERLY DISPOSE OF ALL CONSTRUCTION AND DEMOLITION DEBRIS. CONTRACTOR SHALL OBTAIN APPROVAL OF OWNER (AND GOVERNING AUTHORITIES, IF APPLICABLE) FOR DETAILS RELATED TO REMOVAL OF TRASH, INCLUDING SUCH ISSUES AS PATH OF TRAVEL.
5. CONTRACTOR SHALL BECOME FAMILIAR WITH AND COMPLY WITH GOVERNMENT'S PROCEDURES FOR MAINTAINING A SECURE SITE AND BUILDING.
6. EACH INSTALLER SHALL EXAMINE SUBSTRATE CONDITION AND/OR SITE CONDITIONS WHICH AFFECT THE QUALITY OF EACH PRODUCT TO BE INSTALLED. IF ANY CONDITIONS EXIST WHICH WILL HAVE A DETRIMENTAL EFFECT ON THE QUALITY OF THE INSTALLATION, THE INSTALLER SHALL IMMEDIATELY NOTIFY THE CONTRACTOR. INSTALLATION SHALL NOT PROCEED UNTIL THE UNSATISFACTORY CONDITIONS ARE CORRECTED. PROCEEDING WITH THE INSTALLATION SHALL SIGNIFY ACCEPTANCE OF THE CONDITIONS.
7. CONTRACTOR SHALL MAINTAIN RECORD DRAWINGS ON SITE AT ALL TIMES.
8. CONTRACTOR SHALL BE RESPONSIBLE FOR ENSURING COORDINATION EFFORTS OF ALL SUBCONTRACTORS.
9. CONTRACTOR SHALL NOT CLOSE UP CEILING UNTIL ARCHITECT HAS AN OPPORTUNITY TO INSPECT ALL WORK WHICH WILL BE CONCEALED BY CEILING. CONTRACTOR SHALL NOTIFY ARCHITECT AT LEAST TWENTY-FOUR HOURS PRIOR TO CLOSE-UP.
10. CONTRACTOR SHALL LAY OUT WORK AS SOON AS POSSIBLE. ANY DISCREPANCIES SHALL BE REPORTED TO THE ARCHITECT FOR RESOLUTION PRIOR TO PROCEEDING WITH THE WORK IN QUESTION.

USE OF CONSTRUCTION DOCUMENTS

1. CONTRACTOR SHALL NOT SCALE DRAWINGS. ONLY WRITTEN DIMENSIONS OR KEYED NOTES SHALL BE USED. CONTACT ARCHITECT IF CLARIFICATION OR ADDITIONAL INFORMATION IS REQUIRED.
2. DRAWINGS SHALL NOT BE REPRODUCED FOR SUBMITTALS. DRAWINGS OR PORTIONS OF DRAWINGS USED FOR SUBMITTALS WILL BE REJECTED AND RETURNED TO CONTRACTOR.
3. DIMENSIONS ARE AS FOLLOWS UNLESS NOTED OTHERWISE:
   A. FACE OF STUD
   B. TO CENTERLINE OF COLUMNS, PARTY WALL, WINDOWS AND DOORS
   C. TO TOP OF STRUCTURAL DECK
   D. TO BOTTOM OF FINISHED CEILING

DEFINITIONS

1. "ALIGN" AS USED IN THESE DOCUMENTS SHALL MEAN TO ACCURATELY LOCATE AND FINISH FACES IN THE SAME PLANE AND/OR TO INSTALL NEW CONSTRUCTION ADJACENT TO EXISTING CONSTRUCTION WITHOUT ANY VISIBLE JOINTS OR SURFACE IRREGULARITIES.
2. "CLEAR" AS USED IN THESE DOCUMENTS SHALL MEAN THAT THE CONDITION IS NOT ADJUSTABLE WITHOUT THE APPROVAL OF THE ARCHITECT, CLEAR DIMENSIONS ARE TYPICALLY TO FINISH FACE.
3. "MAXIMUM" OR "MAX" AS USED IN THESE DOCUMENTS SHALL MEAN THAT THE CONDITION IS SLIGHTLY ADJUSTABLE BUT MAY NOT VARY TO A DIMENSION OR QUANTITY GREATER THAN THAT SHOWN WITHOUT APPROVAL OF THE ARCHITECT.
4. "MINIMUM" OR "MIN." AS USED IN THESE DOCUMENTS SHALL MEAN THAT THE CONDITION IS SLIGHTLY ADJUSTABLE BUT MAY NOT VARY TO A DIMENSION OR QUANTITY LESS THAN THAT SHOWN WITHOUT APPROVAL OF THE ARCHITECT.
5. "TYPICAL" OR "TYP" AS USED IN THESE DOCUMENTS SHALL MEAN THAT THE CONDITION OR DIMENSION IS THE SAME OR REPRESENTATIVE FOR SIMILAR CONDITIONS THROUGHOUT.
6. "+/-" AS USED IN THESE DOCUMENTS SHALL MEAN THE DIMENSION OR QUANTITY IS SLIGHTLY ADJUSTABLE TO ACCOMMODATE ACTUAL CONDITIONS.

GENERAL CONSTRUCTION ISSUES

1. HATCHED AREAS INDICATE AREA TO BE FURRED DOWN ABOVE FINISHED FLOOR UNLESS NOTED OTHERWISE.
2. ALL PLUMBING SUPPLY LINES IN EXTERIOR WALLS TO RECEIVE FULL INSULATION.
3. DO NOT ALLOW EXTERIOR SHEATHING TO BE IN CONTACT WITH CONCRETE SURFACE.
4. HOLD ALL WOOD TRIM A MINIMUM OF 1/4-INCH ABOVE CONTACT WITH HORIZONTAL CONCRETE SURFACES.

PASSIVE SUB SLAB DEPRESSURIZATION RADON CONTROL SYSTEM

1. PROVIDE UNDERSLAB RADON MITIGATION SYSTEM WITH REQUIRED VENTING.
2. DESIGN OF SUB SLAB DEPRESSURIZATION RADON CONTROL SYSTEM WILL BE THE RESPONSIBILITY OF THE CONTRACTOR.
3. PROVIDE ELECTRICAL JUNCTION BOX IN ATTIC FOR POSSIBLE FUTURE INSTALLATION OF WARNING DEVICE FOR EACH VERTICAL STACK.
4. PROVIDE 15 AMP, 115 VOLT ELECTRIC CIRCUIT AND JUNCTION BOX FOR FUTURE INSTALLATION OF VENT FAN.
5. ALL CONCRETE SLABS THAT COME IN CONTACT WITH THE GROUND SHALL BE LAID OVER A GAS PERMEABLE MATERIAL MADE UP OF EITHER A MINIMUM 4" THICK UNIFORM OF CLEAN AGGREGATE OR A MINIMUM 4" THICK UNIFORM LAYER OF SAND, OVERLAIN BY A LAYER OR STRIPS OF MANUFACTURED MATTING DESIGNED TO ALLOW THE LATERAL FLOW OF SOIL GASES.
6. ALL CONCRETE FLOOR SLABS SHALL BE DESIGNED AND CONSTRUCTED IN ACCORDANCE WITH LOCAL BUILDING CODES.
7. ALL OPENINGS, GAPS, AND JOISTS IN FLOOR AND WALL ASSEMBLIES IN CONTACT WITH SOIL OR GAPS AROUND PIPES, TOILETS, BATHTUBS OR DRAINS PENETRATING THESE ASSEMBLIES SHALL BE FILLED OR CLOSED WITH MATERIALS THAT PROVIDE A PERMANENT AIR-TIGHT SEAL. SEAL LARGE OPENINGS WITH NON-SHRINK MORTAR, GROUTS OR EXPANDING FOAM MATERIALS AND SMALLER GAPS WITH ELASTOMERIC JOINTS SEALANT, AS DEFINED ASTM C920-A7.
8. VENT PIPES SHALL BE INSTALLED SO THAT ANY RAINWATER OR CONDENSATION DRAINS DOWNWARD INTO THE GROUND BENEATH THE SLAB OR SOIL - GAS - RETARDER MEMBRANE.
9. EXHAUST CLEARANCES MUST CONFORM TO THE CURRENT NATIONAL STANDARD PLUMBING CODE, FOR EXHAUST TERMINATION LIMITATION AND REQUIREMENTS.

PRINTS ISSUED
10/30/23 PERMIT SUBMITTAL

REVISIONS:

rosemann & ASSOCIATES P.C.
ARCHITECTURE
INTERIOR DESIGN
ENGINEERING
PLANNING
1526 Grand Boulevard
Kansas City, MO 64108-1404
p: 816.472.1448
w: www.rosemann.com
© 2023 Rosemann & Associates, P.C.
DENVER ▲ KANSAS CITY ▲ ST. LOUIS ▲ ATLANTA

STATE OF MISSOURI
DAVID EUGENE HENDRIKS
NUMBER A-7365
REGISTERED ARCHITECT
10/30/23

WILSHIRE HILLS III
LEE'S SUMMIT, MISSOURI
MHDC - 22-057

SHEET TITLE
GENERAL INFORMATION

PROJECT NUMBER: 23034

SHEET NUMBER:
G-002

10/27/2023 2:53:03 PM
C:\Revit Local Files\R23\23034_Wilshire Hills III_Central_R23_revitTILCAR.rvt

ROOF PLAN GENERAL NOTES

1. ALL NEW WORK TO MEET ALL APPLICABLE BUILDING, PLUMBING, MECHANICAL, HANDICAP, AND LIFE SAFETY CODES AND REQUIREMENTS.
2. THE MINIMUM NET FREE VENTILATING AREA SHALL BE 1/150 OF THE AREA OF THE SPACE VENTILATED. THE OPENINGS SHALL BE COVERED WITH CORROSION-RESISTANT MESH OR OTHER APPROVED MATERIALS WITH OPENINGS NOT MORE THAN 1/2" IN ANY DIRECTION.
3. WHERE RIDGE OR GABLE VENTS ARE UTILIZED, ADDITIONAL PROTECTION AGAINST SNOW INFILTRATION SHALL BE PROVIDED BY BALANCING THE AREA OF THE VENTS IN THE RIDGES AND THE EAVES SUCH THAT AT LEAST 1/2 OF THE VENTILATION AREA SHALL BE PROVIDED BY SOFFIT OR EAVE VENTS, WITH THE BALANCE OF THE VENTILATION OPENINGS PROVIDED BY THE GABLE OR RIDGE VENTS. REFERENCE IBC 2018 SECTION 1202.
4. ALL FLOOR JOIST BEARING HEIGHTS ARE 9'-1 1/8". ALL ROOF TRUSS BEARING HEIGHTS ARE 9' - 1 1/8". REFERENCE WALL SECTIONS ON A-300 SHEETS.
5. 1'-6" ROOF SOFFIT, UNLESS NOTED OTHERWISE, REF: ROOF PLAN.
6. CONTRACTOR TO INSTALL GUTTERS, DOWNSPOUTS AND ALL FLASHING PER APPLICABLE SMACNA GUIDELINES. IF ADDITIONAL DOWNSPOUTS ARE REQUIRED, CONTRACTOR SHALL CONFIRM LOCATIONS WITH ARCHITECT PRIOR TO INSTALLATION.
7. MEMBRANE ROOFING SYSTEM ON RIGID INSULATION, ALL ROOF LOCATIONS TYP. U.O.N.
8. COLORS T.B.D., COORDINATE WITH ARCHITECT.

REFLECTED CEILING PLAN GENERAL NOTES

1. SEE MEP SET FOR LOCATIONS OF ALL LIGHT FIXTURES AND MECHANICAL DIFFUSERS.
2. COORDINATE ANY DISCREPANCIES WITH MEP AND ARCHITECT PRIOR TO INSTALLATION.
3. REFERENCE ALL INTERIORS DRAWINGS FOR COORDINATION
4. ALL CEILINGS TO CONFORM TO 2018 IBC TABLE 803.13
5. ALL ACT TILES TO BE WHOLE DIMENSIONS AND ARE NOT TO BE FIELD CUT, ALL ACT TO BE FIELD CENTERED IN SPACE, U.N.O. OR DIMENSIONED
6. SEE ENLARGED UNIT PLANS (A-400 SERIES) FOR ALL UNIT RCP PLANS EXCEPT WHERE HEIGHTS ARE LISTED ON RCP PLANS IN A-100 SERIES.
7. DROPPED CEILINGS AT BATHROOMS ARE TO BE LOCATED AT 8'-0" ABOVE FINISHED FLOOR UNLESS OTHERWISE INDICATED ON THE PLAN.
8. DROPPED CEILINGS AT BEDROOMS ARE TO BE LOCATED AT 9'-0" ABOVE FINISHED FLOOR UNLESS OTHERWISE INDICATED ON THE PLAN.
9. DROP SOFFITS ABOVE KITCHEN CABINETS ARE INTENDED TO BE LOCATED AT 9'-0" ABOVE FINISHED FLOOR IN AREAS SHOWN TO ACCOMMODATE DUCT WORK, RECESSED LIGHTING, AND VENTING. INSTALL AS FRAMED GYPSUM BOARD SYSTEM.
10. ALL UN-HATCHED REGIONS ARE TO BE OPEN UNFINISHED CEILING TO THE STRUCTURAL DECK AND STRUCTURAL MEMBERS ABOVE. SURFACES TO BE CLEANED AND PATCHED/REPAIRED .
11. ALL EXISTING HISTORICAL CAPITALS, PEDIMENTS, PLASTER DETAILS, ETC. AT COLUMNS AND PILASTERS ARE TO REMAIN. SURFACES TO BE CLEANED AND PATCHED/REPAIRED. PAINT TO MATCH ADJACENT WALL.
12. WHERE CEILING HEIGHT IS B.O. FLOOR ASSEMBLY, FINISH TO BE LEVEL FOUR FINISH. ALL UNITS TO HAVE A LEVEL FOUR FINISH AT CEILINGS.
13. ALL MECH DUCTS WHICH FEED TO PLENUM SPACE VIA MECH SHAFTS SHALL BE ENCLOSED ON THE BOTTOM ACCORDING TO PROGRESSIVE ENGINEERING REPORT AER-09-038.
14. ACCESS TO EQUIPMENT SHALL BE THROUGH ACT WHERE AVAILABLE. WHERE NECESSARY, ACCESS THROUGH GWB CEILING TO USE ACCESS HATCHES. GC TO PROVIDE HATCHES AND HATCH LOCATION DIAGRAM PRIOR TO INSTALL.
15. ALL DIMENSIONS FOR CEILING TYPE C5 AND C1 ARE TO FINISHED FACE. ALL DIMENSIONS TO WALLS ARE TO F.O. STUD.
16. ALL DROPPED SOFFIT FRAMING IN COMMON AREAS SHALL BE OUT OF METAL STUDS. ONE (1) HOUR RATED CEILING THROUGHOUT BUILDING AT UNDERSIDE OF ROOF TRUSSES AND ARE PART OF THE FIRE RATED FLOOR-CEILING ASSEMBLY
17. ALL GYPSUM BOARD CEILINGS TO BE PAINTED PA-1 (U.O.N.).
18. MISCELLANEOUS SYMBOLS INDICATED ON REFLECTED CEILING PLAN ARE MECHANICAL IN NATURE. REFER TO MEP DRAWING SHEETS FOR FURTHER CLARIFICATION FOR ITEM IDENTIFICATION AND LOCATIONS.

PLAN GENERAL NOTES

01 - GENERAL
A. ALL NEW WORK TO MEET ALL APPLICABLE BUILDING, PLUMBING, MECHANICAL, ELECTRICAL, HANDICAP, AND LIFE SAFETY CODES AND REQUIREMENTS.
B. ALL WALL DIMENSIONS ARE TO FACE OF STUD, UNLESS NOTED OTHERWISE.
C. DO NOT SCALE DRAWINGS.
D. NOTIFY ARCHITECT OF ANY DISCREPANCIES BETWEEN PROJECT DOCUMENTS AND EXISTING CONDITIONS. ANY MODIFICATIONS DUE TO DIMENSIONAL CHANGES SHOULD BE PART OF THE PROJECT COST.
E. GENERAL CONTRACTOR AND ALL SUBCONTRACTORS SHALL THOROUGHLY FAMILIARIZE THEMSELVES TO ALL SITE SPECIFIC REQUIREMENTS AND EXTENTS OF THE NEW WORK PRIOR TO BIDDING. NO CHANGES IN THE CONTRACT WILL BE CONSIDERED FOR INFORMATION DISCERNABLE FROM THE EXISTING CONDITIONS OR THE PROJECT DOCUMENTS.
F. CONTRACTORS SHALL BE FAMILIAR AND INCORPORATE ALL PROVISIONS AND REQUIREMENTS ESTABLISHED BY CODES APPLICABLE TO THE PROJECT INCLUDING FAIR HOUSING, UFAS, ANSI, & ADAAG
G. REPORT ALL EXISTING CONDITIONS THAT ARE DAMAGED OR MARRED TO THE ARCHITECT PRIOR TO COMMENCEMENT OF THE NEW WORK.
H. TYPICAL TOP OF FIRST FLOOR SUBFLOOR ELEVATION IS REFERENCED AS 100'-0". CONTRACTOR SHALL VERIFY BUILDING FINISH FLOOR ELEVATION WITH ACTUAL CONDITIONS. COORDINATE ACTUAL GRADE WITH CIVIL DRAWINGS.
I. FULLY ACCESSIBLE UNITS SHALL MEET THE REQUIREMENTS OF 2009 ICC/ANSI A117.1 - TYPE 'A' DWELLING UNITS AND 2010 ADAAG (DOJ). ALL OTHER DWELLING UNITS TO BE TYPE 'B'.
J. MAIN LEVEL ELEVATION IS T.O. GYPCRETE, OR T.O. CONCRETE SLAB, RESPECTIVELY.
K. LEVELS ABOVE MAIN LEVEL ARE MEASURED TO T.O. SUBFLOOR.
L. WHOLE BUILDING TO MEET FAIR HOUSING ACT.
M. ALL PENETRATIONS INTO FIRE-RATED ASSEMBLIES ARE TO BE FIRESTOPPED WITH UL APPROVED FIRESTOPPING ASSEMBLIES. UL INFORMATION SHALL BE PROVIDED BY TRADE RESPONSIBLE FOR PENETRATION. REFERENCE THE G-200 SERIES.
N. THROUGH PENETRATIONS NOT LOCATED WITHIN WALL CAVITY OR FLOOR/CEILING/ROOF ASSEMBLY SHALL BE REQUIRED TO HAVE FIRE RESISTIVE PENETRATION WITH A T-RATING EQUAL TO OR EXCEEDING THE ASSEMBLY THAT IS PENETRATED.
O. CONTROL JOINTS IN GWB AT ALL UNIT CORRIDORS SHALL BE LOCATED AT INSIDE CORNER OF PILASTERS AND ACROSS TOP OF DROP SOFFIT AT PILASTERS. AT LOCATIONS WHICH THERE IS A 30' SPAN BETWEEN PILASTERS, A CONTROL JOINT SHALL OCCUR AT THE CENTRAL LOCATION BETWEEN THE TWO PILASTERS ADJACENT TO THE NEAREST DOOR, RUNNING FROM HEAD TO T.O. PARTITION AT CORNER. AT LOCATIONS WHICH THERE IS A 30' SPAN BETWEEN SOFFIT WHERE PILASTER OCCURS, A CONTROL JOINT SHALL OCCUR AT THE INSIDE CORNER OF PILASTER AND SOFFITS. CONTROL JOINTS SHALL OCCUR AT THE CORNERS OF ALL STOREFRONT, RUNNING TO THE T.O. THE PARTITION. GC TO VERIFY WITH ARCHITECT DURING CONSTRUCTION ALL CONTROL JOINT LOCATIONS PRIOR TO INSTALL.
P. PROVIDE FIREBLOCKING AND DRAFTSTOPPING AS REQUIRED AND IN ACCORDANCE WITH 2018 IBC, SECTION 718.
Q. CONTRACTOR TO PROVIDE FIRE BLOCKING AT FIRE SEPARATION PARTITION AT 10' ON CENTER VERTICALLY, TYPICAL. CONTRACTOR TO PROVIDE FIRE BLOCKING AT FIRE SEPARATION PARTITION AT ALL BACK-TO-BACK ELECTRICAL OUTLETS.
R. ALL INTERIOR WALLS ARE TYPE P1, UNLESS NOTED OTHERWISE. ALL EXTERIOR WALLS ARE TYPE P30, UNLESS NOTED OTHERWISE. SEE SHEET G-102 FOR PARTITION SCHEDULE.
S. ALL EXTERIOR MATERIALS TO BE APPLIED PER MANUFACTURER RECOMMENDATIONS AND WITH ASSOCIATED PRODUCTS (SUCH AS STAPLES, NAILS, TAPER, SEALANT).

03 - CONCRETE
A. CONCRETE SEALANT TO BE USED ON FIRST FLOOR WHERE RECEIVING RESILIENT VINYL FLOORING.
B. AT SLAB ON GRADE UNITS, LEVEL CONCRETE SURFACE AT AREAS WHERE VCT FLOORING TO BE INSTALLED.

04 - MASONRY
A. ALL EXTERIOR BRICK TO HAVE WEEP HOLES AT MAX 2' ABOVE GRADE
B. ALL EXTERIOR BRICK TO EXTEND BELOW GRADE BY 3 COURSES (8") MIN. AND HAVE A BRICK LEDGE.
C. ALL LOCATIONS WITH EXTERIOR BRICK TO BE GROUTED SOLID FROM BELOW GRADE CONDITION TO LOWEST WEEP HOLE.

05 - METALS
A. STAIR HANDRAILS, TREADS, STRINGERS TO BE PRE-FINISHED OR PAINTED STEEL.
B. ALL DOWNSPOUTS TO BE CONNECTED TO UNDERDRAINS, SLOPED AWAY FROM BUILDING.
C. ALL EXTERIOR METAL TO BE PRE-FINISHED OR PRIMED/PAINTED. COLOR PER ARCH.

06 - WOOD, PLASTICS AND COMPOSITES
A. ALL COMMON SPACE, UNIT TOILET ROOMS, AND BATHROOMS TO HAVE BLOCKING FOR GRAB BARS. SEE G-301 FOR HEIGHTS AND LOCATIONS. GRAB BARS TO BE INSTALLED IN ALL COMMON SPACE, UNIT TOILET ROOMS, AND BATHROOMS. BLOCKING TO BE PROVIDED FOR ALL SHOWER GRAB BARS AND SEATING AS REQUIRED BY MANUFACTURER.
B. CONTRACTOR TO COORDINATE BLOCKING AT ALL ADJACENT POCKET DOORS, MEDICINE CABINETS, AND OTHER ELEMENTS.
C. AT ALL IDF, MDF & ELEC ROOMS; INTERIOR FINISH TO BE FIRE-TREATED PLYWOOD PAINTED WHITE ON ALL WALLS
D. ALL SHEAR WALL LOCATIONS & EXTENT OF SHEATHING TO BE COORDINATE WITH STRUCTURAL DRAWINGS.
E. ALL EXPOSED CABINET ENDS TO HAVE FINISHED PANELS, INCLUDING BUT NOT LIMITED TO END OF CABINET RUN, ADJACENT TO REFRIGERATOR, LOCATIONS OF VERTICAL OFFSETS.

07 - THERMAL AND MOISTURE PROTECTION
A. CAULK ALL JOINTS BETWEEN DISSIMILAR MATERIALS FOR WEATHER TIGHT, WATERTIGHT, AIRTIGHT, ETC. PERFORMANCE.
B. ALL EXTERIOR WRB TO BE APPLIED, TAPERED AND SEALED PER INSTRUCTIONS
C. PROVIDE SOUND ATTENUATION INSULATION OVER ALL BATHROOM CEILINGS AND IN BATHROOM WALLS, TYPICAL ALL BATHROOMS
D. AT EXTERIOR WALLS, CAULK CONTROL JOINTS IN FLOOR SLAB 12" INTO BUILDING TO PREVENT AGAINST WATER INFILTRATION.

08 - OPENINGS
A. DOORS- ELECTRICIAN IS REQUIRED TO COORDINATE WITH DOOR HARDWARE SCHEDULE FOR ALL ELECTRICAL ROUGH IN REQUIREMENTS FOR DOORS, INCLUDING AUTO OPERATORS, MAG HOLD OPENS, ELECTRONIC STRIKES, KEYPADS AND MAG LOCKS.
B. ALL DOOR HARDWARE SHALL BE COORDINATED W/ OWNER BY DESIGN BUILD CONTRACTOR.

09 - FINISHES
A. PRIME, PAINT AND SEAL ALL WALLS, COLUMNS AND CEILINGS AS REQUIRED PRIOR TO INSTALLATION OF M/E/P/F/TELEPHONE/SECURITY INSTALLATION.
B. CONTRACTOR TO COORDINATE ALL WET WALLS WITH ADJACENT RATINGS AND TO ACCOMMODATE PLUMBING FIXTURES. WALLS TO BE ALIGNED.
C. ALL WALLS TO BE ALIGNED AS INDICATED ON DRAWINGS - IF WALL IS MISALIGNED MID-WALL AND WILL AFFECT VISUAL APPEARANCE IN ROOM (I.E. 'JOG' WILL APPEAR) GC TO BRING TO ARCH ATTENTION PRIOR TO FINISHING
D. FLOOR TRANSITION SHALL OCCUR AT MIDDLE OF WALL WHERE OCCURS IN DOORWAY. PROVIDE VINYL REDUCER STRIP.

PLAN GENERAL NOTES - (CONT.)

10 - SPECIALTIES
A. ALL PUBLIC SOAP DISPENSERS TO BE INSTALLED IN SIDE WALL OF SINK OVER COUNTER.
B. ALL FIREPLACES TO BE INSTALLED PER MANUFACTURERS REQUIREMENTS AND TO MEET FIRE RATING OF WALLS ADJACENT.
C. ALL BACK OF HOUSE CORNERS TO HAVE CORNER GUARDS, PER INTERIORS.
D. ADDITIONAL CORNER GUARDS AT COMMON SPACES, PER INTERIORS
E. PROVIDE VENTILATED WIRE SHELVING AT ALL CLOSETS AND PANTRY UNO. REFERENCE ENLARGED FLOOR PLAN NOTES ON A-400 SHEETS FOR LOCATIONS. DEPTH TO BE COORDINATED WITH ANY LIGHT FIXTURES TO NOT ENCROACH ON IFC CLEARANCES.
F. TOILET PAPER DISPENSER TO BE INSTALLED PER A2/G-302 AND 2009 ICC ANSI 117.1
G. SEE G-301 FOR SIGNAGE REQUIREMENTS. NUMBERING OF UNITS AND ROOMS SHALL BE UPDATED TO MEET AHJ AND OWNER REQUIREMENTS PRIOR TO SIGNAGE PRODUCTION.

21 - FIRE SUPPRESSION
A. ALL UNITS TO HAVE APPROPRIATE NUMBER OF SMOKE DETECTORS INSTALLED INTERCONNECTED AND HARD-WIRED WITH BATTERY BACKUP PER CODE, INCLUDING ONE (1) IN EACH BEDROOM. ALL UNITS TO BE ABLE TO COMMUNICATE WITH NURSE CALL SYSTEM, GENERAL CONTRACTOR TO COORDINATE.
B. FIRE EXTINGUISHERS SHALL BE LOCATED SO THAT THE MAXIMUM TRAVEL DISTANCE SHALL NOT EXCEED 75 FEET. GENERAL CONTRACTOR TO PROVIDE SEMI-RECESSED TYPE THROUGHOUT WITH RATED CABINET. PROVIDE (1) TYPE "CLASS K" WITHIN 30 FEET OF COMMERCIAL COOKING EQUIPMENT. PROVIDE RESIDENTIAL TYPE ANSUL SYSTEM AT ALL RESIDENTIAL RANGES AS REQUIRED BY FIRE DEPARTMENT HEIGHT TO MEET ANSI.
C. CONCEALED SPRINKLER HEADS TO BE USED U.N.O.
D. IN RESIDENT UNITS, SEMI-RECESSED SPRINKLER HEADS TO BE USED. ALL COMMON AREA SPRINKLERS TO BE FULLY CONCEALED. SEE SPECIFICATION 21 00 00
E. DRY SPRINKLERS TO BE COORDINATED WITH DESIGN-BUILD CONTRACTOR. ALL SPRINKLERS IN BUILDING CAN BE WET. SPRINKLER LOCATIONS AND SPRINKLER EQUIP TO BE COORDINATED W/ ARCH PRIOR TO INSTALL - GC TO PROVIDE LOCATIONS OF HEADS ON RCPS FOR ARCH REVIEW PRIOR TO INSTALL. GC TO COORD FIRE SPRINKLER LINER W/ ALL MEP IN CORRIDOR SPACE TO MAINTAIN CEILING TYPE & HT. PER ARCH DWGS

22 - PLUMBING
A. PLUMBING VENT STACKS, FLUES, FRESH AIR INTAKES, ETC. NOT SHOWN FOR CLARITY. SEE MEP DRAWINGS FOR HVAC/ELECTRICAL/PLUMBING REQUIREMENTS/EQUIPMENT/LOCATIONS. GC TO VERIFY LOCATIONS OF ALL SIDEWALL VENTS PRIOR TO INSTALL.
B. PROVIDE FLOOR DRAINS AS INDICATED ON PLUMBING DRAWINGS AND PER APPLICABLE PLUMBING CODE.
C. DRAINAGE SHALL BE PER 2018 IBC 3201.4 - DRAINAGE WATER COLLECTED FROM A ROOF, AWNING, CANOPY OR MARQUEE AND CONDENSATE FROM MECHANICAL EQUIPMENT SHALL NOT FLOW OVER A PUBLIC WALKING SURFACE
D. CONTRACTOR TO COORDINATE MECHANICAL DUCT, SPRINKLER, PLUMBING, AND ELECTRICAL SUCH THAT CEILING HEIGHTS AND LOCATIONS ARE MAINTAINED PER REFLECTED CEILING PLANS.
E. ALL DOWNSPOUTS INTO COURTYARDS AND AT HARDSCAPE TO BE HARDPIPED TO STORM SEWER. GUTTERS/DOWNSPOUTS SHALL NOT FLOW OVER SIDEWALKS OR OTHER HARDSCAPE.

23 - HVAC
A. GC TO COORDINATE MECHANICAL PADS FOR ROOFTOP AND GROUND MOUNTED UNITS.

26 - ELECTRICAL
A. SEE ELECTRICAL PLANS FOR ELECTRIC DEVICE LAYOUTS.
B. SEE D4/G-300 FOR ELECTRICAL MOUNTING HEIGHT REQUIREMENTS.
C. PROVIDE EXIT SIGNS AT LOCATIONS AND PER **1013, IBC. -** A TACTILE SIGN STATING 'EXIT' AND COMPLYING WITH ICC A117.1 SHALL BE PROVIDED ADJACENT TO EACH DOOR TO AN AREA OF REFUGE, AN EXTERIOR AREA FOR ASSISTED RESCUE, AN EXIT STAIRWAY, AN EXIT RAMP, AN EXIT PASSAGEWAY AND THE EXIT DISCHARGE
D. PROVIDE DIMMER CAPABILITY FOR ALL COMMON AREA DECORATIVE AND DOWNLIGHTS/SPOTS (CAN LIGHTS).
E. TIMECLOCK AND PHOTOCELL FOR EXTERIOR LIGHTS. MULTIPLE ZONES MAY BE NECESSARY. INSTALL PER MANUFACTURERS RECOMMENDATIONS.
F. ALL ELECTRICAL AND IDF/MDF ROOMS TO HAVE SOLID BLOCKING TO ACCOMMODATE PANEL ATTACHMENT. BLOCKING TO BE PAINTED TO MATCH WALLS. WALLS TO REMAIN RATED AS INDICATED PER PLAN.
G. FIRE PULL STATIONS TO BE PROVIDED PER 2018 IFC AND A.H.J.
H. ALL LIGHTING, T-STATS AND OTHER SWITCHES TO BE INSTALLED PER ANSI 117.1, 2010 ADAAG, AND THE FAIR HOUSING ACT. LOCATIONS AND GROUPINGS OF SWITCHES TO BE ACCEPTED BY ARCH PRIOR TO INSTALL.

PRINTS ISSUED
10/30/23 PERMIT SUBMITTAL

REVISIONS:

rosemann & ASSOCIATES P.C.
ARCHITECTURE
INTERIOR DESIGN
ENGINEERING
PLANNING
1526 Grand Boulevard
Kansas City, MO 64108-1404
p: 816.472.1448
w: www.rosemann.com
© 2023 Rosemann & Associates, P.C.
DENVER ▲ KANSAS CITY ▲ ST. LOUIS ▲ ATLANTA

STATE OF MISSOURI
DAVID EUGENE HENDRIKSE
NUMBER A-7365
REGISTERED ARCHITECT
10/30/23

WILSHIRE HILLS III
LEE'S SUMMIT, MISSOURI
MHDC - 22-057

SHEET TITLE
PLAN GENERAL NOTES

PROJECT NUMBER: 23034

SHEET NUMBER:

G-003

10/27/2023 2:53:04 PM
C:\Revit Local Data\R23\23034_Wilshire Hills III_Central_R23_revitTUCAR.rvt

WEATHER-RESISTIVE BARRIER INSTALLATION GUIDELINES

WEATHER-RESISTIVE BARRIER INSTALLATION ON VERTICAL WALLS

PRIOR TO INSTALLATION OF WINDOWS OR DOORS

STEP 1
UNWRAP ROLL AT CORNER, LEAVE 6" TO 12" OVERLAP - PRINTED STUD MARKS TO LINE UP WITH FIRST STUD.

STEP 2
ROLL SHOULD BE PLUMB - EXTEND BOTTOM ROLL EDGE OVER SILL PLATE INTERFACE AT LEAST 2" TO 3".

STEP 3A
WEATHER-RESISTIVE BARRIER TO BE SECURED ON VERTICAL STUD LINE EVERY 12" TO 18". WHEN USING WOOD, INSULATED SHEATHING BOARD, OR EXTERIOR GYPSUM BOARD; LARGE HEAD OR PLASTIC WEATHER HEAD NAIL USE IS BEST PRACTICE. ALSO, 1" MIN. CROWN WIDE STAPLES MAY BE USED.

STEP 3B
WHEN USING MASONRY, TEMPORARILY ATTACH BARRIER WITH ADHESIVES CONTAINING POLYURETHANE, ELASTOMERIC, OR LATEX BASE IN VERTICAL STRIPS - SPACE APPROXIMATELY 24" APART (CONSULT BUILDING WRAP MANUFACTURER FOR LIST OF SUGGESTED ADHESIVES). AS A PERMANENT ATTACHMENT, USE CLADDING FASTENERS.

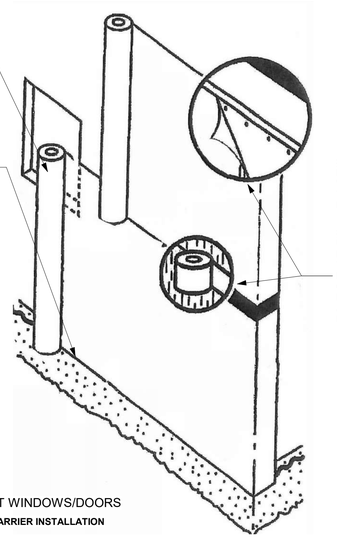

STEP 4
DIRECTLY UNROLL BARRIER OVER WINDOWS AND DOORS - UPPER ROLL TO OVERLAP BOTTOM ROLL 6" HORIZONTALLY.

STEP 5
UPPER OF UPPER AND LOWER PLATES TO BE COVERED BY BARRIER - TAPE ALL HORIZONTAL SEAMS AT BAND JOISTS, HEADERS AND ROLL OVERLAPS USING 2" OR 3" MANUFACTURER APPROVED TAPE. ALL ACCIDENTAL TEARS, DAMAGE OR PENETRATIONS TO BE TAPED.

FLASHING SYSTEM INSTALLATION AT WINDOWS/DOORS

UPON COMPLETION OF WEATHER-RESISTIVE BARRIER INSTALLATION

GENERAL INSTRUCTIONS

- USE AND INSTALL APPROVED FLASHING PER WEATHER-RESISTIVE BARRIER MANUFACTURER'S RECOMMENDATIONS.
- INSTALL FLASHING ON CLEAN, DRY SURFACES. SURFACES TO BE WIPED TO REMOVE MOISTURE, DIRT, GREASE AND OTHER DEBRIS WHICH MAY INTERFERE WITH ADHESION.
- PRESSURE TO BE APPLIED ALONG ENTIRE SURFACE TO ACHIEVE A GOOD BOND.
- SMOOTH/REPOSITION SURFACE AS NECESSARY TO ELIMINATE ALL WRINKLES AND BUBBLES.

STEP 6
PREPARE WEATHER-RESISTIVE BARRIER FOR WINDOW OR DOOR INSTALLATION:

A. MAKE A MODIFIED 'I-CUT' IN THE BARRIER, BEGINNING WITH A HORIZONTAL CUT ACROSS THE TOP OF THE WINDOW FRAME. (FOR ROUNDTOP WINDOWS, BEGIN THE CUT 2" ABOVE THE MULL JOINT; SEE D). CUT STRAIGHT DOWN FROM THE CENTER APPROXIMATELY 2/3 OF THE WAY, THEN ANGLE THE CUT TO THE CORNERS (SEE A).
B. TO EXPOSE SHEATHING, OR FRAMING MEMBERS, AND TO ALLOW FOR HEAD FLASHING INSTALLATION, CUT A FLAP ABOVE THE ROUGH OPENING.
C. INTO THE ROUGH OPENING, FOLD SIDE AND BOTTOM FLAPS AND THEN SECURE.
D. FLIP THE HEAD FLAP UP AND SECURE TEMPORARILY.

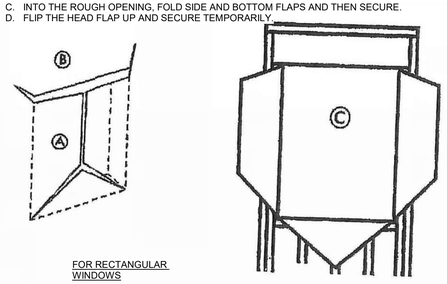

FOR RECTANGULAR WINDOWS

FOR ROUNDTOP WINDOWS

STEP 7

A. CUT FLEXIBLE FLASHING AT LEAST 12" LONGER THAN SILL ROUGH OPENING WIDTH.
B. REMOVE FIRST PIECE OF RELEASE PAPER, COVER HORIZONTAL SILL BY ALIGNING INSIDE EDGE OF SILL, AND SECURE IN ROUGH OPENING ACROSS SILL AND TURN UP JAMBS - MINIMUM 6". COVER HORIZONTAL SILL BY ALIGNING FLEXIBLE FLASHING EDGE WITH SILL INSIDE EDGE.
C. REMOVE SECOND PIECE OF RELEASE PAPER.

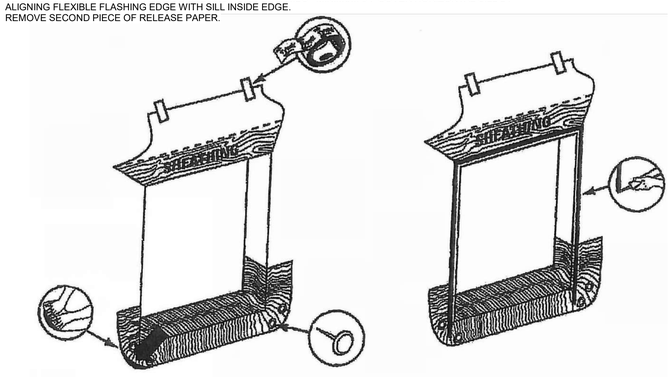

STEP 8

A. FAN FLEXIBLE FLASHING ONTO WALL FACE AT BOTTOM CORNERS.
B. PRESS SILL FLASHING FIRMLY TO ENSURE FULL ADHESION.
C. **FANNED EDGES TO BE SECURED WITH MECHANICAL FASTENERS.**

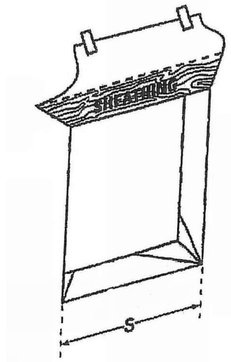

STEP 9

A. AT WALL OR BACK SIDE OF WINDOW MOUNTING FLANGE, APPLY A CONTINUOUS BEAD OF CAULK ACROSS JAMBS AND HEAD - BOTTOM SILL FLANGE TO REMAIN UNCAULKED.
B. **CAULK NOT TO BE APPLIED TO BOTTOM SILL FLANGE.**

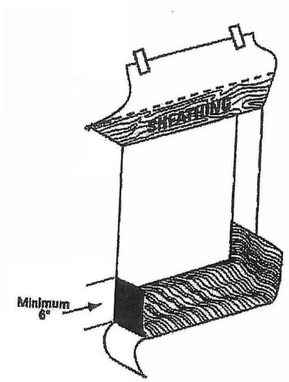

STEP 10

A. INSTALL WINDOW/DOOR PER MANUFACTURER'S INSTRUCTIONS. (IMAGE A)
B. CUT TWO PIECES OF FLASHING OR FLEXIBLE FLASHING FOR JAMB FLASHING TO EXTEND 1" ABOVE WINDOW HEAD FLANGE AND BELOW BOTTOM EDGE OF SILL FLASHING. REMOVE RELEASE PAPER AND TIGHTLY PRESS ALONG SIDES OF WINDOW FRAME. (IMAGE B)
C. CUT A PIECE OF FLASHING OR FLEXIBLE FLASHING FOR HEAD FLASHING, TO EXTEND BEYOND OUTER EDGES OF JAMB FLASHING. REMOVE RELEASE PAPER AND INSTALL COMPLETELY COVERING MOUNTING FLANGE AND ADHERING TO EXPOSED SHEATHING OR FRAMING MEMBERS. (IMAGE C)

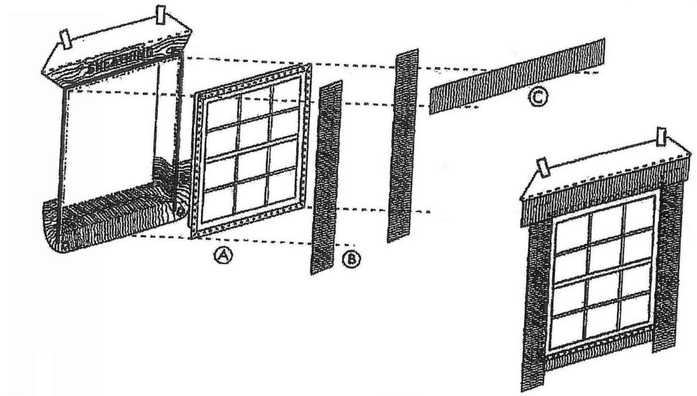

STEP 11

A. FLIP DOWN WEATHER-RESISTIVE BARRIER UPPER FLAP SO THAT IT LAYS FLAT ACROSS HEAD FLASHING.
B. TAPE ALONG ALL CUTS IN WEATHER-RESISTIVE BARRIER AND ACROSS WINDOW HEAD WITH APPROVED TAPE PER MANUFACTURER'S RECOMMENDATIONS.

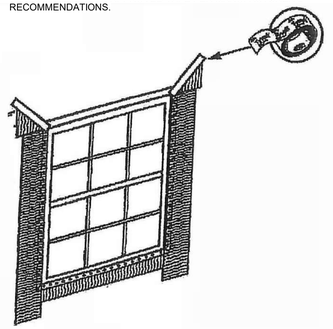

STEP 12

CAULK (BACKER ROD, AS NECESSARY) AT REAR OF WINDOW/DOOR FRAME TO SEAL INSIDE OF ROUGH OPENING ACROSS BOTTOM AND A MINIMUM 12" TURN UP AT SIDES TO FORM A BACK DAM. IN ORDER TO AIR SEAL AROUND WINDOW OPENING, COMPLETELY CAULK AROUND BACK EDGE OF WINDOW PERIMETER.

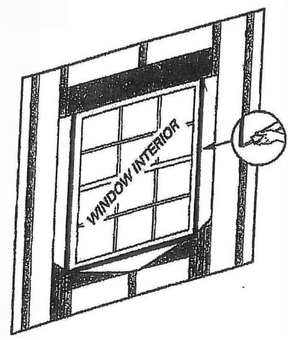

PRINTS ISSUED
10/30/23 PERMIT SUBMITTAL

REVISIONS:

rosemann & ASSOCIATES P.C.
ARCHITECTURE
INTERIOR DESIGN
ENGINEERING
PLANNING
1526 Grand Boulevard
Kansas City, MO 64108-1404
p: 816.472.1448
w: www.rosemann.com
© 2023 Rosemann & Associates, P.C.
DENVER ▲ KANSAS CITY ▲ ST. LOUIS ▲ ATLANTA

STATE OF MISSOURI
DAVID EUGENE HENDRIKSE
NUMBER A-7395
REGISTERED ARCHITECT
10/30/23

WILSHIRE HILLS III

LEE'S SUMMIT, MISSOURI

MHDC - 22-057

SHEET TITLE
GENERAL INFORMATION

PROJECT NUMBER: 23034

SHEET NUMBER:

G-004

10/27/2023 2:53:05 PM
C:\Revit Local Cache\R2023\23034_Wilshire Hills III_Central_R23_revit70.LCAR.rvt

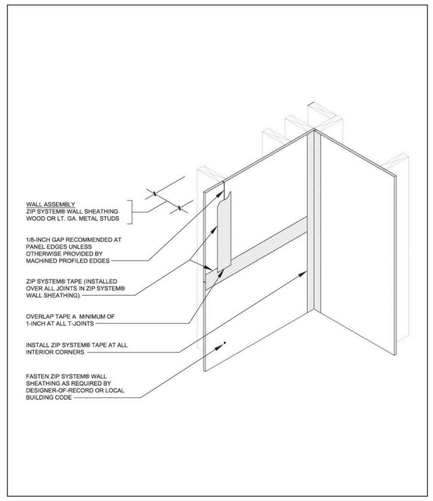

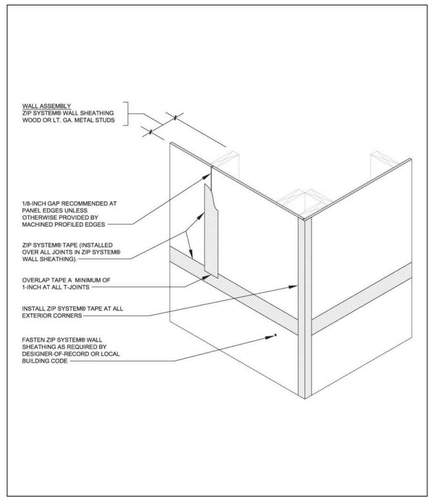

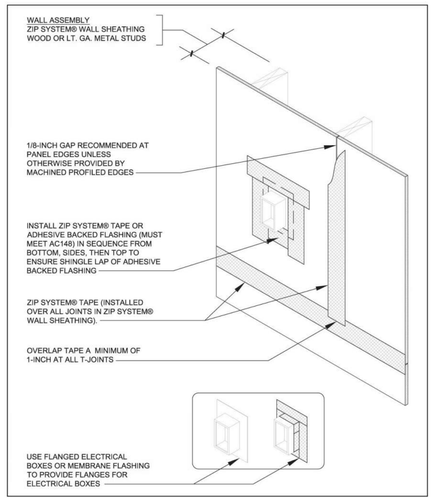

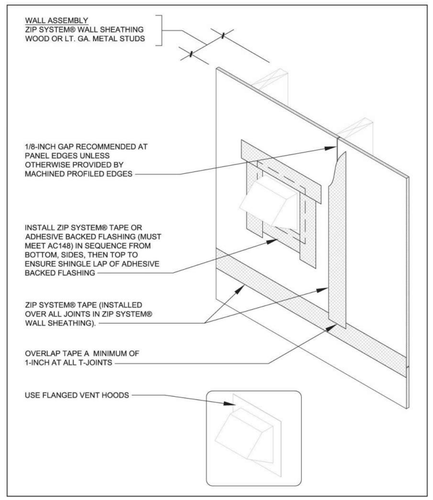

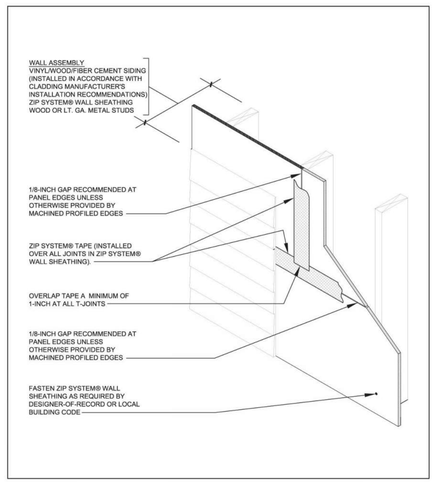

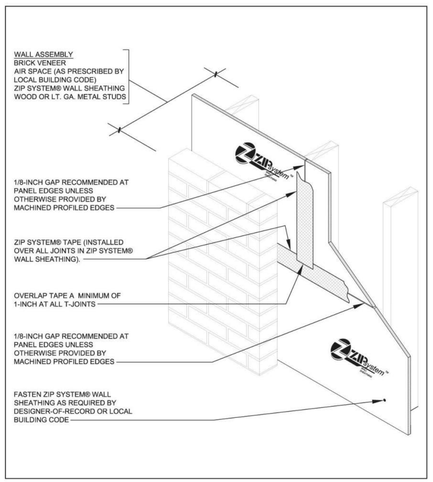

Brick Mould Windows (continued)

3. ZIP System tape may be used as pan flashing if installed in accordance with brick mould window installation details posted on zipsystem.com. Other adhesive-based flashing tapes (must meet ICC-ES Acceptance Criteria for Flashing Materials (AC148)) may be used as pan flashing if installed per ASTM 2112-07. Apply the flashing to cover the bottom of the opening, overhanging onto the sheathing by at least 2" and extending a minimum of 6" up each jamb.

4. For vertical jambs, cut ZIP System tape or another adhesive-backed flashing tape (must meet ICC-ES Acceptance Criteria for Flashing Materials (AC148)) and apply to each of the window jambs. Ensure that they cover the entire inside of the rough opening as well as overlap onto the sheathing by at least 2". Flashing shall also extend above the rough opening, such that it will project 1" beyond the exterior trim of the window.

Once the tape is in place, use the tape gun or roller to seal the flashing to the sheathing.

5. Apply sealant to jambs and header allowing for drainage at the sill in accordance with window manufacturer's installation instructions. When using ZIP System tape, use a butyl, polyurethane or silicone sealant. Do not use latex sealants with ZIP System tape. When using another flashing tape, follow the flashing manufac-turer's recommendations in selecting a sealant compatible with that flashing.

6. Install and level window per manufacturer's installation instructions.

7. Cut a piece of rigid head flashing so that when installed, it is flush with the edges of the exterior moulding of the window. Apply a bead of sealant to the back and bottom surface of the rigid head flashing. Use sealant recommended by the flashing manufacturer.

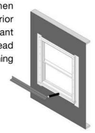

8. Secure the rigid head flashing to ZIP System wall sheathing.

9. Cut a length of ZIP System tape or another adhesive-backed flashing tape (must meet ICC-ES Acceptance Criteria for Flashing Materials (AC148)) and apply to the rigid head flashing, ensuring that the adhesive-backed flashing overlaps the jamb flashings.

Once the tape is in place, use the tape gun or roller to seal the flashing to the sheathing.

10. From the interior, apply low-pressure polyurethane foam (for windows) between the rough opening and the window frame. (Caulk sealant compatible with the sill flashing may be used at the sill if the opening between the sill flashing and window is too narrow to allow the use of low-pressure polyurethane foam.)

When using ZIP System tape, butyl, silicone or polyurethane sealants are acceptable. Do not use latex sealants with ZIP System tape. If using another flashing tape, follow the flashing manufacturer's recommendation in selecting a sealant compatible with that flashing.

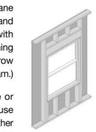

Apply ZIP System tape after all ZIP System wall sheathing panels are fully fastened to wall-framing members. Only ZIP System tape should be used to seal the seams of ZIP System panels. Ensure that the panel surface is dry and free of sawdust and dirt prior to taping. **ZIP System tape is a contact tape that requires pressure for an adequate seal.**

Step 1. Tape all seams using ZIP System tape. Ensure that the tape is centered over the seam within +/- 1/2" to provide adequate coverage and that wrinkles in tape are minimal.

Use the ZIP System tape gun or roller to apply pressure to the tape and smooth out any wrinkles.

Step 2. Wherever tape splices occur at a horizontal or vertical seam, create an overlapping splice of at least 3".

At T-joints, the tape pieces should overlap by at least 1". Apply moderate pressure onto the surface of the tape to ensure a secure bond between the panel and the tape.

Use the ZIP System tape gun or roller to apply pressure to the tape and smooth out any wrinkles.

Take special care to remove any voids and/or trapped air at splice areas and T-joints.

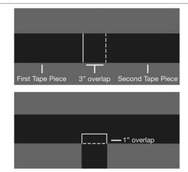

Step 3. Tape inside and outside corner seams.

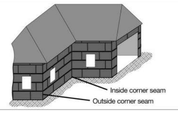

Flanged Windows

1. Fasten the ZIP System wall sheathing sheathing to the wood frame and install ZIP System tape to all wall panel seams, as de-tailed in sections 02 and 03.

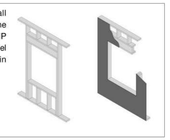

2. ZIP System tape may be used as pan flashing if installed in accordance with flanged window installation details posted on zipsystem.com. Other adhesive-based flashing tapes (must meet ICC-ES Acceptance Criteria for Flashing Materials (AC148)) may be used as pan flashing if installed per ASTM 2112-07. Apply the flashing to cover the bottom of the opening, overhanging onto the sheathing by at least 2" and extending a minimum of 6" up each jamb.

3. Apply sealant around inside face of mounting flange. Sealant must be gapped at the sill to permit drainage. Install and level window per manufacturer's installation instructions. Verify sealant compatibility with window manufacturer. When using ZIP System tape as pan flashing, butyl, silicone or polyurethane sealants are acceptable. Do not use latex sealants.

4. Cut two pieces of ZIP System tape or another adhesive-backed flashing tape (must meet ICC-ES Acceptance Criteria for Flashing Materials (AC148)) and apply to each of the window jamb flanges, ensuring the jamb flashings overlap the sill flashing.

Once the tape is in place, use the tape gun or roller to seal the flashing to the sheathing.

5. Cut a length of ZIP System tape or another adhesive-backed flashing tape (must meet ICC-ES Acceptance Criteria for Flashing Materials (AC148)) and apply to the header, ensuring that the flashing overlaps the jamb flashings.*

Once the tape is in place, use the tape gun or roller to seal the flashing to the sheathing.

*DO NOT tape bottom flange.

6. From the interior, apply low-pressure polyurethane foam (for windows) between the rough opening and the window frame. (Caulk sealant compatible with the sill flashing may be used at the sill if the opening between the sill flashing and window is too narrow to allow the use of low-pressure polyurethane foam.)

When using ZIP System tape, butyl, silicone or polyurethane sealants are acceptable. Do not use latex sealants with ZIP System tape. If using another flashing tape, follow the flashing manufacturer's recommendation in selecting a sealant compatible with that flashing.

Brick Mould Windows

1. Fasten the ZIP System wall sheathing sheathing to the wood frame and install ZIP System tape to all wall panel seams, as de-tailed in sections 02 and 03.

2. If recommended by the win-dow manufacturer, cut a strip of wood to function as a back dam at the sill. The wood strip should have a length equal to the width of the rough opening and a height and width of at least 1/2". Position the block at the inside edge of the window frame.

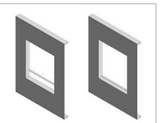

THIS SHEET IS PROVIDED FOR REFERENCE ONLY. ALL INSTALLATION TO BE PER MANUFACTURER RECOMMENDATION

PRINTS ISSUED
10/30/23 PERMIT SUBMITTAL

REVISIONS:

rosemann & ASSOCIATES P.C.
ARCHITECTURE
INTERIOR DESIGN
ENGINEERING
PLANNING
1526 Grand Boulevard
Kansas City, MO 64108-1404
p: 816.472.1448
w: www.rosemann.com
© 2023 Rosemann & Associates, P.C.
DENVER ◀ KANSAS CITY ◀ ST. LOUIS ◀ ATLANTA

STATE OF MISSOURI
DAVID EUGENE HENDRIKSE
NUMBER A-7365
REGISTERED ARCHITECT
10/30/23

WILSHIRE HILLS III
LEE'S SUMMIT, MISSOURI
MHDC - 22-057

SHEET TITLE
GENERAL INFORMATION

PROJECT NUMBER: 23034

SHEET NUMBER:

G-005

10/27/2023 2:53:05 PM
C:\Revit Local Files\R23\23034_Wilshire Hills III_Central_R23_mwm01vCAR.rvt

Appendix

Air Sealing key points

1. General Requirements
2. Ceiling/attic
3. Walls
4. Windows, skylights and doors
5. Rim joists
6. Floors (including above garage and cantilevered floors)
7. Crawl Space walls
8. Shafts, penetrations
9. Narrow cavities
10. Garage separation
11. Recessed lighting
12. Plumbing and wiring
13. Shower/tub on exterior wall
14. Electrical/phone bo on exterior walls
15. HVAC register boots
16. Concealed sprinklers
17. Blocking between framing (e.g. beneath knee walls, cantilvered floors, garage separation walls)
18. Common walls
19. Fireplaces

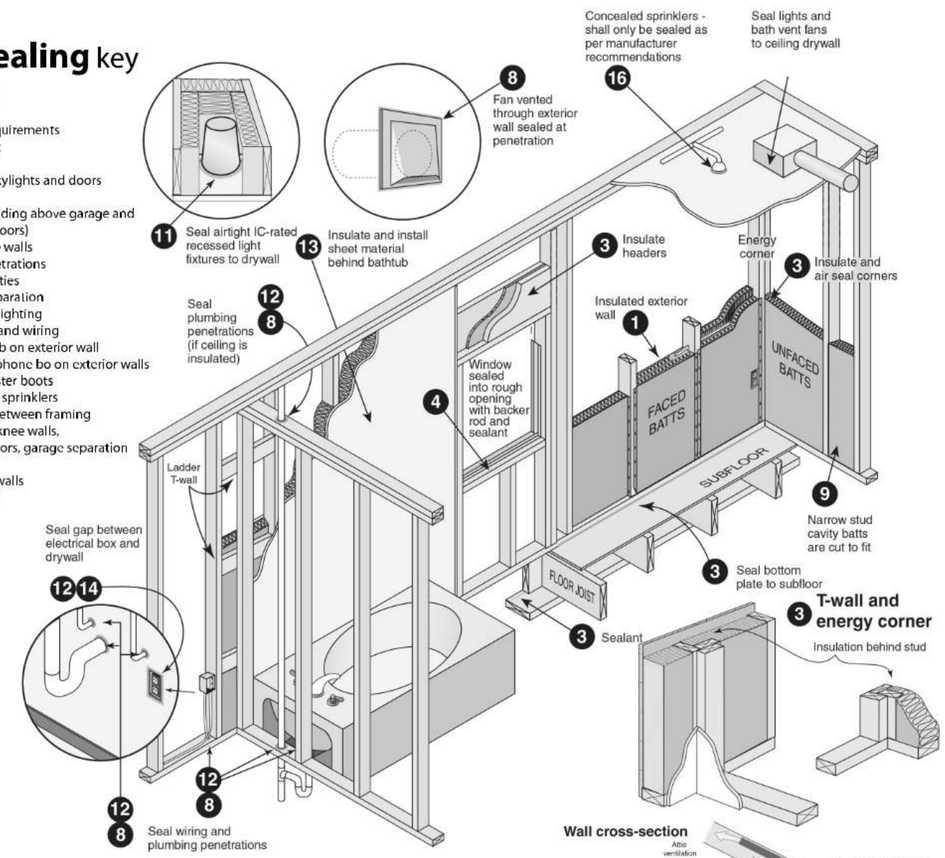

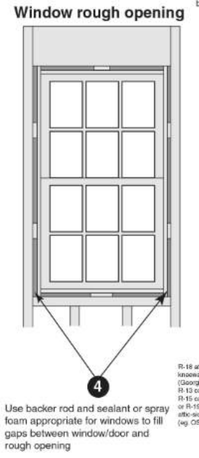

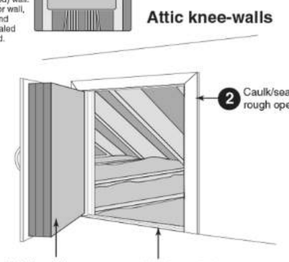

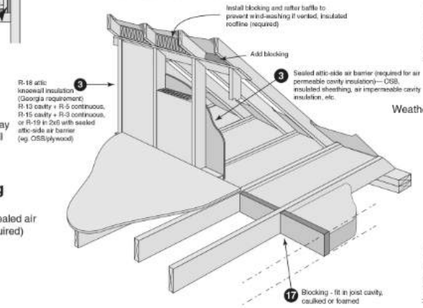

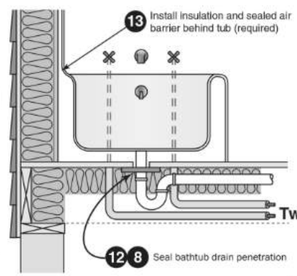

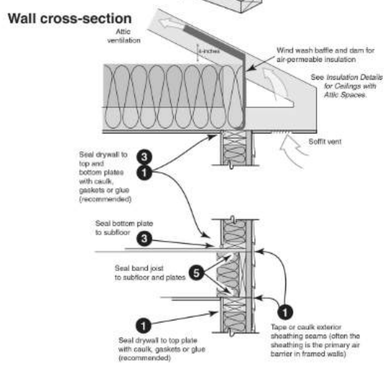

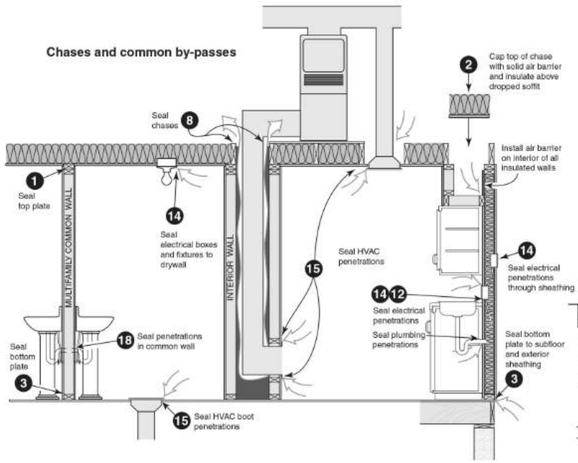

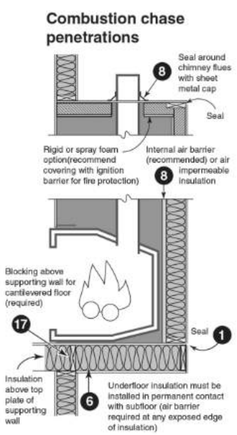

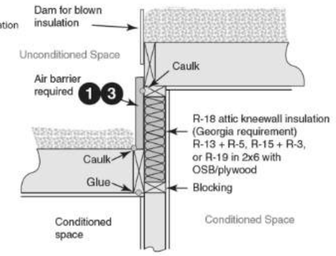

Disclaimer:
This document is intended solely to help graphically demonstrate the air leakage and insulation provisions of the 2015 IECC. It does not cover all air sealing locations, materials or techniques. Other code provisions may be applicable as well.

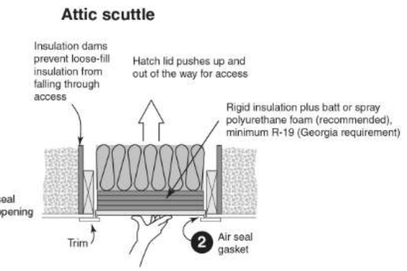

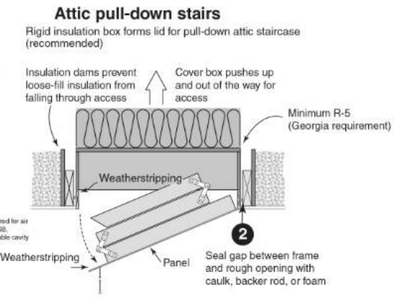

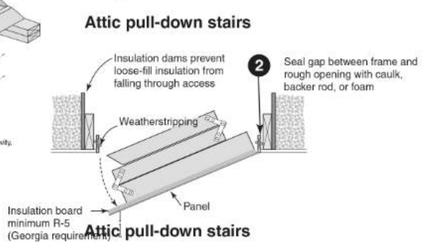

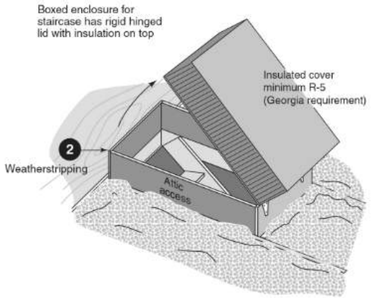

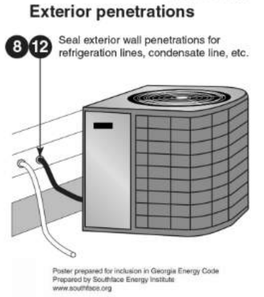

PRINTS ISSUED
10/30/23 PERMIT SUBMITTAL

REVISIONS:

rosemann & ASSOCIATES P.C.
ARCHITECTURE
INTERIOR DESIGN
ENGINEERING
PLANNING
1526 Grand Boulevard
Kansas City, MO 64108-1404
p: 816.472.1448
w: www.rosemann.com
© 2023 Rosemann & Associates, P.C.
DENVER ▲ KANSAS CITY ▲ ST. LOUIS ▲ ATLANTA

STATE OF MISSOURI
DAVID EUGENE HENDRIKSE
NUMBER A-7365
REGISTERED ARCHITECT
10/30/23

WILSHIRE HILLS III
LEE'S SUMMIT, MISSOURI
MHDC - 22-057

SHEET TITLE
GENERAL INFORMATION

PROJECT NUMBER: 23034

SHEET NUMBER:

G-006

10/27/2023 2:53:06 PM
C:\Revit Local Files\R23\23034_Wilshire Hills III_Central_R23_mwh01KJR.rvt

Garage blocking and sealing key points

Blocking, air sealing and insulation required above garage separation wall

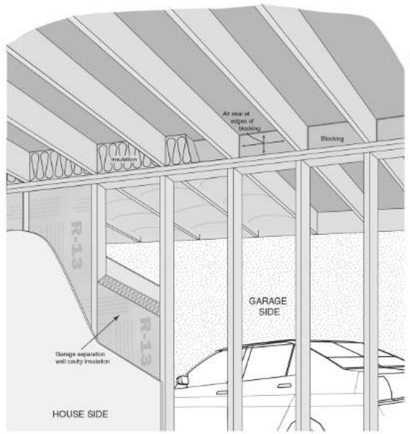

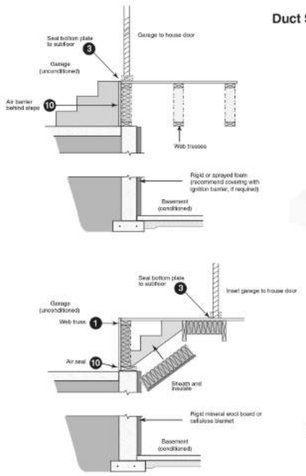

Duct Sealing key points

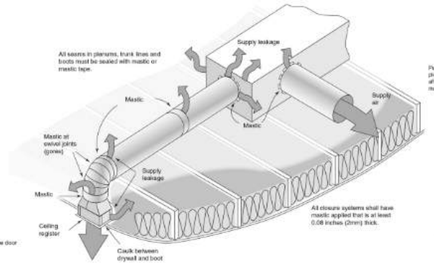

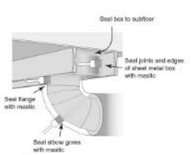

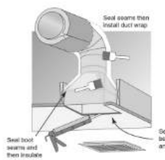

Air Handler Sealing key points

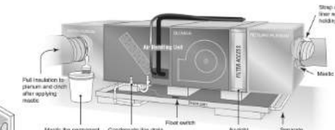

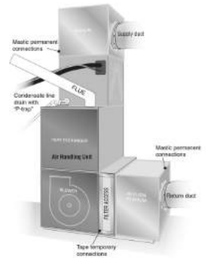

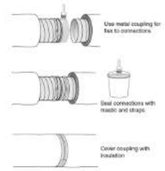

Air sealing key points *continued*

Multifamily

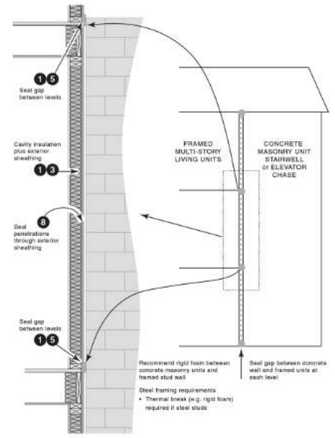

Wall Insulation key points

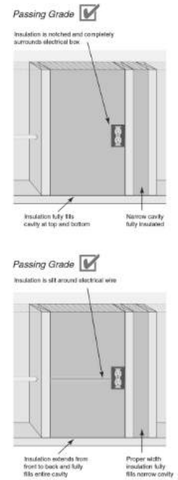

Roofline Installed Insulation Options

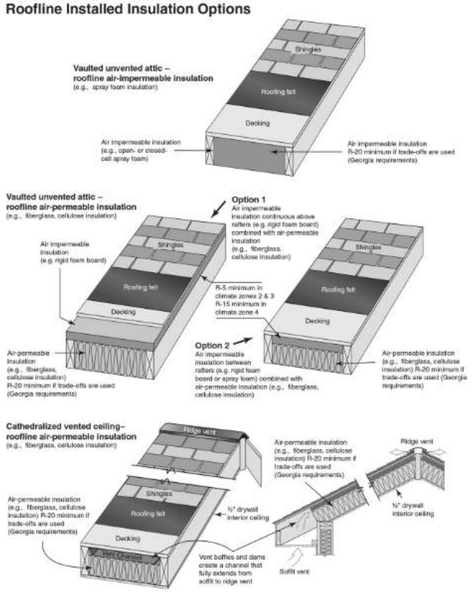

Insulation Details for Ceilings with Attic spaces

Rafter and Truss

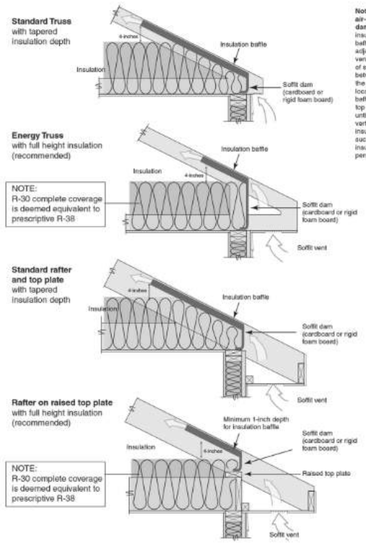

Note: Wind wash baffle and air-permeable insulation dam. For air permeable insulation in vented attics, baffles shall be installed adjacent to soffit and eave vents. A minimum of a 1-inch of space shall be provided between the insulation and the roof sheathing and at the location of the vent. The baffle shall extend over the top of the insulation inward until it is at least 4 inches vertically above the top of the insulation. Any solid material such as cardboard or thin insulating sheathing shall be permissible as the baffle.

Ceiling Insulation key points

Passing Grade ☑

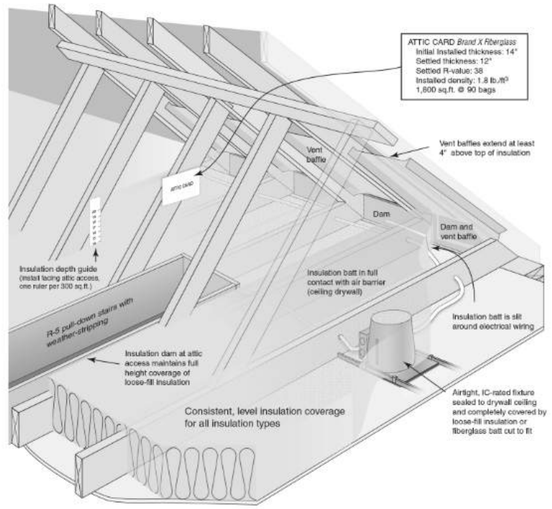

Air sealing key points *continued*

Multifamily Mechanical Closet

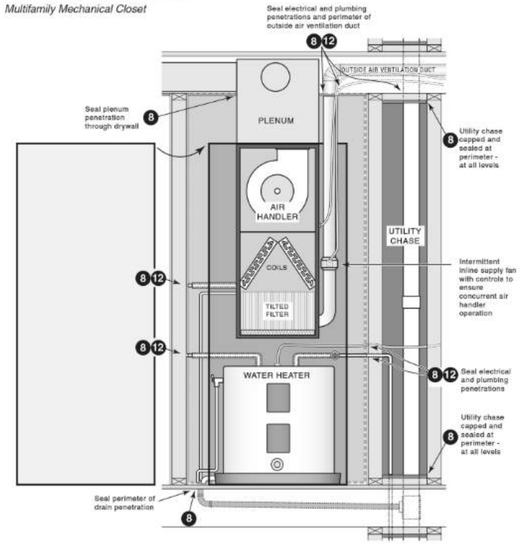

Air sealing key points *continued*

Multifamily

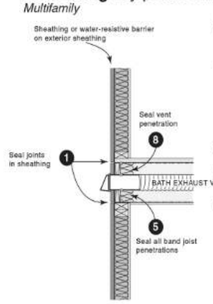

Multifamily Air-sealing Details

1 Cap and seal all chases including chases for grouped utility lines and radon vents

Seal penetrations in mechanical closet including penetrations for the:

- 2 supply plenum
- 3 outside air ventilation
- 5 12 refrigerant line
- 12 plumbing
- 12 11 electrical
- 12 gas fuel

5 Seal band area at exterior sheathing side and all penetrations through band

1 4 UL-compliant air sealing at drywall finishing for any wall adjacent to stairwell or elevator. Air seal this gap at every change in floor level

6 Seal miscellaneous clustered penetrations through building envelope (e.g. refrigerant lines)

Wall and ceiling insulation that makes up portions of the building thermal envelope shall be installed to Passing Grade quality.

Two criteria affect installed insulation grading: **voids/gaps** (in which no insulation is present in a portion of the overall insulated surface) and **compression/incomplete fill** (in which the insulation does not fully fill out or extend to the desired depth).

Voids/Gaps

- Voids or gaps in the insulation are < 1% of overall component surface area (only occasional and very small gaps allowed for Passing Grade)

Compression/Incomplete Fill

- Compression/Incomplete Fill for both *air permeable insulation* (e.g., fiberglass, cellulose) and *air impermeable insulation* (e.g., spray polyurethane foam) must be less than 1 inch in depth or less than 30% of the intended depth, whichever is more stringent. The allowable area of compression/incomplete fill must be less than 2% of the overall insulated surface to achieve a Passing Grade.
- Any compression/incomplete fill with a **depth** greater than the above specifications (up to 1" or 30% of the intended depth, whichever is more stringent) shall not achieve a Passing Grade.

Additional Wall Insulation Requirements

- All vertical air permeable insulation shall be installed in substantial contact with an air barrier on all six (6) sides.
  Exception: Unfinished basements, rim/band joist cavity insulation and fireplaces (insulation shall be restrained to stay in place).
  For unfinished basements, air permeable insulation and associated framing in a framed cavity wall shall be installed less than ¼" from the basement wall surface.
- Attic knee wall details – Attic knee walls shall be insulated to a total R-value of at least R-18 through any combination of cavity and continuous insulation. Air permeable insulation shall be installed with a fully sealed attic-side air barrier (e.g., OSB with seams caulked, rigid insulation with joints taped, etc.). Attic knee walls with air impermeable insulation shall not require an additional attic-side air barrier.

Underfloor insulation that makes up portions of the building thermal envelope shall be installed to Passing Grade quality.

Two criteria affect installed insulation grading: **voids/ gaps** (in which no insulation is present in a portion of the overall insulated surface) and **compression/incomplete fill** (in which the insulation does not fully fill out or extend to the desired depth).

Voids/Gaps

- Voids or gaps in the insulation are minimal for Passing Grade (< 2% of overall component surface area)

Compression/Incomplete Fill

- Compression/Incomplete Fill for both *air permeable insulation* (e.g., fiberglass, cellulose) and *air impermeable insulation* (e.g., spray polyurethane foam) must be less than 1 inch in depth or less than 30% of the intended depth, whichever is more stringent. The allowable area of compression/incomplete fill must be less than 10% of the overall insulated surface to achieve a Passing Grade.
- Any compression/incomplete fill with a **depth** greater than the above specifications (up to 1" or 30% of the intended depth, whichever is more stringent) shall not achieve a Passing Grade.
- Air-permeable underfloor insulation shall be permanently installed against the subfloor decking. Adequate insulation supports (e.g., wire staves) for air permeable insulation shall be installed at least every 18-24".
  Exception: The floor framing-cavity insulation shall be permitted to be in contact with the topside of sheathing or continuous insulation installed on the bottom side of floor framing where combined with insulation that meets or exceeds the minimum wood frame wall R-value and that extends from the bottom to the top of all perimeter floor framing members.

Disclaimer:
This document is intended solely to help graphically demonstrate the air leakage and insulation provisions of the 2015 IECC. It does not cover all air sealing locations, materials or techniques. Other code provisions may be applicable as well.

Floor Insulation key points

Passing Grade ☑

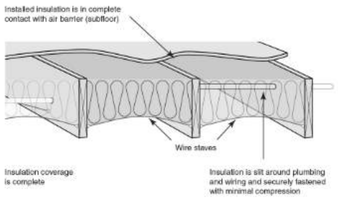

PRINTS ISSUED
10/30/23 PERMIT SUBMITTAL

REVISIONS:

rosemann & ASSOCIATES P.C.
ARCHITECTURE
INTERIOR DESIGN
ENGINEERING
PLANNING
1526 Grand Boulevard
Kansas City, MO 64108-1404
p: 816.472.1448
w: www.rosemann.com
© 2023 Rosemann & Associates, P.C.
DENVER ▲ KANSAS CITY ▲ ST. LOUIS ▲ ATLANTA

STATE OF MISSOURI
DAVID EUGENE HENDRIKS
NUMBER A-7365
REGISTERED ARCHITECT
10/30/23

WILSHIRE HILLS III
LEE'S SUMMIT, MISSOURI
MHDC - 22-057

SHEET TITLE
GENERAL INFORMATION

PROJECT NUMBER: 23034

SHEET NUMBER:

G-007

10/27/2023 2:43:07 PM
C:\Revit Local\Rosemann\23034_Wilshire Hills III_Central_R23_mwm01CAR.rvt

1st Floor Occupancy Tabulation per 2018 IBC Table 1004.1.1					
ROOM NO.	OCCUPANCY CHP.3	ROOM NAME	Area	Occupant Load calc	IBC occupant load factor
1001	A-3	LOBBY/MAIL	330 SF	22	15
1005	A-3	COMMUNITY	783 SF	53	15
			1113 SF	75	
1002	B	OFFICE	196 SF	2	150
			196 SF	2	
101	R	2 BED TYPE B	822 SF	5	200
102	R	1 BED TYPE B	660 SF	4	200
103	R	2 BED TYPE B	822 SF	5	200
104	R	2 BED TYPE B	822 SF	5	200
105	R	2 BED TYPE B	822 SF	5	200
106	R	2 BED TYPE B	822 SF	5	200
107 ⚿	R	1 BED TYPE A	660 SF	4	200
108	R	1 BED TYPE B	660 SF	4	200
109 ⚿	R	2 BED TYPE A	822 SF	5	200
110 ⚿	R	2 BED TYPE A	822 SF	5	200
111	R	2 BED TYPE B	822 SF	5	200
112	R	2 BED TYPE B	822 SF	5	200
113	R	1 BED TYPE B	660 SF	4	200
114	R	2 BED TYPE B	822 SF	5	200
115	R	1 BED TYPE B	660 SF	4	200
116	R	1 BED TYPE B	660 SF	4	200
			12175 SF	74	
1002.1	S	FILE	48 SF	1	300
1003	S	SPRINKLER	240 SF	1	300
1004	S	MECH.	17 SF	1	300
1006	S	UTILITY	43 SF	1	300
1008	S	ELEV. EQUIP.	76 SF	1	300
			423 SF	5	
			13907 SF	156	
Grand total: 24			13907 SF	156	

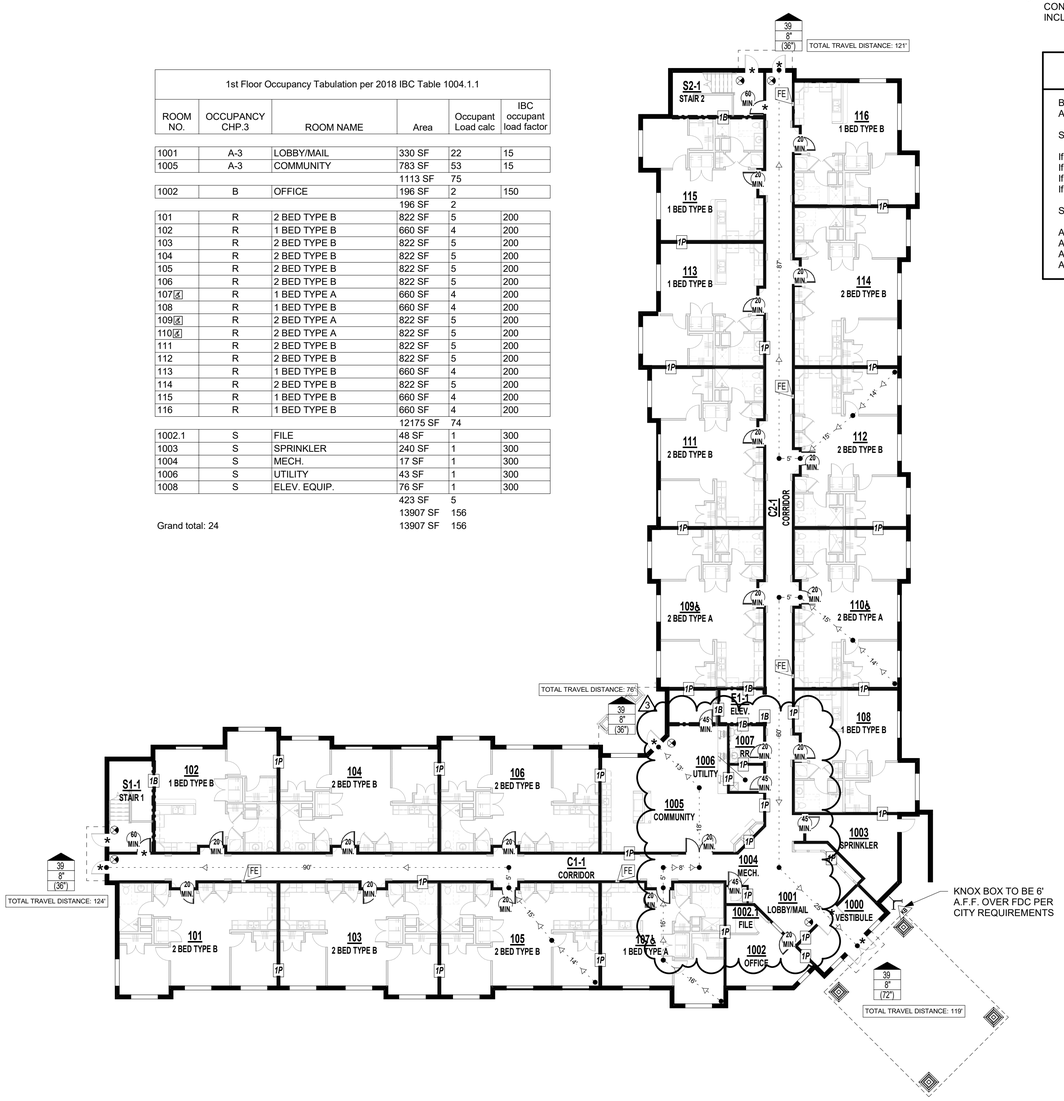

A1 1ST FLOOR CODE PLAN
1/16" = 1'-0"

CODE PLAN GENERAL NOTES:

1. FIRE EXTINGUISHERS SHALL BE LOCATED SO THAT THE MAXIMUM TRAVEL DISTANCE SHALL NOT EXCEED 75 FEET. GENERAL CONTRACTOR TO PROVIDE SEMI-RECESSED FIRE EXTINGUISHER CABINETS WITH FIRE EXTINGUISHERS THROUGHOUT AT ACCESSIBLE HEIGHT.
2. SIGNS IDENTIFYING FIRE PROTECTION EQUIPMENT, CONTROLS FOR AIR CONDITIONING SYSTEMS, SPRINKLER RISERS AND VALVES, OR OTHER FIRE DETECTION, SUPPRESSION OR CONTROL ELEMENTS SHALL BE IDENTIFIED FOR THE USE OF THE FIRE DEPARTMENT PER 2018 IBC. SIGNAGE SHALL ALSO MEET 2018 IFC REQUIREMENTS FOR HEIGHT AND LETTERING. GC TO COORDINATE WITH AUTHORITY HAVING JURISDICTION ON ALL SIGNAGE.
3. KNOX BOX QUANTITY AND LOCATION TO BE COORDINATED BY THE GENERAL CONTRACTOR WITH AUTHORITY HAVING JURISDICTION.
4. ANNUNCIATOR PANEL AND FACP QUANTITY AND LOCATION TO BE COORDINATED BY THE GENERAL CONTRACTOR WITH AUTHORITY HAVING JURISDICTION PRIOR TO INSTALL.
5. ALL DIMENSIONS ARE APPROXIMATE ON CODE PLAN. ACTUAL ARCHITECTURAL DIMENSIONS PER ARCHITECTURAL AND STRUCTURAL PLAN.
6. PROJECT COMPLIES WITH 2018 INTERNATIONAL ENERGY CONSERVATION CODE (IECC) - COMCHECK REPORT INCLUDED IN THE SPECIFICATIONS.

AREA INCREASE

BASED ON TYPE V-A CONSTRUCTION WITH AN ALLOWABLE SF OF 12,000 SF

SECTION 506.2 (EQUATION 5-2)

If = [F/P - 0.25] W/30
If = [830/830 - 0.25] 30/30
If = [0.75] 1
If = 0.75

SECTION 506.2 (EQUATION 5-1)

Aa = {At + [At x If] + [At x Is]}
Aa = {12,000 + [12,000 x 0.75] + [12,000 x 0]}
Aa = {12,000 + [9,000] + 0}
Aa = 21,000 SF

CODE REVIEW

PROJECT NAME:	WILSHIRE HILLS III
PROJECT LOCATION:	LEE'S SUMMIT, MO
CODE:	2018 IBC
CODE REVIEW COMPLETED BY:	SARAH BURDIEK

CHAPTER THREE

SECTION 302 CLASSIFICATION:	R-2

CHAPTER FOUR

SECTION 402 COVERED MALL BUILDINGS:	N/A
SECTION 403 HIGH RISE BUILDINGS:	N/A
SECTION 404 ATRIUMS:	N/A
SECTION 405 UNDERGROUND BUILDINGS:	N/A
SECTION 406 MOTOR-VEHICLE-RELATED OCCUP:	N/A
SECTION 407 GROUP I-2:	N/A
SECTION 408 GROUP I-3:	N/A
SECTION 409 MOTION PICTURE PROJECTION ROOMS:	N/A
SECTION 410 STAGES AND PLATFORMS:	N/A
SECTION 411 SPECIAL AMUSEMENT BUILDINGS:	N/A
SECTION 412 AIRCRAFT RELATED OCCUP:	N/A
SECTION 413 COMBUSTIBLE STORAGE:	N/A
SECTION 414 HAZARDOUS MATERIALS:	N/A
SECTION 415 GROUPS H-1, H-2, H-3, H-4, H-5:	N/A

CHAPTER FIVE

TABLE 504.3 ALLOWABLE HT IN FEET ABOVE GRADE:	R S13R: 60'
SECTION 504.4 ALLOWABLE # OF STORIES ABOVE GRADE:	R-2 TYPE V-A; 4 STORIES
506.2 ALLOWABLE AREA/FLOOR:	R-2 TYPE V-A: 12,000 SF
SECTION 504 HEIGHT MODIFICATIONS:	NONE TAKEN
SECTION 506.2.3 AREA MODIFICATIONS:	ALLOWABLE 12,000 SF / ACTUAL 17,860 SF
506.2 FRONTAGE INCREASE:	SEE AREA INCREASE CALCULATION
SECTION 507 UNLIMITED AREA BUILDINGS:	N/A
TABLE 508.2 ACCESSORY OCCUPANCIES:	MAX 10% AREA / FLOOR MAX 12,000 SF TOTAL
TABLE 508.3.3 REQUIRED SEPARATION OF OCCUPANCIES:	1 HR SEPARATION ACCESSORY OCCUPANCIES ONLY
TABLE 509 INCIDENTAL USE AREAS:	N/A

CHAPTER SIX

TABLE 601 FIRE RESISTANCE REQUIREMENTS FOR BUILDING ELEMENTS (HOURS):	
STRUCTURAL FRAME:	V-A - 1 HR
BEARING WALLS, EXTERIOR:	V-A - 1 HR
BEARING WALLS, INTERIOR:	V-A - 1 HR
NONBEARING WALLS AND PARTITIONS, INTERIOR:	0 HOUR
FLOOR CONSTRUCTION:	V-A - 1 HR
ROOF CONSTRUCTION:	V-A - 1 HR
TABLE 602 FIRE RESISTANCE RATING REQUIREMENTS FOR EXTERIOR WALLS BASED ON FIRE SEPARATION DISTANCE:	R-2 VA 10 </= 1 HR, 0 HR >30 FEET

CHAPTER SEVEN

SECTION 704 FIRE-RESISTANCE RATING OF STRUCTURAL MEMBERS:	1 HR RE: 601
TABLE 705.8 MAX AREA EXTERIOR WALL OPENINGS:	(UNPROTECTED)
SECTION 706 FIRE WALLS:	V-A - 2 HR (NONE REQ'D)
SECTION 707 FIRE BARRIERS:	1 HR
SECTION 708 FIRE PARTITIONS:	1 HR
SECTION 709 SMOKE BARRIERS:	DAMPERS REQUIRED
SECTION 710 SMOKE PARTITIONS:	0 HR
SECTION 711 HORIZONTAL ASSEMBLIES:	1 HR
SECTION 712 VERTICAL OPENINGS:	1 HR R-2
SECTION 713 SHAFT ENCLOSURES:	1 HR (< 3 STORIES)
SECTION 714 PENETRATIONS:	VARIES
SECTION 715 FIRE-RESISTANT JOINT SYSTEMS:	1 HR (TO MATCH SYSTEMS)
SECTION 716 OPENING PROTECTIVES:	CORRIDOR - 20 MIN., EXTERIOR - 3/4 HR CORRIDOR TO STAIR - 1 HR
SECTION 717 DUCTS AND AIR TRANSFER OPENINGS:	1.5 HOUR DAMPER RATING
SECTION 718 CONCEALED SPACES:	NONE

CHAPTER NINE

SECTION 903 AUTOMATIC SPRINKLER SYSTEM:	REQUIRED, NFPA 13R
SECTION 905 STANDPIPE SYSTEM:	REQUIRED
SECTION 907 FIRE ALARM & DETECTION SYSTEM:	REQUIRED, NFPA 72
SECTION 909 SMOKE CONTROL SYSTEM:	NOT REQUIRED

CHAPTER TEN

TABLE 1004.1.1 MAX FLOOR AREA ALLOW/OCCUP:	200 GROSS - RESIDENTIAL
SECTION 1005.3 EGRESS WIDTH/ OCCUP SERVED:	STAIRS 0.3/OCC, OTHER EGRESS 0.2/OCC.
SECTION 1006.2.1 COMMON PATH OF TRAVEL:	125' COMMON PATH 20 OCC. MAX. SINGLE EXIT
SECTION 1006.3.2 NUMBER OF EXITS & EXIT PER STORY	> 500 OCCUPANTS: 2 EXITS
SECTION 1009 ACCESSIBLE EGRESS:	1 / 30x48 SPACE / 200 OCC.
SECTION 1014 HANDRAIL HEIGHTS:	34" MIN. - 38" MAX.
TABLE 1017.2 EXIT ACCESS TRAVEL DISTANCE:	250' SPRINKLED
TABLE 1019.3 STAIRWELL EGRESS:	3 STORIES - RE: 713
TABLE 1020.1 CORRIDOR FIRE RESISTANCE RATING:	RE: 708: 0.5 HR

CHAPTER ELEVEN

TABLE 1106.1 ACCESSIBLE PARKING SPACES:	AS PER CIVIL

CHAPTER TWELVE

1203.5 NATURAL VENTILATION:	4% VENTILATION
1205.2 NATURAL LIGHT:	NOT LESS THAN 8% FLOOR AREA SERVED

CHAPTER TWENTY NINE

TABLE 2902.1 PLUMBING FAC. NO.	1 WC / UNIT; 1 LAVATORY / UNIT

2018 IECC

CLIMATE ZONE: 4A CONST. TYPE: V-A CHAPTER 4-RESIDENTIAL ENERGY EFFICIENCY

PROJECT COMPLYING WITH 2018 IECC VIA PERFORMANCE METHOD; REFERENCE COMCHECK.

MEETS 2018 IECC SECTION R402.1.2 PER PRELIMINARY COMCHECK.

BELOW ARE GENERAL GUIDELINES:

TABLE 402.1.2- BUILDING ENVELOPE REQUIREMENTS
FENESTRATION U-FACTOR = 0.32
SKYLIGHT U-FACTOR = 0.55
GLAZED FENESTRATIONS SHGC = 0.40
CEILING R-VALUE = 49
WOOD FRAME WALL R-VALUE = 20
MASS WALL R-VALUE = 8/13
FLOOR R-VALUE = 19
BASEMENT WALL R-VALUE = 10/13
SLAB R-VALUE = 10, 2 ft.

ALL OF IECC 2018 APPLIES, HOWEVER PARTICULAR NOTE SHALL BE TAKEN OF THE FOLLOWING. ADDITIONALLY, GC TO PROVIDE INSULATION, FENESTRATION, AND OTHER REQUIREMENTS PER BELOW:

1. AIR LEAKAGE PER SECTION R402.4
2. AIR BARRIER PENETRATIONS PER R402.4.1.1
3. AIR LEAKAGE OF FENESTRATION PER SECTION R402.4.3
4. BUILDING MECHANICAL SYSTEM REQUIREMENTS PER SECTION R403
5. DUCT/PLENUM INSULATION AND SEALING PER R403.3
6. PIPING INSULATION PER R403.4
7. SERVICE WATER HEATING PER SECTION R403.5
8. LIGHTING ELECTRICAL SYSTEMS PER SECTION R404

CODE PLAN LEGEND

- 100 / 20' / (72') — NUMBER OF OCCUPANTS EXITING; REQUIRED EXIT WIDTH; EXIT WIDTH PROVIDED BY DESIGN
- EXT. - RATED PARTITION (IBC CH. 6) SEE ASSEMBLY SHEET FOR MORE INFO ON EXTERIOR RATED WALLS
- NON - RATED PARTITION
- 1P — 1P — 1 HR RATED PARTITION (IBC 708)
- 1B — 1B — 1 HR RATED BARRIER (IBC 707)
- 1000 / Room Name — ROOM NUMBER
- FE — FIRE EXTINGUISHER CABINET OR SURFACE MTD. AT CONC.
- KB — FIRE DEPARTMENT KNOX BOX (DEFER SUBMITTAL FOR LOC.)
- FIRE DEPARTMENT CONNECTION
- (60/S) — DOOR RATING
- * — DOOR WITH PANIC HARDWARE (SEE DOOR SCHEDULE)
- EXIT SIGNAGE; SEE ELECTRICAL
- EGRESS STARTING POINT
- EGRESS DISTANCE OF TRAVEL
- EGRESS DIRECTION OF TRAVEL

PRINTS ISSUED
10/30/23 PERMIT SUBMITTAL

REVISIONS:
1 12/15/23 Addendum 1 - Response to City Comments
3 04/19/24 Addendum 3 - Response to City Comments #2

rosemann & ASSOCIATES P.C.
ARCHITECTURE
INTERIOR DESIGN
ENGINEERING
PLANNING
1526 Grand Boulevard
Kansas City, MO 64108-1404
p: 816.472.1448
w: www.rosemann.com
© 2023 Rosemann & Associates, P.C.
DENVER ▲ KANSAS CITY ▲ ST. LOUIS ▲ ATLANTA

STATE OF MISSOURI
DAVID EUGENE HENDRIKSEN
NUMBER A-7365
REGISTERED ARCHITECT
04/19/24

WILSHIRE HILLS III
LEE'S SUMMIT, MISSOURI
MHDC Project No. #22-057 MT

SHEET TITLE
CODE ANALYSIS

PROJECT NUMBER: 23034

SHEET NUMBER:

G-100

4/19/2024 2:22:04 PM
C:\Revit Local Files\23034_Wilshire Hills III_Central_R23_dsurdiek7KWD.rvt

REFERENCE G-003 FOR GENERAL NOTES
REFERENCE G-100 FOR CODE LEGEND

PRINTS ISSUED
10/30/23 PERMIT SUBMITTAL

REVISIONS:

3	04/19/24	Addendum 3 - Response to City Comments #2

rosemann & ASSOCIATES P.C.
ARCHITECTURE
INTERIOR DESIGN
ENGINEERING
PLANNING
1526 Grand Boulevard
Kansas City, MO 64108-1404
p: 816.472.1448
w: www.rosemann.com

© 2023 Rosemann & Associates, P.C.

DENVER ▲ KANSAS CITY ▲ ST. LOUIS ▲ ATLANTA

STATE OF MISSOURI
DAVID EUGENE HENDRIKSEN
NUMBER A-7365
REGISTERED ARCHITECT
04/19/24

3rd Floor Occupancy Tabulation per 2018 IBC Table 1004.1.1

ROOM NO.	OCCUPANCY CHP.3	ROOM NAME	Area	Occupant Load calc	IBC occupant load factor
3001	A-3	MEETING	640 SF	43	15
3002	A-3	FITNESS	360 SF	8	50
			1000 SF	51	
301	R	2 BED TYPE B	822 SF	5	200
302	R	1 BED TYPE B	660 SF	4	200
303	R	2 BED TYPE B	822 SF	5	200
304	R	2 BED TYPE B	822 SF	5	200
305	R	2 BED TYPE B	822 SF	5	200
306	R	2 BED TYPE B	822 SF	5	200
307⊿	R	1 BED TYPE A	660 SF	4	200
308	R	2 BED TYPE B	921 SF	5	200
309	R	1 BED TYPE B	660 SF	4	200
310⊿	R	2 BED TYPE A	822 SF	5	200
311	R	2 BED TYPE B	822 SF	5	200
312	R	2 BED TYPE B	822 SF	5	200
313	R	2 BED TYPE B	822 SF	5	200
314	R	1 BED TYPE B	660 SF	4	200
315	R	2 BED TYPE B	822 SF	5	200
316	R	1 BED TYPE B	660 SF	4	200
317	R	1 BED TYPE B	660 SF	4	200
			13096 SF	79	
			14097 SF	130	
Grand total: 19			14097 SF	130	

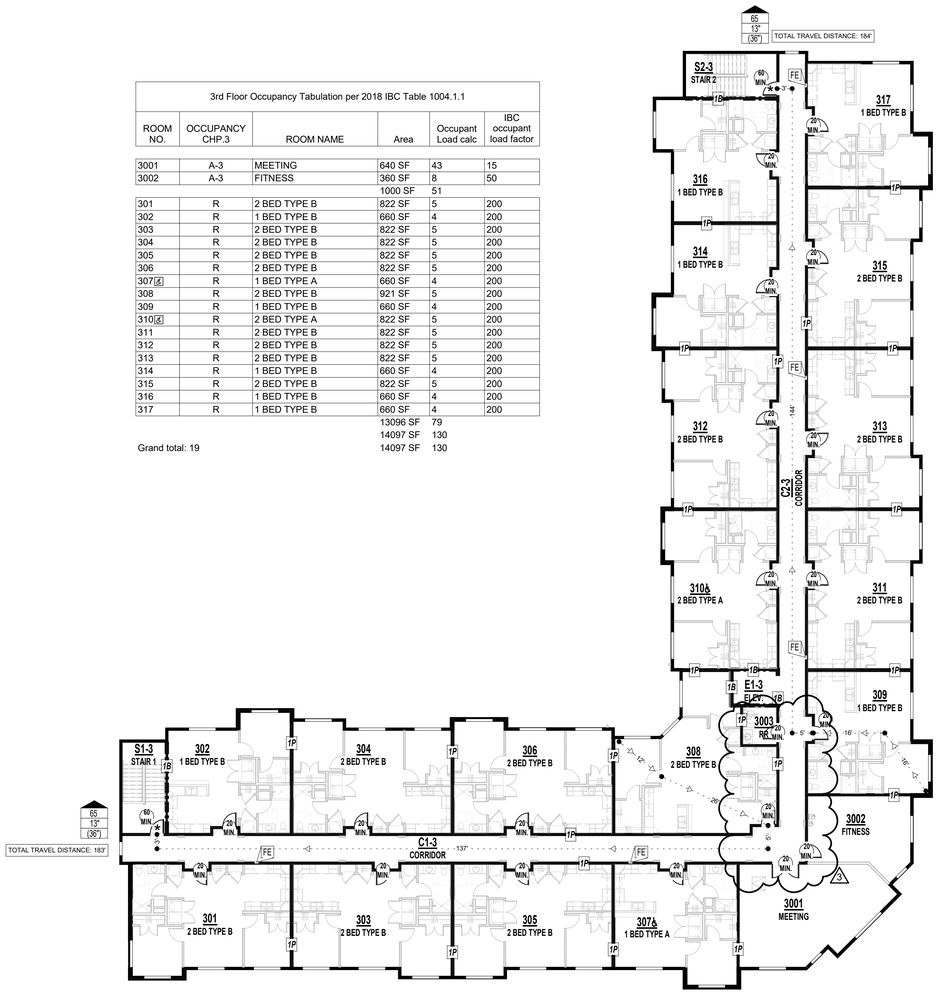

A2 THIRD FLOOR PLAN
1/16" = 1'-0"

2nd Floor Occupancy Tabulation per 2018 IBC Table 1004.1.1

ROOM NO.	OCCUPANCY CHP.3	ROOM NAME	Area	Occupant Load calc	IBC occupant load factor
2001	A-3	MULTI-PURPOSE	1021 SF	69	15
			1021 SF	69	
201	R	2 BED TYPE B	822 SF	5	200
202	R	1 BED TYPE B	660 SF	4	200
203	R	2 BED TYPE B	822 SF	5	200
204	R	2 BED TYPE B	822 SF	5	200
205	R	2 BED TYPE B	822 SF	5	200
206	R	2 BED TYPE B	822 SF	5	200
207⊿	R	1 BED TYPE A	660 SF	4	200
208	R	2 BED TYPE B	921 SF	5	200
209	R	1 BED TYPE B	660 SF	4	200
210⊿	R	2 BED TYPE A	822 SF	5	200
211⊿	R	2 BED TYPE A	822 SF	5	200
212	R	2 BED TYPE B	822 SF	5	200
213	R	2 BED TYPE B	822 SF	5	200
214	R	1 BED TYPE B	660 SF	4	200
215	R	2 BED TYPE B	822 SF	5	200
216	R	1 BED TYPE B	660 SF	4	200
217	R	1 BED TYPE B	660 SF	4	200
			13096 SF	79	
			14117 SF	148	
Grand total: 18			14117 SF	148	

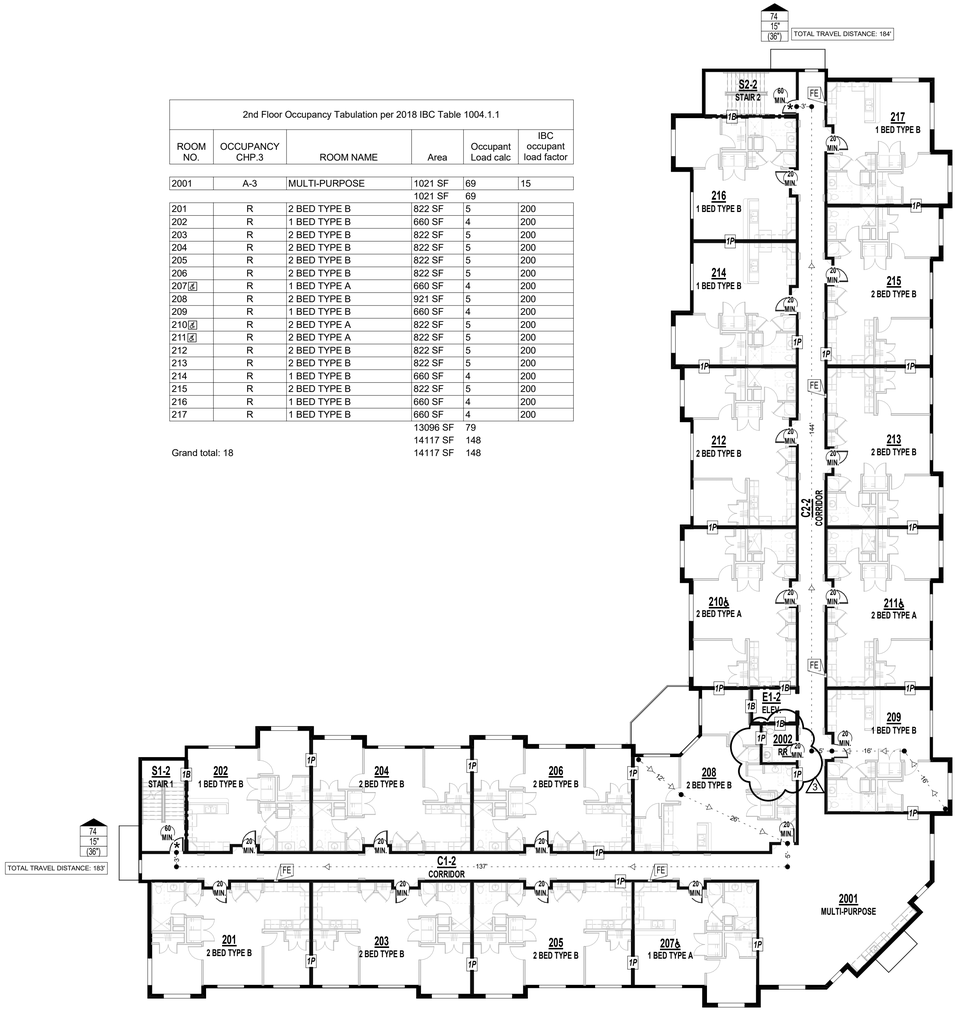

A1 2ND FLOOR CODE PLAN
1/16" = 1'-0"

WILSHIRE HILLS III
LEE'S SUMMIT, MISSOURI
MHDC Project No. #22-057 MT

SHEET TITLE
CODE PLANS

PROJECT NUMBER: 23034

SHEET NUMBER:

G-101

4/19/2024 2:23:08 PM
C:\Revit Local Cache\23034_Wilshire Hills III_Central_R23_dsunblad.rvt

FLOOR/CEILING ASSEMBLIES - WOOD

F1

CONCRETE - NON-RATED - SLAB ON GRADE
- CONCRETE SLAB ON GRADE PER STRUCT. DWGS.

NOTES
a. SEE STRUCTURAL FOR REINFORCING AND THICKNESS
b. VERIFY SLAB ELEVATIONS WITH CIVIL AND LANDSCAPE

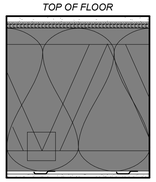

F3

WOOD OPEN WEB TRUSS - 1HR
- 1" GYPCRETE TOPPING
- 1/4" ACOUSTICAL MAT
- 19/32" MIN. PLYWOOD SHEATHING, TYPE 'C/D' , SEE ALSO NOTE b.
- WOOD TRUSSES PER STRUCTURAL, REFER TO UL FOR MIN. REQS
- UNFACED FIBERGLASS INSULATION COMPLETELY FILLED IN CONCEALED CAVITY TO COMPLY WITH NFPA 13 CONCEALED SPACES.
- 25 MSG GALVANIZED RESILIENT CHANNELS, SPACED PER U.L.
- (1) LAYER OF 5/8" TYPE 'C' GWB PER UL

NOTES:
a. ASSEMBLY TO COMPLY WITH UL DESIGN L546 (DEC 16, 2019)
b. STRUCTURAL SHALL SUPERCEDE IF STRUCT SHEATHING IS THICKER OR DIFFERENT TYPE THAN LISTED ABOVE. PROVIDE REQ MIN ABOVE.
c. REFER TO UL FOR SCREW PATTERN
d. STC TO BE MIN. 50 PER IBC CHAPTER 12, IIC TO BE EQUAL OR GREATER THAN 50 WHEN TESTED UNDER ASTM E 492. (STC 60 BASED UPON TESTING 30160-08-90744-11. IIC 52 BASED UPON TESTING 30160-08-90744-7 ASSUMING VCT FLOOR FINISH.)
e. VERIFY GWB AND RESILIENT CHANNEL WITH UL SPECIFIED, TAKE NOTE OF REQUIRED RESILIENT CHANNEL SPACING WITH INSULATION-FILLED CAVITY
f. MIN. DEPTH OF TRUSS SHALL BE 18" WHEN DUCT PRESENT.

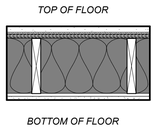

F6

WOOD 2X10 LUMBER - 1HR
- 1" GYPCRETE TOPPING
- 1/4" ACOUSTICAL MAT
- MIN 15/32" TYPE 'C/D' SHEATHING OR PER UL SYSTEM, SEE NOTE b.
- 2X10 WOOD JOISTS SPACED MAX 16" O.C.; REFER TO STRUCTURAL FOR REQUIRED SPACING IF MORE RESTRICTIVE
- CROSS BRIDGING PER UL
- UNFACED FIBERGLASS INSULATION COMPLETELY FILLED IN CONCEALED CAVITY TO COMPLY WITH NFPA 13 CONCEALED SPACES AND UL
- 25 MSG GALVANIZED RESILIENT CHANNEL SPACED PER UL.
- (1) LAYER OF 5/8" TYPE 'C' GWB PER UL

NOTES:
a. ASSEMBLY TO COMPLY WITH UL DESIGN L516, (APRIL 29, 2020)
b. STRUCTURAL SHALL SUPERCEDE IF STRUCT SHEATHING IS THICKER OR DIFFERENT TYPE THAN LISTED ABOVE. PROVIDE REQ MIN ABOVE.
c. STC SHALL BE MIN. 50 PER IBC CHAPTER 12, IIC TO BE EQUAL OR GREATER THAN 50 WHEN TESTED UNDER ASTM E 492. (STC 59 BASED UPON TESTING TL88-110. IIC 52 BASED UPON TESTING 100336557CRT-001m ASSUMING VINYL FLOOR FINISH.)
d. REFER TO UL FOR SCREW PATTERN
e. VERIFY SHEATHING TYPE, GWB, AND RESILIENT CHANNEL WITH UL SYSTEM SPECIFIED, TAKE NOTE OF REQUIRED RESILIENT CHANNEL SPACING WITH INSULATION-FILLED CAVITY

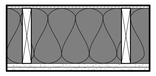

F19

WOOD 2X10 LUMBER - 1HR - T.O. ELEVATOR SHAFT
- 1/2" SHEATHING PER IBC
- WOOD 2X10 JOISTS SPACED PER STRUCTURAL
- UNFACED FIBERGLASS INSULATION COMPLETELY FILLED IN CONCEALED CAVITY TO COMPLY WITH NFPA 13 CONCEALED SPACES.
- (2) LAYERS 5/8" TYPE X GWB. PER IBC

NOTES:
a. ASSEMBLY TO COMPLY WITH 2018 IBC TABLE 721.1(3) ITEM 21-1.1
b. REFER TO IBC FOR SCREW PATTERN
c. FIRE CAULK BOTTOM OF CEILING TO WALL, CONTINUOUSLY

ROOF/CEILING ASSEMBLIES - WOOD

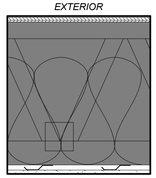

R3

WOOD SLOPED TRUSS - 1HR - SHINGLES
- ASPHALT SHINGLES PER SPECIFICATIONS
- ROOF UNDERLAYMENT PER SPECIFICATIONS
- 15/32" MIN. ROOF SHEATHING, SEE NOTE b.
- WOOD TRUSS FRAMING PER STRUCT. DWGS, MAX SPACING 24" OC - REFERENCE UL FOR CONSTRUCTION
- R-38 INSULATION PER 2018 IECC, INSTALLED PER UL
- VAPOR BARRIER CLASS 1 ON UNDERSIDE OF TRUSS, AS REQUIRED
- 25 MSG GALVANIZED STEEL RESILIENT CHANNELS, SPACED PER UL
- (1) LAYER OF 5/8" TYPE 'C' GWB

NOTES:
a. ASSEMBLY TO COMPLY WITH UL DESIGN P545 (APR 4, 2019)
b. STRUCTURAL SHALL SUPERCEDE IF STRUCT SHEATHING IS THICKER OR DIFFERENT TYPE THAN LISTED ABOVE. PROVIDE REQ MIN ABOVE.
c. REFER TO UL FOR SCREW PATTERN

INTERIOR BARRIER ASSEMBLIES - WOOD - 1 HR RATED

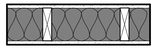

P20

WOOD 2X6 STUD - 1HR BARRIER - INTERIOR
- (1) LAYER 5/8" TYPE "X" GYPSUM BOARD
- 2x6 WOOD STUDS SPACED 16" O.C. MAX. OR PER STRUCT. DWGS.
- 5-1/2" FRICTION FIT UNFACED BATT INSULATION IN STUD CAVITY
- (1) LAYER 5/8" TYPE "X" GYPSUM BOARD

NOTES:
a. ASSEMBLY TO COMPLY WITH UL DESIGN U305 (JAN 14, 2020)
b. REFER TO UL FOR SCREW PATTERN AND OTHER REQUIREMENTS
c. SHALL COMPLY WITH IBC SECTION 7 FOR FIRE BARRIERS

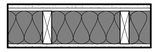

P21

WOOD 2X6 STUD - 1HR BARRIER - INTERIOR SOUND DAMPENING
- (1) LAYER 5/8" TYPE "X" GYPSUM BOARD
- 25 MSG GALVANIZED RESILIENT CHANNEL, SPACED 24" O.C.
- 2x6 WOOD STUDS SPACED 16" O.C. MAX OR PER STRUCT. DWGS.
- 5-1/2" FRICTION FIT UNFACED BATT INSULATION IN STUD CAVITY
- (1) LAYER 5/8" TYPE "X" GYPSUM BOARD

NOTES:
a. ASSEMBLY TO COMPLY WITH UL DESIGN U305 (JAN 14, 2020)
b. REFER TO UL FOR SCREW PATTERN AND OTHER REQUIREMENTS
c. SHALL COMPLY WITH IBC SECTION 7 FOR FIRE BARRIERS
d. STC SHALL BE 50 OR OVER AT UNIT ASSEMBLIES, MEETING ASTM E90 (STC 51 BASED UPON TESTING NGC 2011071)
e. WHERE BARRIER DIVIDES A CORRIDOR AND A UNIT, CORRIDOR SIDE SHALL RECEIVE THE RESILIENT CHANNEL

EXTERIOR PARTITION ASSEMBLIES - WOOD - RATING VARIES

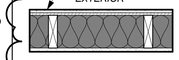

P30

WOOD 2X6 STUD - 1HR PARTITION - EXTERIOR (INTERIOR RATED)
EXTERIOR
- EXTERIOR FINISH SYSTEM PER ELEVATIONS
- WEATHER RESISTANT BARRIER, PER SPECIFICATIONS
- (1) LAYER SHEATHING PER STRUCT. DWGS.
- 2x6 WOOD STUDS SPACED 16" O.C. MAX OR PER STRUCT. DWGS.
- 5-1/2" KRAFT OR FOIL FACED BATT INSULATION IN STUD CAVITY, R-VALUE PER DRAWINGS/SPECIFICATIONS TO MEET IECC.
- (1) LAYER 5/8" TYPE "X" GYPSUM BOARD
INTERIOR

NOTES:
a. ASSEMBLY TO COMPLY WITH UL DESIGN U356 (AUG. 04, 2023)
b. REFER TO UL FOR SCREW PATTERN AND OTHER REQUIREMENTS
c. EXTERIOR SYSTEM TO BE PER DETAILS AND ELEVATIONS

SITE WALL ASSEMBLIES

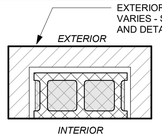

P90

CMU 8" BLOCK - SITE WALL
- EXTERIOR FINISH PER SPEC, WRAP CORNERS, BRICK WITH 1" AIR GAP SHOWN
- 8" CMU (REINFORCING PER STRUCT)

NOTES:
a. APPLY WATERPROOFING AT ALL SUBGRADE PORTION OF WALLS
b. INTERIOR EXPOSED AREAS TO BE PAINTED PER FINISH SCHEDULE

INTERIOR PARTITION ASSEMBLIES - WOOD - NON RATED

P1

WOOD 2X4 STUD - NON-RATED PARTITION - INTERIOR
- (1) LAYER 5/8" TYPE 'X' GYPSUM BOARD
- 2x4 WOOD STUDS SPACED 16" O.C.
- (1) LAYER 5/8" TYPE 'X' GYPSUM BOARD

NOTES:
a. ATTACH GYPSUM WITH 1-1/4" TYPE 'W' STEEL SCREWS @ 12" O.C.

P2

WOOD 2X6 STUD - NON-RATED PARTITION - INTERIOR
- (1) LAYER 5/8" TYPE 'X' GYPSUM BOARD
- 2x6 WOOD STUDS SPACED 16" O.C.
- (1) LAYER 5/8" TYPE 'X' GYPSUM BOARD

NOTES:
a. ATTACH GYPSUM WITH 1-1/4" TYPE 'W' STEEL SCREWS @ 12" O.C.

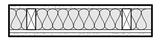

P3

WOOD 2X4 STUD - NON-RATED PARTITION - INTERIOR SOUND
- (1) LAYER 5/8" TYPE 'X' GYPSUM BOARD
- 2x4 WOOD STUDS SPACED 16" O.C.
- 3 1/2" BATT INSULATION IN STUD CAVITY
- 1/2" RESILIENT CHANNEL, SPACED 24" O.C.
- (1) LAYER 5/8" TYPE 'X' GYPSUM BOARD

NOTES:
a. ATTACH GYPSUM WITH 1-1/4" TYPE 'W' STEEL SCREWS AT 12" O.C.

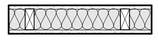

P4

WOOD 2X4 STUD - NON-RATED PARTITION - INTERIOR SOUND DAMPENING
- (1) LAYER 5/8" TYPE 'X' GYPSUM BOARD
- 2x4 WOOD STUDS SPACED 16" O.C.
- 3 1/2" BATT INSULATION IN STUD CAVITY
- (1) LAYER 5/8" TYPE 'X' GYPSUM BOARD

NOTES:
a. ATTACH GYPSUM WITH 1-1/4" TYPE 'W' STEEL SCREWS @ 12" O.C.

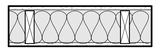

P5

WOOD 2X6 STUD - NON-RATED PARTITION - INTERIOR SOUND DAMPENING
- (1) LAYER 5/8" TYPE 'X' GYPSUM BOARD
- 2x6 WOOD STUDS SPACED 16" O.C.
- 5 1/2" BATT INSULATION IN STUD CAVITY
- (1) LAYER 5/8" TYPE 'X' GYPSUM BOARD

NOTES:
a. ATTACH GYPSUM WITH 1-1/4" TYPE 'W' STEEL SCREWS @ 12" O.C.

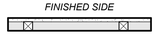

P6

WOOD 2X2 STUD - NON-RATED FURRING - INTERIOR
- (1) LAYER 5/8" TYPE 'X' GYPSUM BOARD ON OCCUPIED SIDE
- 2x2 WOOD STUDS SPACED 16" O.C.

NOTES:
a. ATTACH GYPSUM WITH 1-1/4" TYPE 'W' STEEL SCREWS @ 12" O.C.

P7

WOOD 2X4 STUD - NON-RATED FURRING - INTERIOR
- (1) LAYER 5/8" TYPE 'X' GYPSUM BOARD ON OCCUPIED SIDE
- 2x4 WOOD STUDS SPACED 16" O.C.

NOTES:
a. ATTACH GYPSUM WITH 1-1/4" TYPE 'W' STEEL SCREWS @ 12" O.C.

INTERIOR PARTITION ASSEMBLIES - WOOD - 1 HR RATED

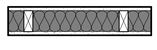

P10

WOOD 2X4 STUD - 1HR PARTITION - INTERIOR
- (1) LAYER 5/8" TYPE "X" GYPSUM BOARD
- 2x4 WOOD STUDS SPACED 16" O.C. MAX. OR PER STRUCT. DWGS.
- 3-1/2" FRICTION FIT UNFACED BATT INSULATION IN STUD CAVITY
- (1) LAYER 5/8" TYPE "X" GYPSUM BOARD

NOTES:
a. ASSEMBLY TO COMPLY WITH UL DESIGN U305 (JAN 14, 2020)
b. REFER TO UL FOR SCREW PATTERN AND OTHER REQUIREMENTS

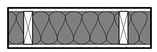

P11

WOOD 2X6 STUD - 1HR PARTITION - INTERIOR
- (1) LAYER 5/8" TYPE "X" GYPSUM BOARD
- 2x6 WOOD STUDS SPACED 16" O.C. MAX. OR PER STRUCT. DWGS.
- 5-1/2" FRICTION FIT UNFACED BATT INSULATION IN STUD CAVITY
- (1) LAYER 5/8" TYPE "X" GYPSUM BOARD

NOTES:
a. ASSEMBLY TO COMPLY WITH UL DESIGN U305 (JAN 14, 2020)
b. REFER TO UL FOR SCREW PATTERN AND OTHER REQUIREMENTS

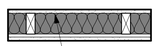

P12

VERIFY IF WALL SHEATHING FOR SHEAR W/ STRUCT DWGS. IS REQUIRED. SHEATHING SHALL ATTACH DIRECTLY TO STUDS PER STRUCT.

WOOD 2X4 STUD - 1HR PARTITION - INTERIOR SOUND DAMPENING
- (1) LAYER 5/8" TYPE "X" GYPSUM BOARD
- 2x4 WOOD STUDS SPACED 16" O.C. MAX. OR PER STRUCT. DWGS.
- 3-1/2" FRICTION FIT UNFACED BATT INSULATION IN STUD CAVITY
- 25 MSG GALVANIZED STEEL RESILIENT CHANNEL, 24" O.C.
- (1) LAYER 5/8" TYPE "X" GYPSUM BOARD

NOTES:
a. ASSEMBLY TO COMPLY WITH UL DESIGN U305 (JAN 14, 2020)
b. REFER TO UL FOR SCREW PATTERN AND OTHER REQUIREMENTS
c. STC SHALL BE 50 OR OVER AT UNIT ASSEMBLIES, MEETING ASTM E90 (STC 51 BASED UPON TESTING NGC 2011071)
d. WHERE PARTITION DIVIDES A CORRIDOR AND UNIT, RESILIENT CHANNEL SHALL BE ON CORRIDOR SIDE OF WALL, GC TO COORDINATE
e. WHERE PARTITION IS USED AS A DEMISING WALL AND/OR FOR STRUCTURAL SHEAR, GC TO COORDINATE ADDITIONAL LAYERS OF STRUCTURAL MATERIAL PER STRUCTURAL DRAWINGS. THESE LAYERS TO BE ADDITIVE TO THE ASSEMBLY LISTED ABOVE AND SHALL BE INCORPORATED PER UL 263. WHERE ONLY ONE LAYER IS ADDED FOR STRUCTURAL SHEAR, THIS SHALL BE PLACED ON SIDE OF WALL WHERE ONLY GYPSUM BOARD RESIDES, NOT ON RESILIENT CHANNEL SIDE.

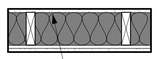

P13

VERIFY IF WALL SHEATHING FOR SHEAR W/ STRUCT DWGS. IS REQUIRED. SHEATHING SHALL ATTACH DIRECTLY TO STUDS PER STRUCT.

WOOD 2X6 STUD - 1HR PARTITION - INTERIOR SOUND DAMPENING
- (1) LAYER 5/8" TYPE "X" GYPSUM BOARD
- 2x6 WOOD STUDS SPACED 16" O.C. MAX. OR PER STRUCT. DWGS.
- 5-1/2" FRICTION FIT UNFACED BATT INSULATION IN STUD CAVITY
- 25 MSG GALVANIZED STEEL RESILIENT CHANNEL, 24" O.C.
- (1) LAYER 5/8" TYPE "X" GYPSUM BOARD

NOTES:
a. ASSEMBLY TO COMPLY WITH UL DESIGN U305 (JAN 14, 2020)
b. REFER TO UL FOR SCREW PATTERN AND OTHER REQUIREMENTS
c. STC SHALL BE 50 OR OVER AT UNIT ASSEMBLIES, MEETING ASTM E90 (STC 51 BASED UPON TESTING NGC 2011071)
d. WHERE PARTITION DIVIDES A CORRIDOR AND UNIT, RESILIENT CHANNEL SHALL BE ON CORRIDOR SIDE OF WALL, GC TO COORDINATE
e. WHERE PARTITION IS USED AS A DEMISING WALL AND/OR FOR STRUCTURAL SHEAR, GC TO COORDINATE ADDITIONAL LAYERS OF STRUCTURAL MATERIAL PER STRUCTURAL DRAWINGS. THESE LAYERS TO BE ADDITIVE TO THE ASSEMBLY LISTED ABOVE AND SHALL BE INCORPORATED PER UL 263. WHERE ONLY ONE LAYER IS ADDED FOR STRUCTURAL SHEAR, THIS SHALL BE PLACED ON SIDE OF WALL WHERE ONLY GYPSUM BOARD RESIDES, NOT ON RESILIENT CHANNEL SIDE.

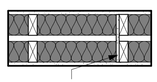

P14

1/2" GYP DRAFT STOP @ MAX 10' O.C. (RE: IBC 718.3 FOR LOCATION REQ'S)

WOOD DOUBLE 2X4 STUD - 1HR PARTITION - INTERIOR
- (1) LAYER 5/8" TYPE "X" GYPSUM BOARD
- 2x4 WOOD STUDS SPACED 16" O.C. MAX, OR PER STRUCT. DWGS.
- 3 1/2" FRICTION FIT BATT INSULATION IN STUD CAVITY
- 1" AIR GAP
- 2x4 WOOD STUDS SPACED 16" O.C. MAX, OR PER STRUCT. DWGS.
- 3 1/2" FRICTION FIT BATT INSULATION IN STUD CAVITY
- (1) LAYER 5/8" TYPE "X" GYPSUM BOARD

NOTES:
a. ASSEMBLY TO COMPLY WITH UL U341 (SEPT 23, 2020)
b. REFER TO UL FOR SCREW PATTERN AND OTHER REQUIREMENTS
c. PROVIDE 1/2" GYP BOARD DRAFT STOP AT MAX 10'-0" O.C.
d. STC SHALL BE 50 OR OVER AT UNIT ASSEMBLIES, MEETING ASTM E90 (STC 61 BASED UPON TESTING TL11-120)

PRINTS ISSUED
10/30/23 PERMIT SUBMITTAL

REVISIONS:
1 12/15/23 Addendum 1 - Response to City Comments

rosemann & ASSOCIATES P.C.
ARCHITECTURE
INTERIOR DESIGN
ENGINEERING
PLANNING
1526 Grand Boulevard
Kansas City, MO 64108-1404
p: 816.472.1448
w: www.rosemann.com
© 2023 Rosemann & Associates, P.C.
DENVER ▲ KANSAS CITY ▲ ST. LOUIS ▲ ATLANTA

STATE OF MISSOURI
DAVID EUGENE HENDRIKSE
NUMBER A-7395
REGISTERED ARCHITECT
12/27/23

WILSHIRE HILLS III
LEE'S SUMMIT, MISSOURI
MHDC - 22-057

SHEET TITLE
ASSEMBLIES - PARTITION, CEILING, ROOF

PROJECT NUMBER: 23034

SHEET NUMBER:
G-102

12/27/2023 4:55:27 AM
C:\Revit Local Central\2023\23034_Wilshire Hills III_Central_R23_mvellTUCAR.rvt

UL DESIGN - U305

UL Product **iQ**®

UL Solutions

Design/System/Construction/Assembly Usage Disclaimer

- Authorities Having Jurisdiction should be consulted in all cases as to the particular requirements covering the installation and use of UL Certified products, equipment, system, devices, and materials.
- Authorities Having Jurisdiction should be consulted before construction.
- Fire resistance assemblies and products are developed by the design submitter and have been investigated by UL for compliance with applicable requirements. The published information cannot always address every construction nuance encountered in the field.
- When field issues arise, it is recommended the first contact for assistance be the technical service staff provided by the product manufacturer noted for the design. Users of fire resistance assemblies are advised to consult the general Guide Information for each product category and each group of assemblies. The Guide Information includes specifics concerning alternate materials and alternate methods of construction.
- Only products which bear UL's Mark are considered Certified.

BXUV - Fire Resistance Ratings - ANSI/UL 263 Certified for United States

BXUV7 - Fire Resistance Ratings - CAN/ULC-S101 Certified for Canada

See General Information for Fire-resistance Ratings - ANSI/UL 263 Certified for United States
Design Criteria and Allowable Variances

See General Information for Fire Resistance Ratings - CAN/ULC-S101 Certified for Canada
Design Criteria and Allowable Variances

Design No. **U305**

August 4, 2023

Bearing Wall Rating — 1 Hr
Finish Rating — See Items 3, 3A, 3D, 3E, 3F, 3G, 3H, 3J and 3L.
STC Rating - 56 (See Item 9)
This design was evaluated using a load design method other than the Limit States Design Method (e.g., Working Stress Design Method). For jurisdictions employing the Limit States Design Method, such as Canada, a load restriction factor shall be used — See Guide BXUV or BXUV7

*** Indicates such products shall bear the UL or cUL Certification Mark for jurisdictions employing the UL or cUL Certification (such as Canada), respectively.**

Feedback

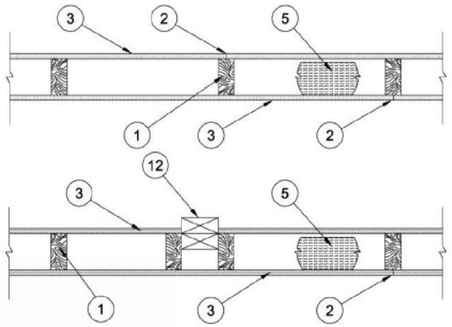

1. **Wood Studs —** Nom 2 by 4 in. spaced 16 in. OC max, effectively firestopped.

2. **Joints and Nail-Heads —** Joints covered with joint compound and paper tape. Joint compound and paper tape may be omitted when square edge boards are used. As an alternate, nom 3/32 in. thick gypsum veneer plaster may be applied to the entire surface of Classified veneer baseboard with the joints reinforced with paper tape. Nailheads exposed or covered with joint compound.

3. **Gypsum Board* —** 5/8 in. thick paper or vinyl surfaced, with beveled, square, or tapered edges, applied either horizontally or vertically. Gypsum panels nailed 7 in. OC with 6d cement coated nails 1-7/8 in. long, 0.0915 in. shank diam and 15/64 in. diam heads. When used in widths other than 48 in., gypsum panels are to be installed horizontally. For an alternate method of attachment of gypsum panels, refer to Items 6 through 6F. **Steel Framing Members***.
When Items 6, 6B, 6C, 6D, 6E, or 6F, **Steel Framing Members***, are used, gypsum panels attached to furring channels with 1 in. long Type S bugle-head steel screws spaced 12 in. OC.

When Item 6A, **Steel Framing Members***, is used, two layers of gypsum panels attached to furring channels. Base layer attached to furring channels with 1 in. long Type S bugle-head steel screws spaced 12 in. OC. Face layer attached to furring channels with 1-5/8 in. long Type S bugle-head steel screws spaced 12 in. OC. All joints in face layers staggered with joints in base layers. One layer of gypsum board attached to opposite side of wood stud without furring channels as described in Item 3.

When Item 7, resilient channels are used, 5/8 in. thick, 4 ft wide gypsum panels applied vertically. Screw attached furring channels with 1 in. long, self-drilling, self-tapping Type S or S-12 steel screws spaced 8 in. OC, vertical joints located midway between studs.

AMERICAN GYPSUM CO — Types AGX-1(finish rating 23 min.), M-Glass (finish rating 23 min.), Type AGX-11 (finish rating 26 min), Type AGX-12 (finish rating 22 min), Type LightRoc (finish rating 23 min.) or Type AG-C

BEIJING NEW BUILDING MATERIALS PUBLIC LTD CO — Type DBX-1 (finish rating 24 min)

CABOT MANUFACTURING ULC — Type X (finish rating 22 min), 5/8 Type X, Moisture Resistant Type X, Gypsum Sheathing Type X, Mold & Mildew Resistant Type X and Mold & Mildew Resistant AR Type X, Type Blueglass Exterior Sheathing

Feedback

CERTAINTEED GYPSUM INC — Type C, Type X-1 (finish rating 26 min); Type EGRG or GlasRoc (finish rating 23 min), GlasRoc-2, Type Habito (finish rating 26 min), Type LWTX (finish rating 18 min), Type LGFC6A (finish rating 34 min), Type LGFC2A, Type LGFC-C/A, Type LGFC-WD, Type LGLLX (finish rating 21 min), Type CLLX (finish rating 24 min)

CGC INC — Type AR (finish rating 24 min), Type C (finish rating 24 min), Type IP-AR (finish rating 24 min), Type IPC-AR (finish rating 24 min), Type IP-X1 (finish rating 24 min), Type IP-X2 (finish rating 24 min), Type SCX (finish rating 24 min), Type SHX (finish rating 24 min), Type ULX (finish rating 22 min), Type WRC (finish rating 24 min), Type WRX (finish rating 24 min), Type ULIX (finish rating 20 min)

GEORGIA-PACIFIC GYPSUM L L C — Type 5 (finish rating 26 min), Type 6 (finish rating 23 min), Type 9 (finish rating 26 min), Type C (finish rating 26 min), Type DGG (finish rating 20 min), Type GPFS1 (finish rating 20 min), Type GPFS2 (finish rating 20 min), Type GPFS6 (finish rating 26 min), Type DS, Type DAP, Type DID (finish rating 20 min), Type DA, Type DAPC, Type LS (finish rating 23 min), Type X, Veneer Plaster Base - Type X, Water Rated - Type X, Sheathing - Type X, Soffit - Type X, Type LWX (finish rating 22 min), Veneer Plaster Base-Type LWX (finish rating 22 min), Water Rated-Type LWX (finish rating 22 min), Sheathing Type-LWX (finish rating 22 min), Soffit-Type LWX (finish rating 22 min), Type DGLW (finish rating 22 min), Water Rated-Type DGLW (finish rating 22 min), Sheathing Type- DGLW (finish rating 22 min), Soffit-Type DGLW (finish rating 22 min), Type LWX (finish rating 22 min), Type LW2X (finish rating 22 min), Veneer Plaster Base - Type LW2X (finish rating 22 min), Water Rated - Type LW2X (finish rating 22 min), Sheathing - Type LW2X (finish rating 22 min), Soffit - Type LW2X (finish rating 22 min), Type DGL2W (finish rating 22 min), Water Rated - Type DGL2W (finish rating 22 min), Sheathing - Type DGL2W (finish rating 22 min)

NATIONAL GYPSUM CO — Type FSK (finish rating 20 min), Type FSK-G (finish rating 20 min), Type FSW (finish rating 20 min), Type FSW-2 (finish rating 24 min), Type FSW-3 (finish rating 20 min), Type FSW-5 (finish rating 22 min), Type FSW-G (finish rating 20 min), Type FSK-C (finish rating 20 min), Type FSW-C (finish rating 20 min), Type FSMR-C, Type FSW-6 (finish rating 20 min), Type FSL (finish rating 24 min), Type FSW-8, Type FSLX (finish rating 21 min), Type RSX (finish rating 26 min).

NATIONAL GYPSUM CO — Riyadh, Saudi Arabia — Type FR, or WR.

PABCO BUILDING PRODUCTS L L C, DBA PABCO GYPSUM — Types C, PG-2 (finish rating 20 min), PG-3 (finish rating 20 min), Types PG-3W, PG-5W (finish rating 20 min), Type PG-4 (finish rating 20 min), Type PG-6 (finish rating 23 min), Types PG-3WS, PG-5WS, PGS-WRS (finish rating 20 min), Types PG-5, PG-9 (finish rating 26 min), PG-11 PG-13 (Nails increased to 2 in.), Type PG-C or PGI (finish rating 26 min)

PANEL REY S A — Type ARX, GREX, GRIX, PRX, PRC, PRC2; Types RHX, Guard Rey, MDX, ETX (finish rating 22 min), PRX2 (finish rating 21 min)

SIAM GYPSUM INDUSTRY (SARABURI) CO LTD — Type EX-1 (finish rating 26 min)

THAI GYPSUM PRODUCTS PCL — Type C, Type X (finish rating 26 min)

UNITED STATES GYPSUM CO — Type AR (finish rating 24 min), Type C (finish rating 24 min), Type FRX-G (finish rating 29 min), Type IP-AR (finish rating 24 min), Type IPC-AR (finish rating 24 min), Type IP-X1 (finish rating 24 min), Type IP-X2 (finish rating 24 min), Type SHX (finish rating 24 min), Type SCX (finish rating 24 min), Type SGX (finish rating 24 min), Type ULX (finish rating 22 min), Type WRX (finish rating 24 min), Type WRC (finish rating 24 min), Type ULIX (finish rating 20 min)

USG BORAL DRYWALL SFZ LLC — Type SGX (finish rating 24 min).

USG MEXICO S A DE C V — Type AR (finish rating 24 min), Type C (finish rating 24 min), Type WRX (finish rating 24 min), Type WRC (finish rating 24 min), Type IP-X1 (finish rating 24 min), Type IP-X2 (finish rating 24 min), Type SHX (finish rating 24 min), Type SCX (finish rating 24 min), Type IP-AR (finish rating 24 min), Type IPC-AR (finish rating 24 min)

3A. **Gypsum Board* —** (As an alternate to Item 3) — 5/8 in. thick gypsum panels, with beveled, square, or tapered edges, applied either horizontally or vertically. Gypsum panels fastened to framing with 1-1/4 in. long Type W coarse thread gypsum panel steel screws spaced a max 8 in. OC, with last screw 1 in. from edge of board. When used in widths of other than 48 in., gypsum boards are to be installed horizontally.

AMERICAN GYPSUM CO — Types AGX-1 (finish rating 25 min.), M-Glass (finish rating 25 min.), AG-C (finish rating 25 min.), LighttRoc (finish rating 25 min.)

Feedback

CERTAINTEED GYPSUM INC — Type C, Type X-1 (finish rating 26 min), Type EGRG or GlasRoc, LWTX.

CGC INC — Type AR (finish rating 24 min), Type C (finish rating 24 min), Type IP-AR (finish rating 24 min), Type IPC-AR (finish rating 24 min), Type IP-X1 (finish rating 24 min), Type IP-X2 (finish rating 24 min), Type SCX (finish rating 24 min), Type SHX (finish rating 24 min), Type WRC (finish rating 24 min), Type WRX (finish rating 24 min)

NATIONAL GYPSUM CO — Type FSW (finish rating 24 min)

UNITED STATES GYPSUM CO — Type AR (finish rating 24 min), Type SCX (finish rating 24 min), Type SGX (finish rating 24 min), Type C (finish rating 24 min), Type WRX (finish rating 24 min), Type WRC (finish rating 24 min), Type IP-X1 (finish rating 24 min), Type IP-X2 (finish rating 24 min), Type SHX (finish rating 24 min), Type FRX-G (finish rating 24 min), Type IP-AR (finish rating 24 min), Type IPC-AR (finish rating 24 min)

USG BORAL DRYWALL SFZ LLC — Types C, SCX, SGX (finish rating 24 min).

USG MEXICO S A DE C V — Type AR (finish rating 24 min), Type C (finish rating 24 min), Type WRX (finish rating 24 min), Type WRC (finish rating 24 min), Type IP-X1 (finish rating 24 min), Type IP-X2 (finish rating 24 min), Type SHX (finish rating 24 min), Type SCX, Type IP-AR (finish rating 24 min), Type IPC-AR (finish rating 24 min)

3B. **Gypsum Board* —** (As an alternate to Item 3) — Nom 3/4 in. thick, installed with 1-7/8 in. long cement coated nails as described in Item 3 or 1-3/8 in. long Type W coarse thread gypsum panel steel screws as described in Item 3A.
CGC INC — Types AR, IP-AR

UNITED STATES GYPSUM CO — Types AR, IP-AR

USG MEXICO S A DE C V — Types AR, IP-AR

3C. **Gypsum Board* —** (As an alternate to Items 3, 3A and 3B) — 5/8 in. thick, 2 ft wide, tongue and groove edge, applied horizontally to one side of the assembly. Installed with 1-7/8 in. long cement coated nails as described in Item 3 or 1-1/4 in. long Type W coarse thread gypsum panel steel screws as described in Item 3A. Joint covering (Item 2) not required.
CGC INC — Type SHX

UNITED STATES GYPSUM CO — Type SHX

USG MEXICO S A DE C V — Type SHX

3D. **Gypsum Board* —** (As an alternate to Items 3, 3A, 3B, or 3C — Not Shown) — For Direct Application to Studs Only- Nom 5/8 in. thick lead backed gypsum panels with beveled, square or tapered edges, applied vertically. Vertical joints centered over studs and staggered min 1 stud cavity on opposite sides of studs. Wallboard secured to studs with 1-5/8 in. long Type W coarse thread gypsum panel steel screws spaced 8 in. OC at perimeter and in the field. Lead batten strips required behind vertical joints of lead backed gypsum wallboard and optional at remaining stud locations. Lead batten strips, min 1-1/2 in. wide, max 10 ft long with a max thickness of 0.125 in. placed on the face of studs and attached to the stud with two 1 in. long Type S-12 pan head steel screws, one at the top of the strip and one at the bottom of the strip. Lead discs or tabs may be used in lieu of or in addition to the lead batten strips or optional at other locations. Max 3/4 in. diam by max 0.125 in. thick lead discs compression fitted or adhered over steel screw heads or max 1/2 in. by 1-1/4 in. by max 0.125 in. thick lead tabs placed on gypsum boards underneath screw locations prior to the installation of the screws. Lead batten strips to have a purity of 99.9% meeting the Federal specification QQ-L-201f, Grade "C".
RAY-BAR ENGINEERING CORP — Type RB-LBG (finish rating 24 min)

3E. **Gypsum Board* —** (As an alternate to Items 3, 3A, 3B, 3C, and 3D) — 5/8 in. thick gypsum panels, with square edges, applied either horizontally or vertically. Gypsum panels fastened to framing with 1-1/4 in. long Type W coarse thread gypsum panel steel screws spaced a max 8 in. OC, with last 2 screws 1 and 4 in. from edge of board or nailed 7 in. OC with 6d cement coated nails 1-7/8 in. long, 0.0915 in. shank diam and 15/64 in. diam heads. When used in widths of other than 48 in., gypsum boards are to be installed horizontally.
GEORGIA-PACIFIC GYPSUM L L C — Type DGG (finish rating 20 min), GreenGlass Type X (finish rating 23 min)

3F. **Gypsum Board* —** (As an alternate to Items 3, 3A, 3B, 3C, 3D, and 3E) — 5/8 in. glass-mat faced with square edges, applied either horizontally or vertically. Gypsum panels nailed 7 in. OC around the perimeter and in the field with 6d cement coated nails 1-7/8 in. long, 0.0915 in. shank diam and 15/64 in. diam heads. Nails shall be placed 1 inch and 3 inch from horizontal joints and 7 inch OC thereafter.
CGC INC — Type USGX (finish rating 22 min)

UNITED STATES GYPSUM CO — Type USGX (finish rating 22 min.)

USG BORAL DRYWALL SFZ LLC — , Type USGX (finish rating 22 min.)

USG MEXICO S A DE C V — Type USGX (finish rating 22 min.)

3G. **Gypsum Board* —** (As an alternate to Items 3 through 3F) — 5/8 in. thick paper surfaced applied vertically. Gypsum panels nailed 7 in. OC with 6d cement coated nails 1-7/8 in. long, 0.0915 in. shank diam and 15/64 in. diam heads.
GEORGIA-PACIFIC GYPSUM L L C — Type X ComfortGuard Sound Deadening Gypsum Board (finish rating 27 min)

3H. **Gypsum Board* —** (As an alternate to Items 3) — Not to be used with items 6 or 7. 5/8 in. thick paper surfaced applied vertically only. Gypsum panels nailed 7 in. OC with 6d cement coated nails 1-7/8 in. long, 0.0915 in. shank diam and 15/64 in. diam heads.
NATIONAL GYPSUM CO — Type SBWB

3I. **Gypsum Board* —** (As an alternate to Items 3 through 3H, Not Shown) — Nominal 5/8 in. thick, 4 ft wide panels, applied vertically. Panels nailed 7 in. OC with 6d cement coated nails 1-7/8 in. long, 0.0915 in. shank diam and 15/64 in. diam heads. Panel joints covered with paper tape and two layers of joint compound. Nailheads covered with two layers of joint compound.
PABCO BUILDING PRODUCTS L L C, DBA PABCO GYPSUM — Type QuietRock ES (finish rating 20 min)

3J. **Gypsum Board* —** (As an alternate to Item 3) — 5/8 in. thick paper surfaced applied vertically or horizontally. Gypsum panels secured with 1-1/4 in. Type W coarse thread gypsum panel steel screws spaced a maximum of 12 in. OC.
CERTAINTEED GYPSUM INC — Type SilentFX

3K. **Gypsum Board* —** (As an alternate to Item 3) — 5/8 in. thick gypsum panels, with beveled, square, or tapered edges, applied either horizontally or vertically. Gypsum panels fastened to framing with 1-1/4 in. long Type W coarse thread gypsum panel steel screws spaced a maximum 8 in. OC with the last screw 1 in. from the edge of the board. When used in widths other than 48 in., gypsum panels are to be installed horizontally.
NATIONAL GYPSUM CO — Type FSK (finish rating 20 min), Type FSK-G (finish rating 20 min), Type FSW (finish rating 20 min), Type FSW-2 (finish rating 24 min), Type FSW-3 (finish rating 20 min), Type FSW-5 (finish rating 22 min), Type FSW-G (finish rating 20 min), Type FSK-C (finish rating 20 min), Type FSW-C (finish rating 20 min), Type FSMR-C, Type FSW-6 (finish rating 20 min), Type FSL (finish rating 24 min).

3L. **Gypsum Board* —** (As an alternate to Item 3) — For Direct Application to Studs Only — Nom 5/8 in. thick lead backed gypsum panels with beveled, square or tapered edges, applied vertically. Vertical joints centered over studs and staggered min 1 stud cavity on opposite sides of studs. Wallboard secured to studs with 1-5/8 in. long Type W coarse thread gypsum panel steel screws spaced 8 in. OC at perimeter and in the field. Lead batten strips required behind vertical joints of lead backed gypsum wallboard and optional at remaining stud locations. Lead batten strips, min 2 in. wide, max 10 ft long with a max thickness of 0.140 in. placed on the face of studs and attached to the stud with two 1 in. long Type S-8 pan head steel screws, one at the top of the strip and one at the bottom of the strip. Lead discs, max 5/16 in. diam by max 0.140 in. thick. compression fitted or adhered over the screw heads. Lead batten strips to have a purity of 99.5% meeting the Federal specification QQ-L-201f, Grades "B, C or D".
MAYCO INDUSTRIES INC — "X-Ray Shielded Gypsum"

3M. **Gypsum Board* —** (As an alternate to Items 3) — For Direct Application to Studs Only — For use as the base layer or as the face layer. Nom 5/8 in. thick lead backed gypsum panels with beveled, square or tapered edges, applied vertically. Vertical joints centered over studs and staggered min 1 stud cavity on opposite sides of studs. Wallboard secured to studs with 1-5/8 in. long Type W coarse thread gypsum panel steel screws spaced 8 in. OC at perimeter and in the field when applied as the base layer. When applied as the face layer screw length to be increased to 2-1/2 in. Lead batten strips required behind vertical joints of lead backed gypsum wallboard and optional at remaining stud locations. Lead batten strips, min 2 in. wide, max 8 ft long with a max thickness of 0.14 in. placed on the face of studs and attached to the stud with construction adhesive and two 1 in. long Type S-12 pan head steel screws, one at the top of the strip and one at the bottom of the strip. Lead discs, nominal 3/8 in. diam by max 0.085 in. thick. Compression fitted or adhered over the screw heads. Lead batten strips and discs to have a purity of 99.9% meeting the Federal specification QQ-L-201f, Grade "C". Fasteners for face layer gypsum panels (Items 4, 4A or 4B) when installed over lead backed board to be min 2-1/2 in. Type S-12 bugle head steel screws spaced as described in Item 4.
RADIATION PROTECTION PRODUCTS INC — Type RPP - Lead Lined Drywall

3N. **Gypsum Board* —** (As an alternate to Item 3) — 5/8 in. thick, 4 ft. wide, applied horizontally or vertically with vertical joints centered over studs and staggered one stud cavity on opposite sides of studs. Secured as described in Item 3 or 3A.
CERTAINTEED GYPSUM INC — Easi-Lite Type X (finish rating 24 min), Easi-Lite Type X-2 (finish rating 24 min)

3O. **Wall and Partition Facings and Accessories* —** (As an alternate to Item 3, Not Shown) — Nominal 5/8 in. thick, 4 ft wide panels, applied vertically. Panels nailed 7 in. OC with 6d cement coated nails 1-7/8 in. long, 0.0915 in. shank diam and 15/64 in. diam heads. Panel joints covered with paper tape and two layers of joint compound. Nailheads covered with two layers of joint compound.
PABCO BUILDING PRODUCTS L L C, DBA PABCO GYPSUM — Type QuietRock 527 (finish rating 24 min).

3P. **Gypsum Board* —** (As an alternate to Item 3, Not Shown) — Two layers nom. 5/16 in. thick gypsum panels applied vertically or horizontally. Horizontal edge joints and horizontal butt joints on opposite sides of studs need not be staggered or backed by wood studs. Horizontal joints on the same side between face and base layers need not be staggered. Base layer gypsum panels fastened to studs with 1-1/4 in. long drywall nails spaced 8 in. OC. Face layer gypsum panels fastened to studs with 1-7/8 in. long drywall nails spaced 8 in. OC starting with a 4" stagger.
NATIONAL GYPSUM CO — Type FSW (finish rating 25 min)

3Q. **Gypsum Board* —** (As an alternate to Item 3) — 5/8 in. thick gypsum panels, with beveled, square, or tapered edges, applied either horizontally or vertically. Gypsum panels fastened to framing with 1-1/4 in. long Type W coarse thread gypsum panel steel screws spaced a maximum 10 in. OC with the last two screws 4 and 1 in. from the edges of the board. When used in widths other than 48 in., gypsum panels are to be installed horizontally.
CERTAINTEED GYPSUM INC — Type LGFC6A (finish rating 21 min), Type LGFC2A, Type LGFC-C/A, Type LGFC-WD, Type LGLLX

3R. **Gypsum Board* —** (As an alternate to Item 3. For use with Item 5H) — Any 5/8 in. thick, 4 ft. wide, Gypsum Board listed in Item 3 above. Applied either horizontally or vertically, and screwed to panels with 1-5/8 in. long Type W coarse thread steel screws at 8 in. OC at perimeter and in the field with the last two screws 4 and 3/4 in. from the edges of the board when applied as the base layer. When used in widths other than 48 in., gypsum panels are to be installed horizontally.

3S. **Gypsum Board* —** 3/4 in. thick paper or vinyl surfaced, with beveled, square, or tapered edges, applied either horizontally or vertically. Gypsum panels secured as described in Item 3 with nail length increased to 2 in.
PABCO BUILDING PRODUCTS L L C, DBA PABCO GYPSUM — Type PG-13

3T. **Wall and Partition Facings and Accessories* —** (As an alternate to 5/8 in. thick board as outlined in Item 3) — Nominal 1-3/8 in. thick, 4 ft wide panels, applied vertically or horizontally. Fastened with #6 x 2 in. long drywall screws spaced 8 in. OC along the perimeter and 12 in. OC in the field.
PABCO BUILDING PRODUCTS L L C, DBA PABCO GYPSUM — Type QuietRock 545

3U. **Gypsum Board* —** (As an alternate to Item 3 - For use with Foamed Plastic products, Item 5J) — 5/8 in. thick, 4 ft. wide, applied vertically with vertical joints centered over studs and staggered one stud cavity on opposite sides of studs. Gypsum panels nailed 7 in. OC with 6d cement coated nails 1-7/8 in. long, 0.0915 in. shank diam and 15/64 in. diam heads.
AMERICAN GYPSUM CO — Types AGX-1

BEIJING NEW BUILDING MATERIALS PUBLIC LTD CO — Type DBX-1

CABOT MANUFACTURING ULC — Type X

CERTAINTEED GYPSUM INC — Type X

Feedback

CGC INC — Type SCX

PANEL REY S A — Type ARX, PRX

SIAM GYPSUM INDUSTRY (SARABURI) CO LTD — Type EX-1

THAI GYPSUM PRODUCTS PCL — Type X

UNITED STATES GYPSUM CO — Types SCX and SGX

USG BORAL DRYWALL SFZ LLC — Types SCX and SGX

USG MEXICO S A DE C V — Type SCX

3V. **Gypsum Board* —** (As an alternate to Item 3. For use with Item 5K) — Any 5/8 in. thick, 4 ft. wide, Gypsum Board listed in Item 3 above. Applied vertically with vertical joints centered over studs and staggered one stud cavity on opposite sides of studs. Gypsum panels secured to studs with 1-5/8 in. long Type W coarse thread gypsum panel steel screws spaced 8 in. OC at perimeter and in the field.

3W. **Gypsum Board* —** (As an alternate to Item 3. For use with Item 5L) — Any 5/8 in. thick, 4 ft. wide, Gypsum Board listed in Item 3 above. Applied vertically with vertical joints centered over studs and staggered one stud cavity on opposite sides of studs. Gypsum panels secured to studs with 1-1/4 in. long Type W screws spaced 8 in. OC at perimeter and in the field.

4. **Steel Corner Fasteners —** (Optional) — For use at wall corners. Channel shaped, 2 in. long by 1 in. high on the back side with two 1/8 in. wide cleats protruding into the 5/8 in. wide channel, fabricated from 24 gauge galv steel. Fasteners applied only to the end or cut edge (not along tapered edges) of the gypsum board, no greater than 2 in. from corner of gypsum board, max spacing 16 in. OC. Nailed to adjacent stud through tab using one No. 6d cement coated nail per fastener. Corners of wall board shall be nailed to top and bottom plate using No. 6d cement coated nails.

5. **Batts and Blankets* —** (Optional — Required when Item 6A is used (RC-1)) — Glass fiber or mineral wool insulation. Placed to completely or partially fill the stud cavities. When Item 6A is used, glass fiber or mineral wool insulation shall be friction-fitted to completely fill the stud cavities.
CERTAINTEED CORP

JOHNS MANVILLE

KNAUF INSULATION LLC

MANSON INSULATION INC

ROCKWOOL — Types Acoustical Fire Batts and Type AFB, min. density 1.69 pcf / 27.0 kg/m^3

ROCKWOOL MALAYSIA SDN BHD — Type Acoustical Fire Batts

ROCK WOOL MANUFACTURING CO — Delta Board

THERMAFIBER INC — Type SAFB, SAFB FF

5A. **Fiber, Sprayed* —** (Not Shown — Not for use with Item 6) — As an alternate to Batts and Blankets (Item 5) — Spray applied cellulose material. The fiber is applied with water to completely fill the enclosed cavity in accordance with the application instructions supplied with the product with a nominal dry density of 2.7 lb/ft^3. Alternate Application Method: The fiber is applied without water or adhesive at a nominal dry density of 3.5 lb/ft^3, in accordance with the application instructions supplied with the product. When Item 6B is used, Fiber, Sprayed shall be INS735, INS745, INS750LD, INS765LD, INS773LD or SANCTUARY.

Feedback

Applegate Greenfiber Acquisition LLC — Insulmax and SANCTUARY for use with wet or dry application. INS515LD and INS541LD are to be used for dry application only

5B. **Fiber, Sprayed* —** (Not Shown - Not for use with Item 6) — As an alternate to Batts and Blankets (Item 5) - Spray applied cellulose insulation material. The fiber is applied with water to interior surfaces in accordance with the application instructions supplied with the product. Applied to completely fill the enclosed cavity. Minimum dry density of 4.3 pounds per cubic ft.
NU-WOOL CO INC — Cellulose Insulation

5C. **Batts and Blankets* —** Required for use with resilient channels, Item 7, 3 in. thick mineral wool batts, friction-fitted to fill interior of wall.
THERMAFIBER INC — Type SAFB, SAFB FF

5D. **Glass Fiber Insulation —** (As an alternate to Item 5C) — 3 in. thick glass fiber batts bearing the UL Classification Marking as to Surface Burning and/or Fire Resistance, friction-fitted to fill the interior of the wall. See **Batts and Blankets** (BKNV or BZJZ) Categories for names of Classified companies.

5E. **Batts and Blankets* —** (Required for use with Wall and Partition Facings and Accessories, Item 3D) — Glass fiber insulation, nom 3-1/2 in. thick, min. density of 0.80 pcf, with a flame spread of 25 or less and a smoke developed of 50 or less, friction-fitted to completely fill the stud cavities. See Batts and Blankets Category (BKNV) for names of manufacturers.

5F. **Fiber, Sprayed* —** (Optional, Not Shown — Not for use with Items 6, 6A, 6B, 6C, or 6D) — As an alternate to Batts and Blankets (Item 5) and Item 5A - Spray applied granulated mineral fiber material. The fiber is applied with adhesive, at a minimum density of 4.0 pcf, to completely fill the enclosed cavity in accordance with the application instructions supplied with the product. See **Fiber, Sprayed** (CCAZ).
AMERICAN ROCKWOOL MANUFACTURING, LLC — Type Rockwool Premium Plus

5G. **Fiber, Sprayed* —** (Optional, Not Shown — Not for use with Items 6, 6A, 6B, 6C, or 6D). — As an alternate to Batts and Blankets (Item 5) and Item 5A - Brown Colored Spray applied cellulose fiber. The fiber is applied with water to completely fill the enclosed stud cavity in accordance with the application instructions supplied with the product. The minimum dry density shall be 4.30 lbs/ft^3.
INTERNATIONAL CELLULOSE CORP — Celbar-RL

5H. **Foamed Plastic* —** (Optional -For use with Item 3R) — Spray applied, foamed plastic insulation, at any thickness from partial fill to completely filling stud cavity.
SES FOAM INC — Nexseal™ 2.0 or Nexseal™ 2.0 LE Spray Foam and Sucraseal Spray Foam.

5I. Deleted.

5J. **Foamed Plastic* —** (Optional, Not Shown - For use with Item 3U) — Spray applied, foamed plastic insulation, at any thickness from partial fill to completely filling stud cavity.
GACO WESTERN L L C — Types GacoEZSpray F4500, GacoProFill FR6500R, Gaco 052N, GacoOnePass F1850, GacoOnePass Low GWP F1880, and Gaco WallFoam 183M

5K. **Foamed Plastic* —** (Optional, Not Shown - For use with Item 3V) — Spray applied, foamed plastic insulation, at any thickness from partial fill to completely filling stud cavity.
CARLISLE SPRAY FOAM INSULATION — Types SealTite ONE, SealTite Pro Closed Cell (CC), SealTite Pro Open Cell (OC), SealTite Pro OCX, SealTite Pro No Trim 21, SealTite Pro One Zero, Foamulate Closed Cell, Foamulate OCX, Foamulate 70, and Foamulate HFO.

5L. **Foamed Plastic* -** (Optional, Not Shown – For use with Item 3W) - Spray applied, foamed plastic insulation, at any thickness from partial fill to completely filling stud cavity.
BASF CORP – Types Enertite® NM, Enertite® G, FE178®, Spraytite® 178, Spraytite® 81206, Walltite® 200, Walltite® US, Walltite® US-N, Walltite® HP+, Sprayfite® Comfort XL, and Walltite® XL.

6. **Steel Framing Members* —** (Optional, Not Shown) **—** Furring channels and Steel Framing Members as described below:

Feedback

rosemann & ASSOCIATES P.C.
ARCHITECTURE
INTERIOR DESIGN
ENGINEERING
PLANNING
1526 Grand Boulevard
Kansas City, MO 64108-1404
p: 816.472.1448
w: www.rosemann.com

© 2023 Rosemann & Associates, P.C.

DENVER ▲ KANSAS CITY ▲ ST. LOUIS ▲ ATLANTA

PRINTS ISSUED
10/30/23 PERMIT SUBMITTAL

REVISIONS:

STATE OF MISSOURI
DAVID EUGENE HENDRIKSE
NUMBER A-7365
REGISTERED ARCHITECT
10/30/23

WILSHIRE HILLS III

LEE'S SUMMIT, MISSOURI

MHDC - 22-057

SHEET TITLE
UL ASSEMBLIES

PROJECT NUMBER: 23034

SHEET NUMBER:

G-200

10/27/2023 2:53:28 PM
C:\Revit Local Cache\22057\2024_Wilshire Hills III_Central_R23_zwn9TULAR.rvt

UL DESIGN - U305 - CONT.

a. **Furring Channels —** Formed of No. 25 MSG galv steel. 2-9/16 in. or 2-23/32 in. wide by 7/8 in. deep, spaced 24 in. OC perpendicular to studs. Channels secured to studs as described in Item b. Ends of adjoining channels are overlapped 6 in. and tied together with double strand of No. 18 SWG galv steel wire near each end of overlap. As an alternate, ends of adjoining channels may be overlapped 6 in. and secured together with two self-tapping #6 framing screws, min. 7/16 in. long at the midpoint of the overlap, with one screw on each flange of the channel. Gypsum board attached to furring channels as described in Item 3.

b. **Steel Framing Members* —** Used to attach furring channels (Item 6a) to studs. Clips spaced 48 in. OC. RSIC-1 and RSIC-1 (2.75) clips secured to studs with No. 8 x 2-1/2 in. coarse drywall screw through the center grommet. RSIC-V and RSIC-V (2.75) clips secured to studs with No. 8 x 1-1/2 in. coarse drywall screw through the center hole. Furring channels are friction fitted into clips. RSIC-1 and RSIC-V clips for use with 2-9/16 in. wide furring channels. RSIC-1 (2.75) and RSIC-V (2.75) clips for use with 2-23/32 in. wide furring channels.
PAC INTERNATIONAL L L C — Types RSIC-1, RSIC-V, RSIC-1 (2.75), RSIC-V (2.75)

6A. **Steel Framing Members* —** (Optional, Not Shown) — Furring channels and Steel Framing Members on one side of studs as described below:
a. **Furring Channels —** Formed of No. 25 MSG galv steel, spaced 24 in. OC perpendicular to studs. Channels secured to studs as described in Item b. Ends of adjoining channels are overlapped 6 in. and tied together with double strand of No. 18 SWG galv steel wire near each end of overlap. Batts and Blankets placed in stud cavity as described in Item 5. Two layers of gypsum board attached to furring channels as described in Item 3.

b. **Steel Framing Members* —** Used to attach furring channels (Item 6Aa) to one side of studs only. Clips spaced 48 in. OC., and secured to studs with two No. 8 x 2-1/2 in. coarse drywall screws, one through the hole at each end of the clip. Furring channels are friction fitted into clips.
KINETICS NOISE CONTROL INC — Type Isomax

6B. **Steel Framing Members* —** (Optional, Not Shown) — Furring channels and Steel Framing Members as described below:
a. **Furring Channels —** Formed of No. 25 MSG galv steel. 2-3/8 in. wide by 7/8 in. deep, spaced 24 in. OC perpendicular to studs. Channels secured to studs as described in Item b. Ends of adjoining channels are overlapped 6 in. and tied together with double strand of No. 18 SWG galv steel wire near each end of overlap. As an alternate, ends of adjoining channels may be overlapped 6 in. and secured together with two self-tapping #6 framing screws, min. 7/16 in. long at the midpoint of the overlap, with one screw on each flange of the channel. Gypsum board attached to furring channels as described in Item 3.

b. **Steel Framing Members* —** Used to attach furring channels (Item 6Ba) to studs. Clips spaced 48 in. OC. Genie clips secured to studs with No. 8 x 1-1/2 in. coarse drywall screw through the center hole. Furring channels are friction fitted into clips.
PLITEQ INC — Type Genie Clip

6C. **Steel Framing Members* —** (Optional, Not Shown) — Furring channels and Steel Framing Members as described below:
a. **Furring Channels —** Formed of No. 25 MSG galv steel. Spaced 24 in. OC perpendicular to studs. Channels secured to studs as described in Item b. Ends of adjoining channels overlapped 6 in. and tied together with double strand of No. 18 AWG galvanized steel wire. Gypsum board attached to furring channels as described in Item 3.

b. **Steel Framing Members* —** Used to attach furring channels (Item 6Ca) to studs. Clips spaced 48 in. OC., and secured to studs with No. 2 in. coarse drywall screw with 1 in. diam washer through the center hole. Furring channels are friction fitted into clips.
STUDCO BUILDING SYSTEMS — RESILMOUNT Sound Isolation Clips - Type A237 or A237R

6D. **Steel Framing Members* —** (Optional, Not Shown) — Furring channels and Steel Framing Members as described below:
a. **Furring Channels —** Formed of No. 25 MSG galv steel, spaced 24 in. OC, and perpendicular to studs. Channels secured to studs as described in Item b. Ends of adjoining channels overlapped 6 in. and secured in place with a double strand of No. 18 AWG twisted steel wire. Gypsum board attached to furring channels as described in Item 3.

b. **Steel Framing Members* —** Used to attach furring channels (Item 6Da) to studs. Clips spaced 48 in. OC., and secured to studs with No. 8 x 2-1/2 in. coarse drywall screw through the center hole. Furring channels are friction fitted into clips.
REGUPOL AMERICA — Type SonusClip

6E. **Steel Framing Members* —** (Optional, Not Shown) — Resilient channels and Steel Framing Members as described below:

a. **Resilient Channels —** Formed of No. 25 MSG galv steel, spaced 24 in. OC, and perpendicular to studs. Channels secured to studs as described in Item b. Ends of adjoining channels overlapped 6 in. and secured in place with two No. 8 15 x 1/2 in. Philips Modified Truss screws spaced 2-1/2 in. from the center of the overlap. Gypsum board attached to resilient channels as described in Item 3.

b. **Steel Framing Members* —** Used to attach resilient channels (Item 6Ea) to studs. Clips spaced 48 in. OC., and secured to studs with No. 8 x 2-1/2 in. coarse drywall screw through the center hole. Resilient channels are secured to clips with one No. 10 x 1/2 in. pan-head self-drilling screw.
KEENE BUILDING PRODUCTS CO INC - Type RC+ Assurance Clip

6F. **Steel Framing Members* —** (Optional, Not Shown) — Furring channels and Steel Framing Members as described below:
a. **Furring Channels —** Formed of No. 25 MSG galv steel. 2-23/32 in. wide by 7/8 in. deep, spaced 24 in. OC perpendicular to studs. Channels secured to studs as described in Item b. Ends of adjoining channels are overlapped 6 in. and tied together with double strand of No. 18 SWG galv steel wire near each end of overlap. As an alternate, ends of adjoining channels may be overlapped 6 in. and secured together with two self-tapping #6 framing screws, min. 7/16 in. long at the midpoint of the overlap, with one screw on each flange of the channel. Gypsum board attached to furring channels as described in Item 3.

b. **Steel Framing Members* —** Used to attach furring channels (Item 6Fa) to studs. Clips spaced 48 in. OC. Clips secured to studs with No. 8 x 2-1/2 in. coarse drywall screw through the center grommet. Furring channels are friction fitted into clips.
CLARKDIETRICH BUILDING SYSTEMS — Type ClarkDietrich Sound Clip

6G. **Steel Framing Members* —** (Optional, Not Shown) — Used as an alternate method to attach resilient channels to wall studs. A resilient sound isolation accessory shall be used at each attachment point of the resilient channels and spaced max 16 in. O.C. Channel ends butted and centered under the structural members and attached with one accessory at each end. Additional accessories used to hold resilient channels that support the gypsum board end joints. The accessory envelops the mounting edge of the resilient channel. The accessory and resilient channel are fastened to the structural members with the screws supplied with the accessory and per the accessory manufacturer's installation instructions.
PAC INTERNATIONAL L L C — Type RC-1 Boost

7. **Furring Channel —** Optional — Not Shown — For use on one side of the wall - Resilient channels, 25 MSG galv steel, spaced vertically 24 in. OC, flange portion screw attached to one side of studs with 1-1/4 in. long diamond shaped point, double lead Phillips head steel screws. When resilient channels are used, insulation, Items 5C or 5D is required.

8. **Caulking and Sealants —** (Not Shown, Optional) — A bead of acoustical sealant applied around the partition perimeter for sound control.

9. **STC Rating —** The STC Rating of the wall assembly is 56 when it is constructed as described by Items 1 through 6, except:

A. Item 2, above — Nailheads Shall be covered with joint compound.

B. Item 2, above — Joints As described, shall be covered with fiber tape and joint compound.

C. Item 5, above — Batts and Blankets* The cavities formed by the studs shall be friction fit with R-19 unfaced fiberglass insulation batts measuring 6-1/4 in. thick and 15-1/4 in. wide.

D. Item 6, above — Steel Framing Members* Type RSIC-1 clips shall be used to attach gypsum board to studs on either side of the wall assembly.

E. Item 8, above — Caulking and Sealants (Not Shown) A bead of acoustical sealant shall be applied around the partition perimeter for sound control.

F. Steel Corner Fasteners (Item 4), Fiber, Sprayed (Items 5A and 5B) and Steel Framing Members (Item 6A), not evaluated as alternatives for obtaining STC rating.

10. **Wall and Partition Facings and Accessories* —** (Optional, Not Shown) — Nominal 1/2 in. thick, 4 ft wide panels, for optional use as an additional layer on one or both sides of the assembly. Panels attached in accordance with manufacturer's recommendations.

When the QR-500 or QR-510 panel is installed between the wood framing and the UL Classified gypsum board, the required UL Classified gypsum board layer(s) is/are to be installed as indicated as to fastener type and spacing, except that the required fastener length shall be increased by a minimum of 1/2 in. Not evaluated or intended as a substitute for the required layer(s) of UL Classified Gypsum Board.
PABCO BUILDING PRODUCTS L L C, DBA PABCO GYPSUM — Type QuietRock QR-500 and QR-510

11. **Cementitious Backer Units* —** (Optional Item Not Shown — For Use On Face Of 1 Hr Systems With All Standard Items Required) - 7/16 in., 1/2 in., 5/8 in., 3/4 in. or 1 in. thick, min. 32 in. wide. Applied vertically or horizontally with vertical joints centered over studs. Fastened to studs and runners with cement board screws of adequate length to penetrate stud by a minimum of 3/8 in. for steel framing members, and a minimum of 3/4 in. for wood framing members spaced a max of 8 in. OC. When 4 ft. wide boards are used, horizontal joints need not be backed by framing.
NATIONAL GYPSUM CO — Type DuraBacker, PermaBase, DuraBacker Plus, or PermaBase Plus

12. **Non-Bearing Wall Partition Intersection —** (Optional) —Two nominal 2 by 4 in. studs or nominal 2 by 6 in. studs nailed together with two 3 in. long 10d nails spaced a max. 16 in. OC. vertically and fastened to one side of the minimum 2 by 4 in. stud with 3 in. long 10d nails spaced a max. 16 in. OC. vertically. Intersection between partition wood studs to be flush with the 2 by 4 in. studs. The wall partition wood studs are to be framed by with a second 2 by 4 in. wood stud fastened with 3 in. long 10d nails spaced a max. 16 in. OC. vertically. Maximum one non-bearing wall partition intersection per stud cavity. Non-bearing wall partition stud depth shall be at a minimum equal to the depth of the bearing wall.

13. **Mesh Netting —** (Not Shown) — Any thin, woven or non-woven fibrous netting material attached with staples to the outer face of one row of studs to facilitate the installation of the sprayed fiber from the opposite row.

14. **Mineral and Fiber Board* —** (Optional, Not Shown) — For optional use as an additional layer on one side of wall. Nom 1/2 in. thick, 4 ft wide with long dimension parallel and centered over studs. Attached to framing with 2 in. long Type W steel screws, spaced 12 in. OC. The required UL Classified gypsum board layer(s) is/are to be installed as indicated as to fastener type and spacing, except that the required fastener length shall be increased by a minimum of 1/2 in. Not evaluated or intended as a substitute for the required layer(s) of UL Classified Gypsum Board.
HOMASOTE CO — Homasote Type 440-32

14A. **Mineral and Fiber Board* —** (Optional, Not Shown) — For use with Items 14B-14E) — For optional use as an additional layer on one side of wall. Nom 1/2 in. thick, 4 ft wide with long dimension parallel and centered over studs. Attached to framing with minimum 1-3/8 in. long ring shanked nails or 1-1/4 in. long Type W steel screws, spaced 12 in. OC along board edges and 24 in. OC in field of board along intermediate framing. Not evaluated or intended as a substitute for the required layer(s) of UL Classified Gypsum Board.
HOMASOTE CO — Homasote Type 440-32

14B. **Glass Fiber Insulation —** (For use with Item 14A) — 3-1/2 in. thick glass fiber batts bearing the UL Classification Marking as to Surface Burning and/or Fire Resistance, placed to fill the interior of the wall. See Batts and Blankets (BKNV or BZJZ) categories for names of Classified companies.

14C. **Batts and Blankets* —** (As an alternate to Item 14B, For use with Item 14A), 3 in. thick mineral wool batts, placed to fill interior of wall, attached to the 3-1/2 in. face of the studs with staples placed 24 in. OC.
THERMAFIBER INC — Type SAFB, SAFB FF

14D. **Adhesive —** (For use with Item 14A) — Construction grade adhesive applied in vertical, serpentine, nominal 3/8 in. wide beads down the length of both vertical edges of Mineral and Fiber Board (Item 14A).

14E. **Gypsum Board* —** (For use with Item 14A) — 5/8 in. thick, 4 ft wide, applied vertically over Mineral and Fiber Board (Item 14A) with vertical joints located anywhere over stud cavities. Secured to mineral and fiber boards with 1-1/2 in. Type G Screws spaced 8 in. OC along edges of each vertical joint and 12 in. OC in intermediate field of the Mineral and Fiber Board (Item 14A). Secured to outermost studs and bearing plates with 2 in. long Type S screws spaced 8 in. OC. Gypsum Board joints covered with paper tape and joint compound. Screw heads covered with joint compound. Finish Rating 30 Min.
AMERICAN GYPSUM CO — Type AG-C

CGC INC — Types C, IP-X2, IPC-AR

CERTAINTEED GYPSUM INC — Type LGFC-C/A

GEORGIA-PACIFIC GYPSUM L L C — Types 5, DAPC, TG-C

NATIONAL GYPSUM CO — Types FSK-C, FSW-C

PABCO BUILDING PRODUCTS L L C, DBA PABCO GYPSUM — Type PG-C

PANEL REY S A — Type PRC

THAI GYPSUM PRODUCTS PCL — Type C

UNITED STATES GYPSUM CO — Types C, IP-X2, IPC-AR

USG BORAL DRYWALL SFZ LLC — Type C

USG MEXICO S A DE C V — Types C, IP-X2, IPC-AR

14F. **Mineral and Fiber Board —** (Optional, Not Shown) — For optional use as an additional layer on one side of wall - Nom 1/2 in. thick, 4 ft wide, square edge fiber boards applied vertically to studs on one side of the wall in between the wood studs and the UL Classified Gypsum Board (Item 3). Fiber boards installed with 1-1/4 in. long, Type W, bugle head, coarse thread gypsum board screws spaced 12 in. OC max, with the last screws spaced 2 in. and 6 in. from edge of board. Gypsum board (Item 3) installed as indicated as to fastener type and spacing, except that the required fastener length shall be increased by a minimum of 1/2 in. Not evaluated or intended as a substitute for the required layer(s) of UL Classified Gypsum Board.
BLUE RIDGE FIBERBOARD INC — SoundStop

14G. **Building Units –** (Optional Item Not Shown – For use over Gypsum Board, Item 3) 1 in., 2 in. or 3 in. thick, 4 ft. wide – Applied vertically or horizontally with vertical joints centered over studs. Fastened to studs and runners with wafer head screws of adequate length to penetrate framing by a minimum of of ¾ in., spaced a max 8 in. o.c.
NATIONAL GYPSUM CO – Type PBCI

*** Indicates such products shall bear the UL or cUL Certification Mark for jurisdictions employing the UL or cUL Certification (such as Canada), respectively.**

Last Updated on 2023-08-04

The appearance of a company's name or product in this database does not in itself assure that products so identified have been manufactured under UL Solutions' Follow - Up Service. Only those products bearing the UL Mark should be considered to be Certified and covered under UL Solutions' Follow - Up Service. Always look for the Mark on the product.

UL Solutions permits the reproduction of the material contained in Product iQ subject to the following conditions: 1. The Guide Information, Assemblies, Constructions, Designs, Systems, and/or Certifications (files) must be presented in their entirety and in a non-misleading manner, without any manipulation of the data (or drawings). 2. The statement "Reprinted from Product iQ with permission from UL Solutions" must appear adjacent to the extracted material. In addition, the reprinted material must include a copyright notice in the following format: "©2023 UL LLC."

Feedback

12/27/2023 2:43:29 PM
C:\Revit Local Files\BIM360\230304_Wilshire Hills III_Central_R23_jmeltf11c5dR.rvt

UL DESIGN - U341

UL Product iQ®

UL Solutions

Design/System/Construction/Assembly Usage Disclaimer

- Authorities Having Jurisdiction should be consulted in all cases as to the particular requirements covering the installation and use of UL Certified products, equipment, system, devices, and materials.
- Authorities Having Jurisdiction should be consulted before construction.
- Fire resistance assemblies and products are developed by the design submitter and have been investigated by UL for compliance with applicable requirements. The published information cannot always address every construction nuance encountered in the field.
- When field issues arise, it is recommended the first contact for assistance be the technical service staff provided by the product manufacturer noted for the design. Users of fire resistance assemblies are advised to consult the general Guide Information for each product category and each group of assemblies. The Guide Information includes specifics concerning alternate materials and alternate methods of construction.
- Only products which bear UL's Mark are considered Certified.

BXUV - Fire Resistance Ratings - ANSI/UL 263 Certified for United States
BXUV7 - Fire Resistance Ratings - CAN/ULC-S101 Certified for Canada

See General Information for Fire-resistance Ratings - ANSI/UL 263 Certified for United States
Design Criteria and Allowable Variances

See General Information for Fire Resistance Ratings - CAN/ULC-S101 Certified for Canada
Design Criteria and Allowable Variances

Design No. U341

August 4, 2023

Bearing Wall Rating — 1 Hr.
Finish Rating — Min 20 min.
This design was evaluated using a load design method other than the Limit States Design Method (e.g., Working Stress Design Method). For jurisdictions employing the Limit States Design Method, such as Canada, a load restriction factor shall be used — See Guide BXUV or BXUV7

*** Indicates such products shall bear the UL or cUL Certification Mark for jurisdictions employing the UL or cUL Certification (such as Canada), respectively.**

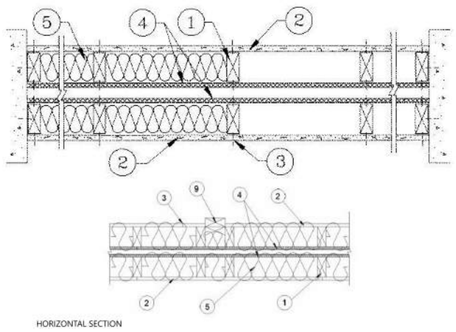

HORIZONTAL SECTION

1. **Wood Studs —** Nom 2 by 4 in., spaced 24 in. OC max. Cross braced at mid-height and effectively firestopped at top and bottom of wall. No min. air space between stud rows except to accommodate attachment of sheathing, where required. See items 4 and 5.

2. **Gypsum Board* — Any 5/8 in. thick UL Classified Gypsum Board that is eligible for use in Design Nos. L501, G512 or U305.** Nom 5/8 in. thick 4 ft wide. Gypsum board applied horizontally or vertically, unless specified below, and nailed to studs and bearing plates 7 in. OC with 6d cement coated nails, 1-7/8 in. long, 0.0915 in. shank diam and 1/4 in. diam head. As an alternate, No. 6 bugle head drywall screws, 1-7/8 in. long, may be substituted for the 6d cement coated nails.
When **Steel Framing Members*** (Item 6 or any alternate clips) are used, wallboard attached to furring channels with 1 in. long Type S bugle-head steel screws spaced 12 in. OC.

When used in widths other than 48 in., gypsum board to be installed horizontally.

AMERICAN GYPSUM CO (View Classification) — CKNX.R14196

BEIJING NEW BUILDING MATERIALS PUBLIC LTD CO (View Classification) — CKNX.R19374

CABOT MANUFACTURING ULC (View Classification) — CKNX.R25370

CERTAINTEED GYPSUM INC (View Classification) — CKNX.R3660

CGC INC (View Classification) — CKNX.R19751

CERTAINTEED GYPSUM INC (View Classification) — CKNX.R18482

GEORGIA-PACIFIC GYPSUM L L C (View Classification) — CKNX.R2717

NATIONAL GYPSUM CO (View Classification) — CKNX.R3501

Feedback

PABCO BUILDING PRODUCTS L L C, DBA PABCO GYPSUM (View Classification) — CKNX.R7094

PANEL REY S A (View Classification) — CKNX.R21796

SIAM GYPSUM INDUSTRY (SARABURI) CO LTD (View Classification) — CKNX.R19262

THAI GYPSUM PRODUCTS PCL (View Classification) — CKNX.R27517

UNITED STATES GYPSUM CO (View Classification) — CKNX.R1319

USG BORAL DRYWALL SFZ LLC (View Classification) — CKNX.R38438

USG BORAL DRYWALL SFZ LLC (View Classification) — CKNX.R38438

USG MEXICO S A DE C V (View Classification) — CKNX.R16089

2A. **Gypsum Board* —** (As an alternate to Item 2, not shown) — Nominal 5/8 in. thick, 4 ft wide panels, applied vertically to studs and bearing plates on one side of the assembly with 1-5/8 in. long Type S screws spaced 12 in. OC at perimeter of panels and 8 in. OC in the field. Horizontal joints of vertically applied panels need not be backed by studs. Panel joints covered with paper tape and two layers of joint compound. Screwheads covered with two layers of joint compound. Batts and Blankets placed in stud cavity as described in Item 5C. Not evaluated for use with Steel Framing Members, Furring Channels or Fiber, Sprayed.
PABCO BUILDING PRODUCTS L L C, DBA PABCO GYPSUM — Type QuietRock QR-530 (finish rating 23 min).

2B. **Gypsum Board* —** (As an alternate to Item 2, not shown) — Any 5/8 in. thick gypsum panels that are eligible for use in Design Nos. L501, G512 or U305, supplied by the Classified companies listed below shown in the **Gypsum Board*** (CKNX) category. Applied horizontally or vertically and attached to studs and bearing plates with 1-1/4 in. long Type W coarse thread gypsum panel steel screws spaced a max 8 in. OC, with last screw 1 in. from edge of board. When used in widths other than 48 in., gypsum board to be installed horizontally.
UNITED STATES GYPSUM CO

USG BORAL DRYWALL SFZ LLC

USG MEXICO S A DE C V

2C. **Gypsum Board* —** (As an alternate to Item 2, Not Shown) — 5/8 in. thick gypsum panels applied horizontally or vertically and attached to studs and bearing plates with 1-1/4 in. long Type W coarse thread gypsum panel steel screws spaced a max 8 in. OC, with last screw 1 in. from edge of board. When used in widths other than 48 in., gypsum board to be installed horizontally.
AMERICAN GYPSUM CO — Types AGX-1, M-Glass, AG-C, LightRoc

CERTAINTEED GYPSUM INC — Type C or Type X-1

NATIONAL GYPSUM CO — Type FSK, Type FSK-G, Type FSW, Type FSW-3, Type FSW-5, Type FSW-G, Type FSK-C, Type FSW-C, Type FSMR-C, Type FSW-6, Type FSL

THAI GYPSUM PRODUCTS PCL — Type C or Type X

2D. **Gypsum Board* —** (As an alternate to Items 2, 2A, 2B and 2C) — 5/8 in. thick gypsum panels, with square edges, applied either horizontally or vertically. Gypsum panels fastened to framing with 1-1/4 in. long Type W coarse thread gypsum panel steel screws spaced a max 8 in. OC, with last 2 screws 1 and 4 in. from edge of board or nailed as described in Item 2. When used in widths of other than 48 in., gypsum boards are to be installed horizontally.
GEORGIA-PACIFIC GYPSUM L L C — GreenGlass Type X, Type DGG.

2E. **Gypsum Board* —** (As an alternate to Items 2 through 2D) — 5/8 in. thick, 4 ft. wide, paper surfaced applied vertically only and secured as described in Item 2.
GEORGIA-PACIFIC GYPSUM L L C — Type X ComfortGuard Sound Deadening Gypsum Board.

2F. **Gypsum Board* —** (As an alternate to Items 2 through 2E) - Installed as described in Item 2. 5/8 in. thick, 4 ft. wide, paper surfaced, applied vertically only and fastened to the studs and plates with 6d cement coated nails 1-7/8 in. long, 0.0915 in. shank diam and 1/4 in. diam heads, 7 in. OC. Not for use with item #6.
NATIONAL GYPSUM CO — Type SBWB

2G. **Gypsum Board* —** (As an alternate to Items 2 through 2F) — Nominal 5/8 in. thick, 4 ft wide panels, applied vertically and secured as described in Item 2.
PABCO BUILDING PRODUCTS L L C, DBA PABCO GYPSUM — Types QuietRock ES.

2H. **Gypsum Board* —** (As an alternate to Items 2 through 2G) — Installed as described in Item 2. 5/8 in. thick, 4 ft. wide, paper surfaced, applied vertically or horizontally fastened to the studs and plates with 1-1/4 in. long Type W coarse thread gypsum panel steel screws spaced a max 12 in. OC.
CERTAINTEED GYPSUM INC — Type SilentFX

2I. **Wall and Partition Facings and Accessories* —** (As an alternate to Items 2 through 2H) — Nominal 5/8 in. thick, 4 ft wide panels, applied vertically and secured as described in Item 2.
PABCO BUILDING PRODUCTS L L C, DBA PABCO GYPSUM — Type QuietRock 527.

2J. **Gypsum Board* —** (As an alternate to 5/8 in. Type FSW in Item 2) — 2 layers nom. 5/16 in. thick gypsum panels applied vertically or horizontally. Horizontal joints on the same side need not be staggered. Inner layer attached with fasteners, as described in item 2, spaced 24 in. OC. Outer layer attached per Item 2.
NATIONAL GYPSUM CO — Type FSW.

2K. **Gypsum Board* —** (As an alternate to Item 2) — 5/8 in. thick gypsum panels, with beveled, square, or tapered edges, applied either horizontally or vertically. Gypsum panels fastened to framing with 1-1/4 in. long Type W coarse thread gypsum panel steel screws spaced a maximum 10 in. OC with the last two screws 4 and 1 in. from the edges of the board. When used in widths other than 48 in., gypsum panels are to be installed horizontally.
CERTAINTEED GYPSUM INC — Type LGFC6A (finish rating 21 min), Type LGFC2A, Type LGFC-C/A, Type LGFC-WD, Type LGLLX

3. **Joints and Nailheads —** Gypsum board joints of outer layer covered with tape and joint compound. Nail heads of outer layer covered with joint compound. As an alternate, nom 3/32 in. thick gypsum veneer plaster may be applied to the entire surface of Classified veneer baseboard with joints reinforced with paper tape.

4. **Sheathing —** (Optional) — Septum may be sheathed with min 7/16 in. thick wood structural panels min grade "C-D" or "Sheathing" or min 1/2 in. thick **Mineral and Fiber Boards***.
See **Mineral and Fiber Boards** (CERZ) category for names of Classified companies.

5. **Batts and Blankets* —** 3-1/2 in. max thickness glass or mineral fiber batt insulation. **Optional** when sheathing (Item 4) is used on both halves of wall.
See **Batts and Blankets** (BZJZ) category for list of Classified companies.

5A. **Fiber, Sprayed* —** As an alternate to Batts and Blankets (Item 5) — Spray applied cellulose material. The fiber is applied with water to completely fill the enclosed cavity in accordance with the application instructions supplied with the product with a nominal dry density of 2.7 lb/ft^3. Alternate Application Method: The fiber is applied without water or adhesive at a nominal dry density of 3.5 lb/ft^3, in accordance with the application instructions supplied with the product.

Applegate Greenfiber Acquisition LLC — Insulmax and SANCTUARY for use with wet or dry application. INS515LD and INS541LD are to be used for dry application only.

5B. **Fiber, Sprayed* —** As an alternate to Batts and Blankets (Item 5) when Sheathing (Item 4) is used on both halves of wall - Spray applied cellulose insulation material. The fiber is applied with water to interior surfaces in accordance with the application instructions

Feedback

PRINTS ISSUED
10/30/23 PERMIT SUBMITTAL

REVISIONS:

rosemann & ASSOCIATES P.C.
ARCHITECTURE
INTERIOR DESIGN
ENGINEERING
PLANNING
1526 Grand Boulevard
Kansas City, MO 64108-1404
p: 816.472.1448
w: www.rosemann.com
© 2023 Rosemann & Associates, P.C.
DENVER ▲ KANSAS CITY ▲ ST. LOUIS ▲ ATLANTA

STATE OF MISSOURI
DAVID EUGENE HENDRIKSE
NUMBER A-7365
REGISTERED ARCHITECT
10/30/23

WILSHIRE HILLS III

LEE'S SUMMIT, MISSOURI

MHDC - 22-057

SHEET TITLE
UL ASSEMBLIES

PROJECT NUMBER: 23034

SHEET NUMBER:

G-201

UL DESIGN - U341 - CONT.

supplied with the product. Applied to completely fill the enclosed cavity. Minimum dry density of 4.3 pounds per cubic ft.
NU-WOOL CO INC — Cellulose Insulation

5C. **Batts and Blankets* —** (Required for use with Wall and Partition Facings and Accessories, Item 2A. Use of Sheathing, Item 4, does not nullify requirement of Item 5C for use with Item 2A) — Glass fiber insulation, nom 3-1/2 in. thick, min. density of 0.80 pcf, with a flame spread of 25 or less and a smoke developed of 50 or less, friction-fitted to completely fill the stud cavities. See Batts and Blankets Category (BKNV) for names of manufacturers.

5D. **Fiber, Sprayed* —** As an alternate to Batts and Blankets (Item 5) and Item 5A when Sheathing (Item 4) is used on both halves of wall - Spray applied cellulose fiber. The fiber is applied with water to completely fill the enclosed cavity in accordance with the application instructions supplied with the product. The minimum dry density shall be 4.30 lbs/ft^3.
INTERNATIONAL CELLULOSE CORP — Celbar-RL

5E. Deleted.

6. **Steel Framing Members* —** (Optional, Not Shown) — Furring channels and Steel Framing Members as described below:
A. **Furring Channels —** Formed of No. 25 MSG galv steel. 2-9/16 in. or 2-23/32 in. wide by 7/8 in. deep, spaced 24 in. OC perpendicular to studs. Channels secured to studs as described in Item b. Ends of adjoining channels are overlapped 6 in. and tied together with double strand of No. 18 SWG galv steel wire near each end of overlap. As an alternate, ends of adjoining channels may be overlapped 6 in. and secured together with two self-tapping #6 framing screws, min. 7/16 in. long at the midpoint of the overlap, with one screw on each flange of the channel. Wallboard attached to furring channels as described in Item 2.

B. **Steel Framing Members* —** Used to attach furring channels (Item a) to studs (Item 1) . Clips spaced 48 in. OC., and secured to studs with No. 8 x 2-1/2 in. coarse drywall screw through the center grommet. Furring channels are friction fitted into clips. RSIC-1 clip for use with 2-9/16 in. wide furring channels. RSIC-1 (2.75) clip for use with 2-23/32 in. wide furring channels.
PAC INTERNATIONAL L L C — Types RSIC-1, RSIC-1 (2.75).

6A. **Steel Framing Members* —** (Optional, Not Shown, As an alternate to Item 6) — Furring channels and Steel Framing Members as described below:
a. **Furring Channels —** Formed of No. 25 MSG galv steel. 2-3/8 in. wide by 7/8 in. deep, spaced 24 in. OC perpendicular to studs. Channels secured to studs as described in Item b. Ends of adjoining channels are overlapped 6 in. and tied together with double strand of No. 18 SWG galv steel wire near each end of overlap. As an alternate, ends of adjoining channels may be overlapped 6 in. and secured together with two self-tapping #6 framing screws, min. 7/16 in. long at the midpoint of the overlap, with one screw on each flange of the channel. Gypsum board attached to furring channels as described in Item 2.

b. **Steel Framing Members* —** Used to attach furring channels (Item a) to studs. Clips spaced 48 in. OC. Genie clips secured to studs with No. 8 x 1-1/2 in. coarse drywall screw through the center hole. Furring channels are friction fitted into clips.
PLITEQ INC — Type Genie Clip

6B. **Steel Framing Members* —** (Optional, Not Shown, As an alternate to Item 6) — Furring channels and Steel Framing Members as described below:
a. **Furring Channels —** Formed of No. 25 MSG galv steel. Spaced 24 in. OC perpendicular to studs. Channels secured to studs as described in Item b. Ends of adjoining channels overlapped 6 in. and tied together with double strand of No. 18 AWG galvanized steel wire. Gypsum board attached to furring channels as described in Item 2.

b. **Steel Framing Members* —** Used to attach furring channels (Item 6Ba) to studs. Clips spaced 48 in. OC., and secured to studs with 2 in. coarse drywall screw with 1 in. diam washer through the center hole. Furring channels are friction fitted into clips.
STUDCO BUILDING SYSTEMS — RESILMOUNT Sound Isolation Clips - Type A237R

6C. **Steel Framing Members* —** (Optional, Not Shown, As an alternate to Item 6) — Furring channels and Steel Framing Members as described below:
A. **Furring Channels —** Formed of No. 25 MSG galv steel. Spaced 24 in. OC perpendicular to studs. Channels secured to studs as described in Item 6Cb. Ends of adjoining channels overlapped 6 in. and tied together with double strand of No. 18 AWG galvanized steel wire. Gypsum board attached to furring channels as described in Item 2.

B. **Steel Framing Members* —** Used to attach furring channels (Item 6CA) to studs. Clips spaced 48 in. OC., and secured to studs with No. 8 x 2-1/2 in. coarse drywall screw through the center hole. Furring channels are friction fitted into clips.
REGUPOL AMERICA — Type SonusClip

6D. **Steel Framing Members* —** (Optional, Not Shown, As an alternate to Item 6) — Resilient channels and Steel Framing Members as described below:
a. **Resilient Channels —** Formed of No. 25 MSG galv steel, spaced 24 in. OC, and perpendicular to studs. Channels secured to studs as described in Item b. Ends of adjoining channels overlapped 6 in. and secured in place with two No. 8 15 x 1/2 in. Philips Modified Truss screws spaced 2-1/2 in. from the center of the overlap. Gypsum board attached to resilient channels as described in Item 2.

b. **Steel Framing Members* —** Used to attach resilient channels (Item 6Da) to studs. Clips spaced 48 in. OC., and secured to studs with No. 8 x 2-1/2 in. coarse drywall screw through the center hole. Resilient channels are secured to clips with one No. 10 x 1/2 in. pan-head self-drilling screw.
KEENE BUILDING PRODUCTS CO INC — Type RC+ Assurance Clip

6E. **Steel Framing Members* —** (Optional, Not Shown) — Resilient channels and Steel Framing Members as described below:
a. **Resilient Channels —**Formed of No. 25 MSG galv steel, spaced 24 in. OC, and perpendicular to studs. Channels secured to studs as described in Item b. Gypsum board attached to resilient channels as described in Item 2.

b. **Steel Framing Members*** - Used to attach resilient channels to wall studs. A resilient sound isolation accessory shall be used at each attachment point of the resilient channels to the studs. Channel ends butted and centered under the structural members and attached with one accessory at each end. Additional accessories used to hold resilient channels that support the gypsum board end joints. The accessory envelops the mounting edge of the resilient channel. The accessory and resilient channel are fastened to the studs with the screws supplied with the accessory and per the accessory manufacturer's installation instructions.

PAC INTERNATIONAL L L C — Type RC-1 Boost

6F **Steel Framing Members* —** (Optional, Not Shown, As an alternate to Item 6) — Furring channels and Steel Framing Members as described below:
a **Furring Channels —** Formed of No. 25 MSG galv steel. 2-23/32 in. wide by 7/8 in. deep, spaced 24 in. OC perpendicular to studs. Channels secured to studs as described in Item b. Ends of adjoining channels are overlapped 6 in. and tied together with double strand of No. 18 SWG galv steel wire near each end of overlap. As an alternate, ends of adjoining channels may be overlapped 6 in. and secured together with two self-tapping #6 framing screws, min. 7/16 in. long at the midpoint of the overlap, with one screw on each flange of the channel. Gypsum board attached to furring channels as described in Item 2.

b **Steel Framing Members* —** Used to attach furring channels (Item 6Fa) to studs. Clips spaced maximum 48 in. OC. Clips secured to studs with No. 8 x 2-1/2 in. coarse drywall screw through the center grommet. Furring channels are friction fitted into clips.

CLARKDIETRICH BUILDING SYSTEMS — Type ClarkDietrich Sound Clip

7. **Wall and Partition Facings and Accessories* —** (Optional, Not shown) — Nominal 1/2 in. thick, 4 ft wide panels, for optional use as an additional layer on one or both sides of the assembly. Panels attached in accordance with manufacturer's recommendations. When the QR-500 or QR-510 panel is installed between the wood framing and the UL Classified gypsum board, the required UL Classified gypsum board layer(s) is/are to be installed as indicated as to fastener type and spacing, except that the required fastener length shall be increased by a minimum of 1/2 in. Not evaluated or intended as a substitute for the required layer(s) of UL Classified Gypsum Board.
PABCO BUILDING PRODUCTS L L C, DBA PABCO GYPSUM — Type QuietRock QR-500 and QR-510

8. **Mineral and Fiber Board* —** ((Optional, Not Shown) — For optional use as an additional layer on one or both sides of wall. Nom 1/2 in. thick, 4 ft wide with long dimension parallel and centered over studs. Attached to framing as described in Item 2. The required UL Classified gypsum board layer(s) is/are to be installed as indicated as to fastener type and spacing, except that the required fastener length shall be increased by a minimum of 1/2 in. Not evaluated or intended as a substitute for the required layer(s) of UL Classified Gypsum Board.
HOMASOTE CO — Homasote Type 440-32

9. **Non-Bearing Wall Partition Intersection —** (Optional) — Two nominal 2 by 4 in. stud or nominal 2 by 6 in. stud nailed together with two 3in. long 10d nails spaced a max. 16 in. OC. vertically and fastened to one side of the minimum 2 by 4 in. stud with 3 in. long 10d nails spaced a max 16 in. OC. vertically. Intersection between partition wood studs to be flush with the 2 by 4 in. studs. The wall partition wood studs are to be framed by with a second 2 by 4 in. wood stud fastened with 3 in. long 10d nails spaced a max. 16 in. OC. vertically. Maximum one non-bearing wall partition intersection per stud cavity. Non-bearing wall partition stud depth shall be at a minimum equal to the depth of the bearing wall.

(Optional, Not Shown) Alternate Construction For Use On One Side Of The Wall.

10. **Mineral and Fiber Board* —** For use with Items 10A-10D) —Nom 1/2 in. thick, 4 ft wide with long dimension parallel and centered over studs. Attached to framing with minimum 1-3/8 in. long ring shanked nails or 1-1/4 in. long Type W steel screws, spaced 12 in. OC along board edges and 24 in. OC in field of board along intermediate framing. Not evaluated or intended as a substitute for the required layer(s) of UL Classified Gypsum Board.
HOMASOTE CO — Homasote Type 440-32

10A. **Glass Fiber Insulation —** (For use with Item 10) — 3-1/2 in. thick glass fiber batts bearing the UL Classification Marking as to Surface Burning and/or Fire Resistance, placed to fill the interior of the wall. See Batts and Blankets (BKNV or BZJZ) categories for names of Classified companies.

10B. **Batts and Blankets* —** (As an alternate to Item 10B, For use with Item 10), 3 in. thick mineral wool batts, placed to fill interior of wall, attached to the 3-1/2 in. face of the studs with staples placed 24 in. OC.
THERMAFIBER INC — Type SAFB, SAFB FF

10C. **Adhesive —** (For use with Item 10) — Construction grade adhesive applied in vertical, serpentine, nominal 3/8 in. wide beads down the length of both vertical edges of Mineral and Fiber Board (Item 14A).

10D. **Gypsum Board* —** (For use with Item 10) — 5/8 in. thick, 4 ft wide, applied vertically over Mineral and Fiber Board (Item 14A) with vertical joints located anywhere over stud cavities. Secured to mineral and fiber boards with 1-1/2 in. Type G Screws spaced 8 in. OC along edges of each vertical joint and 12 in. OC in intermediate field of the Mineral and Fiber Board (Item 10). Secured to outermost studs and bearing plates with 2 in. long Type S screws spaced 8 in. OC. Gypsum Board joints covered with paper tape and joint compound. Screw heads covered with joint compound. Finish Rating 30 Min.
AMERICAN GYPSUM CO — Type AG-C

CERTAINTEED GYPSUM INC — Type C

CERTAINTEED GYPSUM INC — Type LGFC-C/A

GEORGIA-PACIFIC GYPSUM L L C — Types 5, DAPC, TG-C

NATIONAL GYPSUM CO — Types FSK-C, FSW-C

PABCO BUILDING PRODUCTS L L C, DBA PABCO GYPSUM — Type PG-C

PANEL REY S A — Type PRC

THAI GYPSUM PRODUCTS PCL — Type C

UNITED STATES GYPSUM CO — Type CTypes C, IP-X2, IPC-AR

USG BORAL DRYWALL SFZ LLC — Type C

USG MEXICO S A DE C V — Types C, IP-X2, IPC-AR

*** Indicates such products shall bear the UL or cUL Certification Mark for jurisdictions employing the UL or cUL Certification (such as Canada), respectively.**

Last Updated on 2023-08-04

The appearance of a company's name or product in this database does not in itself assure that products so identified have been manufactured under UL Solutions' Follow - Up Service. Only those products bearing the UL Mark should be considered to be Certified and covered under UL Solutions' Follow - Up Service. Always look for the Mark on the product.

UL Solutions permits the reproduction of the material contained in Product iQ subject to the following conditions: 1. The Guide Information, Assemblies, Constructions, Designs, Systems, and/or Certifications (files) must be presented in their entirety and in a non-misleading manner, without any manipulation of the data (or drawings). 2. The statement "Reprinted from Product iQ with permission from UL Solutions" must appear adjacent to the extracted material. In addition, the reprinted material must include a copyright notice in the following format: "©2023 UL LLC."

10/27/2023 2:53:28 PM
C:\Revit Local Cache\23034_Wilshire Hills III_Central_R23_mwRTUCAR.rvt

UL DESIGN - L516

UL Product **iQ**®

UL Solutions

Design/System/Construction/Assembly Usage Disclaimer

- Authorities Having Jurisdiction should be consulted in all cases as to the particular requirements covering the installation and use of UL Certified products, equipment, system, devices, and materials.
- Authorities Having Jurisdiction should be consulted before construction.
- Fire resistance assemblies and products are developed by the design submitter and have been investigated by UL for compliance with applicable requirements. The published information cannot always address every construction nuance encountered in the field.
- When field issues arise, it is recommended the first contact for assistance be the technical service staff provided by the product manufacturer noted for the design. Users of fire resistance assemblies are advised to consult the general Guide Information for each product category and each group of assemblies. The Guide Information includes specifics concerning alternate materials and alternate methods of construction.
- Only products which bear UL's Mark are considered Certified.

BXUV - Fire Resistance Ratings - ANSI/UL 263 Certified for United States

BXUV7 - Fire Resistance Ratings - CAN/ULC-S101 Certified for Canada

See General Information for Fire-resistance Ratings - ANSI/UL 263 Certified for United States
Design Criteria and Allowable Variances

See General Information for Fire Resistance Ratings - CAN/ULC-S101 Certified for Canada
Design Criteria and Allowable Variances

Design No. **L516**

July 11, 2023

Unrestrained Assembly Rating — 1 Hr.
Finish Rating — 28 Min. or (16 Min. See Item 7B)
This design was evaluated using a load design method other than the Limit States Design Method (e.g., Working Stress Design Method). For jurisdictions employing the Limit States Design Method, such as Canada, a load restriction factor shall used — See Guide BXUV or BXUV7

*** Indicates such products shall bear the UL or cUL Certification Mark for jurisdictions employing the UL or cUL Certification (such as Canada), respectively.**

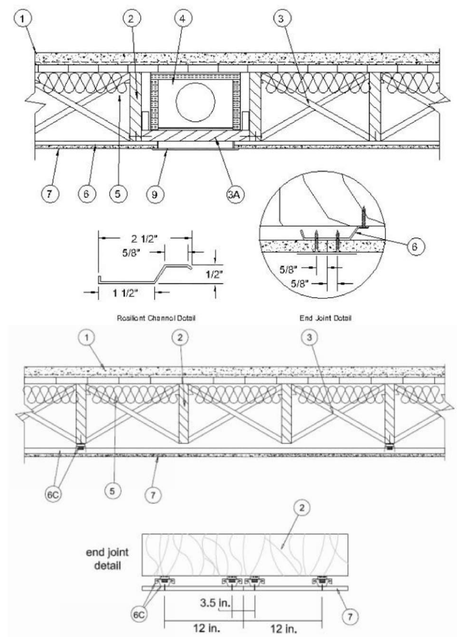

1. **Flooring System —** The flooring system shall consist of one of the following:
System No. 1

Subflooring — Min 1 by 6 in. T & G lumber fastened diagonally to joists, or min 15/32 in. thick plywood or min 7/16 in. thick oriented strand board (OSB) wood structural panels, min grade "C-D" or "Sheathing". Face grain of plywood or strength axis of panel to be perpendicular to joists with joints staggered.

Wire Reinforcement — Hexagonal mesh constructed of No. 19 SWG galv steel wire with No. 16 SWG galv steel wire woven longitudinally into the mesh spaced 3 in. OC. Mesh installed with No. 16 SWG wires perpendicular to joists and lapped 5 in. at the sides.

Sheathing Material* — Polyethylene film vapor barrier.

See **Sheathing Materials** (BVDV) Category in the Building Materials Directory for names of manufacturers.

Finish Flooring Perlite Concrete — Min 1-5/8 in. thickness of perlite-sand concrete, having a min compressive strength of 2000 psi. Mixture shall consist of 1 part Portland cement, 2 parts sand and 3 parts **Perlite Aggregate***.

See **Perlite Aggregate** (CFFX) category for names of manufacturers.

System No. 2

Subflooring — Min 1 by 6 in. T & G lumber fastened diagonally to joists, or min 15/32 in. thick plywood or min 7/16 in. thick oriented strand board (OSB) wood structural panels, min grade "C-D" or "Sheathing". Face grain of plywood or strength axis of panel to be perpendicular to joists with joints staggered.

Mineral and Fiber Board* — Min 1/2 in. thick, supplied in sizes ranging from 3 ft by 4 ft to 8 ft by 12 ft. All joints to be staggered a min of 12 in with adjacent sub-floor joints.

HOMASOTE CO — Type 440-32 Mineral and Fiber Board

System No. 3

Subflooring — Min 1 by 6 in. T & G lumber fastened diagonally to joists, or min 15/32 in. thick plywood or min 7/16 in. thick oriented strand board (OSB) wood structural panels, min grade "C-D" or "Sheathing". Face grain of plywood or strength axis of panel to be perpendicular to joists with joints staggered.

Floor Mat Materials* — (Optional) — Floor mat material nom 5/64 in. (2mm) thick adhered to subfloor with Hacker Floor Primer. Primer to be applied to the surface of the mat prior to the placement of a min 1 in. of floor-topping mixture.

HACKER INDUSTRIES INC — Type Hacker Sound-Mat.

Alternate Floor Mat Materials - (Optional) — Floor mat material nom 1/4 in. (6mm) thick adhered to subfloor with Hacker Floor Primer. Primer to be applied to the surface of the mat prior to the placement of a min 1-1/4 in. (32mm) of floor-topping mixture.

HACKER INDUSTRIES INC — Type Hacker Sound-Mat II.

Alternate Floor Mat Materials - (Optional) — Floor mat material nom 1/8 in. (3mm) thick loose laid over the subfloor. Floor topping thickness shall be a min of 3/4 in. (19mm)

HACKER INDUSTRIES INC — FIRM-FILL SCM 125

Alternate Floor Mat Materials - (Optional) — Floor mat material nom 1/4 in. (6mm) thick loose laid over the subfloor. Floor topping thickness shall be a min of 1 in. (25mm)

HACKER INDUSTRIES INC — Type FIRM-FILL SCM 250, Quiet Qurl 55/025

Alternate Floor Mat Materials - (Optional) — Floor mat material nom 3/8 in. (10mm) thick loose laid over the subfloor. Floor topping thickness shall be a min of 1-1/4 in. (32mm)

HACKER INDUSTRIES INC — FIRM-FILL SCM 400, Quiet Qurl 60/040

Alternate Floor Mat Materials - (Optional) — Floor mat material nom 3/4 in. (19mm) thick loose laid over the subfloor. Floor topping thickness shall be a min of 1-1/2 in. (38mm)

HACKER INDUSTRIES INC — Type FIRM-FILL SCM 750, Quiet Qurl 65/075

Metal Lath (Optional) — For use with 3/8 in. (10 mm) floor mat materials, 3/8 in. expanded steel diamond mesh, 3.4 lbs/sq yd placed over the floor mat material. Hacker Floor Primer to be applied prior to the placement of the metal lath. When metal lath is used, floor topping thickness is nom 1-1/4 in. over the floor mat.

Finish Flooring - Floor Topping Mixture* — Min 3/4 in. thickness of floor topping mixture having a min compressive strength of 1100 psi. Mixture shall consist of 6.8 gal of water to 80 lbs of floor topping mixture to 1.9 cu ft of sand.

HACKER INDUSTRIES INC — Type Firm-Fill Gypsum Concrete, Firm-Fill 2010, Firm-Fill 4010, Firm-Fill High Strength, Gyp-Span Radiant, Firm-Fill 3310

System No. 4

Subflooring — Min 1 by 6 in. T & G lumber fastened diagonally to joists, or min 15/32 in. thick plywood or min 7/16 in. thick oriented strand board (OSB) wood structural panels, min grade "C-D" or "Sheathing". Face grain of plywood or strength axis of panel to be perpendicular to joists with joints staggered.

Finish Flooring - Floor Topping Mixture* — Min 3/4 thickness of floor topping mixture having a minimum compressive strength of 1500 psi. Refer to manufacturer's instructions accompanying the material for specific mix design.

MAXXON CORP — Type Maxxon Standard and Maxxon High Strength

Floor Mat Materials* - (Optional) — Floor mat material loose laid over the subfloor. Refer to manufacturer's instructions regarding the minimum thickness of floor topping over each floor mat material.

MAXXON CORP — Type Encapsulated Sound Mat.

Floor Mat Reinforcement - (Optional) - Refer to manufacturer's instructions regarding minimum thickness of floor topping for use with floor mat reinforcement.

Metal Lath (Optional) — 3/8 in. expanded galvanized steel diamond mesh, 3.4 lbs/sq yd loose laid over the floor mat material.

Fiber Glass Reinforcement - (Optional, Not Shown) - 0.015 in. thick PVC coated non-woven fiberglass mesh, 0.368 lbs/sq yd loose laid over the floor mat material.

System No. 5

Subflooring — Min 1 by 6 in. T & G lumber fastened diagonally to joists, or min 15/32 in. thick plywood or min 7/16 in. thick oriented strand board (OSB) wood structural panels, min grade "C-D" or "Sheathing". Face grain of plywood or strength axis of panel to be perpendicular to joists with joints staggered.

Vapor Barrier — (Optional) Nom 0.010 in. thick commercial rosin-sized building paper.

Finish Flooring — Floor Topping Mixture* — Min 3/4 in. thickness of floor topping mixture having a min compressive strength of 1000 psi. Refer to manufacturer's instructions accompanying the material for specific mix design.

FORMULATED MATERIALS LLC — Types FR-25, FR-30, and SiteMix

Floor Mat Material* — (Optional) Floor mat material nominal 2 - 9.5 mm thick loose laid over the subfloor. Floor topping shall be a min of 3/4

FORMULATED MATERIALS LLC — Types M1, M2, M3, Elite, Duo, R1, and R2

System No. 6

Subflooring — Min 1 by 6 in. T & G lumber fastened diagonally to joists, or min 15/32 in. thick plywood or min 7/16 in. thick oriented strand board (OSB) wood structural panels, min grade "C-D" or "Sheathing". Face grain of plywood or strength axis of panel to be perpendicular to joists with joints staggered.

Vapor Barrier — (Optional) - Nom 0.010 in. thick commercial asphalt saturated felt.

Finish Flooring - Floor Topping Mixture* - — Min 3/4 in. thickness of floor topping mixture having a minimum compressive strength of 1800 psi. Refer to manufacturer's instructions accompanying the material for specific mix design.

UNITED STATES GYPSUM CO — Types LRK, HSLRK, CSD

USG MEXICO S A DE C V — Types LRK, HSLRK, CSD

PRINTS ISSUED
10/30/23 PERMIT SUBMITTAL

REVISIONS:

rosemann & ASSOCIATES P.C.
ARCHITECTURE
INTERIOR DESIGN
ENGINEERING
PLANNING
1526 Grand Boulevard
Kansas City, MO 64108-1404
p: 816.472.1448
w: www.rosemann.com
© 2023 Rosemann & Associates, P.C.
DENVER ◀ KANSAS CITY ▲ ST. LOUIS ▲ ATLANTA

STATE OF MISSOURI
DAVID EUGENE HENDRIKS
NUMBER A-7365
REGISTERED ARCHITECT
10/30/23

WILSHIRE HILLS III
LEE'S SUMMIT, MISSOURI
MHDC - 22-057

SHEET TITLE
UL ASSEMBLIES

PROJECT NUMBER: 23034

SHEET NUMBER:

G-202

UL DESIGN - L516 - CONT.

Floor Mat Materials* — (Optional) — Floor mat material loose laid over the subfloor. Refer to manufacturer's instructions regarding the minimum thickness of floor topping over each floor mat material.

UNITED STATES GYPSUM CO — Types SAM, LEVELROCK® Brand Sound Reduction Board, LEVELROCK® Brand Floor Underlayment SRM-25

Alternate Floor Mat Materials* — (Optional) - Nom 3/8 in. thick floor mat material loose laid over the subfloor.

GRASSWORX L L C — Type SC50

System No. 7

Subflooring — Min 15/32 in. thick wood structural panels, min grade "C-D" or "Sheathing". Face grain of plywood or strength axis of panels to perpendicular to the joists with joints staggered.

Vapor Barrier — (Optional) - Commercial asphalt saturated felt, 0.030 in. thick.

Vapor Barrier — (Optional) - Nom 0.010 in. thick commercial rosin-sized building paper.

Finish Flooring* — Min 3/4 in. thickness of any Floor Topping Mixture bearing the UL Classification Marking as to Fire Resistance. See Floor- an Roof-Topping Mixtures (CCOX) category for names of Classified Companies. Refer to the manufacturer's instructions accompanying the material and/or contact the manufacturer's technical support for specific mix design and minimum thickness recommended for use with eligible floor mat(s).

Floor Mat Materials* — (Optional) - Nom. 1/4 in. thick loose laid over the subfloor. Floor topping thickness shall be a minimum of 3/4 in.

KEENE BUILDING PRODUCTS CO INC — Type Quiet Qurl 55/025 and Quiet Qurl 55/025 N

Alternate Floor Mat Materials* — (Optional) - Floor mat material Nom. 3/8 in. thick loose laid over the subfloor. Floor topping thickness shall a minimum of 1 in.

KEENE BUILDING PRODUCTS CO INC — Type Quiet Qurl 60/040 and Quiet Qurl 60/040 N

Alternate Floor Mat Materials* — (Optional) - Floor mat material Nom. 3/4 in. thick loose laid over the subfloor. Floor topping thickness shall a minimum of 1-1/2 in.

KEENE BUILDING PRODUCTS CO INC — Type Quiet Qurl 65/075, Quiet Qurl 65/075 N

Alternate Floor Mat Materials* — (Optional) - Floor mat material Nom. 1/8 in. thick loose laid over the subfloor. Floor topping thickness shall a minimum of 3/4 in.

KEENE BUILDING PRODUCTS CO INC — Type Quiet Qurl 52/013 and Quiet Qurl 52/013 N

Alternate Floor Mat Materials* — (Optional) - Floor mat material Nom. 1/4 in. entangled net core with a compressible fabric attached to the bottom loose laid over the subfloor. Floor topping thickness shall be a minimum of 1 in.

KEENE BUILDING PRODUCTS CO INC — Quiet Qurl 55/025 MT and Quiet Qurl 55/025 N MT

System No. 8

Subflooring — Min 1 by 6 in. T & G lumber fastened diagonally to joists, or min 15/32 in. thick plywood or min 7/16 in. thick oriented strand board (OSB) wood structural panels, min grade "C-D" or "Sheathing". Face grain of plywood or strength axis of panel to be perpendicular to joists with joints staggered.

Vapor Barrier - (Optional) — Nom 0.010 in. thick commercial rosin-sized building paper.

Finish Flooring - Floor Topping Mixture* — Min 3/4 in. thickness of floor topping mixture having a min compressive strength of 1000 psi. Ref to manufacturer's instructions accompanying the material for specific mix design.

ARCOSA SPECIALTY MATERIALS — AccuCrete® Types NexGen, Green, Prime and PrePour, AccuRadiant®, AccuLevel® Types G40, G50 and SC

Floor Mat Material* — (Optional) - Floor mat material nominal 2 - 9.5 mm thick loose laid over the subfloor. Floor topping shall be a min of 3/4 in.

ARCOSA SPECIALTY MATERIALS — AccuQuiet Types D13, D-18, D25, DX38, EM.125, EM.125S, EM.250, EM.250S, EM.375, EM.375S, EM.750, and EM.750S.

System No. 9

Subflooring — Min 23/32 in. thick T&G wood structural panels, min grade "Underlayment" or "Single-Floor". Face grain of plywood or strength axis of panels to be perpendicular to the trusses with end joints staggered 4 ft. Panels secured to trusses with construction adhesive and No. 6d ringed shank nails spaced 12 in. OC along each truss. Staples having equal or greater withdrawal and lateral resistance strength may be substituted for the 6d nails.

Gypsum Board* — One layer of nom 5/8 in. thick, 4 ft wide gypsum board, installed with long dimension perpendicular to joists. Gypsum board secured with 1 in. long No. 6 Type W bugle head steel screws spaced 12 in. OC and located a min of 1-1/2 in. from side and end joints. The joint of the gypsum board are to be staggered a minimum of 12 inches from the joints of the subfloor.

GEORGIA-PACIFIC GYPSUM L L C — Type DS

Floor Mat Materials* — (As an alternate to the single layer gypsum board) - Floor mat material loose laid over the subfloor.

MAXXON CORP — Type Encapsulated Sound Mat.

Gypsum Board* — (For use when floor mat is used) Two layers of nom 5/8 in. thick, 4 ft wide gypsum board, installed with long dimension perpendicular to joists on top of the floor mat material. Gypsum board secured to each other with 1 in. long No. 6 Type G bugle head steel screws spaced 12 in. OC and located a min of 1-1/2 in. from side and end joints. The joints of the gypsum board are to be staggered a minimum of 12 inches in between layers and from the joints of the subfloor.

GEORGIA-PACIFIC GYPSUM L L C — Type DS

System No. 10

Subflooring — Min 15/32 in. thick wood structural panels, min grade "C-D" or "Sheathing". Face grain of plywood or strength axis of panels to be perpendicular to the joists with joints staggered.

Vapor Barrier — (Optional) — Nom 0.030 in. thick commercial asphalt saturated felt.

Finish Flooring — Floor Topping Mixture* — Min 3/4 or 1 in. thickness of floor topping mixture for 19/32 or 15/32 in. thick wood structural panels respectively, having a min compressive strength of 1000 psi. Refer to manufacturer's instructions accompanying the material for specific mix design.
DEPENDABLE LLC — Types GSL M3.4, GSL K2.6, GSL-CSD and GSL RH

Floor Mat Materials* — (Optional) — Nom. 1/4 in. thick loose laid over the subfloor. Floor topping thickness shall be a minimum of 3/4 in.
KEENE BUILDING PRODUCTS CO INC — Types Quiet Qurl 55/025 and Quiet Qurl 55/025 N

Alternate Floor Mat Materials* — (Optional) — Floor mat material Nom. 3/8 in. thick loose laid over the subfloor. Floor topping thickness shall be a minimum of 1 in.
KEENE BUILDING PRODUCTS CO INC — Types Quiet Qurl 60/040 and Quiet Qurl 60/040 N

Alternate Floor Mat Materials* — (Optional) — Floor mat material Nom. 3/4 in. thick loose laid over the subfloor. Floor topping thickness shall be a minimum of 1-1/2 in.
KEENE BUILDING PRODUCTS CO INC — Types Quiet Qurl 65/075, Quiet Qurl 65/075 N

Alternate Floor Mat Materials* — (Optional) — Floor mat material Nom. 1/8 in. thick loose laid over the subfloor. Floor topping thickness shall be a minimum of 3/4 in.
KEENE BUILDING PRODUCTS CO INC — Types Quiet Qurl 52/013 and Quiet Qurl 52/013 N

Alternate Floor Mat Materials* — (Optional) — Floor mat material Nom. 1/4 in. entangled net core with a compressible fabric attached to the bottom loose laid over the subfloor. Floor topping thickness shall be a minimum of 1 in.
KEENE BUILDING PRODUCTS CO INC — Types Quiet Qurl 55/025 MT and Quiet Qurl 55/025 N MT

System No. 11

Subflooring — Min 1 by 6 in. T & G lumber fastened diagonally to joists, or min 15/32 in. thick plywood or min 7/16 in. thick oriented strand board (OSB) wood structural panels, min grade "C-D" or "Sheathing". Face grain of plywood or strength axis of panel to be perpendicular to joists with joints staggered.

Finish Flooring* — Floor Topping Materials — Min 3/4 in. to 1-1/2 in. thickness of any Floor Topping Mixture bearing the UL Classification Marking as to Fire Resistance with a minimum compressive strength of 1500 psi.
See **Floor- and Roof-Topping Mixtures** (CCOX) category for names of Classified Companies.

Floor Mat Materials* — (Optional) — Floor mat material nom 1/8 in. to 3/4 in. thick. Loose laid over the subfloor. When used, Acousti-flor CSM (crack suppression mat) is loose laid over the floor mat material. Floor topping material thickness is dependent on thickness of floor mat used.
WALFLOR INDUSTRIES INC — Type Acousti-flor, Acousti-flor CSM. Floor topping thickness depends on products used as follows:

Acousti-flor (1/8 in. thick) - Floor topping thickness shall be a minimum of 3/4 in.

Acousti-flor (1/4 in. thick) - Floor topping thickness shall be a minimum of 1 in.

Acousti-flor (3/8 in. thick) - Floor topping thickness shall be a minimum of 1 in.

Acousti-flor (3/4 in. thick) - Floor topping thickness shall be a minimum of 1-1/2 in.

Metal Lath — (Optional) — Expanded steel diamond mesh, 2.5 lb / sq yd loose laid over floor mat material.

Fiberglass Mesh Reinforcement — (Optional) — Coated non-woven glass fiber mesh grid loose laid over floor mat material.

System No. 12

Subflooring — Min 1 by 6 in. T & G lumber fastened diagonally to joists, or min 15/32 in. thick plywood or min 7/16 in. thick oriented strand board (OSB) wood structural panels, min grade "C-D" or "Sheathing". Face grain of plywood or strength axis of panel to be perpendicular to joists with joints staggered.

Finish Flooring - Floor Topping Mixture* — Min 1 in. thickness of floor topping mixture having a min compressive strength of 450 psi. Refer to manufacturer's instructions accompanying the material for specific mix design.
SIKA DEUTSCHLAND GMBH — Type SCHONOX AP Rapid Plus

System No. 13

Subflooring — Min 1 by 6 in. T & G lumber fastened diagonally to joists, or min 15/32 in. thick plywood or min 7/16 in. thick oriented strand board (OSB) wood structural panels, min grade "C-D" or "Sheathing". Face grain of plywood or strength axis of panel to be perpendicular to joists with joints staggered.

Vapor Barrier — (Optional) - Commercial asphalt saturated felt, 0.030 in. thick.

Vapor Barrier — (Optional) - Nom 0.010 in. thick commercial rosin-sized building paper.

Finish Flooring - Floor Topping Mixture* — Min 3/4 in. thickness of any Floor Topping Mixture bearing the UL Classification Marking as to Fire Resistance. See Floor- and Roof-Topping Mixtures (CCOX) category for names of Classified Companies.

Floor Mat Materials* — (Optional, Not Shown) - Floor mat material loose laid over the subfloor. Refer to manufacturer's instructions regarding the minimum thickness of floor topping over each floor mat material.
LOW & BONAR INC — EnkaSonic® by Colbond a member of the Low & Bonar group Types 125, 250, 250 Plus, 400, 400 Plus, 750, and 750 Plus

Floor Mat Reinforcement — (Optional) - Refer to manufacturer's instructions regarding minimum thickness of floor topping for use with floor mat reinforcement.

Metal Lath — (Optional) — Expanded steel diamond mesh, 2.5 lb / sq yd loose laid over floor mat material.

Fiberglass Mesh Reinforcement — (Optional) — Coated non-woven glass fiber mesh grid loose laid over floor mat material.

2. **Wood Joists —** Min 2 by 10, spaced 16 in. OC and effectively fireblocked in accordance with local codes.

3. **Cross Bridging —** Min 1 by 3 in. or min 2 by 10 in. solid blocking.

3A. **Horizontal Bridging —** Used in lieu of Item 3 in same joist bay as ceiling damper (Item 4), when ceiling damper is employed. Wood 2 by 4 in. secured between joists with nails.

4. **Ceiling Damper* - (Optional) —** Max nom area shall be 198 sq in. Max rectangular size shall be 12 in. wide by 16-1/2 in. long. Max height of damper shall be 8-3/4 in. Aggregate damper openings shall not exceed 99 sq in. per 100 sq ft of ceiling area. Damper installed in accordance with the manufacturers installation instructions provided with the damper. A steel grille (Item 9) shall be installed in accordance with installation instructions.
AIR BALANCE INC — Type 299 (See Item 7B)

AIR KING VENTILATION PRODUCTS — Series FRAS, Series FRAK, Series FRAKV

CENTRAL VENTILATION SYSTEMS CO L L C — Models C-S/R-HC(-A), C-RD-HC(-A)

JAMIL ALI NASSER AL-ZADJALI FOR INDUSTRY — Models C-S/R-HC(-A), C-RD-HC(-A)

BADR & ASFOUR COMPANY FOR ENGINEERING AND METAL INDUSTRIES — Models C-S/R-HC(-A), C-RD-HC(-A)

GREENHECK FAN CORP — Model CRD-1WJ

METAL-FAB INC — Models MSCDHC, MRCDHC

METAL INDUSTRIES INC — Models CD-S/R-HC, CD-S/R-HC-A, CD-RD-HC, CD-RD-HC-A

NCA MFG INC — Models CD-S/R-HC, CD-S/R-HC-A, CD-RD-HC, CD-RD-HC-A

BRISK MFG INC — Model BMI-50-CRD-S/R-WT

PRICE INDUSTRIES LTD — Models CD-S/R-HC, CD-RD-HC

RUSKIN COMPANY — Model CFD7

UNITED ENERTECH CORP — Models C-S/R-HC(-A), C-RD-HC(-A)

5. **Batts and Blankets* - (Optional) —** Nom 48 by 16 by 3 in. thickness of glass fiber batts secured to joists on both sides with staples spaced 12 in. OC.
CERTAINTEED CORP

KNAUF INSULATION LLC

JOHNS MANVILLE

KNAUF INSULATION LLC

MANSON INSULATION INC

OWENS CORNING

6. **Resilient Channels —** Resilient channels, formed from No. 25 MSG galv steel and shaped as shown, spaced 24 in. OC perpendicular to joists. Channels overlapped 1/2 in. at ends and secured to each joist with one 1-1/4 in. long No. 7 Type S bugle head screw. Additional resilient channels positioned so as to coincide with end joints of gypsum board (Item 7). Additional channels shall extend min 3 in. beyond each side edge of board.

6A. **Steel Framing Members* —** (Not Shown) - As an alternate to Item 6. Used with Item 7A only.
a. **Furring Channels —** Hat-shaped furring channels, 7/8 in. deep by 2-5/8 in. wide at the base and 1-1/4 in. wide at the face, formed from No. 25 ga. galv steel, spaced max. 16 in. OC perpendicular to joists and Cold Rolled Channels (Item 6Ab). Furring channels secured to Cold Rolled Channels at every intersection with a 1/2 in. pan head self-drilling screw through each furring channel leg. End of adjoining channels overlapped 4 in. and tied together with two double strand No. 18 SWG galv steel wire ties, one at each end of overlap. Supplemental furring channels at base layer and outer layer gypsum board butt joints are not required. Optional Batts and Blankets may be draped over furring channels as described in Item 5. Two layers of gypsum board attached to furring channels as described in Item 7A.

b. **Cold Rolled Channels —** 1-1/2 in. by 1/2 in., formed from No. 16 ga. galv steel, positioned vertically and parallel to joists, friction fitted into the channel caddy on the Steel Framing Members (Item 6Ad). Adjoining lengths of cold rolled channels lapped min. 6 in. and wire-tied together with two double strand 18 SWG galv steel wire ties, one at each end of overlap.

c. **Blocking —** Where joist design does not permit direct, full contact of the hanger bracket, a piece of nominal 2 by 4 in. lumber (blocking), min. 6 in. long to permit full contact of the hanger bracket, to be secured vertically to the side of the joists (Item 2) at the top and bottom of the blocking at each Steel Framing Member (Item 6Ad) location.

d. **Steel Framing Members* —** Hangers spaced 48 in. OC. max along joist, and secured to the Blocking (Item 6Ac) on alternating joists with a single 5/16 in. by 2 in. hex head lag bolt or four #6 1-1/4 in. drywall screws through mounting hole(s) on the hanger bracket. The two 1/4 in. long steel teeth on the hanger are embedded in the side of the blocking. Hanger positioned on blocking an leveling bolt height adjusted such that furring channels are flush with bottom of joists before gypsum board installation. Spring gau of hanger chosen per manufacturer's instructions.
KINETICS NOISE CONTROL INC — Type ICW.

6B. **Steel Framing Members* —** (Not Shown) As an alternate to Item 6, furring channels and Steel Framing Members as described below:
a. **Furring Channels —** Formed of No. 25 MSG galv steel, 2-9/16 in. or 2-23/32 in. wide by 7/8 in. deep, spaced 24 in. OC perpendicular to joists. Channels secured to joists as described in Item b. Ends of adjoining channels overlapped 6 in. and tied together with double strand of No. 18 SWG galv steel wire near each end of overlap.

b. **Steel Framing Members* —** Used to attach furring channels (Item a) to joists (Item 2). Clips spaced 48 in. OC. RSIC-1 and RSIC-1 (2.75) secured to alternating joists with No. 8 x 2-1/2 in. coarse drywall screw through the center grommet. RSIC-V and RSIC-V (2.75) clips secured to alternating trusses with No. 8 x 1-1/2 in. coarse drywall screw through the center hole. RSIC-Si-X secured to alternating joists with No. 10 x 3-1/2 in. coarse screw. Furring channels are friction fitted into clips. RSIC-1, RSIC-Si-X, and RSIC-V cli for use with 2-9/16 in. wide furring channels. RSIC-1 (2.75) and RSIC-V (2.75) clips for use with 2-23/32 in. wide furring channels. Adjoining channels are overlapped as described in Item a. Additional clips required to hold furring channel that supports the gypsur board butt joints, as described in Item 7.
PAC INTERNATIONAL L L C — Types RSIC-1, RSIC-V, RSIC-1 (2.75), RSIC-V (2.75), RSIC-Si-X.

6C. **Steel Framing Members* —** (Not Shown) — As an alternate to Item 6, furring channels and Steel Framing Members as describe below:
a. **Furring Channels —** Formed of No. 25 MSG galv steel, 2-3/8 in. wide by 7/8 in. deep, spaced 24 in. OC perpendicular to joists. Channels secured to joists as described in Item b. Ends of adjoining channels overlapped 6 in. and tied together with double strand No. 18 SWG galv steel wire near each end of overlap.

b. **Steel Framing Members* —** Used to attach furring channels (Item a) to joists (Item 2). Clips spaced 48 in. OC., and secured to alternating joists with No. 8 x 2-1/2 in. coarse drywall screw through the center grommet. Furring channels are friction fitted into clip Adjoining channels are overlapped as described in Item a. Additional clips required to hold furring channel that supports the gypsur board butt joints, as described in Item 7.
PLITEQ INC — Type GENIECLIP

6D. **Alternate Steel Framing Members* —** (Not Shown) As an alternate to Item 6, furring channels and Steel Framing Members as described below.
a. **Furring Channels —** Formed of No. 25 MSG galv steel, 2-5/8 in. wide by 7/8 in deep, spaced 24 in OC, perpendicular to joists. Channels secured to joists as described in Item b.

b. **Steel Framing Members* —** Used to attach furring channels (Item a) to the wood joists (Item 2). Clips spaced at 48 in. OC and secured to the bottom of the joists with one 2 in. Coarse Drywall Screw with 1 in. diam washer through the center hole. Furring channels are then friction fitted into clips. Ends of channels are overlapped 6" and tied together with double strand of No. 18 AWG galvanized steel wire. Additional clips are required to hold the Gypsum Butt joints as described in Item 7.
STUDCO BUILDING SYSTEMS — RESILMOUNT Sound Isolation Clips - Type A237 or A237R

6E. **Alternate Steel Framing Members* —** (Not Shown) As an alternate to Item 6, furring channels and Steel Framing Members as described below.
a. **Furring Channels —** Formed of No. 25 MSG galv steel, 2-1/2 in. wide by 7/8 in deep, spaced 24 in OC, perpendicular to joists. Channels secured to joists as described in Item b.

b. **Steel Framing Members* —** Used to attach furring channels (Item a) to the wood joists (Item 2). Clips spaced at 48 in. OC and secured to the bottom of the joists with one 2-1/2 in. Coarse Drywall Screw with 1 in. diam washer through the center hole. Furring channels are then friction fitted into clips. Ends of channels are overlapped 6" and tied together with double strand of No. 18 AWG galvanized steel wire. Additional clips are required to hold the Gypsum Butt joints as described in Item 7.
REGUPOL AMERICA — Type SonusClip

6F. **Steel Framing Members* —** (Optional, Not Shown) — As an alternate to Item 6.
a. **Furring Channels —** Formed of No. 25 MSG galv steel, nominal 2-1/2 in. wide by 7/8 in. deep, spaced 24 in. OC, perpendicular to the joists. Channels secured to Cold Rolled Channels at every intersection with a 3/4 in. TEK screw through each furring channel leg. Ends of adjoining channels overlapped 12 in. and fastened together with two double strand No. 18 SWG galv steel wire ties, one at each end of overlap, or with two 3/4 in. TEK screws in each leg of the overlap section. Two furring channels positioned 3 in. OC, 1-1/2 in. on each side of gypsum board (Item 7) end joints, each extending a min of 6 in. beyond both side edges of the board.

b. **Cold Rolled Channels —** — 1-1/2 in. by 1/2 in., formed from No. 16 ga. galv steel, positioned vertically and parallel to joists, friction-fitted into the channel caddy on the Steel Framing Members (Item 6Fc) and secured with two 3/4 in. TEK screws. Adjoining lengths of cold rolled channels lapped min. 12 in. and secured along bottom legs with four 3/4 in. TEK screws and wire-tied together with two double strand 18 SWG galv steel wire ties, one at each end of overlap.

c. **Steel Framing Members* —** Spaced 48 in. OC. max along joist, and secured to the joist on alternating joists with two, #10 x 1-1/2 in. screws through mounting holes on the hanger bracket.
PAC INTERNATIONAL L L C — Type RSIC-SI-CRC EZ Clip

6G. **Steel Framing Members* —** (Optional, Not Shown) — As an alternate to Item 6.
a. **Furring Channels —** Formed of No. 25 MSG galv steel, nominal 2-1/2 in. wide by 7/8 in. deep, spaced 24 in. OC perpendicular to joists and friction fit into Steel Framing Members (Item 6Gb). Ends of adjoining channels overlapped 6 in. and tied together with double strand of No. 18 SWG galv steel wire near each end of overlap or with two TEK screws along each leg of the 6 in. overlap. Two furring channels positioned 6 in. OC, 3 in. on each side of gypsum board (Item 7) end joints. Butt joint channels held in place by stro back channels placed upside down, on top of, and running perpendicular to primary furring channels, extending 6 in. longer than length of gypsum side joint. Strong back channels spaced maximum 48 in. OC. Strong back channels secured to every intersection o primary furring channels with four 7/16 in. pan head screws, two along each of the legs at intersections. Butt joint channels run perpendicular to strong back channels and shall be minimum 6 in. longer than length of joint, secured to strong back channels with 7/16 in. pan head screws, two along each of the legs at intersection with strong back channels.

b. **Steel Framing Members* —** Used to attach furring channels (Item 6Ga) to joists. Clips spaced 48 in. OC and secured along joist webs at each furring channel intersection with min. 3/4 in. long self-drilling #10 x 1-1/2 in. screws through each of the provided hole locations. Furring channels are friction fitted into clips.
PAC INTERNATIONAL L L C — Type RSIC-S1-1 Ultra

7. **Gypsum Board* —** Nom 5/8 in. thick, 48 in. wide gypsum board, installed with long dimension perpendicular to resilient channel and side edges located between joists. Gypsum board secured with 1 in. long No. 7 Type S bugle head screws spaced 12 in. OC. End joints of gypsum board similarly fastened to additional resilient channels positioned at end joint locations. Screws located 3/4 and 5 in. from side and end joints, respectively.
When **Steel Framing Members*** (Item 6B, 6C) are used, sheets installed with long dimension perpendicular to furring channels and side joints o sheet located beneath joists. Nom 1 in. long No. 6 Type S bugle head screws are driven through channel spaced 12 in. OC in the field. Gypsum board butt joints shall be staggered min. 2 ft. within the assembly, and occur between the main furring channels. At the gypsum board butt join each end of each gypsum board shall be supported by a single length of furring channel equal to the width of the gypsum board plus 6 in. on each end. The two furring channels shall be spaced approximately 3-1/2 in. OC, and be attached to the joist with one clip at each end of the channel. Screw spacing along the butt joint to attach the gypsum board to the furring channels shall be 8 in. OC.

When **Steel Framing Members** (Item 6D) are used, one layer of nom 5/8 in. thick, 4 ft wide gypsum board is installed with long dimensions perpendicular to furring channels. Gypsum board secured to furring channels with nom 1 in. long Type S bugle-head steel screws spaced 8 in. O in the field of the board. Gypsum board butted end joints shall be staggered minimum 48 in. and centered over main furring channels. At the gypsum board butt joints, each end of each gypsum board shall be supported by a single length of furring channel equal to the width of the gypsum board plus 3 in. on each end. The two support furring channels shall be spaced approximately 3 in. in from joint. Screw spacing along th gypsum board butt joint and along both additional channels shall be 8 in. OC. Additional screws shall be placed in the adjacent section of gypsu board into the aforementioned 3 in. extension of the extra butt joint channels as well as into the main channel that runs between. Butt joint furri channels shall be attached with one RESILMOUNT Sound Isolation Clip at each end of the channel.

When **Steel Framing Members** (Item 6E) are used, one layer of nom 5/8 in. thick, 4 ft wide gypsum board is installed with long dimensions perpendicular to furring channels. Gypsum board secured to furring channels with nom 1 in. long Type S bugle-head steel screws spaced 8 in. O in the field of the board. Gypsum board butted end joints shall be staggered minimum 48 in. and centered over main furring channels. At the gypsum board butt joints, an additional single length of furring channel shall be installed and be spaced approximately 3 in. from the butt joint in. from the continuous furring channels) to support the floating end of the gypsum board. Each of these shorter sections of furring channel sha extend one joist beyond the width of the gypsum panel and be attached to the adjacent joists with one SonusClip at every joist involved with th butt joint.

When **Steel Framing Members** (Item 6F) are used, nom 5/8 in. thick, 4 ft wide gypsum board, installed as described in Item 7. Adjacent butt joi staggered minimum 48 in. OC.

When **Steel Framing Members** (Item 6G) are used, nom 5/8 in. thick, 4 ft wide gypsum board, installed as described in Item 7. Butt joints staggered minimum 24 in. OC.

AMERICAN GYPSUM CO — Type AG-C

CERTAINTEED GYPSUM INC — Type C

CGC INC — Type C, IP-X2, IPC-AR

CERTAINTEED GYPSUM INC — Type LGFC-C/A

GEORGIA-PACIFIC GYPSUM L L C — Types 5, DAPC, TG-C.

NATIONAL GYPSUM CO — Types eXP-C, FSK-C, FSW-C, FSW-G

PABCO BUILDING PRODUCTS L L C, DBA PABCO GYPSUM — Type C or PG-C

PANEL REY S A — Type PRC

THAI GYPSUM PRODUCTS PCL — Type C

UNITED STATES GYPSUM CO — Types C, IP-X2, IPC-AR

USG BORAL DRYWALL SFZ LLC — Type C

USG MEXICO S A DE C V — Types C, IP-X2, IPC-AR

7A. **Gypsum Board —** When **Steel Framing Members** (Item 6A) are used, two layers of nom 5/8 in. thick, 4 ft wide gypsum board a installed with long dimensions perpendicular to furring channels (Item 6Aa). Base layer attached to the furring channels using 1 in. long Type S bugle head steel screws spaced 8 in. OC along butted end joints and 12 in. OC in the field of the board. Butted end joint centered on the continuous furring channels. Butted base layer end joints to be offset a min of 16 in. in adjacent courses. Outer laye attached to the furring channels using 1-5/8 in. long Type S bugle head steel screws spaced 8 in. OC at butted end joints and 12 in. OC in the field. Butted end joints centered on the continuous furring channels and offset a min of 16 in. from butted end joints of base layer. Butted side joints of outer layer to be offset min 16 in. from butted side joints of base layer.
CGC INC — Type C, IP-X2, IPC-AR

UNITED STATES GYPSUM CO — Types C, IP-X2, IPC-AR

USG BORAL DRYWALL SFZ LLC — Type C

USG MEXICO S A DE C V — Types C, IP-X2, IPC-AR

7B. **Gypsum Board* —** (Finish Rating - 16 min.) Required when Air Balance Inc. Type 299 ceiling damper (Item 4) is installed. Nom 5/8 in. thick, 48 in. wide gypsum board, installed and secured as described in items 7 and 7A.
UNITED STATES GYPSUM CO — Type C

USG BORAL DRYWALL SFZ LLC — Type C

USG MEXICO S A DE C V — Type C

7C. **Gypsum Board* (As an alternative to Items 7, 7A and 7B) —** Nom 5/8 in. thick, 48 in. wide gypsum board, installed and secur as described in Items 7, 7A and 7B with max screw spacing 8 in. OC.
CGC INC — Type ULIX

UNITED STATES GYPSUM CO — ULIX

8. **Finishing System - (Not Shown) —** Vinyl, dry or premixed joint compound, applied in two coats to joints and screw-heads. Nom in. wide paper tape embedded in first layer of compound over all joints. As an alternate, nom 3/32 in. thick veneer plaster may be applied to the entire surface of gypsum board.

9. **Grille —** Steel grille, installed in accordance with the installation instructions provided with the ceiling damper.

10. **Discrete Products Installed in Air-handling Spaces* —** Automatic Balancing Valve/Damper — (Not Shown - Optional) — For u with item 4, Ruskin Company's Model CFD7 damper (CABS). Ceiling damper to be provided with plenum box per damper manufacturer's instructions with side outlet only. Entire assembly to be installed into any UL Class 0 or Class 1 flexible air duct in accordance with the instructions provided by the automatic balancing valve/damper manufacturer.
METAL INDUSTRIES INC — Model ABV-4, ABV-5, ABV-6

*** Indicates such products shall bear the UL or cUL Certification Mark for jurisdictions employing the UL or cUL Certificatio (such as Canada), respectively.**

Last Updated on 2023-07-

The appearance of a company's name or product in this database does not in itself assure that products so identified have been manufactured under UL Solutions' Follow - Up Service. Only those products bearing the UL Mark should be considered to be Certified and covered under UL Solutions' Follow - Up Service. Always look for the Mark on the product.

UL Solutions permits the reproduction of the material contained in Product iQ subject to the following conditions: 1. The Guide Information, Assemblies, Constructions, Designs, Systems, and/or Certifications (files) must be presented in their entirety and in a non-misleading manner, without any manipulation of the data (or drawings). 2. The statement "Reprinted from Product iQ with permission from UL Solutions" must appe adjacent to the extracted material. In addition, the reprinted material must include a copyright notice in the following format: "©2023 UL LLC."

Feedback

10/27/2023 2:53:31 PM
C:\Revit Local Cache\23032\004_Wilshire Hills III_Central_R23_mw8f1UCAR.rvt

PRINTS ISSUED
10/30/23 PERMIT SUBMITTAL

REVISIONS:

rosemann & ASSOCIATES P.C.
ARCHITECTURE
INTERIOR DESIGN
ENGINEERING
PLANNING
1526 Grand Boulevard
Kansas City, MO 64108-1404
p: 816.472.1448
w: www.rosemann.com
© 2023 Rosemann & Associates, P.C.
DENVER ▲ KANSAS CITY ▲ ST. LOUIS ▲ ATLANTA

STATE OF MISSOURI
DAVID EUGENE HENDRIKSE
NUMBER A-7365
REGISTERED ARCHITECT
10/30/23

WILSHIRE HILLS III
LEE'S SUMMIT, MISSOURI
MHDC - 22-057

SHEET TITLE
UL ASSEMBLIES

PROJECT NUMBER: 23034

SHEET NUMBER:

G-203

UL DESIGN - L546

UL Product **iQ**®

UL Solutions

Design/System/Construction/Assembly Usage Disclaimer

- Authorities Having Jurisdiction should be consulted in all cases as to the particular requirements covering the installation and use of UL Certified products, equipment, system, devices, and materials.
- Authorities Having Jurisdiction should be consulted before construction.
- Fire resistance assemblies and products are developed by the design submitter and have been investigated by UL for compliance with applicable requirements. The published information cannot always address every construction nuance encountered in the field.
- When field issues arise, it is recommended the first contact for assistance be the technical service staff provided by the product manufacturer noted for the design. Users of fire resistance assemblies are advised to consult the general Guide Information for each product category and each group of assemblies. The Guide Information includes specifics concerning alternate materials and alternate methods of construction.
- Only products which bear UL's Mark are considered Certified.

BXUV - Fire Resistance Ratings - ANSI/UL 263 Certified for United States

BXUV7 - Fire Resistance Ratings - CAN/ULC-S101 Certified for Canada

See General Information for Fire-resistance Ratings - ANSI/UL 263 Certified for United States
Design Criteria and Allowable Variances

See General Information for Fire Resistance Ratings - CAN/ULC-S101 Certified for Canada
Design Criteria and Allowable Variances

Design No. **L546**

August 4, 2023

Unrestrained Assembly Rating — 1 Hr
Finish Rating — 24 or 25 Min (See Item 5)
This design was evaluated using a load design method other than the Limit States Design Method (e.g., Working Stress Design Method). For jurisdictions employing the Limit States Design Method, such as Canada, a load restriction factor shall be used — See Guide BXUV or BXUV7

*** Indicates such products shall bear the UL or cUL Certification Mark for jurisdictions employing the UL or cUL Certification (such as Canada), respectively.**

Feedback

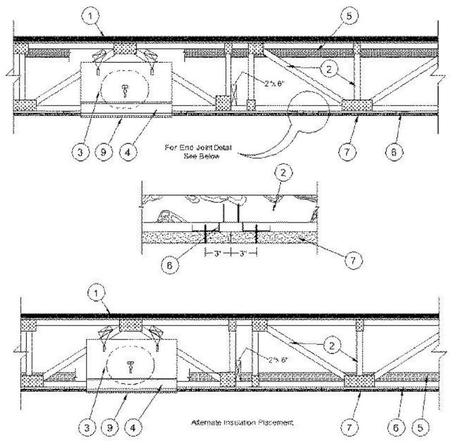

1. **Flooring System —** The flooring system shall consist of one of the following:

System No. 1

Subflooring — Min 15/32 or 19/32 in. thick wood structural panels, min grade "C-D" or "Sheathing". Face grain of plywood or strength axis of panel to be perpendicular to trusses with joints staggered.

Finish Flooring - Floor Topping Mixture* — Min 3/4 thickness of floor topping mixture having a minimum compressive strength of 1500 psi. Refer to manufacturer's instructions accompanying the material for specific mix design.

MAXXON CORP — Types Maxxon Standard and Maxxon High Strength

Floor Mat Materials* — (Optional) — Floor mat material loose laid over the subfloor. Refer to manufacturer's instructions regarding the minimum thickness of floor topping over each floor mat material.

MAXXON CORP — Type Encapsulated Sound Mat

Floor Mat Reinforcement — (Optional) Refer to manufacturer's instructions regarding minimum thickness of floor topping for use with floor mat reinforcement.

Metal Lath — (Optional) — 3/8 in. expanded galvanized steel diamond mesh, 3.4 lbs/sq yd loose laid over the floor mat material.

Fiber Glass Reinforcement - (Optional, Not Shown) - 0.015 in. thick PVC coated non-woven fiberglass mesh, 0.368 lbs/sq yd loose laid over the floor mat material.

10/27/2023 2:53:23 PM
C:\Revit Local Cache\R2024\2034_Wilshire Hills III_Central_R23_revBTU-CAR.rvt

System No. 2

Subflooring — Min 1 by 6 in. T & G lumber fastened diagonally to joists, or min 15/32 in. thick plywood or min 7/16 in. thick oriented strand board (OSB) wood structural panels, min grade "C-D" or "Sheathing". Face grain of plywood or strength axis of panel to be perpendicular to trusses with joints staggered.

Finish Floor — Mineral and Fiber Board* — Min 1/2 in. thick, supplied in sizes ranging from 3 ft by 4 ft to 8 ft by 12 ft. All joints to be staggered a min of 12 in. with adjacent sub-floor joints.

HOMASOTE CO — Type 440-32 Mineral and Fiber Board

System No. 3

Subflooring — Min 15/32 in. thick wood structural panels, min grade "C-D" or "Sheathing". Face grain of plywood or strength axis of panels to be perpendicular to the trusses with joints staggered.

Vapor Barrier — (Optional) — Nom 0.030 in thick commercial asphalt saturated felt.

Finish Flooring — Floor Topping Mixture* — Min 1-1/2 in. thickness of floor topping mixture having a min compressive strength of 1000 psi and a cast density of 100 plus or minus 5 pcf. Foam concentrate mixed 40:1 by volume with water and expanded at 100 psi through nozzle. Mixture shall consist of 1.4 cu feet of preformed foam concentrate to 94 lbs Type I Portland cement, 300 lbs of sand with 5-1/2 gal of water.

ELASTIZELL CORP OF AMERICA — Type FF

System No. 4

Subflooring — Min 15/32 or 19/32 in. thick wood structural panels, min grade C-D or Sheathing. Face grain of plywood or strength axis of panel to be perpendicular to trusses with joints staggered.

Vapor Barrier — (Optional) Nom 0.030 in. thick commercial asphalt saturated felt.

Finish Flooring — Floor Topping Mixture* —Min 3/4 in. thickness of floor topping mixture having a minimum compressive strength of 1500 psi. Refer to manufacturer's instructions accompanying the material for specific mix design.

FORMULATED MATERIALS LLC — Types FR-25, FR-30, and SiteMix

Alternate Floor Mat Material* — (Optional) Floor mat material nominal 2 - 9.5 mm thick loose laid over the subfloor. Floor topping thickness shall be a minimum of 3/4 in.

FORMULATED MATERIALS LLC — Types M1, M2, M3, Elite, Duo, R1, and R2

System No. 5

Subflooring — Min 15/32 in. thick wood structural panels, min grade "C-D" or "Sheathing". Face grain of plywood or strength axis of panel to be perpendicular to trusses with joints staggered.

Floor Mat Materials* — (Optional) — Floor mat material nom 5/64 in. (2 mm) thick adhered to subfloor with Hacker Floor Primer. Primer to be applied to the surface of the mat prior to the placement of a min 1 in. of floor-topping mixture.

HACKER INDUSTRIES INC — Type Hacker Sound-Mat.

Alternate Floor Mat Materials — (Optional) — Floor mat material nom 1/4 in. (6 mm) thick adhered to subfloor with Hacker Floor Primer. Primer to be applied to the surface of the mat prior to the placement of a min 1-1/4 in. (32 mm) of floor-topping mixture.

HACKER INDUSTRIES INC — Type Hacker Sound-Mat II.

Alternate Floor Mat Materials — (Optional) — Floor mat material nom 1/8 in. (3mm) thick loose laid over the subfloor. Floor topping thickness shall be a min of 3/4 in. (19 mm)

HACKER INDUSTRIES INC — FIRM-FILL SCM 125

Alternate Floor Mat Materials — (Optional) — Floor mat material nom 1/4 in. (6 mm) thick loose laid over the subfloor. Floor topping thickness shall be a min of 1 in. (25 mm)

HACKER INDUSTRIES INC — Type FIRM-FILL SCM 250, Quiet Qurl 55/025

Feedback

Alternate Floor Mat Materials — (Optional) — Floor mat material nom 3/8 in. (10 mm) thick loose laid over the subfloor. Floor topping thickness shall be a min of 1-1/4 in. (32mm)

HACKER INDUSTRIES INC — FIRM-FILL SCM 400, Quiet Qurl 60/040

Alternate Floor Mat Materials — (Optional) — Floor mat material nom 3/4 in. (19 mm) thick loose laid over the subfloor. Floor topping thickness shall be a min of 1-1/2 in. (38mm)

HACKER INDUSTRIES INC — Type FIRM-FILL SCM 750, Quiet Qurl 65/075

Metal Lath — (Optional) — For use with 3/8 in. (10 mm) floor mat materials, 3/8 in. expanded steel diamond mesh, 3.4 lbs/sq yd placed over the floor mat material. Hacker Floor Primer to be applied prior to the placement of the metal lath. When metal lath is used, floor topping thickness a nom 1-1/4 in. over the floor mat.

Finish Flooring — Floor Topping Mixture* — Min 3/4 in. thickness of floor topping mixture having a min compressive strength of 1100 psi. Mixture shall consist of 6.8 gal of water to 80 lbs of floor topping mixture to 1.9 cu ft of sand.

HACKER INDUSTRIES INC — Firm-Fill Gypsum Concrete, Firm-Fill 2010, Firm-Fill 3310, Firm-Fill 4010, Firm-Fill High Strength, Gyp-Span Radiant

System No. 6

Subflooring — Min 15/32 or 19/32 in. thick wood structural panels, min grade "C-D" or "Sheathing". Face grain of plywood or strength axis of panel to be perpendicular to trusses with joints staggered.

Vapor Barrier — (Optional) — Nom 0.030 in. thick commercial asphalt saturated felt.

Finish Flooring — Floor Topping Mixture* — Min 3/4 or 1 in. thickness of floor topping mixture for 19/32 or 15/32 in. thick wood structural panels respectively, having a min compressive strength of 1000 psi. Refer to manufacturer's instructions accompanying the material for specific mix design.

ARCOSA SPECIALTY MATERIALS — AccuCrete® Types NexGen, Green, Prime and PrePour, AccuRadiant®, AccuLevel® Types G40, G50 and SD30

Alternate Floor Mat Material* — (Optional) — Floor mat material nominal 2 - 9.5 mm thick loose laid over the subfloor. Floor topping shall be a min of 3/4 in. or 1 in. thickness of floor topping for 19/32 or 15/32 in. thick wood structural panels respectively.

ARCOSA SPECIALTY MATERIALS — AccuQuiet® Types D13, D-18, D25, DX38, EM.125, EM.125S, EM.250, EM.250S, EM.375, EM.375S, EM.750, and EM.750S.

System No. 7

Subflooring — 15/32 or 19/32 in. thick wood structural panels, min. grade "C-D" or "Sheathing". Face grain of plywood or strength axis of panels to be perpendicular to joists with joints staggered.

Vapor Barrier — (Optional) — Commercial asphalt saturated felt 0.030 in. thick.

Finish Flooring — Floor Topping Mixture* — Compressive strength to be 2100 psi min. Thickness to be 3/4 in. min for 19/32 in thick wood structural panels or 1 in. min. for 15/32 in thick wood structural panels. Refer to manufacturer's instructions accompanying the material for specific mix design. Refer to the manufacturer's instructions accompanying the material and/or contact the manufacturer's technical support for specific mix design and minimum thickness recommended for use with eligible floor mat(s).

System No. 8

Subflooring — Min 15/32 in. thick wood structural panels, min grade "C-D" or "Sheathing". Face grain of plywood or strength axis of panels to be perpendicular to the trusses with joints staggered.

Vapor Barrier — (Optional) — Nom 0.010 in. thick commercial asphalt saturated felt.

Finish Flooring — Floor Topping Mixture* — Min 3/4 in. thickness of floor topping mixture having a minimum compressive strength of 1800 psi. Refer to manufacturer's instructions accompanying the material for specific mix design.

UNITED STATES GYPSUM CO — Types LRK, HSLRK, CSD

USG MEXICO S A DE C V — Types LRK, HSLRK, CSD

Feedback

Floor Mat Materials* — (Optional) — Floor mat material loose laid over the subfloor. Refer to manufacturer's instructions regarding the minimum thickness of floor topping over each floor mat material.

UNITED STATES GYPSUM CO — Types SAM, LEVELROCK® Brand Sound Reduction Board, LEVELROCK® Brand Floor Underlayment SRM-25

Alternate Floor Mat Materials* — (Optional) - Floor mat material loose laid over the subfloor. Refer to manufacturer's instructions regarding minimum thickness of floor topping over floor mat.

GRASSWORX L L C — SC Types

System No. 9

Subflooring — Min 23/32 in. thick T&G wood structural panels, min grade "Underlayment" or "Single-Floor". Face grain of plywood or strength axis of panels to be perpendicular to the trusses with end joints staggered 4 ft. Panels secured to trusses with construction adhesive and No. 6d ringed shank nails spaced 12 in. OC along each truss. Staples having equal or greater withdrawal and lateral resistance strength may be substituted for the 6d nails.

Gypsum Board* — One layer of nom 5/8 in. thick, 4 ft wide gypsum board, installed with long dimension perpendicular to joists. Gypsum board secured with 1 in. long No. 6 Type W bugle head steel screws spaced 12 in. OC and located a min of 1-1/2 in. from side and end joints. The joints of the gypsum board are to be staggered a minimum of 12 inches from the joints of the subfloor.

GEORGIA-PACIFIC GYPSUM L L C — Type DS

Floor Mat Materials* — (As an alternate to the single layer gypsum board) — Floor mat material loose laid over the subfloor.

MAXXON CORP — Type Encapsulated Sound Mat

Gypsum Board* — (For use when floor mat is used) Two layers of nom 5/8 in. thick, 4 ft wide gypsum board, installed with long dimension perpendicular to joists on top of the floor mat material. Gypsum board secured to each other with 1 in. long No. 6 Type G bugle head steel screws spaced 12 in. OC and located a min of 1-1/2 in. from side and end joints. The joints of the gypsum board are to be staggered a minimum of 12 inches in between layers and from the joints of the subfloor.

GEORGIA-PACIFIC GYPSUM L L C — Type DS

System No. 10

Subflooring — Min 15/32 or 19/32 in. thick wood structural panels, min grade "C-D" or "Sheathing". Face grain of plywood or strength axis of panel to be perpendicular to trusses with joints staggered.

Vapor Barrier — (Optional) — Nom 0.030 in. thick commercial asphalt saturated felt.

Finish Flooring — Floor Topping Mixture* — Min 3/4 or 1 in. thickness of floor topping mixture for 19/32 or 15/32 in. thick wood structural panels respectively, having a min compressive strength of 1000 psi. Refer to manufacturer's instructions accompanying the material for specific mix design.

DEPENDABLE LLC — GSL M3.4, GSL K2.6, GSL-CSD, GSL RH, and SKIMFLOW.

Floor Mat Materials* — (Optional) — Nom. 1/4 in. thick loose laid over the subfloor. Floor topping thickness shall be a minimum of 3/4 in.

KEENE BUILDING PRODUCTS CO INC — Type Quiet Qurl 55/025 and Quiet Qurl 55/025 N

Alternate Floor Mat Materials* — (Optional) — Floor mat material Nom. 3/8 in. thick loose laid over the subfloor. Floor topping thickness shall be a minimum of 1 in.

KEENE BUILDING PRODUCTS CO INC — Type Quiet Qurl 60/040 and Quiet Qurl 60/040 N

Alternate Floor Mat Materials* — (Optional) — Floor mat material Nom. 3/4 in. thick loose laid over the subfloor. Floor topping thickness shall be a minimum of 1-1/2 in.

KEENE BUILDING PRODUCTS CO INC — Type Quiet Qurl 65/075, Quiet Qurl 65/075 N

Feedback

Alternate Floor Mat Materials* — (Optional) — Floor mat material Nom. 1/8 in. thick loose laid over the subfloor. Floor topping thickness shall be a minimum of 3/4 in.

KEENE BUILDING PRODUCTS CO INC — Type Quiet Qurl 52/013 and Quiet Qurl 52/013 N

Alternate Floor Mat Materials* — (Optional) — Floor mat material Nom. 1/4 in. entangled net core with a compressible fabric attached to the bottom loose laid over the subfloor. Floor topping thickness shall be a minimum of 1 in.

KEENE BUILDING PRODUCTS CO INC — Quiet Qurl 55/025 MT and Quiet Qurl 55/025 N MT

System No. 11

Subflooring — Min 15/32 or 19/32 in. thick wood structural panels, min grade "C-D" or "Sheathing". Face grain of plywood or strength axis of panel to be perpendicular to trusses with joints staggered.

Finish Flooring - Floor Topping Mixture* — Min 1 in. thickness of floor topping mixture having a min compressive strength of 4500 psi. Refer to manufacturer's instructions accompanying the material for specific mix design.
SIKA DEUTSCHLAND GMBH — Type SCHONOX AP Rapid Plus

System No. 12

Subflooring — Min 15/32 or 19/32 in. thick wood structural panels, min grade "C-D" or "Sheathing". Face grain of plywood or strength axis of panel to be perpendicular to trusses with joints staggered.

Vapor Barrier — (Optional) - Commercial asphalt saturated felt, 0.030 in. thick.

Finish Flooring - Floor Topping Mixture* — Min 3/4 in. thickness of any Floor Topping Mixture bearing the UL Classification Marking as to Fire Resistance. See Floor- and Roof-Topping Mixtures (CCOX) category for names of Classified Companies. Refer to the manufacturer's instructions accompanying the material and/or contact the manufacturer's technical support for specific mix design and minimum thickness recommended for use with eligible floor mat(s).

Floor Mat Materials* — (Optional, Not Shown) - Floor mat material loose laid over the subfloor. Refer to manufacturer's instructions regarding the minimum thickness of floor topping over each floor mat material.
LOW & BONAR INC — EnkaSonic® by Colbond a member of the Low & Bonar group Types 125, 250, 250 Plus, 400, 400 Plus, 750, and 750 Plus.

Floor Mat Reinforcement — (Optional) - Refer to manufacturer's instructions regarding minimum thickness of floor topping for use with floor mat reinforcement.

Metal Lath — (Optional) — Expanded steel diamond mesh, 2.5 lb / sq yd loose laid over floor mat material.

Fiberglass Mesh Reinforcement — (Optional) — Coated non-woven glass fiber mesh grid loose laid over floor mat material.

System No. 13

Subflooring — Min 15/32 or 19/32 in. thick wood structural panels, min grade "C-D" or "Sheathing". Face grain of plywood or strength axis of panel to be perpendicular to trusses with joints staggered.

Vapor Barrier — (Optional) — Nom 0.030 in. thick commercial asphalt saturated felt.

Floor Mat Materials* — (Optional) — Floor mat material loose laid over the subfloor. Refer to manufacturer's instructions regarding the minimum thickness of floor topping over each floor mat material.

GRASSWORX L L C — SC Types

Finish Flooring* — Min 3/4 in. thickness of any Floor Topping Mixture bearing the UL Classification Marking as to Fire Resistance. See Floor- and Roof-Topping Mixtures (CCOX) category for names of Classified Companies. Refer to the manufacturer's instructions accompanying the material and/or contact the manufacturer's technical support for specific mix design and minimum thickness recommended for use with eligible floor mat(s).

Floor Mat Reinforcement — (Optional) - Refer to manufacturer's instructions regarding minimum thickness of floor topping for use with floor mat reinforcement.

Feedback

2. **Trusses —** Parallel chord trusses spaced a max of 24 in. OC fabricated from nom 2 by 4 lumber, with lumber oriented vertically or horizontally. Min truss depth is 12 in. when dampers are not used and 18 in. when dampers are used. Truss members secured together with min 0.036 in. thick galv steel plates. Plates have 5/16 in. long teeth projecting perpendicular to the plane of the plate. The teeth are in pairs facing each other (made by the same punch), forming a split tooth type plate. Each tooth has a chisel point on its outside edge with these points being diagonally opposite each other for each pair. The top half of each tooth has a twist for stiffness. The pairs are repeated on approximately 7/8 in. centers with four rows of teeth per inch of plate width.

3. **Air Duct* —** (Optional) **—** Any UL Class 0 or Class 1 flexible air duct installed in accordance with the instructions provided by the damper manufacturer

4. **Ceiling Damper* —** (Optional. To be used with Air Duct Item 3) **—** For use with min 18 in. deep trusses. Max nom area shall be 324 sq in. Max square size shall be 18 in. by 18 in. Rectangular sizes not to exceed 324 sq in. with a max width of 18 in. Max height of damper shall be 14 in. Aggregate damper openings shall not exceed 162 sq in. per 100 sq ft of ceiling area. Damper installed in accordance with the manufacturers installation instructions provided with the damper. A steel grille (Item 9) shall be installed in accordance with installation instructions.
C&S AIR PRODUCTS — Model RD-521

POTTORFF — Model CFD-521

4A. **Alternate Ceiling Damper* —** For use with min 18 in. deep trusses. Max nom area shall be 196 sq in. Max square size shall be 14 in. by 14 in. Rectangular sizes not to exceed 196 sq in. with a max width of 26 in. Max height of damper shall be 7 in. Aggregate damper openings shall not exceed 98 sq in. per 100 sq ft of ceiling area. Damper installed in accordance with the manufacturers installation instructions provided with the damper. A steel grille (Item 9) not to exceed 144 in.^{2} shall be installed in accordance with installation instructions.
C&S AIR PRODUCTS — Model RD-521-BT

POTTORFF — Model CFD-521-BT.

4B. **Alternate Ceiling Damper* —** (Optional. To be used with Air Duct Item 3) **—** For use with min 18 in. deep trusses. Max nom area shall be 256 sq in. with the length not to exceed 24 in. and the width not to exceed 20 in. Max height of damper shall be 17 in. Aggregate damper openings shall not exceed 128 sq in. per 100 sq ft of ceiling area. Damper installed in accordance with the manufacturers installation instructions provided with the damper. A steel grille (Item 9) shall be installed in accordance with installation instructions.
C&S AIR PRODUCTS — Model RD-521-IP, RD-521-NP

POTTORFF — Models CFD-521-IP, CFD-521-NP

4C. **Alternate Ceiling Damper* —** For use with min 18 in. deep trusses. Max nom area shall be 144 sq in. with the length not to exceed 14 in. and the width not to exceed 12 in. Max height of damper shall be 17-7/8 in. Aggregate damper openings shall not exceed 74 sq in. per 100 sq ft of ceiling area. Damper installed in accordance with the manufacturers installation instructions provided with the damper. A steel grille (Item 9) shall be installed in accordance with installation instructions.
C&S AIR PRODUCTS — Model RD-521-90, RD-521-NP90

POTTORFF — Models CFD-521-90, CFD-521-90NP

4D. **Alternate Ceiling Damper* —** For use with min. 18 in. deep trusses. Max. nom area shall be 349 sq in. Max. overall length and width shall not exceed 18-11/16 in. by 18-11/16 in. with max. 16 in. by 16 in. register opening. Aggregate damper openings shall not exceed 175 sq in. per 100 sq ft of ceiling area. Damper installed in accordance with the manufacturers installation instructions provided with the damper. An aluminum or steel grille (Item 9) shall be installed in accordance with installation instructions.
MIAMI TECH INC — Model Series RxCRD, RxCRDS or RxCRPD

Feedback

4E. **Alternate Ceiling Damper* —** Ceiling damper & fan assembly for use with min 18 in. deep trusses. Max nom area shall be 75 sq in. with the length not to exceed 8-9/16 in. and the width not to exceed 8-3/4 in. Max height of damper shall be 9-7/8 in. Aggregate damper openings shall not exceed 38 sq in. per 100 sq ft of ceiling area. Damper shall be installed in combination with one of the fan models described in, and in accordance with, the manufacturers installation instructions provided with the damper. A plastic grille (Item 9) shall be installed in accordance with installation instructions.
DELTA ELECTRONICS INC — Models CRD2, GBR-CRD, ITG-CRD

4F. **Alternate Ceiling Damper* —** For use with min 18 in. deep trusses. Max nom area shall be 324 sq in. Max square size shall be 18 in. by 18 in. Rectangular sizes not to exceed 324 sq in. with a max length of 20 in. and a max width of 22 in. Max height of damper shall be 14 in. Aggregate damper openings shall not exceed 154 sq in. per 100 sq ft of ceiling area. Damper installed in accordance with the manufacturer's installation instructions provided with the damper. An aluminum or steel grille (Item 9) shall be installed in accordance with installation instructions.
UNITED ENERTECH CORP — Type C-S/R-WT or C-S/R-WTP (Max nom area 324 sq. in.) or C-S/R-WTS or C-S/R-WTPS (Max nom area 162 sq. in.)

4G. **Alternate Ceiling Damper* —** Ceiling damper & fan assembly for use with min 18 in. deep trusses. Max nom area shall be 75 sq in. with the length not to exceed 9-1/4 in. and the width not to exceed 9-3/4 in. Max height of damper shall be 9-7/8 in. Aggregate damper openings shall not exceed 45 sq in. per 100 sq ft of ceiling area. Damper shall be installed in combination with one of the fan models described in, and in accordance with, the manufacturer's installation instructions provided with the damper. A plastic grille (Item 9) shall be installed in accordance with installation instructions.
DELTA ELECTRONICS INC — Model SIG-CRD

4H. **Alternate Ceiling Damper* —** Ceiling damper & fan assembly for use with min 18 in. deep trusses. Max nom area shall be 131 sq in. with the length not to exceed 11-1/16 in. and the width not to exceed 11-7/8 in. Aggregate damper openings shall not exceed 66 sq in. per 100 sq ft of ceiling area. Damper shall be installed in combination with one of the fan models described in, and in accordance with, the manufacturer's installation instructions provided with the damper. A plastic grille (Item 9) shall be installed in accordance with installation instructions.
DELTA ELECTRONICS INC — Model SMT-CRD

4I. **Alternate Ceiling Damper* —** Ceiling damper & fan assembly for use with min 18 in. deep trusses. Max nom area shall be 103 sq in. with the length not to exceed 10-1/8 in. and the width not to exceed 10-1/8 in. Aggregate damper openings shall not exceed 52 sq in. per 100 sq ft of ceiling area. Damper shall be installed in combination with one of the fan models described in, and in accordance with, the manufacturer's installation instructions provided with the damper. A plastic grille (Item 9) shall be installed in accordance with installation instructions.
PANASONIC CORPORATION, PANASONIC CORPORATION OF NORTH AMERICA — Model PC-RD05C5

4J. **Alternate Ceiling Damper* —** Ceiling damper & fan assembly for use with min 18 in. deep trusses. Max nom area shall be 113 sq in. with the length not to exceed 10-1/8 in. and the width not to exceed 11-1/8 in. Aggregate damper openings shall not exceed 57 sq in. per 100 sq ft of ceiling area. Damper shall be installed in combination with one of the fan models described in, and in accordance with, the manufacturer's installation instructions provided with the damper. A plastic grille (Item 9) shall be installed in accordance with installation instructions.
BROAN-NUTONE L L C — Model RDFUWT

4K. **Alternate Ceiling Damper* —** Ceiling damper & fan assembly for use with min 18 in. deep trusses. Max nom area shall be 79 sq in. with the length not to exceed 10 in. and the width not to exceed 7-15/16 in. Aggregate damper openings shall not exceed 40 sq in. per 100 sq ft of ceiling area. Damper shall be installed in combination with one of the fan models described in, and in accordance with, the manufacturer's installation instructions provided with the damper. A metallic grille (Item 9) shall be installed in accordance with installation instructions.
BROAN-NUTONE L L C — Models RDJ1 and RDH

4L. **Alternate Ceiling Damper* —** Ceiling damper & fan assembly for use with min 18 in. deep trusses. Max nom area shall be 87 sq in. with the length not to exceed 9 in. and the width not to exceed 9-11/16 in. Aggregate damper openings shall not exceed 44 sq in. per 100 sq ft of ceiling area. Damper shall be installed in combination with one of the fan models described in, and in accordance with, the manufacturer's installation instructions provided with the damper. A plastic grille (Item 9) shall be installed in accordance with installation instructions.
BROAN-NUTONE L L C — Model RDMWT

Feedback

PRINTS ISSUED
10/30/23 PERMIT SUBMITTAL

REVISIONS:

rosemann & ASSOCIATES P.C.
ARCHITECTURE
INTERIOR DESIGN
ENGINEERING
PLANNING
1526 Grand Boulevard
Kansas City, MO 64108-1404
p: 816.472.1448
w: www.rosemann.com
© 2023 Rosemann & Associates, P.C.
DENVER ◀ KANSAS CITY ▲ ST. LOUIS ▲ ATLANTA

STATE OF MISSOURI
DAVID EUGENE HENDRIKSE
NUMBER A-7365
REGISTERED ARCHITECT
10/30/23

WILSHIRE HILLS III

LEE'S SUMMIT, MISSOURI

MHDC - 22-057

SHEET TITLE
UL ASSEMBLIES

PROJECT NUMBER: 23034

SHEET NUMBER:

G-204

UL DESIGN - L546 - CONT.

4M. **Alternate Ceiling Damper* —** Ceiling damper & fan assembly for use with min 18 in. deep trusses. Max nom area shall be 87 sq in. with the length not to exceed 9 in. and the width not to exceed 9-11/16 in. Aggregate damper openings shall not exceed 44 sq in. per 100 sq ft of ceiling area. Damper shall be installed in combination with one of the fan models described in, and in accordance with, the manufacturer's installation instructions provided with the damper. A plastic grille (Item 9) shall be installed in accordance with installation instructions.
BROAN-NUTONE L L C — Model RDMWT2

4N. **Alternate Ceiling Damper* —** (Optional, To be used with Air Duct Item 3) — For use with min 18 in. deep trusses. Max nom 21 in. long by 18 in. wide, fabricated from galvanized steel. Plenum box max size nom 21 in. long by 18 in. wide by 14 in. high (inner dimension) fabricated from either galvanized steel or min 1 in. thick Listed Duct Board bearing the UL Listing Marking having a min R-Value of 4.3. Installed in accordance with the instructions provided by the manufacturer. Max damper openings not to exceed 180 sq in. per 100 sq ft of ceiling area.
GREENHECK FAN CORP — Model CRD-1WT

4O. **Alternate Ceiling Damper* —** (Optional, To be used with Air Duct Item 3) — For use with min 18 in. deep trusses. Max nom 12 in. long by 12 in. wide with an 8 in. diameter damper, fabricated from galvanized steel. Installed in accordance with the instructions provided by the manufacturer. Max damper openings not to exceed 72 sq in. per 100 sq ft of ceiling area. .
GREENHECK FAN CORP — Model CRD-2WT

4P. **Alternate Ceiling Damper* —** (Optional. To be used with Air Duct, Item 3) — For use with min 18 in. deep trusses. Max nom 18 in. long by 18 in. wide, fabricated from galvanized steel. Installed in accordance with the instructions provided by the manufacturer. Max damper openings not to exceed 162 sq in. per 100 sq ft of ceiling area.
RUSKIN COMPANY — Model CFD7T, CFD7T-END-BT, CFD7T-90-BT, CFD7T-ST-BT, CFD7T-SB, CFD7T-R6-DB, or CFD7T-IB6

4Q. **Alternate Ceiling Damper* —** (Optional. To be used with Air Duct, Item 3) — For use with min 18 in. deep trusses. Max 8 in. diameter damper, fabricated from galvanized steel. Installed in accordance with the instructions provided by the manufacturer. Max damper openings not to exceed 25 sq in. per 100 sq ft of ceiling area.
RUSKIN COMPANY — Model CFDR7T

4R. **Alternate Ceiling Damper* —** (Optional, to be used with Air Duct Item 3) For use with min 18 in. deep trusses. Max nom 11-1/8 in. long by 13-5/8 in. wide, fabricated from galvanized steel. Installed in accordance with the instructions provided by the manufacturer. Max damper openings not to exceed 76 sq in. per 100 sq ft of ceiling area.
GREENHECK FAN CORP — Model CRD-310WT

4S. **Damper* —** (Optional, to be used with Air Duct Item 3) For use with min 18 in. deep trusses. Max nom 12-3/8 in. long by 14-1/2 in. wide, fabricated from galvanized steel. Installed in accordance with the instructions provided by the manufacturer. Max damper openings not to exceed 90 sq in. per 100 sq ft of ceiling area.
GREENHECK FAN CORP — Model CRD-320WT

4T. **Alternate Ceiling Damper* —** (Optional, to be used with Air Duct Item 3) For use with min 18 in. deep trusses. Max 12 in. diameter damper within max 15 in. by 15 in. register box with max 12 in. by 12 in. register opening fabricated from galvanized steel. Aggregate area of the register opening(s) through the ceiling membrane shall not exceed 72 sq. in. per 100 sq. ft. of ceiling area. Damper assembly installed in accordance with the manufacturer's installation instructions.
RUSKIN COMPANY — Model CFD7T-SR

4U. **Alternate Ceiling Damper* -** (Optional, to be used with Air Duct Item 3) For use with min 18 in. deep trusses. Maximum 20 in. long by 18 in. wide by 2-1/8 in. high, fabricated from galvanized steel. Plenum box maximum size nom. 21 in. long by 18 in. wide by 16 in. high fabricated from either galvanized steel or Classified Air Duct Materials bearing the UL Class 0 or Class 1 rigid air duct material. Installed in accordance with the instructions provided by the manufacturer. Max damper openings not to exceed 180 sq in. per 100 sq ft of ceiling area.

NAILOR INDUSTRIES INC — Types 0755, 0755A, 0756, 0756D, 0757, 0757D, 0757FP, 0757DFP, 0763

SAFE AIR DOWCO — 0455, 0455A, 0456, 0456D, 0457, 0457D, 0457-DB, 0457-CB, 0463-FB, 0457-EB, 0463-GB, 0463

4V. **Alternate Ceiling Damper* —** (Optional, to be used with Air Duct Item 3) For use with min 18 in. deep trusses. Max nom 10-3/8 in. long by 10-3/8 in. wide, fabricated from galvanized steel. Installed in accordance with the instructions provided by the manufacturer. Max damper openings not to exceed 54 sq in. per 100 sq ft of ceiling area.

GREENHECK FAN CORP — Model CRD-300WT

5. **Batts and Blankets* —** (Optional with Items 7 and 7B; Required with Item 7A) — Glass fiber or mineral wool insulation bearing the UL Classification Marking as to Surface Burning Characteristics and/or Fire Resistance. When the resilient channels (Item 6) or furring channels (Item 6A, 6O) are spaced 16 in. OC, the insulation shall be a max of 3-1/2 in. thick, and shall be secured against the subflooring with staples at 12 in. OC or held suspended in the concealed space with 0.090 in. diam galv steel wires attached to the wood trusses at 12 in. OC. When the resilient channels (Item 6) or furring channels (Item 6A, 6O) are spaced a max of 12 in. OC or when the Steel Framing Members (Item 6B) are used, there is no limit in the overall thickness of insulation, and the insulation can be secured against the subflooring, held suspended in the concealed space or draped over the resilient or furring channels (or Steel Framing Members) and gypsum panel membrane. When **Steel Framing Members** (Item 6C) are used, max 3-1/2 in. thick insulation shall be draped over the furring channels (Item 6Ca) and gypsum board ceiling membrane, and friction-fitted between trusses and Steel Framing Members (Item 6Cd). The finished rating has only been determined when the insulation is secured to the subflooring.

5A. **Fiber, Sprayed* —** (Dry Dense Packed 100% Borate Formulation) — As an alternate to Item 5 — When used, the resilient channel and gypsum board attachment is modified as specified in Items 6 and 7 and wire mesh (Item 10) shall be attached to the furring channels to facilitate installation of the material. The finished rating when Fiber, Sprayed is used has not been determined. The fiber is applied without water or adhesive at a nominal dry density of 3.5 lb/ft^3, in accordance with the application instructions supplied with the product. When Item 5A (Fiber, Sprayed) is used, two layers of gypsum board required as described in Item 7. Not evaluated for use with Items 6B, 6C or 6D.
APPLEGATE GREENFIBER ACQUISITION LLC — Insulmax & SANCTUARY to be used with dry application only.

5B. **Fiber, Sprayed* —** (Loose Fill 100% Borate Formulation) — As an alternate to Items 5 and 5A — The finished rating when Fiber, Sprayed is used has not been determined. The fiber is applied without water or adhesive at a minimum dry density of 0.5 lb/ft^3 and at a max thickness of 3-1/2 in., in accordance with the application instructions supplied with the product. Wire mesh (Item 10) shall be attached to the furring channels to facilitate installation of the material. When Item 5B (Fiber, Sprayed) is used, two layers of gypsum board required as described in Item 7. Not evaluated for use with Items 6B, 6C or 6D.
APPLEGATE GREENFIBER ACQUISITION LLC — Insulmax & SANCTUARY to be used with dry application only.

5C. **Cavity Insulation - Batts and Blankets* or Fiber, Sprayed* —** (Required for Item 7C, As described above in Items 5 through 5B) — Min. 3-1/2 in thick with no limit on maximum thickness fitted in the concealed space, draped over the resilient channel (Item 6I)/gypsum board (Item 7C) ceiling membrane.

6. **Resilient Channels —** Resilient channels, formed of 25 MSG thick galv steel, spaced 16 in. OC perpendicular to trusses. When insulation (Items 5, 5A, 5B) is draped over the resilient channel/gypsum board ceiling membrane, the spacing shall be reduced to 12 in. OC. Channels secured to each truss with 1-1/4 in. long Type S bugle head steel screws. Channels overlapped 4 in. at splices. Two channels, spaced 6 in OC, oriented opposite each gypsum board end joint as shown in the above illustration. Additional channels shall extend 6 in beyond each side edge of board.

6A. **Steel Framing Members* —** (Not Shown) — As an alternate to Item 6, furring channels and Steel Framing Members* as described below:
a. **Furring Channels —** Formed of No. 25 MSG galv steel, 2-9/16 in. or 2-23/32 in. wide by 7/8 in. deep, spaced 16 in. OC perpendicular to trusses. When batt insulation (Items 5) is draped over the resilient channel/gypsum board ceiling membrane, the resilient channel spacing shall be reduced to 12 in. OC. Channels secured to trusses as described in Item b. Ends of adjoining channels overlapped 6 in. and tied together with double strand of No. 18 SWG galv steel wire near each end of overlap.

b. **Steel Framing Members* —** Used to attach furring channels (Item a) to trusses (Item 2). Clips spaced 48 in. OC. RSIC-1 and RSIC-1 (2.75) clips secured to alternating trusses with No. 8 x 2-1/2 in. coarse drywall screw through the center grommet. RSIC-Si-X secured with No. 10 x 3-1/2 in. screws. RSIC-V and RSIC-V (2.75) clips secured to alternating trusses with No. 8 x 1-1/2 in. coarse drywall screw through the center hole. Furring channels are friction fitted into clips. RSIC-1, RSIC-Si-X, and RSIC-V clips for use with 2-9/16 in. wide furring channels. RSIC-1 (2.75) and RSIC-V (2.75) clips for use with 2-23/32 in. wide furring channels. Adjoining channels are overlapped as described in Item a. As an alternate, ends of adjoining channels may be overlapped 6 in. and secured together with two self-tapping No. 6 framing screws, min 7/16 in. long at the midpoint of the overlap, with one screw on each flange of the channel. Additional clips required to hold furring channel that supports the gypsum board butt joints, as described in Item 7.
PAC INTERNATIONAL L L C — Types RSIC-1, RSIC-V, RSIC-Si-X, RSIC-1 (2.75), RSIC-V (2.75).

6B. **Alternate Steel Framing Members —** (Not Shown) — As an alternate to Items 6 and 6A, main runners, cross tees, cross channels and wall angle as listed below.

a. **Main Runners —** Nom 10 or 12 ft long, 15/16 in. or 1-1/2 in. wide face, spaced 4 ft. OC. Main runners suspended by min 12 SWG galv steel hanger wires spaced 48 in. OC. Hanger wires to be located adjacent to main runner/cross tee intersections. Hanger wires wrapped and twist-tied on 16d nails driven in to side of trusses at least 5 in. above the bottom face.

b. **Cross Tees or Channels —** Nom 4 ft long cross tees, with 15/16 in. or 1-1/2 in. wide face, or nom 4 ft long cross channels, with 1-1/2 in. wide face, either spaced 16 in. OC, installed perpendicular to the main runners. Additional cross tees or channels used 8 in. from each side of butted gypsum board end joints. The cross tees or channels may be riveted or screw-attached to the wall angle or channel to facilitate the ceiling installation.

c. **Wall Angle or Channel —** Painted or galv steel angle with 1 in. legs or channel with 1 in. legs, 1-9/16 in. deep attached to walls at perimeter of ceiling with fasteners 16 in. OC. To support steel framing member ends and for screw-attachment of the gypsum panel.
CGC INC — Type DGL or RX.

USG INTERIORS LLC — Type DGL or RX.

6C. **Steel Framing Members* —** (Not Shown) — As an alternate to Items 6, 6A and 6B.
a. **Furring Channels —** Hat-shaped furring channels, 7/8 in. deep by 2-5/8 in. wide at the base and 1-1/4 in. wide at the face, formed from No. 25 ga. galv steel, spaced max. 16 in. OC perpendicular to trusses and Cold Rolled Channels (Item 6Cb). Furring channels secured to Cold Rolled Channels at every intersection with a 1/2 in. pan head self-drilling screw through each furring channel leg. Ends of adjoining channels overlapped 4 in. and tied together with two double strand No. 18 SWG galv steel wire ties, one at each end of overlap. Supplemental furring channels at base layer and outer layer gypsum board butt joints are not required. Batts and Blankets draped over furring channels as described in Item 5. Two layers of gypsum board attached to furring channels as described in Item 7.

b. **Cold Rolled Channels —** 1-1/2 in. by 1/2 in., formed from No. 16 ga. galv steel, positioned vertically and parallel to trusses, friction-fitted into the channel caddy on the Steel Framing Members (Item 6Cd). Adjoining lengths of cold rolled channels lapped min. 6 in. and wire-tied together with two double strand 18 SWG galv steel wire ties, one at each end of overlap.

c. **Blocking —** Where truss design does not permit direct, full contact of the hanger bracket, a piece of nominal 2 by 4 in. lumber (blocking), min. 6 in. long to permit full contact of the hanger bracket, to be secured vertically to the side of the truss (Item 2) at the top and bottom of the blocking at each Steel Framing Member (Item 6Cd) location.

d. **Steel Framing Members* —** Hangers spaced 48 in. OC. max along truss, and secured to the Blocking (Item 6Cc) on alternating trusses with a single 5/16 in. by 2 in. hex head lag bolt or four #6 1-1/4 in. drywall screws through mounting hole(s) on the hanger bracket. The two 1/4 in. long steel teeth on the hanger are embedded in the side of the blocking. Hanger positioned on blocking and leveling bolt height adjusted such that furring channels are flush with bottom of trusses before gypsum board installation. Spring gauge of hanger chosen per manufacturer\'s instructions.
KINETICS NOISE CONTROL INC — Type ICW.

6D. **Steel Framing Members* —** (Not Shown) — As an alternate to Items 6, 6A, 6B and 6C.
a. **Furring Channels —** Formed of No. 25 MSG galv steel, 2-3/8 in. wide by 7/8 in. deep, spaced 16 in. OC perpendicular to wood structural members. When insulation, Items 5 or 5A is applied over the furring channel/gypsum panel ceiling membrane, the furring channel spacing shall be reduced to 12 in. OC. Channels secured to trusses as described in Item b. Ends of adjoining channels overlapped 6 in. and tied together with double strand of No. 18 AWG galv steel wire near each end of overlap.

b. **Steel Framing Members* —** Used to attach furring channels (Item a) to trusses (Item 2). Clips spaced 48 in. OC, and secured to the bottom chord of alternating trusses with two No. 8 x 2-1/2 in. course drywall screws, one through the hole at each end of the clip. When insulation, Items 5 or 5A is applied over the furring channel/gypsum panel ceiling membrane, the clip spacing shall be reduced to 24 in. OC and secured to consecutive trusses. Furring channels are friction fitted into clips. Adjoining channels are overlapped as described in Item a. As an alternate, ends of adjoining channels may be overlapped 6 in. and secured together with two self-tapping No. 6 framing screws, min 7/16 in. long at the midpoint of the overlap, with one screw on each flange of the channel. Additional clips required to hold furring channel that supports the gypsum board butt joints, as described in Item 7. Two layers of gypsum board required as described in Item 7. Not evaluated for use with Item 5B.
KINETICS NOISE CONTROL INC — Type Isomax.

6E. **Steel Framing Members* —** (Optional, Not Shown) — Used as an alternate method to attach min. 1/2 in. deep resilient channels (Item 6) to wood trusses (Item 2). Resilient channels are friction fitted into clips, and then clips are secured to the bottom chord of each wood truss with a min. 1-3/4 in. long Type S bugle head steel screw through the center hole of the clip and the resilient channel flange. Adjoining resilient channels are overlapped 4 in. under trusses. The clip flange is opened slightly to accommodate the two overlapped channels. Additional clips required to hold resilient channel that supports the gypsum board butt joints, as described in Item 7.
KEENE BUILDING PRODUCTS CO INC — Type RC Assurance.

6F. **Steel Framing Members —** (Not Shown) — As an alternate to Item 6, furring channels and Steel Framing Members* as described below:
a. **Furring Channels —** Formed of No. 25 MSG galv steel, 2-3/8 in. wide by 7/8 in. deep, spaced 16 in. OC perpendicular to trusses. When batt insulation (Items 5) is draped over the resilient channel/gypsum board ceiling membrane, the resilient channel spacing shall be reduced to 12 in. OC. Channels secured to trusses as described in Item b. Ends of adjoining channels overlapped 6 in. and tied together with double strand of No. 18 SWG galv steel wire near each end of overlap.

b. **Steel Framing Members* —** Used to attach furring channels (Item a) to trusses (Item 2). Clips spaced 48 in. OC. GenieClips secured to alternating joists with No. 8 x 2-1/2 in. coarse drywall screw through the center grommet. When insulation, Items 5 is applied over the furring channel/gypsum panel ceiling membrane, the clip spacing shall be reduced to 24 in. OC and secured to consecutive trusses. Furring channels are friction fitted into clips. Adjoining channels are overlapped as described in Item a. As an alternate, ends of adjoining channels may be overlapped 6 in. and secured together with two self-tapping No. 6 framing screws, min 7/16 in. long at the midpoint of the overlap, with one screw on each flange of the channel. Additional clips required to hold furring channel that supports the gypsum board butt joints, as described in Item 7. Not evaluated for use with Item 5A or 5B.
PLITEQ INC — Type GENIECLIP

6G. **Alternate Steel Framing Members* —** (Not Shown) — As an alternate to items 6-6F, furring channels and Steel Framing Members as described below.
a. **Furring Channels —** Formed of No. 25 MSG galv steel, 2-5/8 in. wide by 7/8 in deep, spaced 16 in OC, perpendicular to trusses. When batt insulation (Items 5) is draped over the resilient channel/gypsum board ceiling membrane, the resilient channel spacing shall be reduced to 12 in. OC. Channels secured to trusses as described in Item b.

b. **Steel Framing Members* —** Used to attach furring channels (Item a) to trusses (Item 2). Clips spaced at 48" OC and secured to the bottom of the joists with one 2 in. Coarse Drywall Screw with 1 in. diam washer through the center hole. Furring channels are then friction fitted into clips. Ends of channels are overlapped 6" and tied together with double strand of No. 18 AWG galvanized steel wire Additional clips are required to hold the Gypsum Butt joints as described in item 7B.
STUDCO BUILDING SYSTEMS — RESILMOUNT Sound Isolation Clips - Type A237 or A237R

6H. **Alternate Steel Framing Members* —** (Not Shown) — As an alternate to items 6-6G, furring channels and Steel Framing Members as described below.
a. **Furring Channels —** Formed of No. 25 MSG galv steel, 2-1/2 in. wide by 7/8 in deep, spaced 16 in OC, perpendicular to trusses. When batt insulation (Items 5) is draped over the resilient channel/gypsum board ceiling membrane, the resilient channel spacing shall be reduced to 12 in. OC. Channels secured to trusses as described in Item b.

b. **Steel Framing Members* —** Used to attach furring channels (Item a) to trusses (Item 2). Clips spaced at 48" OC and secured to the bottom of the trusses with one 2-1/2 in. Coarse Drywall Screw with 1 in. diam washer through the center hole. Furring channels are then friction fitted into clips. Ends of channels are overlapped 6" and tied together with double strand of No. 18 AWG galvanized steel wire Additional clips are required to hold the Gypsum Butt joints as described in item 7B.
REGUPOL AMERICA — Type SonusClip

6I. **Resilient Channels —** For Use With Item 7C - Formed from min 25 MSG galv. steel installed perpendicular to trusses and spaced 16 in. OC. Channels secured to each truss with 1-5/8 in. long Type S bugle head steel screws. Channels overlapped 4 in. at splices. Two channels, spaced 6 in. OC, oriented opposite each gypsum panel end joint. Additional channels shall extend min 6 in. beyond each side edge of panel. Insulation, Item 5C is applied over the resilient channel/gypsum panel ceiling membrane.

6J. **Steel Framing Members* —** (Optional, Not Shown) — As an alternate to Item 6.
a. **Furring Channels —** Formed of No. 25 MSG galv steel, nominal 2-1/2 in. wide by 7/8 in. deep, spaced as indicated in Item 6, perpendicular to the trusses. Channels secured to Cold Rolled Channels at every intersection with a 3/4 in. TEK screw through each furring channel leg. Ends of adjoining channels overlapped 12 in. and fastened together with two double strand No. 18 SWG galv steel wire ties, one at each end of overlap, or with two 3/4 in. TEK screws in each leg of the overlap section. Two furring channels used at end joints of gypsum board (Item 7), each extending a min of 6 in. beyond both side edges of the board.

b. **Cold Rolled Channels —** 1-1/2 in. by 1/2 in., formed from No. 16 ga. galv steel, positioned vertically and parallel to trusses, friction-fitted into the channel caddy on the Steel Framing Members (Item 6Jd) and secured with two 3/4 in. TEK screws. Adjoining lengths of cold rolled channels lapped min. 12 in. and secured along bottom legs with four 3/4 in. TEK screws and wire-tied together with two double strand 18 SWG galv steel wire ties, one at each end of overlap.

c. **Blocking —** Where truss design does not permit direct, full contact of the hanger bracket, a piece of nominal 2 by 4 in. lumber (blocking), min. 12 in. long to permit full contact of the hanger bracket, to be secured vertically to the side of the trusses at the top and bottom of the blocking at each Steel Framing Member (Item 6Jd) location with 16d nails or minimum 2-1/2 in. screws. d. Steel Framing Members* — Spaced 48 in. OC. max along truss, and secured to the truss on alternating trusses with two, #10 x 1-1/2 in. screws through mounting holes on the hanger bracket.
PAC INTERNATIONAL L L C — Type RSIC-SI-CRC EZ Clip

6K. **Steel Framing Members* —** (Not Shown) — As an alternate to Item 6.
a. **Furring Channels —** Formed of No. 25 MSG galv steel, nominal 2-1/2 in. wide by 7/8 in. deep, spaced as indicated in Item 6, perpendicular to trusses and friction fit into Steel Framing Members (Item 6Kc). Ends of adjoining channels overlapped 6 in. and tied together with double strand of No. 18 SWG galv steel wire near each end of overlap or with two TEK screws along each leg of the 6 in. overlap. Two furring channels used at end joints of gypsum board (Item 7). Butt joint channels held in place by strong back channels placed upside down, on top of, and running perpendicular to primary furring channels, extending 6 in. longer than length of gypsum side joint. Strong back channels spaced maximum 48 in. OC. Strong back channels secured to every intersection of primary furring channels with four 7/16 in. pan head screws, two along each of the legs at intersections. Butt joint channels run perpendicular to strong back channels and shall be minimum 6 in. longer than length of joint, secured to strong back channels with 7/16 in. pan head screws, two along each of the legs at intersection with strong back channels.

b. **Blocking —** Where truss design does not permit direct, full contact of the hanger bracket, a piece of nominal 2 by 4 in. lumber (blocking), min. 12 in. long to permit full contact of the hanger bracket, to be secured vertically to the side of the trusses at the top and bottom of the blocking at each Steel Framing Member (Item 6Kc) location with 16d nails or minimum 2-1/2 in. screws.

c. **Steel Framing Members* —** Used to attach furring channels (Item 6Ka) to trusses. Clips spaced 48 in. OC and secured along truss webs at each furring channel intersection with min. 3/4 in. long self-drilling #10 x 1-1/2 in. screws through each of the provided hole locations. Furring channels are friction fitted into clips.
PAC INTERNATIONAL L L C — Type RSIC-S1-1 Ultra

6L. **Steel Framing Members* —** (Optional - Not Shown) — Used to attach resilient channels (Item 6) to trusses (Item 2). Clips spaced 48 in. OC and secured to trusses with one No. 8 x 2-1/2 in. coarse drywall screw through center grommet hole. Channels secured to clips with one #10 x 1/2 in. pan-head self-drilling screw. Ends of adjoining channels overlapped 6 in. and secured together with two #8 15 x 1/2 in. Philips Modified screws spaced 2-1/2 in. from the center of the overlap. Gypsum board butt joints require additional resilient channels spaced 1-1/2 in. from the butt joint on either side. One edge of the extra channels will extend to an adjacent truss where it is secured with a clip.
KEENE BUILDING PRODUCTS CO INC — Type RC+ Assurance Clip

6M. **Steel Framing Members* —** (Optional, Not Shown) — Used as an alternate method to attach resilient channels to structural members. A resilient sound isolation accessory shall be used at each attachment point of the resilient channels and spaced max 24 in. O.C. Channel ends butted and centered under the structural members and attached with one accessory at each end. Additional accessories used to hold resilient channels that support the gypsum board end joints. The accessory envelops the mounting edge of the resilient channel. The accessory and resilient channel are fastened to the structural members with the screws supplied with the accessory and per the accessory manufacturer's installation instructions. Gypsum Board butt joints staggered minimum 24 in. OC and Gypsum Board screws spaced 8 in. OC when used.
PAC INTERNATIONAL L L C — Type RC-1 Boost

6N. **Resilient Channels —** For use with **American Gypsum Co. Type AG-C gypsum board only**. Resilient channels, formed of 25 MSG thick galv steel, spaced 16 in. OC perpendicular to trusses. When insulation (Items 5, 5A, 5B) is applied over the resilient channel/gypsum board ceiling membrane, the spacing may remain at 16 in. OC. Channels secured to each truss with 1-1/4 in. long Type S bugle head steel screws. Channels overlapped 4 in. at splices. Two channels, spaced 6 in OC, oriented opposite each gypsum board end joint as shown in the above illustration. Additional channels shall extend 6 in beyond each side edge of board.

6O. **Steel Framing Members* —** (Optional, Not Shown, As an alternate to Item 6) — Furring channels and Steel Framing Members as described below:

a. **Furring Channels —** Formed of No. 25 MSG galv steel. 2-23/32 in. wide by 7/8 in. When there is no insulation installed in the concealed space the furring channels are spaced 24 in. OC max perpendicular to trusses. When insulation (Item 5) is secured to the underside of the subfloor the furring channels are spaced 16 in. OC max. When insulation (Item 5) is applied over the furring channel/gypsum panel ceiling membrane, the furring channels are spaced 12 in. OC max. Channels secured to trusses as described in Item 6Ob. Ends of adjoining channels are overlapped 6 in. and tied together with double strand of No. 18 SWG galv steel wire near each end of overlap. As an alternate, ends of adjoining channels may be overlapped 6 in. and secured together with two self-tapping #6 framing screws, min. 7/16 in. long at the midpoint of the overlap, with one screw on each flange of the channel. Additional clips required to hold furring channel that supports the wallboard butt joints, as described in Item 7.

b. **Steel Framing Members* —** Used to attach furring channels (Item 6Oa) to trusses (Item 2). Clips spaced 48 in. OC max with No. 8 x 2-1/2 in. course drywall screw through the center grommet. Furring channels are friction fitted into clips.

CLARKDIETRICH BUILDING SYSTEMS — Type ClarkDietrich Sound Clips

7. **Gypsum Board* —** Nom 5/8 in. thick, 48 in. wide gypsum board. When resilient channels (Item 6) are used, gypsum board installed with long dimension perpendicular to resilient channels. Gypsum board secured with 1 in. long Type S bugle head screws spaced 12 in. OC and located a min of 1/2 in. from side joints and 3 in. from end joints. End joints secured to both resilient channels as shown in end joint detail. When batt insulation (Item 5) is draped over the resilient channel/gypsum board ceiling membrane, screws spacing shall be 8 in. OC. When **Steel Framing Members*** (Item 6A, 6F, 6O) are used, gypsum board installed with long dimension perpendicular to furring channels and side joints of sheet located beneath joists. Gypsum board secured to furring channels with 1 in. long Type S bugle head screws spaced 12 in. OC in the field. Butted end joints shall be staggered min 2 ft within the assembly, and occur between the continuous furring channels. At butted end joints, each end of each gypsum board shall be supported by a single length of furring channel equal to the width of the gypsum board plus 6 in. on each end. The two furring channels shall be spaced approximately 3-1/2 in. OC and be attached to underside of the joist with one clip at each end of the channel. Screw spacing along the end joint shall be 8 in. OC.
When **Steel Framing Members** (Item 6J) are used, nom 5/8 in. thick, 4 ft wide gypsum board, installed as described in Item 7. Adjacent butt joints staggered minimum 48 in. OC.

When **Steel Framing Members** (Item 6K) are used, nom 5/8 in. thick, 4 ft wide gypsum board, installed as described in Item 7. Butt joints staggered minimum 24 in. OC.

AMERICAN GYPSUM CO — Type AG-C

CGC INC — Types C, IP-X2, IPC-AR

CERTAINTEED GYPSUM INC — Type LGFC-C/A

GEORGIA-PACIFIC GYPSUM L L C — Types 5, DAPC, TG-C

PABCO BUILDING PRODUCTS L L C, DBA PABCO GYPSUM — Type C

UNITED STATES GYPSUM CO — Types C, IP-X2, IPC-AR

USG BORAL DRYWALL SFZ LLC — Type C

USG MEXICO S A DE C V — Types C, IP-X2, IPC-AR

7A. **Gypsum Board* —** Nom 5/8 in. thick, 48 in. wide gypsum board, installed with long dimension perpendicular to resilient channels. Gypsum board secured with 1-1/8 in. long Type S bugle head screws spaced 8 in. OC and located a min of 1/2 in. from side joints and 3 in. from the end joints. End joints secured to both resilient channels as shown in end joint detail. When Item 7A is used, the insulation must be used and must be draped over the resilient channel/gypsum board.
NATIONAL GYPSUM CO — Types eXP-C, FSW-G, FSW-C, FSK-G, FSK-C

7B. **Gypsum Board* —** Nom 5/8 in. thick, 48 in. wide gypsum panels. When resilient channels (Item 6) are used, gypsum panels installed with long dimension perpendicular to resilient channels. Gypsum panels secured with 1 in. long Type S bugle head steel screws spaced 12 in. OC and located a min of 1/2 in. from side joints and 3 in. from the end joints. When insulation (Items 5 or 5A) is applied over the resilient channel/gypsum panel ceiling membrane screw spacing shall be reduced to 8 in. OC. End joints secured to both resilient channels as shown in end joint detail. When **Steel Framing Members** (Item 6A, 6O) are used, gypsum panels installed with long dimensions perpendicular to furring channels. Panels attached to the furring channels using 1 in. long Type S bugle-head steel screws spaced 8 in. OC along butted end joints and in the field of the panel. Butted end joints shall be staggered min. 2 ft within the assembly, and occur midway between the continuous furring channels. Each end of each gypsum panel shall be supported by a single length of furring channel equal to the width of the gypsum panel plus 6 in. on each end. The two support furring channels shall be spaced approximately 3-1/2 in. OC, and be attached to underside of the truss with one clip at each end of the channel. When **Steel Framing Members*** (Item 6B) are used, gypsum panels installed with long dimension perpendicular to cross tees with side joints centered along main runners and end joints centered along cross tees. Panels fastened to cross tees with 1 in. long . Type S bugle-head screws spaced in the field and 8 in. OC along end joints. Panels fastened to main runners with 1 in. long . Type S bugle-head screws spaced midway between cross tees. Screws along sides and ends of panels spaced 3/8 to 1/2 in. from panel edge. End joints of panels shall be staggered with spacing between joints on adjacent panels not less than 4 2 ft OC. When **Fiber, Sprayed** (Items 5A or 5B) is used, two layers of nom 5/8 in. thick, 4 ft wide gypsum board are installed with long dimensions perpendicular to furring channels. Base layer gypsum board secured with 1 in. long Type S bugle head steel screws spaced 12 in. OC and located a min of 1/2 in. from side joints and 3 in. from the end joints. End joints secured to both resilient channels as shown in end joint detail. Outer layer gypsum board secured with 1-5/8 in. long Type S bugle head steel screws spaced 12 in. OC and located a min of 1/2 in. from side joints and 3 in. from the end joints. Outer layer shall be finished as described in Item 8. When both **Steel Framing Members** (Item 6A) and **Fiber, Sprayed** (Items 5A or 5B) are used, furring channels spaced 12 in. OC and two layers of nom 5/8 in. thick, 4 ft wide gypsum board are installed with long dimension perpendicular to furring channels. Base layer secured to furring channels with nom 1 in. long Type S bugle head screws spaced 8 in. OC along butted end joints and in the field of the board. Butted end joints shall be staggered min. 2 ft within the assembly, and occur midway between the continuous furring channels. Each end of each gypsum board shall be supported by a single length of furring channel equal to the width of the gypsum board plus 6 in. on each end. The two support furring channels shall be spaced approximately 3-1/2 in. OC, and be attached to the underside of the truss with one clip at each end of the channel. Outer layer secured to furring channels using 1-5/8 in. long Type S screws spaced 8 in. OC and 1-1/2 in. from the end joint. Butted end joints to be offset a min. of 8 in. from base layer end joints. Butted side joints of outer layer to be offset min. 18 in. from butted side joints of base layer. When **Steel Framing Members** (Item 6C) are used, two layers of nom 5/8 in. thick, 4 ft wide gypsum board are installed with long dimensions perpendicular to furring channels (Item 6Ca). Base layer attached to the furring channels using 1 in. long Type S bugle head steel screws spaced 8 in. OC along butted end joints and 12 in. OC in the field of the board. Butted end joints centered on the continuous furring channels. Butted base layer end joints to be offset a min of 16 in. in adjacent courses. Outer layer attached to the furring channels using 1-5/8 in. long Type S bugle head steel screws spaced 8 in. OC at butted end joints and 12 in. OC in the field. Butted end joints centered on the continuous furring channels and offset a min of 16 in. from butted end joints of base layer. Butted side joints of outer layer to be offset min 16 in. from butted side joints of base layer. When **Steel Framing Members** (Item 6D) are used, two layers of nom 5/8 in. thick, 4 ft wide gypsum board are installed with long dimensions perpendicular to furring channels. Base layer attached to the furring channels using 1 in. long Type S bugle-head steel screws spaced 12 in. OC in the field of the board. Butted end joints shall be staggered min 2 ft. within the assembly, and occur midway between the continuous furring channels. Each end of each gypsum board shall be supported by a single length of furring channel equal to the width of the gypsum board plus 6 in. on each end. The two furring channels shall be spaced approximately 4 in. OC, and be attached to underside of the truss with one Isomax clip at each end of the channel. Screw spacing along the gypsum board butt joint shall be 8 in. OC. Outer layer attached to the furring channels using 1-5/8 in. long Type S bugle-head steel screws spaced 12 in. OC in the field. The end of the outer layer boards at the butt joint shall be attached to the base layer boards with 1-5/8 in. long Type G screws spaced 8 in. OC and 1-1/2 in. from the end joint. Butted end joints to be offset a min of 8 in. from base layer end joints. Butted side joints of outer layer to be offset min 18 in. from butted side joints of base layer. Outer layer shall be finished as described in Item 8. When **Steel Framing Members** (Item 6F) are used, two layers of nom 5/8 in. thick, 4 ft wide are installed with long dimensions perpendicular to furring channels. Gypsum board secured to furring channels using 1 in. long No. 6 Type S bugle-head steel screws spaced 12 in. OC in the field of the board. Butted end joints shall be staggered minimum 2 ft. within the assembly. Additional furring channels constructed as per Item 6F shall be used to support each end of each gypsum board. These additional furring channels shall be attached to underside of the truss with Genie clips as described in Item 6F. Screw spacing along the gypsum board butt joint shall be 8 in. OC. Outer layer attached to the furring channels using 1-5/8 in. long No. 6 Type S bugle-head steel screws spaced 12 in. OC in the field. The outer layer boards at the butt joint shall be attached to the base layer boards with No. 10, 1-1/2 in. long drywall screws spaced 8 in. OC and 1-1/2 in. from the end joint. Butted end joints to be offset a min of 24 in. from base layer end joints. Butted side joints of outer layer to be offset min 16 in. from butted side joints of base layer. When **Steel Framing Members** (Item 6G) are used, one layer of nom 5/8 in. thick, 4 ft wide gypsum board is installed with long dimensions perpendicular to furring channels. Gypsum board secured to furring channels with nom 1 in. long Type S bugle-head steel screws spaced 8 in. OC in the field of the board. Gypsum board butted end joints shall be staggered minimum 48 in. and centered over main furring channels. At the gypsum board butt joints, each end of each gypsum board shall be supported by a single length of furring channel equal to the width of the gypsum board plus 3 in. on each end. The two support furring channels shall be spaced approximately 3 in. in from joint. Screw spacing along the gypsum board butt joint and along both additional channels shall be 8 in. OC. Additional screws shall be placed in the adjacent section of gypsum board into the aforementioned 3 in. extension of the extra butt joint channels as well as into the main channel that runs between. Butt joint furring channels shall be attached with one RESILMOUNT Sound Isolation Clip at each end of the channel.
When **Steel Framing Members** (Item 6H) are used, one layer of nom 5/8 in. thick, 4 ft wide gypsum board is installed with long dimensions perpendicular to furring channels. Gypsum board secured to furring channels with nom 1 in. long Type S bugle-head steel screws spaced 8 in. OC in the field of the board. Gypsum board butted end joints shall be staggered minimum 48 in. and centered over main furring channels. At the gypsum board butt joints, an additional single length of furring channel shall be installed and be spaced approximately 3 in. from the butt joint (6 in. from the continuous furring channels) to support the floating end of the gypsum board. Each of these shorter sections of furring channel shall extend one truss beyond the width of the gypsum panel and be attached to the adjacent trusses with one SonusClip at every truss involved with the butt joint.

CERTAINTEED GYPSUM INC — Type C

CGC INC — Types C, IP-X2, IPC-AR

CERTAINTEED GYPSUM INC — Type LGFC-C/A

GEORGIA-PACIFIC GYPSUM L L C — Types 5, DAPC, TG-C

PABCO BUILDING PRODUCTS L L C, DBA PABCO GYPSUM — Type C

UNITED STATES GYPSUM CO — Types C, IP-X2, IPC-AR

USG BORAL DRYWALL SFZ LLC — Type C

USG MEXICO S A DE C V — Types C, IP-X2, IPC-AR

7C. **Gypsum Board* —** (As an alternative to Items 7 and 7B, For use with Items 5C and 6I) — Nom 5/8 in. thick, 48 in. wide gypsum board, installed and secured as described in Items 7 and 7B but with max screw spacing 8 in. OC. When used with insulation (Batts and Blankets* or Fiber Sprayed*) that is installed over the resilient channel/Gypsum Board* ceiling membrane, the resilient channels may remain at 16 in. OC and not need to be reduced to 12 in. OC.
CGC INC — Type ULIX

UNITED STATES GYPSUM CO — ULIX

7D. **Gypsum Board* —** (As an alternative to Items 7, 7A, 7B and 7C) — For use when no insulation is used. Nom 5/8 in. thick, 48 in. wide gypsum board, installed as described in item 7 with resilient channels (Item 6) spaced 24 in OC.

AMERICAN GYPSUM CO — Type AG-C

8. **Finishing System —** (Not Shown) — Vinyl, dry or premixed joint compound, applied in two coats to joints and screw-heads. Nom 2 in. wide paper tape embedded in first layer of compound over all joints. As an alternate, nom 3/32 in. thick veneer plaster may be applied to the entire surface of gypsum board.

9. **Grille —** Grille, installed in accordance with the installation instructions provided with the ceiling damper.

PRINTS ISSUED
10/30/23 PERMIT SUBMITTAL

REVISIONS:

rosemann & ASSOCIATES P.C.
ARCHITECTURE
INTERIOR DESIGN
ENGINEERING
PLANNING

1526 Grand Boulevard
Kansas City, MO 64108-1404
p: 816.472.1448
w: www.rosemann.com
© 2023 Rosemann & Associates, P.C.
DENVER ▲ KANSAS CITY ▲ ST. LOUIS ▲ ATLANTA

STATE OF MISSOURI
DAVID EUGENE HENDRIKSE
NUMBER A-7395
REGISTERED ARCHITECT
10/30/23

WILSHIRE HILLS III
LEE'S SUMMIT, MISSOURI
MHDC - 22-057

SHEET TITLE
UL ASSEMBLIES

PROJECT NUMBER: 23034

SHEET NUMBER:

G-205

10/27/2023 4:08:48 PM
C:\Revit Local Cache\2023\23034_Wilshire Hills III_Central_R23_revit9TUCAR.rvt

UL DESIGN - L546 - CONT.

10. **Wire Mesh —** (Not Shown) — For use with Item 5A and 5B — 1 in. 20 gauge galvanized poultry netting installed between the furring channels and gypsum board. The poultry netting is attached with washers and 1/2 in. wafer head screws, spaced 24 in. OC., to the furring channels. The **Fiber, Sprayed** (Item 5A or 5B) is installed through cut-openings in the poultry netting, in-between trusses. The cut-openings in the poultry netting shall be staggered at a maximum of 6 ft.

*** Indicates such products shall bear the UL or cUL Certification Mark for jurisdictions employing the UL or cUL Certification (such as Canada), respectively.**

Last Updated on 2023-08-04

The appearance of a company's name or product in this database does not in itself assure that products so identified have been manufactured under UL Solutions' Follow - Up Service. Only those products bearing the UL Mark should be considered to be Certified and covered under UL Solutions' Follow - Up Service. Always look for the Mark on the product.

UL Solutions permits the reproduction of the material contained in Product iQ subject to the following conditions: 1. The Guide Information, Assemblies, Constructions, Designs, Systems, and/or Certifications (files) must be presented in their entirety and in a non-misleading manner, without any manipulation of the data (or drawings). 2. The statement "Reproduced from Product iQ with permission from UL Solutions" must appear adjacent to the extracted material. In addition, the reprinted material must include a copyright notice in the following format: "©2023 UL LLC."

UL DESIGN - P545

UL Product **iQ**®

Design/System/Construction/Assembly Usage Disclaimer

- Authorities Having Jurisdiction should be consulted in all cases as to the particular requirements covering the installation and use of UL Certified products, equipment, system, devices, and materials.
- Authorities Having Jurisdiction should be consulted before construction.
- Fire resistance assemblies and products are developed by the design submitter and have been investigated by UL for compliance with applicable requirements. The published information cannot always address every construction nuance encountered in the field.
- When field issues arise, it is recommended the first contact for assistance be the technical service staff provided by the product manufacturer noted for the design. Users of fire resistance assemblies are advised to consult the general Guide Information for each product category and each group of assemblies. The Guide Information includes specifics concerning alternate materials and alternate methods of construction.
- Only products which bear UL's Mark are considered Certified.

BXUV - Fire Resistance Ratings - ANSI/UL 263 Certified for United States
BXUV7 - Fire Resistance Ratings - CAN/ULC-S101 Certified for Canada

See General Information for Fire-resistance Ratings - ANSI/UL 263 Certified for United States
Design Criteria and Allowable Variances

See General Information for Fire Resistance Ratings - CAN/ULC-S101 Certified for Canada
Design Criteria and Allowable Variances

Design No. **P545**

June 26, 2023

Unrestrained Assembly Rating — 1 Hr.
Finish Rating — 24 or 25 Min (See Items 3 and 3A)
This design was evaluated using a load design method other than the Limit States Design Method (e.g., Working Stress Design Method). For jurisdictions employing the Limit States Design Method, such as Canada, a load restriction factor shall be used — See Guide BXUV or BXUV7

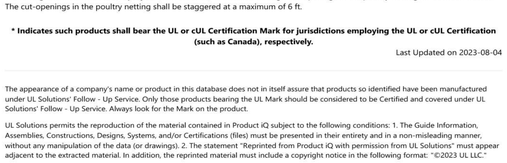

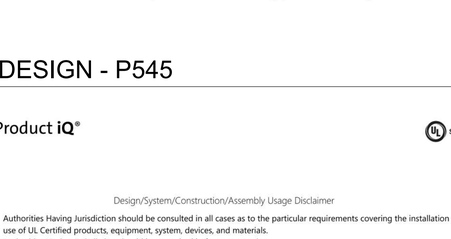

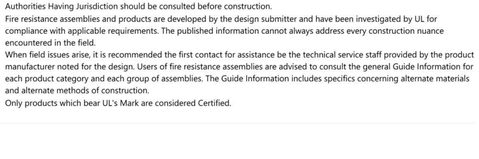

Alternate Insulation Placement

1. **Roofing System* —** Any UL Class A, B or C Roofing System **(TGFU)** or Prepared Roof Covering **(TFWZ)** acceptable for use over nom 15/32 in. thick wood structural panels, min. grade "C-D" or "Sheathing". Nom 15/32 in. thick wood structural panels secured to trusses with No. 6d ringed shank nails. Nails spaced 12 in. OC along each truss. Staples having equal or greater withdrawal and lateral resistance strength may be substituted for the 6d nails. Construction adhesive is optional. Feedback

2. **Trusses —** Pitch chord trusses, spaced a max of 24 in. OC, fabricated from nom 2 by 4 lumber, with lumber oriented vertically or horizontally. Truss members secured together with 0.0356 in. thick galv steel plates. Plates have 5/16 in. long teeth projecting perpendicular to the plane of the plate. The teeth are in pairs facing each other (made by the same punch), forming a split tooth type plate. Each tooth has a chisel point on its outside edge. These points are diagonally opposite each other for each pair. The top half of each tooth has a twist for stiffness. The pairs are repeated on approximately 7/8 in. centers with four rows of teeth per inch of plate width. Where the truss intersects with the interior face of the exterior walls, the min truss depth shall be 5-1/4 in. and a min. average depth of 18 in.. Where the truss intersects with the interior face of the exterior walls, the min truss depth may be reduced to 3 in. if the batts and blankets (Item 3) are used as shown in the above illustration (Alternate Insulation Placement) and are firmly packed against the intersection of the bottom chords and the plywood sheathing. Min roof slope of 3/12 unless American Gypsum boards are used, in which case there is no minimum slope.

3. **Batts and Blankets* —** (Optional) — Glass fiber insulation, secured to the wood structural panels with staples spaced 12 in. OC or to the trusses with 0.090 in. diam galv steel wires spaced 12 in. OC. Any glass fiber insulation bearing the UL Classification Marking as to Surface Burning Characteristics and/or Fire Resistance, having a min density of 0.5 pcf. As an option, the insulation may be fitted in the concealed space, draped over the resilient channel/gypsum wallboard ceiling membrane when resilient channels and gypsum wallboard attachment is modified as specified in Items 6 and 7. The Finish Rating is 24 min. when the insulation is draped over the resilient channels and gypsum board ceiling membrane and 25 min. when it is installed on underside of the plywood deck or when it is omitted.
When Type AG-C panels are installed there is no limit on maximum thickness.

When Type TG-C panels are installed the maximum thickness is 3-1/2 in.

3A. **Loose Fill Material* —** As an alternate to Item 3 — Loose fill material bearing the UL Classification Marking for Surface Burning Characteristics, having a min density of 0.5 pcf, fitted in the concealed space, draped over the resilient channel/gypsum wallboard ceiling membrane when resilient channels and gypsum wallboard attachment is modified as specified in Items 6 and 7. The finished rating when this insulation is used has not been determined.
When Type AG-C panels are installed there is no limit on maximum thickness.

When Type TG-C panels are installed the maximum thickness is 3-1/2 in.

3B. **Fiber, Sprayed* —** For Use With American Gypsum Type AG-C only. As an alternate to Item 3 (not evaluated for use with Item 6B and 6C) — spray-applied cellulose insulation material, having a min density of 0.5 lb/ft^3, applied with water, over the resilient channel/gypsum board ceiling membrane when resilient channels and gypsum board attachment is modified as specified in Items 6 and 7. Fiber, Sprayed is applied with moisture in accordance with the application instructions supplied with the product. The finish rating when Fiber Sprayed is used has not been determined. Alternate application method: The fiber is applied without water or adhesive in accordance with the application instructions supplied with a minimum density of 0.5 lb/ft^3 over the resilient channel/gypsum board ceiling membrane when resilient channels and gypsum board attachment is modified as specified in Items 6 and 7. Alternate application method: The fiber is applied without water or adhesive to a nominal density of 3.5 lb/ft^3 behind netting (Item 11) stapled to the rafters. The netting is stapled at both lower edges of the rafters creating a cavity to accept the cellulose fiber The finished rating when this insulation is used has not been determined.
When Type AG-C panels are installed there is no limit on maximum thickness.

When Type TG-C panels are installed the maximum thickness is 3-1/2 in.

APPLEGATE GREENFIBER ACQUISITION LLC — INS735, INS745, INS750LD, Insulmax, and SANCTUARY for use with wet or dry application. INS510LD, INS515LD, INS541LD, INS735, INS765LD, and INS773LD are to be used for dry application only.

3C. **Foamed Plastic* —** For Use With American Gypsum Type AG-C only. (As an alternate to Item 3, Not Shown) — Spray foam insulation applied directly to the underside of the underside of the roofing system (Item 1). Spray foam insulation installed to a maximum thickness of 10 in. at a nominal 0.5 lb/ft^3 density, while maintaining a minimum 8-1/2 in. clearance between the spray foam insulation and the gypsum board. When spray foam insulation is used, resilient channels (Item 6) shall be installed maximum 12 in. OC, with channels adjacent to butt joints of gypsum board (Item 7) installed at 6 in. OC to allow for maximum 3 in. spacing off ends of the gypsum board joints. Gypsum board to be installed using 1-1/4 in. long Type S screws, spaced maximum 8 in. OC, and butted end joints shall be staggered min. 2 ft within the assembly, and occur midway between the continuous furring channels. If used with a ceiling damper (Items 5 through 5AC) in the concealed space, minimum 1 in. clearance to be maintained between damper housing and spray foam insulation. Limited to resilient channels, Item 6 only, no Item 6 alternates. The finished rating when this insulation is used has not been determined.
SES FOAM INC — Sucraseal Feedback

3D. **Foamed Plastic* —** For Use With American Gypsum Type AG-C only. (As alternate to Item 3 Not Shown) — Spray foam insulation applied directly to the underside of the roofing system. Spray foam insulation installed to a maximum thickness of 10 in. at a nominal 0.5 lb/ft^3 or 2.0 lb/ft^3 density, depending on the product installed. When spray foam insulation is installed, resilient channels (Item 6) shall be installed maximum 12 in. OC, with channels adjacent to butt joints of gypsum board spaced maximum 3 in. away from gypsum butt joints. Gypsum board to be installed using minimum 1-1/4 in. long Type S screws, spaced maximum 8 in. OC, and butted end joints shall be staggered min. 2 ft within the assembly, and occur midway between the continuous furring channels. If used with a ceiling damper (Items 5 through 5AC) in the concealed space, minimum 1 in. clearance to be maintained between damper housing and spray foam insulation. Limited to resilient channels, Item 6 only, no Item 6 alternates. The finished rating when this insulation is used has not been determined.
BASF CORP — Enertite® NM, Enertite® G, FE178®, Spraytite® 178, Spraytite® 81206, Walltite® 200, Walltite® US, Walltite® US-N, and Walltite® HP+

3E. **Foamed Plastic* —** For Use With American Gypsum Type AG-C only. (As an alternate to Item 3, Not Shown) — Spray foam insulation applied directly to the underside of the underside of the roofing system. Spray foam insulation installed to a maximum thickness of 17 in. at a nominal 0.5 lb/ft^3 density, while maintaining a minimum 1-1/2 in. clearance between the spray foam insulation and the gypsum board. When spray foam insulation is used, resilient channels (Item 6) shall be installed maximum 12 in. OC, with channels adjacent to butt joints of gypsum board installed at 6 in. OC to allow for maximum 3 in. spacing off ends of the gypsum board joints. Gypsum board to be installed using 1-1/4 in. long Type S screws, spaced maximum 8 in. OC, and butted end joints shall be staggered min. 2 ft within the assembly, and occur midway between the continuous furring channels. If used with a ceiling damper (Items 5 through 5AC) in the concealed space, no clearance is necessary between damper housing and spray foam insulation. Limited to resilient channels, Item 6 only, no Item 6 alternates. The finished rating when this insulation is used has not been determined.
SES FOAM INC — EasySeal.5, EasySeal ULD

3F. **Foamed Plastic* —** (As alternate to Item 3 - not to be used in combination with any alternates to item 3) — Spray foam insulation applied directly to the underside of the underside of the roofing system. Spray foam insulation installed to a maximum thickness of 11 in. at a nominal 1.0 lb/ft^3 - 2.5 lb/ft^3 density, while maintaining a minimum 7 in. clearance between the spray foam insulation and the gypsum board (Item 7). Spray foam insulation is limited for use with minimum 18 in. deep trusses (Item 2). When spray foam insulation is installed, resilient channels (Item 6) shall be installed maximum 12 in. OC, with channels adjacent to butt joints of gypsum board spaced maximum 3 in. away from gypsum butt joints. Gypsum board to be installed using minimum 1-1/4 in. long Type S screws, spaced maximum 8 in. OC, and butted end joints shall be staggered min. 2 ft within the assembly, and occur midway between the continuous furring channels, as illustrated above. If used with a ceiling damper (Items 5 through 5AC) in the concealed space, no clearance is necessary between damper housing and spray foam insulation. Only for use with item 5 not evaluated for use with alternates to item 5. Only for use with item 6 not evaluated for use with alternates to item 6.
CARLISLE SPRAY FOAM INSULATION — Types SealTite Pro Closed Cell (CC), SealTite Pro Open Cell (OC), SealTite Pro OCX, SealTite Pro No Trim 21, SealTite Pro One Zero, SealTite PRO HFO, Foamulate Closed Cell, Foamulate OCX, Foamulate 70, Foamulate HFO, and Foamulate HFO 2.0.

4. **Air Duct* —** For use with **Ceiling Damper*** - Any UL Class 0 or Class 1 flexible air duct installed in accordance with the instructions provided by the damper manufacturer.

5. **Ceiling Damper* —** Nom 20 in. long by 18 in. wide by 2-1/8 in. high, fabricated from galvanized steel. Plenum box maximum size nom. 21 in. long by 18 in. wide by 16 in. high fabricated from either galvanized steel or Classified Air Duct Materials bearing the UL Class 0 or Class 1 rigid air duct material. Installed in accordance with the instructions provided by the manufacturer. Max damper openings not to exceed 180 sq in. per 100 sq ft of ceiling area.
NAILOR INDUSTRIES INC — Types 0755, 0755A, 0756, 0756D, 0757, 0757D, 0757FP, 0757DFP, 0758, 0759, 0760, 0761, 0762, 0763, CRD5, CRD5D, CRD6, CRD6D, CRD6FP, CRD6DFP.

SAFE AIR DOWCO — 0455, 0455A, 0456, 0456D, 0457, 0457D, 0457-DB, 0457-CB, 0463-FB, 0457-EB, 0463-GB, 0463

5A. **Alternate Ceiling Damper* —** Max plenum box size nom 19 in. long by 19 in. wide and 11-7/8 in. high fabricated from galv steel. Aggregate damper openings shall not exceed 128 sq in. per 100 sq ft of ceiling area. Damper installed in accordance with the manufacturers installation instructions provided with the damper.
AIRE TECHNOLOGIES INC — Models: CRD model 50 w/Boot, CRD model 50EA w/Boot, CRD model 55 w/Boot, CRD model 55 EA w/Boot Feedback

LLOYD INDUSTRIES INC — Model CRD 50-BT, CRD 50-EA-BT, CRD 55-BT, CRD 55 EA-BT

5B. **Alternate Ceiling Damper* —** Max plenum box size nom 13 in. long by 13 in. wide and 11-7/8 in. high fabricated from galv steel. Aggregate damper openings shall not exceed 50 sq in. per 100 sq ft of ceiling area. Damper installed in accordance with the manufacturers installation instructions provided with the damper.

LLOYD INDUSTRIES INC — Model CRD 50-BT-6, CRD 50-EA-BT-6, CRD 55-BT-6, CRD 55 EA-BT-6, CRD50-M X-BT-6

5C. **Alternate Ceiling Damper* —** Max size ceiling outlet in plenum box nom 12 in. long by 12 in. wide. Plenum box fabricated from galv steel. Aggregate damper openings shall not exceed 72 sq in. per 100 sq ft of ceiling area. Installed in accordance with the manufacturers installation instructions provided with the damper.
AIRE TECHNOLOGIES INC — Models: CRD model 50 w/Boot, CRD model 50EA w/Boot, CRD model 55 w/Boot, CRD model 55 EA w/Boot

LLOYD INDUSTRIES INC — Model CRD 50-95BT, CRD 50-EA-95BT, CRD 55-95BT, CRD 55 EA-95BT

5D. **Alternate Ceiling Damper* —** Max size ceiling outlet in plenum box nom 16 in. long by 16 in. wide. Aggregate damper openings shall not exceed 128 sq in. per 100 sq ft of ceiling area. Damper installed in accordance with the manufacturers installation instructions provided with the damper.
LLOYD INDUSTRIES INC — Models CRD 50- FGPB-4.2, - 4.2 NI, -6.0, -6.0 NI; CRD50-EA-FGPB-4.2, -4.2 NI, -6.0, -6.0 NI

5E. **Alternate Ceiling Damper* —** Max plenum box size nom 15 in. long by 15 in. wide and 11-7/8 in. high fabricated from galv steel. Aggregate damper openings shall not exceed 72 sq in. per 100 sq ft of ceiling area. Damper installed in accordance with the manufacturers installation instructions provided with the damper.
LLOYD INDUSTRIES INC — Models 45-CRD-LT-BT and 45-CRD-LTD-BT

5F. **Alternate Ceiling Damper* —** Max size ceiling outlet in plenum box nom 10 in. long by 10 in. wide. Plenum box fabricated from galv steel. Aggregate damper openings shall not exceed 50 sq in. per 100 sq ft of ceiling area. Installed in accordance with the manufacturers installation instructions provided with the damper.
LLOYD INDUSTRIES INC — Model 45-LTD-95-BT-4

5G. **Alternate Ceiling Damper* —** Max plenum box size nom 19 in. long by 15 in. wide and 11-7/8 in. high fabricated from galv steel. Aggregate damper openings shall not exceed 96 sq in. per 100 sq ft of ceiling area. Damper installed in accordance with the manufacturers installation instructions provided with the damper.
LLOYD INDUSTRIES INC — Model CRD50-M X-BT

5H. **Alternate Ceiling Damper* —** Max nom area shall be 324 sq in. Max square size shall be 18 in. by 18 in. Rectangular sizes not to exceed 324 sq in. with a max width of 18 in. Max height of damper shall be 14 in. Aggregate damper openings shall not exceed 162 sq in. per 100 sq ft of ceiling area. Damper installed in accordance with the manufacturers installation instructions provided with the damper. A steel grille (Item 9) shall be installed in accordance with installation instructions.
C&S AIR PRODUCTS — Model RD-521

POTTORFF — Model CFD-521

5I. **Alternate Ceiling Damper* —** Max nom area shall be 196 sq in. Max square size shall be 14 in. by 14 in. Rectangular sizes not to exceed 196 sq in. with a max width of 26 in. Max height of damper shall be 7 in. Aggregate damper openings shall not exceed 98 sq in. per 100 sq ft of ceiling area. Damper installed in accordance with the manufacturers installation instructions provided with the damper. A steel grille (Item 9) not to exceed 144 in.2 shall be installed in accordance with installation instructions.
C&S AIR PRODUCTS — Model RD-521-BT

POTTORFF — Model CFD-521-BT

5J. **Alternate Ceiling Damper* —** Max nom area shall be 256 sq in. with the length not to exceed 24 in. and the width not to exceed 20 in. Max height of damper shall be 17 in. Aggregate damper openings shall not exceed 128 sq in. per 100 sq ft of ceiling area. Damper installed in accordance with the manufacturers installation instructions provided with the damper. A steel grille (Item 9) shall be installed in accordance with installation instructions.
C&S AIR PRODUCTS — Model RD-521-IP, RD-521-NP Feedback

POTTORFF — Models CFD-521-IP, CFD-521-NP

5K. **Alternate Ceiling Damper* —** Max nom area shall be 144 sq in. with the length not to exceed 14 in. and the width not to exceed 12 in. Max height of damper shall be 17-7/8 in. Aggregate damper openings shall not exceed 74 sq in. per 100 sq ft of ceiling area. Damper installed in accordance with the manufacturers installation instructions provided with the damper. A steel grille (Item 9) shall be installed in accordance with installation instructions.
C&S AIR PRODUCTS — Model RD-521-90, RD-521-NP90

POTTORFF — Models CFD-521-90, CFD-521-90NP

5L. **Alternate Ceiling Damper* —** (Optional) Max nom area shall be 324 sq in. Max square size shall be 18 in. by 18 in. Rectangular sizes not to exceed 324 sq in. with a max width and max length of 18 in. Max round size shall be 18 in. dia. Aggregate damper openings shall not exceed 162 sq in. per 100 sq ft of ceiling area. Damper installed in accordance with the manufacturers installation instructions provided with the damper.
RUSKIN COMPANY — Models CFD7T, CFD7T-END-BT, CFD7T-90-BT, CFD7T-ST-BT, CFD7T-SB, CFD7T-R6-DB, CFD7T-IB6, or CFDR7T

5M. **Alternate Ceiling Damper* —** Ceiling damper & fan assembly. Max nom area shall be 75 sq in. with the length not to exceed 8-9/16 in. and the width not to exceed 8-3/4 in. Max height of damper shall be 9-7/8 in. Aggregate damper openings shall not exceed 38 sq in. per 100 sq ft of ceiling area. Damper shall be installed in combination with one of the fan models described in, and in accordance with, the manufacturers installation instructions provided with the damper. A plastic grille shall be installed in accordance with installation instructions.
DELTA ELECTRONICS INC — Models CRD2, GBR-CRD, ITG-CRD

5N. **Alternate Ceiling Damper* —** Max nom area shall be 324 sq in. Max square size shall be 18 in. by 18 in. Rectangular sizes not to exceed 324 sq in. with a max length of 20 in. and a max width of 22 in. Max height of damper shall be 14 in. Aggregate damper openings shall not exceed 154 sq in. per 100 sq ft of ceiling area. Damper installed in accordance with the manufacturer's installation instructions provided with the damper. An aluminum or steel grille shall be installed in accordance with installation instructions.
UNITED ENERTECH CORP — Type C-S/R-WT or C-S/R-WTP (Max nom area 324 sq. in.) or C-S/R-WTS or C-S/R-WTPS (Max nom area 162 sq. in.)

5O. **Alternate Ceiling Damper* —** Ceiling damper & fan assembly. Max nom area shall be 75 sq in. with the length not to exceed 9-1/4 in. and the width not to exceed 9-3/4 in. Max height of damper shall be 9-7/8 in. Aggregate damper openings shall not exceed 45 sq in. per 100 sq ft of ceiling area. Damper shall be installed in combination with one of the fan models described in, and in accordance with, the manufacturer's installation instructions provided with the damper. A plastic grille shall be installed in accordance with installation instructions.
DELTA ELECTRONICS INC — Model SIG-CRD

5P. **Alternate Ceiling Damper* —** Ceiling damper & fan assembly. Max nom area shall be 131 sq in. with the length not to exceed 11-1/16 in. and the width not to exceed 11-7/8 in. Aggregate damper openings shall not exceed 66 sq in. per 100 sq ft of ceiling area. Damper shall be installed in combination with one of the fan models described in, and in accordance with, the manufacturer's installation instructions provided with the damper. A plastic grille (Item 9) shall be installed in accordance with installation instructions.
DELTA ELECTRONICS INC — Model SMT-CRD

5Q. **Alternate Ceiling Damper* —** Ceiling damper & fan assembly. Max nom area shall be 103 sq in. with the length not to exceed 10-1/8 in. and the width not to exceed 10-1/8 in. Aggregate damper openings shall not exceed 52 sq in. per 100 sq ft of ceiling area. Damper shall be installed in combination with one of the fan models described in, and in accordance with, the manufacturer's installation instructions provided with the damper. A plastic grille shall be installed in accordance with installation instructions.
PANASONIC CORPORATION, PANASONIC CORPORATION OF NORTH AMERICA — Model PC-RD0SC5

5R. **Alternate Ceiling Damper* —** Ceiling damper & fan assembly. Max nom area shall be 113 sq in. with the length not to exceed 10-1/8 in. and the width not to exceed 11-1/8 in. Aggregate damper openings shall not exceed 57 sq in. per 100 sq ft of ceiling area. Damper shall be installed in combination with one of the fan models described in, and in accordance with, the manufacturer's installation instructions provided with the damper. A plastic grille shall be installed in accordance with installation instructions.
BROAN-NUTONE L L C — Model RDFUWT Feedback

5S. **Alternate Ceiling Damper* —** Ceiling damper & fan assembly. Max nom area shall be 79 sq in. with the length not to exceed 10 in. and the width not to exceed 7-15/16 in. Aggregate damper openings shall not exceed 40 sq in. per 100 sq ft of ceiling area. Damper shall be installed in combination with one of the fan models described in, and in accordance with, the manufacturer's installation instructions provided with the damper. A metallic grille shall be installed in accordance with installation instructions.

BROAN-NUTONE L L C — Models RDJ1 and RDH

5T. **Alternate Ceiling Damper* —** Max plenum box size nom 19 in. long by 19 in. wide and 11-7/8 in. high fabricated from galv steel. Aggregate damper openings shall not exceed 128 sq in. per 100 sq ft of ceiling area. Damper installed in accordance with the manufacturers installation instructions provided with the damper.
METAL-FAB INC — Models MSCD-HC and MRCD-HC

5U. **Alternate Ceiling Damper* —** Ceiling damper & fan assembly. Max nom area shall be 87 sq in. with the length not to exceed 9 in. and the width not to exceed 9-11/16 in. Aggregate damper openings shall not exceed 44 sq in. per 100 sq ft of ceiling area. Damper shall be installed in combination with one of the fan models described in, and in accordance with, the manufacturer's installation instructions provided with the damper. A plastic grille shall be installed in accordance with installation instructions.
BROAN-NUTONE L L C — Model RDMWT

5V. **Alternate Ceiling Damper* —** Ceiling damper & fan assembly. Max nom area shall be 87 sq in. with the length not to exceed 9 in. and the width not to exceed 9-11/16 in. Aggregate damper openings shall not exceed 44 sq in. per 100 sq ft of ceiling area. Damper shall be installed in combination with one of the fan models described in, and in accordance with, the manufacturer's installation instructions provided with the damper. A plastic grille shall be installed in accordance with installation instructions.
BROAN-NUTONE L L C — Model RDMWT2

5W. **Alternate Ceiling Damper* —** Max nom 21 in. long by 18 in. wide, fabricated from galvanized steel. Plenum box max size nom 21 in. long by 18 in. wide by 14 in. high (inner dimension) fabricated from either galvanized steel or min 1 in. thick Listed Duct Board bearing the UL Listing Marking having a min R-Value of 4.3. Installed in accordance with the instructions provided by the manufacturer. Max damper openings not to exceed 180 sq in. per 100 sq ft of ceiling area.
GREENHECK FAN CORP — Model CRD-1WT

5X. **Alternate Ceiling Damper* —** Max nom 12 in. long by 12 in. wide with an 8 in. diameter damper, fabricated from galvanized steel. Installed in accordance with the instructions provided by the manufacturer. Max damper openings not to exceed 72 sq in. per 100 sq ft of ceiling area.
GREENHECK FAN CORP — Model CRD-2WT

5Y. **Alternate Ceiling Damper* —** Max 12 in. diameter damper and insulated register box assembly. The maximum size of the register box assembly is nom. 20 in. long by 20 in. wide and 4 in. high fabricated from galv steel. The aggregate area of the register opening(s) through the ceiling membrane shall not exceed 128 sq in. per 100 sq ft of ceiling area. Damper assembly installed in accordance with the manufacturers installation instructions.
AIRE TECHNOLOGIES INC — Model 571B.

5Z. **Alternate Ceiling Damper* —** Max 20 in. long by 16 in. wide by 4 in. high rectangular damper with plenum box assembly. The maximum outer dimensions of the plenum box assembly is 23-1/2 in. long by 19-1/2 in. wide and 17 in. high fabricated from 6pcf, 1-1/2 to 2 in. thick Knauf Air Duct Board M*. The aggregate area of the register opening(s) through the ceiling membrane shall not exceed 160 sq in. per 100 sq ft ceiling area. Damper assembly installed in accordance with the manufacturers installation instructions.
AIRE TECHNOLOGIES INC — Series 58.

5AA. **Alternate Ceiling Damper* —** Max 14 in. long by 14 in. wide and 18 in. high ceiling damper with boot or box assembly, fabricated from galv steel. The aggregate area of the register opening(s) through the ceiling membrane shall not exceed 98 sq in. per 100 sq ft of ceiling area. Damper assembly installed in accordance with the manufacturers installation instructions.
AIRE TECHNOLOGIES INC — Model 51 w/Boot.

5AB. **Alternate Ceiling Damper* —** Max nom 11-1/8 in. long by 13-5/8 in. wide, fabricated from galvanized steel. Installed in accordance with the instructions provided by the manufacturer. Max damper openings not to exceed 76 sq in. per 100 sq ft of ceiling area.
GREENHECK FAN CORP — Model CRD-310WT Feedback

5AC. **Alternate Ceiling Damper* —** Max nom 12-3/8 in. long by 14-1/2 in. wide, fabricated from galvanized steel. Installed in accordance with the instructions provided by the manufacturer. Max damper openings not to exceed 90 sq in. per 100 sq ft of ceiling area.
GREENHECK FAN CORP — Model CRD-320WT

5AD. **Alternate Ceiling Damper* —** Max 12 in. diameter damper within max 15 in. by 15 in. register box with max 12 in. by 12 in. register opening fabricated from galvanized steel. Aggregate area of the register opening(s) through the ceiling membrane shall not exceed 72 sq. in. per 100 sq. ft. of ceiling area. Damper assembly installed in accordance with the manufacturer's installation instructions.
RUSKIN COMPANY — Model CFD7T-SR

5AE. **Alternate Ceiling Damper* —** Max 12 in. diameter damper and insulated register box assembly. The maximum size of the register box assembly is nom. 20 in. long by 20 in. wide and 4 in. high fabricated from galv steel. The aggregate area of the register opening(s) through the ceiling membrane shall not exceed 128 sq in. per 100 sq ft of ceiling area. Damper assembly installed in accordance with the manufacturers installation instructions.
SOUTHWARK METAL MFG CO — Model 800 w/Box

5AF. **Alternate Ceiling Damper* —** Max 20 in. long by 16 in. wide by 4 in. high rectangular damper with plenum box assembly. The maximum outer dimensions of the plenum box assembly are 23-1/2 in. long by 19-1/2 in. wide and 17 in. high fabricated from 6pcf, 1-1/2 to 2 in. thick Knauf Air Duct Board M*. The aggregate area of the register opening(s) through the ceiling membrane shall not exceed 160 sq in. per 100 sq ft ceiling area. Damper assembly installed in accordance with the manufacturers installation instructions.
SOUTHWARK METAL MFG CO — CRD w/DB Box

5AG. **Alternate Ceiling Damper* —** Max 14 in. long by 14 in. wide and 18 in. high ceiling damper with boot or box assembly, fabricated from galv steel. The aggregate area of the register opening(s) through the ceiling membrane shall not exceed 98 sq in. per 100 sq ft of ceiling area. Damper assembly installed in accordance with the manufacturers installation instructions.
SOUTHWARK METAL MFG CO — Model 500 w/Boot, 510 w/Boot, 500 w/Box or 510 w/Box

5AH. **Alternate Ceiling Damper* —** Max nom 10-3/8 in. long by 10-3/8 in. wide, fabricated from galvanized steel. Installed in accordance with the instructions provided by the manufacturer. Max damper openings not to exceed 54 sq in. per 100 sq ft of ceiling area.
GREENHECK FAN CORP — Model CRD-300WT

6. **Furring Channels —** Resilient channels formed of 25 MSG galv steel, spaced 16 in. OC, installed perpendicular to trusses. When insulations are installed or draped over the resilient channel/gypsum wallboard ceiling membrane, the spacing shall be as described below. Channels secured to each truss with 1-1/4 in. long Type S steel screws. Channels overlapped 4 in. at splices. Channels oriented opposite at wallboard butt joints (spaced 6 in. OC) as shown in the above illustration.
When Type AG-C panels are attached to the resilient channels, the channels may remain at 16 in. OC.

When Type TG-C panels are attached to the resilient channels, the channels are installed at 12 in. OC.

6A. **Steel Framing Members* —** (Not Shown) — As an alternate to Item 6, furring channels and Steel Framing Members* as described below:
a. **Furring Channels —** Formed of No. 25 MSG galv steel, 2-9/16 in. or 2-23/32 in. wide by 7/8 in. deep, spaced 16 in. OC perpendicular to trusses. When batt insulation (Item 3) is draped over the resilient channel/gypsum board ceiling membrane, the resilient channel spacing shall be reduced to 12 in. OC. Channels secured to trusses as described in Item b. Ends of adjoining channels overlapped 6 in. and tied together with double strand of No. 18 SWG galv steel wire near each end of overlap.

b. **Steel Framing Members* —** Used to attach furring channels (Item a) to trusses (Item 2). Clips spaced 48 in. OC. RSIC-1 and RSIC-1 (2.75) clips secured to alternating trusses with No. 8 x 2-1/2 in. coarse drywall screw through the center grommet. RSIC-V and RSIC-V (2.75) clips secured to alternating trusses with No. 8 x 1-1/2 in. coarse drywall screw through the center hole. Furring channels are friction fitted into clips. RSIC-1 and RSIC-V clips for use with 2-9/16 in. wide furring channels. RSIC-1 (2.75) and RSIC-V (2.75) clips for use with 2-23/32 in. wide furring channels. Adjoining channels are overlapped as described in Item a. As an alternate, ends of adjoining channels may be overlapped 6 in. and secured together with two self-tapping No. 6 framing screws, min 7/16 in. long at the midpoint of the overlap, with one screw on each flange of the channel. Additional clips required to hold furring channel that supports the gypsum board butt joints, as described in Item 7.
PAC INTERNATIONAL L L C — Types RSIC-1, RSIC-V, RSIC-1 (2.75), RSIC-V (2.75) Feedback

6B. **Alternate Steel Framing Members* —** (Not Shown) — Not evaluated with Item 3 (Batts and Blankets). As an alternate to Items 6 or 6A, furring channels and Steel Framing Members as described below.
a. **Furring Channels —** Formed of No. 25 MSG galv steel, 2-5/8 in. wide by 7/8 in deep, spaced 16 in OC, perpendicular to trusses. Channels secured to trusses as described in Item b.

12/27/2023 4:08:49 PM
C:\Revit Local Files\R23\23034_Wilshire Hills III_Central_R23_revIII1UCAR.rvt

PRINTS ISSUED
10/30/23 PERMIT SUBMITTAL

REVISIONS:

rosemann & ASSOCIATES P.C.
ARCHITECTURE
INTERIOR DESIGN
ENGINEERING
PLANNING
1526 Grand Boulevard
Kansas City, MO 64108-1404
p: 816.472.1448
w: www.rosemann.com
© 2023 Rosemann & Associates, P.C.
DENVER ▲ KANSAS CITY ▲ ST. LOUIS ▲ ATLANTA

STATE OF MISSOURI
DAVID EUGENE HENDRIKS
NUMBER A-7365
REGISTERED ARCHITECT
10/30/23

WILSHIRE HILLS III
LEE'S SUMMIT, MISSOURI
MHDC - 22-057

SHEET TITLE
UL ASSEMBLIES

PROJECT NUMBER: 23034

SHEET NUMBER:

G-206

UL DESIGN - P545 (CONT.)

b. **Steel Framing Members* —** Used to attach furring channels (Item a) to the wood trusses (Item 2). Clips spaced at 48" OC and secured to the bottom of the trusses with one 2 in. Coarse Drywall Screw with 1 in. diam washer through the center hole. Furring channels are then friction fitted into clips. Ends of channels are overlapped 6" and tied together with double strand of No. 18 AWG galvanized steel wire. Additional clips are required to hold the Gypsum Butt joints as described in Item 7.
STUDCO BUILDING SYSTEMS — RESILMOUNT Sound Isolation Clips - Type A237 or A237R

6C. **Alternate Steel Framing Members* —** (Not Shown) — Not evaluated with Item 3 (Batts and Blankets). As an alternate to Items 6 through 6B, furring channels and Steel Framing Members as described below.
a. **Furring Channels —** Formed of No. 25 MSG galv steel, 2-1/2 in. wide by 7/8 in deep, spaced 16 in OC, perpendicular to trusses. Channels secured to trusses as described in Item b.

b. **Steel Framing Members* —** Used to attach furring channels (Item a) to the wood trusses (Item 2). Clips spaced at 48" OC and secured to the bottom of the trusses with one 2-1/2 in. Coarse Drywall Screw with 1 in. diam washer through the center hole. Furring channels are then friction fitted into clips. Ends of channels are overlapped 6" and tied together with double strand of No. 18 AWG galvanized steel wire. Additional clips are required to hold the Gypsum Butt joints as described in Item 7.
REGUPOL AMERICA — Type SonusClip

7. **Gypsum Board* —** Nom 5/8 in. thick, 48 in. wide, installed with long dimension perpendicular to resilient channels with 1 in. long Type S screws spaced 12 in. OC and located a min of 1/2 in. from side joints and 3 in. from the end joints. At end joints, two resilient channels are used, extending a min of 6 in. beyond both ends of the joint. When batt and blanket insulation, Item 3, is draped over the resilient channel/gypsum wallboard ceiling membrane, screws shall be installed at 8 in. OC. When **Steel Framing Members** (Item 6B) are used, one layer of nom 5/8 in. thick, 4 ft wide gypsum board is installed with long dimensions perpendicular to furring channels. Gypsum board secured to furring channels with nom 1 in. long Type S bugle-head steel screws spaced 8 in. OC in the field of the board. Gypsum board butted end joints shall be staggered minimum 48 in. and centered over main furring channels. At the gypsum board butt joints, each end of each gypsum board shall be supported by a single length of furring channel equal to the width of the gypsum board plus 3 in. on each end. The two support furring channels shall be spaced approximately 3 in. in from end joint. Screw spacing along the gypsum board butt joint and along both additional channels shall be 8 in. OC. Additional screws shall be placed in the adjacent section of gypsum board into the aforementioned 3 in. extension of the extra butt joint channels as well as into the main channel that runs between. Butt joint furring channels shall be attached with one RESILMOUNT Sound Isolation Clip at each end of the channel.
When **Steel Framing Members** (Item 6C) are used, one layer of nom 5/8 in. thick, 4 ft wide gypsum board is installed with long dimensions perpendicular to furring channels. Gypsum board secured to furring channels with nom 1 in. long Type S bugle-head steel screws spaced 8 in. OC in the field of the board. Gypsum board butted end joints shall be staggered minimum 48 in. and centered over main furring channels. At the gypsum board butt joints, an additional single length of furring channel shall be installed and be spaced approximately 3 in. from the butt joint (6 in. from the continuous furring channels) to support the floating end of the gypsum board. Each of these shorter sections of furring channel shall extend one truss beyond the width of the gypsum panel and be attached to the adjacent trusses with one SonusClip at every truss involved with the butt joint.

AMERICAN GYPSUM CO — Types AG-C

GEORGIA-PACIFIC GYPSUM L L C — Type TG-C

7A. **Gypsum Board* —** (As an alternative to Item 7) — For use when no insulation is used. Nom 5/8 in. thick, 48 in. wide gypsum board, installed as described in item 7 with resilient channels (Item 6) spaced 24 in OC.

AMERICAN GYPSUM CO — Type AG-C

8. **Finishing System —** (Not Shown) — Vinyl, dry or premixed joint compound, applied in two coats to joints and screw-heads; paper tape, 2 in. wide, embedded in first layer of compound over all joints. As an alternate, nom 3/32 in. thick veneer plaster may be applied to the entire surface of gypsum wallboard.

9. **Grille —** Installed in accordance with the installation instructions provided with the ceiling damper

10. **Discrete Products Installed in Air-handling Spaces* —** Automatic Balancing Valve/Damper — (Not Shown - Optional) — For use with item 5L, Ruskin Company's Model CFD7T damper (CABS). Ceiling damper to be provided with plenum box per damper

manufacturer's instructions with side outlet only. Entire assembly to be installed into any UL Class 0 or Class 1 flexible air duct in accordance with the instructions provided by the automatic balancing valve/damper manufacturer.
METAL INDUSTRIES INC — Model ABV-4, ABV-5, ABV-6

11. **Netting —** (Not shown) Fibrous, woven netting material fastened to underside of each joist with staples, with side joints overlapped.

12. **Netting —** (Not shown) - Non-woven polypropylene fabric fastened to underside of each joist with staples, with side joints overlapped. For use with Type AG-C gypsum boards only.

*** Indicates such products shall bear the UL or cUL Certification Mark for jurisdictions employing the UL or cUL Certification (such as Canada), respectively.**

Last Updated on 2023-06-26

The appearance of a company's name or product in this database does not in itself assure that products so identified have been manufactured under UL Solutions' Follow - Up Service. Only those products bearing the UL Mark should be considered to be Certified and covered under UL Solutions' Follow - Up Service. Always look for the Mark on the product.

UL Solutions permits the reproduction of the material contained in Product iQ subject to the following conditions: 1. The Guide Information, Assemblies, Constructions, Designs, Systems, and/or Certifications (files) must be presented in their entirety and in a non-misleading manner, without any manipulation of the data (or drawings). 2. The statement "Reprinted from Product iQ with permission from UL Solutions" must appear adjacent to the extracted material. In addition, the reprinted material must include a copyright notice in the following format: "©2023 UL LLC."

Feedback

10/27/2023 4:58:05 PM
C:\Revit Cloud Cache\2023\2034_Wilshire Hills III_Central_R23_mm9TUCAR.rvt

UL DESIGN - W-L1003

THROUGH-PENETRATION FIRESTOP SYSTEM

Assembly Usage Disclaimer

XHEZ - Through-penetration Firestop Systems

See General Information for Through-penetration Firestop Systems

System No. W-L-1003

February 14, 2008

F Ratings — 1 and 2 Hr (See Item 1)

T Rating — 0 Hr

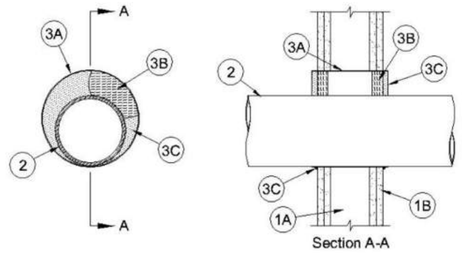

Section A-A

1. **Wall Assembly —** The 1 or 2 hr fire-rated gypsum board/stud wall assembly shall be constructed of the materials and in the manner described in the individual U300, U400 or V400 Series Wall and Partition Design in the UL Fire Resistance Directory and shall include the following construction features:

A. **Studs —** Wall framing may consist of either wood studs or steel channel studs. Wood studs to consist of nom 2 by 4 in. (51 by 102 mm) lumber spaced 16 in. (406 mm) OC with nom 2 by 4 in. (51 by 102 mm) lumber end plates and cross braces. Steel studs to be min

3-1/2 in. (89 mm) wide by 1-3/8 in. (35 mm) deep channels spaced max 24 in. (610 mm) OC.

B. **Gypsum Board* —** Nom 5/8 in. (16 mm) thick, 4 ft (1.2 m) wide with square or tapered edges. The gypsum board type, thickness, number of layers, fastener type and sheet orientation shall be as specified in the individual U300, U400 or V400 Series Design in the UL Fire Resistance Directory. Max diam of opening is 15 in. (381 mm).
The hourly F Rating of the firestop system is equal to the hourly fire rating of the wall assembly in which it is installed.

2. **Through-Penetrant —** One metallic pipe, conduit or tubing to be installed either concentrically or eccentrically within the firestop system. The space between pipes, conduits or tubing and the steel sleeve (Item 3A) shall be min of 0 in. (point contact) to max 2-3/8 in. (60 mm). Pipe, conduit or tubing to be rigidly supported on both sides of wall assembly. The following types and sizes of metallic pipes, conduits or tubing may be used:

A. **Steel Pipe —** Nom 12 in. (305 mm) diam (or smaller) Schedule 10 (or heavier) steel pipe.

B. **Iron Pipe —** Nom 12 in. (305 mm) diam (or smaller) service weight (or heavier) cast iron soil pipe, nom 12 in. (305 mm) diam (or smaller) or Class 50 (or heavier) ductile iron pressure pipe.

C. **Conduit —** Nom 6 in. (152 mm) diam (or smaller) steel conduit or nom 4 in. (102 mm) diam (or smaller) steel electrical metallic tubing.

D. **Copper Tubing —** Nom 6 in. (152 mm) diam (or smaller) Type L (or heavier) copper tubing.

E. **Copper Pipe —** Nom 6 in. (152 mm) diam (or smaller) Regular (or heavier) copper pipe.

3. **Firestop System —** Installed symmetrically on both sides of wall assembly. The details of the firestop system shall be as follows.

A. **Steel Sleeve —** Cylindrical sleeve fabricated from min 0.019 in. thick (0.48 mm) galv sheet steel and having a min 2 in. (51 mm) lap along the longitudinal seam. Length of steel sleeve to be equal to thickness of wall plus 1 to 4 in. (25 to 102 mm) such that, when installed, the ends of the sleeve will project approx 1/2 to 2 in. (13 to 51 mm) beyond the surface of the wall on both sides of the wall assembly.
Sleeve installed by coiling the sheet steel to a diam smaller than the through opening, inserting the coil through the openings and releasing the coil to let it uncoil against the circular cutouts in the gypsum board layers.

B. **Packing Material —** Min 1 in. (25 mm) thickness of mineral wool batt insulation firmly packed into steel sleeve on both sides of the wall assembly as permanent forms. Packing material to be recessed min 1/2 in. (13 mm) from end of steel sleeve (flush with or recessed into gypsum board surface) on both sides of wall assembly.

B1. **Packing Material —** (Not shown) — As an alternate to Item B, nom 1 in. (25 mm) thick polyethylene backer rod may be used. The backer rod is to be recessed within the steel sleeve a min of 1 in. (25 mm) from each surface of wall.

C. **Fill, Void or Cavity Materials* — Caulk or Sealant —** When mineral wool batt insulation is used, caulk or sealant applied to fill the steel sleeve to a min depth of 1/2 in. (13 mm) on both sides of wall assembly. When backer rod is used, a min thickness of 1 in. (25 mm) of caulk or sealant is required flush with both sides of wall. A nom 1/4 in. (6 mm) diam continuous bead of caulk or sealant shall be applied around the circumference of the steel sleeve at its egress from the gypsum board layers on both sides of the wall assembly.
3M COMPANY — CP 25WB+, IC 15WB+ or FB-3000 WT

*** Indicates such products shall bear the UL or cUL Certification Mark for jurisdictions employing the UL or cUL Certification (such as Canada), respectively.**

Last Updated on 2008-02-14

Design/System/Construction/Assembly Usage Disclaimer

- Authorities Having Jurisdiction should be consulted in all cases as to the particular requirements covering the installation and use of UL Certified products, equipment, system, devices, and materials.
- Authorities Having Jurisdiction should be consulted before construction.
- Fire resistance assemblies and products are developed by the design submitter and have been investigated by UL for compliance with applicable requirements. The published information cannot always address every construction nuance encountered in the field.
- When field issues arise, it is recommended the first contact for assistance be the technical service staff provided by the product manufacturer noted for the design. Users of fire resistance assemblies are advised to consult the general Guide Information for each product category and each group of assemblies. The Guide Information includes specifics concerning alternate materials and alternate methods of construction.
- Only products which bear UL's Mark are considered Certified.

The appearance of a company's name or product in this database does not in itself assure that products so identified have been manufactured under UL's Follow-Up Service. Only those products

bearing the UL Mark should be considered to be Certified and covered under UL's Follow-Up Service. Always look for the Mark on the product.

UL permits the reproduction of the material contained in the Online Certification Directory subject to the following conditions: 1. The Guide Information, Assemblies, Constructions, Designs, Systems, and/or Certifications (files) must be presented in their entirety and in a non-misleading manner, without any manipulation of the data (or drawings). 2. The statement "Reprinted from the Online Certifications Directory with permission from UL" must appear adjacent to the extracted material. In addition, the reprinted material must include a copyright notice in the following format: "© 2019 UL LLC".

UL and the UL logo are trademarks of UL LLC © 2019 All Rights Reserved.

UL DESIGN - WG3640

WALL ASSEMBLY
ASSEMBLY RATING - 1 HOUR

RESOURCE: GA-600-2018 FIRE RESISTANCE AND SOUND CONTROL DESIGN MANUAL

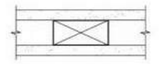

Thickness: 2-7/8" (Fire)
Approx. Weight: 7 psf (Fire)
Fire Test: UL R1319, 9-12-96, UL Design U338

GYPSUM WALLBOARD, WOOD STUDS
Fire Design:
One layer 5/8" type X gypsum wallboard or gypsum veneer base applied parallel or at right angles to each side of either 2 x 3 or 2 x 4 wood studs, turned flatwise, 24" o.c. with 6d cement-coated nails, 1-7/8" long, 0.0915" shank, 1/4" heads, 7" o.c. Horizontal joints staggered not less than 12" on OPPOSITE SIDES. (NLB)

PRINTS ISSUED
10/30/23 PERMIT SUBMITTAL

REVISIONS:

rosemann & ASSOCIATES P.C.
ARCHITECTURE
INTERIOR DESIGN
ENGINEERING
PLANNING
1526 Grand Boulevard
Kansas City, MO 64108-1404
p: 816.472.1448
w: www.rosemann.com
© 2023 Rosemann & Associates, P.C.
DENVER ▲ KANSAS CITY ▲ ST. LOUIS ▲ ATLANTA

STATE OF MISSOURI
DAVID EUGENE HENDRIKSE
NUMBER A-7365
REGISTERED ARCHITECT
10/30/23

WILSHIRE HILLS III
LEE'S SUMMIT, MISSOURI
MHDC - 22-057

SHEET TITLE
UL ASSEMBLIES

PROJECT NUMBER: 23034

SHEET NUMBER:

G-207

UL DESIGN - W-L2003

THROUGH-PENETRATION FIRESTOP SYSTEM

Assembly Usage Disclaimer

XHEZ - Through-penetration Firestop Systems

See General Information for Through-penetration Firestop Systems

System No. W-L-2003

November 20, 2009

F Ratings — 1 and 2 Hr (See Item 3)

T Ratings — 1 and 2 Hr (See Item 3)

L Rating At Ambient — 7 CFM/sq ft (See Item 3B)

L Rating At 400 F — less than 1 CFM/sq ft (See Item 3B)

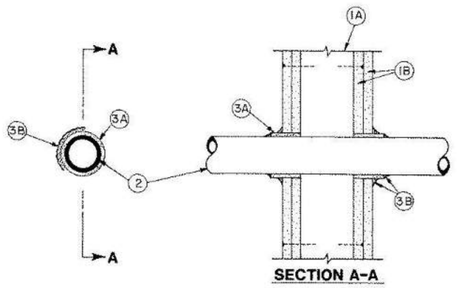

1. **Wall Assembly —** The 1 or 2 hr fire-rated gypsum board/stud wall assembly shall be constructed of the materials and in the manner described in the individual U300,

U400 or V400 Series Wall or Partition Design in the UL Fire Resistance Directory and shall include the following construction features:

A. **Studs —** Wall framing may consist of either wood studs or steel channel studs. Wood studs to consist of nom 2 by 4 in. (51 by 102 mm) lumber spaced 16 in. (406 mm) OC with nom 2 by 4 in. (51 by 102 mm) lumber end plates and cross braces. Steel studs to be min 3-5/8 in. (92 mm) wide by 1-3/8 in. (35 mm) deep channels spaced max 24 in. (610 mm) OC.

B. **Gypsum Board* —** 5/8 in. (16 mm) thick, 4 ft (122 cm) wide with square or tapered edges. The gypsum board type, thickness, number of layers, fastener type and sheet orientation shall be as specified in the individual U300, U400 or V400 Series Design in the UL Fire Resistance Directory. Max diam of opening is 3-1/8 in. (79 mm).

2. **Through Penetrants —** One nonmetallic pipe or conduit to be centered in the through opening. The annular space between pipe or conduit and periphery of opening shall be min 1/4 in. (6 mm) and max 3/8 in. (10 mm). Pipe or conduit to be rigidly supported on both sides of the floor-ceiling assembly. The following types and sizes of nonmetallic pipes or conduits may be used:

A. **Polyvinyl Chloride (PVC) Pipe —** Nom 2 in. (51 mm) diam (or smaller) Schedule 40 solid core PVC pipe for use in closed (process or supply) or vented (drain, waste or vent) piping system.

B. **Rigid Nonmetallic Conduit++ —** Nom 2 in. (51 mm) diam (or smaller)(Schedule 40 or 80) PVC conduit installed in accordance with the National electric Code (NFPA No. 70).

C. **Chlorinated Polyvinyl Chloride (CPVC) Pipe —** Nom 2 in. (51 mm) diam (or smaller) SDR13.5 CPVC pipe for use in closed (process or supply) piping systems.

D. **Cellular Core Polyvinyl Chloride (ccPVC) Pipe —** Nom 2 in. (51 mm) diam (or smaller) Schedule 40 cellular core PVC pipe for use in closed (process or supply) or vented (drain, waste or vent) piping system.

E. **Acrylonitrile Butadiene Styrene (ABS) Pipe —** Nom 2 in. (51 mm) diam (or smaller) Schedule 40 solid core ABS pipe for use in closed (process or supply) or vented (drain, waste or vent) piping systems.

F. **Cellular Core Acrylonitrile Butadiene Styrene (ccABS) Pipe —** Nom 2 in. (51 mm) diam (or smaller) Schedule 40 cellular core ABS pipe for use in closed (process or supply) or vented (drain, waste or vent) piping systems.

3. **Firestop System —** Installed symmetrically on both sides of wall assembly. The hourly F and T Ratings for the firestop system are equal to the hourly fire rating of

the wall assembly in which it is installed. The details of the firestop system shall be as follows.

A. **Fill, Void or Cavity Materials* — Wrap Strip —** Nom 1/4 in. (6 mm) thick intumescent elastomeric material faced on one side with aluminum foil, supplied in 2 in. (51 mm) wide strips. Nom 2 in. (51 mm) wide strip tightly wrapped around nonmetallic pipe (foil side out) with seam butted. Wrap strip layer securely bound with steel wire or aluminum foil tape and slid into annular space approx 1-1/4 in. (32 mm) such that approx 3/4 in. (19 mm) of the wrap strip protrudes from the wall surface.
3M COMPANY — FS-195+

B. **Fill, Void or Cavity Materials* — Caulk, Sealant or Putty —** Min 5/8 in. (16 mm) thickness of caulk or putty applied into annular space between wrap strip and periphery of opening. A nom 1/4 in. (6 mm) diam bead of caulk or putty to be applied to the wrap strip/wall interface and to the exposed edge of the wrap strip layers approx 3/4 in. (19 mm) from the wall surface.
3M COMPANY — CP 25WB+ caulk or MP+ Stix putty, IC 15WB+ caulk, FireDam 150+ caulk or FB-3000 WT sealant. (Note: L Ratings apply only when Type CP 25WB+ caulk or FB-3000 WT sealant is used. CP 25WB+ and FireDam 150+ not suitable for use with CPVC pipes.)

C. **Foil Tape —** (not shown) — Nom 4 in. (102 mm) wide, 3 mil thick aluminum tape wrapped around pipe prior to the installation of the wrap strip (Item 3A). Min of one wrap, flush with both sides of wall and proceeding outward. Tape is not required for pipes shown in Items 2A, 2B and 2C.

*** Indicates such products shall bear the UL or cUL Certification Mark for jurisdictions employing the UL or cUL Certification (such as Canada), respectively.**

Last Updated on 2009-11-20

Design/System/Construction/Assembly Usage Disclaimer

- Authorities Having Jurisdiction should be consulted in all cases as to the particular requirements covering the installation and use of UL Certified products, equipment, system, devices, and materials.
- Authorities Having Jurisdiction should be consulted before construction.
- Fire resistance assemblies and products are developed by the design submitter and have been investigated by UL for compliance with applicable requirements. The published information cannot always address every construction nuance encountered in the field.

- When field issues arise, it is recommended the first contact for assistance be the technical service staff provided by the product manufacturer noted for the design. Users of fire resistance assemblies are advised to consult the general Guide Information for each product category and each group of assemblies. The Guide Information includes specifics concerning alternate materials and alternate methods of construction.
- Only products which bear UL's Mark are considered Certified.

The appearance of a company's name or product in this database does not in itself assure that products so identified have been manufactured under UL's Follow-Up Service. Only those products bearing the UL Mark should be considered to be Certified and covered under UL's Follow-Up Service. Always look for the Mark on the product.

UL permits the reproduction of the material contained in the Online Certification Directory subject to the following conditions: 1. The Guide Information, Assemblies, Constructions, Designs, Systems, and/or Certifications (files) must be presented in their entirety and in a non-misleading manner, without any manipulation of the data (or drawings). 2. The statement "Reprinted from the Online Certifications Directory with permission from UL" must appear adjacent to the extracted material. In addition, the reprinted material must include a copyright notice in the following format: "© 2019 UL LLC".

UL and the UL logo are trademarks of UL LLC © 2019 All Rights Reserved.

10/27/2023 2:53:37 PM
C:\Revit Local Cache\R2023\2024_Wilshire Hills III_Central_R23_revitRTUCAR.rvt

PRINTS ISSUED
10/30/23 PERMIT SUBMITTAL

REVISIONS:

rosemann & ASSOCIATES P.C.
ARCHITECTURE
INTERIOR DESIGN
ENGINEERING
PLANNING
1526 Grand Boulevard
Kansas City, MO 64108-1404
p: 816.472.1448
w: www.rosemann.com
© 2023 Rosemann & Associates, P.C.
DENVER ▲ KANSAS CITY ▲ ST. LOUIS ▲ ATLANTA

STATE OF MISSOURI
DAVID EUGENE HENDRIKSE
NUMBER A-7365
REGISTERED ARCHITECT
10/30/23

WILSHIRE HILLS III
LEE'S SUMMIT, MISSOURI
MHDC - 22-057

SHEET TITLE
UL ASSEMBLIES

PROJECT NUMBER: 23034

SHEET NUMBER:

G-208

UL DESIGN - U356

UL Product iQ®

UL Solutions

Design/System/Construction/Assembly Usage Disclaimer

- Authorities Having Jurisdiction should be consulted in all cases as to the particular requirements covering the installation and use of UL Certified products, equipment, system, devices, and materials.
- Authorities Having Jurisdiction should be consulted before construction.
- Fire resistance assemblies and products are developed by the design submitter and have been investigated by UL for compliance with applicable requirements. The published information cannot always address every construction nuance encountered in the field.
- When field issues arise, it is recommended the first contact for assistance be the technical service staff provided by the product manufacturer noted for the design. Users of fire resistance assemblies are advised to consult the general Guide Information for each product category and each group of assemblies. The Guide Information includes specifics concerning alternate materials and alternate methods of construction.
- Only products which bear UL's Mark are considered Certified.

BXUV - Fire Resistance Ratings - ANSI/UL 263 Certified for United States
BXUV7 - Fire Resistance Ratings - CAN/ULC-S101 Certified for Canada

See General Information for Fire-resistance Ratings - ANSI/UL 263 Certified for United States
Design Criteria and Allowable Variances

See General Information for Fire Resistance Ratings - CAN/ULC-S101 Certified for Canada
Design Criteria and Allowable Variances

Design No. **U356**

August 4, 2023

Bearing Wall Rating - 1 Hr Rating Exposed to Fire on Interior Face Only
Bearing Wall Rating — 1 Hr Rating Exposed to Fire on Exterior Face (See Item 6E)
Finish Rating — 23 Min or 25 Min (See Item 2C)
This design was evaluated using a load design method other than the Limit States Design Method (e.g., Working Stress Design Method). For jurisdictions employing the Limit States Design Method, such as Canada, a load restriction factor shall be used — See Guide BXUV or BXUV7

*** Indicates such products shall bear the UL or cUL Certification Mark for jurisdictions employing the UL or cUL Certification (such as Canada), respectively.**

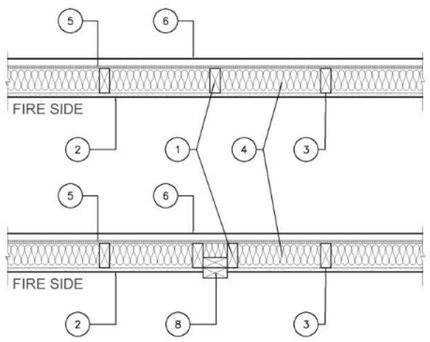

1. **Wood Studs —** Nom 2 by 4 in. spaced 16 in. OC with two 2 by 4 in. top and one 2 by 4 in. bottom plates. Studs laterally-braced by wood structural panel sheathing (Item 5). When **Mineral and Fiber Boards*** (Item 5A) are considered as bracing for the studs, the load is restricted to 76% of allowable axial load. Walls effectively fire stopped at top and bottom of wall.

2. **Gypsum Board* — Any 5/8 in. thick UL Classified Gypsum Board that is eligible for use in Design Nos. L501, G512 or U305.** Nom 5/8 in. thick, 4 ft wide, applied vertically and nailed to studs and bearing plates 7 in. OC with 6d cement-coated nails, 1-7/8 in. long with 1/4 in. diam head.

Feedback

When Item **Steel Framing Members*** (Item 7 or any alternate clips), is used, gypsum panels attached to furring channels with 1 in. long Type S bugle-head steel screws spaced 12 in. OC.

When Item 7A **Steel Framing Members***, is used, two layers of gypsum panels attached to furring channels. Base layer attached to furring channels with 1 in. long Type S bugle-head steel screws spaced 12 in. OC. Face layer attached to furring channels with 1-5/8 in. long Type S bugle-head steel screws spaced 12 in. OC. All joints in face layers staggered with joints in base layers.

AMERICAN GYPSUM CO (View Classification) — CKNX.R14196

BEIJING NEW BUILDING MATERIALS PUBLIC LTD CO (View Classification) — CKNX.R19374

CABOT MANUFACTURING ULC (View Classification) — CKNX.R25370

CERTAINTEED GYPSUM INC (View Classification) — CKNX.R3660

CGC INC (View Classification) — CKNX.R19751

CERTAINTEED GYPSUM INC (View Classification) — CKNX.R18482

GEORGIA-PACIFIC GYPSUM L L C (View Classification) — CKNX.R2717

NATIONAL GYPSUM CO (View Classification) — CKNX.R3501

PABCO BUILDING PRODUCTS L L C, DBA PABCO GYPSUM (View Classification) — CKNX.R7094

PANEL REY S A (View Classification) — CKNX.R21796

SIAM GYPSUM INDUSTRY (SARABURI) CO LTD (View Classification) — CKNX.R19262

THAI GYPSUM PRODUCTS PCL (View Classification) — CKNX.R27517

UNITED STATES GYPSUM CO (View Classification) — CKNX.R1319

USG BORAL DRYWALL SFZ LLC (View Classification) — CKNX.R38438

USG MEXICO S A DE C V (View Classification) — CKNX.R16089

2A. **Gypsum Board* —** (As an alternate to Item 2, Not Shown) — Any 5/8 in. thick 4 ft wide gypsum panels that are eligible for use in Design Nos. L501, G512 or U305, supplied by the Classified Companies listed below shown in the **Gypsum Board*** (CKNX) category. Applied vertically and attached to studs and bearing plates with 1-1/4 in. long Type W coarse thread gypsum panel steel screws spaced a max 8 in. OC, with last screw 1 in. from edge of board.
CGC INC

UNITED STATES GYPSUM CO

USG BORAL DRYWALL SFZ LLC

USG MEXICO S A DE C V

2B. **Gypsum Board* —** (As an alternate to Item 2, Not Shown) — 5/8 in. thick 4 ft wide gypsum panels applied vertically and attached to studs and bearing plates with 1-1/4 in. long Type W coarse thread gypsum panel steel screws spaced a max 8 in. OC, with last screw 1 in. from edge of board.

Feedback

AMERICAN GYPSUM CO — Types AGX-1, M-Glass, AG-C, LightRoc

CABOT MANUFACTURING ULC — Type X, 5/8 Type X, Type Blueglass Exterior Sheathing

CERTAINTEED GYPSUM INC — Type C, Type X-1, Easi-Lite Type X-2

GEORGIA-PACIFIC GYPSUM L L C — Types X, Veneer Plaster Base-Type X, Water Rated-Type X, Sheathing Type-X, Soffit-Type X, Type X ComfortGuard Sound Deadening Gypsum Board.

PABCO BUILDING PRODUCTS L L C, DBA PABCO GYPSUM — Types PG-11, PGS-WRS, PGI.

THAI GYPSUM PRODUCTS PCL — Type C or Type X

2C. **Gypsum Board* —** (As an alternate to Item 2, Not Shown) — For Use with Item 5A only - 5/8 in. thick 4 ft wide gypsum panels applied horizontally and attached to studs and bearing plates with 1-1/4 in. long Type W coarse thread gypsum panel steel screws spaced a max 8 in. OC, with last screws 1 in.and 4 in. from edges of board. Finish Rating is 25 min.
CABOT MANUFACTURING ULC — 5/8 Type X, Type Blueglass Exterior Sheathing

GEORGIA-PACIFIC GYPSUM L L C — Type X, Veneer Plaster Base-Type X, Water Rated-Type X, Sheathing Type-X, Soffit-Type X

PABCO BUILDING PRODUCTS L L C, DBA PABCO GYPSUM — Types PG-11, PGS-WRS, PGI

2D. **Gypsum Board* —** (As an alternate to Item 2) — Not to be used with item 7. 5/8 in. thick, 4 ft. wide, paper surfaced, applied vertically only and fastened to the studs and plates with 6d cement coated nails 1-7/8 in. long, 0.0915 in. shank diam and 1/4 in. diam heads, 7 in. OC.
NATIONAL GYPSUM CO — Type SBWB

2E **Gypsum Board* —** (As an alternate to Items 2 through 2D) — Nominal 5/8 in. thick, 4 ft wide panels, secured as described in Item 2.
PABCO BUILDING PRODUCTS L L C, DBA PABCO GYPSUM — Type QuietRock ES.

2F. **Gypsum Board* —** (As an alternate to Item 2) — Not to be used with item 7. 5/8 in. thick, 4 ft. wide, paper surfaced, applied vertically or horizontally and fastened to the studs and plates with 1-1/4 in. long Type W coarse thread gypsum panel steel screws spaced a max 8 in. OC, with last screw 1 in. from edge of board.
CERTAINTEED GYPSUM INC — Type SilentFX

2G. **Wall and Partition Facings and Accessories* —** (As an alternate to Items 2 through 2F) — Nominal 5/8 in. thick, 4 ft wide panels, secured as described in Item 2.
PABCO BUILDING PRODUCTS L L C, DBA PABCO GYPSUM — Type QuietRock 527.

2H. **Gypsum Board* —** (As an alternate to Item 2) — 5/8 in. thick gypsum panels, with beveled, square, or tapered edges, applied either horizontally or vertically. Gypsum panels fastened to framing with 1-1/4 in. long Type W coarse thread gypsum panel steel screws spaced a maximum 10 in. OC with the last two screws 4 and 1 in. from the edges of the board. When used in widths other than 48 in., gypsum panels are to be installed horizontally.
CERTAINTEED GYPSUM INC — Type LGFC6A (finish rating 21 min), Type LGFC2A, Type LGFC-C/A, Type LGFC-WD, Type LGLLX

2I. **Gypsum Board* —** (As an alternate to Item 2) — 5/8 in. thick gypsum panels, with beveled, square, or tapered edges, applied either horizontally or vertically. Gypsum panels fastened to framing with 1-1/4 in. long Type W coarse thread gypsum panel steel screws spaced a max 8 in. OC, with last screw 1 in. from edge of board. When used in widths of other than 48 in., gypsum boards are to be installed horizontally.
AMERICAN GYPSUM CO — Types AGX-1 (finish rating 25 min.), M-Glass (finish rating 25 min.), AG-C (finish rating 25 min.), LightRoc (finish rating 25 min.)

Feedback

NATIONAL GYPSUM CO — Type FSK, Type FSK-G, Type FSW, Type FSW-3, Type FSW-5, Type FSW-G, Type FSK-C, Type FSW-C, Type FSMR-C, Type FSW-6, Type FSL

2J. **Gypsum Board* —** (As an alternate to Item 2) - 5/8 in. thick gypsum panels, with beveled, square, or tapered edges, applied either horizontally or vertically. Gypsum panels fastened to framing with 1-1/4 in. long Type W coarse thread steel screws spaced a max 8 in. OC with the last screw 1 in. from edge of board. When used in widths other than 48 in., gypsum boards are to be installed horizontally.
CERTAINTEED GYPSUM INC — Type C, Type X-1(finish rating 26 min), Easi-Lite Type X (finish rating 24 min), Easi-Lite Type X-2, Type EGRG or GlasRoc or GlasRoc Sheathing (finish rating 23 min)

3. **Joints and Fastener Heads —** (Not Shown) — Gypsum board joints covered with tape and joint compound. Fastener heads covered with joint compound.

4. **Batts and Blankets* —** Mineral fiber or glass fiber insulation, 3-1/2 in. thick, pressure fit to fill wall cavities between studs and plates. Mineral fiber insulation to be unfaced and to have a min density of 3 pcf. Glass fiber insulation to be faced with aluminum foil or kraft paper and to have a min density of 0.9 pcf (min R-13 thermal insulation rating).
See **Batts and Blankets*** (BKNX) Category in the Building Materials Directory and **Batts and Blankets*** (BZJZ) Category in the Fire Resistance Directory for names of Classified Companies.

4A. **Fiber, Sprayed* —** As an alternate to Batts and Blankets (Item 4) — Spray applied cellulose material. The fiber is applied with water to completely fill the enclosed cavity in accordance with the application instructions supplied with the product with a nominal dry density of 2.7 lb/ft^3. Alternate Application Method: The fiber is applied without water or adhesive at a nominal dry density of 3.5 lb/ft^3, in accordance with the application instructions supplied with the product.
Applegate Greenfiber Acquisition LLC — INS515LD, INS541LD, Insulmax, and SANCTUARY are to be used for dry application only.

4B. **Fiber, Sprayed* —** As an alternate to Item 4 and 4A — Spray applied cellulose material. The fiber is applied with water to completely fill the enclosed cavity in accordance with the application instructions supplied with the product. Nominal dry density of 4.58 lb/ft ^{3}.
NU-WOOL CO INC — Cellulose Insulation

4C. **Fiber, Sprayed* —** As an alternate to Batts and Blankets (Item 4) — Spray applied cellulose fiber. The fiber is applied with water to completely fill the enclosed cavity in accordance with the application instructions supplied with the product. The minimum dry density shall be 4.30 lbs/ft^3.
INTERNATIONAL CELLULOSE CORP — Celbar-RL

4D. **Fiber, Sprayed* —** As an alternate to Batts and Blankets (Item 4) — Spray applied, granulated mineral fiber material. The fiber is applied with adhesive, at a minimum density of 4.0 pcf, to completely fill the enclosed cavity in accordance with the application instructions supplied with the product. See Fiber, Sprayed (CCAZ).
AMERICAN ROCKWOOL MANUFACTURING, LLC — Type Rockwool Premium Plus

5. **Wood Structural Panel Sheathing —** Min 7/16 in. thick, 4 ft wide wood structural panels, min grade "C-D" or "Sheathing", Installed with long dimension of sheet (strength axis) or face grain of plywood parallel with or perpendicular to studs. Vertical joints centered on studs. Horizontal joints backed with nom 2 by 4 in. wood blocking. Attached to studs on exterior side of wall with 6d cement coated box nails spaced 6 in. OC at perimeter of panels and 12 in. OC along interior studs.

5A. **Mineral and Fiber Boards* —** As an alternate to Item 5 - Min 1/2 in. thick, 4 ft wide sheathing, installed vertically to studs. Vertical joints centered on studs. Horizontal joints backed with nom 2 by 4 in. wood blocking. Attached to studs on exterior side of wall with 1-1/2 in. long galvanized roofing nails spaced 6 in. OC at perimeter of panels and 12 in. OC along interior studs. As an option a weather resistive barrier may be applied over the Mineral and Fiber Boards.

6. **Exterior Facings —** Installed in accordance with the manufacturer's installation instructions. One of the following exterior facings is to be applied over the sheathing:
A. **Vinyl Siding — Molded Plastic* —** Contoured rigid vinyl siding having a flame spread value of 20 or less.
See **Molded Plastic** (BTAT) category in the Building Materials Directory for names of manufacturers.

Feedback

B. **Particle Board Siding —** Hardboard exterior sidings including patterned panel or lap siding.

C. **Wood Structural Panel or Lap Siding —** APA Rated Siding, Exterior, plywood, OSB or composite panels with veneer faces and structural wood core, per PS 1 or APA Standard PRP-108, including textured, rough sawn, medium density overlay, brushed, grooved and lap siding.

D. **Cementitious Stucco —** Portland cement or synthetic stucco systems with self-furring metal lath or adhesive base coat. Thickness from 3/8 to 3/4 in., depending on system.

E. **Brick Veneer —** Any type on nom 4 in. wide brick veneer. When brick veneer is used, the rating is applicable with exposure on either face. Brick veneer fastened with corrugated metal wall ties attached over sheathing to wood studs with 8d nail per tie: ties spaced not more than each sixth course of brick and max 32 in. OC horizontally. One in. air space provided between brick veneer and sheathing.

F. **Exterior Insulation and Finish System (EIFS) —** Nom 1 in. **Foamed Plastic*** insulation bearing the UL Classification Marking, attached over sheathing and finished with coating system, or Portland cement or synthetic stucco systems, in accordance with manufacturer's instructions. See **Foamed Plastic** (BRYX and CCVW) categories for names of Classified companies.

G. **Siding —** Aluminum or steel siding attached over sheathing to studs.

H. **Fiber-Cement Siding —** Fiber-cement exterior sidings including smooth and patterned panel or lap siding.

I. **Wall and Partition Facings and Accessories* —** Stone veneer is mortar bonded to a lath, scratch coat and water resistant barrier applied to sheathing, installed in accordance with the manufacturers installation instructions, and meeting the requirements of local code agencies.
ELDORADO STONE OPERATIONS L L C — Type Eldorado Stone

J. **Cementitious Backer Units —** 1/2 in. or 5/8 in., min. 32 in. wide.- Applied vertically or horizontally with vertical joints centered over studs. Fastened to studs and runners with cement board screws of adequate length to penetrate stud by a minimum 3/4 in., spaced a max of 8 in. OC. Horizontal joints need not be backed by framing. When Cementitious Backer Units are used, the rating is applicable with exposure on either face. Cementitious Backer Units for use as substrate for exterior finishes such as ceramic tile, slate, marble, natural stone, manufactured stone, thin brick, or Portland cement or synthetic stucco.
NATIONAL GYPSUM CO — Type Permallase

K. **Building Units –** 1 in., 2 in. or 3 in. thick, 4 ft. wide composite exterior cement backer board with rigid insulation, finished with ceramic tile, marble, natural stone, manufactured stone, thin brick, Portland cement or synthetic stucco.

NATIONAL GYPSUM CO – Type PBCI

6A. **Building Units* — As an alternate to Exterior Facing Item 6 —** Insulated steel panels, 12 through 42 in. wide. Attached over sheathing through retainer clips to studs or support steel with No. 14 hex head self-tapping screws located at each joint in the concealed lip of the units and spaced in accordance with the structural design requirements. KINGSPAN INSULATED PANELS INC — Types 200, 300, 400, 900, or KS series, 2 through 6 in. thickness; CWP-V, H, 2 through 3 in. nominal thickness or Designwall 2000 or Designwall 4000, 2 and 3 in. nominal thickness.

7. **Steel Framing Members* —** (Optional, Not Shown) — Furring Channels and Steel Framing Members as described below:
a. **Furring Channels —** Formed of No. 25 MSG galv steel. 2-9/16 in. or 2-23/32 in. wide by 7/8 in. deep, spaced 24 in. OC perpendicular to studs. Channels secured to studs as described in Item b. Ends of adjoining channels are overlapped 6 in. and tied together with double strand of No. 18 SWG galv steel wire near each end of overlap. As an alternate, ends of adjoining channels may be overlapped 6 in. and secured together with two self-tapping #6 framing screws, min. 7/16 in. long at the midpoint of the overlap, with one screw on each flange of the channel. Gypsum board attached to furring channels as described in Item 2.

b. **Steel Framing Members* —** Used to attach furring channels (Item 7A) to studs. Clips spaced maximum 48 in. OC., and secured to studs with No. 8 x 2-1/2 in. coarse drywall screw through the center grommet. Furring channels are friction fitted into clips. RSIC-1 clip for use with 2-9/16 in. wide furring channels. RSIC-1 (2.75) clip for use with 2-23/32 in. wide furring channels.
PAC INTERNATIONAL L L C — Types RSIC-1, RSIC-1 (2.75).

Feedback

7A. **Steel Framing Members* —** (Optional, Not Shown, As an alternate to Item 7) — Furring channels and Steel Framing Members as described below:
a. **Furring Channels —** Formed of No. 25 MSG galv steel, spaced 24 in. OC perpendicular to studs. Channels secured to studs as described in Item b. Ends of adjoining channels are overlapped 6 in. and tied together with double strand of No. 18 SWG galv steel wire near each end of overlap. As an alternate, ends of adjoining channels may be overlapped 6 in. and secured together with two self-tapping #6 framing screws, min. 7/16 in. long at the midpoint of the overlap, with one screw on each flange of the channel. Gypsum board attached to furring channels as described in Item 2.

b. **Steel Framing Members* —** Used to attach furring channels (Item 7Aa) to interior side of studs. Clips spaced 48 in. OC., and secured to studs with two No. 8 x 2-1/2 in. coarse drywall screws, one through the hole at each end of the clip. Furring channels are friction fitted into clips.
KINETICS NOISE CONTROL INC — Type Isomax.

7B. **Steel Framing Members* —** (Optional, Not Shown, As an alternate to Item 7) — Furring channels and Steel Framing Members as described below:
a. **Furring Channels —** Formed of No. 25 MSG galv steel. 2-3/8 in. wide by 7/8 in. deep, spaced 24 in. OC perpendicular to studs. Channels secured to studs as described in Item b. Ends of adjoining channels are overlapped 6 in. and tied together with double strand of No. 18 SWG galv steel wire near each end of overlap. As an alternate, ends of adjoining channels may be overlapped 6 in. and secured together with two self-tapping #6 framing screws, min. 7/16 in. long at the midpoint of the overlap, with one screw on each flange of the channel. Gypsum board attached to furring channels as described in Item 2.

b. **Steel Framing Members* —** Used to attach furring channels (Item a) to studs. Clips spaced 48 in. OC. Genie clips secured to studs with No. 8 x 1-1/2 in. coarse drywall screw through the center hole. Furring channels are friction fitted into clips.
PLITEQ INC — Type Genie Clip

7C. **Steel Framing Members* —** (Optional, Not Shown, As an alternate to Item 7) — Furring channels and Steel Framing Members as described below:
a. **Furring Channels —** Formed of No. 25 MSG galv steel. Spaced 24 in. OC perpendicular to studs. Channels secured to studs as described in Item b. Ends of adjoining channels overlapped 6 in. and tied together with double strand of No. 18 AWG galvanized steel wire.Gypsum board attached to furring channels as described in Item 2.

b. **Steel Framing Members* —** Used to attach furring channels (Item 7Ca) to studs. Clips spaced 48 in. OC., and secured to studs with 2 in. coarse drywall screw with 1 in. diam washer through the center hole. Furring channels are friction fitted into clips.
STUDCO BUILDING SYSTEMS — RESILMOUNT Sound Isolation Clips - Type A237R

7D. **Steel Framing Members* —** (Optional, Not Shown, As an alternate to Item 7) — Furring channels and Steel Framing Members as described below:
a. **Furring Channels —** Formed of No. 25 MSG galv steel. Spaced 24 in. OC perpendicular to studs. Channels secured to studs as described in Item 7Db. Ends of adjoining channels overlapped 6 in. and tied together with double strand of No. 18 AWG galvanized steel wire. Gypsum board attached to furring channels as described in Item 2.

b. **Steel Framing Members* —** Used to attach furring channels (Item 7Da) to studs. Clips spaced 48 in. OC., and secured to studs with No. 8 x 2-1/2 in. coarse drywall screw through the center hole. Furring channels are friction fitted into clips.
REGUPOL AMERICA — Type SonusClip

7E. **Steel Framing Members* —** (Optional, Not Shown, As an alternate to Item 7) — Resilient channels and Steel Framing Members as described below:
a. **Resilient Channels —** Formed of No. 25 MSG galv steel, spaced 24 in. OC, and perpendicular to studs. Channels secured to studs as described in Item b. Ends of adjoining channels overlapped 6 in. and secured in place with two No. 8 15 x 1/2 in. Philips Modified Truss screws spaced 2-1/2 in. from the center of the overlap. Gypsum board attached to resilient channels as described in Item 2.

b. **Steel Framing Members* —** Used to attach resilient channels (Item 7Ea) to studs. Clips spaced 48 in. OC., and secured to studs with No. 8 x 2-1/2 in. coarse drywall screw through the center hole. Resilient channels are secured to clips with one No. 10 x 1/2 in. pan-head self-drilling screw.
KEENE BUILDING PRODUCTS CO INC — Type RC+ Assurance Clip

Feedback

7F **Steel Framing Members* —** (Optional, Not Shown, As an alternate to Item 7) — Furring channels and Steel Framing Members as described below:
a **Furring Channels —** Formed of No. 25 MSG galv steel. 2-23/32 in. wide by 7/8 in. deep, spaced 24 in. OC perpendicular to studs. Channels secured to studs as described in Item b. Ends of adjoining channels are overlapped 6 in. and tied together with double strand of No. 18 SWG galv steel wire near each end of overlap. As an alternate, ends of adjoining channels may be overlapped 6 in. and secured together with two self-tapping #6 framing screws, min. 7/16 in. long at the midpoint of the overlap, with one screw on each flange of the channel. Gypsum board attached to furring channels as described in Item 2.

b **Steel Framing Members* —** Used to attach furring channels (Item 7Fa) to studs. Clips spaced maximum 48 in. OC. Clips secured to studs with No. 8 x 2-1/2 in. coarse drywall screw through the center grommet. Furring channels are friction fitted into clips.

CLARKDIETRICH BUILDING SYSTEMS — Type ClarkDietrich Sound Clip

8. **Non-Bearing Wall Partition Intersection —** (Optional) — Two nominal 2 by 4 in. stud or nominal 2 by 6 in. stud nailed together with two 3in. long 10d nails spaced a max. 16 in. OC. vertically and fastened to one side of the minimum 2 by 4 in. stud with 3 in. long 10d nails spaced a max 16 in. OC. vertically. Intersection between partition wood studs to be flush with the 2 by 4 in. studs. The wall partition wood studs are to be framed by with a second 2 by 4 in. wood stud fastened with 3 in. long 10d nails spaced a max. 16 in. OC. vertically. Maximum one non-bearing wall partition intersection per stud cavity. Non-bearing wall partition stud depth shall be at a minimum equal to the depth of the bearing wall.

*** Indicates such products shall bear the UL or cUL Certification Mark for jurisdictions employing the UL or cUL Certification (such as Canada), respectively.**

Last Updated on 2023-08-04

The appearance of a company's name or product in this database does not in itself assure that products so identified have been manufactured under UL Solutions' Follow - Up Service. Only those products bearing the UL Mark should be considered to be Certified and covered under UL Solutions' Follow - Up Service. Always look for the Mark on the product.

UL Solutions permits the reproduction of the material contained in Product iQ subject to the following conditions: 1. The Guide Information, Assemblies, Constructions, Designs, Systems, and/or Certifications (files) must be presented in their entirety and in a non-misleading manner, without any manipulation of the data (or drawings). 2. The statement "Reprinted from Product iQ with permission from UL Solutions" must appear adjacent to the extracted material. In addition, the reprinted material must include a copyright notice in the following format: "©2023 UL LLC."

Feedback

PRINTS ISSUED
10/30/23 PERMIT SUBMITTAL

REVISIONS:
1 12/15/23 Addendum 1 - Response to City Comments

rosemann & ASSOCIATES P.C.
ARCHITECTURE
INTERIOR DESIGN
ENGINEERING
PLANNING
1526 Grand Boulevard
Kansas City, MO 64108-1404
p: 816.472.1448
w: www.rosemann.com
© 2023 Rosemann & Associates, P.C.
DENVER ▲ KANSAS CITY ▲ ST. LOUIS ▲ ATLANTA

STATE OF MISSOURI
DAVID EUGENE HENDRIKSEN
NUMBER A-2005
REGISTERED ARCHITECT
12/27/23

WILSHIRE HILLS III
LEE'S SUMMIT, MISSOURI
MHDC - 22-057

SHEET TITLE
UL ASSEMBLIES

PROJECT NUMBER: 23034

SHEET NUMBER:
G-209
1

12/27/2023 8:55:29 AM
C:\Revit Local Cache\R2023\2034_Wilshire Hills III_Central_R23_revit013-LCAR.rvt

REFERENCE G-003 FOR GENERAL NOTES

DIAGRAMS BELOW ARE APPLICABLE TO PUBLIC SPACES AND ALL UNIT TYPES UNLESS NOTED OTHERWISE

GENERAL NOTES

1. THE PROJECT SHALL MEET ALL APPLICABLE CODES SPECIFIED BY LOCAL AND FEDERAL REQUIREMENTS, INCLUDING BUT NOT LIMITED TO THE INFORMATION PRESENTED ON THE FOLLOWING G-300 SHEETS.
   A. LOCAL AND FEDERAL REQUIREMENTS SHALL SUPERCEDE ANY CONFLICTING INFORMATION
2. ALL DIMENSIONS PROVIDED ON THE FOLLOWING G-300 SHEETS REPRESENT CLEAR DIMENSIONS AND ARE TAKEN FROM FACE OF FINISH/COMPONENT

UNIVERSAL DESIGN REQ'S

REQUIREMENTS FOR UNIVERSAL DESIGN HOUSING FOR THE ELDERLY AND SINGLE FAMILY DWELLINGS.

1. EQUITABLE USE
   A. FLAT LANDING SURFACES LEADING TO DOORWAYS
   B. LEVER ACTION DOOR HARDWARE
   C. LEVER ACTION PLUMBING FIXTURE CONTROLS
   D. NO THRESHOLDS AND/OR CHANGE OF WALKING SURFACE GREATER THAN 1/2 INCH
2. FLEXIBILITY IN USE
   A. BLOCKING IN BATHROOM WALLS TO ACCEPT GRAB RAILS
   B. BLOCKING IN OR BEHIND SHOWER/TUB ENCLOSURES TO ACCEPT GRAB RAILS
   C. DOOR ASSEMBLIES AND CABINET DOOR ASSEMBLIES THAT WILL ACCEPT LEVER OR KNOB HARDWARE WITHOUT ALTERATION OR REPLACEMENT
3. SIMPLE AND INTUITIVE
   A. BUTTONS ON CONTROL PANELS THAT CAN BE DISTINGUISHED BY TOUCH
4. PERCEPTIBLE INFORMATION
   A. SIGNAGE WITH LARGE CONTRASTING PRINT IN ADDITION TO GENERALLY RECOGNIZED ICONS
   B. CONTRASTING COLORS BETWEEN WIRING DEVICES [RECEPTACLES AND LIGHT SWITCHES] AND SURROUNDING SURFACES
   C. CONTRASTING COLORS BETWEEN STEPS AND LANDINGS
   D. CONTRASTING COLORS BETWEEN DIFFERENT FLOOR COVERINGS
   E. CONTRASTING COLORS BETWEEN COUNTERTOPS AND FLOORING
   F. CONTRASTING COLORS BETWEEN PLUMBING FIXTURES AND FLOORING/COUNTERTOPS
5. TOLERANCE FOR ERROR
   A. LIGHT SWITCHES WITH LARGE FLAT PADS
   B. NON-SLIP WALKING SURFACES
6. LOW PHYSICAL EFFORT
   A. SELF CLOSING FIRE RATED DOORS MUST BE ON LOWEST SETTING WHILE COMPLYING WITH THE ENFORCED BUILDING CODE
   B. NO INTERIOR RAMPS
7. SIZE AND SPACE FOR APPROACH AND USE
   A. 36 INCH WIDE DOORS
   B. FLOOR SPACE TO ACCOMMODATE A 60 INCH DIAMETER CIRCLE FOR WHEEL CHAIR TURNING IN KITCHEN AND BATHROOM
   C. 42 INCH WIDE RESIDENTIAL UNIT AND COMMON HALLWAYS

OTHER HEIGHTS

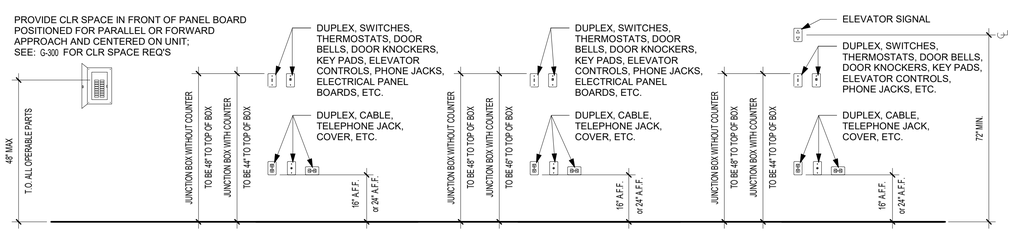

D4 MOUNTING HEIGHTS
NOT TO SCALE

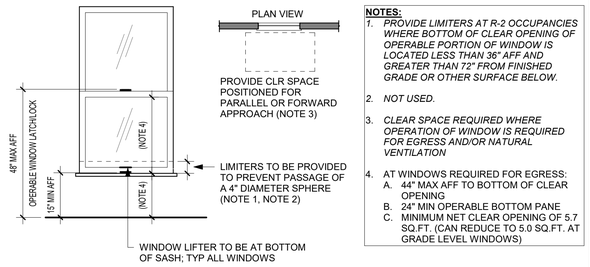

NOTES:

1. *PROVIDE LIMITERS AT R-2 OCCUPANCIES WHERE BOTTOM OF CLEAR OPENING OF OPERABLE PORTION OF WINDOW IS LOCATED LESS THAN 36" AFF AND GREATER THAN 72" FROM FINISHED GRADE OR OTHER SURFACE BELOW.*
2. *NOT USED.*
3. *CLEAR SPACE REQUIRED WHERE OPERATION OF WINDOW IS REQUIRED FOR EGRESS AND/OR NATURAL VENTILATION*
4. AT WINDOWS REQUIRED FOR EGRESS:
   A. 44" MAX AFF TO BOTTOM OF CLEAR OPENING
   B. 24" MIN OPERABLE BOTTOM PANE
   C. MINIMUM NET CLEAR OPENING OF 5.7 SQ.FT. (CAN REDUCE TO 5.0 SQ.FT. AT GRADE LEVEL WINDOWS)

A4 WINDOW LATCH/LOCK REQ'S
NOT TO SCALE

DOORS

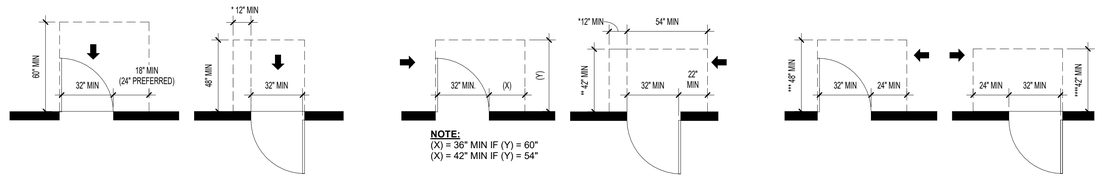

NOTE:
DOOR CLEARANCES ARE REQUIRED FOR ALL DOORS AT THE FOLLOWING LOCATIONS:
PUBLIC AREAS, ACCESSIBLE UNITS, "TYPE A" UNITS

"TYPE B" UNIT DOOR PUSH/PULL CLEARANCES ARE REQUIRED FOR UNIT ENTRY DOORS ONLY; SEE UNIT PLANS FOR MORE INFORMATION

GENERAL LEGEND:
* = IF BOTH CLOSER & LATCH ARE REQUIRED
** = 48" MIN IF BOTH CLOSER & LATCH PROVIDED
*** = 54" MIN IF CLOSER IS PROVIDED
**** = 48" MIN IF CLOSER PROVIDED

D3 DOOR CLEARANCES
NOT TO SCALE

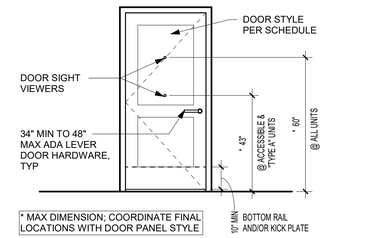

A3 DOOR HARDWARE HEIGHTS
NOT TO SCALE

MAIL BOXES

100% OF MAILBOXES PROVIDED MEET ACCESSIBILITY GUIDELINES

ACCESSIBLE MAILBOXES
48" MAX AFF (CL OF LOCK)
PROVIDE **30"x48"** CLEAR FLOOR SPACE AT ALL ACCESSIBLE LOCKERS, CENTERED ON MAILBOX

USPS ARROW LOCK
36" MIN & 48" MAX AFF (CL OF LOCK)
PARCEL LOCKER
15" AFF MIN (T.O. BOTTOM SHELF
MINIMUM OF 1 PARCEL LOCKER FOR EVERY 5 MAILBOXES

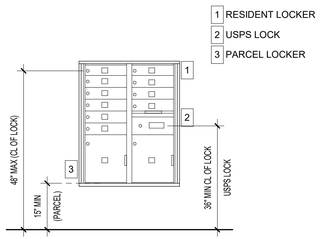

E2 FULLY ACCESSIBLE MAIL BOXES
NOT TO SCALE

CLEAR FLOOR SPACES

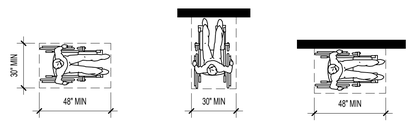

NOTE: ALL CLEAR SPACES ARE 30"x48" UNLESS SPECIFIED OTHERWISE.

C2 CLEAR FLOOR SPACE
NOT TO SCALE

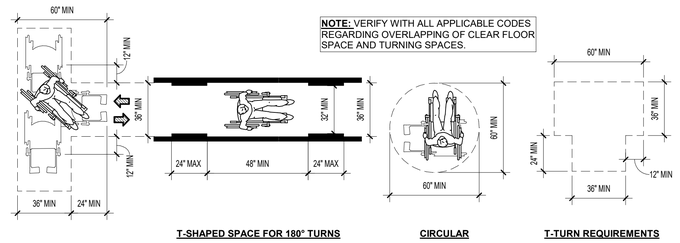

A2 WHEELCHAIR TURNING SPACE
NOT TO SCALE

REACH RANGES

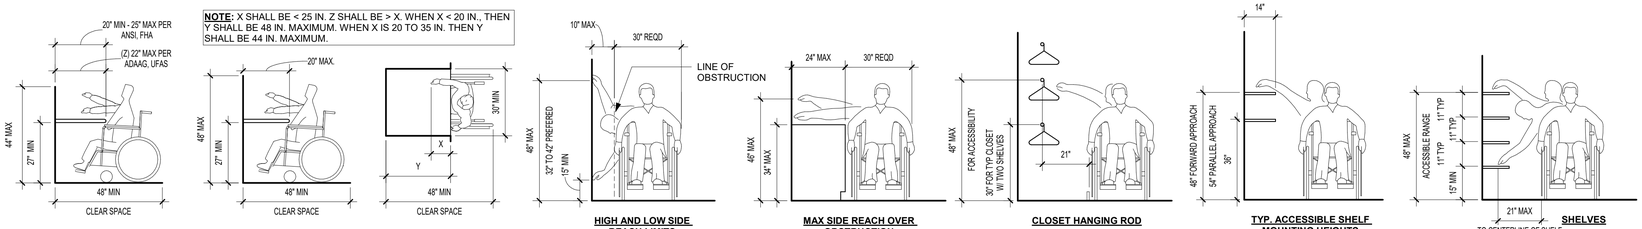

D1 REACH REQUIREMENTS
NOT TO SCALE

PRINTS ISSUED
10/30/23 PERMIT SUBMITTAL

REVISIONS:

rosemann & ASSOCIATES P.C.
ARCHITECTURE
INTERIOR DESIGN
ENGINEERING
PLANNING
1526 Grand Boulevard
Kansas City, MO 64108-1404
p: 816.472.1448
w: www.rosemann.com

© 2023 Rosemann & Associates, P.C.

DENVER ▲ KANSAS CITY ▲ ST. LOUIS ▲ ATLANTA

STATE OF MISSOURI
DAVID EUGENE HENDRIKSE
NUMBER A-7365
REGISTERED ARCHITECT
10/30/23

WILSHIRE HILLS III
LEE'S SUMMIT, MISSOURI
MHDC - 22-057

SHEET TITLE
ACCESSIBILITY STANDARDS

PROJECT NUMBER: 23034

SHEET NUMBER:

G-300

10/2/2023 2:53:39 PM
C:\Revit Local Cache\20232034_Wilshire Hills III_Central_R23_mm5f1UCAR.rvt

REFERENCE G-003 FOR GENERAL NOTES

DIAGRAMS BELOW ARE APPLICABLE TO PUBLIC SPACES AND ALL UNIT TYPES UNLESS NOTED OTHERWISE

SIGNAGE

TACTILE SIGN HEIGHT TO BE PER 2009 ANSI A117.1 SECTION 703.3.10

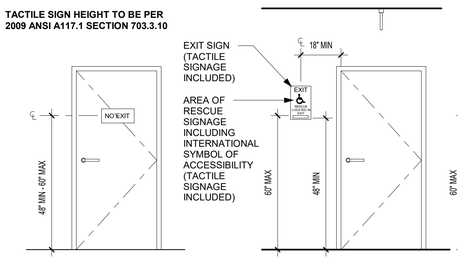

SIGNAGE AT NON-EXIT | SIGNAGE AT STAIR ENTRY | SIGNAGE AT AREA OF RESCUE

AREA OF RESCUE INSTRUCTIONS INDICATING ALL OF THE FOLLOWING:

1. DIRECTIONS TO FIND OTHER MEANS OF EGRESS
2. UNLESS THEY ARE ASSISTING OTHERS, PERSONS ABLE TO USE THE EXIT STAIRWAY SHOULD DO SO AS SOON AS POSSIBLE.
3. INFORMATION ON PLANNED AVAILABILITY OF ASSISTANCE IN THE USE OF STAIRS OR SUPERVISED OPERATION OF ELEVATORS AND HOW TO SUMMON SUCH ASSISTANCE.
4. DIRECTIONS FOR USE OF THE EMERGENCY COMMUNICATIONS SYSTEM.

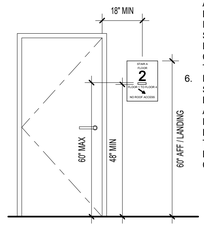

SIGNAGE AT STAIR FLOOR LANDING

STAIR SIGNAGE REQ'S:

5. SIGNAGE PROVIDED AT EACH FLOOR LANDING AT INTERIOR EXIT STAIRWAYS AND/OR RAMPS CONNECTING MORE THAN 3 STORIES
6. FLOOR LEVEL SIGNAGE SHALL BE LOCATED ADJACENT EACH FLOOR-LEVEL LANDING ADJACENT TO THE DOOR LEADING TO CORRIDOR

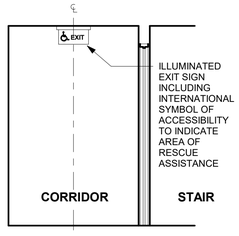

SIGNAGE AT EXIT

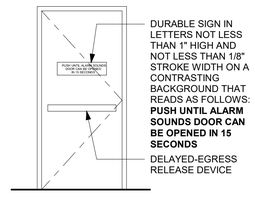

SIGNAGE AT DELAYED -EGRESS LOCKS

NOTE: SIGNS CONTAINING RAISED CHARACTERS AND BRAILLE SHALL BE LOCATED ON LATCH SIDE OF DOOR WITH A 18x18 CLEAR FLOOR SPACE OUTSIDE THE SWING OF THE DOOR

D4 CODE COMPLIANT SIGNAGE
NOT TO SCALE

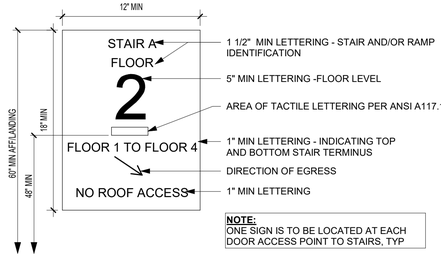

NOTE:
ONE SIGN IS TO BE LOCATED AT EACH DOOR ACCESS POINT TO STAIRS, TYP

A4 EGRESS STAIR SIGNAGE
NOT TO SCALE

RAMPS

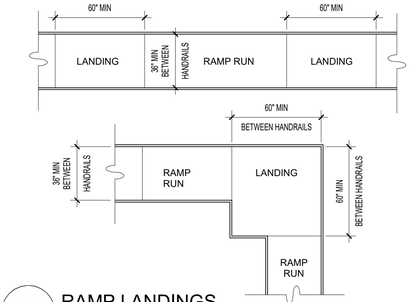

D3 RAMP LANDINGS
NOT TO SCALE

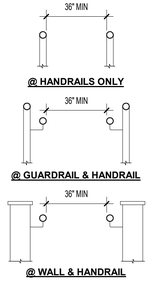

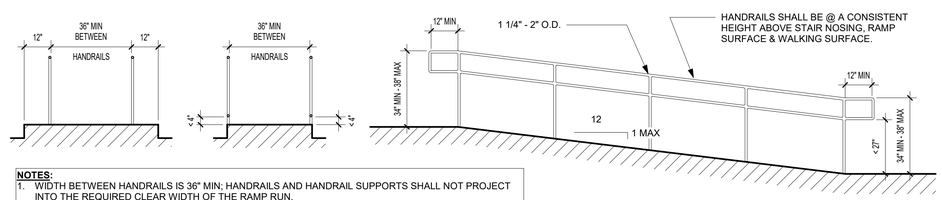

NOTES:

1. WIDTH BETWEEN HANDRAILS IS 36" MIN; HANDRAILS AND HANDRAIL SUPPORTS SHALL NOT PROJECT INTO THE REQUIRED CLEAR WIDTH OF THE RAMP RUN.
2. CROSS SLOPE OF RAMP SURFACES SHALL BE NO GREATER THAN 1:48 AND SHALL BE STABLE, FIRM, AND SLIP-RESISTANT. IF THE SLOPE IS EQ. OR GREATER THAN 1:20 YOU ARE REQ. TO HAVE HANDRAILS ON BOTH SIDES OF RAMP.
3. RAMP RUNS WITH A RISE GREATER THAN 6 INCHES SHALL HAVE HANDRAILS.

C3 RAMP & HANDRAIL SPECS
NOT TO SCALE

ADDITIONAL REQUIREMENTS

CARPET	MAX PILE HEIGHT SHALL BE 1/2 IN. EXPOSED EDGES OF CARPET SHALL BE FASTENED TO FLOOR SURFACES AND HAVE TRIM ALONG THE ENTIRE LENGTH OF THE EXPOSED EDGE. IF CARPET TILE IS USED ON AN ACCESSIBLE GROUND OF FLOOR SURFACE, IT SHALL HAVE A MAXIMUM COMBINED THICKNESS OF PILE, CUSHION, AND BACKING HEIGHT OF 1/2 IN.		
RAMPS	SLOPE	MAX RISE	MAX HORIZONTAL PROJECTION
	1:12 TO <1:16	30 IN.	30 FT.
	1:16 TO <1:20	30 IN.	40 FT.
	1:12 TO 1:20 - REQUIRES A HANDRAIL		
INTERIOR SIGNAGE	**CHARACTER PROPORTION AND COLOR CONTRAST** LETTERS AND NUMBERS ON SIGNS SHALL HAVE A WIDTH-TO-HEIGHT RATIO BETWEEN 3:5 AND 1:1 AND A STROKE WIDTH-TO-HEIGHT RATIO BETWEEN 1:5 AND 1:10. CHARACTERS AND SYMBOLS SHALL CONTRAST WITH THEIR BACKGROUND AND BE NON-GLARE. CHARACTERS SHALL BE UPPER CASE. CHARACTER HEIGHT, MEASURED VERTICALLY FROM THE BASELINE OF THE CHARACTER, SHALL BE 5/8 IN. MINIMUM, AND 2 IN. MAXIMUM, BASED ON THE UPPERCASE LETTER "I".		
	RAISED OR INDENTED CHARACTERS OR SYMBOLS LETTERS AND NUMBERS ON SIGNS SHALL BE RAISED OR INCISED 1/32 IN. MIN AND SHALL BE SANS SERIF CHARACTERS. RAISED CHARACTERS OR SYMBOLS SHALL BE AT LEAST 5/8 IN HIGH, BUT NO HIGHER THAN 2 IN. INDENTED CHARACTERS OR SYMBOLS SHALL HAVE A STROKE WIDTH OF AT LEAST 1/4 IN. SYMBOLS OR PICTOGRAPHS ON SIGNS SHALL BE RAISED OR INDENTED 1/32 IN MIN		
	MOUNTING LOCATION AND HEIGHT INTERIOR SIGNAGE SHALL BE LOCATED ALONGSIDE THE DOOR ON THE LATCH SIDE AND SHALL BE MOUNTED AT A HEIGHT OF BETWEEN 54 IN. AND 66 IN. ABOVE THE FINISHED FLOOR PER UFAS AND BETWEEN 48 IN. AND 60 IN. PER ANSI. REFER TO **ICC/ANSI A117.1-2009, 703.2.8** FOR MORE REQUIREMENTS ON MOUNTING LOCATION.		

STAIRS AND RAILINGS

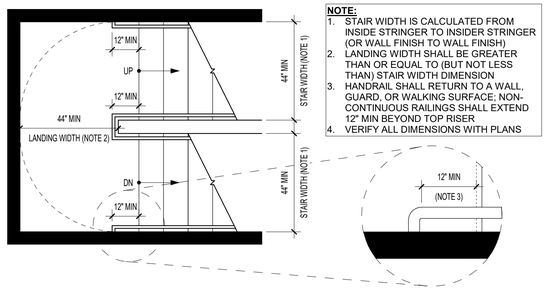

NOTE:

1. STAIR WIDTH IS CALCULATED FROM INSIDE STRINGER TO INSIDER STRINGER (OR WALL FINISH TO WALL FINISH)
2. LANDING WIDTH SHALL BE GREATER THAN OR EQUAL TO (BUT NOT LESS THAN) STAIR WIDTH DIMENSION
3. HANDRAIL SHALL RETURN TO A WALL, GUARD, OR WALKING SURFACE; NON-CONTINUOUS RAILINGS SHALL EXTEND 12" MIN BEYOND TOP RISER
4. VERIFY ALL DIMENSIONS WITH PLANS

D2 EGRESS STAIR REQ'S
NOT TO SCALE

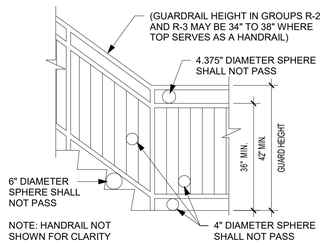

C2 STAIR OPENING GUARD LIMITATIONS
NOT TO SCALE

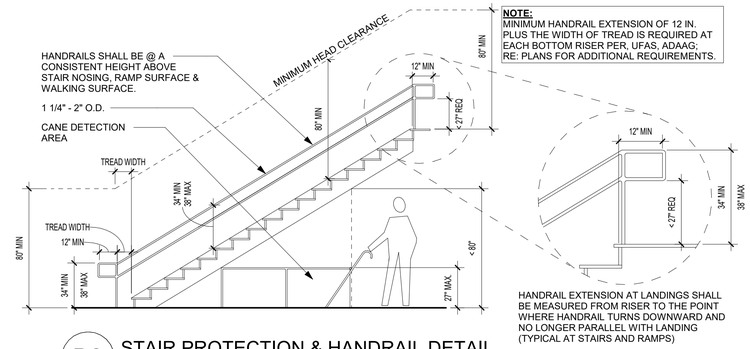

NOTE:
MINIMUM HANDRAIL EXTENSION OF 12 IN. PLUS THE WIDTH OF TREAD IS REQUIRED AT EACH BOTTOM RISER PER, UFAS, ADAAG; RE: PLANS FOR ADDITIONAL REQUIREMENTS.

HANDRAIL EXTENSION AT LANDINGS SHALL BE MEASURED FROM RISER TO THE POINT WHERE HANDRAIL TURNS DOWNWARD AND NO LONGER PARALLEL WITH LANDING (TYPICAL AT STAIRS AND RAMPS)

B2 STAIR PROTECTION & HANDRAIL DETAIL
NOT TO SCALE

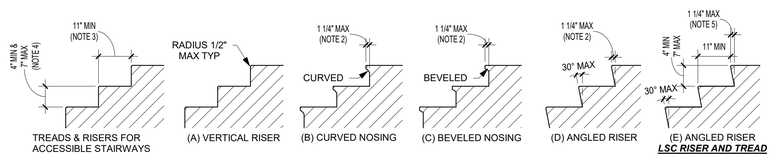

NOTES:

1. **REFER TO THE CODE OF THE CITY & STAIR DETAILS BEFORE DETERMINING THE STYLE OF THE STAIR**
2. 3/4" MIN NOSING PROJECTION WITHIN R-2 DWELLING UNITS WITH SOLID RISERS WHERE THE TREAD DEPTH IS LESS THAN 11"
3. 10" MIN TREAD DEPTH WITHIN INDIVIDUAL R-2 DWELLING UNITS.
4. 7 3/4" MAX RISER HEIGHT WITHIN INDIVIDUAL R-2 DWELLING UNITS
5. 1 1/2" PER LIFE SAFETY CODE WHERE ALLOWABLE

D1 STAIR RISER AND TREAD REQ
NOT TO SCALE

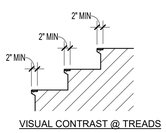

VISUAL CONTRAST @ TREADS

THE LEADING 2" OF TREADS SHALL HAVE VISUAL CONTRAST OF DARK-ON-LIGHT OR LIGHT-ON-DARK FROM THE REMAINDER OF THE TREAD

MATERIAL CHANGES SHALL PROVIDE A FLUSH SURFACE

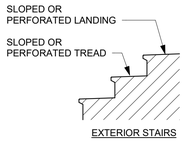

EXTERIOR STAIRS

TREADS AND LANDINGS SUBJECT TO WET CONDITIONS SHALL BE DESIGNED TO PREVENT ACCUMULATION OF WATER

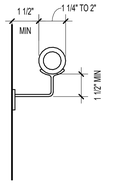

B1 IBC HANDRAIL DETAIL
NOT TO SCALE

PRINTS ISSUED
10/30/23 PERMIT SUBMITTAL

REVISIONS:

rosemann & ASSOCIATES P.C.
ARCHITECTURE
INTERIOR DESIGN
ENGINEERING
PLANNING
1526 Grand Boulevard
Kansas City, MO 64108-1404
p: 816.472.1448
w: www.rosemann.com
© 2023 Rosemann & Associates, P.C.
DENVER ▲ KANSAS CITY ▲ ST. LOUIS ▲ ATLANTA

STATE OF MISSOURI
DAVID EUGENE HENDRIKSE
NUMBER A-7365
REGISTERED ARCHITECT
10/30/23

WILSHIRE HILLS III
LEE'S SUMMIT, MISSOURI
MHDC - 22-057

SHEET TITLE
ACCESSIBILITY STANDARDS

PROJECT NUMBER: 23034

SHEET NUMBER:

G-301

10/27/2023 2:53:42 PM
C:\Revit Local Files\R20220230A_Wilshire Hills III_Central_R23_mm9TVLKdR.rvt

REFERENCE G-003 FOR GENERAL NOTES

DIAGRAMS BELOW ARE APPLICABLE TO PUBLIC SPACES AND ALL UNIT TYPES UNLESS NOTED OTHERWISE

AGE APPROPRIATE REQ'S

AGE APPROPRIATE SPEC. FOR WATER CLOSETS

	AGES 3-4	AGES 5-8	AGES 9-12	ADULTS
WATER CLOSET-CENTERLINE TO WALL	12 IN.	12-15 IN.	15-18 IN.	18 IN.
TOILET SEAT HEIGHT FROM AFF	11-12 IN.	12-15 IN.	15-17 IN.	17-19 IN.
GRAB BAR HEIGHT FROM AFF	18-20 IN.	20-25 IN.	25-27 IN.	33-36 IN.
DISPENSER HEIGHT FROM AFF	14 IN.	14-17 IN.	17-19 IN.	24 IN.

CHILDREN'S REACH RANGES FROM A WHEELCHAIR

FORWARD OR SIDE REACH	AGES 3-4	AGES 5-8	AGES 9-12
HIGH (MAXIMUM)	36 IN.	40 IN.	44 IN.
LOW (MINIMUM)	20 IN.	18 IN.	16 IN.

TOILET, BATH, LAUNDRY ACCESSORY SCHEDULE

TOILET, BATH, AND LAUNDRY ACCESSORY SCHEDULE (SPEC 10 2800)

ACCESSORY	MOUNTING HEIGHT	LOCATION
MIRROR	SEE G-XXX	PUBLIC & UNIT
PAPER TOWEL DISP/RECP	3'-4" AFF TO TOP OF CONTROLS	PUBLIC
TOILET PAPER DISPENSER	SEE G-301	PUBLIC & UNIT
GRAB BARS	SEE G-301 (2'-10" AFF UNO)	PUBLIC & UNIT
SANITARY NAPKIN RECEPTOR	1'-7" AFF & 3'-6" FROM REAR WALL	PUBLIC
DRINKING FOUNTAIN	PER MFR	PUBLIC
DRINKING FOUNTAIN - ACCESSIBLE	SEE G-301	PUBLIC
WATER CLOSET (FLOOR-MOUNTED)	1'-4" AFF MIN TO RIM	PUBLIC & UNIT
WATER CLOSET - ACCESSIBLE (FLOOR-MOUNTED)	SEE G-301	PUBLIC & UNIT
LAVATORY	STANDARD (SEE INTERIOR ELEVATIONS)	PUBLIC & UNIT
LAVATORY - ACCESSIBLE	2' - 10" AFF TO TOP OF SINK RIM (FOR SURFACE MOUNTED SINKS)...	PUBLIC & UNIT
SOAP DISPENSER	3'-8" AFF TO CONTROLS	PUBLIC
REFER TO SPECIFICATIONS FOR ADDITIONAL INFORMATION		

GENERAL NOTES

1. GRAB BAR BLOCKING IS REQUIRED AT ALL TOILET, SHOWER AND BATHTUB GRAB BAR LOCATIONS; APPLICABLE AT ALL PUBLIC SPACES, ACCESSIBLE UNITS, "TYPE A" UNITS, AND "TYPE B" UNITS.
2. CONTRACTOR SHALL BE FAMILIAR AND INCORPORATE ALL PROVISIONS AND REQUIREMENTS ESTABLISHED BY CODES APPLICABLE TO THE PROJECT INCLUDING FAIR HOUSING, UFAS, ANSI, & ADAAG

TUB SEAT

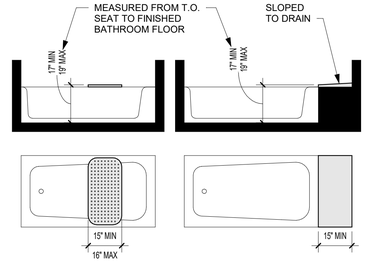

B4 BATHTUB SEAT
NOT TO SCALE

SHOWER SEAT

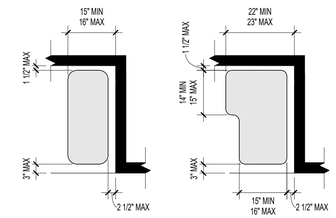

A4 SHOWER SEAT
NOT TO SCALE

SHOWERS

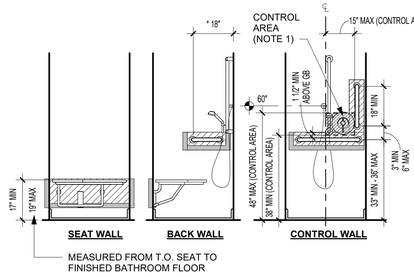

D3 TRANSFER SHOWER
NOT TO SCALE

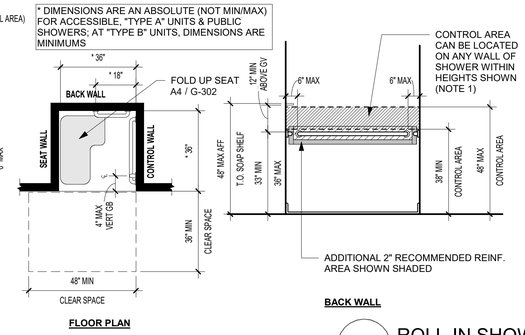

C3 ROLL-IN SHOWER W/O SEAT
NOT TO SCALE

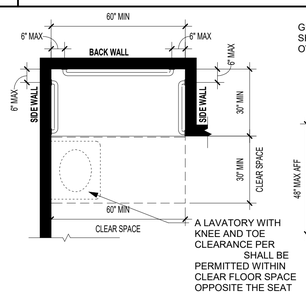

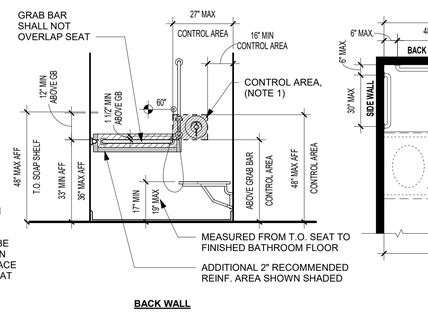

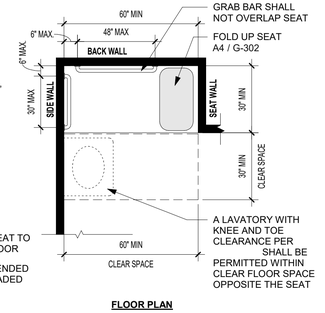

B3 ROLL-IN SHOWER W/ SEAT
NOT TO SCALE

SHOWER NOTES

SHOWER DIAGRAMS & NOTES BELOW ARE APPLICABLE TO PUBLIC, ACCESSIBLE, AND "TYPE A" COMPLIANT BATHROOMS.

SEE UNIT PLANS AND/OR PLUMBING SCHEDULE FOR "TYPE B" OR EXEMPT SHOWER REQUIREMENTS

1. AN ADJUSTABLE-HEIGHT HAND SHOWER, MOUNTED ON A VERTICAL BAR, SHALL BE INSTALLED SUCH THAT THE HANDLE OF THE HAND SHOWER (POSITIONED AT ITS LOWEST POSITION) SHALL BE LOCATED WITHIN THE CONTROL AREA SHOWN
   A. FIXED SHOWER HEAD MOUNTED AT 48" MAX ABOVE SHOWER FLOOR PERMITTED AT PUBLIC SHOWERS.
2. A HAND SHOWER WITH A HOSE OF 59" MINIMUM IN LENGTH TO BE PROVIDED.
   A. HAND SHOWER SHALL HAVE A CONTROL WITH A NONPOSITIVE SHUT OFF FEATURE.
3. ADDITIONAL 2" RECOMMENDED REINFORCED AREA AROUND GRAB BARS (SHOWN SHADED)
4. SEE UNIT PLANS AND/OR INTERIOR ELEVATIONS FOR ADDITIONAL INFORMATION
5. THRESHOLDS SHALL BE 1/2" MAX

TUB

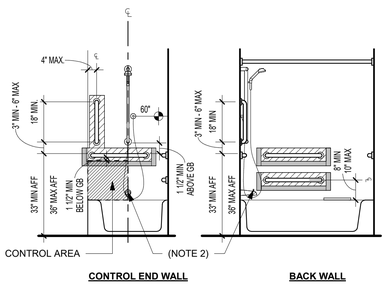

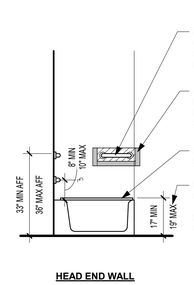

D2 BATHTUB HEIGHT REQ'S
NOT TO SCALE

ACCESSIBLE UNITS:
SINK OR CABINETRY NOT ALLOWED WITHIN CLEAR FLOOR SPACE

"TYPE A" UNITS:
COUNTER TOPS AND CABINETRY PERMITTED WITHIN CLEAR FLOOR SPACE PROVIDED ALL OF THE FOLLOWING:
A. REMOVABLE COUNTER TOP & CABINETRY
B. FLOOR AND WALL FINISHES EXTEND UNDER AND BEHIND THE REMOVABLE CABINETRY & COUNTER TOP.

"TYPE B" UNITS:
OPTION A - PARALLEL APPROACH TUB:
LAVATORY PERMITTED WITHIN CLEAR FLOOR SPACE PROVIDED A 48"X30" CLEAR SPACE IS PROVIDED IN FRONT OF THE TUB
OPTION A - FORWARD APPROACH TUB:
WATER CLOSET AND LAVATORY PERMITTED WITHIN CLEAR FLOOR SPACE
OPTION B:
SINK OR CABINETRY NOT ALLOWED WITHIN 30"X48" CLEAR FLOOR SPACE

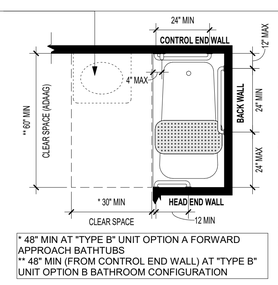

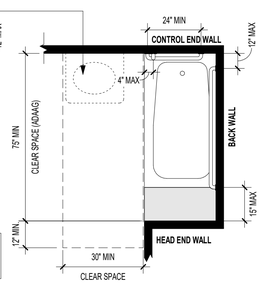

C2 BATHTUB CLEARANCES
NOT TO SCALE

TUB NOTES

TUB DIAGRAMS & NOTES BELOW ARE APPLICABLE TO ACCESSIBLE, AND "TYPE A" COMPLIANT BATHROOMS.

SEE UNIT PLANS AND/OR PLUMBING SCHEDULE FOR "TYPE B" OR EXEMPT TUB REQUIREMENTS.

1. A HAND SHOWER WITH A HOSE OF 59" MINIMUM IN LENGTH TO BE PROVIDED.
   A. HAND SHOWER SHALL HAVE A CONTROL WITH A NONPOSITIVE SHUT OFF FEATURE.
2. NO PIN KNOB DIVERTERS IN ACCESSIBLE OR "TYPE A" UNITS AT TUB FAUCETS.
3. ADDITIONAL 2" RECOMMENDED REINFORCED AREA AROUND GRAB BARS (SHOWN SHADED).
4. REMOVABLE SEAT NOT REQUIRED AT "TYPE A" UNITS.
5. SEE UNIT PLANS AND/OR INTERIOR ELEVATIONS FOR ADDITIONAL INFORMATION.

GRAB BAR

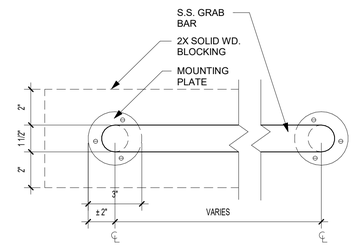

A2 GRAB BAR DETAIL
NOT TO SCALE

TOILET

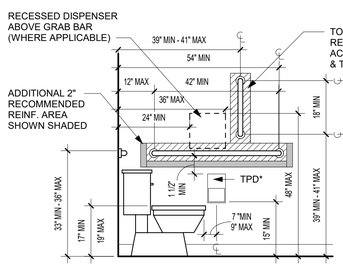

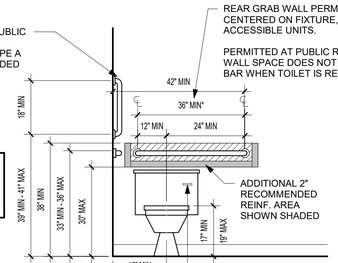

NOTE: SEE ALSO INDIVIDUAL UNIT PLANS FOR ADDITIONAL REQUIREMENTS

* TOILET PAPER DISPENSER (TPD) = 2 ROLL DISPENSER, 5" DIAMETER ROLLS
* TOILET PAPER HOLDER (TP) TO BE MOUNTED 21" AFF TO CENTER OF HOLDER, 7"- 9" FROM EDGE OF W.C.
* ALL OTHER DISPENSERS MOUNTED 18" MIN / 48" MAX AFF, AND 24" MIN / 42" MAX FROM BACK WALL TO OUTLET

D1 TOILET STANDARDS
NOT TO SCALE

WHERE TOILET PARTITIONS EXTEND TO FINISHED FLOOR (NO TOE CLEARANCE PROVIDED); CLEARANCE REQ'S INCREASE BY +6" EACH SIDE

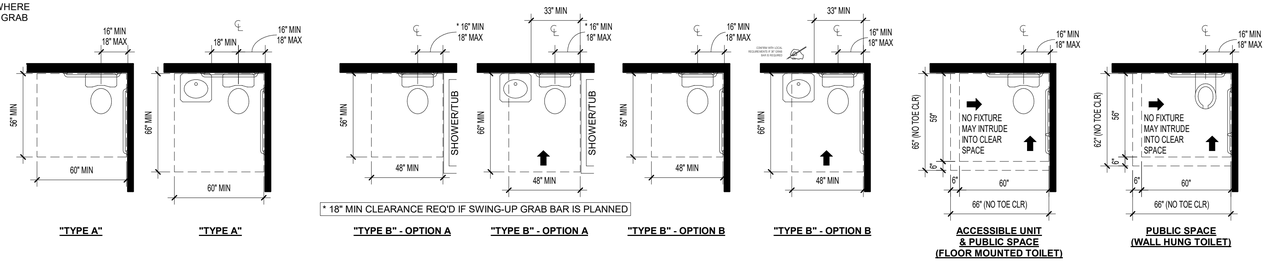

C1 TOILET APPROACHES
NOT TO SCALE

PRINTS ISSUED
10/30/23 PERMIT SUBMITTAL

REVISIONS:

rosemann & ASSOCIATES P.C.
ARCHITECTURE
INTERIOR DESIGN
ENGINEERING
PLANNING
1526 Grand Boulevard
Kansas City, MO 64108-1404
p: 816.472.1448
w: www.rosemann.com

© 2023 Rosemann & Associates, P.C.

DENVER ▲ KANSAS CITY ▲ ST. LOUIS ▲ ATLANTA

STATE OF MISSOURI
DAVID EUGENE HENDRIKSE
NUMBER A-7365
REGISTERED ARCHITECT
10/30/23

WILSHIRE HILLS III

LEE'S SUMMIT, MISSOURI

MHDC - 22-057

SHEET TITLE
ACCESSIBILITY STANDARDS

PROJECT NUMBER: 23034

SHEET NUMBER:

G-302

10/27/2023 2:53:45 PM
C:\Revit Local Cache\23034_Wilshire Hills III_Central_R23_mm5FTUCAR.rvt

REFERENCE G-003 FOR GENERAL NOTES

DIAGRAMS BELOW ARE APPLICABLE TO PUBLIC SPACES AND ALL UNIT TYPES UNLESS NOTED OTHERWISE

THRESHOLD

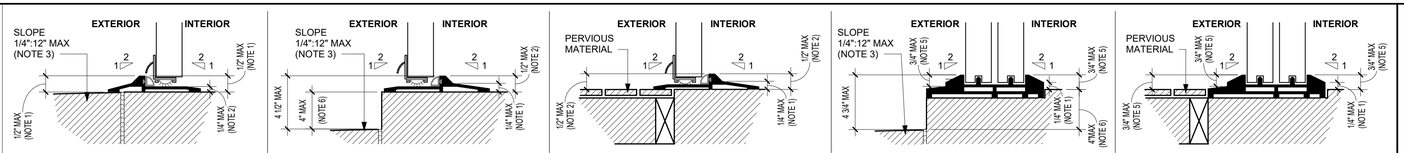

SWINGING @ IMPERVIOUS MATERIAL	SWINGING SECONDARY DOOR @ IMPERVIOUS MATERIAL	SWINGING SECONDARY DOOR @ PERVIOUS MATERIAL	SLIDING SECONDARY DOOR @ IMPERVIOUS MATERIAL	SLIDING SECONDARY DOOR @ PERVIOUS MATERIAL
ALL DOORS INTENDED FOR PASSAGE	BALCONY OR OTHER EXTERIOR DOORS	BALCONY OR OTHER EXTERIOR DOORS	BALCONY OR OTHER EXTERIOR DOORS	BALCONY OR OTHER EXTERIOR DOORS
✓ PUBLIC DOORS		✓ PUBLIC DOORS		
✓ ACCESSIBLE UNITS (ALL DOORS)		✓ ACCESSIBLE UNITS		
✓ "TYPE A" UNITS (ALL DOORS)		✓ "TYPE A" UNITS		
✓ "TYPE B" UNITS (UNIT ENTRY DOORS ONLY)	✓ "TYPE B" UNITS	✓ "TYPE B" UNITS	✓ "TYPE B" UNITS	✓ "TYPE B" UNITS

SEE ARCHITECTURAL DRAWINGS FOR PROJECT SPECIFIC THRESHOLD DETAILS AND WEATHER PROOFING

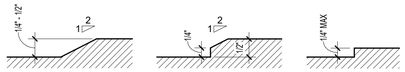

IMAGE 3 IMAGE 2 IMAGE 1

NOTES:
1. CHANGES IN LEVEL OF 1/4" MAXIMUM IN HEIGHT SHALL BE PERMITTED TO BE VERTICAL WITH NO BEVEL PROVIDED **(IMAGE 1)**
2. CHANGES IN LEVEL GREATER THAN 1/4" SHALL BE BEVELED WITH A 1:2 SLOPE FOR UP TO 1/2" MAX **(IMAGE 2,3)**
3. FINISHED SURFACE OUTSIDE OF PRIMARY ENTRY DOOR MAY BE SLOPED AT A MAXIMUM OF 1/4" PER 12"
4. **EXISTING BUILDINGS ONLY**: EXISTING OR ALTERED THRESHOLDS SHALL BE PERMITTED TO BE 3/4" MAX WITH A 1:2 BEVELED EDGE ON EA SIDE OF HEIGHT EXCEEDING 1/4"
5. **SLIDING DOORS ONLY:** THRESHOLD SHALL BE PERMITTED TO BE 3/4" MAX WITH A 1:2 BEVELED EDGE ON EACH SIDE FOR HEIGHT EXCEEDING 1/4"
6. ALLOWABLE AT SECONDARY EXTERIOR RESIDENTIAL DOORS ONLY (**ANSI A117.1 1004.4.2 & FHA 4.11**)

C4 CHANGES IN LEVEL & THRESHOLDS
NOT TO SCALE

CLOSETS

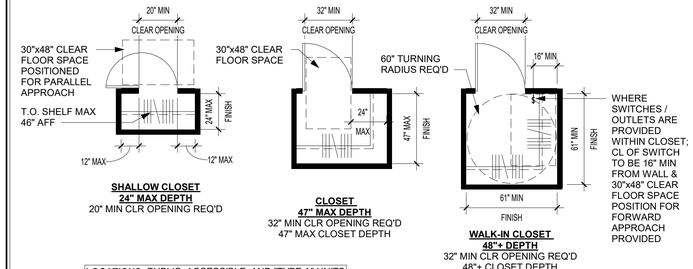

LOCATIONS: PUBLIC, ACCESSIBLE, AND "TYPE A" UNITS

A4 CLOSET DIMENSIONS
NOT TO SCALE

PASSENGER LOADING ZONE

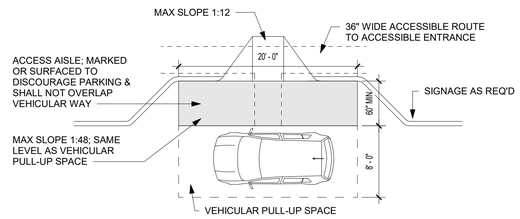

D3 PASSENGER LOADING ZONE
NOT TO SCALE

HEARING & VISION IMPAIRED

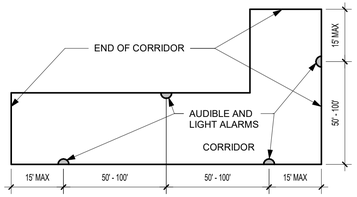

C3 ALARM SPACING IN CORRIDOR
NOT TO SCALE

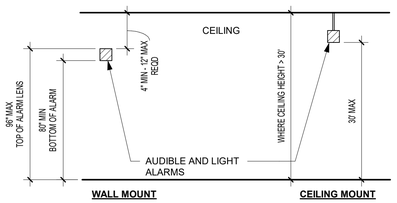

B3 CEILING/ WALL MOUNTED ALARM LOCATIONS
NOT TO SCALE

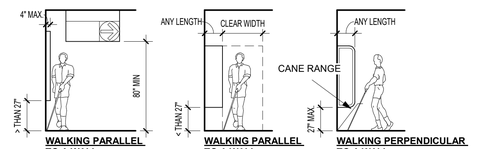

A3 PROTRUDING OBJECTS
NOT TO SCALE

KITCHENS

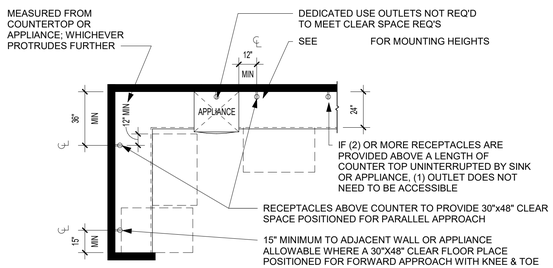

D2 ABOVE COUNTER RECEPTACLES
NOT TO SCALE

NOTE:
FOR PUBLIC SPACES, ACCESSIBLE UNITS, AND "TYPE A" UNITS:
1. **SIDE-HINGED DOOR OVENS -** WORK SURFACE IS TO BE POSITIONED ADJACENT TO THE LATCH SIDE OF THE OVEN DOOR.
2. **BOTTOM-HINGED DOOR OVENS -** WORK SURFACE IS TO BE POSITIONED ADJACENT TO ONE SIDE OF THE OVEN DOOR.
3. **CONTROLS -** OVENS SHALL HAVE CONTROLS ON FRONT PANELS

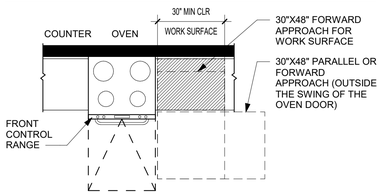

C2 OVEN WITH WORK SPACE
NOT TO SCALE

* AT PUBLIC SPACES, 50% OF SHELF SPACE SHALL BE WITHIN REACH RANGE (2010 ADA 804.5); COORDINATE WITH DRAWINGS

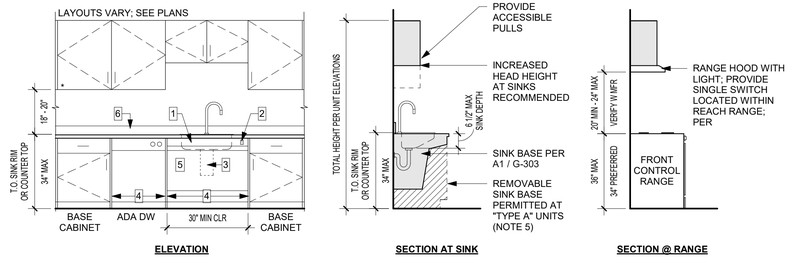

B2 KITCHEN REQUIREMENTS
NOT TO SCALE

KITCHEN NOTES

KITCHEN DIAGRAMS AND NOTES APPLICABLE TO PUBLIC SPACES, ACCESSIBLE, AND "TYPE A" COMPLIANT KITCHENS

SEE UNIT PLANS AND/OR INTERIOR ELEVATIONS FOR "TYPE B" OR EXEMPT KITCHENS

NOTES:
1. SINK DEPTH MAX 6 1/2" AND HAVE REAR LOCATED DRAINS
2. GARBAGE DISPOSAL SWITCH TO BE LOCATED WITHIN REACH RANGE; COORDINATE FINAL LOCATION WITH ARCHITECT
3. INSULATE ALL PIPES AND DRAIN EXPOSED BELOW SINK
4. PROVIDE FINISHED END PANELS EACH SIDE OF SINK PANEL AND DISHWASHER
   A. WALL BASE, WALL FINISH & FLOOR FINISH TO CONTINUE TO UNDERSIDE OF SINK
5. CABINETRY PERMITTED UNDER SINK AT "TYPE A" UNITS PROVIDED ALL THE FOLLOWING:
   A. REMOVABLE CABINETRY WITHOUT REPLACING SINK
   B. FLOORING, WALL FINISH, AND WALL BASE TO CONTINUE TO UNDERSIDE OF SINK
6. BACKSPLASH VARIES; COORDINATE WITH DRAWINGS
7. SEE INDIVIDUAL UNIT PLANS AND INTERIOR ELEVATIONS FOR SPECIFIC LAYOUTS

DRINKING FOUNTAINS

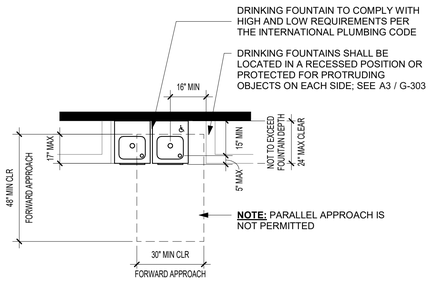

D1 DRINKING FOUNTAINS CLEAR SPACE REQUIREMENTS
NOT TO SCALE

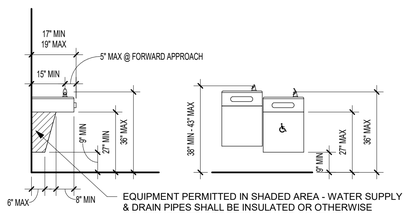

C1 DRINKING FOUNTAIN HEIGHT REQUIREMENTS
NOT TO SCALE

SINKS

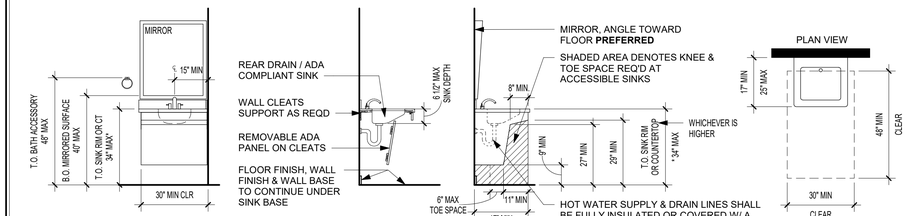

* 36" MAX T.O. SINK OR COUNTERTOP AT "TYPE B" UNITS

NOTES:
1. 34" MAX AFF TO TOP OF WALL MOUNTED SINKS
2. SEE PLANS & ELEV. FOR PROJ. SPECIFIC DETAILS
3. SINKS SHALL BE 6 1/2" DEEP MAX

FOR "TYPE B" UNITS:
1. PARALLEL APPROACH CENTERED ON SINK PERMITTED WHEN CENTERLINE OF SINK IS 24" MIN FROM ADJACENT WALL
2. IF FORWARD APPROACH IS PROVIDED, CABINETRY ALLOWED UNDER THE LAVATORY PROVIDED:
   A. CABINETRY CAN BE REMOVED WITHOUT REPLACEMENT OF THE LAVATORY
   B. FLOOR FINISH EXTENDS UNDER THE CABINETRY
   C. WALLS BEHIND AND SURROUNDING THE CABINETRY ARE FINISHED

A1 SINK KNEE & TOE CLEARANCES & HEIGHT REQUIREMENTS
NOT TO SCALE
LOCATIONS: PUBLIC AREAS, ACCESSIBLE UNITS, "TYPE A" UNITS

PRINTS ISSUED
10/30/23 PERMIT SUBMITTAL

REVISIONS:

rosemann & ASSOCIATES P.C.
ARCHITECTURE
INTERIOR DESIGN
ENGINEERING
PLANNING
1526 Grand Boulevard
Kansas City, MO 64108-1404
p: 816.472.1448
w: www.rosemann.com

© 2023 Rosemann & Associates, P.C.

DENVER ▲ KANSAS CITY ▲ ST. LOUIS ▲ ATLANTA

STATE OF MISSOURI
DAVID EUGENE HENDRIKSE
NUMBER A-7365
REGISTERED ARCHITECT
10/30/23

WILSHIRE HILLS III

LEE'S SUMMIT, MISSOURI

MHDC - 22-057

SHEET TITLE
ACCESSIBILITY STANDARDS

PROJECT NUMBER: 23034

SHEET NUMBER:

G-303

10/27/2023 3:53:48 PM
C:\Revit Local Files\R2023\23034_Wilshire Hills III_Central_R23_mm5f1cAR.rvt

WILSHIRE HILLS PHASE III

LEE'S SUMMIT, JACKSON COUNTY, MISSOURI

SITE PLAN

JUNE 30, 2023

REVISED: APRIL 17, 2024

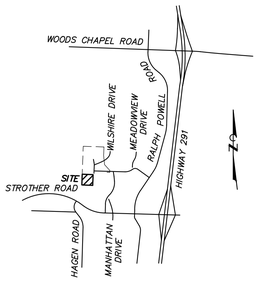

VICINITY MAP

NOT TO SCALE

LEGEND

E	PROPERTY LINE
E	ELECTRIC LINE
T	TELECOMMUNICATIONS LINE
UE	UNDERGROUND ELECTRIC LINE
UT	UNDERGROUND TELECOMMUNICATIONS LINE
UFO	UNDERGROUND FIBER OPTIC LINE
S	SANITARY SEWER LINE
SS	STORM SEWER LINE
G	GAS LINE
W	WATER LINE
X	FENCE
	TREE & BRUSH LINE
	DRAINAGE SWALE
750	EXISTING CONTOUR
	ANCHOR
	TEST BORING
	IRON
CP#	CONTROL POINT
EM	ELECTRIC METER
FES	FLARED END SECTION
FH	FIRE HYDRANT
FL	FLOW LINE
HDPE	HIGH DENSITY POLYETHYLENE PIPE
PCCP	PRESTRESSED CONCRETE CYLINDER PIPE
PVC	POLYVINYL CHLORIDE PIPE
TW	TOP OF WALL
UP	UTILITY POLE
WM	WATER METER
WV	WATER VALVE
YL	YARD LIGHT
	SILT FENCE
	TEMPORARY DIVERSION DIKE
	TREE PRESERVATION BARRIER
750	FINISH CONTOUR
750	FINISH GRADE CONTOUR
50.0	TOP OF CURB ELEVATION
49.5	TOP OF PAVEMENT ELEVATION
49.5	FINISH GRADE ELEVATION
S	PROPOSED SANITARY SEWER LINE
W	PROPOSED WATER LINE
UE	PROPOSED UNDERGROUND ELECTRIC
UT	PROPOSED UNDERGROUND TELECOMMUNICATIONS
	PROPOSED STORM SEWER
S	EXISTING SANITARY SEWER LINE
W	EXISTING WATER LINE
UE	EXISTING UNDERGROUND ELECTRIC
UT	EXISTING UNDERGROUND TELECOMMUNICATIONS
	EXISTING STORM SEWER
	PROPOSED WATER VALVE
	PROPOSED FIRE HYDRANT & VALVE
	THRUST BLOCK
	THRUST COLLAR
	STANDARD DUTY CONCRETE
	HEAVY DUTY CONCRETE

UTILITY NOTES

THE LOCATIONS, SIZES, AND MATERIAL TYPES OF UNDERGROUND UTILITIES INDICATED ON THE PLAT, NOT VISIBLE OR APPARENT FROM THE SURFACE, ARE SHOWN IN THEIR APPROXIMATE LOCATIONS FROM A MISSOURI ONE CALL SYSTEM LOCATE, OR UTILITY COMPANY RECORDS AND WERE NOT VERIFIED IN THE FIELD.

WATER
JACKSON COUNTY PWSD #14
CITY OF LEE'S SUMMIT
220 SE GREEN STREET
LEE'S SUMMIT, MISSOURI 64063
CONTACT: PUBLIC WORKS DEPARTMENT 816-969-1800
12" DI ALONG THE NORTH SIDE OF MEADOWVIEW DRIVE.
30" PCCP ALONG THE WEST PROPERTY LINE.

SANITARY SEWER
CITY OF LEE'S SUMMIT
220 SE GREEN STREET
LEE'S SUMMIT, MISSOURI 64063
CONTACT: WES OWEN 816-969-1955
AS SHOWN

STORM SEWER
CITY OF LEE'S SUMMIT
220 SE GREEN STREET
LEE'S SUMMIT, MISSOURI 64063
CONTACT: SHAWN GRAFF 816-969-1800
AS SHOWN

ELECTRIC
EVERGY
1300 SE HAMBLEN ROAD
LEE'S SUMMIT, MISSOURI 64081
CONTACT: 888-471-5275

FIBER OPTIC
GOOGLE FIBER
2812 WEST 47TH STREET
KANSAS CITY, KS 66103
CONTACT: CRAIG YOUNG 870-219-5630

GAS
MISSOURI GAS ENERGY
3025 SE CLOVER ROAD
LEE'S SUMMIT, MISSOURI 64081
CONTACT: BECCA ORR 816-969-2230

TELECOM
AT&T
215 N. SPRING STREET, 2nd FLOOR
INDEPENDENCE, MO 64050
CONTACT: MARK MANION 816-275-2341
AS SHOWN

TIME WARNER CABLE
CONTACT: ROY BELLIS 913-643-1914
AS SHOWN

COMCAST CABLE COMMUNICATIONS
3400 NW DUNCAN ROAD
BLUE SPRINGS, MO 64015
CONTACT: BARBARA BROWN 816-795-2255
AS SHOWN

Call BEFORE you DIG
TOLL FREE
1-800-DIG-RITE
MISSOURI ONE-CALL SYSTEM, INC.

SURVEY CONTROL POINTS

MODIFIED STATE PLANE COORDINATES
NAD 83, MISSOURI CENTRAL ZONE, NAVD 88, U.S. SURVEY FEET

POINT #	NORTH	EAST	ELEVATION	DESCRIPTION
CP1	1021333.86	2826648.68	929.50	PK
CP176	1021358.38	2827317.26	923.23	DH
CP177	1020927.07	2826507.36	951.74	IR
CP178	1021669.21	2826691.72	922.55	IR
CP179	1021367.58	2826896.04	922.38	IR
CP500	1021193.58	2826970.42	921.04	IR
CP501	1020639.36	2827222.04	925.57	DH

ENTERPRISE GREEN COMMUNITIES NOTE

CONSTRUCTION SHALL ADHERE TO ALL ENTERPRISE GREEN COMMUNITIES REQUIREMENTS. ALL MANDATORY ITEMS LISTED BELOW:

1. LOCATION AND NEIGHBORHOOD FABRIC
   - 2.1 – SENSITIVE SITE PROTECTION (CIVIL)
     - 2.1.1 – NO SENSITIVE AREAS ONSITE. NO FLOODPLAINS ONSITE, NO AQUATIC ECOSYSTEMS (I.E. WETLANDS OR DEEPWATER HABITATS) ONSITE, NO ENDANGERED SPECIES (NO ENDANGERED SPECIES ONSITE AND THUS NO DESTRUCTION OF HABITAT), AND NO AGRICULTURAL SOILS ONSITE
   - 2.2 – CONNECTIONS TO EXISTING DEVELOPMENT AND INFRASTRUCTURE (CIVIL)
     - 2.2.1 – >25% OF THE SURROUNDING SITE IS DEVELOPED AND HAS ACCESS TO EXISTING ROAD, WATER, AND SEWER
     - 2.2.2 – NEW DRIVEWAYS AND SIDEWALKS WERE PROVIDED TO GIVE ACCESS TO THE EXISTING PEDESTRIAN NETWORKS ALONG NE WILSHIRE DRIVE.
     - 2.2.3 – SITE LESS THAN 5 ACRES
   - 2.3 – COMPACT DEVELOPMENT (CIVIL)
     - 2.3.1 – 50 UNITS/2.54 AC = 19.68 UNITS/AC > 3.01 (PER CENTER FOR NEIGHBORHOOD TECHNOLOGY "RESIDENTIAL DENSITY OF A LOCATION" CALCULATOR)
     - 2.3.2 – 19.68 UNITS/AC > 15 UNITS PER ACRE FOR MULTI-FAMILY BUILDINGS GREATER THAN 2 STORIES
   - 2.5 – PROXIMITY TO SERVICES AND COMMUNITY RESOURCES (CIVIL)
     - 2.5.1 – GREATER THAN FOUR SERVICES AND/OR COMMUNITY RESOURCES ARE LOCATED WITHIN A HALF MILE OF THE PROJECT SITE.
   - 2.6 – PRESERVATION OF AND ACCESS TO OPEN SPACE FOR RURAL/TRIBAL/SMALL TOWN
     - 2.6.1 – GREATER THAN 10% OF THE PROJECT ACREAGE HAS BEEN SET ASIDE AS ACCESSIBLE OPEN SPACE FOR ALL RESIDENTS TO USE.
   - 2.15 – ACCESS TO BROADBAND: BROADBAND READY (CIVIL)
     - 2.15.1 – SITE WILL HAVE BROADBAND INFRASTRUCTURE INSTALLED AND INTERNET SERVICE WILL BE PROVIDED THROUGHOUT THE BUILDING
2. SITE IMPROVEMENTS
   - 3.1 – ENVIRONMENTAL REMEDIATION (CIVIL)
     - 3.1.1 – NO HAZARDOUS MATERIAL IS FOUND ON THE SITE. IT HAS BEEN MASS GRADED AND PAD READY BEFORE CONSTRUCTION.
   - 3.2 – MINIMIZATION OF DISTURBANCE DURING STAGING AND CONSTRUCTION (CIVIL)
     - 3.2.1 – SWPPP AND ESC PLANS WERE CREATED TO BE IMPLEMENTED DURING THE CONSTRUCTION PHASE PROCESS OF THIS PROJECT.
   - 3.3 – ECOSYSTEM SERVICES/LANDSCAPE (CIVIL)
     - 3.3.1 – NO INVASIVE PLANT SPECIES WERE USED IN THE LANDSCAPE PLAN. ALL PLANT SPECIES ARE SUSCEPTIBLE TO THE PLANTING REGION AND SHALL BE WELL SUITED WITHIN THE ENVIRONMENT. ALL DISTURBED AREAS WILL BE PLANTED, SEEDED OR XERISCAPED.
   - 3.4 – SURFACE STORMWATER MANAGEMENT
     - 3.4.1 – ONSITE RUNOFF HAS BEEN TREATED FOR THE WATER QUALITY STORM EVENT USING AN ONSITE REGIONAL DETENTION BASIN.
   - 3.6 – EFFICIENT IRRIGATION AND WATER REUSE (IRRIGATION CONTRACTOR)

BUILDING & PARKING NOTE (1)

LOT SIZE = 110,478 SQ. FT.

BUILDING AREA
BUILDING FOOTPRINT = 17,860 SQ. FT.
TOTAL SQ. FT. = 53,580 SQ. FT.

FLOOR AREA RATIO = 1:0.67

NUMBER OF DWELLING UNITS = 50 UNITS

NUMBER OF BEDS = 82

IMPERVIOUS COVERAGE = 76,230 SQ. FT.

REQUIRED PARKING

1 SPACE PER 2 BEDS	= 50 SPACES
1 SPACE PER EMPLOYEE ON MAX SHIFT	= 2 SPACES
TOTAL REQUIRED	= 52 SPACES

PROVIDED PARKING

STANDARD	= 48 SPACES
ACCESSIBLE	= 11 SPACES
TOTAL PROVIDED	= 59 SPACES

IMPERVIOUS AREA

PRE PROJECT

PERVIOUS	= 0.00 ACRE
IMPERVIOUS	= 2.54 ACRE
TOTAL	= 2.54 ACRE

POST PROJECT

PERVIOUS	= 1.29 ACRE
IMPERVIOUS	= 1.25 ACRE
TOTAL	= 2.54 ACRE

MDNR PERMIT

MDNR PERMIT NO.

PROPERTY DESCRIPTION

PROPOSED LOT 5 OF WILSHIRE HILLS – 5TH PLAT

BENCH MARK

BM – MISSOURI DEPARTMENT OF TRANSPORTATION VRS NETWORK.

PROPERTY OWNER

JEFFREY E. SMITH INVESTMENT CO, LLC
206 PEACH WAY
COLUMBIA, MISSOURI 65203

ZONING NOTE

THIS PROPERTY IS ZONED "P-MIX" PLANNED MIXED USE DISTRICT

FLOODPLAIN NOTE

THIS PROPERTY IS LOCATED IN ZONE X "AREAS DETERMINED TO BE OUTSIDE THE 0.2% ANNUAL CHANCE FLOOD" AS SHOWN BY FIRM COMMUNITY PANEL NUMBER 29095C0430G, DATED JANUARY 20, 2017.

SHEET INDEX

C0.01	COVER
C0.02	GENERAL NOTES
V1.01–V1.02	BOUNDARY & TOPOGRAPHIC SURVEY
C1.01	OVERALL PLAN
C2.01	SITE PLAN
C3.01	JOINT PLAN
C4.01	GRADING & DRAINAGE PLAN
C5.01	STORM SEWER PLAN
C6.01	STORM SEWER PROFILES
C7.01	UTILITY PLAN & PROFILE
C8.01–C8.03	ACCESSIBILITY PLAN
C9.01	INITIAL EROSION CONTROL PLAN
C9.02	FINAL EROSION CONTROL PLAN
C10.01–C10.03	SITE DETAILS
C11.01–C11.02	STORM SEWER DETAILS
C12.01	SANITARY SEWER DETAILS
(2) C13.01–C13.02	WATER DETAILS
C14.01–C14.03	EROSION CONTROL DETAILS
C15.01	PRE-DEVELOPMENT DRAINAGE AREA MAP
C15.02	POST DEVELOPMENT DRAINAGE AREA MAP
C15.03	STORM SEWER DRAINAGE AREA MAP
L1.01–L1.05	LANDSCAPE PLAN
RW1.01	RETAINING WALL PLAN
RW2.01	RETAINING WALL DETAILS

Engineering Surveys & Services
DELIVERING YOUR VISION ™
1113 Fay Street, Columbia, MO 65201
573 - 449 - 2646
802 El Dorado Drive, Jefferson City, MO 65101
573-636-3303
1775 West Main Street, Sedalia, MO 65301
660-826-8618
www.ess-inc.com
MO Engineering Corp. # 2004005018

WILSHIRE HILLS PHASE III
3200 NE MANHATTAN DR
LEE'S SUMMIT, JACKSON COUNTY, MISSOURI

4/17/2024
STATE OF MISSOURI
MATTHEW AARON KRIETE
NUMBER PE-2007002811
PROFESSIONAL ENGINEER

MATTHEW A. KRIETE
PROFESSIONAL ENGINEER
PE-2007002811

IF ORIGINAL SIGNATURE OR DIGITAL AUTHENTICATION IS NOT PRESENT THIS MEDIA SHOULD NOT BE CONSIDERED A CERTIFIED DOCUMENT.

Date
JUNE 30, 2023

Revised
(1) FEBRUARY 6, 2024
(2) APRIL 17, 2024

Design: ST Drawn: MJS

COVER

Sheet
C0.01

ES&S PROJECT NO. 15925

CONSTRUCTION DOCUMENTS

P:\GENERAL PROJECTS\15925E—JES—WILSHIRE HILLS—3—ENG\CAD\15925 COVER & DETAILS.DWG 4/19/2024

SEQUENCE OF EVENTS

1. PRIOR TO CONSTRUCTION, COORDINATE AND HAVE A PRE-CONSTRUCTION MEETING REGARDING SWPPP TRAINING WITH CONSTRUCTION PERSONNEL.
2. DETERMINE ALL UTILITY FIELD LOCATES AS NECESSARY.
3. CONSTRUCT TEMPORARY CONSTRUCTION ENTRANCE AND CONCRETE WASH OUT. INSTALL ALL PERIMETER EROSION AND SEDIMENT CONTROL PER PLAN.
4. COMMENCE ALL CLEARING AND GRUBBING PER PLAN. CONTRACTOR SHALL OBTAIN ALL REQUIRED PERMITS.
5. STRIP TOPSOIL IN GRADING AREAS AND STOCKPILE IN AREAS AS SHOWN ON PLAN.
6. COMMENCE SITE GRADING. FILL ACTIVITIES SHALL MEET THE REQUIREMENTS OF THE GEOTECHNICAL REPORT.
7. CONSTRUCT RETAINING WALL AND FENCE.
8. INSTALL STORM SEWERS PER PLAN. INSTALL INLET PROTECTION IMMEDIATELY UPON COMPLETION OF EACH STORM STRUCTURE.
9. UTILIZE ONSITE FILL MATERIALS FOR OVER EXCAVATED AREAS. FOLLOW GEOTECHNICAL REPORT REQUIREMENTS FOR FILL MATERIAL.
10. INSTALL SITE UTILITIES AS GRADING ALLOWS.
11. FINALIZE BUILDING SUBGRADE PREPARATION IN ACCORDANCE WITH THE PROJECT GEOTECHNICAL REPORT.
12. BEGIN BUILDING CONSTRUCTION.
13. FINALIZE PAVEMENT SUBGRADE PREPARATION. INSTALL BASE MATERIAL AS REQUIRED FOR PAVED AREAS. REMOVE INLET PROTECTION AROUND INLETS NO MORE THAN 48 HOURS PRIOR TO PLACING STABILIZED BASE COURSE.
14. COMMENCE PAVEMENT AND SIDEWALK CONSTRUCTION. REMOVE TEMPORARY CONSTRUCTION ENTRANCE ONLY PRIOR TO PAVEMENT CONSTRUCTION IN THAT AREA (PAVE THIS AREA LAST).
15. COMPLETE FINISH GRADING, TOPSOIL, PLACEMENT, SEED/SOD, AND MULCH ALL DISTURBED AREAS. EXCESS TOPSOIL SHALL BE MOVED TO NEIGHBORING SITE.
16. INSTALL LANDSCAPING.
17. REMOVE ALL TEMPORARY EROSION AND SEDIMENT CONTROL WHEN ALL DISTURBED AREAS ARE STABILIZED.

CONSTRUCTION NOTES

1. THE CONTRACTOR IS SPECIFICALLY CAUTIONED THAT THE LOCATION AND/OR ELEVATION OF EXISTING UTILITIES AS SHOWN ON THESE PLANS IS BASED ON RECORDS OF THE VARIOUS UTILITY COMPANIES, AND WHERE POSSIBLE, MEASUREMENTS TAKEN IN THE FIELD. THE INFORMATION IS NOT TO BE RELIED ON AS BEING EXACT OR COMPLETE. THE CONTRACTOR MUST CALL THE APPROPRIATE UTILITY COMPANIES AT LEAST 72 HOURS BEFORE ANY EXCAVATION TO REQUEST EXACT FIELD LOCATION OF UTILITIES. IT SHALL BE THE RESPONSIBILITY OF THE CONTRACTOR TO RELOCATE ALL EXISTING UTILITIES WHICH CONFLICT WITH THE PROPOSED IMPROVEMENTS SHOWN ON THE PLANS.
2. CONSTRUCTION SHALL COMPLY WITH ALL APPLICABLE GOVERNING CODES AND BE CONSTRUCTED TO SAME.
3. IT SHALL BE THE RESPONSIBILITY OF THE CONTRACTOR TO PROTECT ALL IDENTIFIED PROPERTY CORNERS, LAND SURVEY CORNERS, AND ACCESSORIES. THE CONTRACTOR SHALL CAUSE THE CORNERS AND ACCESSORIES TO BE REFERENCED BY A LICENSED LAND SURVEYOR, AND ANY SUCH CORNER OR ACCESSORIES DISTURBED OR DESTROYED DURING CONSTRUCTION SHALL BE RESET BY THE SURVEYOR AT THE ORIGINAL LOCATION, AND FILE THE RESTORATIONS AND MONUMENT DOCUMENTS AS THE LAW REQUIRES.
4. CONTRACTOR SHALL SUBMIT SHOP DRAWINGS TO ENGINEERING SURVEYS AND SERVICES FOR REVIEW AND APPROVAL FOR ALL MATERIALS BEFORE ORDERING.
5. ALL DIMENSIONS ARE TO BACK OF CURB, FACE OF SIDEWALK, OR EDGE OF PAVEMENT, UNLESS OTHERWISE NOTED.
6. CONCRETE DRIVEWAY APRONS SHALL BE CONSTRUCTED AS PER CITY OF LEE'S SUMMIT SPECIFICATIONS. CONTRACTOR SHALL OBTAIN PERMIT FROM CITY TO WORK WITHIN STREET RIGHT-OF-WAY.
7. ALL STRIPING SHALL BE 4" WIDE WHITE LINES, ACCESSIBLE SPACES SHALL BE 4" WIDE BLUE LINES AND ALL STRIPING SHALL BE A MINIMUM OF 2 COATS.
8. CONTRACTOR SHALL ADJUST AND/OR CUT EXISTING PAVEMENT AS NECESSARY TO ASSURE A SMOOTH FIT AND CONTINUOUS GRADE.
9. ALL TRAFFIC CONTROL SHALL BE PER CURRENT MUTCD REQUIREMENTS AND SHALL BE THE RESPONSIBILITY OF THE CONTRACTOR. A TRAFFIC CONTROL PLAN WILL BE REQUIRED FOR ANY WORK WITHIN THE RIGHT-OF-WAY.
10. CONTRACTOR SHALL NOTIFY ADJACENT PROPERTY OWNERS IN WRITING 30 DAYS PRIOR TO CONSTRUCTION.
11. IF A CONFLICT EXISTS BETWEEN THE CIVIL PLANS AND CIVIL SPECIFICATIONS, THE CIVIL PLANS SHALL GOVERN.
12. ALL INCIDENTAL ITEMS INCLUDING BUT NOT LIMITED TO SIGNS, PAVEMENT MARKING, PAVEMENT, CURBS, TRUNCATED DOMES, FENCING, LANDSCAPING, IRRIGATION, ETC. EITHER DAMAGED OR REMOVED DURING CONSTRUCTION SHALL BE RETURNED TO ORIGINAL CONDITIONS BY THE CONTRACTOR.

HAZARDOUS SUBSTANCE NOTE

1. SUBSTANCES REGULATED BY FEDERAL LAW UNDER THE RESOURCE CONSERVATION AND RECOVERY ACT (RCRA) OR THE COMPREHENSIVE ENVIRONMENTAL RESPONSE COMPENSATION AND LIABILITY ACT (CERCLA) WHICH ARE TRANSPORTED, STORED OR USED FOR MAINTENANCE, CLEANING OR REPAIRS SHALL BE MANAGED ACCORDING TO THE PROVISIONS OF RCRA AND CERCLA.
2. ALL PAINTS, SOLVENTS, PETROLEUM PRODUCTS AND PETROLEUM WASTE PRODUCTS (EXCEPT FUELS) AND STORAGE CONTAINERS (SUCH AS DRUMS, CANS OR CARTONS) SHALL BE STORED SUCH THAT THESE MATERIALS ARE NOT EXPOSED TO STORM WATER. SUFFICIENT PRACTICES OF SPILL PREVENTION, CONTROL AND/OR MANAGEMENT SHALL BE PROVIDED TO PREVENT ANY SPILLS OF THESE POLLUTANTS FROM ENTERING A WATER OF THE STATE. ANY CONTAINMENT SYSTEM USED TO IMPLEMENT THIS REQUIREMENT SHALL BE CONSTRUCTED OF MATERIALS COMPATIBLE WITH THE SUBSTANCES CONTAINED AND SHALL ALSO PREVENT THE CONTAMINATION OF GROUNDWATER.
3. THE APPLICANT SHALL NOTIFY BY TELEPHONE AND IN WRITING THE DEPARTMENT OF NATURAL RESOURCES, WATER POLLUTION CONTROL PROGRAM, POST OFFICE BOX 176, JEFFERSON CITY, MO 65102, 1-800-361-4827, OF ANY OIL SPILLS OR IF HAZARDOUS SUBSTANCES ARE FOUND DURING THE PROSECUTION OF WORK UNDER THIS PERMIT.

ELECTRIC NOTES

SITE CONTRACTOR SHALL CONTACT EVERGY TO COORDINATE INSTALLATION OF ELECTRIC SERVICES. RESPONSIBILITY OF INSTALLATION SHALL BE AS FOLLOWS.

	SUPPLIED BY:	INSTALLED BY:
SECONDARY		
CONDUIT	CONTRACTOR	CONTRACTOR
CONDUCTOR	EVERGY	EVERGY
METER	EVERGY	EVERGY
CONNECTIONS	---	EVERGY
TRANSFORMER	EVERGY	EVERGY
TRANSFORMER PAD	EVERGY	CONTRACTOR
PRIMARY		
CONDUIT, CONNECTORS, ETC.	CONTRACTOR	CONTRACTOR
CONDUCTOR	EVERGY	EVERGY
CONNECTIONS	---	EVERGY

GRADING AND STORM SEWER CONSTRUCTION NOTES

1. ALL STORM SEWER PIPES AND INLETS SHALL MEET HEAVY DUTY TRAFFIC (HS20) LOADING AND BE INSTALLED ACCORDINGLY.
2. CONCRETE STORM SEWER INLETS & JUNCTION BOXES SHALL BE INSTALLED PER THE CITY OF LEE'S SUMMIT SPECIFICATIONS AND AS DETAILED IN THESE PLANS.
3. REINFORCED CONCRETE PIPE (RCP) SHALL BE INSTALLED PER THE "EMBEDMENT OF RCP STORM SEWER PIPE" DETAIL. PIPE CLASS SHALL BE APPROPRIATE TO DEPTH AND BEDDING MATERIAL AS SHOWN IN SCHEDULE.
4. ALL RCP PIPE JOINTS SHALL BE SOIL TIGHT PER CURRENT MODOT SPECIFICATIONS SECTION 726.3.1.
5. ALL HDPE PIPE SHALL BE ADS N-12 ST SOIL TIGHT, SMOOTH INTERIOR PIPE OR APPROVED EQUAL. INSTALLATION SHALL FOLLOW THE "EMBEDMENT OF PLASTIC STORM SEWER PIPE" DETAIL.
6. PVC PIPE MAY BE USED IN LIEU OF HDPE FOR DIAMETERS LESS THAN 15". PVC PIPE SHALL BE SDR 35 OR GREATER, AS REQUIRED BY DEPTH OR AS NOTED IN THESE PLANS.
7. INLINE DRAIN AND DRAIN BASINS SHALL BE NYLOPLAST, HARCO, OR APPROVED EQUAL AND SHALL BE PVC CONFORMING TO ASTM D1784 CELL CLASS 12454. JOINTS SHALL BE WATER TIGHT FLEXIBLE ELASTOMERIC SEALS CONFORMING TO ASTM D3212. INLINE DRAIN AND DRAIN BASIN GRATES AND FRAMES SHALL BE DUCTILE IRON CONFORMING TO ASTM A536 GRADE 70-50-05, OR 80-55-06.
8. CONTRACTOR SHALL ADJUST ALL GRATES, MANHOLES, VALVE BOXES, ETC. TO MATCH FINISH GRADES, AS REQUIRED.
9. ALL STRUCTURE CONNECTIONS SHALL BE WATERTIGHT.
10. ALL CONCRETE STORM STRUCTURES SHALL HAVE A SMOOTH UNIFORM POURED CONCRETE INVERT FROM INVERT IN TO INVERT OUT.
11. ALL STORM SEWER MANHOLES IN PAVED AREAS SHALL BE FLUSH WITH PAVEMENT, AND SHALL HAVE TRAFFIC BEARING RING & COVERS. MANHOLES IN UNPAVED AREAS SHALL BE FLUSH WITH FINISH GRADE. LIDS SHALL BE LABELED "STORM SEWER". TOP OF BOXES SHALL BE SLOPED TO MATCH PAVEMENT GRADE.
12. PIPE LENGTHS ARE GIVEN FROM CENTER OF STRUCTURE OR DOWNSTREAM END OF FLARED END SECTIONS.
13. ALL FLARED END SECTIONS FOR CONCRETE PIPE SHALL BE REINFORCED PRECAST CONCRETE. ALL FLARED END SECTIONS FOR PLASTIC PIPE SHALL BE GALVANIZED METAL UNLESS OTHERWISE NOTED.
14. ALL SITES USED FOR IMPORTING OR EXPORTING OF FILL MATERIAL SHALL HAVE AN ACTIVE MISSOURI DEPARTMENT OF NATURAL RESOURCES LAND DISTURBANCE PERMIT, AS REQUIRED.
15. CONTRACTOR SHALL REMOVE ALL TRASH AND DEBRIS, TREES AND BRUSH, AND OTHER MATERIAL CREATED AS A RESULT OF CONSTRUCTION. MATERIAL SHALL BE DISPOSED OF IN COMPLIANCE WITH ALL APPLICABLE LAWS AND REGULATIONS. BURNING ON SITE SHALL BE ALLOWED BY PERMIT ONLY.
16. CONTRACTOR SHALL REMOVE ALL STUMPS BY EXCAVATING TO INCLUDE REMOVAL OF ASSOCIATED ROOT SYSTEM.
17. CONTRACTOR SHALL NOT ADVANCE TRENCH EXCAVATION BEYOND AMOUNT THAT CAN ACCOMMODATE PIPE INSTALLATION AND BACKFILLING AT THE END OF EACH DAY.
18. ENGINEERED FILL SHOULD BE FREE OF FROZEN SOIL, ORGANICS, RUBBISH, LARGE ROCKS, WOOD, OR OTHER DELETERIOUS MATERIAL. COHESIVE FILLS SHOULD BE UNIFORMLY COMPACTED TO AT LEAST 95 PERCENT OF THE "STANDARD" MAXIMUM DRY DENSITY AND BE WITHIN -2 TO +4 PERCENT OF OPTIMUM MOISTURE CONTENT AS DESCRIBED BY ASTM D698. GRANULAR FILLS SHOULD BE UNIFORMLY COMPACTED TO AT LEAST 95 PERCENT OF THE "STANDARD" MAXIMUM DRY DENSITY. THE MOISTURE CONTENT SHOULD BE HIGH ENOUGH TO PROVIDE FOR PROPER COMPACTION BUT LOW ENOUGH TO PREVENT UNDUE PUMPING. PLACE FILL MATERIAL IN LOOSE LIFTS NOT TO EXCEED 8 INCHES IN THICKNESS.
19. ROCKS AND STONES THAT EXCEED THE THICKNESS OF THE LOOSE LIFT FILL LAYER SHOULD BE REMOVED AND DISPOSED OF OFF THE IMMEDIATE CONSTRUCTION AREA.
20. IMPORTED SOILS PROPOSED FOR USE AS FILL OR BACKFILL SHOULD BE REVIEWED AND ANALYZED BY THE GEOTECHNICAL ENGINEER PRIOR TO USE ON SITE. SOIL CLASSIFIED AS MH, OH, OL, OR PT (HIGH PLASTICITY SOILS AND ORGANIC SOILS) BY THE UNIFIED SOIL CLASSIFICATION SYSTEM (ASTM D2487) SHOULD NOT BE IMPORTED FOR USE AS ENGINEERED FILL. SUITABLE IMPORTED MATERIALS FOR GENERAL SITE FILL ARE THOSE THAT CLASSIFY AS GW, GM, GC, SC, AND CL IN ACCORDANCE WITH ASTM D 2487. MATERIALS CLASSIFIED AS CH SHOULD BE APPROVED BY THE GEOTECHNICAL ENGINEER PRIOR TO THEIR IMPORTATION AND ONLY USED OUTSIDE THE BUILDING PAD AT DEPTHS BELOW THE UPPER 2 FEET OF SUBGRADE. SUBJECT TO FINAL DESIGN REQUIREMENTS FOR WALL BACKFILL, SUITABLE IMPORTED MATERIALS FOR WALL AND TRENCH BACKFILL ARE THOSE THAT CLASSIFY AS GW, GP, GM, GC, SM, SW, SP, SC, AND CL IN ACCORDANCE WITH ASTM D2487.
21. FILLS PLACED IN AREAS WHERE THE NATURAL SLOPE IS GREATER THAN 5H:1V (HORIZONTAL TO VERTICAL) SHOULD BE BENCHED INTO THE EXISTING GRADE TO REDUCE THE POTENTIAL FOR SLIPPAGE BETWEEN EXISTING SLOPES AND ENGINEERED FILL. BENCHES SHOULD BE LEVEL AND WIDE ENOUGH TO ACCOMMODATE COMPACTION AND EARTH MOVING EQUIPMENT.
22. FILL AND SUBGRADE CONSTRUCTION SHOULD NOT BE STARTED ON FOUNDATION SOIL, PARTIALLY COMPLETED FILL, OR SUBGRADES THAT CONTAIN FROST OR ICE. FILL SHOULD NOT BE CONSTRUCTED USING FROZEN SOIL. FROZEN SOIL SHOULD BE REMOVED PRIOR TO PLACING FILL MATERIAL.
23. AFTER STRIPPING AND GRUBBING OPERATIONS ARE COMPLETED AND PRIOR TO FILL PLACEMENT, AREAS TO BE FILLED SHALL BE PROOF ROLLED USING A LOADED TANDEM AXLE DUMP TRUCK TO IDENTIFY SOFT AND UNSUITABLE AREAS. SOFT MATERIAL MAY BE MOISTURE CONDITIONED AND REUSED AS ENGINEERED FILL, UNSUITABLE AND DELETERIOUS MATERIAL SHALL BE REMOVED FROM SITE.
24. ALL NEW UTILITY TRENCHES SHOULD BE BACKFILLED IN ACCORDANCE WITH APPROPRIATE CONTROLLED ENGINEERED FILL SPECIFICATIONS.
25. FIELD DENSITY TESTS SHOULD BE CONDUCTED IN ACCORDANCE WITH ASTM D6938 (NUCLEAR METHODS) OR ASTM D 1556 (SAND CONE METHOD). FIELD DENSITY TESTS SHOULD BE PERFORMED AT THE RATE OF ONE TEST PER 2,500 SQUARE FEET PER LIFT WITHIN THE BUILDING AND 10,000 SQUARE FEET PER LIFT BENEATH PAVEMENTS, SIDEWALKS, AND OTHER POTENTIAL STRUCTURAL AREAS WITH A MINIMUM OF 3 TESTS PER LIFT AND ONE TEST PER 150 LINEAL FEET PER LIFT FOR FOUNDATION, TRENCH AND WALL BACKFILL.
26. BUILDING PAD AND PARKING AREAS SHALL BE PROOF-ROLLED WITH A FULLY LOADED TANDEM AXLE DUMP TRUCK TO IDENTIFY ANY SOFT OR UNSUITABLE AREAS, PRIOR TO BASE ROCK PLACEMENT. THE PROOF-ROLL SHALL BE OBSERVED BY THE PROJECT GEOTECHNICAL ENGINEER. AREAS IDENTIFIED AS UNSUITABLE SHALL BE OVER EXCAVATED AND RECONSTRUCTED WITH ENGINEERED FILL.
27. CONTRACTOR SHALL ASSURE POSITIVE DRAINAGE AWAY FROM ALL BUILDINGS FOR ALL LANDSCAPED AND PAVED AREAS.
28. CONTRACTOR SHALL PLACE STOCKPILED TOPSOIL FROM SITE IN ALL LANDSCAPE AREAS TO A MINIMUM DEPTH OF OF 6", UNLESS NOTED OTHERWISE IN PROJECT SPECIFICATIONS. ANY EXCESS TOPSOIL SHALL BE DISPOSED OF ONSITE PER OWNER.

PLAN REFERENCE NOTES (1)

1. THESE PLANS ARE PART OF A LARGE PLAN FOR THE DEVELOPMENT OF WILSHIRE HILLS. THE FULL SET OF PLANS INCLUDES THE FOLLOWING LIST, PREPARED BY AND DATED SPECIFICALLY FEBRUARY 16, 2024.
   a. ROAD & STORM SEWER PLAN
   b. UTILITY EXTENSION PLAN
   c. SANITARY SEWER EXTENSION PLAN
   d. MASS GRADING & EROSION CONTROL PLAN
2. IMPROVEMENTS FROM THE PUBLIC IMPRVOMENT PLAN (PDP) ARE SHOWN AS GREY SCALED ON THIS PLAN AND ARE ASSUMED TO BE THE EXISTING CONDITION FOR THESE PLANS.

SUBSTITUTION AND ALTERNATIVE MATERIALS NOTE

1. THE FOLLOWING MATERIALS WILL BE CONSIDERED ACCEPTABLE AS ALTERNATIVE/SUBSTITUTE MATERIAL.
   a. WATER MAIN, SERVICE FITTINGS, AND PIPES MAY BE SUBSTITUTED WITH EQUIVALENT ALTERNATIVE MATERIAL. ACCEPTABLE MATERIALS, SELECTED AS APPROPRIATE FOR PIPE SIZE, INCLUDE:
      i 280 PSI PRESSURE RATED, GASKETED BELL AND JOINT PVC
      ii DUCTILE IRON (BAGGED)
      iii SMALL DIAMETER TUBING: PEX-A, PEX-B, SDR9 PVC
   b. STORM: HDPE CAN BE SUBSTITUTED WITH RCP AND CMP (ALUMINIZED/SMOOTH WALL). CMP MUST BE INSTALLED UNDER MANUFACTURERS OBSERVATION. RCP MAY NOT BE SUBSTITUTED.

ALL SUBSTITUTIONS MUST BE NOTED IN THE BID PROVIDING A DEDUCTED ALTERNATIVE VALUE VERSUS THE AS DESIGNATED MATERIALS. ALL SUBSTITUTIONS MUST BE APPROVED BY THE ENGINEER AND OWNER PRIOR TO USE.

WATER NOTES

1. ALL WATER LINE CONSTRUCTION SHALL BE PER CURRENT CITY OF LEE'S SUMMIT WATER UTILITY STANDARDS AND SPECIFICATIONS UNLESS NOTED OTHERWISE.
2. SITE CONTRACTOR SHALL FURNISH AND INSTALL:
   a. ALL WATER MAINS AND FIRE HYDRANTS
   b. DOMESTIC LINES TO WITHIN 5' OF BUILDING
   c. METERS
   d. BACKFLOW PREVENTERS
   e. ALL VALVES
   f. FIRE RISER
3. BUILDING CONTRACTOR SHALL CONNECT TO DOMESTIC WITHIN 5' OF BUILDING.
4. SITE CONTRACTOR SHALL INSTALL FIRE RISERS IN BUILDINGS TURN AND CAP 18 INCHES ABOVE FINISH FLOOR (SEE MEP PLANS FOR EXACT LOCATION).
5. ALL VALVES, TEES, CROSSES, BENDS AND REDUCERS SHALL BE RESTRAINED.
6. WATER METER BOXES SHALL BE PLACED INTERNAL TO BUILDING.
7. ACTUAL DEPTH OF THE 30-INCH WATER MAIN ON THE WEST EDGE OF THE PROPERTY WILL BE FIELD VERIFIED BEFORE ANY GRADING WORK BEGINS.
8. ALL WATER MAINS SHALL BE DISINFECTED IN ACCORDANCE WITH AWWA STANDARD C651 LATEST EDITION.

FIRE NOTES (1)

1. ALL ISSUES PERTAINING TO LIFE SAFETY AND PROPERTY PROTECTION FROM THE HAZARDS OF FIRE, EXPLOSION OR DANGEROUS CONDITIONS IN NEW AND EXISTING BUILDINGS, STRUCTURES AND PREMISES, AND TO THE SAFETY TO FIRE FIGHTERS AND EMERGENCY RESPONDERS DURING EMERGENCY OPERATIONS, SHALL BE IN ACCORDANCE WITH THE 2018 INTERNATIONAL FIRE CODE.
2. AN APPROVED WATER SUPPLY CAPABLE OF SUPPLYING THE REQUIRED FIRE FLOW FOR FIRE PROTECTION SHALL BE PROVIDED TO PREMISES UPON WHICH FACILITIES, BUILDINGS OR PORTIONS OF BUILDINGS ARE HEREAFTER CONSTRUCTED OR MOVED INTO OR WITHIN THE JURISDICTION.
3. PRIOR TO ANY COMBUSTIBLE CONSTRUCTION, WILSHIRE DRIVE SHALL BE COMPLETED THROUGH STROTHER ROAD, ALL PUBLIC AND PRIVATE HYDRANTS SHALL BE IN PLACE AND OPERABLE, AND THE APARTMENT PARKING LOT'S ASPHALT BASE SHALL BE IN PLACE.
4. THE LOCATION OF FIRE DEPARTMENT CONNECTIONS SHALL BE APPROVED BY THE FIRE CODE OFFICIAL. CONNECTIONS SHALL BE A 4-INCH STORZ TYPE FITTING AND LOCATED WITHIN 100 FEET OF A FIRE HYDRANT, OR AS APPROVED BY THE CODE OFFICIAL.

STORM WATER POLLUTION PREVENTION PLAN NOTES

1. CONTRACTOR SHALL FOLLOW THE STORM WATER POLLUTION PREVENTION PLAN (SWPPP) AND ADHERE TO ALL TERMS & CONDITIONS AS OUTLINED IN THE GENERAL N.P.D.E.S. PERMIT FOR STORM WATER DISCHARGE ASSOCIATED WITH CONSTRUCTION ACTIVITIES. A COPY OF THIS PLAN, SWPPP, AND ALL PERMITS SHALL REMAIN ON SITE THROUGHOUT CONSTRUCTION.
2. CONTRACTORS ARE REQUIRED TO SUBMIT TO CITY INSPECTION STAFF COPIES OF THEIR INSPECTION REPORTS REQUIRED BY THE SWPPP ON A MONTHLY BASIS.
3. NO LAND CLEARING OR GRADING SHALL BEGIN UNTIL ALL EROSION CONTROL MEASURES HAVE BEEN INSTALLED AND APPROVAL HAS BEEN RECEIVED FROM ALL GOVERNING AUTHORITIES.
4. IMMEDIATELY UPON COMPLETION OF FINISH GRADING IN EACH AREA, ALL LANDSCAPING AREAS SHALL BE STABILIZED PER PLANS AND/OR SPECIFICATIONS.
5. SHOULD CONSTRUCTION STOP FOR LONGER THAN 14 DAYS, THE SITE SHALL BE SEEDED AS SPECIFIED IN THE SWPPP.
6. SITE INSPECTION SHOULD OCCUR ON A REGULAR SCHEDULE AND WITHIN 24 HOURS OF A STORM EVENT OF 0.25 INCHES OR GREATER. REGULARLY SCHEDULED INSPECTION SHALL BE A MINIMUM OF ONCE EVERY 7 CALENDAR DAYS. ANY DEFICIENCIES SHALL BE NOTED IN A WEEKLY REPORT OF THE INSPECTION AND CORRECTED WITHIN SEVEN CALENDAR DAYS OF THE REPORT.
7. THIS PLAN SHALL NOT BE CONSIDERED ALL INCLUSIVE AS THE CONTRACTOR SHALL TAKE ALL NECESSARY PRECAUTIONS TO PREVENT SOIL SEDIMENT FROM LEAVING THE SITE.
8. CONTRACTOR SHALL COMPLY WITH ALL STATE AND LOCAL ORDINANCES THAT APPLY.
9. ADDITIONAL EROSION AND SEDIMENT CONTROL MEASURES SHALL BE INSTALLED IF DEEMED NECESSARY BY ON SITE INSPECTION.
10. CONTRACTOR SHALL BE RESPONSIBLE TO TAKE WHATEVER MEANS NECESSARY TO ESTABLISH PERMANENT SOIL STABILIZATION.
11. ALL SLOPES GREATER THAN 3:1 SHALL BE REINFORCED BY NORTH AMERICAN GREEN P300 PERMANENT TURF REINFORCEMENT MAT OR APPROVED EQUAL.
12. ALL ROLLED EROSION CONTROL MATS, BIONETS, BLANKETS, ETC. SHALL BE INSTALLED PER MANUFACTURER'S REQUIREMENTS. INSTALLATION SHALL RESULT IN A PRODUCT THAT IS TIGHTLY SECURED TO THE GROUND THAT FORCES RUNOFF TO DRAIN OVER, NOT UNDER, THE PRODUCT. GRASS SHALL BE PLANTED PRIOR TO PRODUCT PLACEMENT SO IT WILL GROW THRU THE BLANKET. ALL ASPECTS OF THE PRODUCT SHALL BE FIRMLY SECURED TO THE GROUND SO IT CAN BE MOWED OVER WITHOUT GETTING TANGLED IN THE MOWER.
13. CONTRACTOR SHALL REMOVE ALL TRASH, DEBRIS, TREES & BRUSH AND OTHER MATERIAL CREATED AS A RESULT OF THE CONSTRUCTION WORK AND THE SITE SHALL BE RETURNED TO ITS ORIGINAL CONDITION.
14. ALL PERIMETER LANDSCAPED AREAS SHALL BE GRASS COVERED.
15. IN ORDER TO TERMINATE A MISSOURI DEPARTMENT OF NATURAL RESOURCES (MDNR) STATE OPERATING PERMIT, THE CONTRACTOR SHALL SUBMIT A REQUEST FOR TERMINATION OF OPERATING PERMIT FORM TO MDNR. A PERMIT IS ELIGIBLE FOR TERMINATION WHEN EITHER PERENNIAL VEGETATION, PAVEMENT, BUILDINGS, OR STRUCTURES USING PERMANENT MATERIALS COVER ALL AREAS THAT HAVE BEEN DISTURBED. VEGETATIVE COVER SHOULD BE AT LEAST 70% OF FULLY ESTABLISHED PLANT DENSITY OVER 100% OF THE DISTURBED AREA. A COPY OF THE REQUEST FOR TERMINATION OF OPERATING PERMIT FORM SHALL BE SUBMITTED TO THE CITY OF COLUMBIA AT WHICH TIME THE CITY WILL REMOVE THE PROJECT FROM ITS INSPECTION SCHEDULE.
16. THE SITE CONTRACTOR SHALL INCLUDE MAINTENANCE OF ALL BMP'S AS PART OF THEIR CONTRACT AND SHALL BE RESPONSIBLE FOR THE PROJECT UNTIL THE NPDES PERMIT IS TERMINATED.
17. SOIL STOCKPILES SHALL COMPLY WITH THE CITY OF LEE'S SUMMIT.

GENERAL CONSTRUCTION NOTES

1. PARKING SUMMARY
   a. REQUIRED PARKING
   b. PROVIDED PARKING
      i. 48 STANDARD SPACES
      ii. 11 ACCESSIBLE SPACES
      iii. 59 TOTAL SPACES
2. SITE PAVEMENT SHALL BE PLACE AS FOLLOWS:
   a. CONCRETE PAVING
      i. STANDARD DUTY SHALL BE A MINIMUM OF 6-INCHES THICK REINFORCED CONCRETE WITH A MINIMUM 4" OF CRUSHED STONE BASE (SEE DETAIL SHEET C10.01).
      ii. HEAVY DUTY SHALL BE A MINIMUM 8-INCHES THICK REINFORCED CONCRETE WITH A MINIMUM 6-INCHES OF CRUSHED STONE BASE (SEE DETAIL SHEET C10.01).
   b. CONCRETE CURB (SEE DETAIL ON SHEET C10.01)
      i. ALL CURB SHALL BE 24-INCHES WIDE FROM BACK OF CURB TO EDGE OF GUTTER PAN.
      ii. CURB SHALL HAVE A MINIMUM 4-INCH OF CRUSHED STONE BASE.
      iii. ALL ACCESSIBLE CONCRETE PAVING SHALL BE DOWELED TO CURB.
   c. SIDEWALKS (SEE DETAIL ON SHEET C10.01-C10.03)
      i. TO BE FOUR INCH (4") THICK CONCRETE.
      ii. ALL SIDEWALK AT BACK OF CURB SHALL BE DOWELED TO CURB (SEE DETAIL ON SHEET C10.01).
      iii. SIDEWALKS SHALL NOT BE POURED UNTIL BUILDING EXTERIOR FINISHES ARE SUBSTANTIALLY COMPLETE. ANY PLACEMENT OF SIDEWALK PRIOR, WITHOUT OWNER'S APPROVAL, SHALL BE AT THE PAVING CONTRACTOR'S SOLE RISK.
   d. CONCRETE JOINTS
      i. CONCRETE PARKING LOT PAVING AND SIDEWALK SHALL BE PROVIDED JOINTS FOR PER THE JOINT PLAN AND PER DETAIL ON SHEET C10.01.
      ii. EXPANSION JOINTS SHOULD BE PLACED EVERY 100 LINEAL FEET FOR PARKING LOT PAVEMENT AND EVERY 50 LINEAL FEET FOR SIDEWALK, MINIMUM
      iii. PAVING JOINTS SHALL BE CONTINUOUS THRU CURB AND GUTTER.
      iv. PAVING JOINTS FOR SIDEWALK AT BACK OF CURB SHALL ALIGN WITH CURB AND GUTTER JOINTS.
   e. STANDARD DUTY CONCRETE PAVEMENT SHALL BE USED BELOW THE PORTE COCHERE.
   f. ALL DUMPSTER PADS AND APPROACHES SHALL BE HEAVY DUTY CONCRETE PAVEMENT.
3. SITE ACCESSIBILITY
   a. ALL ACCESSIBLE PARKING STALLS, CROSSWALKS, AND OTHER ACCESSIBLE ROUTES WITHIN THE PARKING AREA SHALL BE STANDARD DUTY CONCRETE, UNLESS NOTED OTHERWISE
   b. ACCESSIBLE CONCRETE PARKING SHALL HAVE A MAXIMUM SLOPE OF 1.7% IN ALL DIRECTIONS.
   c. ALL SIDEWALKS SHALL BE CONSTRUCTED AS FOLLOWS:
      i. 1.7% MAXIMUM CROSS SLOPE.
      ii. 4.7% MAXIMUM RUNNING SLOPE.
      iii. LANDINGS AT 1.7% MAX SLOPE IN ALL DIRECTIONS.
   d. RAMPS SHALL BE CONSTRUCTED AS FOLLOWS:
      i. 7.5% MAXIMUM RUNNING SLOPE
      ii. MAXIMUM RISE 6-INCHES
      iii. MAXIMUM CROSS SLOPE OF 1.7%
   e. LANDINGS SHALL BE PROVIDED AS THE INTERSECTION OF ALL SIDEWALKS AND AT THE TOP AND BOTTOM OF ALL RAMPS.
   f. ALL SIDEWALKS SHALL BE CONSIDERED ACCESSIBLE, UNLESS NOTED OTHERWISE.
   g. ALL SITE AMENITIES SHALL BE ACCESSIBLE.
   h. ALL DUMPSTERS SHALL BE ACCESSIBLE.
   i. NO ELEMENTS SHALL PROJECT MORE THAN 4" INTO AN ACCESSIBLE ROUTE.
4. FENCING
   a. ALL FENCING ABOVE RETAINING WALL SHALL BE 4' BLACK VINYL COATED CHAINLINK FENCE.
5. DUMPSTER ENCLOSURE
   a. ALL ENCLOSURES SHALL BE BLOCK WITH BRICK VENEER.
   b. ALL GATES SHALL BE STEEL FRAME AND VINYL SLATS.
   c. SEE ARCHITECTURAL PLANS FOR DETAILS.
6. MONUMENT SIGN
   a. SHALL BE BLOCK AND BRICK VENEER CONSTRUCTION.
   b. SIGN SHALL HAVE A 4' BY 8' SIGN FACE WITH 2' X 2' COLUMNS EACH END.
   c. ALL LIGHTING SHALL BE GROUND MOUNTED.
   d. A MINIMUM 2" PVC CONDUIT SHALL BE EXTENDED FROM THE HOUSE PANEL TO THE MONUMENT SIGN FOR POWER.
7. MAINTENANCE BUILDING
   a. PROVIDE A MINIMUM 2" PVC CONDUIT FROM THE HOUSE PANEL FOR ELECTRICAL SERVICE.
   b. MAINTENANCE BUILDING SHALL BE BRICK WAINSCOT AND SIDING.
   c. SEE ARCHITECTURAL PLANS.
8. FLAG POLE
   a. SEE ARCHITECTURAL PLANS FOR LOCATION AND DETAIL OF FLAG POLE
   b. FLAG POLE SHALL BE PROVIDED WITH AN ACCESSIBLE PATH.
   c. ALL LIGHTING SHALL BE GROUND MOUNTED, SEE MEP PLANS FOR LIGHTING DESIGN.
   d. A MINIMUM 2" PVC CONDUIT SHALL BE EXTENDED FROM THE HOUSE PANEL TO THE FLAG POLE FOR POWER.
9. SANITARY SEWER SERVICES SHALL BE TIED NEAR THE MIDDLE OF SLAB TO REDUCE DEPTH BELOW SLAB WHEN BUILDING IS OVER 150FT LONG. SEWER INVERT TO BE MINIMUM 5' BELOW FFE IN ORDER TO COME OUT BELOW THE FOOTING.
10. SITE CONTRACTOR SHALL BE RESPONSIBLE FOR
    a. COORDINATION OF THE INSTALLATION OF THE WATER METER WITH THE UTILITY.
    b. COORDINATION OF WITH UTILITY PROVIDER FOR THE WATER MAIN TAP
    c. THE STANDARD SERVICE CONNECTION OR NEW MANHOLE LOCATION
    d. INSTALLATION OF THE FIRE RISER FOR WATER SERVICE INTO THE BUILDING, STUBBED 18" ABOVE FINISH FLOOR.
11. SITE CONTRACTOR SHALL BE RESPONSIBLE FOR
    a. INSTALLATION THE CONNECTION OF THE SITE SEWER SERVICE TO THE MAIN INCLUDING ALL MATERIALS AND LABOR. THE CONTRACTOR SHALL PROVIDE TWENTY-FOUR (24) HOURS' NOTICE TO THE DEPARTMENT FOR CONNECTION. NONE OF THE BUILDING SEWER OR PLUMBING OR SANITARY DRAINAGE SYSTEM SHALL BE COVERED OR ENCLOSED UNTIL INSPECTED, HYDRAULICALLY TESTED, AND APPROVED BY THE DEPARTMENT
12. THE SITE CONTACTOR SHALL PERFORM A SITE SURVEY AFTER CLEARING & GRUBBING IN ORDER TO CONFIRM TOPO ON PLANS IS ACCURATE PRIOR TO MASS GRADING.
13. ALL 3-STORY OR TALLER BUILDINGS SHALL HAVE A LIGHTNING ROD (SEE ARCHITECTURAL).
14. LANDSCAPING
    a. PLANTS SHALL BE PROPERLY SELECTED TO FOR SITE CONDITION CONDITIONS SUCH AS:
       i. SHADE, PARTIAL SHADE, FULL SUN
       ii. WELL DRAINED OR POORLY DRAINED SOILS.
       iii. SUITABLE FOR USDA PLANT HARDINESS ZONE.
    b. SHADE TREES SHALL BE MINIMUM 2" CALIPER, UNLESS NOTED OTHERWISE.
    c. EVERGREEN TREES SHALL BE AT LEAST 6-FOOT TALL.
    d. SHRUBS SHALL BE 3-5 GALLON.
    e. SOD SHALL BE PLACE ON ALL DISTURBED AREAS AND AT A MINIMUM:
       i. BETWEEN THE BUILDING/PARKING LOT AND DISTURBED SITE FRONTAGE.
       ii. BETWEEN THE PARKING LOT AND BUILDING(S).
       iii. BETWEEN PARKING LOT AND SIDEWALKS.
       iv. A MINIMUM 15-FEET BEYOND EDGE OF SIDEWALK, PARKING LOT, AND SITE AMENITIES.
    f. ALL AREAS NOT SODDED SHALL BE HYDROSEEDED.
    g. TURF REINFORCEMENT MATS AND EROSION CONTROL BLANKETS SHALL BE PLACED AS NOTED ON PLAN.
15. IRRIGATION SYSTEM NOTES
    a. ALL SODDED AREA SHALL BE IRRIGATED.
    b. ALL HYDROSEEDED LAWN AREAS SHALL BE IRRIGATED.
    c. IRRIGATION METER AND BACKFLOW PREVENT SHALL BE PLACED PER PLAN.
    d. IRRIGATION METER SHALL BE INSTALLED PER LOCAL JURISDICTION.
    e. IRRIGATION CONTROLLER SHALL BE PLACED PER PLAN.
    f. IRRIGATION BACKFLOW PREVENTOR SHALL BE PLACED ABOVE GROUND WITHIN A LOCKABLE HOUSING CONSTRUCTED OR POWDER COATED STEEL FRAME AND MESH. BACKFLOW PREVENTOR SHALL BE PROPERLY PROTECTED FROM FROST.
    g. IRRIGATION SHALL BE ZONED. ALL PLANTING BEDS AND TURF SHALL BE SEPARATELY ZONED.
    h. CONSTRUCTOR SHALL SUBMIT IRRIGATION PLANS TO THE OWNER A MINIMUM OF 30 DAYS PRIOR TO PROPOSED INSTALLATION FOR APPROVAL. SHOW NOTE THAT IRRIGATION DESIGN DRAWINGS ARE TO BE SUBMITTED FOR APPROVAL.
16. THE MISSOURI DEPARTMENT OF NATURAL RESOURCES DATABASE OF WELLS (WISDIM) DOES NOT PROVIDE EVIDENCE FOR ANY ACTIVE, INACTIVE, OR ABANDONED OAL AND/OR GAS WELLS ON THE PROPERTY.

UTILITY CONSTRUCTION NOTES

1. LOCATION OF SITE UTILITIES SHALL BE VERIFIED BY CONTRACTOR AND THE PROPER UTILITY COMPANY PROVIDING SERVICE PRIOR TO THE START OF CONSTRUCTION.
2. EXISTING UTILITIES SHALL BE VERIFIED IN FIELD PRIOR TO INSTALLATION OF ANY NEW LINES.
3. UTILITY TIE-INS ARE SHOWN IN APPROXIMATE LOCATIONS. REFER TO MEP PLANS FOR EXACT TIE-IN OF ALL UTILITIES.
4. SITE CONTRACTOR SHALL COORDINATE WITH ALL UTILITY COMPANIES FOR INSTALLATION REQUIREMENTS AND SPECIFICATIONS. CONTRACTOR IS RESPONSIBLE FOR COMPLYING WITH THE SPECIFICATIONS OF LEE'S SUMMIT WATER DEPARTMENT AND CITY OF LEE'S SUMMIT PUBLIC WORKS WITH REGARDS TO MATERIALS AND INSTALLATION OF THE WATER AND SEWER LINES, RESPECTIVELY.
5. OWNER OR OWNER'S AGENT WILL BE RESPONSIBLE FOR ALL TAP AND TIE ON FEES REQUIRED. SITE CONRACTOR IS RESPONSIBLE FOR COST OF UNDERGROUND SERVICE CONNECTIONS TO THE BUILDING.
6. ALL WATER AND SANITARY LEADS TO BUILDING SHALL END 5' OUTSIDE THE BUILDING LIMITS AS SHOWN ON PLAN AND SHALL BE PROVIDED WITH A TEMPORARY PLUG AT END, VISIBLE ABOVE FINISHED GRADE.
7. ALL TRENCHING, PIPE LAYING, AND BACKFILLING SHALL BE IN ACCORDANCE WITH FEDERAL OSHA REGULATIONS, BACKFILL OF TRENCHES THROUGH ANY IMPROVED AREAS, SUCH AS STREET, DRIVES OR PARKING LOTS SHALL BE COMPACTED TO MINIMUM 95% STANDARD PROCTOR DENSITY (ASTM D-698).
8. PROPOSED ELECTRIC, TELEPHONE, TELEVISION, AND GAS LINES ARE SHOWN FOR COORDINATION PURPOSES ONLY. SYSTEM DESIGN PREPARED BY EACH RESPECTIVE AGENCY. REFER TO MEP PLANS FOR CONDUIT REQUIREMENTS.
9. ALL UNDERGROUND UTILITY CONDUITS SHALL BE PLACED 48" BELOW FINISH GRADE UNLESS NOTED OTHERWISE.
10. WATER MAINS SHALL BE LAID AT LEAST 10 FEET HORIZONTALLY, MEASURED EDGE TO EDGE, FROM ANY EXISTING OR PROPOSED SANITARY SEWER. WATER MAINS CROSSING SANITARY SEWERS SHALL BE LAID TO PROVIDE A MINIMUM VERTICAL CLEAR DISTANCE OF 18 INCHES BETWEEN THE OUTSIDE OF THE WATER MAIN AND THE OUTSIDE OF THE SANITARY SEWER. CENTER A FULL LENGTH OF WATER MAIN OVER OR UNDER THE SEWER SO BOTH WATER MAIN JOINTS ARE AS FAR FROM THE SEWER AS POSSIBLE. AT SANITARY SEWER CROSSINGS, PLACE COMPACTED CLAY SOIL BACKFILL 18 INCHES ABOVE OR BELOW THE WATER MAIN FOR A DISTANCE OF AT LEAST 10 FEET ON EITHER SIDE OF THE SANITARY SEWER. CONTRACTOR SHALL NOTIFY ENGINEER IF HORIZONTAL AND VERTICAL SEPARATION CANNOT BE PROVIDED.
11. ALL UNDERGROUND LINES SHALL BE INSTALLED, INSPECTED AND APPROVED BEFORE BACKFILLING.
12. TOPS OF EXISTING ELECTRIC, SANITARY, STORM, WATER, TELECOMMUNICATION, GAS, IRRIGATION, CHILLED WATER, AND STEAM STRUCTURES SHALL BE RAISED AS NECESSARY TO BE FLUSH WITH PROPOSED FINISHED ELEVATIONS.
13. ALL CONCRETE FOR ENCASEMENTS SHALL HAVE A MINIMUM 28 DAY COMPRESSION STRENGTH OF 3000 P.S.I.
14. ALL NECESSARY INSPECTIONS AND/OR CERTIFICATIONS REQUIRED BY CODE AND/OR UTILITY SERVICE COMPANIES SHALL BE PERFORMED PRIOR TO ANNOUNCED BUILDING POSSESSION AND THE FINAL CONNECTION OF SERVICE.
15. REFER TO ARCHITECTURAL <MEP> PLANS FOR SITE LIGHTING PLAN.
16. PVC CONDUIT SHALL BE SCHEDULE 40 PVC WITH LONG SWEEPS ONLY (36" MINIMUM RADIUS) AND CONTAIN PULLTAPE, UNLESS OTHERWISE NOTED.
17. SITE CONTRACTOR SHALL PROVIDE AND INSTALL THE CONCRETE PAD FOR THE TRANSFORMER PER THE ELECTRIC COMPANY SPECIFICATIONS.
18. SITE CONTRACTOR SHALL CONTACT EVERGY TO COORDINATE INSTALLATION OF NEW TRANSFORMERS.
19. A MINIMUM 18" OF VERTICAL SEPARATION SHALL BE MAINTAINED BETWEEN THE OUTSIDE OF THE ELECTRIC CONDUIT AND THE OUTSIDE OF THE WATER, STORM SEWER, SANITARY SEWER, OR GAS PIPE AT ALL CROSSINGS.
20. STUBS FOR FUTURE UTILITIES SHOULD BE CLEARLY MARKED AND ES&S CONTACTED FOR DATA COLLECTION.

Engineering Surveys & Services
DELIVERING YOUR VISION ™
1113 Fay Street, Columbia, MO 65201
573 - 449 - 2646
802 El Dorado Drive, Jefferson City, MO 65101
573-636-3303
1775 West Main Street, Sedalia, MO 65301
660-826-8618
www.ess-inc.com
MO Engineering Corp. # 2004005018

WILSHIRE HILLS PHASE III
3200 NE WILSHIRE DR
LEE'S SUMMIT, JACKSON COUNTY, MISSOURI

2/22/2024
STATE OF MISSOURI
MATTHEW AARON KRIETE
NUMBER PE-2007002811
PROFESSIONAL ENGINEER

MATTHEW A. KRIETE
PROFESSIONAL ENGINEER
PE-2007002811

IF ORIGINAL SIGNATURE OR DIGITAL AUTHENTICATION IS NOT PRESENT THIS MEDIA SHOULD NOT BE CONSIDERED A CERTIFIED DOCUMENT.

Date
JUNE 30, 2023

Revised
(1) FEBRUARY 22, 2024

CONSTRUCTION DOCUMENTS

Design: ST Drawn: MJS

GENERAL NOTES

Sheet
C0.02

ES&S PROJECT NO. 15925

P:\GENERAL PROJECTS\15925E-JES-WILSHIRE-HILLS-3-ENG\CAD\15925 COVER & DETAILS.DWG 2/23/2024

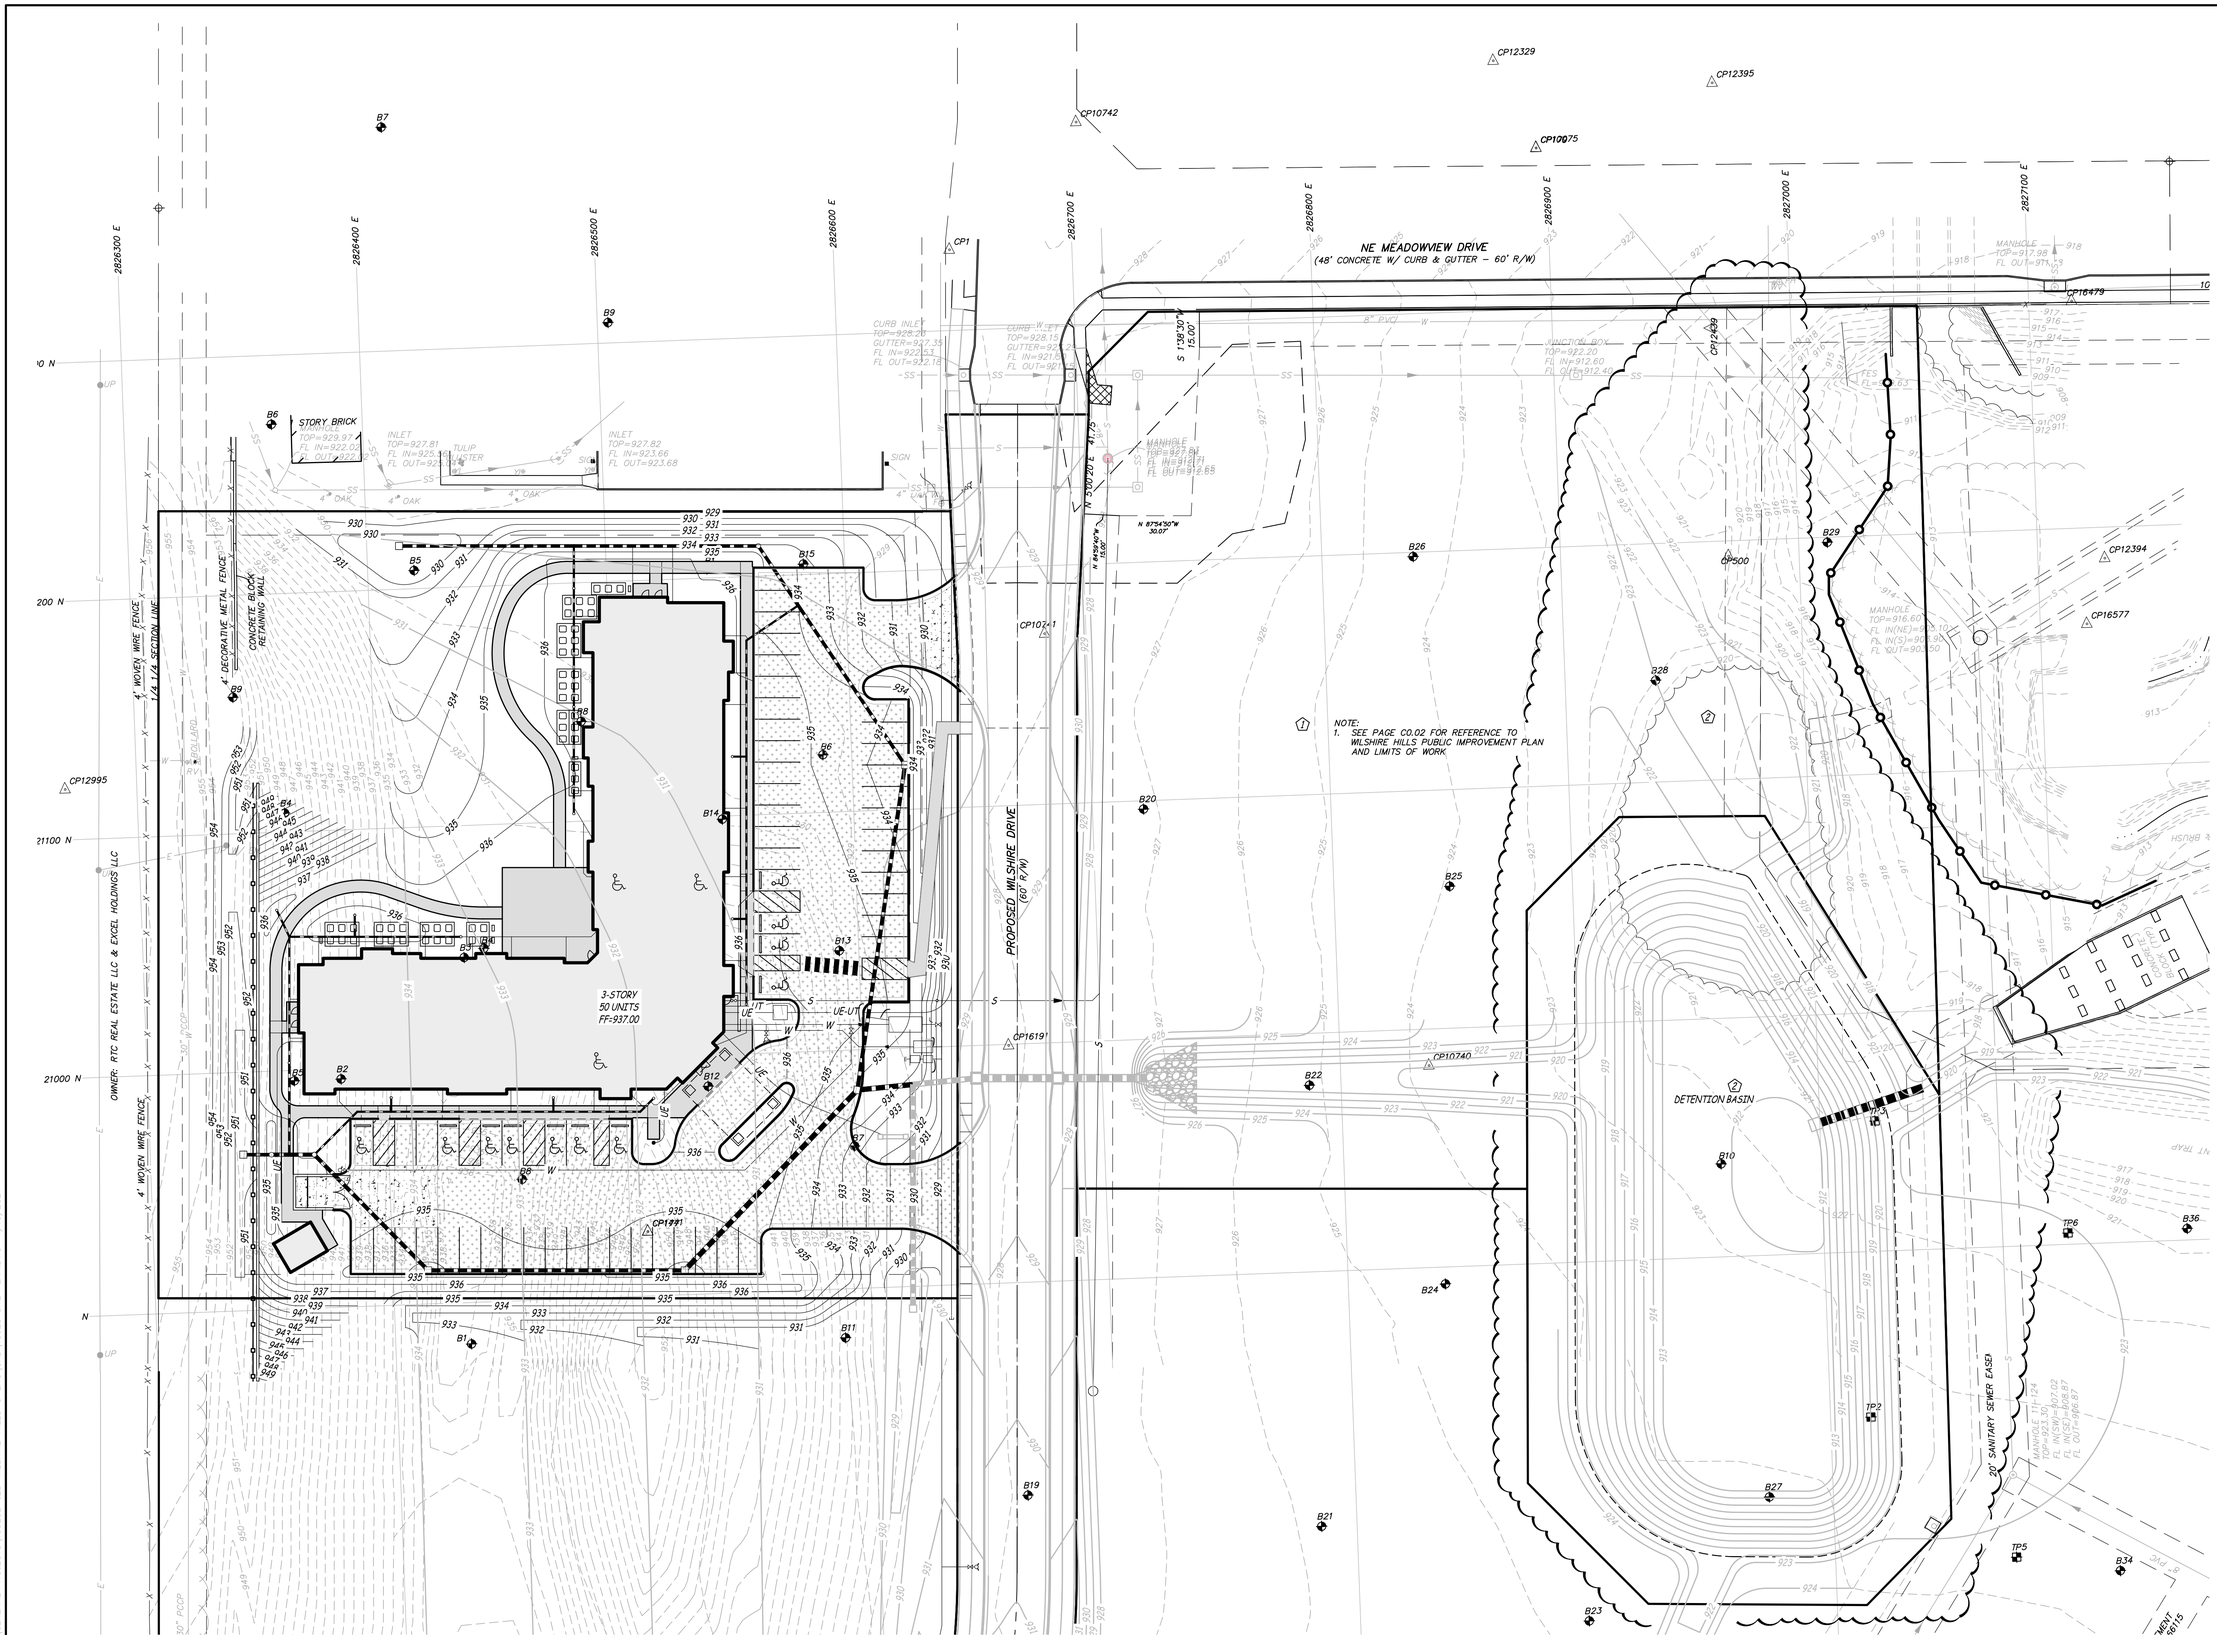

Engineering Surveys & Services
DELIVERING YOUR VISION ™

1113 Fay Street, Columbia, MO 65201
573 - 449 - 2646
802 El Dorado Drive, Jefferson City, MO 65101
573-636-3303
1775 West Main Street, Sedalia, MO 65301
660-826-8818
www.ess-inc.com
MO Engineering Corp. # 2004005018

N

0 1"
SCALE: 1" = 30'

WILSHIRE HILLS PHASE III

3200 NE WILSHIRE DR
LEE'S SUMMIT, JACKSON COUNTY, MISSOURI

4/17/2024
STATE OF MISSOURI
MATTHEW AARON KRIETE
NUMBER PE-2007002811
PROFESSIONAL ENGINEER

MATTHEW A. KRIETE
PROFESSIONAL ENGINEER
PE-2007002811

IF ORIGINAL SIGNATURE OR DIGITAL AUTHENTICATION IS NOT PRESENT THIS MEDIA SHOULD NOT BE CONSIDERED A CERTIFIED DOCUMENT.

Date
JUNE 30, 2023

Revised
1 FEBRUARY 22, 2024
2 APRIL 17, 2024

Design: ST Drawn: MJS

OVERALL PLAN

Sheet
C1.01

ES&S PROJECT NO. 15925

CONSTRUCTION DOCUMENTS

P:\GENERAL PROJECTS\15925E - JES - WILSHIRE HILLS - 3-ENG\CAD\15925 SITE PLAN.DWG 4/19/2024

OWNER: WILSHIRE PROPERTIES LLC

LOT 4A WILSHIRE HILLS – 3RD PLAT RECORDED IN DOC. NO. 2016E022915 IN BOOK 161 PAGE 43–46

OWNER: RTC REAL ESTATE LLC & EXCEL HOLDINGS LLC

5

110,478 SQ. FT.
OR 2.54 ACRES

3200 WILSHIRE DRIVE

2.50 ACRES

3-STORY
50 UNITS
FF=937.00

PATIO

MAINT. SHED
FF=935.50

DUMPSTER ENCLOSURE

FLAG POLE 5'R 10'R

PORTICO

MONUMENT SIGN

1 STORY BRICK

TULIP CLUSTER

SIGN

CONCRETE W/ CURB & GUTTER

CONCRETE SIDEWALK

4" OAK

GRAVEL

UTILITY EASEMENT (DTP)

PROPOSED 15' UTILITY EASEMENT

4' WOVEN WIRE FENCE

4' DECORATIVE METAL FENCE

CONCRETE BLOCK RETAINING WALL

SEGMENTAL BLOCK RETAINING WALL W/ 4' BLACK VINYL COATED CHAIN LINK FENCE

BOLLARD

CP12995

CP10741

CP16191

CP19971

B1 B2 B3 B4 B5 B6 B8 B9 B11 B12 B13 B14 B15 B20

1ST, 2ND, 3RD

1ST, 2ND

ACCESSIBLE PARKING SIGN (TYP)

ACCESSIBLE VAN PARKING SIGN

STANDARD DUTY CONCRETE

HEAVY DUTY CONCRETE

CCAG

5' CSW

5.5' CSW @ BOC

CURB TAPER

EXISTING 5' CONCRETE SIDEWALK

7.5' UTILITY EASEMENT PER PLAT RECORDED IN BOOK____ PAGE____

10' BUILDING LINE (DTP)

10' BUILDING LINE PER PLAT RECORDED IN BOOK____ PAGE____

20' BUILDING LINE PER PLAT RECORDED IN BOOK____ PAGE____

15' UTILITY EASEMENT PER PLAT RECORDED IN BOOK____ PAGE____

20' WATERLINE EASEMENT IN DOCUMENT NO. 1981I0450725 RECORDED IN BOOK I 1066 PAGE 1736

10' UTILITY EASEMENT PER PLAT RECORDED IN BOOK____ PAGE____

1/4 1/4 SECTION LINE

PROPOSED WILSHIRE DRIVE (60' R/W)

(SEE WILSHIRE HILL III PUBLIC IMPROVEMENT PLAN)

WILSHIRE DRIVE (R/W VARIES)

N 0°46'40"W 40.65'

S 87°54'40"E 332.03'

S 87°54'40"E 60.00'

S 88°21'30"E 322.38'

N 87°54'50"W 30.07'

N 87°54'40"W 335.00'

N 2°05'20"E 330.00'

S 2°06'50"W 268.29'

S 2°06'49"W 487.02'

S 2°06'50"W 228.97'

S 2°06'50"W 162.44'

N 5°00'20"E 41.75'

S 5°00'20"W 95.75'

N 84°59'40"W 15.00'

S 1°38'30"W 15.00'

S 45°12'20"W 70.75'

N 46°51'50"E 35.22'

N 2°05'20"E 148.62'

15' UTILITY EASEMENT

NOTE:
1. SEE PAGE C0.02 FOR REFERENCE TO WILSHIRE HILLS PUBLIC IMPROVEMENT PLAN AND LIMITS OF WORK

Engineering Surveys & Services
DELIVERING YOUR VISION ™

1113 Fay Street, Columbia, MO 65201
573 - 449 - 2646

802 El Dorado Drive, Jefferson City, MO 65101
573-636-3303

1775 West Main Street, Sedalia, MO 65301
660-826-8818

www.ess-inc.com

MO Engineering Corp. # 2004005018

N

0 1"
SCALE: 1" = 20'

WILSHIRE HILLS PHASE III

3200 NE WILSHIRE DR
LEE'S SUMMIT, JACKSON COUNTY, MISSOURI

CONSTRUCTION DOCUMENTS

2/22/2024

STATE OF MISSOURI
MATTHEW AARON KRIETE
NUMBER PE-2007002811
PROFESSIONAL ENGINEER

MATTHEW A. KRIETE
PROFESSIONAL ENGINEER
PE-2007002811

IF ORIGINAL SIGNATURE OR DIGITAL AUTHENTICATION IS NOT PRESENT THIS MEDIA SHOULD NOT BE CONSIDERED A CERTIFIED DOCUMENT.

Date
JUNE 30, 2023

Revised
1 FEBRUARY 22, 2024

Design: ST Drawn: MJS

SITE PLAN

Sheet
C2.01

ES&S PROJECT NO. 15925

P:\GENERAL PROJECTS\15925E--JES-WILSHIRE-HILLS--3-ENG\CAD\15925 SITE PLAN.DWG 2/26/2024

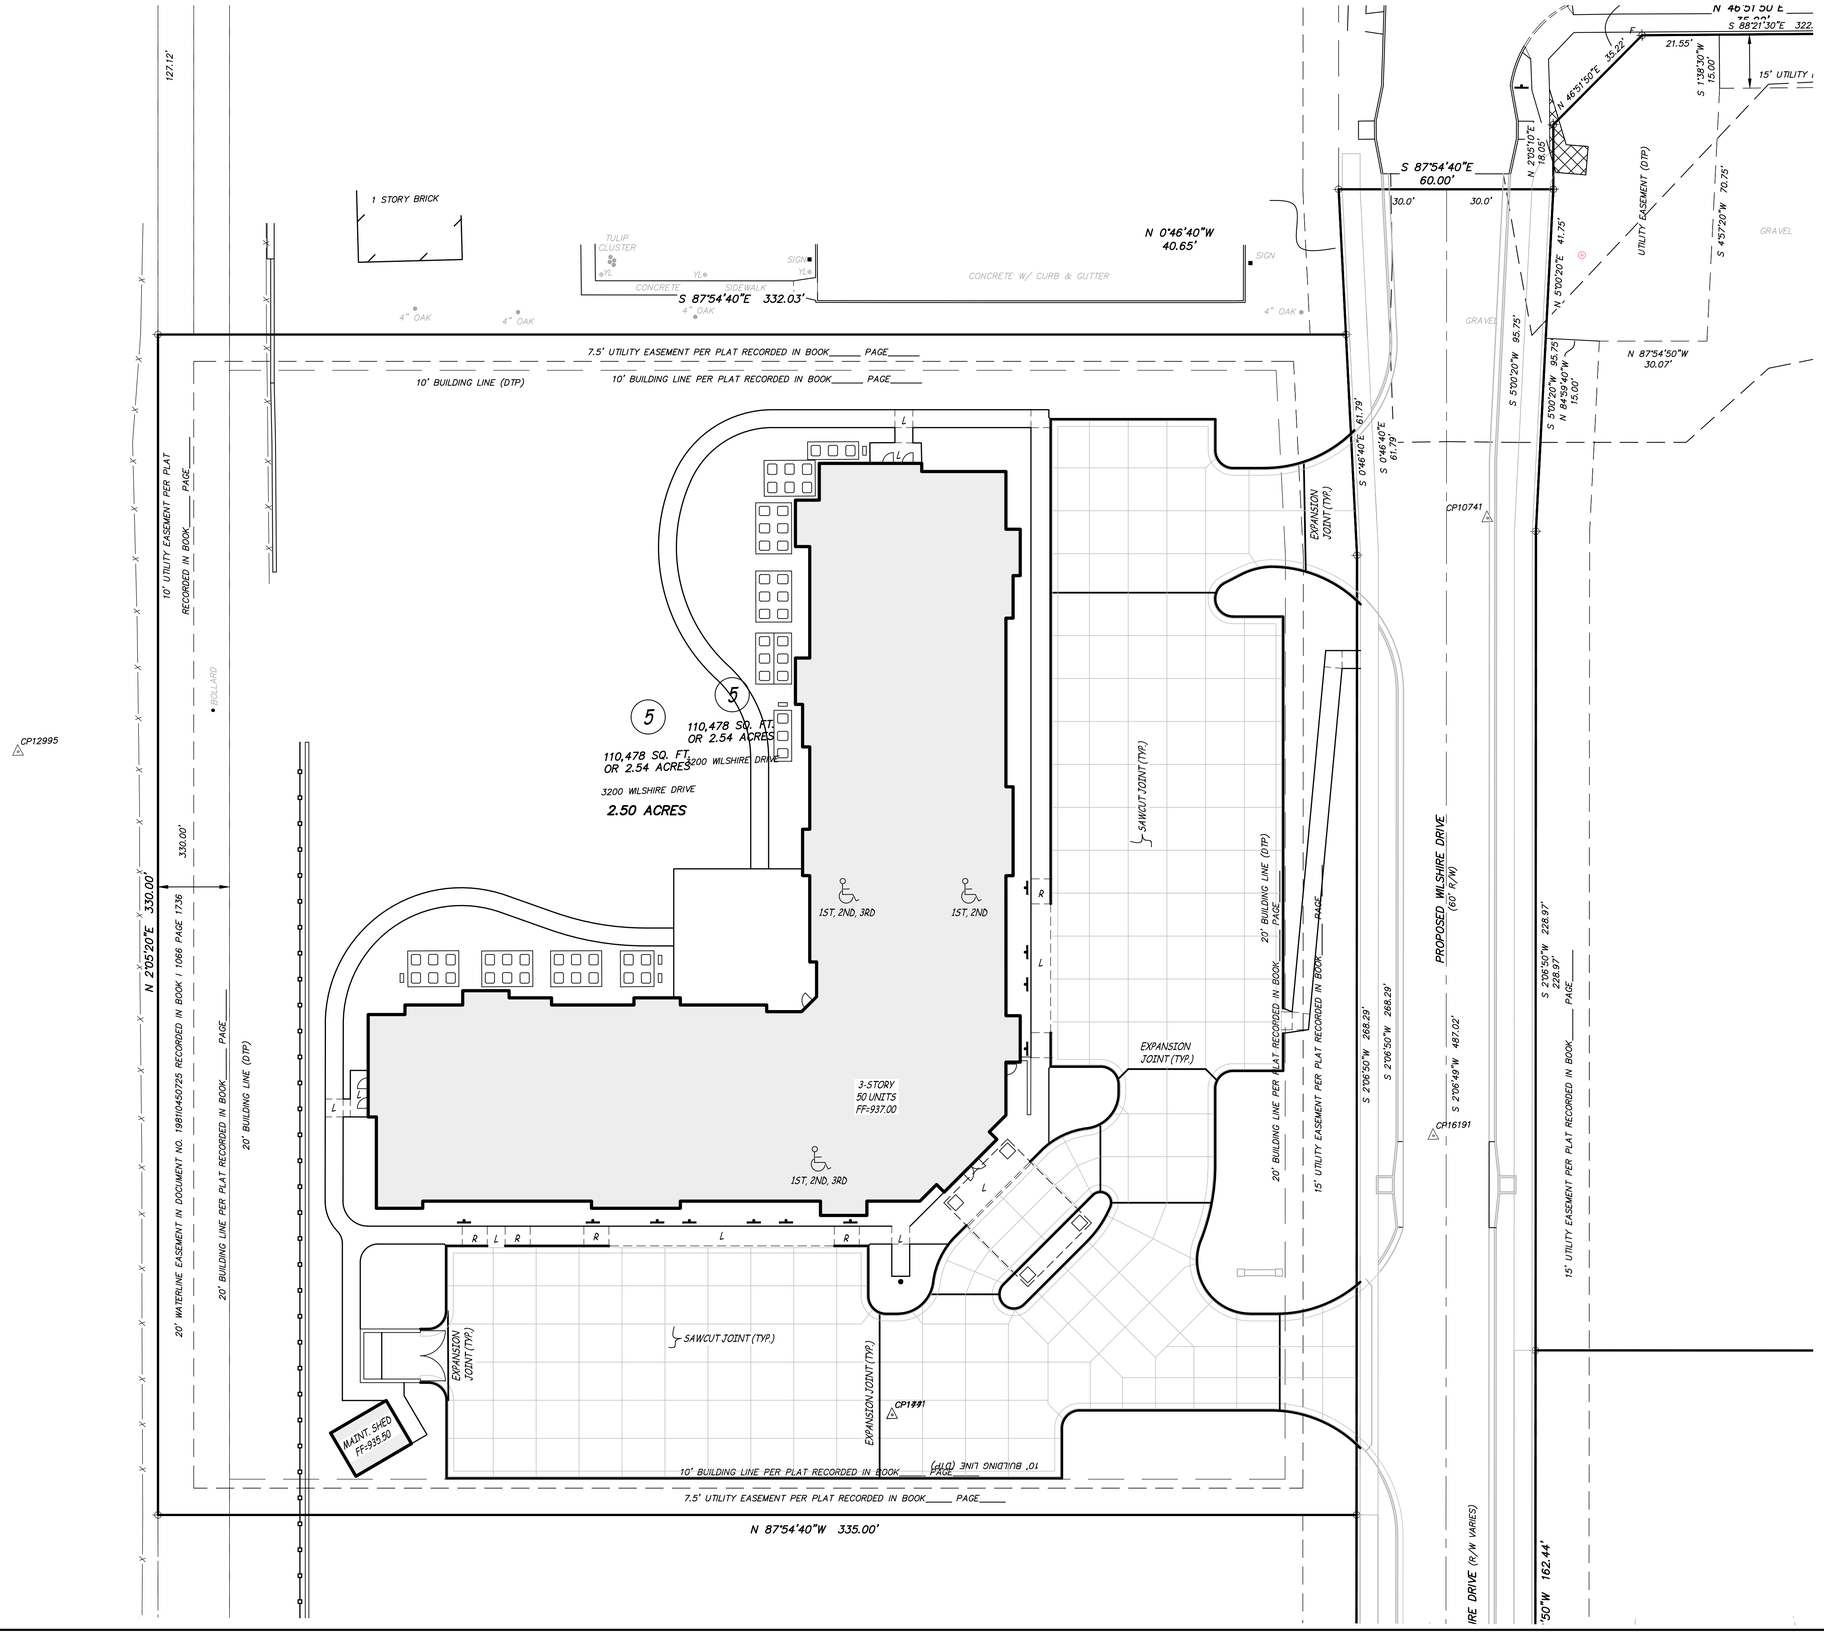

1 NOTE:
1. SEE PAGE C0.02 FOR REFERENCE TO WILSHIRE HILLS PUBLIC IMPROVEMENT PLAN AND LIMITS OF WORK

P:\GENERAL PROJECTS\15925E—JES—WILSHIRE—HILLS—3—ENG\CAD\15925 SITE PLAN.DWG 2/26/2024

Engineering Surveys & Services
DELIVERING YOUR VISION ™
1113 Fay Street, Columbia, MO 65201
573 - 449 - 2646
802 El Dorado Drive, Jefferson City, MO 65101
573-636-3303
1775 West Main Street, Sedalia, MO 65301
660-826-8818
www.ess-inc.com
MO Engineering Corp. # 2004005018

N

0 1"
SCALE: 1" = 20'

WILSHIRE HILLS PHASE III

3200 NE WILSHIRE DR
LEE'S SUMMIT, JACKSON COUNTY, MISSOURI

2/22/2024

STATE OF MISSOURI
MATTHEW AARON KRIETE
NUMBER PE-2007002811
PROFESSIONAL ENGINEER

MATTHEW A. KRIETE
PROFESSIONAL ENGINEER
PE-2007002811

IF ORIGINAL SIGNATURE OR DIGITAL AUTHENTICATION IS NOT PRESENT THIS MEDIA SHOULD NOT BE CONSIDERED A CERTIFIED DOCUMENT.

Date
JUNE 30, 2023

Revised
1 FEBRUARY 22, 2024

Design: ST Drawn: MJS

CONSTRUCTION DOCUMENTS

JOINT PLAN

Sheet
C3.01

ES&S PROJECT NO. 15925

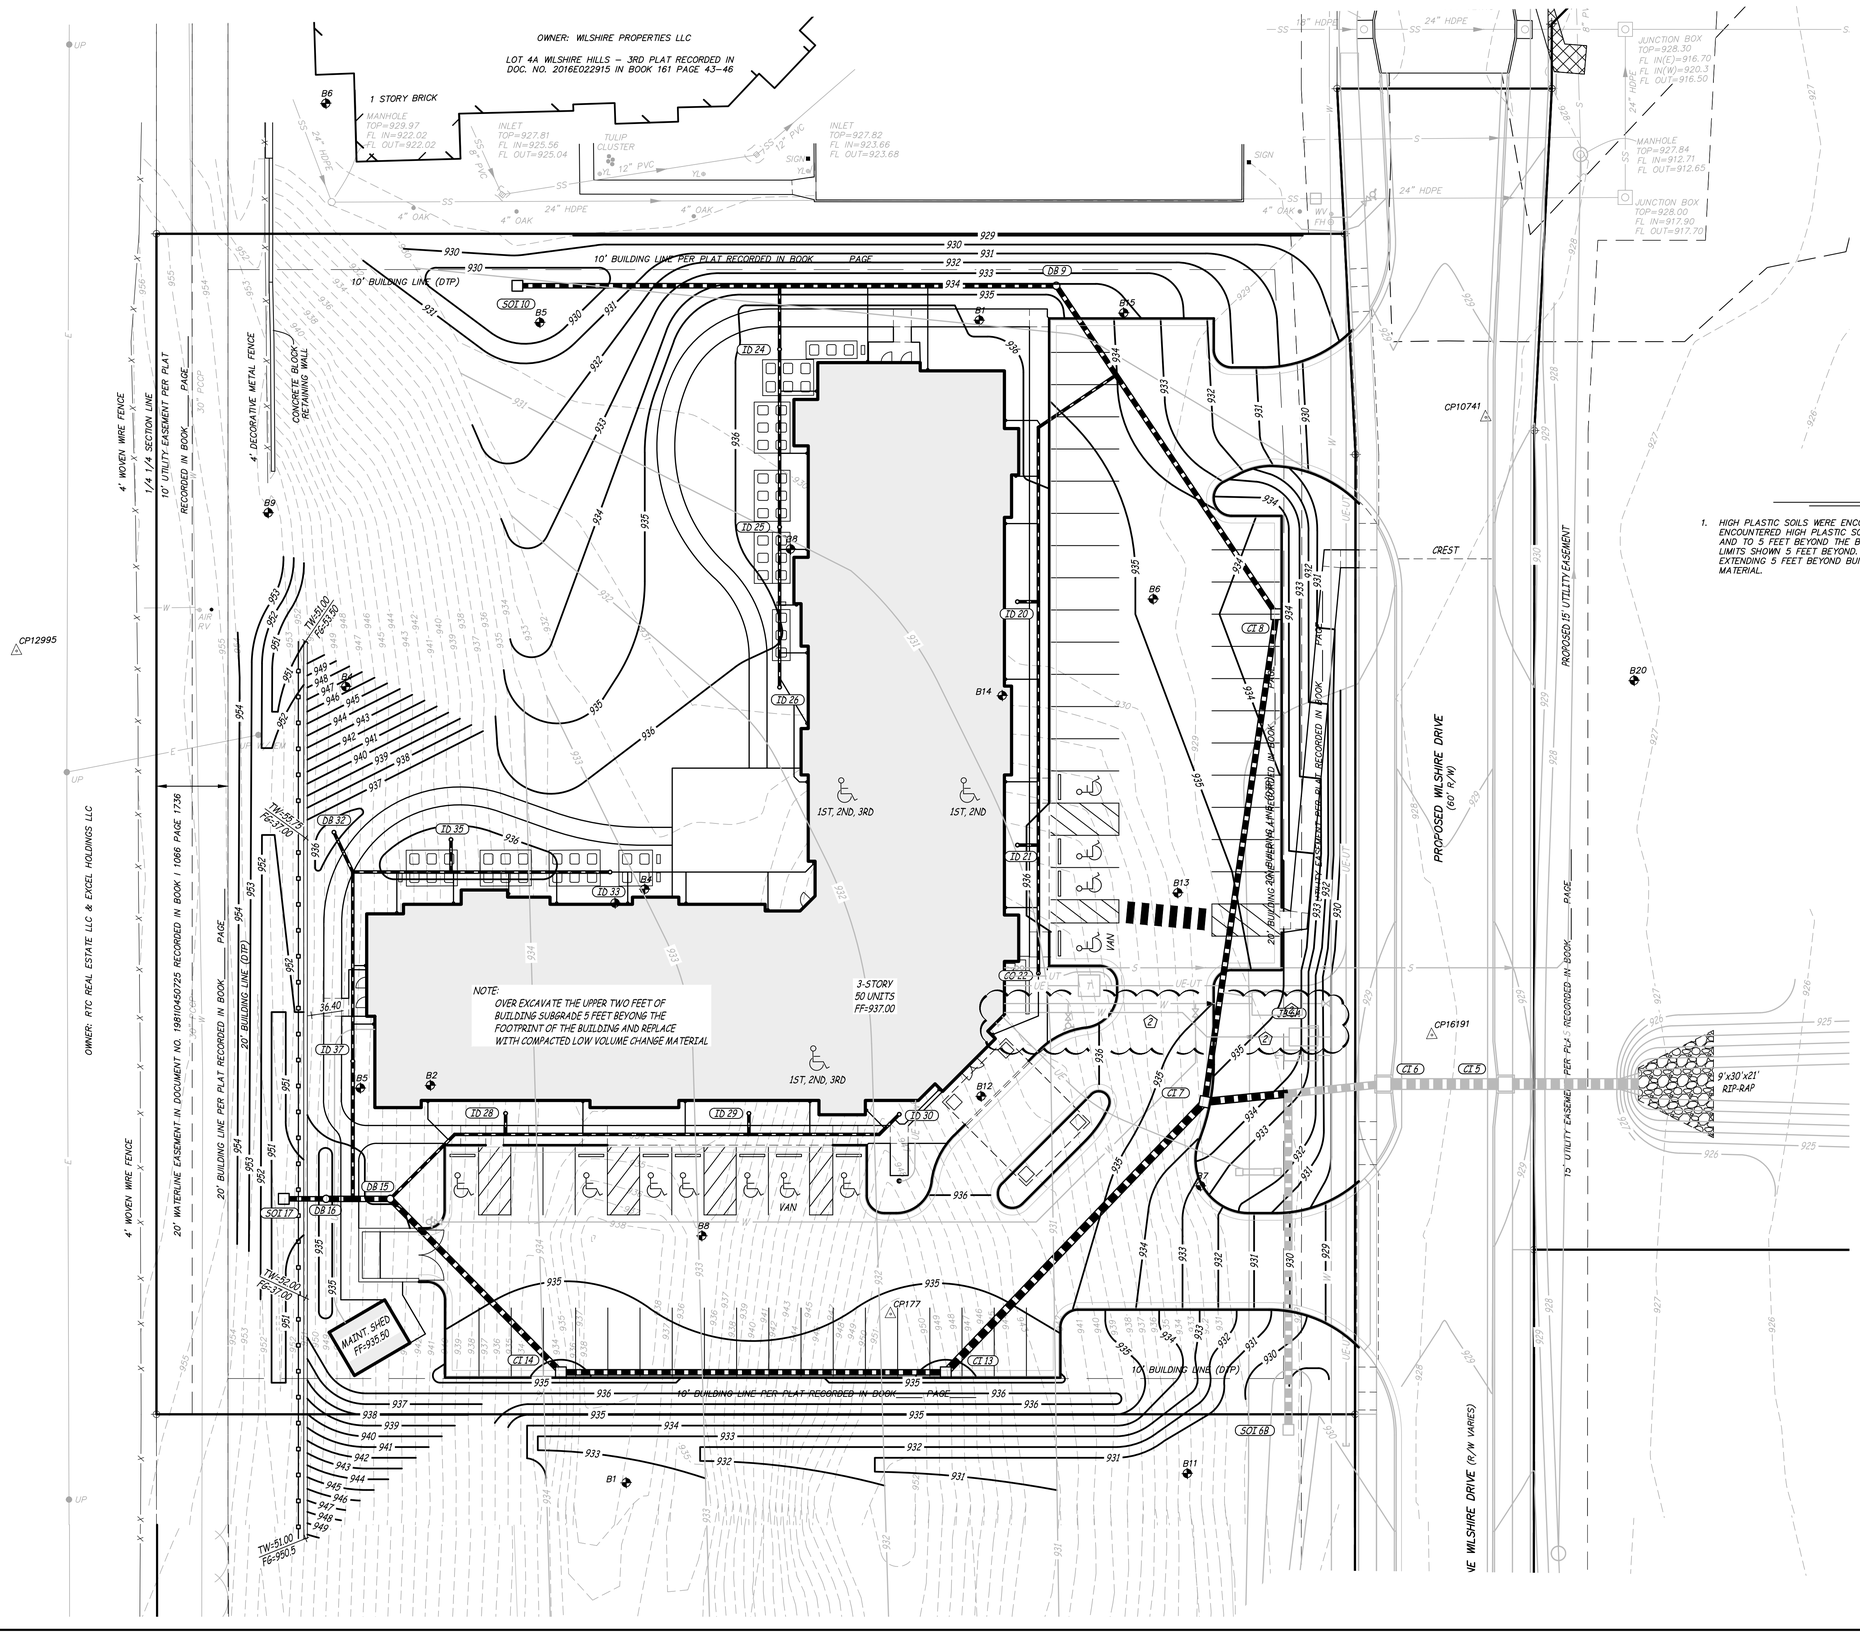

EARTHWORK NOTES (1)

1. HIGH PLASTIC SOILS WERE ENCOUNTERED IN THE AREA. CONTRACTOR SHALL OVER-EXCAVATE ENCOUNTERED HIGH PLASTIC SOILS WITHIN THE 2 FOOT OF FINISHED SUBGRADE BUILDING PAD AND TO 5 FEET BEYOND THE BUILDING, AND AT LEAST 1 FOOT BELOW PAVEMENT SUBGRADE LIMITS SHOWN 5 FEET BEYOND. ANY FILL PLACED WITHIN THE UPPER 2 FEET OF SUBGRADE EXTENDING 5 FEET BEYOND BUILDING FOOTPRINT SHOULD CONSIST OF LOW VOLUME CHANGE MATERIAL.

(1) NOTE:
1. SEE PAGE C0.02 FOR REFERENCE TO WILSHIRE HILLS PUBLIC IMPROVEMENT PLAN AND LIMITS OF WORK

Engineering Surveys & Services
DELIVERING YOUR VISION ™
1113 Fay Street, Columbia, MO 65201
573 - 449 - 2646
802 El Dorado Drive, Jefferson City, MO 65101
573-636-3303
1775 West Main Street, Sedalia, MO 65301
660-826-8818
www.ess-inc.com
MO Engineering Corp. # 2004005018

N

0 1"
SCALE: 1" = 20'

WILSHIRE HILLS PHASE III

3200 NE WILSHIRE DR
LEE'S SUMMIT, JACKSON COUNTY, MISSOURI

4/17/2024

STATE OF MISSOURI
MATTHEW AARON KRIETE
NUMBER PE-2007002811
PROFESSIONAL ENGINEER

MATTHEW A. KRIETE
PROFESSIONAL ENGINEER
PE-2007002811

IF ORIGINAL SIGNATURE OR DIGITAL AUTHENTICATION IS NOT PRESENT THIS MEDIA SHOULD NOT BE CONSIDERED A CERTIFIED DOCUMENT.

Date
JUNE 30, 2023

Revised	
1	FEBRUARY 22, 2024
2	APRIL 17, 2024

Design: ST Drawn: MJS

GRADING & DRAINAGE PLAN

Sheet
C4.01

CONSTRUCTION DOCUMENTS

ES&S PROJECT NO. 15925

P:\GENERAL PROJECTS\15925E—JES- WILSHIRE-HILLS-3-ENG\CAD\15925 SITE PLAN.DWG 4/19/2024

OWNER: WILSHIRE PROPERTIES LLC

LOT 4A WILSHIRE HILLS – 3RD PLAT RECORDED IN DOC. NO. 2016E022915 IN BOOK 161 PAGE 43-46

OWNER: RTC REAL ESTATE LLC & EXCEL HOLDINGS LLC

1 STORY BRICK

MANHOLE TOP=929.97 FL IN=922.02 FL OUT=922.02

INLET TOP=927.81 FL IN=925.56 FL OUT=925.04

INLET TOP=927.82 FL IN=923.66 FL OUT=923.68

TULIP CLUSTER

CONCRETE W/ CURB & GUTTER

CONCRETE SIDEWALK

10' BUILDING LINE PER PLAT RECORDED IN BOOK ____ PAGE ____

10' BUILDING LINE (DTP)

20' BUILDING LINE PER PLAT RECORDED IN BOOK ____ PAGE ____

20' BUILDING LINE (DTP)

10' UTILITY EASEMENT PER PLAT RECORDED IN BOOK ____ PAGE ____

1/4 1/4 SECTION LINE

4' WOVEN WIRE FENCE

4' DECORATIVE METAL FENCE

CONCRETE BLOCK RETAINING WALL

20' WATERLINE EASEMENT IN DOCUMENT NO. 1981I0450725 RECORDED IN BOOK I 1066 PAGE 1736

SOT 10
STA. 7+14.1
SIDE OPEN INLET (3.0'x3.0')
TOP=930.50
OPENING=929.50
FL OUT=927.19

17.7 LF 8" PVC @ 20.14%

DB 9
STA. 5+63.5
24" DRAIN BASIN
SILL=934.00
FL IN(10)=926.43
FL OUT=926.43

150.6 LF 15" HDPE @ 0.50%

28.2 LF 8" PVC @ 23.31%

110.5 LF 15" HDPE @ 0.50%

DB 24
STA. 6+58.7
12" INLINE DRAIN
SILL=936.50
FL=930.39

49.7 LF 8" PVC @ 1.00%

DB 25
STA. 7+08.4
12" INLINE DRAIN
SILL=936.50
FL=930.89

DOWNSPOUT COLLECTOR (TYP)

6" PVC (TYP)

DB 20
STA. 6+08.6
12" INLINE DRAIN
SILL=936.25

CI 8
STA. 4+53.0
TYPE A INLET (3.0'x3.0')
TOP=933.75
GUTTER=933.25
FL IN(9)=925.88
FL OUT=925.57

44.8 LF 8" PVC @ 1.00%

DB 26
STA. 7+53.2
12" INLINE DRAIN
SILL=936.30
FL=931.34

DB 32
STA. 7+10.6
12" DRAIN BASIN
SILL=935.90
FL OUT=931.81

TD 35
STA. 7+60.1
12" INLINE DRAIN
SILL=935.40
FL=932.06

TD 33
STA. 7+82.4
12" INLINE DRAIN
SILL=936.30
FL=932.36

12.1 LF 8" PVC @ 1.00%

9 LF 8" PVC @ 1.00%

71.9 LF 8" PVC @ 0.93%

TD 21
STA. 6+76.6
12" INLINE DRAIN
SILL=936.25

1ST, 2ND, 3RD

3-STORY
50 UNITS
FF=937.00

CO 22
CLEANOUT
TOP=936.63
FL=933.91

137.3 LF 18" HDPE @ 0.50%

20' BUILDING LINE PER PLAT RECORDED IN BOOK ____ PAGE ____

TD 37
STA. 6+57.6
12" INLINE DRAIN
SILL=936.50
FL=931.16
FL=931.03

TD 28
STA. 6+35.3
12" INLINE DRAIN
SILL=936.50

TD 29
STA. 7+03.3
12" INLINE DRAIN
SILL=936.50

TD 30
STA. 7+47.7
12" INLINE DRAIN
SILL=936.50
FL=934.00

CI 7
STA. 3+15.3
TYPE A INLET (3.0'x3.0')
TOP=934.90
GUTTER=934.40
FL IN(13)=927.20
FL IN(8)=924.88
FL OUT=924.18

23.4 LF 6" HDPE @ 0.50%

6" PVC (TYP)

126.6 LF 8" PVC @ 1.00%

DB 10
STA. 6+13.5
24" DRAIN BASIN
SILL=934.90
FL IN(17)=930.65
FL OUT=930.65

38.5 LF 10" PVC @ 1.00%

25.6 LF 8" PVC @ 1.00%

DB 15
STA. 5+95.6
24" DRAIN BASIN
SILL=936.10'
FL IN(16 (3))=930.41
FL IN(28)=932.48
FL OUT=930.41

11.8 LF 15" RCP @ 1.37%

17.9 LF 18" HDPE @ 1.31%

SOT 17
STA. 6+25.4
SIDE OPEN INLET (3.0'x3.0')
TOP=950.50
OPENING=949.50
FL OUT=930.81

CI 14
STA. 5+27.6
TYPE A INLET (3.0'x3.0')
TOP=934.90
GUTTER=934.40
FL IN(15)=929.73
FL OUT=929.53

160.0 LF 18" HDPE @ 1.03%

MAINT. SHED FF=935.50

CI 13
STA. 4+20.0 35
TYPE A INLET (3.0'x3.0')
TOP=934.90
GUTTER=934.40
FL IN(14)=928.45
FL OUT=928.25

104.7 LF 24" HDPE @ 0.50%

94.0 LF 24" HDPE @ 0.50%

107.6 LF 18" HDPE @ 1.00%

10' BUILDING LINE PER PLAT RECORDED IN BOOK ____ PAGE ____

10' BUILDING LINE (DTP)

B1 B2 B3 B4 B5 B6 B7 B8 B9 B10 B11 B12 B13 B14 B15 B20

CP12995 CP10741 CP16191

JUNCTION BOX TOP=928.30 IN(E)=916.70 IN(W)=920.3 OUT=916.50

MANHOLE TOP=927.84 FL IN=912.71 FL OUT=912.65

JUNCTION BOX TOP=928.00 FL IN=917.90 FL OUT=917.70

UTILITY EASEMENT (DTP)

N 5°03'20"E 41.75'

S 45°37'20"W 70.75'

N 84°59'40"W 15.00'

N 87°54'50"W 30.07'

GRAVEL

CREST

PROPOSED 15' UTILITY EASEMENT

PROPOSED WILSHIRE DRIVE (60' R/W)

NE WILSHIRE DRIVE (R/W VARIES)

9'x30'x21' RIP-RAP

1 NOTE:
1. SEE PAGE C0.02 FOR REFERENCE TO WILSHIRE HILLS PUBLIC IMPROVEMENT PLAN AND LIMITS OF WORK

P:\GENERAL PROJECTS\15925E-JES-WILSHIRE-HILLS-3-ENG\CAD\15925 SITE PLAN.DWG 4/19/2024

Engineering Surveys & Services
DELIVERING YOUR VISION ™
1113 Fay Street, Columbia, MO 65201
573 - 449 - 2646
802 El Dorado Drive, Jefferson City, MO 65101
573-636-3303
1775 West Main Street, Sedalia, MO 65301
660-826-8818
www.ess-inc.com
MO Engineering Corp. # 2004005018

N

0 1"
SCALE: 1" = 20'

WILSHIRE HILLS PHASE III

3200 NE WILSHIRE DR
LEE'S SUMMIT, JACKSON COUNTY, MISSOURI

4/17/2024

STATE OF MISSOURI
MATTHEW AARON KRIETE
NUMBER PE-2007002811
PROFESSIONAL ENGINEER

MATTHEW A. KRIETE
PROFESSIONAL ENGINEER
PE-2007002811

IF ORIGINAL SIGNATURE OR DIGITAL AUTHENTICATION IS NOT PRESENT THIS MEDIA SHOULD NOT BE CONSIDERED A CERTIFIED DOCUMENT.

Date
JUNE 30, 2023

Revised
1 FEBRUARY 22, 2024
2 APRIL 17, 2024

Design: ST Drawn: MJS

CONSTRUCTION DOCUMENTS

STORM SEWER PLAN

Sheet
C5.01

ES&S PROJECT NO. 15925

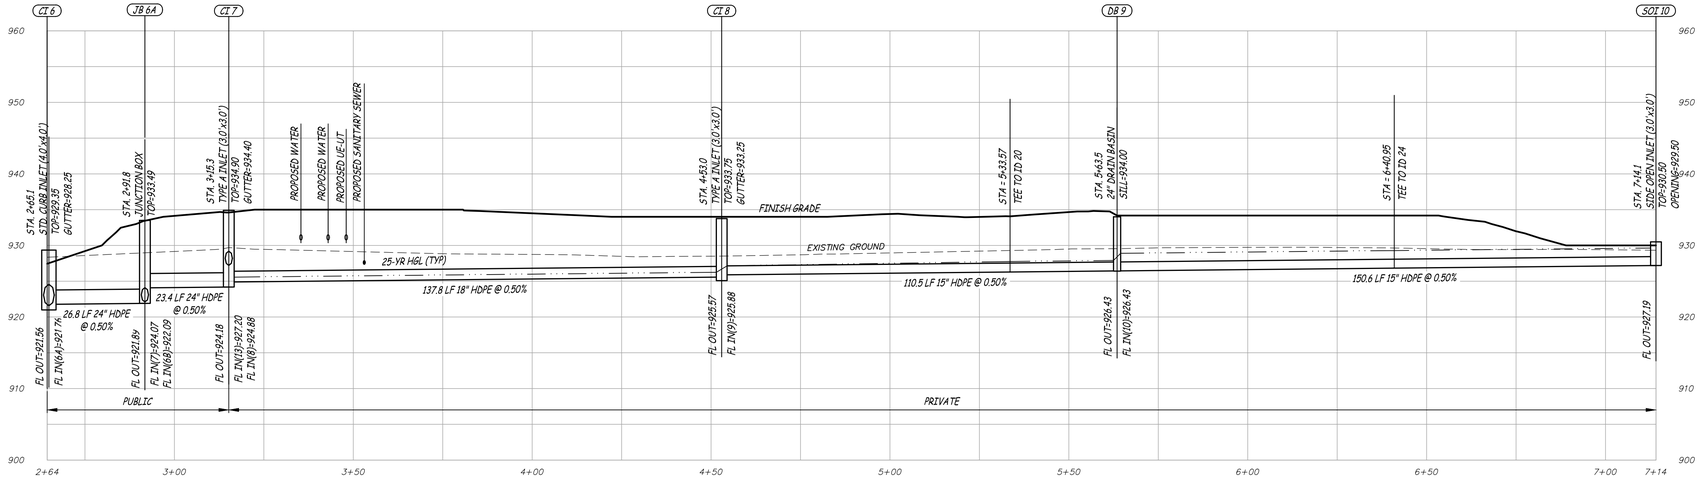

SCALE – HORIZ. 1" = 20'
VERT. 1" = 10'

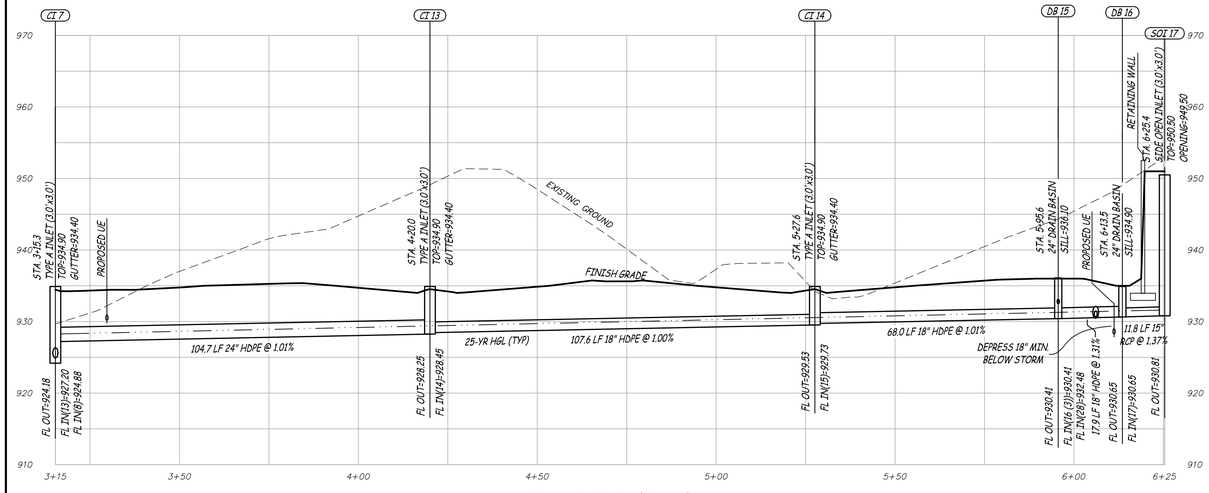

CI 7 THRU SOI 17 (PRIVATE)
SCALE – HORIZ. 1" = 20'
VERT. 1" = 10'

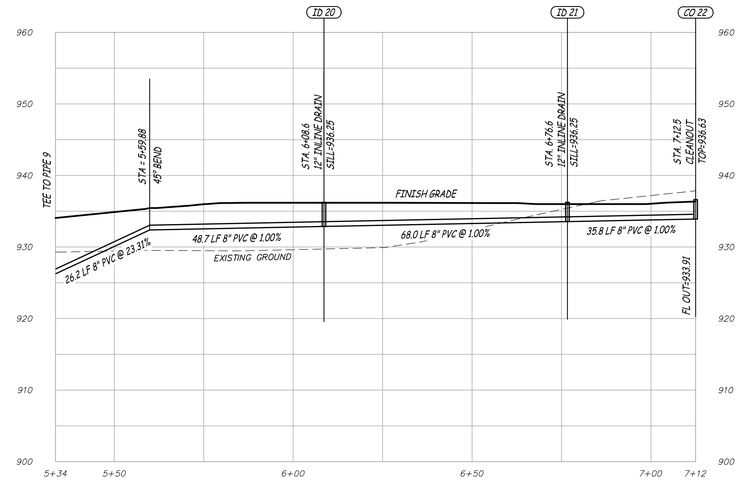

TEE 9 THRU CO 22 (PRIVATE)
SCALE – HORIZ. 1" = 20'
VERT. 1" = 10'

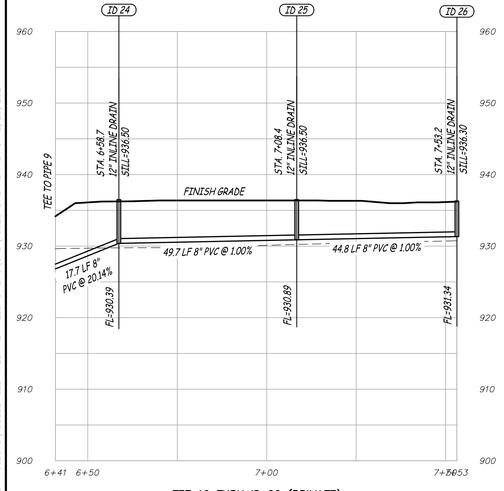

TEE 10 THRU ID 26 (PRIVATE)
SCALE – HORIZ. 1" = 20'
VERT. 1" = 10'

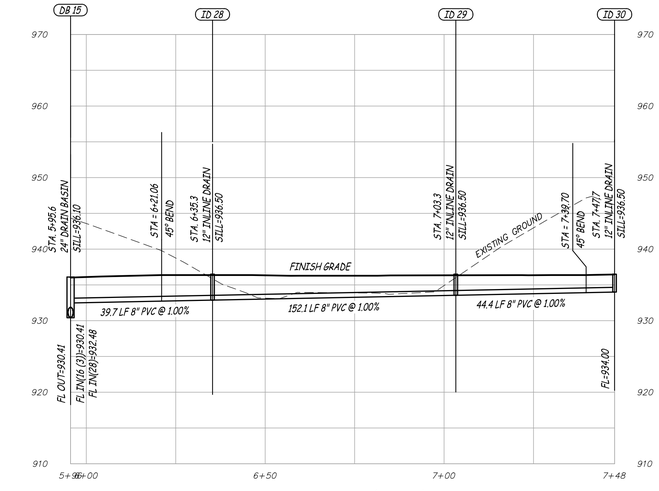

DB 15 THRU ID 30 (PRIVATE)
SCALE – HORIZ. 1" = 20'
VERT. 1" = 10'

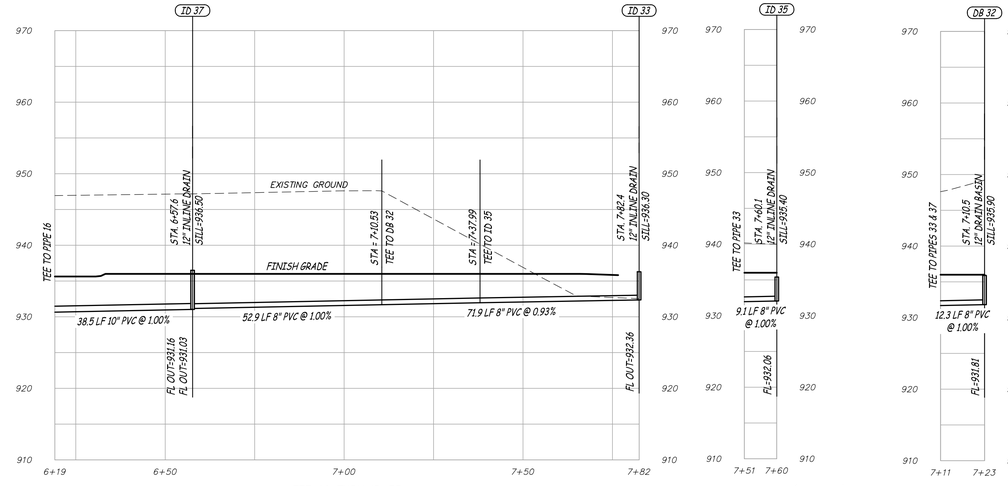

TEE 16 THRU ID 33
SCALE – HORIZ. 1" = 20'
VERT. 1" = 10'

TEE 33 THRU ID 35 (PRIVATE)
SCALE – HORIZ. 1" = 20'
VERT. 1" = 10'

DB 32 THRU TEE 33–37
SCALE – HORIZ. 1" = 20'
VERT. 1" = 10'

Engineering Surveys & Services
DELIVERING YOUR VISION ™
1113 Fay Street, Columbia, MO 65201
573 - 449 - 2646
802 El Dorado Drive, Jefferson City, MO 65101
573-636-3303
1775 West Main Street, Sedalia, MO 65301
660-826-8818
www.ess-inc.com
MO Engineering Corp. # 2004005018

WILSHIRE HILLS PHASE III

3200 NE WILSHIRE DR
LEE'S SUMMIT, JACKSON COUNTY, MISSOURI

CONSTRUCTION DOCUMENTS

2/22/2024

STATE OF MISSOURI
MATTHEW AARON KRIETE
NUMBER PE-2007002811
PROFESSIONAL ENGINEER

MATTHEW A. KRIETE
PROFESSIONAL ENGINEER
PE-2007002811

IF ORIGINAL SIGNATURE OR DIGITAL AUTHENTICATION IS NOT PRESENT THIS MEDIA SHOULD NOT BE CONSIDERED A CERTIFIED DOCUMENT.

Date
JUNE 30, 2023

Revised
1 FEBRUARY 22, 2024

Design: ST Drawn: MJS

STORM SEWER PROFILES

Sheet
C6.01

ES&S PROJECT NO. 15925

P:\GENERAL PROJECTS\15925E—ES-WILSHIRE—HILLS-3—ENG\CAD\15925 SITE PLAN.DWG 2/23/2024

OWNER: WILSHIRE PROPERTIES LLC

LOT 4A WILSHIRE HILLS – 3RD PLAT RECORDED IN DOC. NO. 2016E022915 IN BOOK 161 PAGE 43-46

OWNER: RTC REAL ESTATE LLC & EXCEL HOLDINGS LLC

UTILITY NOTES

1. ALL ISSUES PERTAINING TO LIFE SAFETY AND PROPERTY PROTECTION FROM THE HAZARDS OF FIRE, EXPLOSION OR DANGEROUS CONDITIONS IN NEW AND EXISTING BUILDINGS, STRUCTURES AND PREMISES, AND TO THE SAFETY TO FIRE FIGHTERS AND EMERGENCY RESPONDERS DURING EMERGENCY OPERATIONS, SHALL BE IN ACCORDANCE WITH THE 2018 INTERNATIONAL FIRE CODE.

2. PRIOR TO ANY COMBUSTIBLE CONSTRUCTION, WILSHIRE DRIVE SHALL BE COMPLETED THROUGH TO STROTHER ROAD. ALL PUBLIC AND PRIVATE HYDRANTS SHALL BE IN PLACE AND OPERABLE, AND THE APARTMENT PARKING LOT'S ASPHALT BASE SHALL BE IN PLACE.

5

110,478 SQ. FT.
OR 2.54 ACRES

3200 NE WILSHIRE DRIVE

2.50 ACRES

10' BUILDING LINE PER PLAT RECORDED IN BOOK_____ PAGE_____

20' WATERLINE EASEMENT IN DOCUMENT NO. 1981010450725 RECORDED IN BOOK I 1066 PAGE 1736

20' BUILDING LINE PER PLAT RECORDED IN BOOK_____ PAGE_____

10' UTILITY EASEMENT PER PLAT RECORDED IN BOOK_____ PAGE_____

4' WOVEN WIRE FENCE

4' DECORATIVE METAL FENCE

CONCRETE BLOCK RETAINING WALL

1 STORY BRICK
MANHOLE
TOP=929.97
FL IN=922.02
FL OUT=922.02

INLET
TOP=927.81
FL IN=925.56
FL OUT=925.04

TULIP CLUSTER

INLET
TOP=927.82
FL IN=923.66
FL OUT=923.68

CONCRETE W/ CURB & GUTTER

CONCRETE SIDEWALK

SIGN

4" OAK

24" HDPE

12" PVC

8" PVC

CURB INLET
TOP=928.23
GUTTER=927.35
FL IN=922.53
FL OUT=922.18

CURB INLET
TOP=928.15
GUTTER=927.29
FL IN=921.50
FL OUT=921.15

18" HDPE

24" HDPE

JUNCTION BOX
TOP=928.30
IN(E)=916.70
IN(W)=920.30
OUT=916.50

MANHOLE
TOP=927.84
FL IN=912.71
FL OUT=912.65

JUNCTION BOX
TOP=928.00
FL IN=917.90
FL OUT=917.70

UTILITY EASEMENT (OTP)

GRAVEL

N 2°55'10"E 18.24'

N 46°51'50"E 35.22'

F 21.55'

S 1°38'30"W 15.00'

N 5°20'20"E 41.75'

S 4°57'20"W 70.75'

N 84°39'40"W 15.00'

0.00

CP10741

CP16191

CP177

B1 B2 B3 B4 B5 B6 B8 B9 B11 B12 B13 B14 B15 B20 B27

1ST, 2ND, 3RD

1ST, 2ND

3-STORY
50 UNITS
FF=937.00

DOMESTIC BACK FLOW PREVENTER LOCATED WITHIN BUILDING

CO F
TWO-WAY CLEANOUT
TOP=936.00
FL=927.94

2 FIRE DOMESTIC FDC

FIRE HYDRANT ASSEMBLY

45° BEND

SEE DETAIL

86.0 LF 6" SDR35 PVC W/ TRACER WIRE @ 1.00%

3" SDR21 PVC W/ TRACER WIRE

6" C-900 PVC W/ TRACER WIRE

1-4" PVC UE
1-4" PVC AT&T
1-4" PVC UT COMCAST
1-4" PVC UT EMPTY

2" PVC UE

MAINT. SHED
FF=935.50

BOLLARD

UP W/ EM

AIR RV

30" POCP

PROPOSED WILSHIRE DRIVE (60' R/W)

PROPOSED 15' UTILITY EASEMENT I-00

15' UTILITY EASEMENT PER PLAT RECORDED IN BOOK_____ PAGE_____

20' BUILDING LINE PER PLAT RECORDED IN BOOK_____ PAGE_____

EXISTING WILSHIRE DRIVE (VARIES)

3+00

2+00

CO C

CO F

PROPOSED UE
PROPOSED WATER
STA. 2+93.7
CLEANOUT
TOP=931.00

PROPOSED STORM SEWER

STA. 3+79.7
TWO-WAY CLEANOUT
TOP=936.00

FINISH GRADE

EXISTING GROUND

86.0 LF 6" SDR35 PVC
W/ TRACER WIRE @ 1.00%

65.1 LF 6"
SDR26 PVC @ 6.03%

4.2 LF 6"
PVC @ 100.00%

FL OUT=923.20

FL IN/FL=927.08

FL OUT=927.94

PUBLIC
(SEE WILSHIRE HILL III
PUBLIC IMPROVEMENT PLAN)

PRIVATE

NOTE: CONNECT TO EXISTING PUBLIC PIPE

960
950
940
930
920
910
900
890

2+24
2+50
3+00
3+50
3+80

SERVICE CONNECTION THRU CO F (PRIVATE)
SCALE – HORIZ. 1" = 20'
VERT. 1" = 10'

6"x6" DI
TO PVC COUPLER

2" SUMP
DRAINAGE PIPE

UE-UT

6" C-900 PVC W/
TRACER WIRE

3 BFP VAULT
(SEE DETAIL
SHEET C13.02)

6" DI

VALVE
(TYP)

8"x6"
CUT-IN TEE

10 LF 6" DI

3" SDR21 PVC W/
TRACER WIRE

10 LF 4" DI

3" WM

8"x4"
CUT-IN TEE

3"x4" DI
TO PVC COUPLER

BFP

2" WM

IRRIGATION

2" TYPE
K COPPER

DETAIL
SCALE: 1" = 10'

1 NOTE:
1. SEE PAGE C0.02 FOR REFERENCE TO WILSHIRE HILLS PUBLIC IMPROVEMENT PLAN AND LIMITS OF WORK.

Engineering Surveys & Services
DELIVERING YOUR VISION ™
1113 Fay Street, Columbia, MO 65201
573 - 449 - 2646
802 El Dorado Drive, Jefferson City, MO 65101
573-636-3303
1775 West Main Street, Sedalia, MO 65301
660-826-8818
www.ess-inc.com
MO Engineering Corp. # 2004005018

N

0 1"
SCALE: 1" = 20'

WILSHIRE HILLS PHASE III

3200 NE WILSHIRE DR

LEE'S SUMMIT, JACKSON COUNTY, MISSOURI

4/17/24

STATE OF MISSOURI
MATTHEW AARON KRIETE
NUMBER PE-2007002811
PROFESSIONAL ENGINEER

MATTHEW A. KRIETE
PROFESSIONAL ENGINEER
PE-2007002811

IF ORIGINAL SIGNATURE OR DIGITAL AUTHENTICATION IS NOT PRESENT THIS MEDIA SHOULD NOT BE CONSIDERED A CERTIFIED DOCUMENT.

Date
JUNE 30, 2023

Revised	
1	FEBRUARY 6, 2024
2	MARCH 27, 2024
3	APRIL 17, 2024

Design: ST Drawn: MJS

UTILITY PLAN & PROFILE

Sheet
C7.01

ES&S PROJECT NO. 15925

CONSTRUCTION DOCUMENTS

\\192.168.0.99\PROJECTS\GENERAL PROJECTS\15925E-JES-WILSHIRE-HILLS-3-ENG\CAD\15925 SITE PLAN.DWG 4/17/2024

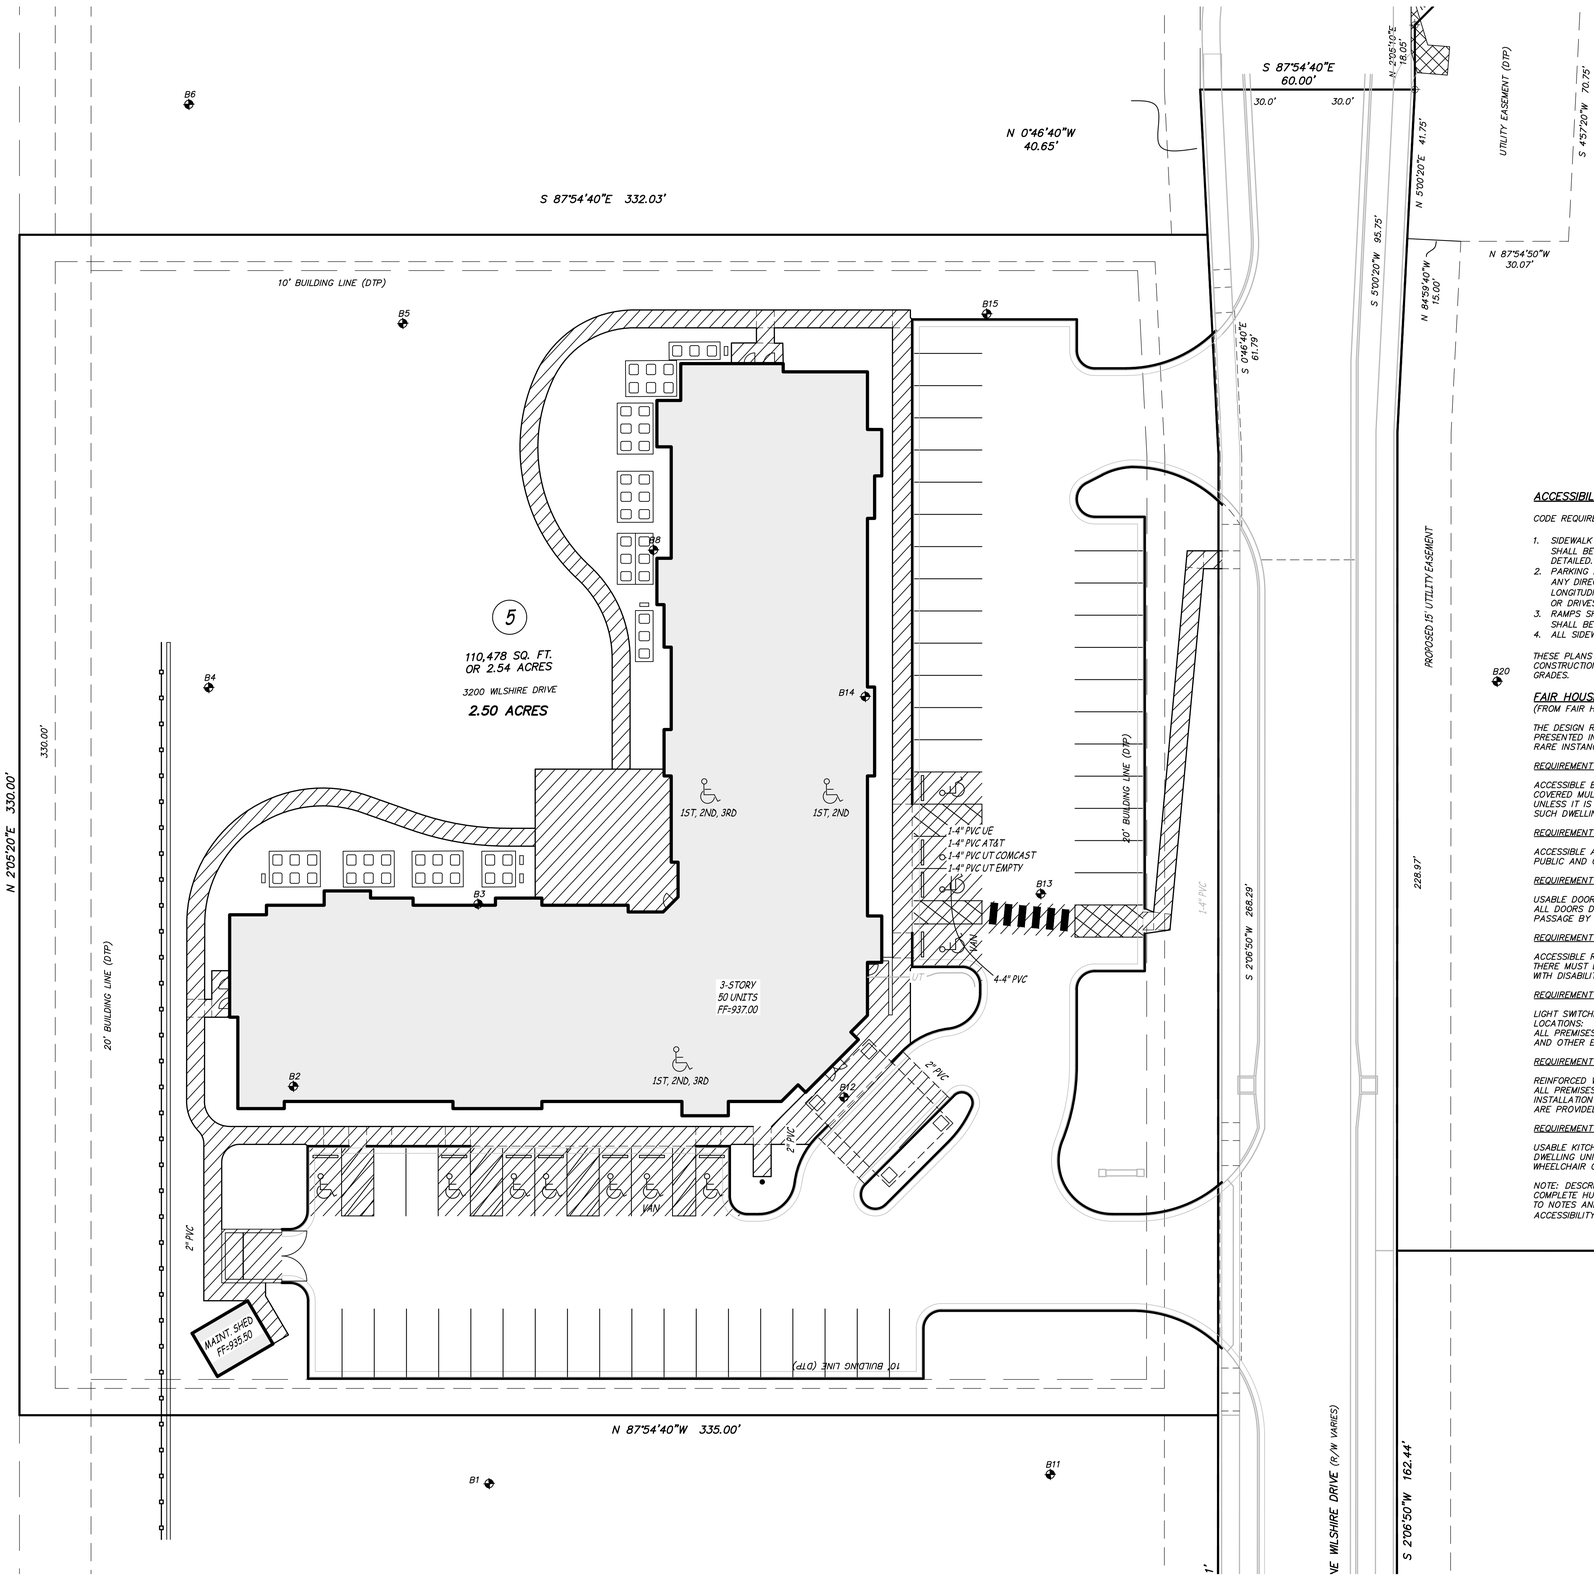

ACCESSIBILITY NOTES

CODE REQUIRES THE FOLLOWING:

1. SIDEWALK SHALL NOT EXCEED 5% (1'–0" IN 20'–0") SLOPE WITH A 2% (1'–0" IN 50'–0") CROSS–SLOPE AND SHALL BE 5' WIDE EXCEPT AS NOTED ON SITE PLAN. PROVIDE STAIRS, RAMPS, CURBS, ETC., AS NOTED AND DETAILED.
2. PARKING AREAS FOR ACCESSIBLE SPACES AND ACCESS AISLE SHALL NOT EXCEED A 2% (1'–0" IN 50'–0") IN ANY DIRECTION. OTHER PORTIONS OF THE ACCESSIBLE ROUTE SHALL NOT EXCEED A 5% (1'–0" IN 20'–0") LONGITUDINAL SLOPE NOR A 2% (1'–0" IN 50'–0") CROSS–SLOPE. OTHER PARKING AREAS AND CROSS–SLOPE OR DRIVES SHALL NOT EXCEED A 5% (1'–0" IN 20'–0") SLOPE.
3. RAMPS SHALL NOT EXCEED 8.33% (1'–0" IN 12'–0") SLOPE WITH A 2% (1'–0" IN 50'–0") CROSS–SLOPE AND SHALL BE 5' WIDE EXCEPT AS NOTED ON SITE LAYOUT PLAN. RISE OF RAMP SHALL NOT EXCEED 6".
4. ALL SIDEWALK INTERSECTIONS SHALL HAVE A 5' x 5' LANDING AT 1/4" PER 1' MAX SLOPE IN ALL DIRECTIONS.

THESE PLANS AND SPECIFICATIONS HAVE BEEN DESIGNED WITH TOLERANCE BELOW THE CODE TO IMPROVE POST CONSTRUCTION COMPLIANCE. REFERENCE THE PLAN SHEETS AND DETAILS FOR SPECIFIED GRADES AND MAXIMUM GRADES.

FAIR HOUSING ACCESSIBILITY GUIDELINES

(FROM FAIR HOUSING ACT DESIGN MANUAL, REVISED APRIL 1998)

THE DESIGN REQUIREMENTS OF THE GUIDELINES TO WHICH NEW BUILDINGS AND DWELLING UNITS MUST COMPLY ARE PRESENTED IN ABRIDGED FORM BELOW. DWELLING UNITS ARE NOT SUBJECT TO THESE REQUIREMENTS ONLY IN THE RARE INSTANCE WHERE THERE ARE EXTREMES OF TERRAIN OR UNUSUAL CHARACTERISTICS OF THE SITE.

REQUIREMENT 1

ACCESSIBLE BUILDING ENTRANCE ON AN ACCESSIBLE ROUTE:
COVERED MULTIFAMILY DWELLINGS MUST HAVE AT LEAST ONE BUILDING ENTRANCE ON AN ACCESSIBLE ROUTE, UNLESS IT IS IMPRACTICAL TO DO SO BECAUSE OF TERRAIN OR UNUSUAL CHARACTERISTICS OF THE SITE. FOR ALL SUCH DWELLINGS WITH A BUILDING ENTRANCE ON AN ACCESSIBLE ROUTE THE FOLLOWING SIX REQUIREMENTS APPLY.

REQUIREMENT 2

ACCESSIBLE AND USABLE PUBLIC AND COMMON USE AREAS:
PUBLIC AND COMMON USE AREAS MUST BE READILY ACCESSIBLE TO AND USABLE BY PEOPLE WITH DISABILITIES.

REQUIREMENT 3

USABLE DOORS:
ALL DOORS DESIGNED TO ALLOW PASSAGE INTO AND WITHIN ALL PREMISES MUST BE SUFFICIENTLY WIDE TO ALLOW PASSAGE BY PERSONS IN WHEELCHAIRS. SEE ARCH PLANS.

REQUIREMENT 4

ACCESSIBLE ROUTE INTO AND THROUGH THE COVERED DWELLING UNIT:
THERE MUST BE AN ACCESSIBLE ROUTE INTO AND THROUGH THE DWELLING UNITS, PROVIDING ACCESS FOR PEOPLE WITH DISABILITIES THROUGHOUT THE UNIT. SEE ARCH PLANS

REQUIREMENT 5

LIGHT SWITCHES, ELECTRICAL OUTLETS, THERMOSTATS AND OTHER ENVIRONMENTAL CONTROLS IN ACCESSIBLE LOCATIONS:
ALL PREMISES WITHIN THE DWELLING UNITS MUST CONTAIN LIGHT SWITCHES, ELECTRICAL OUTLETS, THERMOSTATS AND OTHER ENVIRONMENTAL CONTROLS IN ACCESSIBLE LOCATIONS. SEE ARCH PLANS

REQUIREMENT 6

REINFORCED WALLS FOR GRAB BARS:
ALL PREMISES WITHIN DWELLING UNITS MUST CONTAIN REINFORCEMENTS IN BATHROOM WALLS TO ALLOW LATER INSTALLATION OF GRAB BARS AROUND TOILET, TUB, SHOWER STALL AND SHOWER SEAT, WHERE SUCH FACILITIES ARE PROVIDED. SEE ARCH PLANS.

REQUIREMENT 7

USABLE KITCHENS AND BATHROOMS:
DWELLING UNITS MUST CONTAIN USABLE KITCHENS AND BATHROOMS SUCH THAT AN INDIVIDUAL WHO USES A WHEELCHAIR CAN MANEUVER ABOUT THE SPACE. SEE ARCH PLANS.

NOTE: DESCRIPTIONS OF THE SEVEN REQUIREMENTS ABOVE ARE OF AN ABBREVIATED NATURE. REFER TO THE COMPLETE HUD FAIR HOUSING ACCESSIBILITY GUIDELINES FOR DETAILED DESCRIPTION OF EACH REQUIREMENT. REFER TO NOTES AND DETAILS ON VARIOUS PLAN SHEETS FOR CERTAIN SPECIFIC REQUIREMENTS OF THE FAIR HOUSING ACCESSIBILITY GUIDELINES (FHA) AND THE UNIFORM FEDERAL ACCESSIBILITY STANDARDS (UFAS).

Engineering Surveys & Services
DELIVERING YOUR VISION ™
1113 Fay Street, Columbia, MO 65201
573 - 449 - 2646
802 El Dorado Drive, Jefferson City, MO 65101
573-636-3303
1775 West Main Street, Sedalia, MO 65301
660-826-8818
www.ess-inc.com
MO Engineering Corp. # 2004005018

N

0 1"
SCALE: 1" = 20'

WILSHIRE HILLS PHASE III

3200 NE WILSHIRE DR
LEE'S SUMMIT, JACKSON COUNTY, MISSOURI

2/22/2024

STATE OF MISSOURI
MATTHEW AARON KRIETE
NUMBER PE-2007002811
PROFESSIONAL ENGINEER

MATTHEW A. KRIETE
PROFESSIONAL ENGINEER
PE-2007002811

IF ORIGINAL SIGNATURE OR DIGITAL AUTHENTICATION IS NOT PRESENT THIS MEDIA SHOULD NOT BE CONSIDERED A CERTIFIED DOCUMENT.

Date
JUNE 30, 2023

Revised
1 FEBRUARY 22, 2024

Design: ST Drawn: MJS

ACCESSIBILITY PLAN

Sheet
C8.01

CONSTRUCTION DOCUMENTS

ES&S PROJECT NO. 15925

P:\GENERAL PROJECTS\15925E–JES–WILSHIRE–HILLS–3–ENG\CAD\15925 SITE PLAN.DWG 2/26/2024

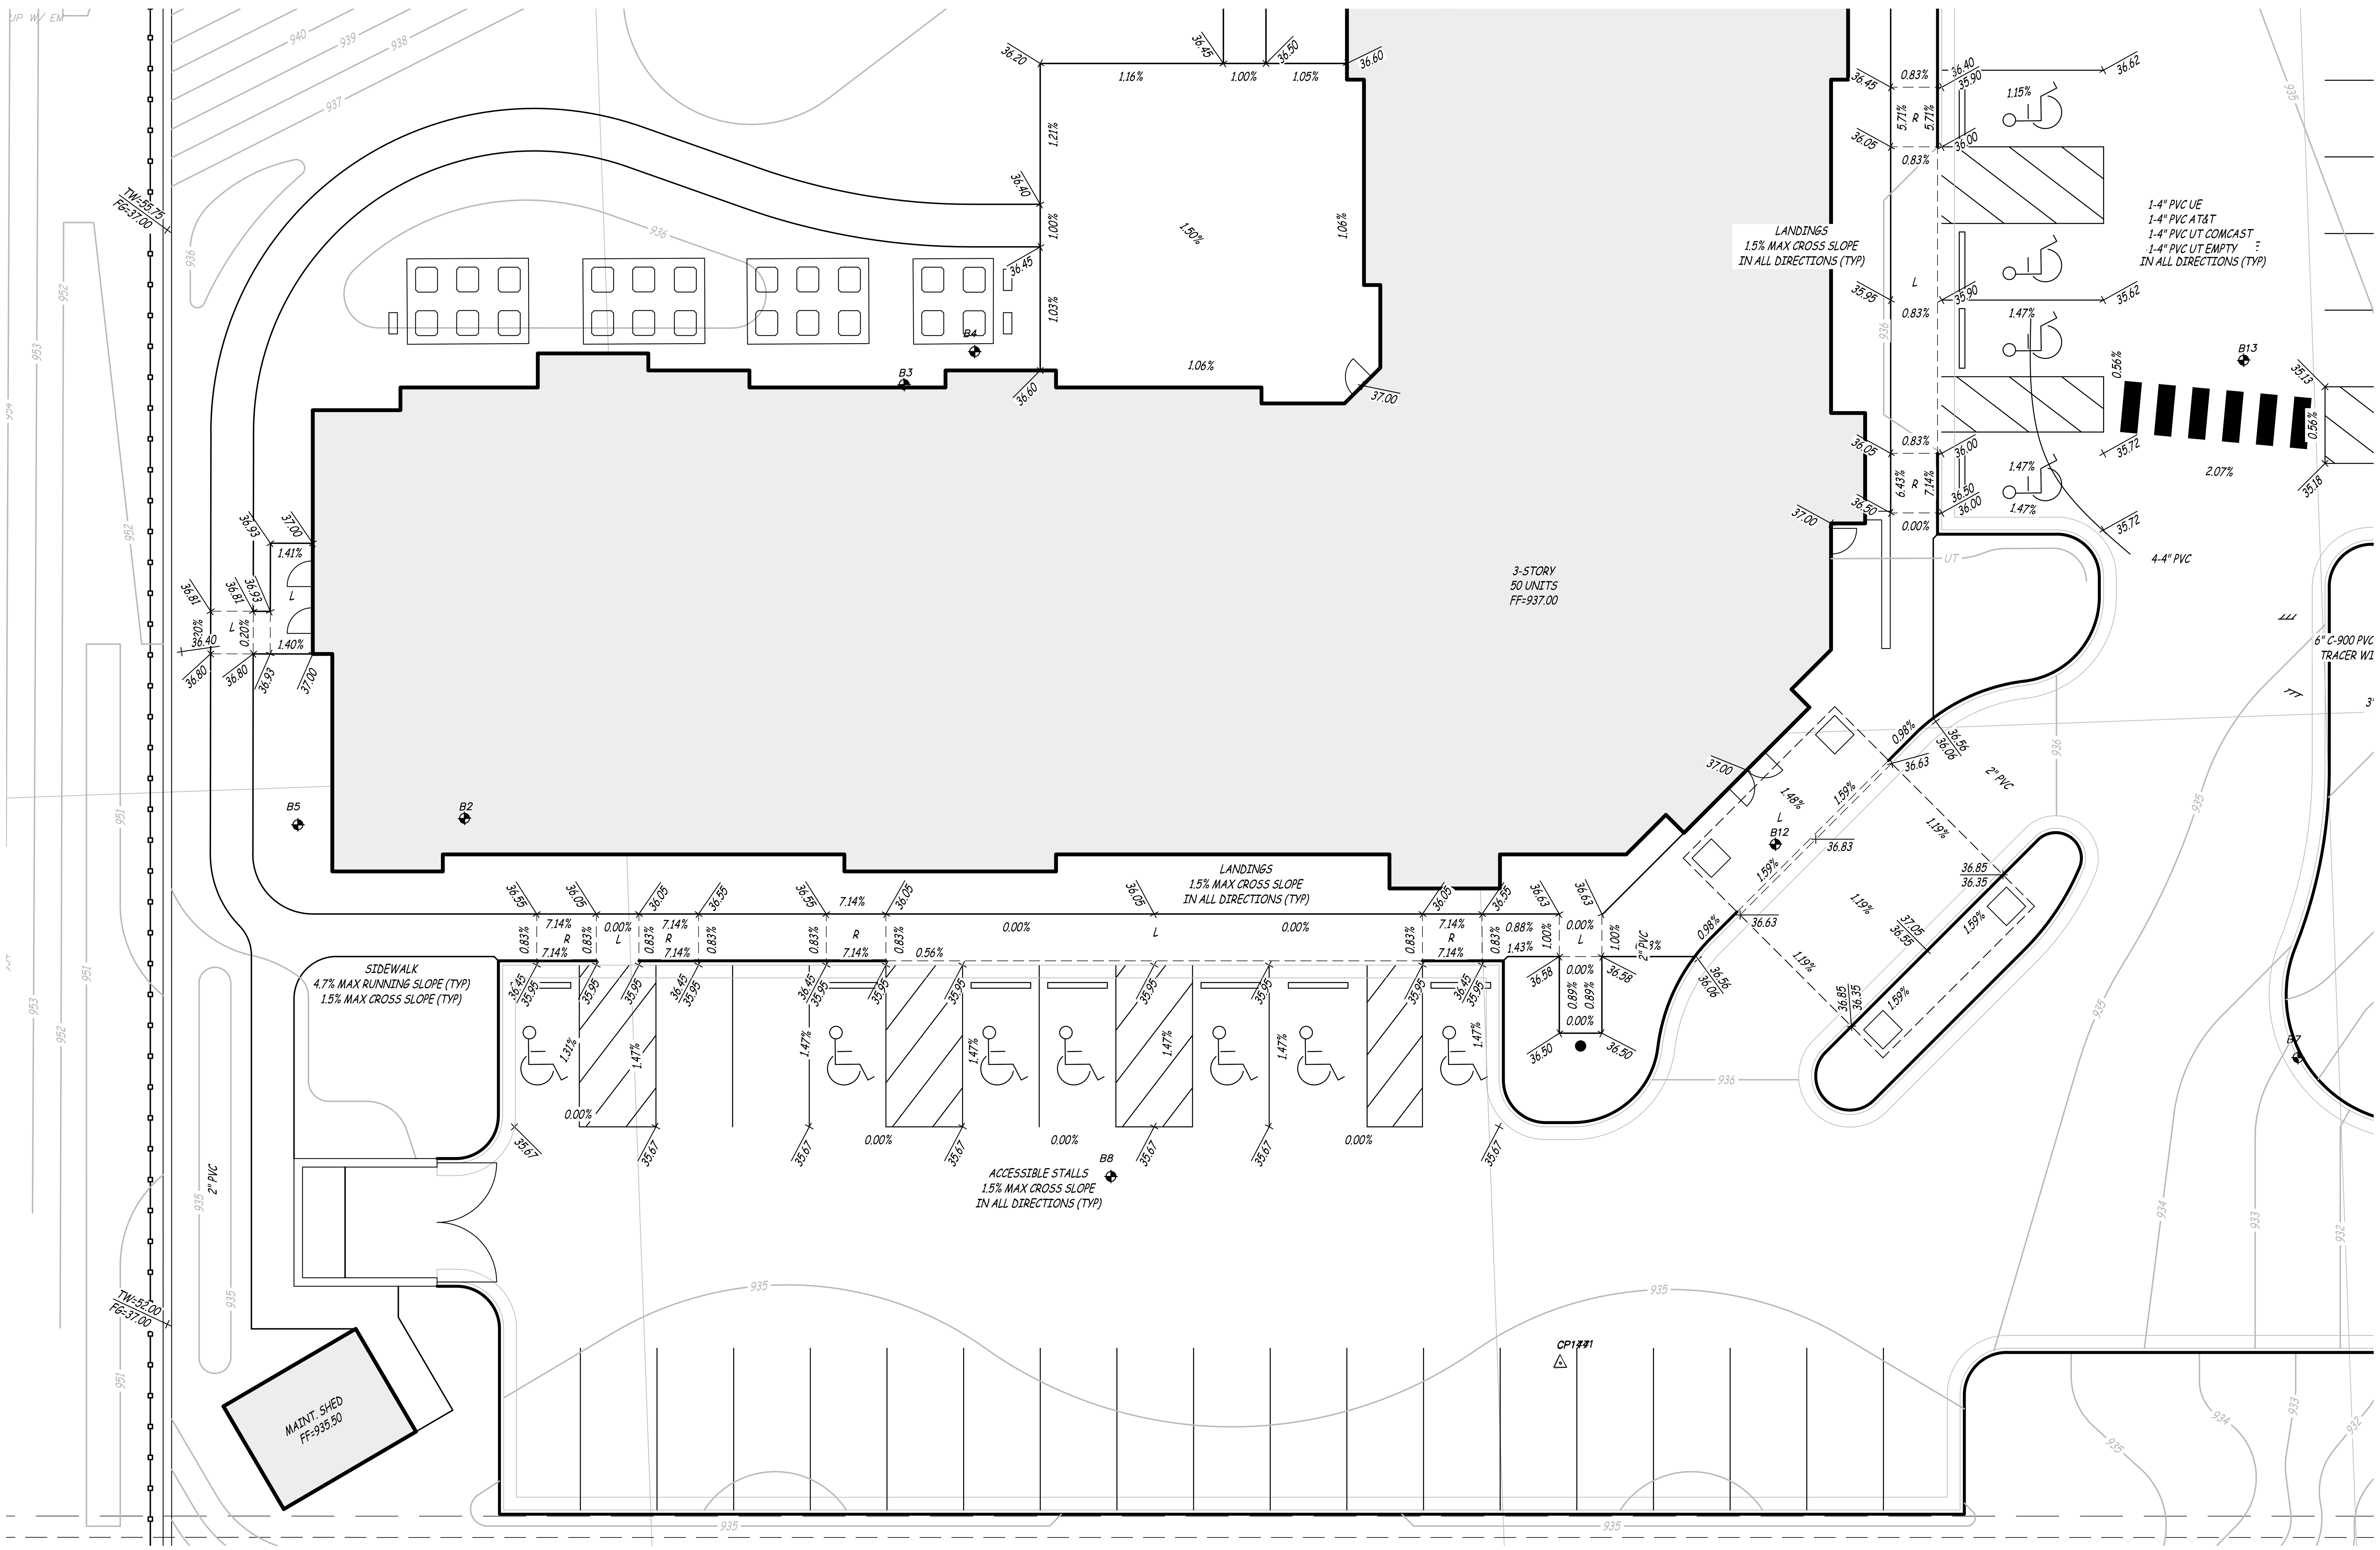

ES&S
Engineering Surveys & Services
DELIVERING YOUR VISION ™
1113 Fay Street, Columbia, MO 65201
573 - 449 - 2646
802 El Dorado Drive, Jefferson City, MO 65101
573-636-3303
1775 West Main Street, Sedalia, MO 65301
660-826-8618
www.ess-inc.com
MO Engineering Corp. # 2004005018

N

0 1"
SCALE: 1" = 10'

WILSHIRE HILLS PHASE III
3200 NE WILSHIRE DR
LEE'S SUMMIT, JACKSON COUNTY, MISSOURI

2/22/2024
STATE OF MISSOURI
MATTHEW AARON KRIETE
NUMBER PE-2007002811
PROFESSIONAL ENGINEER

MATTHEW A. KRIETE
PROFESSIONAL ENGINEER
PE-2007002811

IF ORIGINAL SIGNATURE OR DIGITAL AUTHENTICATION IS NOT PRESENT THIS MEDIA SHOULD NOT BE CONSIDERED A CERTIFIED DOCUMENT.

Date
JUNE 30, 2023

Revised
1 FEBRUARY 22, 2024

Design: ST Drawn: MJS

ACCESSIBILITY PLAN

Sheet
C8.02

ES&S PROJECT NO. 15925

CONSTRUCTION DOCUMENTS

P:\GENERAL PROJECTS\15925E-JES-WILSHIRE-HILLS-3-ENG\CAD\15925 SITE PLAN.DWG 2/26/2024

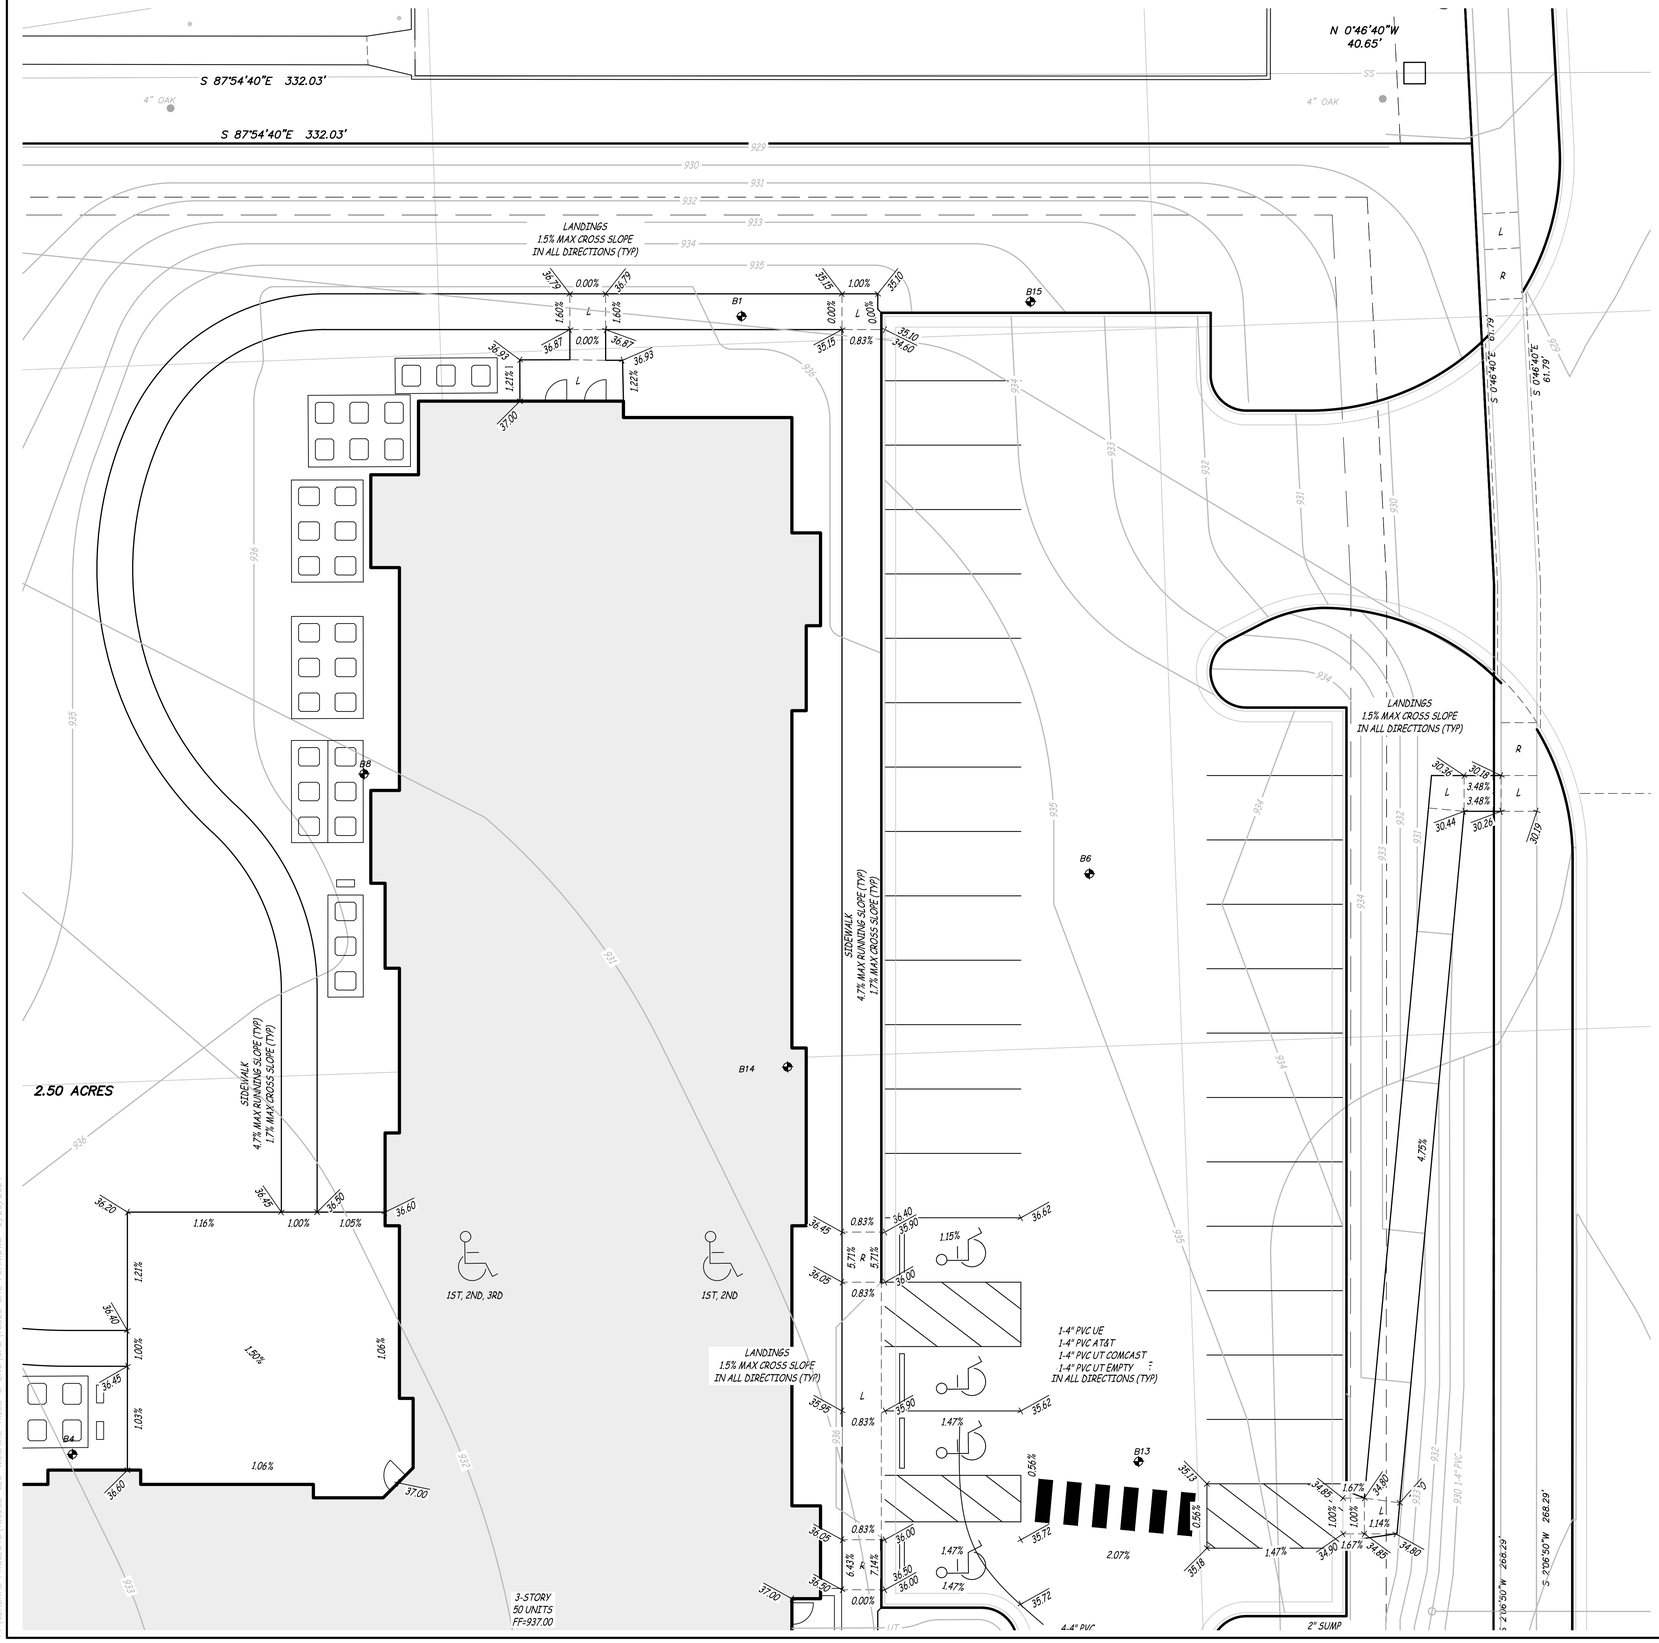

1 NOTE:
1. REFERENCE TO PUBLIC IMPROVEMENT PLAN

Engineering Surveys & Services
DELIVERING YOUR VISION ™
1113 Fay Street, Columbia, MO 65201
573 - 449 - 2646
802 El Dorado Drive, Jefferson City, MO 65101
573-636-3303
1775 West Main Street, Sedalia, MO 65301
660-826-8818
www.ess-inc.com
MO Engineering Corp. # 2004005018

N

0 1"
SCALE: 1" = 10'

WILSHIRE HILLS PHASE III

3200 NE WILSHIRE DR
LEE'S SUMMIT, JACKSON COUNTY, MISSOURI

2/22/2024

STATE OF MISSOURI
MATTHEW AARON KRIETE
NUMBER PE-2007002811
PROFESSIONAL ENGINEER

MATTHEW A. KRIETE
PROFESSIONAL ENGINEER
PE-2007002811

IF ORIGINAL SIGNATURE OR DIGITAL AUTHENTICATION IS NOT PRESENT THIS MEDIA SHOULD NOT BE CONSIDERED A CERTIFIED DOCUMENT.

Date
JUNE 30, 2023

Revised
1 FEBRUARY 22, 2024

Design: ST Drawn: MJS

CONSTRUCTION DOCUMENTS

ACCESSIBILITY PLAN

Sheet
C8.03

ES&S PROJECT NO. 15925

P:\GENERAL PROJECTS\15925E-JES-WILSHIRE-HILLS-3-ENG\CAD\15925 SITE PLAN.DWG 2/26/2024

OWNER: WILSHIRE PROPERTIES LLC

LOT 4A WILSHIRE HILLS – 3RD PLAT RECORDED IN DOC. NO. 2016E022915 IN BOOK 161 PAGE 43–46

OWNER: RTC REAL ESTATE LLC & EXCEL HOLDINGS LLC

1 STORY BRICK

MANHOLE TOP=929.97 FL IN=922.02 FL OUT=922.02

INLET TOP=927.81 FL IN=925.56 FL OUT=925.04

INLET TOP=927.82 FL IN=923.66 FL OUT=923.68

TULIP CLUSTER

SIGN

CONCRETE SIDEWALK

CONCRETE W/ CURB & GUTTER

N 0°46'40"W 40.65'

S 87°54'40"E 332.03'

S 87°54'40"E 60.00'

30.0'

30.0'

N 2°05'20"E 18.05'

JUNCTION BOX TOP=928.30 FL IN(E)=916.70 FL IN(W)=920.3 FL OUT=916.50

MANHOLE TOP=923.83 FL IN=912.71 FL OUT=912.65

JUNCTION BOX TOP=928.00 FL IN=917.90 FL OUT=917.70

GRAVEL

24" HDPE

18" HDPE

4" OAK

CLEARING & GRADING LIMITS

SILT FENCE

10' BUILDING LINE PER PLAT RECORDED IN BOOK____ PAGE____

SOI 10

INLET PROTECTION (TYP)

DI 9

TEMPORARY DIVERSION DIKE

CONCRETE WASHOUT

20'x50' TEMPORARY CONSTRUCTION ENTRANCE

S 0°46'40"E 61.79'

S 5°00'20"W 95.75'

CONSTRUCTION TRAILER

PORTABLE TOILET

CI 8

5

TOPSOIL STOCKPILE

110,478 SQ. FT. OR 2.54 ACRES

3200 NE WILSHIRE DRIVE

PROPOSED WILSHIRE DRIVE (60' R/W)

PROPOSED 15' UTILITY EASEMENT

4' WOVEN WIRE FENCE

1/4 1/4 SECTION LINE

10' UTILITY EASEMENT PER PLAT RECORDED IN BOOK____ PAGE____

4' DECORATIVE METAL FENCE

CONCRETE BLOCK RETAINING WALL

BOLLARD

90° PICP

N 2°05'20"E 330.00'

20' WATERLINE EASEMENT IN DOCUMENT NO. 1981I0450725 RECORDED IN BOOK 1 1086 PAGE 1736

CLEARING & GRADING LIMITS

20' BUILDING LINE PER PLAT RECORDED IN BOOK____ PAGE____

15' UTILITY EASEMENT PER PLAT RECORDED IN BOOK____ PAGE____

S 2°06'50"W 268.29'

S 2°06'50"W 228.97'

S 2°06'50"W 162.44'

9'x30'x21' RIP-RAP

INLET PROTECTION (TYP)

CI 7

N 87°54'40"W 335.00'

TOPSOIL STOCKPILE

CLEARING & GRADING LIMITS

N 87°54'40"W 330.00'

UP

UP W/ EM

1100 N

021000 N

P:\GENERAL PROJECTS\15925E-JES-WILSHIRE-HILLS-3-ENG\CAD\15925 EROSION.DWG 4/19/2024

Engineering Surveys & Services

DELIVERING YOUR VISION ™

1113 Fay Street, Columbia, MO 65201
573 - 449 - 2646

802 El Dorado Drive, Jefferson City, MO 65101
573-636-3303

1775 West Main Street, Sedalia, MO 65301
660-826-8818

www.ess-inc.com

MO Engineering Corp. # 2004005018

N

0 1"

SCALE: 1" = 20'

WILSHIRE HILLS PHASE III

STREET ADDRESS

LEE'S SUMMIT JACKSON COUNTY, MISSOURI

1/23/2024

STATE OF MISSOURI
MATTHEW AARON KRIETE
NUMBER PE-2007002811
PROFESSIONAL ENGINEER

MATTHEW A. KRIETE
PROFESSIONAL ENGINEER
PE-2007002811

IF ORIGINAL SIGNATURE OR DIGITAL AUTHENTICATION IS NOT PRESENT THIS MEDIA SHOULD NOT BE CONSIDERED A CERTIFIED DOCUMENT.

Date

JUNE 30, 2023

Revised

1 JANUARY 23, 2024

Design: ST Drawn: MJS

CONSTRUCTION DOCUMENTS

INITIAL EROSION CONTROL PLAN

Sheet

C9.01

ES&S PROJECT NO. 15925

OWNER: WILSHIRE PROPERTIES LLC

LOT 4A WILSHIRE HILLS – 3RD PLAT RECORDED IN DOC. NO. 2016E022915 IN BOOK 161 PAGE 43–46

S 87°54'40"E 332.03'

N 0°46'40"W 40.65'

S 87°54'40"E 60.00'

30.0'

30.0'

N 2°05'20"E 18.05'

S 0°46'40"E 61.79'

S 5°00'20"W 95.75'

CLEARING & GRADING LIMITS

10' BUILDING LINE PER PLAT RECORDED IN BOOK ____ PAGE ____

SILT FENCE

INLET PROTECTION (TYP)

110,478 SQ. FT. OR 2.54 ACRES

3200 NE WILSHIRE DRIVE

1 STORY BRICK

MANHOLE TOP=929.97 FL IN=922.02 FL OUT=922.02

INLET TOP=927.81 FL IN=925.56 FL OUT=925.04

INLET TOP=927.82 FL IN=923.66 FL OUT=923.68

TULIP CLUSTER

12" PVC

CONCRETE SIDEWALK

CONCRETE W/ CURB & GUTTER

4" OAK

24" HDPE

18" HDPE

JUNCTION BOX TOP=928.30 FL IN(E)=916.70 FL IN(W)=920.3 FL OUT=916.50

MANHOLE TOP=923.83 FL IN=912.71 FL IN=912.71 FL OUT=912.65

JUNCTION BOX TOP=928.00 FL IN=917.90 FL OUT=917.70

GRAVEL

4" WOVEN WIRE FENCE

4' DECORATIVE METAL FENCE

CONCRETE BLOCK RETAINING WALL

1/4 1/4 SECTION LINE

10' UTILITY EASEMENT PER PLAT RECORDED IN BOOK ____ PAGE ____

BOLLARD

90° PICKP

CP12995

1100 N

330.00'

N 2°05'20"E 330.00'

OWNER: RTC REAL ESTATE LLC & EXCEL HOLDINGS LLC

20' WATERLINE EASEMENT IN DOCUMENT NO. 1981004507?5 RECORDED IN BOOK I 1066 PAGE 1736

CLEARING & GRADING LIMITS

20' BUILDING LINE PER PLAT RECORDED IN BOOK ____ PAGE ____

021000 N

3-STORY 50 UNITS FF=937.00

MAINT. SHED FF=935.50

1ST, 2ND, 3RD

1ST, 2ND

CP11991

CP10741

CP16191

CREST

PROPOSED 15' UTILITY EASEMENT

PROPOSED WILSHIRE DRIVE (60' R/W)

S 2°06'50"W 228.97'

15' UTILITY EASEMENT PER PLAT RECORDED IN BOOK ____ PAGE ____

S 2°06'50"W 162.44'

9'x30'x21' RIP-RAP

N 87°54'40"W 335.00'

S 2°06'50"W 268.29'

20' BUILDING LINE PER PLAT RECORDED IN BOOK ____ PAGE ____

10' BUILDING LINE PER PLAT RECORDED IN BOOK ____ PAGE ____

CLEARING & GRADING LIMITS

N 87°54

0 1"

SCALE: 1" = 20'

P:\GENERAL PROJECTS\15925E—ES—WILSHIRE—HILLS—3—ENG\CAD\15925 EROSION.DWG 4/19/2024

CONSTRUCTION DOCUMENTS

Engineering Surveys & Services

DELIVERING YOUR VISION ™

1113 Fay Street, Columbia, MO 65201
573 - 449 - 2646

802 El Dorado Drive, Jefferson City, MO 65101
573-636-3303

1775 West Main Street, Sedalia, MO 65301
660-826-8818

www.ess-inc.com

MO Engineering Corp. # 2004005018

WILSHIRE HILLS PHASE III

STREET ADDRESS

LEE'S SUMMIT JACKSON COUNTY, MISSOURI

4/17/2024

STATE OF MISSOURI
MATTHEW AARON KRIETE
NUMBER PE-2007002811
PROFESSIONAL ENGINEER

MATTHEW A. KRIETE
PROFESSIONAL ENGINEER
PE-2007002811

IF ORIGINAL SIGNATURE OR DIGITAL AUTHENTICATION IS NOT PRESENT THIS MEDIA SHOULD NOT BE CONSIDERED A CERTIFIED DOCUMENT.

Date

JUNE 30, 2023

Revised

1 JANUARY 23, 2024

2 APRIL 17, 2024

Design: ST Drawn: MJS

FINAL EROSION CONTROL PLAN

Sheet

C9.02

ES&S PROJECT NO. 15925

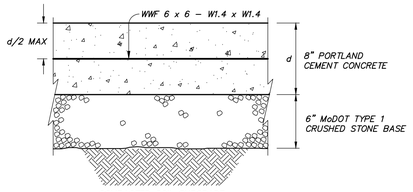

NOTE: TOP OF REINFORCEMENT SHALL BE A MINIMUM OF 2" BELOW THE TOP OF PAVEMENT.

HEAVY DUTY CONCRETE PAVEMENT

NOT TO SCALE

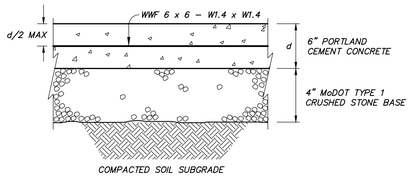

NOTE: TOP OF REINFORCEMENT SHALL BE A MINIMUM OF 2" BELOW THE TOP OF PAVEMENT.

STANDARD DUTY CONCRETE PAVEMENT

NOT TO SCALE

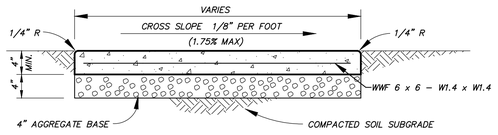

NOTES:
1. SIDEWALK SHALL BE 5–8% AIR–ENTRAINED, 6 BAG MIX, 4,000 PSI PORTLAND CEMENT CONCRETE.
2. INSTALL TRANSVERSE EXPANSION JOINTS TO MATCH STREET OR CURB AND GUTTER EXPANSION JOINTS AND AT ALL DRIVEWAY APPROACHES, FIXED STRUCTURES, BUILDINGS, AND SIDEWALK RAMPS. SPACING SHALL NOT EXCEED 50'.
3. FOR SIDEWALKS UP TO 6 FT. WIDE, INSTALL TRANSVERSE SAW–CUT JOINTS AT SPACING EQUAL TO SIDEWALK WIDTH.
4. FOR SIDEWALKS WIDER THAN 6 FT., INSTALL LONGITUDINAL SAW JOINT AT CENTERLINE OR AT A SPACING NOT TO EXCEED 5 FT. TRANSVERSE SAW–CUT JOINT SPACING EQUAL TO HALF SIDEWALK WIDTH.
5. IF SIDEWALK IS REINFORCED, NO STEEL SHALL BE PLACED THROUGH AN EXPANSION JOINT.
6. SEE SEPARATE DETAIL FOR ADDITIONAL CONCRETE JOINT REQUIREMENTS.

CONCRETE SIDEWALK

NOT TO SCALE

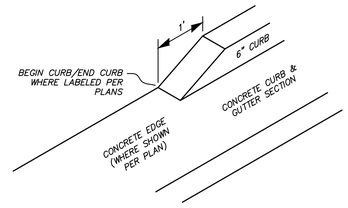

BEGIN CURB / END CURB DETAIL

NOT TO SCALE

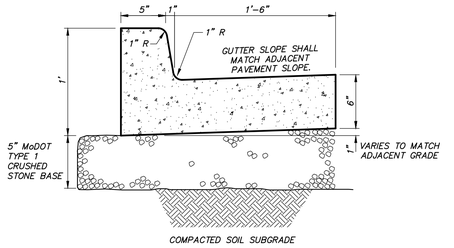

NOTES:
1. CURB AND GUTTER MAY BE INTEGRAL IF CONCRETE PAVEMENT IS USED.
2. INSTALL TRANSVERSE EXPANSION JOINTS TO MATCH ADJACENT PAVEMENT,OR AT EVERY 150' MAX.
3. INSTALL SAW–CUT JOINTS TO MATCH ADJACENT PAVEMENT OR EVERY 10' MAX.
4. SAW–CUT JOINTS SHALL EXTEND THROUGH THE ENTIRE CURB SECTION FROM THE TOP OF CURB TO A DEPTH OF 2" BELOW THE GUTTER SURFACE.

6" CONCRETE CURB & GUTTER SECTION

NOT TO SCALE

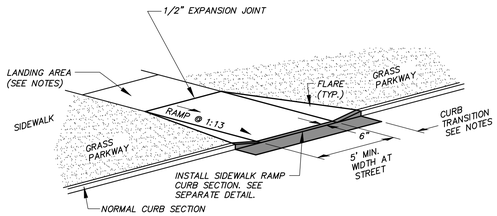

NOTES:
1. RAMP SHALL BE 4" THICK P.C.C.
2. EXPANSION JOINT SHALL BE 1/2" PREFORMED CORK OR BITUMINOUS EXPANSION JOINT MATERIAL.
3. ALL SLOPES ARE MEASURED FROM THE HORIZONTAL.
4. REPLACE STANDARD CURB SECTION WITH SIDEWALK RAMP CURB SECTION – SEE SEPARATE DETAIL.
5. RAMP LENGTH IS DEPENDENT ON 1:13 MAX SLOPE. USE FLATTER WHEN POSSIBLE.
6. LANDING AREA SHALL BE 4'–0" MIN WIDTH, CROSS SLOPE OF LANDING SHALL NOT EXCEED 1.7%.
7. FLARES ARE REQUIRED AT RAMPS TO KEEP GRASS PARKWAY SLOPES IN CONFORMANCE WITH THE TYPICAL CROSS SECTION.
8. CURB TRANSITION LENGTH IS DEPENDENT ON FLARE SLOPE.
9. MAXIMUM RAMP CROSS SLOPE IS 1.7% IN ALL DIRECTIONS.

PERPENDICULAR CURB RAMP

NOT TO SCALE

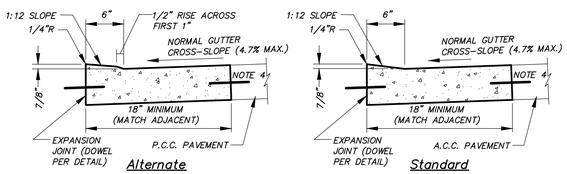

NOTES:
1. CONCRETE THICKNESS AND BASE SHALL MATCH ADJACENT CONCRETE PAVEMENT OR ADJACENT CURB AND GUTTER.
2. EXPANSION JOINTS AND CONTRACTION JOINTS SHALL BE PLACED AT LOCATIONS SIMILAR TO THE ADJACENT PAVEMENT AND CURB & GUTTER.
3. CURB EDGE SHALL BE TOOLED WITH 1/4" RADIUS.
4. WHERE PAVEMENT IS P.C.C. DOWEL USING 12" LONG #4 BARS AT 24" CTRS.

SIDEWALK RAMP CURB

NOT TO SCALE

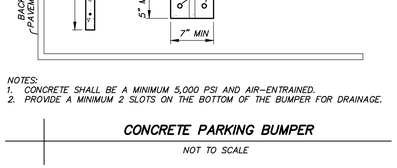

NOTES:
1. CONCRETE SHALL BE A MINIMUM 5,000 PSI AND AIR–ENTRAINED.
2. PROVIDE A MINIMUM 2 SLOTS ON THE BOTTOM OF THE BUMPER FOR DRAINAGE.

CONCRETE PARKING BUMPER

NOT TO SCALE

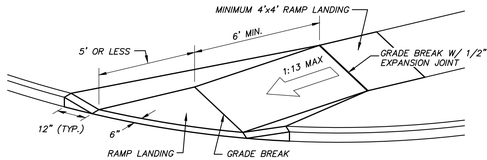

CONDITION 1

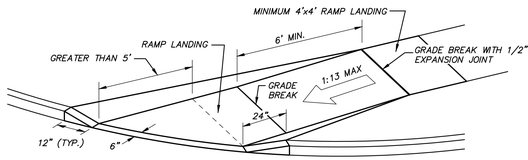

CONDITION 2

NOTES:
1. RAMP SHALL BE 4" THICK PORTLAND CEMENT CONCRETE – SEE SPECS.
2. EXPANSION JOINTS SHALL BE 1/2" PREFORMED CORK OR BITUMINOUS EXPANSION JOINT MATERIAL.
3. MAXIMUM RAMP CROSS SLOPE IS 1.7%.
4. MAXIMUM RAMP LONGITUDINAL SLOPE IS 1:13. USE A FLATTER RAMP SLOPE WHEN POSSIBLE.
5. RAMP LANDING SLOPE SHALL NOT EXCEED 1.7% IN ALL DIRECTIONS.

SKEW / RADIAL CURB RAMPS

NOT TO SCALE

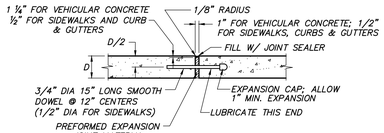

EXPANSION JOINT

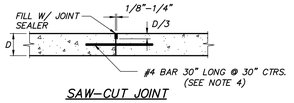

SAW–CUT JOINT

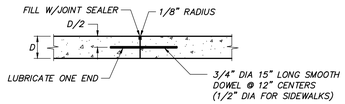

CONSTRUCTION JOINT

NOTES:
1. PRIOR TO CONSTRUCTION, CONTRACTOR SHALL SUBMIT A PAVEMENT JOINT PLAN OF ALL CONCRETE PAVEMENT FOR APPROVAL.
2. CONCRETE PAVEMENT SHALL HAVE SAW–CUT OR CONSTRUCTION JOINTS EVERY 10 FEET FOR 4 INCH THICK PAVEMENT, 12 FEET FOR 5 INCH THICK PAVEMENT, AND 15 FEET FOR 6 INCH THICK PAVEMENT OR GREATER. PANELS SHALL BE CUT SUCH THAT PANELS ARE NEARLY SQUARE AND DO NOT EXCEED 100 SQUARE FEET IN AREA OR 1.4 LENGTH TO WIDTH RATIO. EXPANSION JOINTS SHALL BE PROVIDED AT ALL FIXED STRUCTURES, SUCH AS; LIGHT STANDARD FOUNDATIONS, SEWER STRUCTURES, BUILDINGS, WALLS, BOTTOM OF STAIRS, ROOF DRAINS, ETC., AND EVERY 100 FEET MAXIMUM. DOWEL BARS SHALL BE PROVIDED AT TRANSVERSE JOINTS IN ALL HEAVY DUTY PAVEMENT DRIVE AISLES.
3. THIS DETAIL APPLIES TO ALL CONCRETE PAVEMENT FOR PARKING LOTS, DRIVE/ACCESS AISLES, CURBS & GUTTERS, AND SIDEWALKS.
4. INCLUDE BAR WITH TRANSVERSE SAW–CUT JOINTS FOR HEAVY DUTY PAVEMENT. OMIT BAR WITH SAW–CUT JOINTS FOR STANDARD DUTY PAVEMENT AND SIDEWALKS.
5. PROVIDE CONSTRUCTION JOINT AT END OF DAYS WORK OR IF CONCRETE PLACEMENT IS SUSPENDED FOR MORE THAN 30 MINUTES.
6. SAW–CUT JOINTS SHALL BE CUT WITHIN 12 HOURS OF INITIAL SET OF CONCRETE. RAVELED JOINTS WILL NOT BE ACCEPTED.
7. ELASTOMERIC POLYURETHANE OR SILICONE JOINT SEALANT IS REQUIRED FOR ALL JOINTS AND SHALL BE LIGHT GRAY IN COLOR.
8. OMIT DOWEL BARS FOR EXPANSION JOINTS AT BUILDINGS, LIGHT STANDARDS, AND ROOF DRAINS.

CONCRETE PAVEMENT JOINTS

NOT TO SCALE

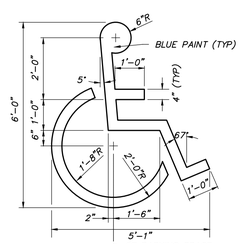

ACCESSIBLE SYMBOL FOR PARKING SPACES

NO SCALE

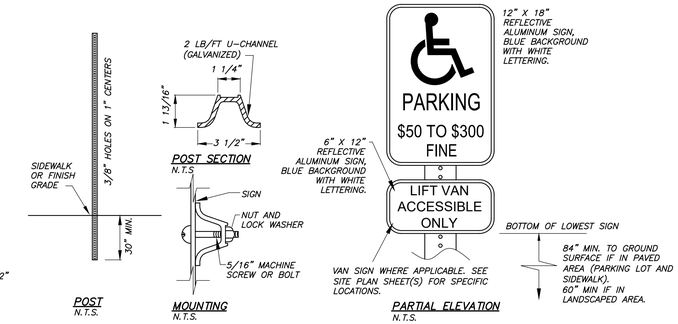

NOTES:
1. SEE SITE PLAN SHEET(S) FOR SIGN LOCATIONS.
2. ALL SIGNS SHALL BE 0.80 ENGINEER GRADE REFLECTIVE ALUMINUM.

ACCESSIBLE PARKING STALL SIGNAGE

NOT TO SCALE

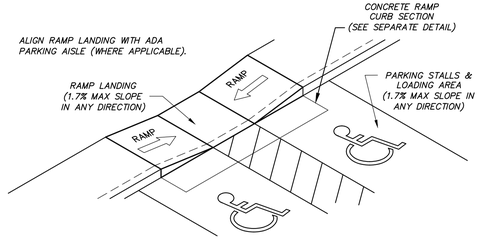

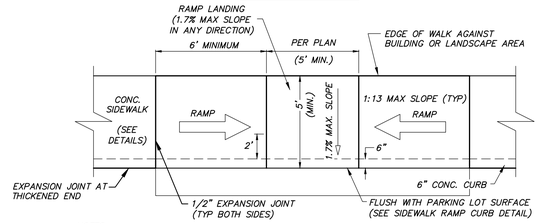

NOTES:
1. RAMP SHALL BE 4" THICK PORTLAND CEMENT CONCRETE – SEE SPECS.
2. EXPANSION JOINT SHALL BE 1/2" PREFORMED CORK OR BITUMINOUS EXPANSION JOINT MATERIAL.
3. MAXIMUM RAMP CROSS SLOPE IS 1.7%.
4. MAXIMUM RAMP LONGITUDINAL SLOPE IS 1:13. USE A FLATTER RAMP SLOPE WHEN POSSIBLE.
5. RAMP LANDING SLOPE SHALL NOT EXCEED 1.7% IN ALL DIRECTIONS.

PARALLEL CURB RAMP

NOT TO SCALE

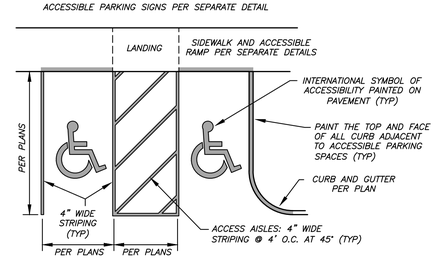

NOTES:
1. ALL ACCESSIBLE STRIPING SHALL BE BLUE RETROREFLECTIVE.
2. ALL PAVEMENT WITHIN ACCESSIBLE PARKING AREAS SHALL BE AT 1.7% OR LESS SLOPE IN ALL DIRECTIONS.

ACCESSIBLE PARKING STALL STRIPING (MISSOURI)

NOT TO SCALE

Engineering Surveys & Services
DELIVERING YOUR VISION ™
1113 Fay Street, Columbia, MO 65201
573 - 449 - 2646
802 El Dorado Drive, Jefferson City, MO 65101
573-636-3303
1775 West Main Street, Sedalia, MO 65301
660-826-6618
www.ess-inc.com
MO Engineering Corp. # 2004005018

WILSHIRE HILLS PHASE III

3200 NE WILSHIRE DR
LEE'S SUMMIT, JACKSON COUNTY, MISSOURI

6/30/2023

STATE OF MISSOURI
MATTHEW AARON KRIETE
NUMBER PE-2007002811
PROFESSIONAL ENGINEER

MATTHEW A. KRIETE
PROFESSIONAL ENGINEER
PE-2007002811

IF ORIGINAL SIGNATURE OR DIGITAL AUTHENTICATION IS NOT PRESENT THIS MEDIA SHOULD NOT BE CONSIDERED A CERTIFIED DOCUMENT.

Date
JUNE 30, 2023

Revised

Design: ST Drawn: MJS

SITE DETAILS

Sheet
C10.01

ES&S PROJECT NO. 15925

CONSTRUCTION DOCUMENTS

P:\GENERAL PROJECTS\15925E–JES–WILSHIRE–HILLS–3–ENG\CAD\15925 COVER & DETAILS.DWG 6/30/2023

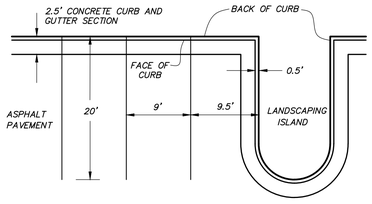

ASPHALT PAVEMENT

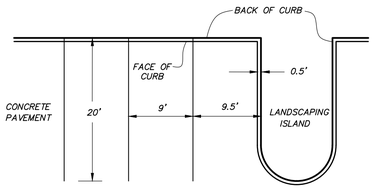

CONCRETE PAVEMENT

TYPICAL PARKING STALL DETAIL

NOT TO SCALE

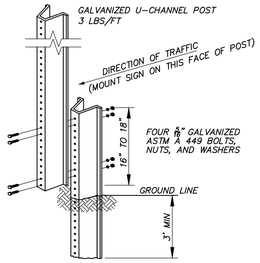

NOTES:
1. STUB HEIGHT AND SPLICE LAP SHALL BE 16" TO 18".
2. SPLICE SHALL NOT EXTEND BELOW THE GROUND.
3. ONLY ONE SPLICE WILL BE ALLOWED PER POST.
4. USE OF SPLICE IS OPTIONAL.
5. SIGNS SHALL BE 7' MIN. FROM FINISH GRADE TO BOTTOM OF LOWEST MOUNTED SIGN.

SIGN POST DETAIL

NOT TO SCALE

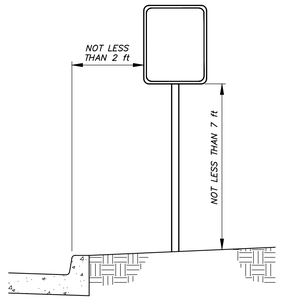

URBAN ROADSIDE SIGN LOCATION

NOT TO SCALE

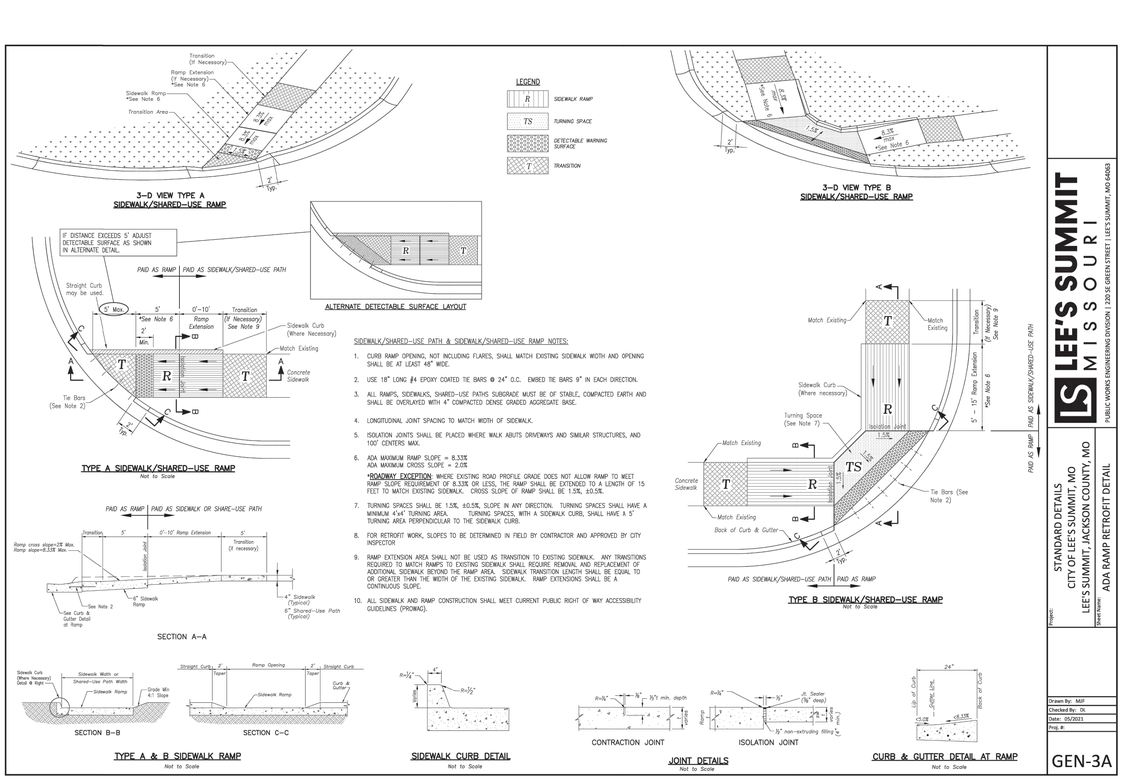

GEN-3A

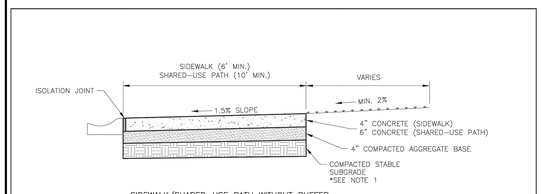

SIDEWALK/SHARED-USE PATH WITHOUT BUFFER
NOT TO SCALE

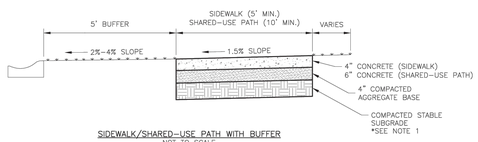

SIDEWALK/SHARED-USE PATH WITH BUFFER
NOT TO SCALE

GENERAL NOTES:
1. SUBGRADE MUST BE OF STABLE, COMPACTED EARTH AND SHALL BE OVERLAYED WITH 4" COMPACTED DENSE GRADED AGGREGATE BASE.
2. 1.5% CROSS SLOPE MUST BE MAINTAINED THROUGH DRIVEWAYS.
3. KCMMB 4K CONCRETE MIX SHALL BE REQUIRED FOR ALL SIDEWALKS/SHARED-USE PATHS.
4. ALL SIDEWALK/SHARED-USE PATHS SHALL MEET CURRENT PUBLIC RIGHT OF WAY ACCESSIBILITY GUIDELINES (PROWAG).
5. AN ISOLATION JOINT SHALL BE PLACED AT A MAXIMUM OF 100 FT. CONSTRUCTION JOINTS SHALL BE PLACED THE SAME WIDTH OF SIDEWALK/SHARED-USE PATHS, BUT NO GREATER THAN 10 FT.
6. AN ISOLATION JOINT SHALL BE PLACED WHERE THE SIDEWALK/SHARED-USE PATHS MEETS A RESIDENTIAL DRIVEWAY.
7. SHARED-USE PATHS WIDTH SHALL BE 10 FT. WIDE.
8. SIDEWALK/SHARED-USE PATHS FINISHING SHALL BE FULL BROOM FINISH OR AS DIRECTED BY CITY INSPECTOR.
9. WHITE CURING COMPOUND MUST BE APPLIED UNIFORMLY TO THE CONCRETE SURFACE IMMEDIATELY AFTER FINAL FINISHING.

LEE'S SUMMIT MISSOURI
PUBLIC WORKS ENGINEERING DIVISION | 220 SE GREEN STREET | LEE'S SUMMIT, MO 64063
SIDEWALK/SHARED-USE PATH DETAIL
Date: 05/2021 | Drawn By: MJF | Checked By: DL
GEN-2

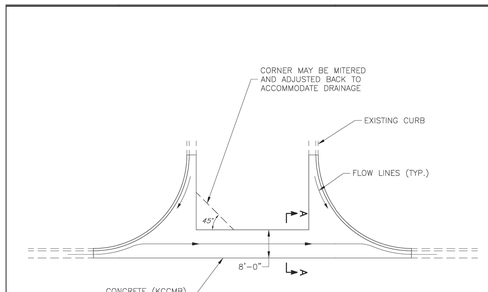

SECTION

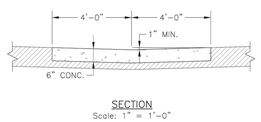

SECTION
Scale: 1" = 1'-0"

VALLEY GUTTER DETAIL
Intersection of Two Public Streets

LEE'S SUMMIT MISSOURI
PUBLIC WORKS ENGINEERING DIVISION | 220 SE GREEN STREET | LEE'S SUMMIT, MO 64063
VALLEY GUTTER DETAIL
Date: 05/2021 | Drawn By: MJF | Checked By: DL
GEN-7

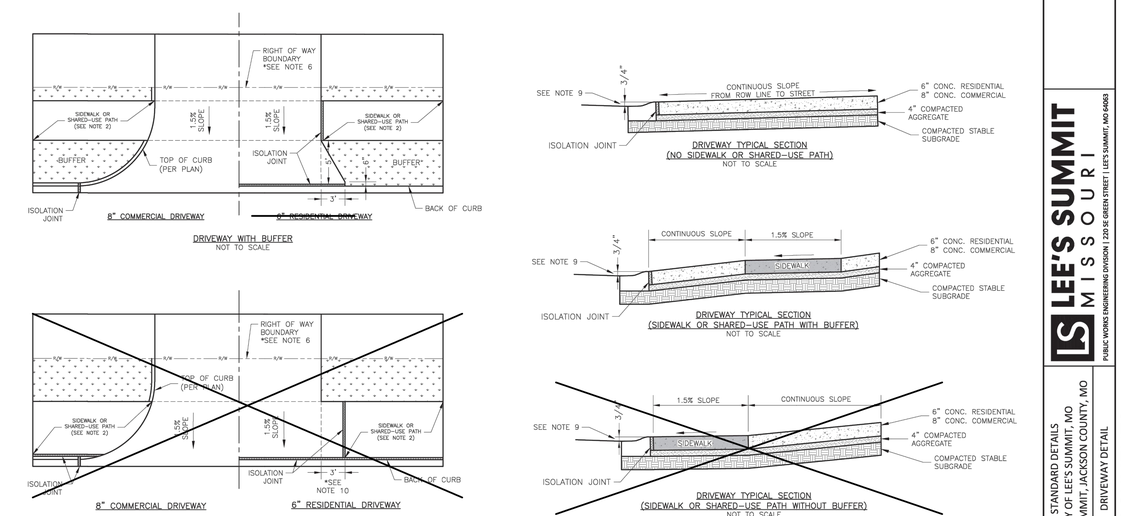

GENERAL NOTES
1. SUBGRADE SHALL BE STABLE, COMPACTED EARTH AND SHALL BE OVERLAYED WITH 4" COMPACTED DENSE GRADED AGGREGATE BASE.
2. ALL DRIVE APPROACHES SHALL MEET CURRENT PUBLIC RIGHT OF WAY ACCESSIBILITY GUIDELINES (PROWAG) FOR SLOPE REQUIREMENTS WHEN SIDEWALK IS REQUIRED (SEE ADA RAMP RETROFIT DETAIL GEN-3B, SIDEWALK/SHARED USE PATH RAMP AT DRIVEWAY DETAIL).
3. JOINT AT BACK OF CURB LINE SHALL BE AN ISOLATION JOINT FOR RESIDENTIAL DRIVEWAYS.
4. KCMMB 4K CONCRETE MIX IS REQUIRED FOR ALL CURBS.
5. COMMERCIAL DRIVEWAYS, IN THE PUBLIC RIGHT OF WAY, SHALL BE KCMMB 4K CONCRETE MIX.
6. RESIDENTIAL DRIVEWAYS, IN THE PUBLIC RIGHT OF WAY, KCMMB 4K CONCRETE MIX IS RECOMMENDED. OTHER CONCRETE MIXES NEED TO BE APPROVED BY CITY INSPECTOR.
7. A JOINT MUST BE INSTALLED AT THE RIGHT OF WAY BOUNDARY FOR PROPERTY DELINEATION.
8. WHITE CURING COMPOUND MUST BE APPLIED UNIFORMLY TO THE CONCRETE SURFACE IMMEDIATELY AFTER FINAL FINISHING.
9. ¾" FROM TOP OF CURB TO FLOWLINE AT DRIVEWAY (TYPE CG-1 CURB ONLY). MUST MAINTAIN ORIGINAL FLOWLINE OF CURB.
10. SIDEWALK ADJOINING CURB SHALL BE 6" THICK, EXTENDING 3' FROM THE DRIVEWAY.
11. THE MAXIMUM WIDTH OF A RESIDENTIAL DRIVEWAY IS 36 FEET WITHIN THE RIGHT OF WAY.

LEE'S SUMMIT MISSOURI
PUBLIC WORKS ENGINEERING DIVISION | 220 SE GREEN STREET | LEE'S SUMMIT, MO 64063
STANDARD DETAILS
CITY OF LEE'S SUMMIT, MO
LEE'S SUMMIT, JACKSON COUNTY, MO
Project:
Sheet Name: DRIVEWAY DETAIL
Drawn By: MJF | Checked By: DL | Date: 05/2021 | Proj. #:
GEN-1

CONSTRUCTION DOCUMENTS

Engineering Surveys & Services
DELIVERING YOUR VISION ™
1113 Fay Street, Columbia, MO 65201
573 - 449 - 2646
802 El Dorado Drive, Jefferson City, MO 65101
573-636-3303
1775 West Main Street, Sedalia, MO 65301
660-826-8818
www.ess-inc.com
MO Engineering Corp. # 2004005018

WILSHIRE HILLS PHASE III

3200 NE WILSHIRE DR
LEE'S SUMMIT, JACKSON COUNTY, MISSOURI

6/30/2023
STATE OF MISSOURI
MATTHEW AARON KRIETE
NUMBER PE-2007002811
PROFESSIONAL ENGINEER

MATTHEW A. KRIETE
PROFESSIONAL ENGINEER
PE-2007002811

IF ORIGINAL SIGNATURE OR DIGITAL AUTHENTICATION IS NOT PRESENT THIS MEDIA SHOULD NOT BE CONSIDERED A CERTIFIED DOCUMENT.

Date
JUNE 30, 2023

Revised

Design: ST Drawn: MJS

SITE DETAILS

Sheet
C10.02

ES&S PROJECT NO. 15925

P:\GENERAL PROJECTS\15925E-JES-WILSHIRE-HILLS-3-ENG\CAD\15925 COVER & DETAILS.DWG 6/30/2023

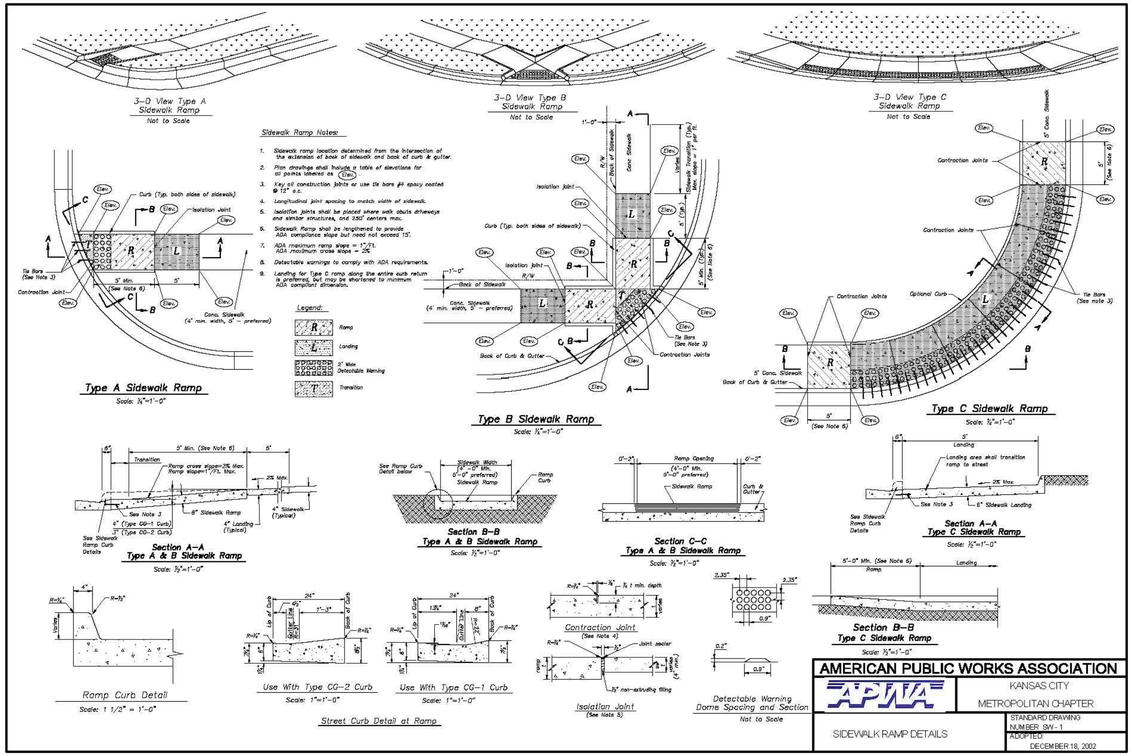

AMERICAN PUBLIC WORKS ASSOCIATION
APWA KANSAS CITY METROPOLITAN CHAPTER
SIDEWALK RAMP DETAILS
STANDARD DRAWING NUMBER SW-1
ADOPTED: DECEMBER 18, 2002

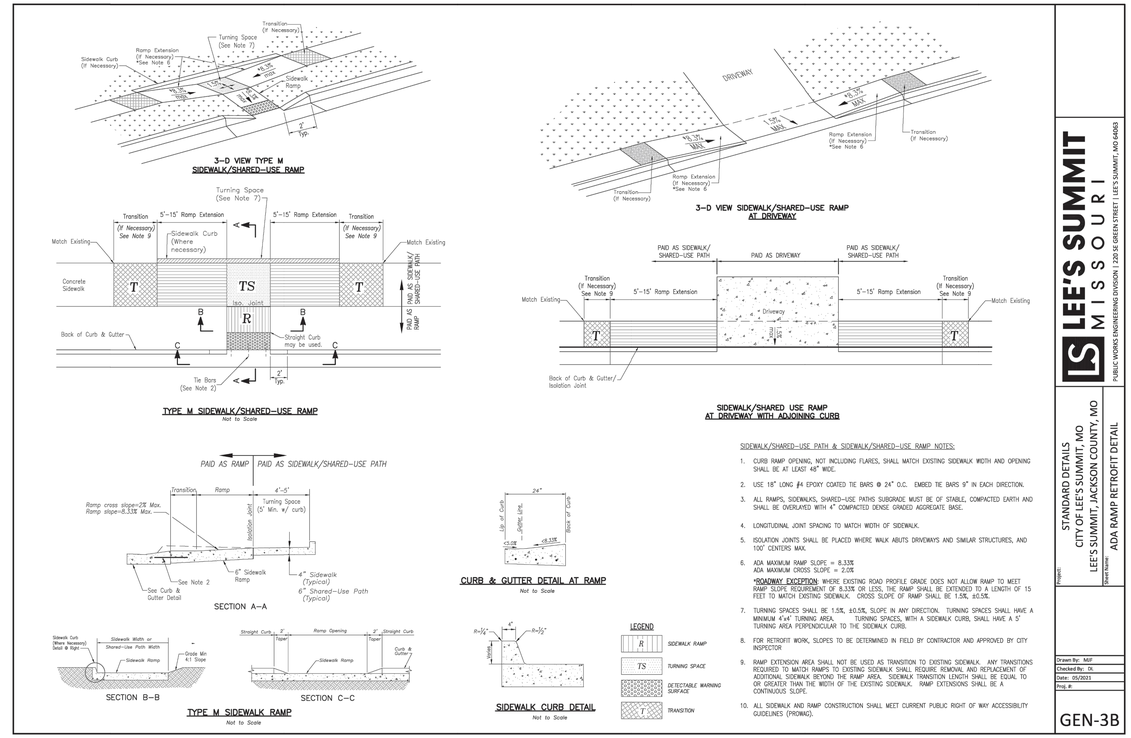

SIDEWALK/SHARED-USE PATH & SIDEWALK/SHARED-USE RAMP NOTES:

1. CURB RAMP OPENING, NOT INCLUDING FLARES, SHALL MATCH EXISTING SIDEWALK WIDTH AND OPENING SHALL BE AT LEAST 48" WIDE.
2. USE 18" LONG #4 EPOXY COATED TIE BARS @ 24" O.C. EMBED TIE BARS 9" IN EACH DIRECTION.
3. ALL RAMPS, SIDEWALKS, SHARED-USE PATHS SUBGRADE MUST BE OF STABLE, COMPACTED EARTH AND SHALL BE OVERLAYED WITH 4" COMPACTED DENSE GRADED AGGREGATE BASE.
4. LONGITUDINAL JOINT SPACING TO MATCH WIDTH OF SIDEWALK.
5. ISOLATION JOINTS SHALL BE PLACED WHERE WALK ABUTS DRIVEWAYS AND SIMILAR STRUCTURES, AND 100' CENTERS MAX.
6. ADA MAXIMUM RAMP SLOPE = 8.33%
ADA MAXIMUM CROSS SLOPE = 2.0%
*ROADWAY EXCEPTION: WHERE EXISTING ROAD PROFILE GRADE DOES NOT ALLOW RAMP TO MEET RAMP SLOPE REQUIREMENT OF 8.33% OR LESS, THE RAMP SHALL BE EXTENDED TO A LENGTH OF 15 FEET TO MATCH EXISTING SIDEWALK. CROSS SLOPE OF RAMP SHALL BE 1.5%, ±0.5%.
7. TURNING SPACES SHALL BE 1.5%, ±0.5%, SLOPE IN ANY DIRECTION. TURNING SPACES SHALL HAVE A MINIMUM 4'x4' TURNING AREA. TURNING SPACES, WITH A SIDEWALK CURB, SHALL HAVE A 5' TURNING AREA PERPENDICULAR TO THE SIDEWALK CURB.
8. FOR RETROFIT WORK, SLOPES TO BE DETERMINED IN FIELD BY CONTRACTOR AND APPROVED BY CITY INSPECTOR
9. RAMP EXTENSION AREA SHALL NOT BE USED AS TRANSITION TO EXISTING SIDEWALK. ANY TRANSITIONS REQUIRED TO MATCH RAMPS TO EXISTING SIDEWALK SHALL REQUIRE REMOVAL AND REPLACEMENT OF ADDITIONAL SIDEWALK BEYOND THE RAMP AREA. SIDEWALK TRANSITION LENGTH SHALL BE EQUAL TO OR GREATER THAN THE WIDTH OF THE EXISTING SIDEWALK. RAMP EXTENSIONS SHALL BE A CONTINUOUS SLOPE.
10. ALL SIDEWALK AND RAMP CONSTRUCTION SHALL MEET CURRENT PUBLIC RIGHT OF WAY ACCESSIBILITY GUIDELINES (PROWAG).

LEE'S SUMMIT MISSOURI
PUBLIC WORKS ENGINEERING DIVISION | 220 SE GREEN STREET | LEE'S SUMMIT, MO 64063

Project: STANDARD DETAILS CITY OF LEE'S SUMMIT, MO LEE'S SUMMIT, JACKSON COUNTY, MO
Sheet Name: ADA RAMP RETROFIT DETAIL

Drawn By: AGF
Checked By: DL
Date: 05/2023
Proj. #:

GEN-3B

Engineering Surveys & Services
DELIVERING YOUR VISION ™
1113 Fay Street, Columbia, MO 65201
573 - 449 - 2646
802 El Dorado Drive, Jefferson City, MO 65101
573-636-3303
1775 West Main Street, Sedalia, MO 65301
660-826-8618
www.ess-inc.com
MO Engineering Corp. # 2004005018

WILSHIRE HILLS PHASE III

3200 NE WILSHIRE DR

LEE'S SUMMIT, JACKSON COUNTY, MISSOURI

CONSTRUCTION DOCUMENTS

6/30/2023

STATE OF MISSOURI
MATTHEW AARON KRIETE
NUMBER PE-2007002811
PROFESSIONAL ENGINEER

MATTHEW A. KRIETE
PROFESSIONAL ENGINEER
PE-2007002811

IF ORIGINAL SIGNATURE OR DIGITAL AUTHENTICATION IS NOT PRESENT THIS MEDIA SHOULD NOT BE CONSIDERED A CERTIFIED DOCUMENT.

Date
JUNE 30, 2023

Revised

Design: ST Drawn: MJS

SITE DETAILS

Sheet
C10.03

ES&S PROJECT NO. 15925

P:\GENERAL PROJECTS\15925E-JES-WILSHIRE-HILLS-3-ENG\CAD\15925 COVER & DETAILS.DWG 6/30/2023

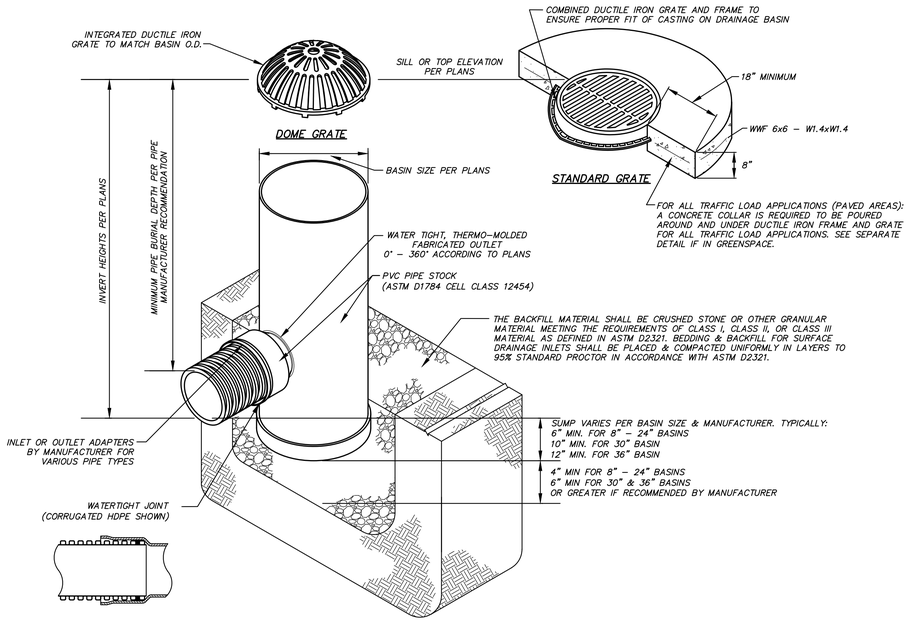

NOTES:
1. ALL CONNECTIONS SHALL BE WATERTIGHT.
2. SEE PLANS FOR GRATE TYPE FOR EACH BASIN.
3. ALL FRAMES & GRATES SHALL BE DUCTILE IRON PER ASTM A536 GRADE 70-50-05, OR 80-55-06.
4. ALL STANDARD OR SOLID GRATES SHALL BE MEET H-20 LOAD RATING. DOME GRATES HAVE NO LOAD RATING.
5. DRAIN BASINS SHALL BE CUSTOM MANUFACTURED AS A SINGLE UNIT ACCORDING TO PLAN DIMENSIONS. RISERS SHALL NOT BE ALLOWED WITHOUT PRIOR APPROVAL BY ENGINEER.
6. DRAINAGE CONNECTION STUB JOINT TIGHTNESS SHALL CONFORM TO ASTM D3212 FOR CORRUGATED HDPE & PVC PIPE.
7. STORM INLET TOP/GRATE SHALL BE LABELED TO DISCOURAGE DUMPING OF POLLUTANTS TO WATERWAY.

PVC DRAIN BASIN & GRATE

NOT TO SCALE

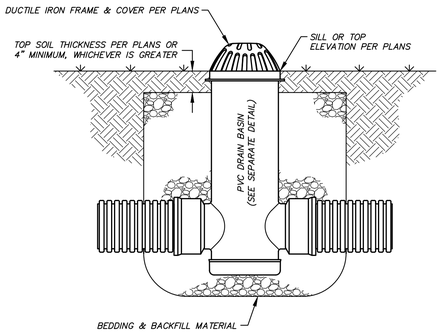

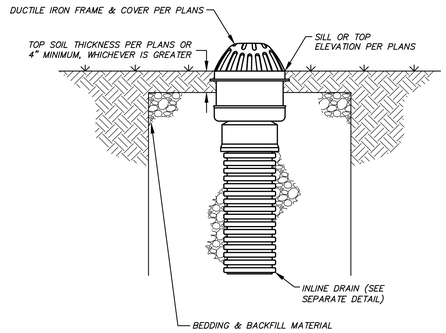

NOTES:
1. THE BEDDING & BACKFILL MATERIAL SHALL BE CRUSHED STONE OR OTHER GRANULAR MATERIAL MEETING THE REQUIREMENTS OF CLASS I, CLASS II, OR CLASS III MATERIAL AS DEFINED IN ASTM D2321. ALL BEDDING & BACKFILL SHALL BE PLACED & COMPACTED UNIFORMLY IN LIFTS TO 95% STANDARD PROCTOR IN ACCORDANCE WITH ASTM D2321.
2. STORM INLET TOP/GRATE SHALL BE LABELED TO DISCOURAGE DUMPING OF POLLUTANTS TO WATERWAY.

PVC BASIN/DRAIN INSTALLATION FOR NON-TRAFFIC/GREENSPACE AREAS ONLY

NOT TO SCALE

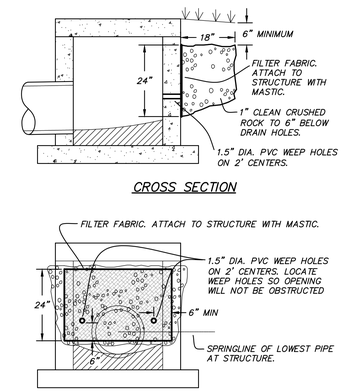

NOTES:
1. PLACE WEEP HOLES ON UPSTREAM FACE OF ALL STRUCTURES AND ALSO ON PAVEMENT FACE OF CURB INLET STRUCTURES.
2. WEEP HOLE FILTER FABRIC SHALL CONSIST OF A NON WOVEN, POLYPROPYLENE TYPE FABRIC SUCH AS: TENCATE MIRAFI 180N, GEOTEX 801, OR APPROVED EQUAL.

WEEP HOLES FOR CONCRETE STORM SEWER STRUCTURES

NOT TO SCALE

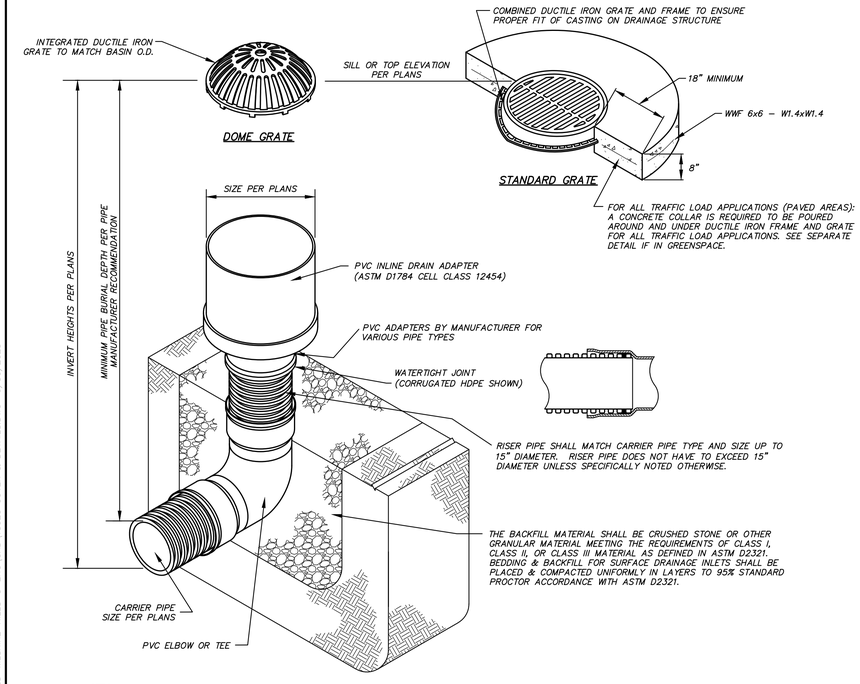

NOTES:
1. ALL CONNECTIONS SHALL BE WATERTIGHT.
2. SEE PLANS FOR GRATE TYPE FOR EACH DRAIN.
3. ALL FRAMES & GRATES SHALL BE DUCTILE IRON PER ASTM A536 GRADE 70-50-05, OR 80-55-06.
4. ALL STANDARD OR SOLID GRATES SHALL BE MEET H-20 LOAD RATING. DOME GRATES HAVE NO LOAD RATING.
5. DRAIN ADAPTER SHALL BE CUSTOM MANUFACTURED AS A SINGLE UNIT ACCORDING TO PLAN DIMENSIONS. RISERS SHALL NOT BE ALLOWED WITHOUT PRIOR APPROVAL BY ENGINEER.
6. DRAINAGE CONNECTION STUB JOINT TIGHTNESS SHALL CONFORM TO ASTM D3212 FOR CORRUGATED HDPE & PVC PIPE.
7. STORM INLET TOP/GRATE SHALL BE LABELED TO DISCOURAGE DUMPING OF POLLUTANTS TO WATERWAY.

PVC INLINE DRAIN & GRATE

NOT TO SCALE

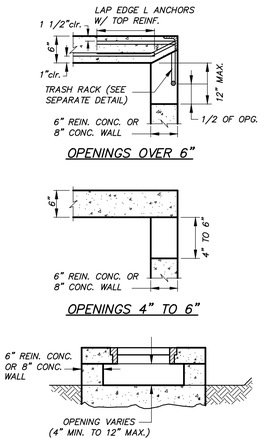

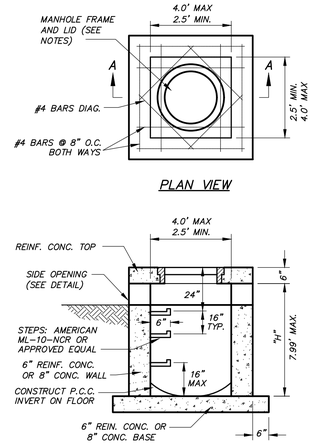

NOTES:
1. CONCRETE SHALL BE 4,000 PSI AT 28 DAYS WITH 6% AIR.
2. REINFORCING STEEL SHALL BE GRADE 60.
3. INSTALL WEEP HOLES PER SEPARATE DETAIL.
4. REINFORCED CONCRETE SHALL BE #4 BARS AT 12" CTRS, BOTH WAYS AND #4 BARS DIAGONAL AT PIPE OPENINGS.
5. FRAME AND LID SHALL BE NEENAH R-1960-A (TYPE C LID), DEETER 1180, OR APPROVED EQUAL.
6. SIDE OPENINGS SHALL BE 6" HIGH ON ALL FOUR SIDES UNLESS NOTED OTHERWISE.
7. INSTALL TRASH RACK ON OPENINGS OVER 6", SEE SEPARATE DETAIL.
8. FORM ALL INVERTS FOR SMOOTH FLOW THRU STRUCTURE.
9. SEE SEPARATE DETAIL FOR CONCRETE BOX DESIGN FOR DIMENSIONS THAT EXCEED THE MAXIMUMS LISTED HERE.
10. STEPS NOT REQUIRED WHERE "H" IS LESS THAN 4'. PLACE STEPS ON VACANT WALL WHEN POSSIBLE. STAGGER STEPS 2" EACH WAY FROM CENTERLINE OF FRAME AND LID.
11. FRAME AND LID SHALL BE CENTERED ON CENTERLINE OF STEPS.
12. STORM INLET TOP/GRATE SHALL BE LABELED TO DISCOURAGE DUMPING OF POLLUTANTS TO WATERWAY.

SIDE OPENING INLET

NOT TO SCALE

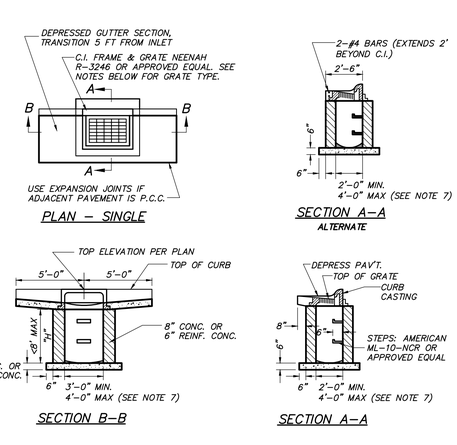

NOTES:
1. CONCRETE SHALL BE 4,000 PSI AT 28 DAYS WITH 6% AIR.
2. INSTALL WEEP HOLES PER SEPARATE DETAIL.
3. REINFORCED CONCRETE SHALL BE #4 BARS AT 12" CTRS, BOTH WAYS AND #4 BARS DIAGONAL AT PIPE OPENINGS FOR BOXES UP TO 4.0' WIDTH AND <8' HEIGHT. SEE SEPARATE DETAIL FOR CONCRETE BOX DESIGN FOR DIMENSIONS THAT EXCEED THESE MAXIMUMS.
4. FORM ALL INVERTS FOR SMOOTH FLOW THRU STRUCTURE WITH NON SHRINK GROUT.
5. STEPS NOT REQUIRED WHERE "H" IS LESS THAN 4' PLACE STEPS ON VACANT WALL WHEN POSSIBLE. STAGGER STEPS 2" FROM CENTERLINE OF FRAME AND GRATE. TOP STEP SHALL BE 24" BELOW GRATE. STEP SPACING SHALL BE 16" TO BOTTOM OF STRUCTURE.
6. GRATE SHALL BE NEENAH TYPE C IF AT LOW POINT (SUMP) OR TYPE L BICYCLE VANE GRATE WHEN INLET IS SET ON GRADE (NOT IN SUMP).
7. FOR STRUCTURES LARGER THAN 3'x2' FOR SINGLE INLETS, OR 6'-2"x2' FOR DOUBLE INLETS, INSTALL REINFORCED CONCRETE TOP WITH 3'x2' OR 6'-2"x2' OPENING.
8. FOR BOXES <4' WIDE AND <8' TALL TOP REINFORCEMENT SHALL BE #4 BARS @ 8" E.W. WITH #4 BARS DIAGONAL AT OPENING. BOXES >4' WIDE AND >8' TALL REINFORCEMENT SHALL BE PER SEPARATE DETAIL.
9. TOP ELEVATION SHOWN ON THE PLAN SHALL BE THE CENTER OF THE CURB RETURN OF THE CASTING.
10. SLOPE THE TOP TO MATCH ADJACENT GRADE IF NOT LOCATED AT LOW POINT. MAINTAIN WATERTIGHTNESS.
11. STORM INLET TOP/GRATE SHALL BE LABELED TO DISCOURAGE DUMPING OF POLLUTANTS TO WATERWAY.

TYPE "A" INLET (CURB INLET)

NOT TO SCALE

Engineering Surveys & Services
DELIVERING YOUR VISION ™
1113 Fay Street, Columbia, MO 65201
573 - 449 - 2646
802 El Dorado Drive, Jefferson City, MO 65101
573-636-3303
1775 West Main Street, Sedalia, MO 65301
660-826-8818
www.ess-inc.com
MO Engineering Corp. # 2004005018

WILSHIRE HILLS PHASE III

3200 NE WILSHIRE DR
LEE'S SUMMIT, JACKSON COUNTY, MISSOURI

6/30/2023
STATE OF MISSOURI
MATTHEW AARON KRIETE
NUMBER PE-2007002811
REGISTERED PROFESSIONAL ENGINEER

MATTHEW A. KRIETE
PROFESSIONAL ENGINEER
PE-2007002811

IF ORIGINAL SIGNATURE OR DIGITAL AUTHENTICATION IS NOT PRESENT THIS MEDIA SHOULD NOT BE CONSIDERED A CERTIFIED DOCUMENT.

Date
JUNE 30, 2023

Revised

Design: ST Drawn: MJS

STORM SEWER DETAILS

Sheet
C11.01

CONSTRUCTION DOCUMENTS

ES&S PROJECT NO. 15925

P:\GENERAL PROJECTS\15925E-JES-WILSHIRE-HILLS-3-ENG\CAD\15925 COVER & DETAILS.DWG 6/30/2023

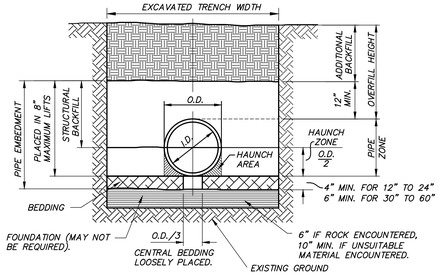

TYPICAL TRENCH DETAIL

TABLE II
MINIMUM COVER FOR CONSTRUCTION LOADS

PIPE DIA. (IN.)	MINIMUM COVER (FT) FOR INDICATED AXLE LOADS (THOUSANDS OF POUNDS)			
	18–50	50–75	75–110	110–150
12–36	2.0	2.5	3.0	3.0
42–48	3.0	3.0	3.5	4.0

THE CONTRACTOR SHALL PROVIDE MINIMUM COVER PLUS ANY ADDITIONAL COVER REQUIRED TO AVOID DAMAGE TO THE PIPE. IN UNPAVED SITUATIONS, THE SURFACE MUST BE MAINTAINED TO A LEVEL AND NON-RUTTED CONDITION.

LEGEND

I.D. = NORMAL INSIDE DIAMETER OF PIPE.
O.D. = OUTSIDE DIAMETER OF PIPE.
H = FILL COVER HEIGHT OVER PIPE (FEET).
MIN. = MINIMUM
MAX = MAXIMUM
= UNDISTURBED SOIL

BACKFILL NOTES:
1. BEDDING, HAUNCH, AND STRUCTURAL BACKFILL SHALL BE IN CONFORMANCE WITH AASHTO M145 A1 OR A-3 COMPACTED TO A MINIMUM OF 95% OF THE MAXIMUM DRY DENSITY AS DEFINED BY ASTM D698.
2. ALL PIPE INSTALLATION SHALL BE IN ACCORDANCE WITH THE MANUFACTURER'S RECOMMENDATIONS AND ASTM D2321 LATEST ADDITION.
3. HAUNCH, STRUCTURAL, AND ADDITIONAL BACKFILL SHALL BE PLACED IN LIFTS NOT TO EXCEED 8 INCHES AND COMPACTED TO 95% OF THE MAXIMUM DRY DENSITY AS DEFINED BY ASTM D698.

TABLE I
CORRUGATED HDPE AND POLYVINYL CHLORIDE CIRCULAR PIPE

SPECIFIED DIA OF PIPE (IN.)	MIN OVERFILL HEIGHT (FT)	HDPE MAX OVERFILL HEIGHT* (FT)	POLYVINYL CHLORIDE MAX OVERFILL HEIGHT* (FT)		VIRGIN RESIN (AASHTO M294) OVERFILL HEIGHT* (FT)			ENGINEERED COMPOUND (RECYCLED, ASTM F2648) OVERFILL HEIGHT* (FT)			TRENCH WIDTH (IN.)
			SDR 35#	SDR 26#	CLASS 1**	CLASS 2**	CLASS 3**	CLASS 1**	CLASS 2**	CLASS 3**	
12	2	26	15	30	43	29	21	27	19	12	34
15	2	28	15	30	45	30	22	27	20	13	39
18	2	24	15	30	40	27	19	25	18	11	44
24	2	20	15	30	36	25	17	22	16	12	55
30	2.5	17	N/A	N/A	29	21	15	16	12	6	67
36	2.5	19	N/A	N/A	34	23	16	21	15	10	76
42	2.5	19	N/A	N/A	31	23	16	17	13	7	84
48	2.5	17	N/A	N/A	30	20	14	18	13	10	95
54	2.5	9	N/A	N/A	33	22	15	N/A	N/A	N/A	104
60	2.5	9	N/A	N/A	33	22	15	20	15	10	113

TABLE ASSUMES STANDARD PROCTOR DENSITY OF 95%
* MAXIMUM OVERFILL MEASURED FROM THE TOP OF PIPE TO SURFACE
** CLASS 1 – CRUSHED ROCK, ANGULAR; AASHTO M43 – 5, 6, 56, 57, 67
** CLASS 2 – CLEAN, COURSE GRAINED SOILS TO BORDERLINE CLEAN FINES; AASHTO M43 – 5, 6, 56, 57, 67; AASHTO M145 – A1, A3
** CLASS 3 – COURSE GRAINED SOILS WITH FINES AND INORGANIC FINE-GRAINED SOILS; AASHTO M43 – GRAVEL AND SAND WITH <10% FINES; AASHTO M145 – A-2-4, A-2-5, A-2-6, A-4, OR A-6 WITH >30% RETAINED ON #200 SIEVE
** REFER TO CURRENT ADS INC. DRAINAGE HANDBOOK FOR A COMPLETE LISTING OF SUITABLE MATERIALS
# PER ASTM D-3034 FOR PIPE UP TO 15" AND ASTM F679 OVER 15"

EMBEDMENT OF PLASTIC STORM SEWER PIPE
NOT TO SCALE

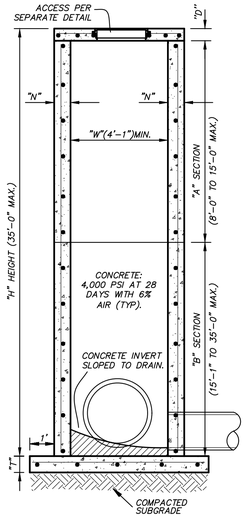

TABLE OF "T" & "N" DIMENSIONS				
SECTION	WIDTH ("W")	"T"	"N"	"D"
"A"	BETWEEN 4' & 7'	6" + PIPE THICKNESS	8"	6"
	GREATER THAN 7'	6" + PIPE THICKNESS	8"	8"
"B"	4'-1"	6" + PIPE THICKNESS	8"	8"
	BETWEEN 4' & 7'	6" + PIPE THICKNESS	10"	8"

REINFORCEMENT SCHEDULE, TOP		
DIMENSIONS	STEEL	SPECIAL PATTERN
W1 = 7' OR LESS	#4's @ 8" E.W.	DIAGONAL @ COVER
W2 = 7' OR LESS	#4's @ 8" E.W.	DIAGONAL @ COVER
W1 = GREATER THAN 7'	#4's @ 8" E.W.	DIAGONAL @ COVER
W2 = GREATER THAN 7'	#4's @ 6" E.W.	DIAGONAL @ COVER
W1 = GREATER THAN 7'	#4's @ 6" E.W.	DIAGONAL @ COVER
W2 = GREATER THAN 7'	#4's @ 6" E.W.	DIAGONAL @ COVER

REINFORCEMENT SCHEDULE, WALLS			
SECTION	WIDTH ("W")	HOR.	VERT.
"A"	4'-1"	#4's @ 9"	#4's @ 10"
	BETWEEN 4' & 7'	#6's @ 9"	#4's @ 10"
	GREATER THAN 7'	#5's @ 4 1/2"	#4's @ 10"
"B"	4'-1"	#4's @ 6"	#4's @ 10"
	BETWEEN 4' & 7'	#6's @ 6"	#4's @ 10"

REINFORCEMENT SCHEDULE, BASE	
SECTION	
"A" ONLY	#4's @ 6" E.W.
"A" & "B"	#6's @ 6" E.W.

NOTES:
1. SEE PLANS FOR CURB INLET, JUNCTION BOX, CATCH BASIN, ETC. DESIGNATION. SEE CORRESPONDING DETAILS FOR ACCESS FRAME AND GRATE/LID REQUIREMENTS.
2. ALL EXPOSED CORNERS SHALL HAVE 3/4" CHAMFERS.
3. ALL #4 & #5 REINFORCING BARS SHALL HAVE 1-1/2" MINIMUM COVER. LARGER BAR SIZES SHALL HAVE 2" MINIMUM COVER.
4. PIPES SHALL CONNECT TO THE FLAT FACES OF THE STRUCTURE. CONNECTIONS SHALL NOT BE MADE AT CORNERS OF STRUCTURE.
5. ALL REINFORCING BARS SHALL BE GRADE 60.
6. INSTALL WEEP HOLES AND STEPS PER SEPARATE DETAILS.

STORM SEWER LARGE CONCRETE BOX REINFORCEMENT
(WIDTH GREATER THAN 4'; HEIGHT 8' AND GREATER)
NOT TO SCALE

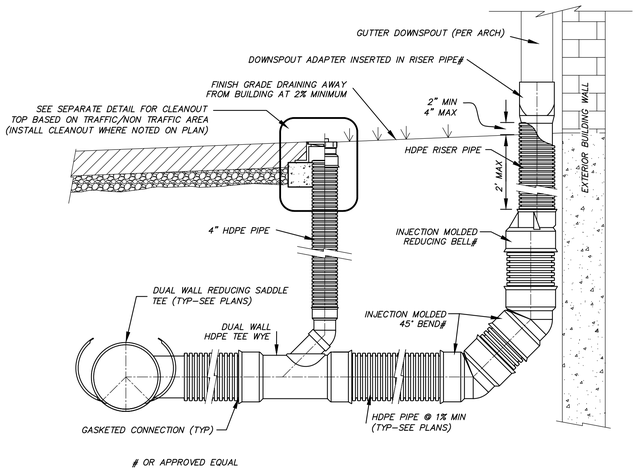

OR APPROVED EQUAL

NOTES:
1. SEE PLANS TO DETERMINE IF FITTINGS AND JOINTS ARE SOIL TIGHT (ST) OR WATER TIGHT (WT).
2. INSTALL ALL PIPING PER SEPARATE DETAIL OR MANUFACTURER'S WRITTEN INSTRUCTIONS.
3. THIS DETAIL IS FOR GENERAL LAYOUT PURPOSES ONLY. ADDITIONAL COUPLERS, GASKETS, FITTINGS, ETC. MAY BE NECESSARY PER MANUFACTURER'S REQUIREMENTS.
4. IF GUTTER DOWNSPOUT SIZE EXCEEDS THE LARGEST AVAILABLE MANUFACTURER DOWNSPOUT ADAPTER, THE HDPE PIPE SIZE SHALL BE INCREASED TO ACCOMMODATE THE DOWNSPOUT AND THE DOWNSPOUT ADAPTER SHALL BE REPLACED WITH AN HDPE END CAP PREFABRICATED OR CUT TO FIT THE DOWNSPOUT GUTTER AND UPSIZED HDPE PIPE. CAP/PIPE SHALL BE INSTALLED SO CAP IS 2" ABOVE FINISHED GRADE, MINIMUM.
5. SDR35 PVC PIPE MAY BE SUBSTITUTED FOR ANY HDPE PIPE AND/OR FITTING UP TO 15" IN DIAMETER.

GUTTER DOWNSPOUT CONNECTION
NOT TO SCALE

Engineering Surveys & Services
DELIVERING YOUR VISION ™
1113 Fay Street, Columbia, MO 65201
573 - 449 - 2646
802 El Dorado Drive, Jefferson City, MO 65101
573-636-3303
1775 West Main Street, Sedalia, MO 65301
660-826-6615
www.ess-inc.com
MO Engineering Corp. # 2004005018

WILSHIRE HILLS PHASE III
3200 NE WILSHIRE DR
LEE'S SUMMIT, JACKSON COUNTY, MISSOURI

6/30/2023
STATE OF MISSOURI
MATTHEW AARON KRIETE
NUMBER PE-2007002811
PROFESSIONAL ENGINEER

MATTHEW A. KRIETE
PROFESSIONAL ENGINEER
PE-2007002811

IF ORIGINAL SIGNATURE OR DIGITAL AUTHENTICATION IS NOT PRESENT THIS MEDIA SHOULD NOT BE CONSIDERED A CERTIFIED DOCUMENT.

Date
JUNE 30, 2023

Revised

Design: ST Drawn: MJS

STORM SEWER DETAILS

Sheet
C11.02

ES&S PROJECT NO. 15925

CONSTRUCTION DOCUMENTS

P:\GENERAL PROJECTS\15925E-JES-WILSHIRE-HILLS-3-ENG\CAD\15925 COVER & DETAILS.DWG 6/30/2023

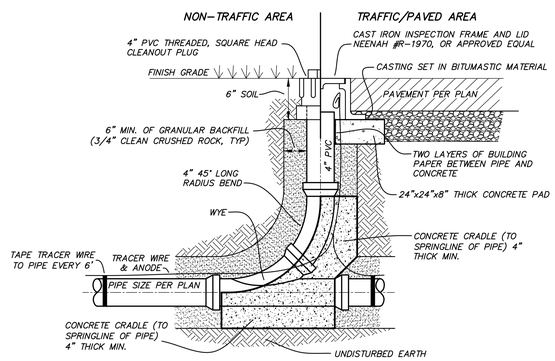

NOTES:
1. ALL PIPE & FITTINGS SHALL BE WATER TIGHT, GASKETED, SDR35 PVC.
2. INSTALL ALL PIPING PER SEPARATE DETAIL OR MANUFACTURER'S WRITTEN INSTRUCTIONS.
3. THIS DETAIL IS FOR GENERAL LAYOUT PURPOSES ONLY. ADDITIONAL COUPLERS, GASKETS, FITTINGS, ETC. MAY BE NECESSARY PER MANUFACTURER'S REQUIREMENTS
4. TOP SHALL BE SET FLUSH WITH FINISH GRADE.
5. INSTALL IN THE DIRECTION OF FLOW AS SHOWN UNLESS OTHERWISE INDICATED IN PLANS.

IN–LINE SANITARY SEWER CLEANOUT W/ TRACER WIRE

NOT TO SCALE

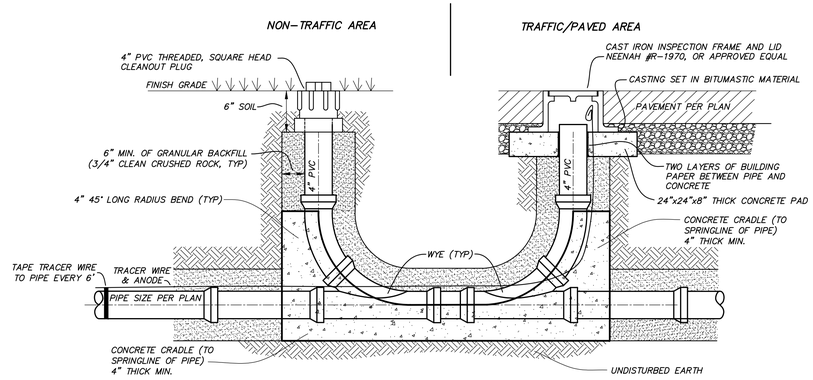

NOTES:
1. ALL PIPE & FITTINGS SHALL BE WATER TIGHT, GASKETED, SDR35 PVC.
2. INSTALL ALL PIPING PER SEPARATE DETAIL OR MANUFACTURER'S WRITTEN INSTRUCTIONS.
3. THIS DETAIL IS FOR GENERAL LAYOUT PURPOSES ONLY. ADDITIONAL COUPLERS, GASKETS, FITTINGS, ETC. MAY BE NECESSARY PER MANUFACTURER'S REQUIREMENTS
4. TOP SHALL BE SET FLUSH WITH FINISH GRADE.
5. INSTALL IN THE DIRECTION OF FLOW AS SHOWN UNLESS OTHERWISE INDICATED IN PLANS.

TWO WAY SANITARY CLEANOUT W/ TRACER WIRE

NOT TO SCALE

PIPE DIA.	MIN. TRENCH WIDTH
≤ 6"	PIPE DIA. + 18"
8"–10"	PIPE DIA. + 10"
12"–36"	PIPE DIA. + 12"

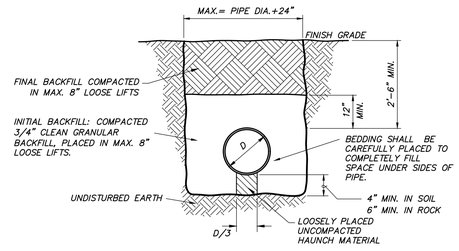

EMBEDMENT OF PVC SANITARY SEWER PIPE

NOT TO SCALE

Engineering Surveys & Services
DELIVERING YOUR VISION ™
1113 Fay Street, Columbia, MO 65201
573 - 449 - 2646
802 El Dorado Drive, Jefferson City, MO 65101
573-636-3303
1775 West Main Street, Sedalia, MO 65301
660-826-8818
www.ess-inc.com
MO Engineering Corp. # 2004005018

WILSHIRE HILLS PHASE III

3200 NE WILSHIRE DR

LEE'S SUMMIT, JACKSON COUNTY, MISSOURI

6/30/2023

STATE OF MISSOURI
MATTHEW AARON KRIETE
NUMBER PE-2007002811
PROFESSIONAL ENGINEER

MATTHEW A. KRIETE
PROFESSIONAL ENGINEER
PE-2007002811

IF ORIGINAL SIGNATURE OR DIGITAL AUTHENTICATION IS NOT PRESENT THIS MEDIA SHOULD NOT BE CONSIDERED A CERTIFIED DOCUMENT.

Date

JUNE 30, 2023

Revised

Design: ST Drawn: MJS

CONSTRUCTION DOCUMENTS

SANITARY SEWER DETAILS

Sheet

C12.01

ES&S PROJECT NO. 15925

P:\GENERAL PROJECTS\15925E-JES-WILSHIRE-HILLS-3-ENG\CAD\15925 COVER & DETAILS.DWG 6/30/2023

REQUIRED CONCRETE BEARING AREA (SQUARE FEET – SF)

NOM. DIA. (INCHES)	180 TEE, PLUG	90 BEND	45 BEND	22.5 BEND	11.25 BEND
6	4.7	6.7	4.0	4.0	4.0
8	8.4	11.8	6.4	4.0	4.0
10	13.1	18.5	10.0	5.1	4.0
12	18.8	26.7	14.4	7.4	4.0
14	25.7	36.3	19.6	10.0	5.0
16	33.5	47.4	25.6	13.1	6.6
18	42.4	REST. JT.	32.5	16.5	8.3
20	REST. JT.	REST. JT.	40.1	20.4	10.3
24	REST. JT.	REST. JT.	REST. JT.	29.4	14.8

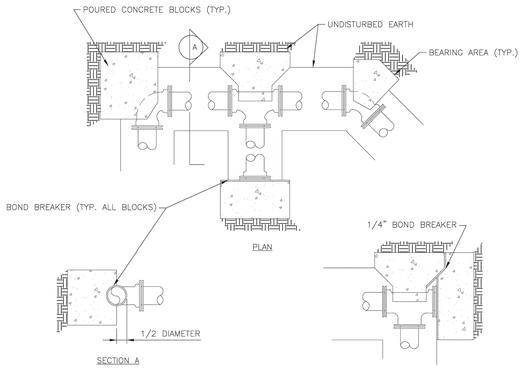

NOTES:
1. ALL BENDS WITHOUT RESTRAINED JOINTS SHALL HAVE CONCRETE THRUST BLOCKS INSTALLED FOR RESTRAINT.
2. MEGA LUGS MAY BE USED ONLY IN CONJUNCTION WITH CONCRETE THRUST BLOCKING.
3. BEARING AREA MUST BE AGAINST UNDISTURBED SOIL.
4. DO NOT COVER JOINTS OR BOLTS (WHERE APPLICABLE) WITH CONCRETE.

LEE'S SUMMIT MISSOURI
PUBLIC WORKS ENGINEERING DIVISION | 220 SE GREEN STREET | LEE'S SUMMIT, MO 64063

HORIZONTAL THRUST BLOCK — WAT-1 — Date: 01/2016 — Drawn By: JN — Checked By: DL

REQUIRED CONCRETE VOLUME (CUBIC FEET – CF)

NOM. DIA. (INCHES)	180 TEE, PLUG	90 BEND	45 BEND	22.5 BEND	11.25 BEND
6	50.5	71.4	38.6	19.7	9.9
8	89.8	126.9	68.7	35.0	17.6
10	140.2	198.3	107.3	54.7	27.5
12	202.0	REST. JT.	154.6	78.8	39.6
14	REST. JT.	REST. JT.	210.4	107.3	53.9
16	REST. JT.	REST. JT.	REST. JT.	140.1	70.4
18	REST. JT.	REST. JT.	REST. JT.	177.3	89.1
20	REST. JT.	REST. JT.	REST. JT.	REST. JT.	110.0
24	REST. JT.	REST. JT.	REST. JT.	REST. JT.	158.4

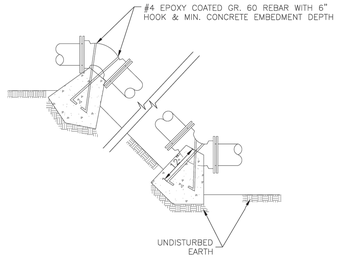

NOTES:
1. ALL BENDS WITHOUT RESTRAINED JOINTS SHALL HAVE CONCRETE THRUST BLOCKS INSTALLED FOR RESTRAINT.
2. MEGA LUGS MAY BE USED ONLY IN CONJUNCTION WITH CONCRETE THRUST BLOCKING.
3. BEARING MUST BE AGAINST UNDISTURBED SOIL.
4. DO NOT COVER JOINTS OR BOLTS (WHERE APPLICABLE) WITH CONCRETE.

LEE'S SUMMIT MISSOURI
PUBLIC WORKS ENGINEERING DIVISION | 220 SE GREEN STREET | LEE'S SUMMIT, MO 64063

VERTICAL THRUST BLOCK — WAT-2 — Date: WAT-2 — Drawn By: JN — Checked By: DL

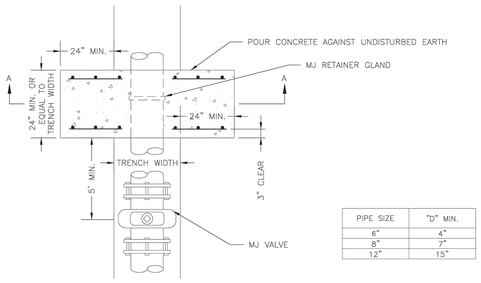

PIPE SIZE	"D" MIN.
6"	4"
8"	7"
12"	15"

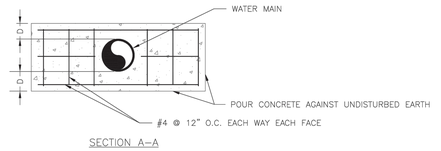

NOTE:
THIS DETAIL NOT TO BE USED FOR PIPE GREATER THAN 12"

LEE'S SUMMIT MISSOURI
PUBLIC WORKS ENGINEERING DIVISION | 220 SE GREEN STREET | LEE'S SUMMIT, MO 64063

STRADDLE BLOCK — WAT-3 — Date: 01/2016 — Drawn By: JN — Checked By: DL

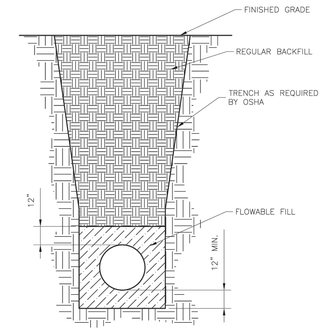

NOTES:
1. FLOWABLE FILL SHALL MEET THE REQUIREMENTS OF THE CITY OF LEE'S SUMMIT DESIGN AND CONSTRUCTION MANUAL.
2. REGULAR BACKFILL ABOVE THE TRENCH CHECK SHALL BE FREE OF DEBRIS, ORGANIC MATTER, AND STONES > 6" IN ANY DIMENSION.
3. TOP OF FLOWABLE BACKFILL SHALL EXTEND 12" ABOVE THE TOP OF THE PIPE.
4. LENGTH OF TRENCH CHECK SHALL BE A MINIMUM OF 12'.

LEE'S SUMMIT MISSOURI
PUBLIC WORKS ENGINEERING DIVISION | 220 SE GREEN STREET | LEE'S SUMMIT, MO 64063

WATER TRENCH CHECK DETAIL — WAT-6 — Date: 01/2016 — Drawn By: JN — Checked By: DL

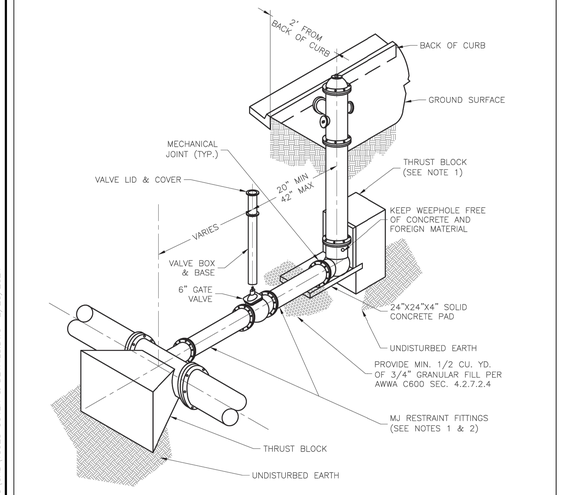

NOTES:
1. WHEN RETAINER GLANDS ARE USED IN LIEU OF MECHANICAL JOINT (MJ) RESTRAINT FITTINGS, HORIZONTAL THRUST BLOCKS ARE REQUIRED.
2. GATE VALVE MAY BE BOLTED DIRECTLY TO MJ RESTRAINT TEE.
3. SEE APPROVED PRODUCTS LIST FOR WATER UTILITIES FOR FIRE HYDRANT, VALVES, VALVE BOX LID, AND COVER.
4. BOTTOM HYDRANT FLANGE SHALL BE 2" TO 6" ABOVE FINISHED GRADE.
5. FOR STREETS WITHOUT CURBS FIRE HYDRANTS SHALL BE PLACED WITHIN 1 FOOT OF THE R/W LINE, BUT NOT MORE THAN 10' FROM EDGE OF PAVEMENT. FIRE HYDRANT SHALL NOT BE PLACED IN BOTTOM OF DITCH.
6. HYDRANT SHALL BE ROTATED AS DIRECTED BY INSPECTOR.

LEE'S SUMMIT MISSOURI
PUBLIC WORKS ENGINEERING DIVISION | 220 SE GREEN STREET | LEE'S SUMMIT, MO 64063

HYDRANT - STRAIGHT SET — WAT-7 — Date: 01/2016 — Drawn By: JN — Checked By: DL

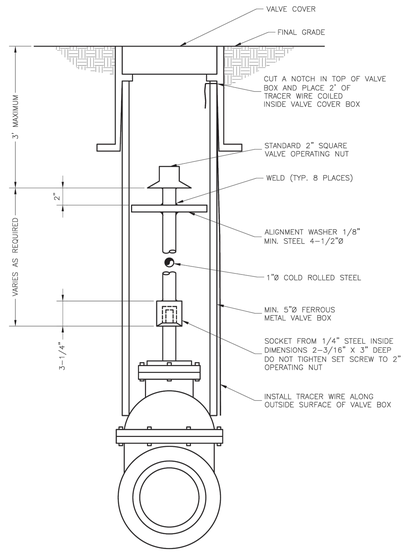

LEE'S SUMMIT MISSOURI
PUBLIC WORKS ENGINEERING DIVISION | 220 SE GREEN STREET | LEE'S SUMMIT, MO 64063

VALVE STEM EXTENSION AND VALVE BOX — WAT-9 — Date: 01/2016 — Drawn By: JN — Checked By: DL

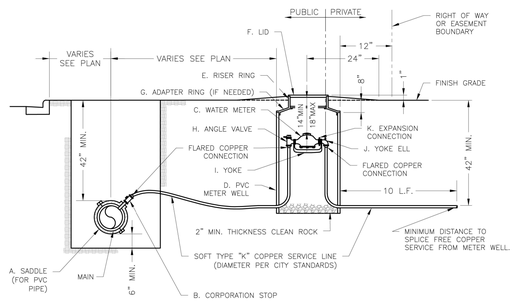

NOTES:
1. METER INSTALLATION SHALL NOT BE LOCATED IN AREAS SUBJECT TO VEHICULAR TRAFFIC OR IN CONCRETE PAVEMENT WITHOUT CITY APPROVAL.
2. IF METER IS TO BE LOCATED OTHER THAN IN FRONT OF PROPERTY LINE, CITY APPROVAL SHALL BE OBTAINED.
3. CITY TO FURNISH ITEMS A–K.
4. NO OTHER EQUIPMENT SHALL BE INSTALLED IN THIS PIT.
5. 42" MINIMUM BURY DEPTH FOR ALL SERVICE LINES.
6. EXCAVATION FOR TAP TO EXPOSE 4 LINEAR FEET OF MAIN.
7. NO SPLICES ALLOWED BETWEEN METER AND MAIN.
8. SERVICE CONNECTION TAP AT APPROXIMATELY 45 DEGREES.
9 LID AND RISER RING SHALL BE SET SO THAT GROUND WATER WILL DRAIN AWAY FROM THE WELL.
10. CONTACT WATER UTILITIES, 816–969–1900, FOR REQUIREMENTS OF A METER LARGER THAN 2"

LEE'S SUMMIT MISSOURI
PUBLIC WORKS ENGINEERING DIVISION | 220 SE GREEN STREET | LEE'S SUMMIT, MO 64063

SERVICE CONNECTION WITH METER WELL 1 — WAT-11 — Date: 08/2023 — Drawn By: MJF — Checked By: KLY

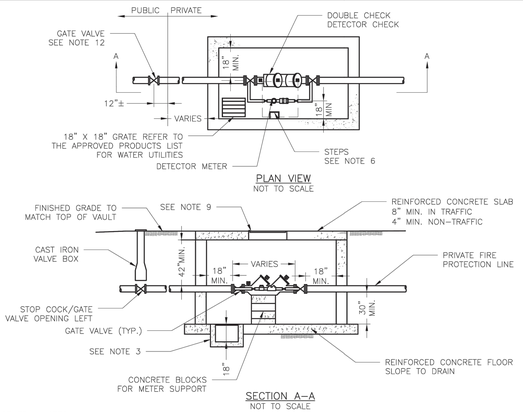

GENERAL NOTES:
1. METER VAULT WALLS TO BE POURED OR PRECAST CONCRETE.
2. METER VAULT ROOF TO BE REINFORCED CONCRETE OPENING CENTERED OVER DETECTOR METER.
3. METER VAULT TO BE LOCATED, WHEN POSSIBLE, OUTSIDE TRAFFIC AREA WHERE SURFACE WATER WILL NOT DRAIN INTO IT. VAULT MUST BE KEPT FREE OF WATER. PROVIDE CONCRETE SUMP AS A MINIMUM. WHERE PRACTICAL, PROVIDE A 2" PIPE DRAIN WITH AN ABOVE–GROUND DISCHARGE POINT. PROJECT OWNER MAY DESIRE A PERMANENTLY INSTALLED SUMP PUMP.
4. ALL PIPE SHALL BE DUCTILE IRON CLASS 50. ALL PIPE FITTINGS FROM THE CITY WATER MAIN THROUGH THE VAULT SHALL BE PROVIDED WITH RESTRAINED JOINT FITTINGS.
5. ALL FITTINGS TO BE BRASS.
6. STEPS SHALL BE IN ACCORDANCE WITH THE APPROVED PRODUCTS LIST FOR WATER UTILITIES AND SHALL BE ON 16" CENTERS.
7. A DEPARTMENT OF NATURAL RESOURCES APPROVED DOUBLE CHECK DETECTOR CHECK BACKFLOW PREVENTER MUST BE USED. FOR A COPY OF THE MISSOURI DEPARTMENT OF NATURAL RESOURCES APPROVED BACKFLOW PREVENTION ASSEMBLIES, CONTACT THE WATER UTILITIES OPERATIONS DIVISION AT 816–969–1940. AS OF JANUARY 1, 1987, THE DNR REQUIRES FIRE SPRINKLER SYSTEMS USING CHEMICALS TO HAVE A DNR APPROVED PRESSURE BACKFLOW PREVENTER INSTALLED, PRIOR TO THE MIXING POINT.
8. ALL VALVES SHALL HAVE RISING STEMS.
9. FOR MANHOLE COVERS, SELECT A MANHOLE FOUND ON THE APPROVED PRODUCTS LIST FOR WATER UTILITIES SUITABLE FOR EITHER TRAFFIC OR NON–TRAFFIC CONDITIONS.
10. A MINIMUM OF 18" CLEARANCE SHALL BE PROVIDED AROUND ALL PIPING, VALVES, APPURTENANCES, ETC.
11. METER SHALL BE OWNED AND MAINTAINED BY THE WATER UTILITIES DEPARTMENT.
12. IF PUBLIC WATER IS LOCATED ON THE OPPOSITE SIDE OF THE STREET, THEN THE PUBLIC WATER MAIN RESPONSIBILITY OF THE WATER UTILITIES DEPARTMENT ENDS AT THE GATE VALVE NEAREST THE VAULT.

LEE'S SUMMIT MISSOURI
PUBLIC WORKS ENGINEERING DIVISION | 220 SE GREEN STREET | LEE'S SUMMIT, MO 64063

VAULT FOR DOUBLE CHECK DETECTOR CHECK — WAT-12 — Date: 02/2016 — Drawn By: JN — Checked By: DL

Engineering Surveys & Services
DELIVERING YOUR VISION ™
1113 Fay Street, Columbia, MO 65201 573 - 449 - 2646
802 El Dorado Drive, Jefferson City, MO 65101 573-636-3303
1775 West Main Street, Sedalia, MO 65301 660-826-8818
www.ess-inc.com
MO Engineering Corp. # 2004005018

WILSHIRE HILLS PHASE III

3200 NE WILSHIRE DR
LEE'S SUMMIT, JACKSON COUNTY, MISSOURI

2/22/2024

STATE OF MISSOURI — MATTHEW AARON KRIETE — NUMBER PE-2007002811 — PROFESSIONAL ENGINEER

MATTHEW A. KRIETE
PROFESSIONAL ENGINEER
PE-2007002811

IF ORIGINAL SIGNATURE OR DIGITAL AUTHENTICATION IS NOT PRESENT THIS MEDIA SHOULD NOT BE CONSIDERED A CERTIFIED DOCUMENT.

Date
JUNE 30, 2023

Revised
1 FEBRUARY 22, 2024

Design: ST Drawn: MJS

WATER DETAILS

Sheet
C13.01

CONSTRUCTION DOCUMENTS

ES&S PROJECT NO. 15925

P:\GENERAL PROJECTS\15925E–JES–WILSHIRE–HILLS–3–ENG\CAD\15925 COVER & DETAILS.DWG 2/23/2024

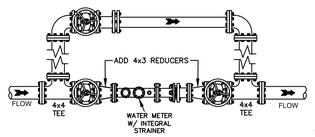

3" METER ASSEMBLY

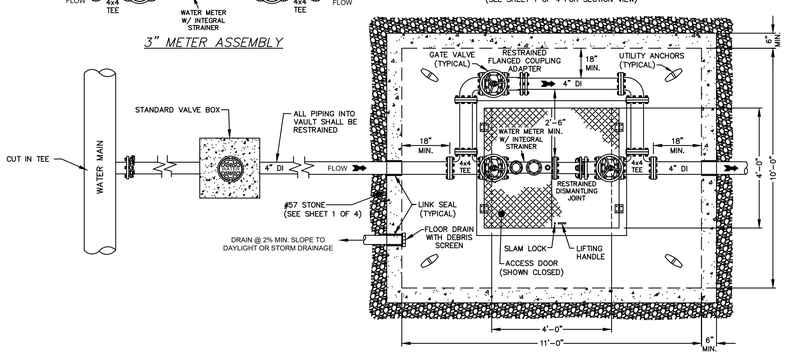

PLAN VIEW
(SEE SHEET 1 OF 4 FOR SECTION VIEW)

PLAN VIEW

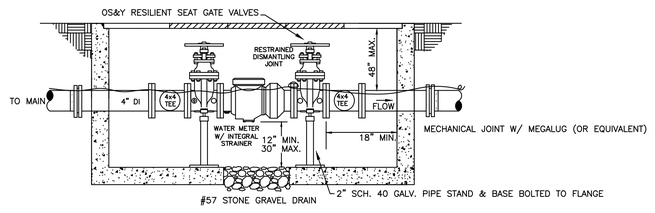

SECTION VIEW

GENERAL NOTES:

1. METER VAULT WILL BE POURED CONCRETE OR PRECAST REINFORCED CONCRETE. A CONCRETE FLOOR SHALL BE REQUIRED. THE FLOOR SHALL BE SLOPED TO A GRATE-COVERED DRAIN SUMP.
2. METER VAULT ROOF TO BE REINFORCED CONCRETE.
3. METER VAULT TO BE LOCATED, WHEN POSSIBLE, OUTSIDE TRAFFIC AREA AND WHERE SURFACE WATER WILL NOT DRAIN INTO IT.
4. STEPS SHALL BE IN ACCORDANCE WITH WATER UTILITIES LIST OF ACCEPTABLE MANUFACTURERS AND MODELS AND SHALL BE ON 16" CENTERS.
5. VALVES MUST HAVE FLANGED ENDS, BE IN ALIGNMENT, AND BE ADEQUATELY SECURED TO WITHSTAND THRUST WITH METER REMOVAL.
6. ALL PIPE SHALL BE DUCTILE IRON CLASS 50. ALL PIPE AND FITTINGS FROM THE CITY WATER MAIN THROUGH THE VAULT SHALL BE PROVIDED WITH RESTRAINED JOINT FITTINGS.
7. IF HIGHER CONTINUOUS RATE OF FLOW IS REQUIRED, A LARGER BY-PASS MAY BE PERMITTED, BUT NOT LARGER THAN PRIMARY DOMESTIC SERVICE.
8. ALL VALVES SHALL BE RISING STEM VALVES.
9. PROVIDE THE CONCRETE SUMP AS A MINIMUM. WHERE PRACTICAL, PROVIDE A 2" PIPE DRAIN WITH AN ABOVE GROUND DISCHARGE POINT. PROJECT OWNER MAY DESIRE A PERMANENTLY INSTALLED SUMP PUMP.
10. A MINIMUM OF 18" CLEARANCE SHALL BE PROVIDED AROUND ALL PIPING, VALVES, APPURTENANCES, ETC.
11. METER SHALL BE OWNED AND MAINTAINED BY THE WATER UTILITIES DEPARTMENT.
12. THE PUBLIC WATER MAIN RESPONSIBILITY OF THE WATER UTILITIES DEPARTMENT ENDS AT THE GATE VALVE.

WATER METER VAULT (2) (3)

NOT TO SCALE

Engineering Surveys & Services
DELIVERING YOUR VISION ™
1113 Fay Street, Columbia, MO 65201
573 - 449 - 2646
802 El Dorado Drive, Jefferson City, MO 65101
573-636-3303
1775 West Main Street, Sedalia, MO 65301
660-826-8618
www.ess-inc.com
MO Engineering Corp. # 2004005018

WILSHIRE HILLS PHASE III
3200 NE MANHATTAN DR
LEE'S SUMMIT, JACKSON COUNTY, MISSOURI

4/17/24

STATE OF MISSOURI
MATTHEW AARON KRIETE
NUMBER PE-2007002811
PROFESSIONAL ENGINEER

MATTHEW A. KRIETE
PROFESSIONAL ENGINEER
PE-2007002811

IF ORIGINAL SIGNATURE OR DIGITAL AUTHENTICATION IS NOT PRESENT THIS MEDIA SHOULD NOT BE CONSIDERED A CERTIFIED DOCUMENT.

Date
MARCH 27, 2024

Revised
(3) APRIL 17, 2024

Design: ST Drawn: MJS

WATER DETAILS

Sheet
C13.02

ES&S PROJECT NO. 15925

CONSTRUCTION DOCUMENTS

\\192.168.0.99\PROJECTS\GENERAL PROJECTS\15925E - JES - WILSHIRE HILLS - 3-ENG\CAD\15925 COVER & DETAILS.DWG 4/17/2024

TEMPORARY CONSTRUCTION ENTRANCE

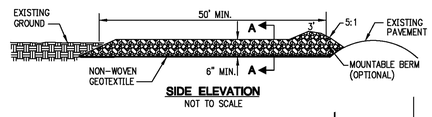

SIDE ELEVATION
NOT TO SCALE

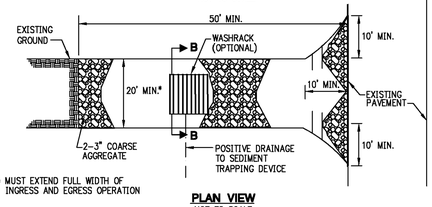

PLAN VIEW
NOT TO SCALE

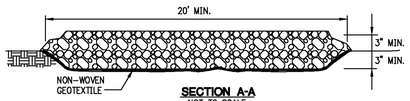

SECTION A-A
NOT TO SCALE

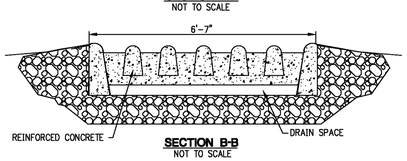

SECTION B-B
NOT TO SCALE

SOURCE: MODIFIED FROM VA. DCR, 1992

TEMPORARY CONSTRCUTION ENTRANCE PAD NOTES:

A) INSTALLATION:

1. AVOID LOCATING ON STEEP SLOPES OR AT CURVES ON PUBLIC ROADS. IF POSSIBLE, LOCATE WHERE PERMANENT ROADS WILL EVENTUALLY BE CONSTRUCTED.
2. REMOVE ALL VEGETATION AND OTHER UNSUITABLE MATERIAL FROM THE FOUNDATION AREA, GRADE, AND CROWN FOR POSITIVE DRAINAGE.
3. IF SLOPE TOWARDS THE PUBLIC ROAD EXCEEDS 2%, CONSTRUCT A 6-TO 8-INCH HIGH RIDGE WITH 3H:1V SIDE SLOPES ACROSS THE FOUNDATION APPROXIMATELY 15 FEET FROM THE EDGE OF THE PUBLIC ROAD TO DIVERT RUNOFF AWAY FROM IT.
4. INSTALL PIPE UNDER THE ENTRANCE IF NEEDED TO MAINTAIN DRAINAGE DITCHES ALONG PUBLIC ROADS.
5. PLACE STONE TO DIMENSIONS AND GRADE AS SHOWN ON PLANS. LEAVE SURFACE SMOOTH AND SLOPED FOR DRAINAGE.
6. DIVERT ALL SURFACE RUNOFF AND DRAINAGE FROM THE ENTRANCE TO A SEDIMENT CONTROL DEVICE.
7. IF WET CONDITIONS ARE ANTICIPATED, PLACE GEOTEXTILE FABRIC ON THE GRADED FOUNDATION TO IMPROVE STABILITY.

B) TROUBLESHOOTING:

1. CONSULT WITH A QUALIFIED DESIGN PROFESSIONAL IF ANY OF THE FOLLOWING OCCUR:
   a. INADEQUATE RUNOFF CONTROL TO THE EXTENT THAT SEDIMENT WASHES ONTO PUBLIC ROAD – INSTALL DIVERSIONS OR OTHER RUNOFF CONTROL MEASURES.
   b. SMALL STONE, THIN PAD, OR ABSENCE OF GEOTEXTILE FABRIC RESULTS IN RUTS AND MUDDY CONDITIONS AS STONE IS PRESSED INTO SOIL – INCREASE STONE SIZE OR PAD THICKNESS OR ADD GEOTEXTILE FABRIC.
   c. PAD TOO SHORT FOR HEAVY CONSTRUCTION TRAFFIC – EXTEND PAD BEYOND THE MINIMUM 50-FOOT LENGTH AS NECESSARY.

C) INSPECTION AND MAINTENANCE:

1. INSPECT STONE PAD AND SEDIMENT DISPOSAL AREA WEEKLY AND AFTER 1/2-INCH OR GREATER STORM EVENTS.
2. RESHAPE PAD AS NEEDED FOR PROPER DRAINAGE AND RUNOFF CONTROL.
3. TOPDRESS WITH CLEAN 2-AND 3-INCH STONE AS NEEDED.
4. IMMEDIATELY REMOVE MUD OR SEDIMENT TRACKED OR WASHED ONTO PUBLIC ROAD. REPAIR ANY BROKEN ROAD PAVEMENT IMMEDIATELY.
5. REMOVE ALL TEMPORARY ROAD MATERIALS FROM AREAS WHERE PERMANENT VEGETATION WILL BE ESTABLISHED.

AMERICAN PUBLIC WORKS ASSOCIATION	
APWA	KANSAS CITY METROPOLITAN CHAPTER
TEMPORARY CONSTRUCTION ENTRANCE	STANDARD DRAWING NUMBER: ESC-01 ADOPTED:

SODDING

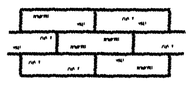

LAY SOD IN A STAGGERED PATTERN. BUTT THE STRIPS TIGHTLY AGAINST EACH OTHER. DO NOT LEAVE SPACES AND DO NOT OVERLAP. A SHARPENED MASON'S TROWEL IS A HANDY TOOL FOR TUCKING DOWN THE ENDS AND TRIMMING PIECES.

BUTTING – ANGLED ENDS CAUSED BY THE AUTOMATIC SOD CUTTER MUST BE MATCHED CORRECTLY.

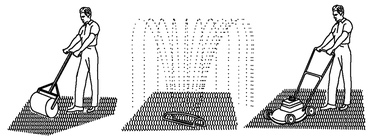

ROLL SOD IMMEDIATELY TO ACHIEVE FIRM CONTACT WITH THE SOIL.

WATER TO A DEPTH OF 4" AS NEEDED. WATER WELL AS SOON AS THE SOD IS LAID.

MOW WHEN THE SOD IS ESTABLISHED, TYPICALLY IN 2-3 WEEKS. SET THE MOWER AT 2 TO 3 INCHES HIGH.

SODDING NOTES:

A) SODDING:

1. THE SOD SHALL BE DENSELY ROOTED, NURSERY GROWN, AND A PERENNIAL GRASS. THE SOD SHALL CONTAIN A GROWTH OF NOT MORE THAN 10 PERCENT OF OTHER GRASSES, SHALL BE FREE FROM ALL PROHIBITED AND NOXIOUS WEEDS, AND SHALL BE CUT IN STRIPS OF UNIFORM THICKNESS. THE RANGE OF ACCEPTABLE THICKNESS SHALL BE 1/2 TO 1 1/2 INCH, WITH EACH STRIP CONTAINING AT LEAST ONE (1) SQUARE YARD. SOD SHALL BE CUT IN STRIPS NOT LESS THAN 12 INCHES WIDE.
2. FERTILIZER SHALL BE INORGANIC 12-12-12 OR 13-13-13 GRADE, UNIFORM IN COMPOSITION, FREE FLOWING, SUITABLE FOR APPLICATION WITH APPROVED EQUIPMENT, AND DELIVERED TO THE SITE IN CONVENIENT CONTAINERS, EACH FULLY LABELED. LABELS SHALL CONFORM TO APPLICABLE STATE FERTILIZER LAWS AND BEARING THE NAME, TRADE NAME OR TRADEMARK, AND WARRANTY OF THE PRODUCER.
3. BEFORE TILLING OPERATIONS, FERTILIZER SHALL BE SPREAD UNIFORMLY AT THE RATE OF 300 POUNDS PER ACRE. FERTILIZING RATE IS EQUIVALENT TO 3.5 POUND PER 500 SQUARE FEET.
4. THE SOD BED SHALL HAVE A UNIFORM SURFACE FREE FROM WASHES AND DEPRESSIONS. IT SHALL CONFORM TO THE FINISHED GRADE PROFILE AND CROSS SECTION SHOWN ON THE PLANS. THE SOIL, EXCEPT WHERE FRESH TOP SOIL HAS BEEN APPLIED AND COMPACTED, SHALL BE THOROUGHLY TILLED TO A DEPTH OF 2 INCHES.
5. FRESHLY GRADED AREAS WHICH HAVE SET LONG ENOUGH TO BECOME DRY AND CRUSTED OVER SHALL BE TILLED, AS SPECIFIED ABOVE, BEFORE PLACING THE SOD.
6. SOD SHALL NOT BE PLACED DURING A DROUGHT NOR ON FROZEN GROUND UNLESS AUTHORIZED BY THE ENGINEER.
7. SOD SHALL BE MOIST WHEN IT IS PLACED. SOD STRIPS SHALL BE LAID ALONG CONTOUR LINES, COMMENCING AT THE LOWEST POINT OF THE AREA AND WORKING UPWARD. THE TRANSVERSE JOINTS OF SOD STRIPS SHALL BE STAGGERED AND THE SOD CAREFULLY PLACED TO PRODUCE TIGHT JOINTS. THE SOD SHALL BE FIRMED AND WATERED IMMEDIATELY AFTER IT IS PLACED. THE FIRMING SHALL BE ACCOMPLISHED BY APPLICATION OF A ROLLER WEIGHING BETWEEN 60 AND 90 POUNDS PER LINEAL FOOT OF ROLLER.
8. ON 2H:1V SLOPES OR STEEPER THE SOD SHALL BE ANCHORED WITH 1/2-INCH SQUARE BY 8-INCH LONG WOODEN PEGS DRIVEN INTO THE GROUND, 3 PEGS TO THE SQUARE YARD OR OTHER APPROVED CONFIGURATION. PEGGING SHALL BE DONE IMMEDIATELY AFTER SOD IS FIRMED. THE AREA SHALL THEN BE CLEARED OF LOOSE SOD, EXCESS OR BROKEN ANCHORS, EXCESSIVE SOIL, AND OTHER FOREIGN MATERIALS.

APPEARANCE OF GOOD SOD

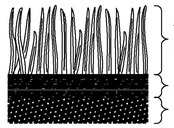

SHOOTS – GRASS BLADES SHOULD BE GREEN AND HEALTHY, MOWED AT A 2"-3" CUTTING HEIGHT.

THATCH – GRASS CLIPPINGS AND DEAD LEAVES, UP TO 1/2" THICK.

ROOT ZONE – SOIL AND ROOTS SHOULD BE 1/2"-3/4" THICK, WITH DENSE ROOT MAT FOR STRENGTH.

B) TROUBLESHOOTING:

1. CONSULT WITH A QUALIFIED DESIGN PROFESSIONAL IF ANY OF THE FOLLOWING OCCUR:
   a. VARIATION IN TOPOGRAPHY ON SITE INDICATE THE SODDING MATERIALS WILL NOT FUNCTION AS INTENDED; CHANGES IN PLAN MAY BE NEEDED.
   b. DESIGN SPECIFICATIONS FOR SOD VARIETY CANNOT BE MET OR IRRIGATION IS NOT POSSIBLE; SUBSTITUTION OR SEEDING MAY BE REQUIRED. UNAPPROVED SUBSTITUTIONS COULD RESULT IN EROSION OR SODDING FAILURE.
2. COMMON PROBLEMS:
   a. SOD LAID ON POORLY PREPARED SOIL OR UNSUITABLE SURFACE DIES BECAUSE IT IS UNABLE TO ROOT – REMOVE DEAD SOD, PREPARE SURFACE, AND RESOD.
   b. SOD NOT ADEQUATELY IRRIGATED AFTER INSTALLATION CAUSES ROOT DIEBACK, GRASS TO NOT ROOT RAPIDLY, AND DRYING OUT – IRRIGATE SOD AND UNDERLYING SOIL TO THE DEPTH OF 4 INCHES AND KEEP MOIST UNTIL ROOTS ARE ESTABLISHED.
   c. SOD NOT ANCHORED PROPERLY IS LOOSENED BY RUNOFF – REPLACE DAMAGED AREAS AND ANCHOR SOD.
   d. SLOW GROWTH DUE TO LACK OF NITROGEN CAUSES YELLOWING OF LEAF BLADES – REFERTILIZE SOD, BUT AVOID FERTILIZING COOL SEASON GRASSES FROM LATE MAY THROUGH JULY.

C) MAINTENANCE AND INSPECTION:

1. THE SODDED AREA SHALL BE THOROUGHLY WATERED DAILY FOR A PERIOD OF FIFTEEN DAYS AFTER PLACING EXCEPT WHEN THOROUGHLY WETTED BY RAIN. ANY PORTION OF THE SOD THAT IS NOT IN GOOD GROWING CONDITION FOLLOWING THE FIRST FULL GROWING SEASON (SPRING TO FALL), SHALL BE REPLACED WITH FRESH LIVE SOD.

AMERICAN PUBLIC WORKS ASSOCIATION	
APWA	KANSAS CITY METROPOLITAN CHAPTER
SODDING	STANDARD DRAWING NUMBER: ESC-02 ADOPTED:

SOURCE: MODIFIED FROM VA. DCR, 1992

EROSION CONTROL BLANKET

NOTE:
ON SHALLOW SLOPES, PROTECTIVE EROSION CONTROL BLANKETS MAY BE APPLIED ACROSS THE SLOPE.

NOTE:
WHERE THERE IS A BERM AT THE TOP OF THE SLOPE, BRING THE MATERIAL OVER THE BERM AND ANCHOR IT BEHIND THE BERM.

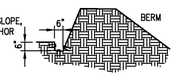

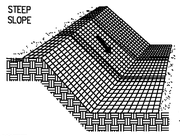

NOTE:
ON STEEP SLOPES, APPLY PROTECTIVE BLANKET PERPENDICULAR TO THE DIRECTION OF FLOW AND ANCHOR SECURELY.

NOTE:
BRING MATERIAL DOWN TO A LEVEL AREA BEFORE TERMINATING THE INSTALLATION.

TOP OF SLOPE BLANKET ANCHOR SLOT

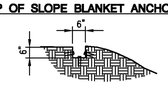

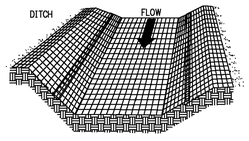

NOTE:
IN DITCHES, APPLY PROTECTIVE COVERING PARALLEL TO THE DIRECTION OF FLOW. USE CHECK SLOTS AS REQUIRED. AVOID JOINING MATERIAL IN THE CENTER OF THE DITCH IF AT ALL POSSIBLE. FOLLOW BLANKET MANUFACTURER'S RECOMMENDATIONS FOR ALLOWABLE VELOCITY AND SHEAR STRESS.

EROSION CONTROL BLANKET NOTES (1 OF 2):

A) SITE PREPARATION:
AFTER SITE HAS BEEN SHAPED AND GRADED, PREPARE A FRIABLE SEEDBED RELATIVELY FREE FROM CLODS AND ROCKS MORE THAN 1 1/2 INCHES IN DIAMETER AND ANY FOREIGN MATERIAL THAT WILL PREVENT UNIFORM CONTACT OF THE PROTECTIVE COVERING WITH THE SOIL SURFACE.

B) PLANTING:
LIME, FERTILIZE, AND SEED IN ACCORDANCE WITH SEEDING OR PLANTING PLAN. WHEN USING JUTE MESH ON A SEEDED AREA, APPLY APPROXIMATELY ONE HALF THE SEED AFTER LAYING THE MAT. THE PROTECTIVE COVERING CAN BE LAID OVER SPRIGGED AREAS WHERE SMALL GRASS PLANTS HAVE BEEN INSERTED INTO THE SOIL. WHERE GROUND COVERS ARE TO BE PLANTED, LAY THE PROTECTIVE COVERING FIRST AND THEN PLANT THROUGH THE MATERIAL AS PER PLANTING PLAN.

C) LAYING AND STAPLING:
IF INSTRUCTIONS HAVE BEEN FOLLOWED, ALL NEEDED CHECK SLOTS WILL HAVE BEEN INSTALLED, AND THE PROTECTIVE COVERING WILL BE LAID ON A FRIABLE SEEDBED FREE FROM CLODS, ROCKS, ROOTS, ETC. THAT MIGHT IMPEDE GOOD CONTACT.

1. START LAYING THE PROTECTIVE COVERING FROM THE TOP OF THE CHANNEL OR SLOPE AND UNROLL DOWN-GRADE. ALLOW TO LAY LOOSELY ON SOIL; DO NOT STRETCH.
2. UPSLOPE ENDS OF THE BLANKET SHOULD BE BURIED IN AN ANCHOR SLOT NO LESS THAN 6-INCHES DEEP. TAMP EARTH
3. FIRMLY OVER THE MATERIAL. WHEN TOP IS RELATIVELY FLAT, EXTEND BLANKET ABOUT 40 INCHES AWAY FROM SLOPE. STAPLE THE MATERIAL AT A MINIMUM OF EVERY 12 INCHES ACROSS THE TOP END.
4. EDGES OF THE MATERIAL SHALL BE STAPLED EVERY 3 FEET. WHERE MULTIPLE WIDTHS ARE LAID SIDE BY SIDE, THE ADJACENT EDGES SHALL BE OVERLAPPED A MINIMUM OF 6 INCHES AND STAPLED TOGETHER.
5. STAPLES SHALL BE PLACED DOWN THE CENTER, STAGGERED WITH THE EDGES AT 3-FOOT INTERVALS.

D) TROUBLESHOOTING:
CONSULT WITH A QUALIFIED DESIGN PROFESSIONAL, IF ANY OF THE FOLLOWING OCCUR:

1. MOVEMENT OF THE BLANKET OR EROSION UNDER THE BLANKET IS OBSERVED.
2. VARIATIONS IN TOPOGRAPHY ON SITE INDICATE EROSION CONTROL MAT WILL NOT FUNCTION AS INTENDED; CHANGES IN PLAN MAY BE NEEDED, OR A BLANKET WITH A SHORTER OR LONGER LIFE MAY BE NEEDED.
3. DESIGN SPECIFICATIONS FOR SEED VARIETY, SEEDING DATES, OR EROSION CONTROL MATERIALS CANNOT BE MET; SUBSTITUTION MAY BE REQUIRED. UNAPPROVED SUBSTITUTIONS COULD RESULT IN FAILURE TO ESTABLISH VEGETATION.

E) MAINTENANCE & INSPECTION
INSPECT CONTROLS AFTER EACH RAIN EVENT OF 1/2 INCH OR GREATER, AND EVERY 7 DAYS UNTIL VEGETATION IS ESTABLISHED, FOR EROSION OR UNDERMINING BENEATH THE NETTING, BLANKETS, OR MATS. IF ANY AREA SHOWS EROSION, PULL BACK THAT PORTION OF THE MATERIAL, ADD SOIL, TAMP DOWN, AND RESEED; RESECURE THE MATERIAL IN PLACE. IF NETTING, BLANKETS OR MATS BECOME DISLOCATED OR DAMAGED, REPAIR OR REPLACE AND RESECURE IMMEDIATELY.

AMERICAN PUBLIC WORKS ASSOCIATION	
APWA	KANSAS CITY METROPOLITAN CHAPTER
EROSION CONTROL BLANKET SHEET 1 OF 2	STANDARD DRAWING NUMBER: ESC-04 ADOPTED:

SOURCE: MODIFIED FROM VA. DCR, 1992

EROSION CONTROL BLANKET INSTALLATION FOR CHANNELS

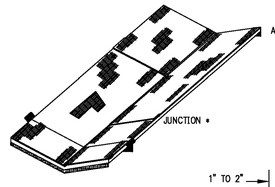

NOTE:
* JUNCTION: OVERLAP TOP BLANKET 6 INCHES MINIMUM AND STAPLE EVERY 6 INCHES ACROSS.

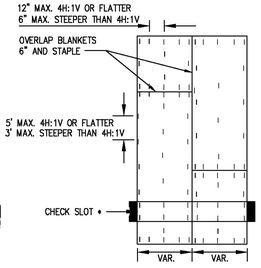

PLAN VIEW
STAPLING DIAGRAM
NOT TO SCALE

NOTE:
* CHECK SLOTS AT MIN. 50' INTERVALS; NOT REQUIRED WITH ALL COMBINATION BLANKETS

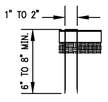

NOT TO SCALE

NOTE:
STAPLE FORMED FROM NO.11 STEEL WIRE.
MIN. 8" STAPLE LENGTH FOR SANDY SOIL.
MIN. 6" STAPLE LENGTH FOR OTHER SOIL.

NOTE:
APPROXIMATELY 200 STAPLES ARE REQUIRED PER 100 SQ. YDS. OF MATERIAL ROLL. ANCHOR SLOTS, JUNCTION SLOTS, AND CHECK SLOTS TO BE BURIED 6" TO 12" DEEP.

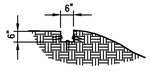

ANCHOR SLOT

EROSION CONTROL BLANKET NOTES (2 OF 2):

F) STAPLES:
STAPLES FOR ANCHORING BLANKET SHALL BE NO. 11-GAUGE WIRE OR HEAVIER. THEIR LENGTH SHALL BE A MINIMUM OF 6 INCHES. A LARGER STAPLE WITH A LENGTH OF UP TO 12 INCHES SHALL BE USED ON LOOSE, SANDY, OR UNSTABLE SOILS.

G) JOINING PREOTECTIVE COVERINGS:
OVERLAP THE END OF THE PREVIOUS ROLL A MINIMUM OF 6 INCHES AND STAPLE. STAPLE ACROSS THE END OF THE ROLL JUST BELOW THE ANCHOR SLOT AND ACROSS THE MATERIAL EVERY 6 INCHES.

H) TERMINAL END:
AT THE POINT AT WHICH THE MATERIAL IS DISCONTINUED, OR WHERE THE PROTECTIVE COVERING MEETS A STRUCTURE OF SOME TYPE, STAPLE A MINIMUM OF EVERY 12 INCHES.

I) FINAL CHECK:
THESE INSTALLATION CRITERIA MUST BE ADHERED TO:
1. ALL DISTURBED AREAS ARE SEEDED.
2. PROTECTIVE BLANKET IS IN UNIFORM CONTACT WITH THE SOIL.
3. ALL LAP JOINTS ARE SECURE.
4. ALL STAPLES ARE DRIVEN FLUSH WITH THE GROUND.

AMERICAN PUBLIC WORKS ASSOCIATION	
APWA	KANSAS CITY METROPOLITAN CHAPTER
EROSION CONTROL BLANKET SHEET 2 OF 2	STANDARD DRAWING NUMBER: ESC-05 ADOPTED:

SOURCE: MODIFIED FROM VA. DCR, 1992

Engineering Surveys & Services
DELIVERING YOUR VISION ™
1113 Fay Street, Columbia, MO 65201
573 - 449 - 2646
802 El Dorado Drive, Jefferson City, MO 65101
573-636-3303
1775 West Main Street, Sedalia, MO 65301
660-826-6618
www.ess-inc.com
MO Engineering Corp. # 2004005018

WILSHIRE HILLS PHASE III

3200 NE WILSHIRE DR
LEE'S SUMMIT, JACKSON COUNTY, MISSOURI

6/30/2023
STATE OF MISSOURI
MATTHEW AARON KRIETE
NUMBER PE-2007002811
PROFESSIONAL ENGINEER

MATTHEW A. KRIETE
PROFESSIONAL ENGINEER
PE-2007002811

IF ORIGINAL SIGNATURE OR DIGITAL AUTHENTICATION IS NOT PRESENT THIS MEDIA SHOULD NOT BE CONSIDERED A CERTIFIED DOCUMENT.

Date
JUNE 30, 2023

Revised

Design: ST Drawn: MJS

EROSION CONTROL DETAILS

Sheet
C14.01

ES&S PROJECT NO. 15925

CONSTRUCTION DOCUMENTS

P:\GENERAL PROJECTS\15925E-JES-WILSHIRE-HILLS-3-ENG\CAD\15925 COVER & DETAILS.DWG 6/30/2023

STAKES, STAPLES, AND PINS

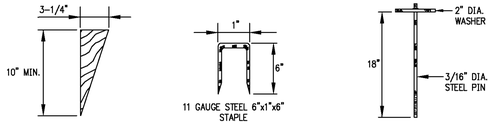

1. STAKE SEE NOTE 1

2. STAPLE SEE NOTE 2

3. PIN SEE NOTE 3

STAKES, STAPLES, AND PINS FOR INSTALLATION OF ROLLED EROSION CONTROL PRODUCTS
NOT TO SCALE

STAKES, STAPLES, AND PINS NOTES; GENERAL NOTES:

1. STAKES SHALL BE 1x4 TRIANGULAR SURVEY STAKES A MINIMUM OF 10" IN LONG.
2. STAPLES SHALL BE 11 GAUGE STEEL A MINIMUM OF 1" WIDE BY 6" IN LONG. A 2"x8" STAPLE MAY BE REQUIRED IN CERTAIN SOIL CONDITIONS.
3. STEEL PINS SHALL BE 3/16 DIAMETER BY 18" IN LONG WITH A 2" DIAMETER WASHER ON TOP. (SEE ILLUSTRATION.)
4. ANCHORING METHODS AND RECOMMENDATIONS VARY BY MANUFACTURERS. THE EXPECTATION OF HIGH VELOCITIES SHOULD DICTATE THE USE OF MORE SUBTANTIAL ANCHORING.

SOURCE: MODIFIED FROM VA. DCR, 1992

AMERICAN PUBLIC WORKS ASSOCIATION		
APWA	KANSAS CITY METROPOLITAN CHAPTER	
STAKES, STAPLES, AND PINS	STANDARD DRAWING NUMBER: ESC-08	ADOPTED:

STAPLE PATTERNS FOR ROLLED EROSION CONTROL PRODUCTS

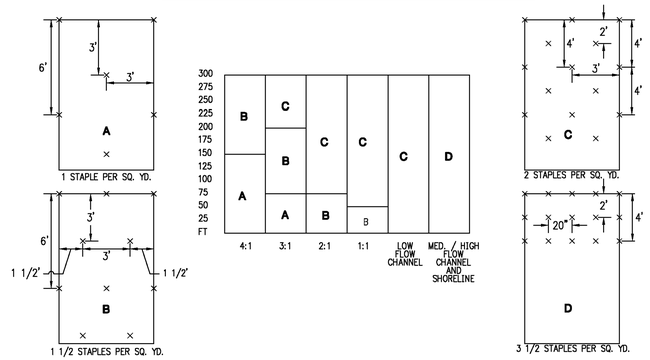

GENERAL STAPLE PATTERN GUIDE AND RECOMMENDATIONS FOR ROLLED EROSION CONTROL PRODUCTS
NOT TO SCALE

NOTE:
FOR OPTIMUM RESULTS, THESE RECOMMENDED STAPLE PATTERN GUIDES MUST BE FOLLOWED UNLESS OTHERWISE DICTATED BY THE MANUFACTURER. SUGGESTED ANCHORING METHODS VARY BY MANUFACTURER. THIS CHART SHOWS HOW SLOPE LENGTHS AND GRADIENTS AFFECT STAPLING PATTERNS.

SOURCE: MODIFIED FROM VA. DCR, 1992

AMERICAN PUBLIC WORKS ASSOCIATION		
APWA	KANSAS CITY METROPOLITAN CHAPTER	
STAPLE PATTERNS FOR ROLLED EROSION CONTROL PRODUCTS	STANDARD DRAWING NUMBER: ESC-09	ADOPTED:

SEDIMENT FENCE

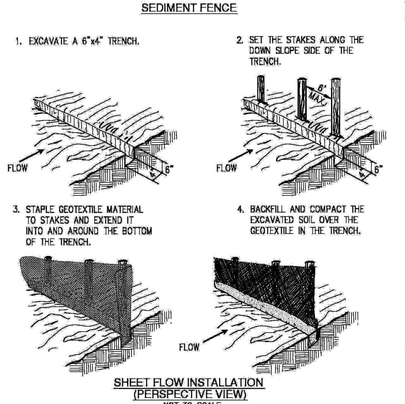

SHEET FLOW INSTALLATION (PERSPECTIVE VIEW)
NOT TO SCALE

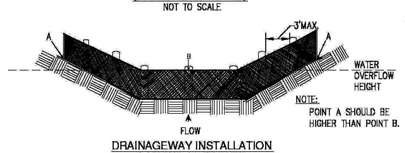

DRAINAGEWAY INSTALLATION (FRONT ELEVATION)
NOT TO SCALE

SEDIMENT FENCE NOTES:

A) INSTALLATION:

1. THE HEIGHT OF SEDIMENT FENCE SHALL BE A MINIMUM OF 16 INCHES ABOVE THE ORIGINAL GROUND SURFACE AND SHALL NOT EXCEED 34 INCHES ABOVE THE GROUND SURFACE.
2. THE FABRIC SHALL BE PURCHASED IN A CONTINUOUS ROLL CUT TO THE LENGTH OF THE BARRIER TO AVOID THE USE OF JOINTS. WHEN JOINTS ARE UNAVOIDABLE, FILTER CLOTH SHALL BE SECURELY SPLICED TOGETHER ONLY AT SUPPORT POSTS, WITH A MAX 6-INCH OVERLAP.
3. DIG A TRENCH AT LEAST 6 INCHES DEEP AND 4 INCHES WIDE ALONG THE FENCE ALIGNMENT.
4. DRIVE POSTS AT LEAST 24 INCHES INTO THE GROUND ON THE DOWNSLOPE SIDE OF THE TRENCH. SPACE POSTS A MAXIMUM OF 6 FEET APART.
5. EXTRA-STRENGTH SEDIMENT FENCE FABRIC SHALL BE USED. POSTS FOR THIS TYPE OF FABRIC SHALL BE PLACED A MAXIMUM OF 6 FEET APART. THE SEDIMENT FABRIC SHALL BE FASTENED SECURELY TO THE UPSLOPE SIDE OF THE POSTS USING A MINIMUM OF ONE INCH LONG, HEAVY-DUTY WIRE STAPLES OR TIE-WIRES, AND EIGHT INCHES OF THE FABRIC SHALL BE EXTENDED INTO THE TRENCH. THE FABRIC SHALL NOT BE STAPLED TO EXISTING TREES.
6. PLACE THE BOTTOM 1 FOOT OF FABRIC IN THE MINIMUM-OF-6-INCH DEEP TRENCH, LAPPING TOWARD THE UPSLOPE SIDE. BACKFILL WITH COMPACTED EARTH OR GRAVEL.
7. IF A SEDIMENT FENCE IS TO BE CONSTRUCTED ACROSS A DITCH LINE OR SWALE, IT MUST BE OF SUFFICIENT LENGTH TO ELIMINATE ENDFLOW, AND THE PLAN CONFIGURATION SHALL RESEMBLE AN ARC OR HORSESHOE, PLACED ON A CONTOUR, WITH THE ENDS ORIENTED UPSLOPE. EXTRA-STRENGTH SEDIMENT FABRIC SHALL BE USED WITH A MAXIMUM 3-FOOT SPACING OF POSTS.
8. TO REDUCE MAINTENANCE, EXCAVATE A SHALLOW SEDIMENT STORAGE AREA IN THE UPSLOPE SIDE OF THE FENCE. PROVIDE GOOD ACCESS IN AREAS OF HEAVY SEDIMENTATION FOR CLEAN OUT AND MAINTENANCE.
9. SEDIMENT FENCES SHALL BE REMOVED WHEN THEY HAVE SERVED THEIR USEFUL PURPOSE, BUT NOT BEFORE THE UPSLOPE AREA HAS BEEN PERMANENTLY STABILIZED.

B) TROUBLESHOOTING:

1. DETERMINE THE EXACT LOCATION OF UNDERGROUND UTILITIES, BEFORE FENCE INSTALLATION SO UTILITIES ARE NOT DISTURBED.
2. GRADE ALIGNMENT OF FENCE AS NEEDED TO PROVIDE A BROAD, NEARLY LEVEL AREA UPSTREAM OF FENCE TO ALLOW SEDIMENT COLLECTION AREA.

C) INSPECTION MAINTENANCE:

1. INSPECT SEDIMENT FENCES AT LEAST ONCE A WEEK AND AFTER EACH RAINFALL. MAKE ANY REQUIRED REPAIRS IMMEDIATELY.
2. SHOULD THE FABRIC OF A SEDIMENT FENCE COLLAPSE, TEAR, DECOMPOSE, OR BECOME INEFFECTIVE, REPLACE IT PROMPTLY.
3. REMOVE SEDIMENT DEPOSITS AS NECESSARY TO PROVIDE ADEQUATE STORAGE VOLUME FOR THE NEXT RAIN AND TO REDUCE PRESSURE ON THE FENCE. AVOID DAMAGING OR UNDERMINING THE FENCE DURING CLEANOUT. SEDIMENT ACCUMULATION SHOULD NOT EXCEED 1/2 THE HEIGHT OF THE FENCE.
4. REMOVE ALL FENCING MATERIALS AND UNSTABLE SEDIMENT DEPOSITS, AND BRING THE AREA TO GRADE AND STABILIZE IT AFTER THE CONTRIBUTING DRAINAGE AREA HAS BEEN PROPERLY AND COMPLETELY STABILIZED.

SOURCE: MODIFIED FROM VA. DCR, 1992

AMERICAN PUBLIC WORKS ASSOCIATION		
APWA	KANSAS CITY METROPOLITAN CHAPTER	
SEDIMENT FENCE	STANDARD DRAWING NUMBER: ESC-10	ADOPTED:

SEDIMENT FENCE DROP INLET PROTECTION

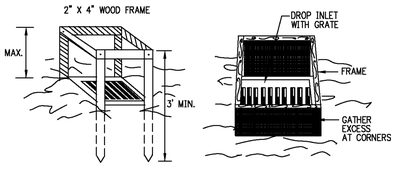

PERSPECTIVE VIEWS
NOT TO SCALE

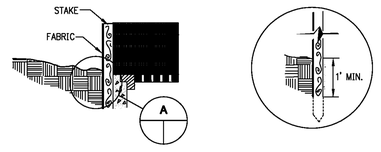

ELEVATION OF STAKE AND FABRIC ORIENTATION

DETAIL A
NOT TO SCALE

SEDIMENT FENCE DROP INLET PROTECTION NOTES:

A) CONSTRUCTION SPECIFICATIONS:

1. SEDIMENT FENCE SHALL CONFORM TO THE CONSTRUCTION SPECIFICATIONS FOR EXTRA STRENGTH FOUND IN THE TABLE BELOW AND SHALL BE CUT FROM A CONTINUOUS ROLL TO AVOID JOINTS.

   PHYSICAL PROPERTIES OF FABRIC IN SEDIMENT FENCE:

PHYSICAL PROPERTY	TEST	REQUIREMENTS
FILTERING EFFICIENCY	ASTM 5141	75%
TENSILE STRENGTH AT 20% (MAX.) ELONGATION*	ASTM 4632 AASHTO M288-96	EXTRA STRENGTH – 50 LBS./LINEAR INCH
FLOW RATE	ASTM 5141	0.2 GAL./SQ.FT/ MINUTE**
ULTRAVIOLET RADIATION STABILITY %	ASTM D 4355	90%

   * REQUIREMENTS REDUCED BY 50% AFTER SIX MONTHS OF INSTALLATION.
   ** HIGH POROSITY FABRIC MADE BY BETTER SUITED FOR THIS DEVICE.
2. FOR STAKES, USE 2X4 WOOD OR EQUIVALENT METAL WITH A MINIMUM LENGTH OF 3 FEET.
3. SPACE STAKES EVENLY AROUND THE PERIMETER OF THE INLET A MAXIMUM OF 3 FEET APART, AND SECURELY DRIVE THEM INTO THE GROUND, APPROXIMATELY 18 INCHES DEEP.
4. TO PROVIDE NEEDED STABILITY TO THE INSTALLATION, FRAME WITH 2X4 WOOD STRIPS AROUND THE CREST OF THE OVERFLOW AREA AT A MAXIMUM OF 1.5 FEET ABOVE THE DROP INLET CREST.
5. PLACE THE BOTTOM 12 INCHES OF THE FABRIC IN A TRENCH AND BACKFILL THE TRENCH WITH 12-INCHES OF COMPACTED SOIL.
6. FASTEN FABRIC SECURELY BY STAPLES, OR WIRE IT TO THE STAKES AND FRAME. JOINTS MUST BE OVERLAPPED TO THE NEXT STAKE.
7. IT MAY BE NECESSARY TO BUILD A TEMPORARY DIKE ON THE DOWNSLOPE SIDE OF THE STRUCTURE TO PREVENT BYPASS FLOW.

B) INSPECTION AND MAINTENANCE:

1. THE STRUCTURE SHALL BE INSPECTED AFTER EACH RAIN EVENT OF 1/2 INCH OR GREATER AND REPAIRS MADE AS NEEDED.
2. SEDIMENT SHALL BE REMOVED AND THE TRAP RESTORED TO ITS ORIGINAL DIMENSIONS WHEN THE SEDIMENT HAS ACCUMULATED TO ONE HALF THE DESIGN DEPTH OF THE TRAP. REMOVED SEDIMENT SHALL BE DEPOSITED IN A SUITABLE AREA AND IN SUCH A MANNER THAT IT WILL NOT ERODE.
3. STRUCTURES SHALL BE REMOVED AND THE AREA STABILIZED WHEN THE REMAINING DRAINAGE AREA HAS BEEN PROPERLY STABILIZED.

SOURCE: MODIFIED FROM VA. DCR, 1992

AMERICAN PUBLIC WORKS ASSOCIATION		
APWA	KANSAS CITY METROPOLITAN CHAPTER	
SEDIMENT FENCE DROP INLET PROTECTION	STANDARD DRAWING NUMBER: ESC-19	ADOPTED:

Engineering Surveys & Services
DELIVERING YOUR VISION ™
1113 Fay Street, Columbia, MO 65201
573 - 449 - 2646
802 El Dorado Drive, Jefferson City, MO 65101
573-636-3303
1775 West Main Street, Sedalia, MO 65301
660-826-8618
www.ess-inc.com
MO Engineering Corp. # 2004005018

WILSHIRE HILLS PHASE III

3200 NE WILSHIRE DR

LEE'S SUMMIT, JACKSON COUNTY, MISSOURI

CONSTRUCTION DOCUMENTS

6/30/2023

STATE OF MISSOURI
MATTHEW AARON KRIETE
NUMBER PE-2007002811
PROFESSIONAL ENGINEER

MATTHEW A. KRIETE
PROFESSIONAL ENGINEER
PE-2007002811

IF ORIGINAL SIGNATURE OR DIGITAL AUTHENTICATION IS NOT PRESENT THIS MEDIA SHOULD NOT BE CONSIDERED A CERTIFIED DOCUMENT.

Date
JUNE 30, 2023

Revised

Design: ST Drawn: MJS

EROSION CONTROL DETAILS

Sheet
C14.02

ES&S PROJECT NO. 15925

P:\GENERAL PROJECTS\15925E-JES-WILSHIRE-HILLS-3-ENG\CAD\15925 COVER & DETAILS.DWG 6/30/2023

DIVERSIONS

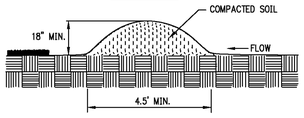

TEMPORARY DIVERSION DIKE
NOT TO SCALE

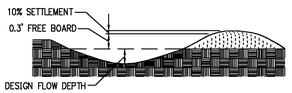

TYPICAL PARABOLIC DIVERSION

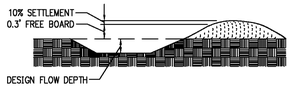

TYPICAL TRAPEZOIDAL DIVERSION

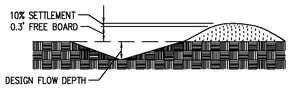

TYPICAL VEE-SHAPED DIVERSION

TEMPORARY RIGHT-OF-WAY DIVERSIONS

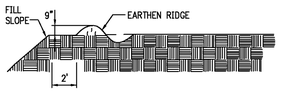

TEMPORARY FILL DIVERSION
NOT TO SCALE

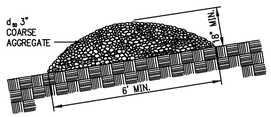

TYPICAL GRAVEL STRUCTURE

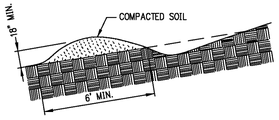

TYPICAL EARTHEN STRUCTURE

TEMPORARY DIVERSION DIKE NOTES:

1. TEMPORARY DIVERSION DIKES MUST BE INSTALLED AS A FIRST STEP IN THE LAND-DISTURBING ACTIVITY AND MUST BE FUNCTIONAL PRIOR TO UPSLOPE LAND DISTURBANCE.
2. THE DIKE SHOULD BE ADEQUATELY COMPACTED TO PREVENT FAILURE.
3. TEMPORARY OR PERMANENT SEEDING AND MULCH SHALL BE APPLIED TO THE DIKE IMMEDIATELY FOLLOWING ITS CONSTRUCTION.
4. THE DIKE SHOULD BE LOCATED TO MINIMIZE DAMAGES BY CONSTRUCTION OPERATIONS AND TRAFFIC.

TEMPORARY FILL DIVERSION NOTES:

1. THE DIVERSION SHALL BE CONSTRUCTED AT THE TOP OF THE FILL AT THE END OF EACH WORK DAY AS NEEDED.
2. THE DIVERSION SHALL BE LOCATED AT LEAST 2 FEET INSIDE THE TOP EDGE OF THE FILL.
3. THE SUPPORTING RIDGE SHALL BE CONSTRUCTED WITH A UNIFORM HEIGHT ALONG ITS ENTIRE LENGTH. WITHOUT UNIFORM HEIGHT, THE FILL DIVERSION MAY BE SUSCEPTIBLE TO BREACHING.

RIGHT-OF-WAY DIVERSION DETAIL NOTES:

1. THE DIVERSION SHALL BE INSTALLED AS SOON AS THE RIGHT-OF-WAY HAS BEEN CLEARED AND/OR GRADED.
2. ALL EARTHEN DIVERSIONS SHALL BE MACHINE- OR HAND-COMPACTED IN 8-INCH LIFTS.
3. THE OUTLET OF THE DIVERSION SHALL BE LOCATED IN AN UNDISTURBED AND STABILIZED AREA WHEN AT ALL POSSIBLE. THE FIELD LOCATION SHOULD BE ADJUSTED AS NEEDED TO UTILIZE A STABILIZED OUTLET.
4. EARTHENED DIVERSIONS WHICH WILL NOT BE SUBJECT TO CONSTRUCTION TRAFFIC SHOULD BE STABILIZED IN ACCORDANCE WITH TEMPORARY SEEDING.

DIVERSION DETAIL NOTES:

1. ALL TREES, BRUSH, STUMPS, OBSTRUCTIONS, AND OTHER OBJECTIONABLE MATERIAL SHALL BE REMOVED AND DISPOSED OF SO AS NOT TO INTERFERE WITH THE PROPER FUNCTIONING OF THE DIVERSION.
2. THE DIVERSION SHALL BE EXCAVATED OR SHAPED TO LINE, GRADE, AND CROSS-SECTION AS REQUIRED TO MEET THE CRITERIA SPECIFIED HEREIN, FREE OF IRREGULARITIES WHICH WILL IMPEDE FLOW.
3. FILLS SHALL BE COMPACTED AS NEEDED TO PREVENT UNEQUAL SETTLEMENT THAT WOULD CAUSE DAMAGE IN THE COMPLETED DIVERSION. FILL SHALL BE COMPOSED OF SOIL WHICH IS FREE FROM EXCESSIVE ORGANIC DEBRIS, ROCKS, OR OTHER OBJECTIONABLE MATERIALS.
4. ALL EARTH REMOVED AND NOT NEEDED IN CONSTRUCTION SHALL BE SPREAD OR DISPOSED OF SO THAT IT WILL NOT INTERFERE WITH THE FUNCTIONING OF THE DIVERSION.
5. PERMANENT STABILIZATION OF DISTURBED AREAS SHALL BE DONE IN ACCORDANCE WITH SECTION 2151.

SOURCE: MODIFIED FROM VA. DCR, 1992

AMERICAN PUBLIC WORKS ASSOCIATION	
APWA	KANSAS CITY METROPOLITAN CHAPTER
DIVERSIONS	STANDARD DRAWING NUMBER ESC-29 ADOPTED:

TEMPORARY SEDIMENT TRAP

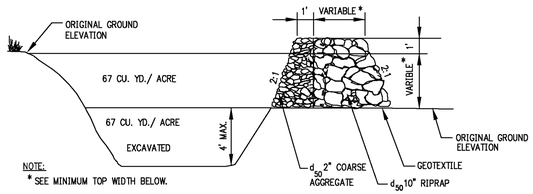

CROSS SECTION OF OUTLET
NOT TO SCALE

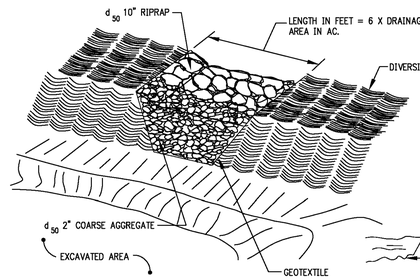

OUTLET (PERSPECTIVE VIEW)

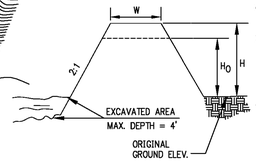

H	HO	W
1.5	0.5	2.0
2.0	1.0	2.0
2.5	1.5	2.5
3.0	2.0	2.5
3.5	2.5	3.0
4.0	3.0	3.0
4.5	3.5	4.0
5.0	4.0	4.5

MINIMUM TOP WIDTH
NOT TO SCALE

TEMPORARY SEDIMENT TRAP NOTES:

A) CONSTRUCTION SPECIFICATIONS:

1. THE AREA UNDER THE EMBANKMENT SHALL BE CLEARED, GRUBBED, AND STRIPPED OF ANY VEGETATION AND ROOT MAT.
2. FILL MATERIAL FOR THE EMBANKMENT SHALL BE FREE OF ROOTS OR OTHER WOODY VEGETATION, ORGANIC MATERIAL, LARGE STONES, AND OTHER OBJECTIONABLE MATERIAL. THE EMBANKMENT SHOULD BE COMPACTED IN 6-INCH LAYERS BY TRAVERSING WITH CONSTRUCTION EQUIPMENT.
3. THE EARTHEN EMBANKMENT SHALL BE SEEDED WITH TEMPORARY OR PERMANENT VEGETATION IMMEDIATELY AFTER INSTALLATION.
4. CONSTRUCTION OPERATIONS SHALL BE CARRIED OUT TO MINIMIZE EROSION AND WATER POLLUTION.
5. THE STRUCTURE SHALL BE REMOVED AND THE AREA STABILIZED WHEN THE UPSLOPE DRAINAGE AREA HAS BEEN STABILIZED.
6. ALL CUT AND FILL SLOPES SHALL BE 2H:1V OR FLATTER EXCEPT FOR EXCAVATED, WET STORAGE AREAS WHICH MAY BE AT A MAXIMUM 1H:1V GRADE.

B) INSPECTION AND MAINTENANCE:

1. INSPECT THE TEMPORARY SEDIMENT TRAP AFTER EACH STORM EVENT OF 1/2-INCH OR GREATER.
2. REMOVE AND PROPERLY DISPOSE OF SEDIMENT WHEN IT ACCUMULATES TO ONE-HALF THE DESIN VOLUME AS INDICATED BY THE CLEAN-OUT STAKE.
3. PERIODICALLY CHECK THE EMBANKMENT, SPILLWAY, AND OUTLET APRON FOR EROSION DAMAGE, SETTLING SEEPAGE, OR SLUMPING ALONG THE TOE AND REPAIR IMMEDIATELY.
4. REPLACE THE SPILLWAY GRAVEL FACING IF IT BECOMES CLOGGED.
5. INSPECT VEGETATION AND RESEED IF NECESSARY.
6. REPLACE ANY DISPLACED RIPRAP SO THAT NO REPLACEMENT ROCK IS ABOVE THE DESIGN GRADE.
7. REMOVE THE TEMPORARY SEDIMENT TRAP AFTER THE DRAINAGE AREA HAS BEEN PERMANENTLY STABILIZED, INSPECTED, AND APPROVED. DO SO BY DRAINING ANY WATER, REMOVING THE SEDIMENT TO A DESIGNATED DISPOSAL AREA, AND GRADING THE SITE TO BLEND WITH THE SURROUNDING AREA; THEN STABILIZE.

SOURCE: MODIFIED FROM VA. DCR, 1992

AMERICAN PUBLIC WORKS ASSOCIATION	
APWA	KANSAS CITY METROPOLITAN CHAPTER
TEMPORARY SEDIMENT TRAP	STANDARD DRAWING NUMBER ESC-33 ADOPTED:

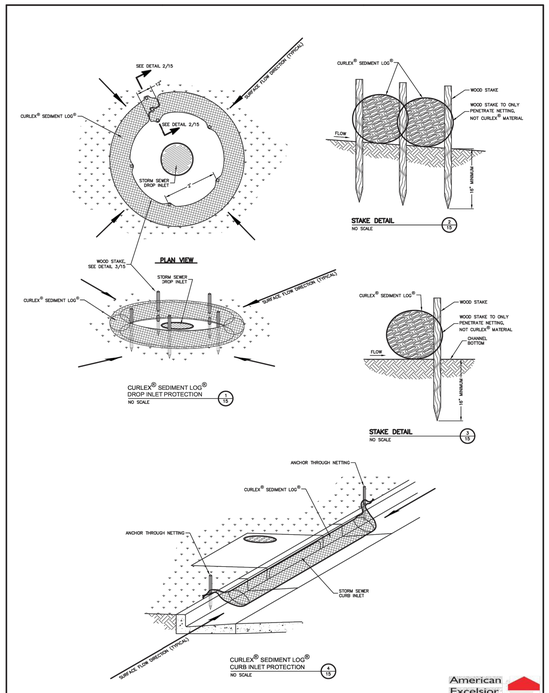

AMERICAN EXCELSIOR COMPANY ARLINGTON, TEXAS	SHEET DESCRIPTION: CURLEX® SEDIMENT LOG® INLET PROTECTION DETAILS	DATE 3/27/17	DRAWN BY
		SCALE: NONE	PROJECT NO.	SHEET NO. 15

American Excelsior Company® Earth Science Division

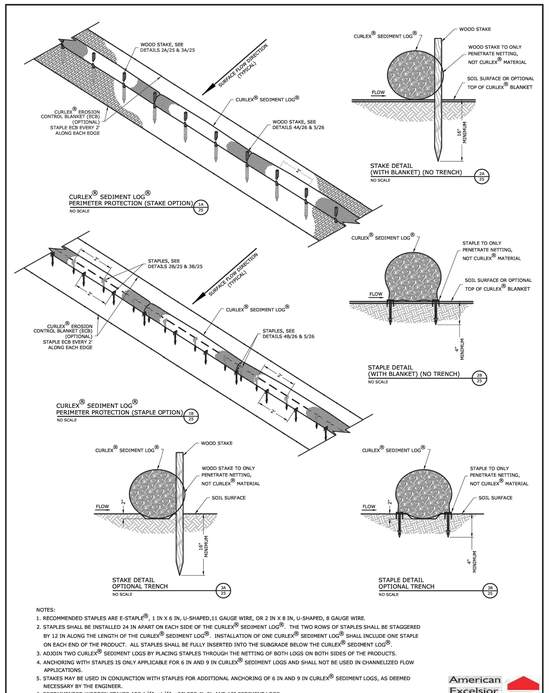

NOTES:
1. RECOMMENDED STAPLES ARE E-STAPLE®, 1 IN X 6 IN, U-SHAPED,11 GAUGE WIRE, OR 2 IN X 8 IN, U-SHAPED, 8 GAUGE WIRE.
2. STAPLES SHALL BE INSTALLED 24 IN APART ON EACH SIDE OF THE CURLEX® SEDIMENT LOG®. THE TWO ROWS OF STAPLES SHALL BE STAGGERED BY 12 IN ALONG THE LENGTH OF THE CURLEX® SEDIMENT LOG®. INSTALLATION OF ONE CURLEX® SEDIMENT LOG® SHALL INCLUDE ONE STAPLE ON EACH END OF THE PRODUCT. ALL STAPLES SHALL BE FULLY INSERTED INTO THE SUBGRADE BELOW THE CURLEX® SEDIMENT LOG®.
3. ADJOIN TWO CURLEX® SEDIMENT LOGS BY PLACING STAPLES THROUGH THE NETTING OF BOTH LOGS ON BOTH SIDES OF THE PRODUCTS.
4. ANCHORING WITH STAPLES IS ONLY APPLICABLE FOR 6 IN AND 9 IN CURLEX® SEDIMENT LOGS AND SHALL NOT BE USED IN CHANNELIZED FLOW APPLICATIONS.
5. STAKES MAY BE USED IN CONJUNCTION WITH STAPLES FOR ADDITIONAL ANCHORING OF 6 IN AND 9 IN CURLEX® SEDIMENT LOGS, AS DEEMED NECESSARY BY THE ENGINEER.
6. RECOMMENDED WOODEN STAKES ARE 1 ½" x 1 ½" x 30" FOR 6", 9", AND 12" SEDIMENT LOGS.
7. RECOMMENDED WOODEN STAKES ARE 1 ½" x 1 ½" x 48" FOR 20" SEDIMENT LOGS.
8. CURLEX® SEDIMENT LOG® PERIMETER CONTROL DETAILS CONTINUE ON SHEET 26.

AMERICAN EXCELSIOR COMPANY ARLINGTON, TEXAS	SHEET DESCRIPTION: CURLEX® SEDIMENT LOG® PERIMETER CONTROL DETAILS	DATE 5/15/17	DRAWN BY
		SCALE: NONE	PROJECT NO.	SHEET NO. 25

American Excelsior Company® Earth Science Division

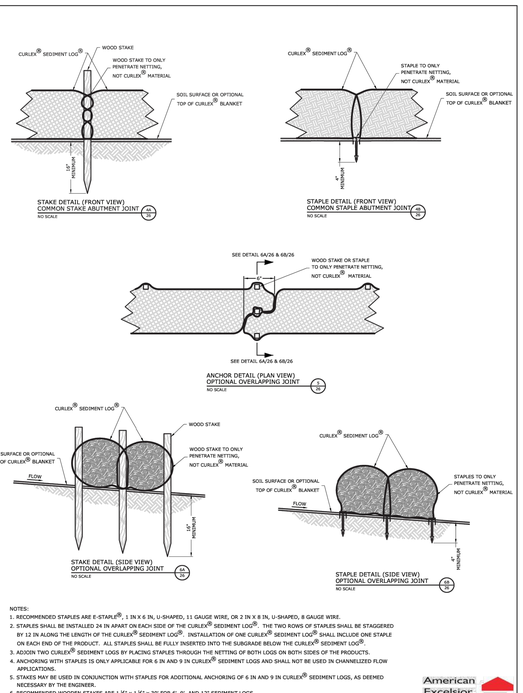

NOTES:
1. RECOMMENDED STAPLES ARE E-STAPLE®, 1 IN X 6 IN, U-SHAPED, 11 GAUGE WIRE, OR 2 IN X 8 IN, U-SHAPED, 8 GAUGE WIRE.
2. STAPLES SHALL BE INSTALLED 24 IN APART ON EACH SIDE OF THE CURLEX® SEDIMENT LOG®. THE TWO ROWS OF STAPLES SHALL BE STAGGERED BY 12 IN ALONG THE LENGTH OF THE CURLEX® SEDIMENT LOG®. INSTALLATION OF ONE CURLEX® SEDIMENT LOG® SHALL INCLUDE ONE STAPLE ON EACH END OF THE PRODUCT. ALL STAPLES SHALL BE FULLY INSERTED INTO THE SUBGRADE BELOW THE CURLEX® SEDIMENT LOG®.
3. ADJOIN TWO CURLEX® SEDIMENT LOGS BY PLACING STAPLES THROUGH THE NETTING OF BOTH LOGS ON BOTH SIDES OF THE PRODUCTS.
4. ANCHORING WITH STAPLES IS ONLY APPLICABLE FOR 6 IN AND 9 IN CURLEX® SEDIMENT LOGS AND SHALL NOT BE USED IN CHANNELIZED FLOW APPLICATIONS.
5. STAKES MAY BE USED IN CONJUNCTION WITH STAPLES FOR ADDITIONAL ANCHORING OF 6 IN AND 9 IN CURLEX® SEDIMENT LOGS, AS DEEMED NECESSARY BY THE ENGINEER.
6. RECOMMENDED WOODEN STAKES ARE 1 ½" x 1 ½" x 30" FOR 6", 9", AND 12" SEDIMENT LOGS.
7. RECOMMENDED WOODEN STAKES ARE 1 ½" x 1 ½" x 48" FOR 20" SEDIMENT LOGS,

AMERICAN EXCELSIOR COMPANY ARLINGTON, TEXAS	SHEET DESCRIPTION: CURLEX® SEDIMENT LOG® PERIMETER CONTROL DETAILS	DATE 5/8/17	DRAWN BY
		SCALE: NONE	PROJECT NO.	SHEET NO. 26

American Excelsior Company® Earth Science Division

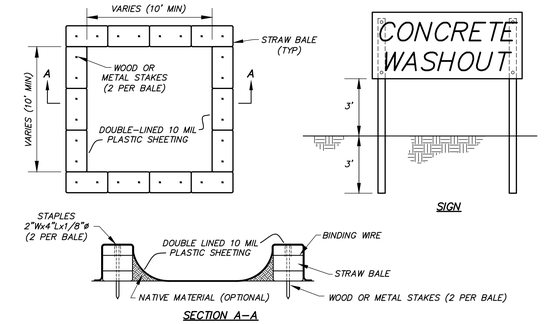

SECTION A-A

NOTES:
1. ALL CONCRETE WASTE MATERIAL, INCLUDING WASHOUT WATER, SHALL BE TOTALLY CONTAINED.
2. SEE SWPPP FOR MORE DETAILS.
3. UPON PROJECT COMPLETION CONTRACTOR SHALL REMOVE AND DISPOSE OF ALL CONCRETE WASTE FROM THE OWNER'S PROPERTY PER ALL APPLICABLE SOLID WASTE REGULATIONS.
4. CONSTRUCT SIGN OF WEATHER PROOF MATERIALS OF A SIZE EASILY READABLE BY CONCRETE TRUCK DRIVERS. PLACE SIGN WITHIN 10' OF WASHOUT.
5. CONTRACTOR SHALL CONTAIN WASHOUT WATERS AT ALL TIMES.

CONCRETE WASHOUT AREA
NOT TO SCALE

ES&S Engineering Surveys & Services
DELIVERING YOUR VISION ™
1113 Fay Street, Columbia, MO 65201 573 - 449 - 2646
802 El Dorado Drive, Jefferson City, MO 65101 573-636-3303
1775 West Main Street, Sedalia, MO 65301 660-826-6618
www.ess-inc.com
MO Engineering Corp. # 2004005018

WILSHIRE HILLS PHASE III

3200 NE WILSHIRE DR
LEE'S SUMMIT, JACKSON COUNTY, MISSOURI

6/30/2023
STATE OF MISSOURI
MATTHEW AARON KRIETE
NUMBER PE-2007002811
PROFESSIONAL ENGINEER

MATTHEW A. KRIETE
PROFESSIONAL ENGINEER
PE-2007002811

IF ORIGINAL SIGNATURE OR DIGITAL AUTHENTICATION IS NOT PRESENT THIS MEDIA SHOULD NOT BE CONSIDERED A CERTIFIED DOCUMENT.

Date
JUNE 30, 2023

Revised

Design: ST Drawn: MJS

EROSION CONTROL DETAILS

Sheet
C14.03

ES&S PROJECT NO. 15925

CONSTRUCTION DOCUMENTS

P:\GENERAL PROJECTS\15925\ES-WILSHIRE-HILLS-3-ENG\CAD\15925 COVER & DETAILS.DWG 6/30/2023

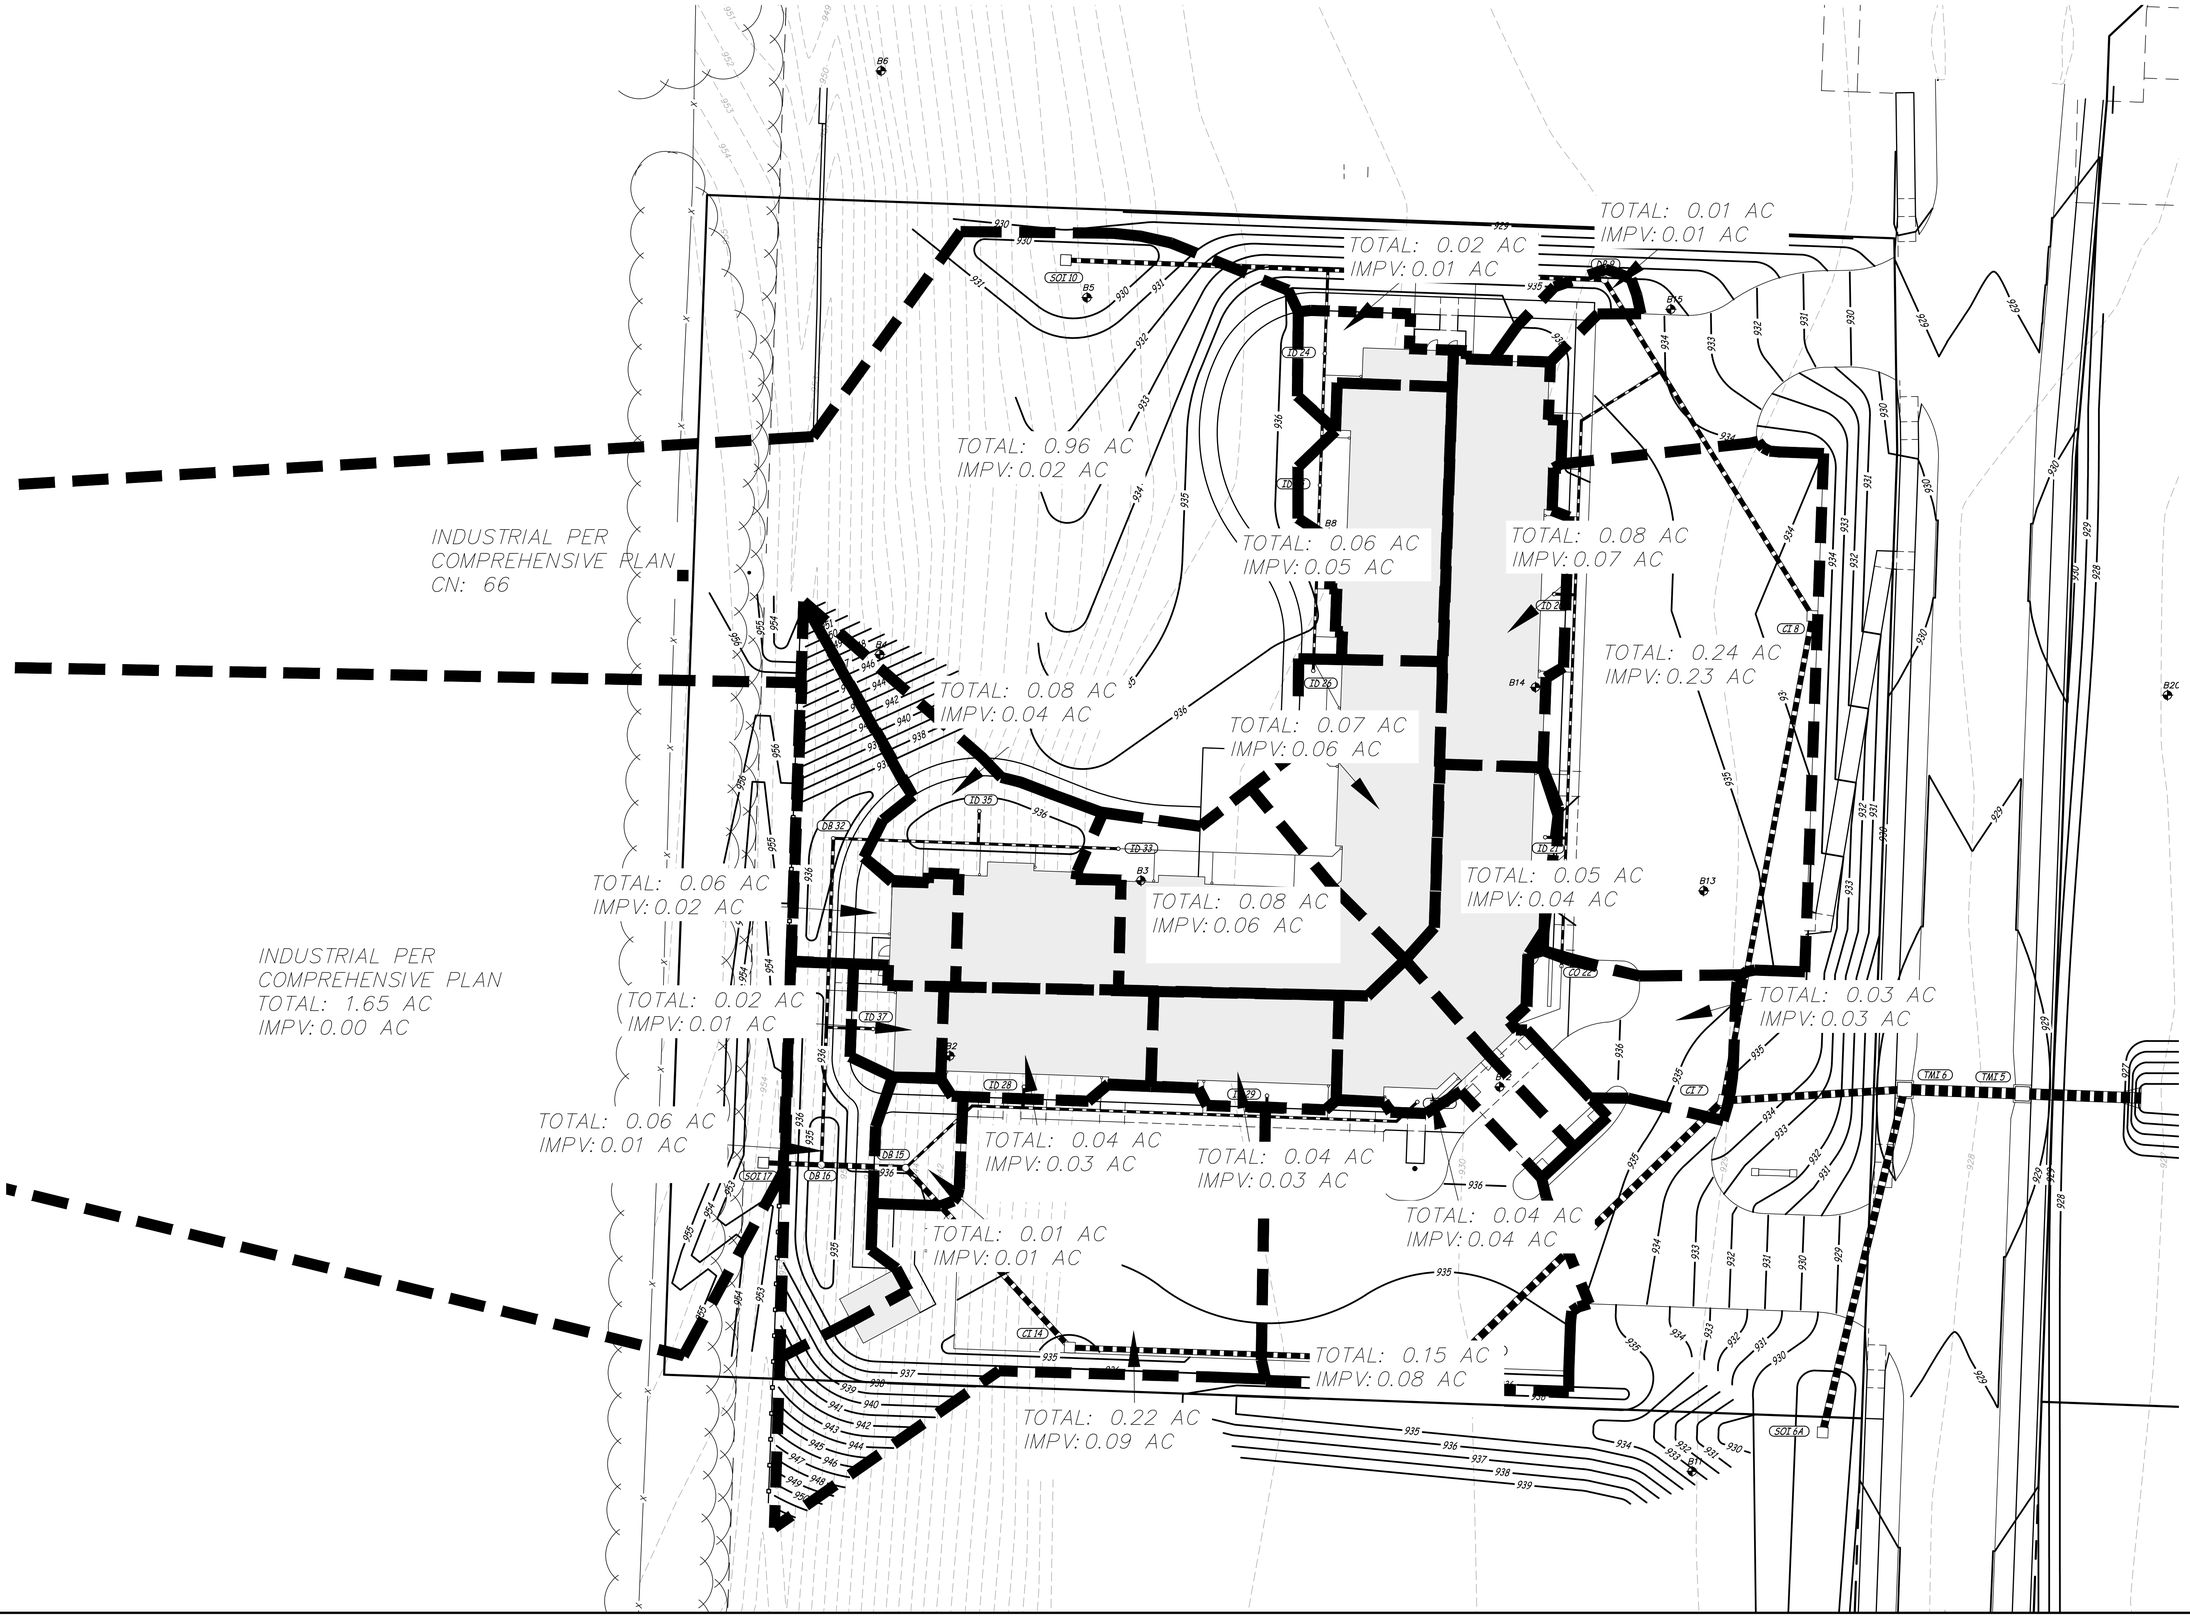

P:\GENERAL PROJECTS\15925E—JES—WILSHIRE—HILLS—3—ENG\CAD\15925 DAM (6-14-2023).DWG 6/30/2023

Engineering Surveys & Services
DELIVERING YOUR VISION ™

1113 Fay Street, Columbia, MO 65201
573 - 449 - 2646

802 El Dorado Drive, Jefferson City, MO 65101
573-636-3303

1775 West Main Street, Sedalia, MO 65301
660-826-8618

www.ess-inc.com

MO Engineering Corp. # 2004005018

N

0 1"
SCALE: 1" = 20'

WILSHIRE HILLS PHASE III

3200 NE WILSHIRE DR
LEE'S SUMMIT JACKSON COUNTY, MISSOURI

6/30/2023

STATE OF MISSOURI
MATTHEW AARON KRIETE
NUMBER PE-2007002811
PROFESSIONAL ENGINEER

MATTHEW A. KRIETE
PROFESSIONAL ENGINEER
PE-2007002811

IF ORIGINAL SIGNATURE OR DIGITAL AUTHENTICATION IS NOT PRESENT THIS MEDIA SHOULD NOT BE CONSIDERED A CERTIFIED DOCUMENT.

Date
JUNE 30, 2023

Revised

Design: ST Drawn: ST

CONSTRUCTION DOCUMENTS

STORM SEWER
DRAINAGE AREA MAP

Sheet
C15.01

ES&S PROJECT NO. 15925

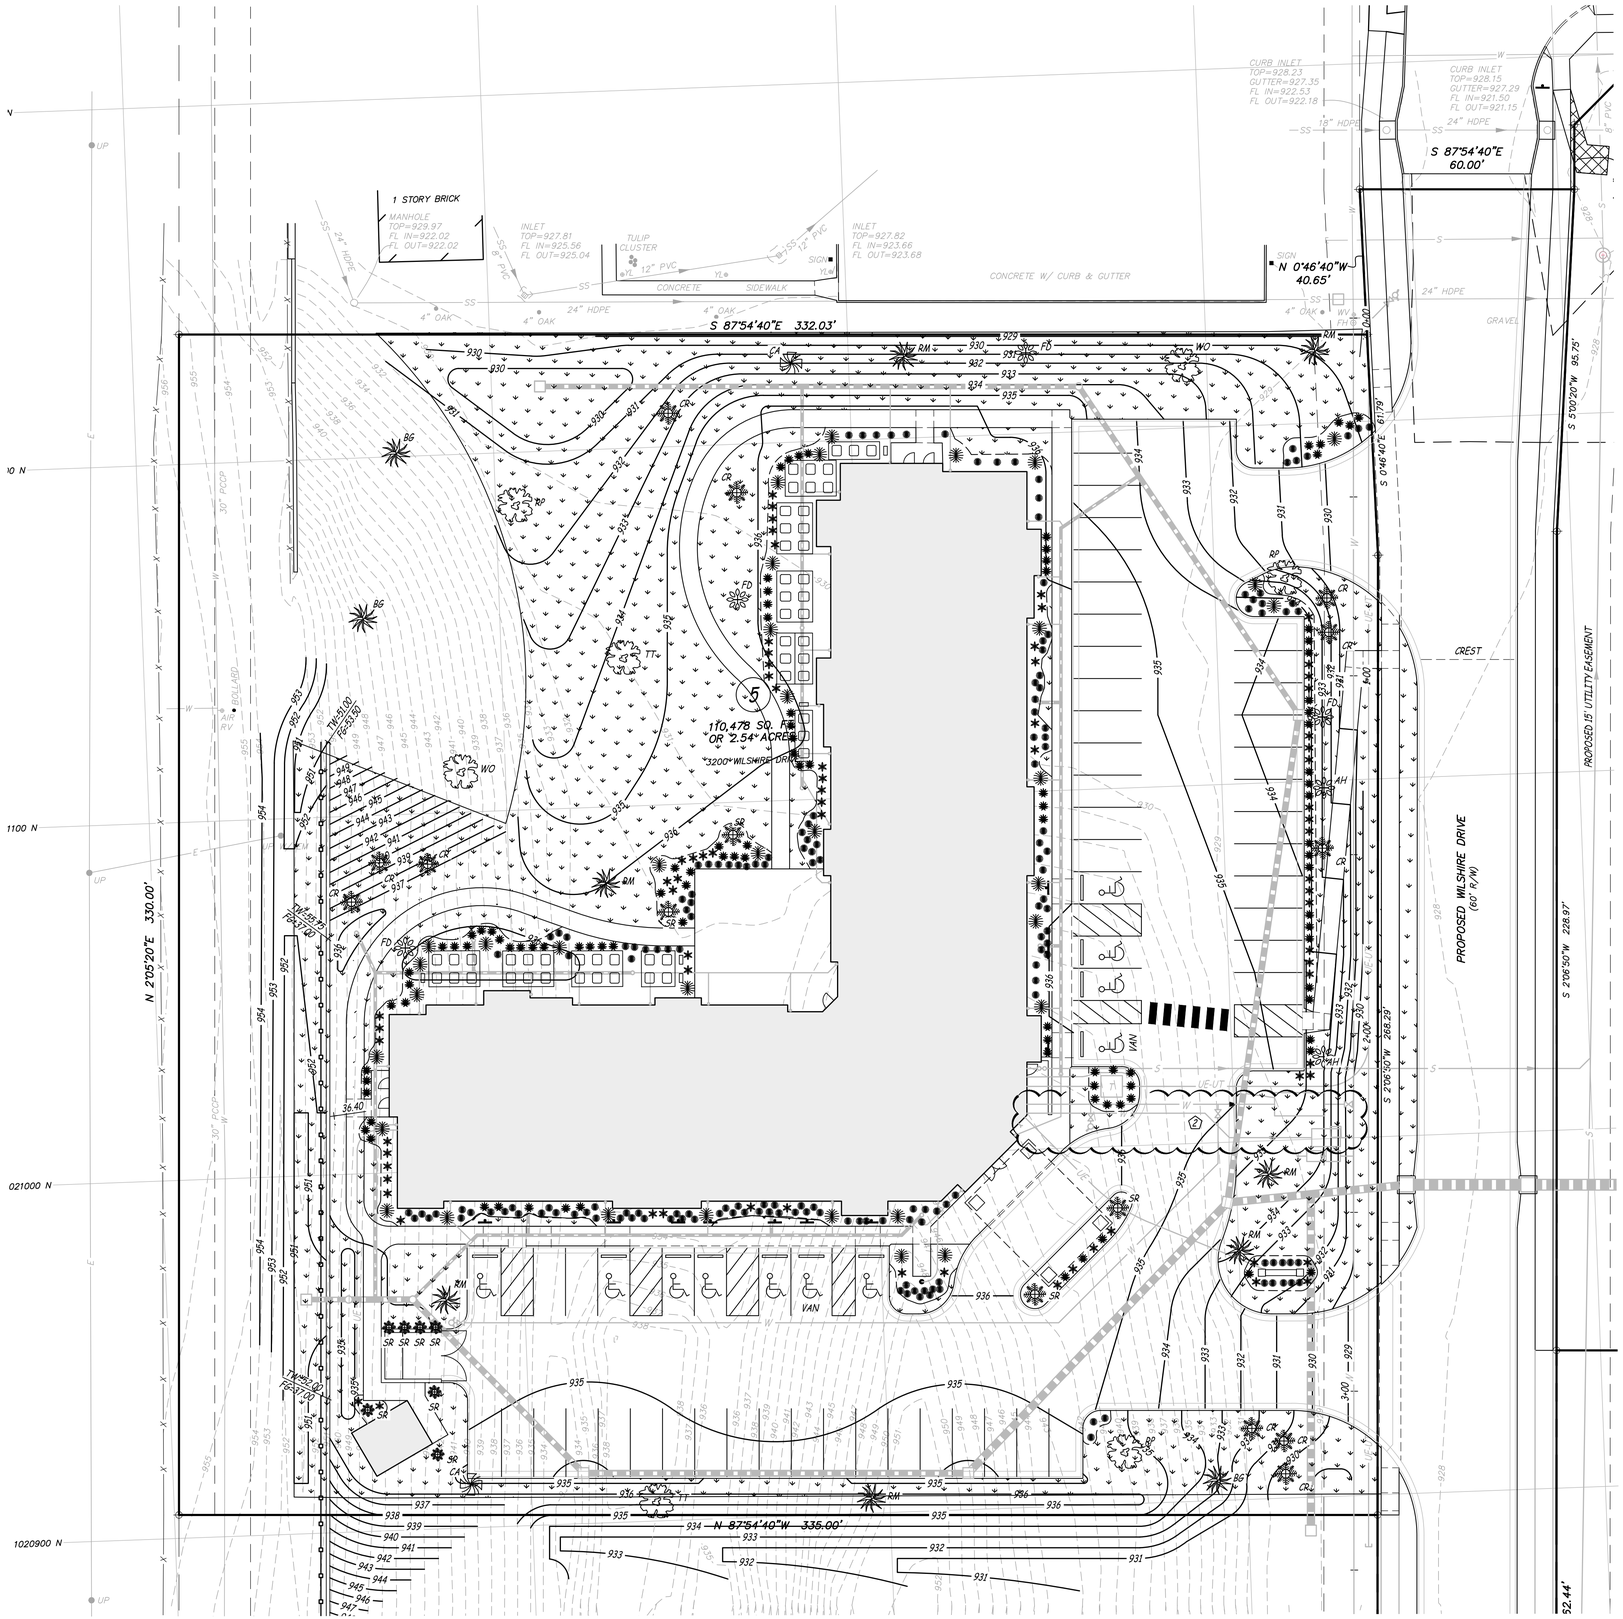

LANDSCAPING REQUIREMENTS	
REQUIRED	PROVIDED
PARKING LOT	
1. AT LEAST 5% OF ENTIRE AREA LANDSCAPED	1. 7%
2. ONE END ISLAND OF EVERY PARKING PLANTED WITH TREES	2. YES
3. NO TREE LOCATED LESS THAN 4 FEET FROM BACK OF CURB	3. YES
4. SCREENING AT HEIGHT OF 2.5 FEET ALONG EDGE OF LOT. MINIMUM 12 SHRUBS PER 40 LINEAR FEET. SHRUBS AT LEAST 18 INCHES TALL AT TIME OF PLANTING.	4. YES
STREET FRONTAGE	
1. ONE TREE FOR EACH 30 FEET OF STREET FRONTAGE --- 330FT / 30FT = 12 TREES	1. 13 TREES
2. MINIMUM 20-FOOT LANDSCAPE STRIP ALONG LENGTH	2. YES
3. ONE SHRUB EVERY 20 FEET OF STREET FRONTAGE --- 330FT / 20FT = 16.5 SHRUBS	3. 42 SHURBS
OPEN YARD AREAS	
1. MINIMUM TWO SHRUBS PER 5,000 SQUARE FEET TOTAL AREA ---110,645 SF / 5,000 SF = 22 SHRUBS	1. 139 SHRUBS
2. ALL OPEN AREAS NOT PAVED SHALL BE SOD.	2. YES
3. ONE TREE FOR EVERY 5,000 SQUARE FEET OF LOT AREA ---110,645 SF / 5,000 SF = 22 TREES	3. 41 TREES
4. DETAILED TRASH STORAGE WITH SCREENING METHODS.	4. YES

IRRIGATION NOTES

1. CONTRACTOR SHALL PROVIDE IRRIGATION OF ALL PLANTING BEDS AND SODDED LAWN AREAS.
2. ALL SLOPES SHALL BE TEMPORARILY IRRIGATED UNTIL VEGETATION IS FULLY ESTABLISHED.
3. IRRIGATION SYSTEM SHALL BE DESIGN BUILD. THE SYSTEM SHALL BE DESIGNED TO PREVENT OVER WATERING AND INCLUDE RAIN SHUT-OFF DEVICES.
4. IRRIGATION SHALL BE ZONED. ALL PLANTING BENDS AND TURF SHALL BE SEPARATELY ZONED.
5. CONTRACTOR SHALL SUBMIT IRRIGATION PLANS TO THE OWNER A MINIMUM OF 30 DAYS PRIOR TO PROPOSED INSTALLATION FOR APPROVAL.
6. ALL SLOPES SHALL BE TEMPORARILY IRRIGATED UNTIL VEGETATION IS FULLY ESTABLISHED.
7. IRRIGATION SYSTEM SHALL BE DESIGN BUILD. THE SYSTEM SHALL BE DESIGNED TO PREVENT OVER WATERING AND INCLUDE RAIN SHUT-OFF DEVICES.
8. IRRIGATION SYSTEM SHALL BE ZONED FOR SPECIFIC WATER NEEDS IN EACH PLANTING AREA.
9. IRRIGATION OPERATION AND MAINTENANCE MANUAL TO BE SUPPLIED BY CONTRACTOR.
10. IRRIGATION SYSTEM SHALL INCLUDE FLOW SENSOR THAT DETECTS & REPORTS HIGH FLOW CONDITIONS DUE TO BROKEN PIPES OR POPPED SPRINKLER HEADS.
11. IRRIGATION SYSTEM SHALL INCLUDE PRESSURE REGULATOR & MASTER SHUT-OFF VALVE.

LANDSCAPING NOTE

1. ALL PLANT MATERIAL SHALL BE:
   a. FREE OF DISEASE AND INSECTS.
   b. CONFORMING TO AMERICAN STANDARD FOR NURSERY STOCK OF THE AMERICAN ASSOCIATION OF NURSERYMEN.
2. SPREAD TOPSOIL AMONG ALL LANDSCAPED AREAS. FOCUS ON PLANTING BEDS BEFORE DISTRIBUTING TO LAWN AREAS.
3. PLANTING MATERIALS SHALL BE OF THE FOLLOWING MINIMUM SIZE
   a. LARGE DECIDUOUS SHADE TREES (MATURE HEIGHT >45') = 3" DHB
   b. MEDIUM DECIDUOUS SHADE TREES (MATURE HEIGHT 30'-45') = 3" DHB
   c. SMALL DECIDUOUS SHADE TREES (MATURE HEIGHT 20'-30') = 2" DHB
   d. ORNAMENTAL TREE (MATURE HEIGHT <20') = 2" DHB
   e. EVERGREEN TREES: MINIMUM HEIGHT OF 8 FEET AT PLANTING.
   f. MEDIUM SHRUBS = 18-24 INCH BALLED AND BURLAPPED OR 2-GAL CONTAINER
   g. MEDIUM SHRUBS = 24-30 INCH BALLED AND BURLAPPED OR 5-GAL CONTAINER
   h. GRASS, SEED, SOD = >80% PURE LIVE SEED, 99% WEED FREE
8. LIVING LANDSCAPING SHALL BE USED TO COVER ALL OPEN GROUND SUPPLEMENTED WITH HARD WOOD MULCH.
9. ALL TRANSFORMERS, A/C UNITS, AND OTHER VISIBLE UTILITIES TO BE SCREENED WITH PLANTS.
10. LANDSCAPING SHALL BE PLANTED SUCH THAT THE MATURE SPREAD OF THE PLANT IS TO REMAIN 2' FROM THE BUILDING.
11. OWNER/TENANT/AGENT SHALL BE JOINTLY RESPONSIBLE FOR THE MAINTENANCE IN GOOD CONDITION OF PLANT MATERIAL.

SEEDING / SODDING SPECIFICATIONS

1. FINISH GRADE SHOWN ON PLAN INCLUDES 6" OF TOPSOIL RESPREAD FROM STOCKPILES.
2. ALL DISTURBED AREAS SHALL BE SEEDED OR SODDED PER SPECIFICATIONS.
3. ALL LAWN AREAS TO BE SOD.
4. IMMEDIATELY UPON COMPLETION OF FINISH GRADING IN EACH AREA, ALL LANDSCAPED AREAS SHALL BE SEEDED AND MULCHED.

SOD

Engineering Surveys & Services
DELIVERING YOUR VISION ™
1113 Fay Street, Columbia, MO 65201
573 - 449 - 2646
802 El Dorado Drive, Jefferson City, MO 65101
573-636-3303
1775 West Main Street, Sedalia, MO 65301
660-826-8818
www.ess-inc.com
MO Engineering Corp. # 2004005018

N

0 1"

SCALE: 1" = 20'

WILSHIRE HILLS PHASE III


LEE'S SUMMIT JACKSON COUNTY, MO

4/17/2024

STATE OF MISSOURI
MATTHEW AARON KRIETE
NUMBER PE-2007002811
PROFESSIONAL ENGINEER

MATTHEW A. KRIETE
PROFESSIONAL ENGINEER
PE-2007002811

IF ORIGINAL SIGNATURE OR DIGITAL AUTHENTICATION IS NOT PRESENT THIS MEDIA SHOULD NOT BE CONSIDERED A CERTIFIED DOCUMENT.

Date

SEPTEMBER 28, 2023

Revised

1	FEBRUARY 22, 2024
2	APRIL 17, 2024

Design: ST Drawn: MJS

LANDSCAPE PLAN

Sheet

L1.01

ES&S PROJECT NO. 15925

P:\GENERAL PROJECTS\15925E-JES-WILSHIRE-HILLS-3-ENG\CAD\15925 LANDSCAPE PLAN.DWG 4/19/2024

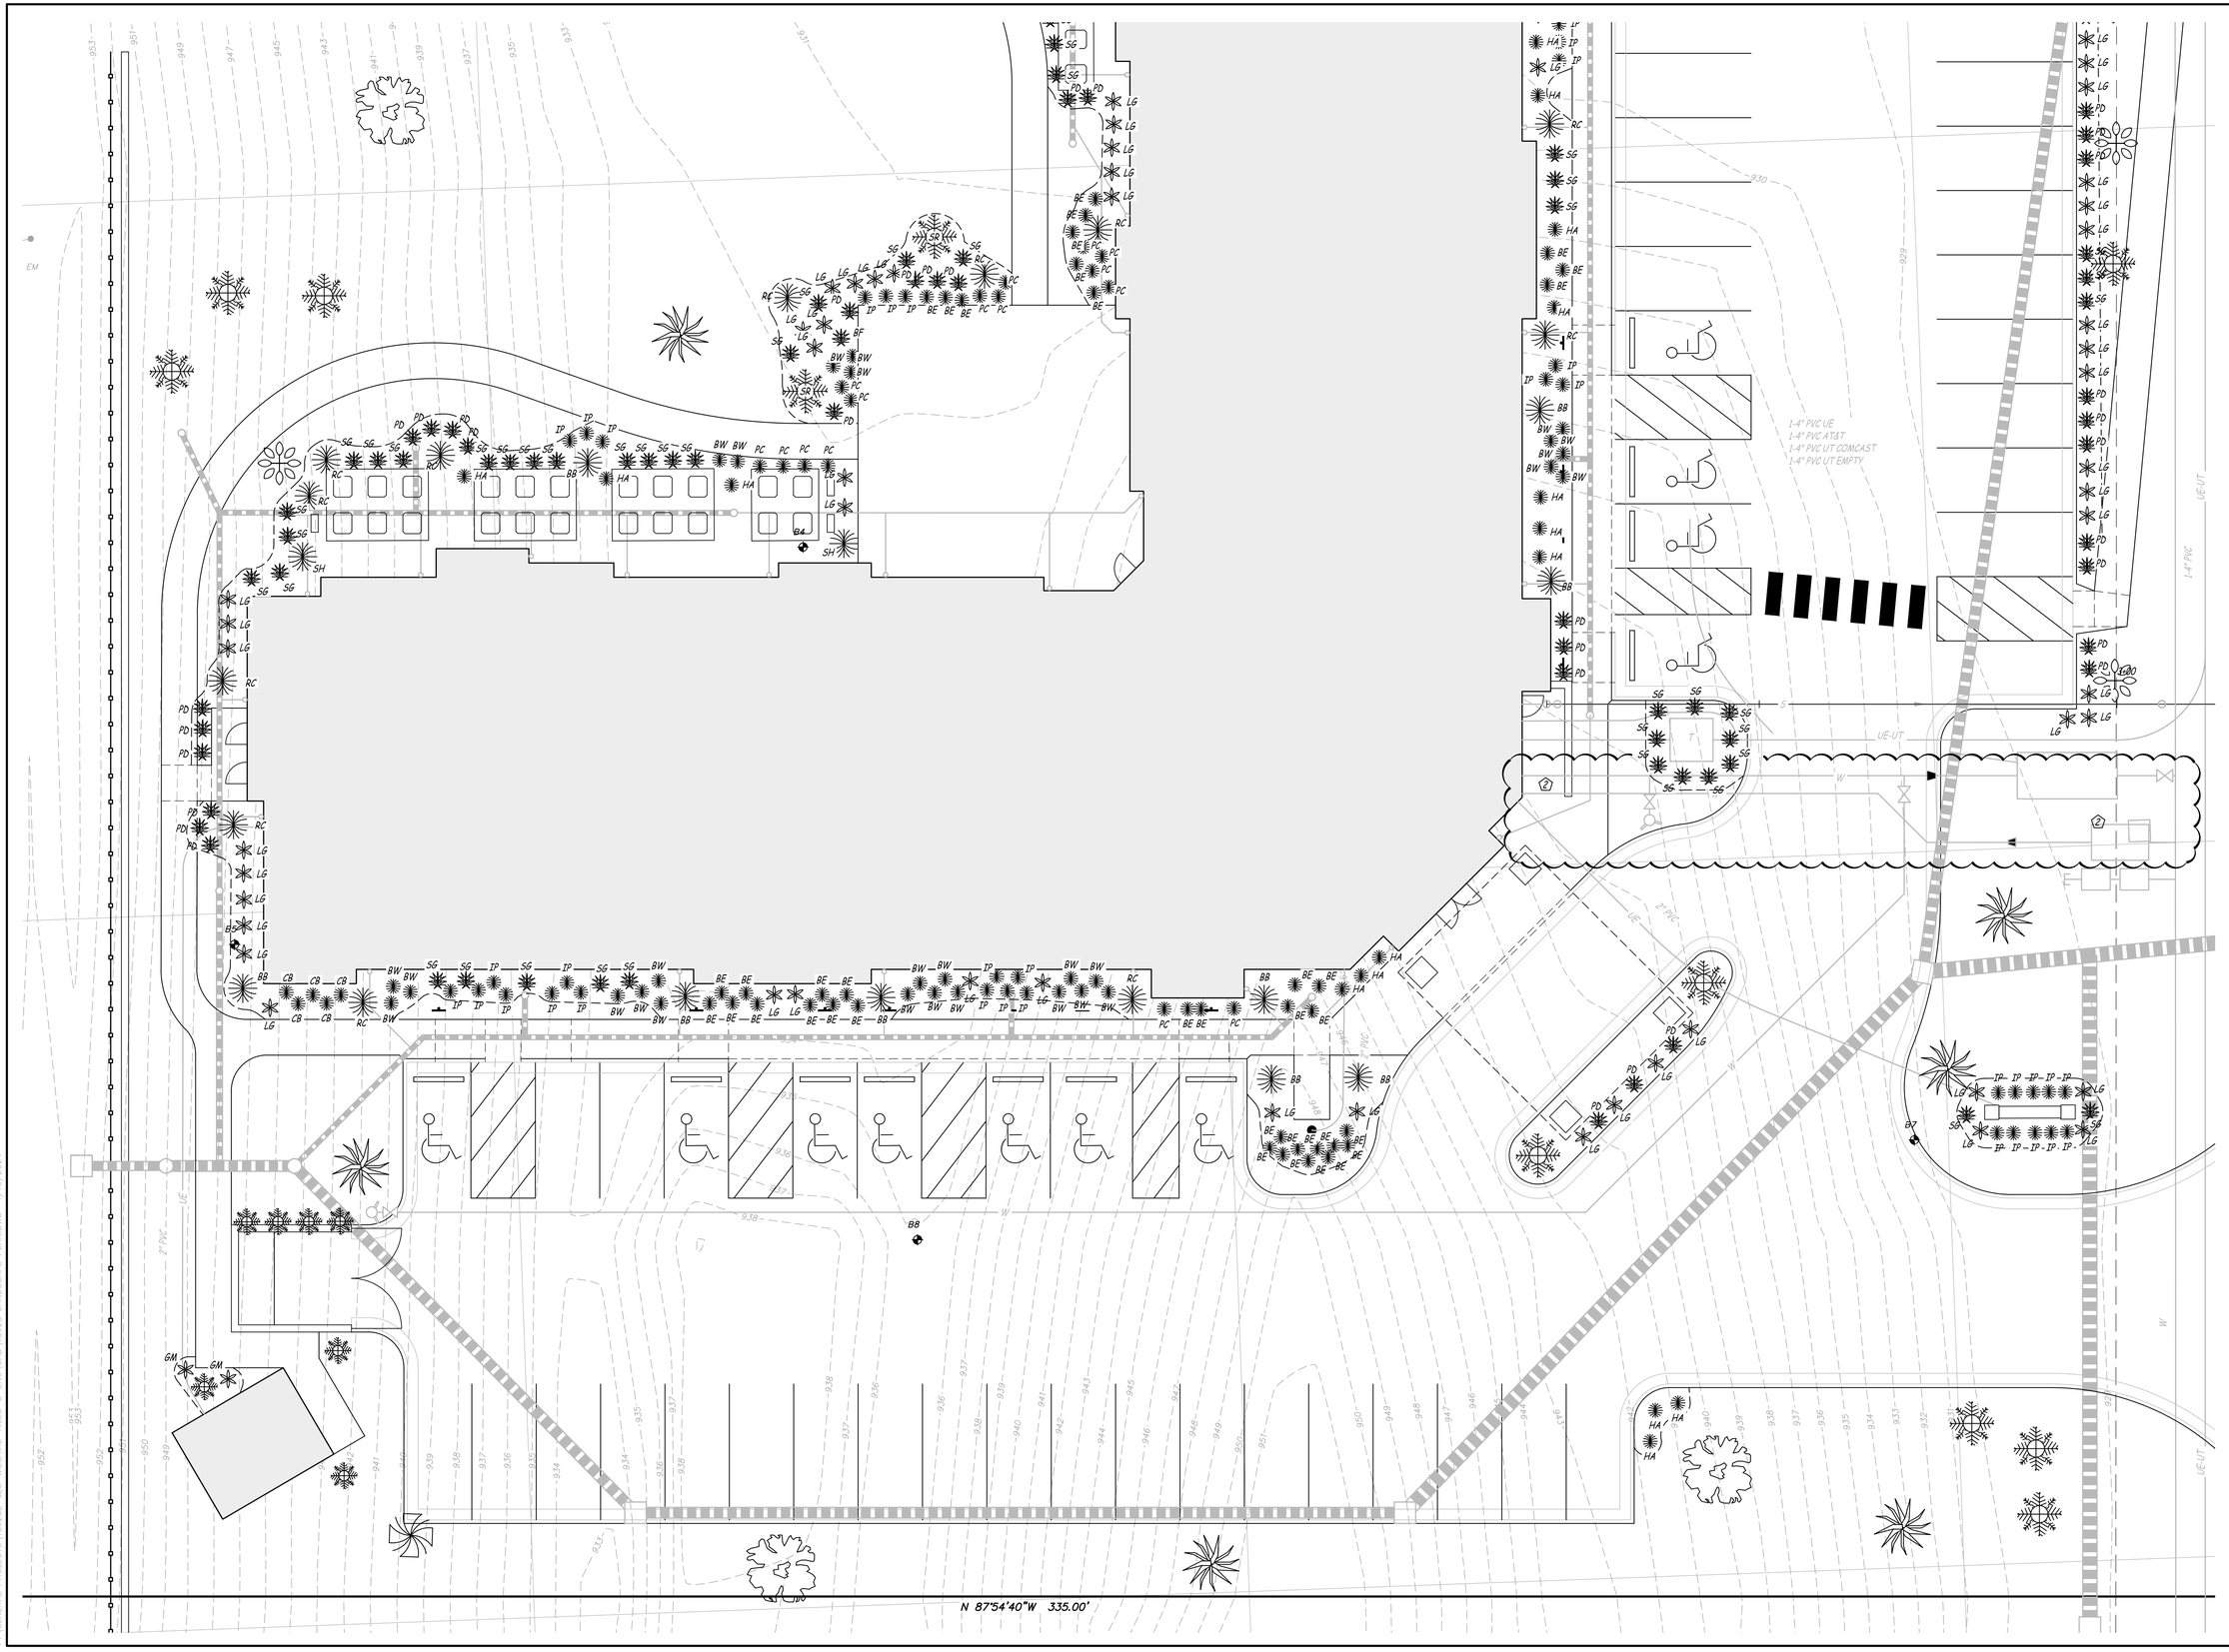

Engineering Surveys & Services
DELIVERING YOUR VISION ™

1113 Fay Street, Columbia, MO 65201
573 - 449 - 2646

802 El Dorado Drive, Jefferson City, MO 65101
573-636-3303

1775 West Main Street, Sedalia, MO 65301
660-826-8818

www.ess-inc.com

MO Engineering Corp. # 2004005018

N

0 1"

SCALE: 1" = 20'

WILSHIRE HILLS PHASE III


LEE'S SUMMIT JACKSON COUNTY, MO

4/17/2024

STATE OF MISSOURI
MATTHEW AARON KRIETE
NUMBER PE-2007002811
PROFESSIONAL ENGINEER

MATTHEW A. KRIETE
PROFESSIONAL ENGINEER
PE-2007002811

IF ORIGINAL SIGNATURE OR DIGITAL AUTHENTICATION IS NOT PRESENT THIS MEDIA SHOULD NOT BE CONSIDERED A CERTIFIED DOCUMENT.

Date

SEPTEMBER 28, 2023

Revised

1	FEBRUARY 22, 2024
2	APRIL 17, 2024

Design: ST Drawn: MJS

LANDSCAPE PLAN

Sheet

L1.02

ES&S PROJECT NO. 15925

P:\GENERAL PROJECTS\15925E---JES--WILSHIRE--HILLS--3--ENG\CAD\15925_LANDSCAPE PLAN.DWG 4/19/2024

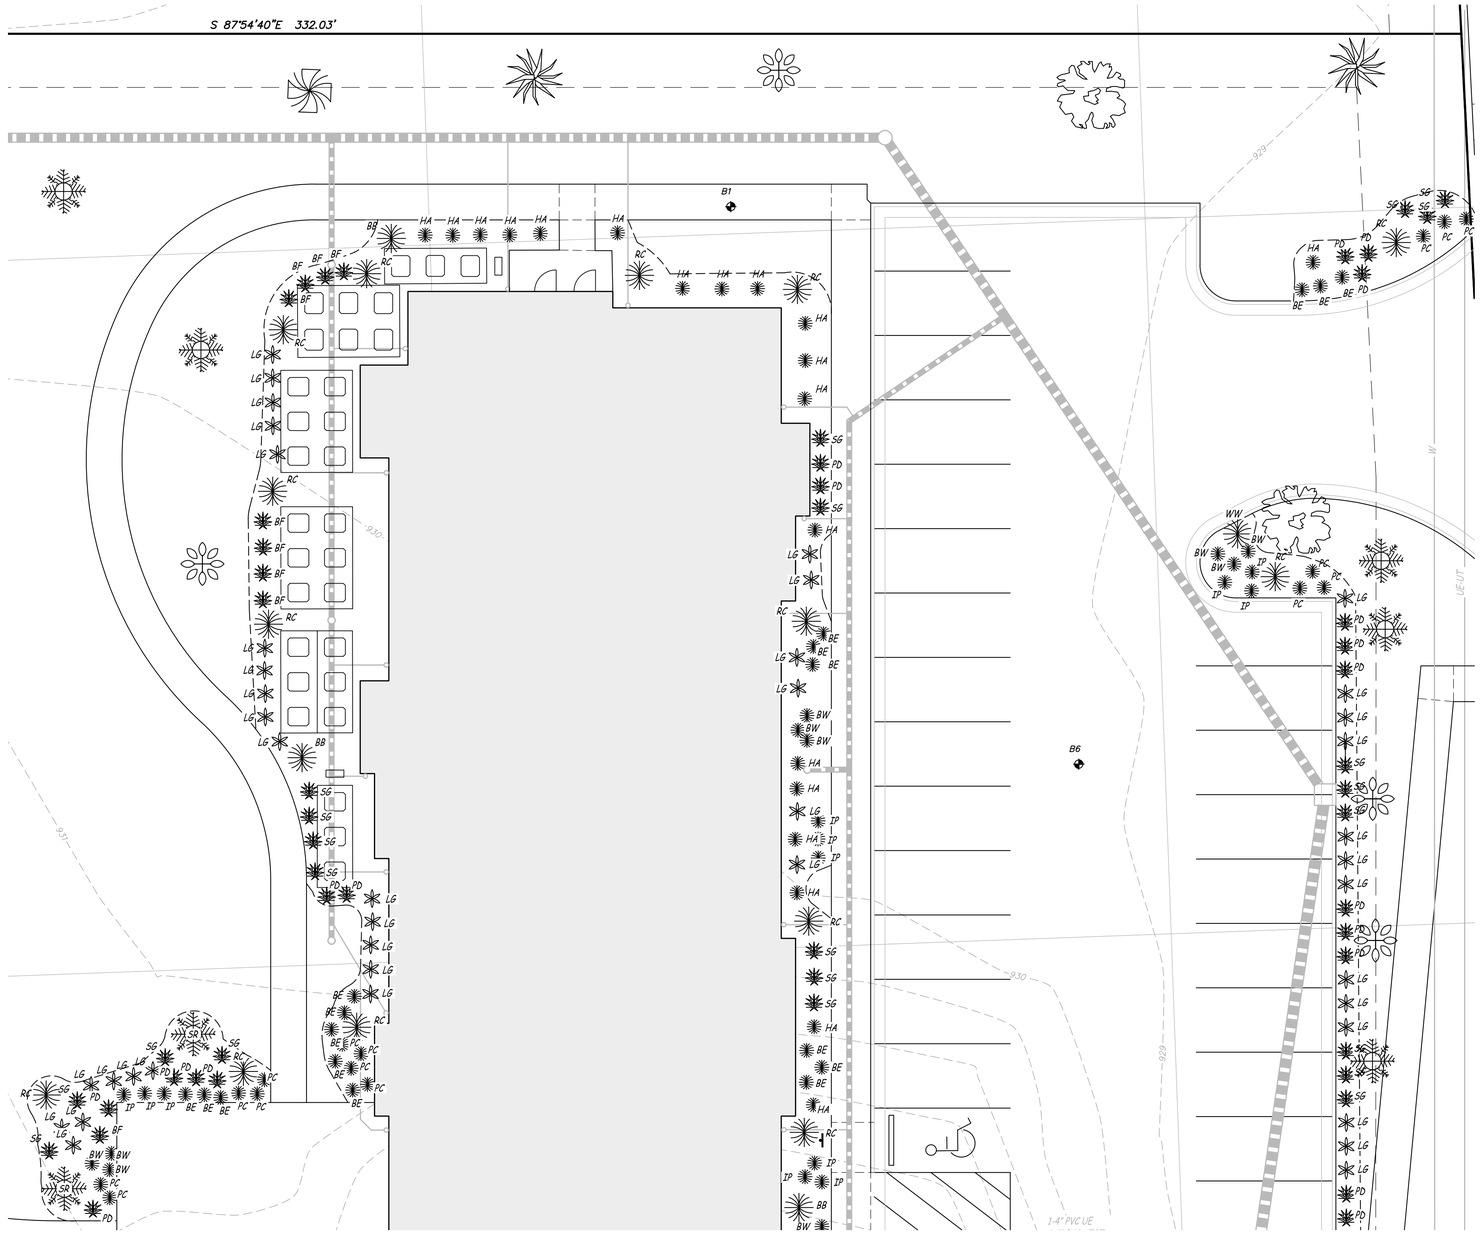

Engineering Surveys & Services
DELIVERING YOUR VISION ™

1113 Fay Street, Columbia, MO 65201
573 - 449 - 2646

802 El Dorado Drive, Jefferson City, MO 65101
573-636-3303

1775 West Main Street, Sedalia, MO 65301
660-826-8618

www.ess-inc.com

MO Engineering Corp. # 2004005018

N

0 1"
SCALE: 1" = 20'

WILSHIRE HILLS PHASE III

3200 NE WILSHIRE DR

LEE'S SUMMIT JACKSON COUNTY, MO

2/22/2024

STATE OF MISSOURI
MATTHEW AARON KRIETE
NUMBER PE-2007002811
PROFESSIONAL ENGINEER

MATTHEW A. KRIETE
PROFESSIONAL ENGINEER
PE-2007002811

IF ORIGINAL SIGNATURE OR DIGITAL AUTHENTICATION IS NOT PRESENT THIS MEDIA SHOULD NOT BE CONSIDERED A CERTIFIED DOCUMENT.

Date
SEPTEMBER 28, 2023

Revised
1 FEBRUARY 22, 2024

Design: ST Drawn: MJS

LANDSCAPE PLAN

Sheet
L1.03

ES&S PROJECT NO. 15925

P:\GENERAL PROJECTS\15925E—ES~WILSHIRE—HILLS~3~ENG\CAD\15925 LANDSCAPE PLAN.DWG 2/26/2024

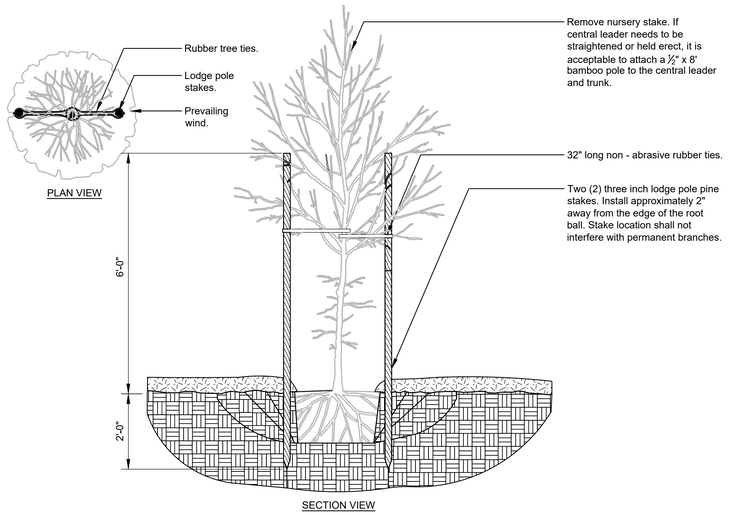

TREE STAKING - LODGE POLES (2)

URBAN TREE FOUNDATION © 2014
OPEN SOURCE FREE TO USE

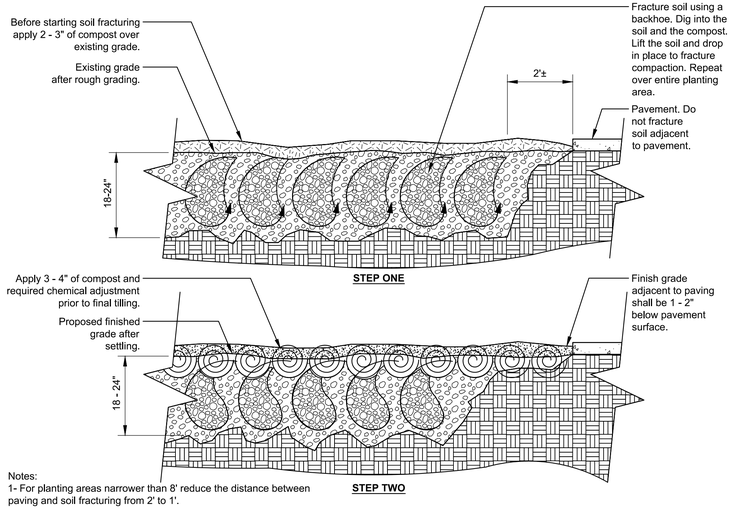

Notes:
1- For planting areas narrower than 8' reduce the distance between paving and soil fracturing from 2' to 1'.

2- See planting soil specification for additional requirements.

URBAN TREE FOUNDATION ©2014
OPEN SOURCE FREE TO USE

MODIFIED EXISTING SOIL - COMPACTED SUB SOIL (FRACTURING)

SYMBOL	LARGE DECIDUOUS SHADE TREES								
	LABEL	QTY	COMMON NAME	BOTANICAL NAME	MATURE HEIGHT (FT)	MATURE SPREAD (FT)	SHADE/SUN	ZONE	FLOWERING	NATIVE REGION
	TT	2	TULIP TREE	LIRIODENDRON TULIPIFERA	60–90	30–50	FULL SUN	4–9	YES, MAY–JUNE	EASTERN U.S.
	WO	2	WHITE OAK	QUERCUS ALBA	50–80	50–80	FULL SUN	3–9	NA	EASTERN U.S.
	RP	3	RED MAPLE	ACER RUBRUM	40–70	30–50	FULL SUN–PART SHADE	3–9	YES, MARCH–APRIL	CENTRAL & EASTERN U.S.

SYMBOL	MEDIUM DECIDUOUS SHADE TREES								
	LABEL	QTY	COMMON NAME	BOTANICAL NAME	MATURE HEIGHT (FT)	MATURE SPREAD (FT)	SHADE/SUN	ZONE	FLOWERING	NATIVE REGION
	RM	7	RED SUNSET RED MAPLE	ACER RUBRUM 'RED SUNSET'	40–50	30–40	FULL SUN–PART SHADE	3–9	YES, MARCH	CENTRAL & EASTERN U.S.
	BG	3	BLACK GUM	NYSSA SYLVATICA 'WILDFIRE'	30–50	20–30	FULL SUN–PART SHADE	3–9	NA	CENTRAL & EASTERN U.S.

SYMBOL	SMALL DECIDUOUS SHADE TREES								
	LABEL	QTY	COMMON NAME	BOTANICAL NAME	MATURE HEIGHT (FT)	MATURE SPREAD (FT)	SHADE/SUN	ZONE	FLOWERING	NATIVE REGION
	AH	2	AMERICAN HORNBEAM	CARPINUS CAROLINIANA	20–35	20–35	PART SHADE–FULL SUN	3–9	NA	CENTRAL & EASTERN U.S.
	FD	4	FLOWERING DOGWOOD	CORNUS FLORIDA	15–30	15–30	FULL SUN–PART SHADE	5–9	YES, APRIL–MAY	CENTRAL & EASTERN U.S.

SYMBOL	ORNAMENTAL DECIDUOUS SHADE TREES								
	LABEL	QTY	COMMON NAME	BOTANICAL NAME	MATURE HEIGHT (FT)	MATURE SPREAD (FT)	SHADE/SUN	ZONE	FLOWERING	NATIVE REGION
	CA	2	PRAIRIFIRE CRABAPPLE	MALUS 'PRAIRIFIRE'	15–20	15–20	FULL SUN	4–8	YES, APRIL–MAY	U.S

SYMBOL	CONIFERS OR EVERGREEN TREES								
	LABEL	QTY	COMMON NAME	BOTANICAL NAME	MATURE HEIGHT (FT)	MATURE SPREAD (FT)	SHADE/SUN	ZONE	FLOWERING	NATIVE REGION
	SR	11	JUNIPER 'SKYROCKET'	JUNIPERUS SCOPULORUM 'SKYROCKET'	15–20	2–3	FULL SUN	4–9	NA	WESTERN U.S.
	CR	12	CANAERTH RED CEDAR	JUNIPERUS VIRGINIANA "CANAERTH"	20–35	8–15	FULL SUN	3–9	NA	CENTRAL & EASTERN U.S.

SYMBOL	EVERGREEN SHRUBS								
	LABEL	QTY	COMMON NAME	BOTANICAL NAME	MATURE HEIGHT (FT)	MATURE SPREAD (FT)	SHADE/SUN	ZONE	FLOWERING	NATIVE REGION
	LG	74	LITTLE GIANT DWARF ARBORVITAE'	THUJA OCCIDENTALS LITTLE GIANT	3–4	3–4	FULL SUN– PART SHADE	3–8	NA	EASTERN U.S.

SYMBOL	DECIDUOUS SHRUBS								
	LABEL	QTY	COMMON NAME	BOTANICAL NAME	MATURE HEIGHT (FT)	MATURE SPREAD (FT)	SHADE/SUN	ZONE	FLOWERING	NATIVE REGION
	RC	21	RED CHOKEBERRY	ARONIA ARBUTIFOLIA 'BRILLIANTISSIMA'	6–8	3–4	FULL SUN–PART SHADE	4–9	YES, APRIL	CENTRAL & EASTERN U.S.
	HA	33	SMOOTH HYDRANGEA	HYDRANGEA ARBORESCENS 'ANNABELLE'	3–5	4–6	PART SHADE	3–9	YES, JUNE–SEPTEMBER	CENTRAL & EASTERN U.S.
	BB	11	BUTTON BUSH 'SUGAR SHACK'	CEPHALANTHUS OCCIDENTALIS 'SMCOSS' SUGAR SHACK	3–4	3–4	FULL SUN–PART SHADE	4–10	YES, JUNE–JULY	CENTRAL & EASTERN U.S.
	IP	37	INDIAN PAINTBRUSH	CASTILLEJA COCCINEA	1–2	1–1.5	FULL SUN–PART SHADE	4–8	YES, SPRING–SUMMER	EASTERN U.S.
	BW	33	BUTTERFLY WEED	ASCLEPIAS TUBEROSA	1–2.5	1–2	FULL SUN	3–9	YES, JUNE–AUGUST	U.S.
	BE	43	BLACK–EYED SUSANS "GOLDSTURMM"	RUDBECKIA FULGIDA	2–3	1.5–2	FULL SUN–PART SHADE	3–9	YES, JUNE–AUGUST	U.S.
	PC	21	PURPLE CONEFLOWER	ECHINACEA PURPUREA	2–5	1–2	FULL SUN–PART SHADE	3–8	YES, JUNE–AUGUST	U.S.

SYMBOL	ORNAMENTAL GRASSES								
	LABEL	QTY	COMMON NAME	BOTANICAL NAME	MATURE HEIGHT (FT)	MATURE SPREAD (FT)	SHADE/SUN	ZONE	FLOWERING	NATIVE REGION
	SG	46	SWITCH GRASS	PANICUM VIRGATUM	3–6	2–3	FULL SUN	3–9	YES, AUGUST–SEPTEMBER	U.S. AND CANADA
	PD	41	PRAIRIE DROPSEED	SPOROBOLUS HETEROLEPIS	2–3	2–3	FULL SUN	3–9	YES, AUGUST–OCTOBER	U.S.

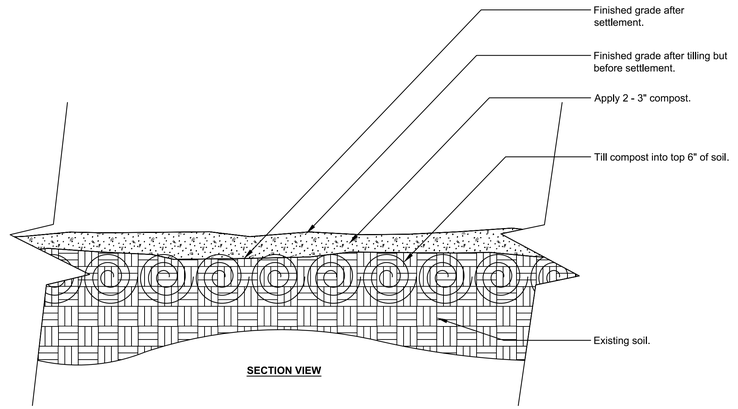

Notes:
1- See planting soil specifications for additional requirements.

MODIFIED EXISTING SOIL - COMPACTED SURFACE SOIL

URBAN TREE FOUNDATION © 2014
OPEN SOURCE FREE TO USE

Engineering Surveys & Services
DELIVERING YOUR VISION ™
1113 Fay Street, Columbia, MO 65201
573 - 449 - 2646
802 El Dorado Drive, Jefferson City, MO 65101
573-636-3303
1775 West Main Street, Sedalia, MO 65301
660-826-8618
www.ess-inc.com
MO Engineering Corp. # 2004005018

N

0 1"
SCALE: 1" = 20'

WILSHIRE HILLS PHASE III
3200 NE WILSHIRE DR
LEE'S SUMMIT JACKSON COUNTY, MO

9/28/2023
STATE OF MISSOURI
MATTHEW AARON KRIETE
NUMBER PE-2007002811
PROFESSIONAL ENGINEER

MATTHEW A. KRIETE
PROFESSIONAL ENGINEER
PE-2007002811

IF ORIGINAL SIGNATURE OR DIGITAL AUTHENTICATION IS NOT PRESENT THIS MEDIA SHOULD NOT BE CONSIDERED A CERTIFIED DOCUMENT.

Date
SEPTEMBER 28, 2023

Revised

Design: ST Drawn: MJS

LANDSCAPE PLAN

Sheet
L1.04

ES&S PROJECT NO. 15925

P:\GENERAL PROJECTS\15925E—JES—WILSHIRE—HILLS—3—ENG\CAD\15925 LANDSCAPE PLAN.DWG 10/26/2023

Notes:
1- Trees shall be of quality prescribed in crown observations and root observations details and specifications.

2- See specifications for further requirements related to this detail.

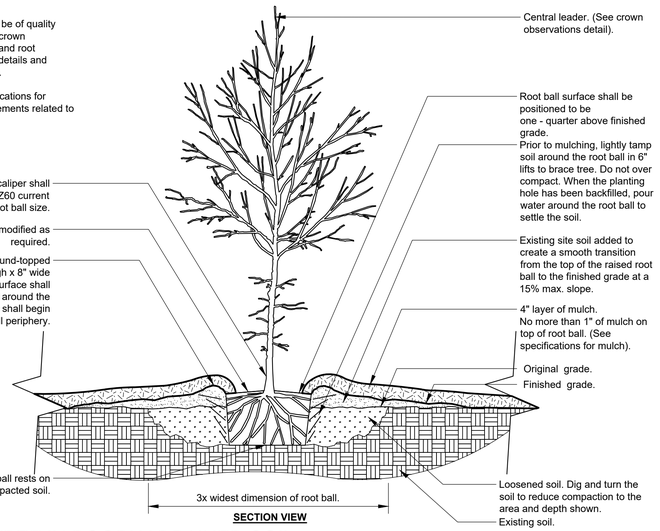

SECTION VIEW

TREE IN POORLY DRAINED SOIL

URBAN TREE FOUNDATION © 2014
OPEN SOURCE FREE TO USE

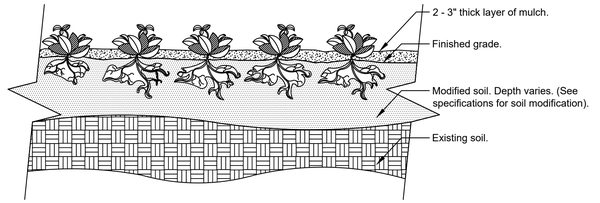

SECTION VIEW

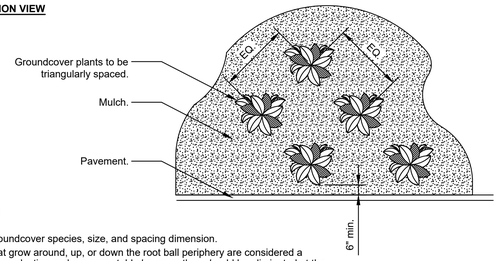

PLAN

Notes:
1- See planting legend for groundcover species, size, and spacing dimension.
2- Small roots (¼" or less) that grow around, up, or down the root ball periphery are considered a normal condition in container production and are acceptable however they should be eliminated at the time of planting. Roots on the periperhy can be removed at the time of planting. (See root ball shaving container detail).
3- Settle soil around root ball of each groundcover prior to mulching.

GROUNDCOVER

URBAN TREE FOUNDATION © 2014
OPEN SOURCE FREE TO USE

Notes:
1- Trees shall be of quality prescribed in crown observations and root observations details and specifications.

2- See specifications for further requirements related to this detail.

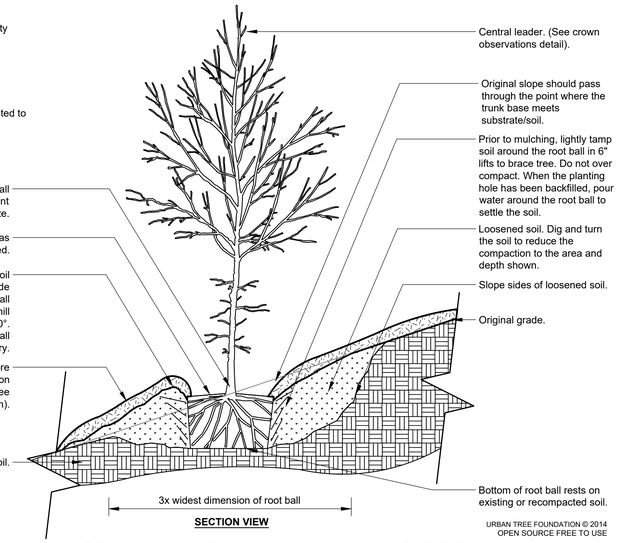

SECTION VIEW

TREE ON SLOPE 5% (20:1) TO 50% (2:1) - UNMODIFIED SOIL

URBAN TREE FOUNDATION © 2014
OPEN SOURCE FREE TO USE

ACCEPTABLE

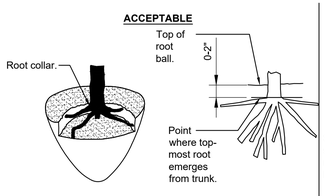

The point where top-most root(s) emerges from the trunk (root collar) should be within the top 2" of substrate. The root collar and the root ball interior should be free of defects including circling, kinked, ascending, and stem girdling roots. Structural roots shall reach the periphery near the top of the root ball.

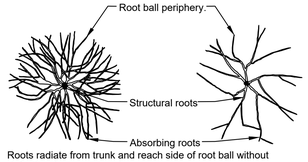

Roots radiate from trunk and reach side of root ball without defecting down or around.

REJECTABLE

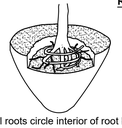

Structural roots circle interior of root ball. No structural roots are horizontal and reach the root ball periphery near the top of the root ball.

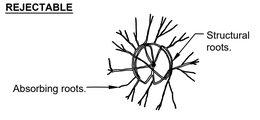

Only absorbing roots reach the periphery near the top of the root ball. Structural roots mostly wrap or are deflected on the root ball interior.

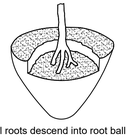

Structural roots descend into root ball interior. No structural roots are horizontal and reach the root ball periphery near the top of the root ball.

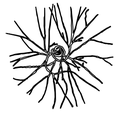

Structural roots circle and do not radiate from the trunk.

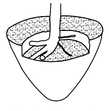

Structural roots primarily grow to one side.

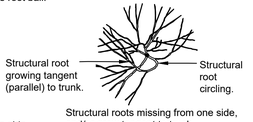

Structural roots missing from one side, and/or grow tangent to trunk.

Notes:
1- Observations of roots shall occur prior to acceptance. Roots and soil may be removed during the observation process; substrate/soil shall be replaced after the observations have been completed.

2- See specifications for observation process and requirements.

ROOT OBSERVATIONS DETAIL - BALLED AND BURLAPPED

URBAN TREE FOUNDATION © 2014
OPEN SOURCE FREE TO USE

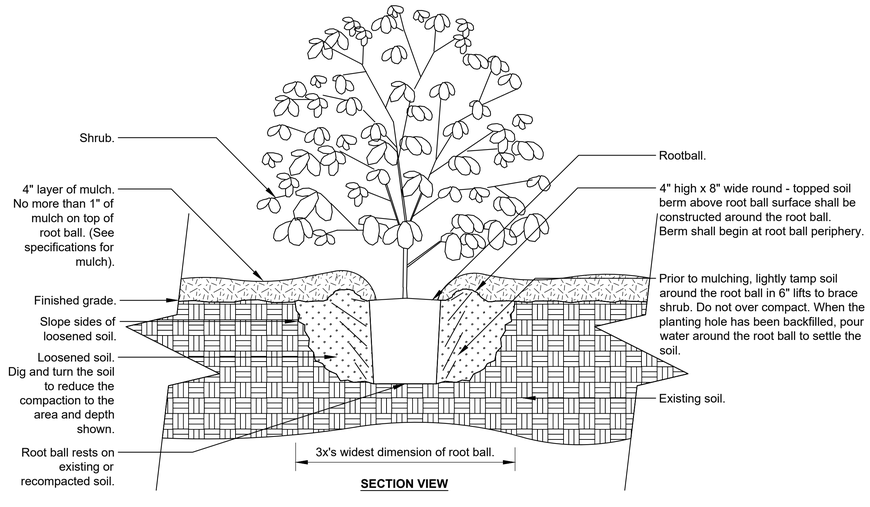

SECTION VIEW

Notes:
1- Shrubs shall be of quality prescribed in the root observations detail and specifications.

2- See specifications for further requirements related to this detail.

SHRUB - UNMODIFIED SOIL

URBAN TREE FOUNDATION © 2014
OPEN SOURCE FREE TO USE

Engineering Surveys & Services
DELIVERING YOUR VISION ™
1113 Fay Street, Columbia, MO 65201
573 - 449 - 2646
802 El Dorado Drive, Jefferson City, MO 65101
573-636-3303
1775 West Main Street, Sedalia, MO 65301
660-826-8618
www.ess-inc.com
MO Engineering Corp. # 2004005018

N

0 1"
SCALE: 1" = 20'

WILSHIRE HILLS PHASE III
3200 NE WILSHIRE DR
LEE'S SUMMIT JACKSON COUNTY, MO

9/28/2023
STATE OF MISSOURI
MATTHEW AARON KRIETE
NUMBER PE-2007002811
PROFESSIONAL ENGINEER

MATTHEW A. KRIETE
PROFESSIONAL ENGINEER
PE-2007002811

IF ORIGINAL SIGNATURE OR DIGITAL AUTHENTICATION IS NOT PRESENT THIS MEDIA SHOULD NOT BE CONSIDERED A CERTIFIED DOCUMENT.

Date
SEPTEMBER 28, 2023

Revised

Design: ST Drawn: MJS

LANDSCAPE PLAN

Sheet
L1.05

ES&S PROJECT NO. 15925

P:\GENERAL PROJECTS\15925E--JES--WILSHIRE--HILLS--3--ENG\CAD\15925 LANDSCAPE PLAN.DWG 10/26/2023

RETAINING WALL NOTES

1. RETAINING WALL DESIGN:
   - A. STRUCTURAL DESIGN HEREIN REPRESENTS A FINISHED STRUCTURE. THE GENERAL CONTRACTOR/OWNER SHALL PROVIDE ALL INTERIM BRACING, SHORING, INTERIM DRAINAGE PROVISIONS, DRAINAGE DIVERSION AND EROSION PROTECTION REQUIRED UNTIL FINAL CAPPING, PAVING, CURBING, AND COMPLETION OF FINAL STORM DRAIN SYSTEM IS COMPLETE.
   - B. THE WALL IS NOT CONSIDERED COMPLETE UNTIL ALL FINAL GRADING AND STORMWATER CONVEYANCE IS COMPLETE.
   - C. IT IS THE GENERAL CONTRACTOR'S RESPONSIBILITY TO ENSURE ALL FINAL GRADES DRAIN AWAY FROM THE TOP OF THE RETAINING WALL.
2. ENGINEERING SURVEYS & SERVICE SHALL BE NOTIFIED IF ANY SETTLEMENT IS OBSERVED DURING CONSTRUCTION.
3. MATERIAL PROPERTIES:
   - A. SEGMENTAL BLOCK UNITS SHALL BE MANUFACTURED IN ACCORDANCE WITH ASTM C1372 HAVING A MINIMUM 28-DAY COMPRESSIVE STRENGTH OF 3,000 PSI AND A MAXIMUM MOISTURE ABSORPTION OF 8%. ALL UNITS SHALL BE SOUND AND FREE OF CRACKS OR OTHER DEFECTS THAT WOULD INTERFERE WITH THE PROPER PLACING OF THE UNIT OR SIGNIFICANTLY IMPAIR THE STRENGTH OR PERFORMANCE OF THE CONSTRUCTION.
   - B. COMPACTED REINFORCED BACKFILL AND DRAINAGE SHALL BE FREE OF ORGANIC MATERIAL. THE ROCK SHALL BE A WELL GRADED GRAVEL OR LIMESTONE WITH A MAXIMUM PARTICLE SIZE OF 2" AND A MAXIMUM OF 20% PASSING A NO. 200 SIEVE. LIMESTONE SCREENINGS ARE NOT ACCEPTABLE FOR STRUCTURE WALL BACKFILL. MATERIAL SHALL BE MODOT TYPE 1/5 OR APPROVED EQUAL.
   - C. THE GEOGRID SHALL BE A HIGH DENSITY POLYETHYLENE EXPANDED SHEET OR POLYESTER WOVEN FIBER MATERIAL, SPECIFICALLY FABRICATED FOR USE AS SOIL REINFORCEMENT. ACCEPTABLE GEOGRID TYPES AND MANUFACTURER
     - TYPE I: SG 200 BY STRATA OR APPROVED EQUAL
   - D. DRAINAGE PIPE SHALL BE MANUFACTURED IN ACCORDANCE WITH ASTM F 405 OR ASTM F 758.
   - E. CONSTRUCTION ADHESIVE SHALL BE EXTERIOR GRADE ADHESIVE AS
4. RECOMMENDED BY THE SEGMENTAL CONCRETE WALL UNIT MANUFACTURER. EXCAVATION: IT IS THE CONTRACTOR'S RESPONSIBILITY TO EXCAVATE TO THE GRADES ON THE PLAN. EXCAVATION MEANS AND METHOD ARE ALSO THE CONTRACTOR'S RESPONSIBILITY INCLUDING: BENCHING, SHORING, STABILITY OF ALL RESPECTIVE EXCAVATIONS, AND THE EFFECTS ON ADJACENT PROPERTIES AND
5. STRUCTURES.
   FOUNDATION SOIL PREPARATION:
   - A. FOLLOWING EXCAVATION FOR THE LEVELING PAD AND THE REINFORCED SOIL ZONE, FOUNDATION SOIL SHALL BE EXAMINED BY THE OWNER'S GEOTECHNICAL ENGINEER TO ASSURE THE ACTUAL FOUNDATION SOIL STRENGTH MEETS OR EXCEEDS THE ASSUMED DESIGN BEARING STRENGTH. SOIL NOT MEETING THE REQUIRED STRENGTH SHALL BE REMOVED AND REPLACED WITH SOIL MEETING THE DESIGN CRITERIA, AS DIRECTED BY THE OWNER'S GEOTECHNICAL ENGINEER.
   - B. FOUNDATION SOIL IS DEFINED AS THE SOIL UNDER THE SEGMENTAL RETAINING WALL VOLUME, EXTENDING FROM THE TOE OF THE LEVELING PAD TO THE BACK OF THE REINFORCED MASS.
6. BASE LEVELING PAD SHALL BE COMPACTED WITH A VIBRATORY PLATE OR ROLLER AND COMPACTION TESTING TO A MINIMUM OF 95% OF STANDARD PROCTOR DENSITY (ASTM D 698) AT A MOISTURE CONTENT OF -2% TO +4% OF OPTIMUM MOISTURE CONTENT.
7. PLACE DRAINAGE AGGREGATE A MINIMUM OF 12" DIRECTLY BEHIND AND BETWEEN THE UNITS AND LEVEL WITH THE TOP OF THE UNIT. PLACE REINFORCED BACKFILL DIRECTLY AGAINST DRAINAGE FILL. COMPACT DRAINAGE AGGREGATE WITH 3 PASSES OF A VIBRATORY COMPACTOR. COMPACTION TESTING OF DRAINAGE AGGREGATE IS NOT REQUIRED. EXCESS MATERIAL SHALL BE REMOVED FROM TOP OF UNITS PRIOR TO INSTALLATION OF NEXT COURSE.
8. GEOGRID INSTALLATION:
   - A. GEOGRID SHALL BE LAID AT THE PROPER ELEVATION AND ORIENTATION AS SHOWN ON THE DRAWINGS.
   - B. THE GEOGRID REINFORCEMENT SHALL BE LAID HORIZONTALLY ON LEVEL, COMPACTED BACKFILL, AND EMBEDDED IN THE BLOCK.
   - C. THE GEOGRID SHALL BE PULLED TIGHT AFTER THE NEXT ROW OF BLOCK AND DRAINAGE AGGREGATE HAS BEEN PLACED.
   - D. THE GEOGRID SHALL BE PLACED WITH THE AXIAL STRENGTH PERPENDICULAR TO THE WALL FACE ALL LOCATIONS.
9. REINFORCED BACKFILL
   - E. MATERIAL SHALL BE PLACED IN 8" MAXIMUM LIFTS AND COMPACTED TO A MINIMUM 95% OF STANDARD PROCTOR DENSITY (ASTM D 698) AT A MOISTURE CONTENT OF -2% TO +4% OF OPTIMUM MOISTURE CONTENT.
   - F. REINFORCED BACKFILL SHALL BE PLACED AND COMPACTED FROM THE BACK OF THE WALL REARWARD INTO THE EMBANKMENT TO ENSURE THAT THE GEOGRID REMAINS TIGHT.
   - G. TRACKED CONSTRUCTION EQUIPMENT SHALL NOT BE OPERATED DIRECTLY ON THE GEOGRID. A MINIMUM BACKFILL THICKNESS OF 6" SHALL BE MAINTAINED TO OPERATE TRACKED VEHICLES OVER THE GEOGRID. TURNING OF TRACKED CONSTRUCTION EQUIPMENT SHALL BE KEPT TO A MINIMUM TO PREVENT TRACKS FROM DISPLACING THE FILL AND DAMAGING THE GEOGRID.
10. FIELD QUALITY CONTROL:
    - H. THE OWNER OR OWNER'S REPRESENTATIVE IS RESPONSIBLE FOR ENGAGING THE SERVICES OF AN INDEPENDENT THIRD PARTY INSPECTOR TO OBSERVE AND VERIFY ALL SOIL PROPERTIES AS WELL AS VERIFY CORRECT INSTALLATION OF ALL SYSTEM COMPONENTS TO MEET THE REQUIREMENTS OF THESE GENERAL NOTES AND DRAWINGS.
    - I. EACH LIFT OF REINFORCED BACKFILL MATERIAL AND BASE LEVELING PAD SHOULD BE COMPACTION TESTED AT A FREQUENCY OF ONE TEST PER 2,500 SQUARE FEET OR A MINIMUM OF 2 TESTS PER LIFT.

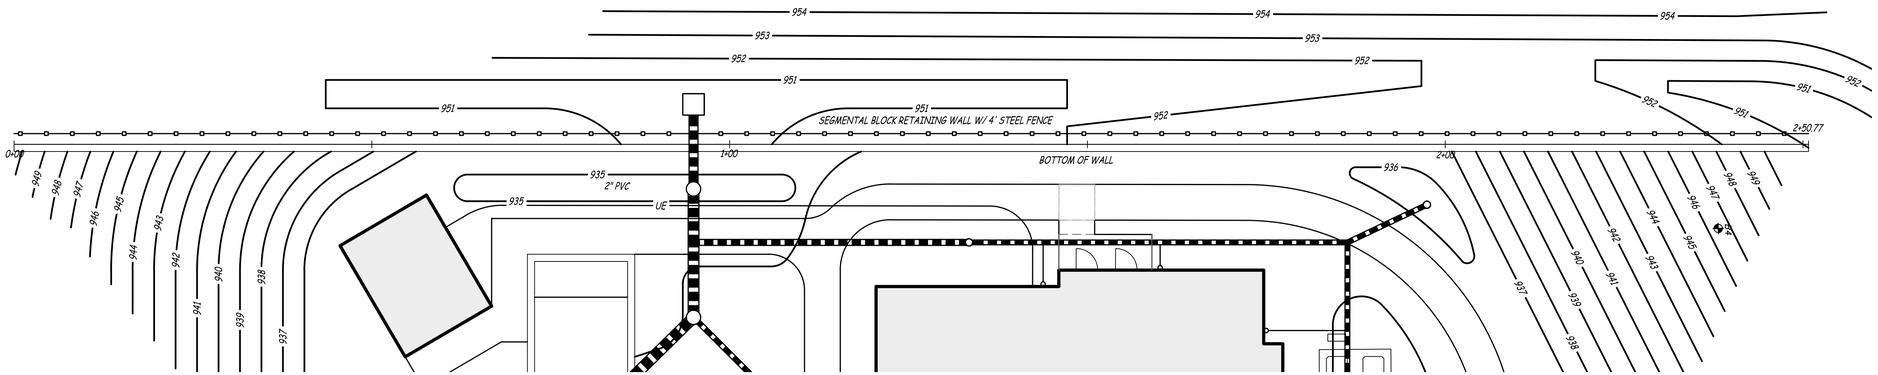

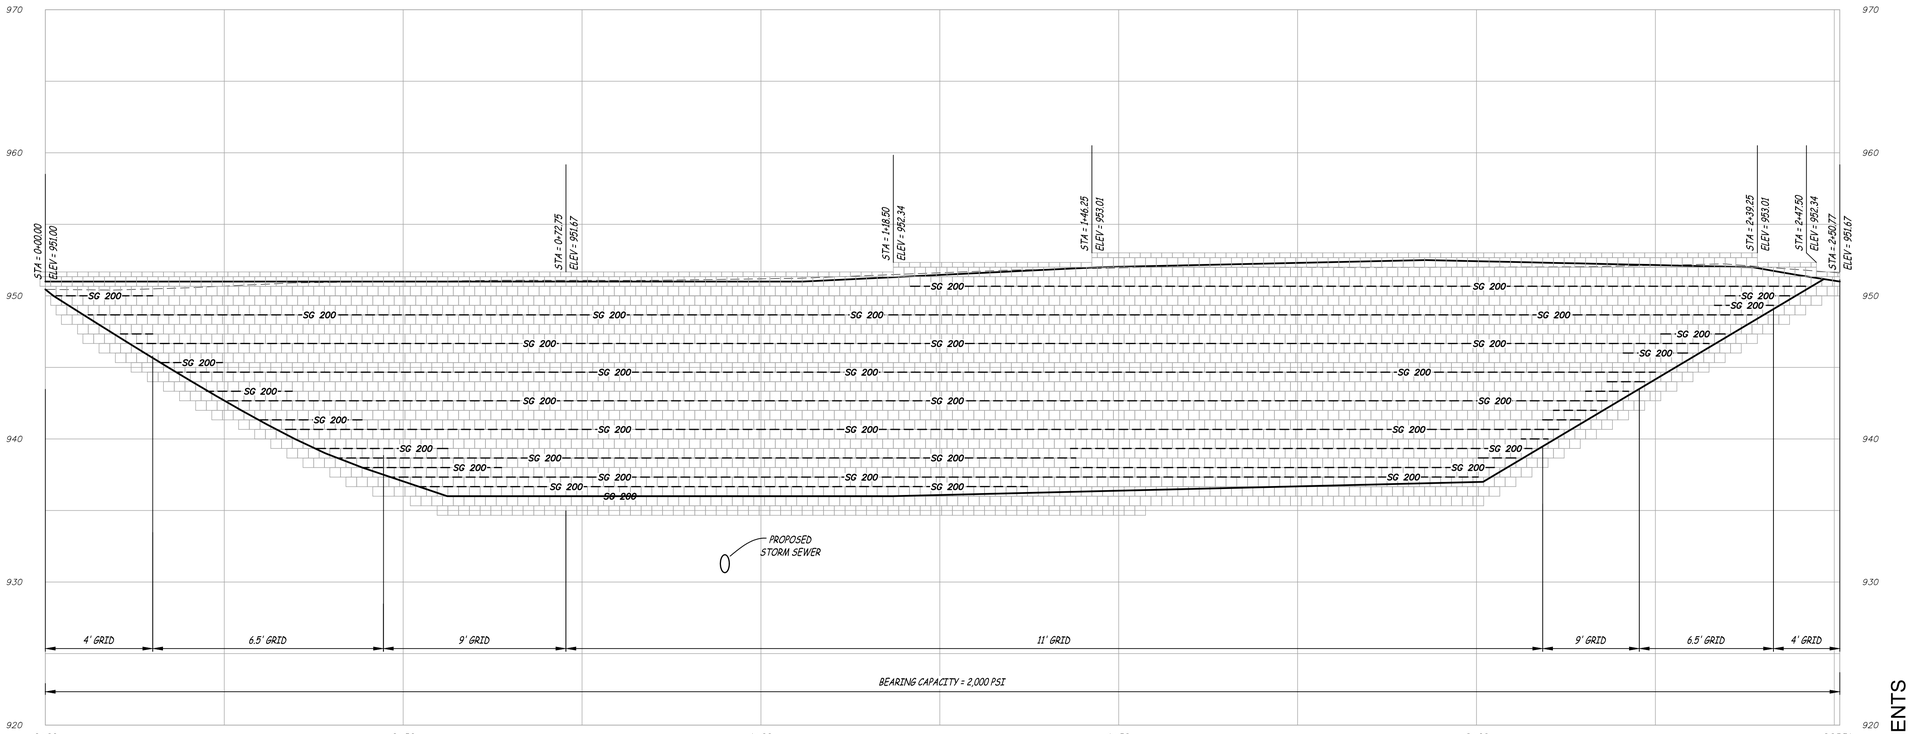

RETAINING WALL
SCALE – HORIZ. 1" = 10'
VERT. 1" = 5'

WALL PROPERTIES		
BACKSLOPE	6:1 (9.46) H:V	DEGREES
TOESLOPE	3:1 (18.43) H:V	DEGREES
BATTER	5.36	DEGREES
SETBACK	1"	INCHES
SURCHARGE		
DEAD LOAD	0	PSF
LIVE LOAD	100	PSF

BLOCK PROPERTIES	
BLOCK TYPE	VERSA-LOK
BLOCK STYLE	SQUARE FOOT

ASSUMED DESIGN SOIL PARAMETERS			
	DESCRIPTION	ϕ (DEGREES)	γ (PCF)
FOUNDATION SOIL	CRUSHED LIMESTONE	38	130
RETAINED SOIL	CLAY SOIL	19	106
REINFORCED BACKFILL	CRUSHED LIMESTONE	38	130

Engineering Surveys & Services
DELIVERING YOUR VISION ™
1113 Fay Street, Columbia, MO 65201
573 - 449 - 2646
802 El Dorado Drive, Jefferson City, MO 65101
573-636-3303
1775 West Main Street, Sedalia, MO 65301
660-826-8818
www.ess-inc.com
MO Engineering Corp. # 2004005018

N

0 1"
SCALE: 1" = 10'

WILSHIRE HILLS PHASE III
3200 NE WILSHIRE DR
LEE'S SUMMIT JACKSON COUNTY, MISSOURI

2/23/2024
STATE OF MISSOURI
JOSHUA DAVID LEHMEN
NUMBER PE-2012000779
PROFESSIONAL ENGINEER
Joshua David Lehmen

JOSHUA D. LEHMEN
PROFESSIONAL ENGINEER
PE-2012000779

IF ORIGINAL SIGNATURE OR DIGITAL AUTHENTICATION IS NOT PRESENT THIS MEDIA SHOULD NOT BE CONSIDERED A CERTIFIED DOCUMENT.

Date
JULY 13, 2023

Revised
1 FEBRUARY 22, 2024

Design: JL Drawn: MJS

RETAINING WALL PLAN

Sheet
RW1.01

ES&S PROJECT NO. 15925

CONSTRUCTION DOCUMENTS

P:\GENERAL PROJECTS\15925E--JES-WILSHIRE-HILLS--3-ENG\CAD\15925 WALL PLAN .DWG 2/27/2024

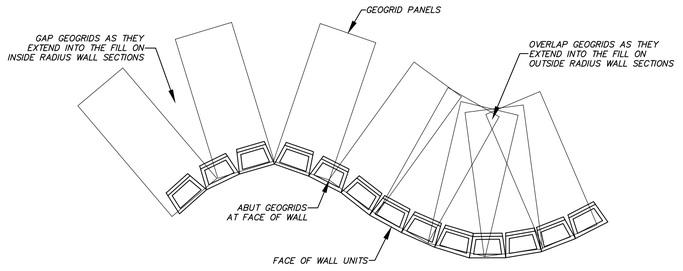

WALL RADIUS DETAIL

NOT TO SCALE

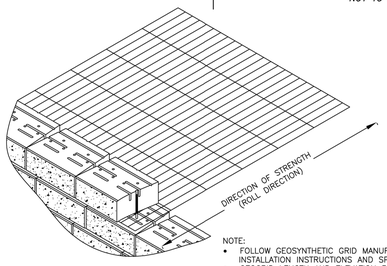

NOTE:
- FOLLOW GEOSYNTHETIC GRID MANUFACTURER'S INSTALLATION INSTRUCTIONS AND SPECIFICATIONS
- GEOGRID LENGTH AND ELEVATION PLACEMENT SHALL BE DETERMINED BY WALL DESIGN ENGINEER

GEOSYNTHETIC INSTALLATION DETAIL

SCALE: NONE

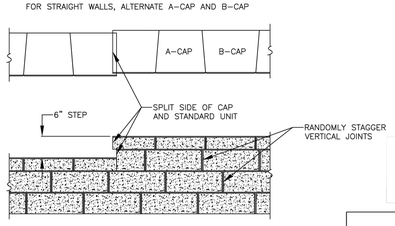

CAPPING DETAIL—PROFILE

STEP AT TOP OF WALL

SCALE: NONE

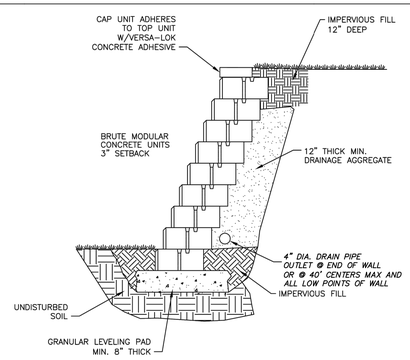

TYPICAL SECTION—UNREINFORCED RETAINING WALL

SCALE: NONE

*FENCING SYSTEMS APPROVED FOR USE WITH SLEEVE-IT(TM) 1224R ARE LIMITED TO THE FOLLOWING HEIGHTS: CHAIN LINK—UP TO 8-FT, PRIVACY —UP TO 6-FT (WOODEN, PVC, METAL). POST SIZE 4"X4" MAX.

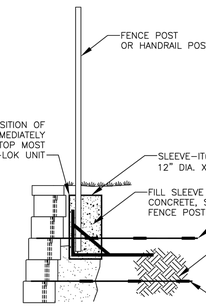

FENCE POST DETAIL W/ SLEEVE-IT(TM) 1224R

SQUARE FOOT UNIT—WITH SLEEVE-IT(TM) 1224R

SCALE: NONE

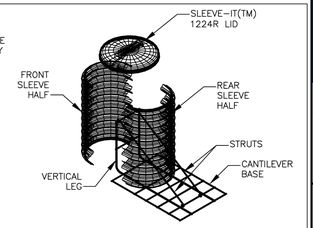

SLEEVE-IT(TM) ISO 1224R

SYSTEM COMPONENTS

SCALE: NONE

SEE SLEEVE-IT(TM) SYSTEM MANUFACTURER, STRATA SYSTEMS FOR COMPLETE SPECIFICATIONS, AND TECHNICAL GUIDANCE

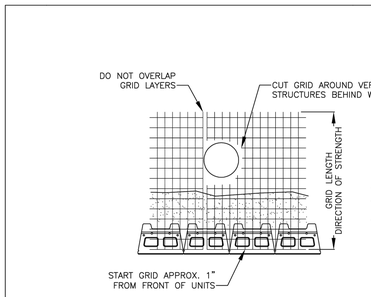

NOTE:
- FOLLOW GEOSYNTHETIC GRID MANUFACTURER'S INSTALLATION INSTRUCTIONS AND SPECIFICATIONS
- GEOGRID LENGTH AND ELEVATION PLACEMENT SHALL BE DETERMINED BY WALL DESIGN ENGINEER

GEOSYNTHETIC AT STRUCTURES BEHIND WALL

SQUARE FOOT UNIT

SCALE: NONE

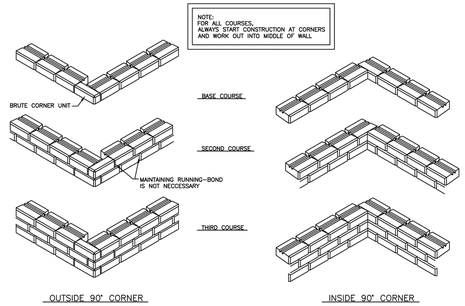

INSTALLATION SEQUENCE

SCALE: NONE

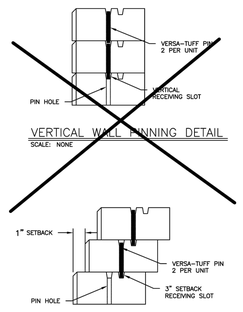

3" SETBACK PINNING DETAIL

SCALE: NONE

VERSA-LOK BRUTE PIN

SCALE: NONE

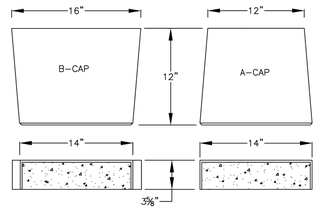

VERSA-LOK CAP UNITS

UNIT DIMENSIONS

SCALE: NONE

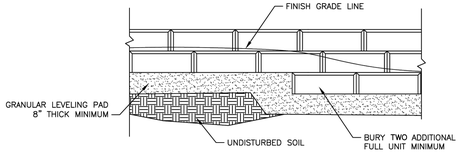

NOTE:
-LIMIT CHANGES IN BASE ELEVATION TO 8" PER STEP TO AVOID DIFFERENTIAL SETTLEMENT
-STEP OFTEN ENOUGH TO MAINTAIN MINIMUM REQUIRED EMBEDMENT

STEPPING BASE DETAIL

SCALE: NONE

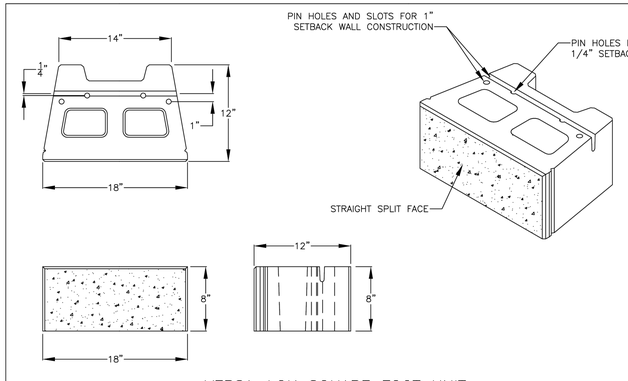

VERSA-LOK SQUARE FOOT UNIT

UNIT DIMENSIONS

SCALE: NONE

THESE PRELIMINARY DETAILS ARE INTENDED AS AN AID IN DESIGNING ATTRACTIVE, DURABLE RETAINING WALLS WITH VERSA-LOK STANDARD UNITS. FINAL DETERMINATION OF THE SUITABILITY OF ANY INFORMATION OR MATERIAL FOR THE USE CONTEMPLATED, AND ITS MANNER OF USE, IS THE SOLE RESPONSIBILITY OF THE USER. A FINAL PROJECT SPECIFIC DESIGN SHOULD BE PREPARED BY A QUALIFIED, LICENSED, PROFESSIONAL ENGINEER.

VERSA-LOK® Retaining Wall Systems (800)770-4525 fax(651)770-4088 6348 Hwy36 Stw1, Oakdale,MN 55128 Solid Solutions.™

BRUTE DETAILS	SCALE: AS NOTED
	DRAWN BY: PPS
UNREINFORCED RETAINING WALL	CHECKED BY:
	DATE: 10/04
	DWG. NO.: brute unreinforced wall

THESE PRELIMINARY DETAILS ARE INTENDED AS AN AID IN DESIGNING ATTRACTIVE, DURABLE RETAINING WALLS WITH VERSA-LOK STANDARD UNITS. FINAL DETERMINATION OF THE SUITABILITY OF ANY INFORMATION OR MATERIAL FOR THE USE CONTEMPLATED, AND ITS MANNER OF USE, IS THE SOLE RESPONSIBILITY OF THE USER. A FINAL PROJECT SPECIFIC DESIGN SHOULD BE PREPARED BY A QUALIFIED, LICENSED, PROFESSIONAL ENGINEER.

VERSA-LOK® Retaining Wall Systems (800)770-4525 fax(651)770-4088 6348 Hwy36 Stw1, Oakdale,MN 55128 Solid Solutions.™

VERSA-LOK SQUARE FOOT DETAILS	SCALE: 3/4"=1'
	DRAWN BY: PPS
FENCEPOST WITH SLEEVE IT	CHECKED BY:
	DATE: 10/2007
	DWG. NO.: 8' fencepost with sleeve it

THESE PRELIMINARY DETAILS ARE INTENDED AS AN AID IN DESIGNING ATTRACTIVE, DURABLE RETAINING WALLS WITH VERSA-LOK STANDARD UNITS. FINAL DETERMINATION OF THE SUITABILITY OF ANY INFORMATION OR MATERIAL FOR THE USE CONTEMPLATED, AND ITS MANNER OF USE, IS THE SOLE RESPONSIBILITY OF THE USER. A FINAL PROJECT SPECIFIC DESIGN SHOULD BE PREPARED BY A QUALIFIED, LICENSED, PROFESSIONAL ENGINEER.

VERSA-LOK® Retaining Wall Systems (800)770-4525 fax(651)770-4088 6348 Hwy36 Stw1, Oakdale,MN 55128 Solid Solutions.™

VERSA-LOK SQUARE FOOT DETAILS	SCALE: AS NOTED
	DRAWN BY: PPS
PINNING	CHECKED BY:
	DATE: 10/04
	DWG. NO.: brute pinning

THESE PRELIMINARY DETAILS ARE INTENDED AS AN AID IN DESIGNING ATTRACTIVE, DURABLE RETAINING WALLS WITH VERSA-LOK STANDARD UNITS. FINAL DETERMINATION OF THE SUITABILITY OF ANY INFORMATION OR MATERIAL FOR THE USE CONTEMPLATED, AND ITS MANNER OF USE, IS THE SOLE RESPONSIBILITY OF THE USER. A FINAL PROJECT SPECIFIC DESIGN SHOULD BE PREPARED BY A QUALIFIED, LICENSED, PROFESSIONAL ENGINEER.

VERSA-LOK® Retaining Wall Systems (800)770-4525 fax(651)770-4088 6348 Hwy36 Stw1, Oakdale,MN 55128 Solid Solutions.™

VERSA-LOK SQUARE FOOT DETAILS	SCALE: 1 1/2"=1'
	DRAWN BY: PPS
CAP UNITS	CHECKED BY:
	DATE: 10/2007
	DWG. NO.: 8" cap units

THESE PRELIMINARY DETAILS ARE INTENDED AS AN AID IN DESIGNING ATTRACTIVE, DURABLE RETAINING WALLS WITH VERSA-LOK STANDARD UNITS. FINAL DETERMINATION OF THE SUITABILITY OF ANY INFORMATION OR MATERIAL FOR THE USE CONTEMPLATED, AND ITS MANNER OF USE, IS THE SOLE RESPONSIBILITY OF THE USER. A FINAL PROJECT SPECIFIC DESIGN SHOULD BE PREPARED BY A QUALIFIED, LICENSED, PROFESSIONAL ENGINEER.

VERSA-LOK® Retaining Wall Systems (800)770-4525 fax(651)770-4088 6348 Hwy36 Stw1, Oakdale,MN 55128 Solid Solutions.™

BRUTE DETAILS	SCALE: AS NOTED
	DRAWN BY: PPS
BASE STEPPING	CHECKED BY:
	DATE: 10/04
	DWG. NO.: brute base stepping

THESE PRELIMINARY DETAILS ARE INTENDED AS AN AID IN DESIGNING ATTRACTIVE, DURABLE RETAINING WALLS WITH VERSA-LOK STANDARD UNITS. FINAL DETERMINATION OF THE SUITABILITY OF ANY INFORMATION OR MATERIAL FOR THE USE CONTEMPLATED, AND ITS MANNER OF USE, IS THE SOLE RESPONSIBILITY OF THE USER. A FINAL PROJECT SPECIFIC DESIGN SHOULD BE PREPARED BY A QUALIFIED, LICENSED, PROFESSIONAL ENGINEER.

VERSA-LOK® Retaining Wall Systems (800)770-4525 fax(651)770-4088 6348 Hwy36 Stw1, Oakdale,MN 55128 Solid Solutions.™

BRUTE DETAILS	SCALE: AS NOTED
	DRAWN BY: PPS
CORNER DETAILS	CHECKED BY:
	DATE: 10/04
	DWG. NO.: brute corner details

ESS
Engineering Surveys & Services
DELIVERING YOUR VISION ™
1113 Fay Street, Columbia, MO 65201
573 - 449 - 2646
802 El Dorado Drive, Jefferson City, MO 65101
573-636-3303
1775 West Main Street, Sedalia, MO 65301
660-826-8818
www.ess-inc.com
MO Engineering Corp. # 2004005018

N

0 1"

SCALE: 1" = 10'

WILSHIRE HILLS PHASE III

3200 NE WILSHIRE DR

LEE'S SUMMIT JACKSON COUNTY, MISSOURI

7/13/2023

STATE OF MISSOURI
JOSHUA DAVID LEHMEN
NUMBER PE-2012000779
PROFESSIONAL ENGINEER

JOSHUA D. LEHMEN
PROFESSIONAL ENGINEER
PE-2012000779

IF ORIGINAL SIGNATURE OR DIGITAL AUTHENTICATION IS NOT PRESENT THIS MEDIA SHOULD NOT BE CONSIDERED A CERTIFIED DOCUMENT.

Date

JULY 13, 2023

Revised

1 FEBRUARY 23, 2024

Design: JL Drawn: MJS

RETAINING WALL DETAILS

Sheet

RW2.01

CONSTRUCTION DOCUMENTS

ES&S PROJECT NO. 15925

P:\GENERAL PROJECTS\15925—JES-WILSHIRE-HILLS-3-ENG\CAD\15925 WALL PLAN .DWG 2/27/2024

GENERAL REQUIREMENTS

1. CONTRACTOR SHALL PERFORM ALL WORK IN CONFORMANCE WITH THE 2018 IBC CODE, AS AMENDED BY THE CITY OF LEE'S SUMMIT, MO.

2. CONTRACTOR SHALL VERIFY ALL DIMENSIONS AND CONDITIONS PRIOR TO CONSTRUCTION AND SHALL BE RESPONSIBLE FOR COORDINATING ALL CONTRACT DOCUMENTS, INCLUDING ALL REQUIREMENTS, OPENINGS, ETC. WHETHER SHOWN ON STRUCTURAL DRAWINGS OR NOT. CONTRACTOR SHALL REVIEW/VERIFY ALL DIMENSIONS & ELEVATIONS AND REPORT ANY DISCREPANCIES, INCONSISTENCIES, OR DIFFICULTIES AFFECTING THE WORK TO THE ARCHITECT AND ENGINEER BEFORE PROCEEDING WITH THE WORK.

3. THE CONTRACTOR SHALL FURNISH ALL LABOR, MATERIALS, AND EQUIPMENT NECESSARY TO COMPLETE THE WORK.

4. THESE DRAWINGS ARE FOR THIS SPECIFIC PROJECT AND NO OTHER USE IS AUTHORIZED, OR PERMITTED.

5. THE BUILDING IS NOT STRUCTURALLY STABLE UNTIL ALL FRAMING, CONNECTIONS, SHEATHING, PERMANENT BRACING, ETC. ARE COMPLETE. THE CONTRACTOR IS THE SOLE PARTY RESPONSIBLE FOR THE STABILITY OF THE BUILDING UNTIL SUCH TIME AS IT IS COMPLETE. THE DESIGN OF ALL TEMPORARY BRACING SYSTEMS IS THE RESPONSIBILITY OF THE CONTRACTOR AS A MEANS AND METHODS OF CONSTRUCTION ITEM. ALL TEMPORARY BRACING SHALL REMAIN IN PLACE UNTIL ALL STRUCTURAL WORK IS COMPLETE. THE DESIGN LOADS SHALL NOT BE EXCEEDED AT ANY TIME DURING CONSTRUCTION.

6. THE CONTRACTOR SHALL BE SOLELY RESPONSIBLE FOR THE MEANS, METHODS AND SEQUENCES OF CONSTRUCTION.

USE OF CONSTRUCTION DRAWINGS

1. CONTRACTOR SHALL NOT SCALE DRAWINGS. ONLY WRITTEN DIMENSIONS OR KEYED NOTES SHALL BE USED. CONTACT ENGINEER IF CLARIFICATION OR ADDITIONAL INFORMATION IS REQUIRED.

2. DRAWINGS SHALL NOT BE REPRODUCED FOR SUBMITTALS. DRAWINGS OR PORTIONS OF DRAWINGS USED FOR SUBMITTALS WILL BE REJECTED AND RETURNED TO CONTRACTOR.

3. DIMENSIONS ARE AS FOLLOWS UNLESS NOTED OTHERWISE:
   A. FACE OF STUD
   B. TO CENTERLINE OF COLUMNS, FOOTINGS, DEMISING WALLS
   C. TO TOP OF STRUCTURAL STEEL

STRUCTURAL DESIGN CRITERIA

1. ROOF LIVE LOAD = 30 psf (+ CODE PRESCRIBED DRIFT)

2. FLOOR LIVE LOAD = 40 psf @ UNITS
   = 100 psf @ CORRIDORS & COMMON AREAS

3. STRUCTURE DEAD LOAD = ACTUAL WEIGHT OF MATERIALS

4. MISC. M.E.P. LOADS = 10 psf

5. SNOW LOAD
   GROUND SNOW LOAD, Pg = 20 psf
   ROOF SNOW LOAD, Pf = 15.4 psf

6. LATERAL LOADS - WIND:
   A. BASIC WIND SPEED, Vult = 109 MPH
   B. EXPOSURE = B

7. LATERAL LOADS - SEISMIC:
   A. OCCUPANCY CATEGORY = II
   B. IMPORTANCE = 1.0
   C. SITE CLASS = C (PER GEOTECH)
   D. S_{DS} = 0.087g
   E. S_{D1} = 0.068g
   F. C_S = 0.0435
   G. BASE SHEAR = 89.3 KIPS
   H. DESIGN CATEGORY = B
   I. RESPONSE = 2
   J. ANALYSIS PROCEDURE = EQUIVALENT LATERAL FORCE PROCEDURE

COMPONENTS & CLADDING PRESSURES (PSF):

ZONE		EFFECTIVE AREA (SF)							
		10		20		50		100	

NOTE: C&C ELEMENTS NOT SPECIFICALLY DESIGNED ON THESE DWGS SHALL BE DESIGNED TO THE WIND PRESSURES STIPULATED BY ASCE 7-16 FOR THE TRIBUTARY AREA OF THE SPECIFIC COMPONENTS.

a = 20' (ASCE 7-16, FIG. 30.4-1)

FOUNDATION CRITERIA

1. THE GEOTECHNICAL REPORT WAS PREPARED BY ENGINEERING SURVEYS & SERVICES. THE PROJECT NUMBER IS L14879, AND THE ENGINEER CAN BE REACHED AT 573.449.2646.

2. THE CONTRACTOR SHALL COMPLY WITH ALL REQUIREMENTS AND RECOMMENDATIONS CONTAINED IN THE GEOTECHNICAL REPORT UNLESS SPECIFIED OR DETAILED OTHERWISE. NOTIFY ENGINEER OF ANY DISCREPANCIES, INCONSISTENCIES OR DIFFICULTIES PRIOR TO PROCEEDING WITH THE WORK.

3. THE CONTRACTOR SHALL NOTIFY THE ENGINEER OF ANY SOIL CONDITIONS THAT ARE IN VARIANCE WITH THE GEOTECHNICAL REPORT.

4. FOUNDATIONS, GRADE BEAMS, AND RETAINING WALLS ARE DESIGNED TO BEAR ON SOIL CAPABLE OF SAFELY SUPPORTING 2,000 psf.

5. THE CONTRACTOR SHALL PROVIDE FOR DEWATERING AT ALL EXCAVATIONS, REGARDLESS OF THE SOURCE OF WATER.

6. ALL FOUNDATION EXCAVATIONS SHALL BE INSPECTED BY A QUALIFIED GEOTECHNICAL ENGINEER, APPROVED BY THE ARCHITECT/ENGINEER, PRIOR TO PLACEMENT OF ANY FOUNDATION ELEMENT.

7. RETAINING STRUCTURES ARE DESIGNED FOR 55 psf OF EQUIVALENT FLUID PRESSURE.

8. ALL CONCRETE IN STRUCTURAL WORK, RETAINING BACKFILL, SHALL HAVE ATTAINED ITS DESIGN STRENGTH AND BE TEMPORARILY BRACED PRIOR TO BEING BACKFILLED.

9. MOISTURE CONTENT IN ALL SOILS BELOW BUILDINGS SHALL NOT BE ALLOWED TO CHANGE AFTER EXCAVATIONS AND AFTER FINAL GRADING FOR SLABS ON GRADE ARE COMPLETE. ANY SUBGRADE MATERIALS THAT BECOME DESICCATED, SOFTENED BY WATER, OR OTHERWISE DISTURBED SHALL BE RECOMPACTED TO CONFORM TO THE GEOTECHNICAL REPORT.

10. DO NOT PLACE ANY FOUNDATIONS OR CONCRETE ON FROZEN GROUND.

11. COLUMN ANCHORS AND SHEAR WALL HOLDOWN ANCHORS SHOULD BE PRE-SET IN CONCRETE WHEN POSSIBLE, OR DRILLED AND EPOXIED IF NECESSARY. PERIMETER ANCHORS MAY BE "WET" SET IN CONCRETE.

CONCRETE CRITERIA

1. ALL CONCRETE SHALL CONFORM TO THE LATEST EDITION OF THE AMERICAN CONCRETE INSTITUTE DOCUMENTS, AND CONCRETE REINFORCING STEEL INSTITUTE MANUAL OF STANDARD PRACTICE.

2. ALL CAST-IN-PLACE CONCRETE, EXCEPT EXTERIOR FLATWORK, SHALL ACHIEVE A MINIMUM 28 DAY COMPRESSIVE STRENGTH OF 3500psi. NOT LESS THAN 500 POUNDS OF CEMENT SHALL BE USED PER CUBIC YARD OF CONCRETE REGARDLESS OF STRENGTHS OBTAINED, AND NOT OVER 6 GALLONS OF WATER PER 100 POUNDS OF CEMENT. DESIGN MIX TO ACHIEVE A MAXIMUM OF 4 INCHES OF SLUMP. ALL FOOTING CONCRETE SHALL BE AIR-ENTRAINED WITH 6% +/-1% AIR. SLAB CONCRETE SHALL NOT BE AIR-ENTRAINED.

3. ALL CAST-IN-PLACE CONCRETE FOR EXTERIOR FLATWORK SHALL ACHIEVE A MINIMUM 28 DAY COMPRESSIVE STRENGTH OF 4500psi. NOT LESS THAN 560 POUNDS OF CEMENT SHALL BE USED PER CUBIC YARD OF CONCRETE REGARDLESS OF STRENGTHS OBTAINED, AND NOT OVER 5 GALLONS OF WATER PER 100 POUNDS OF CEMENT. DESIGN MIX TO ACHIEVE A MAXIMUM OF 4 INCHES OF SLUMP. ALL EXTERIOR FLATWORK CONCRETE SHALL BE AIR-ENTRAINED WITH 6% +/-1% AIR.

4. THE PRECEDING MIX DESIGNS MAY HAVE WATER-REDUCING ADMIXTURES INCLUDED TO IMPROVE WORKABILITY. ALL WATER-REDUCING ADMIXTURES SHALL CONFORM TO ASTM C494.

5. THE PRECEDING MIX DESIGNS MAY HAVE ASTM C618 CLASS C FLY ASH SUBSTITUTED FOR UP TO 15% OF THE CEMENT CONTENT. THE TOTAL CEMENTITIOUS CONTENT MAY NOT BE REDUCED.

6. ALL INTERIOR CONCRETE SLABS ON GRADE SHALL BE PLACED ABOVE 15mil VAPOR BARRIER EQUIVALENT TO STEGO WRAP. ALL VAPOR BARRIER JOINTS SHALL BE LAPPED A MIN. OF 6" AND SEALED PER MANUFACTURER'S RECOMMENDATIONS. THE VAPOR BARRIER SHALL BE PLACED ABOVE A COURSE OF FREE-DRAINING GRANULAR MATERIAL AS SPECIFIED IN THE GEOTECHNICAL REPORT. ALL DAMAGED AREAS OF THE VAPOR BARRIER SHALL BE SEALED PER THE MANUFACTURER'S RECOMMENDATIONS PRIOR TO PLACEMENT OF CONCRETE.

7. PRIOR TO PLACEMENT OF ANY CONCRETE THE CONTRACTOR SHALL VERIFY THAT ALL DIMENSIONS, ELEVATIONS, CONCRETE INSERTS, EMBEDDED ITEMS, AND ANY OPENINGS ARE CORRECT, AND RIGIDLY SECURED. THIS APPLIES TO ALL ITEMS SHOWN ON THE STRUCTURAL, ARCHITECTURAL, AND/OR M.E.P. DRAWINGS.

8. ALL CONTRACTION JOINTS IN CONCRETE SLABS ON GRADE SHALL BE LOCATED AS SHOWN ON PLANS. WHERE NOT SHOWN, LIMIT CONTROLLED AREAS TO NOT MORE THAN 225 SQUARE FEET, AND PANELS NOT GREATER THAN 15 FEET ON ANY SIDE, NOR HAVING A PANEL LENGTH TO WIDTH RATIO GREATER THAN 1.4 TO 1.0. ALL CONTRACTION JOINTS SHALL BE CUT TO A DEPTH OF A MINIMUM OF 1/3 OF THE SLAB DEPTH, AND SHALL BE CUT WITHIN 12 HOURS OF CONCRETE PLACEMENT.

9. ALL CONCRETE IS TO BE REINFORCED UNLESS SPECIFICALLY NOTED AS UNREINFORCED. PROVIDE REINFORCING IN ALL CONCRETE NOT OTHERWISE SHOWN WITH THE SAME REINFORCING AS SIMILAR SECTIONS.

10. ALL REINFORCING SHALL BE DETAILED PER ACI 315 AND MEET THE REQUIREMENTS OF ACI 318, CURRENT EDITIONS, UNLESS NOTED OTHERWISE.

11. CONSTRUCTION JOINTS IN BEAMS, SLABS, AND GRADE BEAMS SHALL OCCUR IN THE MIDDLE THIRD OF THE SPAN UNLESS NOTED OTHERWISE. PROVIDE 2x4 HORIZONTAL KEYS AT ALL CONSTRUCTION JOINTS.

12. VERTICAL COLD JOINTS SHALL BE PROVIDED IN CONTINUOUS CONCRETE WALLS AT 25'-0" MAX.

13. NO ALUMINUM ITEMS SHALL BE EMBEDDED IN CONCRETE.

14. LIMIT CHLORIDE-ION CONTENT OF ALL ADMIXTURES TO 0.06% BY WEIGHT OF CEMENT.

REINFORCING STEEL CRITERIA

1. ALL REINFORCING SHALL BE DETAILED, FABRICATED, PLACED AND SUPPORTED IN ACCORDANCE WITH THE CURRENT EDITION OF ACI 315.

2. ALL REINFORCING STEEL SHALL CONFORM TO THE REQUIREMENTS OF ASTM A615 GRADE 60, EXCEPT FOR ALL WELDED REINFORCING WHICH SHALL CONFORM TO ASTM A706 GRADE 60. WELDING SHALL CONFORM TO AWS D1.4, STRUCTURAL WELDING CODE.

3. ALL WELDED PLAIN WIRE FABRIC SHALL BE SUPPLIED IN SHEETS AND SHALL CONFORM TO ASTM A185. PROVIDE REINFORCING CHAIRS FOR ALL SLAB-ON-GRADE REINFORCING. WWF SHALL NOT BE "PULLED UP" DURING PLACEMENT. ALL WWF SHALL BE 2" BELOW TOP OF SLAB FOR 4" THICK SLABS. OVERLAP EACH SHEET TWO FULL PANELS AND TIE CROSS WIRES ON EACH SIDE.

4. CLEAR MINIMUM COVERAGE OF CONCRETE OVER ALL REINFORCING STEEL SHALL BE AS FOLLOWS:
   (ALL COVERAGE SHALL BE NOMINAL BAR DIAMETER MINIMUM.)
   A. CONCRETE PLACED AGAINST EARTH 3"
   B. FORMED CONCRETE AGAINST EARTH 2"
   C. FORMED SLABS 1"
   D. BEAMS OR COLUMNS 1-1/2"
   E. OTHER 2"

5. PROVIDE CORNER BARS AT ALL WALLS, GRADE BEAMS AND BEAMS IN THE EXTERIOR FACE. ALL CORNER BARS SHALL LAP A MINIMUM OF 24" IN EACH DIRECTION, OR 40 BAR DIAMETERS. ALL CORNER BARS SHALL MATCH SIZE AND SPACING OF HORIZONTAL BARS. WHERE THERE ARE NO VERTICAL BARS IN THE EXTERIOR FACE, PROVIDE 3-#4 VERTICAL SUPPORT BARS.

6. ALL REINFORCING BARS MARKED CONTINUOUS SHALL BE LAPPED 40 BAR DIAMETERS (24" MINIMUM) AT SPLICES AND EMBEDMENTS, UNLESS NOTED OTHERWISE AS CLASS 'B' SPLICES. SPLICE ALL TOP BARS AT MIDSPAN, AND ALL BOTTOM BARS OVER SUPPORTS, UNLESS NOTED OTHERWISE.

7. ALL REINFORCING STEEL ACCESSORIES SHALL BE IN ACCORDANCE WITH THE ACI DETAILING HANDBOOK, AND THE CONCRETE REINFORCING STEEL INSTITUTE DESIGN HANDBOOK. THE MAXIMUM SPACING OF ALL ACCESSORIES SHALL BE 4'-0" ON CENTER. ALL ACCESSORIES ON EXPOSED SURFACES ARE TO HAVE PLASTIC COATED FEET.

8. ALL DOWELS SHALL BE THE SAME SIZE AND SPACING AS ADJOINING MAIN BARS (SPLICE LENGTHS SHALL BE 40 BAR DIAMETERS, OR 24" MINIMUM, UNLESS NOTED OTHERWISE).

9. AT ALL OPENINGS IN CONCRETE WALLS AND SLABS, PROVIDE 2-#5 BARS (LENGTH = R.O. + 80 BAR DIAMETERS) AT EACH OF FOUR SIDES, AND 2-#5 X 5'-0" LG DIAGONALLY AT EACH OF FOUR CORNERS.

10. ALL SLABS AND STAIRS NOT SHOWN OTHERWISE SHALL BE REINFORCED WITH #4 BARS @ 12" O.C. EACH WAY. ALL PORCHES SHALL BE DOWELED TO ADJACENT WALLS OR GRADE BEAMS WITH #4 BARS @ 12" O.C. AND SHALL BE SLOPED 1/8" PER FOOT (MINIMUM) FOR DRAINAGE, UNLESS NOTED OTHERWISE.

11. ALLOW 1 TON OF REINFORCING STEEL TO BE USED IN THE FIELD AS DIRECTED BY THE ENGINEER-OF-RECORD (DELIVERY AND LABOR FOR SAME TO BE INCLUDED).

STRUCTURAL STEEL CRITERIA

1. ALL STRUCTURAL STEEL BEAMS AND COLUMNS SHALL CONFORM TO ASTM A992, GRADE 50 STEEL. ALL MISC. STEEL SHALL BE ASTM A36 GRADE STEEL. ALL HOLLOW STRUCTURAL SECTIONS (HSS) SHALL BE ASTM A500, GRADE B.

2. ALL STRUCTURAL STEEL SHALL BE DETAILED, FABRICATED, AND ERECTED IN ACCORDANCE WITH AISC "CODE OF STANDARD PRACTICE FOR STEEL BUILDINGS AND BRIDGES" IN THE 13TH EDITION OF THE AISC STEEL CONSTRUCTION MANUAL.

3. ALL WELDING SHALL CONFORM TO THE PROVISIONS OF AWS D1.1-10, AND ALL ELECTRODES SHALL BE E70XX. ALL WELDS SHALL BE PERFORMED BY CERTIFIED WELDERS.

4. ALL ANCHOR BOLTS SHALL BE 3/4" DIAMETER, ASTM F1554, GRADE 36 UNLESS NOTED OTHERWISE.

5. ALL BASE PLATES FOR COLUMNS SUPPORTING FLOORS OR ROOFS SHALL BE GROUTED BEFORE THE FLOOR OR ROOF FRAMING IS INSTALLED.

6. ALL BOLTS NOT OTHERWISE SPECIFIED SHALL BE 3/4" DIAMETER HIGH-STRENGTH BOLTS (ASTM A325-N). ALL BOLTS SHALL BE FULLY PRETENSIONED, AND ALL CONNECTIONS SHALL HAVE A MINIMUM OF 2 BOLTS. ALL BEAM CONNECTIONS SHALL BE DESIGNED PER THE AISC MANUAL OF STEEL CONSTRUCTION "FRAMED BEAM CONNECTIONS" FOR THE INDICATED REACTIONS, OR AT LEAST 0.4x BEAM TOTAL SHEAR CAPACITY SHOWN IN THE ALLOWABLE UNIFORM LOAD TABLES, WHICHEVER IS GREATER. ALL CONNECTIONS SHALL ALSO ACCOUNT FOR ECCENTRICITY WHERE REQUIRED BY AISC. CONNECTION DESIGN AND SHOP DRAWING PREPARATION SHALL BE COMPLETED BY A PROFESSIONAL ENGINEER LICENSED IN THE PROJECT STATE, AND ALL SHOP DRAWINGS AND CONNECTION CALCULATIONS SHALL BEAR THEIR SEAL. ALL BOLTED CONNECTIONS SHALL BE ASSEMBLED AND INSPECTED IN ACCORDANCE WITH RCSC-2009, SPECIFICATION FOR STRUCTURAL JOINTS USING HIGH-STRENGTH BOLTS.

7. THE CONTRACTOR SHALL BE RESPONSIBLE FOR PROVIDING ALL MISCELLANEOUS METALS, WHETHER SHOWN ON STRUCTURAL DRAWINGS OR NOT. REFERENCE ARCHITECTURAL DRAWINGS FOR ADDITIONAL MISC. METALS.

8. PROVIDE (1) L 6x3-1/2x3/8 LOOSE LINTEL FOR EACH 4" WIDTH OF MASONRY. MAX SPAN = 6'-0". LOOSE LINTELS SHALL BEAR ON 6" OF SOLID MASONRY ON EACH END. ALL LOOSE LINTELS SHALL BE GALVANIZED AND INSTALLED WITH THE LONG LEG VERTICAL (LLV).

9. ALL DESIGN, FABRICATION, AND INSTALLATION OF STEEL DECKING SHALL COMPLY WITH THE RECOMMENDATIONS OF THE STEEL DECK INSTITUTE. ANY & ALL STEEL ROOF DECKING SHALL BE GALVANIZED, UNLESS NOTED OTHERWISE.

TIMBER AND WOOD FRAMING CRITERIA

1. ALL WOOD FRAMING MEMBERS, WOOD CONSTRUCTION, AND FASTENERS SHALL BE IN ACCORDANCE WITH THE APPLICABLE CODE, AND THE CURRENT EDITION OF THE NATIONAL DESIGN SPECIFICATION FOR WOOD CONSTRUCTION (NDS).

2. ALL WOOD MEMBERS USED IN BENDING (ie HEADERS, BEAMS), SHALL BE DOUGLAS FIR-LARCH #1 OR ANY SPECIES WHICH MEETS THE FOLLOWING PROPERTIES: Fb=1000psi, E=1,600,000psi.

3. ALL WOOD MEMBERS USED IN COMPRESSION (ie STUDS, POSTS), SHALL BE DOUGLAS FIR-LARCH #2 OR ANY SPECIES WHICH MEETS THE FOLLOWING PROPERTIES: Fc=1350psi, E=1,600,000psi.

4. ALL WOOD MEMBERS SHALL BE SEASONED LUMBER WITH A MOISTURE CONTENT AT OR BELOW 19% IN SERVICE.

5. ALL WOOD PLATES, SILLS AND SLEEPERS WHICH REST ON CONCRETE, MASONRY, OR WHICH ARE IN CONTACT WITH THE EARTH SHALL BE TREATED WOOD. ALL FASTENERS IN CONTACT WITH TREATED LUMBER SHALL BE GALVANIZED. ALL ANCHOR BOLTS SHALL BE 1/2" DIAMETER GALVANIZED BOLTS AT 32" O.C. UNLESS NOTED OTHERWISE. A MINIMUM OF (2) ANCHORS ARE REQUIRED PER SILL PLATE SEGMENT WITH (1) BOLT LOCATED FROM THE END OF EACH SEGMENT A MINIMUM OF 4" BUT NOT MORE THAN 12".

6. ALL JOIST HANGERS SHALL HAVE ICC APPROVAL AND SHALL BE EQUAL TO SIMPSON STRONG-TIE "LUS" HANGERS FOR TYPICAL WOOD CONSTRUCTION, "HUCQ" OR "HGLTV" HANGERS FOR ATTACHMENT OF BEAMS AND GIRDERS, "LB" OR "HB" HANGERS FOR WELD-ON APPLICATIONS TO STEEL BEAMS, AND "WMU" HANGERS FOR MASONRY ATTACHMENT, UNLESS NOTED OTHERWISE. HANGERS SHALL BE WELDED TO STEEL BEAMS UNLESS OTHERWISE APPROVED BY THE EOR. ALL HANGERS SHALL HAVE MAXIMUM NAILING PER THE MANUFACTURER'S SPECIFICATIONS.

7. ALL NAILS SHALL BE COMMON WIRE NAILS WITH SIZES AND SPACING CONFORMING TO TABLE 2304.9.1 OF THE SPECIFIED EDITION OF THE IBC.

8. ALL FLOOR SHEATHING SHALL BE 3/4" APA RATED TONGUE AND GROOVE PLYWOOD, STRUCTURAL 1, EXTERIOR GRADE PANELS. ALL FLOOR SHEATHING SHALL BE GLUED AND NAILED WITH 10d COMMON NAILS AT 12" O.C. TO ALL SUPPORTS, 6" O.C. MAX. @ PANEL EDGES, AND @ 4" O.C. MAX. AT DIAPHRAGM EDGES, EXCEPT AS NOTED IN THE ROOF/FLOOR PLAN NAILING SCHEDULE. ALL PANEL EDGES SHALL BE STAGGERED. ANY STANDING WATER THAT ACCUMULATES ON FLOORS SHALL BE REMOVED WITHIN 24 HOURS.

9. ALL ROOF SHEATHING SHALL BE 5/8" APA RATED TONGUE AND GROOVE SHEATHING (AT CONTRACTOR'S OPTION, SQUARE-EDGED PANELS MY BE USED WITH ROOF CLIPS), STRUCTURAL 1, EXPOSURE 1 PANELS. ALL ROOF SHEATHING SHALL BE ATTACHED WITH 10d COMMON NAILS AT 12" O.C. TO ALL SUPPORTS, 6" O.C. MAX. AT PANEL EDGES, AND @ 4" O.C. MAX. AT DIAPHRAGM EDGES, EXCEPT AS NOTED IN THE ROOF/FLOOR PLAN NAILING SCHEDULE. ALL PANEL EDGES SHALL BE STAGGERED.

10. ALL WALL SHEATHING SHALL BE APA RATED OSB, EXPOSURE 1, STRUCTURAL 1 PANELS. ALL WALL SHEATHING SHALL BE ATTACHED WITH 8d COMMON NAILS AT 6" O.C. MAX. AT PANEL EDGES, AND AT 12" O.C. IN THE FIELD FOR 16" STUD SPACING (6" O.C. MAX. IN THE FIELD FOR 24" STUD SPACING), EXCEPT AS NOTED IN THE SHEATHING ATTACHMENT SCHEDULE. IF NAILING LESS THAN 2" O.C. IS REQUIRED, A 3X OR (2)2X STUDS SHALL BE REQUIRED AT ADJOINING PANELS, AND NAILING SHALL BE STAGGERED.

11. ALL BEARING WALLS SHALL BE CONSTRUCTED PER STRUCTURAL DETAILS AND SHALL SUPERSEDE THE ARCHITECTURAL DRAWINGS. IF ANY DISCREPANCIES EXIST BETWEEN STRUCTURAL AND ARCHITECTURAL DRAWINGS IN THE CONSTRUCTION OR SIZE OF BEARING WALLS, THE CONTRACTOR IS RESPONSIBLE FOR CONTACTING THE ARCHITECT AND ENGINEER FOR CLARIFICATION.

12. ALL STRUCTURAL HEADERS ARE TO BE CONSTRUCTED PER STRUCTURAL PLANS AND DETAILS. IF ANY OPENINGS IN BEARING WALLS GREATER THAN 1'-4" ARE NOT SPECIFIED ON THE DRAWINGS, THE CONTRACTOR IS RESPONSIBLE FOR CONTACTING THE ENGINEER FOR CLARIFICATION.

13. ALL JOIST BLOCKING AND BRIDGING SHALL BE SOLID WOOD OR CROSS BRIDGING OF EITHER WOOD OR METAL STRAPS. SPACING OF BLOCKING SHALL NOT EXCEED 8'-0" O.C.

14. BRIDGING OF STUD BEARING WALLS AND SHEAR WALLS SHALL BE SOLID, AND MATCH SHEATHING JOINTS.

15. ALL LAMINATED VENEER LUMBER (LVL) SHALL BE EQUIVALENT TO TRUSS JOIST "MICROLLAM" WITH AN ALLOWABLE FLEXURAL BENDING STRESS (Fb) OF 2600psi AND A MODULUS OF ELASTICITY (E) OF 1,900,000psi.

16. ALL PARALLEL STRAND LUMBER (PSL) SHALL BE EQUIVALENT TO TRUSS JOIST "PARALLAM" WITH AN ALLOWABLE FLEXURAL BENDING STRESS (Fb) OF 2900psi AND A MODULUS OF ELASTICITY (E) OF 2,000,000psi.

17. ALL ENGINEERED WOOD ROOF AND FLOOR TRUSSES SHALL BE DESIGNED IN ACCORDANCE WITH THE TRUSS PLATE INSTITUTE'S NATIONAL DESIGN STANDARD FOR METAL-PLATE CONNECTED WOOD TRUSS CONSTRUCTION (ANSI/TPI-1 CURRENT EDITION). TRUSSES SHALL BE DESIGNED AND MANUFACTURED BY AN AUTHORIZED MEMBER OF THE WOOD TRUSS COUNCIL OF AMERICA (WTCA). TRUSS DESIGN SHALL CONFORM TO SPECIFIED CODES, ALLOWABLE STRESS INCREASES, DEFLECTION LIMITATIONS AND OTHER APPLICABLE CRITERIA OF THE GOVERNING CODE.

18. ENGINEERED WOOD TRUSS DESIGN CRITERIA:
   ROOF TRUSSES:
   TOP CHORD LIVE LOAD = 30 psf
   TOP CHORD DEAD LOAD = 10 psf
   BOTTOM CHORD LIVE LOAD = 20 psf (NON-CONCURRENT W/ TCLL)
   BOTTOM CHORD DEAD LOAD = 15 psf
   ALLOWABLE DEFLECTION = L/360 TL (1/2" MAX LL, 1" MAX TL DEFLECTION)
   (TRUSS DESIGNER TO CALCULATE AND DESIGN FOR SNOW DRIFT AS APPLICABLE)
   FLOOR TRUSSES:
   TOP CHORD LIVE LOAD = 40 psf (100 psf @ COMMON AREAS)
   TOP CHORD DEAD LOAD = 30 psf (INCLUDES 5 psf TRUSS WEIGHT)
   BOTTOM CHORD LIVE LOAD = 0 psf
   BOTTOM CHORD DEAD LOAD = 15 psf
   ALLOWABLE DEFLECTION = L/360 TL (1/2" MAX LL, 1" MAX TL DEFLECTION)

19. WOOD TRUSS SHOP DRAWINGS SHOWING COMPLETE ERECTION AND FABRICATION DETAILS AND CALCULATIONS (INCLUDING CONNECTIONS) SHALL BE SUBMITTED TO THE PROJECT ARCHITECT/ENGINEER FOR REVIEW PRIOR TO FABRICATION AND/OR ERECTION. THESE SHOP DRAWINGS SHALL BEAR THE SEAL OF A PROFESSIONAL ENGINEER, REGISTERED IN THE PROJECT STATE. SHOP DRAWINGS SHALL ALSO BE SUBMITTED TO THE LOCAL GOVERNMENT CONTROLLING AGENCY WHEN REQUIRED BY THAT AGENCY.

20. ALL WOOD TRUSSES SHALL BE SECURELY BRACED BOTH DURING ERECTION AND PERMANENTLY, AS INDICATED ON THE APPROVED TRUSS DESIGN DRAWINGS AND IN ACCORDANCE WITH TPI'S COMMENTARY AND RECOMMENDATIONS FOR HANDLING, INSTALLING AND BRACING METAL-PLATE CONNECTED WOOD TRUSSES (HIB-91, BOOKLET), THE LATEST EDITION OF THE ANSI/TPI-1, AND "THE GUIDE TO GOOD PRACTICE FOR HANDLING, INSTALLING, RESTRAINING, AND BRACING OF METAL PLATE CONNECTED WOOD TRUSSES" (BCSI 1-08) AND RELATED SUMMARY SHEETS.

21. THE TRUSS MANUFACTURER SHALL SUPPLY ALL HARDWARE AND FASTENERS FOR JOINING TRUSS MEMBERS TOGETHER AND FASTENING TRUSS MEMBERS TO THEIR SUPPORTS. METAL CONNECTOR PLATES SHALL BE MANUFACTURED BY A MEMBER OF THE WOOD TRUSS COUNCIL OF AMERICA (WTCA) AND SHALL BE 20 GAUGE MINIMUM. CONNECTOR PLATES SHALL MEET OR EXCEED ASTM A653, GRADE 33, WITH ASTM A924 GALVANIZED COATING DESIGNATION G60.

22. SHIPMENT, HANDLING, AND ERECTION OF TRUSSES SHALL BE BY EXPERIENCED, QUALIFIED PERSONS AND SHALL BE PERFORMED IN A MANNER SO AS NOT TO ENDANGER LIFE OR PROPERTY. APPARENT TRUSS DAMAGE SHALL BE REPORTED TO THE TRUSS MANUFACTURER FOR EVALUATION PRIOR TO ERECTION. CUTTING OR ALTERATION OF TRUSSES IS NOT PERMITTED.

CONCRETE MASONRY UNITS CRITERIA

1. CONCRETE BLOCK USED IN EXTERIOR WALLS OR LOAD BEARING WALLS SHALL MEET THE REQUIREMENTS OF ASTM C90 AND HAVE A MINIMUM NET COMPRESSIVE STRENGTH OF 2,000 PSI AND LAID UP USING TYPE N MORTAR SUCH THAT F'M EQUALS 1,500 PSI. ANY BLOCK IN CONTACT WITH EARTH SHALL BE NORMAL WEIGHT UNITS, LAID USING TYPE "S" MORTAR AND GROUTED SOLID.

2. THE CONTRACTOR SHALL PROVIDE ADEQUATE TEMPORARY BRACING FOR ALL MASONRY WALLS DURING CONSTRUCTION.

3. ALL CONCRETE BLOCK SHALL HAVE 9 GAUGE (OR LARGER) HOT-DIP GALVANIZED HORIZONTAL JOINT REINFORCING (LADDER OR TRUSS) PER SPECIFICATIONS (16" MAXIMUM VERTICAL SPACING).

4. CAVITY WALL CONSTRUCTION SHALL BE REINFORCED AS DESIGNED FOR SPECIFIC CONCRETE BLOCK USED. THE HORIZONTAL JOINT REINFORCING SHALL BE OF THE LADDER OR TRUSS STYLE PER SPECIFICATION AND CONTINUOUS BETWEEN BRICK AND BLOCK, AS PRESCRIBED BY ARCHITECTURAL DRAWINGS, AND/OR SPECIFICATIONS.

5. CONCRETE BLOCK SHALL BE REINFORCED AS FOLLOWS IN 8" WALLS (U.N.O.):
   A. VERTICAL REINFORCING SHALL BE A MINIMUM OF 1 - #4 BAR IN 8" WALLS AT 32" ON CENTER, AT EACH CORNER, AT EACH DOOR AND WINDOW JAMB, EACH SIDE OF CONTROL JOINTS AND IN THE END VOID OF EACH LENGTH OF WALL. LAP SPLICES FOR MASONRY VERTICAL REINFORCING SHALL BE 48 BAR DIAMETERS OR 24" MIN.
   B. HORIZONTAL JOINT REINFORCING SHALL BE AS NOTED ABOVE. CONTINUOUS HORIZONTAL BARS SHALL BE INCLUDED PER SECTION OR DETAIL IN BOND BEAM OR OPTIONAL RUNNING BOND BEAM WHERE NOTED. WHERE BOND BEAMS ARE CONTINUOUS AT CORNERS OF WALLS, SUPPLY CORNER BARS MATCHING SIZE OF HORIZONTAL BARS (MINIMUM 2'-0" OR 40 BAR DIAMETERS IN EACH DIRECTION).

6. GROUT, WHERE NOTED ABOVE, SHALL HAVE A MINIMUM DESIGN ULTIMATE COMPRESSIVE STRENGTH OF 2,500 PSI AT 28 DAY TEST AND 3/8" MAXIMUM AGGREGATE SIZE.

7. NON-LOAD BEARING CONCRETE BLOCK WALLS SHALL BE ISOLATED FROM ADJACENT STRUCTURAL ELEMENTS WITH VERTICAL 3/8" CONTROL JOINTS AND AT THE TOP OF THE WALL WITH 1" AIR SPACE OR COMPRESSIBLE MATERIAL AND SUPPORT PER ARCHITECTURAL DETAIL.

8. WALLS SHALL BE ANCHORED TOP AND BOTTOM BY DOWELS MATCHING WALL VERTICAL REINFORCING (UNLESS NOTED OTHERWISE) FROM FLOOR SLAB BOTTOM AND BRACING ANGLES AT THE TOP, PER DETAILS ON THE DRAWINGS.

MASONRY VENEER CRITERIA

1. MASONRY VENEER SHALL HAVE A MINIMUM AVERAGE NET-AREA COMPRESSIVE STRENGTH OF 3,000 PSI. GROUT SHALL HAVE A MINIMUM COMPRESSIVE STRENGTH OF 2,000 PSI.

2. WIRE TIES SHALL BE AT LEAST WIRE SIZE W1.7 (9 ga.) AND EXTEND AT LEAST HALFWAY THROUGH THE VENEER, BUT MAINTAIN AT LEAST 5/8" COVER ON THE OUTSIDE FACE. OUTER ENDS OF WIRES ARE TO BE BENT 90 DEGREES AND EXTEND 2" PARALLEL TO THE FACE OF THE VENEER.

3. ADJUSTABLE ANCHORS THAT ALLOW VERTICAL OR HORIZONTAL ADJUSTMENT BUT RESIST TENSION AND COMPRESSION FORCES PERPENDICULAR TO THE PLANE OF THE WALL SHALL BE USED FOR ATTACHMENT OVER SHEATHING TO WOOD STUDS. WIRE COMPONENTS OF ADJUSTABLE ANCHORS SHALL CONFORM TO THE SIZE AND INSTALLATION REQUIREMENTS OF THAT ANCHOR TYPE. ALL ANCHORS SHALL BE GALVANIZED.

4. CORRUGATED OR SHEET METAL ANCHORS ARE NOT ALLOWED.

5. MASONRY VENEER ANCHORS SHALL BE PROVIDED AT 32" ON CENTER HORIZONTALLY AND AT 16" ON CENTER VERTICALLY. AT LEAST ONE ANCHOR SHALL BE PROVIDED FOR EVERY 3.5 SQ. FT. OF WALL AREA (REDUCED TO 2.67 SQ. FT. FOR ADJUSTABLE TWO-PIECE ANCHORS). REFERENCE PROJECT SPECIFICATIONS FOR FURTHER INFORMATION ON ACCEPTABLE PRODUCTS.

6. ALL MASONRY SHALL HAVE 9 GAUGE HOT-DIP GALVANIZED HORIZONTAL JOINT REINFORCING (LADDER OR TRUSS) PER SPECIFICATIONS (16" MAXIMUM VERTICAL SPACING).

7. LINTELS OVER ALL OPENINGS IN WALLS NOT OTHERWISE COVERED SHALL BE ONE 6"x3-1/2"x3/8" ANGLE FOR EACH 4" WIDTH OF MASONRY. MAX SPAN = 6'-0". ALL EXTERIOR LINTELS TO BE GALVANIZED.

WOOD UPLIFT LOAD RESISTING SYSTEM

1. THESE NOTES ARE INTENDED TO SUPPLEMENT THE STRUCTURAL PLANS, DETAILS, AND WALL ELEVATIONS. WHERE CONFLICT EXISTS, PLANS, DETAILS, AND WALL ELEVATIONS SHALL GOVERN. CONNECTIONS BELOW ARE MINIMUM AND DO NOT RELIEVE ENGINEERED TRUSS ENGINEER FROM CONNECTION DESIGN.

2. ROOF TRUSSES, TRUSS GIRDERS, JOISTS, AND BEAMS TO WALL CONNECTIONS:
   A. TYPICAL TRUSSES AND JOISTS: (1) SIMPSON H2.5A AT EA. END
   B. 2 SPAN TRUSSES AND JOISTS: (1) SIMPSON H2.5A AT EA. END & (2) H2.5A AT INTERMEDIATE SUPPORTS (ONE EA. SIDE)
   C. GIRDER TRUSS, UNO: (2) SIMPSON H2.5A AT EA. END

3. TOP PLATES TO FLOOR STUDS: (1) SIMPSON H6 @ 48" O.C.

4. GROUND FLOOR STUDS TO MUD SILL PLATE: (2) SIMPSON H3 @ 48" O.C. FOR ROOF BEARING WALLS.

5. FASTEN ALL ROOF LOAD BEARING HEADERS UP TO 10'-0" SPAN W/ (1) CS20 STRAP TO JACK STUDS AT EA. END AND PROVIDE (1) CS20 FLOOR-TO-FLOOR STRAP AT KING STUDS BELOW.

6. WHERE WALL OPENIN IS GREATER THAN 5'-0" WIDE, PROVIDE (1) CS22 STRAP AT MID-SPAN OF OPENING HEADER. STRAP SHALL EXTEND TO BOTTOM OF HEADER ON EA. SIDE.

7. PROVIDE (1) CS22 STRAP @ 48" O.C. THROUGH ALL FLOOR CAVITIES AT ROOF BEARING WALLS.

SHOP DRAWING REVIEW CRITERIA

1. THE GENERAL CONTRACTOR WILL SUBMIT SHOP DRAWINGS FOR REVIEW BY ROSEMANN & ASSOCIATES, P.C. AS NOTED BELOW. THE CONTRACTOR WILL REVIEW ALL SHOP DRAWINGS PRIOR TO SUBMITTAL TO THE ENGINEER, AND ALL SHOP DRAWINGS SHALL BEAR THE GENERAL CONTRACTOR'S SHOP DRAWING STAMP. THE G.C.'S REVIEW SHALL DETERMINE THE CONFORMANCE WITH THE MEANS, METHODS, TECHNIQUES, SEQUENCES AND OPERATIONS OF CONSTRUCTION AND ALL SAFETY PRECAUTIONS; ALL OF WHICH ARE ITEMS THAT ARE THE SOLE RESPONSIBILITY OF THE GENERAL CONTRACTOR.

2. ALL SHOP DRAWINGS MUST BE ORIGINAL DOCUMENTS AND SHALL NOT BE REPRODUCTIONS OF THESE CONTRACT DOCUMENTS WITHOUT THE PRIOR, WRITTEN CONSENT OF ROSEMANN & ASSOCIATES, P.C.

3. ROSEMANN & ASSOCIATES, P.C. SHALL ASSUME THAT NO SUBMISSION COMPRISES A VARIATION UNLESS THE GC ADVISES ROSEMANN & ASSOCIATES, P.C. WITH WRITTEN DOCUMENTATION.

4. ICC REPORTS, MATERIAL SAFETY DATA SHEETS, AND NATIONAL ASSOCIATION OR ORGANIZATION GUIDELINES, SPECIFICATIONS, OR GENERAL PRODUCT INFORMATION DO NOT CONSITUTE SHOP DRAWINGS AND WILL NOT BE REVIEWED. SUBMITTALS SHALL CLEARLY INDICATE THE PRODUCT SELECTED AND ITS INTENDED PURPOSE, WHERE APPROPRIATE.

5. THE GENERAL CONTRACTOR SHALL SUBMIT THE FOLLOWING SHOP DRAWINGS AND RELATED MATERIALS (AS APPLICABLE):
   A. CONCRETE MIX DESIGNS AND MATERIAL CERTIFICATES
   B. REINFORCING STEEL SHOP DRAWINGS INCLUDING ERECTION DRAWINGS AND BENDING DETAILS. BAR LISTS AND QUANTITIES WILL NOT BE REVIEWED.
   C. WOOD TRUSS SHOP DRAWINGS INCLUDING ERECTION/PLACEMENT DRAWINGS AND INDIVIDUAL TRUSS DESIGNS AND CALCULATIONS, WHICH BEAR THE SEAL OF A PROFESSIONAL ENGINEER REGISTERED IN THE PROJECT STATE. TRUSSES ON PLACEMENT PLANS SHALL BE NUMBERED IN A LOGICAL, ORGANIZED ORDER. TRUSS CUT SHEETS SHALL BE PROVIDED IN A SIMILAR ORDER.
   D. MISCELLANEOUS ANCHORS SHOWN ON THE STRUCTURAL DRAWINGS
   E. STRUCTURAL STEEL SHOP DRAWINGS AND CONNECTION DESIGN
   F. ELEVATIONS OF ALL REINFORCED CMU WALLS SHOWING ALL REINFORCING
   G. CMU GROUT AND MORTAR MIX DESIGNS
   H. STANDARD DETAILS AND BRIDGING INFORMATION FOR LIGHT GAUGE METAL FRAMING; ERECTION PLANS AND DETAILS FOR LIGHT GAUGE METAL JOISTS AND LINTELS

6. THE FOLLOWING ITEMS ARE TO BE DEFERRED DESIGN SUBMITTALS:
   ENGINEERED WOOD TRUSSES, STEEL CONNECTION DESIGN AND DETAILING, ELEVATORS, RAILINGS

SPECIAL INSPECTION CRITERIA

1. THE STRUCTURAL DESIGN FOR THIS PROJECT IS BASED ON THE COMPLETION OF STRUCTURAL INSPECTIONS DURING CONSTRUCTION IN ACCORDANCE WITH CHAPTER 17 OF THE INTERNATIONAL BUILDING CODE. ONE OR MORE, QUALIFIED SPECIAL INSPECTORS SHALL BE EMPLOYED BY THE OWNER.

2. THE SPECIAL INSPECTOR(S) SHALL FURNISH INSPECTION REPORTS TO THE BUILDING OFFICIAL, OWNER, ARCHITECT, ENGINEER AND GENERAL CONTRACTOR.

3. ALL OBSERVED DISCREPANCIES SHALL BE BROUGHT TO THE IMMEDIATE ATTENTION OF THE CONTRACTOR FOR RESOLUTION. IF ANY DISCREPANCY IS NOT IMMEDIATELY RESOLVED BY THE CONTRACTOR, THE SPECIAL INSPECTOR SHALL IMMEDIATELY NOTIFY THE DESIGN AUTHORITY, BUILDING OFFICIAL, AND STRUCTURAL ENGINEER.

4. THE SPECIAL INSPECTOR(S) SHALL SUBMIT A FINAL SIGNED REPORT STATING THAT THE WORK REQUIRING SPECIAL INSPECTION WAS COMPLETED IN CONFORMANCE WITH THE APPROVED CONTRACT DOCUMENTS TO THE BEST OF THEIR KNOWLEDGE, AND IN CONFORMANCE WITH THE APPLICABLE BUILDING CODE.

5. THE FOLLOWING ITEMS WILL REQUIRE SPECIAL INSPECTION FOR THIS PROJECT (AS APPLICABLE):
   A. PLACEMENT OF CONCRETE
   B. BOLTS INSTALLED IN CONCRETE
   C. PLACEMENT OF REINFORCING STEEL
   D. TESTING OF CONCRETE
   E. VERIFICATION OF SOIL BEARING CAPACITIES
   F. STRUCTURAL STEEL ERECTION, BOLTING AND WELDING
   G. REBAR & GROUT PLACEMENT IN CMU
   H. METAL-PLATE CONNECTED WOOD TRUSS RESTRAINT/BRACING INSPECTION PER 2018 IBC 1705.5.2

1

COPYRIGHT & DISCLAIMER

I, SCOTT M. ROSEMANN, P.E. DO HEREBY ACCEPT PROFESSIONAL RESPONSIBILITY AS REQUIRED BY THE PROFESSIONAL REGISTRATION LAWS OF THIS STATE FOR THE STRUCTURAL DESIGN DRAWINGS CONSISTING OF THE S-SERIES DRAWINGS. I HEREBY DISCLAIM ANY RESPONSIBILITY FOR ALL OTHER PLANS, SPECIFICATIONS, REPORTS OR OTHER DOCUMENTS OR INSTRUMENTS RELATING TO OR INTENDED TO BE USED FOR ANY PART OR PARTS OF THE ARCHITECTURE OR OTHER ENGINEERING PROJECT OR SURVEY.

PRINTS ISSUED
10/30/23 - PERMIT SUBMITTAL

REVISIONS:
1 12/15/23 Addendum 1 – Response to City Comments

rosemann & ASSOCIATES P.C.
ARCHITECTURE
INTERIOR DESIGN
ENGINEERING
PLANNING
1526 Grand Boulevard
Kansas City, MO 64108-1404
p: 816.472.1448
w: www.rosemann.com
© 2020 Rosemann & Associates, P.C.
DENVER ▲ KANSAS CITY ▲ ST. LOUIS ▲ ATLANTA

STATE OF MISSOURI
SCOTT M. ROSEMANN
NUMBER PE-2008002204
PROFESSIONAL ENGINEER
03/05/24

WILSHIRE HILLS III
LEE'S SUMMIT, MISSOURI
MHDC - 22-057

SHEET TITLE
STRUCTURAL GENERAL NOTES

PROJECT NUMBER: 23034

SHEET NUMBER:

S-001

DRAWN BY: SAH CHECKED BY: MIH

12/12/2023 3:14:20 PM
C:\Revit Local Cache\2023\23034_Wilshire Hills III_STRUCTURAL_Central_R23_revit29BJL9J.rvt

IBC TABLE 2304.10.1
FASTENING SCHEDULE

CONNECTION	NUMBER AND TYPE OF FASTENER	SPACING AND LOCATION
ROOF		
1. BLOCKING BETWEEN CEILING JOISTS, RAFTERS, OR TRUSSES TO TOP PLATE OR OTHER FRAMING BELOW	3-8d COMMON (2 1/2"x0.131") 3-10d BOX (3"x0.128") 3-3" x 0.131" NAILS 3-3" 14 GAGE STAPLES, 7/16" CROWN	EACH END, TOENAIL
BLOCKING BETWEEN RAFTERS OR TRUSS NOT AT THE WALL TOP PLATE, TO RAFTER OR TRUSS	2-8d COMMON (2 1/2"x0.131") 2-3" x 0.131" NAILS 2-3" 14 GAGE STAPLES	EACH END, TOENAIL
	2-16d COMMON (3 1/2"x0.162") 3-3" x 0.131" NAILS 3-3" 14 GAGE STAPLES	END NAIL
FLAT BLOCKING TO TRUSS AND WEB FILLER	16d COMMON (3 1/2"x0.162") 3" x 0.131" NAILS 3" 14 GAGE STAPLES	FACE NAIL @ 6" O.C.
2. CEILING JOISTS TO TOP PLATE	3-8d COMMON (2 1/2"x0.131") 3-10d BOX (3"x0.128") 3-3" x 0.131" NAILS 3-3" 14 GAGE STAPLES, 7/16" CROWN	EACH JOIST, TOENAIL
3. CEILING JOIST NOT ATTACHED TO PARALLEL RAFTER, LAPS OVER PARTITIONS (NO THRUST); SEE SECTION 2308.7.3.1, TABLE 2308.7.3.1	3-16d COMMON (3 1/2"x0.162") 4-10d BOX (3"x0.128") 4-3" x 0.131" NAILS 4-3" 14 GAGE STAPLES, 7/16" CROWN	FACE NAIL
4. CEILING JOIST ATTACHED TO PARALLEL RAFTER (HEEL JOINT); SEE SECTION 2308.7.3.1, TABLE 2308.7.3.1)	PER TABLE 2308.7.3.1	FACE NAIL
5. COLLAR TIE TO RAFTER	3-10d COMMON (3"x0.148") 4-10d BOX (3"x0.128") 4-3" x 0.131" NAILS 4-3" 14 GAGE STAPLES, 7/16" CROWN	FACE NAIL
6. RAFTER OR ROOF TRUSS TO TOP PLATE (SEE SECTION 2308.7.5, TABLE 2308.7.5)	3-10d COMMON (3"x0.148") 3-16d BOX (3 1/2"x0.135") 4-10d BOX (3"x0.128") 4-3" x 0.131" NAILS 4-3" 14 GAGE STAPLES, 7/16" CROWN	TOENAIL[c]
7. ROOF RAFTERS TO RIDGE VALLEY OR HIP RAFTERS, OR ROOF RAFTERS TO 2" RIDGE BEAM	2-16d COMMON (3 1/2"x0.162") 3-10d BOX (3"x0.128") 3-3" x 0.131" NAILS 3-3" 14 GAGE STAPLES, 7/16" CROWN	END NAIL
	3-10d COMMON (3 1/2"x0.148") 4-16d BOX (3 1/2"x0.135") 4-10d BOX (3"x0.128") 4-3" x 0.131" NAILS 4-3" 14 GAGE STAPLES, 7/16" CROWN	TOENAIL
WALL		
8. STUD TO STUD (NOT AT BRACED WALL PANELS)	16d COMMON (3 1/2"x0.162")	FACE NAIL @ 24" O.C.
	10d BOX (3"x0.128") 3" x 0.131" NAILS 3" 14 GAGE STAPLES, 7/16" CROWN	FACE NAIL @ 16" O.C.
9. STUD TO STUD AND ABUTTING STUDS AT INTERSECTING WALL CORNERS (AT BRACED WALL PANELS)	16d COMMON (3 1/2"x0.162")	FACE NAIL @ 16" O.C.
	16d BOX (3 1/2"x0.135")	FACE NAIL @ 12" O.C.
	3"x0.131" NAILS 3" 14 GAGE STAPLES, 7/16" CROWN	FACE NAIL @ 12" O.C.
10. BUILT-UP HEADER (2" TO 2" HEADER)	16d COMMON (3 1/2"x0.162")	FACE NAIL @ 16" O.C. EA. EDGE
	16d BOX (3 1/2"x0.135")	FACE NAIL @ 12" O.C. EA. EDGE
11. CONTINUOUS HEADER TO STUD	4-8d COMMON (2 1/2"x0.131") 4-10d BOX (3"x0.128")	TOENAIL
12. TOP PLATE TO TOP PLATE	16d COMMON (3 1/2"x0.162")	FACE NAIL @ 16" O.C.
	10d BOX (3"x0.128") 3" x 0.131" NAILS 3" 14 GAGE STAPLES, 7/16" CROWN	FACE NAIL @ 12" O.C.
13. TOP PLATE TO TOP PLATE, AT END JOINTS	8-16d COMMON (3 1/2"x0.162") 12-10d BOX (3"x0.128") 12-3" x 0.131" NAILS 12-3" 14 GAGE STAPLES, 7/16" CROWN	EACH SIDE OF END JOINT, FACE NAIL (MIN. 24" LAP SPLICE LENGTH EACH SIDE OF END JOINT)
14. BOTTOM PLATE TO JOIST, RIM JOIST, BAND JOIST, OR BLOCKING (NOT AT BRACED WALL PANELS)	16d COMMON (3 1/2"x0.162")	FACE NAIL @ 16" O.C.
	16d BOX (3 1/2"x0.135") 3" x 0.131" NAILS 3" 14 GAGE STAPLES, 7/16" CROWN	FACE NAIL @ 12" O.C.
15. BOTTOM PLATE TO JOIST, RIM JOIST, BAND JOIST, OR BLOCKING AT BRACED WALL PANELS	2-16d COMMON (3 1/2"x0.162") 3-16d BOX (3 1/2"x0.135") 4-3" x 0.131" NAILS 4-3" 14 GAGE STAPLES, 7/16" CROWN	FACE NAIL @ 16" O.C.
16. STUD TO TOP OR BOTTOM PLATE	4-8d COMMON (2 1/2"x0.131") 4-10d BOX (3"x0.128") 4-3" x 0.131" NAILS 4-3" 14 GAGE STAPLES, 7/16" CROWN	TOENAIL
	2-16d COMMON (3 1/2"x0.162") 3-10d BOX (3"x0.128") 3-3" x 0.131" NAILS 3-3" 14 GAGE STAPLES, 7/16" CROWN	END NAIL
17. TOP PLATES, LAPS AT CORNERS AND INTERSECTIONS	2-16d COMMON (3 1/2"x0.162") 3-10d BOX (3"x0.128") 3-3" x 0.131" NAILS 3-3" 14 GAGE STAPLES, 7/16" CROWN	FACE NAIL
18. 1" BRACE TO EACH STUD AND PLATE	2-8d COMMON (2 1/2"x0.131") 2-10d BOX (3"x0.128") 2-3" x 0.131" NAILS 2-3" 14 GAGE STAPLES, 7/16" CROWN	FACE NAIL
19. 1" x 6" SHEATHING TO EACH BEARING	2-8d COMMON (2 1/2"x0.131") 2-10d BOX (3"x0.128")	FACE NAIL
20. 1" x 8" AND WIDER SHEATHING TO EACH BEARING	3-8d COMMON (2 1/2"x0.131") 3-10d BOX (3"x0.128")	FACE NAIL
(CONTINUED)		

IBC TABLE 2304.10.1
FASTENING SCHEDULE (CONT.)

CONNECTION	NUMBER AND TYPE OF FASTENER	SPACING AND LOCATION
FLOOR		
21. JOIST TO SILL, TOP PLATE, OR GIRDER	3-8d COMMON (2 1/2"x0.131") 3-10d BOX (3"x0.128") 3-3" x 0.131" NAILS 3-3" 14 GAGE STAPLES, 7/16" CROWN	TOENAIL
22. RIM JOIST, BAND JOIST, OR BLOCKING TO TOP PLATE, SILL, OR OTHER FRAMING BELOW	8d COMMON (2 1/2"x0.131") 10d BOX (3"x0.128") 3-3" x 0.131" NAILS 3-3" 14 GAGE STAPLES	TOENAIL @ 6" O.C.
23. 1" x 6" SUBFLOOR OR LESS TO EACH JOIST	2-8d COMMON (2 1/2"x0.131") 2-10d BOX (3"x0.128")	FACE NAIL
24. 2 SUBFLOOR TO JOIST OR GIRDER	2-16d COMMON (3 1/2"x0.162")	FACE NAIL
25. 2" PLANKS (PLANK & BEAM - FLOOR & ROOF)	2-16d COMMON (3 1/2"x0.162")	EACH BEARING, FACE NAIL
26. BUILT-UP GIRDERS AND BEAMS, 2" LUMBER LAYERS	20d COMMON (4"x0.192")	FACE NAIL AT T&B @ 32" O.C. STAGGERED ON OPP. SIDES
	10d BOX (3"x0.128") 3" x 0.131" NAILS 3" 14 GAGE STAPLES, 7/16" CROWN	FACE NAIL AT T&B @ 24" O.C. STAGGERED ON OPP. SIDES
	AND: 2-20d COMMON (4"x0.192") 3-10d BOX (3"x0.128") 3-3" x 0.131" NAILS 3-3" 14 GAGE STAPLES, 7/16" CROWN	FACE NAIL @ ENDS AND AT EACH SPLICE
27. LEDGER STRIP SUPPORTING JOISTS OR RAFTERS	3-16d COMMON (3 1/2"x0.162") 4-10d BOX (3"x0.128") 4-3" x 0.131" NAILS 4-3" 14 GAGE STAPLES, 7/16" CROWN	FACE NAIL EACH JOIST OR RAFTER
28. JOIST TO BAND JOIST OR RIM JOIST	3-16d COMMON (3 1/2"x0.162") 4-10d BOX (3"x0.128") 4-3" x 0.131" NAILS 4-3" 14 GAGE STAPLES, 7/16" CROWN	END NAIL
29. BRIDGING OR BLOCKING TO JOIST, RAFTER, OR TRUSS	2-8d COMMON (2 1/2"x0.131") 2-10d BOX (3"x0.128") 2-3" x 0.131" NAILS 2-3" 14 GAGE STAPLES, 7/16" CROWN	TOENAIL EACH END
WOOD STRUCTURAL PANELS, SUBFLOOR, ROOF, AND INTERIOR WALL SHEATHING TO FRAMING AND PARTICLEBOARD WALL SHEATHING TO FRAMING[a]		
		EDGES (INCHES) / INTERMEDIATE SUPPORTS (INCHES)
30. 3/8" - 1/2"	6d COMMON OR DEFORMED (2"x0.113") (SUBFLOOR AND WALL)	6 / 12
	8d COMMON OR DEFORMED (2 1/2"x0.131") (ROOF) OR RSRS-01 (2 3/8"x0.113") NAIL (ROOF)[d]	6 / 12
	2 3/8"x0.113" NAIL (SUBFLOOR AND WALL)	6 / 12
	1 3/4" 16 GAGE STAPLE, 7/16" CROWN (ROOF)	4 / 8
	2 3/8"x0.113" NAIL (ROOF)	4 / 8
	1 3/4" 16 GAGE STAPLE, 7/16" CROWN (ROOF)	3 / 6
31. 19/32" - 3/4"	4-8d COMMON (2 1/2"x0.131") 4-10d BOX (3"x0.128")	6 / 12
	16d COMMON (3 1/2"x0.162")	6 / 12
	10d BOX (3"x0.128") 3" x 0.131" NAILS 3" 14 GAGE STAPLES, 7/16" CROWN	4 / 8
32. 7/8" - 1 1/4"	8-16d COMMON (3 1/2"x0.162") 12-10d BOX (3"x0.128") 12-3" x 0.131" NAILS 12-3" 14 GAGE STAPLES, 7/16" CROWN	6 / 12
OTHER EXTERIOR WALL SHEATHING		
33. 1/2" FIBERBOARD SHEATHING[b]	1 1/2" GALVANIZED ROOFING NAIL (7/16" HEAD DIA.) 1 1/4" 16 GAGE STAPLE w/ 7/16" OR 1" CROWN	3 / 6
34. 25/32" FIBERBOARD SHEATHING[b]	1 3/4" GALVANIZED ROOFING NAIL (7/16" HEAD DIA.) 1 1/2" 16 GAGE STAPLE w/ 7/16" OR 1" CROWN	3 / 6
WOOD STRUCTURAL PANELS, COMBINATION SUBFLOOR UNDERLAYMENT TO FRAMING		
35. 3/4" AND LESS	8d COMMON (2 1/2"x0.131") 6d DEFORMED (2"x0.113")	6 / 12
36. 7/8" - 1"	8d COMMON (2 1/2"x0.131") 8d DEFORMED (2 1/2"x0.131")	6 / 12
37. 1 1/8" - 1 1/4"	10d COMMON (3"x0.148") 8d DEFORMED (2 1/2"x0.131")	6 / 12
PANEL SIDING TO FRAMING		
38. 1/2" OR LESS	6d CORROSION-RESISTANT SIDING (1 7/8"x0.106") 6d CORROSION-RESISTANT CASING (2"x0.099")	6 / 12
39. 5/8"	8d CORROSION-RESISTANT SIDING (2 3/8"x0.128") 8d CORROSION-RESISTANT CASING (2 1/2"x0.113")	6 / 12
WOOD STRUCTURAL PANELS, SUBFLOOR, ROOF, AND INTERIOR WALL SHEATHING TO FRAMING AND PARTICLEBOARD WALL SHEATHING TO FRAMING[a]		
40. 1/4"	4d CASING (1 1/2"x0.080") 4d FINISH (1 1/2"x0.072")	6 / 12
41. 3/8"	6d CASING (2"x0.099") 6d FINISH (PANEL SUPPORTS @ 24")	6 / 12

a. NAILS SPACED AT 6" AT INTERMEDIATE SUPPORTS WHERE SPANS ARE 48" OR MORE. FOR NAILING OF WOOD STRUCTURAL PANEL AND PARTICLEBOARD DIAPHRAGMS AND SHEAR WALLS, REFER TO SECTION 2305. NAILS FOR WALL SHEATHING ARE PERMITTED TO BE COMMON, BOX, OR CASING.
b. SPACING SHALL BE 6" ON CENTER ON THE EDGES AND 12" ON CENTER AT INTERMEDIATE SUPPORTS FOR NONSTRUCTURAL APPLICATIONS. PANEL SUPPORTS AT 16" (20" IF STRENGTH AXIS IN THE LONG DIRECTION OF THE PANEL, UNLESS OTHERWISE MARKED).
c. WHERE A RAFTER IS FASTENED TO AN ADJACENT PARALLEL CEILING JOIST IN ACCORDANCE WITH THIS SCHEDULE AND THE CEILING JOIST IS FASTENED TO THE TOP PLATE IN ACCORDANCE WITH THIS SCHEDULE, THE NUMBER OF TOENAILS IN THE RAFTER SHALL BE PERMITTED TO BE REDUCED BY ONE NAIL.
d. RSRS-01 IS A ROOF SHEATHING RING SHANK NAIL MEETING THE SPECIFICATIONS IN ASTM F1667.

ABBREVIATIONS

@	AT	LG	LONG
A.B.	ANCHOR BOLT(S)	LLH	LONG LEG HORIZONTAL
A.B.C.	AGGREGATE BASE COURSE	LLV	LONG LEG VERTICAL
ADD'L	ADDITIONAL	LO	LOW
ANCH.	ANCHOR	LOC.	LOCATION OR LOCATED
APPROX.	APPROXIMATE(LY)	LT OR LGT.	LIGHT
ARCH.	ARCHITECT OR ARCHITECTURAL	LW	LIGHT WEIGHT
	DOCUMENTS	MACH.	MACHINE
AVG.	AVERAGE	MSRY	MASONRY
BLDG	BUILDING	MATL	MATERIAL
BLK	BLOCK	MAX.	MAXIMUM
BM	BEAM	M.B.	MACHINE BOLT
B.O.D.	BOTTOM OF DECK	MECH.	MECHANICAL
BOT. OR B.	BOTTOM	MEMB.	MEMBRANE
BRG	BEARING	MEZZ.	MEZZANINE
BTWN OR B/W	BETWEEN	MFR.	MANUFACTURER
BW	BUTT WELD	MID.	MIDDLE
CANT.	CANTILEVER	MIN.	MINIMUM
C-C	CENTER TO CENTER	MISC.	MISCELLANEOUS
CEIL. OR CLG.	CEILING	MTL	METAL
C.I.P.	CAST IN PLACE	N.F.	NEAR FACE
CJ	CONTROL JOINT OR CONSTRUCTION JOINT	NO.	NUMBER
		N.S.	NEAR SIDE
CL OR CLR	CLEAR	N-S	NORTH-SOUTH
CMU	CONCRETE MASONRY UNIT	N.T.S.	NOT TO SCALE
CL	CENTER LINE	NW	NORMAL WEIGHT
CLR	CLEAR	O.C.	ON CENTER
COL	COLUMN	O.D.	OUTSIDE DIAMETER
CONC	CONCRETE	O.F.	OUTSIDE FACE
CONN.	CONNECTION	O.H.	OVERHANG
CONSTR.	CONSTRUCTION	OPNG	OPENING
CONT.	CONTINUE OR CONTINUOUS	OPP	OPPOSITE
CONTR.	CONTRACTOR	OPP HD	OPPOSITE HAND
COV.	COVER	PAR.	PARALLEL
CTR. OR CNTR	CENTER	P.C. OR P/C	PRECAST
CTR'D	CENTERED	PCF	POUNDS PER CUBIC FOOT
DBL.	DOUBLE	PEN	PENETRATION
DEPR	DEPRESSION	PL	PLATE
DET OR DTL	DETAIL	PERP.	PERPENDICULAR
DIA.	DIAMETER	P.L.	PROPERTY LINE
DIAG.	DIAGONAL	PLF	POUNDS PER LINEAL FOOT
DIM.	DIMENSION	PLY	PLYWOOD
DN	DOWN	PRELIM.	PRELIMINARY
DP	DEEP	PSI	POUNDS PER SQUARE INCH
DWG	DRAWING(S)	PT	PRESERVATIVE TREATED OR POST-TENSIONED
DWL	DOWEL		
EA.	EACH	R OR RAD.	RADIUS
E.F.	EACH FACE	RAP	RAMMED AGGREGATE PIER
EJ	EXPANSION JOINT	RE. OR REF.	REFERENCE
E OR ELEC.	ELECTRICAL	REINF.	REINFORCED OR REINFORCING
EL. OR ELEV.	ELEVATION	REQ'D	REQUIRED
EMBED.	EMBEDMENT OR EMBEDDED	SCHED.	SCHEDULE
ENGR	ENGINEER	SECT	SECTION
EOR	ENGINEER OF RECORD	SEOR	STRUCTURAL ENGINEER OF RECORD
EQ	EQUAL	SHTHG	SHEATHING
E.S.	EACH SIDE	SH OR SHT	SHEET
E.W.	EACH WAY	SIM.	SIMILAR
E-W	EAST-WEST	SLV	SLEEVE OR SHORT LEG VERTICAL
EXC	EXCAVATE	SLH	SHORT LEG HORIZONTAL
EXIST.	EXISTING	SOG	SLAB ON GRADE
EXP.	EXPANSION	SP OR SPCS	SPACE(S)
EXT.	EXTERIOR	SPCG	SPACING
FAB	FABRICATION	SPEC.	SPECIFICATION
FDN OR FNDN	FOUNDATION	SQ.	SQUARE
F.F.	FAR FACE OR FINISHED FLOOR	STD.	STANDARD
FIN.	FINISH	STIFF.	STIFFENER
FLG.	FLANGE	STL	STEEL
FLR.	FLOOR	STRUCT.	STRUCTURE OR STRUCTURAL
F.S.	FAR SIDE	FT.	FOOT OR FEET
FTG	FOOTING	SYM.	SYMMETRIC(AL)
GA.	GAGE OR GAUGE	T.	TOP
GALV.	GALVANIZED	T&B	TOP AND BOTTOM
GC OR GEN CONTR	GENERAL CONTRACTOR	T&G	TONGUE AND GROOVE
GLU-LAM	GLUE-LAMINATED	THK	THICK
GR OR GRD	GRADE	THK'ND	THICKENED
GWB	GYPSUM WALL BOARD	T.O.C.	TOP OF CONCRETE
GYP	GYPCRETE OR GYPSUM WALL BOARD	T.O.F.	TOP OF FOOTING
		TOPG	TOPPING
H.A.S.	HEADED ANCHOR STUD	T.O.S.	TOP OF STEEL OR TOP OF SLAB
HI	HIGH		
HORIZ. OR HOR.	HORIZONTAL	T.O.W.	TOP OF WALL
HT.	HEIGHT	TR	TRUSS
I.D.	INSIDE DIAMETER	TYP.	TYPICAL
I.F.	INSIDE FACE	U.N.O	UNLESS NOTED OTHERWISE
ILO	IN LIEU OF	VERT.	VERTICAL
IN.	INCH	W/	WITH
INCL	INCLUDE	W/O	WITHOUT
INFO	INFORMATION	WD	WOOD
INT.	INTERIOR	W.P.	WORKING POINT
JT.	JOINT	WT. OR WGT.	WEIGHT
K	KIP (1000 LBS)	WWF OR WWM	WELDED WIRE FABRIC
LB	POUND(S)	X-BRACE	CROSS BRACING

CONCRETE STRENGTH=4000 psi					CONCRETE STRENGTH=4500 psi					CONCRETE STRENGTH=5000 psi				
CASE / BAR SIZE	DEVELOPMENT LENGTH OR CLASS A LAP		CLASS B LAP		CASE / BAR SIZE	DEVELOPMENT LENGTH OR CLASS A LAP		CLASS B LAP		CASE / BAR SIZE	DEVELOPMENT LENGTH OR CLASS A LAP		CLASS B LAP	
	TOP BARS	OTHER BARS	TOP BARS	OTHER BARS		TOP BARS	OTHER BARS	TOP BARS	OTHER BARS		TOP BARS	OTHER BARS	TOP BARS	OTHER BARS
#3	19	15	24	19	#3	18	14	23	18	#3	17	13	22	17
#4	25	19	33	25	#4	24	18	31	24	#4	23	17	29	23
#5	31	24	41	31	#5	30	23	38	30	#5	28	22	36	28
#6	37	29	49	37	#6	35	27	46	35	#6	34	26	43	34
#7	54	42	71	54	#7	51	40	67	51	#7	49	38	63	49
#8	62	48	81	62	#8	59	45	76	59	#8	56	43	72	56
#9	70	54	91	70	#9	66	51	86	66	#9	63	48	81	63
#10	79	61	102	79	#10	74	57	96	74	#10	70	54	92	70
#11	87	67	113	87	#11	82	64	107	82	#11	78	60	102	78

NOTES:
1. UNLESS SPECIFICALLY INDICATED OTHERWISE ON THE CONTRACT DRAWINGS, USE THE MINIMUM LENGTH FOR A CLASS B LAP SPLICE OR THE MINIMUM DEVELOPMENT LENGTH INDICATED IN THE TABLES ABOVE MULTIPLIED BY THE APPLICABLE FACTOR(S) LISTED BELOW.
2. TOP BARS ARE HORIZONTAL BARS WITH MORE THAN 12 INCHES OF CONCRETE CAST BELOW THE BARS.
3. WHERE THE CLEAR SPACING BETWEEN BARS LAP SPLICED OR EMBEDDED AT ANY SECTION IS LESS THAN 2 BAR DIAMETERS, OR WHERE THE BAR COVER IS LESS THAN OR EQUAL TO THE BAR DIAMETER. INCREASE THE TABULATED BAR SPLICE OR DEVELOPMENT LENGTH BY 50%.
4. TABLE IS FOR 1 OR 2 BAR BUNDLES ONLY. FOR DEVELOPMENT LENGTHS AND TENSION LAP SPLICE LENGTHS OF BUNDLED BARS REFER TO ACI 318-14, 25.6 OR CONTACT THE STRUCTURAL ENGINEER.
5. MECHANICAL COUPLERS MAY BE SUBSTITUTED FOR TENSION LAP SPLICED BARS PROVIDED THAT THEY MEET THE REQUIREMENTS OF ACI 318-14, 25.5.7.

PRINTS ISSUED

10/30/23 - PERMIT SUBMITTAL

REVISIONS:

rosemann & ASSOCIATES P.C.
ARCHITECTURE
INTERIOR DESIGN
ENGINEERING
PLANNING
1526 Grand Boulevard
Kansas City, MO 64108-1404
p: 816.472.1448
w: www.rosemann.com
© 2020 Rosemann & Associates, P.C.
DENVER ▲ KANSAS CITY ▲ ST. LOUIS ▲ ATLANTA

STATE OF MISSOURI
SCOTT M. ROSEMANN
NUMBER PE-2009002204
PROFESSIONAL ENGINEER
10/30/23

WILSHIRE HILLS III
LEE'S SUMMIT, MISSOURI
MHDC - 22-057

SHEET TITLE
STRUCTURAL GENERAL NOTES

PROJECT NUMBER: 23034

SHEET NUMBER:

S-002

DRAWN BY: SAH CHECKED BY: MIH

10/31/2023 8:59:47 AM
C:\Revit Local Cache\23034_Wilshire Hills III_STRUCTURAL_Central_R23_revSMC6MAH.rvt

STATEMENT OF SPECIAL INSPECTIONS

This Statement of Special Inspections is submitted in accordance with the requirements of the 2018 International Building Code (IBC) Sections 1704 and 1705.

Special Inspections and Structural Observations applicable to this project:

• Special Inspections for Standard Buildings (per IBC 1704.2)	REQUIRED
• Special Inspections for Seismic Resistance (per IBC 1705.12)	NOT REQUIRED
• Special Inspections for Wind Resistance (per IBC 1705.11)	NOT REQUIRED
• Structural Observations for Seismic Resistance (per IBC 1704.6.2)	NOT REQUIRED
• Structural Observations for Wind Resistance (per IBC 1704.6.3)	NOT REQUIRED

This Statement of Special Inspections is intended to apply only to items within the scope of work of the Structural Engineer. See Statement of Special Inspections prepared by the design professional in responsible charge for additional special inspection requirements applicable to other disciplines.

The following Schedules of Special Inspections summarize the Special Inspections and Tests required. Special Inspectors shall refer to the approved plans and specifications for detailed special inspection requirements. Any additional tests and inspections required by the approved plans and specifications shall also be performed.

Special Inspections and Testing shall be performed in accordance with the approved plans and specifications, this statement and IBC Sections 1704 and 1705. The owner shall retain and directly pay for the special inspections and testing as required by IBC section 1704.2.

Interim Special Inspection Reports shall be submitted to the Building Official and the Registered Design Professional in Responsible Charge in accordance with IBC Section 1704.2.4. A Final Report of Special Inspections shall be submitted to the Building Official and the Registered Design Professional in Responsible Charge in accordance with IBC Section 1704.2.4.

This Statement of Special Inspections has been developed with the understanding that the Building Official will:
• Review and approve the qualifications of the Special Inspectors who will perform the inspections.
• Monitor special inspection activities on the job site to assure that the Special Inspectors are qualified and are performing their duties as called for in this Statement of Special Inspections.
• Review submitted inspection reports.
• Perform inspections as required by IBC Section 110 and the local building code.

Structural Observations, when required, will be performed by a registered professional engineer from **Rosemann & Associates, P.C.** or a specified delegate. At the conclusion of the work included in the permit, the structural observer shall submit to the Building Official a written statement that the site visits have been made and identify any reported deficiencies that, to the best of the structural observer's knowledge, have not been resolved.

Structural Observation does not include or waive the responsibility for the Special Inspections included in this Statement of Special Inspections or the inspections required by IBC Section 110.

STANDARD BUILDING SPECIAL INSPECTION REQUIREMENTS (per IBC Section 1704.2):
Provide inspections required in the Schedule of Special Inspections for Standard Buildings.

MATERIAL / ACTIVITY	SERVICE	Y/N	EXTENT
1704.2.5 INSPECTION OF FABRICATORS			
VERIFY FABRICATION/QUALITY CONTROL PROCEDURES	IN-PLANT REVIEW (3)	Y	PERIODIC
1705.1.1 SPECIAL CASES (WORK UNUSUAL IN NATURE, INCLUDING BUT NOT LIMITED TO ALTERNATIVE MATERIALS AND SYSTEMS, UNUSUAL DESIGN APPLICATIONS, MATERIALS AND SYSTEMS WITH SPECIAL MANUFACTURER'S REQUIREMENTS)	SUBMITTAL REVIEW, SHOP (3) AND/OR FIELD INSPECTION	Y	

MATERIAL / ACTIVITY	SERVICE	Y/N	EXTENT
1705.2 STEEL CONSTRUCTION			
1. FABRICATOR AND ERECTOR DOCUMENTS (VERIFY REPORTS AND CERTIFICATES AS LISTED IN AISC 360, CHAPTER N, PARAGRAPH 3.2 FOR COMPLIANCE WITH CONSTRUCTION DOCUMENTS)	SUBMITTAL REVIEW	Y	EACH SUBMITTAL
2. MATERIAL VERIFICATION OF STRUCTURAL STEEL	SHOP (3) AND FIELD INSPECTION	Y	PERIODIC
3. EMBEDMENTS (VERIFY DIAMETER, GRADE, TYPE, LENGTH, EMBEDMENT. SEE 1705.3 FOR ANCHORS)	FIELD INSPECTION	Y	PERIODIC
4. VERIFY MEMBER LOCATIONS, BRACES, STIFFENERS, AND APPLICATION OF JOINT DETAILS AT EACH CONNECTION COMPLY WITH CONSTRUCTION DOCUMENTS	FIELD INSPECTION	Y	PERIODIC
5. STRUCTURAL STEEL WELDING:			
A. INSPECTION TASKS PRIOR TO WELDING (OBSERVE, OR PERFORM FOR EACH WELDED JOINT OR MEMBER, THE QA TASKS LISTED IN AISC 360, TABLE N5.4-1)	SHOP (3) AND FIELD INSPECTION	Y	OBSERVE OR PERFORM AS NOTED (4)
B. INSPECTION TASKS DURING WELDING (OBSERVE, OR PERFORM FOR EACH WELDED JOINT OR MEMBER, THE QA TASKS LISTED IN AISC 360, TABLE N5.4-2)	SHOP (3) AND FIELD INSPECTION	Y	OBSERVE (4)
C. INSPECTION TASKS AFTER WELDING (OBSERVE, OR PERFORM FOR EACH WELDED JOINT OR MEMBER, THE QA TASKS LISTED IN AISC 360, TABLE N5.4-3)	SHOP (3) AND FIELD INSPECTION	Y	OBSERVE OR PERFORM AS NOTED (4)
D. NONDESTRUCTIVE TESTING (NDT) OF WELDED JOINTS: *SEE COMMENTARY*			
1) COMPLETE PENETRATION GROOVE WELDS 5/16" OR GREATER IN RISK CATEGORY III OR IV	SHOP (3) OR FIELD ULTRASONIC TESTING - 100%	Y	PERIODIC
2) COMPLETE PENETRATION GROOVE WELDS 5/16" OR GREATER IN *RISK CATEGORY II*	SHOP (3) OR FIELD ULTRASONIC TESTING - 10% OF WELDS MINIMUM	Y	PERIODIC
3) THERMALLY CUT SURFACES OF ACCESS HOLES WHEN MATERIAL T > 2"	SHOP (3) OR FIELD MAGNETIC PARTICAL OR PENETRANT TESTING	N	PERIODIC
4) WELDED JOINTS SUBJECT TO FATIGUE WHEN REQUIRED BY AISC 360, APPENDIX 3, TABLE A-3.1	SHOP (3) OR FIELD RADIOGRAPHIC OR ULTRASONIC TESTING	Y	PERIODIC
5) FABRICATOR'S NDT REPORTS WHEN FABRICATOR PERFORMS NDT	VERIFY REPORTS	Y	EACH SUBMITTAL (5)
6. STRUCTURAL STEEL BOLTING:	SHOP (3) AND FIELD INSPECTION		
A. INSPECTION TASKS PRIOR TO BOLTING (OBSERVE, OR PERFORM TASKS FOR EACH BOLTED CONNECTION, IN ACCORDANCE WITH QA TASKS LISTED IN AISC 360, TABLE N5.6-1)		Y	OBSERVE OR PERFORM AS NOTED (4)
B. INSPECTION TASKS DURING BOLTING (OBSERVE THE QA TASKS LISTED IN AISC 360, TABLE N5.6-2)		Y	OBSERVE (4)
1) PRE-TENSIONED AND SLIP-CRITICAL JOINTS		Y	
A) TURN-OF-NUT WITH MATCHING MARKINGS		N	PERIODIC
B) DIRECT TENSION INDICATOR		Y	PERIODIC
C) TWIST-OFF TYPE TENSION CONTROL BOLT		Y	PERIODIC
D) TURN-OF-NUT WITHOUT MATCHING MARKINGS		N	CONTINUOUS
E) CALIBRATED WRENCH		Y	CONTINUOUS
2) SNUG-TIGHT JOINTS		N	PERIODIC
C. INSPECTION TASKS AFTER BOLTING (PERFORM TASKS FOR EACH BOLTED CONNECTION IN ACCORDANCE WITH QA TASKS LISTED IN AISC 360, TABLE N5.6-3)			PERFORM (4)
7. INSPECTION OF STEEL ELEMENTS OF COMPOSITE CONSTRUCTION PRIOR TO CONCRETE PLACEMENT IN ACCORDANCE WITH QA TASKS LISTED IN AISC 360, TABLE N6.1	SHOP (3) AND FIELD INSPECTION AND TESTING	Y	OBSERVE OR PERFORM AS NOTED (4)

MATERIAL / ACTIVITY	SERVICE	Y/N	EXTENT
1705.2 STEEL CONSTRUCTION OTHER THAN STRUCTURAL STEEL			
1. MATERIAL VERIFICATION OF COLD-FORMED STEEL DECK:			
A. IDENTIFICATION MARKINGS	FIELD INSPECTION	N	PERIODIC
B. MANUFACTURER'S CERTIFIED TEST REPORTS	SUBMITTAL REVIEW	N	EACH SUBMITTAL
2. CONNECTION OF COLD-FORMED STEEL DECK TO SUPPORTING STRUCTURE:	SHOP (3) AND FIELD INSPECTION	N	
A. WELDING		N	PERIODIC
B. OTHER FASTENERS (IN ACCORDANCE WITH AISC 360,SECTION N6)		N	
1) VERIFY FASTENERS ARE IN CONFORMANCE WITH APPROVED SUBMITTAL		N	PERIODIC
2) VERIFY FASTENER INSTALLATION IS IN CONFORMANCE WITH APPROVED SUBMITTAL AND MANUFACTURER'S RECOMMENDATIONS		N	PERIODIC
3. REINFORCING STEEL	SHOP (3) AND FIELD INSPECTION		
A. VERIFICATION OF WELDABILITY OF STEEL OTHER THAN ASTM A706		N	PERIODIC
B. REINFORCING STEEL RESISTING FLEXURAL AND AXIAL FORCES IN INTERMEDIATE AND SPECIAL MOMENT FRAMES, BOUNDARY ELEMENTS OF SPECIAL CONCRETE STRUCTURAL WALLS AND SHEAR REINFORCEMENT		Y	CONTINUOUS
C. SHEAR REINFORCEMENT		Y	CONTINUOUS
D. OTHER REINFORCING STEEL		Y	PERIODIC
4. COLD-FORMED STEEL TRUSSES SPANNING 60 FEET OR GREATER			
A. VERIFY TEMPORARY AND PERMANENT RESTRAINT/BRACING ARE INSTALLED IN ACCORDANCE WITH THE APPROVED TRUSS SUBMITTAL PACKAGE	FIELD INSPECTION	N	PERIODIC

MATERIAL / ACTIVITY	SERVICE	Y/N	EXTENT
1705.3 INSPECTION OF CONCRETE CONSTRUCTION			
1. INSPECTION OF REINFORCING STEEL, INCLUDING PRESTRESSING TENDONS AND PLACEMENT	SHOP (3) AND FIELD INSPECTION	Y	PERIODIC
2. REINFORCING BAR WELDING:	FIELD INSPECTION	Y	
A. VERIFY WELDABILITY OF REINFORCING BARS OTHER THAN ASTM A706; B. INSPECT SINGLE-PASS FILLET WELDS, MAXIMUM 5/16"; C. INSPECT ALL OTHER WELDS			PERIODIC PERIODIC CONTINUOUS
3. INSPECTION OF ANCHORS CAST IN CONCRETE	FIELD INSPECTION	Y	PERIODIC
4. INSPECTION OF ANCHORS INSTALLED IN HARDENED CONCRETE	FIELD INSPECTION	Y	
A. ADHESIVE ANCHORS INSTALLED IN HORIZONTALLY OR UPWARDLY INCLINED ORIENTATIONS TO RESIST SUSTAINED TENSION LOADS B. MECHANICAL ANCHORS AND ADHESIVE ANCHORS NOT DEFINED IN 4A			PERIODIC OR AS REQUIRED BY MANUF.
5. VERIFYING USE OF REQUIRED DESIGN MIX	FIELD INSPECTION	Y	PERIODIC
6. AT THE TIME FRESH CONCRETE IS SAMPLED TO FABRICATE SPECIMENS FOR STRENGTH TESTS, PERFORM SLUMP & AIR CONTENT TESTS, AND DETERMINE THE TEMPERATURE OF THE CONCRETE	FIELD TESTING	Y	CONTINUOUS
7. INSPECTION OF CONCRETE AND SHOTCRETE PLACEMENT FOR PROPER APPLICATION TECHNIQUES	FIELD INSPECTION	Y	CONTINUOUS
8. INSPECTION FOR MAINTENANCE OF SPECIFIED CURING TEMPERATURE AND TECHNIQUES	FIELD INSPECTION	Y	PERIODIC
9. INSPECTION OF PRESTRESSED CONCRETE:	FIELD INSPECTION	Y	
A. APPLICATION OF PRESTRESSING FORCES B. GROUTING OF BONDED PRESTRESSING TENDONS IN THE SEISMIC-FORCE-RESISTING SYSTEM			CONTINUOUS CONTINUOUS
10. ERECTION OF PRECAST CONCRETE MEMBERS	FIELD INSPECTION	Y	
A. INSPECT IN ACCORDANCE WITH CONSTRUCTION DOCUMENTS B. PERFORM INSPECTIONS OF WELDING AND BOLTING IN ACCORDANCE WITH SECTION 1705.2			PERIODIC PER SECTION 1705.2
11. VERIFICATION OF IN-SITU CONCRETE STRENGTH, PRIOR TO STRESSING OF TENDONS IN POST-TENSIONED CONCRETE AND PRIOR TO REMOVAL OF SHORES AND FORMS FROM BEAMS AND STRUCTURAL SLABS.	FIELD INSPECTION AND TESTING	Y	PERIODIC
12. INSPECT FORMWORK FOR SHAPE, LOCATION, AND DIMENSIONS OF THE CONCRETE MEMBER BEING FORMED	FIELD INSPECTION	Y	PERIODIC
13. CONCRETE STRENGTH TESTING AND VERIFICATION OF COMPLIANCE WITH CONSTRUCTION DOCUMENTS	FIELD TESTING	Y	PERIODIC

NOTE: ADDITIONAL INSPECTION MAY BE REQUIRED FOR THE SEISMIC FORCE RESISTING SYSTEMS PER IBC 1707.

MATERIAL / ACTIVITY	SERVICE	Y/N	EXTENT
1705.4 INSPECTION OF MASONRY CONSTRUCTION			
LEVEL A QUALITY ASSURANCE			
1. COMPLIANCE WITH REQUIRED INSPECTION PROVISIONS OF THE CONSTRUCTION DOCUMENTS AND THE APPROVED SUBMITTALS SHALL BE VERIFIED	SUBMITTAL REVIEW AND FIELD INSPECTION	Y	PERIODIC
LEVEL B QUALITY ASSURANCE			
1. COMPLIANCE WITH REQUIRED INSPECTION PROVISIONS OF THE CONSTRUCTION DOCUMENTS AND THE APPROVED SUBMITTALS SHALL BE VERIFIED	SUBMITTAL REVIEW AND FIELD INSPECTION	Y	PERIODIC
2. VERIFICATION OF f'_m AND f'_{AAC} PRIOR TO CONSTRUCTION EXCEPT WHERE SPECIFICALLY EXEMPTED BY THIS CODE	SUBMITTAL REVIEW AND/OR SHOP (3)	Y	PERIODIC
3. VERIFICATION OF SLUMP FLOW & VSI AS DELIVERED TO THE SITE FOR SELF-CONSOLIDATING GROUT	FIELD INSPECTION AND TESTING	Y	CONTINUOUS
4. AS MASONRY CONSTRUCTION BEGINS, THE FOLLOWING SHALL BE VERIFIED TO ENSURE COMPLIANCE:	FIELD INSPECTION	Y	
A. PROPORTIONS OF SITE-PREPARED MORTAR			PERIODIC
B. CONSTRUCTION OF MORTAR JOINTS			PERIODIC
C. LOCATION OF REINFORCEMENT, CONNECTORS, PRESTRESSING TENDONS, AND ANCHORAGES			PERIODIC
D. PRESTRESSING TECHNIQUE			PERIODIC
E. GRADE & SIZE OF PRESTRESSING TENDONS AND ANCHORAGES			PERIODIC
F. PROPERTIES OF THIN-BED MORTAR FOR AAC MASONRY			CONTINUOUS FOR 1ST 5000 SQ. FT; THEN PERIODIC
5. PRIOR TO GROUTING, THE FOLLOWING SHALL BE VERIFIED TO ENSURE COMPLIANCE:	FIELD INSPECTION	Y	
A. GROUT SPACE IS CLEAN			PERIODIC
B. PLACEMENT OF REINFORCEMENT AND CONNECTORS, AND PRESTRESSING TENDONS AND ANCHORAGES			PERIODIC
C. PROPORTIONS OF SITE-PREPARED GROUT AND PRESTRESSING GROUT FOR BONDED TENDONS			PERIODIC
D. CONSTRUCTION OF MORTAR JOINTS			PERIODIC
E. GRADE, TYPE, AND SIZE OF REINFORCEMENT AND ANCHOR BOLTS, AND PRESTRESSING TENDONS AND ANCHORAGES			PERIODIC
6. DURING CONSTRUCTION, THE INSPECTION PROGRAM SHALL VERIFY:	FIELD INSPECTION	Y	
A. SIZE AND LOCATION OF STRUCTURAL ELEMENTS			PERIODIC
B. TYPE, SIZE, AND LOCATION OF ANCHORS, INCLUDING OTHER DETALS OF ANCHORAGE OF MASONRY TO STRUCTURAL MEMBERS, FRAMES OR OTHER CONSTRUCTION			PERIODIC
C. WELDING OF REINFORCING BARS			CONTINUOUS
D. PREPARATION, CONSTRUCTION, AND PROTECTION OF MASONRY DURING COLD WEATHER (TEMP BELOW 40 DEG. F) OR HOT WEATHER (TEMP ABOVE 90 DEG. F)			PERIODIC
E. APPLICATION AND MEASUREMENT OF PRESTRESSING FORCE			CONTINUOUS
F. PLACEMENT OF GROUT AND PRESTRESSING GROUT FOR BONDED TENDONS IS IN COMPLIANCE			CONTINUOUS
G. PLACEMENT OF AAC MASONRY UNITS AND CONSTRUCTION OF THIN-BED MORTAR JOINTS			CONTINUOUS FOR 1ST 5000 SQ. FT; THEN PERIODIC
7. PREPARATION OF ANY REQUIRED GROUT SPECIMENS, MORTAR SPECIMENS, AND/OR PRISMS SHALL BE OBSERVED	FIELD INSPECTION	Y	PERIODIC
LEVEL C QUALITY ASSURANCE			
1. COMPLIANCE WITH REQUIRED INSPECTION PROVISIONS OF THE CONSTRUCTION DOCUMENTS AND THE APPROVED SUBMITTALS SHALL BE VERIFIED	SUBMITTAL REVIEW AND FIELD INSPECTION	Y	PERIODIC
2. VERIFICATION OF f'_m AND f'_{AAC} PRIOR TO CONSTRUCTION EXCEPT WHERE SPECIFICALLY EXEMPTED BY THIS CODE	SUBMITTAL REVIEW AND/OR SHOP (3)	Y	PERIODIC
3. VERIFICATION OF SLUMP FLOW & VSI AS DELIVERED TO THE SITE FOR SELF-CONSOLIDATING GROUT	FIELD INSPECTION AND TESTING	Y	CONTINUOUS
4. VERIFICATION OF PROPORTIONS OF MATERIALS IN PREMIXED OR PREBLENDED MORTAR, PRESTRESSING GROUT, AND OTHER GROUT OTHER THAN SELF-CONSOLIDATING GROUND, AS DELIVERED TO SITE	FIELD INSPECTION AND TESTING	Y	CONTINUOUS
5. THE FOLLOWING SHALL BE VERIFIED TO ENSURE COMPLIANCE:	FIELD INSPECTION	Y	
A. PROPORTIONS OF SITE-PREPARED MORTAR, GROUT, AND PRESTRESSING GROUT FOR BONDED TENDONS			PERIODIC
B. GRADE, TYPE, AND SIZE OF REINFORCEMENT AND ANCHOR BOLTS, AND PRESTRESSING TENDONS AND ANCHORAGES			PERIODIC
C. PLACEMENT OF MASONRY UNITS AND CONSTRUCTION OF MORTAR JOINTS			PERIODIC
D. LOCATION OF REINFORCEMENT, CONNECTORS, PRESTRESSING TENDONS, AND ANCHORAGES			CONTINUOUS
E. GROUT SPACE PRIOR TO GROUTING			CONTINUOUS
F. PLACEMENT OF GROUT AND PRESTRESSING GROUT FOR BONDED TENDONS			CONTINUOUS
G. SIZE AND LOCATION OF STRUCTURAL ELEMENTS			PERIODIC
H. TYPE, SIZE, AND LOCATION OF ANCHORS, INCLUDING OTHER DETALS OF ANCHORAGE OF MASONRY TO STRUCTURAL MEMBERS, FRAMES OR OTHER CONSTRUCTION			CONTINUOUS
I. WELDING OF REINFORCING BARS			CONTINUOUS
J. PREPARATION, CONSTRUCTION, AND PROTECTION OF MASONRY DURING COLD WEATHER (TEMP BELOW 40 DEG. F) OR HOT WEATHER (TEMP ABOVE 90 DEG. F)			PERIODIC
K. APPLICATION AND MEASUREMENT OF PRESTRESSING FORCE			CONTINUOUS
L. PLACEMENT OF AAC MASONRY UNITS AND CONSTRUCTION OF THIN-BED MORTAR JOINTS			CONTINUOUS
M. PROPERTIES OF THIN-BED MORTAR FOR AAC MASONRY			CONTINUOUS
6. PREPARATION OF ANY REQUIRED GROUT SPECIMENS, MORTAR SPECIMENS, AND/OR PRISMS SHALL BE OBSERVED	FIELD INSPECTION	Y	CONTINUOUS

MATERIAL / ACTIVITY	SERVICE	Y/N	EXTENT
1705.6 INSPECTION OF SOILS			
1. VERIFY MATERIALS BELOW SHALLOW FOUNDATIONS ARE ADEQUATE TO ACHIEVE THE DESIGN BEARING CAPACITY	FIELD INSPECTION	Y	PERIODIC
2. VERIFY EXCAVATIONS ARE EXTENDED TO PROPER DEPTH AND HAVE REACHED PROPER MATERIAL	FIELD INSPECTION	Y	PERIODIC
3. PERFORM CLASSIFICATION AND TESTING OF COMPACTED FILL MATERIALS	FIELD INSPECTION	Y	PERIODIC
4. VERIFY USE OF PROPER MATERIALS, DENSITIES, AND LIFT THICKNESSES DURING PLACEMENT AND COMPACTION OF CONTROLLED FILL	FIELD INSPECTION	Y	CONTINUOUS
5. PRIOR TO PLACEMENT OF CONTROLLED FILL, OBSERVE SUBGRADE AND VERIFY THAT THE SITE HAS BEEN PREPARED PROPERLY	FIELD INSPECTION	Y	PERIODIC

MATERIAL / ACTIVITY	SERVICE	Y/N	EXTENT
1705.11 INSPECTION OF WOOD CONSTRUCTION			
1. VERIFY FABRICATION/QUALITY CONTROL AT FABRICATION PLANT FOR PREFABRICATED WOOD STRUCTURAL ELEMENTS AND ASSEMBLIES	SHOP (3) AND FIELD INSPECTION	Y	PERIODIC
2. FOR HIGH LOAD DIAPHRAGMS, VERIFICATION OF GRADE AND THICKNESS OF STRUCTURAL PANEL SHEATHING	SHOP (3) AND FIELD INSPECTION	Y	PERIODIC
3. FOR HIGH LOAD DIAPHRAGMS, VERIFICATION OF NOMINAL SIZE OF FRAMING MEMBERS AT ADJOINING PANEL EDGES NAIL OR STAPLE DIAMETER AND LENGTH, NUMBER OF FASTENER LINES, AND SPACING BETWEEN FASTENERS IN EACH LINE AND AT EDGE MARGINS AGREES WITH CONTRACT DOCUMENTS.	FIELD INSPECTION	Y	PERIODIC
4. INSPECTION OF FIELD GLUING OPERATIONS OF ELEMENTS OF THE LATERAL FORCE RESISTING SYSTEM	FIELD INSPECTION	Y	CONTINUOUS
5. INSPECTION OF NAILING, BOLTING, ANCHORING, AND OTHER FASTENING OF COMPONENTS WITHIN THE LATERAL FORCE RESISTING SYSTEM, INCLUDING WOOD SHEARWALLS, WOOD DIAPHRAGMS, DRAG STRUTS, BRACES, SHEAR PANELS, AND HOLDOWNS (WHERE FASTENER SPACING IS 4" ON CENTER OR LESS)	FIELD INSPECTION	Y	PERIODIC

NOTE: ADDITIONAL INSPECTION MAY BE REQUIRED FOR THE WIND/SEISMIC FORCE RESISTING SYSTEMS PER IBC 1706 & 1707.

MATERIAL / ACTIVITY	SERVICE	Y/N	EXTENT
1705.11.1 STRUCTURAL WOOD SPECIAL INSPECTIONS FOR WIND RESISTANCE			
1. INSPECTION OF FIELD GLUING OPERATIONS OF ELEMENTS OF THE MAIN WINDFORCE-RESISTING SYSTEM	FIELD INSPECTION	Y	CONTINUOUS
2. INSPECTION OF NAILING, BOLTING, ANCHORING AND OTHER FASTENING OF COMPONENTS WITHIN THE MAIN WINDFORCE-RESISTING SYSTEM	SHOP (3) AND FIELD INSPECTION	Y	PERIODIC
1705.11.2 COLD-FORMED STEEL SPECIAL INSPECTIONS FOR WIND RESISTANCE			
1. INSPECTION DURING WELDING OPERATIONS OF ELEMENTS OF THE MAIN WINDFORCE-RESISTING SYSTEM	SHOP (3) AND FIELD INSPECTION	N	PERIODIC
2.INSPECTIONS FOR SCREW ATTACHMENT, BOLTING, ANCHORING AND OTHER FASTENING OF COMPONENTS WITHIN THE MAIN WINDFORCE-RESISTING SYSTEM	SHOP (3) AND FIELD INSPECTION	N	PERIODIC
1705.11.3 WIND-RESISTING COMPONENTS			
1. ROOF CLADDING	SHOP (3) AND FIELD INSPECTION	Y	PERIODIC
2. WALL CLADDING	SHOP (3) AND FIELD INSPECTION	Y	PERIODIC

MATERIAL / ACTIVITY	SERVICE	Y/N	EXTENT
1705.14 SPRAYED FIRE RESISTANT MATERIALS			
1. VERIFY SURFACE CONDITION PREPARATION OF STRUCTURAL MEMBERS	FIELD INSPECTION	Y	PERIODIC
2. VERIFY APPLICATION OF SPRAYED FIRE-RESISTANT MATERIALS	FIELD INSPECTION	Y	PERIODIC
3. VERIFY AVERAGE THICKNESS OF SPRAYED FIRE-RESISTANT MATERIALS APPLIED TO STRUCTURAL MEMBERS	FIELD INSPECTION	Y	PERIODIC
4. VERIFY DENSITY OF THE SPRAYED FIRE-RESISTANT MATERIAL COMPLIES WITH APPROVED FIRE-RESISTANT DESIGN.	FIELD INSPECTION AND TESTING	Y	PER IBC SECTION 1705.13.5
5. VERIFY THE COHESIVE/ADHESIVE BOND STRENGTH OF THE CURED SPRAYED FIRE-RESISTANT MATERIAL	FIELD INSPECTION AND TESTING	Y	PER IBC SECTION 1705.13.6
1705.15 MASTIC AND INTUMESCENT FIRE-RESISTANT COATINGS			
INSPECT MASTIC AND INTUMESCENT FIRE-RESISTANT COATINGS APPLIED TO STRUCTURAL ELEMENTS AND DECKS	FIELD INSPECTION	Y	PERIODIC

MATERIAL / ACTIVITY	SERVICE	Y/N	EXTENT
1705.16 EXTERIOR INSULATION AND FINISH SYSTEMS (EIFS)			
1. VERIFY MATERIALS, DETAILS AND INSTALLATIONS ARE PER THE APPROVED CONSTRUCTION DOCUMENTS	FIELD INSPECTION	Y	PERIODIC
2. INSPECTION OF WATER-RESISTIVE BARRIER OVER SHEATHING SUBSTRATE	FIELD INSPECTION	Y	PERIODIC

MATERIAL / ACTIVITY	SERVICE	Y/N	EXTENT
1705.17 FIRE-RESISTANT PENETRATIONS AND JOINTS			
1. INSPECT PENETRATION FIRESTOP SYSTEMS	FIELD TESTING	Y	PER ASTM E2174
2. INSPECT FIRE-RESISTANT JOINT SYSTEMS	FIELD TESTING	Y	PER ASTM E2393

MATERIAL / ACTIVITY	SERVICE	Y/N	EXTENT
1705.18 SMOKE CONTROL SYSTEMS			
1. LEAKAGE TESTING AND RECORDING OF DEVICE LOCATIONS PRIOR TO CONCEALMENT	FIELD TESTING	Y	PERIODIC
2. PRIOR TO OCCUPANCY AND AFTER SUFFICIENT COMPLETION, PRESSURE DIFFERENCE TESTING, FLOW MEASUREMENTS, AND DETECTION AND CONTROL VERIFICATION	FIELD TESTING	Y	PERIODIC

(3) SPECIAL INSPECTIONS AS REQUIRED BY SECTION 1704.2.5 ARE NOT REQUIRED WHERE THE FABRICATOR IS APPROVED IN ACCORDANCE WITH IBC SECTION 1704.2.5.1

(4) OBSERVE ON A RANDOM BASIS; OPERATIONS NEED NOT BE DELAYED PENDING THESE INSPECTIONS. PERFORM THESE TASKS FOR EACH WELDED JOINT, BOLTED CONNECTION, OR STEEL ELEMENT.

(5) NDT OF WELDS COMPLETED IN AN APPROVED FABRICATOR'S SHOP MAY BE PERFORMED BY THAT FABRICATOR WHEN APPROVED BY THE AJH. REFER TO AISC 360, N7.

PRINTS ISSUED
10/30/23 - PERMIT SUBMITTAL

REVISIONS:

rosemann & ASSOCIATES P.C.
ARCHITECTURE
INTERIOR DESIGN
ENGINEERING
PLANNING
1526 Grand Boulevard
Kansas City, MO 64108-1404
p: 816.472.1448
w: www.rosemann.com
© 2020 Rosemann & Associates, P.C.
DENVER ◄ KANSAS CITY ► ST. LOUIS ▲ ATLANTA

STATE OF MISSOURI
SCOTT H. ROSEMANN
NUMBER PE-2008022204
PROFESSIONAL ENGINEER
10/30/23

WILSHIRE HILLS III
LEE'S SUMMIT, MISSOURI
MHDC - 22-057

SHEET TITLE
SPECIAL INSPECTIONS

PROJECT NUMBER: 23034

SHEET NUMBER:

S-003

DRAWN BY: SAH CHECKED BY: MIH

10/31/2023 8:08:42 AM
C:\Revit Local Data\R23\23034_Wilshire Hills III_STRUCTURAL_Central_R23_revitbMCBAM1.rvt

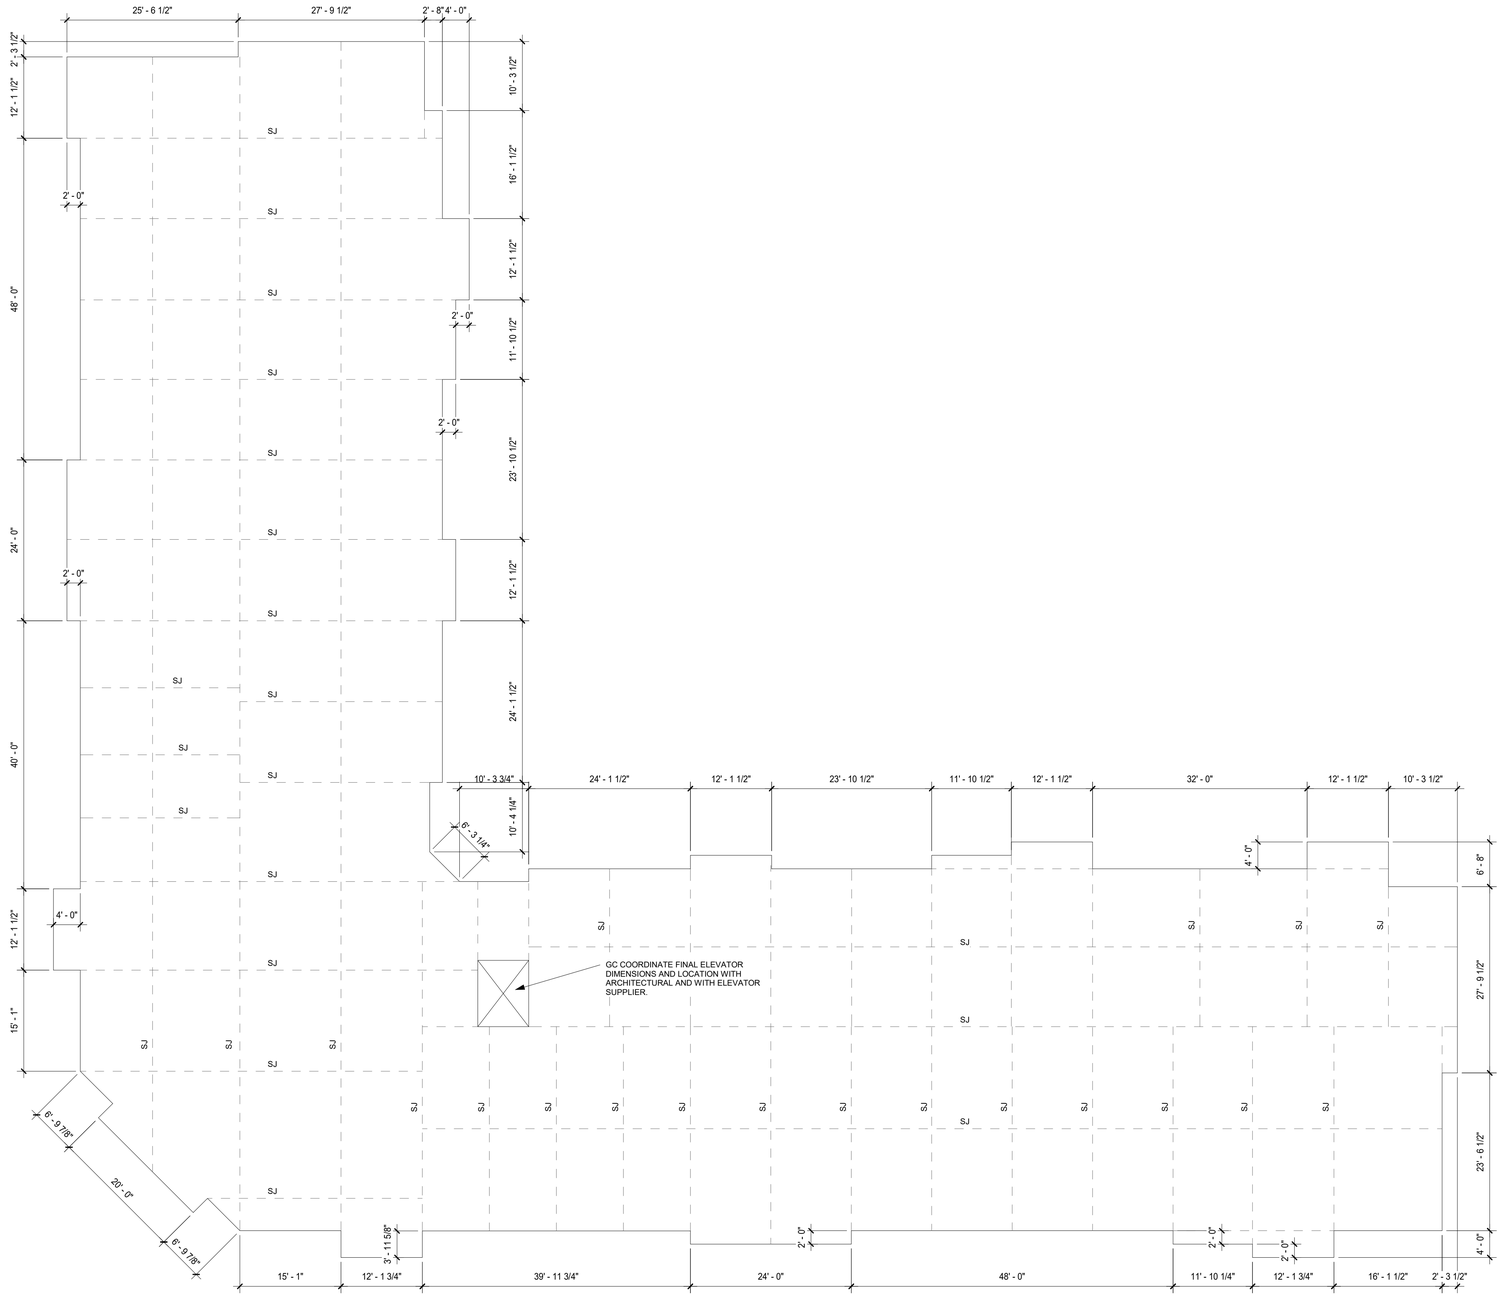

1 Slab Dimension Plan
3/32" = 1'-0"

PRINTS ISSUED
10/30/23 - PERMIT SUBMITTAL

REVISIONS:

rosemann & ASSOCIATES P.C.
ARCHITECTURE
INTERIOR DESIGN
ENGINEERING
PLANNING
1526 Grand Boulevard
Kansas City, MO 64108-1404
p: 816.472.1448
w: www.rosemann.com
© 2020 Rosemann & Associates, P.C.
DENVER ▲ KANSAS CITY ▲ ST. LOUIS ▲ ATLANTA

STATE OF MISSOURI
SCOTT M. ROSEMANN
NUMBER PE-2009002204
PROFESSIONAL ENGINEER
10/30/23

WILSHIRE HILLS III

LEE'S SUMMIT, MISSOURI

MHDC - 22-057

SHEET TITLE
SLAB DIMENSION PLAN

PROJECT NUMBER: 23034

SHEET NUMBER:

S-100

DRAWN BY: SAH CHECKED BY: MIH

10/31/2023 8:58:43 AM
C:\Revit Local\Local\20232034_Wilshire Hills III_STRUCTURAL_Central_R23_mmRHACBAM.rvt

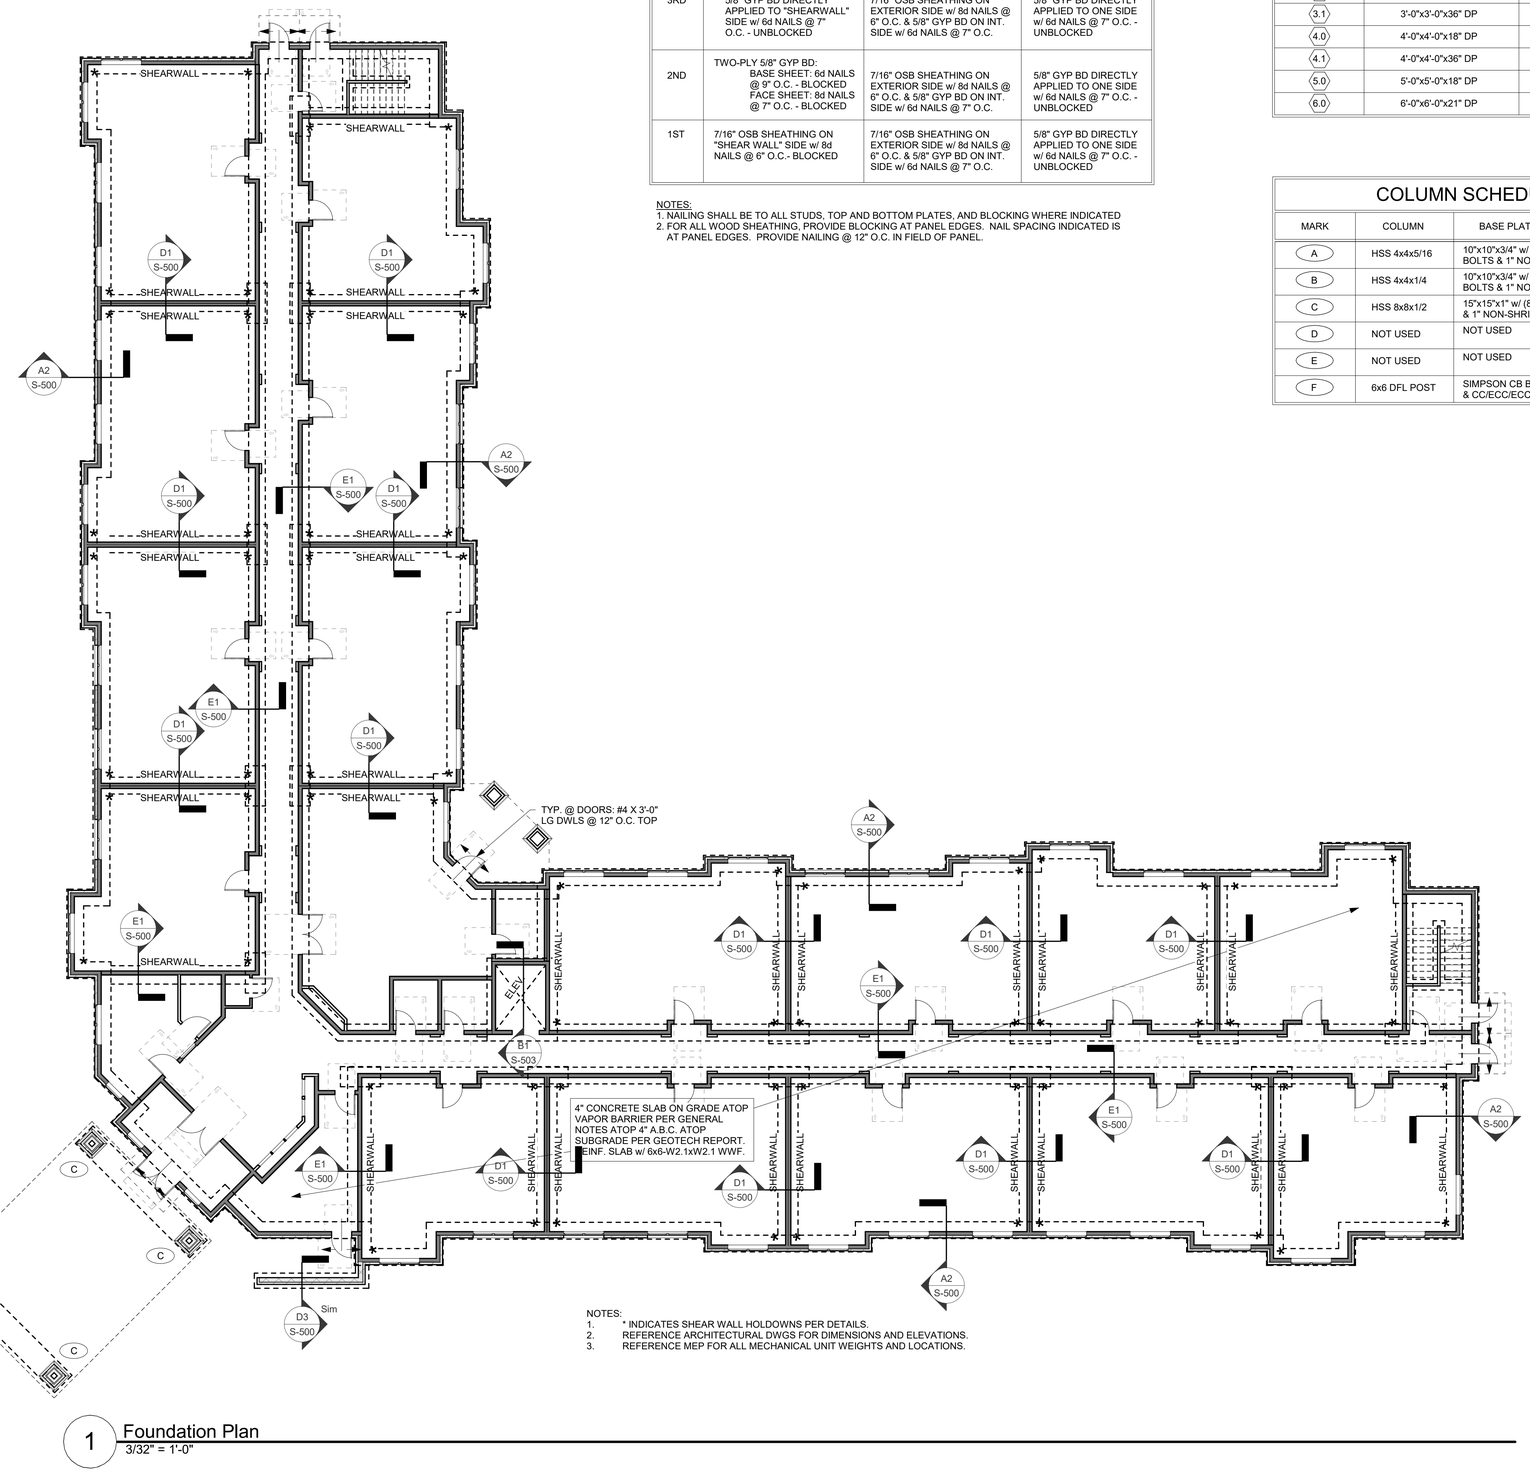

1 Foundation Plan
3/32" = 1'-0"

SHEATHING ATTACHMENT SCHEDULE

FLOOR	WALL TYPE		
	"SHEAR WALLS"	EXTERIOR	CORRIDOR
3RD	5/8" GYP BD DIRECTLY APPLIED TO "SHEARWALL" SIDE w/ 6d NAILS @ 7" O.C. - UNBLOCKED	7/16" OSB SHEATHING ON EXTERIOR SIDE w/ 8d NAILS @ 6" O.C. & 5/8" GYP BD ON INT. SIDE w/ 6d NAILS @ 7" O.C.	5/8" GYP BD DIRECTLY APPLIED TO ONE SIDE w/ 6d NAILS @ 7" O.C. - UNBLOCKED
2ND	TWO-PLY 5/8" GYP BD: BASE SHEET: 6d NAILS @ 9" O.C. - BLOCKED FACE SHEET: 8d NAILS @ 7" O.C. - BLOCKED	7/16" OSB SHEATHING ON EXTERIOR SIDE w/ 8d NAILS @ 6" O.C. & 5/8" GYP BD ON INT. SIDE w/ 6d NAILS @ 7" O.C.	5/8" GYP BD DIRECTLY APPLIED TO ONE SIDE w/ 6d NAILS @ 7" O.C. - UNBLOCKED
1ST	7/16" OSB SHEATHING ON "SHEAR WALL" SIDE w/ 8d NAILS @ 6" O.C.- BLOCKED	7/16" OSB SHEATHING ON EXTERIOR SIDE w/ 8d NAILS @ 6" O.C. & 5/8" GYP BD ON INT. SIDE w/ 6d NAILS @ 7" O.C.	5/8" GYP BD DIRECTLY APPLIED TO ONE SIDE w/ 6d NAILS @ 7" O.C. - UNBLOCKED

NOTES:
1. NAILING SHALL BE TO ALL STUDS, TOP AND BOTTOM PLATES, AND BLOCKING WHERE INDICATED
2. FOR ALL WOOD SHEATHING, PROVIDE BLOCKING AT PANEL EDGES. NAIL SPACING INDICATED IS AT PANEL EDGES. PROVIDE NAILING @ 12" O.C. IN FIELD OF PANEL.

FOOTING SCHEDULE

MARK	FOOTING SIZE	REINFORCING (TOP & BOTTOM)
3.0	3'-0"x3'-0"x18" DP	#6 @ 12" O.C.
3.1	3'-0"x3'-0"x36" DP	#6 @ 12" O.C.
4.0	4'-0"x4'-0"x18" DP	#6 @ 12" O.C.
4.1	4'-0"x4'-0"x36" DP	#6 @ 12" O.C.
5.0	5'-0"x5'-0"x18" DP	#6 @ 12" O.C.
6.0	6'-0"x6'-0"x21" DP	#6 @ 12" O.C.

COLUMN SCHEDULE

MARK	COLUMN	BASE PLATE & ANCHOR BOLTS
A	HSS 4x4x5/16	10"x10"x3/4" w/ (4)3/4" DIA. X 18" LG BOLTS & 1" NON-SHRINK GROUT
B	HSS 4x4x1/4	10"x10"x3/4" w/ (4)3/4" DIA. X 18" LG BOLTS & 1" NON-SHRINK GROUT
C	HSS 8x8x1/2	15"x15"x1" w/ (8)1" DIA. X 18" LG BOLTS & 1" NON-SHRINK GROUT
D	NOT USED	NOT USED
E	NOT USED	NOT USED
F	6x6 DFL POST	SIMPSON CB BASE (CAST IN FOOTING) & CC/ECC/ECCL CAP

NOTES:
1. * INDICATES SHEAR WALL HOLDOWNS PER DETAILS.
2. REFERENCE ARCHITECTURAL DWGS FOR DIMENSIONS AND ELEVATIONS.
3. REFERENCE MEP FOR ALL MECHANICAL UNIT WEIGHTS AND LOCATIONS.

PRINTS ISSUED
10/30/23 - PERMIT SUBMITTAL

REVISIONS:

rosemann & ASSOCIATES P.C.
ARCHITECTURE
INTERIOR DESIGN
ENGINEERING
PLANNING
1526 Grand Boulevard
Kansas City, MO 64108-1404
p: 816.472.1448
w: www.rosemann.com
© 2020 Rosemann & Associates, P.C.
DENVER ▲ KANSAS CITY ▲ ST. LOUIS ▲ ATLANTA

STATE OF MISSOURI
SCOTT M. ROSEMANN
NUMBER PE-2009002204
PROFESSIONAL ENGINEER
10/30/23

WILSHIRE HILLS III
LEE'S SUMMIT, MISSOURI
MHDC - 22-057

SHEET TITLE
FOUNDATION PLAN

PROJECT NUMBER: 23034

SHEET NUMBER:

S-101

DRAWN BY: SAH CHECKED BY: MIH

10/31/2023 8:33:45 AM
C:\Revit Local Files\RVT23\23034_Wilshire Hills III_STRUCTURAL_Central_R23_mrn5MACBAW.rvt

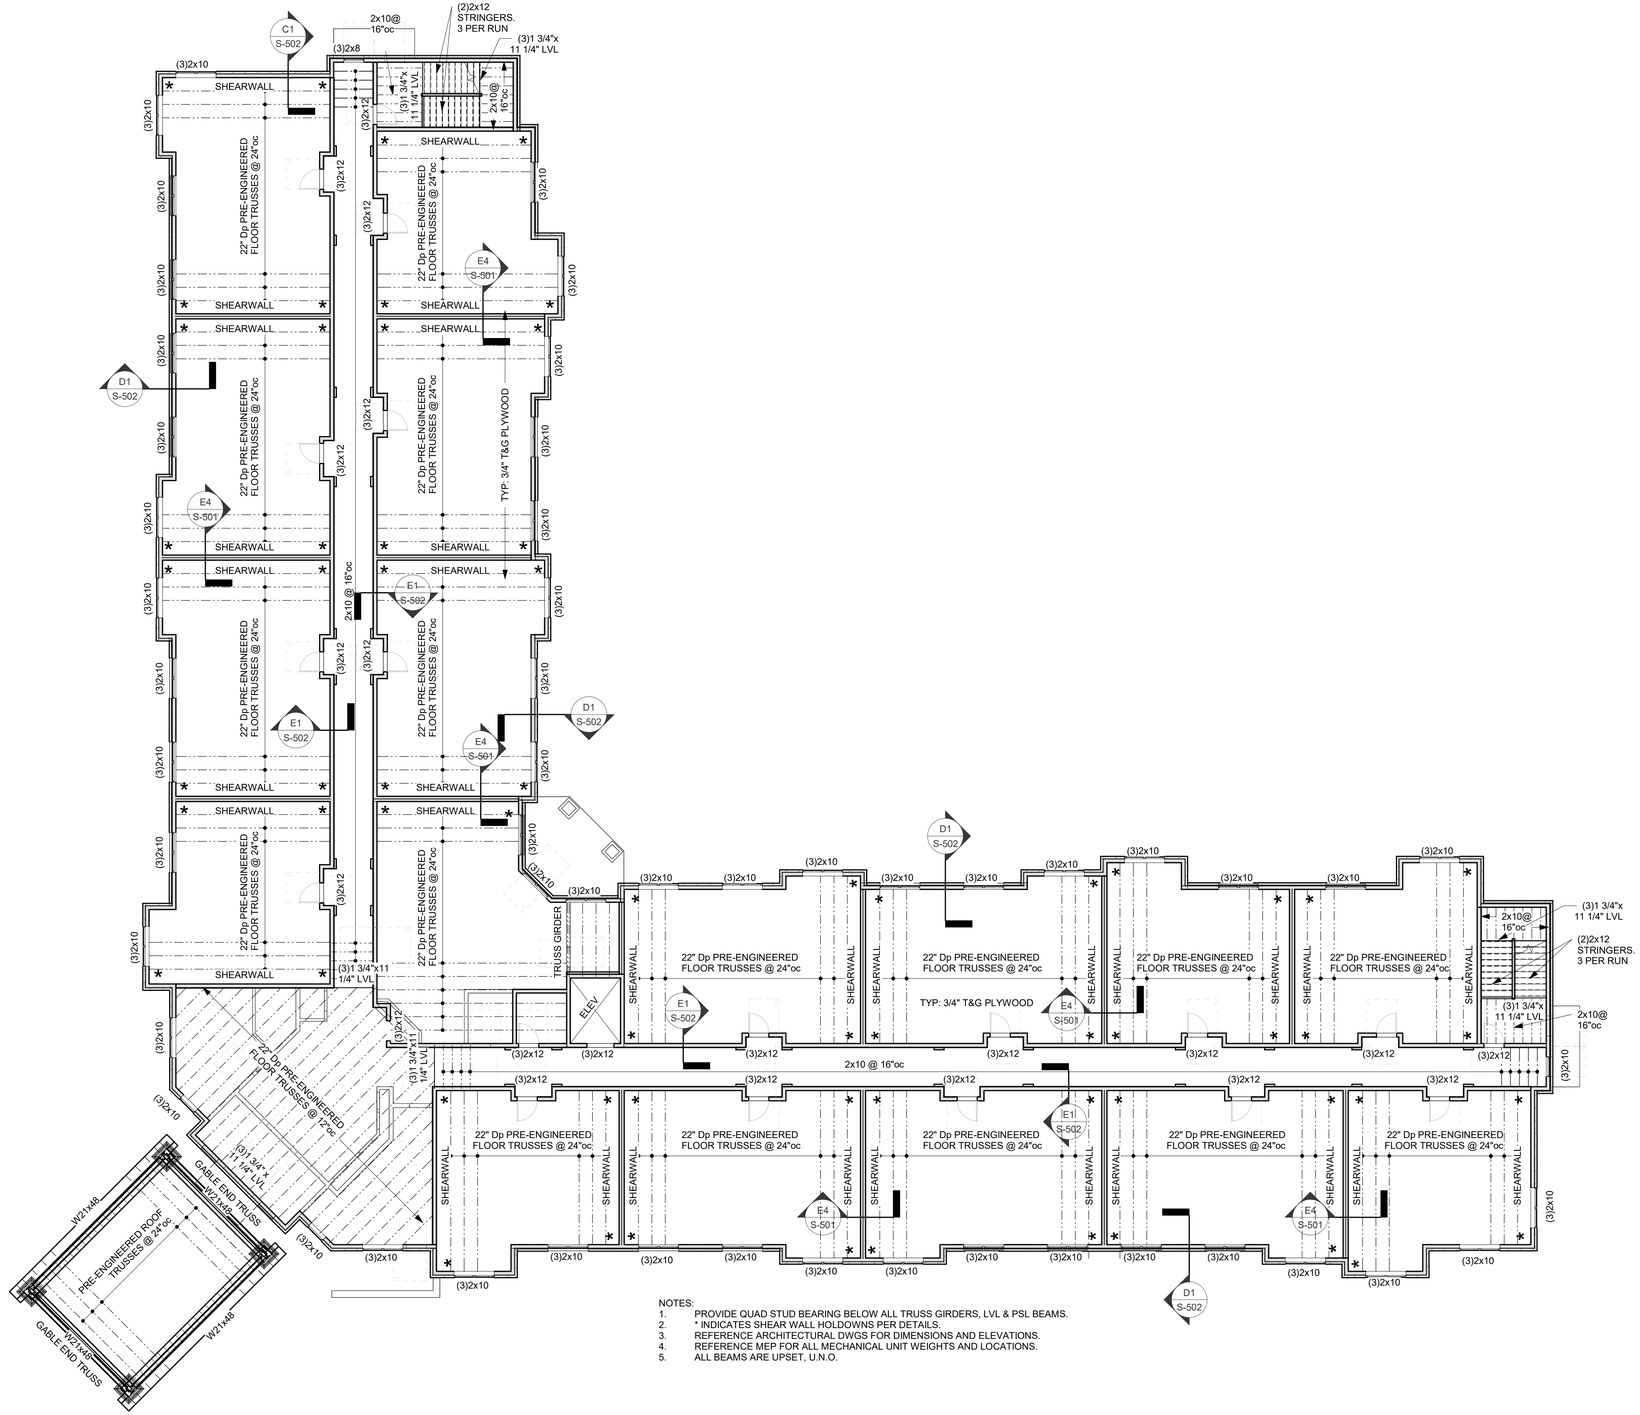

NOTES:
1. PROVIDE QUAD STUD BEARING BELOW ALL TRUSS GIRDERS, LVL & PSL BEAMS.
2. * INDICATES SHEAR WALL HOLDOWNS PER DETAILS.
3. REFERENCE ARCHITECTURAL DWGS FOR DIMENSIONS AND ELEVATIONS.
4. REFERENCE MEP FOR ALL MECHANICAL UNIT WEIGHTS AND LOCATIONS.
5. ALL BEAMS ARE UPSET, U.N.O.

1 2nd Floor Framing Plan
3/32" = 1'-0"

PRINTS ISSUED
10/30/23 - PERMIT SUBMITTAL

REVISIONS:

rosemann & ASSOCIATES P.C.
ARCHITECTURE
INTERIOR DESIGN
ENGINEERING
PLANNING
1526 Grand Boulevard
Kansas City, MO 64108-1404
p: 816.472.1448
w: www.rosemann.com
© 2020 Rosemann & Associates, P.C.
DENVER ▲ KANSAS CITY ▲ ST. LOUIS ▲ ATLANTA

STATE OF MISSOURI
SCOTT
M. ROSEMANN
NUMBER
PE-2009002204
PROFESSIONAL ENGINEER
10/30/23

WILSHIRE HILLS III

LEE'S SUMMIT, MISSOURI

MHDC - 22-057

SHEET TITLE
2ND FLOOR FRAMING PLAN

PROJECT NUMBER: 23034

SHEET NUMBER:

S-102

DRAWN BY: SAH CHECKED BY: MIH

10/31/2023 6:08:48 AM
C:\Revit Local Cache\R2023\2034_Wilshire Hills III_STRUCTURAL_Central_R23_revitMACBAM.rvt

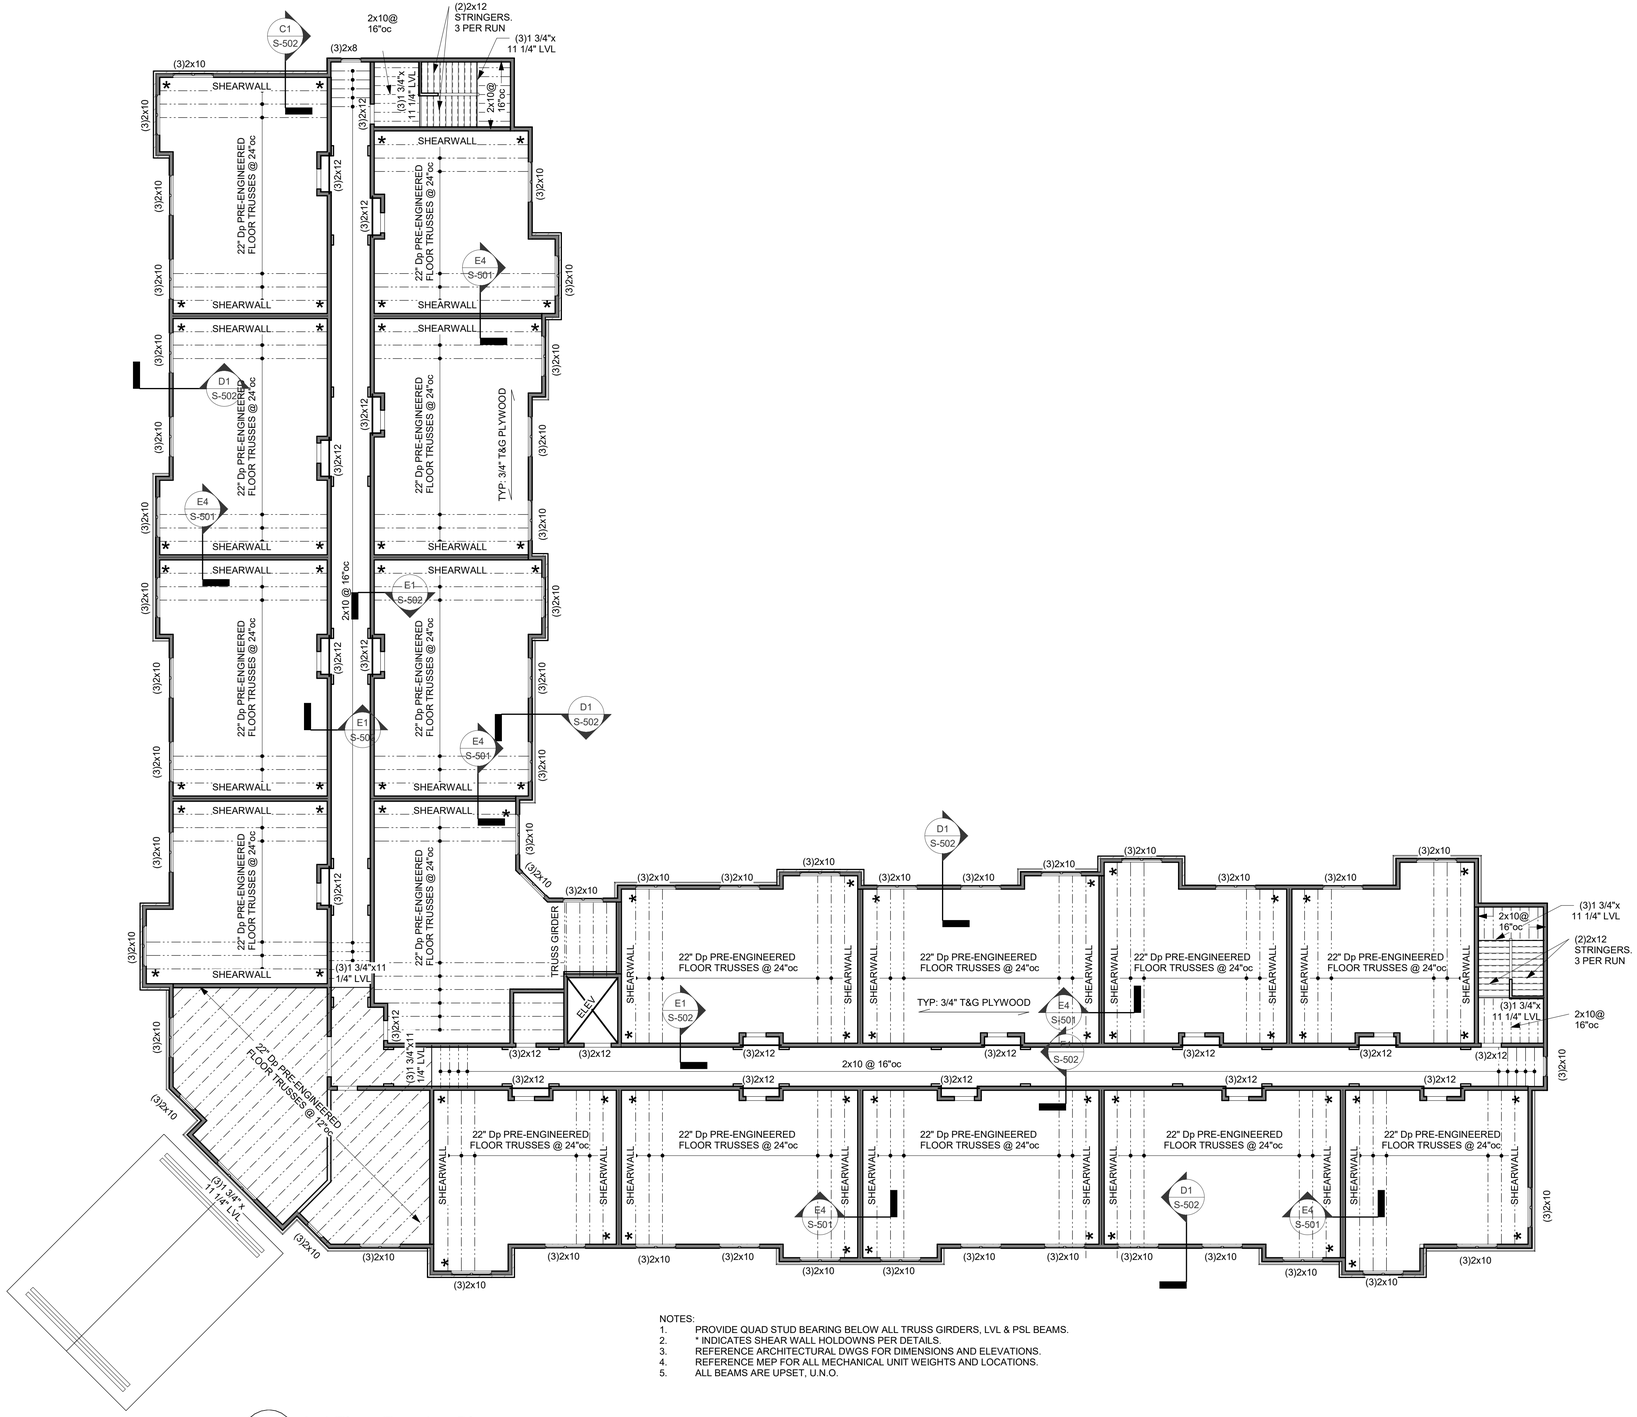

NOTES:
1. PROVIDE QUAD STUD BEARING BELOW ALL TRUSS GIRDERS, LVL & PSL BEAMS.
2. * INDICATES SHEAR WALL HOLDOWNS PER DETAILS.
3. REFERENCE ARCHITECTURAL DWGS FOR DIMENSIONS AND ELEVATIONS.
4. REFERENCE MEP FOR ALL MECHANICAL UNIT WEIGHTS AND LOCATIONS.
5. ALL BEAMS ARE UPSET, U.N.O.

1 3rd Floor Framing Plan
3/32" = 1'-0"

10/31/2023 8:59:50 AM
C:\Revit Local Cache\23034_Wilshire Hills III_STRUCTURAL_Central_R23_mn5bkGBAWr.rvt

PRINTS ISSUED
10/30/23 - PERMIT SUBMITTAL

REVISIONS:

rosemann & ASSOCIATES P.C.
ARCHITECTURE
INTERIOR DESIGN
ENGINEERING
PLANNING
1526 Grand Boulevard
Kansas City, MO 64108-1404
p: 816.472.1448
w: www.rosemann.com
© 2020 Rosemann & Associates, P.C.
DENVER ▲ KANSAS CITY ▲ ST. LOUIS ▲ ATLANTA

STATE OF MISSOURI
SCOTT
M. ROSEMANN
NUMBER
PE-2009002204
PROFESSIONAL ENGINEER
10/30/23

WILSHIRE HILLS III
LEE'S SUMMIT, MISSOURI
MHDC - 22-057

SHEET TITLE
3RD FLOOR FRAMING PLANS

PROJECT NUMBER: 23034

SHEET NUMBER:

S-103

DRAWN BY: SAH CHECKED BY: MIH

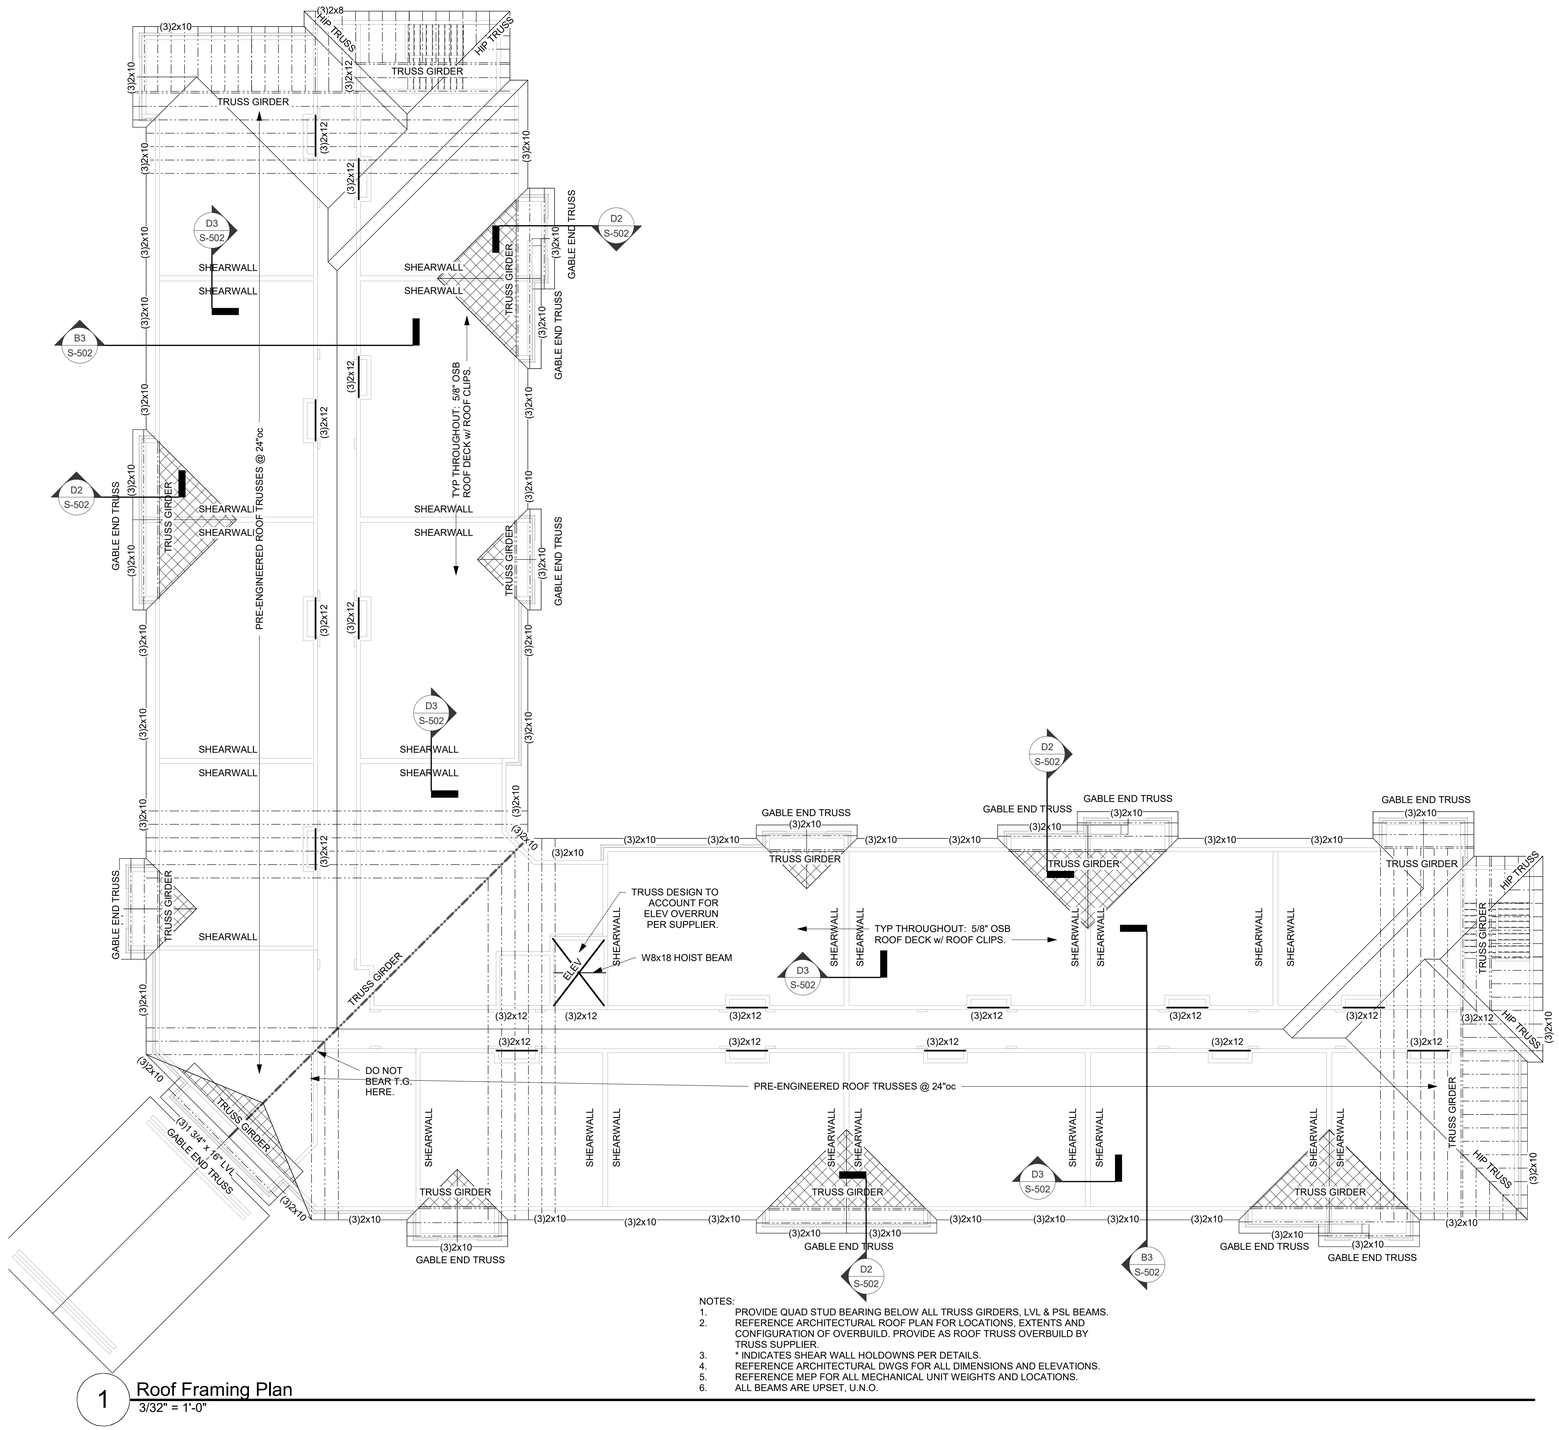

1 Roof Framing Plan
3/32" = 1'-0"

NOTES:
1. PROVIDE QUAD STUD BEARING BELOW ALL TRUSS GIRDERS, LVL & PSL BEAMS.
2. REFERENCE ARCHITECTURAL ROOF PLAN FOR LOCATIONS, EXTENTS AND CONFIGURATION OF OVERBUILD. PROVIDE AS ROOF TRUSS OVERBUILD BY TRUSS SUPPLIER.
3. * INDICATES SHEAR WALL HOLDOWNS PER DETAILS.
4. REFERENCE ARCHITECTURAL DWGS FOR ALL DIMENSIONS AND ELEVATIONS.
5. REFERENCE MEP FOR ALL MECHANICAL UNIT WEIGHTS AND LOCATIONS.
6. ALL BEAMS ARE UPSET, U.N.O.

PRINTS ISSUED
10/30/23 - PERMIT SUBMITTAL

REVISIONS:

rosemann & ASSOCIATES P.C.
ARCHITECTURE
INTERIOR DESIGN
ENGINEERING
PLANNING
1526 Grand Boulevard
Kansas City, MO 64108-1404
p: 816.472.1448
w: www.rosemann.com
© 2020 Rosemann & Associates, P.C.
DENVER ▲ KANSAS CITY ▲ ST. LOUIS ▲ ATLANTA

STATE OF MISSOURI
SCOTT M. ROSEMANN
NUMBER PE-2009002204
PROFESSIONAL ENGINEER
10/30/23

WILSHIRE HILLS III

LEE'S SUMMIT, MISSOURI

MHDC - 22-057

SHEET TITLE
ROOF FRAMING PLAN

PROJECT NUMBER: 23034

SHEET NUMBER:

S-104

DRAWN BY: SAH CHECKED BY: MIH

10/31/2023 8:25:52 AM
C:\Revit Local Cache\23034_Wilshire Hills III_STRUCTURAL_Central_R23_revitMACBAIH.rvt

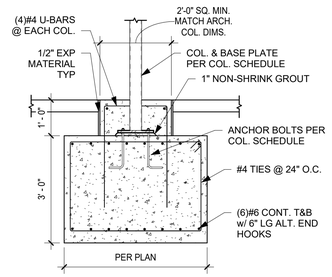

E3 CANOPY FOOTING
1/2" = 1'-0"

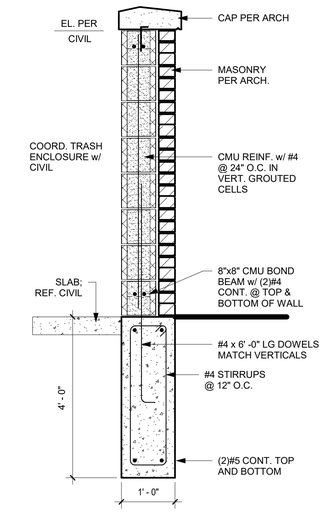

D3 TRASH ENCLOSURE WALL SECTION2
3/4" = 1'-0"

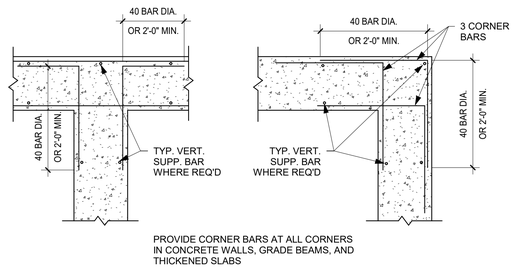

C3 TYP. CORNER BARS2
3/4" = 1'-0"

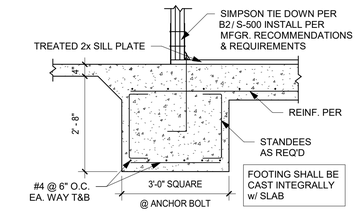

B3 SHEAR WALL FOUNDATION DETAIL1
1/2" = 1'-0"

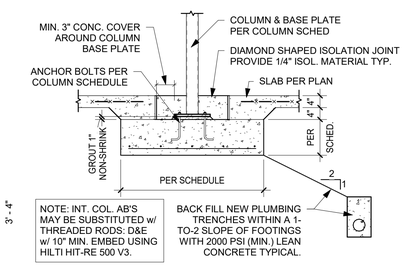

A3 TYP. COLUMN FOOTING1
1/2" = 1'-0"

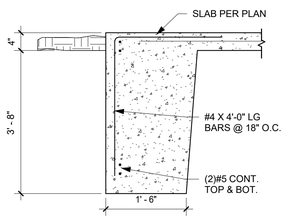

E2 SLAB TURNDOWN
3/4" = 1'-0"

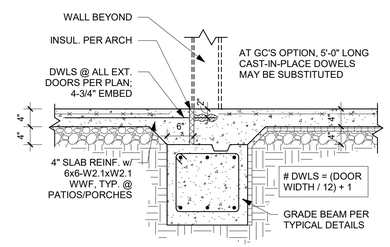

D2 TYP. FNDN @ EXTERIOR DOOR
3/4" = 1'-0"

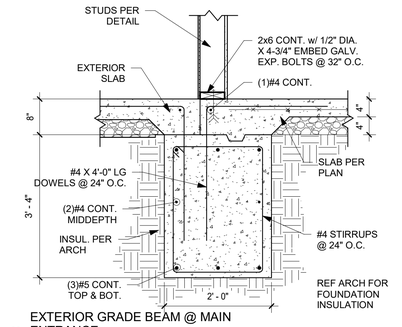

EXTERIOR GRADE BEAM @ MAIN ENTRANCE
C2 3/4" = 1'-0"

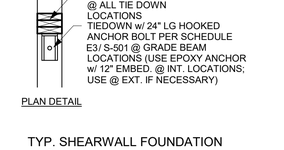

TYP. SHEARWALL FOUNDATION ANCHOR1
B2 3/4" = 1'-0"

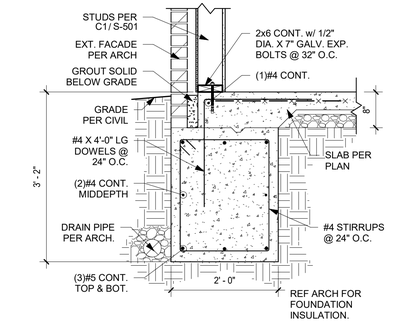

A2 EXTERIOR GRADE BEAM
3/4" = 1'-0"

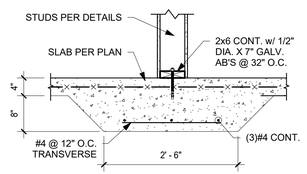

E1 THICKENED SLAB AT CORRIDOR1
3/4" = 1'-0"

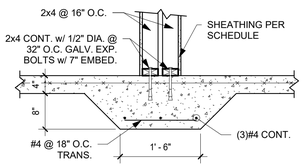

D1 THICKENED SLAB AT SHEARWALL
3/4" = 1'-0"

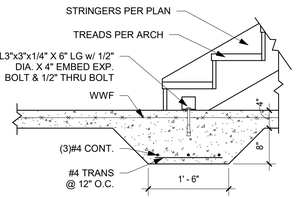

C1 THICKENED SLAB AT STAIR2
3/4" = 1'-0"

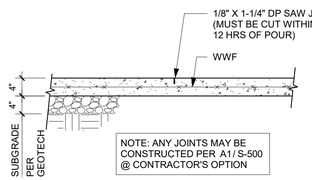

B1 TYP. SAW JOINT2
3/4" = 1'-0"

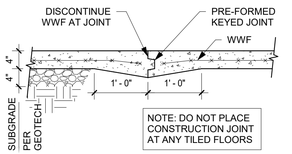

A1 TYP. CONSTRUCTION JOINT2
3/4" = 1'-0"

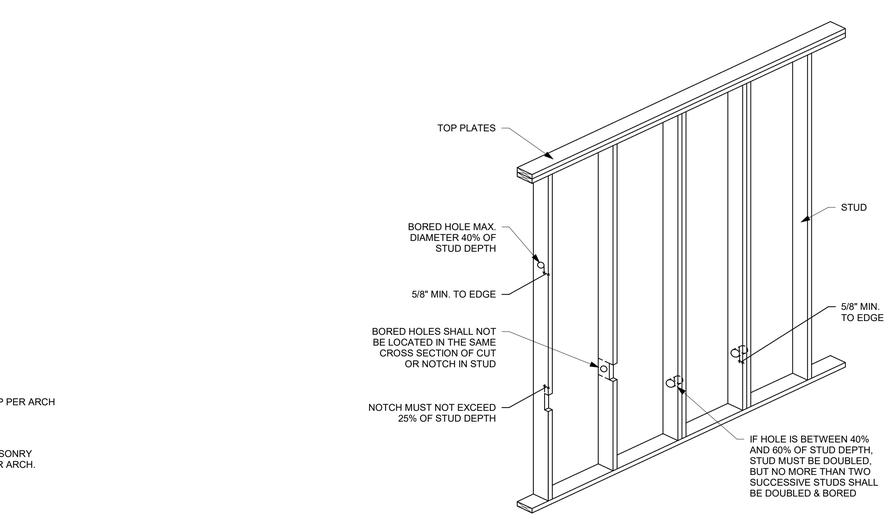

B4 STUDS - BORED OR NOTCHED1
N.T.S.

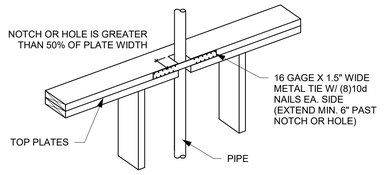

EXTERIOR, BEARING, OR SHEAR WALL

A5 PLATE PENETRATION1
N.T.S.

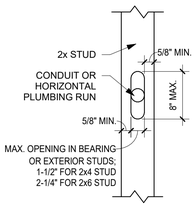

FLOOR	ANTICIPATED CUMULATIVE SHRINKAGE
5TH	1/4"
4TH	1/2"
3RD	3/4"
2ND	1"
1ST	1-1/4"

GAP REQUIRED ABOVE & BELOW

A4 STUD PENETRATION - SHRINKAGE1
N.T.S.

PRINTS ISSUED
10/30/23 - PERMIT SUBMITTAL

REVISIONS:

rosemann & ASSOCIATES P.C.
ARCHITECTURE
INTERIOR DESIGN
ENGINEERING
PLANNING
1526 Grand Boulevard
Kansas City, MO 64108-1404
p: 816.472.1448
w: www.rosemann.com
© 2020 Rosemann & Associates, P.C.
DENVER ▲ KANSAS CITY ▲ ST. LOUIS ▲ ATLANTA

STATE OF MISSOURI
SCOTT M. ROSEMANN
NUMBER PE-2009002204
PROFESSIONAL ENGINEER
10/30/23

WILSHIRE HILLS III
LEE'S SUMMIT, MISSOURI
MHDC - 22-057

SHEET TITLE
STRUCTURAL DETAILS

PROJECT NUMBER: 23034

SHEET NUMBER:

S-500

DRAWN BY: SAH CHECKED BY: MH

10/31/2023 8:03:54 AM
C:\Revit Local Cache\23034_Wilshire Hills III_STRUCTURAL_Central_R23_mrl9MGBAM.rvt

KING STUD SCHEDULE

LOCATION / LEVEL	UP TO 4'-0" OPENING		UP TO 8'-0" OPENING		UP TO 10'-0" OPENING	
	INTERIOR	EXTERIOR	INTERIOR	EXTERIOR	INTERIOR	EXTERIOR
ALL FLOORS	(1) 2x KING	(1) 2x KING	(1) 2x KING	(2) 2x KING	(2) 2x KING	(3) 2x KING

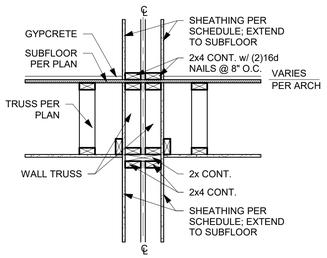

REF ARCH FOR ALL RATED ASSEMBLIES

E4 PARTY WALL NON-BEARING
3/4" = 1'-0"

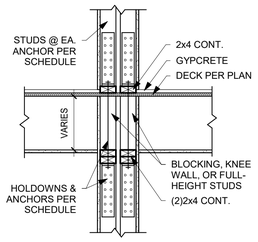

SHEARWALL ANCHORAGE			
FLOOR	HOLDOWN	ANCHOR	STUDS
3RD	MSTC52 STRAP		(2)2x4
2ND	MSTC52 STRAP		(4)2x4
1ST	HDU14-SDS2.5	1-1/8" DIA.	6x4

NOTE:
PROVIDE REQ'D FASTENERS PER MANUF. SPECS.

E3 SHEARWALL HOLDOWN SCHEDULE
3/4" = 1'-0"

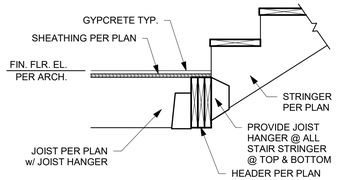

D3 TYP. STAIR FRAMING1
3/4" = 1'-0"

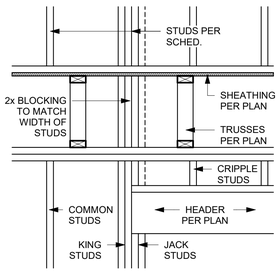

D2 TYP. BLOCKING DETAIL AT HEADERS
3/4" = 1'-0"

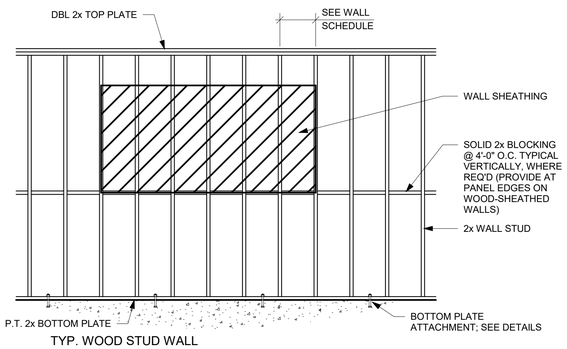

D1 TYP. WOOD STUD WALL CONSTRUCTION
N.T.S.

C4 KING STUD SCHEDULE2
1/8" = 1'-0"

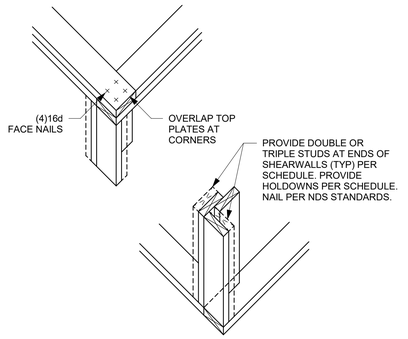

C3 TYP. 2x CORNER FRAMING DETAILS
N.T.S.

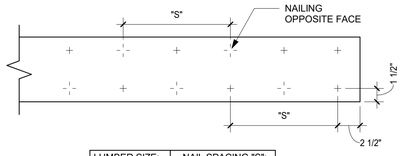

LUMBER SIZE:	NAIL SPACING "S":
2x6 OR 2x8	12" O.C. EACH FACE
2x10	8" O.C. EACH FACE
2x12	6" O.C. EACH FACE

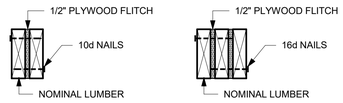

2-PLY BEAM 3-PLY BEAM

C2 TYP. BUILT-UP BEAM DETAIL
1 1/2" = 1'-0"

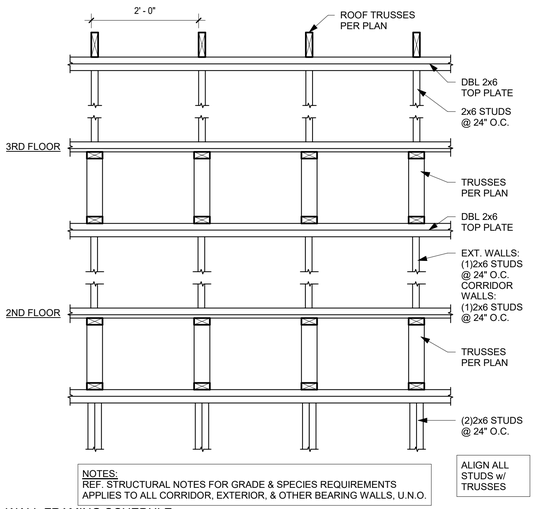

NOTES:
REF. STRUCTURAL NOTES FOR GRADE & SPECIES REQUIREMENTS APPLIES TO ALL CORRIDOR, EXTERIOR, & OTHER BEARING WALLS, U.N.O.

C1 WALL FRAMING SCHEDULE
3/4" = 1'-0"

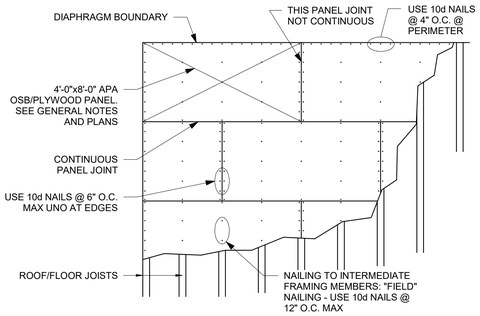

B4 ROOF/FLOOR PLAN NAILING SCHEDULE
N.T.S.

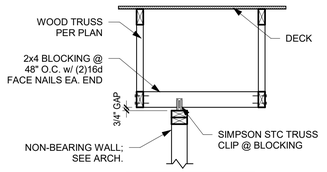

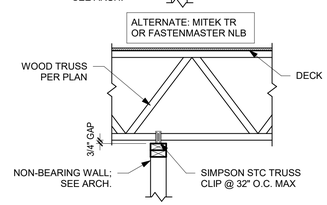

B3 TYP. NON-BEARING PARTITION WALL
N.T.S.

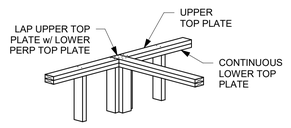

TOP PLATE INTERSECTION

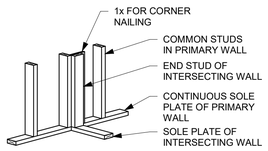

SOLE PLATE INTERSECTION

B2 TYP. INTERSECTION FRAMING DETAILS
N.T.S.

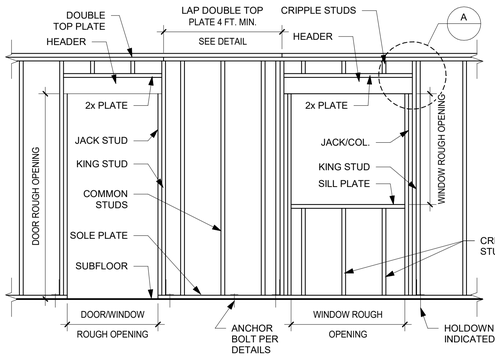

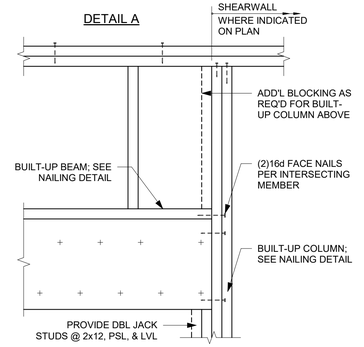

A1 TYP. OPENING IN LOAD BEARING WALL
N.T.S.

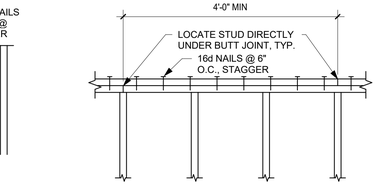

NOTES:
1. THIS DETAIL APPLIES AT ALL EXTERIOR WALLS AND INTERIOR SHEARWALLS.
2. DO NOT SPLICE TOP PLATES WITHIN 6'-0" OF SHEARWALL ENDS.

A4 TYP. TOP PLATE LAP SPLICE DETAIL
N.T.S.

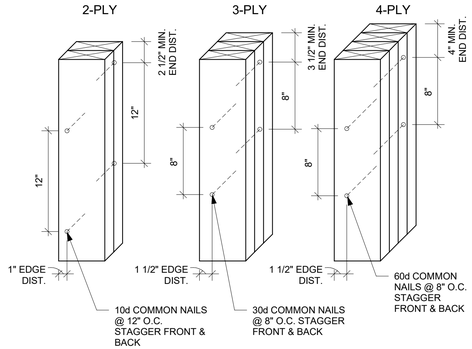

A3 TYP. 2x BUILT-UP JACK/TRIMMER STUDS
N.T.S.

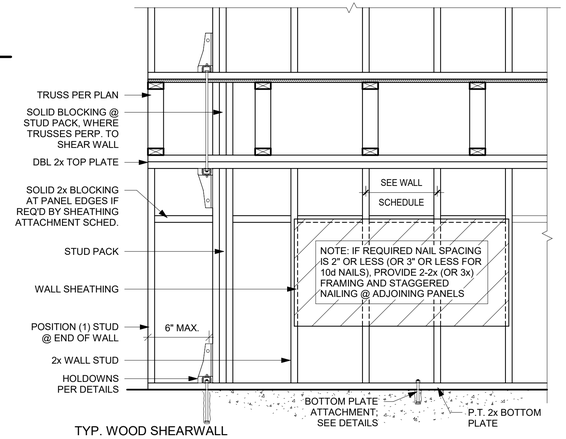

TYP. WOOD SHEARWALL CONSTRUCTION
N.T.S.

PRINTS ISSUED
10/30/23 - PERMIT SUBMITTAL

REVISIONS:

rosemann & ASSOCIATES P.C.
ARCHITECTURE
INTERIOR DESIGN
ENGINEERING
PLANNING
1526 Grand Boulevard
Kansas City, MO 64108-1404
p: 816.472.1448
w: www.rosemann.com

© 2020 Rosemann & Associates, P.C.

DENVER ▲ KANSAS CITY ▲ ST. LOUIS ▲ ATLANTA

STATE OF MISSOURI
SCOTT M. ROSEMANN
NUMBER PE-2009002204
PROFESSIONAL ENGINEER
10/30/23

WILSHIRE HILLS III

LEE'S SUMMIT, MISSOURI

MHDC - 22-057

SHEET TITLE
STRUCTURAL DETAILS

PROJECT NUMBER: 23034

SHEET NUMBER:

S-501

DRAWN BY: SAH CHECKED BY: MIH

10/31/2023 8:58:56 AM
C:\Revit Local Cache\23034_Wilshire Hills III_STRUCTURAL_Central_R23_revitMcSAM1.rvt

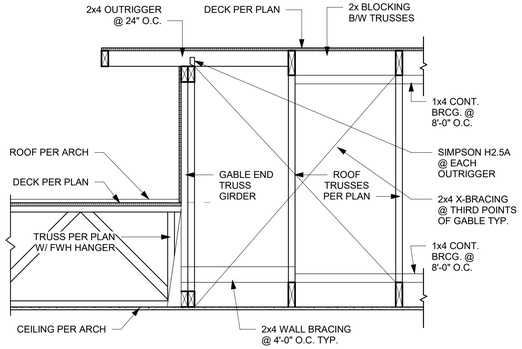

B4 GABLE END DETAIL
3/4" = 1'-0"

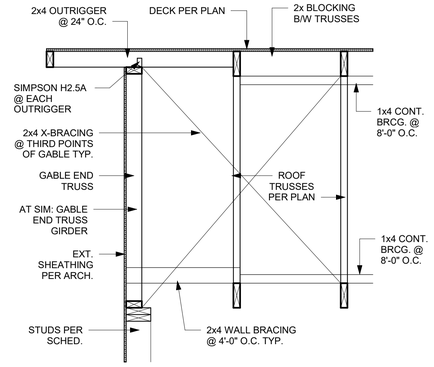

A4 GABLE END DETAIL
3/4" = 1'-0"

PRINTS ISSUED
10/30/23 - PERMIT SUBMITTAL

REVISIONS:

rosemann & ASSOCIATES P.C.
ARCHITECTURE
INTERIOR DESIGN
ENGINEERING
PLANNING
1526 Grand Boulevard
Kansas City, MO 64108-1404
p: 816.472.1448
w: www.rosemann.com
© 2020 Rosemann & Associates, P.C.
DENVER ▲ KANSAS CITY ▲ ST. LOUIS ▲ ATLANTA

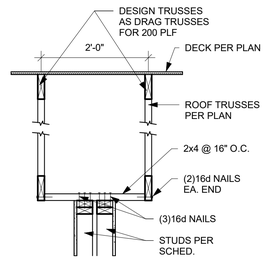

D3 ROOF TRUSS @ SHEARWALL
3/4" = 1'-0"

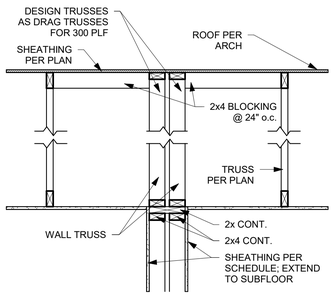

C3 ROOF TRUSS @ SHEARWALL
3/4" = 1'-0"

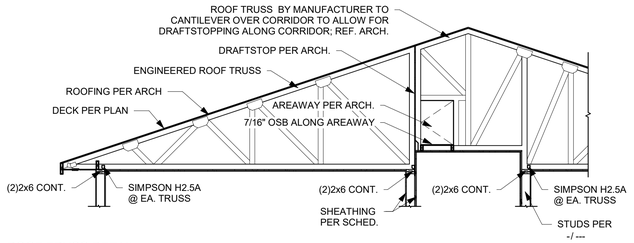

B3 ROOF TRUSS DETAIL
1/4" = 1'-0"

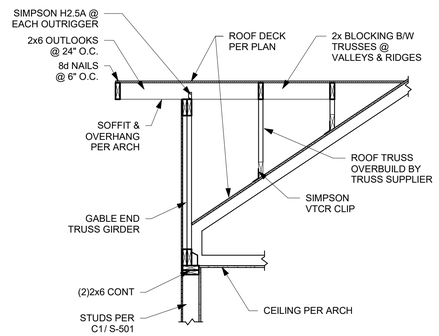

A3 GABLE END DETAIL
1/2" = 1'-0"

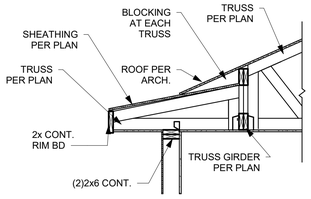

E2 LOW ROOF DETAIL
1/2" = 1'-0"

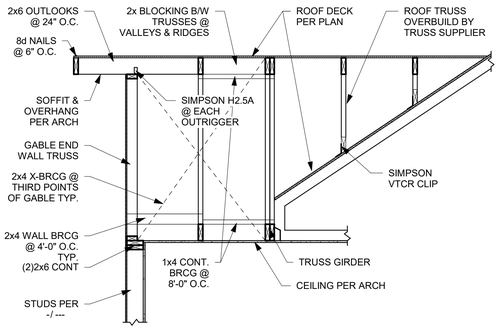

D2 GABLE END DETAIL
1/2" = 1'-0"

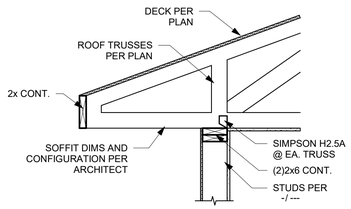

C2 ROOF TRUSS BEARING DETAIL
3/4" = 1'-0"

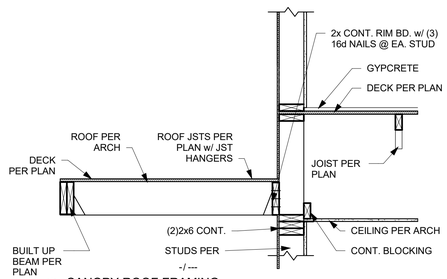

B2 CANOPY ROOF FRAMING
3/4" = 1'-0"

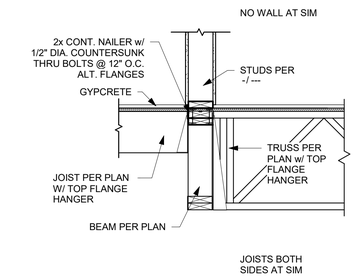

A2 WOOD BEAM DETAIL @ WALL
3/4" = 1'-0"

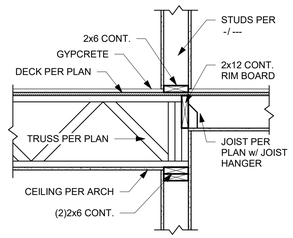

E1 CORRIDOR BEARING DETAIL
3/4" = 1'-0"

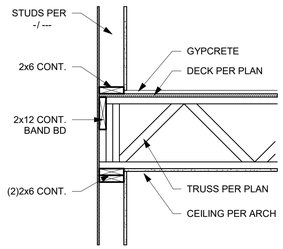

D1 EXTERIOR BEARING DETAIL
3/4" = 1'-0"

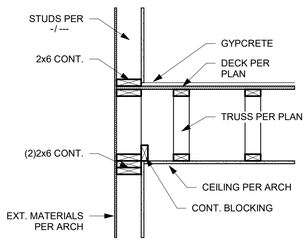

C1 EXTERIOR NON-BEARING DETAIL
3/4" = 1'-0"

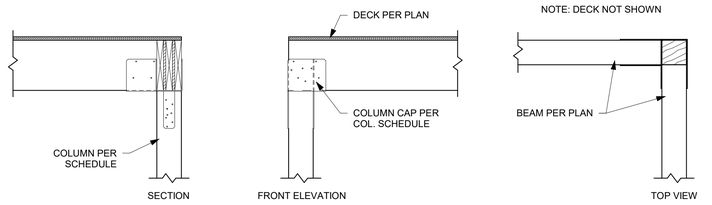

A1 WOOD BEAM TO COLUMN DETAIL
3/4" = 1'-0"

STATE OF MISSOURI
SCOTT M. ROSEMANN
NUMBER PE-2009002204
PROFESSIONAL ENGINEER
10/30/23

WILSHIRE HILLS III
LEE'S SUMMIT, MISSOURI
MHDC - 22-057

SHEET TITLE
STRUCTURAL DETAILS

PROJECT NUMBER: 23034

SHEET NUMBER:

S-502

DRAWN BY: SAH CHECKED BY: MIH

10/31/2023 8:05:56 AM
C:\Revit Local Cache\23034_Wilshire Hills III_STRUCTURAL_Central_R23_mvl9ACBAW.rvt

PRINTS ISSUED

10/30/23 - PERMIT SUBMITTAL

REVISIONS:

rosemann & ASSOCIATES P.C.
ARCHITECTURE
INTERIOR DESIGN
ENGINEERING
PLANNING
1526 Grand Boulevard
Kansas City, MO 64108-1404
p: 816.472.1448
w: www.rosemann.com
© 2020 Rosemann & Associates, P.C.
DENVER ▲ KANSAS CITY ▲ ST. LOUIS ▲ ATLANTA

STATE OF MISSOURI
SCOTT M. ROSEMANN
NUMBER PE-2008002204
PROFESSIONAL ENGINEER

10/30/23

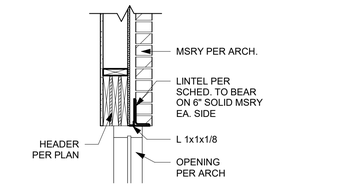

LINTEL	SPAN
L 6"x3-1/2"x3/8"	UP TO 6'-0"
7"x3-1/2"x3/8" BENT PL	>6'-0" TO 9'-0"
8"x3-1/2"x3/8" BENT PL	>9'-0" TO 12'-0"

NOTE: ALL LOOSE LINTELS SHALL BE GALVANIZED

B2 TYP. LOOSE LINTEL DETAIL2
3/4" = 1'-0"

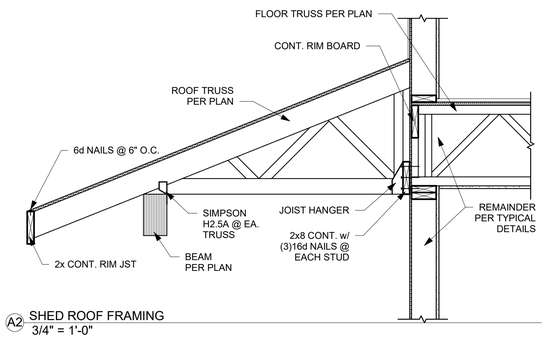

A2 SHED ROOF FRAMING
3/4" = 1'-0"

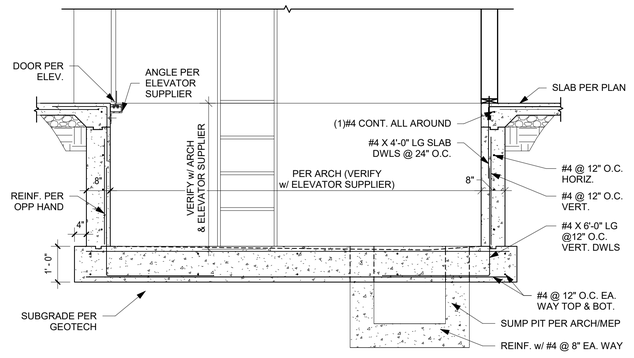

B1 ELEVATOR PIT DETAIL
1/2" = 1'-0"

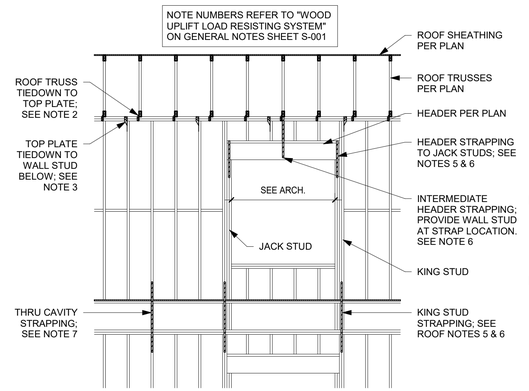

A1 ROOF TIEDOWN/STRAPPING DETAIL
1/4" = 1'-0"

WILSHIRE HILLS III

LEE'S SUMMIT, MISSOURI

MHDC - 22-057

SHEET TITLE
STRUCTURAL DETAILS

PROJECT NUMBER: 23034

SHEET NUMBER:

S-503

DRAWN BY: SAH CHECKED BY: MIH

10/31/2023 8:34:06 AM
C:\Revit Local Files\RVT2022\23034_Wilshire Hills III_STRUCTURAL_Central_R23_mrn5MCBJWr.rvt

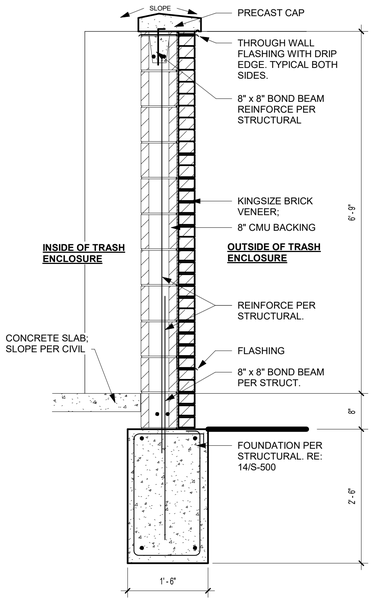

D5 TRASH ENCLOSURE SECTION
3/4" = 1'-0"

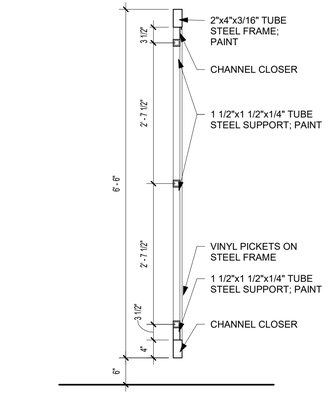

D4 TRASH ENCLOSURE GATE SECTION
3/4" = 1'-0"

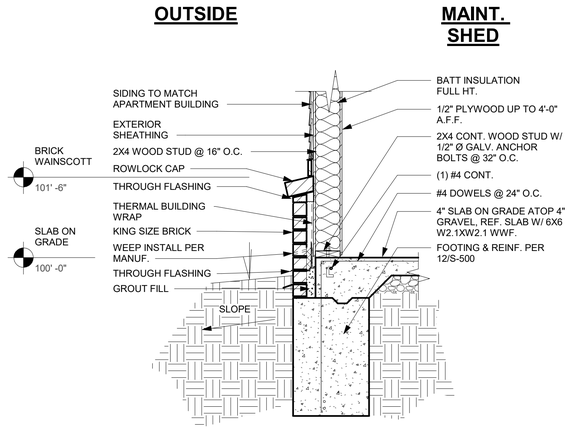

D3 MAINTENANCE SHED SECTION
3/4" = 1'-0"

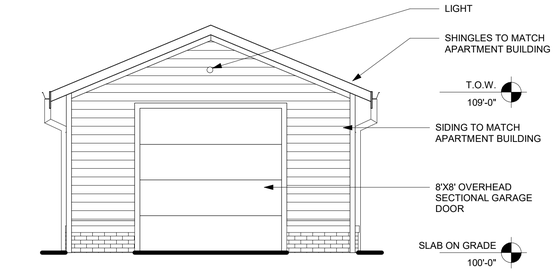

D1 MAINTENANCE SHED FRONT ELEVATION
1/4" = 1'-0"

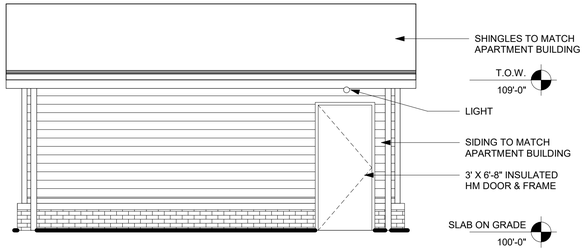

C1 MAINTENANCE SHED SIDE ELEVATION
1/4" = 1'-0"

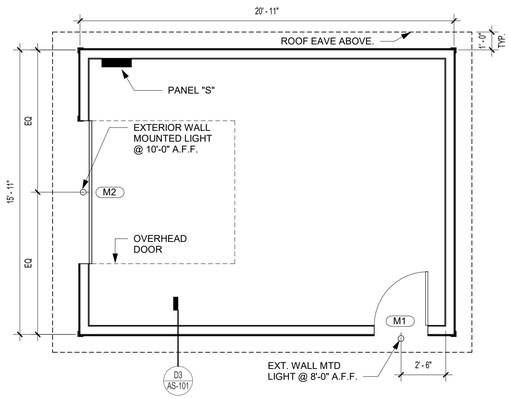

B3 MAINTENANCE SHED FLOOR PLAN
1/4" = 1'-0"

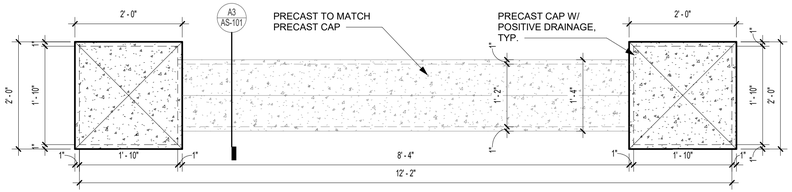

B1 MONUMENT SIGN PLAN
3/4" = 1'-0"

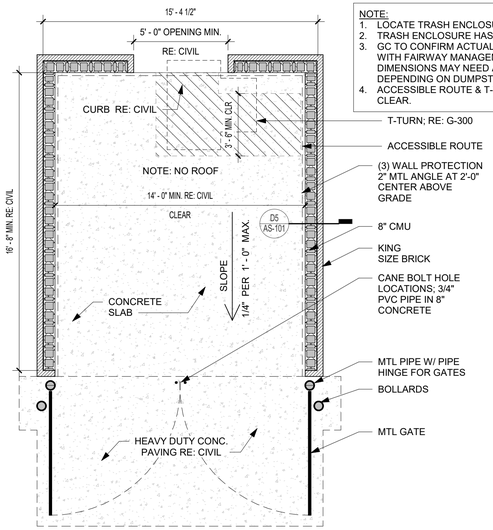

B5 TRASH ENCLOSURE ELEVATION
1/4" = 1'-0"

NOTE:
1. LOCATE TRASH ENCLOSURE PER CIVIL.
2. TRASH ENCLOSURE HAS NO ROOF.
3. GC TO CONFIRM ACTUAL DUMPSTER SIZE WITH FAIRWAY MANAGEMENT. ENCLOSURE DIMENSIONS MAY NEED ADJUSTMENT DEPENDING ON DUMPSTER MANUF. USED.
4. ACCESSIBLE ROUTE & T-TURN TO REMAIN CLEAR.

A5 TRASH ENCLOSURE FLOOR PLAN
1/4" = 1'-0"

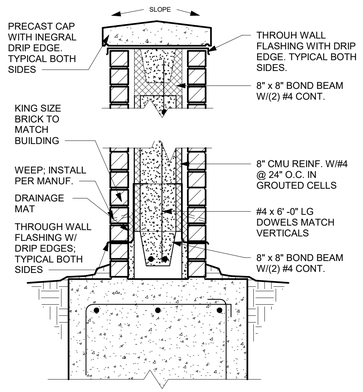

A4 MONUMENT SIGN SECTION
1" = 1'-0"

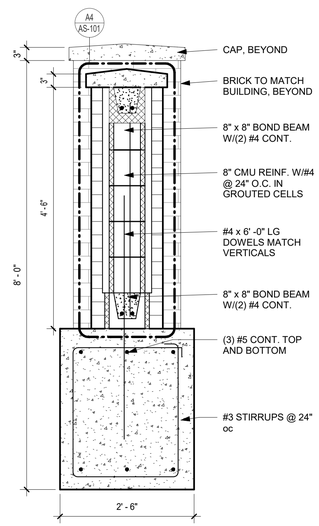

A3 MONUMENT SIGN SECTION
3/4" = 1'-0"

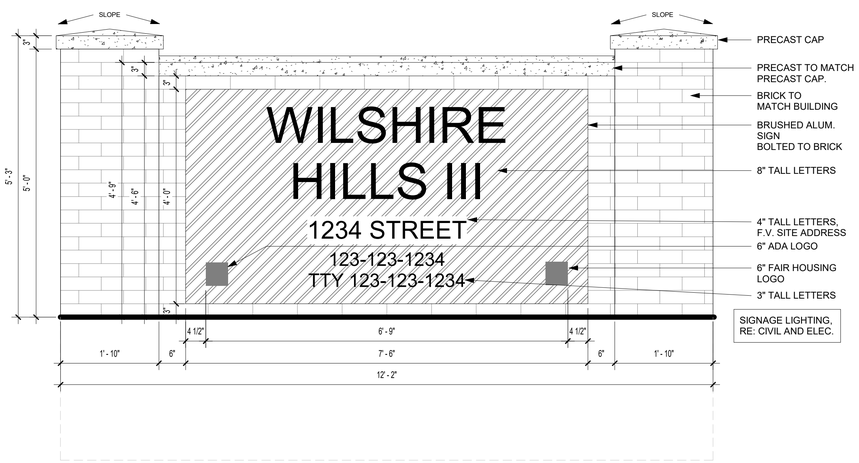

A1 MONUMENT SIGN FRONT ELEVATION
3/4" = 1'-0"

PRINTS ISSUED
10/30/23 PERMIT SUBMITTAL

REVISIONS:

rosemann & ASSOCIATES P.C.
ARCHITECTURE
INTERIOR DESIGN
ENGINEERING
PLANNING
1526 Grand Boulevard
Kansas City, MO 64108-1404
p: 816.472.1448
w: www.rosemann.com
© 2023 Rosemann & Associates, P.C.
DENVER ▲ KANSAS CITY ▲ ST. LOUIS ▲ ATLANTA

STATE OF MISSOURI
DAVID EUGENE HENDRIKS
NUMBER A-7365
REGISTERED ARCHITECT
10/30/23

WILSHIRE HILLS III
LEE'S SUMMIT, MISSOURI
MHDC - 22-057

SHEET TITLE
ARCHITECTURAL SITE AMENITIES

PROJECT NUMBER: 23034

SHEET NUMBER:

AS-101

10/27/2023 2:03:05 PM
C:\Revit Local Cache\23034_Wilshire Hills III_Central_R23_jsmith1KLAR.rvt

REFERENCE G-003 FOR GENERAL NOTES

PLAN LEGEND

- PARTIAL HEIGHT PARTITION
- NON-RATED PARTITION; SEE ASSEMBLIES
- 1 HR RATED PARTITION; SEE ASSEMBLIES
- A1 — WINDOW TYPE; SEE WINDOW SCHEDULE
- 101 — DOOR TYPE; SEE DOOR SCHEDULE
- P7 — PARTITION TYPE; SEE ASSEMBLIES
- 6' - 0" — FRAMING DIMENSIONS
- 6' - 0" LAYOUT — LAYOUT LINE DIMENSIONS

PRINTS ISSUED
10/30/23 PERMIT SUBMITTAL

REVISIONS:

rosemann & ASSOCIATES P.C.
ARCHITECTURE
INTERIOR DESIGN
ENGINEERING
PLANNING
1526 Grand Boulevard
Kansas City, MO 64108-1404
p: 816.472.1448
w: www.rosemann.com

© 2023 Rosemann & Associates, P.C.

DENVER ▲ KANSAS CITY ▲ ST. LOUIS ▲ ATLANTA

STATE OF MISSOURI
DAVID EUGENE HENDRIKSE
NUMBER A-7365
REGISTERED ARCHITECT
10/30/23

WILSHIRE HILLS III

LEE'S SUMMIT, MISSOURI

MHDC - 22-057

SHEET TITLE
FIRST FLOOR PLAN

PROJECT NUMBER: 23034

SHEET NUMBER:

A-101

A1 FIRST FLOOR PLAN
3/32" = 1'-0"

10/27/2023 2:43:09 PM
C:\Revit Local Cache\23034_Wilshire Hills III_Central_R23_revitTUCAR.rvt

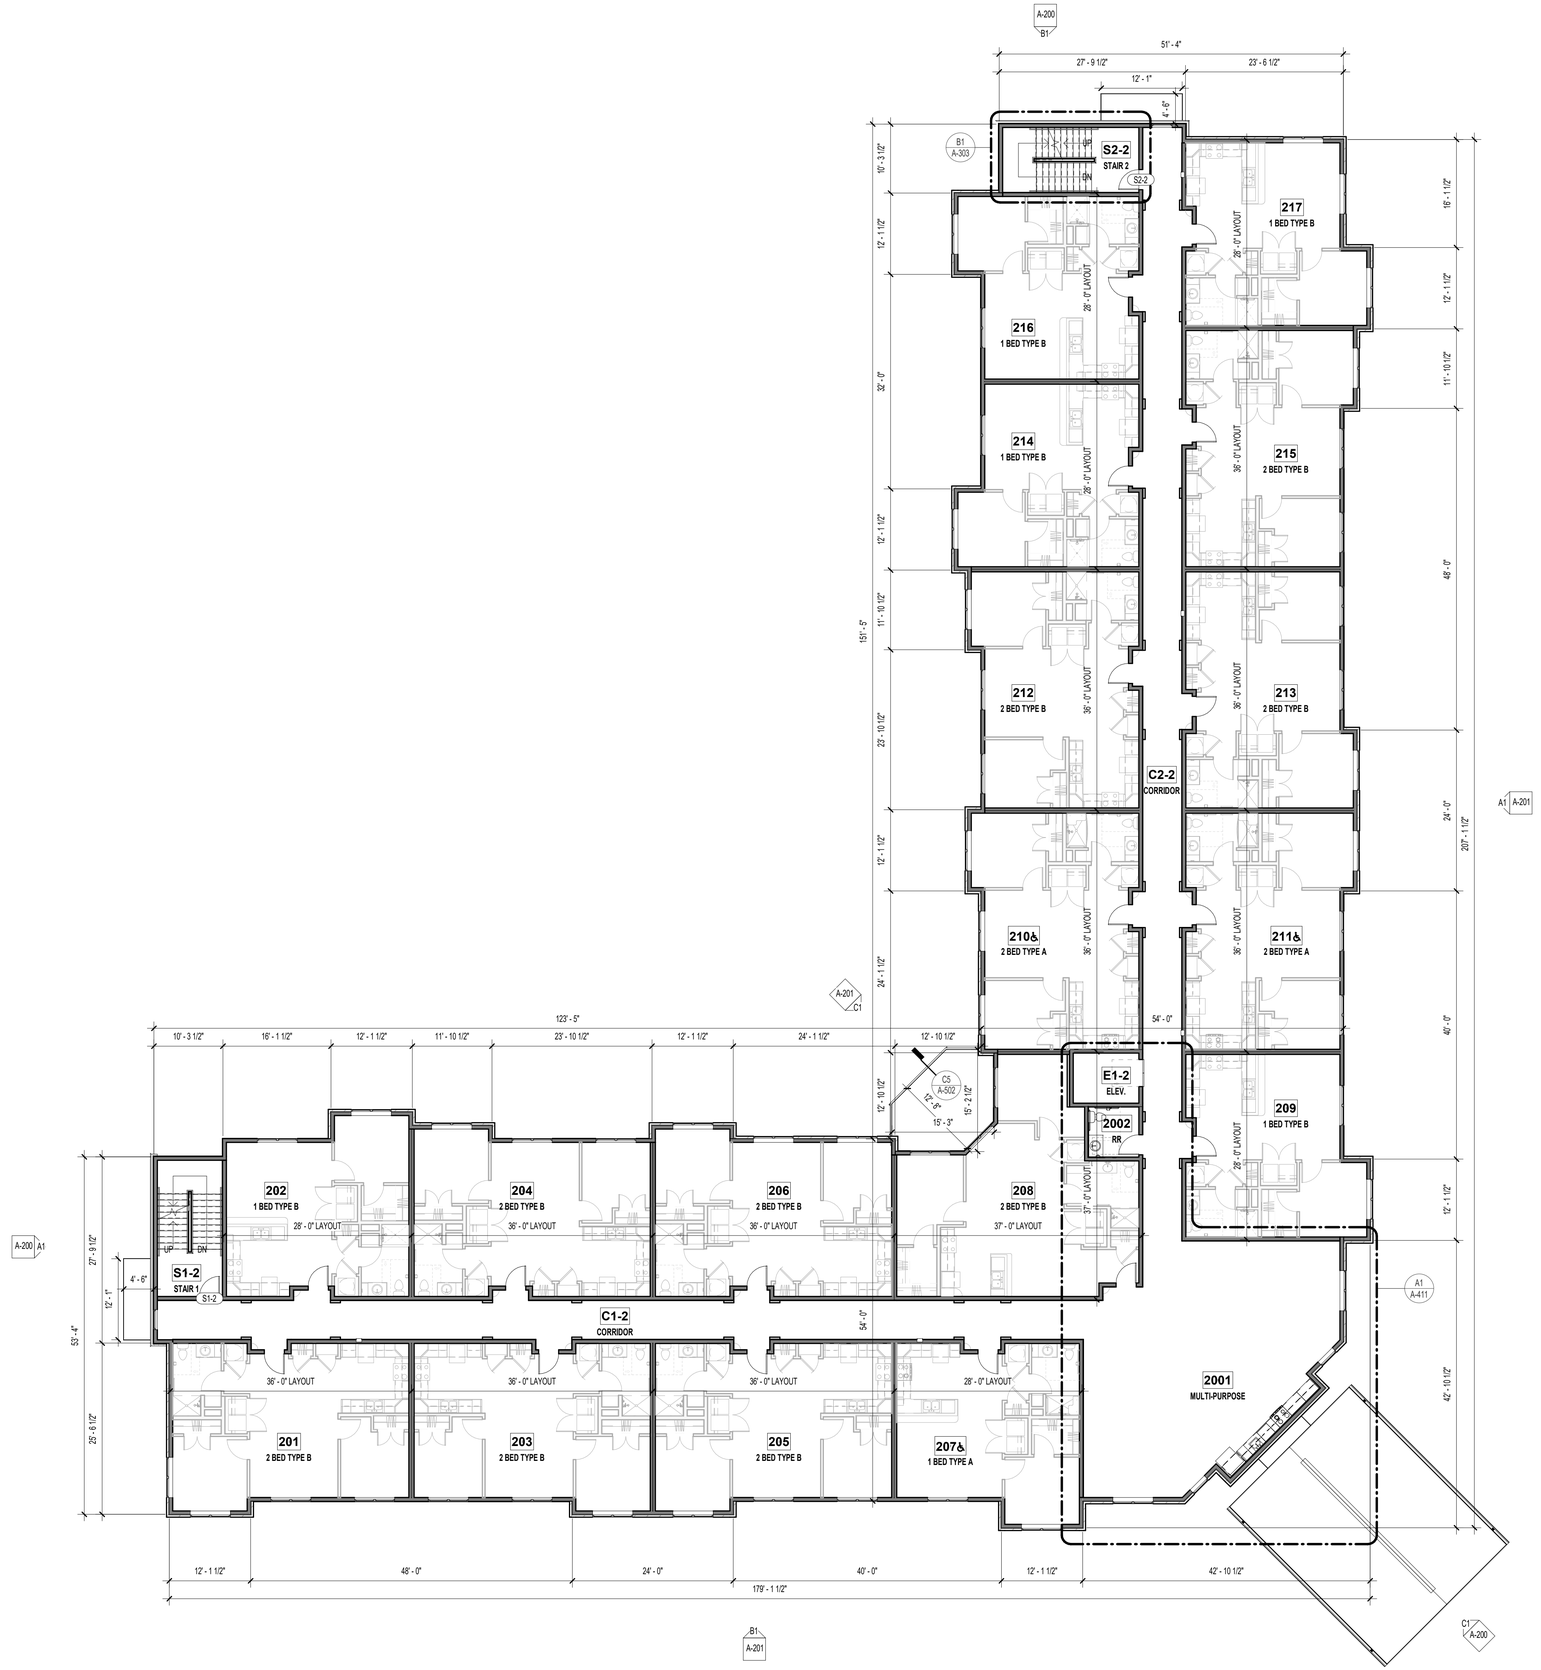

REFERENCE G-003 FOR GENERAL NOTES
REFERENCE A-101 FOR PLAN LEGEND

PRINTS ISSUED
10/30/23 PERMIT SUBMITTAL

REVISIONS:

rosemann & ASSOCIATES P.C.
ARCHITECTURE
INTERIOR DESIGN
ENGINEERING
PLANNING
1526 Grand Boulevard
Kansas City, MO 64108-1404
p: 816.472.1448
w: www.rosemann.com
© 2023 Rosemann & Associates, P.C.
DENVER ▲ KANSAS CITY ▲ ST. LOUIS ▲ ATLANTA

STATE OF MISSOURI
DAVID EUGENE HENDRIKSE
NUMBER A-7365
REGISTERED ARCHITECT
10/30/23

WILSHIRE HILLS III

LEE'S SUMMIT, MISSOURI

MHDC - 22-057

SHEET TITLE
SECOND FLOOR PLAN

PROJECT NUMBER: 23034

SHEET NUMBER:

A-102

A1 SECOND FLOOR PLAN
3/32" = 1'-0"

10/27/2023 2:50:48 PM
C:\Revit Local Cache\R2023\23034_Wilshire Hills III_Central_R23_revitTGCAR.rvt

REFERENCE G-003 FOR GENERAL NOTES
REFERENCE A-101 FOR PLAN LEGEND

PRINTS ISSUED
10/30/23 PERMIT SUBMITTAL

REVISIONS:

rosemann & ASSOCIATES P.C.
ARCHITECTURE
INTERIOR DESIGN
ENGINEERING
PLANNING
1526 Grand Boulevard
Kansas City, MO 64108-1404
p: 816.472.1448
w: www.rosemann.com
© 2023 Rosemann & Associates, P.C.
DENVER ▲ KANSAS CITY ▲ ST. LOUIS ▲ ATLANTA

STATE OF MISSOURI
DAVID EUGENE HENDRIKSE
NUMBER A-7365
REGISTERED ARCHITECT
10/30/23

WILSHIRE HILLS III

LEE'S SUMMIT, MISSOURI

MHDC - 22-057

SHEET TITLE
THIRD FLOOR PLAN

PROJECT NUMBER: 23034

SHEET NUMBER:

A-103

A1 THIRD FLOOR PLAN
3/32" = 1'-0"

10/27/2023 2:52:03 PM
C:\Revit Local Files\R23\23034_Wilshire Hills III_Central_R23_mm911CAR.rvt

AREA A

AREA TO BE VENTED				**2065 S.F.**	
VENTING CALCULATION FACTOR PER **2018** IBC				300	
TOTAL REQUIRED VENTING	=	(2065 S.F. x 144) / 300 =		**991 SQ.IN.**	
HIGH ROOF VENTING	=	991 SQ.IN. x **0.4** =		396 SQ.IN.	
LOW ROOF VENTING	=	991 SQ.IN. x **0.6** =		595 SQ.IN.	
HIGH ROOF VENTING				**396 SQ.IN.**	**REQUIRED**
PROVIDED HIGH ROOF VENTING				**416 SQ.IN.**	**PROVIDED** ☑
(12) LF RIDGE VENT		@	18 NFA =	216 SQ.IN./FT NFA	
(4) BOX VENT		@	50 NFA =	200 SQ.IN./FT NFA	
LOW ROOF VENTING				**595 SQ.IN.**	**REQUIRED**
PROVIDED LOW ROOF VENTING				**600 SQ.IN.**	**PROVIDED** ☑
(12) LF SOFFIT VENT		@	50 NFA =	600 SQ.IN./FT NFA	
TOTAL ROOF VENTING PROVIDED				**1016 SQ.IN.**	**PROVIDED** ☑

AREA B

AREA TO BE VENTED				**1783 S.F.**	
VENTING CALCULATION FACTOR PER **2018** IBC				300	
TOTAL REQUIRED VENTING	=	(1783 S.F. x 144) / 300 =		**856 SQ.IN.**	
HIGH ROOF VENTING	=	856 SQ.IN. x **0.4** =		342 SQ.IN.	
LOW ROOF VENTING	=	856 SQ.IN. x **0.6** =		514 SQ.IN.	
HIGH ROOF VENTING				**342 SQ.IN.**	**REQUIRED**
PROVIDED HIGH ROOF VENTING				**344 SQ.IN.**	**PROVIDED** ☑
(8) LF RIDGE VENT		@	18 NFA =	144 SQ.IN./FT NFA	
(4) BOX VENT		@	50 NFA =	200 SQ.IN./FT NFA	
LOW ROOF VENTING				**514 SQ.IN.**	**REQUIRED**
PROVIDED LOW ROOF VENTING				**600 SQ.IN.**	**PROVIDED** ☑
(12) LF SOFFIT VENT		@	50 NFA =	600 SQ.IN./FT NFA	
TOTAL ROOF VENTING PROVIDED				**944 SQ.IN.**	**PROVIDED** ☑

AREA C

AREA TO BE VENTED				**2201 S.F.**	
VENTING CALCULATION FACTOR PER **2018** IBC				300	
TOTAL REQUIRED VENTING	=	(2201 S.F. x 144) / 300 =		**1056 SQ.IN.**	
HIGH ROOF VENTING	=	1056 SQ.IN. x **0.4** =		422 SQ.IN.	
LOW ROOF VENTING	=	1056 SQ.IN. x **0.6** =		634 SQ.IN.	
HIGH ROOF VENTING				**422 SQ.IN.**	**REQUIRED**
PROVIDED HIGH ROOF VENTING				**452 SQ.IN.**	**PROVIDED** ☑
(14) LF RIDGE VENT		@	18 NFA =	252 SQ.IN./FT NFA	
(4) BOX VENT		@	50 NFA =	200 SQ.IN./FT NFA	
LOW ROOF VENTING				**634 SQ.IN.**	**REQUIRED**
PROVIDED LOW ROOF VENTING				**700 SQ.IN.**	**PROVIDED** ☑
(14) LF SOFFIT VENT		@	50 NFA =	700 SQ.IN./FT NFA	
TOTAL ROOF VENTING PROVIDED				**1152 SQ.IN.**	**PROVIDED** ☑

AREA D

AREA TO BE VENTED				**2055 S.F.**	
VENTING CALCULATION FACTOR PER **2018** IBC				300	
TOTAL REQUIRED VENTING	=	(2055 S.F. x 144) / 300 =		**986 SQ.IN.**	
HIGH ROOF VENTING	=	986 SQ.IN. x **0.4** =		394 SQ.IN.	
LOW ROOF VENTING	=	986 SQ.IN. x **0.6** =		592 SQ.IN.	
HIGH ROOF VENTING				**394 SQ.IN.**	**REQUIRED**
PROVIDED HIGH ROOF VENTING				**444 SQ.IN.**	**PROVIDED** ☑
(8) LF RIDGE VENT		@	18 NFA =	144 SQ.IN./FT NFA	
(6) BOX VENT		@	50 NFA =	300 SQ.IN./FT NFA	
LOW ROOF VENTING				**592 SQ.IN.**	**REQUIRED**
PROVIDED LOW ROOF VENTING				**600 SQ.IN.**	**PROVIDED** ☑
(12) LF SOFFIT VENT		@	50 NFA =	600 SQ.IN./FT NFA	
TOTAL ROOF VENTING PROVIDED				**1044 SQ.IN.**	**PROVIDED** ☑

AREA E

AREA TO BE VENTED				**2103 S.F.**	
VENTING CALCULATION FACTOR PER **2018** IBC				300	
TOTAL REQUIRED VENTING	=	(2103 S.F. x 144) / 300 =		**1009 SQ.IN.**	
HIGH ROOF VENTING	=	1009 SQ.IN. x **0.4** =		404 SQ.IN.	
LOW ROOF VENTING	=	1009 SQ.IN. x **0.6** =		605 SQ.IN.	
HIGH ROOF VENTING				**404 SQ.IN.**	**REQUIRED**
PROVIDED HIGH ROOF VENTING				**416 SQ.IN.**	**PROVIDED** ☑
(12) LF RIDGE VENT		@	18 NFA =	216 SQ.IN./FT NFA	
(4) BOX VENT		@	50 NFA =	200 SQ.IN./FT NFA	
LOW ROOF VENTING				**605 SQ.IN.**	**REQUIRED**
PROVIDED LOW ROOF VENTING				**700 SQ.IN.**	**PROVIDED** ☑
(14) LF SOFFIT VENT		@	50 NFA =	700 SQ.IN./FT NFA	
TOTAL ROOF VENTING PROVIDED				**1116 SQ.IN.**	**PROVIDED** ☑

AREA F

AREA TO BE VENTED				**1983 S.F.**	
VENTING CALCULATION FACTOR PER **2018** IBC				300	
TOTAL REQUIRED VENTING	=	(1983 S.F. x 144) / 300 =		**952 SQ.IN.**	
HIGH ROOF VENTING	=	952 SQ.IN. x **0.4** =		381 SQ.IN.	
LOW ROOF VENTING	=	952 SQ.IN. x **0.6** =		571 SQ.IN.	
HIGH ROOF VENTING				**381 SQ.IN.**	**REQUIRED**
PROVIDED HIGH ROOF VENTING				**416 SQ.IN.**	**PROVIDED** ☑
(12) LF RIDGE VENT		@	18 NFA =	216 SQ.IN./FT NFA	
(4) BOX VENT		@	50 NFA =	200 SQ.IN./FT NFA	
LOW ROOF VENTING				**571 SQ.IN.**	**REQUIRED**
PROVIDED LOW ROOF VENTING				**600 SQ.IN.**	**PROVIDED** ☑
(12) LF SOFFIT VENT		@	50 NFA =	600 SQ.IN./FT NFA	
TOTAL ROOF VENTING PROVIDED				**1016 SQ.IN.**	**PROVIDED** ☑

AREA G

AREA TO BE VENTED				**1614 S.F.**	
VENTING CALCULATION FACTOR PER **2018** IBC				300	
TOTAL REQUIRED VENTING	=	(1614 S.F. x 144) / 300 =		**775 SQ.IN.**	
HIGH ROOF VENTING	=	775 SQ.IN. x **0.4** =		310 SQ.IN.	
LOW ROOF VENTING	=	775 SQ.IN. x **0.6** =		465 SQ.IN.	
HIGH ROOF VENTING				**310 SQ.IN.**	**REQUIRED**
PROVIDED HIGH ROOF VENTING				**330 SQ.IN.**	**PROVIDED** ☑
(10) LF RIDGE VENT		@	18 NFA =	180 SQ.IN./FT NFA	
(3) BOX VENT		@	50 NFA =	150 SQ.IN./FT NFA	
LOW ROOF VENTING				**465 SQ.IN.**	**REQUIRED**
PROVIDED LOW ROOF VENTING				**500 SQ.IN.**	**PROVIDED** ☑
(10) LF SOFFIT VENT		@	50 NFA =	500 SQ.IN./FT NFA	
TOTAL ROOF VENTING PROVIDED				**830 SQ.IN.**	**PROVIDED** ☑

AREA H

AREA TO BE VENTED				**1850 S.F.**	
VENTING CALCULATION FACTOR PER **2018** IBC				300	
TOTAL REQUIRED VENTING	=	(1850 S.F. x 144) / 300 =		**888 SQ.IN.**	
HIGH ROOF VENTING	=	888 SQ.IN. x **0.4** =		355 SQ.IN.	
LOW ROOF VENTING	=	888 SQ.IN. x **0.6** =		533 SQ.IN.	
HIGH ROOF VENTING				**355 SQ.IN.**	**REQUIRED**
PROVIDED HIGH ROOF VENTING				**380 SQ.IN.**	**PROVIDED** ☑
(10) LF RIDGE VENT		@	18 NFA =	180 SQ.IN./FT NFA	
(4) BOX VENT		@	50 NFA =	200 SQ.IN./FT NFA	
LOW ROOF VENTING				**533 SQ.IN.**	**REQUIRED**
PROVIDED LOW ROOF VENTING				**600 SQ.IN.**	**PROVIDED** ☑
(12) LF SOFFIT VENT		@	50 NFA =	600 SQ.IN./FT NFA	
TOTAL ROOF VENTING PROVIDED				**980 SQ.IN.**	**PROVIDED** ☑

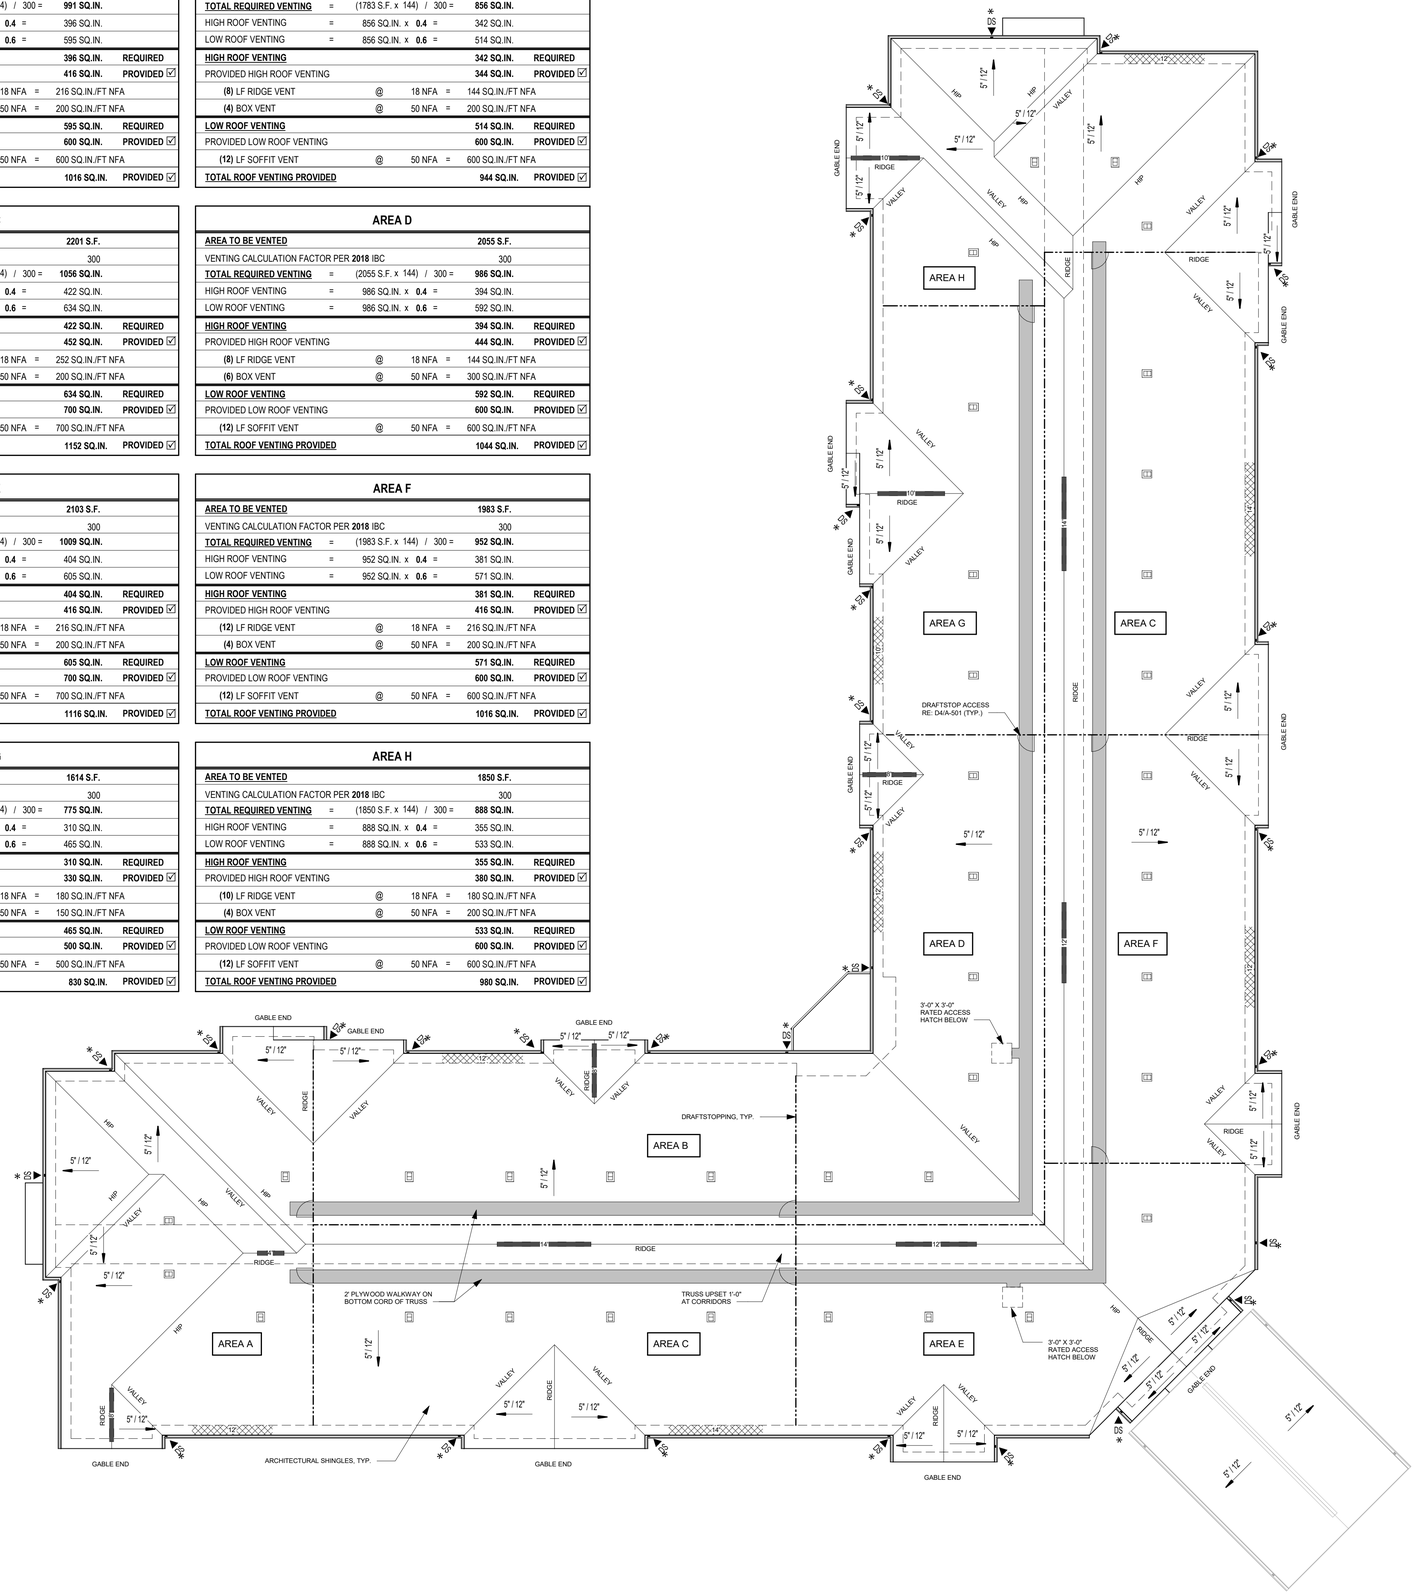

1 ROOF PLAN
3/32" = 1'-0"

REFERENCE G-003 FOR GENERAL NOTES

PRINTS ISSUED
10/30/23 PERMIT SUBMITTAL

REVISIONS:

rosemann & ASSOCIATES P.C.
ARCHITECTURE
INTERIOR DESIGN
ENGINEERING
PLANNING
1526 Grand Boulevard
Kansas City, MO 64108-1404
p: 816.472.1448
w: www.rosemann.com

© 2023 Rosemann & Associates, P.C.

DENVER ▲ KANSAS CITY ▲ ST. LOUIS ▲ ATLANTA

STATE OF MISSOURI
DAVID EUGENE HENDRIKSE
NUMBER A-7365
REGISTERED ARCHITECT
10/30/23

WILSHIRE HILLS III
LEE'S SUMMIT, MISSOURI
MHDC - 22-057

SHEET TITLE
ROOF PLAN

PROJECT NUMBER: 23034

SHEET NUMBER:

A-104

10/27/2023 2:51:02 PM
C:\Revit Local Cache\23034_Wilshire Hills III_Central_R23_wvrBTUCAR.rvt

REFERENCE G-003 FOR GENERAL NOTES

RCP LEGEND

- **C2** - 2' X 4' ACT SYSTEM - CERAMAGUARD UNPERFORATED SQUARE LAY-IN, PER 095113
- **C3** - GWB ON METAL STUD
- **C4** - SMOOTH FIBERCEMENT BOARD. PROVIDE 1X BATTEN @ SEAMS. PAINT FINISH
- **C8** - TONGUE & GROOVE (EXTERIOR) - SIZE: 1X6' PTD PER ARCH RECOMMENDATIONS
- (9' - 0") INDICATES CEILING HEIGHT

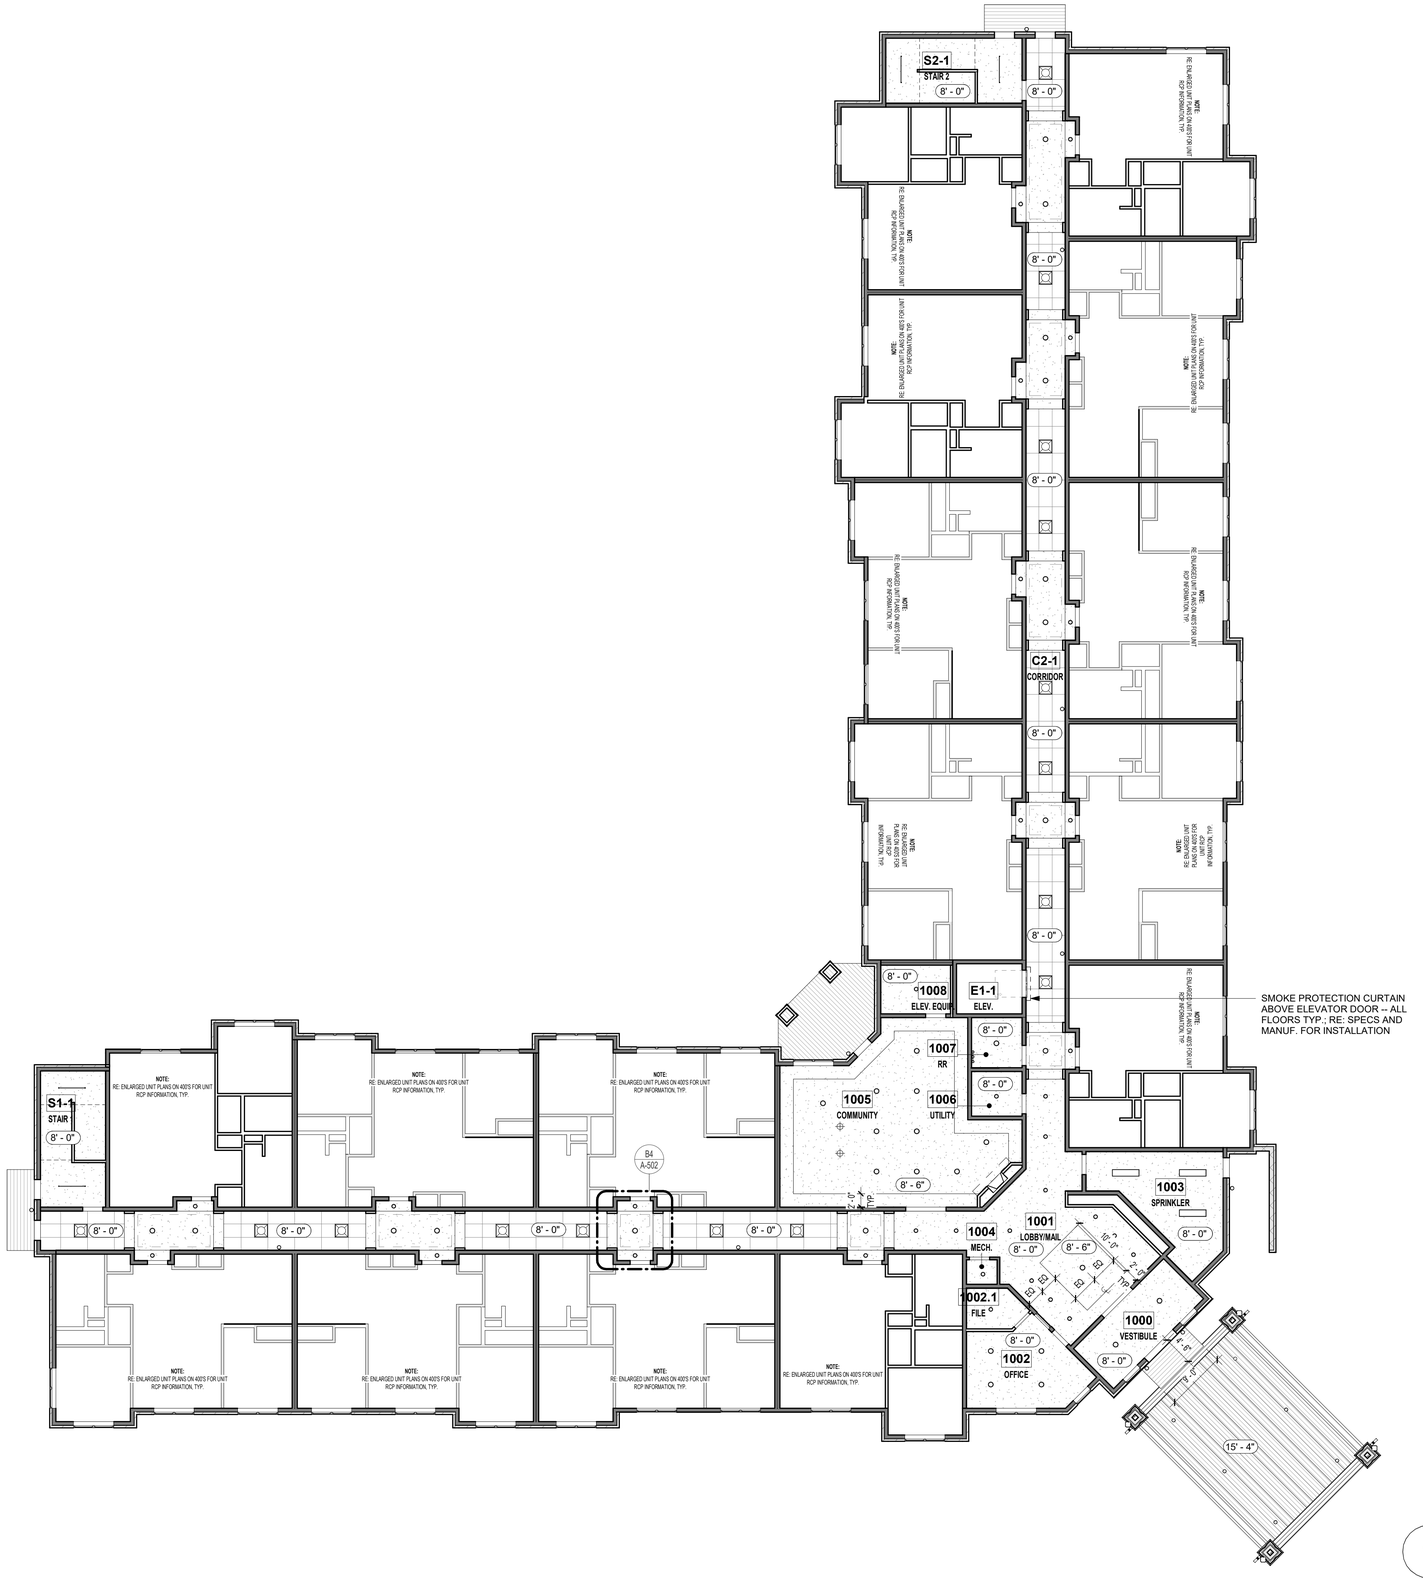

1 FIRST FLOOR REFLECTED CEILING PLAN
3/32" = 1'-0"

PRINTS ISSUED
10/30/23 PERMIT SUBMITTAL

REVISIONS:

rosemann & ASSOCIATES P.C.
ARCHITECTURE
INTERIOR DESIGN
ENGINEERING
PLANNING
1526 Grand Boulevard
Kansas City, MO 64108-1404
p: 816.472.1448
w: www.rosemann.com
© 2023 Rosemann & Associates, P.C.
DENVER ▲ KANSAS CITY ▲ ST. LOUIS ▲ ATLANTA

STATE OF MISSOURI
DAVID EUGENE HENDRIKSE
NUMBER A-7365
REGISTERED ARCHITECT
10/30/23

WILSHIRE HILLS III
LEE'S SUMMIT, MISSOURI
MHDC - 22-057

SHEET TITLE
FIRST FLOOR REFLECTED CEILING PLAN

PROJECT NUMBER: 23034

SHEET NUMBER:

A-120

10/27/2023 2:51:04 PM
C:\Revit Local Files\R23\23034_Wilshire Hills III_Central_R23_mwt01CAR.rvt

REFERENCE G-003 FOR GENERAL NOTES
REFERENCE A-120 FOR RCP LEGEND

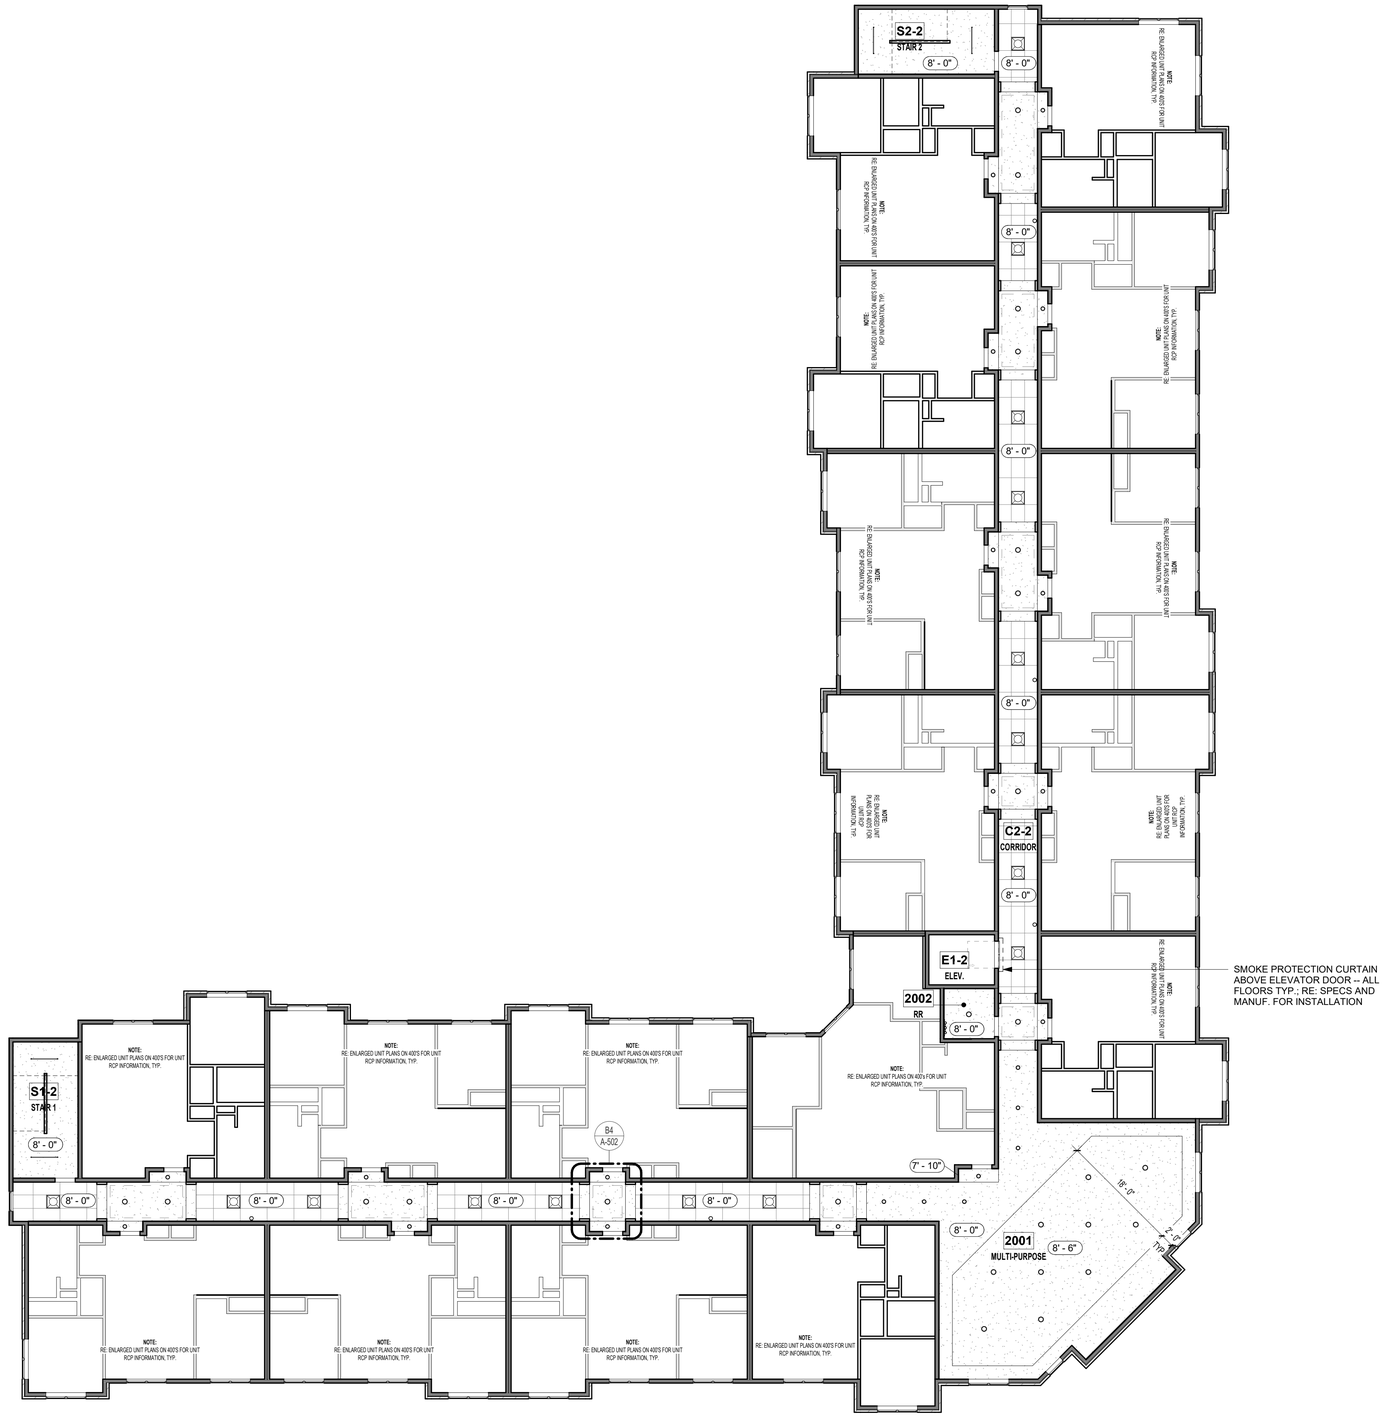

1 SECOND FLOOR REFLECTED CEILING PLAN
3/32" = 1'-0"

PRINTS ISSUED
10/30/23 PERMIT SUBMITTAL

REVISIONS:

rosemann & ASSOCIATES P.C.
ARCHITECTURE
INTERIOR DESIGN
ENGINEERING
PLANNING
1526 Grand Boulevard
Kansas City, MO 64108-1404
p: 816.472.1448
w: www.rosemann.com
© 2023 Rosemann & Associates, P.C.
DENVER ▲ KANSAS CITY ▲ ST. LOUIS ▲ ATLANTA

STATE OF MISSOURI
DAVID EUGENE HENDRIKSE
NUMBER A-7365
REGISTERED ARCHITECT
10/30/23

WILSHIRE HILLS III
LEE'S SUMMIT, MISSOURI
MHDC - 22-057

SHEET TITLE
SECOND FLOOR REFLECTED CEILING PLAN

PROJECT NUMBER: 23034

SHEET NUMBER:

A-121

10/27/2023 2:51:09 PM
C:\Revit Local Files\RVT23\23034_Wilshire Hills III_Central_R23_mmf01CAR.rvt

REFERENCE G-003 FOR GENERAL NOTES
REFERENCE A-120 FOR RCP LEGEND

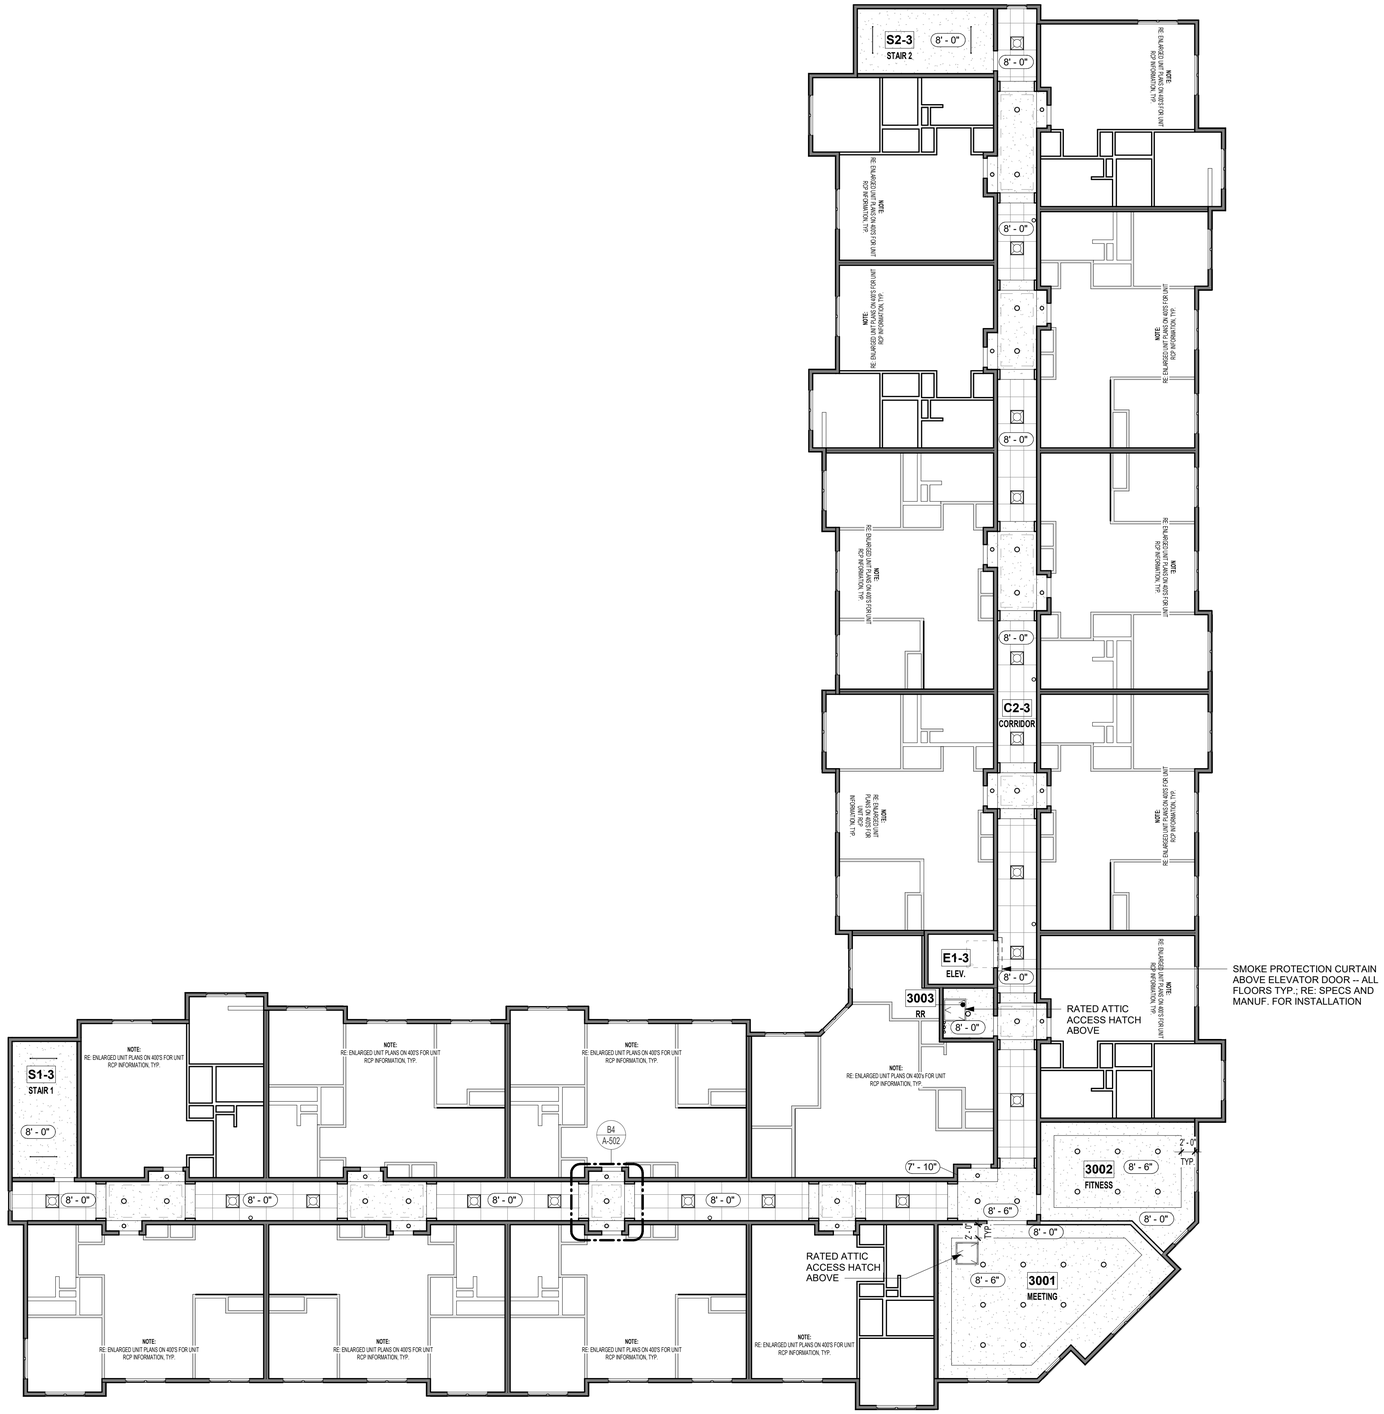

1 THIRD FLOOR REFLECTED CEILING PLAN
3/32" = 1'-0"

rosemann & ASSOCIATES P.C.
ARCHITECTURE
INTERIOR DESIGN
ENGINEERING
PLANNING
1526 Grand Boulevard
Kansas City, MO 64108-1404
p: 816.472.1448
w: www.rosemann.com
© 2023 Rosemann & Associates, P.C.
DENVER ▲ KANSAS CITY ▲ ST. LOUIS ▲ ATLANTA

STATE OF MISSOURI
DAVID EUGENE HENDRIKSE
NUMBER A-7365
REGISTERED ARCHITECT
10/30/23

PRINTS ISSUED
10/30/23 PERMIT SUBMITTAL

REVISIONS:

WILSHIRE HILLS III

LEE'S SUMMIT, MISSOURI

MHDC - 22-057

SHEET TITLE
THIRD FLOOR REFLECTED CEILING PLAN

PROJECT NUMBER: 23034

SHEET NUMBER:

A-122

10/27/2023 2:51:13 PM
C:\Revit Local Cache\23034_Wilshire Hills III_Central_R23_revitRTUCAR.rvt

C1 FRONT ELEVATION
1/8" = 1'-0"

REFERENCE G-003 FOR GENERAL NOTES

MATERIAL LEGEND

- 6" PREFININISHED FIBER LAP SIDING
- BOARD & BATTEN SIDING
- FACE BRICK
- CAST STONE BANDING, WINDOW SILLS AND CAPS
- SPLIT FACE CMU
- PREFINISHED FIBER TRIM - 3-1/2" & 5-1/2" AT WINDOW 11-1/4" AT BANDING 3-1/2" VERTICAL OUTSIDE / INSIDE CORNER TRIM

B1 EAST ELEVATION
1/8" = 1'-0"

A1 NORTH ELEVATION
1/8" = 1'-0"

PRINTS ISSUED
10/30/23 PERMIT SUBMITTAL

REVISIONS:

rosemann & ASSOCIATES P.C.
ARCHITECTURE
INTERIOR DESIGN
ENGINEERING
PLANNING
1526 Grand Boulevard
Kansas City, MO 64108-1404
p: 816.472.1448
w: www.rosemann.com
© 2023 Rosemann & Associates, P.C.
DENVER ▲ KANSAS CITY ▲ ST. LOUIS ▲ ATLANTA

STATE OF MISSOURI
DAVID EUGENE HENDRIKSE
NUMBER A-7365
REGISTERED ARCHITECT
10/30/23

WILSHIRE HILLS III
LEE'S SUMMIT, MISSOURI
MHDC - 22-057

SHEET TITLE
EXTERIOR ELEVATIONS

PROJECT NUMBER: 23034

SHEET NUMBER:

A-200

10/27/2023 2:51:17 PM
C:\Revit Local Files\Revit2023\2023_Wilshire Hills III_Central_R23_mm0114CAR.rvt

REFERENCE G-003 FOR GENERAL NOTES
REFERENCE A-200 FOR MATERIALS LEGEND

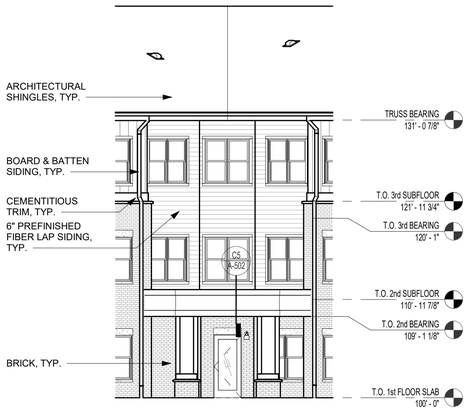

C1 REAR ELEVATION
1/8" = 1'-0"

B1 WEST ELEVATION
1/8" = 1'-0"

A1 SOUTH ELEVATION
1/8" = 1'-0"

10/27/2023 2:51:22 PM
C:\Revit Local Files\R23\23034_Wilshire Hills III_Central_R23_revit20.0CAR.rvt

PRINTS ISSUED
10/30/23 PERMIT SUBMITTAL

REVISIONS:

rosemann & ASSOCIATES P.C.
ARCHITECTURE
INTERIOR DESIGN
ENGINEERING
PLANNING
1526 Grand Boulevard
Kansas City, MO 64108-1404
p: 816.472.1448
w: www.rosemann.com
© 2023 Rosemann & Associates, P.C.
DENVER ▲ KANSAS CITY ▲ ST. LOUIS ▲ ATLANTA

STATE OF MISSOURI
DAVID EUGENE HENDRIKSE
NUMBER A-7365
REGISTERED ARCHITECT
10/30/23

WILSHIRE HILLS III
LEE'S SUMMIT, MISSOURI
MHDC - 22-057

SHEET TITLE
EXTERIOR ELEVATIONS

PROJECT NUMBER: 23034

SHEET NUMBER:

A-201

REFERENCE G-003 FOR GENERAL NOTES

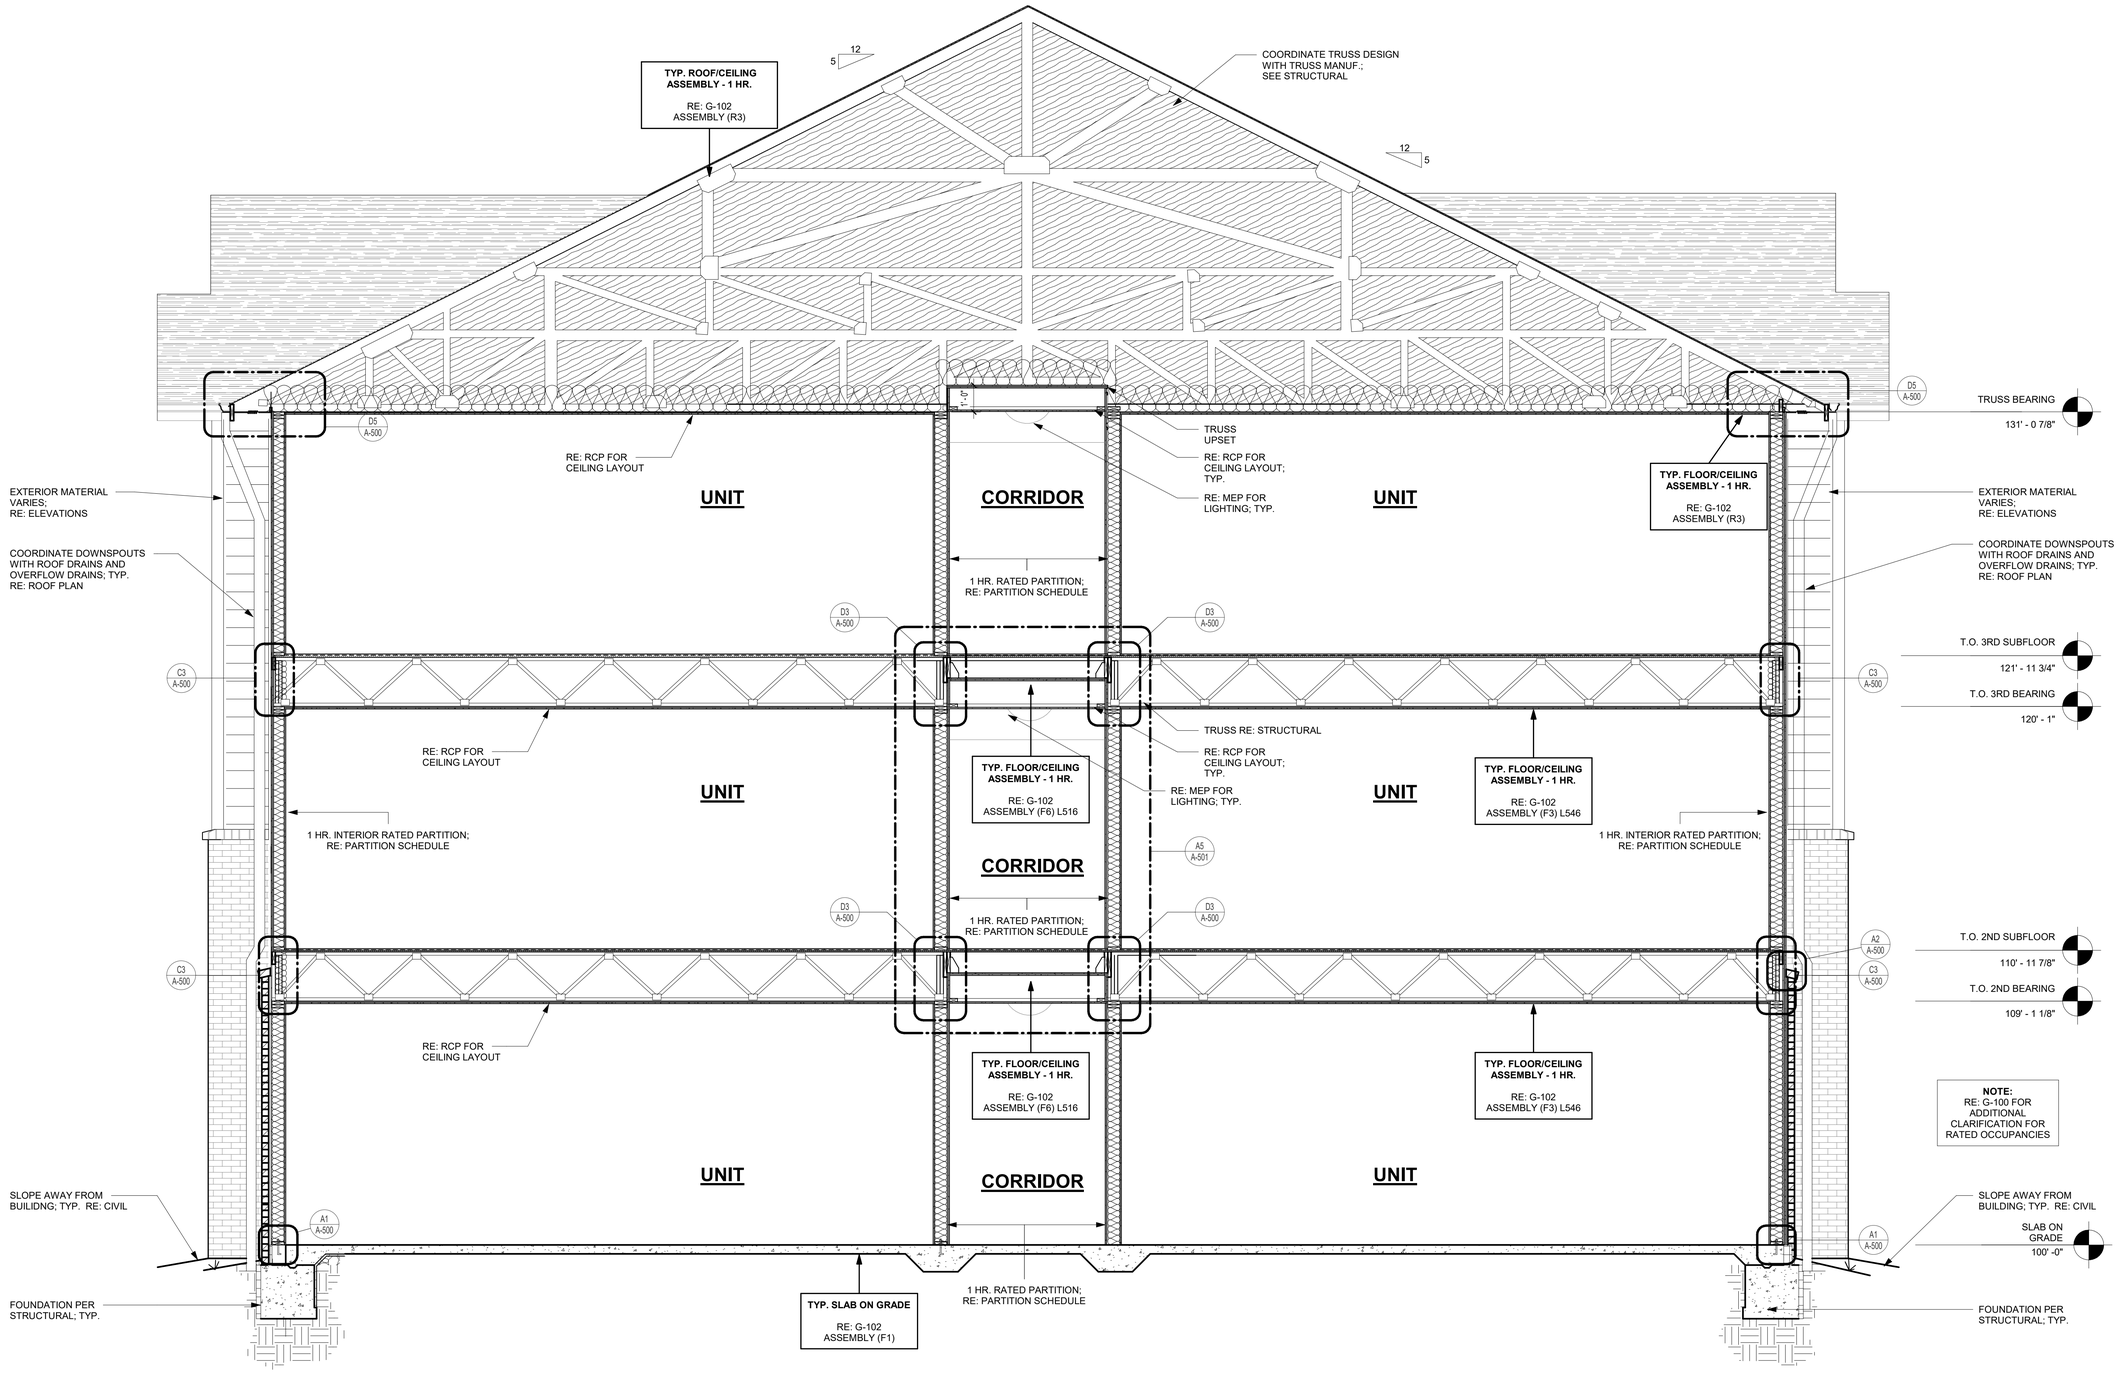

A1 OVERALL BUILDING SECTION
3/8" = 1'-0"

PRINTS ISSUED
10/30/23 PERMIT SUBMITTAL

REVISIONS:

rosemann & ASSOCIATES P.C.
ARCHITECTURE
INTERIOR DESIGN
ENGINEERING
PLANNING
1526 Grand Boulevard
Kansas City, MO 64108-1404
p: 816.472.1448
w: www.rosemann.com
© 2023 Rosemann & Associates, P.C.
DENVER ▲ KANSAS CITY ▲ ST. LOUIS ▲ ATLANTA

STATE OF MISSOURI
DAVID EUGENE HENDRIKSE
NUMBER A-7365
REGISTERED ARCHITECT
10/30/23

WILSHIRE HILLS III
LEE'S SUMMIT, MISSOURI
MHDC - 22-057

SHEET TITLE
OVERALL BUILDING SECTION

PROJECT NUMBER: 23034

SHEET NUMBER:

A-300

10/27/2023 2:51:34 PM
C:\Revit Local Data\23034_Wilshire Hills III_Central_R23_mmBTUCAR.rvt

REFERENCE G-003 FOR GENERAL NOTES

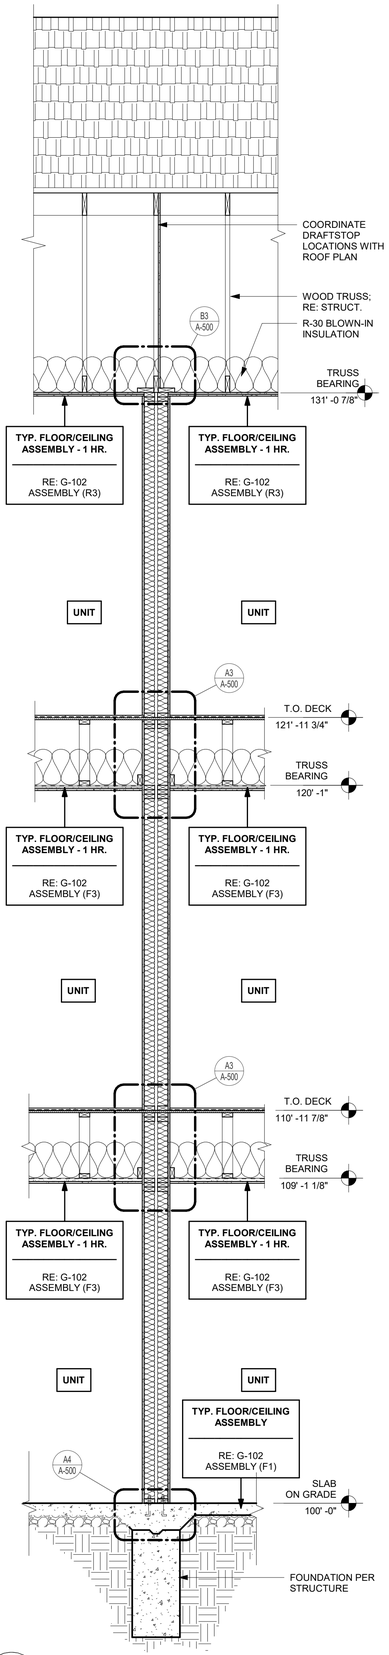

1 WALL SECTION - DEMISING WALL
1/2" = 1'-0"

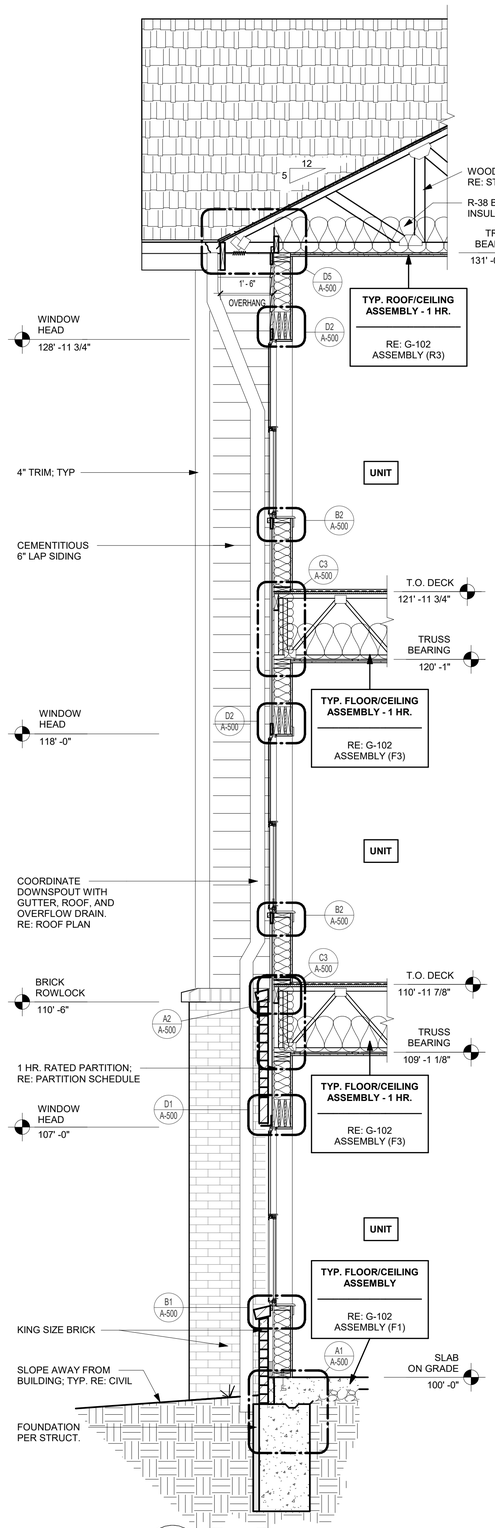

A2 WALL SECTION
1/2" = 1'-0"

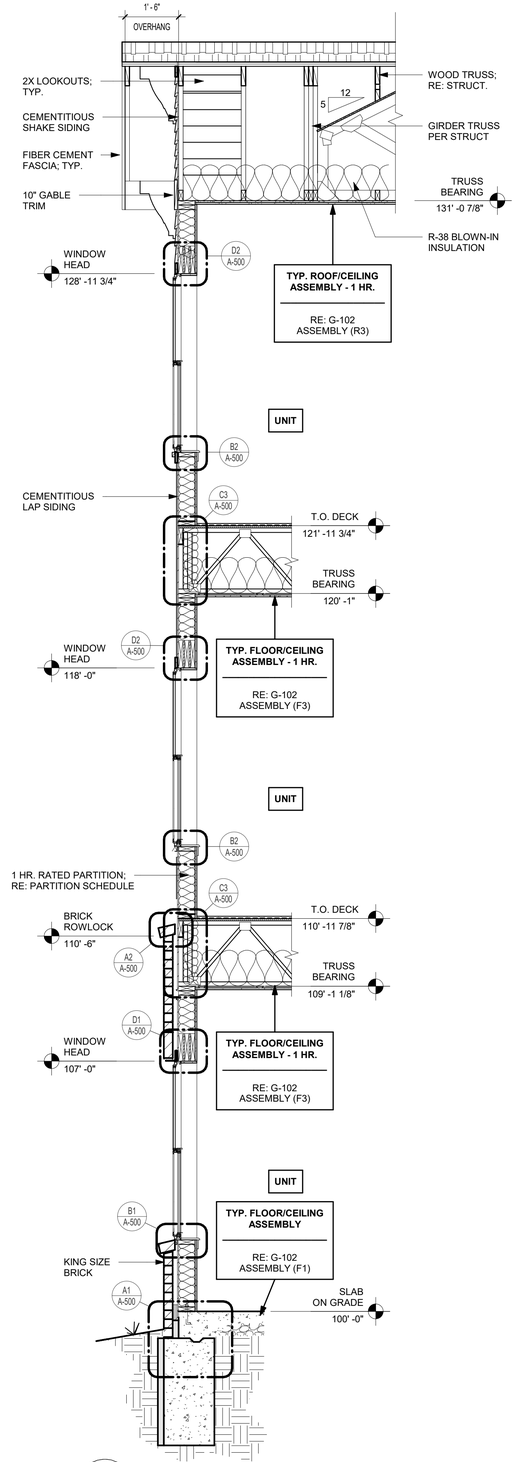

A1 WALL SECTION
1/2" = 1'-0"

PRINTS ISSUED
10/30/23 PERMIT SUBMITTAL

REVISIONS:

rosemann & ASSOCIATES P.C.
ARCHITECTURE
INTERIOR DESIGN
ENGINEERING
PLANNING
1526 Grand Boulevard
Kansas City, MO 64108-1404
p: 816.472.1448
w: www.rosemann.com
© 2023 Rosemann & Associates, P.C.
DENVER ▲ KANSAS CITY ▲ ST. LOUIS ▲ ATLANTA

STATE OF MISSOURI
DAVID EUGENE HENDRIKSE
NUMBER A-7365
REGISTERED ARCHITECT
10/30/23

WILSHIRE HILLS III

LEE'S SUMMIT, MISSOURI

MHDC - 22-057

SHEET TITLE
WALL SECTIONS

PROJECT NUMBER: 23034

SHEET NUMBER:

A-301

10/27/2023 4:14:05 PM
C:\Revit Local Cache\R23\23034_Wilshire Hills III_Central_R23_mvl8TUGAR.rvt

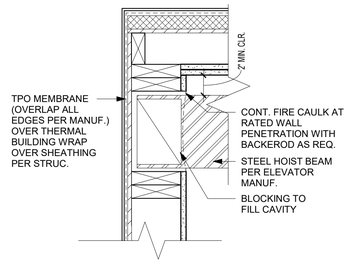

D5 HOIST BEAM DETAIL
1 1/2" = 1'-0"

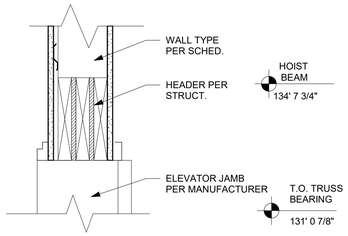

D4 ELEVATOR DOOR HEAD DETAIL
1 1/2" = 1'-0"

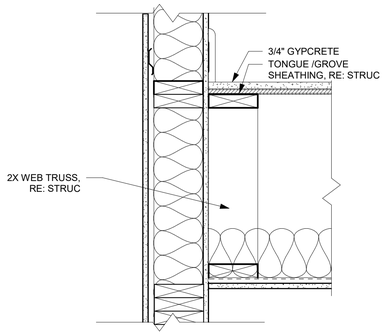

C5 ELEVATOR SHAFT DETAIL
1 1/2" = 1'-0"

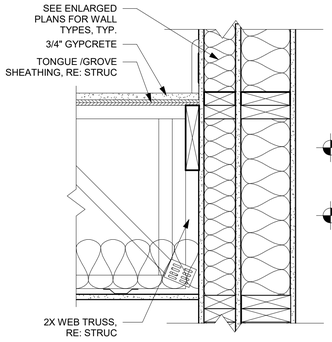

C4 ELEVATOR SHAFT DETAIL
1 1/2" = 1'-0"

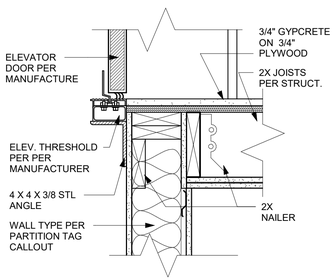

B5 ELEVATOR SHAFT @ THRESHOLD DETAIL
1 1/2" = 1'-0"

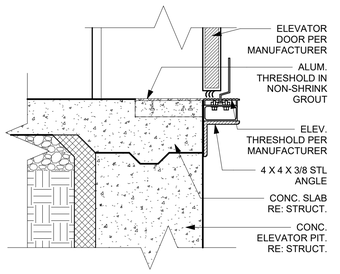

A5 ELEVATOR SHAFT THRESHOLD @ PIT
1 1/2" = 1'-0"

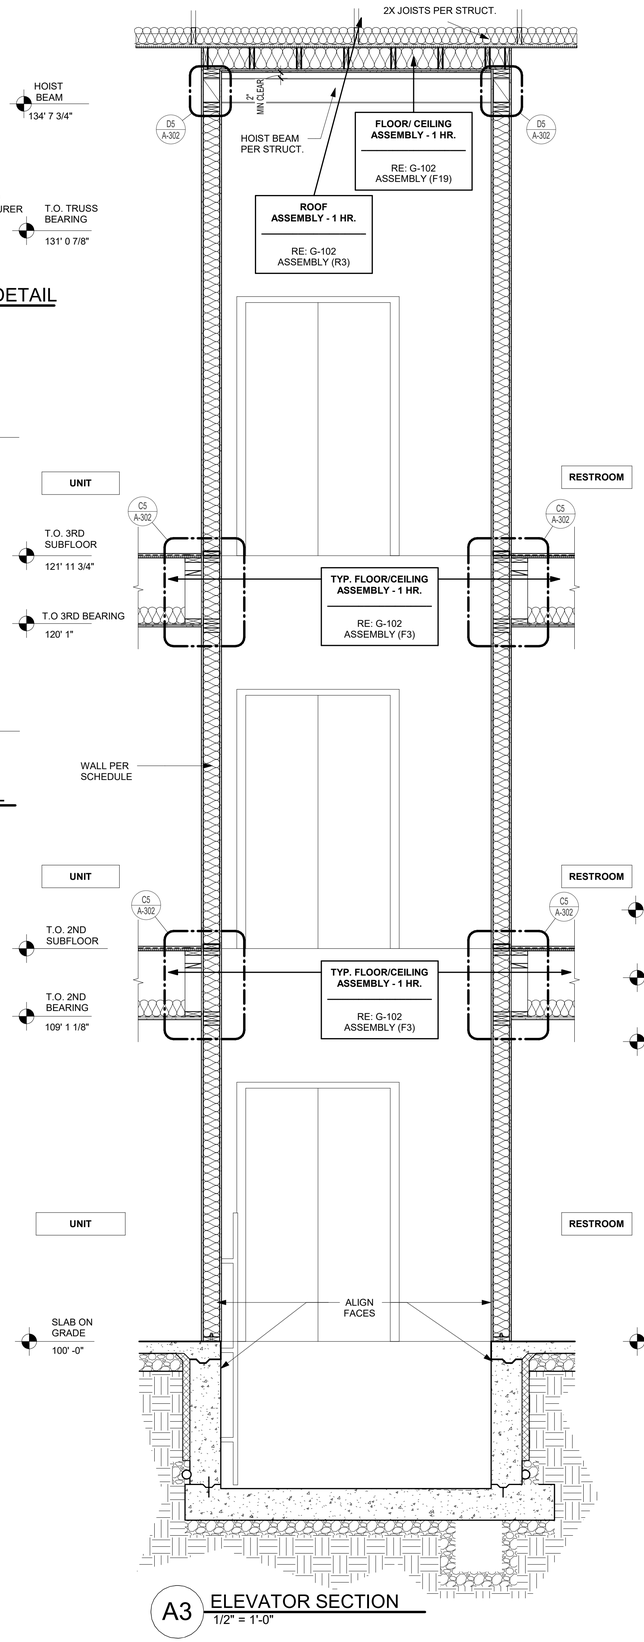

A3 ELEVATOR SECTION
1/2" = 1'-0"

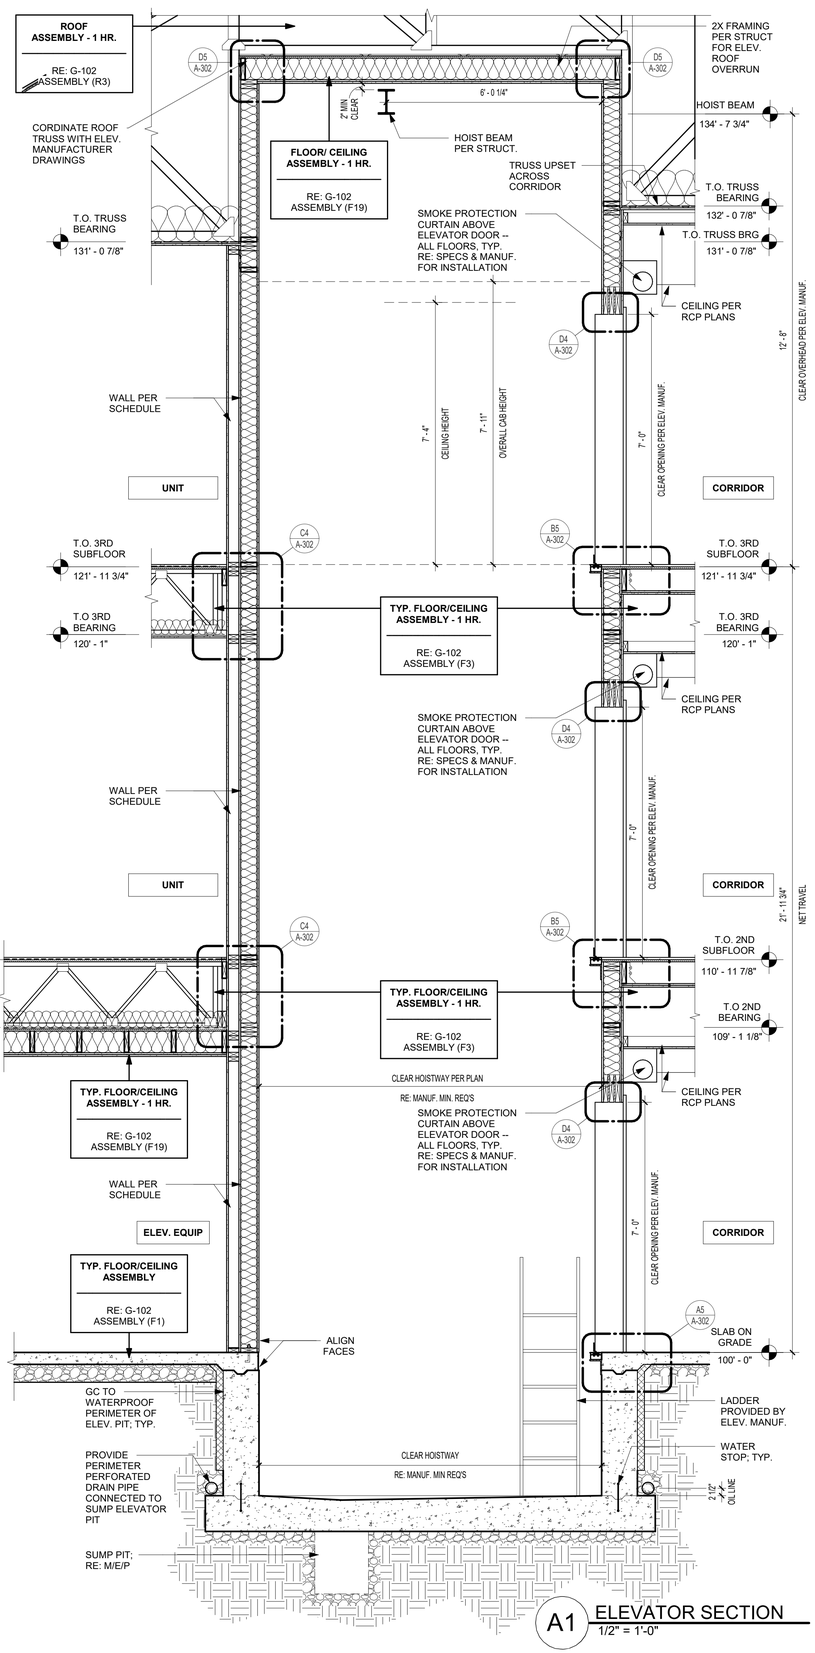

A1 ELEVATOR SECTION
1/2" = 1'-0"

PRINTS ISSUED
10/30/23 PERMIT SUBMITTAL

REVISIONS:

rosemann & ASSOCIATES P.C.
ARCHITECTURE
INTERIOR DESIGN
ENGINEERING
PLANNING
1526 Grand Boulevard
Kansas City, MO 64108-1404
p: 816.472.1448
w: www.rosemann.com
© 2023 Rosemann & Associates, P.C.
DENVER ▲ KANSAS CITY ▲ ST. LOUIS ▲ ATLANTA

STATE OF MISSOURI
DAVID EUGENE HENDRIKSE
NUMBER A-7365
REGISTERED ARCHITECT
10/30/23

WILSHIRE HILLS III

LEE'S SUMMIT, MISSOURI

MHDC - 22-057

SHEET TITLE
ELEVATOR SECTION & DETAILS

PROJECT NUMBER: 23034

SHEET NUMBER:

A-302

10/27/2023 3:41:29 PM
C:\Revit Local Files\R23\23034_Wilshire Hills III_Central_R23_mm5f1XCAR.rvt

REFERENCE G-003 FOR GENERAL NOTES

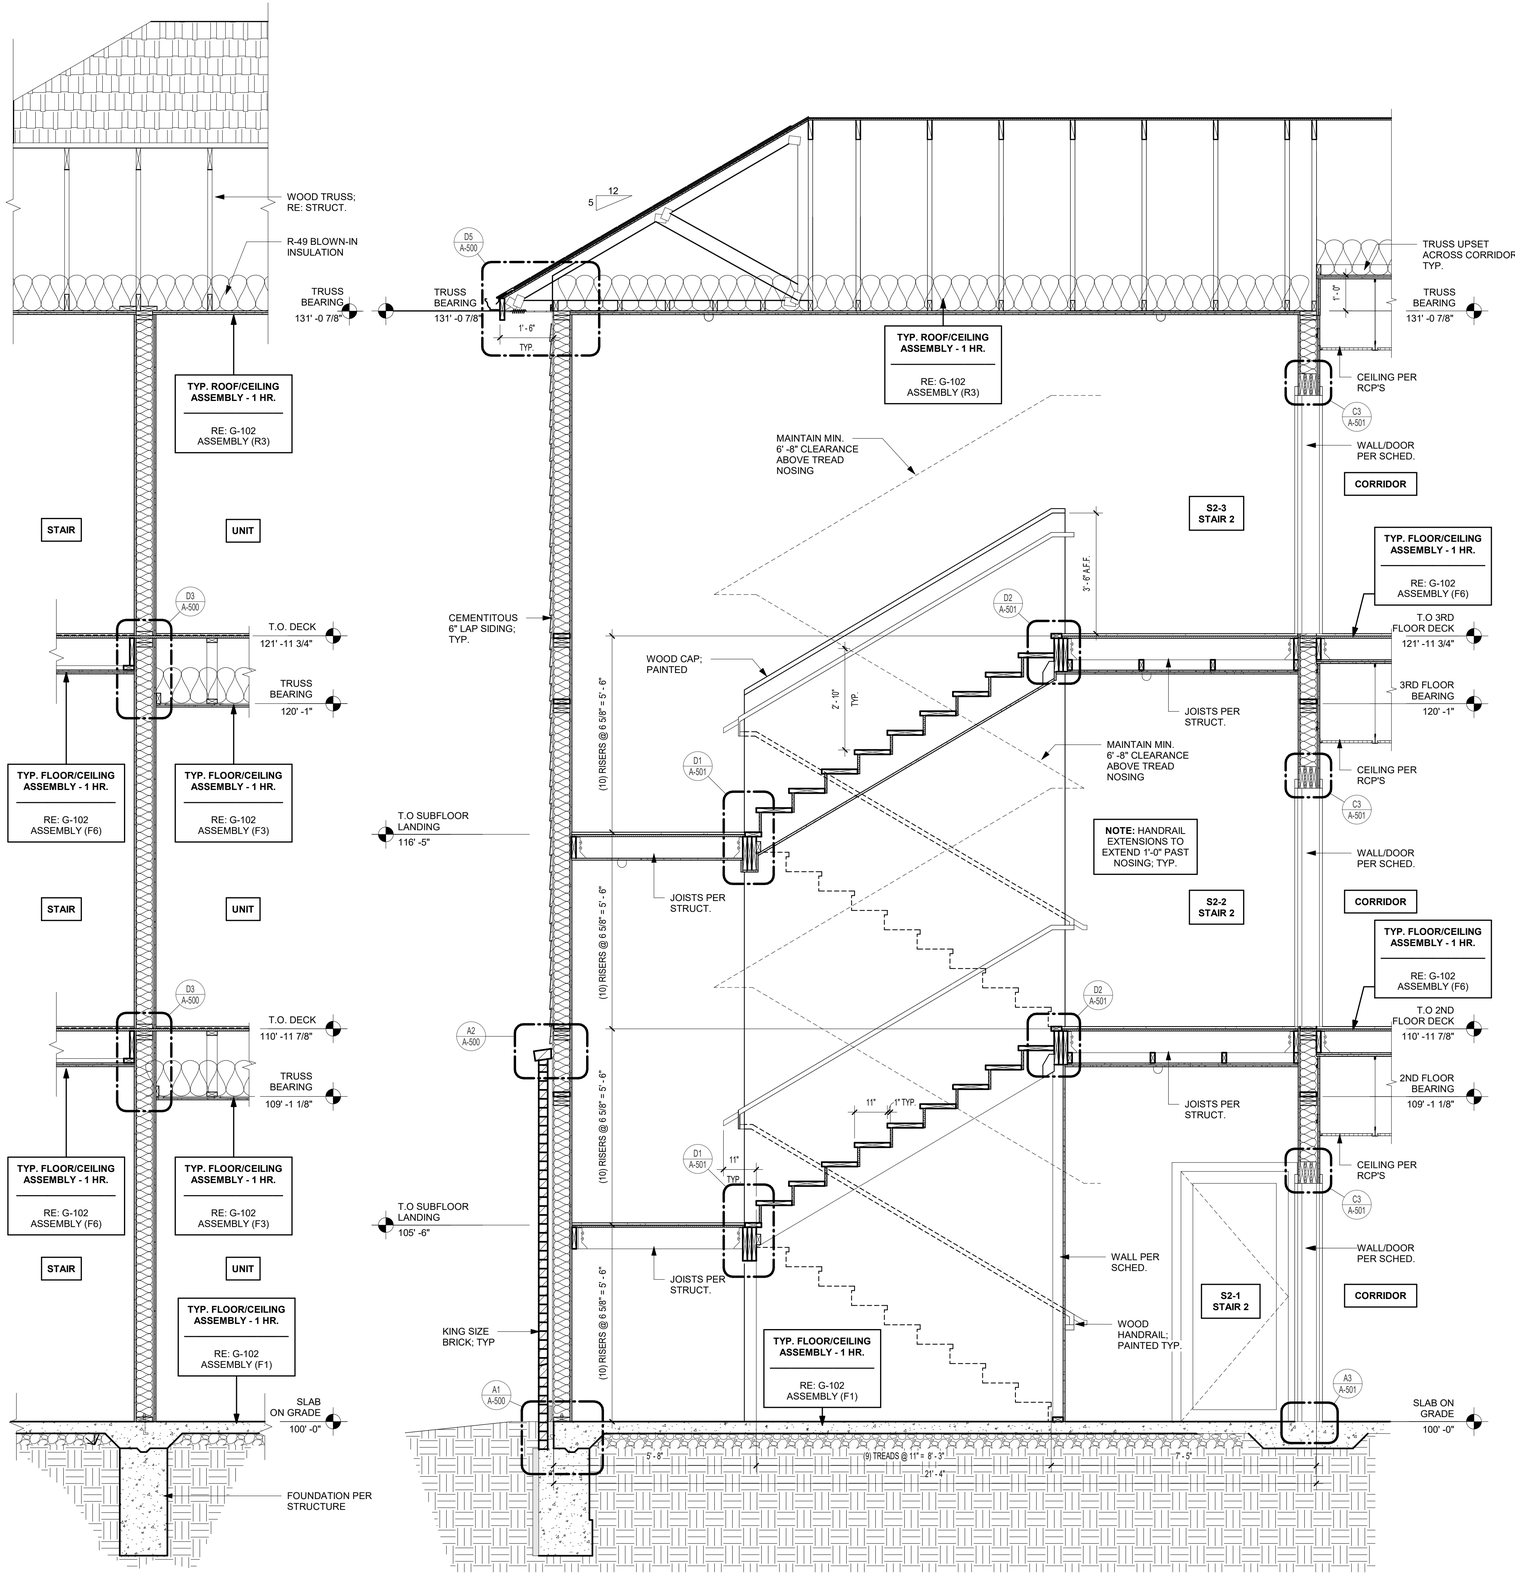

A5 STAIRWELL SECTION
1/2" = 1'-0"

A3 STAIR SECTION
1/2" = 1'-0"

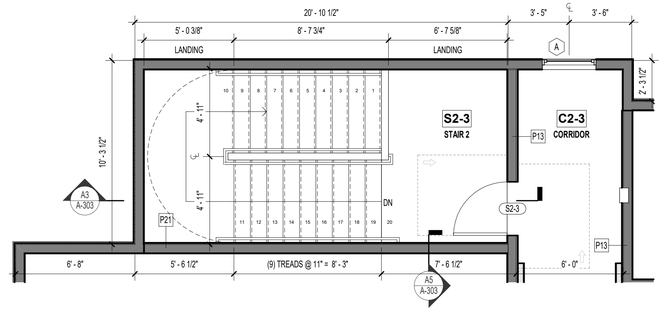

C1 3RD FLOOR STAIR PLAN
1/4" = 1'-0"

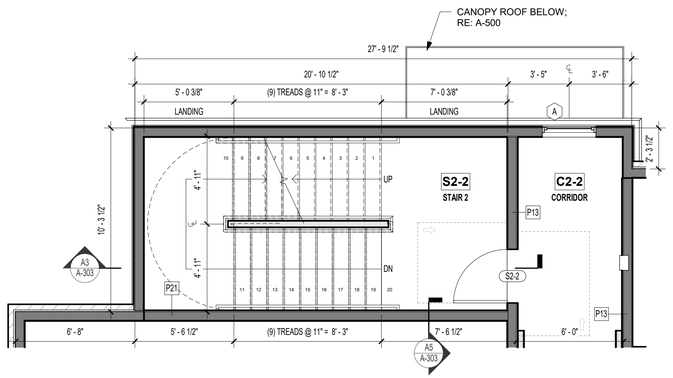

B1 2ND FLOOR STAIR PLAN
1/4" = 1'-0"

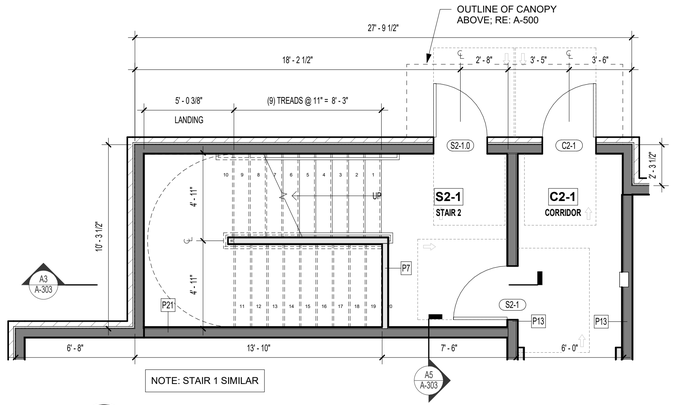

A1 1ST FLOOR STAIR PLAN
1/4" = 1'-0"

PRINTS ISSUED
10/30/23 PERMIT SUBMITTAL

REVISIONS:

rosemann & ASSOCIATES P.C.
ARCHITECTURE
INTERIOR DESIGN
ENGINEERING
PLANNING
1526 Grand Boulevard
Kansas City, MO 64108-1404
p: 816.472.1448
w: www.rosemann.com
© 2023 Rosemann & Associates, P.C.
DENVER ▲ KANSAS CITY ▲ ST. LOUIS ▲ ATLANTA

STATE OF MISSOURI
DAVID EUGENE HENDRIKSE
NUMBER A-7365
REGISTERED ARCHITECT
10/30/23

WILSHIRE HILLS III
LEE'S SUMMIT, MISSOURI
MHDC - 22-057

SHEET TITLE
STAIR SECTION & DETAILS

PROJECT NUMBER: 23034

SHEET NUMBER:

A-303

10/27/2023 2:51:32 PM
C:\Revit Local Cache\R2023\23034_Wilshire Hills III_Central_R23_mm911CAR.rvt

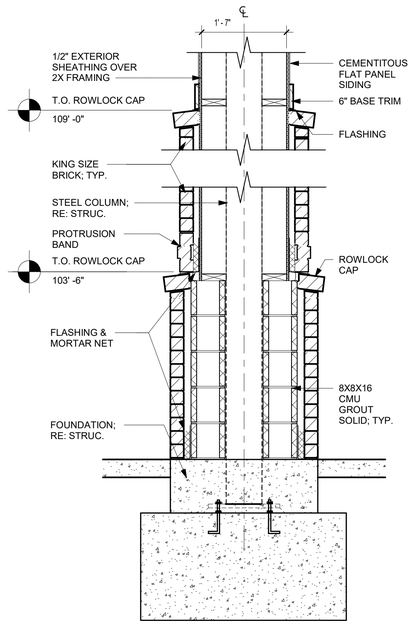

C5 CANOPY COLUMN SECTION DETAIL
3/4" = 1'-0"

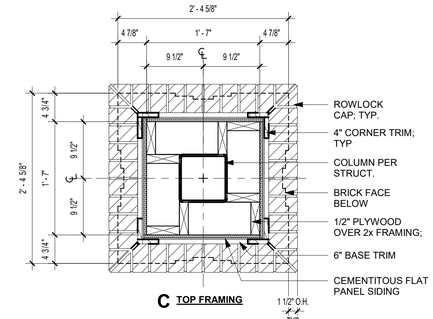

C TOP FRAMING

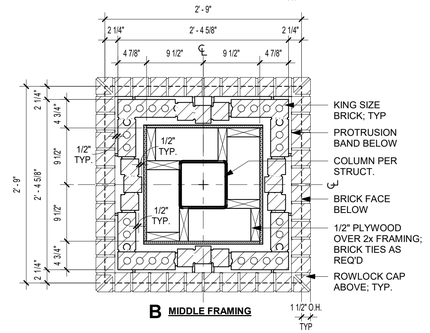

B MIDDLE FRAMING

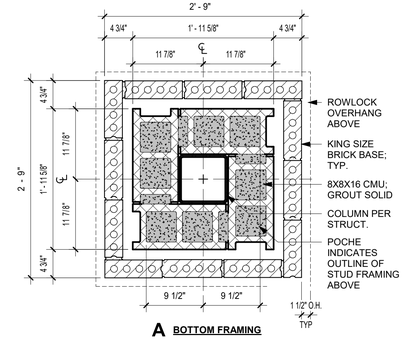

A BOTTOM FRAMING

C3 CANOPY COLUMN PLAN
1" = 1'-0"

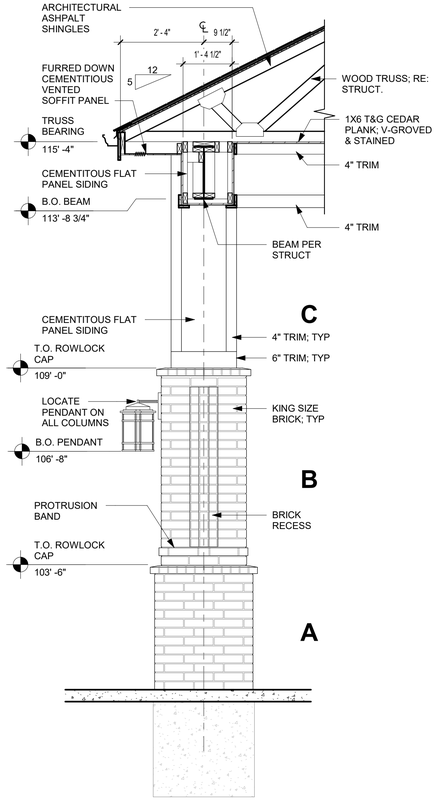

A5 CANOPY SECTION
1/2" = 1'-0"

A3 CANOPY SIDE ELEVATION
1/4" = 1'-0"

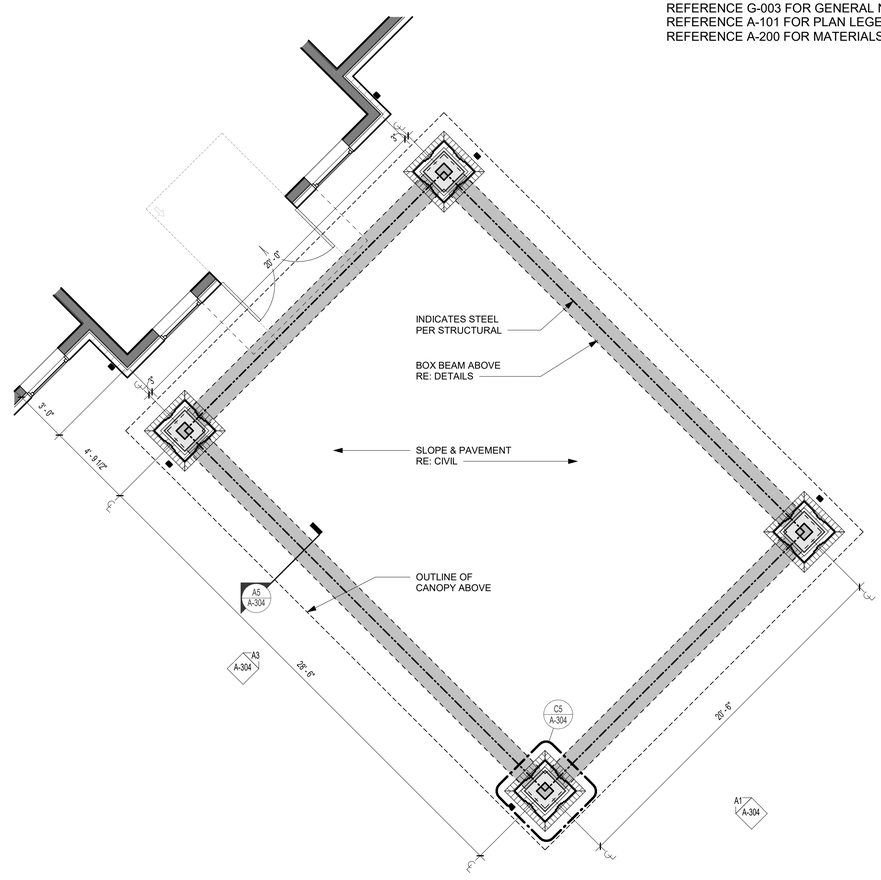

C1 CANOPY PLAN
1/4" = 1'-0"

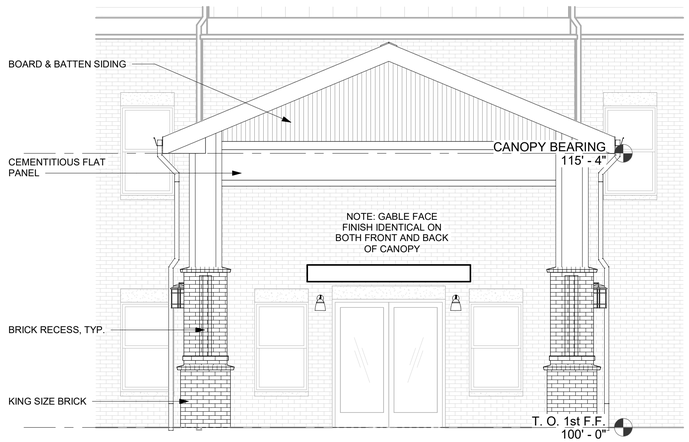

A1 CANOPY FRONT ELEVATION
1/4" = 1'-0"

rosemann & ASSOCIATES P.C.
ARCHITECTURE
INTERIOR DESIGN
ENGINEERING
PLANNING
1526 Grand Boulevard
Kansas City, MO 64108-1404
p: 816.472.1448
w: www.rosemann.com
© 2023 Rosemann & Associates, P.C.
DENVER ▲ KANSAS CITY ▲ ST. LOUIS ▲ ATLANTA

PRINTS ISSUED
10/30/23 PERMIT SUBMITTAL

REVISIONS:

STATE OF MISSOURI
DAVID EUGENE HENDRIKSE
NUMBER A-7365
REGISTERED ARCHITECT
10/30/23

WILSHIRE HILLS III

LEE'S SUMMIT, MISSOURI

MHDC - 22-057

SHEET TITLE
FRONT CANOPY PLAN / ELEV. / SECTION / & DETAILS

PROJECT NUMBER: 23034

SHEET NUMBER:

A-304

10/27/2023 2:51:36 PM
C:\Revit Local Cache\R2023\23034_Wilshire Hills III_Central_R23_wvn97UCAR.rvt

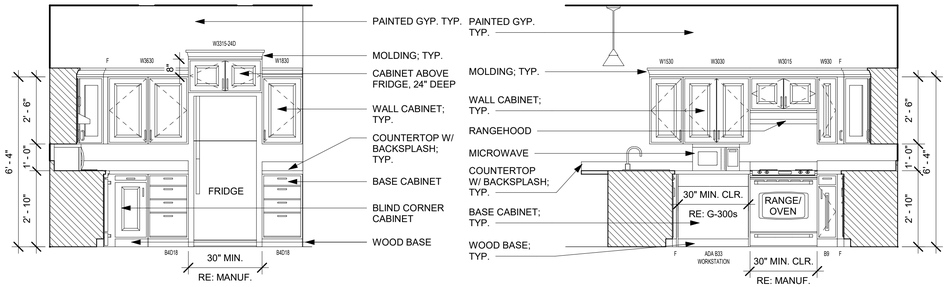

C5 ONE BED TYPE A KITCHEN ELEV. 1
3/8" = 1'-0"

C4 ONE BED TYPE A KITCHEN ELEV. 2
3/8" = 1'-0"

C3 ONE BED TYPE A KITCHEN ELEV. 3
3/8" = 1'-0"

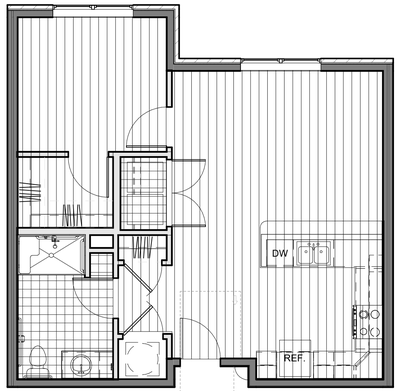

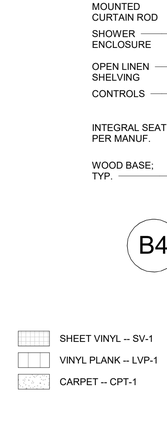

B5 ONE BEDROOM UNIT - TYPE A - FINISH PLAN
3/16" = 1'-0"

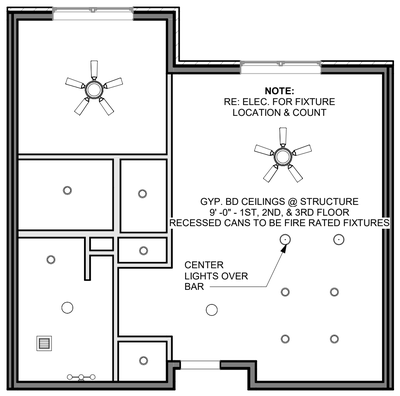

A5 ONE BEDROOM UNIT - TYPE A - FIRST FLOOR REFLECTED CEILING PLAN
3/16" = 1'-0"

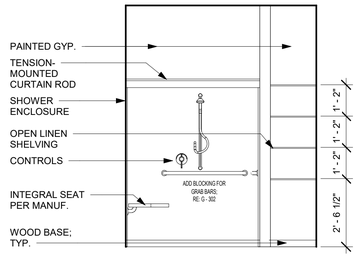

B4 ONE BED TYPE A BATH ELEV. 1
3/8" = 1'-0"

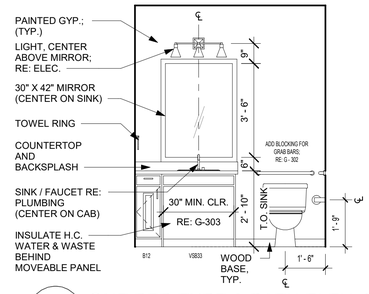

B3 ONE BED TYPE A BATH ELEV. 2
3/8" = 1'-0"

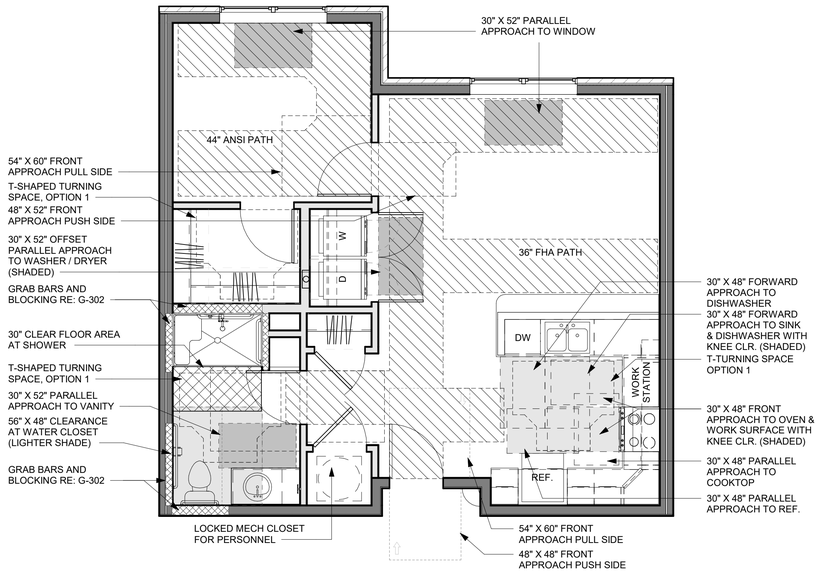

A3 ONE BEDROOM UNIT - TYPE A - CLEAR SPACE PLAN
1/4" = 1'-0"

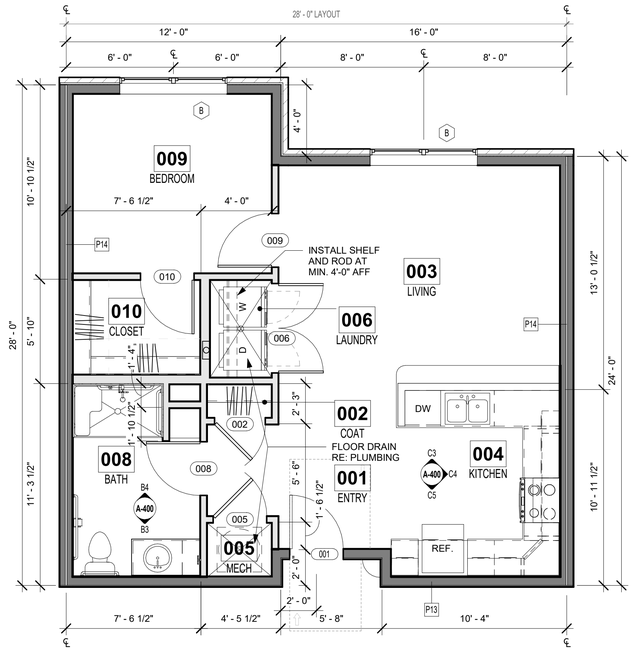

A1 ONE BEDROOM UNIT - TYPE A - FLOOR PLAN
1/4" = 1'-0"

REFERENCE G-003 FOR GENERAL NOTES
REFERENCE A-101 FOR PLAN LEGEND
REFERENCE A-120 FOR RCP LEGEND

DOOR TYPES

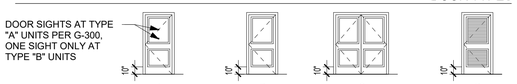

DOOR SCHEDULE - 1 BED UNITS

Mark	Width	Height	Thickness	Type Mark	Door Material	Door Finish	Frame Material	Frame Finish	Fire Rating	Comments	Hardware Group
001	3' - 0"	6' - 8"	0' - 1 3/4"	A	WD S.C.	PT-3	TIMELY MT-1	PT-3	20 MIN.	FACTORY KERF FOR SMOKE SEAL, FRAME READY FOR WOOD CASING	U1
002	2' - 10"	6' - 8"	0' - 1 3/8"	B	WD H.C.	PT-3	WD	PT-3			
005	3' - 0"	6' - 8"	0' - 1 3/8"	D	WD H.C.	PT-3	WD	PT-3			
006	5' - 0"	6' - 8"	0' - 1 3/8"	C	WD H.C.	PT-3	WD	PT-3			
008	3' - 0"	6' - 8"	0' - 1 3/8"	B	WD H.C.	PT-3	WD	PT-3			
009	3' - 0"	6' - 8"	0' - 1 3/8"	B	WD H.C.	PT-3	WD	PT-3			
010	3' - 0"	6' - 8"	0' - 1 3/8"	B	WD H.C.	PT-3	WD	PT-3			

ROOM FINISH SCHEDULE - 1 BED TYPE A UNITS

Number	Name	Floor Finish	Base Finish	Wall Finish	Ceiling Finish	Comments
001	ENTRY	LVP-1	WB-1, PT-3	PT-1	PT-2	
002	COAT	LVP-1	WB-1, PT-3	PT-1	PT-2	
003	LIVING	LVP-1	WB-1, PT-3	PT-1	PT-2	
004	KITCHEN	LVP-1	WB-1, PT-3	PT-1	PT-2	CABS. W/ PL COUNTER W/ SPLASH
005	MECH	--	--	--	--	
006	LAUNDRY	SV-1	WB-1, PT-3	PT-1	PT-2	
008	BATH	SV-1	WB-1, PT-3	PT-1	PT-2	CABS. W/ PL COUNTER W/ SPLASH
009	BEDROOM	LVP-1	WB-1, PT-3	PT-1	PT-2	
010	CLOSET	LVP-1	WB-1, PT-3	PT-1	PT-2	

UNIT FINISH LEGEND

CARPET:
CPT-1 MOHAWK PROPERTIES COLLECTION: BROADLOOM (SMARTSTRAND W/ NANOLOC), PM395 NEUTRAL SHIFT, #859 TWILIGHT JUNGLE

LUXURY VINYL PLANK:
LVP-1 MOHAWK REXFORD COLLECTION: 12MIL, RP811, #890 STURDY BROWN

SHEET VINYL:
SV-1 MOHAWK PORTICO COLLECTION: #592 COOL SANDS

BASE:
WB-1 WOOD BASE, FJ623, 9/16" X 3.25" COLONIAL, PT-3; WOOD SHOE MOLD, FJ129, 7/16" X 11/16" COLONIAL, PT-3

PAINT:
PT-1 SHERWIN WILLIAMS, SW 7044 AMAZING GRAY, EGGSHELL
PT-2 SHERWIN WILLIAMS, SW 7042 SHOJI WHITE, FLAT
PT-3 SHERWIN WILLIAMS, SW 7042 SHOJI WHITE, SEMI-GLOSS

PRINTS ISSUED
10/30/23 PERMIT SUBMITTAL

REVISIONS:

rosemann & ASSOCIATES P.C.
ARCHITECTURE
INTERIOR DESIGN
ENGINEERING
PLANNING
1526 Grand Boulevard
Kansas City, MO 64108-1404
p: 816.472.1448
w: www.rosemann.com
© 2023 Rosemann & Associates, P.C.
DENVER ▲ KANSAS CITY ▲ ST. LOUIS ▲ ATLANTA

STATE OF MISSOURI
DAVID EUGENE HENDRIKSE
NUMBER A-7365
REGISTERED ARCHITECT
10/30/23

WILSHIRE HILLS III
LEE'S SUMMIT, MISSOURI
MHDC - 22-057

SHEET TITLE
ONE BEDROOM UNIT PLAN - TYPE A

PROJECT NUMBER: 23034

SHEET NUMBER:

A-400

10/27/2023 2:51:49 PM
C:\Revit Local Cache\23034_Wilshire Hills III_Central_R23_revitTUCAR.rvt

REFERENCE G-003 FOR GENERAL NOTES
REFERENCE A-101 FOR PLAN LEGEND
REFERENCE A-120 FOR RCP LEGEND

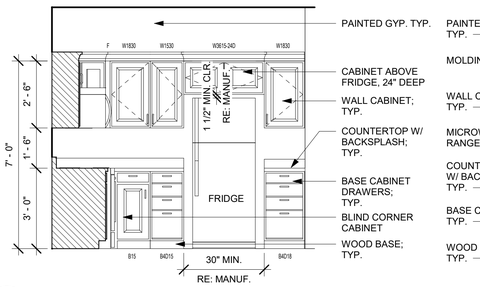

C5 ONE BED TYPE B KITCHEN ELEV. 1
3/8" = 1'-0"

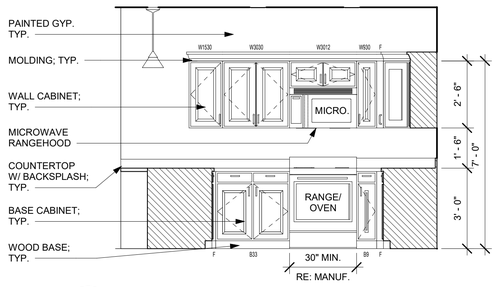

C4 ONE BED TYPE B KITCHEN ELEV. 2
3/8" = 1'-0"

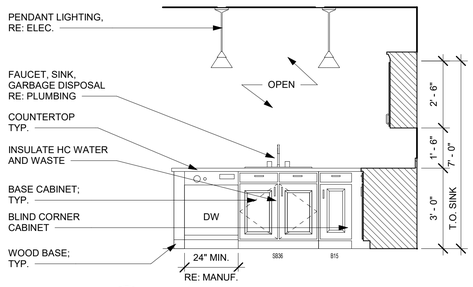

C3 ONE BED TYPE B KITCHEN ELEV. 3
3/8" = 1'-0"

DOOR TYPES

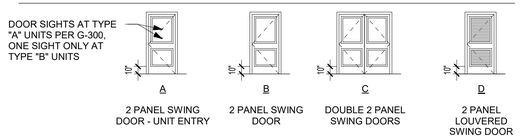

DOOR SCHEDULE - 1 BED UNITS

Mark	Width	Height	Thickness	Type Mark	Door Material	Door Finish	Frame Material	Frame Finish	Fire Rating	Comments	Hardware Group
001	3' - 0"	6' - 8"	0' - 1 3/4"	A	WD S.C.	PT-3	TIMELY MT-1	PT-3	20 MIN.	FACTORY KERF FOR SMOKE SEAL, FRAME READY FOR WOOD CASING	U1
002	2' - 10"	6' - 8"	0' - 1 3/8"	B	WD H.C.	PT-3	WD	PT-3			
005	3' - 0"	6' - 8"	0' - 1 3/8"	D	WD H.C.	PT-3	WD	PT-3			
006	5' - 0"	6' - 8"	0' - 1 3/8"	C	WD H.C.	PT-3	WD	PT-3			
008	3' - 0"	6' - 8"	0' - 1 3/8"	B	WD H.C.	PT-3	WD	PT-3			
009	3' - 0"	6' - 8"	0' - 1 3/8"	B	WD H.C.	PT-3	WD	PT-3			
010	3' - 0"	6' - 8"	0' - 1 3/8"	B	WD H.C.	PT-3	WD	PT-3			

ROOM FINISH SCHEDULE - 1 BED TYPE B UNITS

Number	Name	Floor Finish	Base Finish	Wall Finish	Ceiling Finish	Comments
001	ENTRY	LVP-1	WB-1, PT-3	PT-1	PT-2	
002	COAT	LVP-1	WB-1, PT-3	PT-1	PT-2	
003	LIVING	LVP-1	WB-1, PT-3	PT-1	PT-2	
004	KITCHEN	LVP-1	WB-1, PT-3	PT-1	PT-2	CABS. W/ PL COUNTER W/ SPLASH
005	MECH	--	--	--	--	
006	LAUNDRY	SV-1	WB-1, PT-3	PT-1	PT-2	
008	BATH	SV-1	WB-1, PT-3	PT-1	PT-2	CABS. W/ PL COUNTER W/ SPLASH
009	BEDROOM	CPT-1	WB-1, PT-3	PT-1	PT-2	
010	CLOSET	CPT-1	WB-1, PT-3	PT-1	PT-2	

UNIT FINISH LEGEND

CARPET:
CPT-1 MOHAWK PROPERTIES COLLECTION: BROADLOOM (SMARTSTRAND W/ NANOLOC), PM395 NEUTRAL SHIFT, #859 TWILIGHT JUNGLE

LUXURY VINYL PLANK:
LVP-1 MOHAWK REXFORD COLLECTION: 12MIL, RP811, #890 STURDY BROWN

SHEET VINYL:
SV-1 MOHAWK PORTICO COLLECTION: #592 COOL SANDS

BASE:
WB-1 WOOD BASE, FJ623, 9/16" X 3.25" COLONIAL, PT-3; WOOD SHOE MOLD, FJ129, 7/16" X 11/16" COLONIAL, PT-3

PAINT:
PT-1 SHERWIN WILLIAMS, SW 7044 AMAZING GRAY, EGGSHELL
PT-2 SHERWIN WILLIAMS, SW 7042 SHOJI WHITE, FLAT
PT-3 SHERWIN WILLIAMS, SW 7042 SHOJI WHITE, SEMI-GLOSS

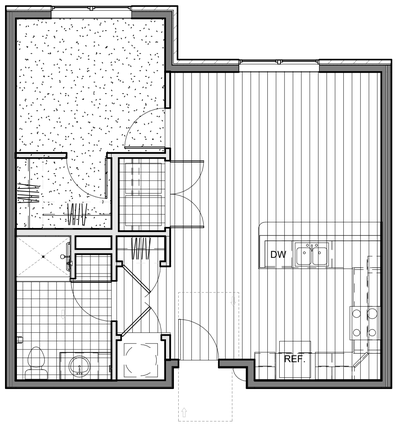

B5 ONE BEDROOM UNIT - TYPE B - FINISH PLAN
3/16" = 1'-0"

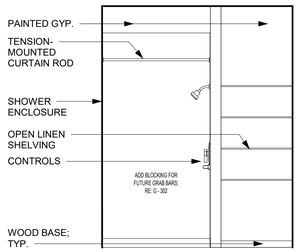

B4 ONE BED TYPE B BATH ELEV. 1
3/8" = 1'-0"

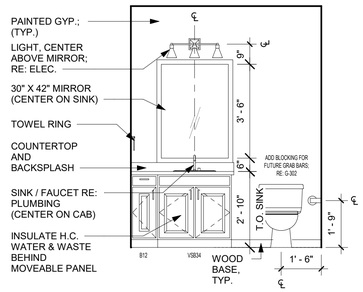

B3 ONE BED TYPE B BATH ELEV. 2
3/8" = 1'-0"

SHEET VINYL -- SV-1
VINYL PLANK -- LVP-1
CARPET -- CPT-1

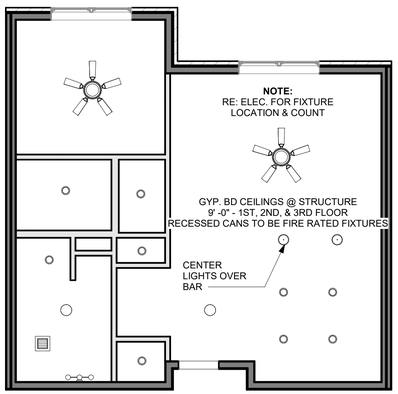

A5 ONE BEDROOM UNIT - TYPE B - REFLECTED CEILING PLAN
3/16" = 1'-0"

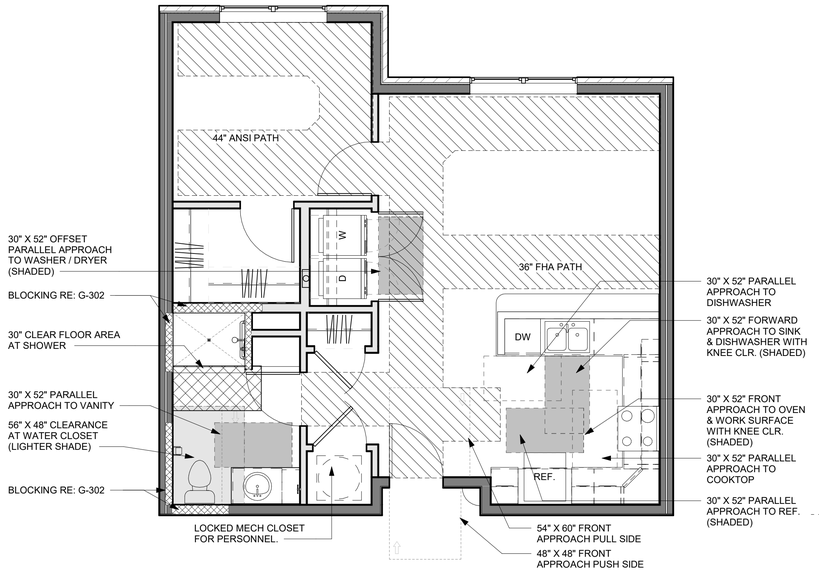

A3 ONE BEDROOM UNIT - TYPE B - CLEAR SPACE PLAN
1/4" = 1'-0"

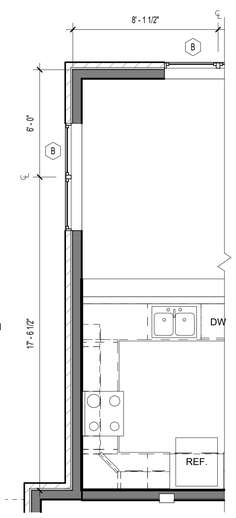

A2 ONE BEDROOM UNIT - END UNIT
1/4" = 1'-0"

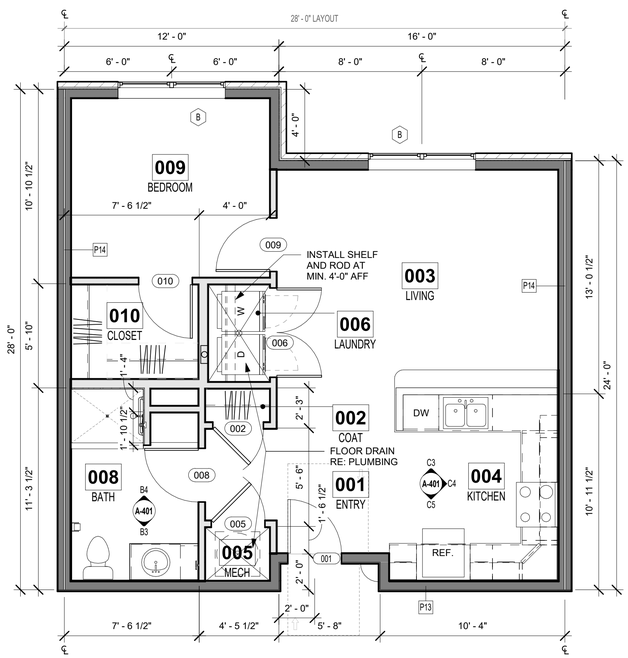

A1 ONE BEDROOM UNIT - TYPE B - FLOOR PLAN
1/4" = 1'-0"

PRINTS ISSUED
10/30/23 PERMIT SUBMITTAL

REVISIONS:

rosemann & ASSOCIATES P.C.
ARCHITECTURE
INTERIOR DESIGN
ENGINEERING
PLANNING
1526 Grand Boulevard
Kansas City, MO 64108-1404
p: 816.472.1448
w: www.rosemann.com
© 2023 Rosemann & Associates, P.C.
DENVER ▲ KANSAS CITY ▲ ST. LOUIS ▲ ATLANTA

STATE OF MISSOURI
DAVID EUGENE HENDRIKSE
NUMBER A-7365
REGISTERED ARCHITECT
10/30/23

WILSHIRE HILLS III
LEE'S SUMMIT, MISSOURI
MHDC - 22-057

SHEET TITLE
ONE BEDROOM UNIT PLAN - TYPE B

PROJECT NUMBER: 23034

SHEET NUMBER:

A-401

10/27/2023 2:52:03 PM
C:\Revit Local Cache\R2023\23034_Wilshire Hills III_Central_R23_revitTGCAR.rvt

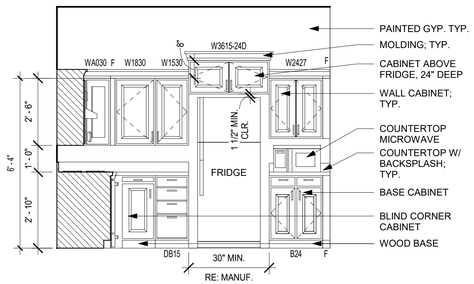

D5 TWO BED TYPE A KITCHEN ELEV. 1
3/8" = 1'-0"

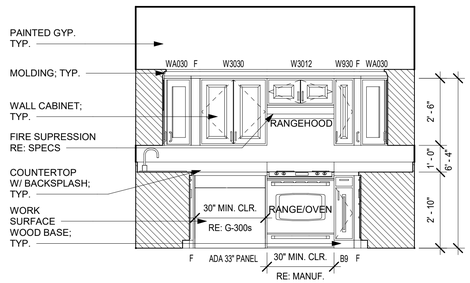

D4 TWO BED TYPE A KITCHEN ELEV. 2
3/8" = 1'-0"

ROOM FINISH SCHEDULE - 2 BED TYPE A UNITS						
Number	Name	Floor Finish	Base Finish	Wall Finish	Ceiling Finish	Comments
001	ENTRY	LVP-1	WB-1, PT-3	PT-1	PT-2	
002	CLOSET	LVP-1	WB-1, PT-3	PT-1	PT-2	
003	LIVING	LVP-1	WB-1, PT-3	PT-1	PT-2	
004	KITCHEN	LVP-1	WB-1, PT-3	PT-1	PT-2	CABS. W/ PL COUNTER W/ SPLASH
005	MECH	--	--	--	--	
006	LAUNDRY	LVP-1	WB-1, PT-3	PT-1	PT-2	
008	BATH	SV-1	WB-1, PT-3	PT-1	PT-2	CABS. W/ PL COUNTER W/ SPLASH
009	BEDROOM	LVP-1	WB-1, PT-3	PT-1	PT-2	
010	CLOSET	LVP-1	WB-1, PT-3	PT-1	PT-2	
012	BEDROOM	LVP-1	WB-1, PT-3	PT-1	PT-2	
013	CLOSET	LVP-1	WB-1, PT-3	PT-1	PT-2	
014	PANTRY	LVP-1	WB-1, PT-3	PT-1	PT-2	

REFERENCE G-003 FOR GENERAL NOTES
REFERENCE A-101 FOR PLAN LEGEND
REFERENCE A-120 FOR RCP LEGEND

DOOR SCHEDULE - 2 BED UNITS										
Mark	Width	Height	Thickness	Type Mark	Door Material	Door Finish	Frame Material	Frame Finish	Fire Rating	Comments	Hardware Group
001	3' - 0"	6' - 8"	0' - 1 3/4"	A	WD S.C.	PT-3	TIMELY MT-1	PT-3	20 MIN.	FACTORY KERF FOR SMOKE SEAL, FRAME READY FOR WOOD CASING	U1
002	2' - 8"	6' - 8"	0' - 1 3/8"	B	WD H.C.	PT-3	WD	PT-3			
005	3' - 0"	6' - 8"	0' - 1 3/8"	D	WD H.C.	PT-3	WD	PT-3			
006	5' - 0"	6' - 8"	0' - 1 3/8"	C	WD H.C.	PT-3	WD	PT-3			
008	3' - 0"	6' - 8"	0' - 1 3/8"	B	WD H.C.	PT-3	WD	PT-3			
009	3' - 0"	6' - 8"	0' - 1 3/8"	B	WD H.C.	PT-3	WD	PT-3			
010	4' - 0"	6' - 8"	0' - 1 3/8"	C	WD H.C.	PT-3	WD	PT-3			
012	3' - 0"	6' - 8"	0' - 1 3/8"	B	WD H.C.	PT-3	WD	PT-3			
013	4' - 0"	6' - 8"	0' - 1 3/8"	C	WD H.C.	PT-3	WD	PT-3			
014	2' - 8"	6' - 8"	0' - 1 3/8"	B	WD H.C.	PT-3	WD	PT-3			

PRINTS ISSUED
10/30/23 PERMIT SUBMITTAL

REVISIONS:

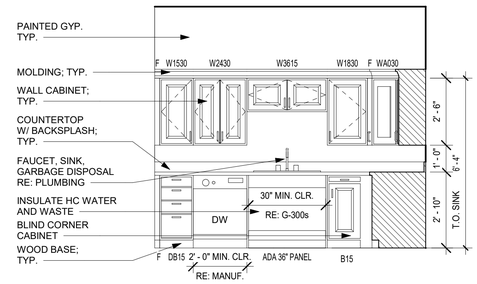

C5 TWO BED TYPE A KITCHEN ELEV. 3
3/8" = 1'-0"

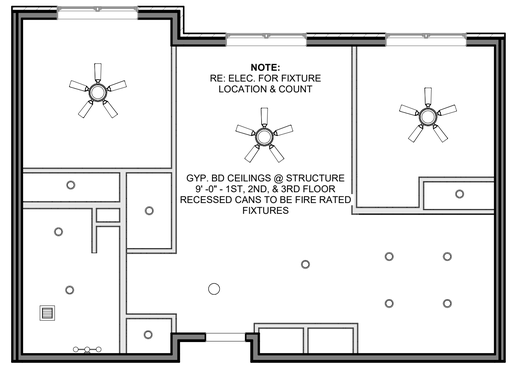

C3 TWO BEDROOM UNIT - TYPE A - REFLECTED CEILING PLAN
3/16" = 1'-0"

SHEET VINYL -- SV-1
VINYL PLANK -- LVP-1
CARPET -- CPT-1

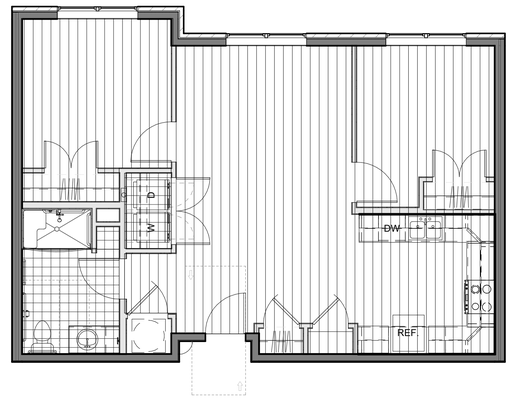

C1 TWO BEDROOM UNIT - TYPE A - FINISH PLAN
3/16" = 1'-0"

DOOR TYPES

DOOR SIGHTS AT TYPE "A" UNITS PER G-300, ONE SIGHT ONLY AT TYPE "B" UNITS

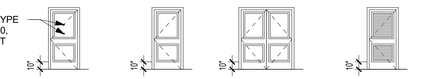

2 PANEL SWING DOOR - UNIT ENTRY | 2 PANEL SWING DOOR | DOUBLE 2 PANEL SWING DOORS | 2 PANEL LOUVERED SWING DOOR

UNIT FINISH LEGEND

CARPET:
CPT-1 MOHAWK PROPERTIES COLLECTION: BROADLOOM (SMARTSTRAND W/ NANOLOC), PM395 NEUTRAL SHIFT, #859 TWILIGHT JUNGLE

LUXURY VINYL PLANK:
LVP-1 MOHAWK REXFORD COLLECTION: 12MIL, RP811, #890 STURDY BROWN

SHEET VINYL:
SV-1 MOHAWK PORTICO COLLECTION: #592 COOL SANDS

BASE:
WB-1 WOOD BASE, FJ623, 9/16" X 3.25" COLONIAL, PT-3; WOOD SHOE MOLD, FJ129, 7/16" X 11/16" COLONIAL, PT-3

PAINT:
PT-1 SHERWIN WILLIAMS, SW 7044 AMAZING GRAY, EGGSHELL
PT-2 SHERWIN WILLIAMS, SW 7042 SHOJI WHITE, FLAT
PT-3 SHERWIN WILLIAMS, SW 7042 SHOJI WHITE, SEMI-GLOSS

rosemann & ASSOCIATES P.C.
ARCHITECTURE
INTERIOR DESIGN
ENGINEERING
PLANNING
1526 Grand Boulevard
Kansas City, MO 64108-1404
p: 816.472.1448
w: www.rosemann.com
© 2023 Rosemann & Associates, P.C.
DENVER ▲ KANSAS CITY ▲ ST. LOUIS ▲ ATLANTA

STATE OF MISSOURI
DAVID EUGENE HENDRIKSE
NUMBER A-7365
REGISTERED ARCHITECT
10/30/23

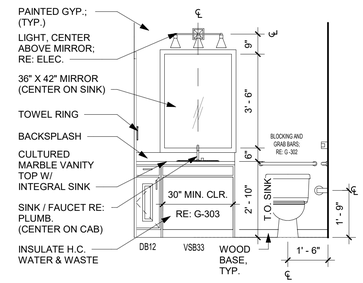

B5 TWO BED TYPE A BATH ELEV. 2
3/8" = 1'-0"

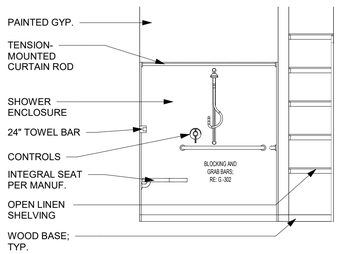

A5 TWO BED TYPE A BATH ELEV. 1
3/8" = 1'-0"

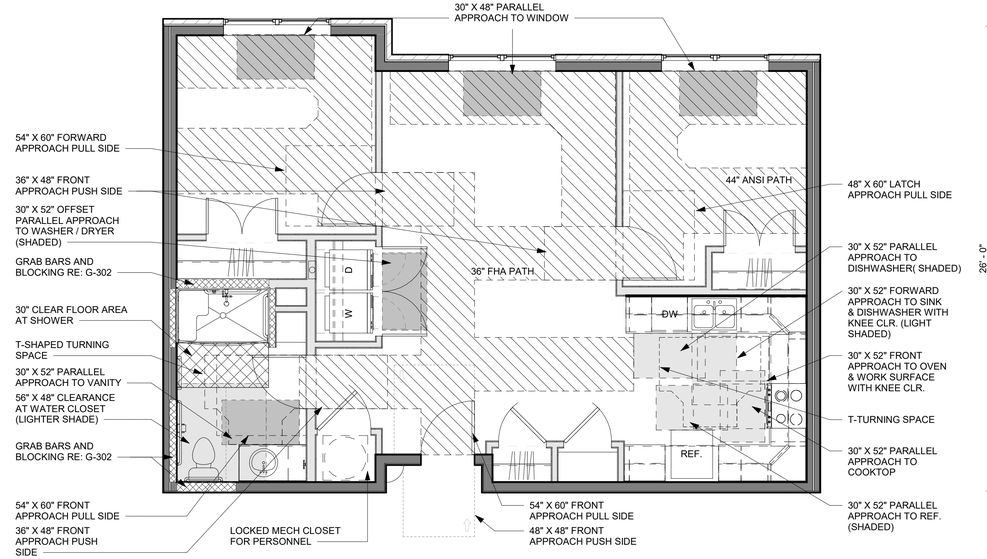

A3 TWO BEDROOM UNIT - TYPE A - CLEAR SPACE PLAN
1/4" = 1'-0"

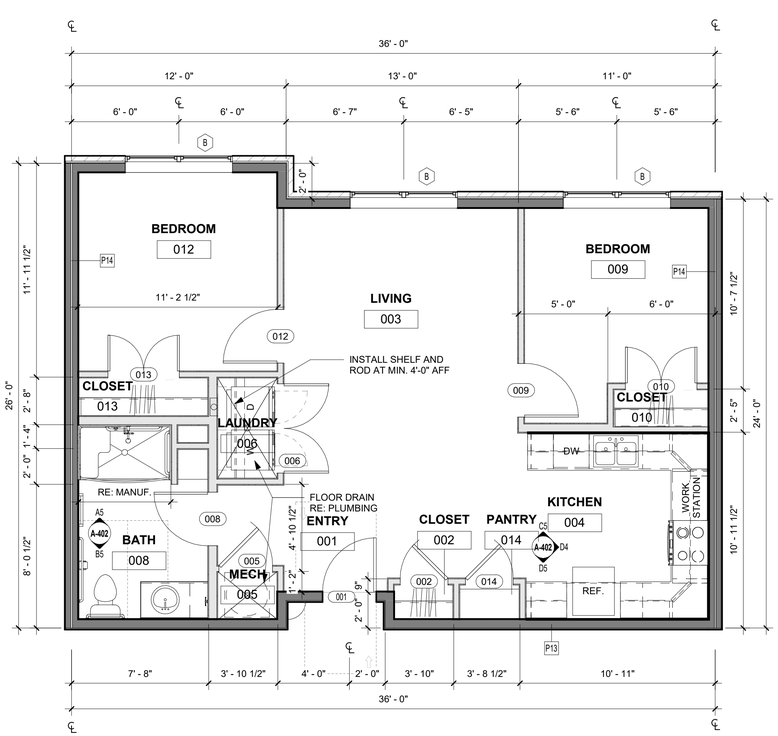

A1 TWO BEDROOM UNIT - TYPE A - FLOOR PLAN
1/4" = 1'-0"

WILSHIRE HILLS III
LEE'S SUMMIT, MISSOURI
MHDC - 22-057

SHEET TITLE
TWO BEDROOM UNIT PLAN - TYPE A

PROJECT NUMBER: 23034

SHEET NUMBER:

A-402

10/27/2023 2:52:3 PM
C:\Revit Local Cache\23034_Wilshire Hills III_Central_R23_zwv0TrUCAR.rvt

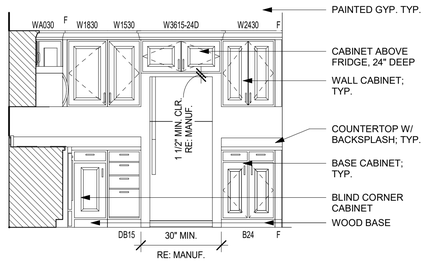

D5 TWO BED TYPE B KITCHEN ELEV. 1
3/8" = 1'-0"

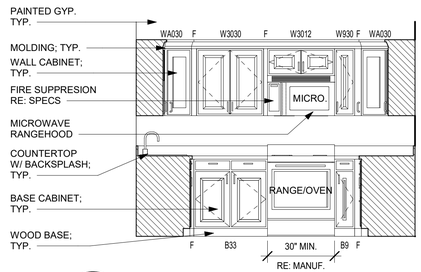

D4 TWO BED TYPE B KITCHEN ELEV. 2
3/8" = 1'-0"

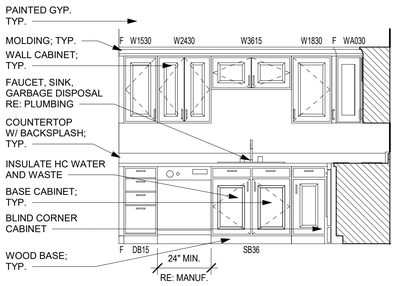

C5 TWO BED TYPE B KITCHEN ELEV. 3
3/8" = 1'-0"

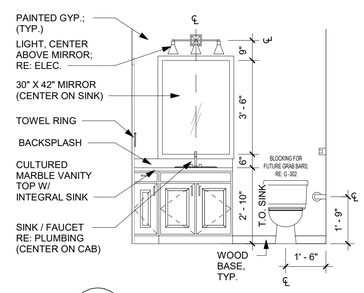

C4 TWO BED TYPE B BATH ELEV. 2
3/8" = 1'-0"

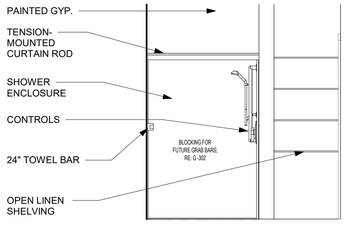

B5 TWO BED TYPE B BATH ELEV. 1
3/8" = 1'-0"

UNIT FINISH LEGEND

CARPET:
CPT-1 MOHAWK PROPERTIES COLLECTION: BROADLOOM (SMARTSTRAND W/ NANOLOC), PM395 NEUTRAL SHIFT, #859 TWILIGHT JUNGLE

LUXURY VINYL PLANK:
LVP-1 MOHAWK REXFORD COLLECTION: 12MIL, RP811, #890 STURDY BROWN

SHEET VINYL:
SV-1 MOHAWK PORTICO COLLECTION: #592 COOL SANDS

BASE:
WB-1 WOOD BASE, FJ623, 9/16" X 3.25" COLONIAL, PT-3; WOOD SHOE MOLD, FJ129, 7/16" X 11/16" COLONIAL, PT-3

PAINT:
PT-1 SHERWIN WILLIAMS, SW 7044 AMAZING GRAY, EGGSHELL
PT-2 SHERWIN WILLIAMS, SW 7042 SHOJI WHITE, FLAT
PT-3 SHERWIN WILLIAMS, SW 7042 SHOJI WHITE, SEMI-GLOSS

ROOM FINISH SCHEDULE - 2 BED TYPE B UNITS

Number	Name	Floor Finish	Base Finish	Wall Finish	Ceiling Finish	Comments
001	ENTRY	LVP-1	WB-1, PT-3	PT-1	PT-2	
002	CLOSET	LVP-1	WB-1, PT-3	PT-1	PT-2	
003	LIVING	LVP-1	WB-1, PT-3	PT-1	PT-2	
004	KITCHEN	LVP-1	WB-1, PT-3	PT-1	PT-2	CABS. W/ PL COUNTER W/ SPLASH
005	MECH	--	--	--	--	
006	LAUNDRY	SV-1	WB-1, PT-3	PT-1	PT-2	
008	BATH	SV-1	WB-1, PT-3	PT-1	PT-2	CABS. W/ PL COUNTER W/ SPLASH
009	BEDROOM	CPT-1	WB-1, PT-3	PT-1	PT-2	
010	CLOSET	CPT-1	WB-1, PT-3	PT-1	PT-2	
012	BEDROOM	CPT-1	WB-1, PT-3	PT-1	PT-2	
013	CLOSET	CPT-1	WB-1, PT-3	PT-1	PT-2	
014	PANTRY	LVP-1	WB-1, PT-3	PT-1	PT-2	

REFERENCE G-003 FOR GENERAL NOTES
REFERENCE A-101 FOR PLAN LEGEND
REFERENCE A-120 FOR RCP LEGEND

DOOR SCHEDULE - 2 BED UNITS

Mark	Width	Height	Thickness	Type Mark	Door Material	Door Finish	Frame Material	Frame Finish	Fire Rating	Comments	Hardware Group
001	3' - 0"	6' - 8"	0' - 1 3/4"	A	WD S.C.	PT-3	TIMELY MT-1	PT-3	20 MIN.	FACTORY KERF FOR SMOKE SEAL, FRAME READY FOR WOOD CASING	U1
002	2' - 8"	6' - 8"	0' - 1 3/8"	B	WD H.C.	PT-3	WD	PT-3			
005	3' - 0"	6' - 8"	0' - 1 3/8"	D	WD H.C.	PT-3	WD	PT-3			
006	5' - 0"	6' - 8"	0' - 1 3/8"	C	WD H.C.	PT-3	WD	PT-3			
008	3' - 0"	6' - 8"	0' - 1 3/8"	B	WD H.C.	PT-3	WD	PT-3			
009	3' - 0"	6' - 8"	0' - 1 3/8"	B	WD H.C.	PT-3	WD	PT-3			
010	4' - 0"	6' - 8"	0' - 1 3/8"	C	WD H.C.	PT-3	WD	PT-3			
012	3' - 0"	6' - 8"	0' - 1 3/8"	B	WD H.C.	PT-3	WD	PT-3			
013	4' - 0"	6' - 8"	0' - 1 3/8"	C	WD H.C.	PT-3	WD	PT-3			
014	2' - 8"	6' - 8"	0' - 1 3/8"	B	WD H.C.	PT-3	WD	PT-3			

DOOR TYPES

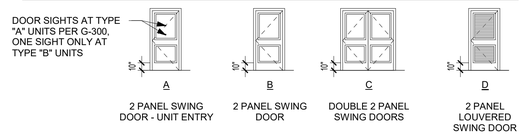

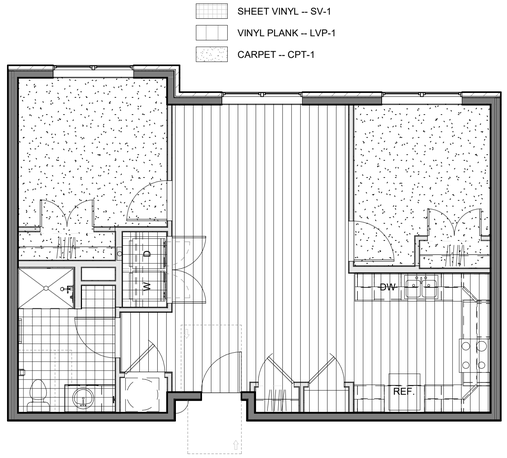

B2 TWO BEDROOM UNIT - TYPE B - FINISH PLAN
3/16" = 1'-0"

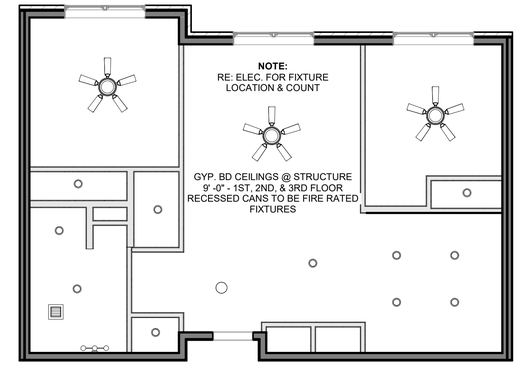

B1 TWO BEDROOM UNIT - TYPE B - REFLECTED CEILING PLAN
3/16" = 1'-0"

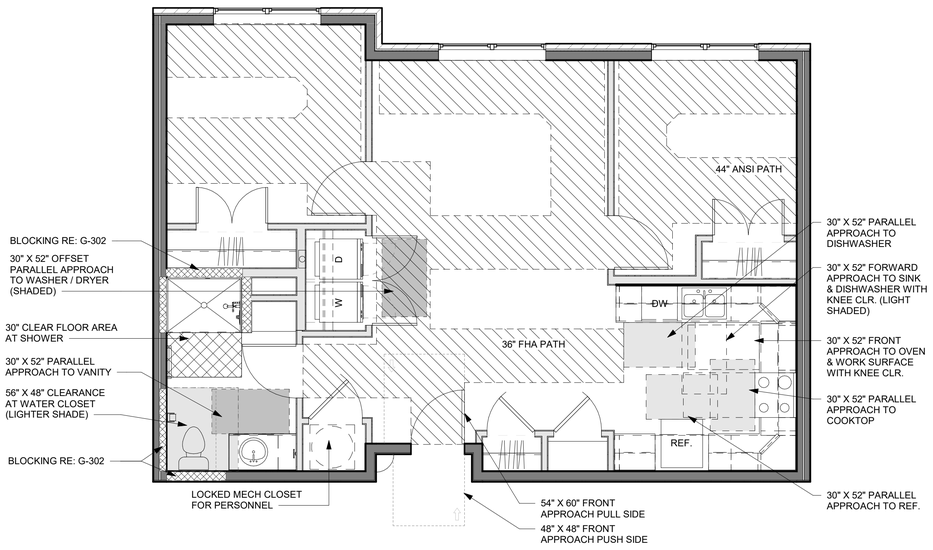

A3 TWO BEDROOM UNIT - TYPE B - CLEAR SPACE PLAN
1/4" = 1'-0"

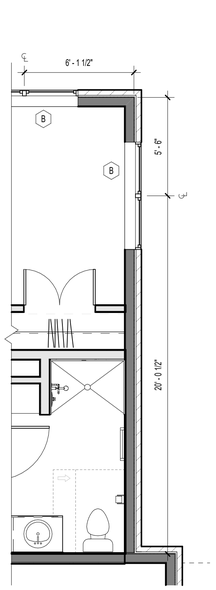

A2 TWO BEDROOM UNIT - END UNIT
1/4" = 1'-0"

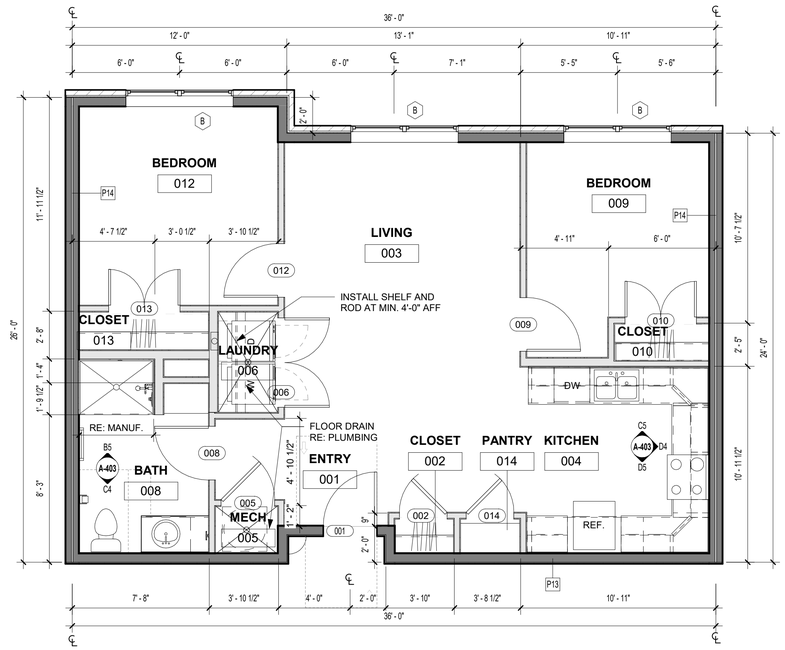

A1 TWO BEDROOM UNIT - TYPE B - FLOOR PLAN
1/4" = 1'-0"

rosemann & ASSOCIATES P.C.
ARCHITECTURE
INTERIOR DESIGN
ENGINEERING
PLANNING
1526 Grand Boulevard
Kansas City, MO 64108-1404
p: 816.472.1448
w: www.rosemann.com
© 2023 Rosemann & Associates, P.C.
DENVER ▲ KANSAS CITY ▲ ST. LOUIS ▲ ATLANTA

PRINTS ISSUED
10/30/23 PERMIT SUBMITTAL

REVISIONS:

STATE OF MISSOURI
DAVID EUGENE HENDRIKSE
NUMBER A-7385
REGISTERED ARCHITECT
10/30/23

WILSHIRE HILLS III
LEE'S SUMMIT, MISSOURI
MHDC - 22-057

SHEET TITLE
TWO BEDROOM UNIT PLAN - TYPE B

PROJECT NUMBER: 23034

SHEET NUMBER:

A-403

10/27/2023 2:42:23 PM
C:\Revit Local Cache\R2023\2034_Wilshire Hills III_Central_R23_mm5YLCAR.rvt

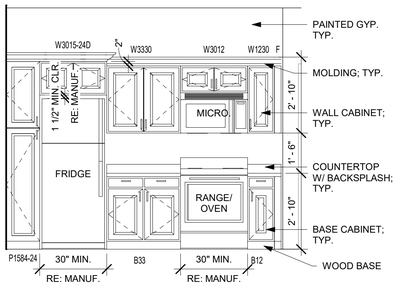

D5 TWO BED CORNER - KITCHEN ELEV. 1
3/8" = 1'-0"

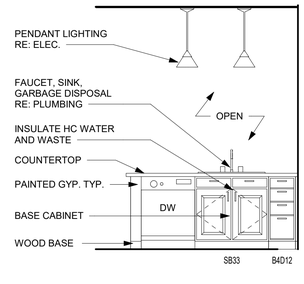

D4 TWO BED CORNER - KITCHEN ELEV. 2
3/8" = 1'-0"

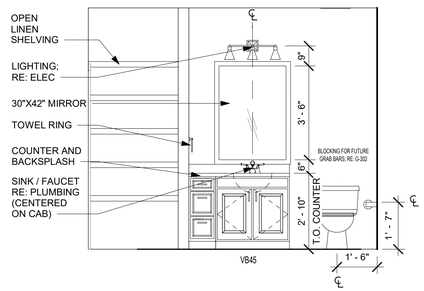

D3 TWO BED CORNER - BATH ELEV. 1
3/8" = 1'-0"

REFERENCE G-003 FOR GENERAL NOTES
REFERENCE A-101 FOR PLAN LEGEND
REFERENCE A-120 FOR RCP LEGEND

DOOR SCHEDULE - 2 BED CORNER UNIT

Mark	Width	Height	Thickness	Type Mark	Door Material	Door Finish	Frame Material	Frame Finish	Fire Rating	Comments	Hardware Group
001	3' - 0"	6' - 8"	0' - 1 3/4"	A	WD S.C.	PT-3	TIMELY MT-1	PT-3	20 MIN.	FACTORY KERF FOR SMOKE SEAL, FRAME READY FOR WOOD CASING	U1
002	3' - 0"	6' - 8"	0' - 1 3/8"	B	WD H.C.	PT-3	WD	PT-3			
005	3' - 0"	6' - 8"	0' - 1 3/8"	D	WD H.C.	PT-3	TIMELY MT-1	PT-3			
006	5' - 0"	6' - 8"	0' - 1 3/8"	C	WD H.C.	PT-3	WD	PT-3			
007	3' - 0"	6' - 8"	0' - 1 3/8"	B	WD H.C.	PT-3	WD	PT-3			
008	3' - 0"	6' - 8"	0' - 1 3/8"	B	WD H.C.	PT-3	WD	PT-3			
010	3' - 0"	6' - 8"	0' - 1 3/8"	B	WD H.C.	PT-3	WD	PT-3			
011	3' - 0"	6' - 8"	0' - 1 3/8"	B	WD H.C.	PT-3	WD	PT-3			

DOOR TYPES

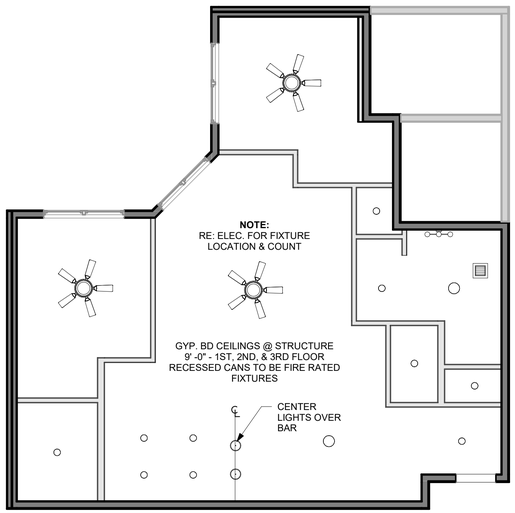

B5 TWO BEDROOM CORNER UNIT - TYPE B - REFLECTED CEILING PLAN
3/16" = 1'-0"

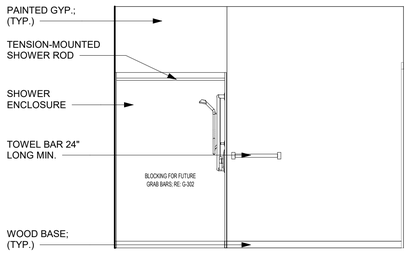

B4 TWO BED CORNER - BATH ELEV. 3
3/8" = 1'-0"

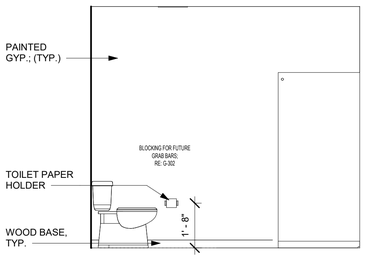

B3 TWO BED CORNER - BATH ELEV. 2
3/8" = 1'-0"

ROOM FINISH SCHEDULE - 2 BED CORNER UNITS

Number	Name	Floor Finish	Base Finish	Wall Finish	Ceiling Finish	Comments
001	ENTRY	LVP-1	WB-1, PT-3	PT-1	PT-2	
002	COAT	LVP-1	WB-1, PT-3	PT-1	PT-2	
003	LIVING	LVP-1	WB-1, PT-3	PT-1	PT-2	
004	KITCHEN	LVP-1	WB-1, PT-3	PT-1	PT-2	CABS. W/ PL COUNTER W/ SPLASH
005	MECH	--	--	--	--	
006	LAUNDRY	SV-1	WB-1, PT-3	PT-1	PT-2	
007	BATH	SV-1	WB-1, PT-3	PT-1	PT-2	CABS. W/ PL COUNTER W/ SPLASH
008	BEDROOM 2	CPT-1	WB-1, PT-3	PT-1	PT-2	
010	BEDROOM 1	CPT-1	WB-1, PT-3	PT-1	PT-2	
011	CLOSET 1	CPT-1	WB-1, PT-3	PT-1	PT-2	

UNIT FINISH LEGEND

CARPET:
CPT-1 MOHAWK PROPERTIES COLLECTION: BROADLOOM (SMARTSTRAND W/ NANOLOC), PM395 NEUTRAL SHIFT, #859 TWILIGHT JUNGLE

LUXURY VINYL PLANK:
LVP-1 MOHAWK REXFORD COLLECTION: 12MIL, RP811, #890 STURDY BROWN

SHEET VINYL:
SV-1 MOHAWK PORTICO COLLECTION: #592 COOL SANDS

BASE:
WB-1 WOOD BASE, FJ623, 9/16" X 3.25" COLONIAL, PT-3; WOOD SHOE MOLD, FJ129, 7/16" X 11/16" COLONIAL, PT-3

PAINT:
PT-1 SHERWIN WILLIAMS, SW 7044 AMAZING GRAY, EGGSHELL
PT-2 SHERWIN WILLIAMS, SW 7042 SHOJI WHITE, FLAT
PT-3 SHERWIN WILLIAMS, SW 7042 SHOJI WHITE, SEMI-GLOSS

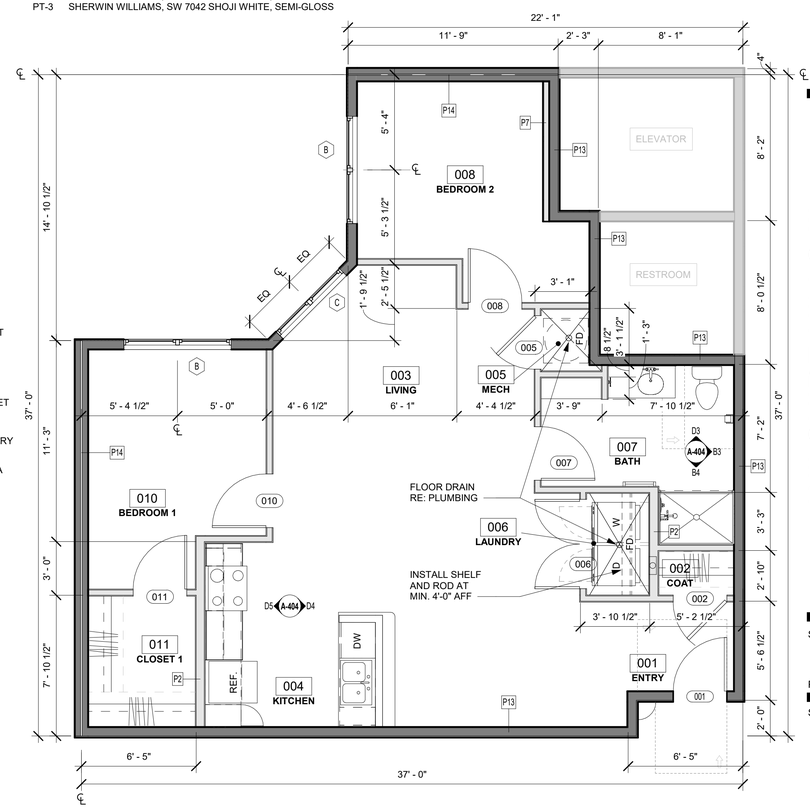

A1 TWO BEDROOM CORNER UNIT - TYPE B - FLOOR PLAN
1/4" = 1'-0"

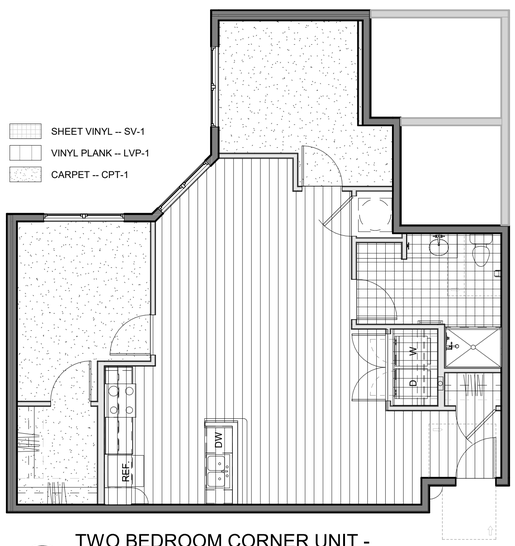

A5 TWO BEDROOM CORNER UNIT - TYPE B - FINISH PLAN
3/16" = 1'-0"

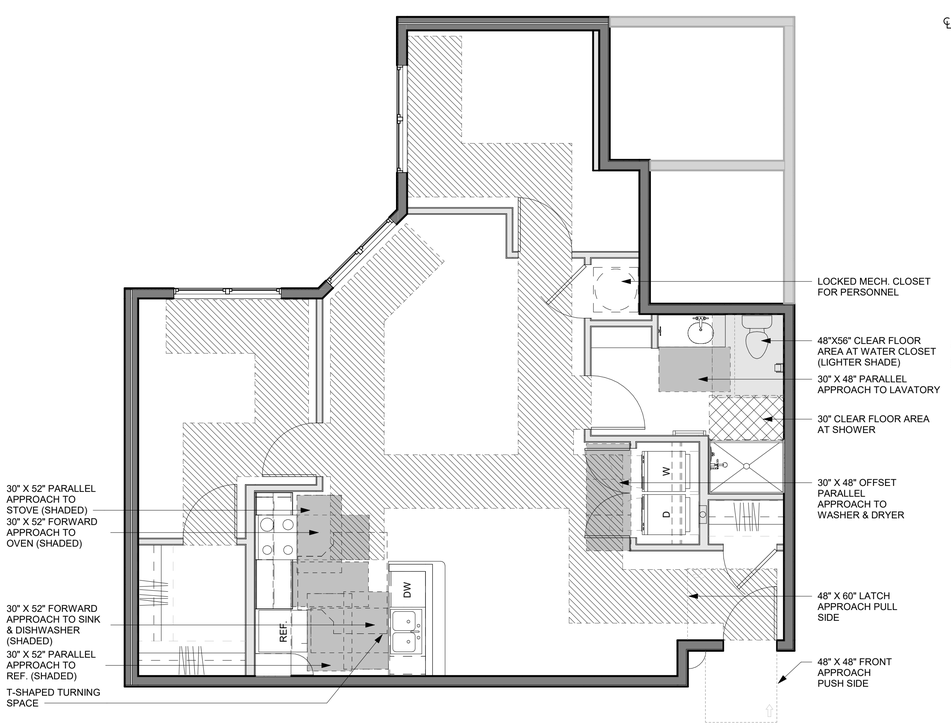

A3 TWO BEDROOM CORNER UNIT - TYPE B - CLEAR SPACE PLAN
1/4" = 1'-0"

PRINTS ISSUED
10/30/23 PERMIT SUBMITTAL

REVISIONS:

rosemann & ASSOCIATES P.C.
ARCHITECTURE
INTERIOR DESIGN
ENGINEERING
PLANNING
1526 Grand Boulevard
Kansas City, MO 64108-1404
p: 816.472.1448
w: www.rosemann.com
© 2023 Rosemann & Associates, P.C.
DENVER ▲ KANSAS CITY ▲ ST. LOUIS ▲ ATLANTA

STATE OF MISSOURI
DAVID EUGENE HENDRIKSE
NUMBER A-7365
REGISTERED ARCHITECT
10/30/23

WILSHIRE HILLS III
LEE'S SUMMIT, MISSOURI
MHDC - 22-057

SHEET TITLE
TWO BEDROOM CORNER UNIT PLAN - TYPE B

PROJECT NUMBER: 23034

SHEET NUMBER:
A-404

10/27/2023 2:53:26 PM
C:\Revit Local Cache\20231023004_Wilshire Hills III_Central_R23_mm5f1UCA.rvt

REFERENCE G-003 FOR GENERAL NOTES
REFERENCE A-101 FOR PLAN LEGEND

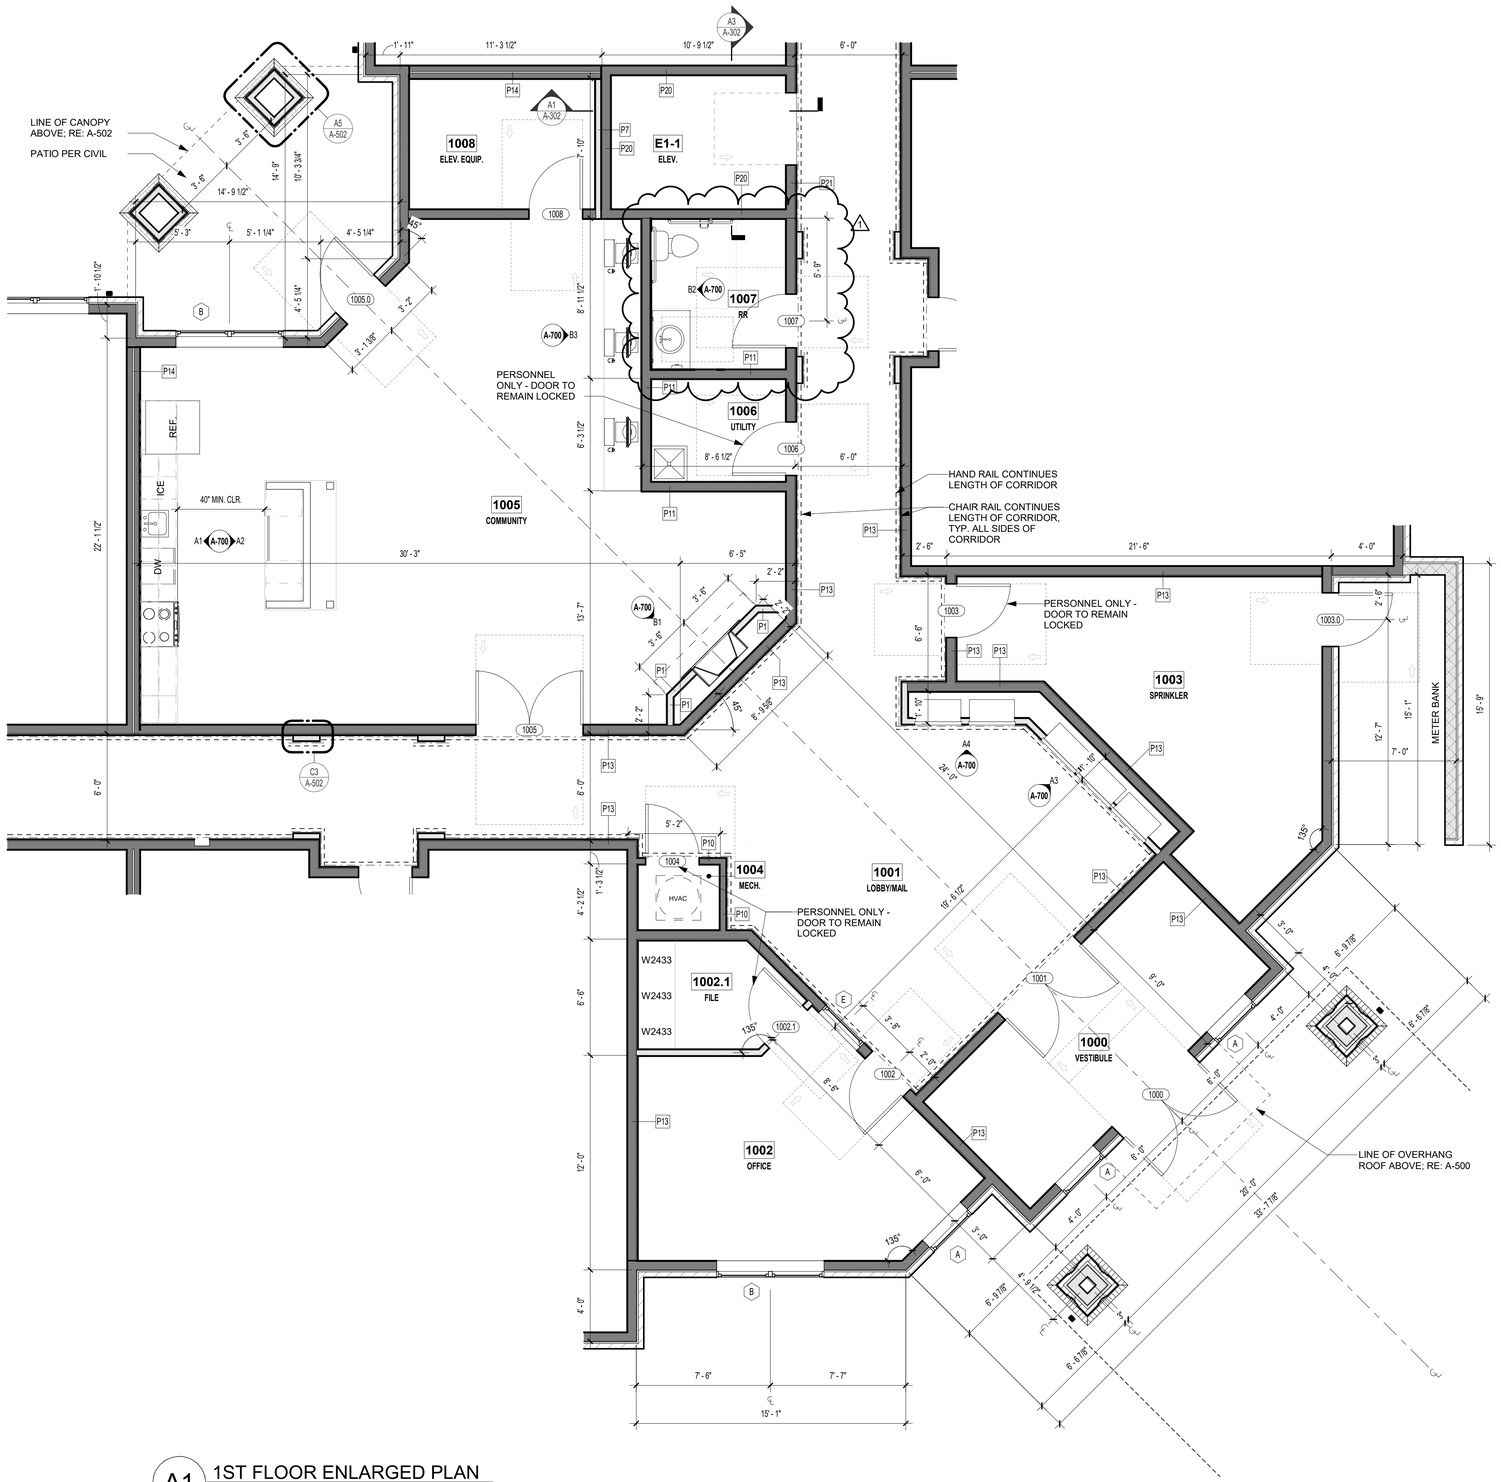

A1 1ST FLOOR ENLARGED PLAN
1/4" = 1'-0"

PRINTS ISSUED
10/30/23 PERMIT SUBMITTAL

REVISIONS:
1 12/15/23 Addendum 1 - Response to City Comments

rosemann & ASSOCIATES P.C.
ARCHITECTURE
INTERIOR DESIGN
ENGINEERING
PLANNING
1526 Grand Boulevard
Kansas City, MO 64108-1404
p: 816.472.1448
w: www.rosemann.com
© 2023 Rosemann & Associates, P.C.
DENVER ▲ KANSAS CITY ▲ ST. LOUIS ▲ ATLANTA

STATE OF MISSOURI
DAVID EUGENE HENDRIKSE
NUMBER A-7365
REGISTERED ARCHITECT
12/27/23

WILSHIRE HILLS III

LEE'S SUMMIT, MISSOURI

MHDC - 22-057

SHEET TITLE
ENLARGED FLOOR PLANS - COMMON AREAS

PROJECT NUMBER: 23034

SHEET NUMBER:

A-410

12/27/2023 8:55:06 AM
O:\Revit Local Central\23034_Wilshire Hills III_Central_R23_revitPTLOAR.rvt

REFERENCE G-003 FOR GENERAL NOTES
REFERENCE A-101 FOR PLAN LEGEND

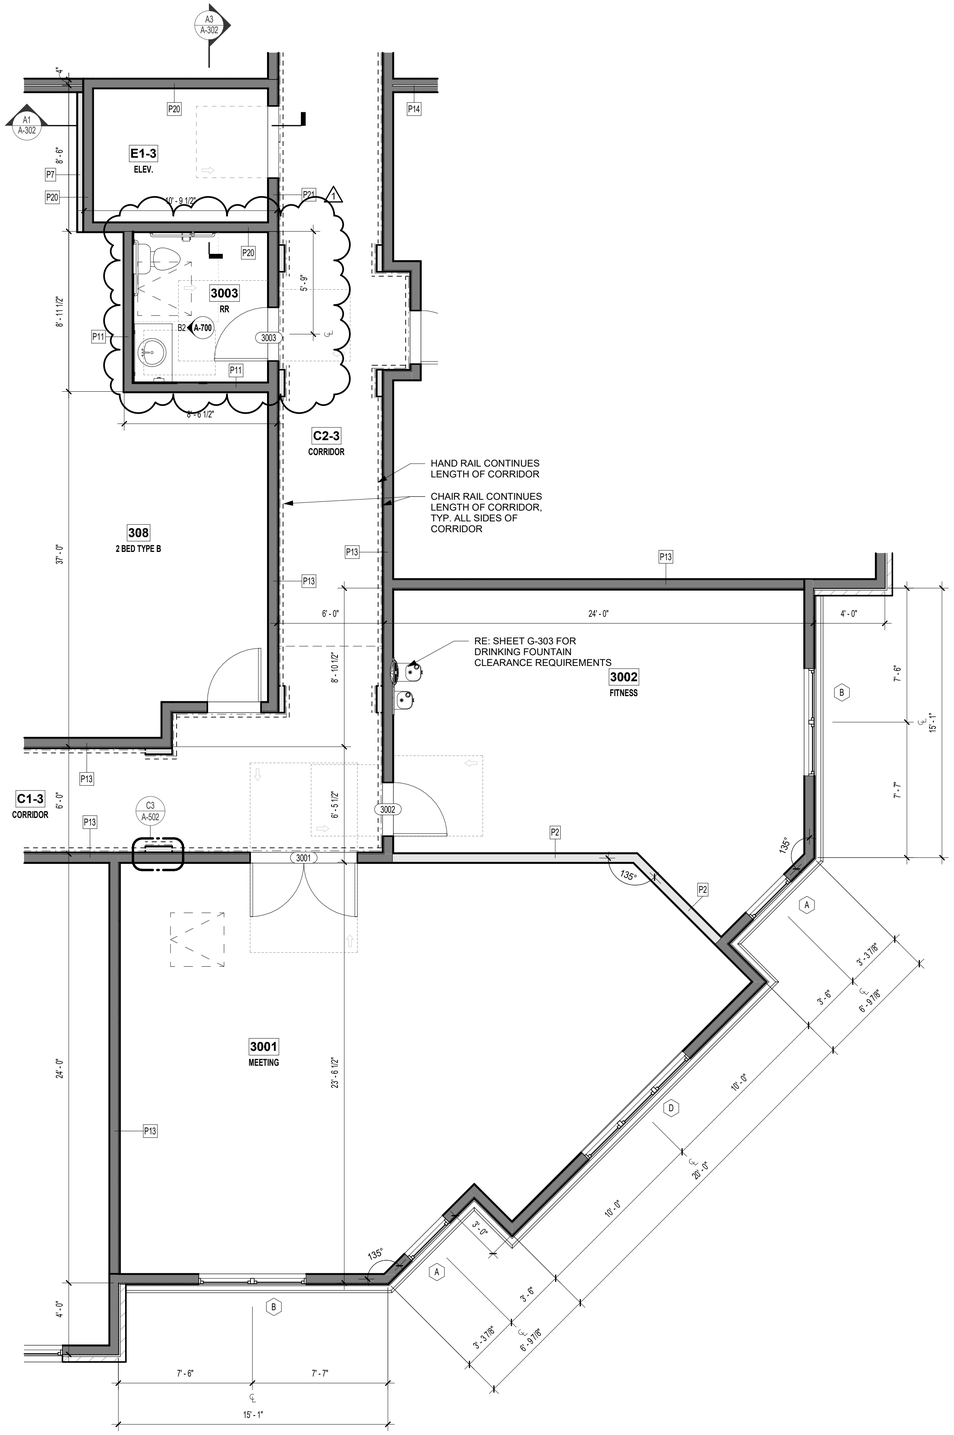

A3 3RD FLOOR ENLARGED PLAN
1/4" = 1'-0"

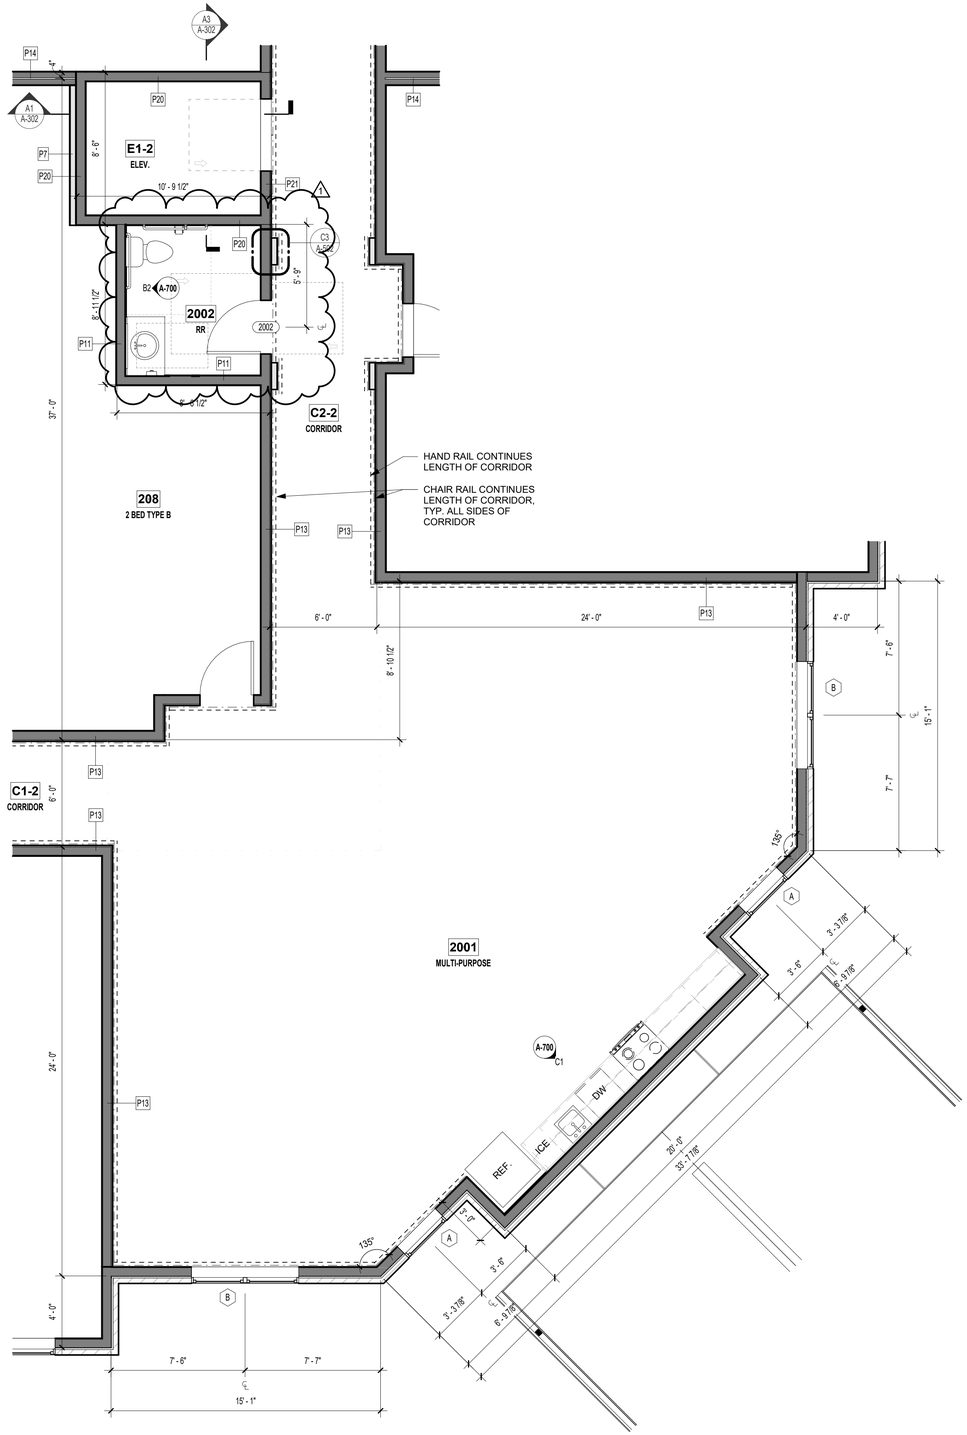

A1 2ND FLOOR ENLARGED PLAN
1/4" = 1'-0"

PRINTS ISSUED
10/30/23 PERMIT SUBMITTAL

REVISIONS:
1 12/15/23 Addendum 1 - Response to City Comments

rosemann & ASSOCIATES P.C.
ARCHITECTURE
INTERIOR DESIGN
ENGINEERING
PLANNING
1526 Grand Boulevard
Kansas City, MO 64108-1404
p: 816.472.1448
w: www.rosemann.com
© 2023 Rosemann & Associates, P.C.
DENVER ▲ KANSAS CITY ▲ ST. LOUIS ▲ ATLANTA

STATE OF MISSOURI
DAVID EUGENE HENDRIKSE
NUMBER A-7365
REGISTERED ARCHITECT
12/27/23

WILSHIRE HILLS III

LEE'S SUMMIT, MISSOURI

MHDC - 22-057

SHEET TITLE
ENLARGED FLOOR PLANS - COMMON AREAS

PROJECT NUMBER: 23034

SHEET NUMBER:

A-411

12/27/2023 8:55:10 AM
O:\Revit Local Data\23034_Wilshire Hills III_Central_R23_revitRTUCAR.rvt

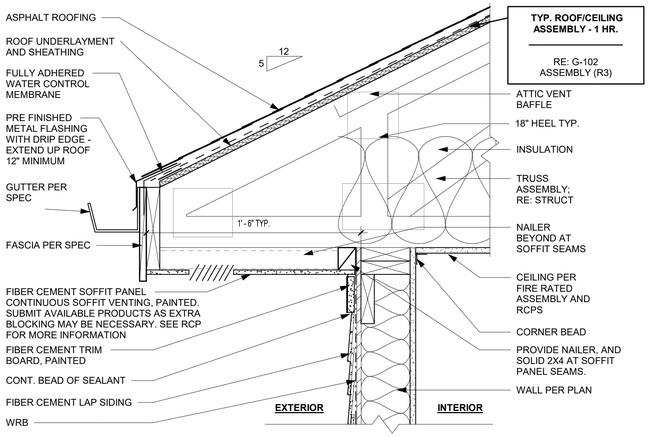

D5 TYP. 5/12 EAVE DETAIL @ SIDING
1 1/2" = 1'-0"

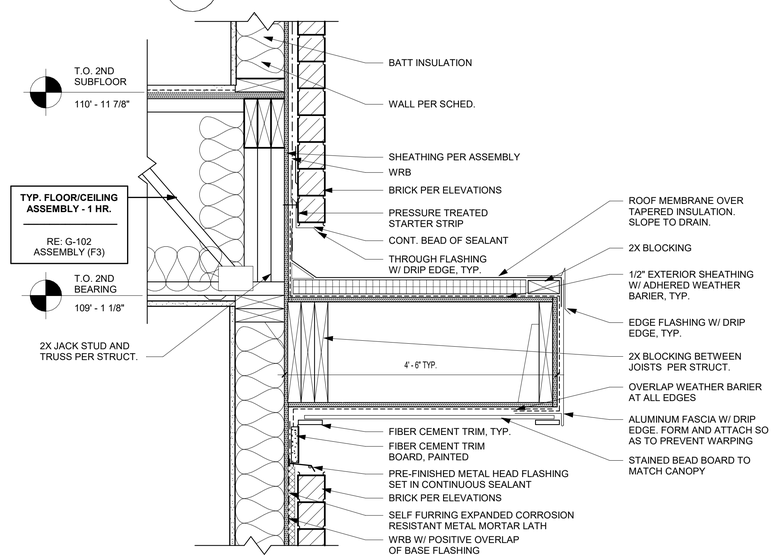

B5 TYP. DETAIL @ CANOPY
1 1/2" = 1'-0"

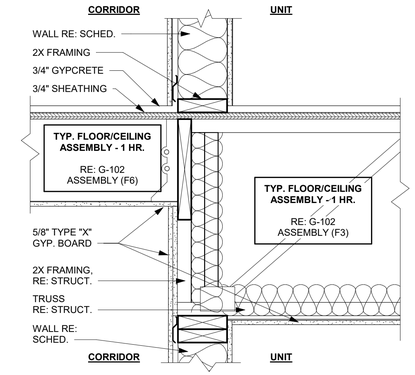

D3 FRAMING FLOOR / CEILING DETAIL
1 1/2" = 1'-0"

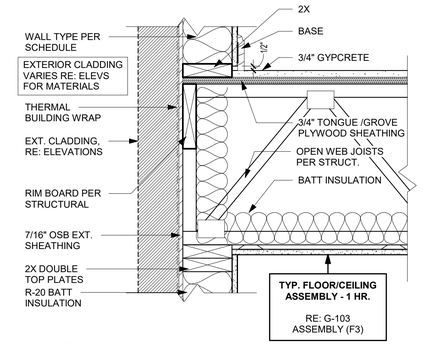

C3 FRAMING FLOOR/CEILING DETAIL
1 1/2" = 1'-0"

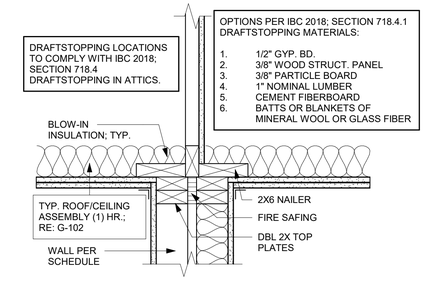

B3 DRAFT STOP @ DEMISING WALL
1 1/2" = 1'-0"

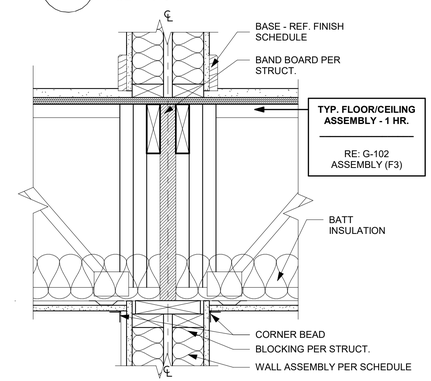

A3 FRAMING FLOOR/ CEILING DETAIL @ DEMISING WALL
1 1/2" = 1'-0"

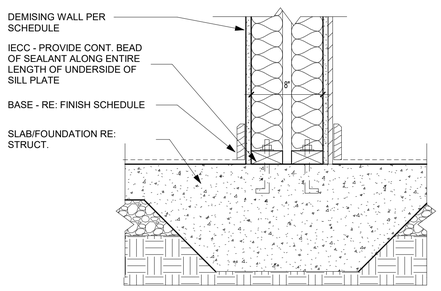

A4 TYP. FOUNDATION @ DEMISING WALL
1 1/2" = 1'-0"

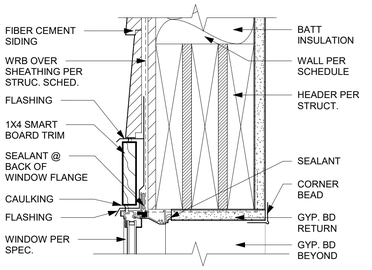

D2 WINDOW HEAD @ SIDING
3" = 1'-0"

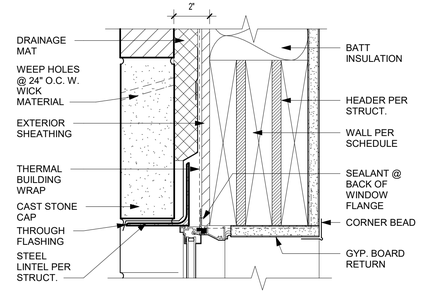

D1 WINDOW HEAD @ BRICK
3" = 1'-0"

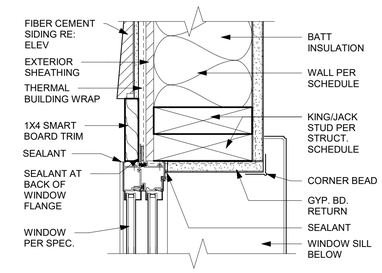

C2 WINDOW JAMB @ SIDING
3" = 1'-0"

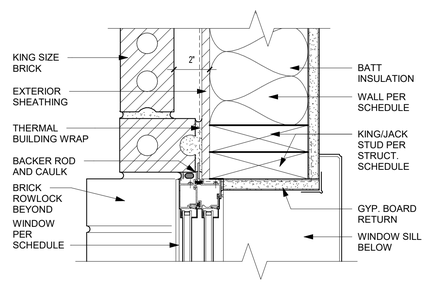

C1 WINDOW JAMB @ BRICK
3" = 1'-0"

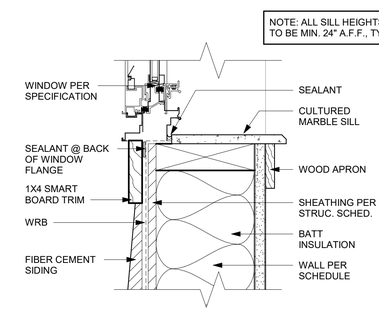

B2 WINDOW SILL @ SIDING
3" = 1'-0"

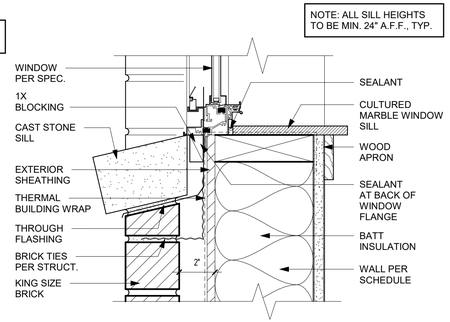

B1 WINDOW SILL @ BRICK
3" = 1'-0"

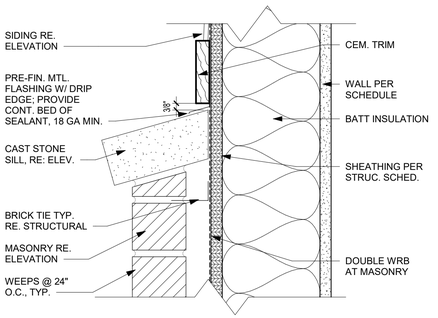

A2 BRICK TO SIDING TRANSITION
3" = 1'-0"

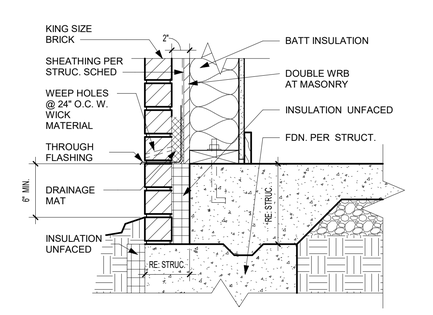

A1 FOUNDATION DETAIL @ BRICK
1 1/2" = 1'-0"

PRINTS ISSUED
10/30/23 PERMIT SUBMITTAL

REVISIONS:

rosemann & ASSOCIATES P.C.
ARCHITECTURE
INTERIOR DESIGN
ENGINEERING
PLANNING
1526 Grand Boulevard
Kansas City, MO 64108-1404
p: 816.472.1448
w: www.rosemann.com
© 2023 Rosemann & Associates, P.C.
DENVER ▲ KANSAS CITY ▲ ST. LOUIS ▲ ATLANTA

STATE OF MISSOURI
DAVID EUGENE HENDRIKSE
NUMBER A-7365
REGISTERED ARCHITECT
10/30/23

WILSHIRE HILLS III
LEE'S SUMMIT, MISSOURI
MHDC - 22-057

SHEET TITLE
DETAILS

PROJECT NUMBER: 23034

SHEET NUMBER:

A-500

10/27/2023 2:53:41 PM
C:\Revit Local Files\R23\23034_Wilshire Hills III_Central_R23_revitTUCAR.rvt

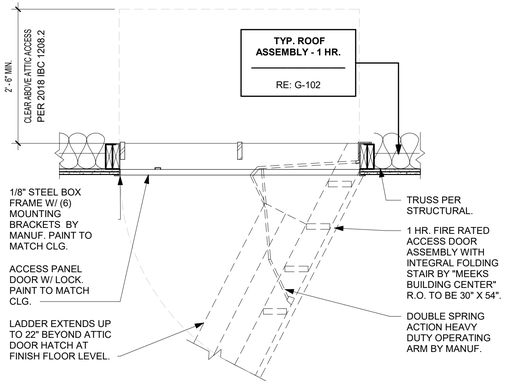

D5 ATTIC ACCESS DETAIL
3/4" = 1'-0"

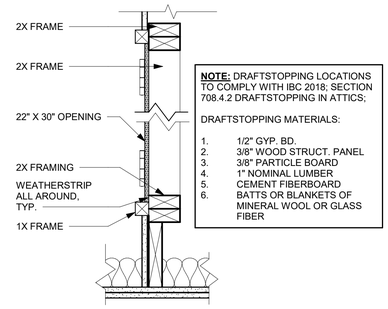

D4 DRAFT STOP ACCESS PANEL
1 1/2" = 1'-0"

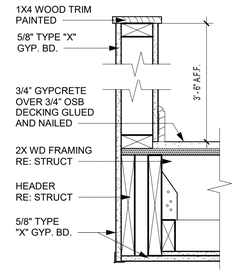

D3 STAIR KNEE WALL DETAIL
1 1/2" = 1'-0"

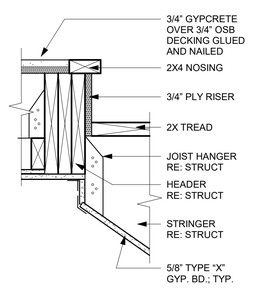

D2 STAIR DETAIL
1 1/2" = 1'-0"

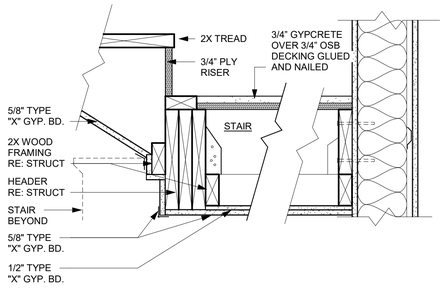

D1 STAIR PLATFORM DTL.
1 1/2" = 1'-0"

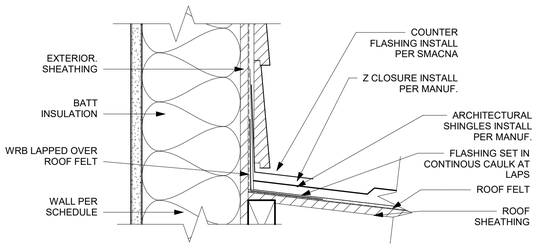

C5 ROOF CONNECTION
3" = 1'-0"

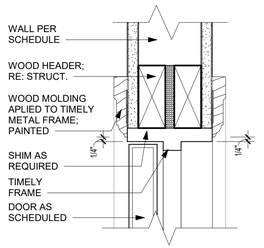

C4 INT. DOOR FRAME HEAD
3" = 1'-0"

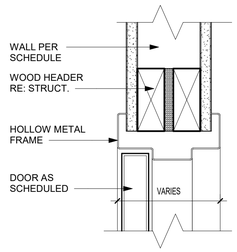

C3 INT DOOR METAL FRAME HEAD
3" = 1'-0"

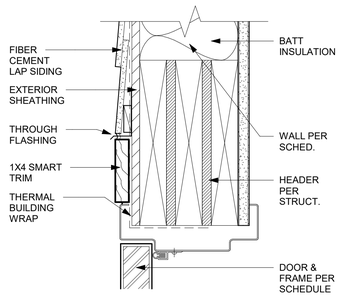

C2 EXT. DOOR HEAD @ SIDING
3" = 1'-0"

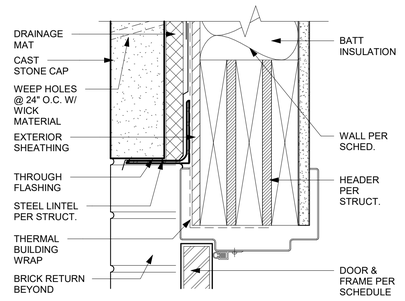

C1 EXTERIOR DOOR HEAD @ BRICK
3" = 1'-0"

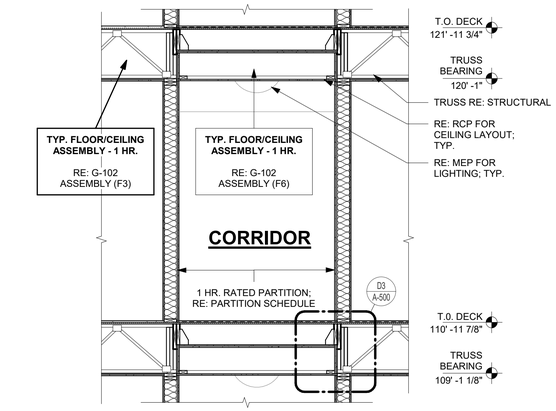

A5 CORRIDOR UPSET DETAIL
3/8" = 1'-0"

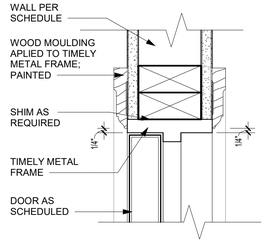

B4 INT. DOOR JAMB DETAIL
3" = 1'-0"

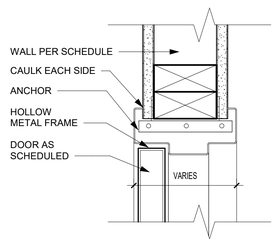

B3 INT. DOOR METAL JAMB DETAIL
3" = 1'-0"

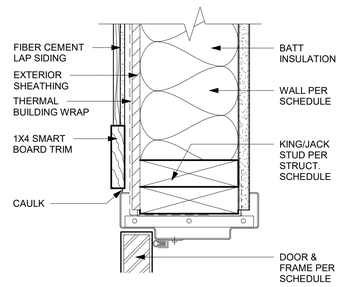

B2 EXT. DOOR JAMB @ SIDING
3" = 1'-0"

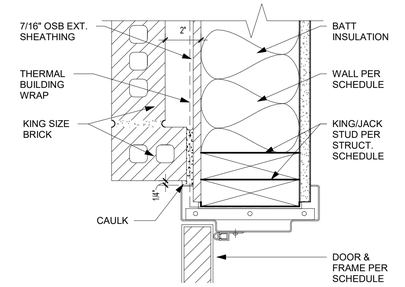

B1 EXT. DOOR JAMB @ BRICK
3" = 1'-0"

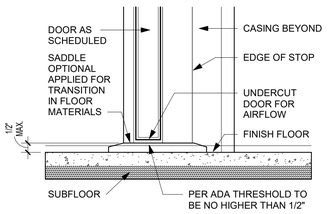

A4 INTERIOR DOOR SILL DETAIL
3" = 1'-0"

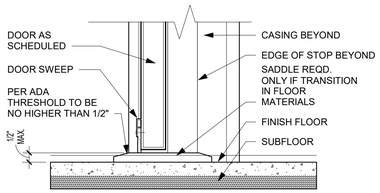

A3 INT. DOOR SILL @ RATED DOOR
3" = 1'-0"

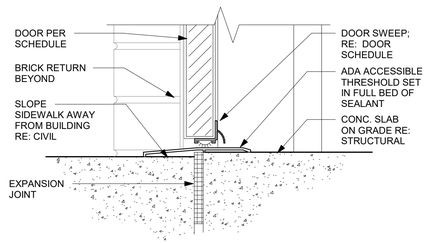

A1 EXT. THRESHOLD @ BRICK
3" = 1'-0"

PRINTS ISSUED
10/30/23 PERMIT SUBMITTAL

REVISIONS:

rosemann & ASSOCIATES P.C.
ARCHITECTURE
INTERIOR DESIGN
ENGINEERING
PLANNING
1526 Grand Boulevard
Kansas City, MO 64108-1404
p: 816.472.1448
w: www.rosemann.com
© 2023 Rosemann & Associates, P.C.
DENVER ▲ KANSAS CITY ▲ ST. LOUIS ▲ ATLANTA

STATE OF MISSOURI
DAVID EUGENE HENDRIKSE
NUMBER A-7365
REGISTERED ARCHITECT
10/30/23

WILSHIRE HILLS III
LEE'S SUMMIT, MISSOURI
MHDC - 22-057

SHEET TITLE
DETAILS

PROJECT NUMBER: 23034

SHEET NUMBER:

A-501

10/27/2023 2:43:44 PM
C:\Revit Local Files\20230034_Wilshire Hills III_Central_R23_mmf01JCAR.rvt

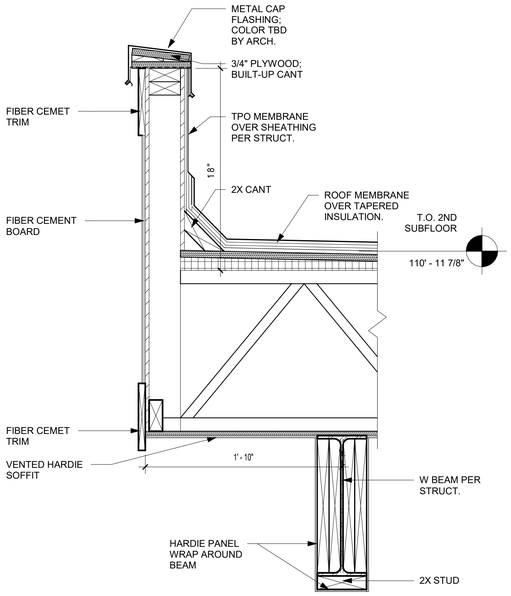

C5 PARAPET @ BACK PATIO
1 1/2" = 1'-0"

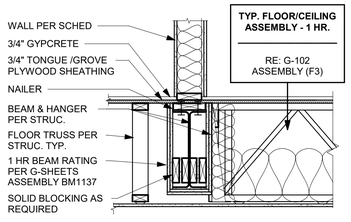

D4 UPSET BEAM DETAIL
3/4" = 1'-0"

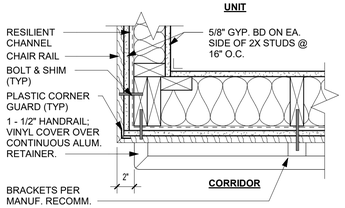

D3 HANDRAIL TO CORNER TRANSITION
1 1/2" = 1'-0"

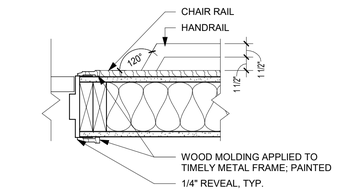

NOTE: CONDITION SIMILAR AT HOLLOW METAL FRAMES, WINDOWS AND OTHER INTERRUPTIONS/TERMINATIONS OF THE HANDRAIL

E2 HANDRAIL TO DOOR TRANSITION
1 1/2" = 1'-0"

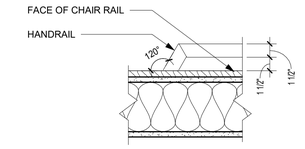

E1 HANDRAIL TO CHAIR RAIL TRANSITION
1 1/2" = 1'-0"

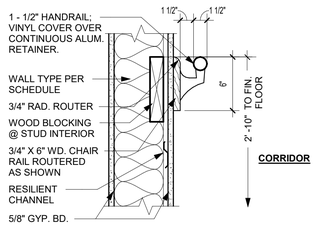

D2 HANDRAIL DETAIL
1 1/2" = 1'-0"

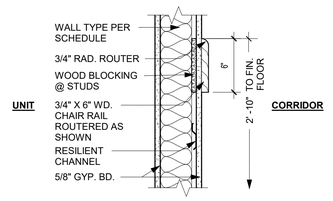

D1 CHAIR RAIL DETAIL
1 1/2" = 1'-0"

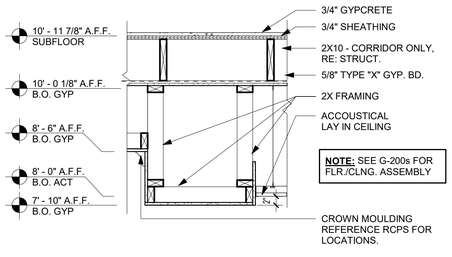

C4 TYPICAL UNIT ENTRY SOFFIT SECTION
3/4" = 1'-0"

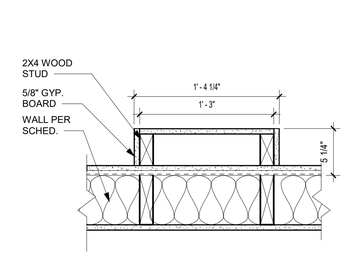

C3 TYPICAL PILASTER DETAIL
1 1/2" = 1'-0"

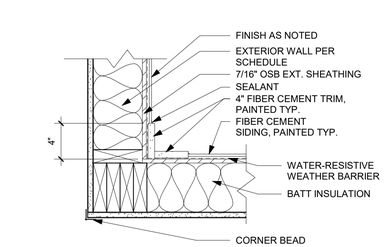

C2 SIDING @ INSIDE CORNER
1 1/2" = 1'-0"

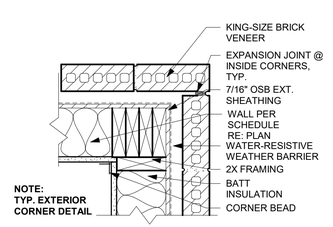

C1 BRICK @ OUTSIDE CORNER
1 1/2" = 1'-0"

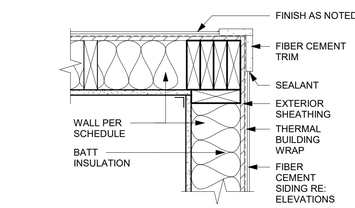

B2 SIDING @ OUTSIDE CORNER
1 1/2" = 1'-0"

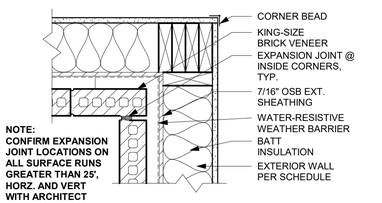

B1 BRICK @ INSIDE CORNER
1 1/2" = 1'-0"

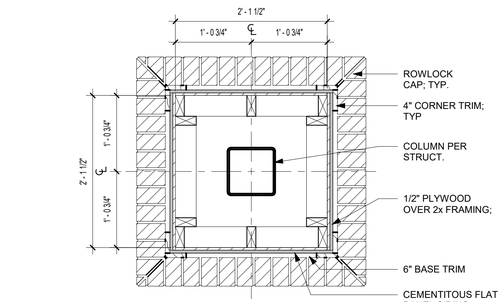

A5 EXTERIOR COLUMN PLAN DETAIL
1" = 1'-0"

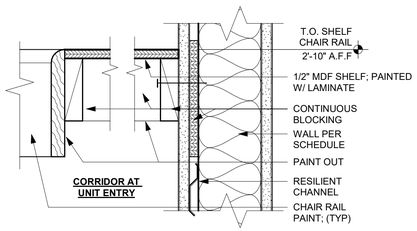

A4 PURSE SHELF AT UNIT ENTRY
3" = 1'-0"

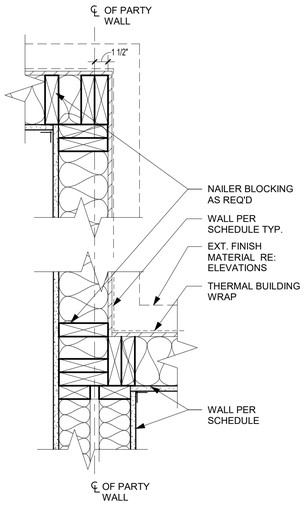

A3 EXTERIOR DEMISING WALL FIRE SEPARATION DETAIL
1 1/2" = 1'-0"

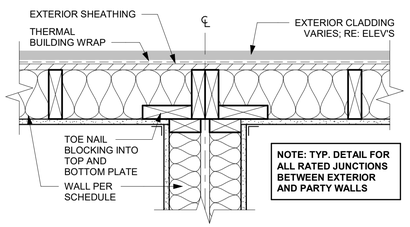

A2 PARTY WALL FIRE SEPARATION PLAN DETAIL
1 1/2" = 1'-0"

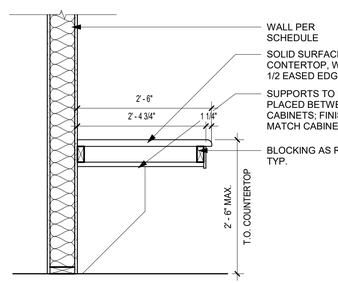

A1 DESK SECTION
3/4" = 1'-0"

10/27/2023 2:52:47 PM
C:\Revit Local Files\R22\23034_Wilshire Hills III_Central_R22_mwh01KJR.rvt

PRINTS ISSUED
10/30/23 PERMIT SUBMITTAL

REVISIONS:

rosemann & ASSOCIATES P.C.
ARCHITECTURE
INTERIOR DESIGN
ENGINEERING
PLANNING
1526 Grand Boulevard
Kansas City, MO 64108-1404
p: 816.472.1448
w: www.rosemann.com
© 2023 Rosemann & Associates, P.C.
DENVER ▲ KANSAS CITY ▲ ST. LOUIS ▲ ATLANTA

STATE OF MISSOURI
DAVID EUGENE HENDRIKSE
NUMBER A-7365
REGISTERED ARCHITECT
10/30/23

WILSHIRE HILLS III
LEE'S SUMMIT, MISSOURI
MHDC - 22-057

SHEET TITLE
DETAILS

PROJECT NUMBER: 23034

SHEET NUMBER:

A-502

THIS SHEET IS PROVIDED FOR REFERENCE ONLY. ALL INSTALLATION TO BE PER MANUFACTURER RECOMMENDATION

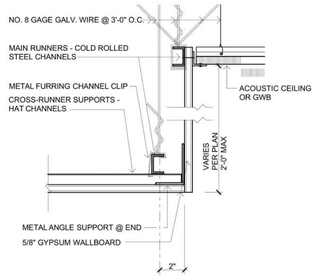

SUSPENDED CEILING/SOFFIT TRANSITION 3" = 1'-0" **20** A13.1

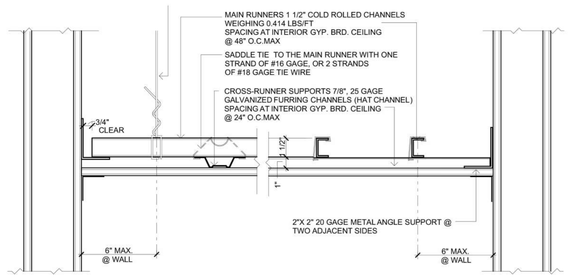

SUSPENDED GYPSUM WALL BOARD CEILING - CONNECTION DETAIL 3" = 1'-0" **12** A13.1

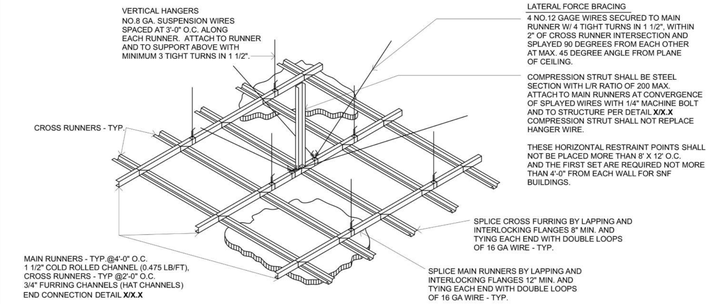

SUSPENDED GYPSUM BOARD CEILING GRID 1 1/2"= 1'-0" **4** A13.1

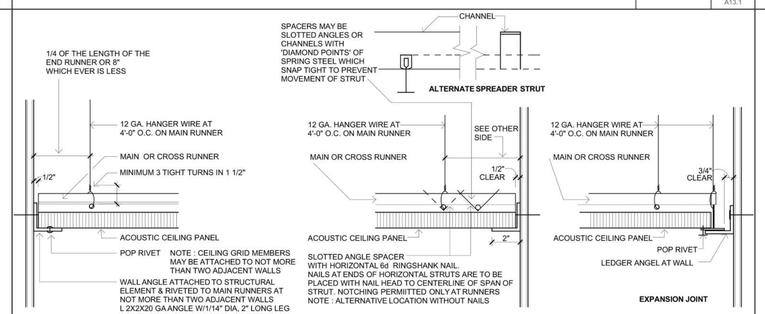

SUSPENDED LAY-IN CEILING - CONNECTION DETAIL 3" = 1'-0" **11** A13.1

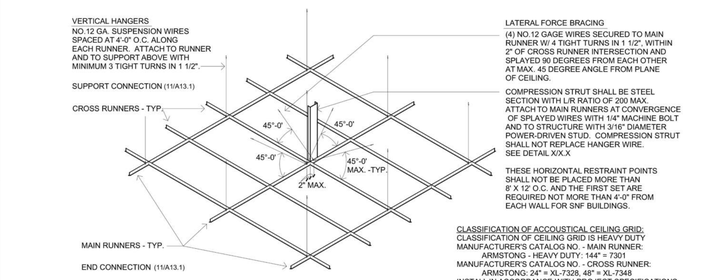

SUSPENDED LAY-IN CEILING GRID 1 1/2"= 1'-0" **3** A13.1

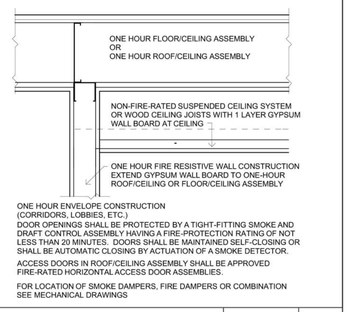

CORRIDOR CONSTRUCTION 1 1/2"= 1'-0" **14** A13.1

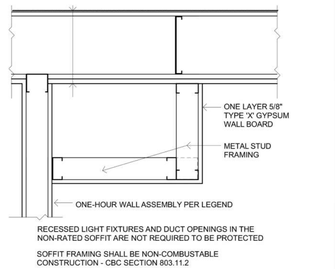

METAL STUD SOFFIT FRAMING 1 1/2"= 1'-0" **13** A13.1

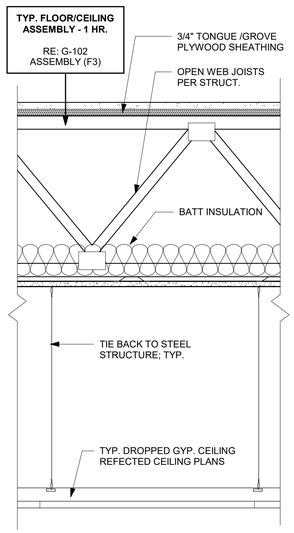

SUSPENDED CEILING AT WOOD FRAMING 1 1/2"= 1'-0" **9** A13.1

PRINTS ISSUED
10/30/23 PERMIT SUBMITTAL

REVISIONS:

rosemann & ASSOCIATES P.C.
ARCHITECTURE
INTERIOR DESIGN
ENGINEERING
PLANNING
1526 Grand Boulevard
Kansas City, MO 64108-1404
p: 816.472.1448
w: www.rosemann.com
© 2023 Rosemann & Associates, P.C.
DENVER ▲ KANSAS CITY ▲ ST. LOUIS ▲ ATLANTA

STATE OF MISSOURI
DAVID EUGENE HENDRIKSE
NUMBER A-7365
REGISTERED ARCHITECT
10/30/23

WILSHIRE HILLS III
LEE'S SUMMIT, MISSOURI

SHEET TITLE
SUSPENDED CEILING DETAILS

PROJECT NUMBER: 23034

SHEET NUMBER:

A-503

10/27/2023 2:43:49 PM
C:\Revit Local Files\R23\23034_Wilshire Hills III_Central_R23_mm5f1XC4R.rvt

FINISH LEGEND

CARPET:
CPT-1 MOHAWK GROUP: UNCHARTED RESTORE TILE, 359 ECOACTIVE, BRICK ASHLAR PATTERN
CPT-2 MOHAWK GROUP: UNCHARTED SOLVE II TILE, 359 ECOACTIVE, BRICK ASHLAR PATTERN
CP-1 MOWHAWK GROUP: BROADLOOM, BIGLOW NEW BASICS II, 26OZ, # 7928 MAJOLICA TIN
WOM-1 SHAW: PATH TILE - 5T034, PORTABELLA #34761, QUARTER TURN

LUXURY VINYL PLANK:
LVP-1 MOHAWK REXFORD COLLECTION: 12MIL, RP811, #890 STURDY BROWN

SHEET VINYL:
SV-1 MOHAWK PORTICO COLLECTION: #592 COOL SANDS

PORCELAIN TILE:
POR-1 DALTILE: ARTICULO, AR09 COLUMN GRAY, 18" X 18"; GROUT 1/8" MAPEI #93 WARM GRAY
POR-2 DALTILE: ARTICULO, AR09 COLUMN GRAY, 12" X 24"; GROUT 1/8" MAPEI #93 WARM GRAY, RUNNING BOND 33% OVERLAP
POR-3 DALTILE: ARTICULO, AR09 COLUMN GRAY, 6" X 24"; GROUT 1/8" MAPEI #93 WARM GRAY, RUNNING BOND 33% OVERLAP

FRP WALL PANEL:
FRP-1 MARLITE ARTIZAN VISUAL WALL PANELS, VERIFY COLOR WITH OWNER

BASE:
WB-1 WOOD BASE, FJ623, 9/16" X 3.25" COLONIAL, PT3; WOOD SHOE MOLD, FJ129, 7/16" X 11/16" COLONIAL, PT3
RB-1 RUBBER BASE, STYLE AND COLOR BY OWNERSHIP

PAINT:
PT-1 SHERWIN WILLIAMS, SW 7044 AMAZING GRAY, EGGSHELL
PT-2 SHERWIN WILLIAMS, SW 7042 SHOJI WHITE, FLAT
PT-3 SHERWIN WILLIAMS, SW 7042 SHOJI WHITE, SEMI-GLOSS
PT-4 SHERWIN WILLIAMS, SW 7069 IRON ORE, SEMI-GLOSS
PT-5 SHERWIN WILLIAMS, SW 7015 REPOSE GRAY, EGGSHELL
PT-6 SHERWIN WILLIAMS, SW 7017 DORIAN GRAY, EGGSHELL
PT-7 SHERWIN WILLIAMS, SW 7633 TAUPE TONE, EGGSHELL
PT-8 SHERWIN WILLIAMS, SW 7046 ANONYMOUS, EGGSHELL
PT-9 SHERWIN WILLIAMS, SW 9143 CADET, EGGSHELL
PT-10 SHERWIN WILLIAMS, SW 9127 AT EASE SOLDIER, EGGSHELL
PT-11 SHERWIN WILLIAMS, SW 9168 ELEPHANT EAR, EGGSHELL
PT-12 SHERWIN WILLIAMS, SW 7048 URBANE BRONZE, EGGSHELL
PT-13 SHERWIN WILLIAMS, SW 7048 URBANE BRONZE, SEMI-GLOSS

FINISH ABBREVIATIONS:
BCR BELOW CHAIR RAIL, VERIFY WITH PLANS AND OWNER
ACR ABOVE CHAIR RAIL, VERIFY WITH PLANS AND OWNER

WINDOW COMMENTS:
1. GLAZING DEEMED TO BE IN A HAZARDOUS LOCATION PER 2406.4 IBC 2018 SHALL BE TEMPERED/SAFETY GLAZING.

2. EACH PANE OF SAFETY GLAZING INSTALLED IN HAZARDOUS LOCATIONS SHALL BE IDENTIFIED BY MANUFACTURER'S DESIGNATION PER 2406 IBC 2018.

3. CONFIRM OPERATION OF SASH LOCKS AT TYPE 'A' UNITS WILL BE WITHIN 48" REQUIRED REACH RANGE. RE: A117.1-2009 SECTION 1003.9 & 1004.5.

4. ALL WINDOWS IN PUBLIC SPACES RECEIVE TRIM; RE: SPECS FOR TRIM PROFILE.

5. REFERENCE EXTERIOR ELEVATIONS FOR EXTERIOR WINDOW TRIM.

6. REFER TO CODE SHEET G-100 FOR ALL FIRE RATINGS

7. WINDOWS ON AND ABOVE SECOND FLOOR MUST HAVE WINDOW OPENING CONTROL DEVICES THAT COMPLY WITH ASTM F 2090.

8. WINDOW LOCATIONS PER A-400S UNO.

9. OPERABLE PARTS SHALL BE OPERABLE WITH ONE HAND AND SHALL NOT REQUIRE TIGHT GRASPING, PINCHING, OR TWISTING OF THE WRIST. THE FORCE REQUIRED TO ACTIVATE OPERABLE PARTS SHALL BE 5.0 POUNDS (22.2 N) MAXIMUM.

PUBLIC DOOR COMMENTS:
1. FINAL HARDWARE SCHEDULE AND FINAL GROUPS TO BE DETERMINED BY DOOR SUB-CONTRACTOR. VERIFY FINAL HARDWARE INSTALLATION WITH CLIENT AND ARCHITECT.

2. DOOR BEING USED FOR EGRESS SHALL BE IN ACCORDANCE WITH IBC 2018 SECT. 1008 AND SHALL NOT REQUIRE TIGHT GRASPING, TIGHT PINCHING, OR TWISTING OF THE WRIST TO OPERATE.

3. ALL FRAMES TO BE 2" UNLESS OTHERWISE NOTED.

4. PAINT / STAIN ALL DOORS AND FRAMES.

5. VERIFY KEYING SCHEDULE WITH OWNER. ALL KEYS TO BE GIVEN TO OWNER AT SUBSTANTIAL COMPLETION.

6. DOOR SIGHTS AT UNIT ENTRY DOORS. RE: G-300 FOR HI/VI DOOR SIGHT

7. MT (TIMELY) FRAMES TO RECEIVE FIELD INSTALLED WOOD TRIM, TYP. ALL LOCATIONS.

8. ALL DOOR HARDWARE TO BE LEVER TYPE HARDWARE, UNLESS OTHERWISE NOTED.

9. ALL COMMON AREA RATED DOORS TO HAVE **SMOKE SEALS (GASKETS), CLOSURES AND LATCH** HARDWARE.

10. UNIT DOORS TO HAVE SPRING HINGES & LATCH TYP UNO.

11. ALL DOORS TO HAVE 32 CLEAR WIDTH PER SECTION 404.2.2 (ICC A117.1-2009).

PUBLIC ROOM FINISH COMMENTS:
1. PAINT BULKHEADS

GENERAL NOTES:
1. BASE FINISH
   A. RB-1 = VINYL TOED/TOELESS - STANDARD COLOR; EXTEND BASE 4" MIN.

WINDOW TYPES

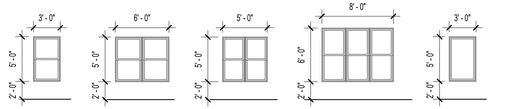

WINDOW SCHEDULE			
Type Mark	Width	Height	Comments
A	3' - 0"	5' - 0"	
B	6' - 0"	5' - 0"	
C	5' - 0"	5' - 0"	
D	8' - 0"	6' - 0"	
E	3' - 0"	5' - 0"	

REFERENCE A-500s FOR DOOR AND WINDOW DETAILS

DOOR TYPES

DOOR SIGHTS AT TYPE "A" UNITS PER G-300, ONE SIGHT ONLY AT TYPE "B" UNITS

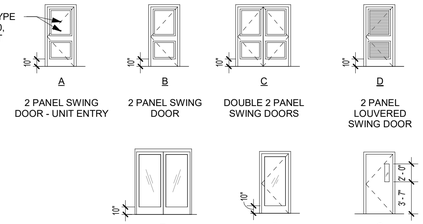

PRINTS ISSUED
10/30/23 PERMIT SUBMITTAL

REVISIONS:
1 12/15/23 Addendum 1 - Response to City Comments
3 04/19/24 Addendum 3 - Response to City Comments #2

rosemann & ASSOCIATES P.C.
ARCHITECTURE
INTERIOR DESIGN
ENGINEERING
PLANNING
1526 Grand Boulevard
Kansas City, MO 64108-1404
p: 816.472.1448
w: www.rosemann.com

© 2023 Rosemann & Associates, P.C.

DENVER ▲ KANSAS CITY ▲ ST. LOUIS ▲ ATLANTA

STATE OF MISSOURI
DAVID EUGENE HENDRIKS
NUMBER A-7365
REGISTERED ARCHITECT
04/19/24

PUBLIC ROOM FINISH SCHEDULE

Number	Name	Floor Finish	Base Finish	Wall Finish	Ceiling Finish	Comments
1000	VESTIBULE	WOM-1	WB-1	TBD BY OWNER	PT-2	
1001	LOBBY/MAIL	CPT-1	WB-1	PT-6 BCR / PT-5 ACR	PT-2	
1002	OFFICE	CPT-1	WB-1	PT-6 BCR / PT-5 ACR	PT-2	
1002.1	FILE	CPT-1	WB-1	PT-1	PT-2	
1003	SPRINKLER	SV-1	RB-1	--	PT-2	
1004	MECH.	SV-1	WB-1	--	PT-2	
1005	COMMUNITY	LVP-1	WB-1	PT-6 BCR / PT-5 ACR	PT-2	POR-3 AT FIREPLACE SURROUND, CABS. W/ PL COUNTER W/ SPLASH; PROVIDE F.R.P. WALL PROTECTION WITHIN 2 FT. OF SERVICE SINKS, URINALS, AND WATER CLOSETS TO A HEIGHT OF 4 FT. A.F.F.
1006	UTILITY	SV-1	WB-1	--	PT-2	
1007	RR	LVP-1	RB-1	TBD BY OWNER	PT-2	CABS. W/ PL COUNTER W/ SPLASH; PROVIDE F.R.P. WALL PROTECTION WITHIN 2 FT. OF SERVICE SINKS, URINALS, AND WATER CLOSETS TO A HEIGHT OF 4 FT. A.F.F.
1008	ELEV. EQUIP.	SV-1	RB-1	--	PT-2	
2001	MULTI-PURPOSE	LVP-1	WB-1	PT-6 BCR / PT-5 ACR	PT-2	CABS. W/ PL COUNTER W/ SPLASH
2002	RR	LVP-1	RB-1	TBD BY OWNER	PT-2	CABS. W/ PL COUNTER W/ SPLASH; PROVIDE F.R.P. WALL PROTECTION WITHIN 2 FT. OF SERVICE SINKS, URINALS, AND WATER CLOSETS TO A HEIGHT OF 4 FT. A.F.F.
3001	MEETING	CPT-1	WB-1	PT-6 BCR / PT-5 ACR	PT-2	
3002	FITNESS	CPT-1	WB-1	PT-6 BCR / PT-5 ACR	PT-2	
3003	RR	LVP-1	RB-1	TBD BY OWNER	PT-2	CABS. W/ PL COUNTER W/ SPLASH; PROVIDE F.R.P. WALL PROTECTION WITHIN 2 FT. OF SERVICE SINKS, URINALS, AND WATER CLOSETS TO A HEIGHT OF 4 FT. A.F.F.
C1-1	CORRIDOR	CPT-2	WB-1	PT-6 BCR / PT-5 ACR	PT-2	
C1-2	CORRIDOR	CPT-2	WB-1	PT-6 BCR / PT-5 ACR	PT-2	
C1-3	CORRIDOR	CPT-2	WB-1	PT-6 BCR / PT-5 ACR	PT-2	
C2-1	CORRIDOR	CPT-2	WB-1	PT-6 BCR / PT-5 ACR	PT-2	
C2-2	CORRIDOR	CPT-2	WB-1	PT-6 BCR / PT-5 ACR	PT-2	
C2-3	CORRIDOR	CPT-2	WB-1	PT-6 BCR / PT-5 ACR	PT-2	
E1-1	ELEV.	POR-2	--	--	PT-2	
E1-2	ELEV.	POR-2	--	--	PT-2	
E1-3	ELEV.	POR-2	--	--	PT-2	
S1-1	STAIR 1	CP-1	WB-1	PT-5	PT-2	
S1-2	STAIR 1	CP-1	WB-1	PT-5	PT-2	
S1-3	STAIR 1	CP-1	WB-1	PT-5	PT-2	
S2-1	STAIR 2	CP-1	WB-1	PT-5	PT-2	
S2-2	STAIR 2	CP-1	WB-1	PT-5	PT-2	
S2-3	STAIR 2	CP-1	WB-1	PT-5	PT-2	

DOOR SCHEDULE - PUBLIC

Mark	Width	Height	Thickness	Type Mark	Door Material	Door Finish	Frame Material	Frame Finish	Fire Rating	Comments	Hardware Group
1000	6' - 0"	7' - 0"	0' - 1 3/4"	E	ALUM.	PRE-FINISH	ALUM. MT-1	PRE-FINISH		CLOSER, ACCESSIBLE CONTROLS, PUSH PULL BARS, WEATHER GASKET, TEMPERED, RAIN DRIP, THRESHOLD	3
1001	6' - 0"	6' - 8"	0' - 1 3/4"	E	ALUM.	PRE-FINISH	ALUM. MT-1	PRE-FINISH		CLOSER, ACCESSIBLE CONTROLS, PUSH PULL BARS, WEATHER GASKET, TEMPERED, KEY FOB OPERATION, MOTION SENSORS, EMERGENCY REQUEST TO EXIT BUTTON	4
1002	3' - 0"	6' - 8"	0' - 1 3/4"	F	ALUM.	PRE-FINISH	TIMELY MT-1	PT	20 MIN.	CLOSER, SMOKE SEALS, SWEEPS, LATCH HARDWARE, TEMPERED	11
1002.1	3' - 0"	6' - 8"	0' - 1 3/4"	B	WD S.C.	PT	TIMELY MT-1	PT		LATCH HARDWARE	7
1003	3' - 0"	6' - 8"	0' - 1 3/4"	B	WD S.C.	PT	TIMELY MT-1	PT	45 MIN.	CLOSER, SMOKE SEALS, SWEEPS, LATCH HARDWARE	9
1003.0	3' - 0"	6' - 8"	0' - 1 3/4"	B	HM	PT	HM MT-1	PT		CLOSER, WEATHER GASKET, THRESHOLD, RAIN DRIP, LATCH HARDWARE	8
1004	3' - 0"	6' - 8"	0' - 1 3/4"	B	WD S.C.	PT	TIMELY MT-1	PT	45 MIN.	LATCH HARDWARE	12
1005	6' - 0"	6' - 8"	0' - 1 3/4"	E	ALUM.	PRE-FINISH	TIMELY MT-1	PT	20 MIN.	SPRING HINGES, SMOKE SEALS, SWEEPS, LATCH HARDWARE, TEMPERED	13
1005.0	3' - 0"	7' - 0"	0' - 1 3/4"	F	ALUM.	PRE-FINISH	ALUM. MT-1	PRE-FINISH		CLOSER, ACCESSIBLE CONTROLS, PUSH PULL BARS, WEATHER GASKET, TEMPERED, RAIN DRIP, THRESHOLD	14
1006	3' - 0"	6' - 8"	0' - 1 3/4"	B	WD S.C.	PT	TIMELY MT-1	PT	45 MIN.	SPRING HINGES, SMOKE SEALS, SWEEPS, LATCH HARDWARE	16
1007	3' - 0"	6' - 8"	0' - 1 3/4"	B	WD S.C.	PT	TIMELY MT-1	PT	20 MIN.	SPRING HINGES, SMOKE SEALS, SWEEPS, LATCH HARDWARE	6
1008	3' - 0"	6' - 8"	0' - 1 3/4"	B	WD S.C.	PT	TIMELY MT-1	PT	45 MIN.	CLOSER, SMOKE SEALS, SWEEPS, LATCH HARDWARE	9
2002	3' - 0"	6' - 8"	0' - 1 3/4"	B	WD S.C.	PT	TIMELY MT-1	PT	20 MIN.	SPRING HINGES, SMOKE SEALS, SWEEPS, LATCH HARDWARE	6
3001	6' - 0"	6' - 8"	0' - 1 3/4"	E	ALUM.	PRE-FINISH	TIMELY MT-1	PT	20 MIN.	SPRING HINGES, SMOKE SEALS, SWEEPS, LATCH HARDWARE, TEMPERED	10
3002	3' - 0"	6' - 8"	0' - 1 3/4"	F	ALUM.	PRE-FINISH	TIMELY MT-1	PT	20 MIN.	SPRING HINGES, SMOKE SEALS, SWEEPS, LATCH HARDWARE, TEMPERED	15
3003	3' - 0"	6' - 8"	0' - 1 3/4"	B	WD S.C.	PT	TIMELY MT-1	PT	20 MIN.	SPRING HINGES, SMOKE SEALS, SWEEPS, LATCH HARDWARE	6
C1-1	3' - 0"	7' - 0"	0' - 1 3/4"	F	ALUM.	PRE-FINISH	ALUM. MT-1	PT		CLOSER, ACCESSIBLE CONTROLS, PUSH PULL BARS, WEATHER GASKET, TEMPERED, RAIN DRIP, THRESHOLD, PANIC HARDWARE, LATCH HARDWARE	2
C2-1	3' - 0"	7' - 0"	0' - 1 3/4"	F	ALUM.	PRE-FINISH	ALUM. MT-1	PT		CLOSER, ACCESSIBLE CONTROLS, PUSH PULL BARS, WEATHER GASKET, TEMPERED, RAIN DRIP, THRESHOLD, PANIC HARDWARE, LATCH HARDWARE	2
S1-1	3' - 0"	6' - 8"	0' - 1 3/4"	G	HM	PRE-FINISH	HM MT-1	PT	60 MIN.	PANIC HARDWARE, CLOSER, SMOKE SEALS, SWEEPS, LATCH HARDWARE, PANIC HARDWARE, KICK PLATE, MAG HOLD	5
S1-1.0	3' - 0"	7' - 0"	0' - 1 3/4"	F	ALUM.	PRE-FINISH	ALUM. MT-1	PT		CLOSER, KEY FOB OPERATION, WEATHER GASKET, TEMPERED, LATCH HARDWARE, PANIC HARDWARE	1
S1-2	3' - 0"	6' - 8"	0' - 1 3/4"	G	HM	PRE-FINISH	HM MT-1	PT	60 MIN.	PANIC HARDWARE, CLOSER, SMOKE SEALS, SWEEPS, LATCH HARDWARE, PANIC HARDWARE, KICK PLATE, MAG HOLD	5
S1-3	3' - 0"	6' - 8"	0' - 1 3/4"	G	HM	PRE-FINISH	HM MT-1	PT	60 MIN.	PANIC HARDWARE, CLOSER, SMOKE SEALS, SWEEPS, LATCH HARDWARE, PANIC HARDWARE, KICK PLATE, MAG HOLD	5
S2-1	3' - 0"	6' - 8"	0' - 1 3/4"	G	HM	PRE-FINISH	HM MT-1	PT	60 MIN.	PANIC HARDWARE, CLOSER, SMOKE SEALS, SWEEPS, LATCH HARDWARE, PANIC HARDWARE, KICK PLATE, MAG HOLD	5
S2-1.0	3' - 0"	7' - 0"	0' - 1 3/4"	F	ALUM.	PRE-FINISH	ALUM. MT-1	PT		CLOSER, KEY FOB OPERATION, WEATHER GASKET, TEMPERED, LATCH HARDWARE, PANIC HARDWARE	1
S2-2	3' - 0"	6' - 8"	0' - 1 3/4"	G	HM	PRE-FINISH	HM MT-1	PT	60 MIN.	PANIC HARDWARE, CLOSER, SMOKE SEALS, SWEEPS, LATCH HARDWARE, PANIC HARDWARE, KICK PLATE, MAG HOLD	5
S2-3	3' - 0"	6' - 8"	0' - 1 3/4"	G	HM	PRE-FINISH	HM MT-1	PT	60 MIN.	PANIC HARDWARE, CLOSER, SMOKE SEALS, SWEEPS, LATCH HARDWARE, PANIC HARDWARE, KICK PLATE, MAG HOLD	5

WILSHIRE HILLS III
LEE'S SUMMIT, MISSOURI
MHDC Project No. #22-057 MT

SHEET TITLE
WINDOW / DOOR / FINISH SCHEDULES

PROJECT NUMBER: 23034

SHEET NUMBER:

A-600

4/19/2024 2:25:43 PM
C:\Revit Local Cache\R2023\23034_Wilshire Hills III_Central_R23_dbrelliek.rvt

REFERENCE G-003 FOR GENERAL NOTES

PRINTS ISSUED

10/30/23 PERMIT SUBMITTAL

REVISIONS:

1	12/15/23	Addendum 1 - Response to City Comments

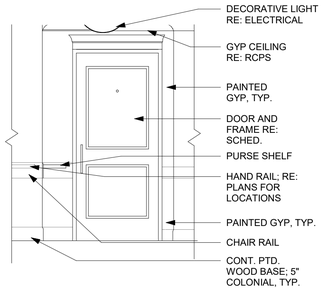

C2 TYP. UNIT ENTRY
3/8" = 1'-0"

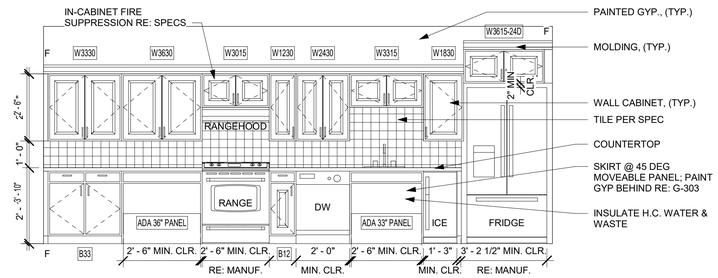

C1 MULTI-PURPOSE KITCHEN ELEVATION
3/8" = 1'-0"

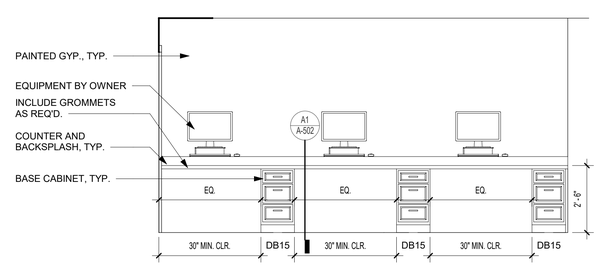

B3 COMPUTER ELEVATION
3/8" = 1'-0"

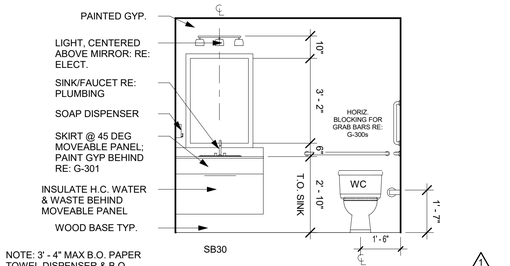

NOTE: 3' - 4" MAX B.O. PAPER TOWEL DISPENSER & B.O. REFLECTIVE SURFACE

B2 PUBLIC RESTROOM ELEVATION
3/8" = 1'-0"

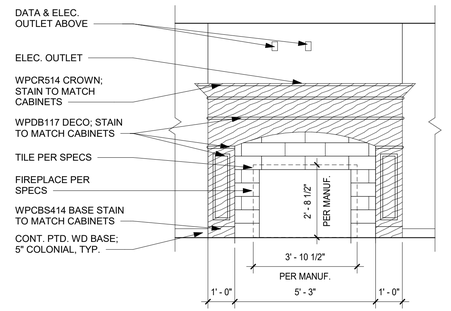

B1 TYP. FIREPLACE ELEVATION
3/8" = 1'-0"

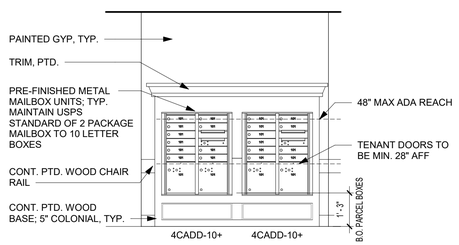

A4 MAILBOX ELEVATION 2
3/8" = 1'-0"

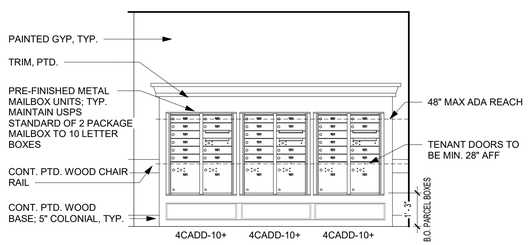

A3 MAILBOX ELEVATION 1
3/8" = 1'-0"

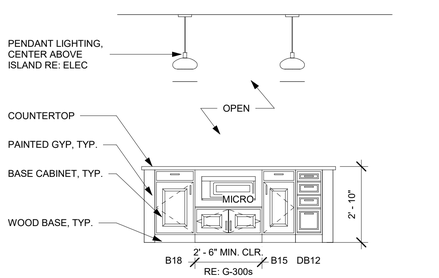

A2 COMMUNITY KITCHEN ELEVATION 2
3/8" = 1'-0"

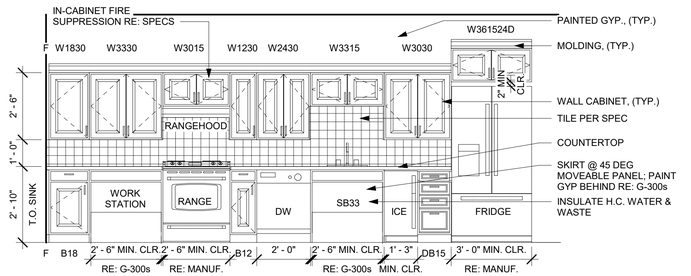

A1 COMMUNITY KITCHEN ELEVATION 1
3/8" = 1'-0"

rosemann & ASSOCIATES P.C.
ARCHITECTURE
INTERIOR DESIGN
ENGINEERING
PLANNING
1526 Grand Boulevard
Kansas City, MO 64108-1404
p: 816.472.1448
w: www.rosemann.com

© 2023 Rosemann & Associates, P.C.

DENVER ▲ KANSAS CITY ▲ ST. LOUIS ▲ ATLANTA

STATE OF MISSOURI
DAVID EUGENE HENDRIKSE
NUMBER A-7365
REGISTERED ARCHITECT

12/27/23

WILSHIRE HILLS III

LEE'S SUMMIT, MISSOURI

MHDC - 22-057

SHEET TITLE
INTERIOR ELEVATIONS

PROJECT NUMBER: 23034

SHEET NUMBER:

A-700

12/27/2023 8:55:14 AM
C:\Revit Local Data\23034_Wilshire Hills III_Central_R23_mm8TUCAR.rvt

ELECTRICAL SYMBOL LEGEND

SOME SYMBOLS AND ABBREVIATIONS ON THIS LEGEND MAY NOT BE USED

CIRCUITING

- HOME RUN (2#12 1#12G UNO)
- INDICATES 2 PHASE, 1 N, & 1 GRD CONDUCTOR
- HOME RUN: INDICATES SHARED CIRCUIT
- HOME RUN: INDICATES #10 CONDUCTORS ENTIRELY

UTILITIES

- UGE — UNDERGROUND ELECTRICAL
- OHE — OVERHEAD ELECTRICAL
- TELE — TELECOMMUNICATIONS CONDUIT
- UGT — UNDERGROUND TELECOMMUNICATIONS CONDUIT

LIGHTING

- FLUORESCENT LIGHT FIXTURE
- FLUORESCENT STRIP FIXTURE
- SURFACE/RECESSED LIGHT FIXTURE
- WALL-MOUNTED LIGHT FIXTURE
- POLE-MOUNTED LIGHT FIXTURE
- EXIT LIGHT
- BATTERY-OPERATED EMERGENCY LIGHT (WALL MTD)
- BATTERY-OPERATED EMERGENCY LIGHT (CEILING MTD)
- WALL-MOUNTED COMBINATION EXIT LIGHT/ BATTERY-OPERATED EMERGENCY LIGHT
- $ — LIGHT SWITCH – SINGLE POLE
- $3 — LIGHT SWITCH – 3-WAY
- $4 — LIGHT SWITCH – 4-WAY
- $K — LIGHT SWITCH – KEY
- $D — LIGHT SWITCH – DIMMER
- $PL — LIGHT SWITCH – PILOT LIGHT
- $2P — LIGHT SWITCH – 2 POLE
- $D3 — LIGHT SWITCH – 3-WAY DIMMER
- $M — WALL-MOUNTED MOTION SWITCH
- (M) — CEILING-MOUNTED MOTION SWITCH
- FD1 — DIMMER BOARD
- RCS-1 — REMOTE CONTROL SWITCH AS SCHEDULED
- TC — TIMECLOCK – REFER TO PLANS / DETAILS

EQUIPMENT

- DISCONNECT SWITCH. RE: PLANS FOR INFORMATION.
- MAGNETIC MOTOR STARTER
- COMBINATION DISCONNECT SWITCH / MOTOR STARTER
- TOGGLE-TYPE DISCONNECT. FURNISH WITH THERMAL MOTOR PROTECTION WHERE SERVING FANS/PUMPS.
- SURFACE PANELBOARD
- RECESSED PANELBOARD

GENERAL SYMBOLS

- INDICATES CONNECT TO EXISTING
- INDICATES ELEVATION

POWER DEVICES

- DUPLEX RECEPTACLE.
- LINE THRU DEVICE INDICATES ABOVE COUNTER
- GFI — SPECIAL DUPLEX RECEPTACLE (GFCI, ISOLATED GROUND, ETC.)
- QUADPLEX RECEPTACLE
- 5-50R — SIMPLEX RECEPTACLE W/NEMA CONFIG AS NOTED
- 5-50R — MULTI-POLE RECEPTACLE W/NEMA CONFIG AS NOTED
- CEILING MOUNTED RECEPTACLE
- RECEPTACLE/DEVICE MOUNTED IN "TOMBSTONE"
- POKE-THRU WITH POWER
- POKE-THRU WITH TELECOMMUNICATIONS
- POKE-THRU W/POWER AND TELECOM
- TC — SINGLE GANG FLOOR BOX (2, 3, 4 GANG SIMILAR)
- PLUG MOLD / WIRE MOLD AS SPECIFIED
- J — JUNCTION BOX
- T — THERMOSTAT – ELECTRIC
- PUSH BUTTON
- MOTOR

TELEPHONE/DATA

- TELEPHONE OUTLET
- LINE THRU DEVICE INDICATES ABOVE COUNTER
- DATA OUTLET
- TELEPHONE/DATA OUTLET
- 1V — PHONE OUTLET WITH NUMBER OF PHONE JACKS AS INDICATED – SEE DETAILS FOR ADD'L INFO.
- 1D — DATA OUTLET WITH NUMBER OF PHONE JACKS AS INDICATED – SEE DETAILS FOR ADD'L INFO.
- 1D/1V — PHONE/DATA OUTLET WITH NUMBER OF PHONE/DATA JACKS AS INDICATED – SEE DETAILS FOR ADD'L INFO.
- W — WALL-MOUNTED WIRELESS INTERNET TRANSMITTER
- W — CEILING-MOUNTED WIRELESS INTERNET TRANSMITTER

AUDIO/VISUAL

- TV — TELEVISION OUTLET
- S — WALL SPEAKER
- S — CEILING SPEAKER
- S — WALL SPEAKER – HORN TYPE
- S — CEILING SPEAKER – HORN TYPE
- SSUB — CEILING SPEAKER – SUBWOOFER
- SSS — CEILING SPEAKER – SOUND SYSTEM
- V — VOLUME CONTROL
- I — INTERCOM CALL STATION
- INTERCOM HANDSET
- SOUND SYSTEM AUDIO JACK
- RM — REMOTE MICROPHONE CONTROL
- PAS — PUBLIC ADDRESS SYSTEM AMPLIFIER
- IMS — INTERCOM MASTER STATION

FIRE ALARM

- F — MANUAL PULL STATION
- D — CEILING SMOKE DETECTOR
- D — DUCT SMOKE DETECTOR
- H — HEAT DETECTOR
- WF — WATERFLOW SWITCH
- TS — TAMPER SWITCH
- 75 — VISIBLE NOTIFICATION DEVICE WITH CANDELA RATING. 15cd RATING UNLESS OTHERWISE NOTED ON PLANS.
- 30 — AUDIBLE/VISIBLE NOTIFICATION DEVICE WITH CANDELA RATING. 15cd UNLESS OTHERWISE NOTED ON PLANS.
- HORN
- 75 — CEILING-MOUNTED STROBE LIGHT WITH CANDELA RATING. MINIMUM OF 15cd RATING.
- 30 — CEILING-MOUNTED COMBINATION HORN/STROBE WITH CANDELA RATING. MIN. OF 15cd RATING.
- CEILING-MOUNTED HORN
- CEILING-MOUNTED SPEAKER
- R — RELAY
- FACP — FIRE ALARM CONTROL PANEL
- FAAP — FIRE ALARM ANNUNCIATOR PANEL
- FARA — REMOTE ANNUNCIATOR PANEL
- FAEC — FIRE ALARM EXTENDER CABINET
- DH — DOOR HOLDER
- D/120V — SINGLE / MULTI-STATION 120V SMOKE ALARM
- ZAM — ZONE ADDRESSABLE MODULE
- IAM — INDIVIDUAL ADDRESSABLE MODULE
- HFSS — KITCHEN HOOD FIRE SUPPRESSION SYSTEM PANEL
- H — KITCHEN HOOD REMOTE PULL STATION
- ARA — AREA OF RESCUE ASSISTANCE STATION
- ARAM — AREA OF RESCUE ASSISTANCE MASTER STATION

MECHANICAL AND PLUMBING SYMBOL LEGEND

SOME SYMBOLS AND ABBREVIATIONS ON THIS LEGEND MAY NOT BE USED

SHEET METAL

- HIGH EFFICIENCY ROUND DUCT TAKEOFF (WITH & WITHOUT MANUAL DAMPER)
- SPIN-IN ROUND DUCT TAKEOFF (WITH & WITHOUT MANUAL DAMPER)
- CONICAL BELLMOUTH ROUND TAKEOFF
- ROUND DUCT RUNOUT WITH FLEX DUCT
- DUCTWORK ELBOW (WITH & WITHOUT TURNING VANES)
- XD — FD:FIRE DAMPER FS:FIRE/SMOKE DAMPER SD:SMOKE DAMPER BD:BACKDRAFT DAMPER (GRAVITY)
- MD — AUTOMATIC MOTORIZED DAMPER
- 8"Ø A 225 — SUPPLY DIFFUSER AND DIFFUSER CALLOUT (NECK SIZE, TYPE AND CFM)
- LINEAR/SLOT DIFFUSER
- RETURN GRILLE OR EXHAUST REGISTER
- SUPPLY AIR FLOW INDICATOR
- RETURN AND EXHAUST AIR FLOW INDICATOR
- THERMOSTAT
- TEMPERATURE SENSOR
- H — HUMIDISTAT
- CONTROL WIRING

GENERAL SYMBOLS

- INDICATES CONNECT TO EXISTING
- INDICATES ELEVATION

MECHANICAL PIPING

- RL — REFRIGERANT LIQUID
- RS — REFRIGERANT SUCTION
- D — DRAIN (CONDENSATE)
- CA — COMPRESSED AIR

PLUMBING PIPING

- DOMESTIC COLD WATER
- DOMESTIC HOT WATER
- RECIRCULATING DOMESTIC HOT WATER
- SAN — WASTE ABOVE GRADE OR FLOOR
- SAN — WASTE BELOW GRADE OR FLOOR
- ST — STORM ABOVE GRADE OR FLOOR
- ST — STORM BELOW GRADE OR FLOOR
- ST/O — STORM OVERFLOW ABOVE GRADE OR FLOOR
- ST/O — STORM OVERFLOW BELOW GRADE OR FLOOR
- V — PLUMBING VENT
- W — WATER SERVICE
- G — GAS (NATURAL)
- PD — FROM SUMP PUMP DISCHARGE
- CA — COMPRESSED AIR
- LP — PROPANE
- SCW — SOFT DOMESTIC COLD WATER
- SHW — SOFT DOMESTIC HOT WATER
- SRW — SOFT RECIRCULATING HOT WATER

FIRE SPRINKLER

- F — FIRE PROTECTION PIPING
- SPRINKLER HEAD
- SIDEWALL SPRINKLER HEAD
- FIRE PROTECTION SIAMESE CONNECTION
- POST INDICATOR VALVE

PIPING SYMBOLS

- SHUTOFF VALVE
- SHUTOFF VALVE IN RISER
- BALANCING VALVE
- PLUG VALVE
- AUTO FLOW CONTROL VALVE
- PIPING ELBOW UP
- PIPING ELBOW DOWN
- PIPING TEE
- PIPING ELBOW
- PIPING TEE UP
- PIPING TEE DOWN
- INCREASER / REDUCER
- UNION
- CAP
- PIPE FLEX
- STRAINER
- CHECK VALVE
- INLINE STRAINER
- TEST PLUG
- GUIDE
- ANCHOR
- TRIPLE DUTY VALVE
- AUTOMATIC 2-WAY CONTROL VALVE
- AUTOMATIC 3-WAY CONTROL VALVE
- S — SOLENOID VALVE

PIPING SPECIALTIES

- PRESS/ TEMP GAUGE WITH COCK
- THERMOMETER.
- HI ▶ LOW — PRESSURE REDUCING VALVE
- RELIEF VALVE
- WATER HAMMER ARRESTER

PLUMBING FIXTURES/EQUIPMENT

- HB — HOSE BIBB
- WH — WALL HYDRANT
- CLEAN OUT
- RPZ — REDUCED PRESSURE BACKFLOW PREVENTER
- DCBP — DOUBLE CHECK BACKFLOW PREVENTER
- WC-1 S-1 — PLUMBING FIXTURE AND CALLOUT
- FD-1 — FD: FLOOR DRAIN, AD: AREA DRAIN, FS: FLOOR SINK
- RD-1 — RD: ROOF DRAIN ORD: OVERFLOW ROOF DRAIN

ABBREVIATIONS

A/E	ARCHITECT / ENGINEER	ELEV	ELEVATION	MLO	MAIN LUGS ONLY
AFF	ABOVE FINISHED FLOOR	EM	EMERGENCY FIXTURE/DEVICE	NFA	NET FREE AREA
AFG	ABOVE FINISHED GRADE	EWT	ENTERING WATER TEMPERATURE	NL	NIGHT LIGHT
AG	ABOVE GRADE	EX	EXISTING ITEM	OA	OUTSIDE AIR
AHJ	AUTHORITY HAVING JURISDICTION	FFA	FROM FLOOR ABOVE	ORD	OVERFLOW ROOF DRAIN
AHU	AIR HANDLING UNIT	FFB	FROM FLOOR BELOW	P/C	PLUMBING CONTRACTOR
ARCH	ARCHITECT	FFCO	FINISHED FLOOR CLEAN OUT	PSI	POUNDS PER SQUARE INCH
BFP	BACKFLOW PREVENTER	FGCO	FLUSH GRADE CLEAN OUT	PVC	POLYVINYLCHLORIDE
BG	BELOW GRADE	FL	FLOW LINE	RA	RETURN AIR
BLDG	BUILDING	FLR	FLOOR	RE/REF	REFER / REFERENCE
BMS	BUILDING MANAGEMENT SYSTEM	FP	FIRE PROTECTION	RF	RELIEF FAN
C	CONDUIT	FPM	FEET PER MINUTE	RL	RELOCATED ITEM
CD	CANDELA	FWCO	FLUSH WALL CLEAN OUT	RPZ	REDUCED PRESSURE ZONE
CD	COLD DECK	G	GROUND / GANG	RR	RESTROOM
CLG	COOLING	G/C	GENERAL CONTRACTOR	SA	SUPPLY AIR
CM	COORDINATE MOUNTING HEIGHT	GFCI	GROUND FAULT CIRCUIT INTERUPTER	SPD	SURGE PROTECTIVE DEVICE
CO	CLEAN OUT	GPM	GALLONS PER MINUTE	ST	SHUNT TRIP
CTE	CONNECT TO EXISTING	HD	HOT DECK	TA	TRANSFER AIR
DCVA	DOUBLE CHECK VALVE ASSEMBLY	HTG	HEATING	TFA	TO FLOOR ABOVE
DCW	DOMESTIC COLD WATER	IG	ISOLATED GROUND	TFB	TO FLOOR BELOW
DDC	DIRECT DIGITAL CONTROLS	JB	JUNCTION BOX	TP	TAMPERPROOF
DF	DRINKING FOUNTAIN	LED	LIGHT EMITTING DIODE	TYP	TYPICAL
DHW	DOMESTIC HOT WATER	LWT	LEAVING WATER TEMPERATURE	UNO	UNLESS NOTED OTHERWISE
DHWR	DOMESTIC HOT WATER RETURN	M/C	MECHANICAL CONTRACTOR	VRF	VARIABLE REFRIGERANT FLOW
DIA	DIAMETER	MA	MIXED AIR	VTR	VENT THROUGH ROOF
DN	DOWN	MAU	MAKE UP AIR UNIT	WCO	WALL CLEANOUT
E/C	ELECTRICAL CONTRACTOR	MCB	MAIN CIRCUIT BREAKER	WG	WIRE GUARD
EA	EXHAUST AIR	MECH	MECHANICAL	WP	WEATHERPROOF
EDF	ELECTRIC DRINKING FOUNTAIN	MH	MANHOLE		

FIRE SEALING NOTES

1. *COORDINATE CONSTRUCTION OF OPENINGS AND PENETRATING ITEMS TO ENSURE THAT THROUGH-PENETRATION FIRESTOP SYSTEMS ARE INSTALLED ACCORDING TO SPECIFIED AND APPLICABLE UL REQUIREMENTS.*
2. *COORDINATE SIZING OF SLEEVES, OPENINGS, CORE-DRILLED HOLES, OR CUT OPENINGS TO ACCOMMODATE THROUGH-PENETRATION FIRESTOP SYSTEMS.*
3. *DO NOT COVER UP THROUGH-PENETRATION FIRESTOP SYSTEM INSTALLATIONS UNTIL EXAMINED BY INSPECTOR, IF REQUIRED BY AUTHORITIES HAVING JURISDICTION.*
4. *COMPATIBILITY: PROVIDE THROUGH-PENETRATION FIRESTOP SYSTEMS THAT ARE COMPATIBLE WITH ONE ANOTHER; WITH THE SUBSTRATES FORMING OPENINGS; AND WITH THE ITEMS, IF ANY, PENETRATING THROUGH-PENETRATION FIRESTOP SYSTEMS, UNDER CONDITIONS OF SERVICE AND APPLICATION, AS DEMONSTRATED BY THROUGH-PENETRATION FIRESTOP SYSTEM MANUFACTURER BASED ON TESTING AND FIELD EXPERIENCE.*
5. *PROVIDE COMPONENTS FOR EACH THROUGH-PENETRATION FIRESTOP SYSTEM THAT ARE NEEDED TO INSTALL FILL MATERIALS. USE ONLY COMPONENTS SPECIFIED BY THROUGH-PENETRATION FIRESTOP SYSTEM MANUFACTURER AND APPROVED BY QUALIFIED TESTING AND INSPECTING AGENCY FOR FIRESTOP SYSTEMS INDICATED.*
6. *PROVIDE SLEEVES THROUGH ALL FIRE-RATED WALLS AND FILL VOIDS SURROUNDING SLEEVES AND INTERIOR TO SLEEVES AROUND PIPING WITH FIRE STOP PUTTY WITH U.L. LISTED 3 HOUR RATING INSTALLED AS PER MANUFACTURERS RECOMMENDATIONS.*
7. *FIRE SEAL ALL PIPING, CONDUIT, CABLE, ETC PENETRATIONS ROUTED THROUGH FIRE RATED WALLS.*
8. *PROVIDE FIRE RATED ENCLOSURES OR WRAPS ON LIGHT FIXTURES AND OTHER ITEMS PENETRATING FIRE RATED CEILINGS, FLOOR/CEILING/ CEILING/ROOF ASSEMBLIES TO MAINTAIN UL LISTING FOR CONSTRUCTION.*

GEN. MECHANICAL NOTES

1. *COMPLETE INSTALLATION SHALL BE IN ACCORDANCE WITH THE LATEST ADOPTED VERSION OF THE INTERNATIONAL MECHANICAL CODE, LOCAL AND STATE CODES, AND REQUIREMENTS OF THE AHJ.*
2. *ANY POWER FOR CONTROL SYSTEMS TO BE PROVIDED BY E/C IS INDICATED ON ELECTRICAL PLANS. ANY ADDITIONAL LINE VOLTAGE OR LOW VOLTAGE POWER REQUIRED BY THE M/C OR SUBCONTRACTORS TO HAVE A FULLY FUNCTIONING SYSTEM SHALL BE PROVIDED BY THE M/C CONTRACTOR OR SUBS.*
3. *ALL EQUIPMENT SHALL BE ADEQUATELY AND PROPERLY SUPPORTED AND FASTENED FROM STRUCTURE.*
4. *ALL EQUIPMENT AND ACCESSORIES INSTALLED IN CONCEALED SPACES REQUIRING ACCESS SHALL BE PROVIDED WITH ACCESS DOORS MEETING ANY FIRE REQUIREMENTS OF THE WALL/CEILING THEY ARE INSTALLED.*
5. *EACH AIR HANDLING UNIT OVER 2000CFM SHALL BE PROVIDED WITH A SMOKE DETECTOR TO SHUT DOWN THE UNIT PER IMC 606 AS REQUIRED BY AHJ. COORDINATE WITH OTHER TRADES.*
6. *START UP AND ADJUST ALL EQUIPMENT AND VERIFY ALL MECHANICAL SYSTEMS IN OPERATE IN ACCORDANCE WITH THEIR INTENDED PURPOSES. SUBMIT BALANCE AND START UP REPORTS TO THE A/E. REFER TO SPECIFICATIONS FOR ANY ADDITIONAL REQUIREMENTS.*

GENERAL PLUMBING NOTES

1. *COMPLETE INSTALLATION SHALL BE IN ACCORDANCE WITH THE LATEST ADOPTED VERSION OF THE INTERNATIONAL PLUMBING CODE, LOCAL AND STATE CODES, AND REQUIREMENTS OF THE AHJ.*
2. *NO PIPING SHALL BE INSTALLED WHERE IT WILL SUBJECT TO FREEZING TEMPERATURES. PIPING IN EXTERIOR WALLS SHALL BE INSTALLED ON THE WARM SIDE OF BUILDING INSULATION, INSULATED AND THE CHASE SHALL BE VENTILATED WITH GRILLES ALLOWING INDOOR AMBIENT CONDITIONS TO CIRCULATE THROUGH THE CHASE.*
3. *PROVIDE CLEANOUTS IN THE FOLLOWING LOCATIONS:*
   - 3.1. *IN ALL HORIZONTAL DRAINS (WITHIN THE BUILDING) NOT MORE THAN 100 FEET APART.*
   - 3.2. *IN BUILDING SEWERS LOCATED NO MORE THAN 100 FEET APART MEASURED FROM THE UPSTREAM ENTRANCE OF THE CLEANOUT.*
   - 3.3. *EACH CHANGE OF DIRECTION OF THE BUILDING DRAIN OR HORIZONTAL WASTE OR SOIL LINES GREATER THAN 45 DEGREES. WHERE MORE THAN ONE CHANGE OF DIRECTION OCCURS IN A RUN OF PIPING, ONLY ONE CLEANOUT SHALL BE REQUIRED FOR EACH 40 FEET OF DEVELOPED LENGTH OF THE DRAINAGE PIPING.*
   - 3.4. *AT THE BASE OF EACH WASTE OR SOIL STACK.*
   - 3.5. *NEAR THE JUNCTION OF THE BUILDING DRAIN AND BUILDING SEWER.*

GENERAL ELECTRICAL NOTES

1. *COMPLETE INSTALLATION SHALL BE IN ACCORDANCE WITH THE LATEST ADOPTED VERSION OF THE NATIONAL ELECTRICAL CODE, LOCAL AND STATE CODES, AND REQUIREMENTS OF THE AHJ.*
2. *COORDINATE LOCATIONS OF RECEPTACLES, SWITCHES, ETC. WITH ARCHITECTURAL CASEWORK AND ELEVATIONS.*
3. *REFER TO MOUNTING HEIGHTS DETAIL FOR MOUNTING HEIGHTS OF ALL DEVICES NOT INDICATED OTHERWISE.*
4. *PROVIDE ALL EMPTY CONDUITS WITH PULL STRINGS AND BUSHED ENDS.*
5. *CONTRACTOR SHALL CONCEAL ALL CONDUIT, FITTINGS, AND DEVICES FROM VIEW WHERE REASONABLY POSSIBLE.*

COORDINATION NOTES

1. *COORDINATE REQUIREMENTS FOR INSTALLATION OF SYSTEMS AND EQUIPMENT WITH ALL OTHER TRADES.*
2. *THE CONTRACTOR SHALL COORDINATE THE ROUTING AND PATH OF ALL SYSTEMS, CONDUITS, PIPES, DUCTS, ETC WITH THE POSITION AND LAYOUT OF THE STRUCTURE. THE CONTRACTOR IS RESPONSIBLE FOR PROVIDING NECESSARY OFFSETS, TURNS, RISES AND DROPS FOR SYSTEMS AND COMPONENTS AS NEEDED TO INSTALL THE MEP SYSTEMS TO CLEAR STRUCTURE, CEILINGS, ETC AND OTHER SYSTEMS IN POTENTIAL CONFLICT WITH ROUTING.*
3. *COORDINATE WORK WITH OTHER TRADES TO INSTALL SYSTEMS ABOVE CEILING HEIGHTS INDICATED ON ARCHITECTURAL PLANS.*
4. *CHECK SPACE REQUIREMENTS WITH OTHER TRADES AND STRUCTURE/CONSTRUCTION TO ENSURE THAT ALL MATERIALS AND EQUIPMENT CAN BE INSTALLED IN THE SPACE ALLOTTED INCLUDING FINISHED SUSPENDED CEILINGS AND OTHER SPACES, CHASES, ETC WITHIN THE BUILDING. MAKE MODIFICATIONS THERETO AS REQUIRED AND APPROVED.*
5. *TRANSMIT TO OTHER TRADES ALL INFORMATION REQUIRED FOR WORK TO BE PROVIDED UNDER THEIR RESPECTIVE SECTIONS IN AMPLE TIME FOR INSTALLATION.*
6. *WHEREVER WORK INTERCONNECTS WITH WORK OF OTHER TRADES, COORDINATE WITH THOSE TRADES TO ENSURE THAT ALL SUBCONTRACTORS HAVE THE INFORMATION NECESSARY SO THAT THEY MAY PROPERLY INSTALL ALL CONNECTIONS AND EQUIPMENT. IDENTIFY ALL ITEMS OF WORK THAT REQUIRE ACCESS SO THAT THE CEILING TRADE WILL KNOW WHERE TO INSTALL ACCESS DOORS AND PANELS.*
7. *COORDINATE, PROJECT AND SCHEDULE WORK WITH OTHER TRADES IN ACCORDANCE WITH THE CONSTRUCTION SEQUENCE.*
8. *DRAWINGS SHOW THE GENERAL RUNS OF CONDUITS, PIPING AND DUCTWORK AND APPROXIMATE LOCATION OF OUTLETS. ANY SIGNIFICANT CHANGES IN LOCATION OF ITEMS NECESSARY IN ORDER TO MEET FIELD CONDITIONS SHALL BE BROUGHT TO THE IMMEDIATE ATTENTION OF THE ARCHITECT/ENGINEER AND RECEIVE HIS APPROVAL BEFORE SUCH ALTERATIONS ARE MADE. ALL SUCH MODIFICATIONS SHALL BE MADE WITHOUT ADDITIONAL COST TO THE OWNER.*
9. *CONTRACTOR SHALL BE RESPONSIBLE FOR PROTECTION AND REPAIR OF SURFACES, AREAS AND PROPERTY THAT MAY BE DAMAGED AS A RESULT OF CONSTRUCTION ACTIVITIES.*
10. *ADJUST LOCATION OF PIPING, DUCTWORK, ETC. TO PREVENT INTERFERENCES, BOTH ANTICIPATED AND ENCOUNTERED. DETERMINE THE EXACT ROUTE AND LOCATION OF EACH ITEM PRIOR TO FABRICATION. MAKE OFFSETS, TRANSITIONS AND CHANGES IN DIRECTION IN SYSTEMS AS REQUIRED TO MAINTAIN ADEQUATE CLEARANCES AND HEADROOM.*
11. *WHEREVER THE WORK IS OF SUFFICIENT COMPLEXITY, PREPARE ADDITIONAL COORDINATION DRAWINGS AND ORGANIZE ON-SITE MEETINGS WITH ALL RELATED SUBCONTRACTORS TO COORDINATE THE WORK BETWEEN TRADES. DRAWINGS SHALL CLEARLY SHOW THE WORK AND ITS RELATION TO THE WORK OF OTHER TRADES, AND BE SUBMITTED FOR REVIEW PRIOR TO COMMENCING SHOP FABRICATION OR ERECTION IN THE FIELD.*
12. *COORDINATE WITH LOCAL UTILITY PROVIDERS FOR THEIR REQUIREMENTS FOR SERVICE CONNECTIONS AND PROVIDE ALL NECESSARY PAYMENTS, MATERIALS, LABOR AND TESTING TO ACCOMPLISH THE WORK.*

GENERAL NOTES

1. *SOME ROOM NAMES MAY NOT BE SHOWN FOR PURPOSE OF CLARIFYING PLAN. REFER TO ARCHITECTURAL PLANS FOR REFERENCE TO ROOM NAMES NOT SHOWN.*
2. *IT IS THE RESPONSIBILITY OF THE CONTRACTOR TO MAINTAIN AND KEEP AT THE JOB SITE, AN UP TO DATE SET OF "RECORD DRAWINGS" SHOWING ALL CHANGES FROM THE ORIGINAL PLANS. THE CONTRACTOR SHALL DELIVER THE "RECORD DRAWINGS" TO THE ENGINEER AT THE CONCLUSION OF THE PROJECT ELECTRONICALLY.*
3. *THESE DRAWINGS ARE DIAGRAMMATIC. THE CONTRACTOR SHALL VERIFY ALL CONDITIONS (NEW AND EXISTING), DIMENSIONS, AND CLEARANCES PRIOR TO THE COMMENCEMENT OF WORK AND SHALL INCLUDE ALL COSTS, EQUIPMENT, MATERIAL, ACCESSSORIES, ETC. REQUIRED FOR A FULLY COMPLETE, FUNCTIONAL AND CODE COMPLIANT INSTALLATION.*
4. *FINAL LOCATIONS OF ALL DEVICES, LIGHT FIXTURES, EQUIPMENT ETC SHALL BE INDICATED ON THE ARCHITECTURAL DRAWINGS. ALL DIMENSIONAL INFORMATION SHALL BE OBTAINED FROM ARCHITECTURAL PLANS. NO DIMENSIONAL INFORMATION SHALL BE OBTAINED FROM MEP DRAWINGS.*
5. *THE CONTRACTOR SHALL OBTAIN ALL REQUIRED PERMITS, APPROVALS, LICENSES, ETC. AS NEEDED FOR THE COMPLETE INSTALLATION AND PROJECT. THE CONTRACTOR SHALL COORDINATE WITH THE OWNER FOR ALL FEES AND DATA NEEDED FOR THIS.*

SHEET INDEX

MEP000	MEP COVER SHEET
MEP101	MEP SITE PLAN
MEP200	MEP PENETRATION DETAILS
MEP201	MEP PENETRATION DETAILS
M101	FIRST FLOOR HVAC PLAN
M102	SECOND FLOOR HVAC PLAN
M103	THIRD FLOOR HVAC PLAN
M201	ENLARGED UNIT PLANS - HVAC
M301	MECHANICAL SCHEDULES
M401	MECHANICAL DETAILS
P101	FIRST FLOOR PLUMBING PLAN
P102	SECOND FLOOR PLUMBING PLAN
P103	THIRD FLOOR PLUMBING PLAN
P201	ENLARGED UNIT PLANS - PLUMBING
P301	PLUMBING SCHEDULES
P302	PLUMBING DETAILS
E101	FIRST FLOOR LIGHTING PLAN
E102	SECOND FLOOR LIGHTING PLAN
E103	THIRD FLOOR LIGHTING PLAN
E111	ENLARGED UNIT PLANS - LIGHTING
E201	FIRST FLOOR POWER PLAN
E202	SECOND FLOOR POWER PLAN
E203	THIRD FLOOR POWER PLAN
E211	ENLARGED UNIT PLANS - POWER
E301	ELECTRICAL RISER DIAGRAMS
E302	ELECTRICAL SCHEDULES
E303	ELECTRICAL SCHEDULES
E401	ELECTRICAL SCHEDULES/DETAILS
E402	ELECTRICAL DETAILS
SL100	SITE PHOTOMETRICS

PRINTS ISSUED

10/30/2023 - PERMIT SUBMITTAL

REVISIONS:

pkmr ENGINEERS

PEARSON KENT MCKINLEY RAAF ENGINEERS LLC
13300 W 98TH STREET LENEXA, KS 66215
913.492.2400 WWW.PKMRENG.COM
MO State Certificate of Authority #E-2002020886

23.161

STATE OF MISSOURI
MICHAEL D RAAF
NUMBER PE-2005028097
REGISTERED PROFESSIONAL ENGINEER
10/30/23

Michael D. Raaf - Engineer
MO# PE-2005028097

WILSHIRE HILLS III

LEE'S SUMMIT, MISSOURI

SHEET TITLE
MEP COVER SHEET

PROJECT NUMBER: 23.161

SHEET NUMBER:

MEP000

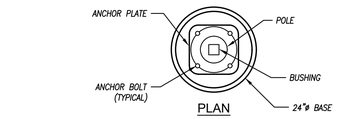

PLAN

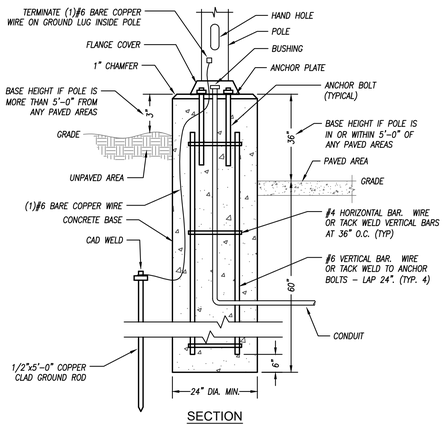

SECTION

POLE BASE DETAIL

NOT TO SCALE

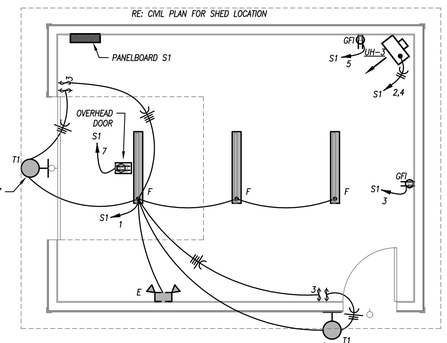

SHED - FLOOR PLAN

1/4" = 1' - 0"

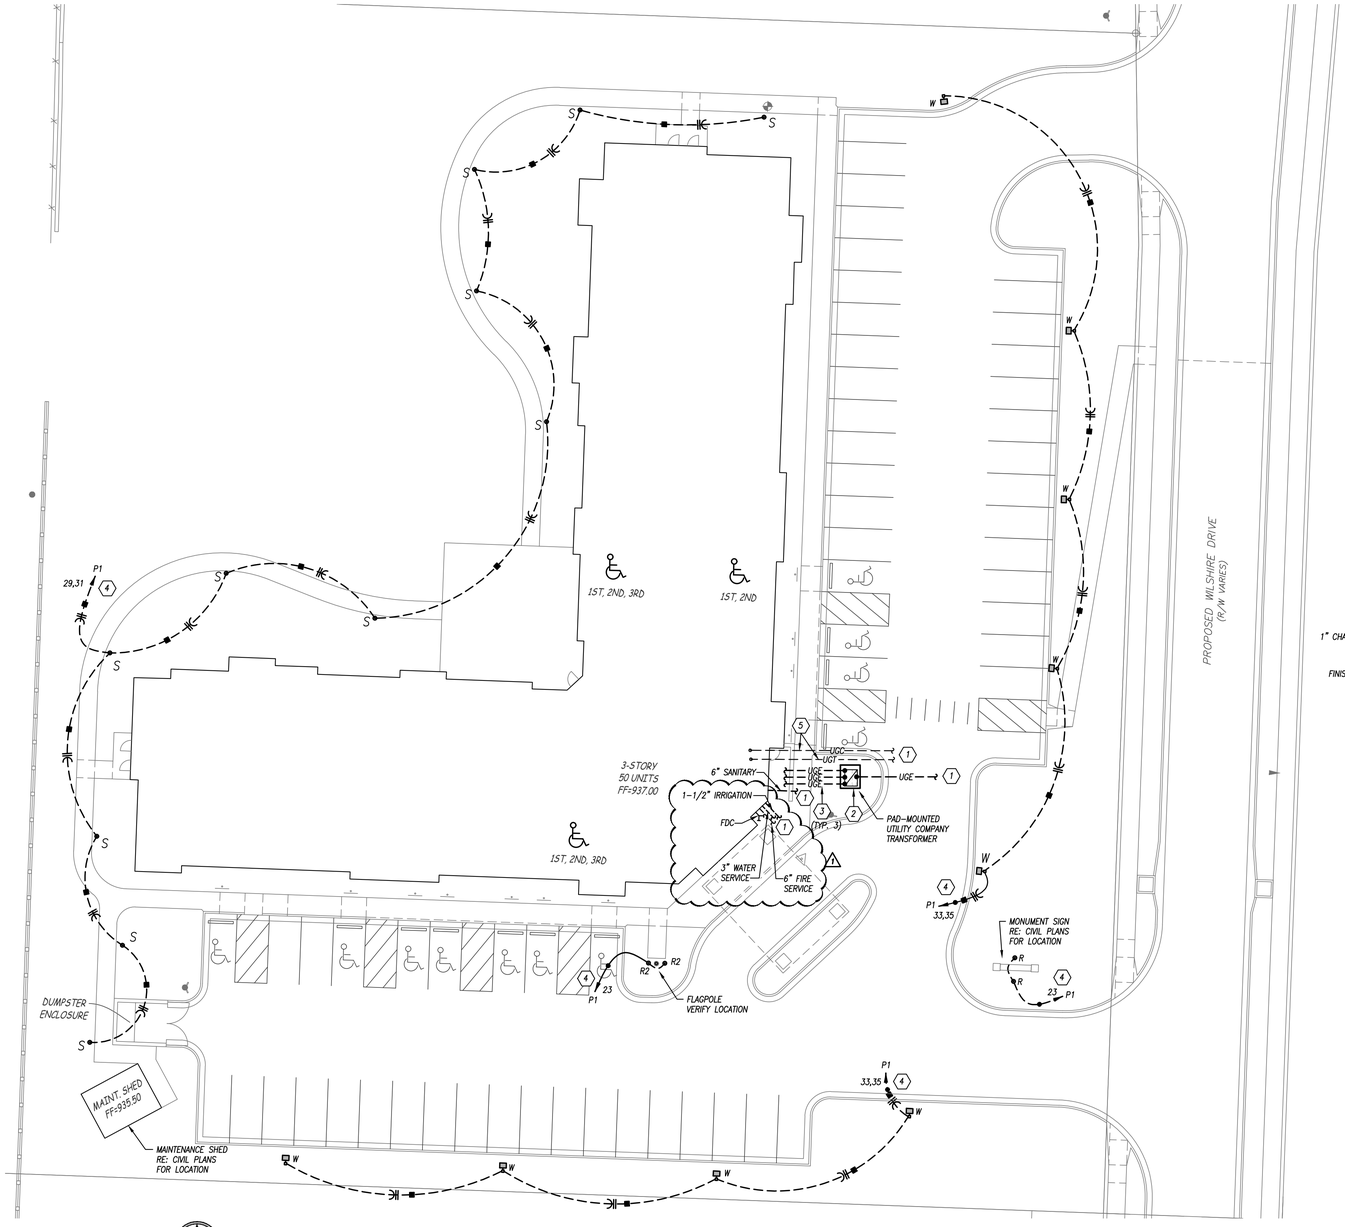

SITE PLAN - MECHANICAL / ELECTRICAL

1"=20'-0"

GENERAL SITE PLAN NOTES

1. REFER TO GENERAL NOTES ON MEP COVER SHEET FOR ADDITIONAL REQUIREMENTS OF WORK.

2. REFER TO CIVIL PLANS FOR CONTINUATION OF SERVICES BEYOND 5'-0" FROM BUILDING UNLESS OTHERWISE SHOWN.

3. REFER TO RESPECTIVE FLOOR PLANS FOR CONTINUATION OF SERVICES INSIDE BUILDING AND/OR EXACT LOCATIONS OF EQUIPMENT.

4. CONTACT UTILITY LOCATING SERVICE TO LOCATE EXACT LOCATION OF ALL EXISTING UTILITIES BELOW GRADE.

SITE PLAN KEYED NOTES

1. REFER TO CIVIL PLANS FOR CONTINUATION OF SERVICES.
2. PAD-MOUNTED UTILITY COMPANY TRANSFORMER. COORDINATE EXACT LOCATION IN FIELD WITH UTILITY CO. STUB OUT ONE (1) 4" PVC CONDUIT FOR FUTURE EXTENSION. CAP AND FLAG SAME.
3. REFER TO RISER DIAGRAM FOR NUMBER AND SIZE OF WIRE AND/OR CONDUIT REQUIRED.
4. ROUTE THROUGH REMOTE CONTROL SWITCH RCS-1, THEN HOMERUN. RE: SCHEDULES ON SHEET E401.
5. ONE (1) 4" EMPTY PVC CONDUIT FOR CABLE TELEVISION AND ONE (1) 4" EMPTY PVC CONDUIT FOR TELEPHONE. PROVIDE EACH WITH PULLSTRING AND TURN UP AT BACKBOARD LOCATION INSIDE BUILDING.

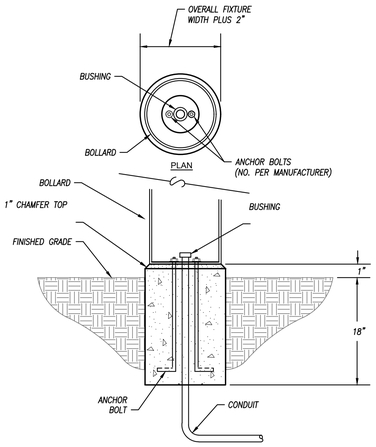

BOLLARD BASE

NOT TO SCALE

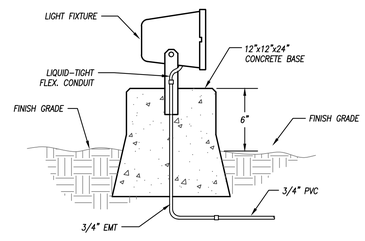

FLOOD LIGHT DETAIL

NOT TO SCALE

PRINTS ISSUED
10/30/2023 - PERMIT SUBMITTAL

REVISIONS:
1 12/15/2023 - CITY COMMENTS

pkmr ENGINEERS
PEARSON KENT MCKINLEY RAAF ENGINEERS LLC
13300 W 98TH STREET LENEXA, KS 66215
913.492.2400 WWW.PKMRENG.COM
MO State Certificate of Authority #E-2002020886

23.161

STATE OF MISSOURI
MICHAEL D RAAF
NUMBER PE-2005028097
REGISTERED PROFESSIONAL ENGINEER
12/15/23
Michael D. Raaf - Engineer
MO# PE-2005028097

WILSHIRE HILLS III

LEE'S SUMMIT, MISSOURI

SHEET TITLE
MEP SITE PLAN

PROJECT NUMBER: 23.161

SHEET NUMBER:

MEP101

System No. W-L-3194
May 19, 2005
F Ratings - 1 & 2 Hr (See Item 1)
T Ratings - 0 & 1/ 2 Hr (See Item 1)

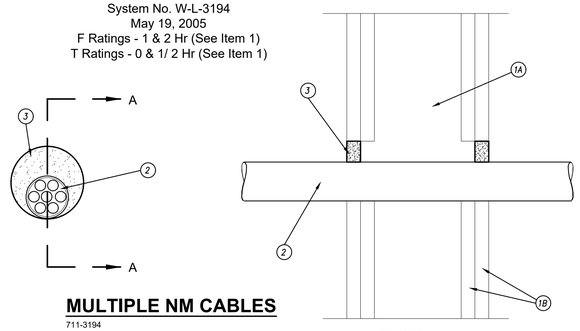

MULTIPLE NM CABLES

711-3194

SECTION A-A

1. WALL ASSEMBLY – THE 1 OR 2 HR FIRE RATED GYPSUM BOARD/STUD WALL ASSEMBLY SHALL BE CONSTRUCTED OF THE MATERIALS AND IN THE MANNER DESCRIBED IN THE INDIVIDUAL U300, U400 OR V400 SERIES WALL OR PARTITION DESIGN IN THE UL FIRE RESISTANCE DIRECTORY AND SHALL INCLUDE THE FOLLOWING CONSTRUCTION FEATURES:
   A. STUDS – WALL FRAMING MAY CONSIST OF EITHER WOOD STUDS OR STEEL CHANNEL STUDS. WOOD STUDS TO CONSIST OF NOM 2 IN. BY 4 IN. (51 MM BY 102 MM) LUMBER SPACED 16 IN. (406 MM) OC. STEEL STUDS TO BE MIN 3–1/2 IN. (89 MM) WIDE SPACED MAX 24 IN. (610 MM) OC.
   B. GYPSUM BOARD* – THE GYPSUM BOARD TYPE, THICKNESS, NUMBER OF LAYERS, FASTENER TYPE AND SHEET ORIENTATION SHALL BE AS SPECIFIED IN THE INDIVIDUAL U300 OR U400 SERIES DESIGN IN THE UL FIRE RESISTANCE DIRECTORY. MAX DIAM OF OPENING IS 2–1/2 IN. (64 MM).
   THE HOURLY F RATING OF THE FIRESTOP SYSTEM IS EQUAL TO THE HOURLY FIRE RATING OF THE WALL ASSEMBLY IN WHICH IT IS INSTALLED.
   THE HOURLY T RATING IS 0 AND 1/2 HR FOR 1 AND 2 HR RATED ASSEMBLIES, RESPECTIVELY.

2. CABLE – ONE CABLE INSTALLED ECCENTRICALLY OR CONCENTRICALLY WITHIN OPENING. ANNULAR SPACE BETWEEN CABLE AND PERIPHERY OF OPENING TO BE MIN 0 IN. (POINT CONTACT) TO MAX 1 IN. (0 MM TO MAX 25 MM). CABLE TO BE RIGIDLY SUPPORTED ON BOTH SIDES OF THE WALL. THE FOLLOWING TYPES AND SIZES OF CABLE MAY BE USED:
   A. MAX 200 PAIR NO. 22 AWG (OR SMALLER) COPPER CONDUCTOR WITH POLYVINYL CHLORIDE (PVC) INSULATION AND JACKETING MATERIAL.
   B. MAX 1/C NO. 350 KCMIL (OR SMALLER) COPPER CONDUCTOR CABLE WITH CROSS–LINKED POLYETHYLENE (XLPE) OR PVC JACKET.
   C. MAX 7/C NO. 12 AWG (OR SMALLER) COPPER CONDUCTOR POWER AND CONTROL CABLES WITH XLPE OR PVC INSULATION WITH XLPE OR PVC JACKET.
   D. MAX 3/C NO. 2/0 AWG (OR SMALLER) COPPER OR ALUMINUM CONDUCTOR SER CABLES WITH XLPE OR PVC INSULATION AND JACKET.
   E. MAX 4/C NO. 2/0 AWG (OR SMALLER) COPPER CONDUCTOR, ALUMINUM CLAD OR STEEL CLAD TECK 90 CABLE WITH OR WITHOUT PVC JACKETED.
   F. MAX 110/125 FIBER OPTIC (F.O.) CABLE WITH PVC INSULATION AND JACKET.
   G. MAX 3/C WITH GROUND NO. 8 AWG (OR SMALLER) COPPER CONDUCTOR NM CABLE WITH PVC INSULATION AND JACKET.
   H. MAX RG/U COAXIAL CABLE WITH FLUORINATED ETHYLENE INSULATION AND JACKET.
   I. MAX 4 PAIR NO. 24 AWG (OR SMALLER) COPPER CONDUCTOR DATA CABLE WITH HYLAR JACKET AND INSULATION.
   J. THROUGH PENETRATING PRODUCT* – ANY CABLES, ARMORED CABLE+ OR METAL CLAD CABLE+ CURRENTLY CLASSIFIED UNDER THE THROUGH PENETRATING PRODUCT CATEGORY.
   SEE THROUGH PENETRATING PRODUCT (XHLY) CATEGORY IN THE FIRE RESISTANCE DIRECTORY FOR NAMES OF MANUFACTURERS

3. FILL, VOID OR CAVITY MATERIAL* – CAULK OR SEALANT – MIN 5/8 IN. (16 MM) THICKNESS OF CAULK APPLIED WITHIN ANNULUS, FLUSH WITH BOTH SURFACES OF WALL. MIN 1/4 IN. (6 MM) DIAM BEAD OF CAULK APPLIED TO GYPSUM BOARD/CABLE INTERFACE AT POINT CONTACT LOCATION ON BOTH SIDES OF WALL.
   3M COMPANY – IC 15WB+, CP 25WB+ CAULK OR FB–3000 WT SEALANT

*BEARING THE UL CLASSIFICATION MARKING

INSTALLATION DETAIL FOR 3M FIRE BARRIER MOLDABLE PUTTY ON ELECTRICAL OUTLET BOXES

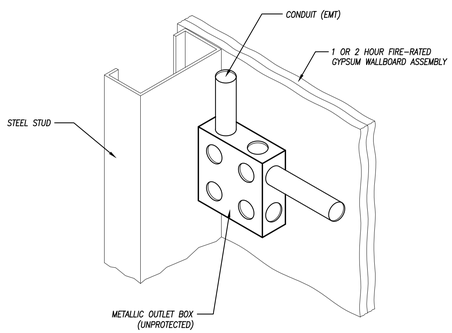

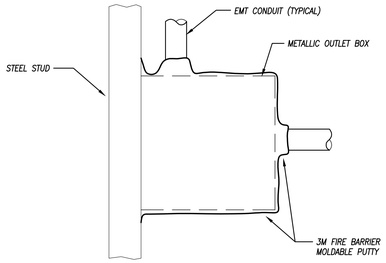

FRONT VIEW

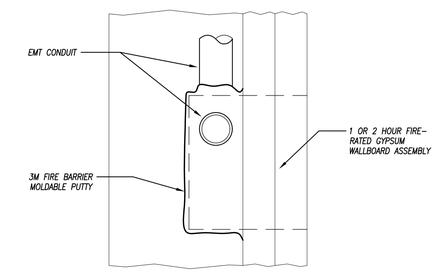

SIDE VIEW

System No. W-L-2300
May 19, 2005
F Ratings - 1 & 2 Hr (See Item 1)
T Ratings - 0 & 1/ 2 Hr (See Item 1)

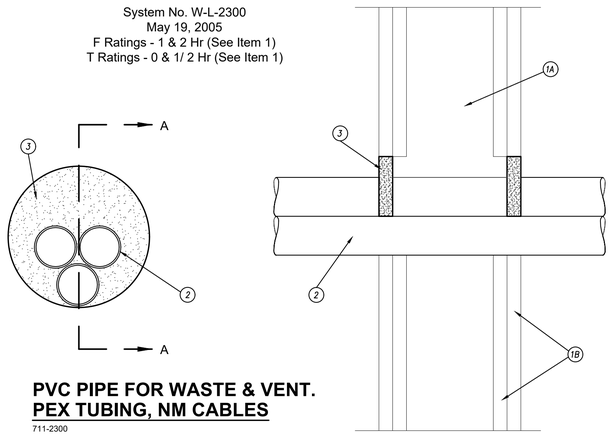

PVC PIPE FOR WASTE & VENT. PEX TUBING, NM CABLES

711-2300

SECTION A-A

1. WALL ASSEMBLY – THE 1 OR 2 HR FIRE RATED GYPSUM BOARD/STUD WALL ASSEMBLY SHALL BE CONSTRUCTED OF THE MATERIALS AND IN THE MANNER DESCRIBED IN THE INDIVIDUAL U300, U400 OR V400 SERIES WALL OR PARTITION DESIGN IN THE UL FIRE RESISTANCE DIRECTORY AND SHALL INCLUDE THE FOLLOWING CONSTRUCTION FEATURES:
   A. STUDS – WALL FRAMING MAY CONSIST OF EITHER WOOD STUDS OR STEEL CHANNEL STUDS. WOOD STUDS TO CONSIST OF NOM 2 IN. BY 4 IN. (51 MM BY 102 MM) LUMBER SPACED 16 IN. (406 MM) OC. STEEL STUDS TO BE MIN 3–1/2 IN. (89 MM) WIDE SPACED MAX 24 IN. (610 MM) OC.
   B. GYPSUM BOARD* – THE GYPSUM BOARD TYPE, THICKNESS, NUMBER OF LAYERS, FASTENER TYPE AND SHEET ORIENTATION SHALL BE AS SPECIFIED IN THE INDIVIDUAL U300 OR U400 SERIES DESIGN IN THE UL FIRE RESISTANCE DIRECTORY. MAX DIAM OF OPENING IS 4 IN. (102 MM).
   THE HOURLY F RATING OF THE FIRESTOP SYSTEM IS EQUAL TO THE HOURLY FIRE RATING OF THE WALL ASSEMBLY IN WHICH IT IS INSTALLED.
   THE HOURLY T RATING IS 0 AND 1/2 HR FOR 1 AND 2 HR RATED ASSEMBLIES, RESPECTIVELY.

2. THROUGH PENETRANTS – ONE OR MORE NONMETALLIC PIPES, CONDUITS OR TUBES INSTALLED CONCENTRICALLY OR ECCENTRICALLY WITHIN OPENING. ANNULAR SPACE BETWEEN PENETRANTS AND PERIPHERY OF OPENING TO BE MIN 0 IN. (POINT CONTACT) TO MAX 1 IN. (0 MM TO MAX 25 MM). SPACE BETWEEN PENETRANTS SHALL BE MIN 0 IN. (POINT CONTACT) TO MAX 1 IN. (0 MM TO MAX 25 MM). PENETRANTS TO BE RIGIDLY SUPPORTED ON BOTH SIDES OF WALL. THE FOLLOWING TYPES AND SIZES OF PENETRANTS MAY BE USED:
   A. POLYVINYL CHLORIDE (PVC) PIPE – NOM 1–1/2 IN. (38 MM) DIAM (OR SMALLER) SCHEDULE 40 SOLID OR CELLULAR CORE PVC PIPE FOR USE IN CLOSED (PROCESS OR SUPPLY) OR VENTED (DRAIN, WASTE OR VENT) PIPING SYSTEMS.
   B. RIGID NONMETALLIC CONDUIT+ + – NOM 1–1/2 IN. (38 MM) DIAM (OR SMALLER) SCHEDULE 40 PVC CONDUIT INSTALLED IN ACCORDANCE WITH ARTICLE 347 OF THE NATIONAL ELECTRICAL CODE (NFPA NO. 70).
   C. CHLORINATED POLYVINYL CHLORIDE (CPVC) PIPE – NOM 1–1/2 IN. (38 MM) DIAM (OR SMALLER) SDR13.5 CPVC PIPE FOR USE IN CLOSED (PROCESS OR SUPPLY) PIPING SYSTEMS.
   D. CROSSLINKED POLYETHYLENE (PEX) TUBING – NOM 1 IN. (25 MM) DIAM (OR SMALLER) SDR 9 PEX TUBING FOR USE IN CLOSED (PROCESS OR SUPPLY) OR VENTED (DRAIN, WASTE OR VENT) PIPING SYSTEMS.

3. FILL, VOID OR CAVITY MATERIAL* – CAULK OR SEALANT – MIN 5/8 IN. (16 MM) THICKNESS OF CAULK APPLIED WITHIN ANNULUS, FLUSH WITH BOTH SURFACES OF WALL. MIN 1/4 IN. (6 MM) DIAM BEAD OF CAULK APPLIED TO GYPSUM BOARD/PENETRANT INTERFACE AT POINT CONTACT LOCATION ON BOTH SIDES OF WALL.
   3M COMPANY – IC 15WB+, CP 25WB+ CAULK OR FB–3000 WT SEALANT
   (NOTE: CP 25WB+ NOT SUITABLE FOR USE WITH CPVC PIPES.)

*BEARING THE UL CLASSIFICATION MARKING

System No. W-L-1146
September 3, 2004
F Ratings - 1 & 2 Hr (See Item 1)
T Rating - 0 Hr

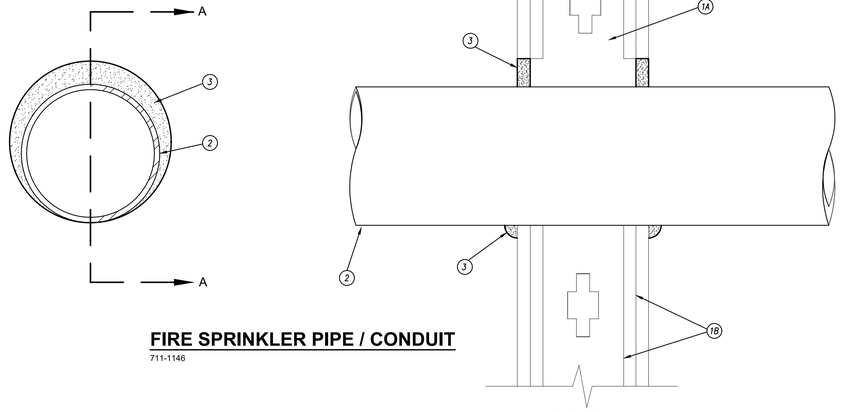

FIRE SPRINKLER PIPE / CONDUIT

711-1146

SECTION A-A

1. WALL ASSEMBLY – THE 1 OR 2 HR FIRE RATED GYPSUM WALLBOARD/STUD WALL ASSEMBLY SHALL BE CONSTRUCTED OF THE MATERIALS AND IN THE MANNER DESCRIBED IN THE INDIVIDUAL U300 OR U400 SERIES WALL OR PARTITION DESIGN IN THE UL FIRE RESISTANCE DIRECTORY AND SHALL INCLUDE THE FOLLOWING CONSTRUCTION FEATURES:
   A. STUDS – WALL FRAMING MAY CONSIST OF EITHER WOOD STUDS OR STEEL CHANNEL STUDS. WOOD STUDS TO CONSIST OF NOM 2 IN. BY 4 IN. (51 MM BY 102 MM) LUMBER SPACED 16 IN. (406 MM) OC. STEEL STUDS TO BE MIN 3–1/2 IN. (89 MM) WIDE AND SPACED MAX 24 IN. (610 MM) OC. WHEN STEEL STUDS ARE USED AND THE DIAM OF OPENING EXCEEDS THE WIDTH OF STUD CAVITY, THE OPENING SHALL BE FRAMED ON ALL SIDES USING LENGTHS OF STEEL STUD INSTALLED BETWEEN THE VERTICAL STUDS AND SCREW–ATTACHED TO THE STEEL STUDS AT EACH END. THE FRAMED OPENING IN THE WALL SHALL BE 4 IN. TO 6 IN. (102 TO 152 MM) WIDER AND 4 IN. TO 6 IN. (102 TO 152 MM) HIGHER THAN THE DIAM OF THE PENETRATING ITEM SUCH THAT, WHEN THE PENETRATING ITEM IS CENTERED IN THE OPENING, A 2 IN. TO 3 IN. (51 MM TO 76 MM) CLEARANCE IS PRESENT BETWEEN THE PENETRATING ITEM AND THE FRAMING IN ALL FOUR SIDES.
   B. GYPSUM BOARD* – THE GYPSUM WALLBOARD TYPE, THICKNESS, NUMBER OF LAYERS, FASTENER TYPE AND SHEET ORIENTATION SHALL BE AS SPECIFIED IN THE INDIVIDUAL U300 OR U400 SERIES DESIGN IN THE UL FIRE RESISTANCE DIRECTORY. MAX DIAM OF OPENING IS 26 IN. (660 MM) FOR STEEL STUD WALLS. MAX DIAM OF OPENING IS 14–1/2 IN. (368 MM) FOR WOOD STUD WALLS.
   THE HOURLY F RATING OF THE FIRESTOP SYSTEM IS EQUAL TO THE HOURLY FIRE RATING OF THE WALL ASSEMBLY IN WHICH IT IS INSTALLED.

2. THROUGH PENETRANT – ONE METALLIC PIPE, CONDUIT OR TUBING INSTALLED EITHER CONCENTRICALLY OR ECCENTRICALLY WITHIN THE FIRESTOP SYSTEM. THE ANNULAR SPACE BETWEEN PIPE, CONDUIT OR TUBING AND PERIPHERY OF OPENING SHALL BE MIN 0F 0 IN. (POINT CONTACT) TO MAX 2 IN. (0 MM TO 51 MM). PIPE, CONDUIT OR TUBING TO BE RIGIDLY SUPPORTED ON BOTH SIDES OF WALL ASSEMBLY. THE FOLLOWING TYPES AND SIZES OF METALLIC PIPES, CONDUITS OR TUBING MAY BE USED:
   A. STEEL PIPE – NOM 24 IN. (610 MM) DIAM (OR SMALLER) SCHEDULE 10 (OR HEAVIER) STEEL PIPE.
   B. IRON PIPE – NOM 24 IN. (610 MM) DIAM (OR SMALLER) SERVICE WEIGHT (OR HEAVIER) CAST IRON SOIL PIPE, NOM 12 IN (305 MM) DIAM (OR SMALLER) OR CLASS 50 (OR HEAVIER) DUCTILE IRON PRESSURE PIPE.
   C. CONDUIT – NOM 6 IN. (152 MM) DIAM (OR SMALLER) STEEL CONDUIT OR NOM 4 IN (102 MM) DIAM (OR SMALLER) STEEL ELECTRICAL METALLIC TUBING
   D. COPPER TUBING – NOM 6 IN. (152 MM) DIAM (OR SMALLER) TYPE L (OR HEAVIER) COPPER TUBING
   E. COPPER PIPE – NOM 6 IN. (152 MM) DIAM (OR SMALLER) REGULAR (OR HEAVIER) COPPER PIPE.

3. FILL, VOID OR CAVITY MATERIALS* – CAULK OR SEALANT – MIN 5/8 IN. (16 MM) THICKNESS OF FILL MATERIAL APPLIED WITHIN THE ANNULUS, FLUSH WITH BOTH SURFACES OF WALL. MIN 1/2 IN. (13 MM) DIAM BEAD OF CAULK APPLIED TO THE PENETRANT/WALLBOARD INTERFACE AT THE POINT CONTACT LOCATION ON BOTH SIDES OF WALL.
   3M COMPANY – CP 25WB+ CAULK OR FB–3000 WT SEALANT.

*BEARING THE UL CLASSIFICATION MARK

PRINTS ISSUED
10/30/2023 - PERMIT SUBMITTAL

REVISIONS:

pkmr ENGINEERS
PEARSON KENT MCKINLEY RAAF ENGINEERS LLC
13300 W 98TH STREET LENEXA, KS 66215
913.492.2400 WWW.PKMRENG.COM
MO State Certificate of Authority #E-2002020886

23.161

STATE OF MISSOURI
MICHAEL D RAAF
NUMBER PE-2005028097
REGISTERED PROFESSIONAL ENGINEER
10/30/23
Michael D. Raaf - Engineer
MO# PE-2005028097

WILSHIRE HILLS III

LEE'S SUMMIT, MISSOURI

SHEET TITLE
MEP PENETRATION DETAILS

PROJECT NUMBER: 23.161

SHEET NUMBER:

MEP200

System No. F-C-3070
May 19, 2005
F Rating - 1 Hr
T Rating - 1 Hr

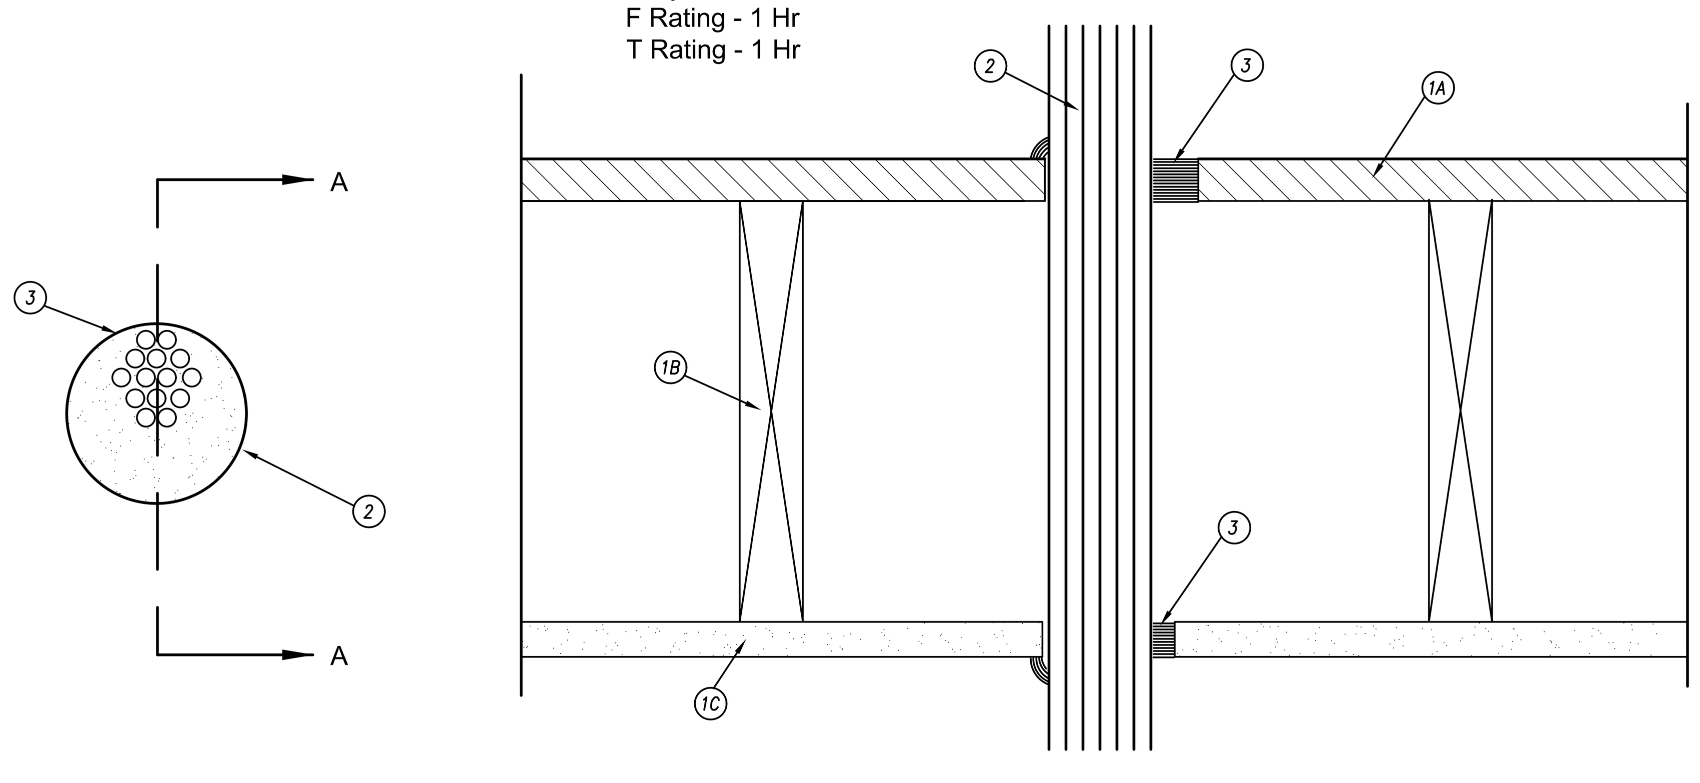

1. FLOOR-CEILING ASSEMBLY – THE 1 HR FIRE-RATED SOLID OR TRUSSED LUMBER JOIST FLOOR-CEILING ASSEMBLY SHALL BE CONSTRUCTED OF THE MATERIALS AND IN THE MANNER SPECIFIED IN THE INDIVIDUAL L500 SERIES FLOOR-CEILING DESIGNS IN THE UL FIRE RESISTANCE DIRECTORY. THE GENERAL CONSTRUCTION DETAILS OF THE FLOOR-CEILING ASSEMBLY ARE SUMMARIZED BELOW:
   A. FLOORING SYSTEM – LUMBER OR PLYWOOD SUBFLOOR WITH FINISH FLOOR OF LUMBER, PLYWOOD OR FLOOR TOPPING MIXTURE* AS SPECIFIED IN THE INDIVIDUAL FLOOR-CEILING DESIGN. MAX DIAM OF OPENING IS 3 IN. (76 MM).
   B. WOOD JOISTS – NOM 10 IN. (254 MM) DEEP (OR DEEPER) LUMBER, STEEL OR COMBINATION LUMBER AND STEEL JOISTS, TRUSSES OR STRUCTURAL WOOD MEMBERS* WITH BRIDGING AS REQUIRED AND WITH ENDS FIRESTOPPED.
   C. GYPSUM BOARD* – NOM 4 FT (122 CM) WIDE BY 5/8 IN. (16 MM) THICK AS SPECIFIED IN THE INDIVIDUAL FLOOR-CEILING DESIGN. MAX DIAM OF OPENING IS 3 IN. (76 MM).

1.1 CHASE WALL (OPTIONAL, NOT. SHOWN) – THE THROUGH PENETRANTS (ITEM NO. 2) MAY BE ROUTED THROUGH A FIRE-RATED SINGLE, DOUBLE OR STAGGERED WOOD STUD/GYPSUM BOARD CHASE WALL HAVING A FIRE RATING CONSISTENT WITH THAT OF THE FLOOR-CEILING ASSEMBLY. THE CHASE WALL SHALL BE CONSTRUCTED OF THE MATERIALS AND IN THE MANNER SPECIFIED IN THE INDIVIDUAL U300 SERIES WALL AND PARTITION DESIGNS IN THE UL FIRE RESISTANCE DIRECTORY AND SHALL INCLUDE THE FOLLOWING CONSTRUCTION FEATURES:
   A. STUDS – NOM 2 IN. BY 6 IN. (51 MM BY 152 MM) OR DOUBLE NOM 2 IN. BY 4 IN. (51 MM BY 102 MM) LUMBER STUDS.
   B. SOLE PLATE – NOM 2 IN. BY 6 IN. (51 MM BY 152 MM) OR PARALLEL 2 IN. BY 4 IN. (51 MM BY 102 MM) LUMBER PLATES, TIGHTLY BUTTED. MAX DIAM OF OPENING IS 3 IN. (76 MM).
   C. TOP PLATE – THE DOUBLE TOP PLATE SHALL CONSIST OF TWO NOM 2 IN. BY 6 IN. (51 MM BY 152 MM) OR TWO SETS OF PARALLEL 2 IN. BY 4 IN. (51 MM BY 102 MM) LUMBER PLATES, TIGHTLY BUTTED. MAX DIAM OF OPENING IS 3 IN. (76 MM).
   D. GYPSUM BOARD* – THICKNESS, TYPE, NUMBER OF LAYERS AND FASTENERS SHALL BE AS SPECIFIED IN INDIVIDUAL WALL AND PARTITION DESIGN.

2. CABLES – MAX 2 IN. DIAM CABLE BUNDLE INSTALLED ECCENTRICALLY OR CONCENTRICALLY WITHIN OPENING. ANNULAR SPACE BETWEEN CABLE BUNDLE AND PERIPHERY OF OPENING TO BE MIN 0 IN. (POINT CONTACT) TO MAX 1 IN. (0 MM TO 25 MM). CABLE BUNDLE TO BE RIGIDLY SUPPORTED ON BOTH SIDES OF WALL. THE FOLLOWING TYPES AND SIZES OF CABLES MAY BE USED:
   A. MAX 200 PAIR NO. 22 AWG (OR SMALLER) COPPER CONDUCTOR WITH POLYVINYL CHLORIDE (PVC) INSULATION AND JACKETING MATERIAL.
   B. MAX 1/C NO. 350 KCMIL (OR SMALLER) COPPER CONDUCTOR CABLE WITH CROSS-LINKED POLYETHYLENE (XLPE) OR PVC JACKET.
   C. MAX 7/C NO. 12 AWG (OR SMALLER) COPPER CONDUCTOR POWER AND CONTROL CABLES WITH XLPE OR PVC INSULATION WITH XLPE OR PVC JACKET.
   D. MAX 3/C NO. 2/0 AWG (OR SMALLER) COPPER OR ALUMINUM CONDUCTOR SER CABLES WITH XLPE OR PVC INSULATION AND JACKET.
   E. MAX 4/C NO. 2/0 AWG (OR SMALLER) COPPER CONDUCTOR, ALUMINUM CLAD OR STEEL CLAD TECK 90 CABLE WITH OR WITHOUT PVC JACKETED.
   F. MAX 110/125 FIBER OPTIC (F.O.) CABLE WITH PVC INSULATION AND JACKET.
   G. MAX 3/C WITH GROUND NO. 8 AWG (OR SMALLER) COPPER CONDUCTOR NM CABLE WITH PVC INSULATION AND JACKET.
   H. MAX RG/U COAXIAL CABLE WITH FLUORINATED ETHYLENE INSULATION AND JACKET.
   I. MAX 4 PAIR NO. 24 AWG (OR SMALLER) COPPER CONDUCTOR DATA CABLE WITH HYLAR JACKET AND INSULATION.
   J. THROUGH PENETRATING PRODUCT* – ANY CABLES, ARMORED CABLE+ OR METAL CLAD CABLE+ CURRENTLY CLASSIFIED UNDER THE THROUGH PENETRATING PRODUCT CATEGORY.
   SEE THROUGH PENETRATING PRODUCT (XHLY) CATEGORY IN THE FIRE RESISTANCE DIRECTORY FOR NAMES OF MANUFACTURERS

3. FILL, VOID OR CAVITY MATERIALS* – CAULK OR SEALANT – MIN 3/4 IN. (19 MM) THICKNESS OF CAULK APPLIED WITHIN ANNULUS, FLUSH WITH TOP SURFACE OF FLOOR OR SOLE PLATE. MIN 5/8 IN. (16 MM) THICKNESS OF CAULK APPLIED WITHIN ANNULUS, FLUSH WITH BOTTOM SURFACE OF CEILING OR TOP PLATE. MIN 1/4 IN. (6 MM) DIAM BEAD OF CAULK APPLIED AT POINT CONTACT LOCATIONS AT CABLE BUNDLE/FLOOR OR SOLE PLATE INTERFACE ON TOP SURFACE OF FLOOR OR SOLE PLATE AND AT CABLE BUNDLE/CEILING OR TOP PLATE INTERFACE.
   3M COMPANY – CP 25WB+, IC 15WB+ CAULK OR FB-3000 WT SEALANT

*BEARING THE UL CLASSIFICATION MARKING

System No. F-C-1006
April 03, 2007
F Rating - 1 Hr
T Ratings - 0 and 1 Hr (see item 2)
L Rating at ambient - Less than 1 CFM/sq ft
L Rating at 400 F - Less than 1 CFM/sq ft

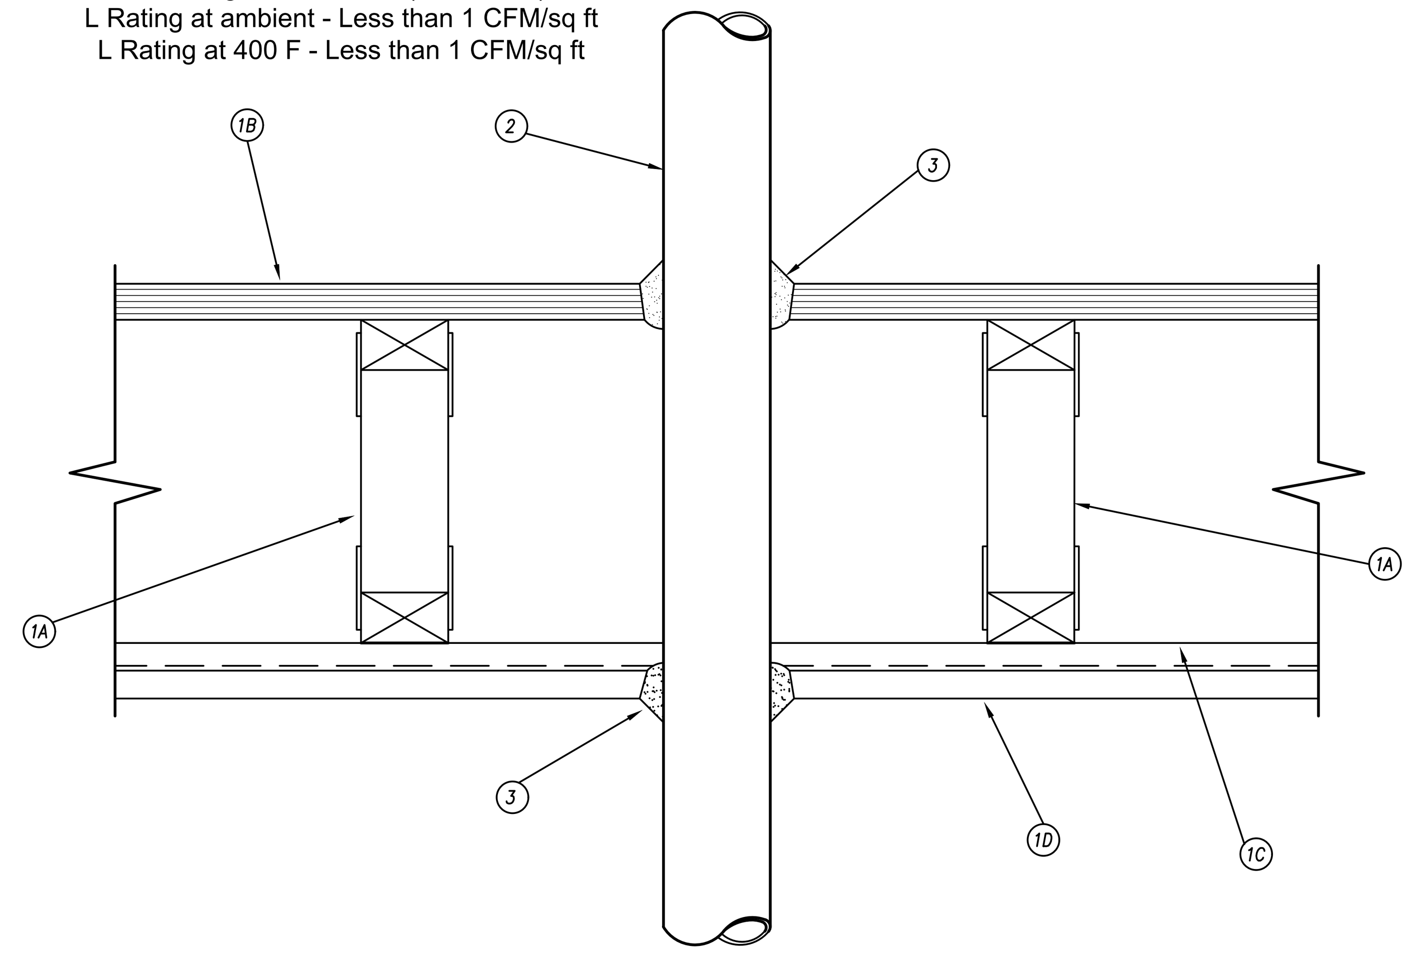

1. FLOOR-CEILING ASSEMBLY – THE 1 HR FIRE RATED WOOD JOIST, WOOD TRUSS OR COMBINATION WOOD AND STEEL TRUSS FLOOR-CEILING ASSEMBLY SHALL BE CONSTRUCTED OF THE MATERIALS AND IN THE MANNER DESCRIBED IN THE INDIVIDUAL L500-SERIES DESIGN IN THE UL FIRE RESISTANCE DIRECTORY, AS SUMMARIZED BELOW:
   A. JOISTS OR TRUSSES – NOM 2 BY 10 IN. (51 BY 254 MM) LUMBER JOISTS, MIN 12 IN. (305 MM) DEEP PARALLEL CHORD TRUSSES FABRICATED FROM NOM 2 BY 4 IN. (51 BY 102 MM) LUMBER IN CONJUNCTION WITH GALV STEEL TRUSS PLATES OR STRUCTURAL WOOD MEMBERS* WITH BRIDGING AS REQUIRED.
   B. FLOORING – NOM 3/4 IN. (19 MM) THICK PLYWOOD FLOORING WITH OR WITHOUT FLOOR TOPPING MIXTURE*. DIAM OF CIRCULAR CUTOUTS IS 1/4 TO 1/2 IN. (6 TO 13 MM) LARGER THAN OUTSIDE DIAM OF THE PIPE.
   C. FURRING CHANNELS – RIGID OR RESILIENT GALV STEEL FURRING CHANNELS INSTALLED PERPENDICULAR TO BOTTOM CHORD OF TRUSSES.
   D. GYPSUM BOARD* – NOM 4 FT (1.2 M) WIDE BY 5/8 IN. (16 MM) THICK, SCREW-ATTACHED TO FURRING CHANNELS. DIAM OF CIRCULAR CUTOUTS IS 1/4 TO 1/2 IN. (6 TO 13 MM) LARGER THAN OUTSIDE DIAM OF THE PIPE.

1.1 CHASE WALL (OPTIONAL, NOW SHOWN) – THE THROUGH PENETRANTS (ITEM NO. 2) MAY BE ROUTED THROUGH A 1 HR FIRE-RATED SINGLE, DOUBLE OR STAGGERED WOOD STUD/GYPSUM WALLBOARD CHASE WALL CONSTRUCTED OF THE MATERIALS AND IN THE MANNER SPECIFIED IN THE INDIVIDUAL U300 SERIES WALL AND PARTITION DESIGNS IN THE UL FIRE RESISTANCE DIRECTORY AND SHALL INCLUDE THE FOLLOWING CONSTRUCTION FEATURES:
   A. STUDS – NOM 2 BY 6 IN. (51 BY 152 MM) OR DOUBLE NOM 2 BY 4 IN. (51 BY 102 MM) LUMBER STUDS.
   B. SOLE PLATE – NOM 2 BY 6 IN. (51 BY 152 MM) OR PARALLEL 2 BY 4 IN. (51 BY 102 MM) LUMBER PLATES, TIGHTLY BUTTED. DIAM OF CIRCULAR CUTOUTS IS 1/4 TO 1/2 IN. (6 TO 13 MM) LARGER THAN OUTSIDE DIAM OF THE PIPE.
   C. TOP PLATE – THE DOUBLE TOP PLATE SHALL CONSIST OF TWO NOM 2 BY 6 IN. (51 BY 152 MM) OR TWO SETS OF PARALLEL 2 BY 4 IN. (51 BY 102 MM) LUMBER PLATES, TIGHTLY BUTTED. DIAM OF CIRCULAR CUTOUTS IS 1/4 TO 1/2 IN. (6 TO 13 MM) LARGER THAN OUTSIDE DIAM OF THE PIPE.
   D. GYPSUM BOARD* – THICKNESS, TYPE, NUMBER OF LAYERS AND FASTENERS SHALL BE AS SPECIFIED IN INDIVIDUAL WALL AND PARTITION DESIGN.

2. THROUGH PENETRANT – NOM 10 IN. (254 MM) DIAM (OR SMALLER) SCHEDULE 10 (OR HEAVIER) STEEL PIPE OR CAST IRON PIPE, NOM 4 IN. (102 MM) DIAM (OR SMALLER) STEEL CONDUIT OR STEEL EMT OR NOM 3 IN. (76 MM) DIAM (OR SMALLER) TYPE L (OR HEAVIER) COPPER TUBING. PIPE TO BE INSTALLED APPROX MIDWAY BETWEEN JOISTS OR TRUSSES AND CENTERED IN CIRCULAR CUTOUTS. ANNULAR SPACE BETWEEN PENETRANT AND PERIPHERY OF OPENING SHALL BE MIN 1/8 IN. (3 MM) TO MAX 1/4 IN. (6 MM). PIPE TO BE RIGIDLY SUPPORTED ON BOTH SIDES OF FLOOR-CEILING ASSEMBLY. T RATING IS 1 HR FOR NOM 4 IN. (102 MM) DIAM (OR SMALLER) PENETRANTS. T RATING IS 0 HR FOR ALL PENETRANTS GREATER THAN NOM 4 IN. (102 MM) DIAM.

3. FILL, VOID OR CAVITY MATERIALS* – CAULK OR SEALANT – MIN 3/4 IN. (19 MM) THICKNESS OF FILL MATERIAL APPLIED WITHIN THE ANNULUS, FLUSH WITH TOP SURFACE OF FLOOR OR SOLE PLATE. MIN 5/8 IN. (16 MM) THICKNESS OF FILL MATERIAL APPLIED WITHIN THE ANNULUS, FLUSH WITH BOTTOM SURFACE OF CEILING OR TOP PLATE. AN ADDITIONAL MIN 1/4 IN. (6 MM) CROWN OF FILL MATERIAL APPLIED TO PERIMETER OF PENETRANT AT ITS EGRESS FROM THE TOP OF FLOORING AND UNDERSIDE OF CEILING OR FROM TOP OF SOLE PLATE AND UNDERSIDE OF TOP PLATE.

   3M COMPANY – CP 25WB+ OR FB-3000 WT

*BEARING THE UL CLASSIFICATION MARKING

SYSTEM NO. F-C-2002
May 18, 2005
F RATING - 2 HR
T RATING - 2 HR
L RATING AT AMBIENT- 7 CFM/sq ft
L RATING AT 400° F - LESS THAN 1 CFM/sq ft

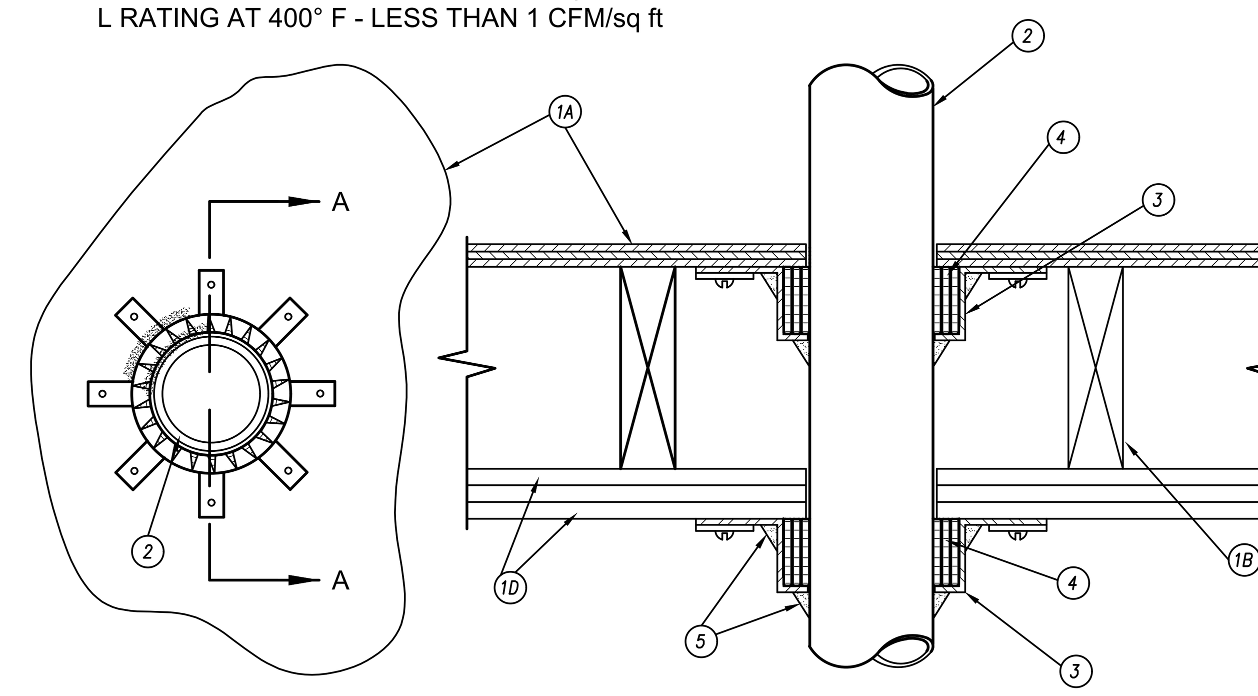

1. FLOOR-CEILING ASSEMBLY – THE FIRE-RATED WOOD JOIST FLOOR-CEILING ASSEMBLY SHALL BE CONSTRUCTED OF THE MATERIALS AND IN THE MANNER SPECIFIED IN DESIGN NO. L505, L511 OR L536 IN THE UL FIRE RESISTANCE DIRECTORY, AS SUMMARIZED BELOW:
   A. FLOORING SYSTEM – LUMBER OR PLYWOOD SUBFLOOR WITH FINISH FLOOR OF LUMBER, PLYWOOD OR FLOOR TOPPING MIXTURE* AS SPECIFIED IN THE INDIVIDUAL FLOOR-CEILING DESIGN. MAX DIAM OF OPENING IN FLOORING IS 4-3/4 IN. (121 MM).
   B. WOOD JOISTS – NOM 2 IN. BY 10 IN. (51 MM BY 254 MM) LUMBER JOISTS SPACED 16 IN. OC WITH NOM 1 IN. BY 3 IN. (25 MM BY 76 MM) LUMBER BRIDGING AND WITH ENDS FIRESTOPPED.
   C. FURRING CHANNELS (NOT SHOWN) – RESILIENT GALV STEEL FURRING CHANNELS INSTALLED PERPENDICULAR TO WOOD JOISTS BETWEEN FIRST AND SECOND LAYERS OF WALLBOARD (ITEM 1D) AND SPACED MAX 24 IN (610 MM) OC.
   D. GYPSUM BOARD* – NOM 4 FT (122 CM) WIDE BY 5/8 IN. (16 MM) THICK AS SPECIFIED IN THE INDIVIDUAL FLOOR-CEILING DESIGN. FIRST LAYER OF WALLBOARD NAILED TO WOOD JOISTS. SECOND LAYER OF WALLBOARD SCREW-ATTACHED TO FURRING CHANNELS. THE SECONDARY FIRESTOP SYSTEM (ITEMS 3, 4 AND 5) MUST BE INSTALLED IN THE JOIST CAVITY PRIOR TO INSTALLATION OF THE GYPSUM WALLBOARD CEILING.

2. NONMETALLIC PIPE – NOM 4 IN. DIAM (OR SMALLER) SCHEDULE 40 SOLID CORE POLYVINYL CHLORIDE (PVC) PIPE OR SCHEDULE 40 CHLORINATED POLYVINYL CHLORIDE (CPVC) PIPE FOR USE IN CLOSED (PROCESS OR SUPPLY) OR VENTED (DRAIN, WASTE, VENT) PIPING SYSTEMS. DIAM OF CIRCULAR OPENINGS HOLE-SAWED THROUGH FLOORING SYSTEM AND THROUGH TWO-LAYER GYPSUM WALLBOARD CEILING TO BE NO GREATER THAN 1/8 IN. (3.2 MM) LARGER THAN OUTSIDE DIAM OF PIPE. PIPE TO BE INSTALLED APPROX MIDWAY BETWEEN WOOD JOISTS AND CENTERED IN CIRCULAR OPENINGS.

3. FILL, VOID, OR CAVITY MATERIALS* – WRAP STRIP – NOM 1/4 IN. (6 MM) THICK INTUMESCENT ELASTOMERIC MATERIAL FACED ON ONE SIDE WITH ALUMINUM FOIL, SUPPLIED IN 2 IN. (51 MM) WIDE STRIPS. NOM 2 IN. (51 MM) WIDE STRIPS TIGHTLY WRAPPED AROUND NONMETALLIC PIPE (FOIL SIDE EXPOSED) WITH THE EDGES BUTTED AGAINST THE UNDERSIDE OF THE SUBFLOOR (SECONDARY FIRESTOP SYSTEM) AND AGAINST THE FINISHED GYPSUM WALLBOARD CEILING (PRIMARY FIRESTOP SYSTEM). WRAP STRIPS FOR PRIMARY AND SECONDARY FIRESTOP SYSTEMS TO BE INSTALLED IDENTICALLY. FOR NOM 1/2 IN. TO NOM 2 IN. (13 MM TO NOM 51 MM) DIAM PIPES, A MIN OF ONE LAYER OF WRAP STRIP IS REQUIRED. FOR NOM 2-1/2 IN. AND NOM 3 IN. (64 MM AND NOM 76 MM) DIAM PIPES, A MIN OF TWO LAYERS OF WRAP STRIP IS REQUIRED. FOR NOM 3-1/2 IN. AND NOM 4 IN. (89 MM AND NOM 102 MM) DIAM PIPES, A MIN OF THREE LAYERS OF WRAP STRIP IS REQUIRED. EACH LAYER OF WRAP STRIP TO BE INSTALLED WITH BUTTED SEAM, WITH BUTTED SEAMS IN SUCCESSIVE LAYERS STAGGERED. WRAP STRIP LAYER(S) TEMPORARILY HELD IN POSITION USING ALUMINUM FOIL TAPE, STEEL WIRE TIE, OR EQUIVALENT.
   3M COMPANY – FS-195+

4. STEEL COLLAR – NOM 2 IN. (51 MM) DEEP COLLAR WITH 1-1/4 IN. (32 MM) WIDE BY 2 IN. (51 MM) LONG ANCHOR TABS AND MIN 3/4 IN. (19 MM) LONG TABS TO RETAIN WRAP STRIP LAYERS. COILS OF PRECUT 0.016 IN. (0.41 MM) THICK (30 GAUGE) GALV SHEET STEEL AVAILABLE FROM WRAP STRIP MANUFACTURER. AS AN ALTERNATE, COLLAR MAY BE FIELD-FABRICATED FROM MIN 0.016 IN. (0.41 MM) THICK (30 GAUGE) GALV SHEET STEEL IN ACCORDANCE WITH INSTRUCTION SHEET SUPPLIED BY WRAP STRIP MANUFACTURER. STEEL COLLAR, WITH ANCHOR TABS BENT OUTWARD 90 DEG, WRAPPED TIGHTLY AROUND WRAP STRIP LAYERS WITH MIN 1 IN. (25 MM) OVERLAP AT THE SEAM. WITH STEEL ANCHOR TABS PRESSED TIGHTLY AGAINST THE SUBFLOOR (SECONDARY FIRESTOP SYSTEM) OR THE FINISHED GYPSUM WALLBOARD CEILING (PRIMARY FIRESTOP SYSTEM), COMPRESS COLLAR AROUND WRAP STRIP LAYERS USING A MIN 1/2 IN. (13 MM) WIDE BY 0.028 IN. (0.71 MM) THICK STAINLESS STEEL BAND CLAMP WITH WORM DRIVE TIGHTENING MECHANISM AT THE COLLAR MIDHEIGHT. AS AN ALTERNATE TO THE BAND CLAMPS, COLLARS MAY BE SECURED BY A MEANS NO 10 IN. BY 1/2 IN. (13 MM) LONG SHEET METAL SCREWS INSTALLED IN THE VERTICAL AXIS AT THE CENTER OF THE 1 IN. (25 MM) OVERLAP ALONG THE PERIMETER JOINT OF THE COLLAR. A MIN OF THREE SCREWS IS REQUIRED. SECURE COLLAR TO SUBFLOOR (SECONDARY FIRESTOP SYSTEM) USING MIN 3/4 IN. (19 MM) LONG STEEL SCREWS IN CONJUNCTION WITH 1-1/4 IN. (32 MM) DIAM STEEL FENDER WASHERS. SECURE COLLAR TO FINISHED GYPSUM WALLBOARD CEILING (PRIMARY FIRESTOP SYSTEM) USING 3/16 IN. (5 MM) DIAM STEEL TOGGLE BOLTS (1-7/8 IN. (48 MM) GRIP) IN CONJUNCTION WITH 1-1/4 IN. (32 MM) DIAM STEEL FENDER WASHERS. MIN OF THREE FASTENERS, SYMMETRICALLY LOCATED, REQUIRED FOR NOM 1/2 IN. TO NOM 3 IN. (13 MM AND NOM 76 MM) DIAM PIPES. MIN OF FOUR FASTENERS, SYMMETRICALLY LOCATED, REQUIRED FOR NOM 3-1/2 IN. AND NOM 4 IN. (89 MM AND NOM 102 MM) AND NOM 4 IN. DIAM PIPES. AS A FINAL STEP, BEND WRAP STRIP RETAINER TABS 90 DEG TOWARD PIPE TO LOCK WRAP STRIP LAYERS IN POSITION.

5. FILL, VOID OR CAVITY MATERIALS* – CAULK OR SEALANT – GENEROUS BEAD OF CAULK TO BE APPLIED AROUND THE PERIMETER OF THE STEEL COLLAR (ITEM 4) AT ITS INTERFACE WITH THE SUBFLOOR (SECONDARY FIRESTOP SYSTEM) AND GYPSUM WALLBOARD CEILING (PRIMARY FIRESTOP SYSTEM). A NOM 1/4 IN. (6 MM) DIAM BEAD OF CAULK SHALL BE APPLIED AROUND THE PERIMETER OF THE NONMETALLIC PIPE AT ITS INTERFACE WITH THE WRAP STRIP LAYERS.
   3M COMPANY – CP 25WB+, IC 15WB+, FIREDAM 150+ CAULK OR FB-3000 WT SEALANT
   (NOTE: CP 25WB+ NOT SUITABLE FOR USE WITH CPVC PIPES.)

6. FIRESTOP DEVICE* (NOT SHOWN) – AS AN ALTERNATE TO ITEMS 3 AND 4 FOR NOM 1-1/2 IN., 2 IN., 3 IN. OR 4 IN. (38 MM, 51 MM, 76 MM OR 102 MM) MM) DIAM NONMETALLIC PIPES, A FIRESTOP DEVICE CONSISTING OF A SHEET-STEEL SPLIT COLLAR LINED WITH INTUMESCENT MATERIAL AND PROVIDED WITH STEEL CLIPS FOR ATTACHMENT MAY BE USED. FIRESTOP DEVICE TO BE INSTALLED ON UNDERSIDE OF SUBFLOOR AND AGAINST THE FINISHED GYPSUM WALLBOARD CEILING IN ACCORDANCE WITH THE ACCOMPANYING INSTALLATION INSTRUCTIONS.
   3M COMPANY – PPD 150, PPD 200, PPD 300, PPD 400

*BEARING THE UL CLASSIFICATION MARKING

System No. W-L-5040
September 7, 2004
F Ratings - 1 and 2 HR (See Item 1)
T Ratings - 1/4, 1/2 and 3/4 HR (See Item 2)

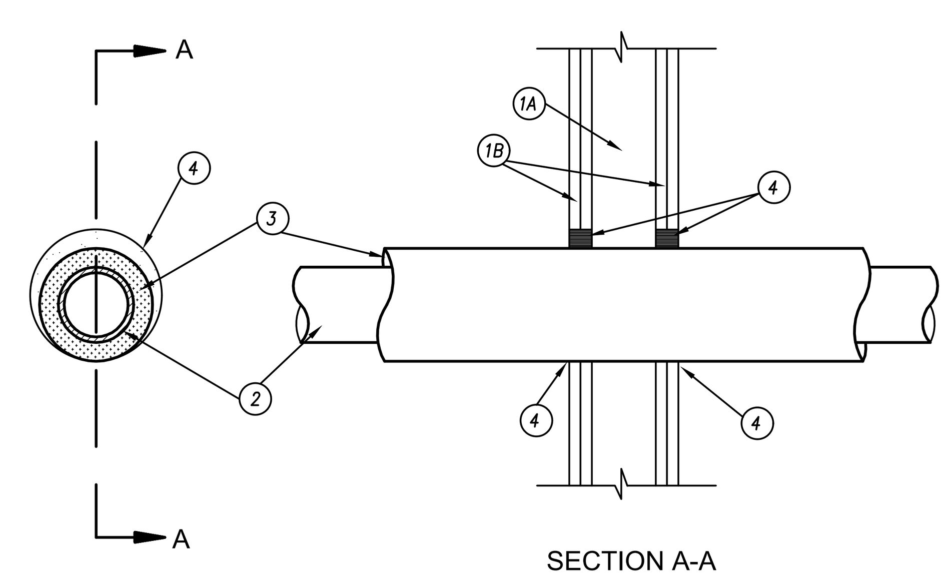

1. WALL ASSEMBLY – THE 1 OR 2 HR FIRE-RATED GYPSUM WALLBOARD/STUD WALL ASSEMBLY SHALL BE CONSTRUCTED OF THE MATERIALS AND IN THE MANNER SPECIFIED IN THE INDIVIDUAL U300 OR U400 SERIES WALL OR PARTITION DESIGNS IN THE UL FIRE RESISTANCE DIRECTORY AND SHALL INCLUDE THE FOLLOWING CONSTRUCTION FEATURES:
   A. STUDS – WALL FRAMING MAY CONSIST OF EITHER WOOD STUDS OR STEEL CHANNEL STUDS. WOOD STUDS TO CONSIST OF NOM 2 BY 4 IN. LUMBER SPACED 16 IN. OC. STEEL STUDS TO BE MIN 3-5/8 IN. WIDE AND SPACED MAX 24 IN. OC.
   B. GYPSUM BOARD* – NOM 5/8 IN. THICK, 4 FT WIDE WITH SQUARE OR TAPERED EDGES. THE GYPSUM WALLBOARD TYPE, NUMBER OF LAYERS, FASTENER TYPE AND SHEET ORIENTATION SHALL BE AS SPECIFIED IN THE INDIVIDUAL WALL AND PARTITION DESIGN. MAX DIAM OF OPENING IN WALLBOARD LAYERS IS 7 IN.
   THE HOURLY F RATING OF THE FIRESTOP SYSTEM IS 1 HR WHEN INSTALLED IN A 1 HR FIRE RATED WALL AND 2 HR WHEN INSTALLED IN A 2 HR FIRE RATED WALL.

2. THROUGH PENETRANTS – ONE METALLIC PIPE OR TUBING TO BE INSTALLED EITHER CONCENTRICALLY OR ECCENTRICALLY WITHIN THE FIRESTOP SYSTEM. PIPE OR TUBING TO BE RIGIDLY SUPPORTED ON BOTH SIDES OF WALL ASSEMBLY. THE FOLLOWING TYPES AND SIZES OF METALLIC PIPES OR TUBING MAY BE USED:
   A. STEEL PIPE – NOM 4 IN. DIAM (OR SMALLER) SCHEDULE 10 (OR HEAVIER) STEEL PIPE. WHEN STEEL PIPE IS USED, T RATING IS 3/4 HR.
   B. COPPER TUBING – NOM 4 IN. DIAM (OR SMALLER) TYPE L (OR HEAVIER) COPPER TUBING. T RATING IS 3/4 HR FOR COPPER TUBING OF NOM 2 IN. DIAM AND SMALLER. FOR COPPER TUBING GREATER THAN NOM 2 IN. DIAM, T RATING IS 1/4 AND 1/2 HR WHEN INSTALLED IN 1 AND 2 HR RATED WALLS, RESPECTIVELY.
   C. COPPER PIPE – NOM 4 IN. DIAM (OR SMALLER) REGULAR (OR HEAVIER) COPPER PIPE. T RATING IS 3/4 HR FOR COPPER PIPE OF NOM 2 IN. DIAM AND SMALLER. FOR COPPER PIPE GREATER THAN NOM 2 IN. DIAM, T RATING IS 1/4 AND 1/2 HR WHEN INSTALLED IN 1 AND 2 HR RATED WALL RESPECTIVELY.

3. PIPE INSULATION – PLASTICS# – NOM 3/4 IN. THICK ACRYLONITRILE BUTADIENE/POLYVINYL CHLORIDE (AB/PVC) FLEXIBLE FOAM FURNISHED IN THE FORM OF TUBING. THE ANNULAR SPACE BETWEEN THE INSULATED PIPE AND THE EDGE OF THE THROUGH OPENING SHALL BE MIN ZERO IN. (POINT CONTACT) TO MAX 1-1/4 IN.
   SEE PLASTICS# (QMFZ2) CATEGORY IN THE RECOGNIZED COMPONENT DIRECTORY FOR NAMES OF MANUFACTURERS. ANY RECOGNIZED COMPONENT TUBE INSULATION MATERIAL MEETING THE ABOVE SPECIFICATIONS AND HAVING A UL94 FLAMMABILITY CLASSIFICATION OF 94-5VA MAY BE USED.

4. FILL, VOID OR CAVITY MATERIALS* – CAULK OR SEALANT – MIN 5/8 IN. THICKNESS OF CAULK APPLIED WITHIN THE ANNULAR SPACE, FLUSH WITH EACH SURFACE OF WALL. A MIN 1/2 IN. DIAM BEAD OF CAULK SHALL BE APPLIED TO THE PIPE INSULATION/ WALLBOARD INTERFACE AT THE POINT CONTACT LOCATION ON BOTH SIDES OF WALL.
   3M COMPANY – CP 25WB+ CAULK OR FB-3000 WT SEALANT

*BEARING THE UL CLASSIFICATION MARKING

SYSTEM NO. F-C-2026
May 18, 2005
F RATING - 1 HR
T RATING - 1 HR

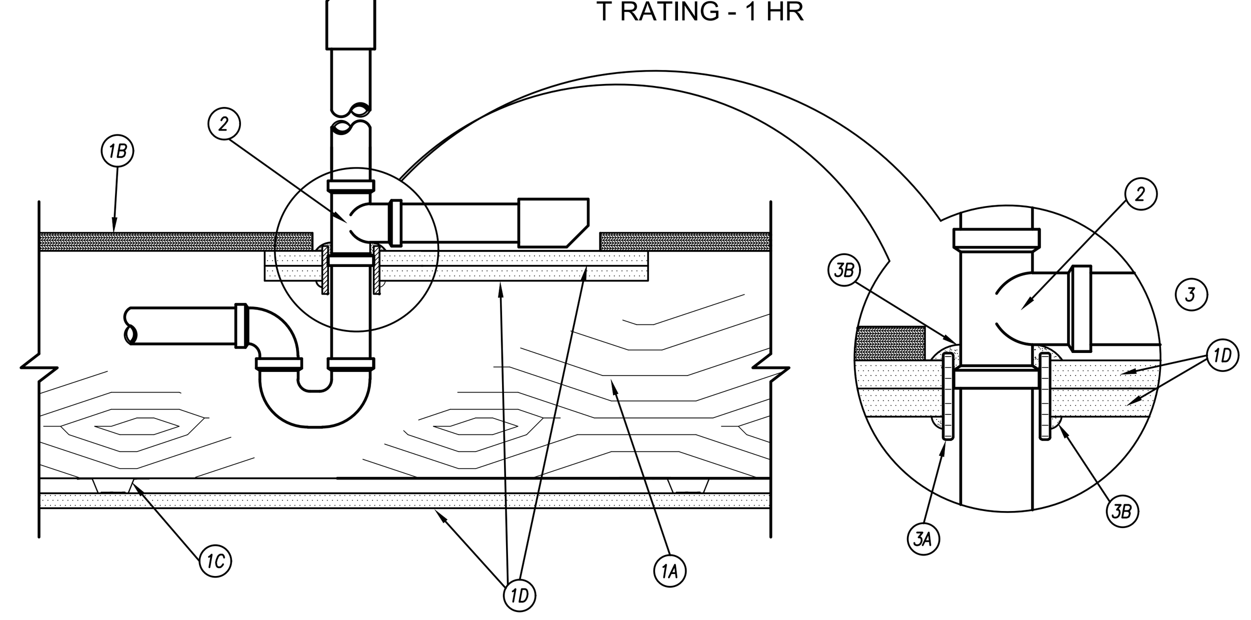

1. FLOOR-CEILING ASSEMBLY – THE FIRE-RATED SOLID OR TRUSSED LUMBER JOIST FLOOR-CEILING ASSEMBLY SHALL BE CONSTRUCTED OF THE MATERIALS AND IN THE MANNER SPECIFIED IN THE INDIVIDUAL L500 SERIES FLOOR-CEILING DESIGNS IN THE UL FIRE RESISTANCE DIRECTORY AND SHALL INCLUDE THE FOLLOWING CONSTRUCTION FEATURES:
   A. JOISTS – NOM 10 IN. (254 MM) DEEP (OR DEEPER) LUMBER, STEEL OR COMBINATION LUMBER AND STEEL JOISTS, TRUSSES OR STRUCTURAL WOOD MEMBERS* WITH BRIDGING AS REQUIRED AND WITH ENDS FIRESTOPPED.
   B. FLOORING SYSTEM – LUMBER OR PLYWOOD SUBFLOOR WITH FINISH FLOOR OF LUMBER, PLYWOOD OR FLOOR TOPPING MIXTURE* AS SPECIFIED IN THE INDIVIDUAL FLOOR-CEILING DESIGN. RECTANGULAR CUTOUT IN FLOORING TO ACCOMMODATE THE BATHTUB DRAIN PIPING (ITEM 2) TO BE MAX 8 BY 12 IN. (203 MM BY 305 MM).
   C. FURRING CHANNELS – RIGID OR RESILIENT GALV STEEL FURRING CHANNELS INSTALLED PERPENDICULAR TO JOISTS.
   D. GYPSUM BOARD* – NOM 4 FT (122 CM) WIDE BY 5/8 IN. (16 MM) THICK. WALLBOARD SCREW-ATTACHED TO FURRING CHANNELS AS SPECIFIED IN THE INDIVIDUAL FLOOR-CEILING DESIGN. TWO PIECES OF GYPSUM WALLBOARD, EACH MIN 4 IN. (102 MM) LONGER AND WIDER THAN THE CUTOUT IN THE FLOORING, SCREW-ATTACHED TO BOTTOM OF FLOORING CONCENTRIC WITH CUTOUT. DIAM OF OPENING HOLE-SAWED THROUGH BOTH LAYERS OF THE GYPSUM WALLBOARD PATCH TO BE 1/2 IN. TO 5/8 IN. (13 MM TO 16 MM) LARGER THAN OUTSIDE DIAM OF BATHTUB DRAIN PIPING (ITEM 2).

2. DRAIN PIPING – NOM 1-1/2 IN. (38 MM) DIAM SCHEDULE 40 PVC PIPE AND DRAIN FITTINGS CEMENTED TOGETHER AND PROVIDED WITH PVC BATHTUB WASTE/OVERFLOW FITTING.

3. FIRESTOP SYSTEM – THE DETAILS OF THE FIRESTOP SYSTEM SHALL BE AS FOLLOWS:
   A. FILL, VOID OR CAVITY MATERIALS* – WRAP STRIP – NOM 1/4 IN. (6 MM) THICK INTUMESCENT ELASTOMERIC MATERIAL FACED ON ONE SIDE WITH ALUMINUM FOIL, SUPPLIED IN 2 IN. (51 MM) WIDE STRIPS. NOM 2 IN. (51 MM) WIDE STRIP TIGHTLY-WRAPPED AROUND PVC DRAIN PIPING (FOIL SIDE EXPOSED), SECURED WITH TWO STEEL WIRE TIES, AND SLID INTO HOLE-SAWED OPENING IN GYPSUM WALLBOARD PATCH (ITEM 1D). BOTTOM EDGE OF WRAP STRIP TO PROJECT APPROX 1/2 IN. (13 MM) BELOW BOTTOM SURFACE OF GYPSUM WALLBOARD PATCH.
      3M COMPANY – FS-195+
   B. FILL, VOID OR CAVITY MATERIALS* – CAULK OR SEALANT – NOM 1/4 IN. (6 MM) DIAM BEAD OF CAULK TO BE APPLIED TO PERIMETER OF WRAP STRIP AT ITS EGRESS FROM THE UNDERSIDE OF THE GYPSUM WALLBOARD PATCH. NOM 1/4 IN. (6 MM) THICKNESS OF CAULK TO BE APPLIED TO THE EXPOSED EDGE OF THE WRAP STRIP LAYER AND TO FILL ALL GAPS BETWEEN THE WRAP STRIP LAYER AND THE TEE OF THE DRAIN FITTING ON THE TOP SURFACE OF THE GYPSUM WALLBOARD PATCH.
      3M COMPANY – CP 25WB+, IC 15 WB+, FIREDAM 150+ CAULK OR FB-3000 WT SEALANT

*BEARING THE UL CLASSIFICATION MARKING

System No. F-C-7022
May 19, 2005
F Rating - 1 Hr
T Rating - 1/ 4 Hr

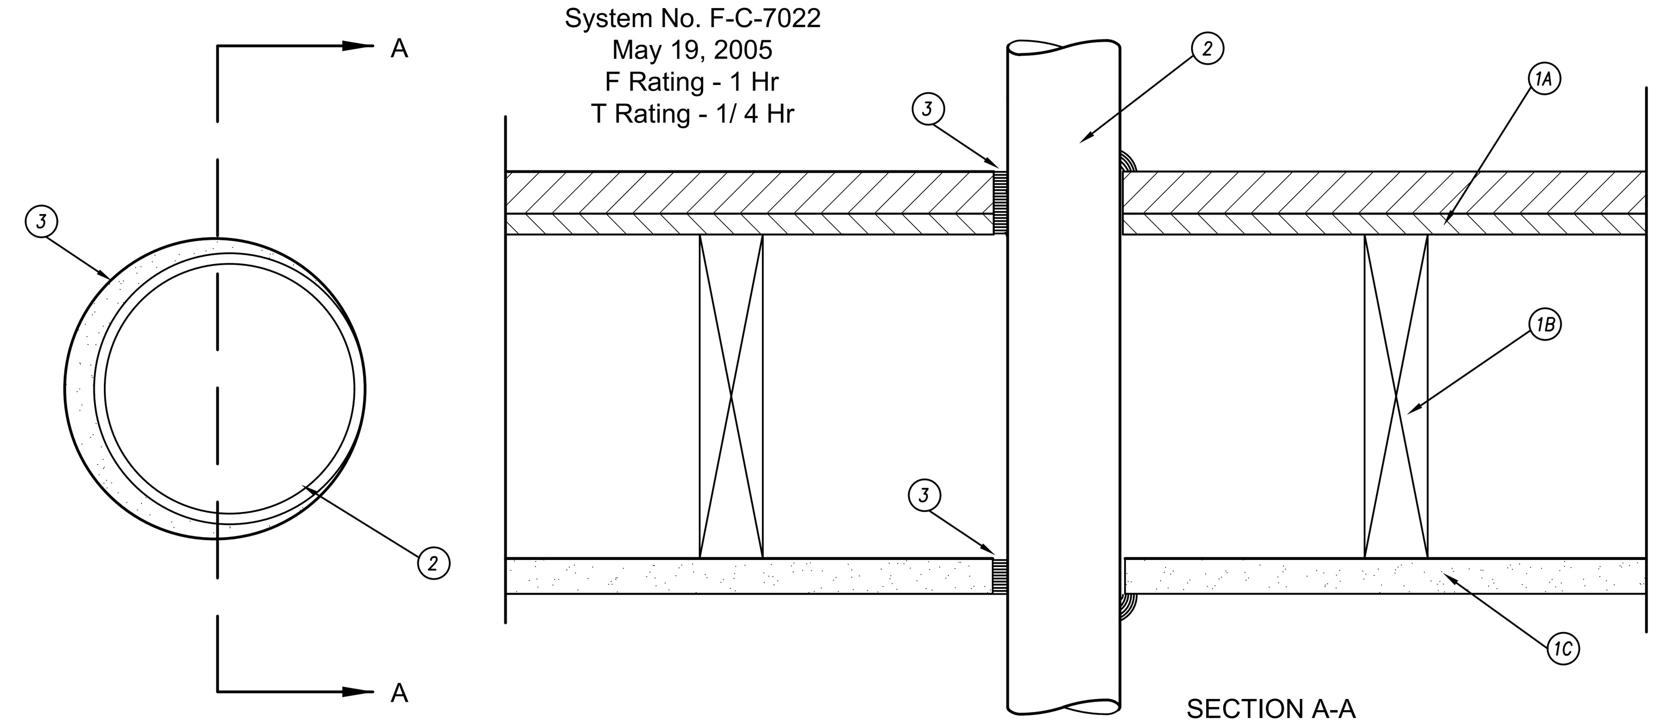

1. FLOOR-CEILING ASSEMBLY – THE 1 HR FIRE-RATED SOLID OR TRUSSED LUMBER JOIST FLOOR-CEILING ASSEMBLY SHALL BE CONSTRUCTED OF THE MATERIALS AND IN THE MANNER SPECIFIED IN THE INDIVIDUAL L500 SERIES FLOOR-CEILING DESIGNS IN THE UL FIRE RESISTANCE DIRECTORY. THE GENERAL CONSTRUCTION DETAILS OF THE FLOOR-CEILING ASSEMBLY ARE SUMMARIZED BELOW:
   A. FLOORING SYSTEM – LUMBER OR PLYWOOD SUBFLOOR WITH FINISH FLOOR OF LUMBER, PLYWOOD OR FLOOR TOPPING MIXTURE* AS SPECIFIED IN THE INDIVIDUAL FLOOR-CEILING DESIGN. MAX DIAM OF OPENING IS 11 IN. (279 MM).
   B. WOOD JOISTS – NOM 10 IN. (254 MM) DEEP (OR DEEPER) LUMBER, STEEL OR COMBINATION LUMBER AND STEEL JOISTS, TRUSSES OR STRUCTURAL WOOD MEMBERS* WITH BRIDGING AS REQUIRED AND WITH ENDS FIRESTOPPED.
   C. GYPSUM BOARD* – NOM 4 FT. (122 CM) WIDE BY 5/8 IN. (16 MM) THICK AS SPECIFIED IN THE INDIVIDUAL FLOOR-CEILING DESIGN. MAX DIAM OF OPENING IS 11 IN. (279 MM).

2. STEEL DUCT – NOM 10 IN. (254 MM) (OR SMALLER) NO. 28 GAUGE (OR HEAVIER) STEEL DUCT OR NOM 5 IN. (127 MM) (OR SMALLER) NO. 30 GAUGE (OR HEAVIER) STEEL DUCT TO BE INSTALLED EITHER CONCENTRICALLY OR ECCENTRICALLY WITHIN OPENING. THE ANNULAR SPACE BETWEEN DUCT AND PERIPHERY OF OPENING SHALL BE MIN 0 IN. (POINT CONTACT) TO MAX 1 IN. (0 MM TO MAX 25 MM). DUCT TO BE RIGIDLY SUPPORTED ON BOTH SIDES OF FLOOR ASSEMBLY.

3. FILL, VOID OR CAVITY MATERIALS* – CAULK OR SEALANT – MIN 3/4 IN. (19 MM) THICKNESS OF CAULK APPLIED WITHIN ANNULUS, FLUSH WITH TOP SURFACE OF FLOOR. MIN 5/8 IN. (16 MM) THICKNESS OF CAULK APPLIED WITHIN ANNULUS, FLUSH WITH BOTTOM SURFACE OF CEILING. MIN 1/4 IN. (6 MM) DIAM BEAD OF CAULK APPLIED AT POINT CONTACT LOCATIONS AT DUCT/FLOOR INTERFACE ON TOP SURFACE OF FLOOR AND AT DUCT/CEILING INTERFACE.
   3M COMPANY – CP 25WB+, IC 15WB+ CAULK OR FB-3000 WT SEALANT

*BEARING THE UL CLASSIFICATION MARKING

PRINTS ISSUED
10/30/2023 - PERMIT SUBMITTAL

REVISIONS:

pkmr ENGINEERS
23.161

PEARSON KENT MCKINLEY RAAF ENGINEERS LLC
13300 W 98TH STREET LENEXA, KS 66215
913.492.2400 WWW.PKMRENG.COM
MO State Certificate of Authority #E-2002020886

STATE OF MISSOURI
MICHAEL D. RAAF
NUMBER PE-2005028097
REGISTERED PROFESSIONAL ENGINEER
10/30/23
Michael D. Raaf - Engineer
MO# PE-2005028097

WILSHIRE HILLS III
LEE'S SUMMIT, MISSOURI

SHEET TITLE
MEP PENETRATION DETAILS

PROJECT NUMBER: 23.161

SHEET NUMBER:

MEP201

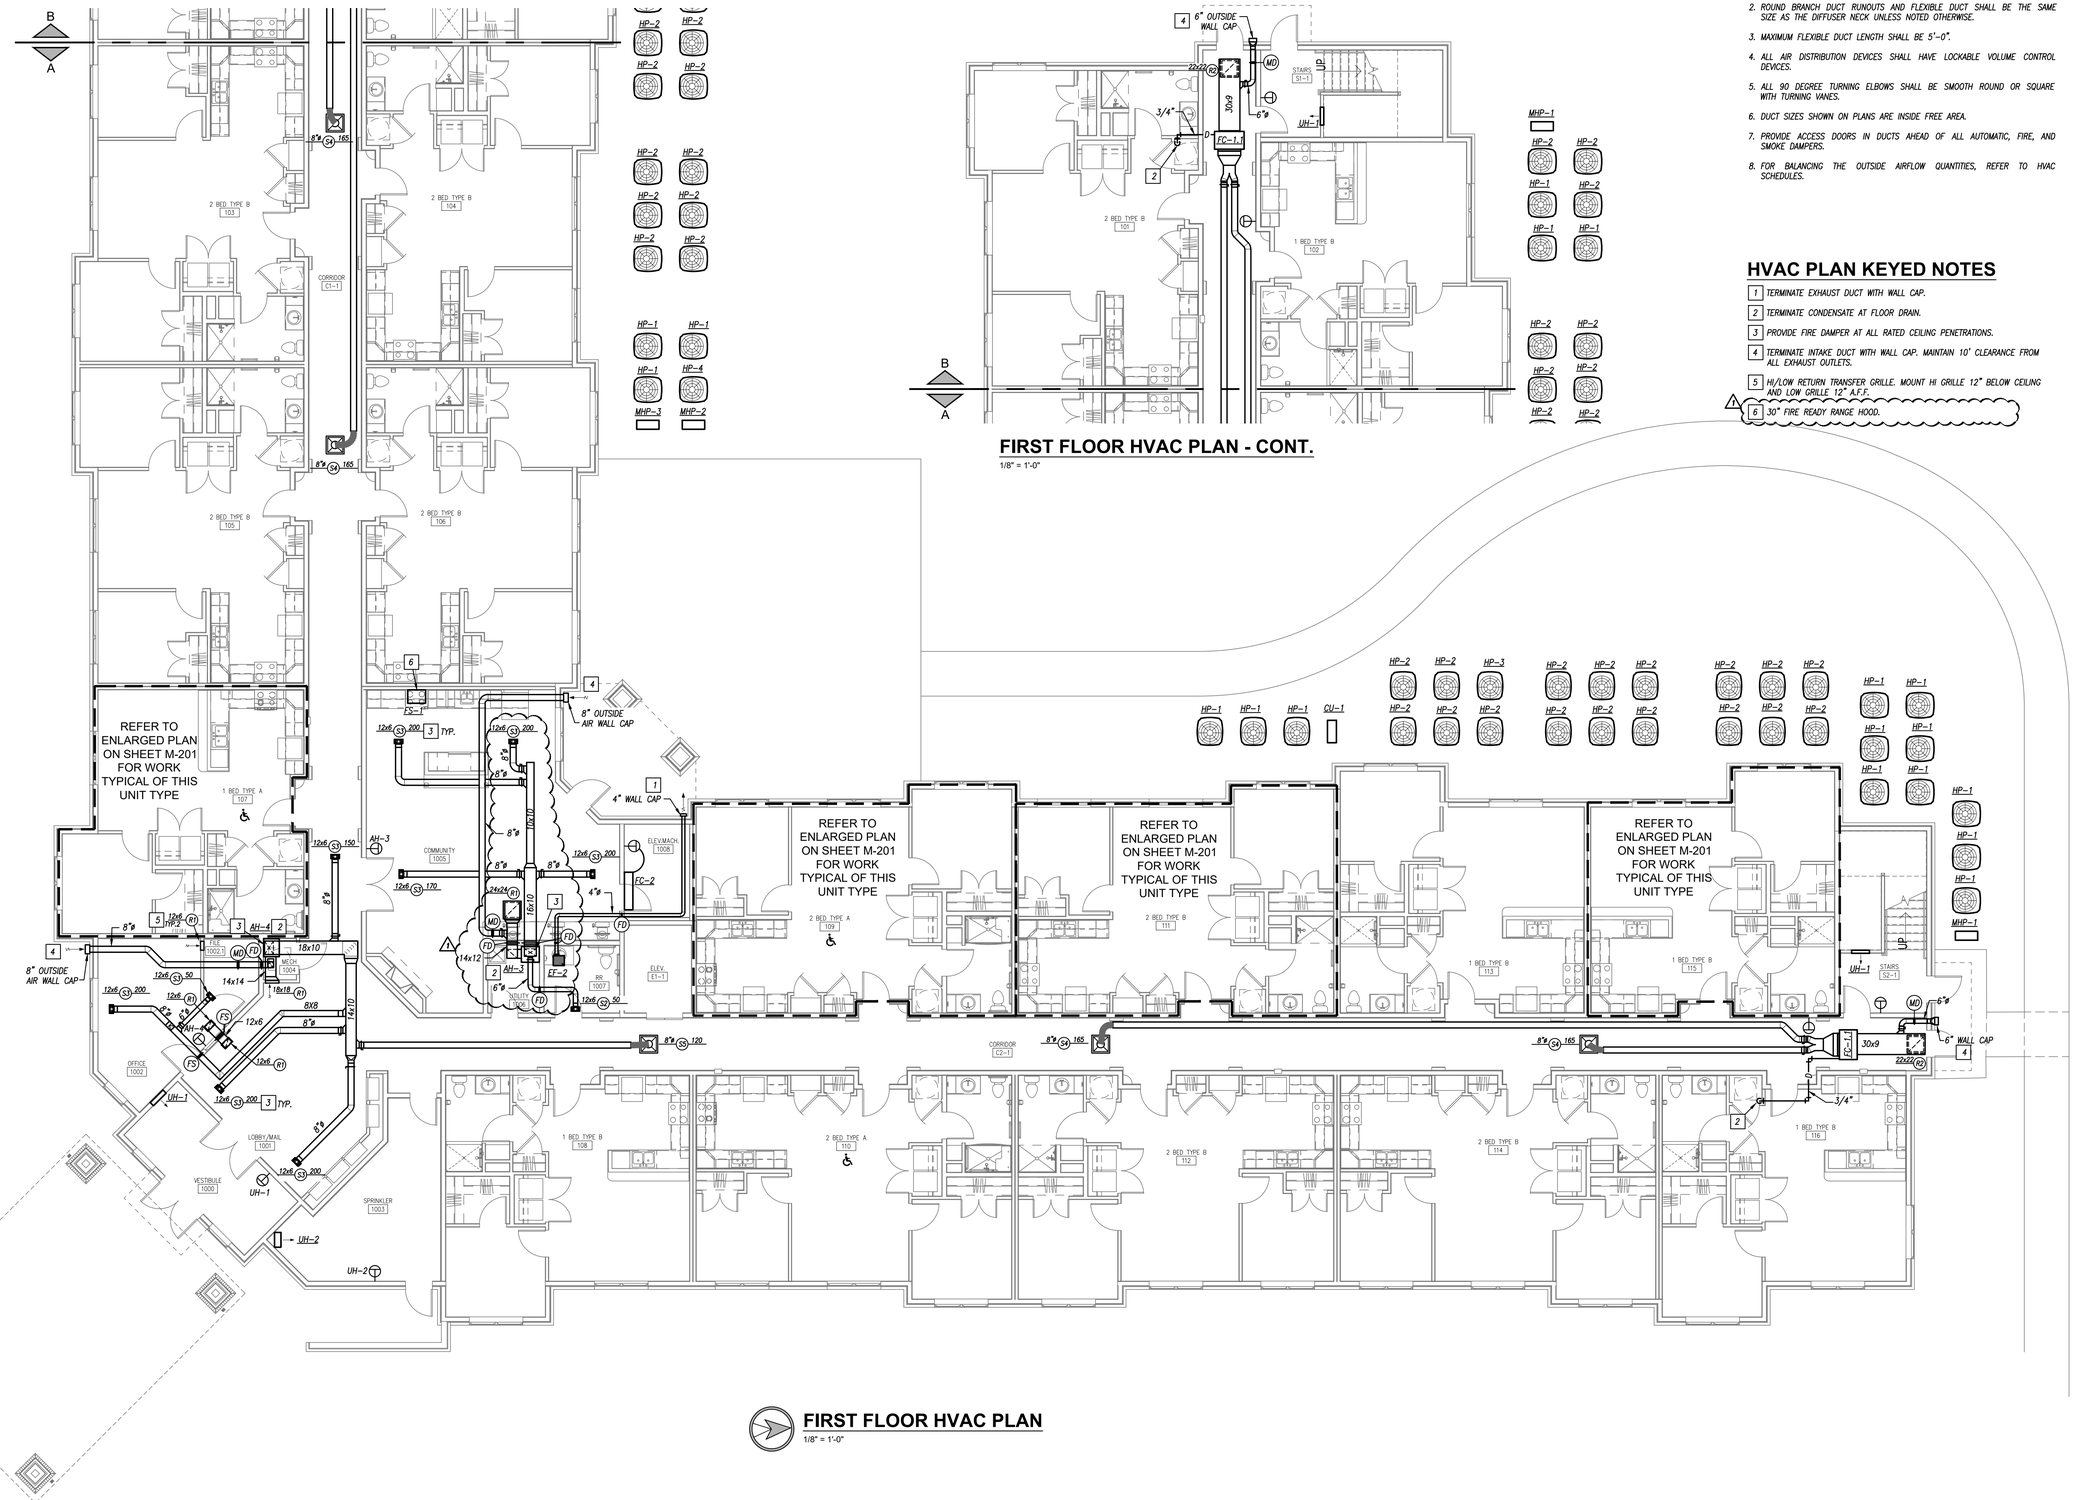

FIRST FLOOR HVAC PLAN - CONT.

1/8" = 1'-0"

FIRST FLOOR HVAC PLAN

1/8" = 1'-0"

GENERAL HVAC NOTES

1. *REFER TO GENERAL NOTES ON MEP COVER SHEET FOR ADDITIONAL REQUIREMENTS OF WORK.*
2. *ROUND BRANCH DUCT RUNOUTS AND FLEXIBLE DUCT SHALL BE THE SAME SIZE AS THE DIFFUSER NECK UNLESS NOTED OTHERWISE.*
3. *MAXIMUM FLEXIBLE DUCT LENGTH SHALL BE 5'-0".*
4. *ALL AIR DISTRIBUTION DEVICES SHALL HAVE LOCKABLE VOLUME CONTROL DEVICES.*
5. *ALL 90 DEGREE TURNING ELBOWS SHALL BE SMOOTH ROUND OR SQUARE WITH TURNING VANES.*
6. *DUCT SIZES SHOWN ON PLANS ARE INSIDE FREE AREA.*
7. *PROVIDE ACCESS DOORS IN DUCTS AHEAD OF ALL AUTOMATIC, FIRE, AND SMOKE DAMPERS.*
8. *FOR BALANCING THE OUTSIDE AIRFLOW QUANTITIES, REFER TO HVAC SCHEDULES.*

HVAC PLAN KEYED NOTES

1. *TERMINATE EXHAUST DUCT WITH WALL CAP.*
2. *TERMINATE CONDENSATE AT FLOOR DRAIN.*
3. *PROVIDE FIRE DAMPER AT ALL RATED CEILING PENETRATIONS.*
4. *TERMINATE INTAKE DUCT WITH WALL CAP. MAINTAIN 10' CLEARANCE FROM ALL EXHAUST OUTLETS.*
5. *HI/LOW RETURN TRANSFER GRILLE. MOUNT HI GRILLE 12" BELOW CEILING AND LOW GRILLE 12" A.F.F.*
6. *30" FIRE READY RANGE HOOD.*

PRINTS ISSUED
10/30/2023 - PERMIT SUBMITTAL

REVISIONS:
1 12/15/2023 - CITY COMMENTS

pkmr ENGINEERS
PEARSON KENT MCKINLEY RAAF ENGINEERS LLC
13300 W 98TH STREET LENEXA, KS 66215
913.492.2400 WWW.PKMRENG.COM
MO State Certificate of Authority #E-2002020886

23.161

STATE OF MISSOURI
MICHAEL D RAAF
NUMBER PE-2005028097
REGISTERED PROFESSIONAL ENGINEER
12/15/23
Michael D. Raaf - Engineer
MO# PE-2005028097

WILSHIRE HILLS III

LEE'S SUMMIT, MISSOURI

SHEET TITLE
FIRST FLOOR HVAC PLAN

PROJECT NUMBER: 23.161

SHEET NUMBER:

M101

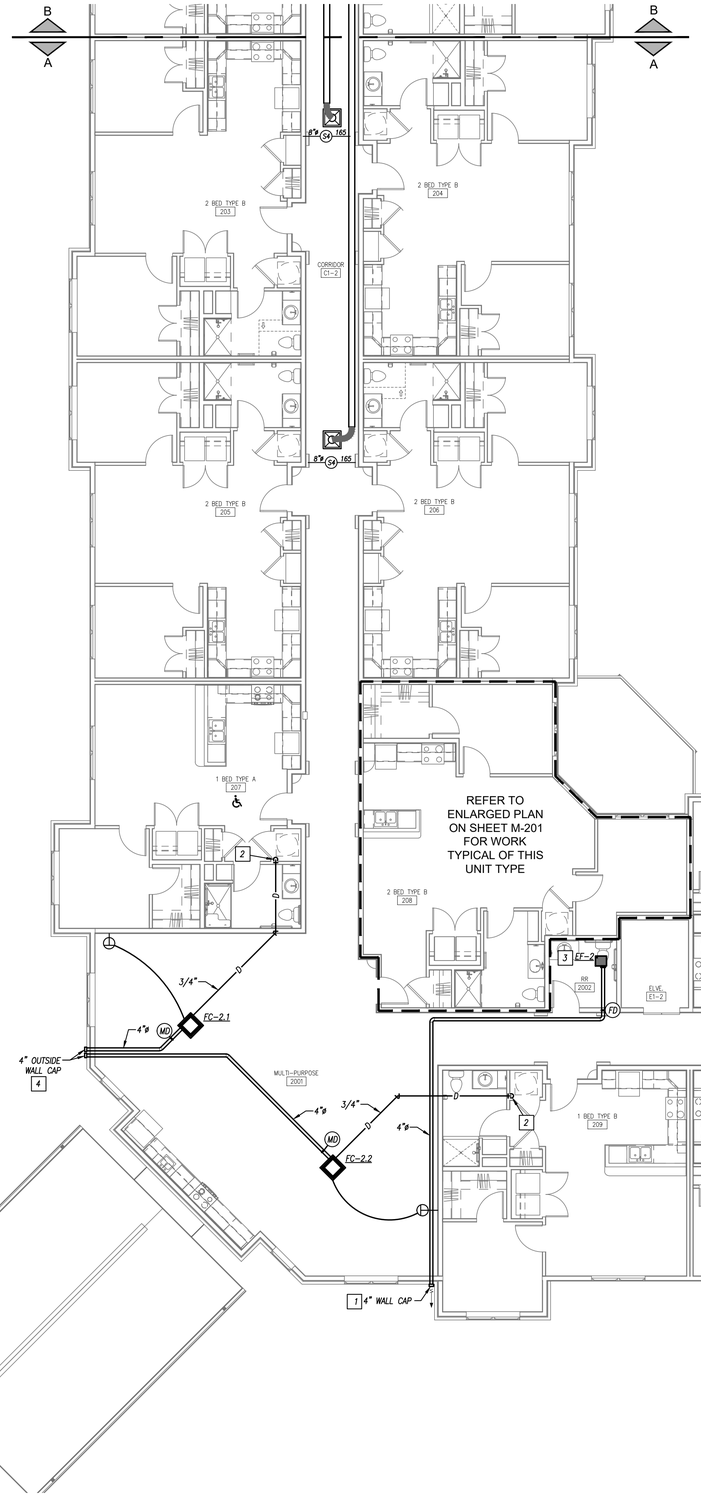

SECOND FLOOR HVAC PLAN

1/8" = 1'-0"

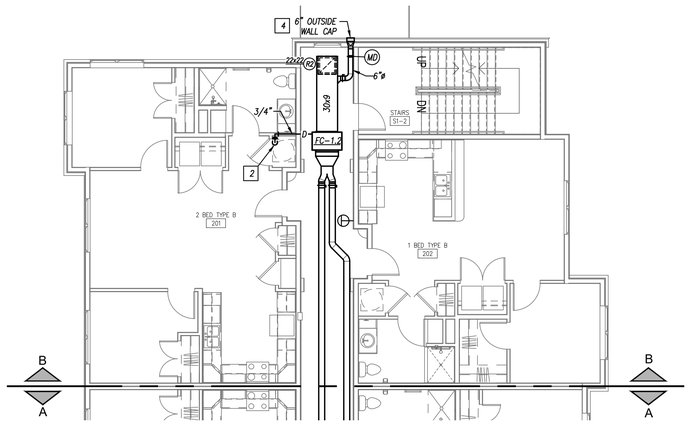

SECOND FLOOR HVAC PLAN - CONT.

1/8" = 1'-0"

GENERAL HVAC NOTES

1. REFER TO GENERAL NOTES ON MEP COVER SHEET FOR ADDITIONAL REQUIREMENTS OF WORK.
2. ROUND BRANCH DUCT RUNOUTS AND FLEXIBLE DUCT SHALL BE THE SAME SIZE AS THE DIFFUSER NECK UNLESS NOTED OTHERWISE.
3. MAXIMUM FLEXIBLE DUCT LENGTH SHALL BE 5'-0".
4. ALL AIR DISTRIBUTION DEVICES SHALL HAVE LOCKABLE VOLUME CONTROL DEVICES.
5. ALL 90 DEGREE TURNING ELBOWS SHALL BE SMOOTH ROUND OR SQUARE WITH TURNING VANES.
6. DUCT SIZES SHOWN ON PLANS ARE INSIDE FREE AREA.
7. PROVIDE ACCESS DOORS IN DUCTS AHEAD OF ALL AUTOMATIC, FIRE, AND SMOKE DAMPERS.
8. FOR BALANCING THE OUTSIDE AIRFLOW QUANTITIES, REFER TO HVAC SCHEDULES.

HVAC PLAN KEYED NOTES

1. TERMINATE EXHAUST DUCT WITH WALL CAP.
2. TERMINATE CONDENSATE AT FLOOR DRAIN.
3. PROVIDE FIRE DAMPER AT ALL RATED CEILING PENETRATIONS.
4. TERMINATE INTAKE DUCT WITH WALL CAP. MAINTAIN 10' CLEARANCE FROM ALL EXHAUST OUTLETS.

PRINTS ISSUED
10/30/2023 - PERMIT SUBMITTAL

REVISIONS:

23.161

pkmr ENGINEERS
PEARSON KENT MCKINLEY RAAF ENGINEERS LLC
13300 W 98TH STREET LENEXA, KS 66215
913.492.2400 WWW.PKMRENG.COM
MO State Certificate of Authority #E-2002020886

STATE OF MISSOURI
MICHAEL D RAAF
NUMBER PE-2005028097
REGISTERED PROFESSIONAL ENGINEER
10/30/23
Michael D. Raaf - Engineer
MO# PE-2005028097

WILSHIRE HILLS III

LEE'S SUMMIT, MISSOURI

SHEET TITLE
SECOND FLOOR HVAC PLAN

PROJECT NUMBER: 23.161

SHEET NUMBER:

M102

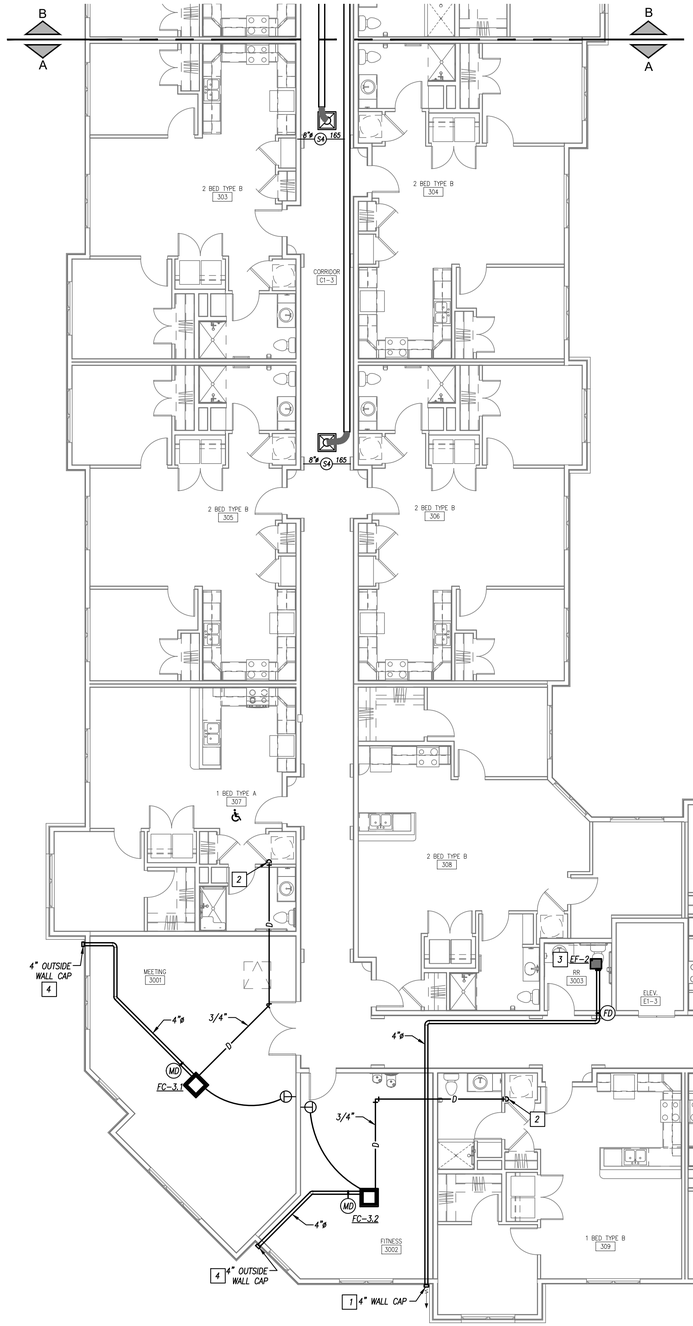

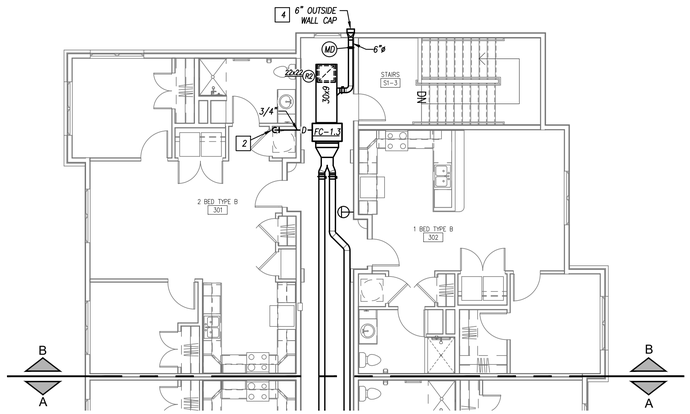

THIRD FLOOR HVAC PLAN - CONT.

1/8" = 1'-0"

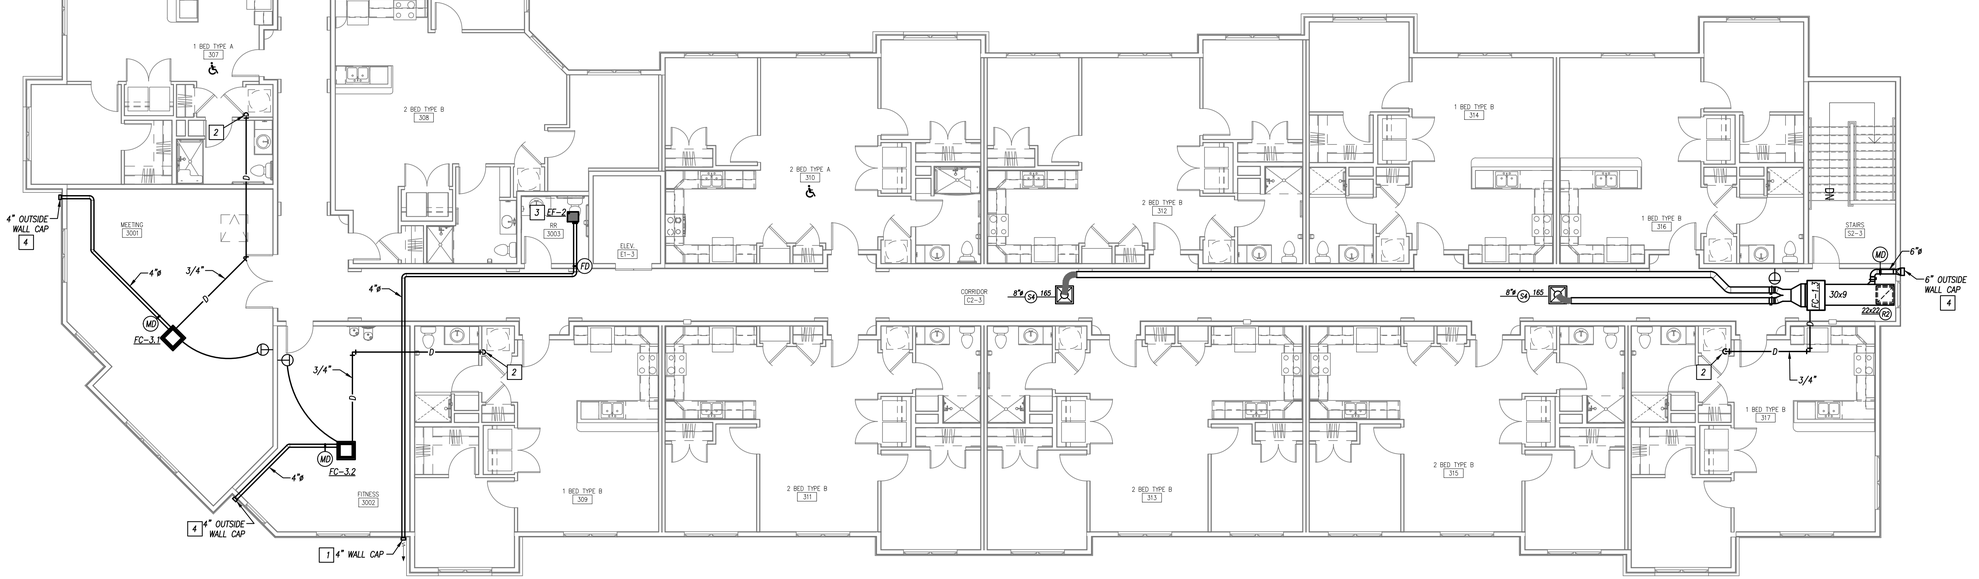

THIRD FLOOR HVAC PLAN

1/8" = 1'-0"

GENERAL HVAC NOTES

1. *REFER TO GENERAL NOTES ON MEP COVER SHEET FOR ADDITIONAL REQUIREMENTS OF WORK.*
2. *ROUND BRANCH DUCT RUNOUTS AND FLEXIBLE DUCT SHALL BE THE SAME SIZE AS THE DIFFUSER NECK UNLESS NOTED OTHERWISE.*
3. *MAXIMUM FLEXIBLE DUCT LENGTH SHALL BE 5'-0".*
4. *ALL AIR DISTRIBUTION DEVICES SHALL HAVE LOCKABLE VOLUME CONTROL DEVICES.*
5. *ALL 90 DEGREE TURNING ELBOWS SHALL BE SMOOTH ROUND OR SQUARE WITH TURNING VANES.*
6. *DUCT SIZES SHOWN ON PLANS ARE INSIDE FREE AREA.*
7. *PROVIDE ACCESS DOORS IN DUCTS AHEAD OF ALL AUTOMATIC, FIRE, AND SMOKE DAMPERS.*
8. *FOR BALANCING THE OUTSIDE AIRFLOW QUANTITIES, REFER TO HVAC SCHEDULES.*

HVAC PLAN KEYED NOTES

1. *TERMINATE EXHAUST DUCT WITH WALL CAP.*
2. *TERMINATE CONDENSATE AT FLOOR DRAIN.*
3. *PROVIDE FIRE DAMPER AT ALL RATED CEILING PENETRATIONS.*
4. *TERMINATE INTAKE DUCT WITH WALL CAP. MAINTAIN 10' CLEARANCE FROM ALL EXHAUST OUTLETS.*

PRINTS ISSUED
10/30/2023 - PERMIT SUBMITTAL

REVISIONS:

23.161

pkmr ENGINEERS
PEARSON KENT MCKINLEY RAAF ENGINEERS LLC
13300 W 98TH STREET LENEXA, KS 66215
913.492.2400 WWW.PKMRENG.COM
MO State Certificate of Authority #E-2002020886

STATE OF MISSOURI
MICHAEL D RAAF
NUMBER PE-2005028097
REGISTERED PROFESSIONAL ENGINEER
10/30/23
Michael D. Raaf - Engineer
MO# PE-2005028097

WILSHIRE HILLS III

LEE'S SUMMIT, MISSOURI

SHEET TITLE
THIRD FLOOR HVAC PLAN

PROJECT NUMBER: 23.161

SHEET NUMBER:

M103

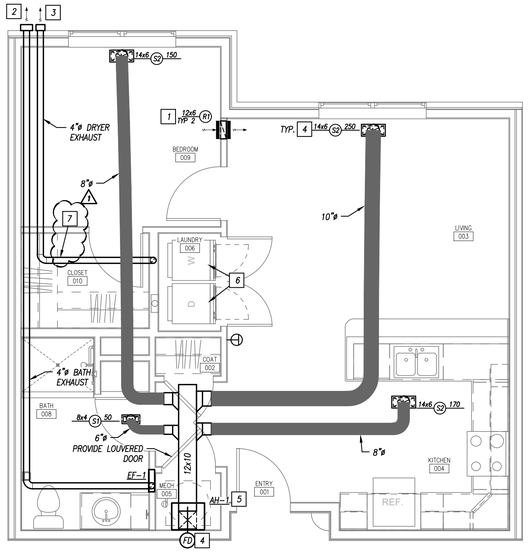

TYPE B - ONE BEDROOM
TYPICAL UNIT FLOOR PLAN - HVAC
1/4" = 1'-0"

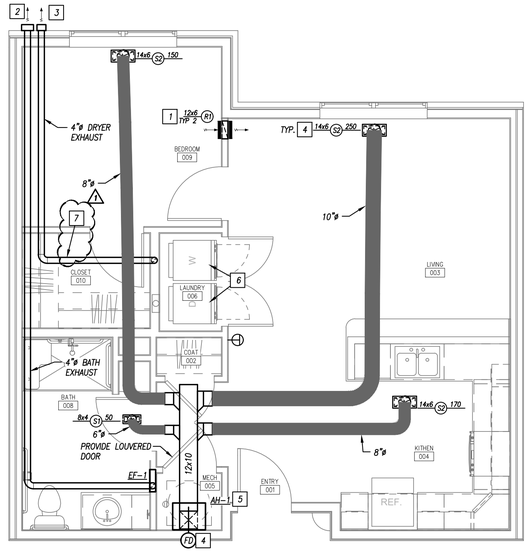

TYPE A - ONE BEDROOM
TYPICAL UNIT FLOOR PLAN - HVAC
1/4" = 1'-0"

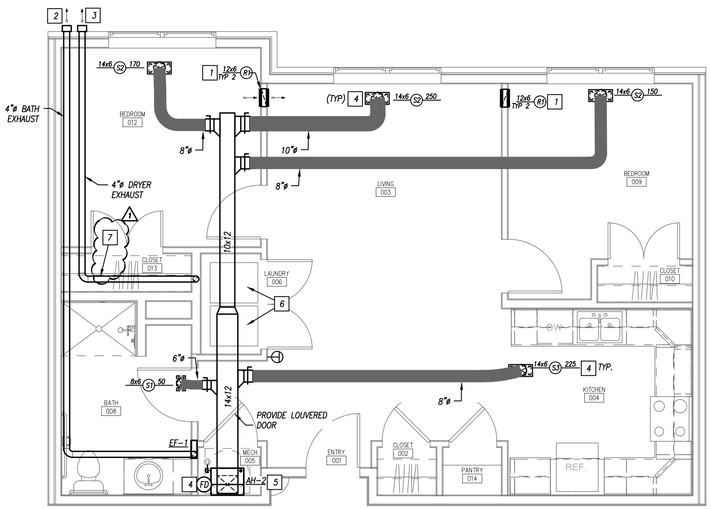

TYPE B - TWO BEDROOM
TYPICAL UNIT FLOOR PLAN - HVAC
1/4" = 1'-0"

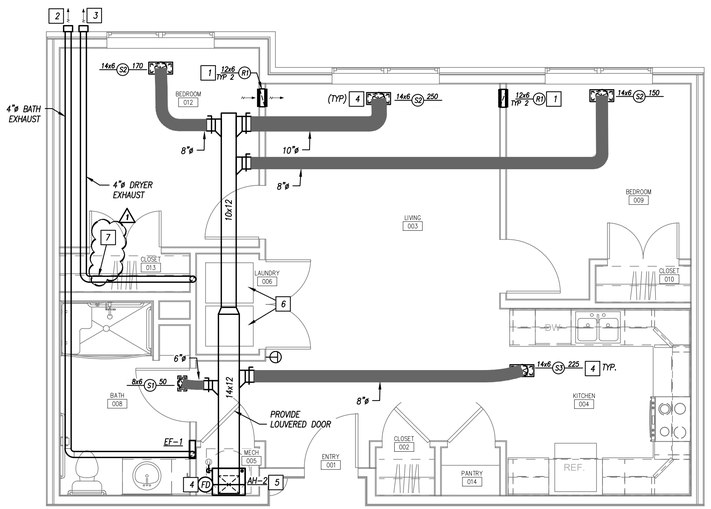

TYPE A - TWO BEDROOM
TYPICAL UNIT FLOOR PLAN - HVAC
1/4" = 1'-0"

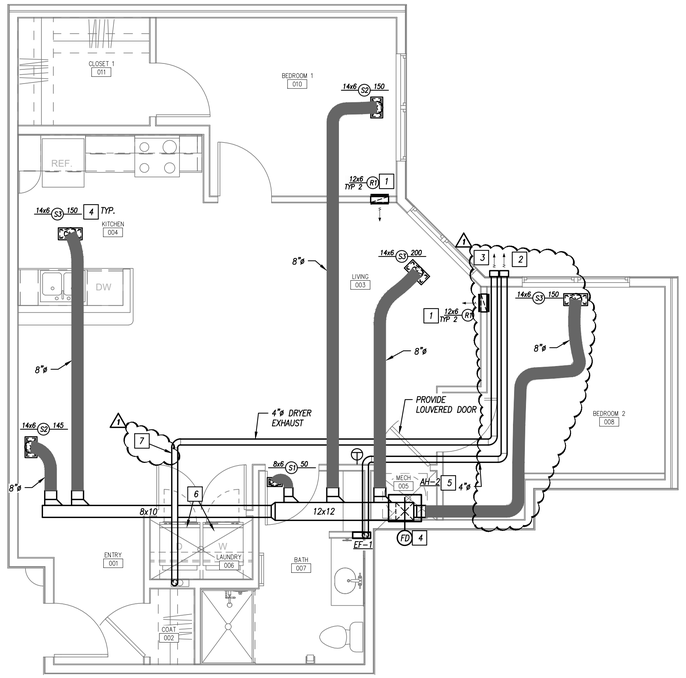

TYPE B - TWO BEDROOM - (CORNER)
TYPICAL UNIT FLOOR PLAN - HVAC
1/4" = 1'-0"

GENERAL HVAC NOTES

1. REFER TO GENERAL NOTES ON MEP COVER SHEET FOR ADDITIONAL REQUIREMENTS OF WORK.
2. ROUND BRANCH DUCT RUNOUTS AND FLEXIBLE DUCT SHALL BE THE SAME SIZE AS THE DIFFUSER NECK UNLESS NOTED OTHERWISE.
3. ALL RUNOUTS TO TERMINAL BOXES SHALL BE ONE SIZE LARGER THAN BOX INLETS UNLESS NOTED OTHERWISE.
4. ALL AIR DISTRIBUTION DEVICES SHALL HAVE LOCKABLE VOLUME CONTROL DEVICES.
5. ALL 90 DEGREE TURNING ELBOWS SHALL BE SMOOTH ROUND OR SQUARE WITH TURNING VANES.
6. DUCT SIZES SHOWN ON PLANS ARE INSIDE FREE AREA.
7. PROVIDE ACCESS DOORS IN DUCTS AHEAD OF ALL AUTOMATIC, FIRE, AND SMOKE DAMPERS.
8. FOR BALANCING THE OUTSIDE AIRFLOW QUANTITIES, REFER TO HVAC SCHEDULES.
9. INSTALL RIGID DUCT WORK OR PULL ALL FLEX DUCTS WITH NO PINCHES AND SUPPORT AT INTERVALS OF 4' OR LESS.

HVAC PLAN KEYED NOTES

1. PROVIDE HIGH/LOW TRANSFER GRILLE.
2. 4" BATH EXHAUST DUCT TERMINATED WITH WALL CAP. WITH BACKDRAFT DAMPER AND BUG SCREEN.
3. 4" DRYER EXHAUST DUCT TERMINATED WITH DRYER EXHAUST CAP.
4. PROVIDE FIRE DAMPER AT ALL RATED CEILING PENETRATIONS.
5. ROUTE CONDENSATE DRAIN LINE TO FLOOR DRAIN IN MECHANICAL CLOSET.
6. WASHER TO BE INSTALLED TO THE LEFT OF DRYER WHEN FACING DRYER.
7. WHERE EXHAUST DUCT EQUIVALENT LENGTH EXCEEDS 35 FEET, THE EQUIVALENT LENGTH OF THE EXHAUST DUCT SHALL BE IDENTIFIED ON A PERMANENT LABEL OR TAG LOCATED WITHIN 6 FEET OF THE EXHAUST DUCT CONNECTION.

PRINTS ISSUED
10/30/2023 - PERMIT SUBMITTAL

REVISIONS:
1 12/15/2023 - CITY COMMENTS

pkmr ENGINEERS
PEARSON KENT MCKINLEY RAAF ENGINEERS LLC
13300 W 98TH STREET LENEXA, KS 66215
913.492.2400 WWW.PKMRENG.COM
MO State Certificate of Authority #E-2002020886

23.161

STATE OF MISSOURI
MICHAEL D RAAF
NUMBER PE-2005028097
REGISTERED PROFESSIONAL ENGINEER
12/15/23
Michael D. Raaf - Engineer
MO# PE-2005028097

WILSHIRE HILLS III
LEE'S SUMMIT, MISSOURI

SHEET TITLE
ENLARGED UNIT PLANS - HVAC

PROJECT NUMBER: 23.161

SHEET NUMBER:

M201

QUAD-ZONE MULTI-SPLIT HEAT PUMP SYSTEM

PLAN MARK	MANUFACTURER	OUTDOOR HEAT PUMP UNIT											INDOOR FAN COIL UNITS							REMARKS
		MODEL	COOLING CAPACITY (MBH)	HEATING CAPACITY (MBH)	AMBIENT	REF.	MCA	MOCP	SEER	HSPF	VOLTAGE	WEIGHT (LBS.)	MARK	MODEL	CFM	CAPACITY (MBH)	AMPS	VOLTAGE	WEIGHT (LBS.)	
MHP-1	DAIKIN	4MXS36RMVJUA	36.0	36.0	105*	R410A	23.9	25	14.00	8.20	208V / 1PH	139	FC-1.1	FDXS12LVJU	330	12.0	0.25	208V / 1PH	47	ALL
													FC-1.2	FDXS12LVJU	330	12.0	0.25	208V / 1PH	47	
													FC-1.3	FDXS12LVJU	330	12.0	0.25	208V / 1PH	47	
													---	---	---	---	---	---	---	
MHP-2	DAIKIN	4MXS36RMVJUA	36.0	36.0	105*	R410A	23.9	25	14.00	8.20	208V / 1PH	139	FC-2.1	FFQ18Q2VJU	378	18.0	0.52	208V / 1PH	39	ALL
													FC-2.2	FFQ18Q2VJU	378	18.0	0.52	208V / 1PH	39	
													---	---	---	---	---	---	---	
													---	---	---	---	---	---	---	
MHP-3	DAIKIN	4MXS36RMVJUA	36.0	36.0	105*	R410A	23.9	25	14.00	8.20	208V / 1PH	139	FC-3.1	FFQ18Q2VJU	378	18.0	0.52	208V / 1PH	39	ALL
													FC-3.2	FFQ18Q2VJU	378	18.0	0.52	208V / 1PH	39	
													---	---	---	---	---	---	---	
													---	---	---	---	---	---	---	

REMARKS:

1. PROVIDE WITH WIRED WALL CONTROL.
2. PROVIDE INTEGRAL DISCONNECT SWITCH FOR INDOOR AND OUTDOOR UNITS.
3. PROVIDE WITH INSULATED REFRIGERANT LINE-SETS AND REFRIGERANT.
4. PROVIDE WITH CONDENSATE PUMP. PROVIDE DRAIN PAN UNDER FAN COIL UNITS WITH OVERFLOW SHUTOFF FLOAT SWITCH.

HVAC PIPING MATERIAL SCHEDULE

PIPING SYSTEM	SIZE	TYPE/SCHED	MATERIAL	ACCEPTABLE FITTINGS	FIELD TEST PRESSURE/TIME	ALLOWABLE IN PLENUMS	INSULATION TYPE	INSULATION THICKNESS
CONDENSATE DRAIN ON ROOF	3/4" - 2"	SCH. 40	PVC	SOLVENT JOINED	10 FT - 1/2HR	NO	-	-
CONDENSATE DRAIN INTERIOR	3/4" - 2"	SCH. 40	CPVC	SOLVENT JOINED	10 FT - 1/2HR	YES	FIBERGLASS W/ ASJ	1/2" (PLENUM ONLY)
CONDENSATE DRAIN INTERIOR	1/2" - 2"	L	COPPER	SOLDER, PRO-PRESS	10 FT - 1/2HR	YES	FIBERGLASS W/ ASJ	1/2" (PLENUM ONLY)
REFRIGERANT LINES	1/2" - 2"	ACR	COPPER	BRAZED		YES	ELASTOMERIC	3/4"

NOTES:

1. ALL PIPING AND MATERIALS IN PLENUMS MUST MEET ASTM E84 FLAME/SMOKE RATING OF 25/50.
2. ALL INSULATION THICKNESSES SHALL MEET ASHRAE 90.1 - 2007 REQUIREMENTS AT A MINIMUM.
3. REFER TO SPECIFICATIONS FOR MORE DETAILED INFORMATION.

ELECTRIC HEATER SCHEDULE

PLAN MARK	MANUFACTURER	MODEL NUMBER	TYPE	CFM	KW	VOLTAGE	REMARKS
UH-1	QMARK	AWH SERIES	WALL HEATER	100	4.0	208V / 1PH	1
UH-2	QMARK	MUH SERIES	UNIT HEATER	350	3.0	208V / 1PH	1

REMARKS:

1. PROVIDE WITH REMOTE THERMOSTAT AND DISCONNECT.

RESIDENTIAL RANGE FIRE SUPRESSION SYSTEM SCHEDULE

PLAN MARK	MANUFACTURER	MODEL NUMBER	RANGE SIZE (WIDTH x DEPTH, IN.)	REMARKS
FS-1	GUARDIAN	G300B	36"x24"	ALL

REMARKS:

1. PROVIDE WITH FUEL SHUTOFF; ELECTRIC 4PRONG OPTION. COORDINATE CORRECT PLUG TYPE WITH APPLIANCE VENDOR.
2. PROVIDE WITH FIRE ALARM INTERFACE MODULE. INTERLOCK SUPPRESSION SYSTEM WITH BUILDING FIRE ALARM PANEL.

MINI-SPLIT SYSTEMS

PLAN MARK	AREA SERVED	MANUFACTURER	MODEL	STYLE	NOM. TON.	SUPPLY FAN						OUTDOOR HEAT PUMP UNIT							REMARKS
						CFM	FLA	EAT/LAT	CAP. (MBH)	TYPE	VOLTAGE	MARK	MODEL	AMBIENT	REF.	MCA	MOCP	VOLTAGE	
FC-2	ELEVATOR EQUIPMENT	DAIKIN	FTKN24NMVJU	WALL MOUNTED	1	300	0.35	75* / 55*	24.0	DX	24V	CU-2	RKN24NMVJU	0*F /95*F	R-410A	18.3	20	208V / 1PH	ALL

REMARKS:

1. PROVIDE WIRED WITH WALL MOUNTED THERMOSTAT / CONTROLLER.
2. PROVIDE INTEGRAL DISCONNECT FOR INDOOR EVAPORATOR AND CONDENSING UNIT. PROVIDE WIRING BETWEEN INDOOR AND OUTDOOR UNIT. COORDINATE WITH EC.
3. UNIT SHALL OPERATE DOWN TO 0*F IN COOLING MODE. PROVIDE ACCESSORIES AS REQUIRED.

GRILLE, REGISTER & DIFFUSER SCHEDULE

PLAN MARK	MANUFACTURER	MODEL NUMBER	STYLE	DESCRIPTION	SERVICE	NECK SIZE (IN)	FACE SIZE (IN)	VOLUME DAMPER	MATERIAL	FINISH COLOR	REMARKS
S1	HART AND COOLEY	682	CEILING / SIDEWALL	2-WAY DEFLECTION	SUPPLY	AS INDICATED	NECK + 1-3/4"	YES	STEEL	WHITE	3
S2	HART AND COOLEY	683	CEILING / SIDEWALL	3-WAY DEFLECTION	SUPPLY	AS INDICATED	NECK + 1-3/4"	YES	STEEL	WHITE	3
S3	HART AND COOLEY	684	CEILING / SIDEWALL	4-WAY DEFLECTION	SUPPLY	AS INDICATED	NECK + 1-3/4"	YES	STEEL	WHITE	3
S4	HART AND COOLEY	SRE	LAY - IN CEILING	STEEL LOUVERED CONCENTRIC CORE	SUPPLY	AS INDICATED	24"x24"	YES	STEEL	WHITE	1
S5	HART AND COOLEY	SRE	HARD CEILING	STEEL LOUVERED CONCENTRIC CORE	SUPPLY	AS INDICATED	18"x18"	YES	STEEL	WHITE	-
R1	HART AND COOLEY	650	CEILING / SIDEWALL	20 DEG LOUVERED RETURN 1/3" BLADE SPACING	RETURN	AS INDICATED	NECK + 1-3/4"	NO	STEEL	WHITE	-

REMARKS:

1. PROVIDE WITHOUT SCREW HOLES WHERE USED IN GRID CEILING.
2. PROVIDE WITH 20x20x1 DISPOSABLE FILTER.
3. PROVIDE UL555C CEILING RADIATION DAMPER ON BACKSIDE OF DEVICE.

EXHAUST FAN SCHEDULE

PLAN MARK	MANUFACTURER	MODEL NUMBER	TYPE	SERVICE	FAN DATA						ELECTRICAL	CONTROL	REMARKS
					CFM	E.S.P. (IN)	HP	DRIVE	SONES	RPM			
EF-1	BROAN	LP50100DC	WALL	BATHROOM	50	0.300	4W	DIRECT	6	1,334	120V / 1PH	SWITCH	-
EF-2	BROAN	XB80	CEILING CABINET	BATHROOM	80	0.250	12W	DIRECT	0.3	---	120V / 1PH	SWITCH	1

REMARKS:

1. UNIT SHALL BE PROVIDED WITH CEILING RADIATION DAMPER WHEN INSTALLED IN RATED CEILING.

DUCTWORK INSULATION SCHEDULE

PURPOSE	DUCT LOCATION	DUCT STYLE	INSULATION MATERIAL	INSULATION APPLICATION	INSULATION THICKNESS	NOTES
SUPPLY	CONCEALED	RECTANGULAR	FIBERGLASS	LINED	1/2"	---
	CONCEALED	ROUND	MINERAL FIBER	WRAPPED	1-1/2"	---
	UNCONDITIONED ATTICS	ALL	MINERAL FIBER	WRAPPED	1-1/2"	1
RETURN	CONCEALED	RECTANGULAR	FIBERGLASS	LINED	1/2"	---
	CONCEALED	ROUND	MINERAL FIBER	WRAPPED	1-1/2"	---
	RETURN/TRANSFER BOOTS	RECTANGULAR	FIBERGLASS	LINED	1/2"	---
	UNCONDITIONED ATTICS	ALL	MINERAL FIBER	WRAPPED	1-1/2"	1
	EXTERIOR	ALL	FLEXIBLE ELASTOMERIC	WRAPPED	2"	---
EXHAUST	CONCEALED	RECTANGULAR	---	---	---	---
	CONCEALED	ROUND	---	---	---	---
	DRYER EXHAUST WITH RATED ASSEMBLY	ROUND	UL LISTED FIRE RATED WRAP SYSTEM			---
OUTSIDE AIR	CONCEALED OR MECH. SPACE	RECTANGULAR	MINERAL FIBER	WRAPPED	1-1/2"	---
	CONCEALED OR MECH. SPACE	ROUND	MINERAL FIBER	WRAPPED	1-1/2"	---

NOTES:

1. IN ADDITION TO OTHER SCHEDULED INSULATION.

GENERAL REMARKS (APPLICABLE TO ALL TYPES):

1) ALL DUCTWORK, INSULATION AND MATERIALS IN PLENUMS MUST MEET ASTM E84 FLAME/SMOKE RATING OF 25/50.
2) ALL INSULATION THICKNESSES SHALL MEET ASHRAE 90.1 - 2010 REQUIREMENTS AT A MINIMUM.
3) REFER TO SPECIFICATIONS FOR MORE DETAILED INFORMATION FOR INSULATION PRODUCTS AND SYSTEMS.

AIR HANDLER SCHEDULE

PLAN MARK	MANUFACTURER	MODEL NUMBER	CFM	O.A. CFM	E.S.P. (IN. W.C.)	FAN HP	TOTAL COOLING CAPACITY (MBH)	HEATING		ELECTRICAL			REMARKS
								COIL KW	ΔT	VOLTAGE	MCA	MOCP	
AH-1	DAIKIN	AWUF 310516A	620	-	0.5"	1/2	17.2	5.0	19.1	208V / 1PH	27.0	30	1,2,4,5
AH-2	DAIKIN	AWUF 310816A	845	-	0.5"	1/3	24.0	5.0	23.7	208V / 1PH	27.0	30	1,2,4,5
AH-3	DAIKIN	ASPT33C14B	820	80	0.5"	3/4	23.4	8.0	23.1	208V / 1PH	41.0	45	1,2,3,4,5
AH-4	DAIKIN	ASPT35B14A	920	100	0.5"	3/4	27.2	10.0	25.8	208V / 1PH	49.0	50	1,2,3,4,5

REMARKS:

1. HEATING CAPACITIES ARE BASED ON 240V RATED VALUE AND WILL BE DERATED FOR 208V.
2. PROVIDE WITH INTEGRAL CIRCUIT BREAKER DISCONNECT.
3. PROVIDE WITH OUTSIDE AIR DUCT TO OUTDOORS WITH MOTORIZED DAMPER, BALANCING DAMPER, AND VENTILATION CONTROLLER (Honeywell YB150 Fresh Air Ventilation System, WB150 Fresh Air Ventilation Control).
4. PROVIDE WITH DAIKIN D4271C AUTO-CHANGEOVER THERMOSTAT AND REMOTE OUTDOOR TEMPERATURE SENSOR.
5. ACCEPTABLE ALTERNATE MANUFACTURERS: AMERICAN STANDARD, CARRIER, GOODMAN, LENNOX, OXBOX, TRANE, YORK, OR OTHER APPROVED EQUAL.

HEAT PUMP UNIT SCHEDULE

PLAN MARK	MANUFACTURER	MODEL NUMBER	COOLING CAPACITY (MBH)	HEATING CAPACITY (MBH)	MINIMUM SEER	AMBIENT TEMP. (°F)	ELECTRICAL			REMARKS
							VOLTS / PH	M.C.A.	M.O.C.P.	
HP-1	DAIKIN	DZ14SA	18.0	17.6 / 9.6	14.0	105*	208V / 1PH	12.2	20	ALL
HP-2	DAIKIN	DZ14SA	24.0	23.0 / 13.4	14.0	105*	208V / 1PH	14.6	25	ALL
HP-3	DAIKIN	DZ14SA	24.0	23.0 / 13.4	14.0	105*	208V / 1PH	14.6	25	ALL
HP-4	DAIKIN	DZ14SA	30.0	28.4 / 16.2	14.0	105*	208V / 1PH	17.8	30	ALL

REMARKS:

1. COOLING CAPACITY BASED ON A SUCTION TEMPERATURE OF 49*F.
2. HEATING CAPACITIES LISTED ARE AT 47*F AND 17*F.
3. PROVIDE 4" CONCRETE HOUSEKEEPING PAD.
4. ACCEPTABLE ALTERNATE MANUFACTURERS: AMERICAN STANDARD, CARRIER, GOODMAN, LENNOX, OXBOX, TRANE, YORK, OR OTHER APPROVED EQUAL.

PRINTS ISSUED
10/30/2023 - PERMIT SUBMITTAL

REVISIONS:
1 12/15/2023 - CITY COMMENTS

23.161

pkmr ENGINEERS
PEARSON KENT MCKINLEY RAAF ENGINEERS LLC
13300 W 98TH STREET LENEXA, KS 66215
913.492.2400 WWW.PKMRENG.COM
MO State Certificate of Authority #E-2002020886

STATE OF MISSOURI
MICHAEL D RAAF
NUMBER PE-2005028097
REGISTERED PROFESSIONAL ENGINEER
12/15/23
Michael D. Raaf - Engineer
MO# PE-2005028097

WILSHIRE HILLS III

LEE'S SUMMIT, MISSOURI

SHEET TITLE
MECHANICAL SCHEDULES

PROJECT NUMBER: 23.161

SHEET NUMBER:

M301

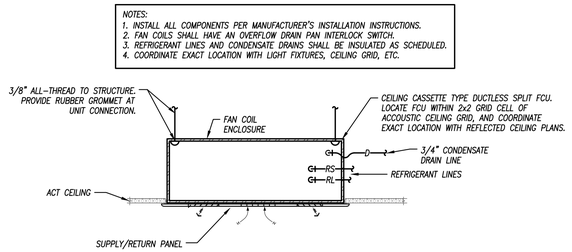

CEILING CASSETTE DUCTLESS FAN COIL DETAIL

NOT TO SCALE

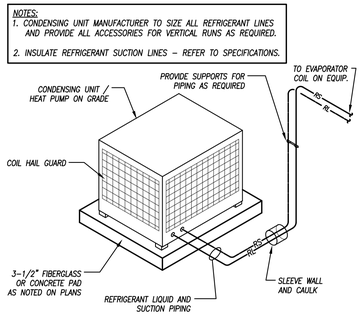

CONDENSING UNIT / HEAT PUMP DETAIL

NOT TO SCALE

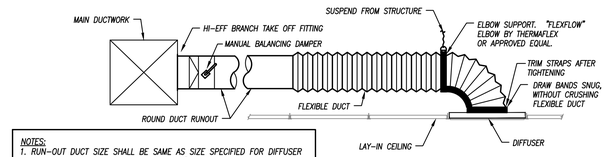

NOTES:
1. RUN-OUT DUCT SIZE SHALL BE SAME AS SIZE SPECIFIED FOR DIFFUSER INLET. INCREASE RUN-OUT DUCT SIZE 2" WHEN LENGTH OF RUN-OUT DUCT EXCEEDS 20'-0" AND PROVIDE TRANSITION AT THE DIFFUSER.
2. MAXIMUM FLEXIBLE DUCTWORK LENGTH IS 6'-0" UNLESS OTHERWISE NOTED ON DRAWINGS.
3. FLEXIBLE DUCTWORK MUST BE FULLY EXTENDED AND NOT IN CONTACT WITH PIPES AND/OR CONDUITS.
4. INSTALL FLEXIBLE DUCTWORK SUPPORTS AT ALL ROUND NECK OUTLETS/INLETS UNLESS OTHERWISE NOTED ON DRAWINGS.
5. FLEXIBLE DUCTWORK IS NOT TO BE USED IN UNACCESSIBLE LOCATIONS. (ABOVE GYP. BOARD CEILINGS, ETC.)

DUCT CONNECTION TO LAY-IN DIFFUSER DETAIL

NOT TO SCALE

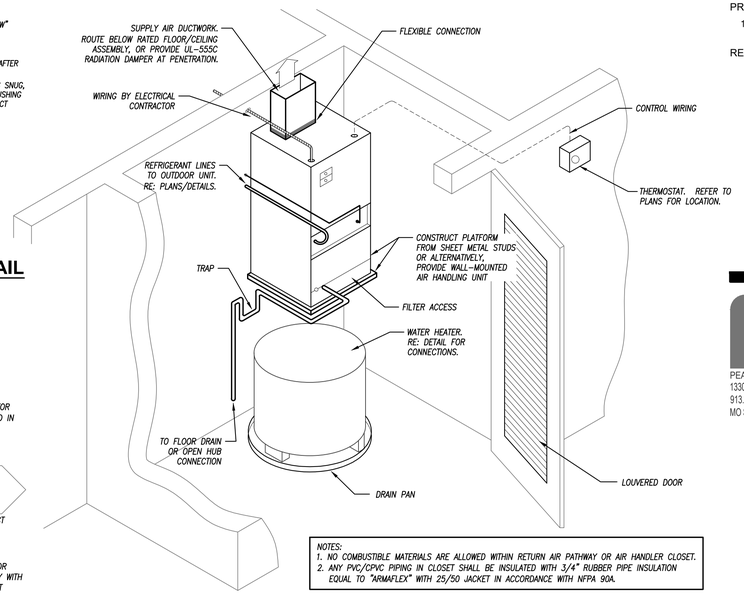

NOTES:
1. NO COMBUSTIBLE MATERIALS ARE ALLOWED WITHIN RETURN AIR PATHWAY OR AIR HANDLER CLOSET.
2. ANY PVC/CPVC PIPING IN CLOSET SHALL BE INSULATED WITH 3/4" RUBBER PIPE INSULATION EQUAL TO "ARMAFLEX" WITH 25/50 JACKET IN ACCORDANCE WITH NFPA 90A.

AIR HANDLING UNIT IN CLOSET DETAIL

NOT TO SCALE

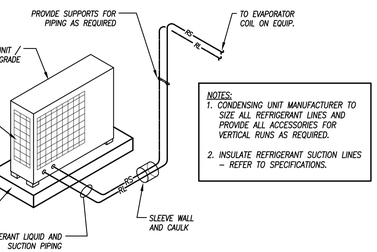

NOTES:
1. CONDENSING UNIT MANUFACTURER TO SIZE ALL REFRIGERANT LINES AND PROVIDE ALL ACCESSORIES FOR VERTICAL RUNS AS REQUIRED.
2. INSULATE REFRIGERANT SUCTION LINES – REFER TO SPECIFICATIONS.

MINI SPLIT CONDENSING UNIT / HEAT PUMP DETAIL

NOT TO SCALE

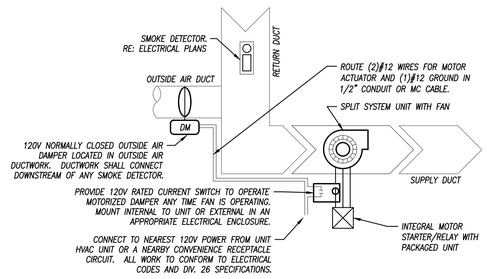

OUTSIDE AIR DAMPER WIRING SCHEMATIC

NOT TO SCALE

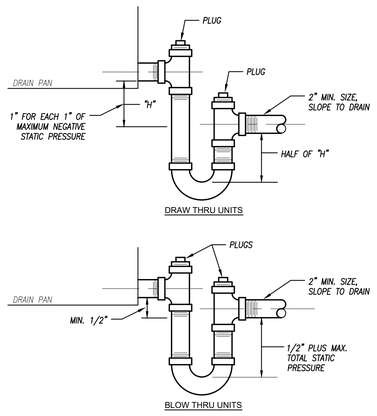

CONDENSATE TRAP DETAIL

NOT TO SCALE

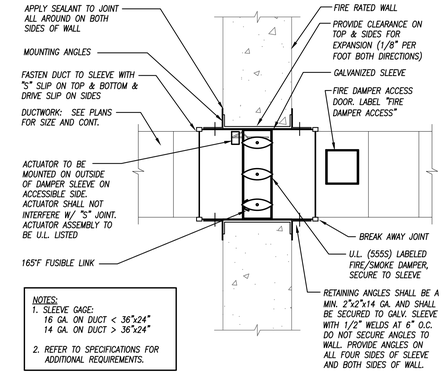

NOTES:
1. SLEEVE GAGE:
16 GA. ON DUCT < 36"x24"
14 GA. ON DUCT > 36"x24"
2. REFER TO SPECIFICATIONS FOR ADDITIONAL REQUIREMENTS.

FIRE/SMOKE DAMPER DETAIL

NOT TO SCALE

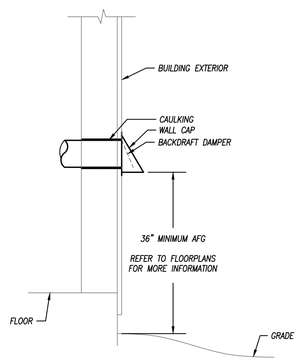

EXHAUST/VENT CAP AT EXTERIOR WALL

NOT TO SCALE

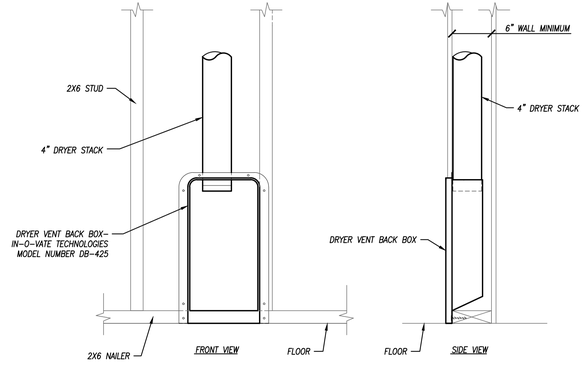

DRYER BOX DETAIL

NOT TO SCALE

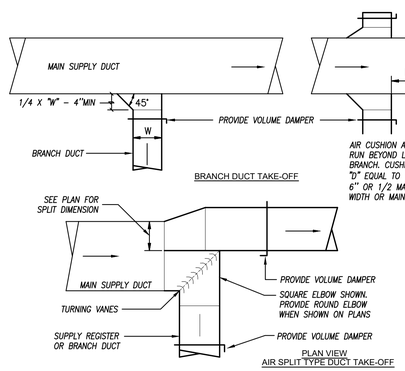

DUCTWORK TAKEOFFS

NOT TO SCALE

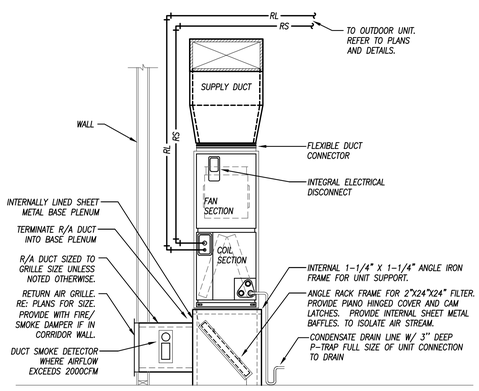

AIR HANDLING UNIT DETAIL

NOT TO SCALE

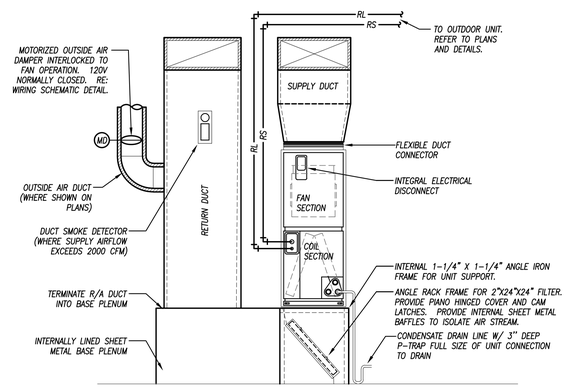

AIR HANDLING UNIT DETAIL

NOT TO SCALE

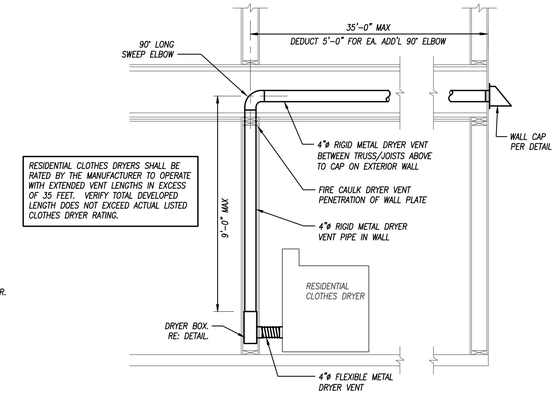

RESIDENTIAL CLOTHES DRYERS SHALL BE RATED BY THE MANUFACTURER TO OPERATE WITH EXTENDED VENT LENGTHS IN EXCESS OF 35 FEET. VERIFY TOTAL DEVELOPED LENGTH DOES NOT EXCEED ACTUAL LISTED CLOTHES DRYER RATING.

CLOTHES DRYER VENT DETAIL

NOT TO SCALE

PRINTS ISSUED
10/30/2023 - PERMIT SUBMITTAL

REVISIONS:

23.161

pkmr ENGINEERS
PEARSON KENT MCKINLEY RAAF ENGINEERS LLC
13300 W 98TH STREET LENEXA, KS 66215
913.492.2400 WWW.PKMRENG.COM
MO State Certificate of Authority #E-2002020886

STATE OF MISSOURI
MICHAEL D RAAF
NUMBER PE-2005028097
REGISTERED PROFESSIONAL ENGINEER
10/30/23
Michael D. Raaf - Engineer
MO# PE-2005028097

WILSHIRE HILLS III

LEE'S SUMMIT, MISSOURI

SHEET TITLE
MECHANICAL DETALS

PROJECT NUMBER: 23.161

SHEET NUMBER:

M401

FIRST FLOOR PLUMBING PLAN - CONT.

1/8" = 1'-0"

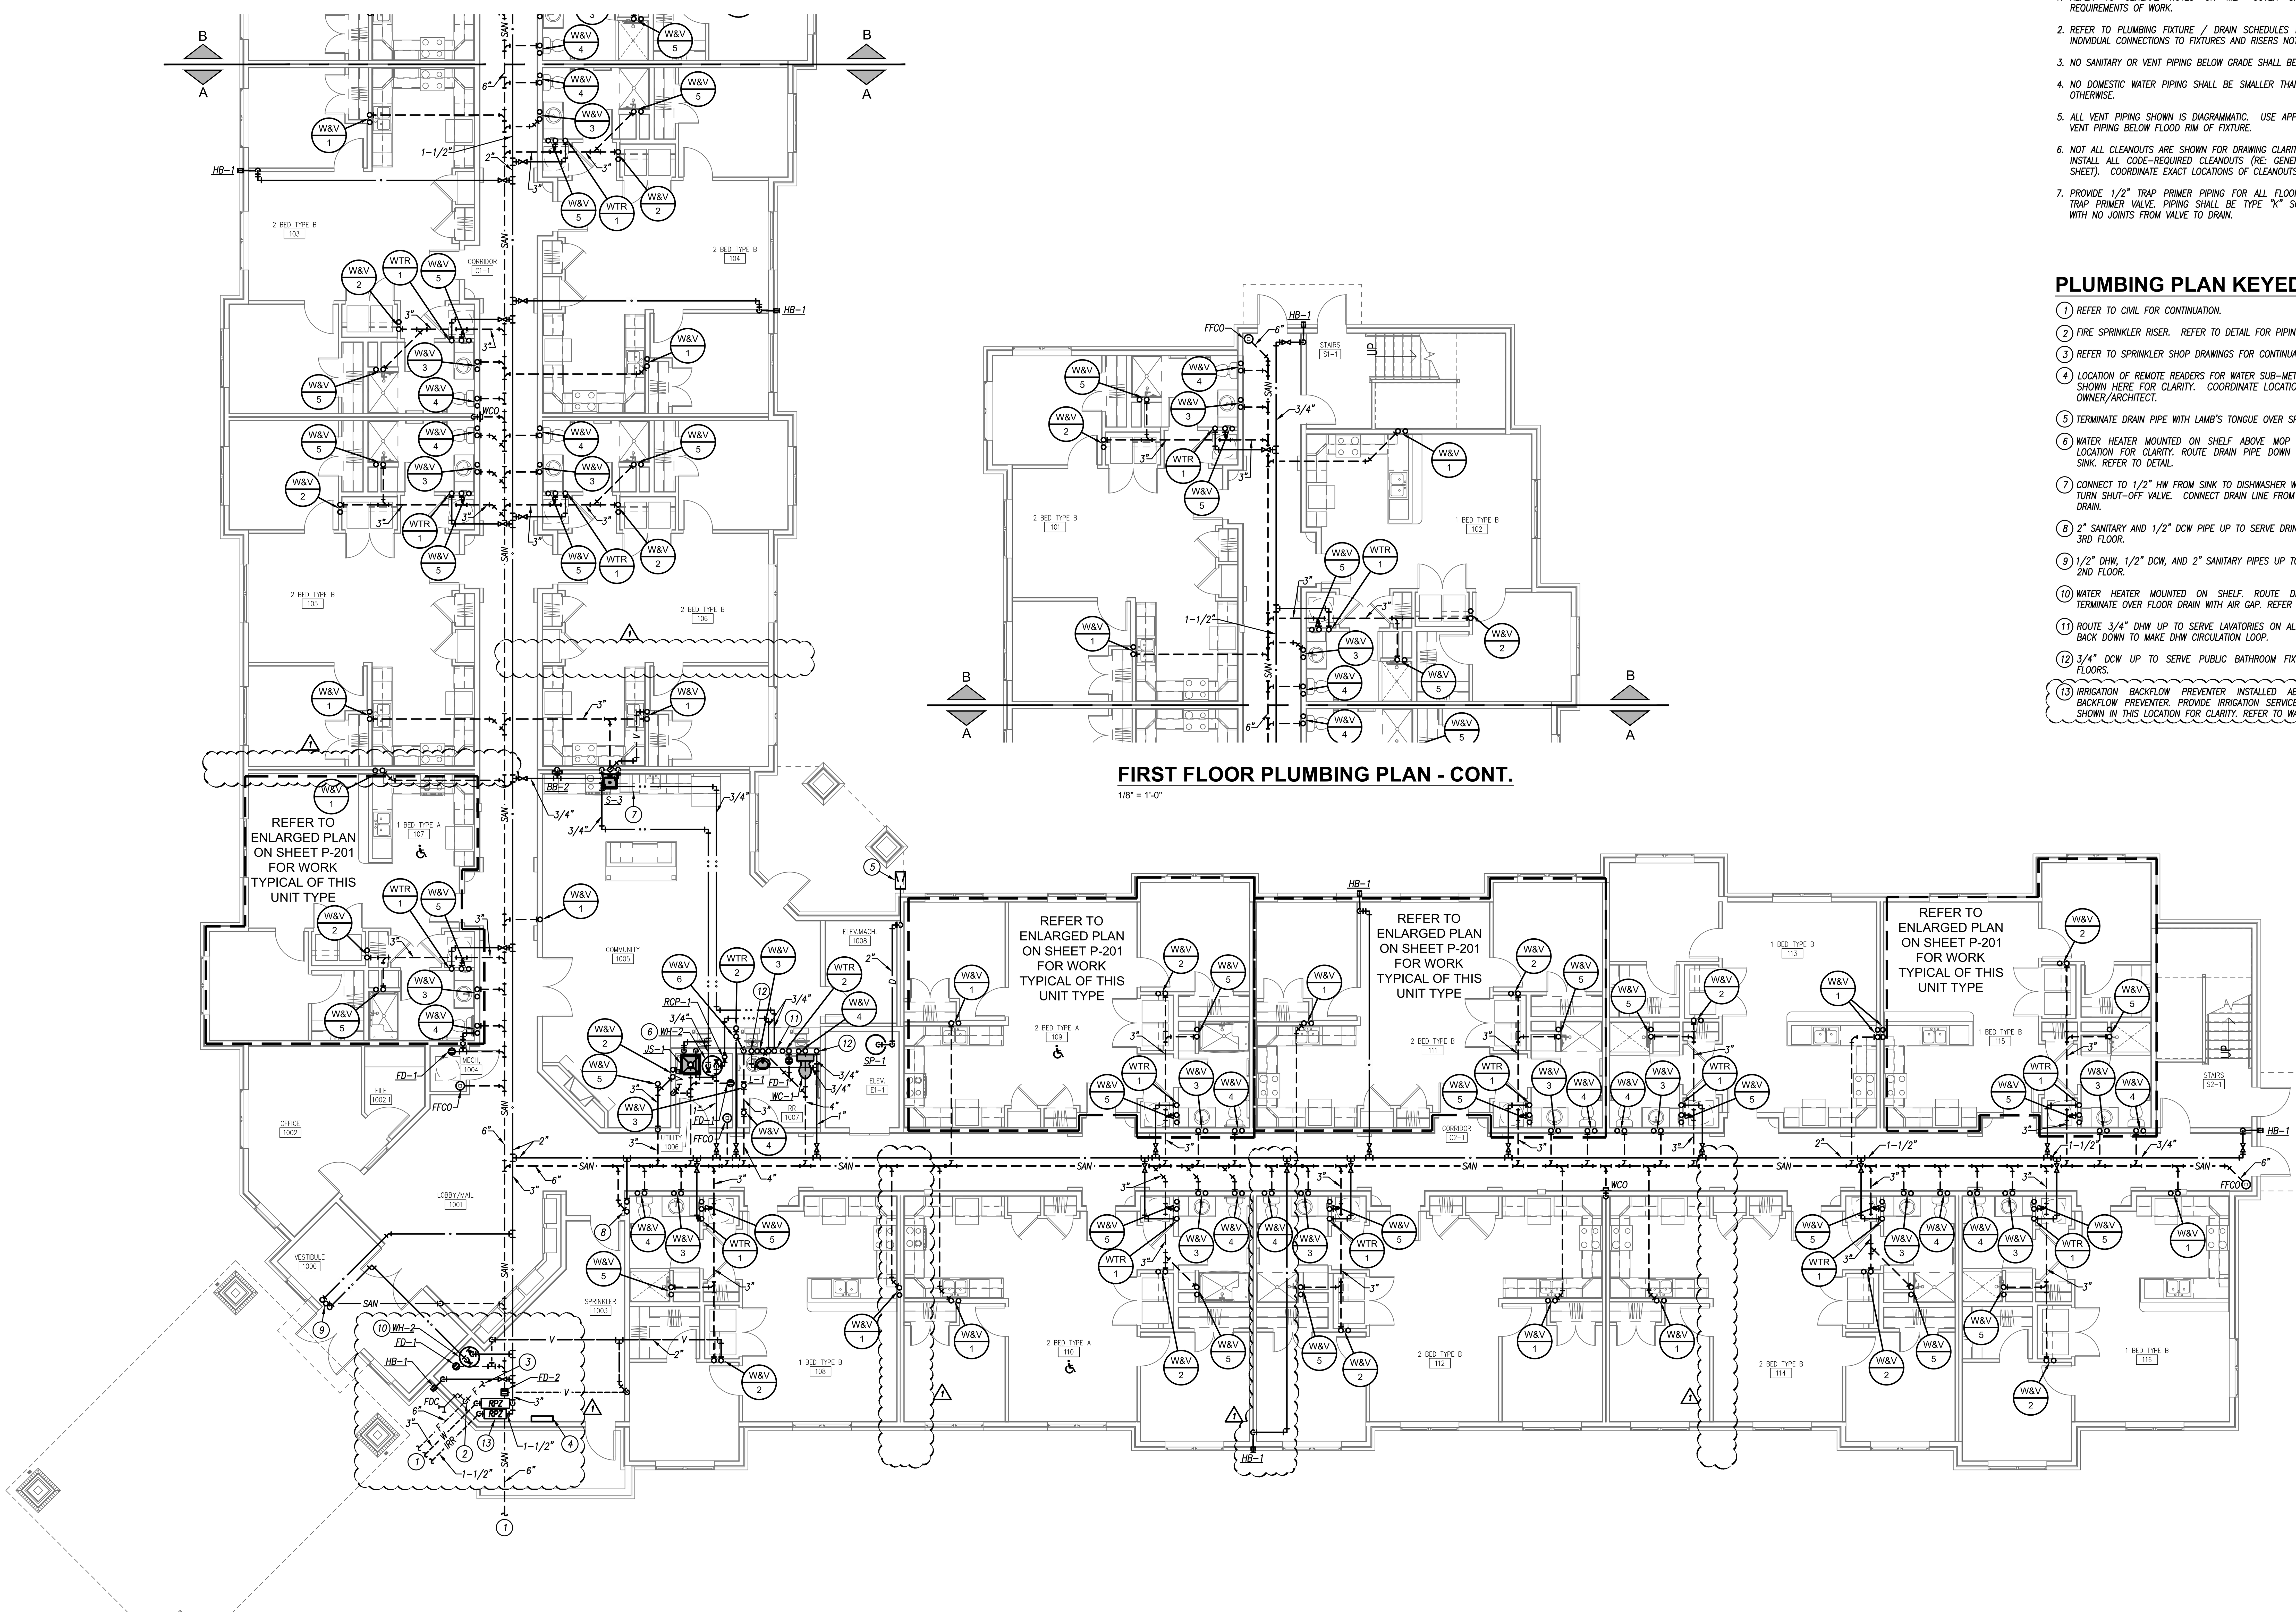

FIRST FLOOR PLUMBING PLAN

1/8" = 1'-0"

GENERAL PLUMBING NOTES

1. REFER TO GENERAL NOTES ON MEP COVER SHEET FOR ADDITIONAL REQUIREMENTS OF WORK.
2. REFER TO PLUMBING FIXTURE / DRAIN SCHEDULES FOR PIPING SIZES FOR INDIVIDUAL CONNECTIONS TO FIXTURES AND RISERS NOT SHOWN ON PLANS.
3. NO SANITARY OR VENT PIPING BELOW GRADE SHALL BE LESS THAN 2".
4. NO DOMESTIC WATER PIPING SHALL BE SMALLER THAN 3/4" UNLESS NOTED OTHERWISE.
5. ALL VENT PIPING SHOWN IS DIAGRAMMATIC. USE APPROPRIATE FITTINGS FOR VENT PIPING BELOW FLOOD RIM OF FIXTURE.
6. NOT ALL CLEANOUTS ARE SHOWN FOR DRAWING CLARITY. CONTRACTOR SHALL INSTALL ALL CODE-REQUIRED CLEANOUTS (RE: GENERAL NOTES ON COVER SHEET). COORDINATE EXACT LOCATIONS OF CLEANOUTS WITH ARCHITECT.
7. PROVIDE 1/2" TRAP PRIMER PIPING FOR ALL FLOOR DRAINS TO NEAREST TRAP PRIMER VALVE. PIPING SHALL BE TYPE "K" SOFT COPPER SEAMLESS WITH NO JOINTS FROM VALVE TO DRAIN.

PLUMBING PLAN KEYED NOTES

(1) REFER TO CIVIL FOR CONTINUATION.
(2) FIRE SPRINKLER RISER. REFER TO DETAIL FOR PIPING ARRANGEMENT.
(3) REFER TO SPRINKLER SHOP DRAWINGS FOR CONTINUATION.
(4) LOCATION OF REMOTE READERS FOR WATER SUB-METERS IN LIVING UNITS. SHOWN HERE FOR CLARITY. COORDINATE LOCATION WITH OWNER/ARCHITECT.
(5) TERMINATE DRAIN PIPE WITH LAMB'S TONGUE OVER SPLASH BLOCK.
(6) WATER HEATER MOUNTED ON SHELF ABOVE MOP SINK. SHOWN IN THIS LOCATION FOR CLARITY. ROUTE DRAIN PIPE DOWN TO TERMINATE IN MOP SINK. REFER TO DETAIL.
(7) CONNECT TO 1/2" HW FROM SINK TO DISHWASHER WITH ACCESSIBLE 1/4 TURN SHUT-OFF VALVE. CONNECT DRAIN LINE FROM DISHWASHER TO SINK DRAIN.
(8) 2" SANITARY AND 1/2" DCW PIPE UP TO SERVE DRINKING FOUNTAIN ON 3RD FLOOR.
(9) 1/2" DHW, 1/2" DCW, AND 2" SANITARY PIPES UP TO SERVE SINK ON 2ND FLOOR.
(10) WATER HEATER MOUNTED ON SHELF. ROUTE DRAIN PIPE DOWN TO TERMINATE OVER FLOOR DRAIN WITH AIR GAP. REFER TO DETAIL.
(11) ROUTE 3/4" DHW UP TO SERVE LAVATORIES ON ALL THREE FLOORS, THEN BACK DOWN TO MAKE DHW CIRCULATION LOOP.
(12) 3/4" DCW UP TO SERVE PUBLIC BATHROOM FIXTURES ON ALL THREE FLOORS.
(13) IRRIGATION BACKFLOW PREVENTER INSTALLED ABOVE WATER SERVICE BACKFLOW PREVENTER. PROVIDE IRRIGATION SERVICE WITH DEDUCT METER. SHOWN IN THIS LOCATION FOR CLARITY. REFER TO WATER SERVICE DETAIL. (1)

PRINTS ISSUED
10/30/2023 - PERMIT SUBMITTAL

REVISIONS:
(1) 12/15/2023 - CITY COMMENTS

pkmr ENGINEERS
23.161
PEARSON KENT MCKINLEY RAAF ENGINEERS LLC
13300 W 98TH STREET LENEXA, KS 66215
913.492.2400 WWW.PKMRENG.COM
MO State Certificate of Authority #E-2002020886

STATE OF MISSOURI
MICHAEL D. RAAF
NUMBER PE-2005028097
REGISTERED PROFESSIONAL ENGINEER
12/15/23
Michael D. Raaf - Engineer
MO# PE-2005028097

WILSHIRE HILLS III
LEE'S SUMMIT, MISSOURI

SHEET TITLE
FIRST FLOOR PLUMBING PLAN

PROJECT NUMBER: 23.161

SHEET NUMBER:

P101

GENERAL PLUMBING NOTES

1. REFER TO GENERAL NOTES ON MEP COVER SHEET FOR ADDITIONAL REQUIREMENTS OF WORK.
2. REFER TO PLUMBING FIXTURE / DRAIN SCHEDULES FOR PIPING SIZES FOR INDIVIDUAL CONNECTIONS TO FIXTURES AND RISERS NOT SHOWN ON PLANS.
3. NO SANITARY OR VENT PIPING BELOW GRADE SHALL BE LESS THAN 2".
4. NO DOMESTIC WATER PIPING SHALL BE SMALLER THAN 3/4" UNLESS NOTED OTHERWISE.
5. ALL VENT PIPING SHOWN IS DIAGRAMMATIC. USE APPROPRIATE FITTINGS FOR VENT PIPING BELOW FLOOD RIM OF FIXTURE.
6. NOT ALL CLEANOUTS ARE SHOWN FOR DRAWING CLARITY. CONTRACTOR SHALL INSTALL ALL CODE-REQUIRED CLEANOUTS (RE: GENERAL NOTES ON COVER SHEET). COORDINATE EXACT LOCATIONS OF CLEANOUTS WITH ARCHITECT.
7. PROVIDE 1/2" TRAP PRIMER PIPING FOR ALL FLOOR DRAINS TO NEAREST TRAP PRIMER VALVE. PIPING SHALL BE TYPE "K" SOFT COPPER SEAMLESS WITH NO JOINTS FROM VALVE TO DRAIN.

PLUMBING PLAN KEYED NOTES

1. 3/4" DCW PIPE UP AND DOWN SERVING PUBLIC BATHROOM FIXTURES ON ALL THREE FLOORS.
2. 3/4" DHW AND DHWR PIPES UP AND DOWN. PIPES ARE CONNECTED ON THE THIRD FLOOR TO CREATE DHW LOOP.
3. SINK DHW, DCW, AND SANITARY PIPING SERVED FROM BELOW. ENSURE DHW, DCW, AND SANITARY PIPING ARE NOT ROUTED IN EXTERIOR WALL.
4. 1/2" DCW AND 2" SANITARY DOWN.
5. 1/2" DCW AND 2" SANITARY UP TO SERVE DRINKING FOUNTAIN.

SECOND FLOOR PLUMBING PLAN - CONT.

1/8" = 1'-0"

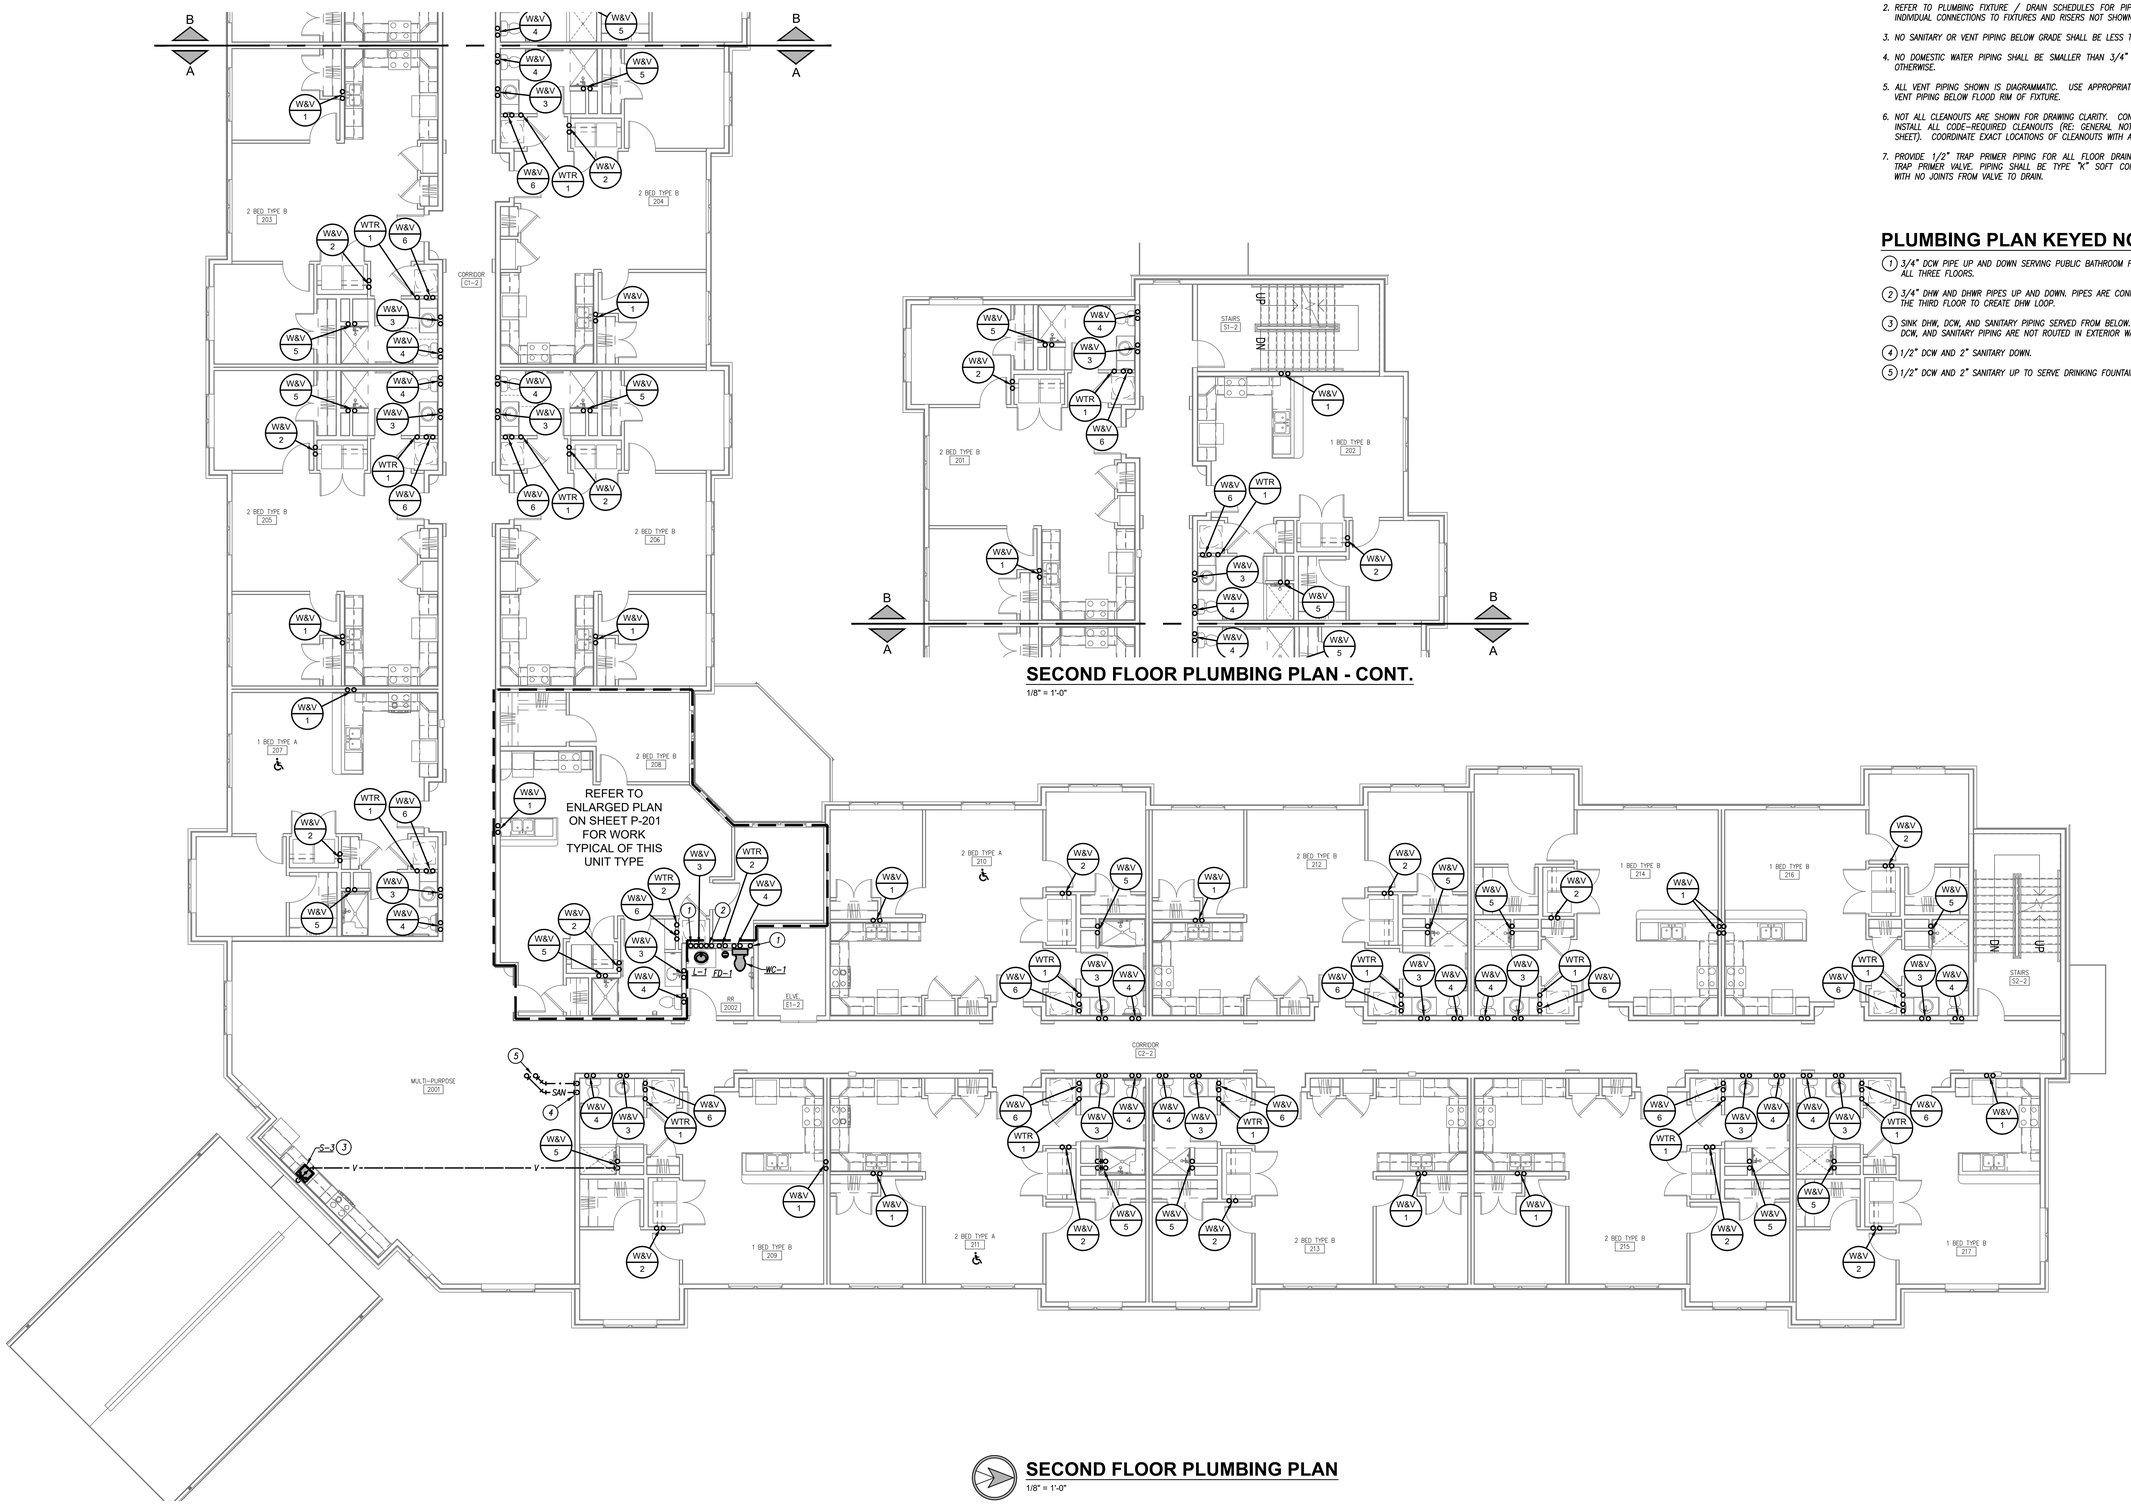

SECOND FLOOR PLUMBING PLAN

1/8" = 1'-0"

PRINTS ISSUED
10/30/2023 - PERMIT SUBMITTAL

REVISIONS:

23.161

pkmr ENGINEERS
PEARSON KENT MCKINLEY RAAF ENGINEERS LLC
13300 W 98TH STREET LENEXA, KS 66215
913.492.2400 WWW.PKMRENG.COM
MO State Certificate of Authority #E-2002020886

STATE OF MISSOURI
MICHAEL D RAAF
NUMBER PE-2005028097
REGISTERED PROFESSIONAL ENGINEER
10/30/23
Michael D. Raaf - Engineer
MO# PE-2005028097

WILSHIRE HILLS III

LEE'S SUMMIT, MISSOURI

SHEET TITLE
SECOND FLOOR PLUMBING PLAN

PROJECT NUMBER: 23.161

SHEET NUMBER:

P102

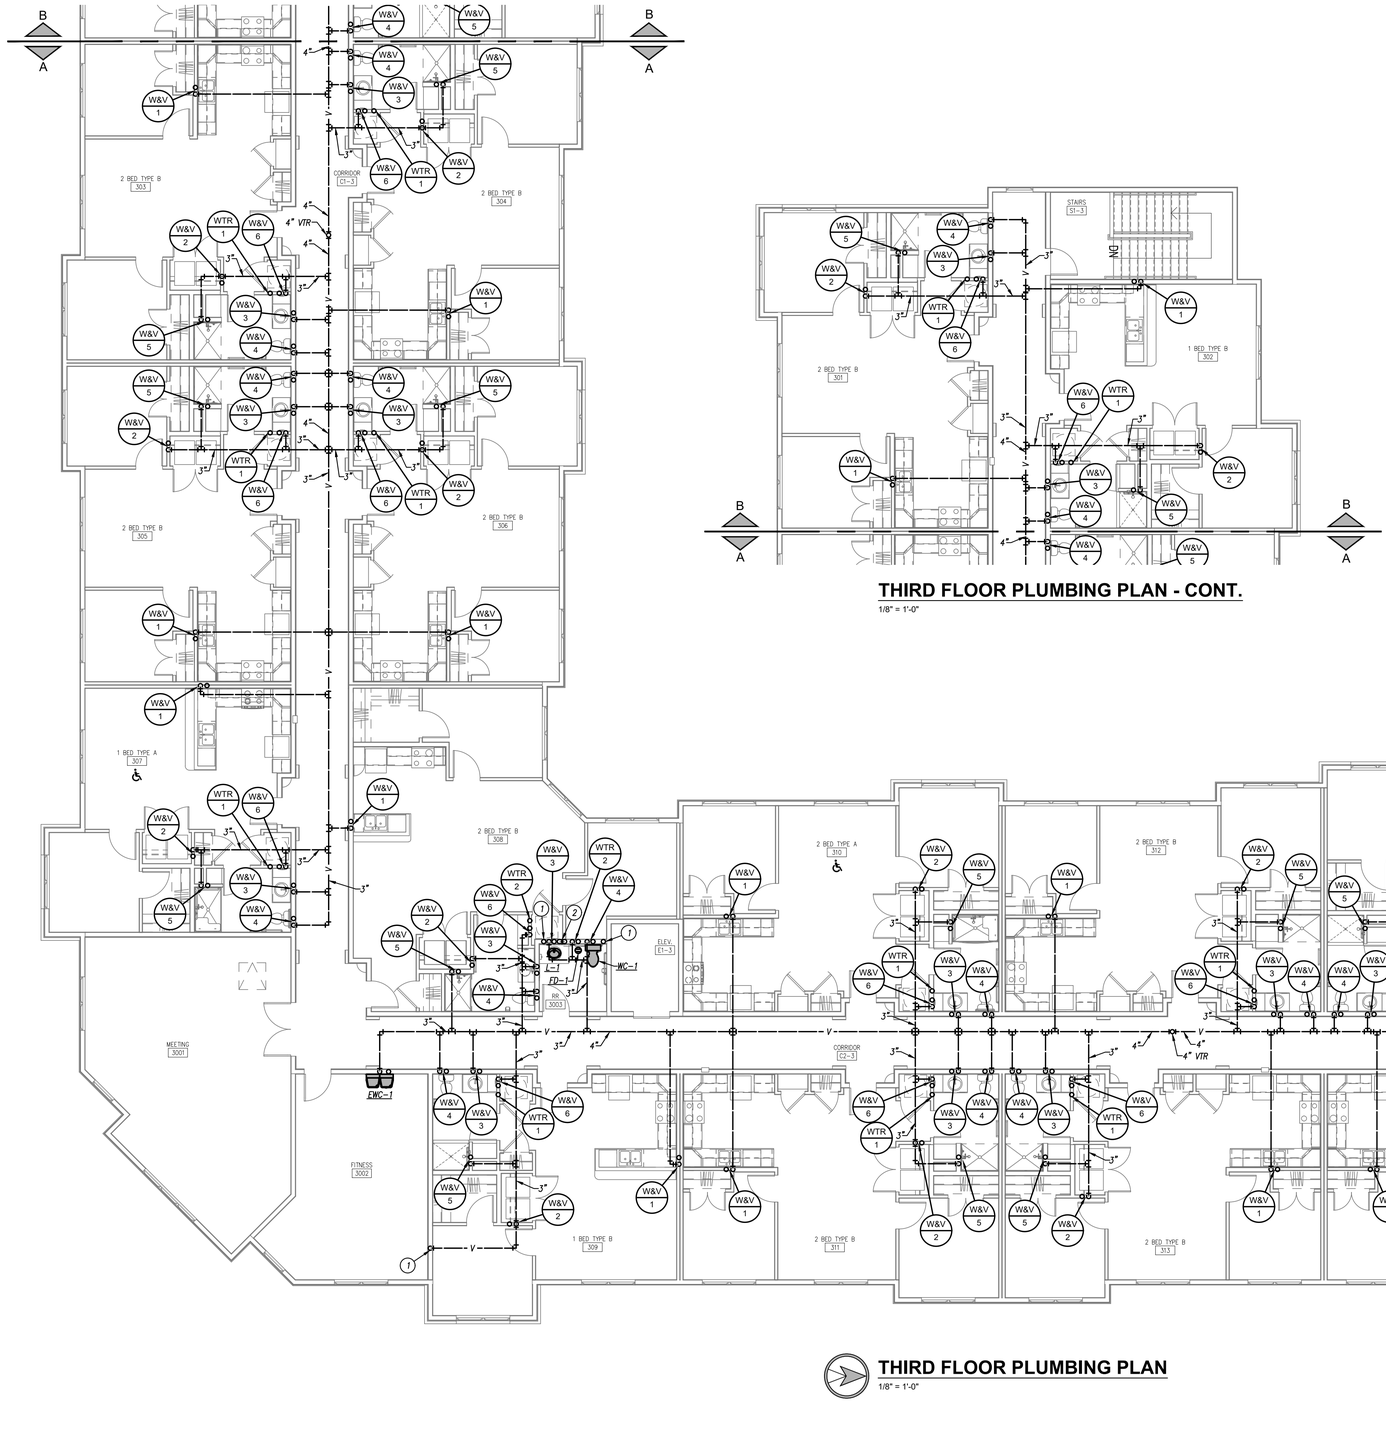

THIRD FLOOR PLUMBING PLAN - CONT.

1/8" = 1'-0"

THIRD FLOOR PLUMBING PLAN

1/8" = 1'-0"

GENERAL PLUMBING NOTES

1. *REFER TO GENERAL NOTES ON MEP COVER SHEET FOR ADDITIONAL REQUIREMENTS OF WORK.*
2. *REFER TO PLUMBING FIXTURE / DRAIN SCHEDULES FOR PIPING SIZES FOR INDIVIDUAL CONNECTIONS TO FIXTURES AND RISERS NOT SHOWN ON PLANS.*
3. *NO SANITARY OR VENT PIPING BELOW GRADE SHALL BE LESS THAN 2".*
4. *NO DOMESTIC WATER PIPING SHALL BE SMALLER THAN 3/4" UNLESS NOTED OTHERWISE.*
5. *ALL VENT PIPING SHOWN IS DIAGRAMMATIC. USE APPROPRIATE FITTINGS FOR VENT PIPING BELOW FLOOD RIM OF FIXTURE.*
6. *NOT ALL CLEANOUTS ARE SHOWN FOR DRAWING CLARITY. CONTRACTOR SHALL INSTALL ALL CODE-REQUIRED CLEANOUTS (RE: GENERAL NOTES ON COVER SHEET). COORDINATE EXACT LOCATIONS OF CLEANOUTS WITH ARCHITECT.*
7. *PROVIDE 1/2" TRAP PRIMER PIPING FOR ALL FLOOR DRAINS TO NEAREST TRAP PRIMER VALVE. PIPING SHALL BE TYPE "K" SOFT COPPER SEAMLESS WITH NO JOINTS FROM VALVE TO DRAIN.*

PLUMBING PLAN KEYED NOTES

1. *3/4" DCW PIPE DOWN SERVING PUBLIC BATHROOM FIXTURES ON ALL THREE FLOORS.*
2. *3/4" DHW AND DHWR PIPES DOWN, CONNECTED AT THE TOP TO CREATE DHW LOOP.*

PRINTS ISSUED
10/30/2023 - PERMIT SUBMITTAL

REVISIONS:

23.161

pkmr ENGINEERS
PEARSON KENT MCKINLEY RAAF ENGINEERS LLC
13300 W 98TH STREET LENEXA, KS 66215
913.492.2400 WWW.PKMRENG.COM
MO State Certificate of Authority #E-2002020886

STATE OF MISSOURI
MICHAEL D RAAF
NUMBER PE-2005028097
REGISTERED PROFESSIONAL ENGINEER
10/30/23
Michael D. Raaf - Engineer
MO# PE-2005028097

WILSHIRE HILLS III

LEE'S SUMMIT, MISSOURI

SHEET TITLE
THIRD FLOOR PLUMBING PLAN

PROJECT NUMBER: 23.161

SHEET NUMBER:

P103

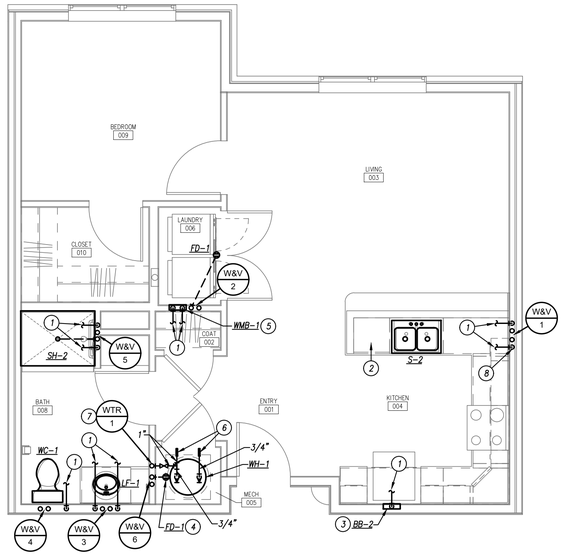

TYPE B - ONE BEDROOM
TYPICAL UNIT FLOOR PLAN - PLUMBING
1/4" = 1'-0"

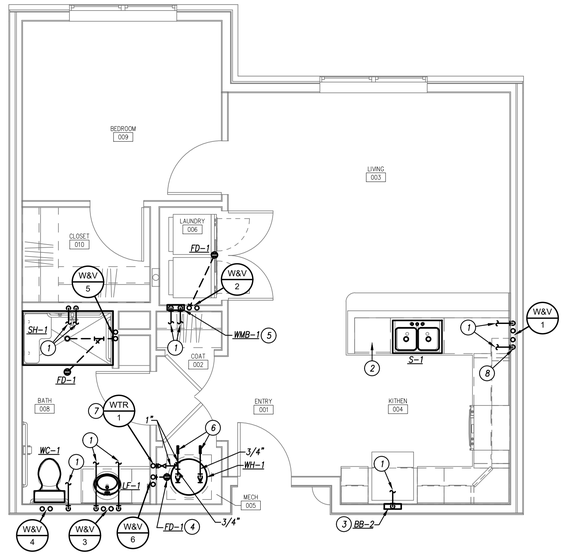

TYPE A - ONE BEDROOM
TYPICAL UNIT FLOOR PLAN - PLUMBING
1/4" = 1'-0"

GENERAL PLUMBING NOTES

1. *REFER TO GENERAL NOTES ON MEP COVER SHEET FOR ADDITIONAL REQUIREMENTS OF WORK.*
2. *REFER TO PLUMBING FIXTURE / DRAIN SCHEDULES FOR PIPING SIZES FOR INDIVIDUAL CONNECTIONS TO FIXTURES AND RISERS NOT SHOWN ON PLANS.*
3. *NO SANITARY OR VENT PIPING BELOW GRADE SHALL BE LESS THAN 2".*
4. *NO DOMESTIC WATER PIPING SHALL BE SMALLER THAN 3/4" UNLESS NOTED OTHERWISE.*
5. *ALL VENT PIPING SHOWN IS DIAGRAMMATIC. USE APPROPRIATE FITTINGS FOR VENT PIPING BELOW FLOOD RIM OF FIXTURE.*
6. *NOT ALL CLEANOUTS ARE SHOWN FOR DRAWING CLARITY. CONTRACTOR SHALL INSTALL ALL CODE-REQUIRED CLEANOUTS (RE: GENERAL NOTES ON COVER SHEET). COORDINATE EXACT LOCATIONS OF CLEANOUTS WITH ARCHITECT.*
7. *PROVIDE 1/2" TRAP PRIMER PIPING FOR ALL FLOOR DRAINS TO NEAREST TRAP PRIMER VALVE. PIPING SHALL BE TYPE "K" SOFT COPPER SEAMLESS WITH NO JOINTS FROM VALVE TO DRAIN.*

PLUMBING PLAN KEYED NOTES

1. *1/2" DOMESTIC WATER PEX LINE BACK TO PEX HEADER.*
2. *ROUTE 1/2" DHW CONNECTION FROM SINK TO STOP VALVE FOR DISHWASHER. CONNECT DISHWASHER TO SINK WASTE WITH FLEX HOSE. REFER TO DETAIL.*
3. *1/2" DCW CONNECTION TO STOP VALVE FOR ICEMAKER. PROVIDE FIRE RATED BACK BOXES IN FIRE RATED WALLS. REFER TO ARCHITECTURAL PLANS.*
4. *EXTEND 3/4" AIR HANDLER CONDENSATE DRAIN LINE AND WATER HEATER T&P TO 2" FLOOR DRAIN.*
5. *WASHING MACHINE SHALL ALWAYS BE LOCATED TO THE LEFT OF THE DRYER.*
6. *PROVIDE PEX MANIFOLD FOR 1" DCW LINE AND 3/4" DHW LINE. ROUTE 1/2" DCW PEX LINE TO EACH PLUMBING FIXTURE. ROUTE 1/2" DHW PEX LINE TO SINK, LAVATORY, WASHER BOX, AND SHOWER.*
7. *PROVIDE SHUTOFF VALVE AND ACCESS PANEL. PROVIDE MJ20 WATER SUB-METER WITH REMOTE READING CAPABILITY AFTER SHUT-OFF VALVE. REFER TO BUILDING PLAN FOR LOCATION OF REMOTE READERS.*
8. *ROUTE DHW, DCW, WASTE, AND VENT PIPING DOWN IN WALL, THEN THROUGH CABINETRY TO CONNECT TO SINK AND DISHWASHER.*

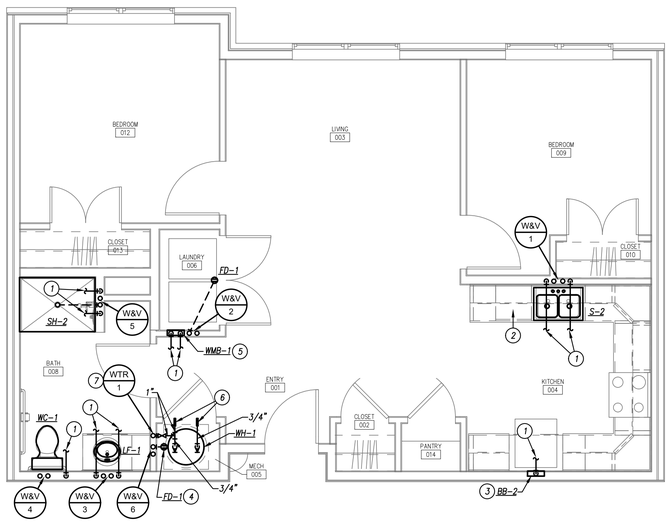

TYPE B - TWO BEDROOM
TYPICAL UNIT FLOOR PLAN - PLUMBING
1/4" = 1'-0"

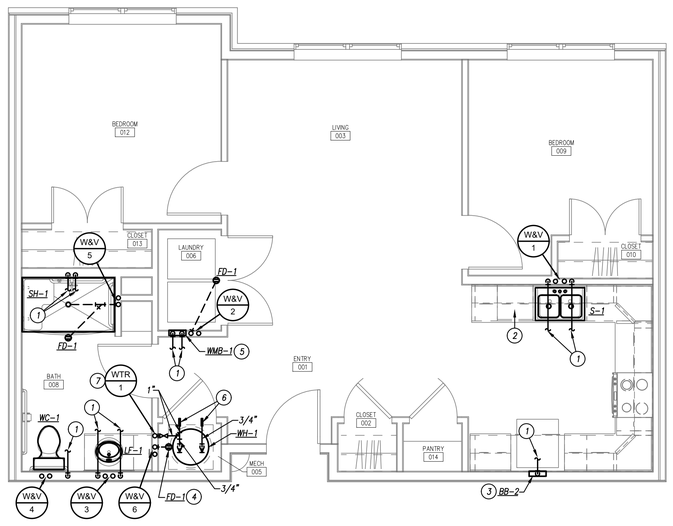

TYPE A - TWO BEDROOM
TYPICAL UNIT FLOOR PLAN - PLUMBING
1/4" = 1'-0"

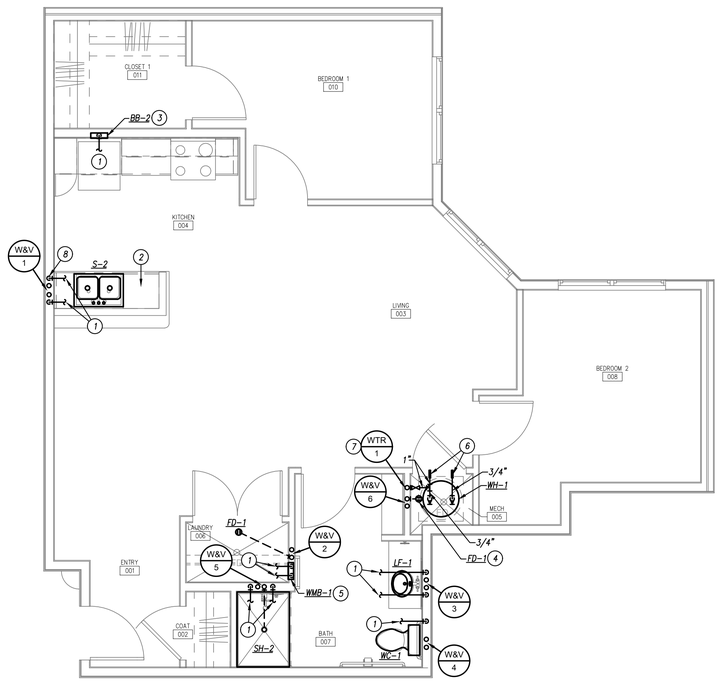

TYPE B - TWO BEDROOM - (CORNER)
TYPICAL UNIT FLOOR PLAN - PLUMBING
1/4" = 1'-0"

PRINTS ISSUED
10/30/2023 - PERMIT SUBMITTAL

REVISIONS:

pkmr ENGINEERS
PEARSON KENT MCKINLEY RAAF ENGINEERS LLC
13300 W 98TH STREET LENEXA, KS 66215
913.492.2400 WWW.PKMRENG.COM
MO State Certificate of Authority #E-2002020886

23.161

STATE OF MISSOURI
MICHAEL D RAAF
NUMBER PE-2005028097
REGISTERED PROFESSIONAL ENGINEER
10/30/23
Michael D. Raaf - Engineer
MO# PE-2005028097

WILSHIRE HILLS III

LEE'S SUMMIT, MISSOURI

SHEET TITLE
ENLARGED UNIT PLANS - PLUMBING

PROJECT NUMBER: 23.161

SHEET NUMBER:

P201

PIPING MATERIAL SCHEDULE

PIPING SYSTEM	SIZE	TYPE/SCHED	MATERIAL	ACCEPTABLE FITTINGS	FIELD TEST PRESSURE/TIME	ALLOWABLE IN PLENUMS	INSULATION TYPE	INSULATION THICKNESS
DOMESTIC COLD WATER	1/2"-2-1/2"	L	COPPER	SOLDER, PRO-PRESS	130 PSI - 1/2HR	YES	FIBERGLASS W/ ASJ	1/2"
DOMESTIC COLD WATER	1-1/4" - 2"	SDR-11 (CTS)	CPVC	SOLVENT JOINED	131 PSI - 1/2HR	YES	--	--
DOMESTIC COLD WATER	1/2" - 2"	PEX-a OR b	PEX	PRO-PRESS / COLD EXPANSION - BRASS OR POLY	130 PSI - 1/2HR	YES	ELASTOMERIC	1/2"
DOMESTIC HOT WATER & HW RETURN	1/2" - 2"	PEX-a OR b	PEX	PRO-PRESS / COLD EXPANSION - BRASS OR POLY	130 PSI - 1/2HR	YES	ELASTOMERIC	1"
DOMESTIC COLD WATER	2-1/2"-6"	L	COPPER	SOLDER, PRO-PRESS	130 PSI - 1/2HR	YES	FIBERGLASS W/ ASJ	1/2"
DOM. HOT & COLD BELOW GRADE	1/2"-2"	PEX-a OR PEX-b	PEX	PRO-PRESS / COLD EXPANSION - BRASS OR POLY	130 PSI - 1/2HR	YES	ELASTOMERIC	3/4" (HOT ONLY)
SOIL & WASTE ABOVE GRADE	1-1/2"-6"	NO HUB / SERVICE WT.	CAST IRON	NO HUB	10 FT - 1/2HR	YES	--	--
SOIL & WASTE ABOVE GRADE	2"-8"	SCH. 40	PVC	SOLVENT JOINED	10 FT - 1/2HR	NO	--	--
SOIL & WASTE BELOW GRADE	2"-8"	SCH. 40	PVC	SOLVENT JOINED	10 FT - 1/2HR	NO	--	--
FIRE SERVICE BELOW GRADE	4"-8"	AWWA C151	DUCTILE IRON	AWWA C111, MECH JOINTS	130 PSI - 1/2HR	YES	--	--
DOM. WATER SERVICE BELOW GRADE	1"-3"	K	COPPER	CONTINUOUS TUBING, BRAZED	130 PSI - 1/2HR	YES	--	--
CONDENSATE DRAIN INTERIOR	3/4"-2"	SCH. 40	CPVC	SOLVENT JOINED	10 FT - 1/2HR	YES	FIBERGLASS W/ ASJ	1/2" (PLENUM ONLY)

NOTES
1. ALL PIPING AND MATERIALS IN PLENUMS MUST MEET ASTM E84 FLAME/SMOKE RATING OF 25/50.
2. ALL INSULATION THICKNESSES SHALL MEET ASHRAE 90.1 - 2007 REQUIREMENTS AT A MINIMUM.
3. REFER TO SPECIFICATIONS FOR MORE DETAILED INFORMATION.

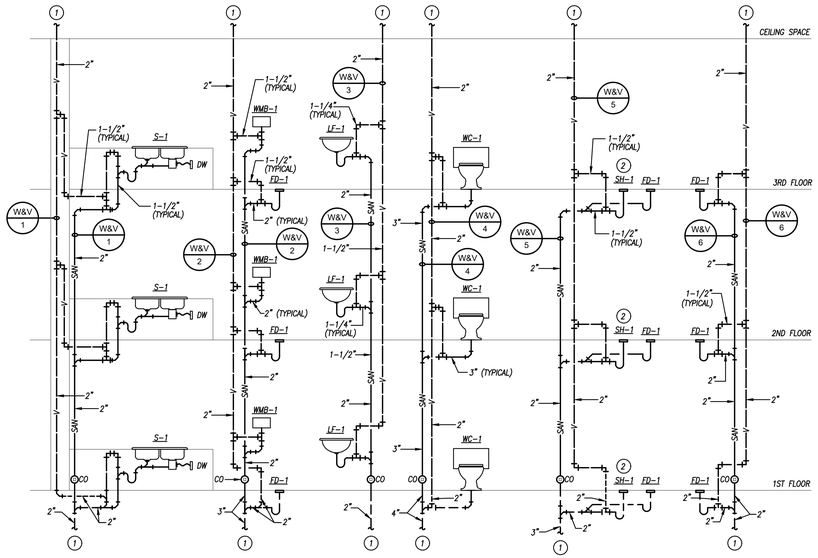

SANITARY & VENT RISER DIAGRAMS

NOT TO SCALE

RISER GENERAL NOTES:
1. PLUMBING RISER IS DIAGRAMMATIC - REFER TO THE FLOOR PLAN TO COORDINATE EXACT ROUTING OF PLUMBING SERVICES.
2. REFER TO PLUMBING FIXTURE SCHEDULE FOR INDIVIDUAL CONNECTION SIZES AND TRAP REQUIREMENTS.
3. PROVIDE TRAP SEALS FOR ALL FLOOR DRAINS.

RISER KEYED NOTES

1. REFER TO OVER ALL PLANS FOR CONTINUATION.
2. NOT ALL ROOMS HAVE SHOWER AND FLOOR DRAIN ON SAME STACK. REFER TO PLAN LAYOUT EXACT LAYOUT.

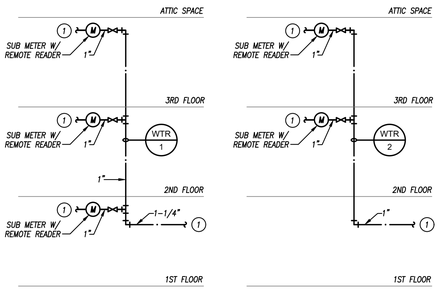

COLD WATER RISER DIAGRAMS

NOT TO SCALE

PLUMBING FIXTURE SCHEDULE

MARK	FIXTURE MODEL	FIXTURE DESCRIPTION	FITTINGS AND TRIM: FITTINGS MODEL	FITTINGS AND TRIM: FITTINGS AND DESCRIPTION	REMARKS	PLUMBING FIXTURE PIPE SIZES: WASTE	VENT	DCW	DHW
WC-1	BRIGGS 4834	ADA-COMPLIANT, 1.28 GPF, FLUSH TANK WATER CLOSET. WHITE VITREOUS CHINA ELONGATED BOWL AND TANK. 17" HIGH. TWO PIECE, 12" ROUGH-IN. FURNISH WITH FLUSH ACTUATOR ON WIDE SIDE OF STALL.	CHURCH 7200SLEC	WHITE, SOLID PLASTIC, CLOSED-FRONT SEAT FOR ELONGATED BOWL. INTEGRAL BUMPERS. EASY CLOSE, NON-CORROSIVE BOLTS AND WING NUTS.	3,6	4"	2"	1/2"	---
LF-1	CFG CA40712 (COMMUNITY/UNIT)	LAVATORY FAUCET: SINGLE HANDLE CAST BRASS MIXING FAUCET, 4" CENTERS, 4-3/4" SPOUT, 1.5GPM VANDAL PROOF AERATOR, 4-5/8" METAL LEVER HANDLE. CERAMIC VOLUME CONTROL & HOT WATER LIMIT STOP CARTRIDGE. WITH POP UP. CHROME. 1.2 GPM MAX			1,2,7	2"	2"	1/2"	1/2"
S-1	DAYTON GE23322 (UNIT) IN-SINK-ERATOR BADGER 5	ADA DOUBLE COMPARTMENT SINK. SEAMLESS #22 GAUGE, TYPE 300 SERIES STAINLESS STEEL. SATIN FINISH, BOTTOM ONLY UNDERCOATED, 5.375" BOWL DEPTH. 1-3/4" RADIUS COVED CORNERS. SELF RIMMING. 3 HOLE CONFIGURATION 4" ON CTR. GARBAGE DISPOSAL. 1/2 HP MOTOR, STAINLESS STEEL GALVANIZED STEEL CONSTRUCTION AND GRINDING ELEMENTS, PERMANENTLY LUBRICATED BEARINGS. PROVIDE WITH STAINLESS STEEL SINK FLANGE AND STOPPER.	CFG/MOEN CA40512	SINGLE HANDLE KITCHEN SINK FAUCET. 1.5 GPM AERATOR, CHROME FINISH. PROVIDE WITH OFFSET DRAIN.	2,3,5,8	2"	2"	1/2"	1/2"
S-2	DAYTON K23322 (UNIT) IN-SINK-ERATOR BADGER 5	DOUBLE COMPARTMENT SINK. SEAMLESS #20 GAUGE, TYPE 300 SERIES STAINLESS STEEL. SATIN FINISH, BOTTOM ONLY UNDERCOATED, HOLES AT 4" O.C. 6" BOWL DEPTH. 1-3/4" RADIUS COVED CORNERS. SELF RIMMING. 3 HOLE CONFIGURATION 4" ON CTR. GARBAGE DISPOSAL. 1/2 HP MOTOR, STAINLESS STEEL GALVANIZED STEEL CONSTRUCTION AND GRINDING ELEMENTS, PERMANENTLY LUBRICATED BEARINGS. PROVIDE WITH STAINLESS STEEL SINK FLANGE AND STOPPER.	CFG/MOEN CA40512	SINGLE HANDLE KITCHEN SINK FAUCET. 1.5 GPM AERATOR, CHROME FINISH.	2,3,5,8	2"	2"	1/2"	1/2"
S-3	DAYTON D12522 (COMMUNITY KITCHEN SINK) IN-SINK-ERATOR BADGER 5	ADA-COMPLIANT SINGLE COMPARTMENT SINK. OFFSET DRAIN, SEAMLESS HEAVY GAUGE, NICKEL BEARING STAINLESS STEEL, BOWL DEPTH 6-9/16", COVED CORNERS RAISED FAUCET DECK, UNDERSIDE FULLY SOUND DEADEND, SELF RIMMING, 3-1/2" DRAIN OPENING, HOLES AT 4" O.C. OTHERWISE NOTED SINK FURNISHEDW/ (3) FAUCET HOLES. GARBAGE DISPOSAL. 1/2 HP MOTOR, STAINLESS STEEL GALVANIZED STEEL CONSTRUCTION AND GRINDING ELEMENTS, PERMANENTLY LUBRICATED BEARINGS. PROVIDE WITH STAINLESS STEEL SINK FLANGE AND STOPPER.	MOEN CAMERIST 7545	SINGLE HANDLE KITCHEN SINK FAUCET WITH. PROVIDE ESCUTCHEON PLATE, 1.5 GPM AERATOR, CLASSIIC STAINLESS FINISH. PROVIDE WITH OFFSET DRAIN.	2,3,5,8	2"	2"	1/2"	1/2"
SH-1	AQUATIC 1603 BFSD	ADA COMPLIANT GELCOAT SHOWER WITH SEAT AND L-SHAPED GRAB BAR. 60"W x 34"D x 75.625"H INSIDE DIMENSIONS. GRAB BARS, CURTAIN ROD, L-SHPAED FOLD-UP CUSHIONED SEAT. FITTINGS TO REMAIN AS SHOWN ON PLANS. PROVIDE IN WHITE WITH TILE LOOK.	CFG 403116C-SHOWER ONLY TRIM CFG 45320 CFG 40124 CHROME	ADA COMPLIANT SHOWER VALVE: PRESSURE BALANCE SHOWER VALVE, CERAMIC DISC VALVE CARTRIDGE WITH AN ADJUSTABLE HOT LIMIT SAFETY STOP, LOW LEAD FORGED BRASS BODY, ALL METAL LEVER HANDLE AND WALL ESCUTCHEON. 32" SLIDE BAR, PERSONAL HAND SHOWER, 59" LONG SHOWERHOSE, WALL SUPPLY, AND 1/2" NPT IN-LINE VACUUM BREAKER. 2.0 GPM.	---	1-1/2"	1-1/2"	1/2"	1/2"
SH-2	AQUATIC 1483TSTH	SHOWER WITH VERTICAL GRAB BAR. 48"W x 34.25"D x 73"H INSIDE DIMENSIONS. FACTORY INSTALLED GRAB BARS AND SEAT. PROVIDE WITH 18" GRAB BAR MOUNTED ON BACK WALL HORIZONTALLY. CURTAIN ROD. FITTINGS TO REMAN AS SHOWN ON PLANS. PROVIDE IN WHITE WITH TILE LOOK. PROVIDE THRESHOLD.	CFG 403115C-SHOWER ONLY TRIM CFG 45320	SHOWER VALVE : PRESSURE BALANCE SHOWER VALVE WITH ROTATING LEVER, METAL ESCUTCHEON,. 2.0 GPM.	---	1-1/2"	1-1/2"	1/2"	1/2"
EWC-1	HALSEY-TAYLOR HTHB-HAC8BLWF	ADA-COMPLIANT, DUAL-HEIGHT, BARRIER-FREE, ELECTRIC WATER COOLER. PROVIDES 8.0 GPM OF 50°F WATER AT 90°F AMBIENT. ADA-COMPLIANT FRONT AND SIDE PUSHBARS. LEAD FREE. INTEGRAL FILTER. MOUNT WITH MIN. 27" KNEE CLEARANCE AND SPOUT AT NO MORE THAN 36" A.F.F.	HALSEY-TAYLOR HTHB-HAC8BLWF	BOTTLE FILLER SHALL INCLUDE ELECTRONIC SENSOR FOR NO-TOUCH ACTIVATION WITH AUTOMATIC 20-SECOND SHUT-OFF. SHALL PROVIDE 1.1 GPM LAMINAR FLOW. ANTI-MICROBIAL PROTECTED PLASTIC COMPONENTS.	4	2"	2"	1/2"	
BB-1	OATEY 12K	ICE MAKER BACK BOX. PROVIDE WITH STOP VALVE.	---	---	---	---	---	1/2"	---
BB-2	OATEY 38486	FIRE RATED ICE MAKER BACK BOX. PROVIDE WITH STOP VALVE.	---	---	---	---	---	1/2"	---
WMB-1	OATEY 38530	WASHING MACHINE SUPPLY AND DRAIN BACK BOX. PROVIDE WITH DRAIN AND DRAIN FITTINGS.	---	---	---	---	2"	1/2"	1/2"
WMB-2	OATEY 38470	FIRE RATED WASHING MACHINE SUPPLY AND DRAIN BACK BOX. PROVIDE WITH DRAIN AND DRAIN FITTINGS.	---	---	---	---	2"	1/2"	1/2"
HB-1	ZURN Z1310	EXPOSED, AUTOMATIC DRAINING, NON-FREEZE, ANIT-SIPHON WALL HYDRANT COMPLETE WITH INTEGRAL BACKFLOW PREVENTER. BRASS CASING, ALL-BRONZE INTERIOR PARTS. NON-TURNING OPERATING ROD WITH FREE-FLOATING COMPRESSION CLOSURE VALVE. REPLACEABLE BRONZE SEAT AND SEAT WASHER. COMBINATION 3/4" FEMALE AND 1" MALE IP INLET CONNECTION STANDARD. INCLUDES OPERATING KEY.	---	---	---	---	---	---	3/4"	---
JS-1	FIAT TSB-100	JANITORS SINK: 24"x24"x12" PRECAST TERRAZO FLOOR SERVICE SINK. STAINLESS STEEL CAP AND 2 SIDE WALL TILING FLANGE. 3" STAINLESS STEEL CAST DRAIN AND STAINLESS STEEL STRAINER PLATE. PROVIDE STAINLESS STEEL WALL GUARDS, MOP BRACKETS, HOSE RACK.	CHICAGO FAUCET 897-CP	C.P. SERVICE SINK FITTING WITH VACUUM BREAKER, 3/4" HOSE THREAD ON SPOUT, ADJUSTABLE WALL BRACE, PAIL HOOK, AND 1/2" FLANGED FEMALE ADJUSTABLE ARMS WITH INTEGRAL STOPS. CAULK BETWEEN WALL AND FLANGE WITH GE SILICONE SEALANT. 3" C.I. "P" TRAP.	---	3"	2"	1/2"	1/2"

REMARKS:
1. PROVIDE CHROME-PLATED BRASS TAILPIECE AND GRID DRAIN.
2. PROVIDE CHROME-PLATED BRASS P-TRAP.
3. PROVIDE LOOSE KEY STOPS AND FLEXIBLE RISERS.
4. PROVIDE CONCEALED ARM TYPE CARRIER WITH SQUARE, TUBULAR STEEL UP-RIGHTS AND BLOCK TYPE BASES.
5. INSULATE EXPOSED TAILPIECE, P-TRAP, AND WATER RISERS. REFER TO SPECIFICATIONS FOR INSULATION METHODS.
6. PROVIDE FLUSH VALVE HANDLE ON WIDE SIDE OF STALL.
7. PROVIDE HANDLE STOPS AND FLEXIBLE RISERS.
8. PROVIDE CHROME-PLATED BRASS TAILPIECE AND BASKET STRAINER.

GENERAL NOTES (APPLICABLE TO ALL FIXTURES):
1) ALL PUBLIC LAVATORIES AND SINKS SHALL BE PROVIDED WITH ANTI-SCALD ASSE 1016 LISTED VALVE ON HOT WATER SUPPLY.

FLOOR DRAIN SCHEDULE

PLAN MARK	MANUFACTURER	MODEL NUMBER	SERVICE	TOP/GRATE SIZE	WASTE SIZE	REMARKS
FD-1	WADE	1100	FLOOR DRAIN	6"Ø	2"	1
FD-2	WADE	2340	FLOOR DRAIN	12"x12"	4"	1

REMARKS:
1. PROVIDE WITH NICKEL BRONZE TOP AND TRAP SEAL.

SUMP PUMP SCHEDULE

PLAN MARK	MANUFACTURER	MODEL NUMBER	GPM	HEAD (FT. WC)	HP	MAX. RPM	ELECTRICAL	DUTY	NOTES
SP-1	WEIL	1411	50.0	20.0	1/2	1,750	120V / 1 PH	ELEVATOR SUMP (HYDRO)	1,2,3,4

REMARKS:
1. PUMP SHALL BE PROVIDE WITH ACCESSORY OIL SENSORS/CONTROLLER CAPABLE OF SENSING OIL, DISABLING OPERATION UPON SENSING AND GENERATING AN ALARM.
2. PROVIDE CONTROL/ALARM PANEL WITH TETHERED LEVEL SWITCH CONTROL AND REMOTE ALARM LIGHT.
3. PROVIDE SPLIT DESIGN FLOOR PLATE AND 24"DIA. X 30" DEEP FIBERGLASS BASIN.
4. COORDINATE ANY REQUIRED AREA DRAIN OR SUBSOIL CONNECTIONS TO BASIN. EXTEND DEPTH OF BASIN AS REQD.

PLUMBING FIXTURE BRANCH CONNECTION SCHEDULE

FIXTURE TYPE	TRAP	PLUMBING FIXTURE PIPE SIZES: WASTE	VENT	DCW	DHW
WATER CLOSET (FLUSH VALVE)	INTEGRAL	4"	2"	1"	---
URINAL (FLUSH VALVE)	INTEGRAL	2"	2"	3/4"	---
FLUSH TANK WATER CLOSET	INTEGRAL	4"	2"	1/2"	---
LAVATORY	PROVIDE TRAP	2"	1-1/2"	1/2"	1/2"
SINK	PROVIDE TRAP	4"	2"	1/2"	1/2"
MOP SINK	PROVIDE DEEP SEAL TRAP	3"	2"	1/2"	1/2"
FLOOR DRAIN	PROVIDE DEEP SEAL TRAP	AS SCHEDULED	1-1/2"	---	---
FLOOR SINK	PROVIDE TRAP	AS SCHEDULED	1-1/2"	---	---
DRINKING FOUNTAINS/EWC'S	PROVIDE TRAP	1-1/2"	1-1/2"	1/2"	---
SHOWERS/TUBS	PROVIDE TRAP	2"	1-1/2"	1/2"	1/2"
SHOWERS	PROVIDE TRAP	2"	1-1/2"	1/2"	1/2"
ICE MACHINE HOOKUP BOX	---	---	---	1/2"	---
WASHER HOOKUP BOXES	PROVIDE TRAP	2"	1-1/2"	1/2"	1/2"

BACKFLOW PREVENTION DEVICE SCHEDULE

FIXTURE TYPE	CONNECTION SIZE	BACKFLOW TYPE	SIMILAR TO	LISTING	REMARKS
DOMESTIC WATER SERVICE	1/2" - 3"	REDUCED PRESSURE ZONE	WATTS LF009 or LF909	ASSE 1013	1
DOMESTIC WATER SERVICE	2-1/2" - 6"	REDUCED PRESSURE ZONE	WATTS LF909	ASSE 1013	1
FIRE SPRINKLER SERVICE	ALL	DOUBLE CHECK	WATTS 709DCDA	ASSE 1014	2,3

REMARKS:
1. LEAD-FREE DEVICE.
2. MAY BE MOUNTED HORIZONTALLY OR VERTICALLY.
3. DETECTOR ASSEMBLY. MODEL WITHOUT DETECTOR MAY BE FURNISHED IF ALLOWED BY LOCAL AHJ.

GENERAL COMMENTS (APPLICABLE TO ALL BACKFLOW DEVICES)
1. ALL BACKFLOW PREVENTERS SHALL BE ON THE LIST OF APPROVED BACKFLOW PREVENTION ASSEMBLIES AS PUBLISHED BY THE USC FOUNDATION FOR CROSS-CONNECTION CONTROL AND HYDRAULIC RESEARCH.
2. ALL BACKFLOW PREVENTERS SHALL BE INSTALLED IN AN ACCESSIBLE LOCATION. RPZS SHALL BE INSTALLED AT A MINIMUM OF 12" A.F.F. AND A MAXIMUM OF 60" A.F.F.
3. VERIFY ALL REQUIREMENTS AND APPROPRIATE DEVICE TYPE FOR BACKFLOW PREVENTION WITH AHJ AND/OR STATE CROSS CONNECTION REQUIREMENTS.

DOMESTIC RECIRCULATION PUMP SCHEDULE

PLAN MARK	MANUFACTURER	MODEL NUMBER	GPM	HEAD (FT. WC)	HP	MAX. RPM	ELECTRICAL	NOTES
RCP-1	BELL & GOSSETT	ECOCIRC 20-18	3.0	15.0	70W	VARI	120V / 1 PH	1,2,3

REMARKS:
1. ENSURE PUMP IS NSF-61 CERTIFIED FOR POTABLE WATER SYSTEMS.
2. MOUNT PUMP AND ACCESSORIES NEAR WATER HEATER AND NO HIGHER THAN 6' AFF.
3. ECM MOTOR WITH INTEGRAL SPEED CONTROL AND TEMPERATURE SWITCH AND DISCONNECT.

WATER HEATER SCHEDULE - ELECTRIC

PLAN MARK	MANUFACTURER	MODEL NUMBER	GALLONS	WATTS	VOLTAGE/ PHASE	REMARKS
WH-1	A.O. SMITH	ENL-40	38.0	4,500	208V / 1PH	1
WH-2	A.O. SMITH	ENL-30	28.0	4,500	208V / 1PH	1,2,3

REMARKS:
1. "LOWBOY"-TYPE WATER HEATER.
2. MOUNT ON WALL.
3. ROUTE DRAIN TO MOP SINK/FLOOR DRAIN.

PRINTS ISSUED
10/30/2023 - PERMIT SUBMITTAL

REVISIONS:

pkmr ENGINEERS
PEARSON KENT MCKINLEY RAAF ENGINEERS LLC
13300 W 98TH STREET LENEXA, KS 66215
913.492.2400 WWW.PKMRENG.COM
MO State Certificate of Authority #E-2002020886

23.161

STATE OF MISSOURI
MICHAEL D RAAF
NUMBER PE-2005028097
REGISTERED PROFESSIONAL ENGINEER
10/30/23
Michael D. Raaf - Engineer
MO# PE-2005028097

WILSHIRE HILLS III
LEE'S SUMMIT, MISSOURI

SHEET TITLE
PLUMBING SCHEDULES

PROJECT NUMBER: 23.161

SHEET NUMBER:

P301

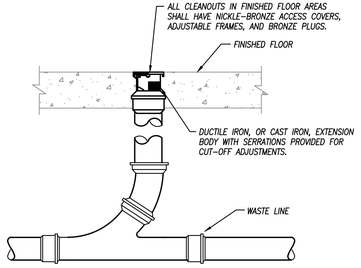

FLOOR CLEANOUT DETAIL

NOT TO SCALE

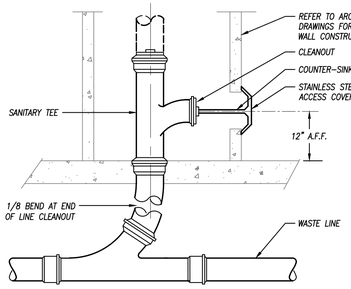

WALL CLEANOUT DETAIL

NOT TO SCALE

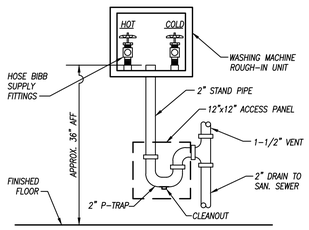

WASHING MACHINE HOOK-UP DETAIL

NOT TO SCALE

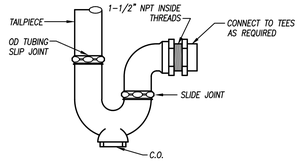

P-TRAP DETAIL

NOT TO SCALE

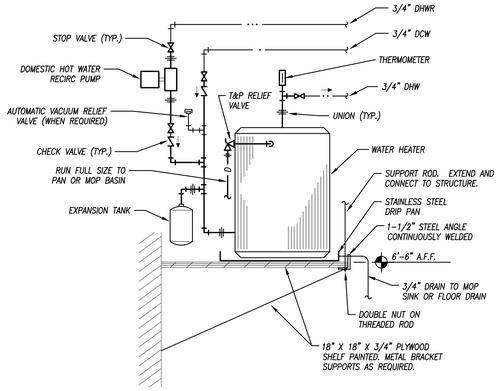

WATER HEATER ON SHELF DETAIL

NOT TO SCALE

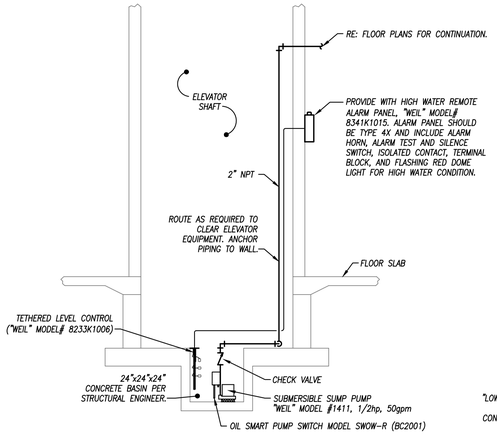

ELEVATOR SUMP PUMP DETAIL

NOT TO SCALE

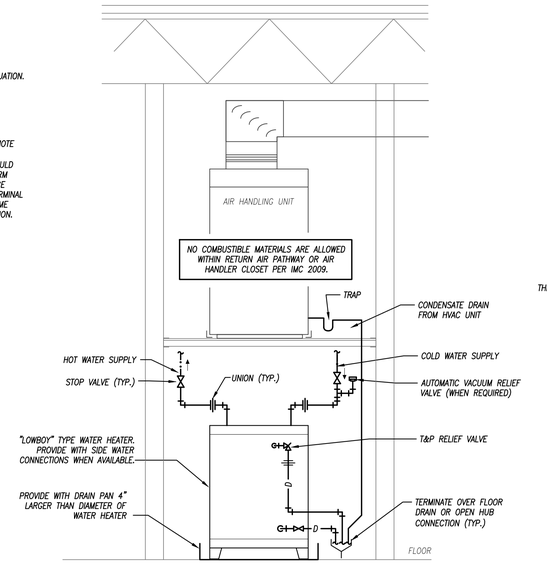

WATER HEATER BELOW FURNACE

NOT TO SCALE

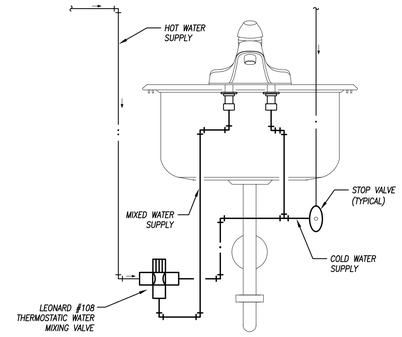

HAND WASHING SINK/LAVATORY TEMPERED WATER SCHEMATIC

NOT TO SCALE

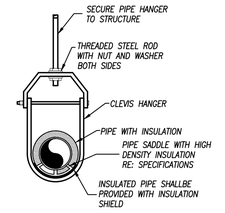

PIPE HANGER DETAIL

NOT TO SCALE

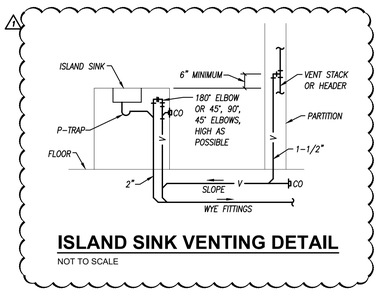

ISLAND SINK VENTING DETAIL

NOT TO SCALE

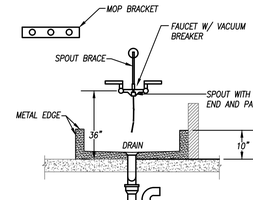

MOP SINK DETAIL

NOT TO SCALE

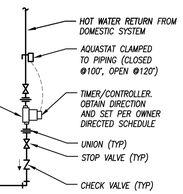

RECIRCULTING PUMP DETAIL

NOT TO SCALE

FIRE SPRINKLER SCOPE

A FULLY ENGINEERED SYSTEM SHALL BE PROVIDED BY THE CONTRACTOR AND SUBMITTED TO PROPER REGULATORY AGENCIES AND DIVISIONS.

PROVIDE AN NFPA 13R SYSTEM THROUGHOUT THE ENTIRE FACILITY. REFER TO ARCHITECTURAL PLANS FOR CEILING CONSTRUCTION.

BACKFLOW PREVENTER MAY BE INSTALLED HORIZONTALLY OR VERTICALLY IF APPROVED BY THE AUTHORITY HAVING JURISDICTION. INSTALLATION MUST ALLOW VALVES TO BE SERVICED WHILE STANDING ON THE FLOOR.

INTERIOR SPACES
PROVIDE WET SPRINKLER SYSTEM IN ALL AREAS WITH DROP CEILINGS AND ALL RESIDENT ROOMS. RESIDENT ROOMS SHALL BE SERVED BY ROUTING MAINS THROUGH HALLWAYS THEN ROUTING LATERALS THROUGH WALLS INTO EACH SPACE. ALL WET PIPING SHALL BE LOCATED IN CONDITIONED SPACES THAT ARE NOT SUBJECT TO FREEZING.

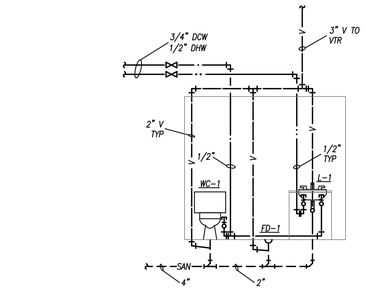

TYPICAL COMMON RESTROOM PLUMBING RISER

NOT TO SCALE

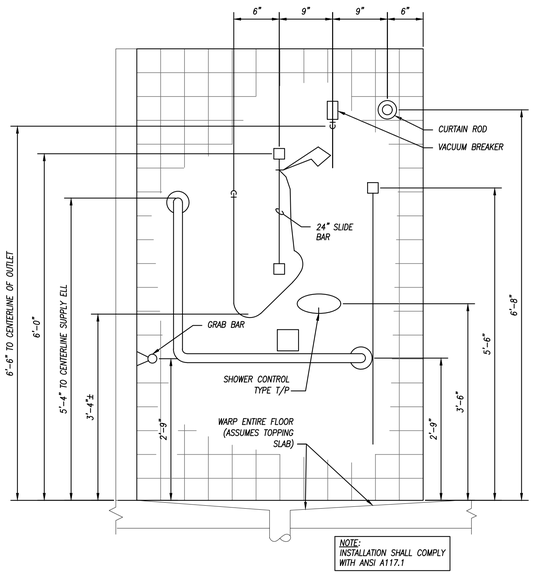

ADA COMPLIANT SHOWER

NOT TO SCALE

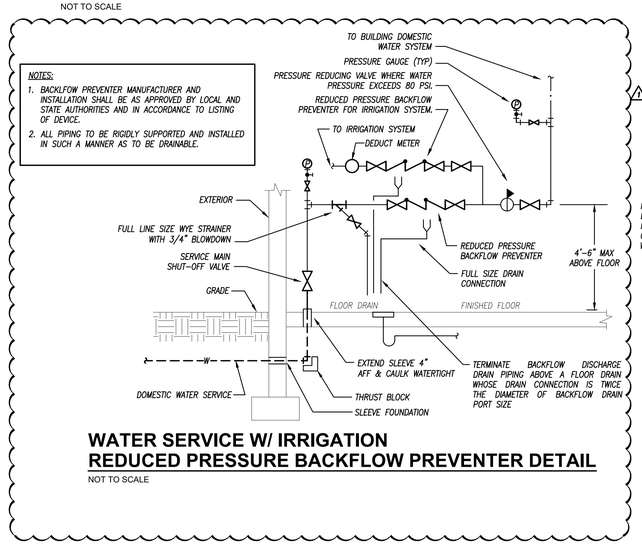

WATER SERVICE W/ IRRIGATION REDUCED PRESSURE BACKFLOW PREVENTER DETAIL

NOT TO SCALE

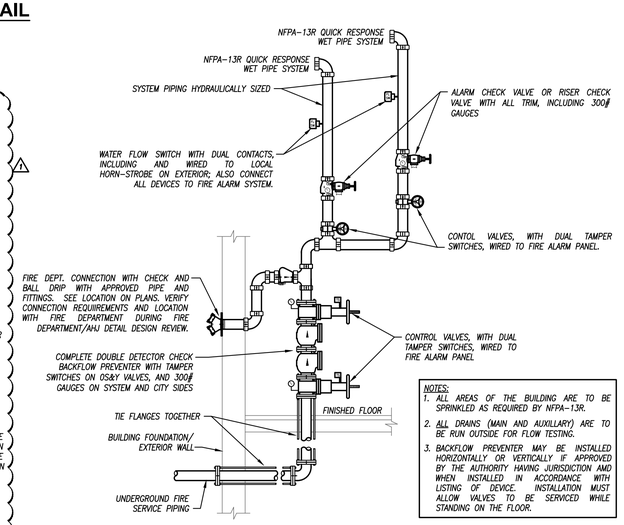

FIRE SPRINKLER RISER DETAIL

NOT TO SCALE

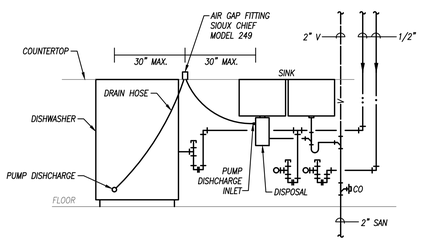

DISHWASHER/DISPOSAL/SINK PLUMBING

NOT TO SCALE

PRINTS ISSUED
10/30/2023 - PERMIT SUBMITTAL

REVISIONS:
1 12/15/2023 - CITY COMMENTS

23.161

pkmr ENGINEERS
PEARSON KENT MCKINLEY RAAF ENGINEERS LLC
13300 W 98TH STREET LENEXA, KS 66215
913.492.2400 WWW.PKMRENG.COM
MO State Certificate of Authority #E-2002020886

STATE OF MISSOURI
MICHAEL D RAAF
NUMBER PE-2005028097
REGISTERED PROFESSIONAL ENGINEER
12/15/23
Michael D. Raaf - Engineer
MO# PE-2005028097

WILSHIRE HILLS III

LEE'S SUMMIT, MISSOURI

SHEET TITLE
PLUMBING DETAILS

PROJECT NUMBER: 23.161

SHEET NUMBER:

P302

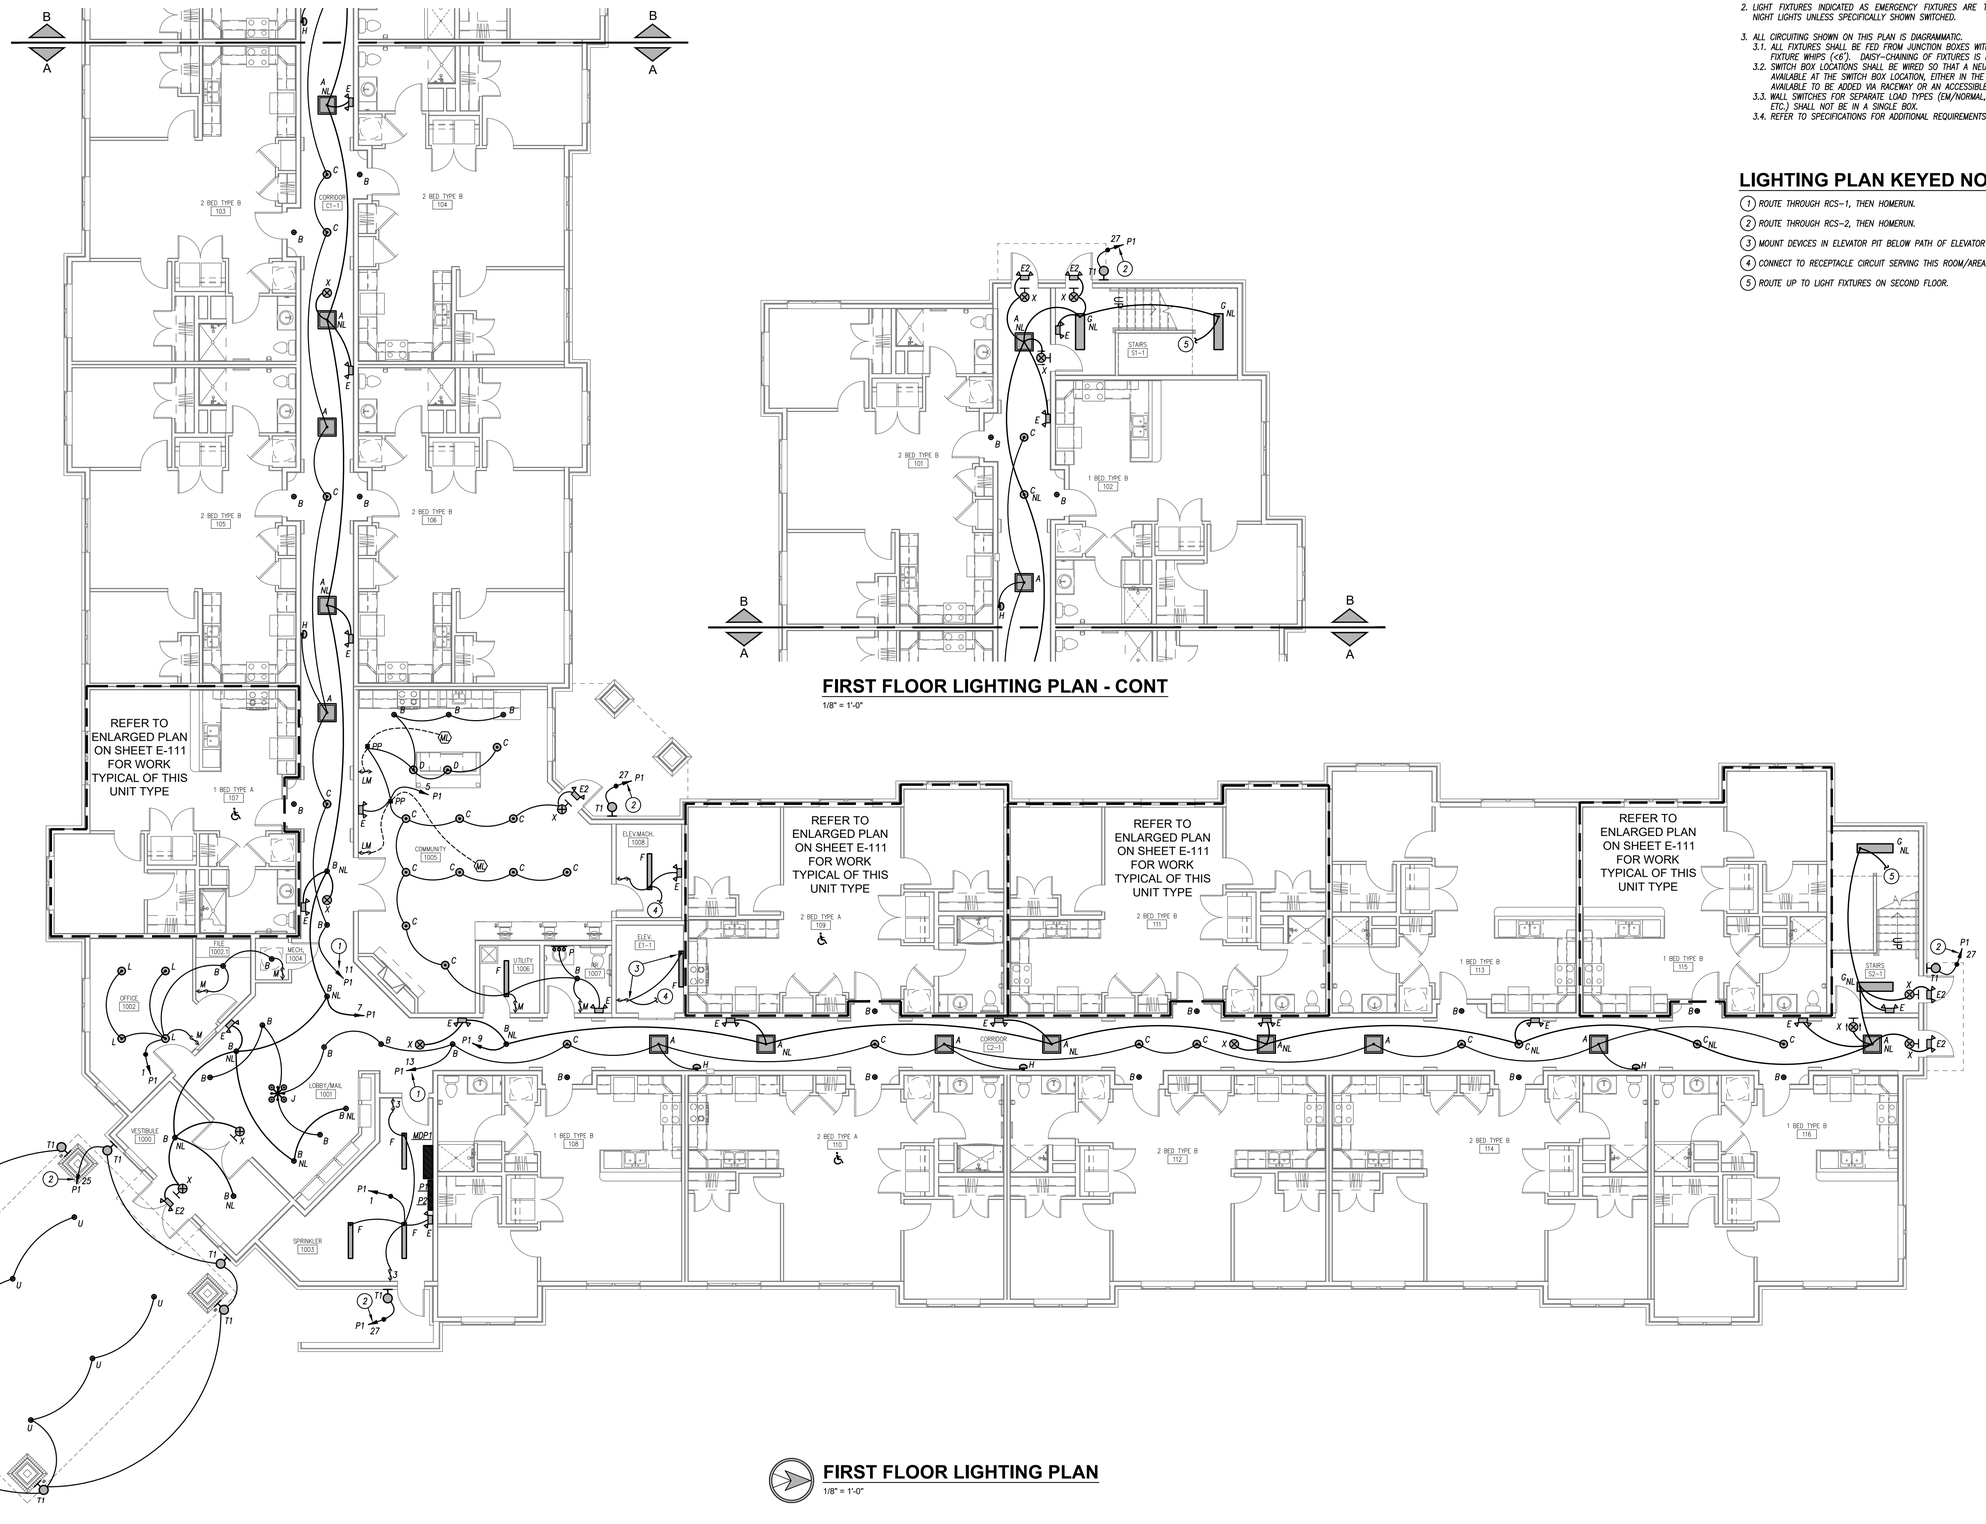

FIRST FLOOR LIGHTING PLAN

1/8" = 1'-0"

FIRST FLOOR LIGHTING PLAN - CONT

1/8" = 1'-0"

GENERAL LIGHTING NOTES

1. REFER TO GENERAL NOTES ON MEP COVER SHEET FOR ADDITIONAL REQUIREMENTS OF WORK.
2. LIGHT FIXTURES INDICATED AS EMERGENCY FIXTURES ARE TO FUNCTION AS NIGHT LIGHTS UNLESS SPECIFICALLY SHOWN SWITCHED.
3. ALL CIRCUITING SHOWN ON THIS PLAN IS DIAGRAMMATIC.
   - 3.1. ALL FIXTURES SHALL BE FED FROM JUNCTION BOXES WITH LIGHT FIXTURE WHIPS (<6'). DAISY-CHAINING OF FIXTURES IS NOT ALLOWED.
   - 3.2. SWITCH BOX LOCATIONS SHALL BE WIRED SO THAT A NEUTRAL WIRE IS AVAILABLE AT THE SWITCH BOX LOCATION, EITHER IN THE BOX OR AVAILABLE TO BE ADDED VIA RACEWAY OR AN ACCESSIBLE WALL CAVITY.
   - 3.3. WALL SWITCHES FOR SEPARATE LOAD TYPES (EM/NORMAL, 120/277V, ETC.) SHALL NOT BE IN A SINGLE BOX.
   - 3.4. REFER TO SPECIFICATIONS FOR ADDITIONAL REQUIREMENTS.

LIGHTING PLAN KEYED NOTES

1. ROUTE THROUGH RCS-1, THEN HOMERUN.
2. ROUTE THROUGH RCS-2, THEN HOMERUN.
3. MOUNT DEVICES IN ELEVATOR PIT BELOW PATH OF ELEVATOR TRAVEL.
4. CONNECT TO RECEPTACLE CIRCUIT SERVING THIS ROOM/AREA.
5. ROUTE UP TO LIGHT FIXTURES ON SECOND FLOOR.

PRINTS ISSUED
10/30/2023 - PERMIT SUBMITTAL

REVISIONS:

23.161

pkmr ENGINEERS
PEARSON KENT MCKINLEY RAAF ENGINEERS LLC
13300 W 98TH STREET LENEXA, KS 66215
913.492.2400 WWW.PKMRENG.COM
MO State Certificate of Authority #E-2002020886

STATE OF MISSOURI
MICHAEL D RAAF
NUMBER PE-2005028097
REGISTERED PROFESSIONAL ENGINEER
10/30/23
Michael D. Raaf - Engineer
MO# PE-2005028097

WILSHIRE HILLS III

LEE'S SUMMIT, MISSOURI

SHEET TITLE
FIRST FLOOR LIGHTING PLAN

PROJECT NUMBER: 23.161

SHEET NUMBER:

E101

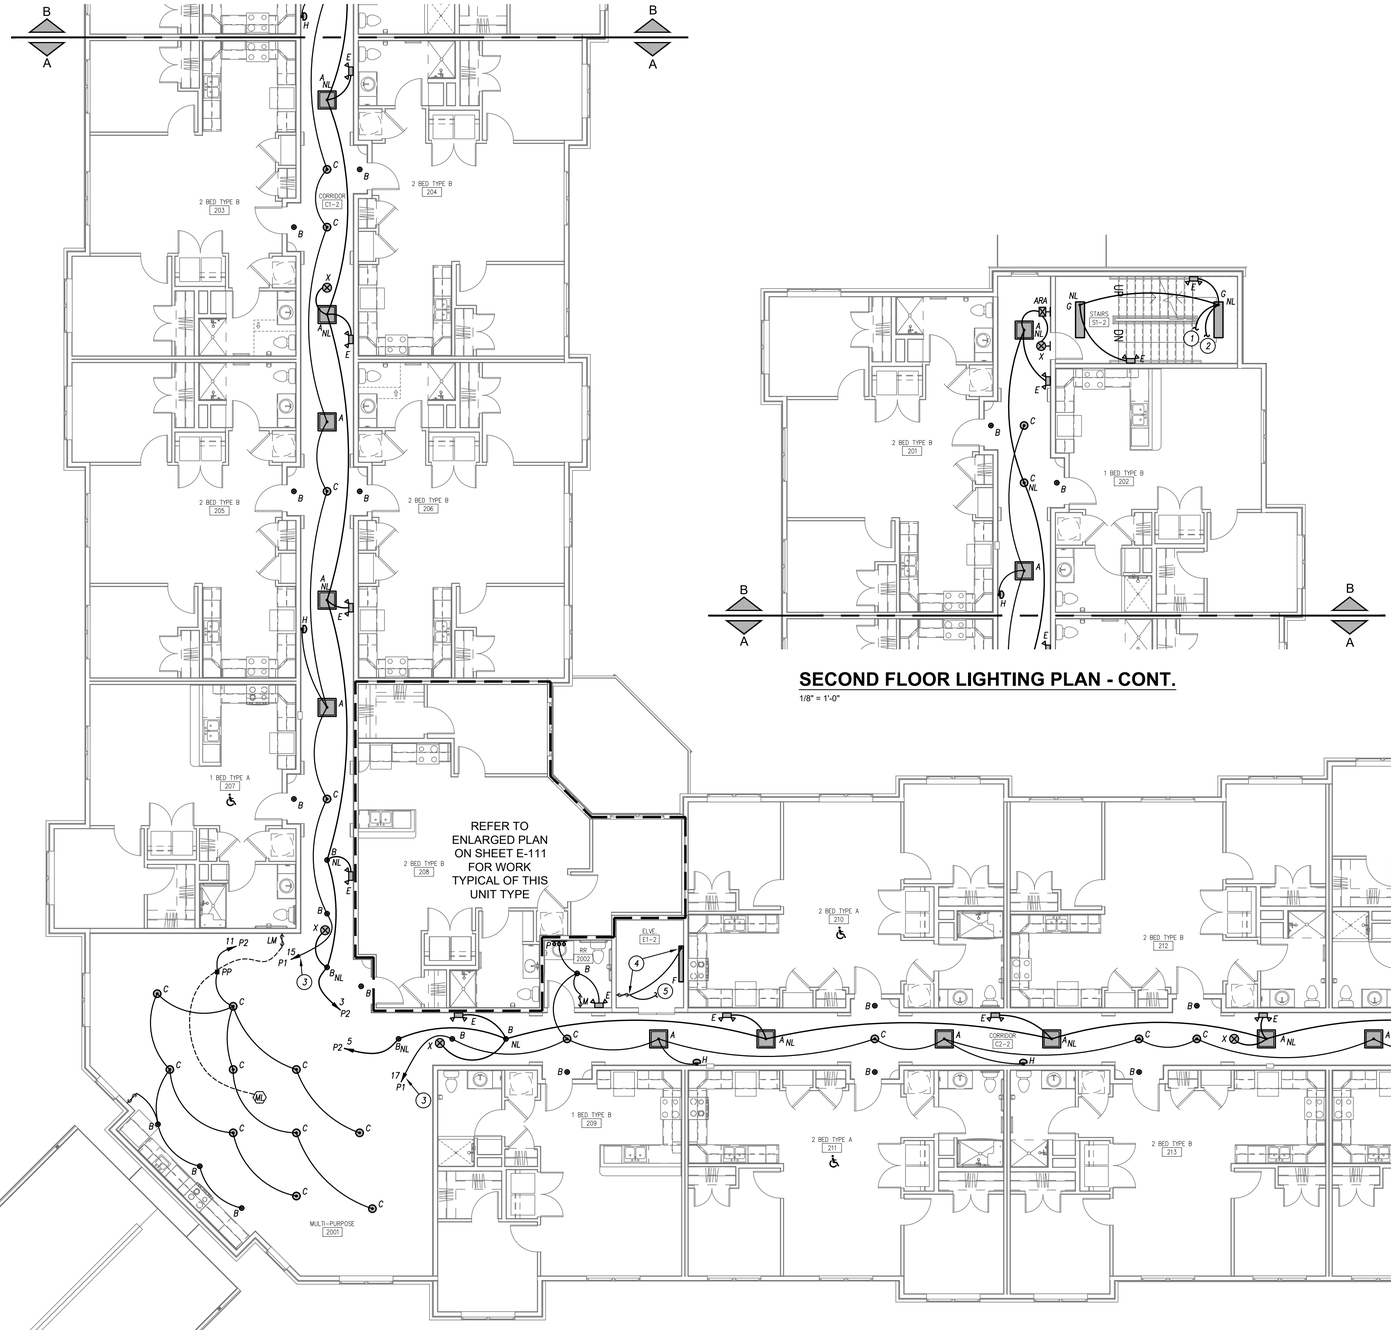

SECOND FLOOR LIGHTING PLAN

1/8" = 1'-0"

SECOND FLOOR LIGHTING PLAN - CONT.

1/8" = 1'-0"

GENERAL LIGHTING NOTES

1. REFER TO GENERAL NOTES ON MEP COVER SHEET FOR ADDITIONAL REQUIREMENTS OF WORK.
2. LIGHT FIXTURES INDICATED AS EMERGENCY FIXTURES ARE TO FUNCTION AS NIGHT LIGHTS UNLESS SPECIFICALLY SHOWN SWITCHED.
3. ALL CIRCUITING SHOWN ON THIS PLAN IS DIAGRAMMATIC.
   - 3.1. ALL FIXTURES SHALL BE FED FROM JUNCTION BOXES WITH LIGHT FIXTURE WHIPS (<6'). DAISY-CHAINING OF FIXTURES IS NOT ALLOWED.
   - 3.2. SWITCH BOX LOCATIONS SHALL BE WIRED SO THAT A NEUTRAL WIRE IS AVAILABLE AT THE SWITCH BOX LOCATION, EITHER IN THE BOX OR AVAILABLE TO BE ADDED VIA RACEWAY OR AN ACCESSIBLE WALL CAVITY.
   - 3.3. WALL SWITCHES FOR SEPARATE LOAD TYPES (EM/NORMAL, 120/277V, ETC.) SHALL NOT BE IN A SINGLE BOX.
   - 3.4. REFER TO SPECIFICATIONS FOR ADDITIONAL REQUIREMENTS.

LIGHTING PLAN KEYED NOTES

1. ROUTE TO LIGHTS ON FIRST FLOOR.
2. ROUTE TO LIGHTS ON THIRD FLOOR.
3. ROUTE THROUGH REMOTE CONTROL SWITCH RCS-1 ON FIRST FLOOR, THEN HOMERUN.
4. MOUNT DEVICES IN ELEVATOR SHAFT OUT OF PATH OF ELEVATOR TRAVEL.
5. CONNECT TO RECEPTACLE CIRCUIT SERVING THIS ROOM/AREA.

PRINTS ISSUED
10/30/2023 - PERMIT SUBMITTAL

REVISIONS:

23.161

pkmr ENGINEERS
PEARSON KENT MCKINLEY RAAF ENGINEERS LLC
13300 W 98TH STREET LENEXA, KS 66215
913.492.2400 WWW.PKMRENG.COM
MO State Certificate of Authority #E-2002020886

STATE OF MISSOURI
MICHAEL D RAAF
NUMBER PE-2005028097
REGISTERED PROFESSIONAL ENGINEER
10/30/23
Michael D. Raaf - Engineer
MO# PE-2005028097

WILSHIRE HILLS III

LEE'S SUMMIT, MISSOURI

SHEET TITLE
SECOND FLOOR LIGHTING PLAN

PROJECT NUMBER: 23.161

SHEET NUMBER:

E102

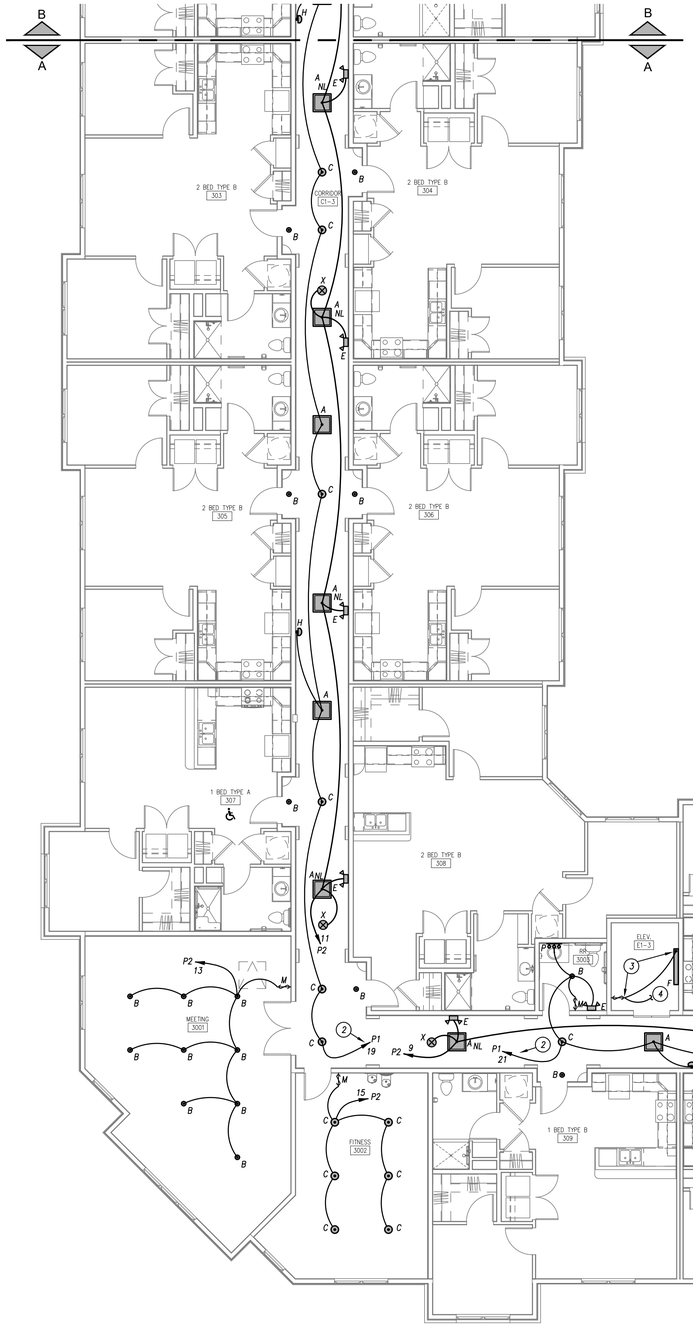

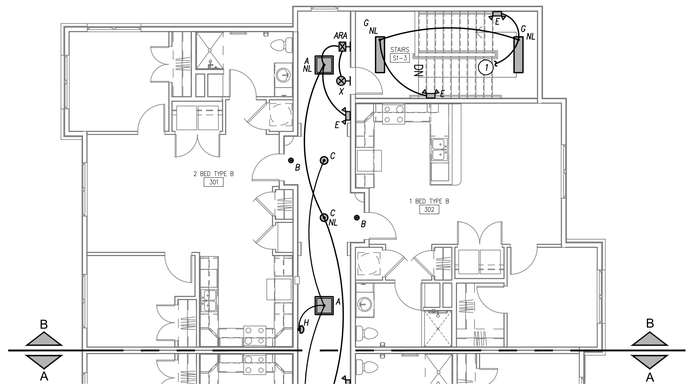

THIRD FLOOR LIGHTING PLAN - CONT.

1/8" = 1'-0"

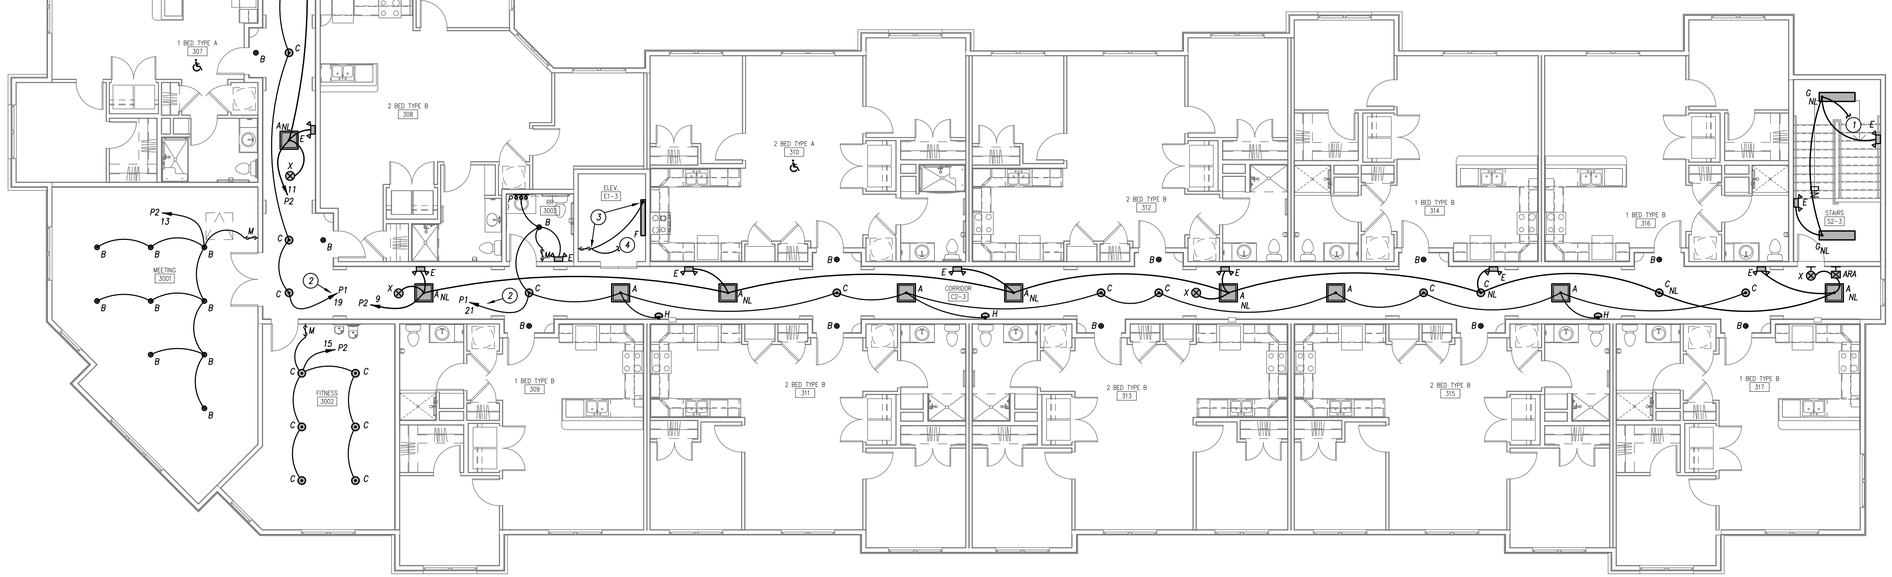

THIRD FLOOR LIGHTING PLAN

1/8" = 1'-0"

GENERAL LIGHTING NOTES

1. REFER TO GENERAL NOTES ON MEP COVER SHEET FOR ADDITIONAL REQUIREMENTS OF WORK.
2. LIGHT FIXTURES INDICATED AS EMERGENCY FIXTURES ARE TO FUNCTION AS NIGHT LIGHTS UNLESS SPECIFICALLY SHOWN SWITCHED.
3. ALL CIRCUITING SHOWN ON THIS PLAN IS DIAGRAMMATIC.
   - 3.1. ALL FIXTURES SHALL BE FED FROM JUNCTION BOXES WITH LIGHT FIXTURE WHIPS (<6'). DAISY-CHAINING OF FIXTURES IS NOT ALLOWED.
   - 3.2. SWITCH BOX LOCATIONS SHALL BE WIRED SO THAT A NEUTRAL WIRE IS AVAILABLE AT THE SWITCH BOX LOCATION, EITHER IN THE BOX OR AVAILABLE TO BE ADDED VIA RACEWAY OR AN ACCESSIBLE WALL CAVITY.
   - 3.3. WALL SWITCHES FOR SEPARATE LOAD TYPES (EM/NORMAL, 120/277V, ETC.) SHALL NOT BE IN A SINGLE BOX.
   - 3.4. REFER TO SPECIFICATIONS FOR ADDITIONAL REQUIREMENTS.

LIGHTING PLAN KEYED NOTES

1. ROUTE TO LIGHTS ON SECOND FLOOR.
2. ROUTE THROUGH REMOTE CONTROL SWITCH RCS-1 ON FIRST FLOOR, THEN HOMERUN.
3. MOUNT DEVICES IN ELEVATOR SHAFT OUT OF PATH OF ELEVATOR TRAVEL.
4. CONNECT TO RECEPTACLE CIRCUIT SERVING THIS ROOM/AREA.

PRINTS ISSUED
10/30/2023 - PERMIT SUBMITTAL

REVISIONS:

23.161

pkmr ENGINEERS
PEARSON KENT MCKINLEY RAAF ENGINEERS LLC
13300 W 98TH STREET LENEXA, KS 66215
913.492.2400 WWW.PKMRENG.COM
MO State Certificate of Authority #E-2002020886

STATE OF MISSOURI
MICHAEL D RAAF
NUMBER PE-2005028097
REGISTERED PROFESSIONAL ENGINEER
10/30/23
Michael D. Raaf - Engineer
MO# PE-2005028097

WILSHIRE HILLS III

LEE'S SUMMIT, MISSOURI

SHEET TITLE
THIRD FLOOR LIGHTING PLAN

PROJECT NUMBER: 23.161

SHEET NUMBER:

E103

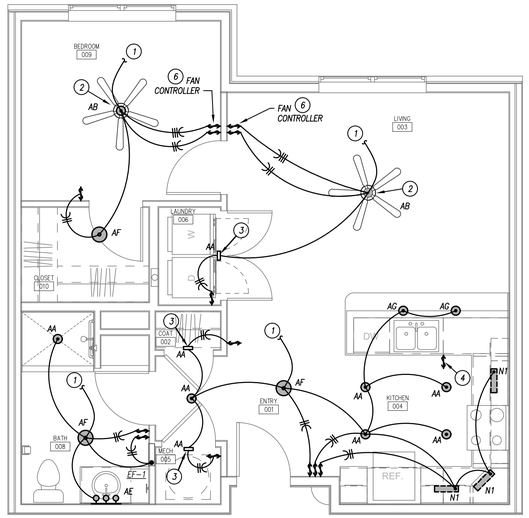

TYPE B - ONE BEDROOM
TYPICAL UNIT FLOOR PLAN - LIGHTING

1/4" = 1'-0"

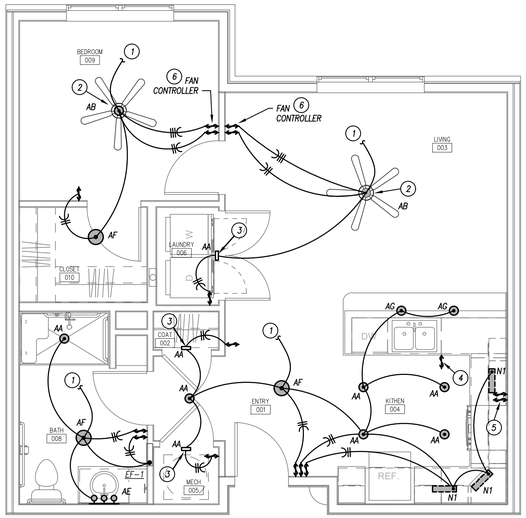

TYPE A - ONE BEDROOM
TYPICAL UNIT FLOOR PLAN - LIGHTING

1/4" = 1'-0"

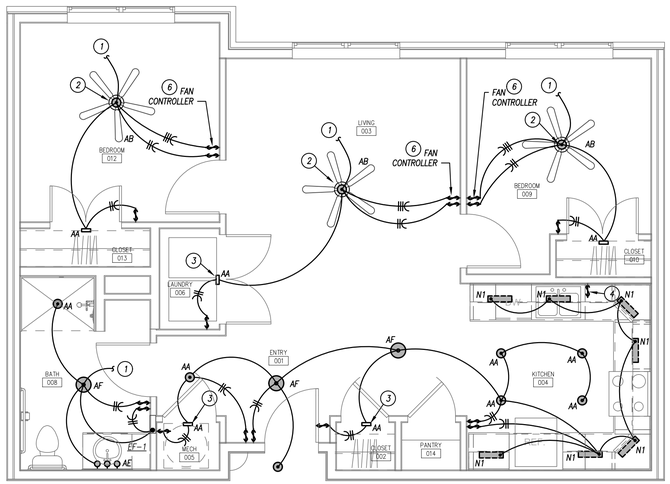

TYPE B - TWO BEDROOM
TYPICAL UNIT FLOOR PLAN - LIGHTINIG

1/4" = 1'-0"

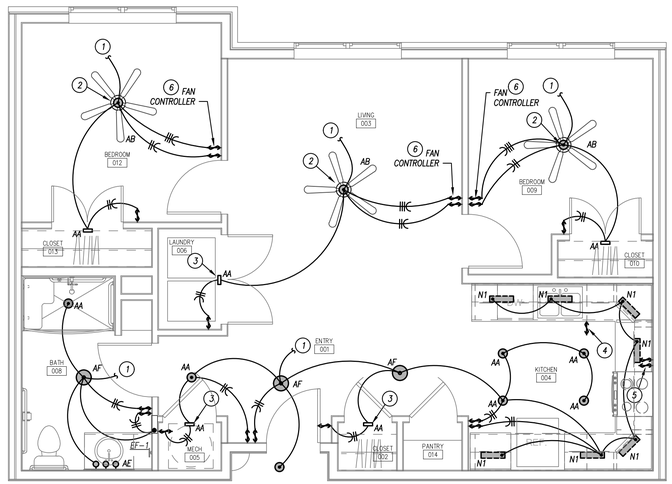

TYPE A - TWO BEDROOM
TYPICAL UNIT FLOOR PLAN - LIGHTING

1/4" = 1'-0"

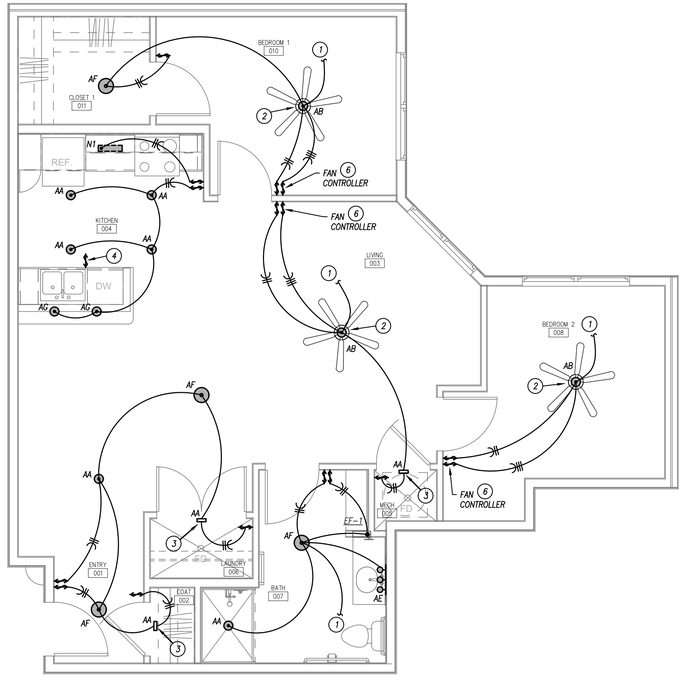

TYPE B - TWO BEDROOM - (CORNER)
TYPICAL UNIT FLOOR PLAN - LIGHTING

1/4" = 1'-0"

GENERAL LIGHTING NOTES

1. REFER TO GENERAL NOTES ON MEP COVER SHEET FOR ADDITIONAL REQUIREMENTS OF WORK.
2. LIGHT FIXTURES INDICATED AS EMERGENCY FIXTURES ARE TO FUNCTION AS NIGHT LIGHTS UNLESS SPECIFICALLY SHOWN SWITCHED.
3. ALL CIRCUITING SHOWN ON THIS PLAN IS DIAGRAMMATIC.
   - 3.1. ALL FIXTURES SHALL BE FED FROM JUNCTION BOXES WITH LIGHT FIXTURE WHIPS (<6'). DAISY-CHAINING OF FIXTURES IS NOT ALLOWED.
   - 3.2. SWITCH BOX LOCATIONS SHALL BE WIRED SO THAT A NEUTRAL WIRE IS AVAILABLE AT THE SWITCH BOX LOCATION, EITHER IN THE BOX OR AVAILABLE TO BE ADDED VIA RACEWAY OR AN ACCESSIBLE WALL CAVITY.
   - 3.3. WALL SWITCHES FOR SEPARATE LOAD TYPES (EM/NORMAL, 120/277V, ETC.) SHALL NOT BE IN A SINGLE BOX.
   - 3.4. REFER TO SPECIFICATIONS FOR ADDITIONAL REQUIREMENTS.

LIGHTING PLAN KEYED NOTES

1. CONNECT TO CIRCUIT SERVING RECEPTACLES THIS ROOM.
2. SWITCH FAN AND LIGHT SEPARATELY.
3. MOUNT FIXTURE VERTICALLY ON WALL ABOVE DOOR.
4. DISPOSAL SWITCH. SEE POWER PLAN.
5. ACCESSIBLE SWITCHES FOR HOOD FAN AND LIGHT. SEE POWER PLAN.
6. PROVIDE 3-SPEED TO OFF FAN SPEED CONTROLLER COMPATIBLE WITH CEILING FAN PROVIDED.

PRINTS ISSUED
10/30/2023 - PERMIT SUBMITTAL

REVISIONS:

23.161

pkmr ENGINEERS
PEARSON KENT MCKINLEY RAAF ENGINEERS LLC
13300 W 98TH STREET LENEXA, KS 66215
913.492.2400 WWW.PKMRENG.COM
MO State Certificate of Authority #E-2002020886

STATE OF MISSOURI
MICHAEL D RAAF
NUMBER PE-2005028097
REGISTERED PROFESSIONAL ENGINEER
10/30/23
Michael D. Raaf - Engineer
MO# PE-2005028097

WILSHIRE HILLS III

LEE'S SUMMIT, MISSOURI

SHEET TITLE
ENLARGED UNIT PLANS - LIGHTING

PROJECT NUMBER: 23.161

SHEET NUMBER:

E111

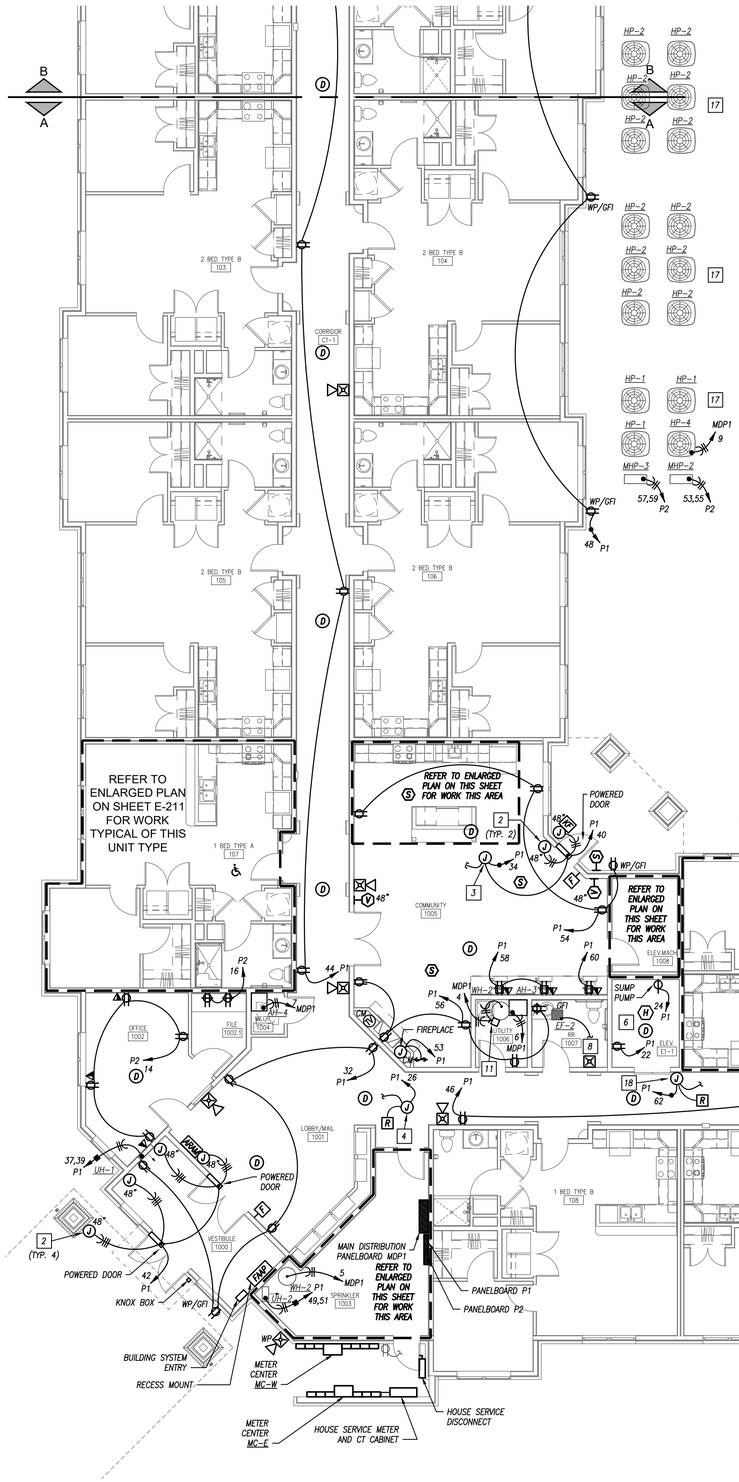

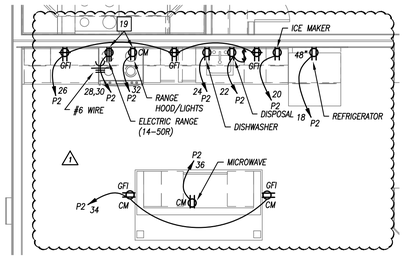

COMMUNITY KITCHEN - ENLARGED PLAN

1/4" = 1'-0"

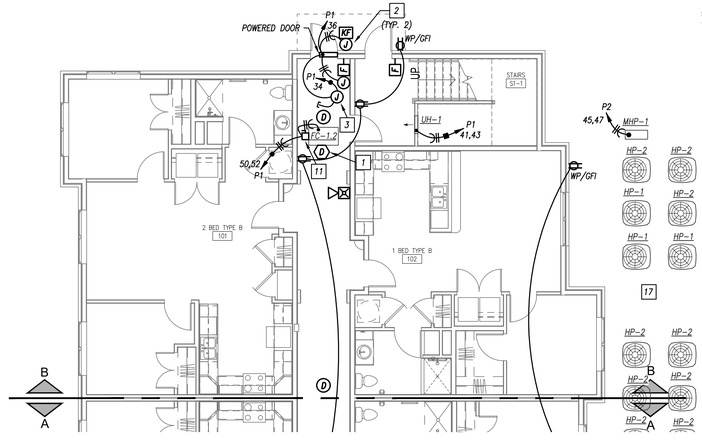

FIST FLOOR POWER PLAN - CONT.

1/8" = 1'-0"

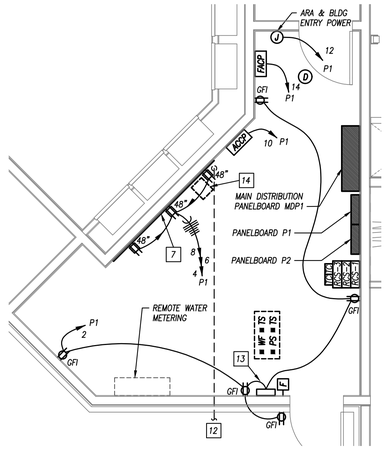

SPRINKLER ROOM - ENLARGED PLAN

1/4" = 1'-0"

ELEVATOR RECALL AND SHUTDOWN

THE SEQUENCE OF OPERATION FOR ELEVATOR RECALL AND SHUTDOWN SHALL BE AS FOLLOWS:

THE ACTIVATION OF SMOKE DETECTORS WITH THE ELEVATOR EQUIPMENT ROOM, ELEVATOR SHAFT OR THE ELEVATOR LOBBIES SHALL INITIATE ELEVATOR RECALL.

THE ACTIVATION OF THE HEAT DETECTOR WITHIN THE ELEVATOR EQUIPMENT ROOM OR SHAFT SHALL SIGNAL THE SHUNT TRIP CIRCUIT BREAKERS SERVING THE ELEVATOR TO OPEN. THE CONTRACTOR SHALL FURNISH AND INSTALL ANY RELAYS AND ASSOCIATED CONDUIT AND WIRE AS REQUIRED TO ACTIVATE THE COIL IN THE SHUNT TRIP CIRCUIT BREAKER SERVING THE ELEVATOR CONTROLLER.

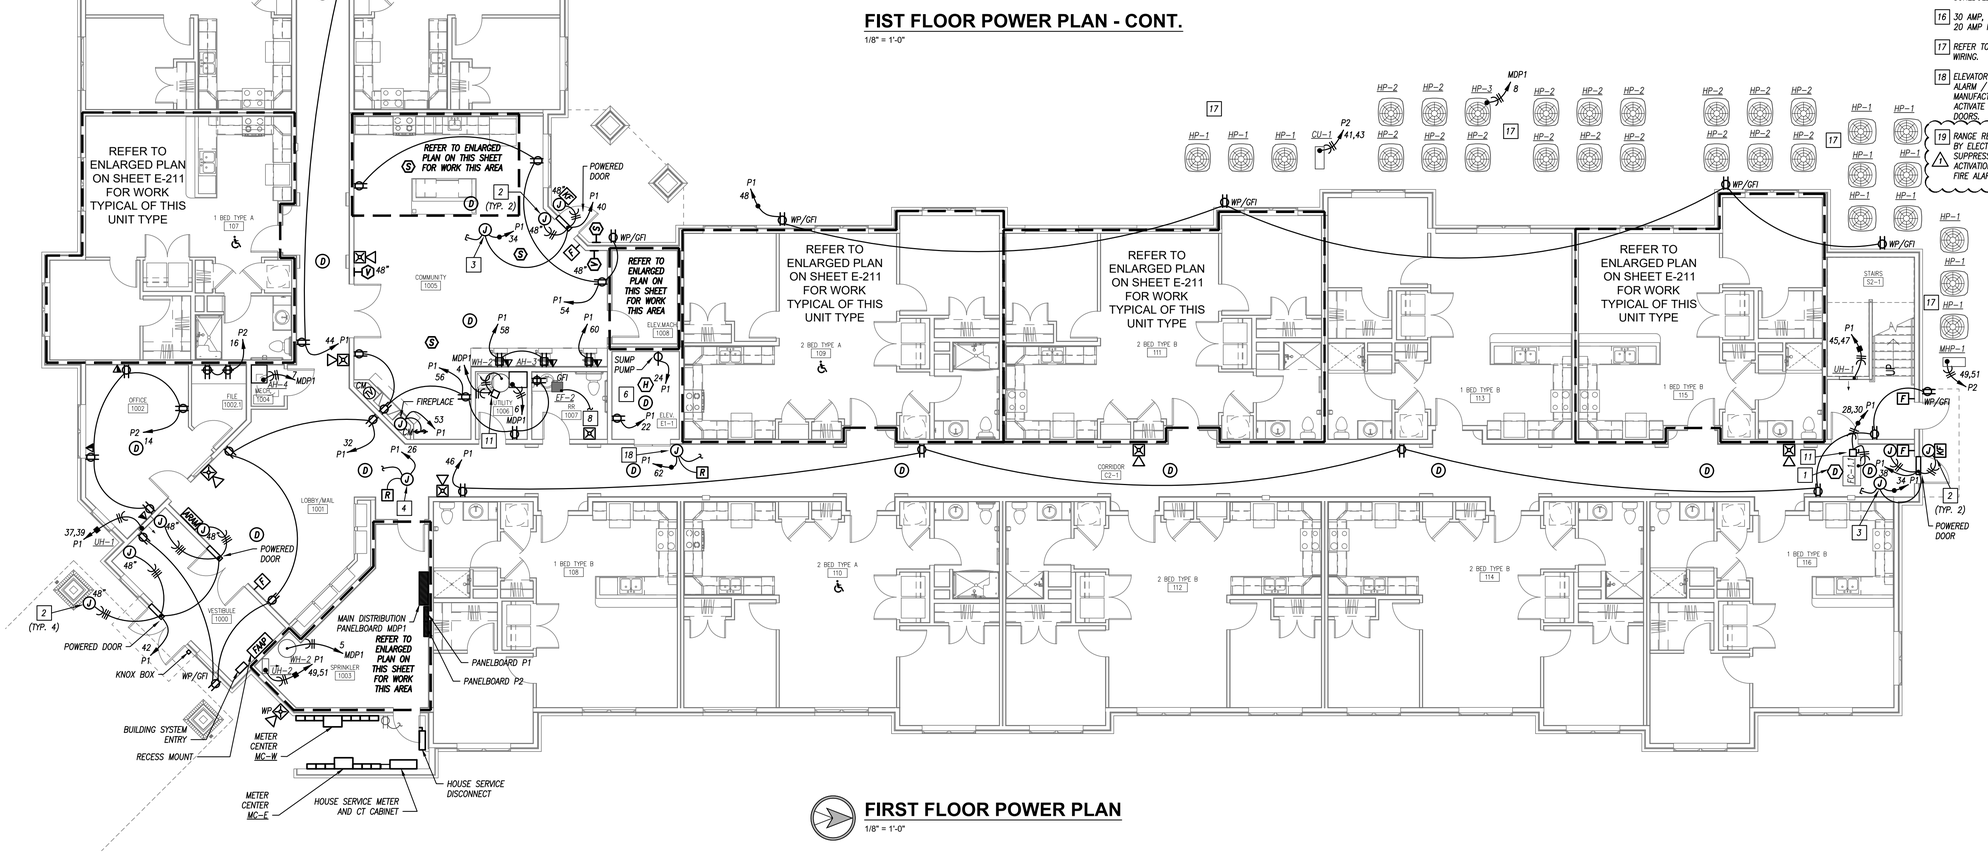

FIRST FLOOR POWER PLAN

1/8" = 1'-0"

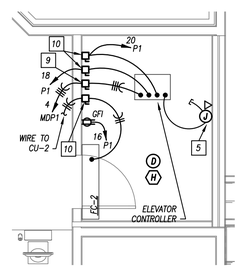

ELEVATOR EQUIPMENT ROOM - ENLARGED PLAN

1/4" = 1'-0"

GENERAL POWER NOTES

1. *REFER TO GENERAL NOTES ON MEP COVER SHEET FOR ADDITIONAL REQUIREMENTS OF WORK.*
2. *COORDINATE EXACT NEMA CONFIGURATIONS OF RECEPTACLES SERVING EQUIPMENT WITH EXACT EQUIPMENT BEING FURNISHED.*
3. *EXACT MECHANICAL EQUIPMENT LOCATIONS MAY NOT BE SHOWN FOR CLARITY. COORDINATE EXACT LOCATIONS OF ALL MECHANICAL EQUIPMENT, DUCT DETECTORS, ETC. WITH MECHANICAL DRAWINGS AND CONTRACTOR.*
4. *COORDINATE EXACT LOCATIONS OF SMOKE DETECTORS WITH CEILING FANS, HVAC DIFFUSERS, SPRINKLER HEADS, ETC. PER NFPA REQUIREMENTS.*
5. *REFER TO SHEETS G-300 AND G-301 FOR MOUNTING HEIGHTS OF DEVICES AND CONTROLS.*

POWER PLAN KEYED NOTES

1. *MOUNT DUCT DETECTOR IN RETURN AIR DUCTWORK. COORDINATE EXACT LOCATION WITH MECHANICAL CONTRACTOR. REFER TO DETAIL ON SHEET E402 FOR WIRING.*
2. *ROUGH-IN FOR POWERED DOOR PUSHBUTTON PER MANUFACTURER'S RECOMMENDATIONS. REFER TO ARCHITECTURAL PLANS FOR EXACT LOCATION.*
3. *PROVIDE JUNCTION BOXES AND CONDUIT AT ±42" A.F.F. FOR KEY FOB AND 80" A.F.F. FOR DOOR LOCK/ACCESS CONTROL WIRING. REFER TO DETAIL ON SHEET E-502.*
4. *WIRE TO FIRE/SMOKE DAMPERS THIS FLOOR. REFER TO MECHANICAL PLANS FOR LOCATIONS AND NUMBERS OF FIRE/SMOKE DAMPERS.*
5. *TELEPHONE CONNECTION TO THE ELEVATOR CONTROLLER. COORDINATE WITH THE ELEVATOR MANUFACTURER.*
6. *INSTALL DEVICES IN ELEVATOR PIT BELOW ELEVATOR TRAVEL. LIGHT SWITCH TO BE INSTALLED 48" A.F.F. AT LOWEST LANDING.*
7. *4'x8'x3/4" FIRE-RATED PLYWOOD TELECOMMUNICATIONS BACKBOARD. MOUNT AT 6" A.F.F.*
8. *WIRE TO AND SWITCH WITH LIGHT FIXTURE(S) THIS ROOM/AREA.*
9. *400 AMP RATED BUSSMAN QUIK-SPEC ELEVATOR POWER MODULE DISCONNECT, FUSED AT 250 AMP. POWER MODULE INCLUDES SHUNT TRIP RELAYS AND FIRE ALARM RELAYS FOR INTEGRATION INTO FIRE ALARM SYSTEM. COORDINATE WITH ELEVATOR MANUFACTURER. COORDINATE EXACT WIRE SIZE, SWITCH SIZE, AND FUSE SIZE WITH ELEVATOR MANUFACTURER SHOP DRAWINGS PRIOR TO WORK.*
10. *SPST 30A DISCONNECT SWITCH FUSED AT 20A, ARRANGED TO BE LOCKED IN THE OPEN POSITION FOR ELEVATOR LIGHTS, RECEPTACLE, AUXILIARY LIGHTING POWER SURFACE AND VENTILATION. MAKE ALL CONNECTIONS FOR A COMPLETE WORKING SYSTEM.*
11. *30 AMP, 2-POLE, NON-FUSED, HEAVY DUTY DISCONNECT SWITCH IN NEMA 1 ENCLOSURE. MOUNT AT UNIT WITH SUITABLE STEEL SUPPORTS.*
12. *TWO (2) 4" CONDUITS WITH PULLSTRINGS FOR COMMUNICATIONS CABLING. STUB UP AT TELEPHONE BACKBOARD LOCATION AND FURNISH CONDUIT WITH BUSHED ENDS. EXTEND OUTSIDE BUILDING TO PROPERTY LINE AS DIRECTED BY SERVICE PROVIDER(S).*
13. *IRRIGATION SYSTEM CONTROLLER. COORDINATE MOUNTING LOCATION WITH SYSTEM PROVIDER.*
14. *TELECOMMUNICATION AND SPEAKER SYSTEM HEADEND EQUIPMENT RACK.*
15. *WIRE TO LIGHT FIXTURE(S) THIS ROOM/AREA. REFER TO EXHAUST FAN SCHEDULE FOR CONTROL.*
16. *30 AMP, 1-POLE DISCONNECT SWITCH IN NEMA 1 ENCLOSURE. FUSE WITH 20 AMP FUSES.*
17. *REFER TO DETAIL ON SHEET E202 FOR HEAT PUMP AND CONDENSING UNIT WIRING.*
18. *ELEVATOR SMOKE CURTAIN. MAKE ALL POWER CONNECTIONS AND FIRE ALARM / SMOKE DETECTOR CONNECTIONS IN ACCORDANCE WITH MANUFACTURER'S INSTALLATION INSTRUCTIONS. ALL SMOKE CURTAINS TO ACTIVATE UPON INITIATION OF ANY SMOKE DETECTOR NEAREST TO ELEVATOR DOORS.*
19. *RANGE RECEPTACLE PROVIDED WITH FIRE SUPPRESSION SYSTEM, INSTALLED BY ELECTRICAL CONTRACTOR. MAKE ALL CONNECTIONS TO FIRE SUPPRESSION SYSTEM FOR AUTOMATIC SHUTOFF OF RANGE UPON SYSTEM ACTIVATION. INTERFACE FIRE SUPPRESSION SYSTEM STATUS WITH BUILDING FIRE ALARM SYSTEM FOR MONITORING.*

PRINTS ISSUED
10/30/2023 - PERMIT SUBMITTAL

REVISIONS:
1 12/15/2023 - CITY COMMENTS

pkmr ENGINEERS
23.161
PEARSON KENT MCKINLEY RAAF ENGINEERS LLC
13300 W 98TH STREET LENEXA, KS 66215
913.492.2400 WWW.PKMRENG.COM
MO State Certificate of Authority #E-2002020886

STATE OF MISSOURI
MICHAEL D RAAF
NUMBER PE-2005028097
REGISTERED PROFESSIONAL ENGINEER
12/15/23
Michael D. Raaf - Engineer
MO# PE-2005028097

WILSHIRE HILLS III

LEE'S SUMMIT, MISSOURI

SHEET TITLE
FIRST FLOOR POWER PLAN

PROJECT NUMBER: 23.161

SHEET NUMBER:

E201

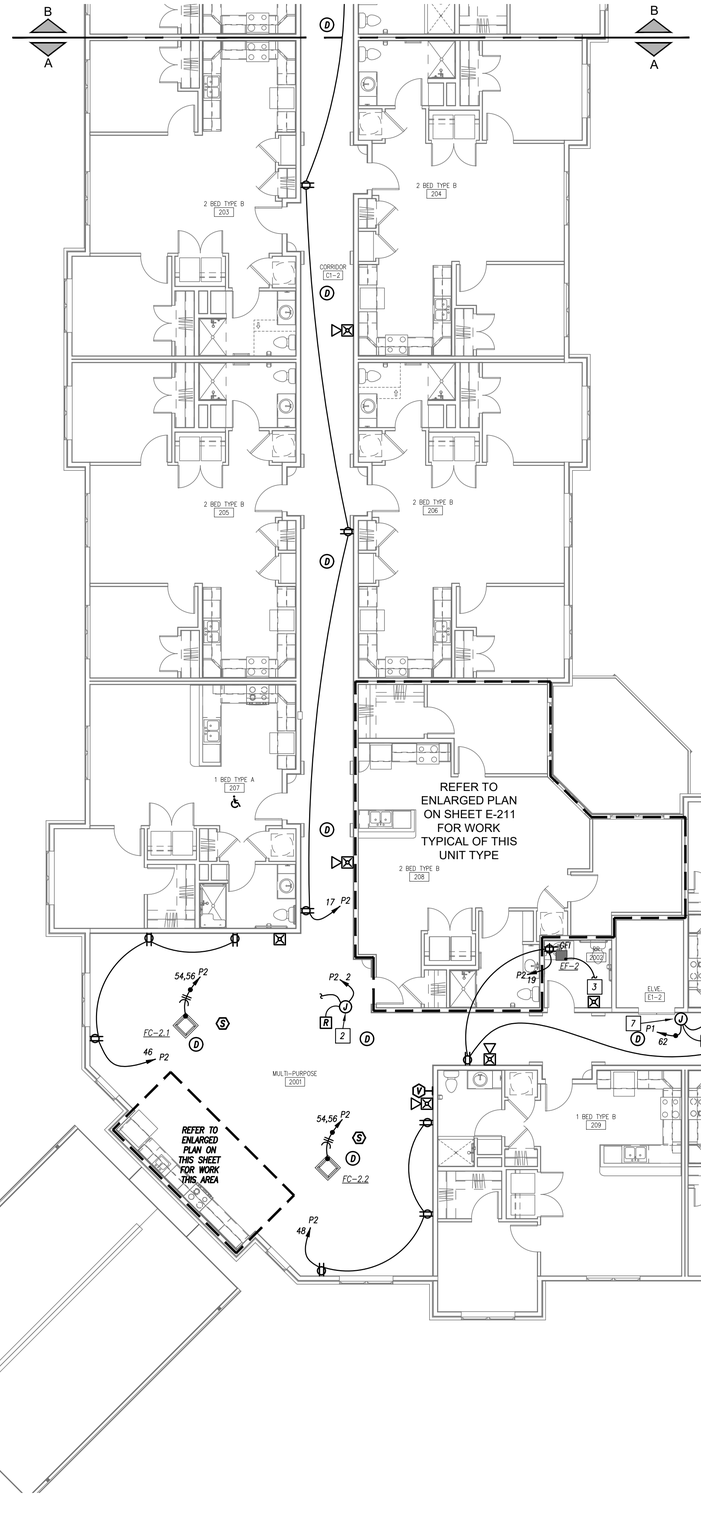

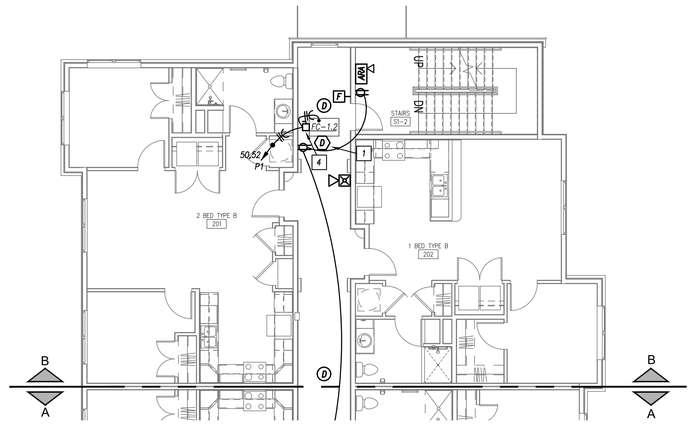

SECOND FLOOR POWER PLAN - CONT.

1/8" = 1'-0"

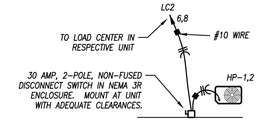

HEAT PUMP WIRING DIAGRAM TYPICAL FOR DWELLING UNITS ONLY

NOT TO SCALE

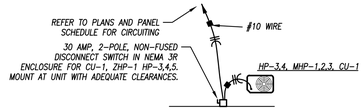

HEAT PUMP WIRING DIAGRAM TYPICAL FOR COMMON AREA UNITS

NOT TO SCALE

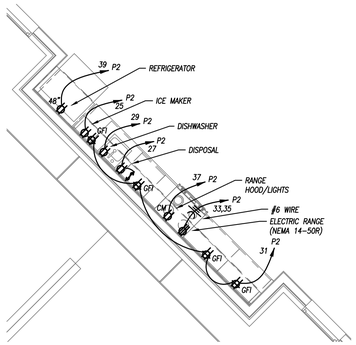

MULTIPURPOSE KITCHEN - ENLARGED PLAN

1/4" = 1'-0"

GENERAL POWER NOTES

1. REFER TO GENERAL NOTES ON MEP COVER SHEET FOR ADDITIONAL REQUIREMENTS OF WORK.
2. COORDINATE EXACT NEMA CONFIGURATIONS OF RECEPTACLES SERVING EQUIPMENT WITH EXACT EQUIPMENT BEING FURNISHED.
3. EXACT MECHANICAL EQUIPMENT LOCATIONS MAY NOT BE SHOWN FOR CLARITY. COORDINATE EXACT LOCATIONS OF ALL MECHANICAL EQUIPMENT, DUCT DETECTORS, ETC. WITH MECHANICAL DRAWINGS AND CONTRACTOR.
4. COORDINATE EXACT LOCATIONS OF SMOKE DETECTORS WITH CEILING FANS, HVAC DIFFUSERS, SPRINKLER HEADS, ETC. PER NFPA REQUIREMENTS.

POWER PLAN KEYED NOTES

1. MOUNT DUCT DETECTOR IN RETURN AIR DUCTWORK. COORDINATE EXACT LOCATION WITH MECHANICAL CONTRACTOR. REFER TO DETAIL ON SHEET E402 FOR WIRING.
2. WIRE TO FIRE/SMOKE DAMPERS THIS FLOOR. REFER TO MECHANICAL PLANS FOR LOCATIONS AND NUMBERS OF FIRE/SMOKE DAMPERS.
3. WIRE TO AND SWITCH WITH LIGHT FIXTURE(S) THIS ROOM/AREA.
4. 30 AMP, 2-POLE, NON-FUSED, HEAVY DUTY DISCONNECT SWITCH IN NEMA 1 ENCLOSURE. MOUNT AT UNIT WITH SUITABLE STEEL SUPPORTS.
5. MOUNT DEVICES IN HOISTWAY ABOVE PATH OF ELEVATOR TRAVEL.
6. (2)#6 WIRE AND (1)#10 GROUND IN 3/4" CONDUIT.
7. ELEVATOR SMOKE CURTAIN. MAKE ALL POWER CONNECTIONS AND FIRE ALARM / SMOKE DETECTOR CONNECTIONS IN ACCORDANCE WITH MANUFACTURER'S INSTALLATION INSTRUCTIONS. ALL SMOKE CURTAINS TO ACTIVATE UPON INITIATION OF ANY SMOKE DETECTOR NEAREST TO ELEVATOR DOORS.

SECOND FLOOR POWER PLAN

1/8" = 1'-0"

PRINTS ISSUED
10/30/2023 - PERMIT SUBMITTAL

REVISIONS:

23.161

pkmr ENGINEERS
PEARSON KENT MCKINLEY RAAF ENGINEERS LLC
13300 W 98TH STREET LENEXA, KS 66215
913.492.2400 WWW.PKMRENG.COM
MO State Certificate of Authority #E-2002020886

STATE OF MISSOURI
MICHAEL D RAAF
NUMBER PE-2005028097
REGISTERED PROFESSIONAL ENGINEER
10/30/23
Michael D. Raaf - Engineer
MO# PE-2005028097

WILSHIRE HILLS III

LEE'S SUMMIT, MISSOURI

SHEET TITLE
SECOND FLOOR POWER PLAN

PROJECT NUMBER: 23.161

SHEET NUMBER:

E202

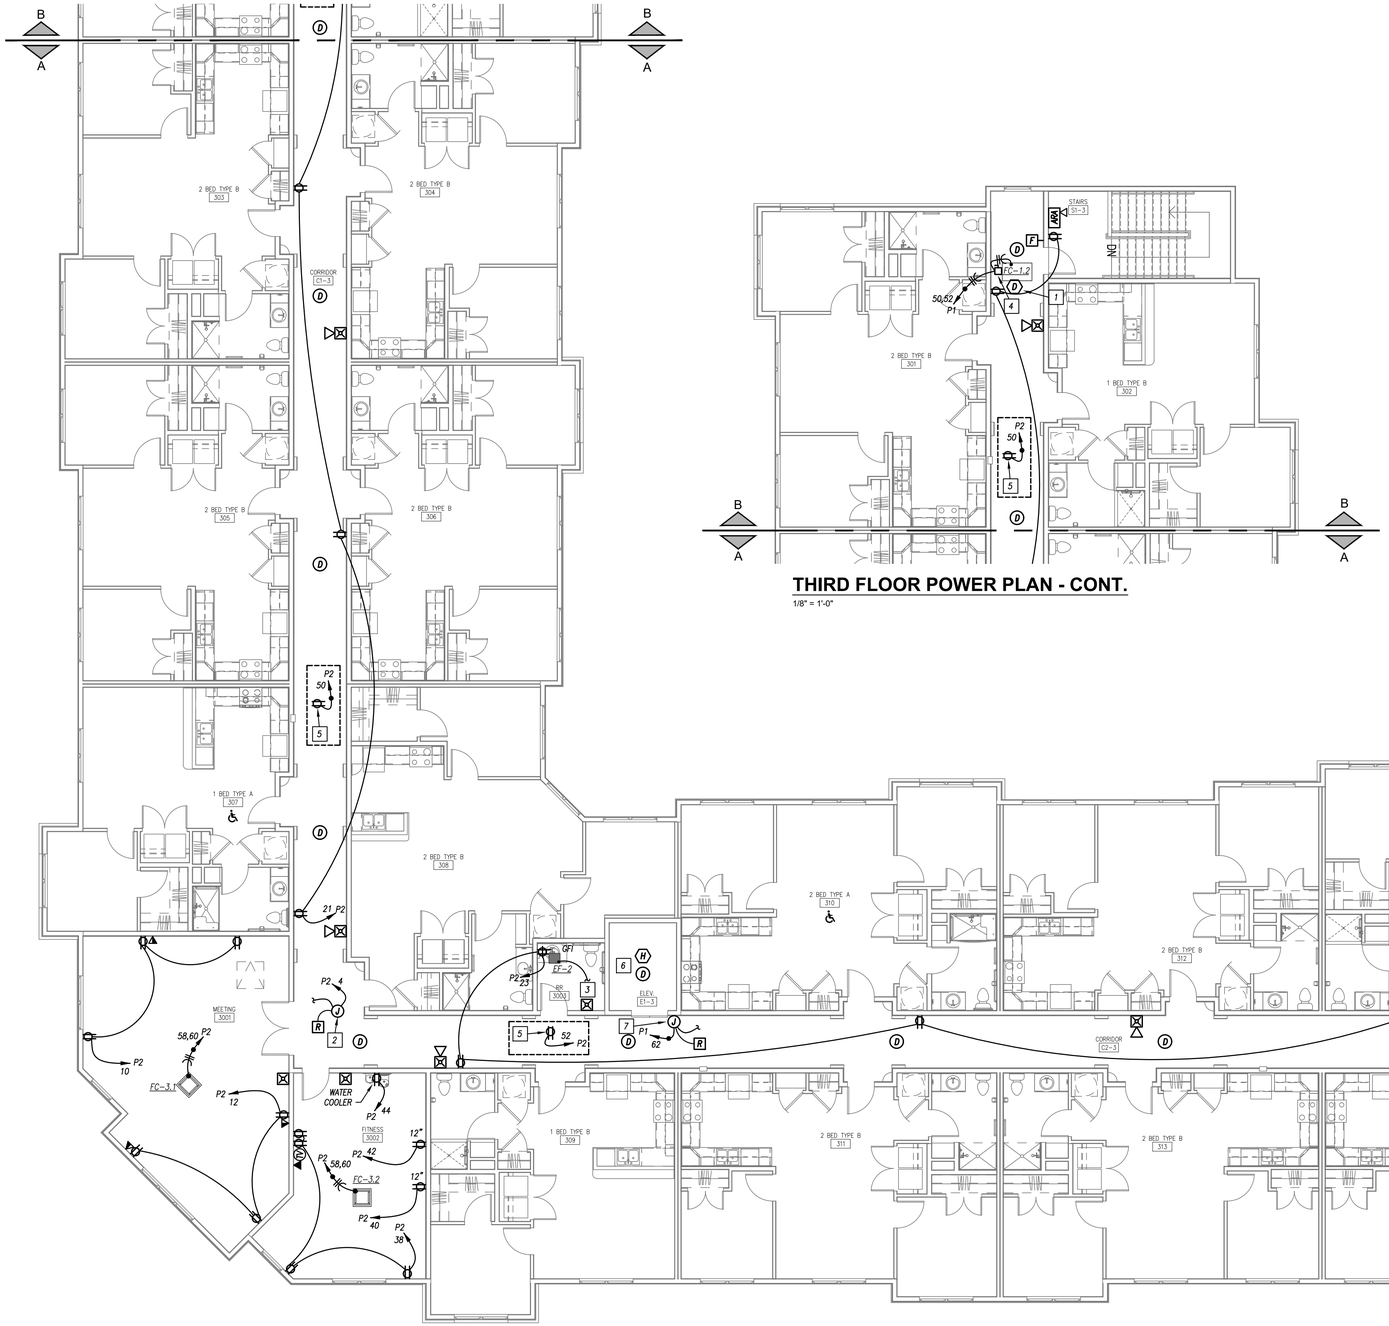

THIRD FLOOR POWER PLAN - CONT.

1/8" = 1'-0"

THIRD FLOOR POWER PLAN

1/8" = 1'-0"

GENERAL POWER NOTES

1. *REFER TO GENERAL NOTES ON MEP COVER SHEET FOR ADDITIONAL REQUIREMENTS OF WORK.*
2. *COORDINATE EXACT NEMA CONFIGURATIONS OF RECEPTACLES SERVING EQUIPMENT WITH EXACT EQUIPMENT BEING FURNISHED.*
3. *EXACT MECHANICAL EQUIPMENT LOCATIONS MAY NOT BE SHOWN FOR CLARITY. COORDINATE EXACT LOCATIONS OF ALL MECHANICAL EQUIPMENT, DUCT DETECTORS, ETC. WITH MECHANICAL DRAWINGS AND CONTRACTOR.*
4. *COORDINATE EXACT LOCATIONS OF SMOKE DETECTORS WITH CEILING FANS, HVAC DIFFUSERS, SPRINKLER HEADS, ETC. PER NFPA REQUIREMENTS.*

POWER PLAN KEYED NOTES

1. *MOUNT DUCT DETECTOR IN RETURN AIR DUCTWORK. COORDINATE EXACT LOCATION WITH MECHANICAL CONTRACTOR. REFER TO DETAIL ON SHEET E402 FOR WIRING.*
2. *WIRE TO FIRE/SMOKE DAMPERS THIS FLOOR. REFER TO MECHANICAL PLANS FOR LOCATIONS AND NUMBERS OF FIRE/SMOKE DAMPERS.*
3. *WIRE TO AND SWITCH WITH LIGHT FIXTURE(S) THIS ROOM/AREA.*
4. *30 AMP, 2-POLE, NON-FUSED, HEAVY DUTY DISCONNECT SWITCH IN NEMA 1 ENCLOSURE. MOUNT AT UNIT WITH SUITABLE STEEL SUPPORTS.*
5. *RECEPTACLE IN ATTIC FOR RADON SYSTEM FAN. COORDINATE EXACT LOCATION WITH RADON SYSTEM PROVIDER.*
6. *MOUNT DEVICES IN HOISTWAY ABOVE PATH OF ELEVATOR TRAVEL.*
7. *ELEVATOR SMOKE CURTAIN. MAKE ALL POWER CONNECTIONS AND FIRE ALARM / SMOKE DETECTOR CONNECTIONS IN ACCORDANCE WITH MANUFACTURER'S INSTALLATION INSTRUCTIONS. ALL SMOKE CURTAINS TO ACTIVATE UPON INITIATION OF ANY SMOKE DETECTOR NEAREST TO ELEVATOR DOORS.*

PRINTS ISSUED
10/30/2023 - PERMIT SUBMITTAL

REVISIONS:

23.161

pkmr ENGINEERS
PEARSON KENT MCKINLEY RAAF ENGINEERS LLC
13300 W 98TH STREET LENEXA, KS 66215
913.492.2400 WWW.PKMRENG.COM
MO State Certificate of Authority #E-2002020886

STATE OF MISSOURI
MICHAEL D RAAF
NUMBER PE-2005028097
REGISTERED PROFESSIONAL ENGINEER
10/30/23
Michael D. Raaf - Engineer
MO# PE-2005028097

WILSHIRE HILLS III

LEE'S SUMMIT, MISSOURI

SHEET TITLE
THIRD FLOOR POWER PLAN

PROJECT NUMBER: 23.161

SHEET NUMBER:

E203

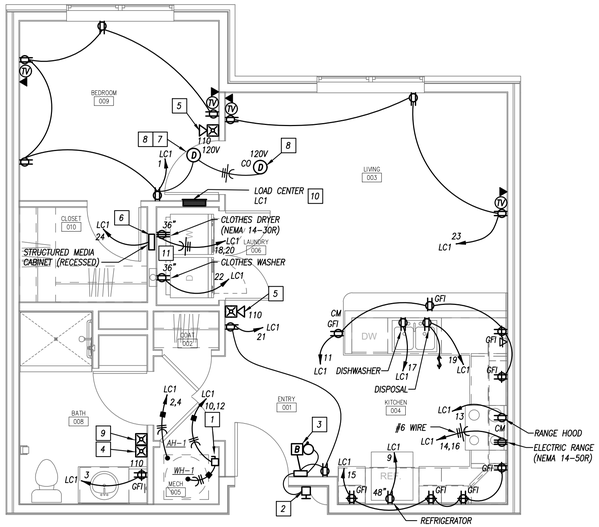

TYPE B - ONE BEDROOM
TYPICAL UNIT FLOOR PLAN - POWER

1/4" = 1'-0"

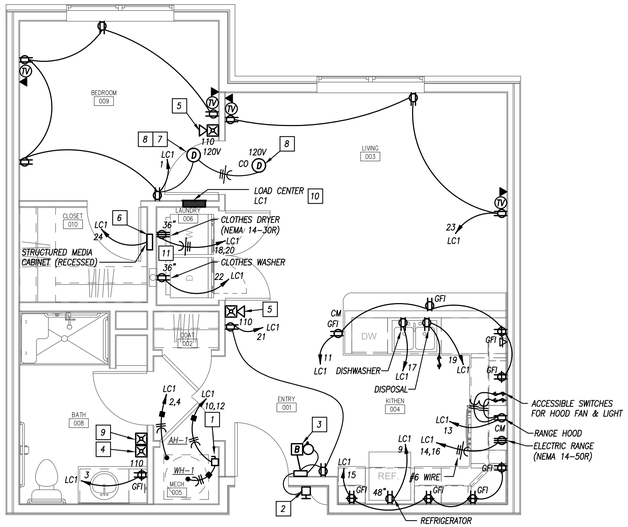

TYPE A - ONE BEDROOM
TYPICAL UNIT FLOOR PLAN - POWER

1/4" = 1'-0"

GENERAL POWER NOTES

1. REFER TO GENERAL NOTES ON MEP COVER SHEET FOR ADDITIONAL REQUIREMENTS OF WORK.
2. COORDINATE EXACT NEMA CONFIGURATIONS OF RECEPTACLES SERVING EQUIPMENT WITH EXACT EQUIPMENT BEING FURNISHED.
3. EXACT MECHANICAL EQUIPMENT LOCATIONS MAY NOT BE SHOWN FOR CLARITY. COORDINATE EXACT LOCATIONS OF ALL MECHANICAL EQUIPMENT, DUCT DETECTORS, ETC. WITH MECHANICAL DRAWINGS AND CONTRACTOR.
4. COORDINATE EXACT LOCATIONS OF SMOKE DETECTORS WITH CEILING FANS, HVAC DIFFUSERS, SPRINKLER HEADS, ETC. PER NFPA REQUIREMENTS.

POWER PLAN KEYED NOTES

1. 30 AMP, 2-POLE, NON-FUSED DISCONNECT SWITCH IN NEMA 1 ENCLOSURE. MOUNT AT UNIT WITH ADEQUATE CLEARANCES.
2. DOORBELL AND DOORBELL POWER SUPPLY. HEATH-ZENITH 57/M SERIES OR SIMILAR HARD-WIRED DOORBELL AND CHIME.
3. FOR HEARING/VISUALLY-IMPAIRED UNIT(S) ONLY, PROVIDE DOORBELL SIGNALER WITH INTEGRAL STROBE AND CHIME IN LIEU OF CHIME ONLY.
4. PROVIDE DEVICE IN HEARING AND VISUALLY IMPAIRED UNIT ONLY. PROVIDE ROUGH-IN AND WIRING FOR FUTURE DEVICE IN ALL OTHER LIVING UNITS.
5. PROVIDE 110cd HORN/STROBE IN HEARING AND VISUALLY-IMPAIRED LIVING UNITS. PROVIDE MINI-HORN IN ALL OTHER UNITS.
6. RECESSED STRUCTURED MEDIA CABINET. MOUNT HIGH ON WALL.
7. COMBINATION SMOKE ALARM AND CARBON MONOXIDE DETECTOR.
8. PROVIDE MULTI-STATION 120 VOLT SMOKE ALARM WITH BATTERY BACK-UP IN NON-HEARING IMPAIRED UNITS. PROVIDE MULTI-STATION 120V SMOKE ALARM WITH 177 CANDELA INTEGRAL VISUAL ALARM AND BATTERY BACK-UP IN HEARING IMPAIRED UNITS. REFER TO ARCHITECTURAL PLANS FOR UNIT TYPES.
9. PROVIDE 120 VOLT 110 CANDELA STROBE IN HEARING IMPAIRED UNITS ONLY. WIRE TO SMOKE DETECTORS IN UNIT. REFER TO ARCHITECTURAL PLANS FOR UNIT TYPES.
10. INSTALL LOAD CENTER SUCH THAT TOP BREAKER IS AT 48" AFF.
11. WASHER AND DRYER SHALL ALWAYS BE ORIENTED WITH WASHER ON LEFT AND DRYER ON RIGHT.

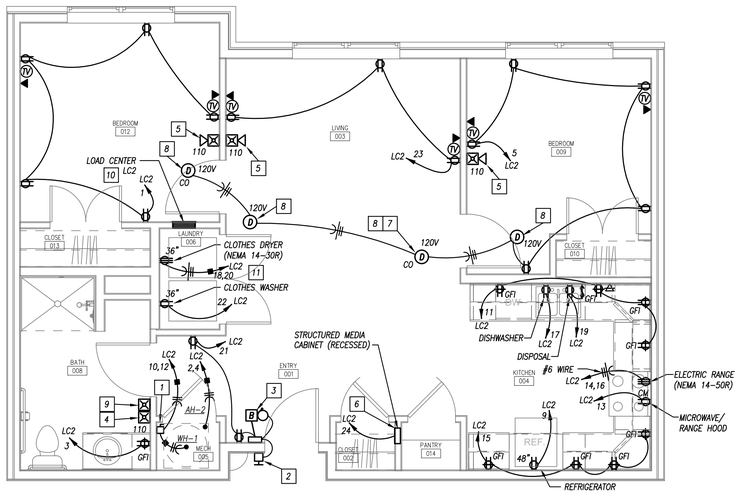

TYPE B - TWO BEDROOM
TYPICAL UNIT FLOOR PLAN - POWER

1/4" = 1'-0"

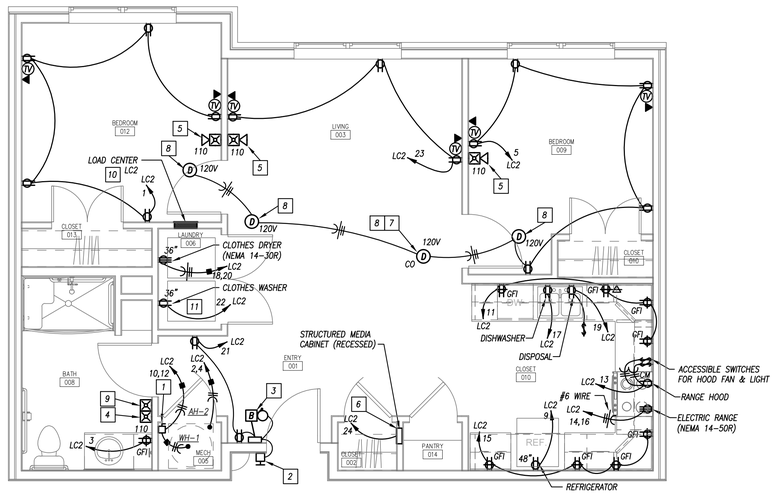

TYPE A - TWO BEDROOM
TYPICAL UNIT FLOOR PLAN - POWER

1/4" = 1'-0"

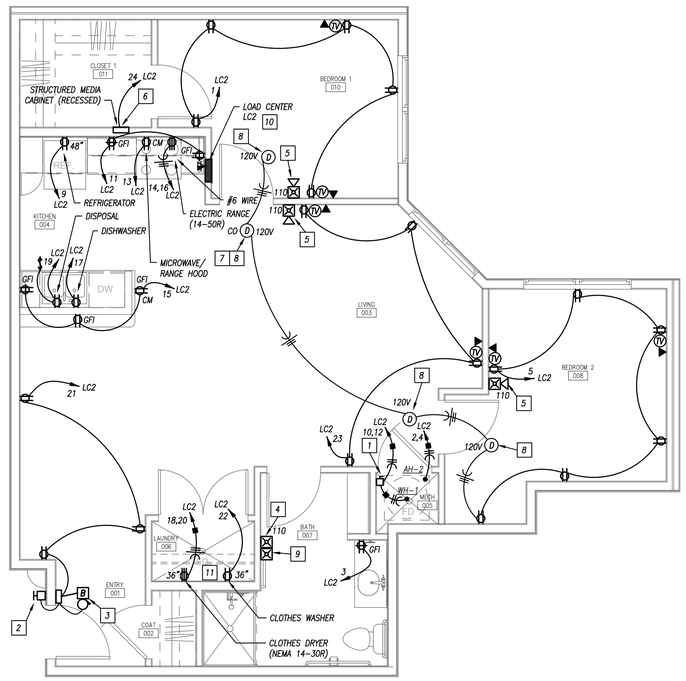

TYPE B - TWO BEDROOM - (CORNER)
TYPICAL UNIT FLOOR PLAN - POWER

1/4" = 1'-0"

PRINTS ISSUED
10/30/2023 - PERMIT SUBMITTAL

REVISIONS:

23.161

pkmr ENGINEERS
PEARSON KENT MCKINLEY RAAF ENGINEERS LLC
13300 W 98TH STREET LENEXA, KS 66215
913.492.2400 WWW.PKMRENG.COM
MO State Certificate of Authority #E-2002020886

STATE OF MISSOURI
MICHAEL D RAAF
NUMBER PE-2005028097
REGISTERED PROFESSIONAL ENGINEER
10/30/23
Michael D. Raaf - Engineer
MO# PE-2005028097

WILSHIRE HILLS III

LEE'S SUMMIT, MISSOURI

SHEET TITLE
ENLARGED UNIT PLANS - POWER

PROJECT NUMBER: 23.161

SHEET NUMBER:

E211

Optional Method Load Calculation for Multi-Family Dwellings

EQUIPMENT DESIGNATION: MC-W | **SERVICE/BUILDING/AREA:** SERVICE #1 | **VOLTAGE:** 208V | **PHASE/WIRE:** 3PH/4W | **# OF UNITS:** 24

1 *General Lighting and Receptacle Loads 220.84(C)(1)* — Do not include open porches, garages, and unused or unfinished spaces not adaptable for future use.	3 x 18,270 (total sq. ft. of all units)	=	1	54,810
2 *Small Appliance Branch–Circuits 220.84(C)(2)*	1,500 x 2 (avg. # per unit) x 24 (number of units)	=	2	72,000
3 *Laundry Branch Circuit 220.84(C)(2)*	1,500 x 1 (avg. # per unit) x 24 (number of units)	=	3	36,000
4 through 11 *Appliances and Motors 220.84(C)(3) and (4)* — Use the nameplate rating of ALL appliances (fastened–in place, permanently connected, or connected to a specific circuit), ranges, wall–mounted ovens, counter–mounted cooking units, motors, water heaters, and clothes dryers. Number of units indicates only those units containing the respective appliance. Load values for appliances are the average value per unit for the building or area.	Microwave / 1,200 (volt–amperes each) x 24 (number)	=	4	28,800
	Dishwasher / 1,000 (volt–amperes each) x 24 (number)	=	5	24,000
	Disposal / 800 (volt–amperes each) x 24 (number)	=	6	19,200
	Water Heater / 4,500 (volt–amperes each) x 24 (number)	=	7	108,000
	Electric Range / 10,000 (volt–amperes each) x 24 (number)	=	8	240,000
	Clothes Dryer / 5,000 (volt–amperes each) x 24 (number)	=	9	120,000
	– / – (volt–amperes each) x (number)	=	10	0
11 *Heating or Air–Conditioning System (Compare the heat and A/C, and omit the smaller.) 220.84(C)(5)* — Include the air handler when using either one. For heat pumps, include the compressor and the maximum amount of electric heat that can be energized while the compressor is installed.			11	187,027
12 *Total Volt–Ampere Demand Load:* — Multiply total VA by Table 220.84 demand factor percent.	889,837 (total volt–amperes from lines 1 through 11) x 35% (Table 220.84)	=	12	311,443
13 *House Load 220.84(B) (If present, other wise skip to line 14)* — Compute in accordance with Article 220, Part III. Do not include in Table 220.84 Demand Factors.			13	0
14 *Total Volt–Ampere Demand Load:* Add lines 12 and 13 to find the minimum required volt–amperes.			14	311,443
15 *Minimum Amperes* — Divide the total volt–amperes by the voltage	311,443 (line x) / 208√3 (voltage)	=	15	864 (minimum amperes)
16 Minimum Size Service and/or Feeder (240.6(A))			16	1,000

Optional Method Load Calculation for Multi-Family Dwellings

EQUIPMENT DESIGNATION: MC-E | **SERVICE/BUILDING/AREA:** SERVICE #2 | **VOLTAGE:** 208V | **PHASE/WIRE:** 3PH/4W | **# OF UNITS:** 26

1 *General Lighting and Receptacle Loads 220.84(C)(1)* — Do not include open porches, garages, and unused or unfinished spaces not adaptable for future use.	3 x 20,140 (total sq. ft. of all units)	=	1	60,420
2 *Small Appliance Branch–Circuits 220.84(C)(2)*	1,500 x 2 (avg. # per unit) x 26 (number of units)	=	2	78,000
3 *Laundry Branch Circuit 220.84(C)(2)*	1,500 x 1 (avg. # per unit) x 26 (number of units)	=	3	39,000
4 through 11 *Appliances and Motors 220.84(C)(3) and (4)* — Use the nameplate rating of ALL appliances (fastened–in place, permanently connected, or connected to a specific circuit), ranges, wall–mounted ovens, counter–mounted cooking units, motors, water heaters, and clothes dryers. Number of units indicates only those units containing the respective appliance. Load values for appliances are the average value per unit for the building or area.	Microwave / 1,200 (volt–amperes each) x 26 (number)	=	4	31,200
	Dishwasher / 1,000 (volt–amperes each) x 26 (number)	=	5	26,000
	Disposal / 800 (volt–amperes each) x 26 (number)	=	6	20,800
	Water Heater / 4,500 (volt–amperes each) x 26 (number)	=	7	117,000
	Electric Range / 10,000 (volt–amperes each) x 26 (number)	=	8	260,000
	Clothes Dryer / 5,000 (volt–amperes each) x 26 (number)	=	9	130,000
	– / – (volt–amperes each) x (number)	=	10	0
11 *Heating or Air–Conditioning System (Compare the heat and A/C, and omit the smaller.) 220.84(C)(5)* — Include the air handler when using either one. For heat pumps, include the compressor and the maximum amount of electric heat that can be energized while the compressor is installed.			11	205,066
12 *Total Volt–Ampere Demand Load:* — Multiply total VA by Table 220.84 demand factor percent.	967,486 (total volt–amperes from lines 1 through 11) x 34% (Table 220.84)	=	12	328,945
13 *House Load 220.84(B) (If present, other wise skip to line 14)* — Compute in accordance with Article 220, Part III. Do not include in Table 220.84 Demand Factors.			13	0
14 *Total Volt–Ampere Demand Load:* Add lines 12 and 13 to find the minimum required volt–amperes.			14	328,945
15 *Minimum Amperes* — Divide the total volt–amperes by the voltage	328,945 (line x) / 208√3 (voltage)	=	15	913 (minimum amperes)
16 Minimum Size Service and/or Feeder (240.6(A))			16	1,000

METER CENTER SCHEDULE

PLAN MARK	SERVICE	MANUFACTURER	VOLTAGE	MAIN SERVICE MODULE			METER STACKS			# OF METER STACKS				NOTES
				MODEL	LOAD (A)	RATING (A)	MODEL	METER SIZE	BUS RATING	2 METERS	3 METERS	4 METERS	5 METERS	
MC–W	SERVICE #1	CUTLER–HAMMER	208V	3MCB	864	1,000	1MM	125 AMPS	800 AMPS	–	–	6	–	1,2,3,4
MC–E	SERVICE #2	CUTLER–HAMMER	208V	3MCB	913	1,000	1MM	125 AMPS	800 AMPS	1	–	6	–	1,2,3,5

REMARKS:
1. NEMA 3R ENCLOSURE, COPPER BUS.
2. EACH UNIT METER MODULE TO HAVE 125A MAIN CIRCUIT BREAKER.
3. REFER TO LOAD CALCULATIONS THIS SHEET FOR SIZING OF EQUIPMENT.
4. DWELLING UNIT LOAD CENTERS ON NORTH PART OF BUILDING TO BE FED FROM THIS METER CENTER. (TOTAL OF 24).
5. DWELLING UNIT LOAD CENTERS ON SOUTH PART OF BUILDING TO BE FED FROM THIS METER CENTER. (TOTAL OF 26).

EQUIPMENT FEEDER SCHEDULE

FEEDER NO.	EQUIPMENT	LOAD (AMPS)	FEEDER					CONDUIT SIZE
			SETS	# OF WIRES	SIZE	GROUND	MATERIAL	
FH1	*HOUSE SERVICE DISCONNECT*	450.7	2	4	250 MCM	–	COPPER	2–1/2"
FH2	*DISTRIBUTION PANELBOARD MDP1*	450.7	2	4	250 MCM	#2	COPPER	2–1/2"
FW1	*METER CENTER MC–W*	864.5	3	4	400 MCM	–	COPPER	3"
FW2	*TYPICAL LOAD CENTER*	110.5	1	3	#2/0	#4	ALUMINUM	2"
FE1	*METER CENTER MC–E*	913.1	3	4	400 MCM	–	COPPER	3"
FE2	*TYPICAL LOAD CENTER*	110.5	1	3	#2/0	#4	ALUMINUM	2"

EQUIPMENT FAULT CURRENT RATING SCHEDULE

EQUIPMENT	SCA **	SCCR	NOTES
HOUSE SERVICE DISCONNECT	45,106	65,000	1
DISTRIBUTION PANELBOARD MDP1	38,522	42,000	1
PANELBOARD P1	32,654	35,000	1,2
PANELBOARD S1	1,882	10,000	1,2
PANELBOARD P2	34,819	35,000	1,2
METER CENTER MC–W	55,391	65,000	1
METER CENTER MC–E	55,391	65,000	1
TYP. LOAD CENTER < 60' FEEDER	10,169	22,000	1,2
TYP. LOAD CENTER > 60' FEEDER	9,521	10,000	1
ELEVATOR #1	15,662	22,000	1

NOTES:
1. RATING BASED ON AN ASSUMED FAULT AT UTILITY CO. TRANSFORMER OF 75,022A.
2. EQUIPMENT MAY BE SERIES RATED.
** CALCULATIONS PERFORMED USING BUSSMANN POINT–TO–POINT METHOD.

LOAD CENTER FEEDER ALTERNATE:
WHERE ALLOWABLE AND USE PERMITTED THE LOAD CENTER FEEDERS MAY BE ALUMINUM SER CABLE, 3–CONDUCTOR #2/0 WIRE WITH GROUND. INSTALLATION SHALL MEET ALL REQUIREMENTS OF NEC ARTICLE 338. FEEDERS TO BE INCREASED PROPORTIONAL FOR VOLTAGE DROP AS DESCRIBED BELOW.

VOLTAGE DROP

FEEDERS TO LOAD CENTERS SHALL BE ADJUSTED AS LISTED BELOW FOR GIVEN LENGTHS OF FEEDER RUNS:

FEEDER < 250' = (3)#2/0 AL WIRE WITH #4 GROUND

FEEDER > 250' = (3)#3/0 AL WIRE WITH #4 GROUND AND FURNISH LOAD CENTER RATED AT 150A TO ACCOMMODATE LUGS FOR #3/0 WIRE.

RISER DIAGRAM KEYED NOTES

1. *TRANSFORMER PAD BY CIVIL. RE: CIVIL PLANS.*
2. *(1)#2/0 GROUNDING ELECTRODE CONDUCTOR IN 1" CONDUIT.*
3. *(1)#3/0 GROUNDING ELECTRODE CONDUCTOR IN 1" CONDUIT.*
4. *INSTALL ON SCREEN WALL PER UTILITY COMPANY STANDARDS.*
5. *500 AMP, 3–POLE, CIRCUIT BREAKER DISCONNECT IN NEMA 3R ENCLOSURE WITH EXTERNALLY OPERABLE HANDLE. BREAKER SHALL BE SUITABLE FOR SERVICE ENTRANCE EQUIPMENT AND FURNISHED WITH GROUND BUS.*
6. *(1)#3/0 BONDING JUMPER IN 1" CONDUIT.*
7. *PROVIDE PERMANENT LABEL WITH AVAILABLE FAULT CURRENT FROM UTILITY CO. RE: SPECIFICATIONS FOR LABELING REQUIREMENTS.*
8. *(1)#8 GROUNDING ELECTRODE CONDUCTOR IN 1/2" CONDUIT.*

ELEVATION OF SERVICE ENTRANCE EQUIPMENT

REFER TO SITE AND POWER PLANS FOR EXACT LOCATION

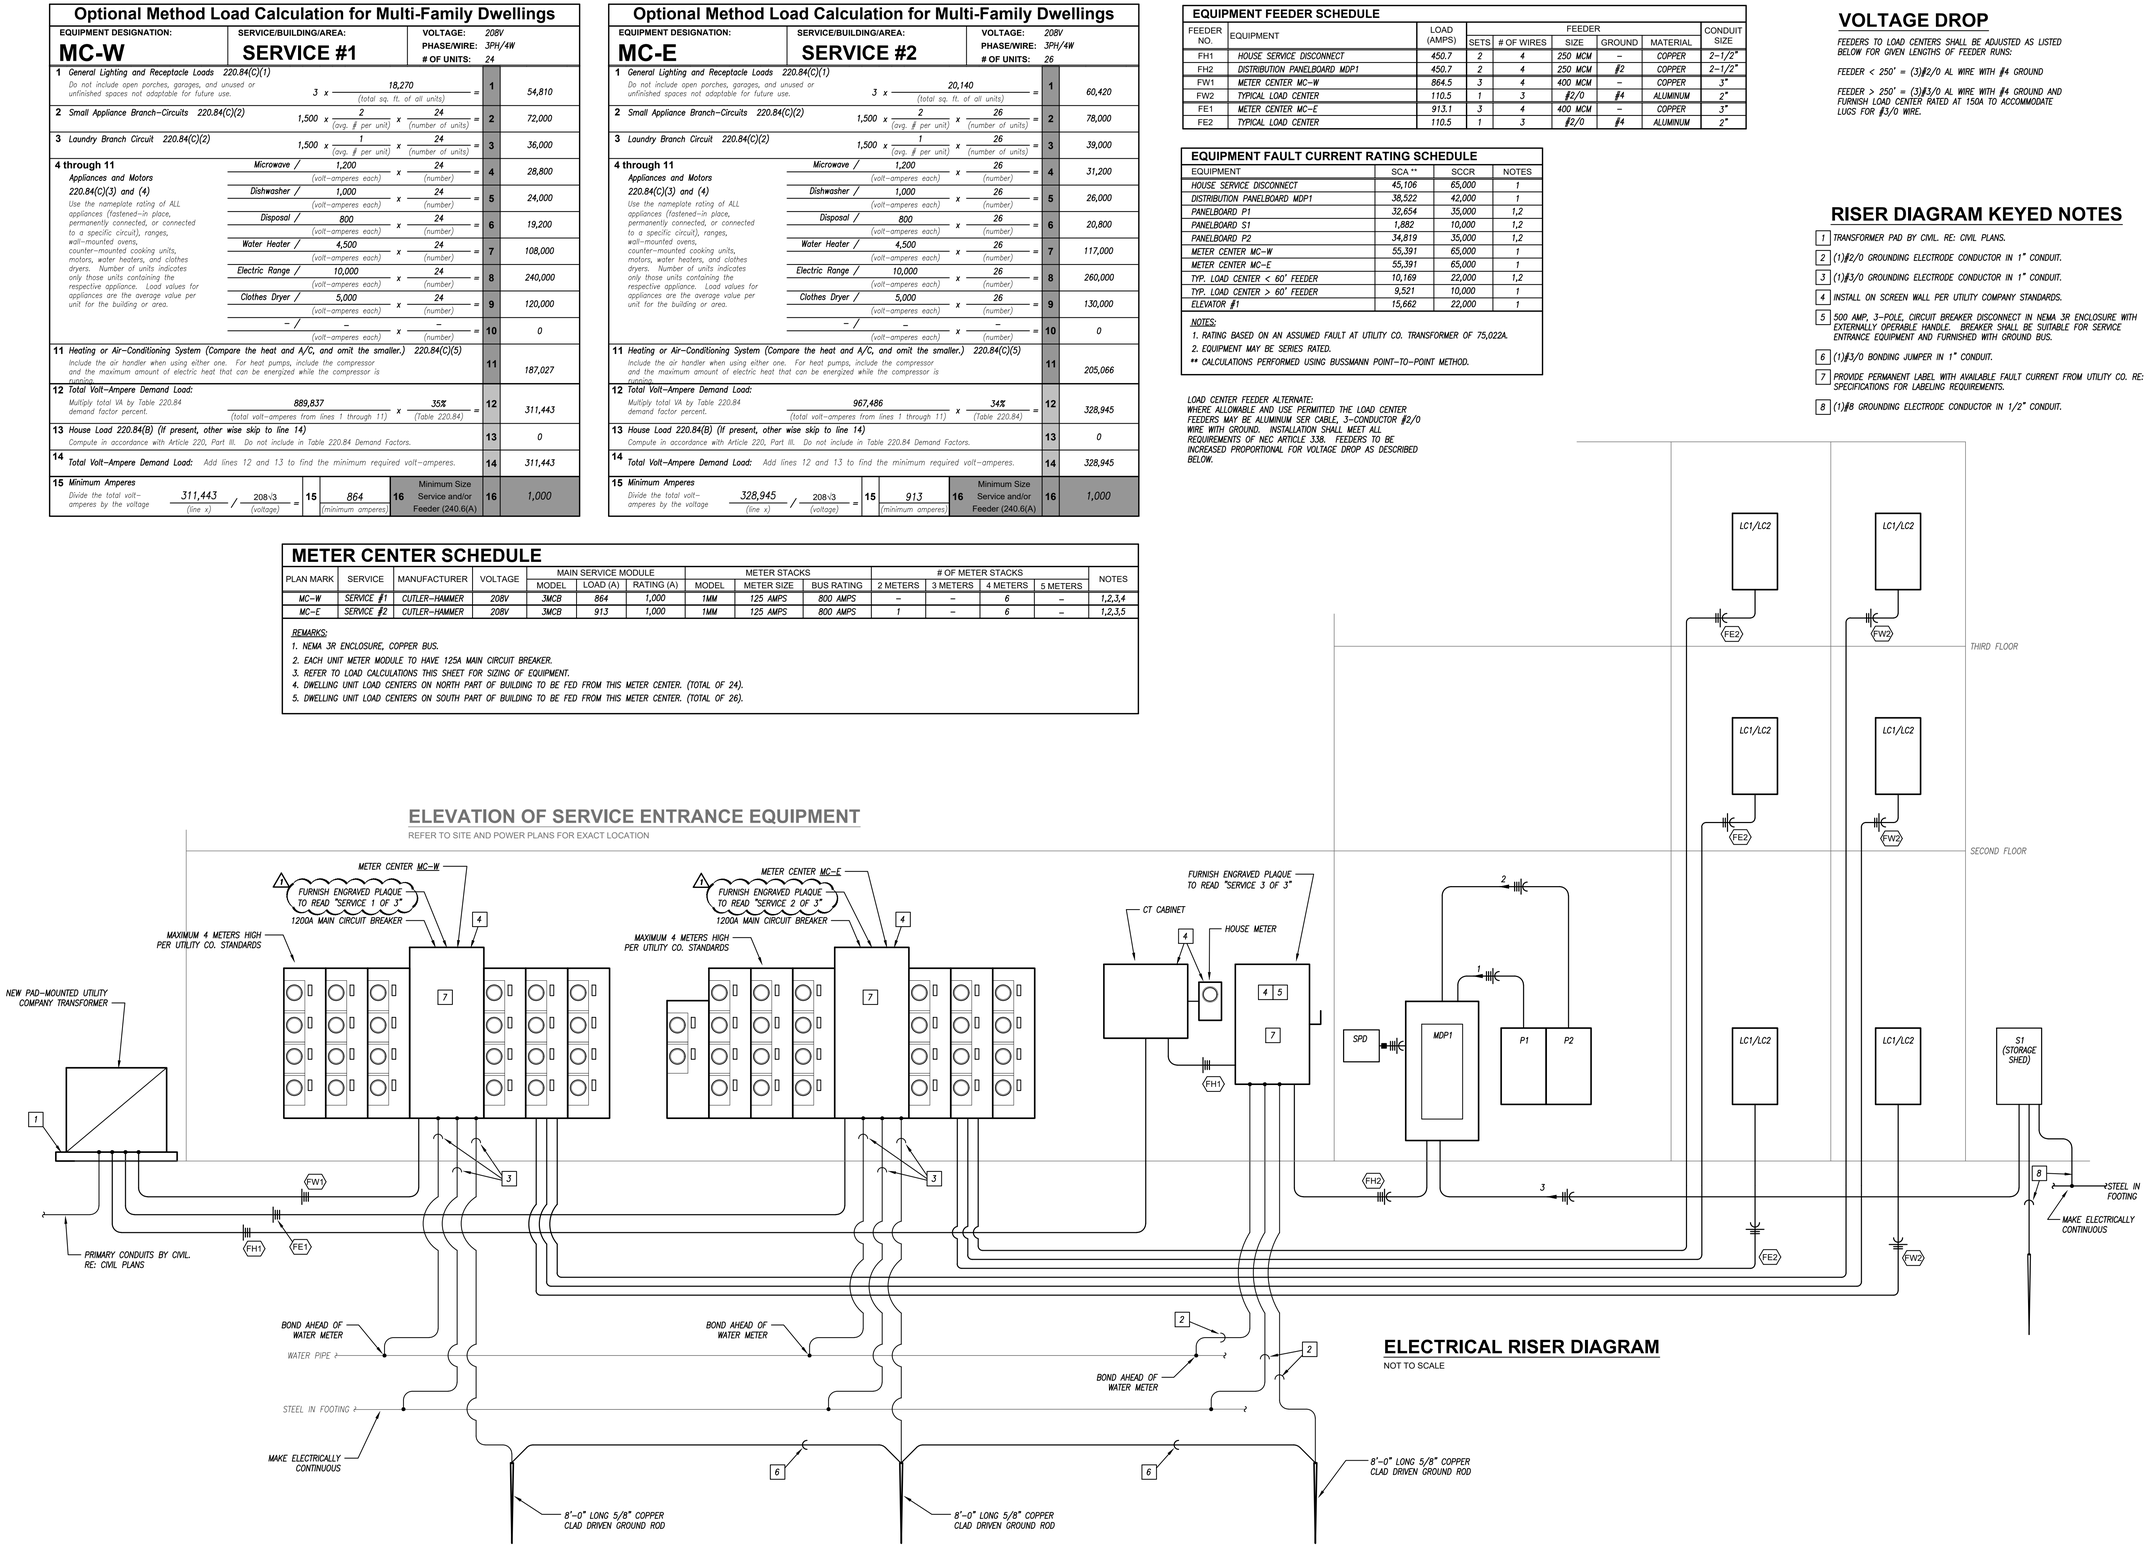

ELECTRICAL RISER DIAGRAM

NOT TO SCALE

PRINTS ISSUED
10/30/2023 - PERMIT SUBMITTAL

REVISIONS:
1 12/15/2023 - CITY COMMENTS

pkmr ENGINEERS
PEARSON KENT MCKINLEY RAAF ENGINEERS LLC
13300 W 98TH STREET LENEXA, KS 66215
913.492.2400 WWW.PKMRENG.COM
MO State Certificate of Authority #E-2002020886

23.161

STATE OF MISSOURI
MICHAEL D RAAF
NUMBER PE-2005028097
REGISTERED PROFESSIONAL ENGINEER
12/15/23
Michael D. Raaf - Engineer
MO# PE-2005028097

WILSHIRE HILLS III

LEE'S SUMMIT, MISSOURI

SHEET TITLE
ELECTRICAL RISER DIAGRAM

PROJECT NUMBER: 23.161

SHEET NUMBER:

E301

DISTRIBUTION PANELBOARD SCHEDULE

PANEL DESIGNATION: **MDP1** | MAIN BUS AMPS: *600* | MAIN BREAKER AMPS: *M.L.O.* | VOLTAGE: *208/120* | PHASE/WIRE: *3Ø, 4W* | MOUNTING: *FLOOR* | LOCATION: *SPRINKLER 1003*

CIRCUIT NO.	CIRCUIT DESIGNATION	KVA	CIRCUIT BREAKER			FEEDER				
			POLE	FRAME	TRIP	SETS	# OF WIRES	SIZE	GROUND	CONDUIT
1	*PANELBOARD P1*	*43.0*	*3*	*200*	*175*	*1*	*4*	*#2/0*	*#6*	*2"*
2	*PANELBOARD P2*	*64.0*	*3*	*200*	*200*	*1*	*4*	*#3/0*	*#6*	*2"*
3	*PANELBOARD S1*	*6.2*	*2*	*100*	*60*	*1*	*2*	*#4*	*#10*	*1"*
4	*ELEVATOR*	*43.2*	*3*	*400*	*250*	*1*	*3*	*250 MCM*	*250 MCM*	*2-1/2"*
5	*WATER HEATER WH-2*	*4.5*	*2*	*100*	*30*	*1*	*2*	*#10*	*#10*	*1/2"*
6	*WATER HEATER WH-2*	*4.5*	*2*	*100*	*30*	*1*	*2*	*#10*	*#10*	*1/2"*
7	*AIR HANDLING UNIT AH-3*	*8.0*	*2*	*100*	*45*	*1*	*2*	*#6*	*#10*	*3/4"*
8	*AIR HANDLING UNIT AH-4*	*10.0*	*2*	*100*	*50*	*1*	*2*	*#6*	*#10*	*3/4"*
9	*HEAT PUMP HP-3*	*2.7*	*2*	*200*	*25*	*1*	*2*	*#10*	*#10*	*1/2"*
10	*HEAT PUMP HP-4*	*3.3*	*2*	*200*	*30*	*1*	*2*	*#10*	*#10*	*1/2"*
11	*EXTERNAL SURGE SUPPRESSION*	*0.0*	*3*	*100*	*30*	*1*	*3*	*#10*	*#10*	*1/2"*
12	*PREPARED SPACE*	*0.0*	–	*200*	–	–	–	–	–	–
13	*PREPARED SPACE*	*0.0*	–	*200*	–	–	–	–	–	–
14	*PREPARED SPACE*	*0.0*	–	*100*	–	–	–	–	–	–
15	*PREPARED SPACE*	*0.0*	–	*100*	–	–	–	–	–	–

PANELBOARD SIZING LOAD			
LOAD DESCRIPTION	CONNECTED LOAD	DEMAND FACTOR	CODE MIN. (VA)
LIGHTS	*12,409*	*1.25*	*15,512*
RECEPTACLES	*29,080*	*10KVA + 50% REST*	*19,540*
MOTORS	*48,278*	*1.25 x LARGEST + SUM OF REST*	*59,086*
AIR CONDITIONING	*21,674*	*0.00*	*0*
SPACE HEATING	*39,180*	*1.00*	*39,180*
HEAT PUMP	*6,065*	*0.00*	*0*
CONTINUOUS	*9,000*	*1.25*	*11,250*
KITCHEN EQUIPMENT	*0*	*1.00*	*0*
NON-CONTINUOUS	*26,664*	*1.00*	*26,664*
TOTAL CONNECTED LOAD (VA):	192,351	SIZING LOAD (VA):	171,232
TOTAL CONNECTED LOAD (AMPS):	533.9	SIZING LOAD (AMPS):	475.3

REMARKS:
1. *CUTLER HAMMER POW-R-LINE 4B PANELBOARD OR EQUAL.*
2. *42" WIDE, SINGLE SECTION PANELBOARD.*
3. *FURNISH PANELBOARD WITH EXTERNAL SURGE PROTECTION DEVICE.*

PANELBOARD BREAKER KEYED NOTES

G *FURNISH GFCI-PROTECTED BREAKER.*

FA *BREAKER SHALL BE PAINTED OR FURNISHED RED AND PROVIDED WITH A LOCK-ON DEVICE.*

SINGLE-PHASE PANELBOARD SCHEDULE

PANEL DESIGNATION: **S1** | MAIN LUG AMPS: *125* | MAIN BREAKER: *60* | VOLTAGE: *208/120* | PHASE/WIRE: *1Ø, 3W* | MOUNTING: *SURFACE* | LOCATION: *MAINT. SHED*

DESCRIPTION	PHASE A	PHASE B	C/B TRIP	C/B POLE	CIRCUIT #		C/B POLE	C/B TRIP	PHASE A	PHASE B	DESCRIPTION
LTS: SHED	*302*		*20*	*1*	*1*	*2*	*2*	*30*	*2500*		*ELECTRIC HEATER UH-3*
RECEPT: SHED		*180*	*20*	*1*	*3*	*4*				*2500*	
RECEPT: SHED	*180*		*20*	*1*	*5*	*6*	*1*	*20*	–		*SPARE*
RECEPT: OVERHEAD DOOR		*500*	*20*	*1*	*7*	*8*	*1*	*20*		–	*SPARE*
SPARE	–		*20*	*1*	*9*	*10*	*1*	*20*	–		*SPARE*
SPARE		–	*20*	*1*	*11*	*12*	*1*	*20*		–	*SPARE*
SPACE	–		–	*1*	*13*	*14*	*1*	–	–		*SPACE*
SPACE		–	–	*1*	*15*	*16*	*1*	–		–	*SPACE*
SPACE	–		–	*1*	*17*	*18*	*1*	–	–		*SPACE*
TOTALS	*482*	*680*							*2500*	*2500*	TOTALS

PANELBOARD SIZING LOAD			
LOAD DESCRIPTION	CONNECTED	DEMAND	CODE MIN. (VA)
LIGHTS	*302*	*1.25*	*378*
RECEPTACLES	*860*	*10KVA + 50% REST*	*860*
MOTORS	*0*	*1.25 x LARGEST + SUM OF REST*	*0*
AIR CONDITIONING	*0*	*0.00*	*0*
SPACE HEATING	*5,000*	*1.00*	*5,000*
HEAT PUMP	*0*	*1.00*	*0*
CONTINUOUS	*0*	*1.25*	*0*
KITCHEN EQUIPMENT	*0*	*1.00*	*0*
NON-CONTINUOUS	*0*	*1.00*	*0*
SIZING LOAD:			6,238
SIZING LOAD (AMPS):			30

CONNECTED PHASE LOADS		
PH.	VA	AMPS
A	*2,982*	*24.9*
B	*3,180*	*26.5*
TTL.	6,162	29.6

REMARKS:
1. *CUTLER HAMMER POW-R-LINE 1A OR EQUAL.*

SINGLE-SECTION PANELBOARD SCHEDULE

PANEL DESIGNATION: **P1** | MAIN LUG AMPS: *225* | MAIN BREAKER: *M.L.O.* | VOLTAGE: *208/120* | PHASE/WIRE: *3Ø, 4W* | SCCR RATING (AIC): *35,000* | MOUNTING: *SURFACE* | LOCATION: *SPRINKLER 1003*

DESCRIPTION	PHASE A	PHASE B	PHASE C	C/B TRIP	C/B POLE	CIRCUIT #		C/B POLE	C/B TRIP	PHASE A	PHASE B	PHASE C	DESCRIPTION	
LTG: SPRINKLER, OFFICE	*220*			*20*	*1*	*1*	*2*	*1*	*20*	*1080*			*REC: SPRINKLER 1005*	
LTG: LOBBY CHANDELIERS		*1000*		*20*	*1*	*3*	*4*	*1*	*20*		*360*		*REC: TELECOM. BACKBOARD*	
LTG: COMMUNITY			*836*	*20*	*1*	*5*	*6*	*1*	*20*			*360*	*REC: TELECOM. BACKBOARD*	
LTG: EM/NL CORR C1 1F	*402*			*20*	*1*	*7*	*8*	*1*	*20*	*360*			*REC: TELECOM. BACKBOARD*	
LTG: EM/NL CORR C2 1F		*365*		*20*	*1*	*9*	*10*	*1*	*20*		*500*		*ACCESS CONTROL PANEL*	
LTG: CORRIDOR C1 1F			*421*	*20*	*1*	*11*	*12*	*1*	*20*			*500*	*BUILDING ENTRY SYSTEM*	
LTG: CORRIDOR C2 1F	*679*			*20*	*1*	*13*	*14*	*1*	*20*	*500*			*FIRE ALARM CONTROL PANEL*	FA
LTG: CORRIDOR C1 2F		*421*		*20*	*1*	*15*	*16*	*1*	*20*		*244*		*REC/LTG: ELEVATOR RM*	
LTG: CORRIDOR C2 2F			*591*	*20*	*1*	*17*	*18*	*1*	*20*			*500*	*ELEVATOR CONTROLLER*	
LTG: CORRIDOR C1 3F	*516*			*20*	*1*	*19*	*20*	*1*	*20*	*200*			*ELEVATOR CAB LTG*	
LTG: CORRIDOR C2 3F		*524*		*20*	*1*	*21*	*22*	*1*	*20*		*191*		*REC/LTG: ELEVATOR PIT*	
LTG: MONUMENT SIGN,FLAGPOLE			*100*	*20*	*1*	*23*	*24*	*1*	*20*			*1176*	*SUMP PUMP*	
LTG: EXT. CANOPY	*983*			*20*	*1*	*25*	*26*	*1*	*20*	*500*			*FIRE/SMOKE DAMPERS*	
LTG: EXT. WALL MOUNTED		*480*		*20*	*1*	*27*	*28*	*2*	*15*		*208*		*FAN COIL UNITS FC-1.1*	
LTG: EXT. BOLLARDS			*387*	*20*	*2*	*29*	*30*					*208*		
	387					*31*	*32*	*1*	*20*	*900*			*REC: LOBBY*	
LTG: PARKING LOT		*702*		*20*	*2*	*33*	*34*	*1*	*20*		*500*		*DOOR ACCESS SYSTEM*	
			702			*35*	*36*	*1*	*20*			*500*	*POWERED DOOR C1*	
ELEC HEAT UH-1; ENTRY	*2000*			*25*	*2*	*37*	*38*	*1*	*20*	*500*			*POWERED DOOR C2*	
		2000				*39*	*40*	*1*	*20*		*500*		*POWERED DOOR DINING*	
ELEC HEAT UH-1; STAIRS S1			*2000*	*25*	*2*	*41*	*42*	*1*	*20*			*1000*	*POWERED DOOR ENTRY*	
	2000					*43*	*44*	*1*	*20*	*1080*			*REC: CORRIDOR C1 1F*	
ELEC HEAT UH-1; STAIRS S2		*2000*		*25*	*2*	*45*	*46*	*1*	*20*		*1080*		*REC: CORRIDOR C2 1F*	
			2000			*47*	*48*	*1*	*20*			*1080*	*REC: EXTERIOR*	
ELEC HEAT UH-2; SPRINKLER	*2000*			*25*	*2*	*49*	*50*	*2*	*15*	*208*			*FAN COIL UNITS FC-1.2*	
		2000				*51*	*52*				*208*			
FIREPLACE			*180*	*15*	*1*	*53*	*54*	*1*	*20*			*720*	*REC: COMMUNITY*	
SPARE	–			*20*	*1*	*55*	*56*	*1*	*20*	*900*			*REC: COMMUNITY*	
SPARE		–		*20*	*1*	*57*	*58*	*1*	*20*		*720*		*REC: COMPUTER*	
SPARE			–	*20*	*1*	*59*	*60*	*1*	*20*			*360*	*REC: COMPUTER*	
SPARE	–			*20*	*1*	*61*	*62*	*1*	*20*	–			*SPARE*	
SPARE		–		*20*	*1*	*63*	*64*	*1*	*20*		–		*SPARE*	
SPARE			–	*20*	*1*	*65*	*66*	*1*	*20*			–	*SPARE*	
SPARE	–			*20*	*1*	*67*	*68*	*1*	*20*	–			*SPARE*	
SPARE		–		*20*	*1*	*69*	*70*	*1*	*20*		–		*SPARE*	
SPARE			–	*20*	*1*	*71*	*72*	*1*	*20*			–	*SPARE*	
SPACE	–			–	*1*	*79*	*80*	*1*	–	–			*SPACE*	
SPACE		–		–	*1*	*81*	*82*	*1*	–		–		*SPACE*	
SPACE			–	–	*1*	*83*	*84*	*1*	–			–	*SPACE*	
TOTALS	*9187*	*9492*	*7217*							*6228*	*4511*	*6404*	TOTALS	

PANELBOARD SIZING LOAD			
LOAD DESCRIPTION	CONNECTED	DEMAND	CODE MIN. (VA)
LIGHTS	*9,991*	*1.25*	*12,489*
RECEPTACLES	*9,360*	*10KVA + 50% REST*	*9,360*
MOTORS	*1,176*	*1.25 x LARGEST + SUM OF REST*	*1,470*
AIR CONDITIONING	*0*	*0.00*	*0*
SPACE HEATING	*16,180*	*1.00*	*16,180*
HEAT PUMP	*0*	*1.00*	*0*
CONTINUOUS	*0*	*1.25*	*0*
NON-CONTINUOUS	*6,332*	*1.00*	*6,332*
MISC. LOADS 1	*0*	*1.00*	*0*
SIZING LOAD:			45,831
SIZING LOAD (AMPS):			127

CONNECTED PHASE LOADS		
PHASE	VA	AMPS
A	*15,415*	*128.4*
B	*14,003*	*116.6*
C	*13,621*	*113.4*
TOTALS	43,039	119.5

REMARKS:
1. *CUTLER HAMMER POW-R-LINE 2A OR EQUAL.*
2. *FURNISH WITH INTEGRAL SURGE PROTECTION.*

SINGLE-SECTION PANELBOARD SCHEDULE

PANEL DESIGNATION: **P2** | MAIN LUG AMPS: *225* | MAIN BREAKER: *M.L.O.* | VOLTAGE: *208/120* | PHASE/WIRE: *3Ø, 4W* | MOUNTING: *SURFACE* | LOCATION: *SPRINKLER 1003*

	DESCRIPTION	PHASE A	PHASE B	PHASE C	C/B TRIP	C/B POLE	CIRCUIT #		C/B POLE	C/B TRIP	PHASE A	PHASE B	PHASE C	DESCRIPTION	
	SPARE	–			*20*	*1*	*1*	*2*	*1*	*20*	*500*			*FIRE/SMOKE DAMPERS 2F*	
	LTG: EM/NL CORR C1 2F		*240*		*20*	*1*	*3*	*4*	*1*	*20*		*500*		*FIRE/SMOKE DAMPERS 3F*	
	LTG: EM/NL CORR C2 2F			*294*	*20*	*1*	*5*	*6*	*1*	*20*			*500*	*FIRE EXTEND. CABINET 3F*	
	LTG: EM/NL CORR C1 3F	*254*			*20*	*1*	*7*	*8*	*1*	*20*	–			*SPARE*	
	LTG: EM/NL CORR C2 3F		*308*		*20*	*1*	*9*	*10*	*1*	*20*		*540*		*REC: MEETING*	
	LTG: MULTIPURPOSE			*579*	*20*	*1*	*11*	*12*	*1*	*20*			*540*	*REC: MEETING*	
	LTG: MEETING	*117*			*20*	*1*	*13*	*14*	*1*	*20*	*720*			*REC: OFFICE*	
	LTG: FITNESS		*324*		*20*	*1*	*15*	*16*	*1*	*20*		*360*		*REC: FILE*	
G	*REC: CORRIDOR C1 2F*			*900*	*20*	*1*	*17*	*18*	*1*	*20*			*500*	*REFRIGERATOR*	G
G	*REC: CORRIDOR C2 2F*	*1080*			*20*	*1*	*19*	*20*	*1*	*20*	*500*			*ICE MAKER*	G
G	*REC: CORRIDOR C1 3F*		*900*		*20*	*1*	*21*	*22*	*1*	*20*		*800*		*DISPOSAL*	G
G	*REC: CORRIDOR C2 3F*			*900*	*20*	*1*	*23*	*24*	*1*	*20*			*1000*	*DISHWASHER*	G
G	*ICE MAKER*	*500*			*20*	*1*	*25*	*26*	*1*	*20*	*540*			*REC: KITCHEN CENTER*	
G	*DISPOSAL*		*800*		*20*	*1*	*27*	*28*	*2*	*50*		*4500*		*ELECTRIC RANGE*	
G	*DISHWASHER*			*1000*	*20*	*1*	*29*	*30*					*4500*		
	REC: KITCHEN CENTER	*720*			*20*	*1*	*31*	*32*	*1*	*15*	*500*			*RANGE HOOD*	
	ELECTRIC RANGE		*4500*		*50*	*2*	*33*	*34*	*1*	*20*		*360*		*REC: KITCHEN CENTER*	
				4500			*35*	*36*	*1*	*20*			*1000*	*MICROWAVE*	
	RANGE HOOD	*500*			*15*	*1*	*37*	*38*	*1*	*20*	*720*			*REC: FITNESS*	
G	*REFRIGERATOR*		*500*		*20*	*1*	*39*	*40*	*1*	*20*		*1000*		*REC: FITNESS EQUIPMENT*	
	CONDENSING UNIT CU-1	*894*			*15*	*2*	*41*	*42*	*1*	*20*			*1000*	*REC: FITNESS EQUIPMENT*	
				894			*43*	*44*	*1*	*20*	*180*			*WATER COOLER*	G
	MHP-1		*2486*		*25*	*2*	*45*	*46*	*1*	*20*		*540*		*REC: MULTIPURPOSE*	
				2486			*47*	*48*	*1*	*20*			*540*	*REC: MULTIPURPOSE*	
	MHP-1	*2486*			*25*	*2*	*49*	*50*	*1*	*20*	*360*			*REC: RADON FANS*	
			2486				*51*	*52*	*1*	*20*		*360*		*REC: RADON FANS*	
	MHP-2			*2486*	*25*	*2*	*53*	*54*	*2*	*15*			*208*	*FAN COIL UNITS FC-2.1,2.2*	
		2486					*55*	*56*			*208*				
	MHP-3		*2486*		*25*	*2*	*57*	*58*	*2*	*15*		*208*		*FAN COIL UNITS FC-3.1,3.2*	
				2486			*59*	*60*					*208*		
	SPARE	–			*20*	*1*	*61*	*62*	*1*	*20*	–			*SPARE*	
	SPARE		–		*20*	*1*	*63*	*64*	*1*	*20*		–		*SPARE*	
	SPARE			–	*20*	*1*	*65*	*66*	*1*	*20*			–	*SPARE*	
	SPARE	–			*20*	*1*	*67*	*68*	*1*	*20*	–			*SPARE*	
	SPARE		–		*20*	*1*	*69*	*70*	*1*	*20*		–		*SPARE*	
	SPARE			–	*20*	*1*	*71*	*72*	*1*	*20*			–	*SPARE*	
	SPACE	–			–	*1*	*79*	*80*	*1*	–	–			*SPACE*	
	SPACE		–		–	*1*	*81*	*82*	*1*	–		–		*SPACE*	
	SPACE			–	–	*1*	*83*	*84*	*1*	–			–	*SPACE*	
	TOTALS	*9037*	*15029*	*16524*							*4228*	*9168*	*9996*	TOTALS	

PANELBOARD SIZING LOAD			
LOAD DESCRIPTION	CONNECTED	DEMAND	CODE MIN. (VA)
LIGHTS	*2,116*	*1.25*	*2,645*
RECEPTACLES	*18,860*	*10KVA + 50% REST*	*14,430*
MOTORS	*1,000*	*1.25 x LARGEST + SUM OF REST*	*1,125*
AIR CONDITIONING	*21,674*	*1.00*	*21,674*
SPACE HEATING	*0*	*0.00*	*0*
HEAT PUMP	*0*	*1.00*	*0*
CONTINUOUS	*0*	*1.25*	*0*
NON-CONTINUOUS	*20,332*	*1.00*	*20,332*
MISC. LOADS 1	*0*	*1.00*	*0*
SIZING LOAD:			60,206
SIZING LOAD (AMPS):			167

CONNECTED PHASE LOADS		
PHASE	VA	AMPS
A	*13,265*	*110.5*
B	*24,197*	*201.5*
C	*26,520*	*220.8*
TOTALS	63,982	177.6

REMARKS:
1. *CUTLER HAMMER POW-R-LINE 1A OR EQUAL.*
2. *FURNISH WITH INTEGRAL SURGE PROTECTION.*

PRINTS ISSUED
10/30/2023 - PERMIT SUBMITTAL

REVISIONS:

23.161

pkmr ENGINEERS
PEARSON KENT MCKINLEY RAAF ENGINEERS LLC
13300 W 98TH STREET LENEXA, KS 66215
913.492.2400 WWW.PKMRENG.COM
MO State Certificate of Authority #E-2002020886

STATE OF MISSOURI
MICHAEL D RAAF
NUMBER PE-2005028097
REGISTERED PROFESSIONAL ENGINEER
10/30/23
Michael D. Raaf - Engineer
MO# PE-2005028097

WILSHIRE HILLS III
LEE'S SUMMIT, MISSOURI

SHEET TITLE
ELECTRICAL SCHEDULES

PROJECT NUMBER: 23.161

SHEET NUMBER:

E302

LOAD CENTER SCHEDULE

LOAD CENTER DESIGNATION: **LC1**

MOUNTING: *RECESSED*
LOCATION: *LAUNDRY*

MAIN LUG AMPS: *125*
MAIN BREAKER *M.L.O*
VOLTAGE: *208/120V*
PHASE/WIRE: *1PH/3W*

	DESCRIPTION	C/B TRIP	C/B POLE	CIRCUIT NO.		C/B POLE	C/B TRIP	DESCRIPTION	
A	BEDROOM 1	15	1	1	2	2	30	AIR HANDLING UNIT AH-1	
	BATHROOM	20	1	3	4				
B	REFRIGERATOR	15	1	5	6	2	20	HEAT PUMP HP-1	
A	KITCHEN RECEPTACLES	20	1	7	8				
A	MICROWAVE/RANGE HOOD	20	1	9	10	2	30	WATER HEATER WH-1	
A	KITCHEN RECEPTACLES	20	1	11	12				
B	DISHWASHER	15	1	13	14	2	40	ELECTRIC RANGE	
B	DISPOSAL	15	1	15	16				
A	ENTRY/HALL/DINING/KITCH LTS	15	1	17	18	2	30	CLOTHES DRYER	
A	LIVING ROOM	15	1	19	20				
A	SPARE	15	1	21	22	1	20	CLOTHES WASHER	A
A	SPARE	15	1	23	24	1	15	STRUCTURED MEDIA CABINET	A
A	SPARE	20	1	25	26	1	–	SPACE	
A	SPARE	20	1	27	28	1	–	SPACE	
	SPACE	–	1	29	30	1	–	SPACE	

REMARKS:

1. *CUTLER HAMMER "CH" LOAD CENTER OR EQUAL.*
2. *THIS SCHEDULE TYPICAL FOR LOAD CENTERS IN 1 BEDROOM UNITS IN THE 3 STORY BUILDING.*

[A] *BREAKER SHALL BE ARC-FAULT PROTECTED.*

[B] *BREAKER SHALL BE COMBINATION ARC-FAULT / GFCI PROTECTED.*

Optional Method Load Calculation for One-Family Dwellings

UNIT DESIGNATION: **UNIT 1 BED**
LOAD CENTER DESIGNATION: **LC1**
VOLTAGE: *208/120V*
PHASE/WIRE: *1PH/3W*
TOTAL AREA: *660*

1 *General Lighting and Receptacle Loads 220.82(B)(1)*
Do not include open porches, garages, and unused or unfinished spaces not adaptable for future use.
3 x 660 (sq ft using outside dimensions) = **1** 1,980

2 *Small Appliance Branch-Circuits 220.82(B)(2)*
At least two small appliance branch-circuits must be included. 210.11(C)(1)
1,500 x 2 (minimum of two) = **2** 3,000

3 *Laundry Branch Circuit 220.82(B)(2)*
At least one laundry branch-circuit must be included. 210.11(C)(2)
1,500 x 1 (minimum of one) = **3** 1,500

4 *Appliances 220.82(B)(3) and (4)*
Use the nameplate rating of ALL appliances (fastened-in-place, permanently connected, or connected to a specific circuit), ranges, ovens, cook tops, motors, and clothes dryers.
Do not include any heating or air-conditioning equipment in this section

Electric Range / 10,000	Clothes Dryer / 5,000	
Microwave / 1,200	– / –	
Dishwasher / 1,000	– / –	Water Heater / 4,500
Disposal / 800	– / –	– / –

Total volt-amperes of all appliances LISTED BELOW = **4** 22,500

5 *Apply 220.82(B) demand factor to the total of lines 1 through 4*
28,980 (total of lines 1 through 4) – 10,000 = 18,980 x 40% = 7,592 + 10,000 = **5** 17,592

6 *Heating or Air-Conditioning System 220.82(C)* *Use the nameplate rating(s) in volt-amperes for all applicable systems in lines a through f.*

a) *100 percent of air-conditioning and cooling system(s)*
2,779 x 100% = **a)** 2,779

b) *100 percent of heat pump system(s), where the heat pump is used without any supplemental heating*
1,749 x 100% = **b)** 1,749

c) *100 percent of heat pump compressor(s) and 65 percent of the supplemental electric heating, where both can operate at the same time.*
1,749 x 100% + 5,000 x 65% = **c)** –

d) *Electric space-heating equipment, if less than four seperately controlled units:*
5,000 x 65% = **d)** 3,250

e) *Electric space-heating equipment, if four or more seperately controlled units:*
– x 40% = **e)** –

f) *Electric thermal storage and other heating systems where the usual load is expected to be continuous at full name plate value: Systems qualifying under this selection shall not be figured under any other selection in 220.82(C).*
– x 100% = **f)** –

7 *Total Volt-Ampere Demand Load:* 3,250 (largest VA rating from line 6a through 6e) + 17,592 (line 5) = **7** 20,842

8 *Minimum Amperes*
Divide the total volt-amperes by the voltage
20,842 (line 15) / 208 (voltage) = **8** 100 (minimum amperes) **9** Minimum Size Service and/or Feeder (240.6(A)) **9** 125

LOAD CENTER SCHEDULE

LOAD CENTER DESIGNATION: **LC2**

MOUNTING: *RECESSED*
LOCATION: *MECHANICAL*

MAIN LUG AMPS: *125*
MAIN BREAKER *M.L.O*
VOLTAGE: *208/120V*
PHASE/WIRE: *1PH/3W*

	DESCRIPTION	C/B TRIP	C/B POLE	CIRCUIT NO.		C/B POLE	C/B TRIP	DESCRIPTION	
A	BEDROOM 1	15	1	1	2	2	30	AIR HANDLING UNIT AH-2	
	BATHROOM	20	1	3	4				
A	BEDROOM 2	15	1	5	6	2	25	HEAT PUMP HP-2	
A	LAUNDRY	15	1	7	8				
B	REFRIG/KITCHEN RECEPT	15	1	9	10	2	30	WATER HEATER WH-1	
A	KITCHEN RECEPTACLES	20	1	11	12				
A	MICROWAVE/RANGE HOOD	20	1	13	14	2	40	ELECTRIC RANGE	
A	KITCHEN RECEPTACLES	20	1	15	16				
B	DISHWASHER	15	1	17	18	2	30	CLOTHES DRYER	
B	DISPOSAL	15	1	19	20				
A	ENTRY/HALL/DINING/KITCH LTS	15	1	21	22	1	20	CLOTHES WASHER	A
A	LIVING ROOM	15	1	23	24	1	15	STRUCTURED MEDIA CABINET	A
A	SPARE	15	1	25	26	1	20	SPARE	A
A	SPARE	15	1	27	28	1	20	SPARE	
	SPACE	–	1	29	30	1	–	SPACE	

REMARKS:

1. *CUTLER HAMMER "CH" LOAD CENTER OR EQUAL.*
2. *THIS SCHEDULE TYPICAL FOR LOAD CENTERS IN 1 BEDROOM UNITS IN THE 3 STORY BUILDING.*

[A] *BREAKER SHALL BE ARC-FAULT PROTECTED.*

[B] *BREAKER SHALL BE COMBINATION ARC-FAULT / GFCI PROTECTED.*

Optional Method Load Calculation for One-Family Dwellings

UNIT DESIGNATION: **UNIT 2-BED**
LOAD CENTER DESIGNATION: **LC2**
VOLTAGE: *208/120V*
PHASE/WIRE: *1PH/3W*
TOTAL AREA: *822*

1 *General Lighting and Receptacle Loads 220.82(B)(1)*
Do not include open porches, garages, and unused or unfinished spaces not adaptable for future use.
3 x 822 (sq ft using outside dimensions) = **1** 2,466

2 *Small Appliance Branch-Circuits 220.82(B)(2)*
At least two small appliance branch-circuits must be included. 210.11(C)(1)
1,500 x 2 (minimum of two) = **2** 3,000

3 *Laundry Branch Circuit 220.82(B)(2)*
At least one laundry branch-circuit must be included. 210.11(C)(2)
1,500 x 1 (minimum of one) = **3** 1,500

4 *Appliances 220.82(B)(3) and (4)*
Use the nameplate rating of ALL appliances (fastened-in-place, permanently connected, or connected to a specific circuit), ranges, ovens, cook tops, motors, and clothes dryers.
Do not include any heating or air-conditioning equipment in this section

Electric Range / 10,000	Clothes Dryer / 5,000	
Microwave / 1,200	– / –	
Dishwasher / 1,000	– / –	Water Heater / 4,500
Disposal / 800	– / –	– / –

Total volt-amperes of all appliances LISTED BELOW = **4** 22,500

5 *Apply 220.82(B) demand factor to the total of lines 1 through 4*
29,466 (total of lines 1 through 4) – 10,000 = 19,466 x 40% = 7,786 + 10,000 = **5** 17,786

6 *Heating or Air-Conditioning System 220.82(C)* *Use the nameplate rating(s) in volt-amperes for all applicable systems in lines a through f.*

a) *100 percent of air-conditioning and cooling system(s)*
3,449 x 100% = **a)** 3,449

b) *100 percent of heat pump system(s), where the heat pump is used without any supplemental heating*
2,019 x 100% = **b)** 2,019

c) *100 percent of heat pump compressor(s) and 65 percent of the supplemental electric heating, where both can operate at the same time.*
2,019 x 100% + 8,000 x 65% = **c)** –

d) *Electric space-heating equipment, if less than four seperately controlled units:*
8,000 x 65% = **d)** 5,200

e) *Electric space-heating equipment, if four or more seperately controlled units:*
– x 40% = **e)** –

f) *Electric thermal storage and other heating systems where the usual load is expected to be continuous at full name plate value: Systems qualifying under this selection shall not be figured under any other selection in 220.82(C).*
– x 100% = **f)** –

7 *Total Volt-Ampere Demand Load:* 5,200 (largest VA rating from line 6a through 6e) + 17,786 (line 5) = **7** 22,986

8 *Minimum Amperes*
Divide the total volt-amperes by the voltage
22,986 (line 15) / 208 (voltage) = **8** 111 (minimum amperes) **9** Minimum Size Service and/or Feeder (240.6(A)) **9** 125

PRINTS ISSUED
10/30/2023 - PERMIT SUBMITTAL

REVISIONS:

23.161

pkmr ENGINEERS
PEARSON KENT MCKINLEY RAAF ENGINEERS LLC
13300 W 98TH STREET LENEXA, KS 66215
913.492.2400 WWW.PKMRENG.COM
MO State Certificate of Authority #E-2002020886

STATE OF MISSOURI
MICHAEL D RAAF
NUMBER PE-2005028097
REGISTERED PROFESSIONAL ENGINEER
10/30/23
Michael D. Raaf - Engineer
MO# PE-2005028097

WILSHIRE HILLS III

LEE'S SUMMIT, MISSOURI

SHEET TITLE
ELECTRICAL SCHEDULES

PROJECT NUMBER: 23.161

SHEET NUMBER:

E303

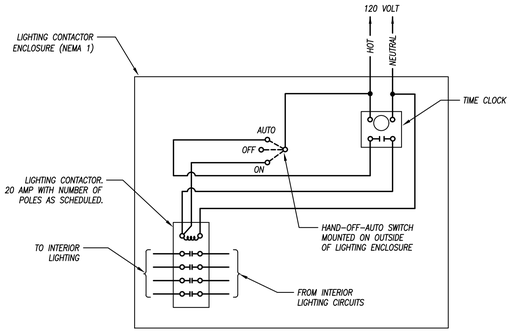

INTERIOR LIGHTING CONTROL

NOT TO SCALE

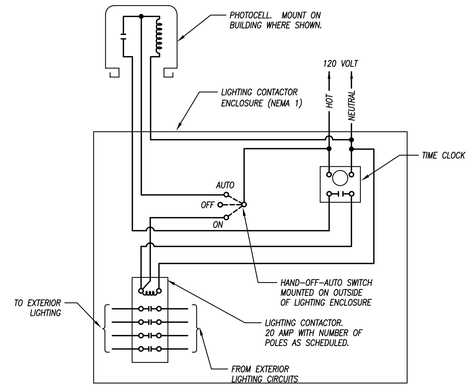

EXTERIOR LIGHTING CONTROL

NOT TO SCALE

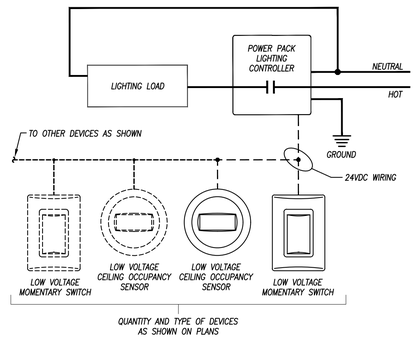

TYPICAL LIGHTING CONTROL SCHEMATIC WIRING DIAGRAM

NOT TO SCALE

SCHEDULE OF REMOTE CONTROL SWITCHES

RCS NUMBER	NUMBER OF POLES	CONTROL DATA			LOAD DATA			CONTROL	NOTES
		VOLTAGE	CIRCUIT #	PANELBOARD	LOAD	VOLTAGE	PANEL & CIRCUITS CONTROLLED		
RCS-1	8	120	2	P1	CORRIDOR LTS	120	P1: 3,5,17,19,21,23,25,27	PHOTOCELL ON / PHOTOCELL OFF	1,2,3
RCS-2	4	120	2	P1	BUILDING EXTERIOR LTS	120	P1:31,33	PHOTOCELL ON / TIMECLOCK OFF	1,2,3
RCS-3	8	120	2	P1	SITE LIGHTS	208	P1:(35,37),(39,41)	PHOTOCELL ON / TIMECLOCK OFF	1,2,3

REMARKS:

1. INSTALL IN NEMA 1 ENCLOSURE WITH MANUAL HOA SWITCH IN HINGED FRONT COVER.
2. REFER TO DETAIL THIS.
3. LOCATED IN MECH. SPRINKLER ROOM 1005.

LIGHT FIXTURE SCHEDULE

FIXTURE TYPE	MANUFACTURER	CATALOG NUMBER	DESCRIPTION	LAMP NUMBER / DESCRIPTION	VOLTAGE	REMARKS
A	RAB LIGHTING	EZPAN	2'x2' EDGE-LIT GRID TROFFER. LIGHTWEIGHT ALUMINUM HOUSING, STEEL PAN. FROSTED POLYSTYRENE LENS. INTEGRAL 0-10V DIMMING LED DRIVER.	ONE (1) 40 WATT, 4218 LUMENS, 3000K LED MODULE	120	1,3
B	SYLVANIA	ULTRA LIGHT DISK LED	RECESSED OR SURFACE MOUNT LED DOWNLIGHT, 900 LUMEN @ 13 WATT, 3000K, 82 CRI, SUITABLE FOR USE IN CLOSETS, COMPLIANT WITH NFPA 70, NEC SECTION 410.16 (A)(3) AND 410.16(C)(5), SUITABLE FOR DRY, DAMP AND WET LOCATIONS.	900 LUMENS, 13 WATTS, 3000K, 82 CRI	120	1,3
C	PROGRESS	P3569-09	SEMI-FLUSH MOUNTED FIXTURE. 19-3/8"Ø x 13-1/4" HIGH. BRUSHED NICKEL FINISH WITH GLASS BOWL.	THREE (3) 18 WATT LED REPLACEMENT LAMPS	120	1,3,4
D	PROGRESS LIGHTING	P5068-09	AVALON MINI-PENDANT, ALABASTER GLASS SHADE, BRUSHED NICKEL FINISH, ONE (1) 100 WATT MEDIUM BASE SOCKET, CEILING STEM MOUNT, TWO (2) 12" AND TWO (2) 15" SECTIONS OF MATCHING STEM INCLUDED TO ATTAIN VARIOUS DESIRED LENGTHS.	ONE (1) 100 WATT MEDIUM BASE LAMP	120	1,3,4
E	DUAL-LITE	EV SERIES	LOW-PROFILE EMERGENCY LIGHTING UNIT. FLAME-RATED, UV-STABLE THERMOPLASTIC HOUSING. TWO (2) SEMI-RECESSED, ADJUSTABLE "EYEBALL" HEADS WITH GLASS LENS. WHITE FINISH. MAINTENANCE-FREE BATTERY FOR 90 MINUTE OPERATION OF LAMPS. INTEGRAL TEST SWITCH AND AC-ON INDICATOR. FURNISH WITH 2 WATT LED HEADS FOR 33' SPACING AT 6' PATH WIDTH.	TWO (2) 2 WATT LED HEADS.	120	1
E2	DUAL-LITE	PG SERIES	EXTERIOR WALL-MOUNTED EMERGENCY LIGHTING FIXTURE. DIE-CAST HOUSING WITH ALUMINUM REFLECTOR AND ACRYLIC LENS. FURNISH WITH OPTIONAL BATTERY HEATER. UL-LISTED WET LOCATION. DARK BRONZE FINISH.	FOUR (4) HIGH-OUTPUT LEDS - TOTAL POWER CONSUMPTION = 15.2 WATTS.	120	1
F	WILLIAMS	SERIES 76	4'-0" LONG COMMERCIAL-GRADE STRIP FIXTURE. CHAIN MOUNT FROM CEILING AT 8-6" A.F.F. WHITE FINISH. INTEGRAL LED DRIVER PRE-WIRED FOR NON-DIMMING APPLICATIONS.	ONE (1) 44 WATT, 5500 LUMEN, L50 LED MODULE. 3500K CCT.	120	1
G	METALUX	SERIES 39	4'-0" LONG SURFACE MOUNTED WRAP-AROUND LED FIXTURE. STEEL HOUSING WITH CLEAR EXTRUDED ACRYLIC DIFFUSER. SQUARE WHITE END CAPS. WHITE POWDER COAT FINISH. INTEGRAL LED DRIVER.	ONE (1) 42.4 WATT, 4000 LUMEN, 40SL LED MODULE. 3000K CCT.	120	1
H	MINKA LAVERY	4460-84	ADA-COMPLIANT DECORATIVE WALL SCONCE. 4.25" x 15.25" HIGH. BRUSHED NICKEL FINISH WITH ETCHED OPAL GLASS SHADE.	ONE (1) 9 WATT T-10 TUBULAR LED REPLACEMENT LAMP	120	1,3,4
J	PROGRESS	P4328-09	LARGE PENDANT-MOUNTED FIXTURE. 23"Ø x 24-1/2" HIGH WITH CHAIN. ETCHED GLASS SHADES. BRUSHED NICKEL FINISH. FIVE-LAMP, SINGLE TIER FOYER FIXTURE.	FIVE (5) 18W A19 LED REPLACEMENT BULBS	120	1,3,4
L	PROGRESS	P7250-0930K9	FLUSH MOUNTED FIXTURE. 19-3/8" Ø. BRUSHED NICKEL FINISH WITH WHITE ACRYLIC DIFFUSER.	ONE (1) 31 WATT LED MODULE. 3000K CCT	120	1,3
M	WILLIAMS	SERIES 29	4'-0" LONG WALL-MOUNTED UP/DOWN LIGHT. STEEL HOUSING WITH CLEAR ACRYLIC PRISMATIC LENS. ALL PARTS PAINTED WHITE AFTER FABRICATION. ELECTRONIC BALLAST.	ONE (1) 42.2 WATT, 5400 LUMEN, L54 LED MODULE. 3500K CCT.	120	1
P	PROGRESS	P2010-09	21.5" WIDE, WALL-MOUNTED, DECORATIVE UPLIGHT VANITY FIXTURE. BRUSHED NICKEL FINISH.. ETCHED GLASS LAMP SHADES. DAMP LOCATION LISTED.	THREE (3) 18 WATT LED REPLACEMENT LAMPS	120	1,3,4
R	LUMARK	CROSSTOUR FLOODLIGHT KIT	EXTERIOR GROUND-MOUNTED RECTANGULAR WIDE FLOOD LED. FIXTURE. SWIVEL MOUNTING. FINISH AS DIRECTED BY ARCHITECT. U.L. LISTED WET LOCATION. FURNISH FIXTURE WITH STANCHION FOR MOUNTING ON GRADE. SET BASE IN CONCRETE AS DIRECTED BY FIXTURE MANUFACTURER - REFER TO DETAIL ON SITE PLAN FOR ADDITIONAL BASE WORK.	ONE (1) 26 WATT, 2804 LUMEN, LED MODULE. 3500K COLOR TEMPERATURE.	120	1
R2	RAB LIGHTING	LFLOOD MIGHTY POST	COMPACT BULLET STYLE LIGHT. SPOT DISTRIBUTION. DIE-CAST ALUMINUM HOUSING, HOOD, AND MOUNTING ARM WITH SET SCREW. CLEAR TEMPERED GLASS LENS AND ONE PIECE STAMPED SILICONE GASKET. COLD WEATHER RATED FOR -40°F STARTING. POWDER COAT BRONZE FINISH OR AS DIRECTED BY ARCHITECT. UL LISTED WET LOCATION. 2-1/2" PVC MOUNTING POST WITH METAL CAP. CAST IN CONCRETE PER MANUFACTURER'S RECOMMENDATIONS. FINISH SAME AS FIXTURE HOUSING.	ONE (1) 13 WATT LED, 3000K, 84 CRI	120	1
S	SPAULDING	FN1 LED SERIES	6.75" SQUARE, 36" HIGH LIGHT BOLLARD. EXTRUDED ALUMINUM RISER WITH FLAT TOP. SEALED, ONE-PIECE ACRYLIC LENS. HEAVY CAST ALUMINUM ANCHOR BASE - REFER TO DETAIL ON SITE PLAN FOR ADDITIONAL BASE WORK. DARK BRONZE FINISH.	ONE (1) 31 WATT, LED MODULE. 3500K COLOR TEMPERATURE.	208	1
T	PROGRESS LIGHTING	P5673-108	DECORATIVE, WALL-MOUNTED LIGHT FIXTURE. 12" WIDE x 32-3/4" CAST ALUMINUM HOUSING WITH BEVELED GLASS LENS. OIL RUBBED BRONZE FINISH.	FOUR (4) 60 WATT CANDELABRA INCANDESCANT BULBS	120	1,3,5
T1	PROGRESS LIGHTING	P5671-108	DECORATIVE, WALL-MOUNTED LIGHT FIXTURE. 8-1/2" WIDE x 16-3/4" CAST ALUMINUM HOUSING WITH BEVELED GLASS LENS. OIL RUBBED BRONZE FINISH.	TWO (2) 60 WATT CANDELABRA INCANDESCANT BULBS	120	1,3,5
U	WILLIAMS	6DR SERIES	6" ROUND RECESSED DOWNLIGHT. DIE-FORMED STEEL PAN WITH FINNED, EXTRUDED ALUMINUM PASSIVE HEAT SINK. SELF-FLANGED, SEMI-SPECULAR LOW IRIDESCENT FINISH ALUMINUM REFLECTOR WITH MEDIUM BEAM ANGLE/DISTRIBUTION AND RECESSED LENS. INTEGRAL LED DRIVER PRE-WIRED FOR 0-10V DIMMING APPLICATIONS. WET LOCATION LISTED UNDER COVERED CEILING.	ONE (1) 43.9 WATT, 5000 LUMEN, L50 LUMEN PACKAGE. 3500K CCT.	120	1
W	RAB LIGHTING	ALED	POLE-MOUNTED 78W LED AREA LIGHT. ARCHITECTURAL, ONE-PIECE DIE-CAST ALUMINUM HOUSING. DIE-CAST ALUMINUM DOOR. FULLY GASKETED, CLEAR, FLAT, TEMPERED GLASS LENS. IES TYPE III DISTRIBUTION. IESNA FULL CUTOFF LIGHTING CLASSIFICATION. LOW TEMP STARTING. DECORATIVE UPSWEPT DIE CAST ALUMINUM MOUNTING ARM. POWDER COAT FINISH IN COLOR AS DIRECTED BY ARCHITECT. PROVIDE WITH 20'-0" HIGH, STRAIGHT, SQUARE STEEL POLE.	SIX (6) MULTI-CHIP, HIGH-OUTPUT LED MODULE. 8,765 LUMENS. 3000K.	208	1
W2	RAB LIGHTING	ALED	POLE-MOUNTED AREA LIGHT WITH TWO HEADS @ 180 DEGREES APART. ARCHITECTURAL, ONE-PIECE DIE-CAST ALUMINUM HOUSING. DIE-CAST ALUMINUM DOOR. FULLY GASKETED, CLEAR, FLAT, TEMPERED GLASS LENS. IES TYPE II DISTRIBUTION. IESNA FULL CUTOFF LIGHTING CLASSIFICATION. LOW TEMP STARTING. DECORATIVE UPSWEPT DIE CAST ALUMINUM MOUNTING ARM. POWDER COAT FINISH IN COLOR AS DIRECTED BY ARCHITECT. PROVIDE WITH 20'-0" HIGH, STRAIGHT, SQUARE STEEL POLE.	PER HEAD - SIX (6) MULTI-CHIP, HIGH-OUTPUT LEDS. 8,765 LUMENS. 5000K.	208	1
X	DUAL-LITE	SEMPRA SERIES	COMPACT, LOW-PROFILE EXIT SIGN. CAST ALUMINUM CONSTRUCTION. FINISH BLACK WITH BRUSHED ALUMINUM FACE. RED LETTERS. END, TOP, OR WALL MOUNTED IN SINGLE/DOUBLE FACE CONFIGURATION WITH DIRECTIONAL ARROWS AS INDICATED ON PLANS. FURNISH WITH EMERGENCY OPTION FOR MAINTENANCE-FREE NICKEL-CADMIUM BATTERY FOR 2 HOUR OPERATION WITH INTEGRAL TEST SWITCH AND AC-ON LIGHT.	FOUR (4) HIGH-OUTPUT LEDS - TOTAL POWER CONSUMPTION = 3.8 WATTS.	120	1
ARA	DUAL-LITE	SEMPRA SERIES	COMPACT, LOW-PROFILE INDICATOR LIGHT. CAST ALUMINUM CONSTRUCTION. FINISH BLACK WITH BRUSHED ALUMINUM FACE. RED LETTERS. WALL MOUNTED. FURNISH WITH SPECIAL WORDING OPTION SW13 - SIGN TO READ "AREA OF RESCUE ASSISTANCE" WITH WHEELCHAIR SYMBOL. FURNISH WITH EMERGENCY OPTION FOR MAINTENANCE-FREE NICKEL-CADMIUM BATTERY FOR 2 HOUR OPERATION WITH INTEGRAL TEST SWITCH AND AC-ON LIGHT.	FOUR (4) HIGH-OUTPUT LEDS - TOTAL POWER CONSUMPTION = 3.8 WATTS.	120	1
AA	NORA LIGHTING	NLOPAC	5" SURFACE MOUNTED DOWNLIGHT. MOUNTS TO STANDARD JUNCTION BOX. INTEGRAL LINE VOLTAGE DIMMABLE LED DRIVER. UL-LISTED FOR WET CELING LOCATIONS. SUITABLE FOR USE IN CLOSETS.	ONE (1) 16.5 WATT, 1100 LUMEN, LED MODULE. 3000K CCT.	120	1
AB	PROGRESS LIGHTING PROGRESS LIGHTING	P2501-09 P2612-09WB	52" BUILDER AIR PRO ENERGY STAR CEILING FAN, BRUSHED NICKEL FINISH, FIVE (5) REVERSIBLE CHERRY/NATURAL CHERRY BLADES, REVERSIBLE, 12 DEGREE PITCH LIGHT KIT. BRUSHED NICKEL FINISH, THREE (3) PORCELAIN CANDELABRA SOCKETS	- TWO (2) 10 WATT LED LAMPS (INCLUDED)	120	1,3 1,3,4
AE	PROGRESS	P2010-09	3 LIGHT VANITY FIXTURE IN BRUSHED NICKEL FINISH WITH ETCHED GLASS FLUTED SHADES, 21-1/2" WIDE X 6-5/8" HIGH. FURNISH IN "DOWN" POSITION.	THREE (3) 100 WATT A19 INCANDESCENT.	120	1,2,3
AF	PROGRESS LIGHTING	P3925-09	FLUSHMOUNT 13 1/4" X 5-7/8", BRUSHED NICKEL FINISH, ALABASTER GLASS, WITH TWO (2) MEDIUM BASE 75 WATT MAX BULBS. SOLID TRIM AND DECORATIVE KNOBS. DAMP LOCATION LISTED.	TWO (2) 75 WATT MEDIUM BASE INCANDESCENT	120	1,3,4
AG	PROGRESS LIGHTING	P5068-09	AVALON MINI-PENDANT, ALABASTER GLASS SHADE, BRUSHED NICKEL FINISH, ONE (1) 100 WATT MEDIUM BASE SOCKET, CEILING STEM MOUNT, TWO (2) 12" AND TWO (2) 15" SECTIONS OF MATCHING STEM INCLUDED TO ATTAIN VARIOUS DESIRED LENGTHS.	ONE (1) 100 WATT MEDIUM BASE LAMP	120	1,3,4
N1	KICHLER	4U	22" LONG LOW-PROFILE UNDER-CABINET FIXTURE. FLAT, FROSTED DIFFUSE LENS. INTEGRAL LED DRIVER. WHITE FINISH. COORDINATE LENGTH WITH MILLWORK SHOP DRAWINGS.	ONE (1) 10 WATT, 551 LUMEN, LINEAR LED MODULE. 3000K CCT.	120	1,2

REMARKS:

1. FURNISH WITH AND INSTALL ALL NECESSARY HARDWARE AND MOUNTING BRACKETS.
2. FURNISH FIXTURE WITH WIRE GUARD.
3. FIXTURE HAS BEEN SELECTED BY OWNER. IN GENERAL, NO SUBSTITUTIONS WILL BE ALLOWED - COORDINATE SAME WITH OWNER.
4. FURNISH FIXTURE WITH CREE SCREW-IN BASE OMNIDIRECTIONAL LED LAMPS IN LIEU OF INCANDESCENT LAMPS. USE 9W LAMPS FOR 60W INCANDESCENT, 6W FOR 40W, 13.5W FOR 75W, AND 18W FOR 100W.
5. INSTALL FIXTURE SUCH THAT BOTTOM IS AT OR ABOVE 84" AFF FOR ADA CLEARANCE REQUIREMENTS.

GENERAL NOTES (APPLICABLE TO ALL FIXTURES):

1) REFER TO SPECIFICATIONS FOR APPROVED EQUAL FIXTURE MANUFACTURERS AND ADDITIONAL FIXTURE/DRIVER/BALLAST REQUIREMENTS.
2) ALL FIXTURES WITH PAINTED METAL PARTS SHALL BE PAINTED AFTER FABRICATION.
3) LUMENS LISTED FOR LED FIXTURES ARE GENERALLY DELIVERED LUMENS UNLESS NOTED OTHERWISE.
4) ALL EXTERIOR LED FIXTURES ARE FULL CUTOFF UNLESS NOTED OTHERWISE.
5) ALL FIXTURES SHALL BE IC RATED OR PROVIDED WITH INSULATION SHIELDS WHEN INSTALLED IN INSULATED AREAS OF THE TRUSS SPACE.
6) FOR ALL FIXTURES INSTALLED IN RATED ASSEMBLIES, FURNISH AND INSTALL APPROVED FIRE BARRIER (E.G. BARRIER OR TENMAT FF109 SERIES) OVER FIXTURE TO MAINTAIN 1 HOUR CEILING ASSEMBLY RATING.

PRINTS ISSUED

10/30/2023 - PERMIT SUBMITTAL

REVISIONS:

pkmr ENGINEERS
PEARSON KENT MCKINLEY RAAF ENGINEERS LLC
13300 W 98TH STREET LENEXA, KS 66215
913.492.2400 WWW.PKMRENG.COM
MO State Certificate of Authority #E-2002020886

23.161

STATE OF MISSOURI
MICHAEL D RAAF
NUMBER PE-2005028097
REGISTERED PROFESSIONAL ENGINEER
10/30/23
Michael D. Raaf - Engineer
MO# PE-2005028097

WILSHIRE HILLS III

LEE'S SUMMIT, MISSOURI

SHEET TITLE
ELECTRICAL SCHEDULES/DETAILS

PROJECT NUMBER: 23.161

SHEET NUMBER:

E401

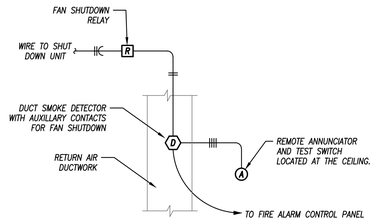

DUCT SMOKE DETECTOR DIAGRAM

NOT TO SCALE

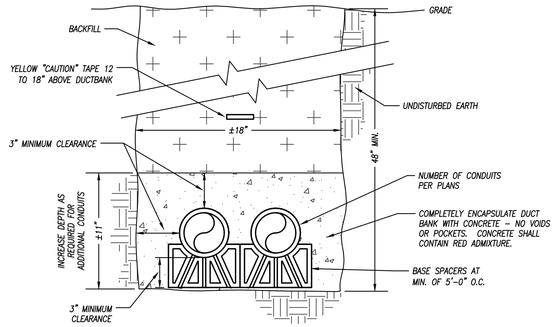

UNDERGROUND ELECTRICAL DUCTBANK DETAIL

NOT TO SCALE

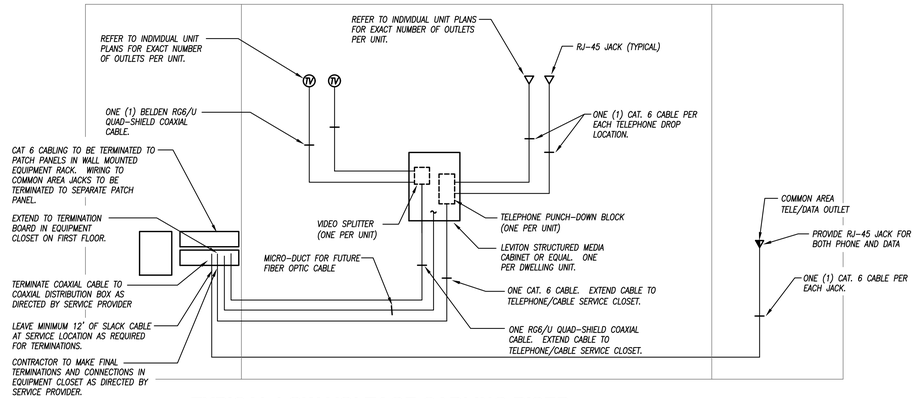

TYPICAL LOW-VOLTAGE CABLING RISER

NOT TO SCALE

TYPICAL FOR EACH DWELLING UNIT

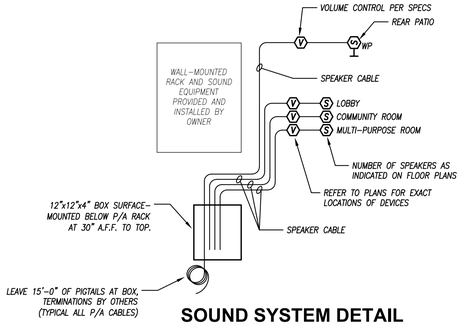

SOUND SYSTEM DETAIL

NOT TO SCALE

SOUND SYSTEM SPECIFICATIONS:

SOUND SYSTEM CABLING: ALL INTERCOM SYSTEM CABLING SHALL BE PLENUM–RATED AND PER MANUFACTURER'S RECOMMENDATIONS. ROOM SPEAKER CIRCUIT CABLING SHALL BE (4)#22 FOIL SHIELD PLENUM CABLE (WESTPENN 25357 OR EQUAL). TERMINATE ALL ROOM SPEAKER CABLE RUNS ON SPLIT PUNCH BLOCKS (R66BJ–50W OR EQUAL).

SPEAKERS SHALL BE DUKANE MODEL 5A606, OR EQUAL, WITH 710–3092 25/70V TRANSFORMERS HAVING TAPS AT 0.5, 1.0, 2.0 WATTS.

SPEAKERS SHALL BE ENCLOSED IN WALL OR CEILING MOUNTED FLUSH BAFFLES, DUKANE MODEL 6A633, OR EQUAL. GRILLES SHALL BE CONSTRUCTED OF STEEL, FINISHED IN FLAT WHITE PAINT. GRILLES MAY BE PAINTED TO MATCH ROOM DECOR. THE 8" SPEAKER SHALL BE MOUNTED ON A SEPARATE STEEL PLATE. SPEAKER BACK BOXES SHALL BE DUKANE MODEL 145–222, OR EQUAL. SPEAKERS MOUNTED IN SUSPENDED CEILING TILES SHALL INCLUDE WEIGHT SUPPORTING BRIDGES, DUKANE MODEL 677–67, OR EQUAL.

CORRIDOR SPEAKER BAFFLES SHALL BE BI–DIRECTIONAL ATLAS/SOUNDOLIER MODEL 512–8, OR EQUAL. CYLINDRICAL BAFFLES CONSTRUCTED OF SPUN ALUMINUM SHALL NOT BE ACCEPTABLE. THE ASSEMBLY SHALL MOUNT TO A 4–INCH, 2–GANG J–BOX. MINIMUM MOUNTING HEIGHT SHALL BE 80" AFF, OR AS INDICATED ON DRAWINGS.

SPEAKERS SHALL BE TAPPED AS FOLLOWS:
COMMUNITY ROOM AND FLOOR PARLOR: 0.5 WATTS
REAR PATIO AND POOL TABLE AREA: 1.0 WATTS

VOLUME CONTROLS: THE VOLUME CONTROLS SHALL BE DUKANE MODEL 9A1550A, OR EQUAL, AND WIRED INTO THE SPEAKER TRANSFORMER PRIMARY CIRCUITS. HEIGHT SHALL NOT EXCEED 48" A.F.F.

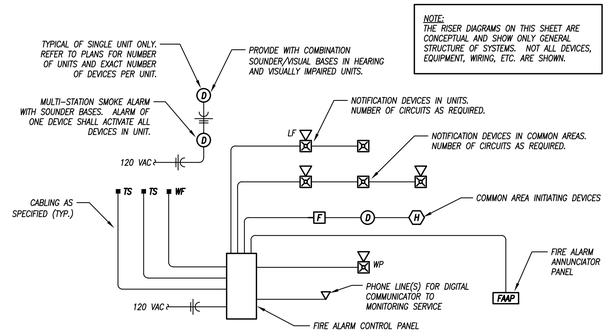

FIRE ALARM SYSTEM RISER DIAGRAM

NOT TO SCALE

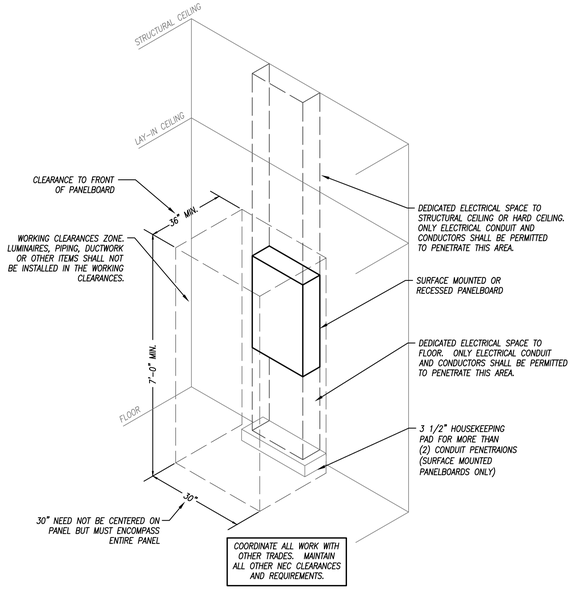

TYPICAL PANELBOARD INSTALLATION DETAIL

NOT TO SCALE

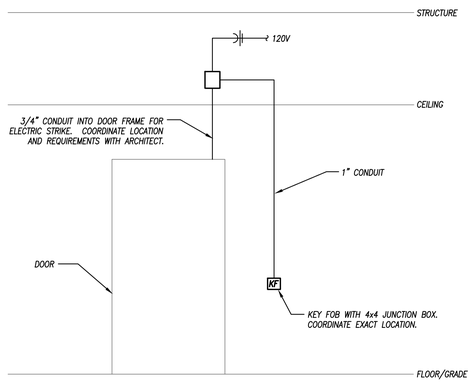

ACCESS CONTROL SYSTEM DETAIL

NOT TO SCALE

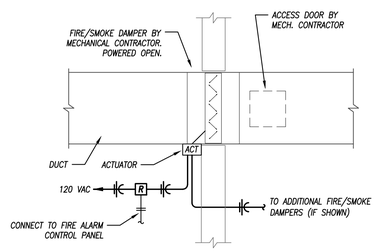

FIRE/SMOKE DAMPER WIRING DIAGRAM

NOT TO SCALE

PRINTS ISSUED
10/30/2023 - PERMIT SUBMITTAL

REVISIONS:

pkmr ENGINEERS
PEARSON KENT MCKINLEY RAAF ENGINEERS LLC
13300 W 98TH STREET LENEXA, KS 66215
913.492.2400 WWW.PKMRENG.COM
MO State Certificate of Authority #E-2002020886

23.161

STATE OF MISSOURI
MICHAEL D RAAF
NUMBER PE-2005028097
REGISTERED PROFESSIONAL ENGINEER
10/30/23
Michael D. Raaf - Engineer
MO# PE-2005028097

WILSHIRE HILLS III

LEE'S SUMMIT, MISSOURI

SHEET TITLE
ELECTRICAL DETAILS

PROJECT NUMBER: 23.161

SHEET NUMBER:

E402

ALED3T78Y USA

RAB

Color: Bronze

Weight: 23.1 lbs

Project:	Type:
Prepared By:	Date:

Driver Info

Type	Constant Current
120V	0.66A
208V	0.41A
240V	0.35A
277V	0.30A
Input Watts	76.8W

LED Info

Watts	78W
Color Temp	3000K (Warm)
Color Accuracy	70 CRI
L70 Lifespan	100,000 Hours
Lumens	8,765 lm
Efficacy	114.1 lm/W

Technical Specifications

Performance

Lifespan:

100,000-Hour LED lifespan based on IES LM-80 results and TM-21 calculations

Wattage Equivalency:

Equivalent to 250W Metal Halide

Compliance

DLC Listed:

This product is on the Design Lights Consortium (DLC) Qualified Products List and is eligible for rebates from DLC Member Utilities.
DLC Product Code: P000019TF

IP Rating:

Ingress protection rating of IP66 for dust and water

IESNA LM-79 & LM-80 Testing:

RAB LED luminaires and LED components have been tested by an independent laboratory in accordance with IESNA LM-79 and LM-80

UL Listed:

Suitable for wet locations as a downlight

Construction

IES Classification:

The Type III distribution is ideal for roadway, general parking and other area lighting applications where a larger pool of lighting is required. It is intended to be located near the side of the area, allowing the light to project outward and fill the area.

Ambient Temperature:

Suitable for use in up to 40°C (104°F)

Cold Weather Starting:

The minimum starting temperature is -40°C (-40°F)

Thermal Management:

Superior heat sinking with external Air-Flow fins

Lens:

Tempered glass lens

Housing:

Die-cast aluminum housing, lens frame and mounting arm

Mounting:

Universal mounting arm compatible for hole spacing patterns from 1" to 5 1/2" center to center. Round Pole Adaptor plate included as a standard. Easy slide and lock to mount fixture with ease. Round pole diameter must be >4" to mount fixtures at 90° orientation.

Reflector:

Specular vacuum-metallized polycarbonate

Gaskets:

High-temperature silicone gaskets

EPA:

1 Fixture: 0.75
2 Fixtures at 90°: 1.2
2 Fixtures at 180°: 2.4
3 Fixtures at 90°: 2.4
4 Fixtures at 90°: 1.8

Finish:

Formulated for high durability and long-lasting color

Green Technology:

Mercury and UV free, RoHS-compliant components.

LED Characteristics

LEDs:

Six (6) multi-chip, 13W, high-output, long-life LEDs

Color Consistency:

3-step MacAdam Ellipse binning to achieve consistent fixture-to-fixture color

Color Stability:

LED color temperature is warrantied to shift no more than 200K in color temperature over a 5-year period.

Need help? Tech help line: **(888) 722-1000** Email: **sales@rablighting.com** Website: **www.rablighting.com**

Copyright © 2023 RAB Lighting All Rights Reserved Note: Specifications are subject to change at any time without notice

HUBBELL Outdoor Lighting

DATE: LOCATION:
TYPE: PROJECT:
CATALOG #:

FRESNO Series

BOLLARDS

FEATURES

- Two size options available
- Sealed one-piece, clear acrylic lens
- Specular, anodized aluminum optical systems
- 30w and 46w energy-efficient LED systems
- Extruded aluminum square or round housing, with tamper resistant hardware
- Flat top, or optional dome top for round FN2

RELATED PRODUCTS

Bristol Park Pavilion Family

SPECIFICATIONS

HOUSING

- Extruded aluminum 6061 alloy square or round housing, with tamper resistant hardware; flat top, for round FN2
- Single screw access for service and maintenance
- Sealed one-piece, clear acrylic lens; Specular, anodized aluminum optical systems
- Concealed, cast aluminum 360 alloy anchor base; four 1/2" x 10" anchor bolts
- Durable Lektrocote® TGIC thermoset polyester powder coat paint finish assures long life and maintenance-free service

OPTICS

- Available in 5000K, 4000K, 3000K CCT and Monochromatic Amber
- Long Life >60,000 hour L90 rated at 25°C
- Optional continuous dimming to 10%
- Rotatable LED assembly adjustment for ideal placement and aiming of asymmetric light pattern

ELECTRICAL

- Universal voltage (120-277, 50/60Hz) drivers with +/- 10% tolerance, starting temperature rated at -20°F

CERTIFICATIONS

- Listed to UL1598 for use in wet locations

WARRANTY

- 5 year limited warranty
- See HLI Standard Warranty for additional information

© 2020 Hubbell Outdoor Lighting, a division of Hubbell Lighting, Inc. Specifications subject to change without notice.
701 Millennium Blvd • Greenville, SC 29607 / Tel 864.678.1000 / Website www.hubbelloutdoor.com

HUBBELL Lighting

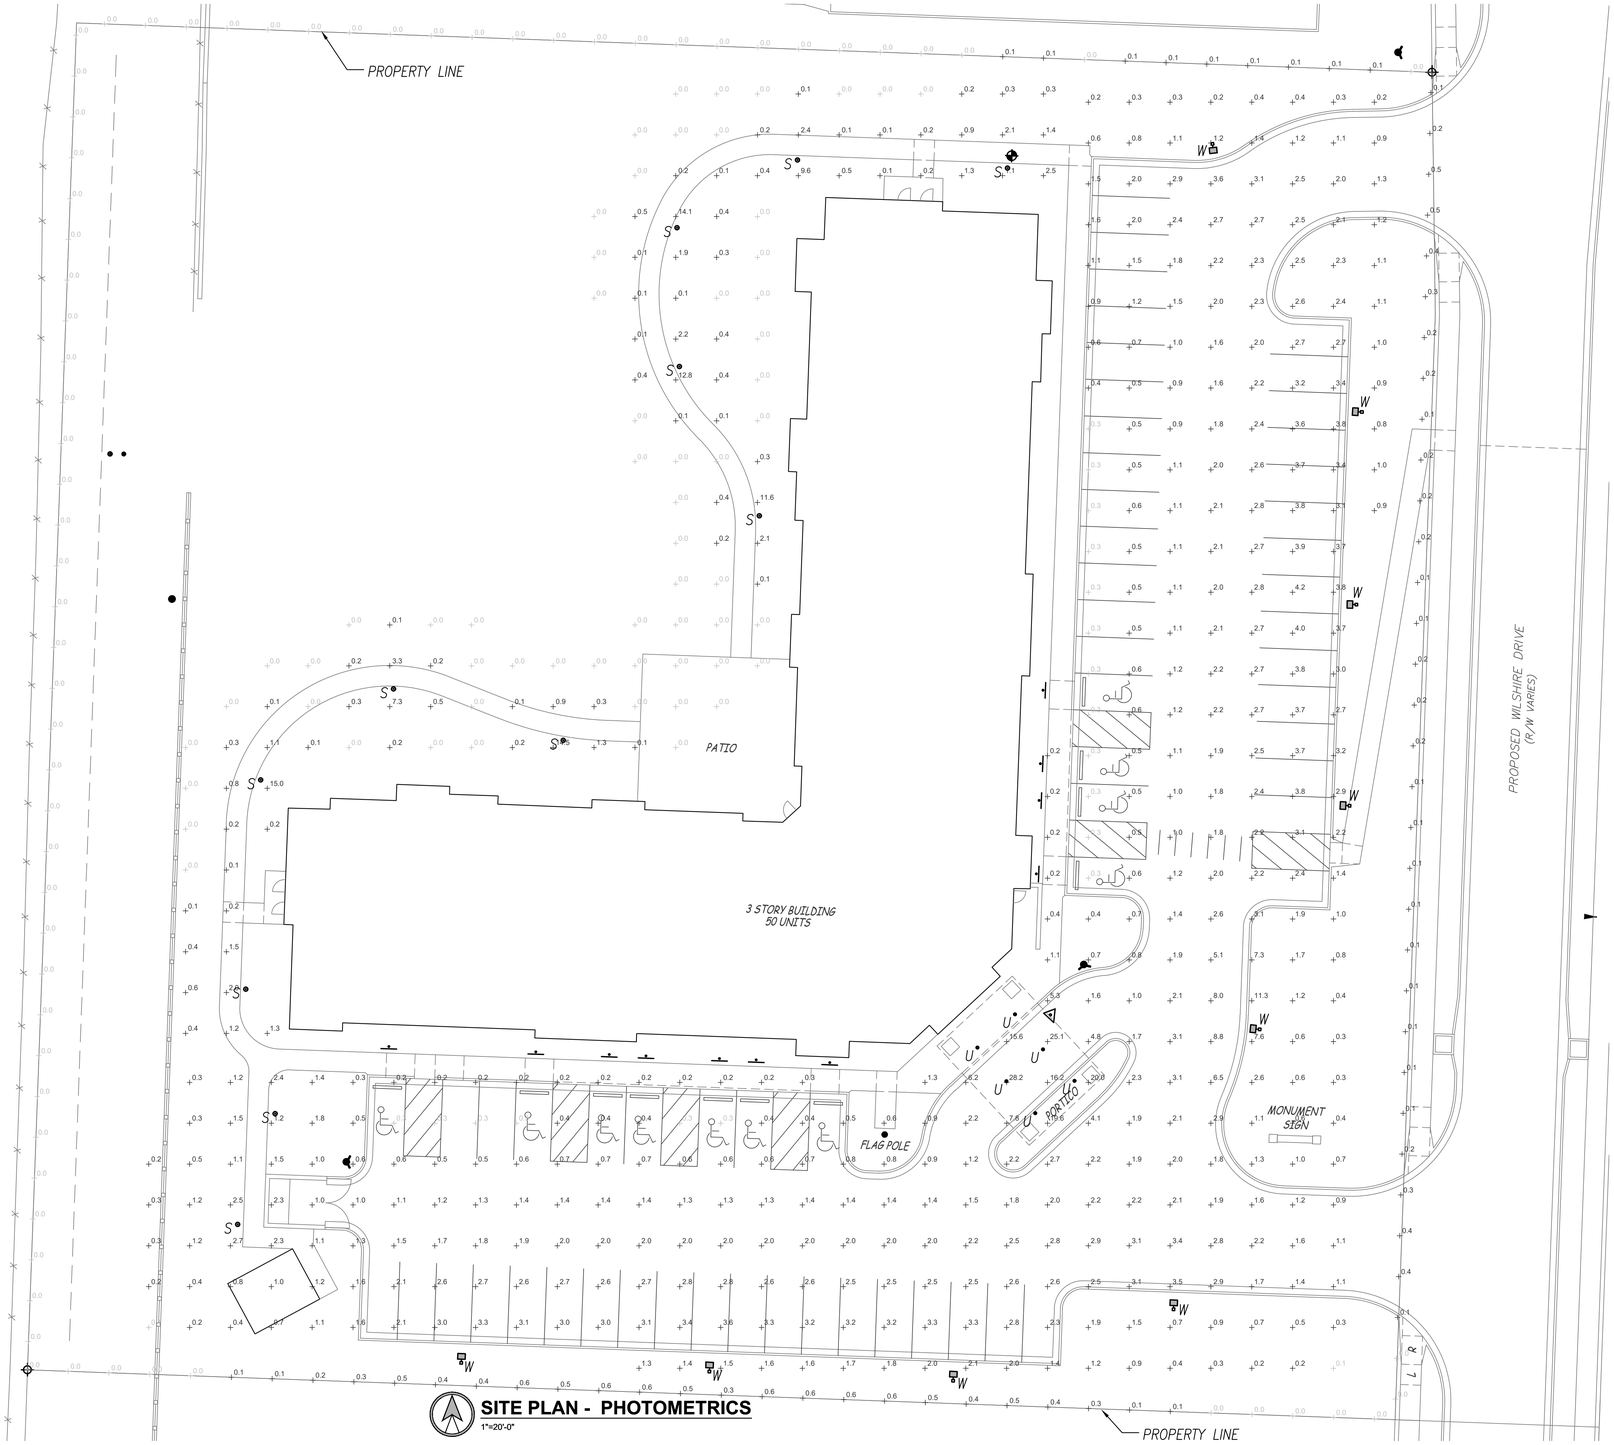

SITE PLAN - PHOTOMETRICS

1"=20'-0"

PARKING LOT STATISTICS

DESCRIPTION	MAINTAINED LIGHTING LEVELS			UNIFORMITY	
	AVG. (F.C.)	MAX. (F.C.)	MIN. (F.C.)	MAX. / MIN.	AVG. / MIN.
PARKING LOT	*1.8*	*4.2*	*0.3*	*14.0 : 1*	*6.0 : 1*

NOTES:
1. NUMBERS INDICATE FOOTCANDLE LEVELS AT GRADE.
2. CALCULATIONS PERFORMED USING VISUAL 2020.
3. THERE SHALL BE NO DIRECT ILLUMINATION OF RESIDENTIAL PROPERTIES ADJACENT TO THIS PROPERTY OR ACROSS PUBLIC RIGHT-OF-WAY.

LIGHT FIXTURE SCHEDULE - SITE LIGHTING

FIXTURE TYPE	MANUFACTURER	CATALOG NUMBER	DESCRIPTION	LAMP NUMBER / DESCRIPTION
S	*SPAULDING*	*FN1 LED SERIES*	*6.75" SQUARE, 36" HIGH LIGHT BOLLARD. EXTRUDED ALUMINUM RISER WITH FLAT TOP. SEALED, ONE-PIECE ACRYLIC LENS. HEAVY CAST ALUMINUM ANCHOR BASE – REFER TO DETAIL ON SITE PLAN FOR ADDITIONAL BASE WORK. DARK BRONZE FINISH.*	*ONE (1) 31 WATT, LED MODULE. 3500K COLOR TEMPERATURE.*
U	*WILLIAMS*	*6DR SERIES*	*6" ROUND RECESSED DOWNLIGHT. DIE-FORMED STEEL PAN WITH FINNED, EXTRUDED ALUMINUM PASSIVE HEAT SINK. SELF-FLANGED, SEMI-SPECULAR LOW IRIDESCENT FINISH ALUMINUM REFLECTOR WITH MEDIUM BEAM ANGLE/DISTRIBUTION AND REGRESSED LENS. INTEGRAL LED DRIVER PRE-WIRED FOR 0-10V DIMMING APPLICATIONS. WET LOCATION LISTED UNDER COVERED CEILING.*	*ONE (1) 43.9 WATT, 5000 LUMEN, L50 LUMEN PACKAGE. 3500K CCT.*
W	*RAB LIGHTING*	*ALED*	*POLE-MOUNTED 78W LED AREA LIGHT. ARCHITECTURAL ONE-PIECE DIE-CAST ALUMINUM HOUSING. DIE-CAST ALUMINUM DOOR. FULLY GASKETED, CLEAR, FLAT, TEMPERED GLASS LENS. IES TYPE III DISTRIBUTION. IESNA FULL CUTOFF LIGHTING CLASSIFICATION. LOW TEMP STARTING. DECORATIVE UPSWEPT DIE CAST ALUMINUM MOUNTING ARM. POWDER COAT FINISH IN COLOR AS DIRECTED BY ARCHITECT. PROVIDE WITH 20'-0" HIGH, STRAIGHT, SQUARE STEEL POLE.*	*SIX (6) MULTI-CHIP HIGH-OUTPUT LED MODULE. 8,765 LUMENS. 3000K.*

PRINTS ISSUED
10/30/2023 - PERMIT SUBMITTAL

REVISIONS:

23.161

pkmr ENGINEERS
PEARSON KENT MCKINLEY RAAF ENGINEERS LLC
13300 W 98TH STREET LENEXA, KS 66215
913.492.2400 WWW.PKMRENG.COM
MO State Certificate of Authority #E-2002020886

STATE OF MISSOURI
MICHAEL D RAAF
NUMBER PE-2005028097
REGISTERED PROFESSIONAL ENGINEER
10/30/23

Michael D. Raaf - Engineer
MO# PE-2005028097

WILSHIRE HILLS III

LEE'S SUMMIT, MISSOURI

SHEET TITLE
SITE PHOTOMETRICS

PROJECT NUMBER: 23.161

SHEET NUMBER:

SL100